



FED. ROAD DIST. NO.	STATE	FED. AID PROJ. NO.	FISCAL YEAR	SHEET NO.	TOTAL SHEETS
HAWAII	HAW.	IM-HI-1(268)	2013	8	31

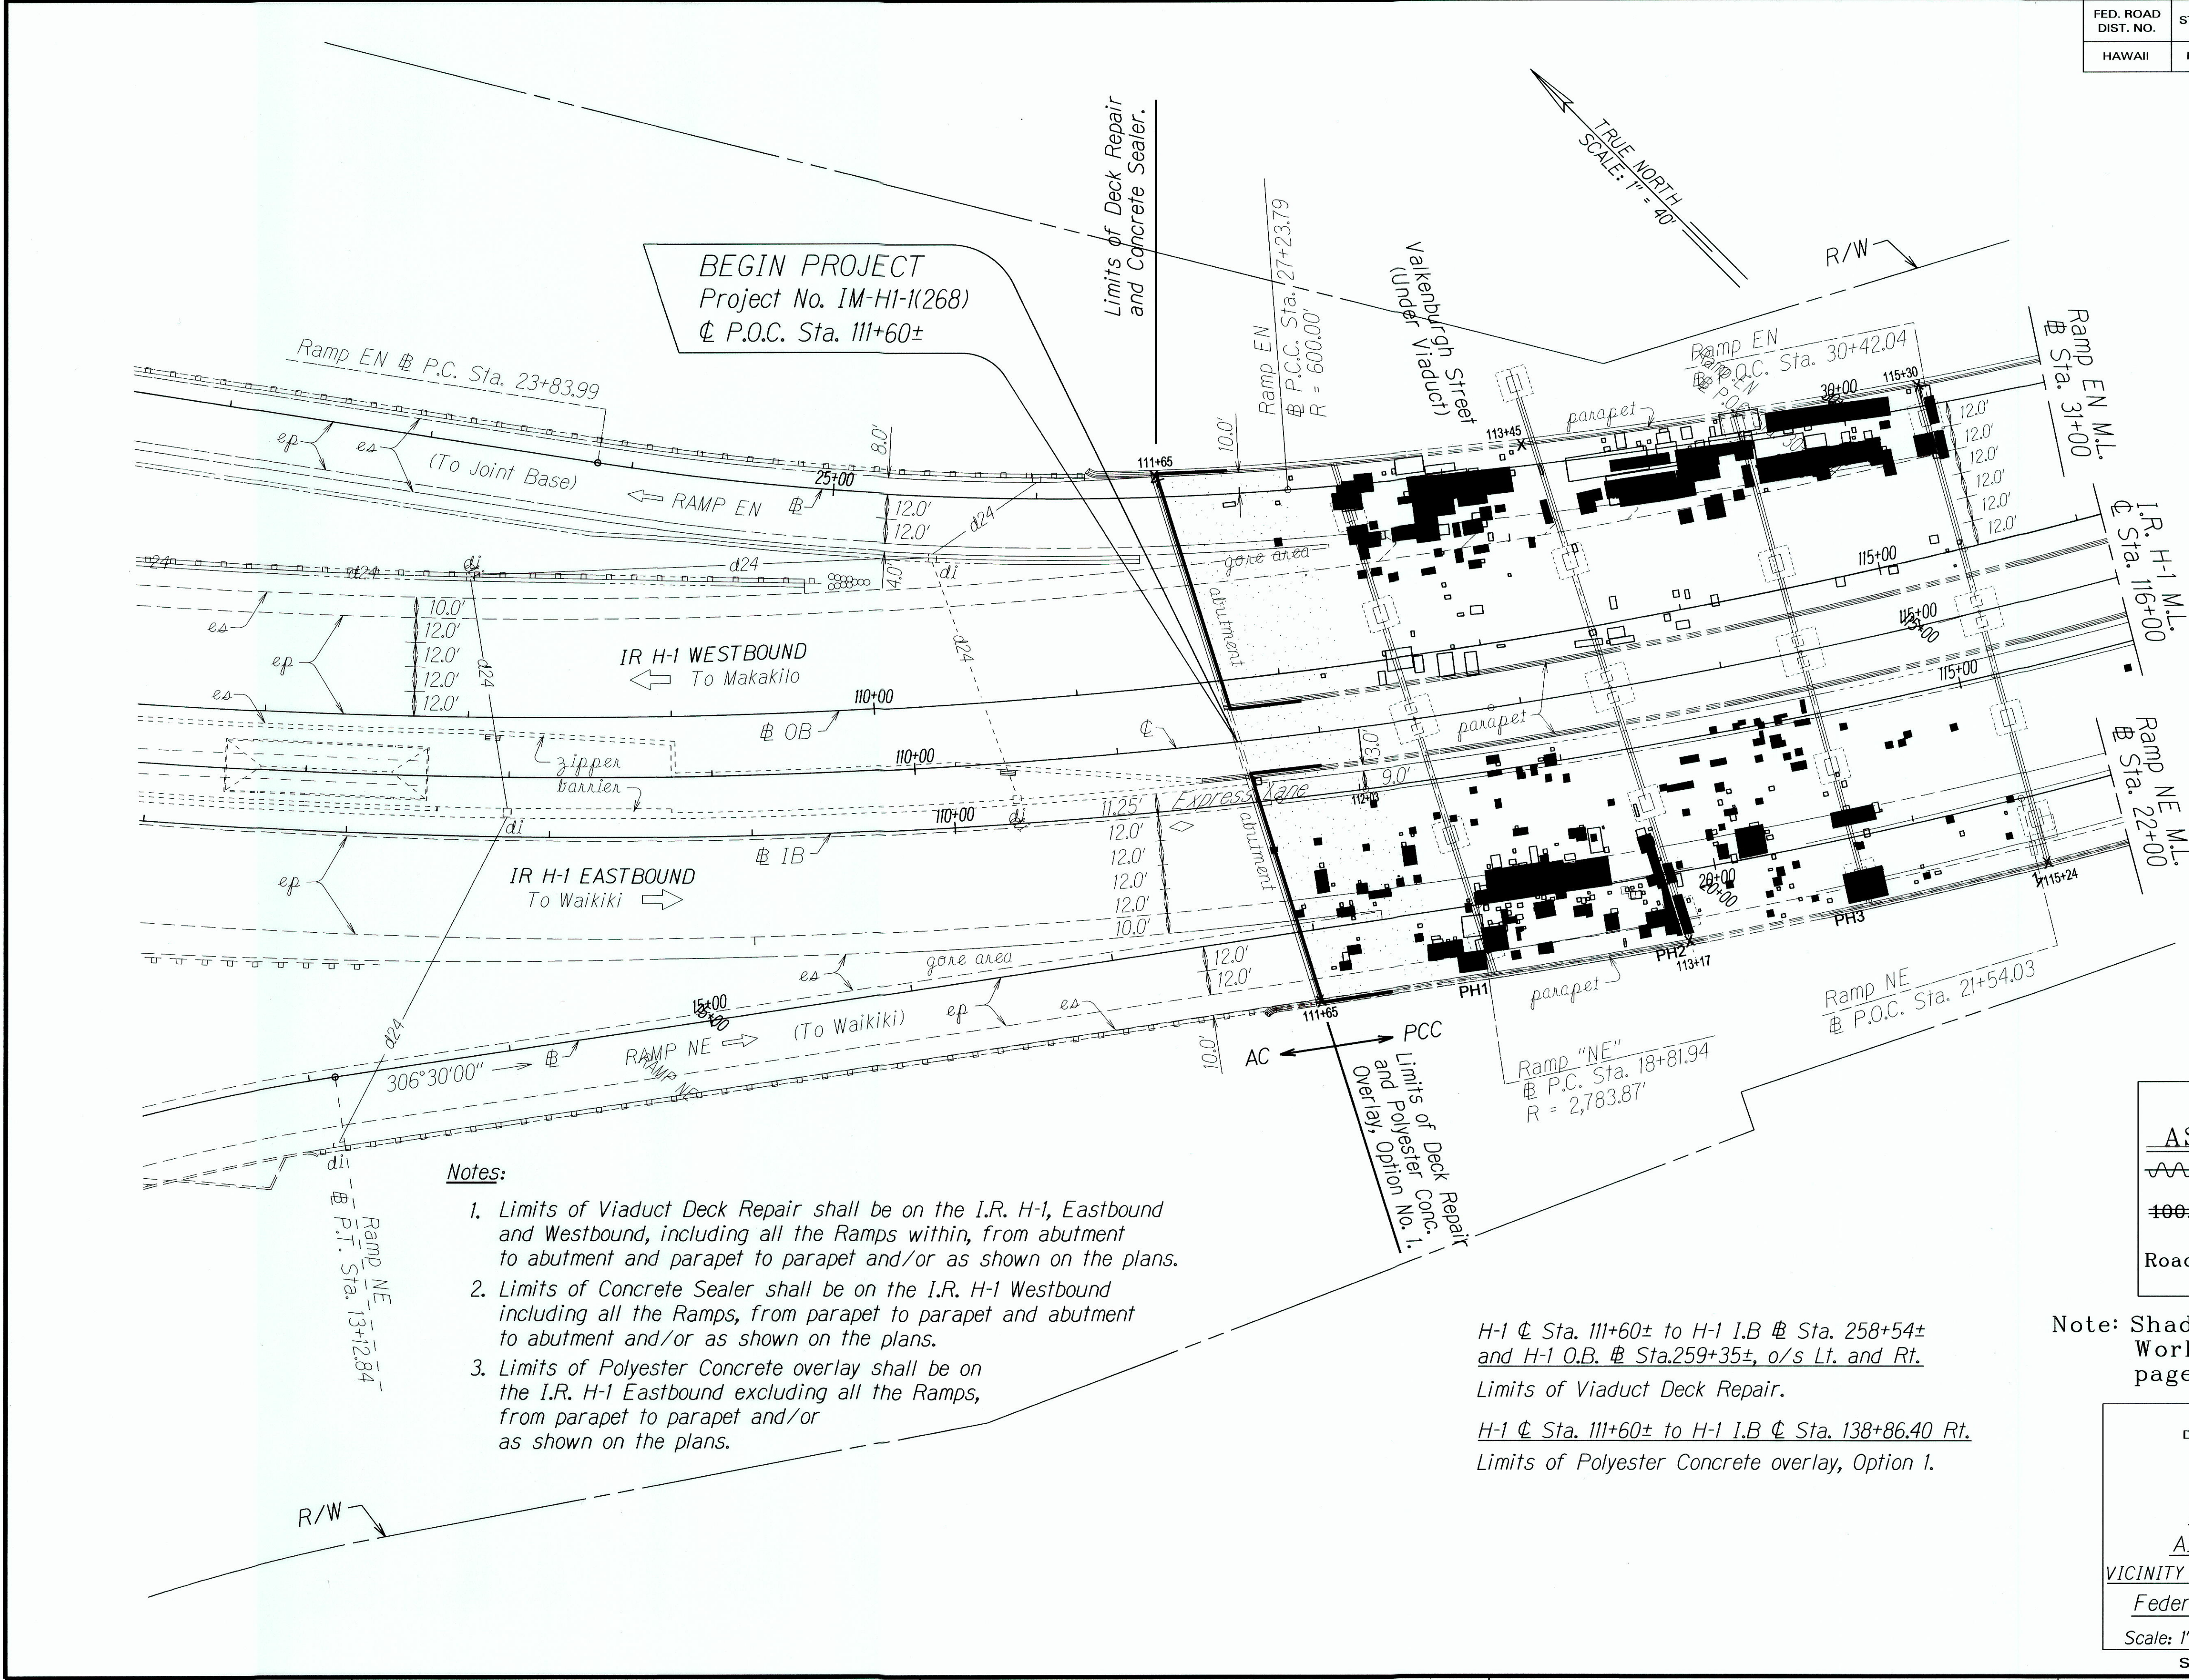

DESIGNED BY	DATE
TRACED BY	10/20/12
QUANTITIES BY	
CHECKED BY	
ORIGINAL PLAN	
NOTE: ROADWAY PLAN	

"AS-BUILT"

FED. ROAD DIST. NO.	STATE	FED. AID PROJ. NO.	FISCAL YEAR	SHEET NO.	TOTAL SHEETS
HAWAII	HAW.	IM-HI-1(268)	2013	9	31

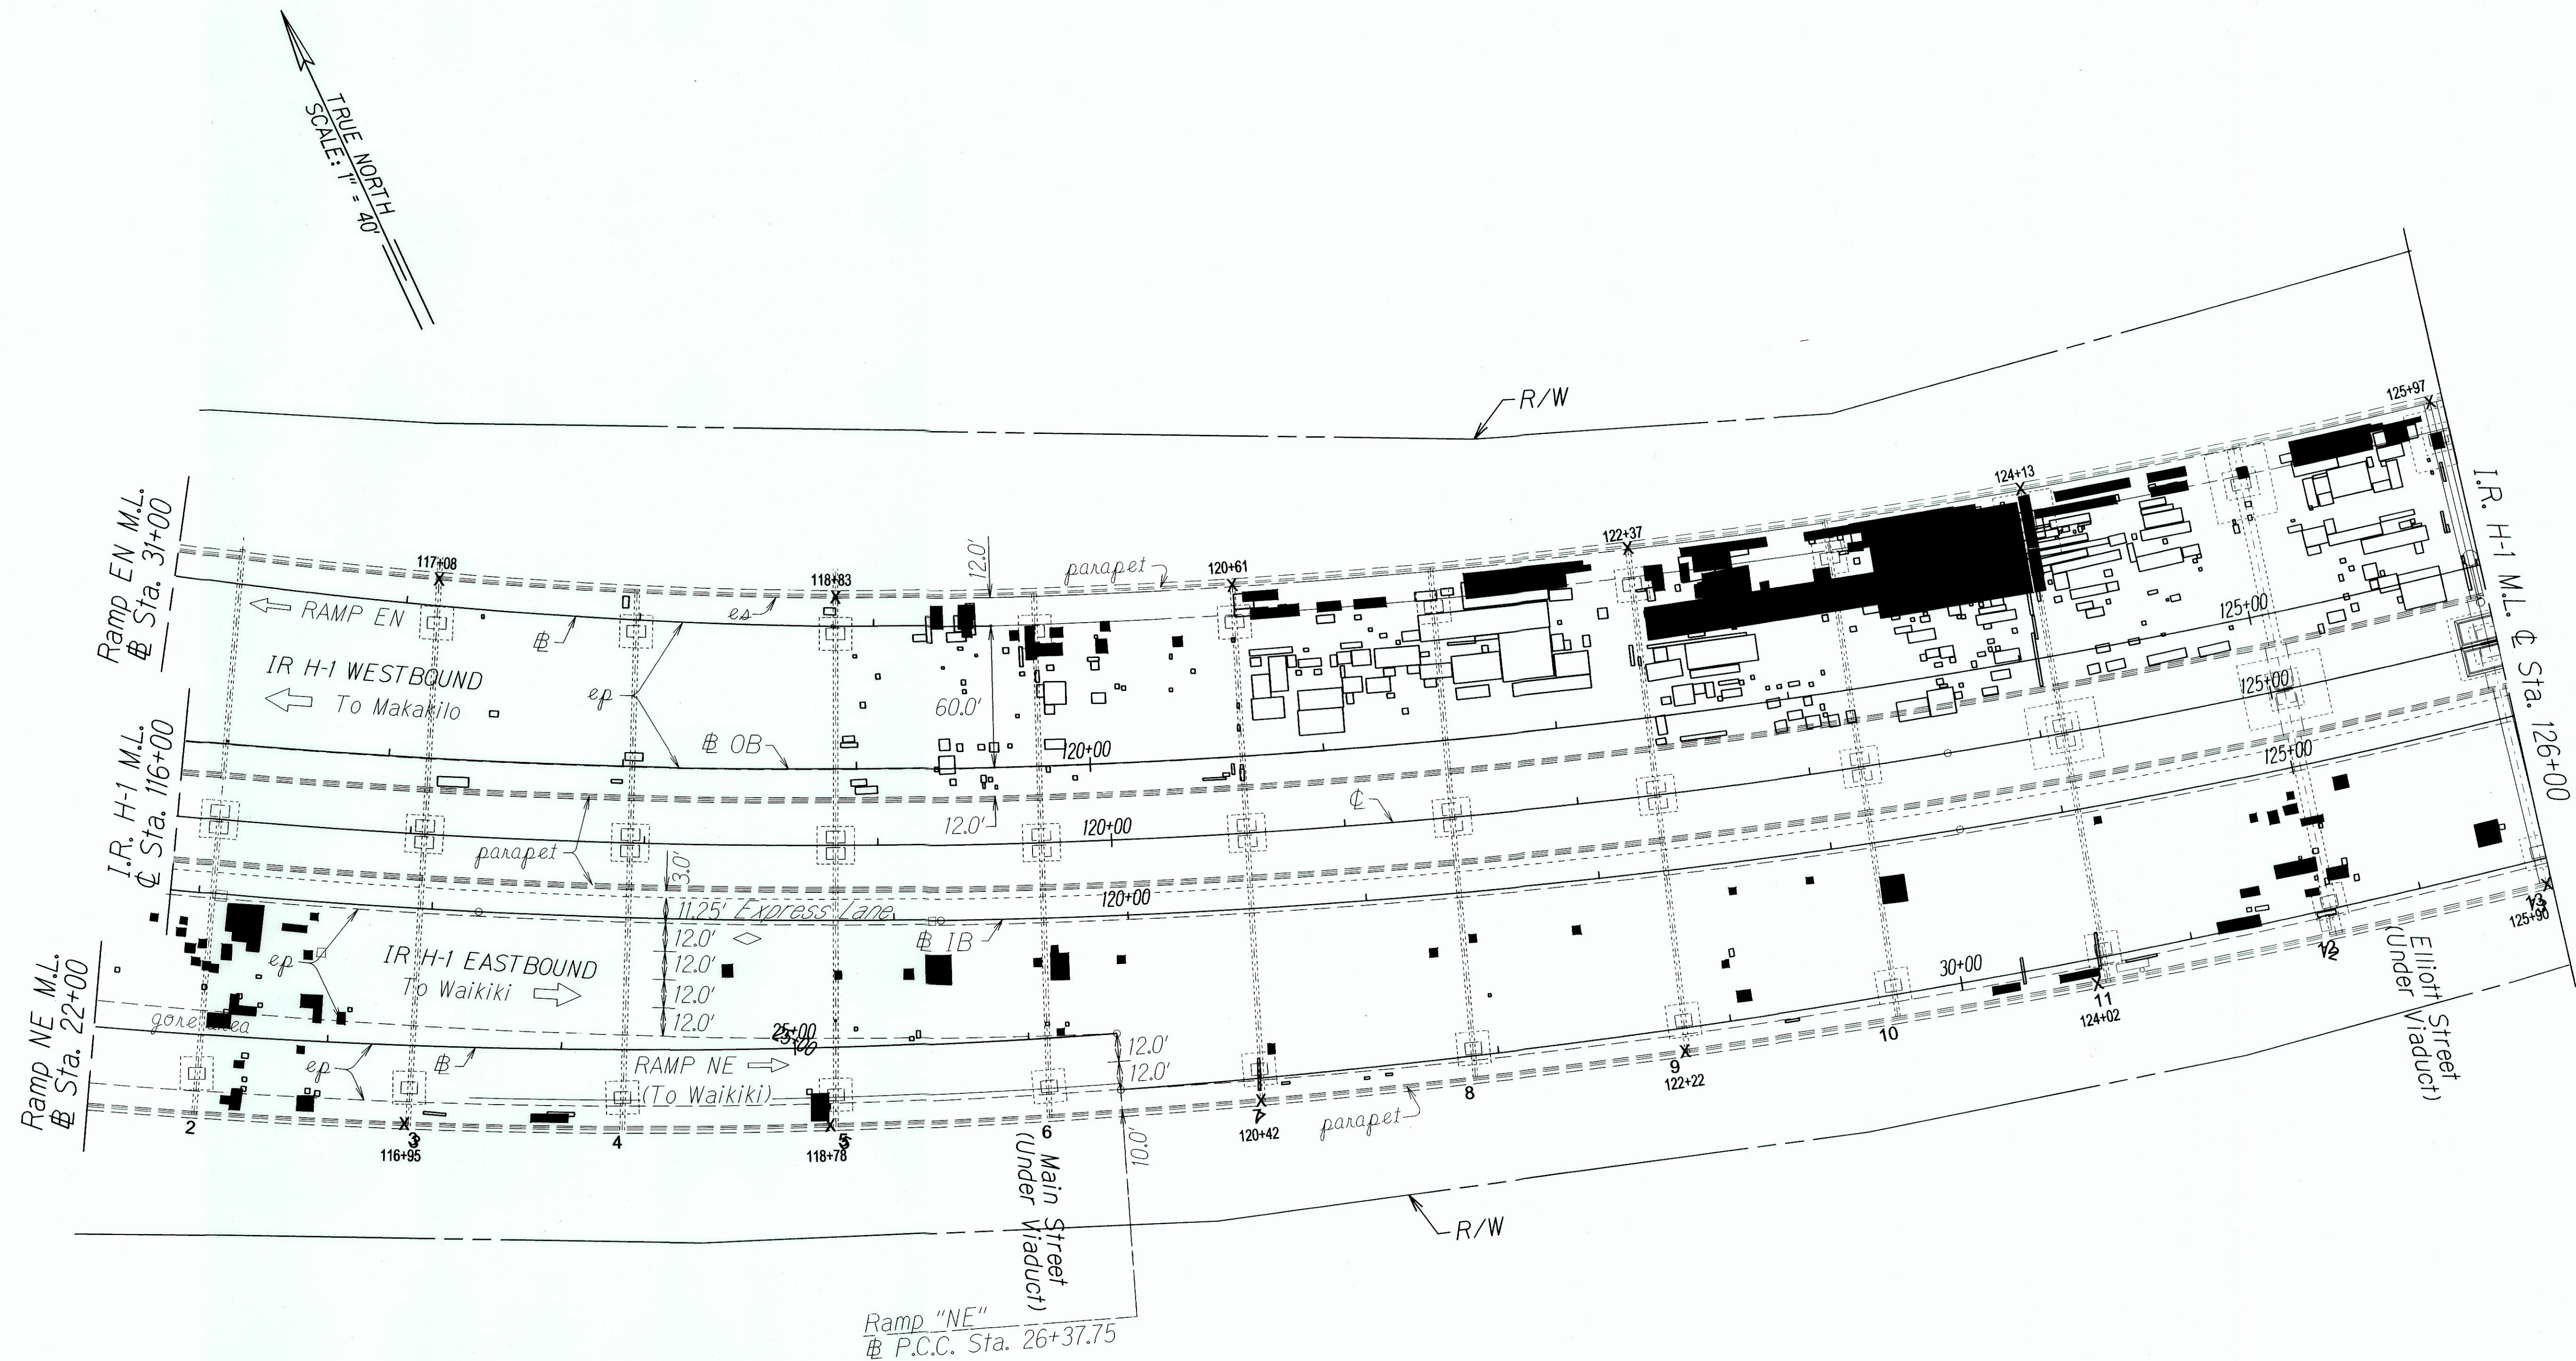

Note: Shaded Areas are the Only Work that was done on this page.

ORIGINAL PLAN	SURVEY PLOTTED BY	DATE
NOTE BOOK	DESIGNED BY	10/01/12
QUANTITIES BY	CHECKED BY	


LEGEND FOR AS-BUILT POSTINGS	
	Squiggly line for as-built deletion
	Double line for as-built deletion
Roadway	Text for as-built posting

STATE OF HAWAII
DEPARTMENT OF TRANSPORTATION
HIGHWAYS DIVISION

ROADWAY PLAN

INTERSTATE ROUTE H-1
AIRPORT VIADUCT REPAIR
VICINITY OF VALKENBURGH ST. TO MIDDLE ST.
Federal Aid Project No. IM-HI-1(268)
Scale: 1" = 40' Date: April, 2012
SHEET No. 2 OF 22 SHEETS

FED. ROAD DIST. NO.	STATE	FED. AID PROJ. NO.	FISCAL YEAR	SHEET NO.	TOTAL SHEETS
HAWAII	HAW.	IM-HI-1(268)	2013	10	31

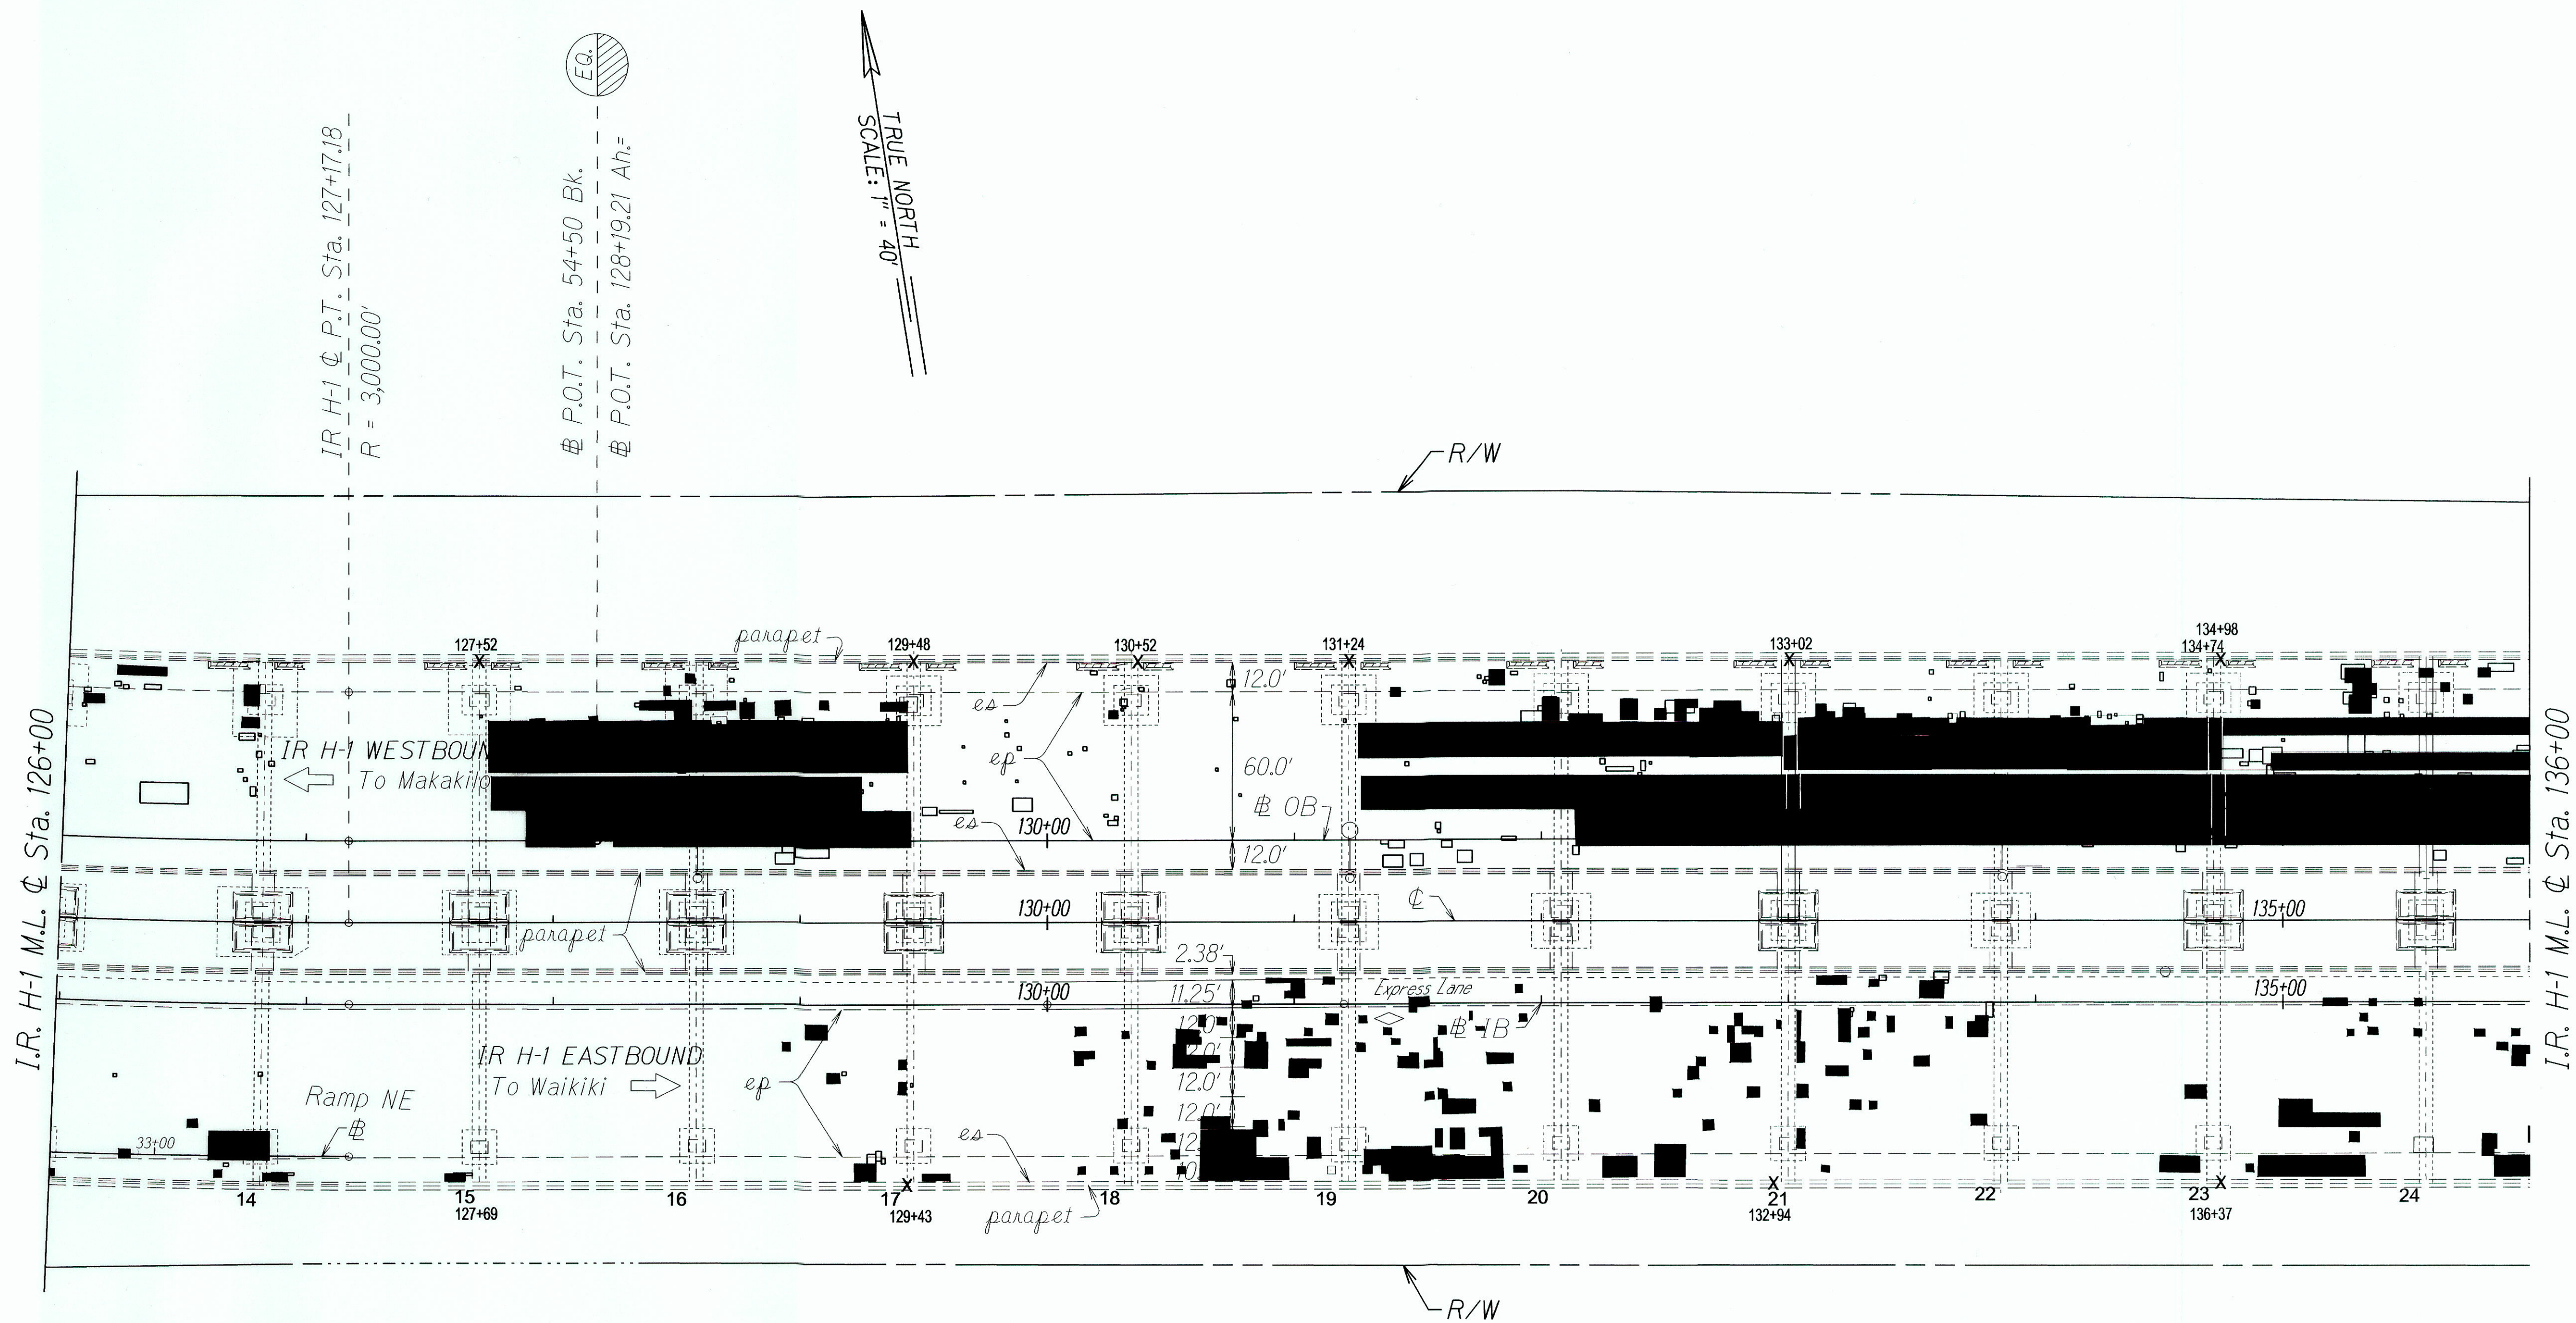


ORIGINAL PLANS	DESIGNED BY	DATE
DATE WORK	DESIGNED BY	DATE
QUANTITIES BY	DESIGNED BY	DATE
CHECKED BY	DESIGNED BY	DATE

LEGEND FOR AS-BUILT POSTINGS	
	Squiggly line for as-built deletion
	Double line for as-built deletion
Roadway	Text for as-built posting

Note: Shaded Areas are the Only Work that was done on this page.

STATE OF HAWAII DEPARTMENT OF TRANSPORTATION HIGHWAYS DIVISION	
ROADWAY PLAN	
INTERSTATE ROUTE H-1	
AIRPORT VIADUCT REPAIR	
VICINITY OF VALKENBURGH ST. TO MIDDLE ST.	
Federal Aid Project No. IM-HI-1(268)	
Scale: 1" = 40'	Date: April, 2012
SHEET No. 3 OF 22 SHEETS	

FED. ROAD DIST. NO.	STATE	FED. AID PROJ. NO.	FISCAL YEAR	SHEET NO.	TOTAL SHEETS
HAWAII	HAW.	1M-HI-1(268)	2013	11	31

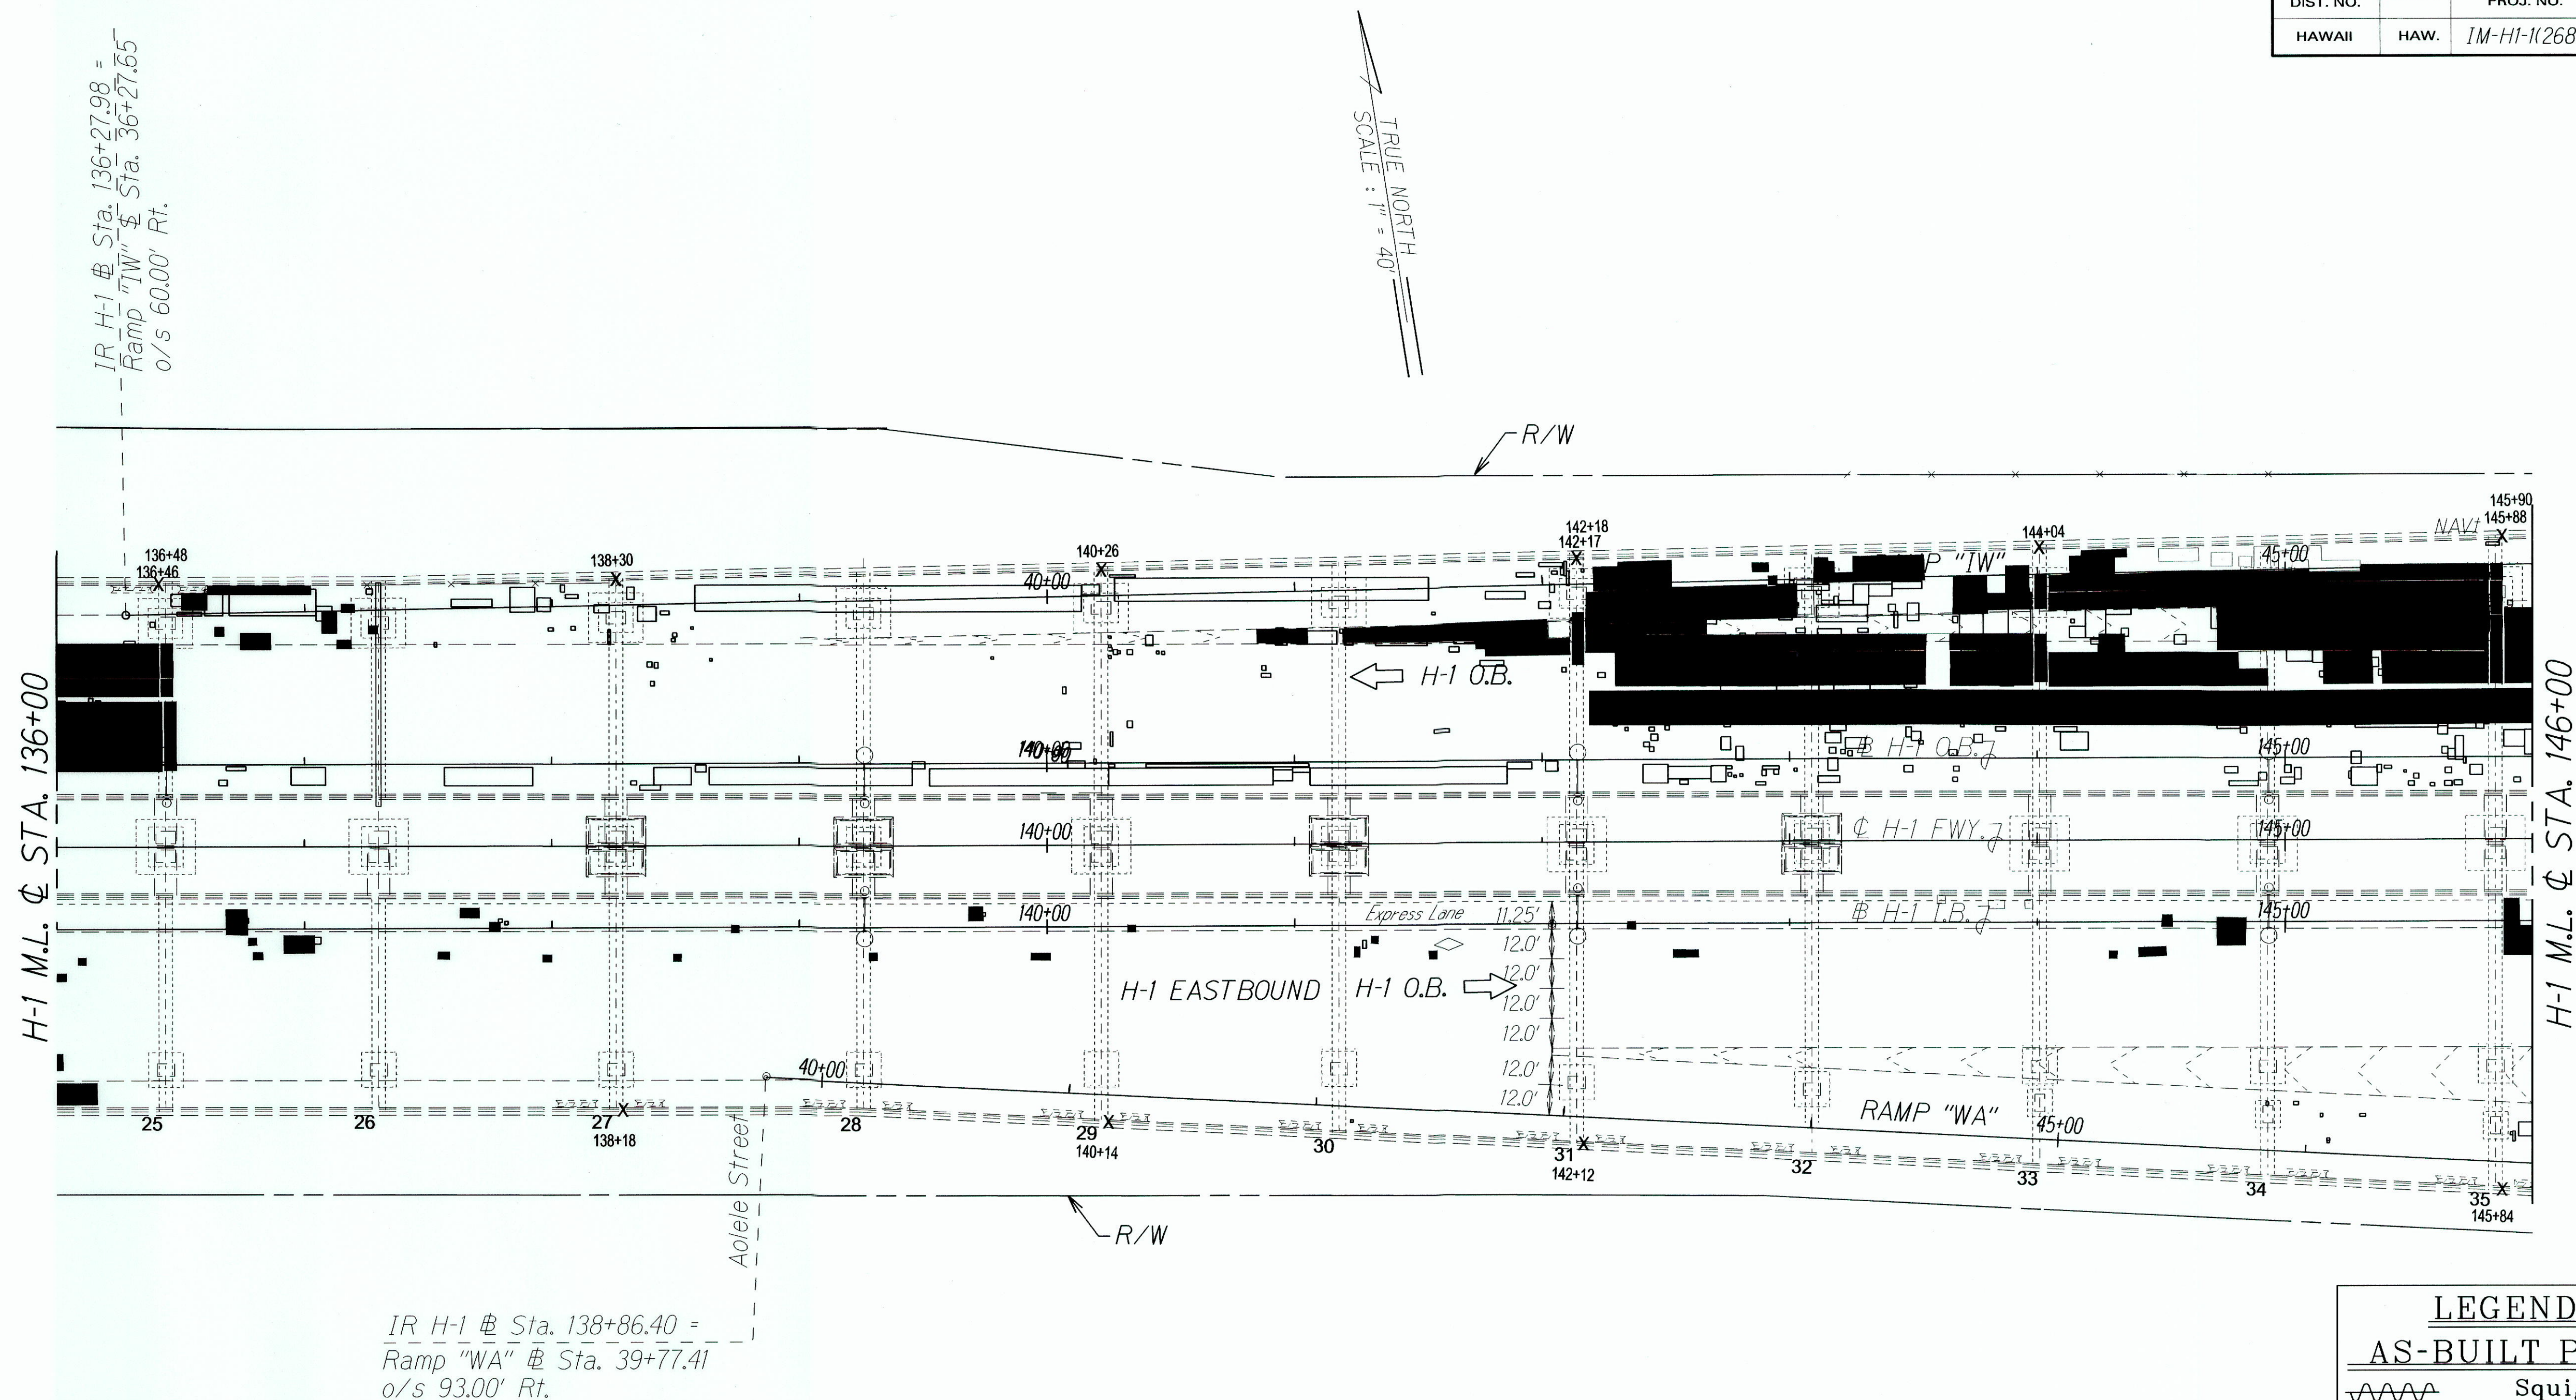

LEGEND FOR AS-BUILT POSTINGS	
	Squiggly line for as-built deletion
	Double line for as-built deletion
Roadway	Text for as-built posting

Note: Shaded Areas are the Only Work that was done on this page.

STATE OF HAWAII
DEPARTMENT OF TRANSPORTATION
HIGHWAYS DIVISION


ROADWAY PLAN
INTERSTATE ROUTE H-1
AIRPORT VIADUCT REPAIR
VICINITY OF VALKENBURGH ST. TO MIDDLE ST.
Federal Aid Project No. 1M-HI-1(268)

Scale: 1" = 40' Date: April, 2012

SHEET No. 4 OF 22 SHEETS

ORIGINAL PLAN	SURVEY PLOTTED BY	DATE
NOTE BOOK	DRAWN BY	
DESIGNED BY	CHECKED BY	
APPROVED BY		

FED. ROAD DIST. NO.	STATE	FED. AID PROJ. NO.	FISCAL YEAR	SHEET NO.	TOTAL SHEETS
HAWAII	HAW.	IM-HI-1(268)	2013	12	31

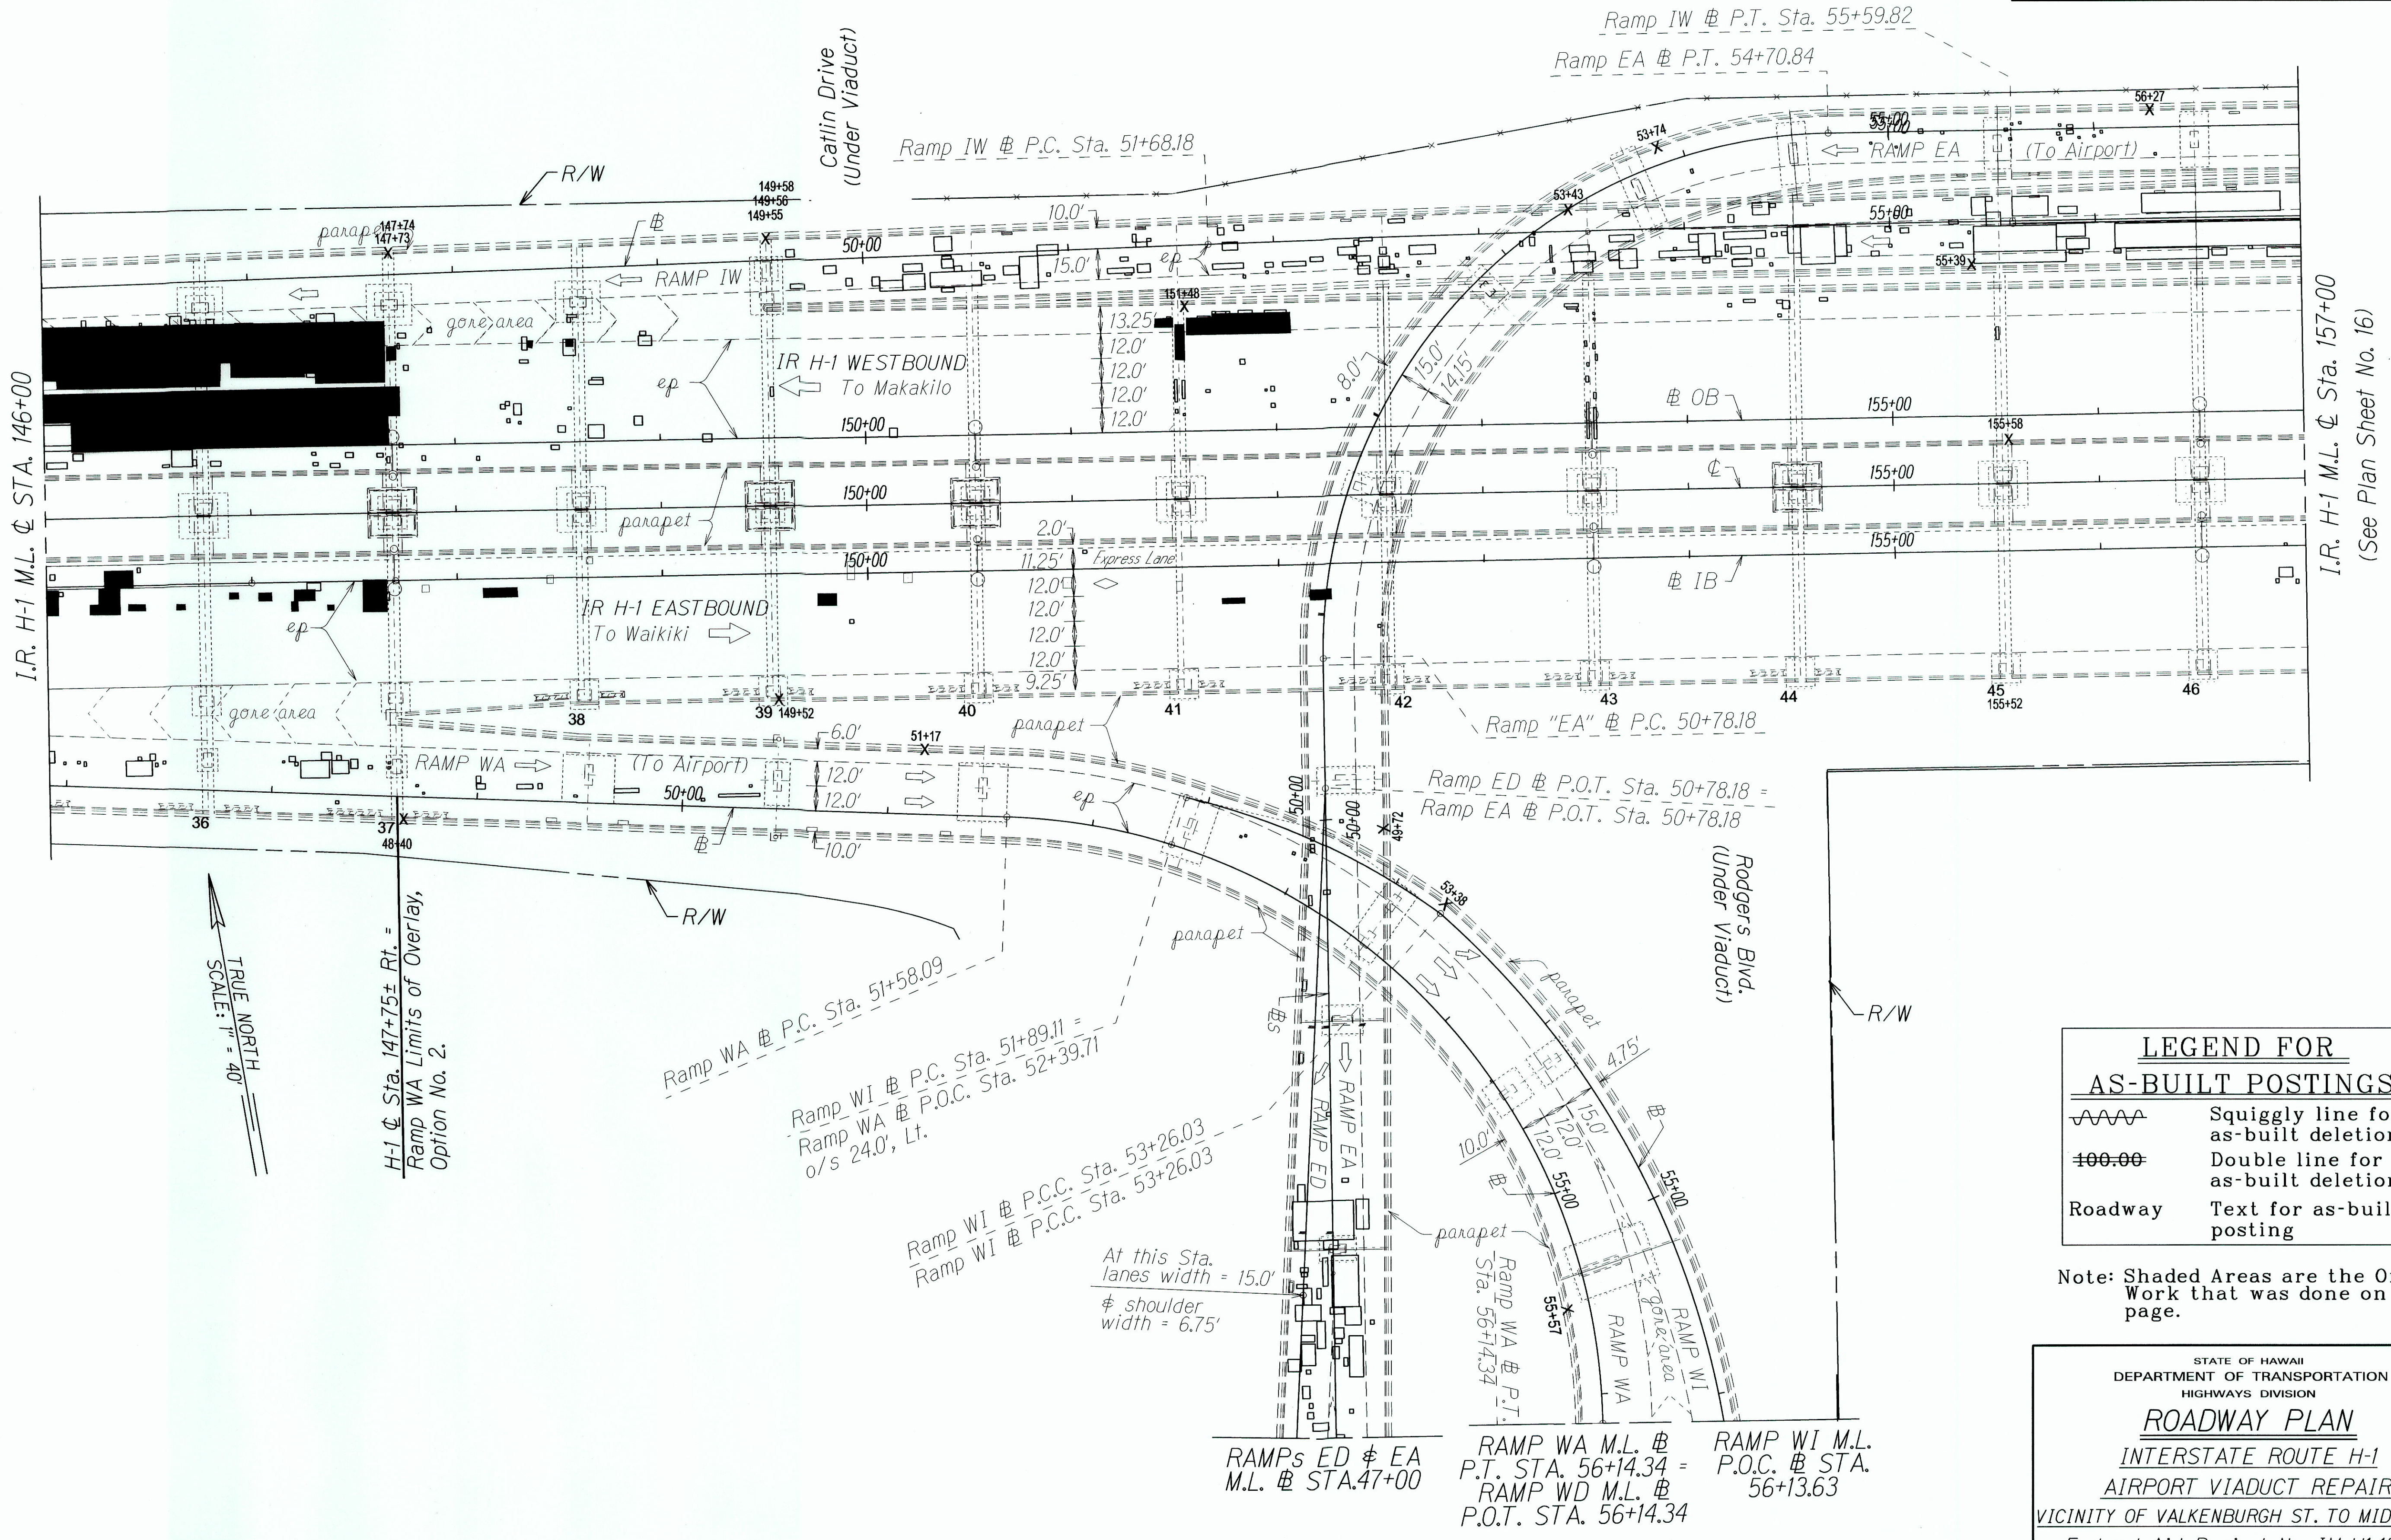

LEGEND FOR AS-BUILT POSTINGS	
	Squiggly line for as-built deletion
	Double line for as-built deletion
Roadway	Text for as-built posting

Note: Shaded Areas are the Only Work that was done on this page.

STATE OF HAWAII
DEPARTMENT OF TRANSPORTATION
HIGHWAYS DIVISION

ROADWAY PLAN
INTERSTATE ROUTE H-1
AIRPORT VIADUCT REPAIR
VICINITY OF VALKENBURGH ST. TO MIDDLE ST.
Federal Aid Project No. IM-HI-1(268)

Scale: 1" = 40'
Date: April, 2012


SHEET No. 5 OF 22 SHEETS

ORIGINAL PLAN	DATE
DESIGNED BY	02/07/12
DRAWN BY	
CHECKED BY	
IN CHARGE	

(See Plan Sheet No. 13)

"AS-BUILT"

FED. ROAD DIST. NO.	STATE	FED. AID PROJ. NO.	FISCAL YEAR	SHEET NO.	TOTAL SHEETS
HAWAII	HAW.	IM-HI-1(268)	2013	13	35

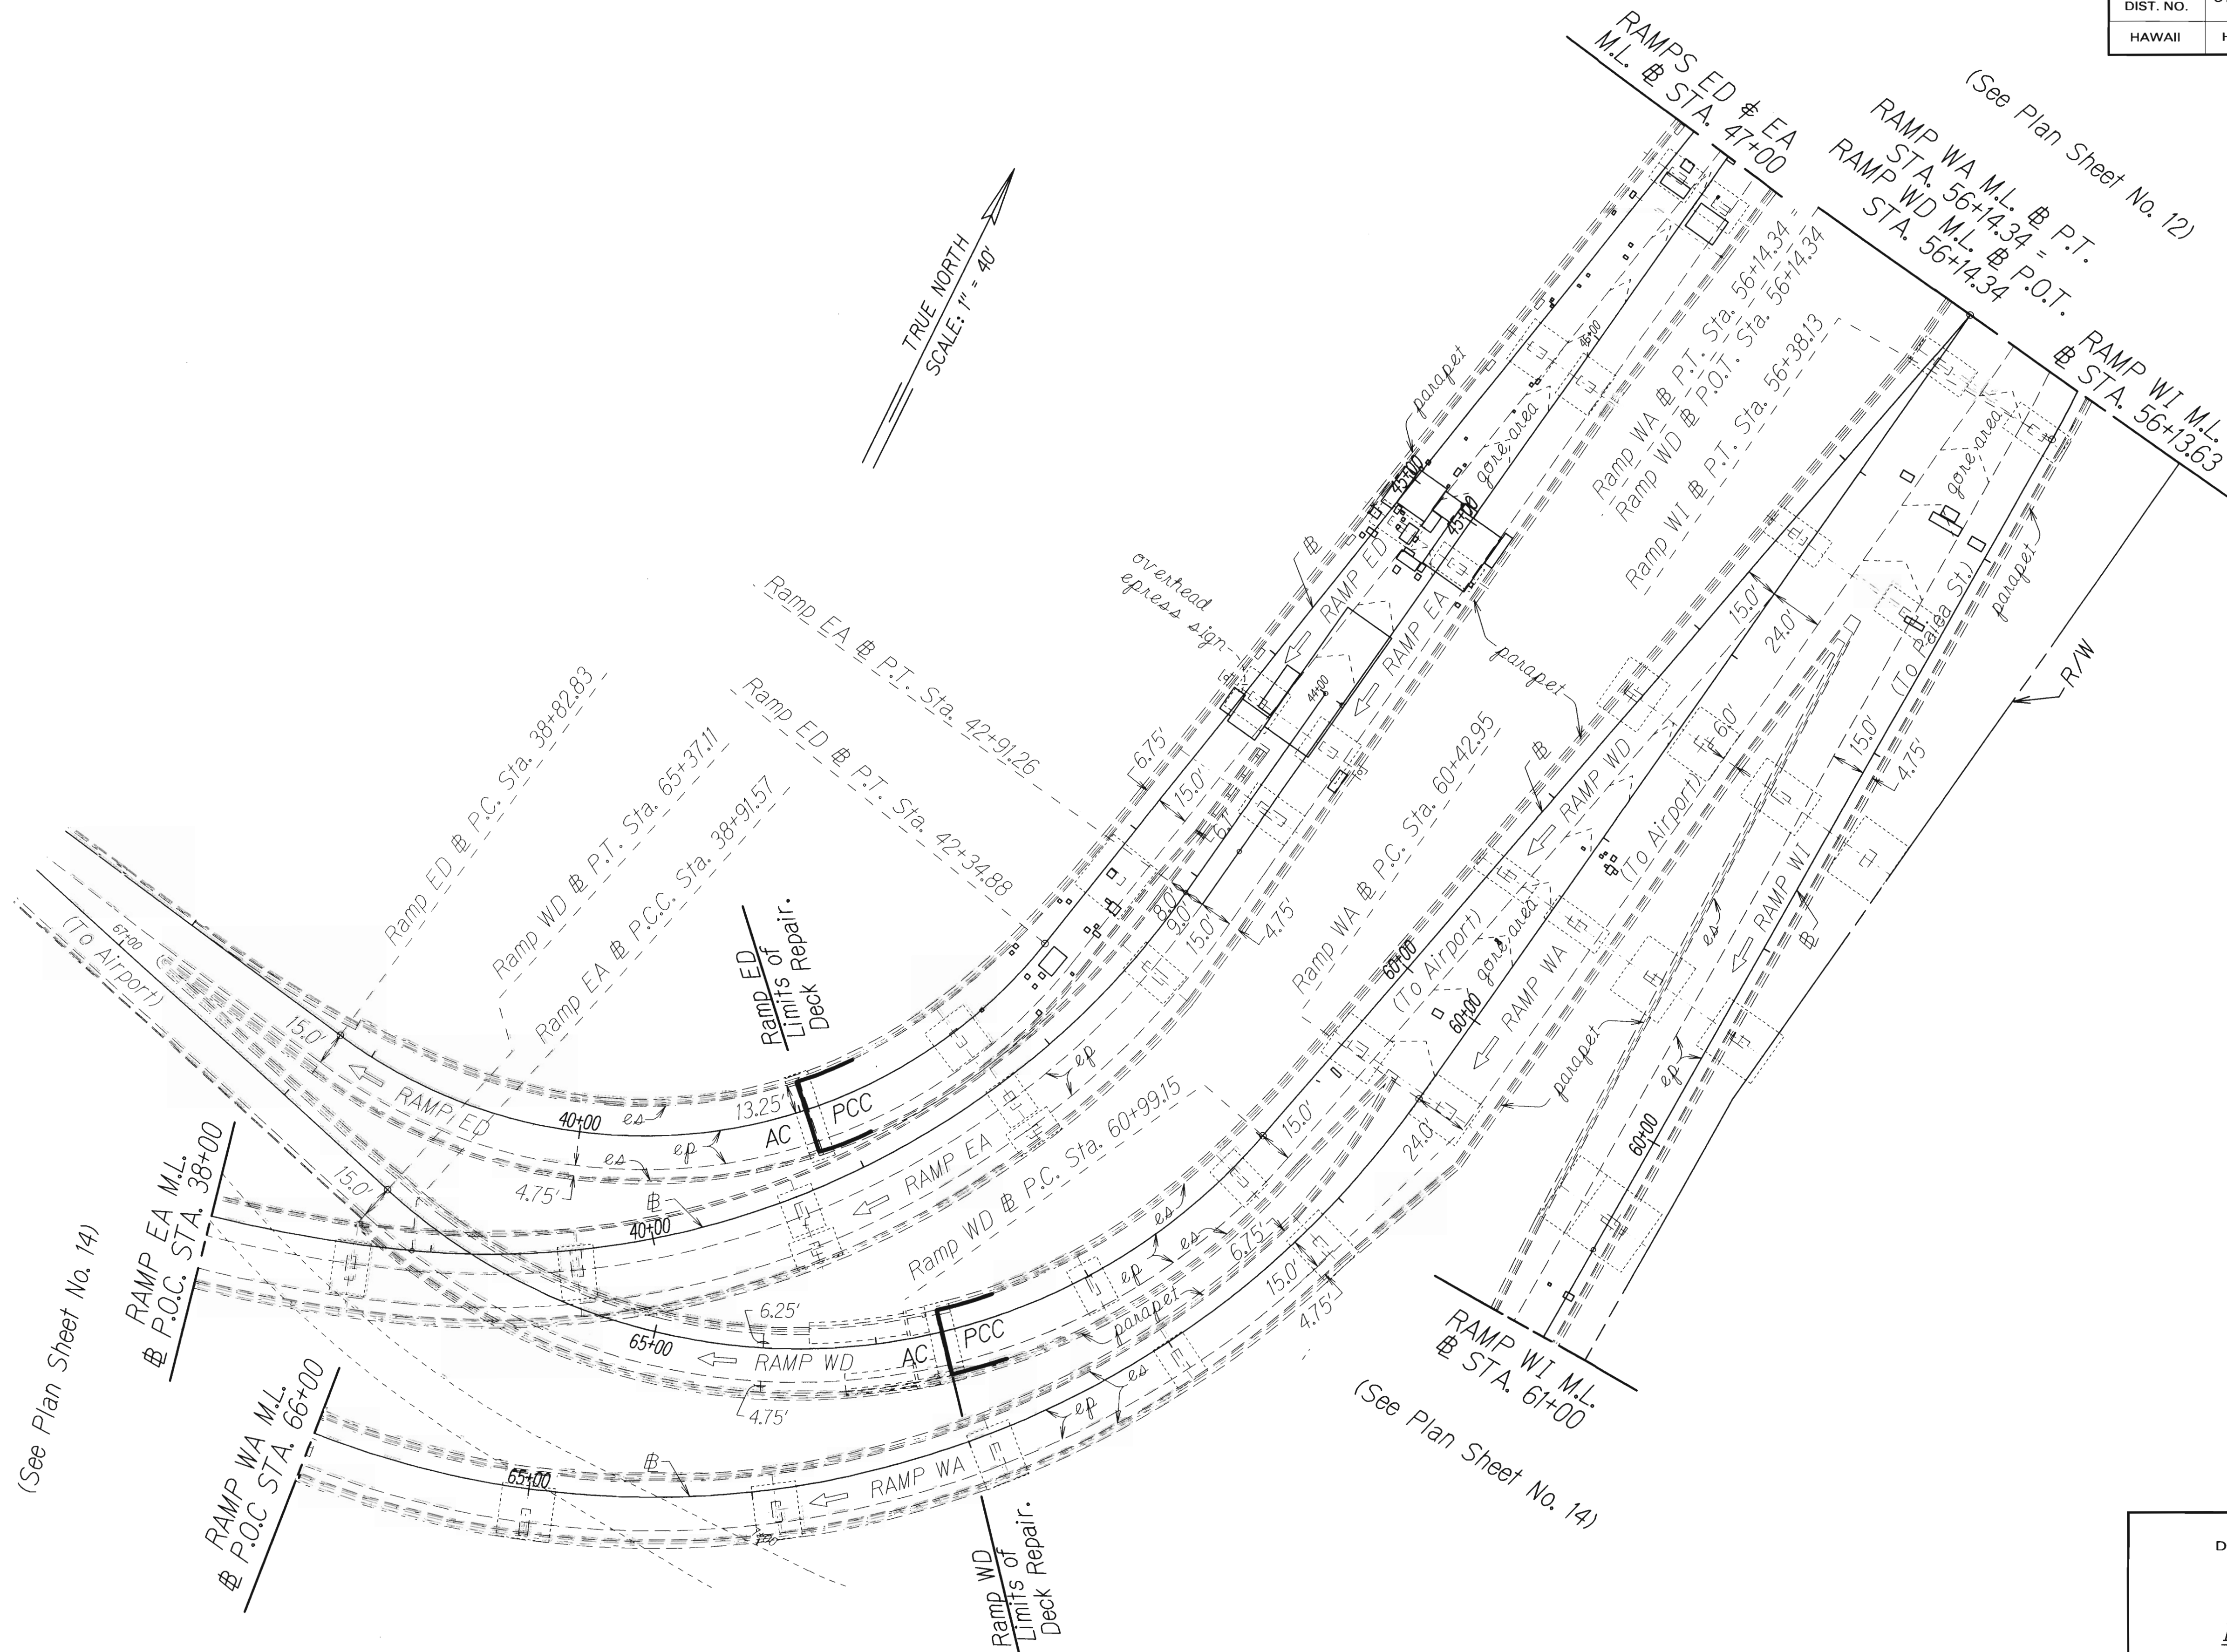

ORIGINAL PLAN	SURVEY PLOTTED BY	DATE
NOTE BOOK	DRAWN BY	
	CHECKED BY	

STATE OF HAWAII
DEPARTMENT OF TRANSPORTATION
HIGHWAYS DIVISION


ROADWAY PLAN

INTERSTATE ROUTE H-1
AIRPORT VIADUCT REPAIR
VICINITY OF VALKENBURGH ST. TO MIDDLE ST.
Federal Aid Project No. IM-HI-1(268)

Scale: 1" = 40' Date: Mar, 2013

SHEET No. 6 OF 22 SHEETS

FED. ROAD DIST. NO.	STATE	FED. AID PROJ. NO.	FISCAL YEAR	SHEET NO.	TOTAL SHEETS
HAWAII	HAW.	IM-HI-1(268)	2013	14	35

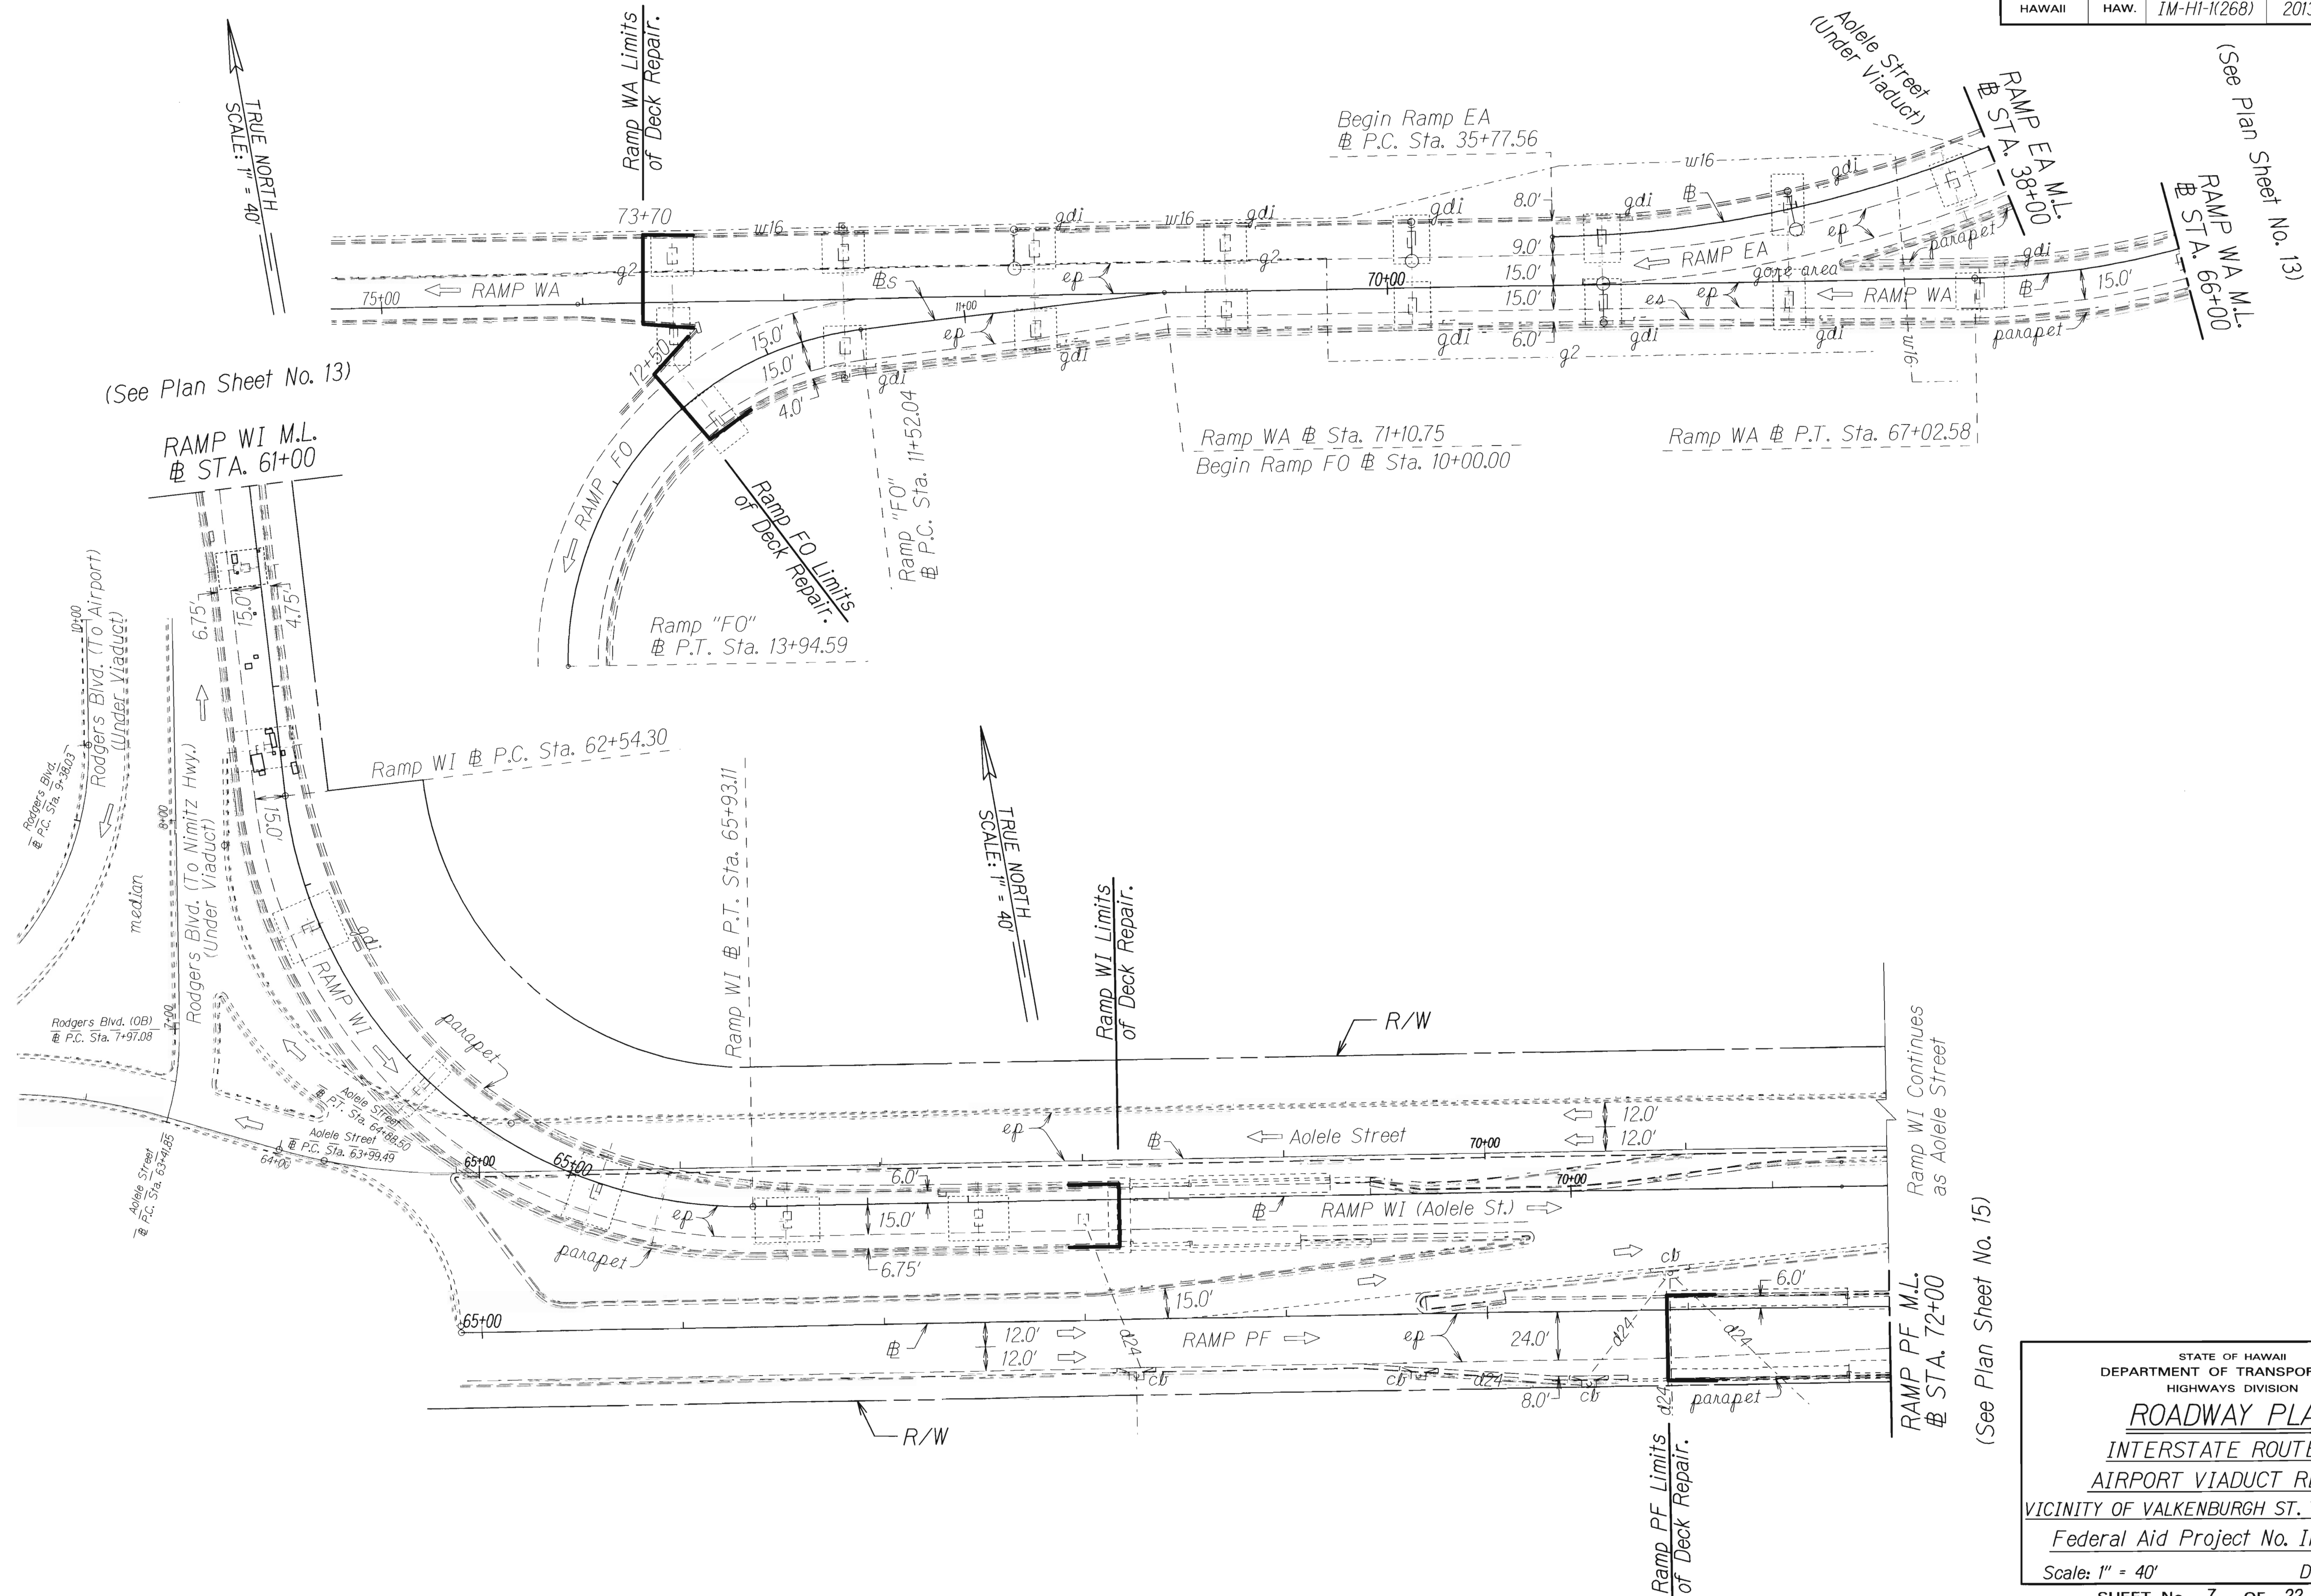

STATE OF HAWAII
DEPARTMENT OF TRANSPORTATION
HIGHWAYS DIVISION

ROADWAY PLAN
INTERSTATE ROUTE H-1
AIRPORT VIADUCT REPAIR
VICINITY OF VALKENBURGH ST. TO MIDDLE ST.
Federal Aid Project No. IM-HI-1(268)
Scale: 1" = 40' Date: Mar, 2013

SHEET No. 7 OF 22 SHEETS


14

ORIGINAL PLAN	SURVEY PLOTTED BY	DATE
DESIGNED BY	DESIGNED BY	
NOTE BOOK	DESIGNED BY	
CHECKED BY	CHECKED BY	
N.		

FED. ROAD DIST. NO.	STATE	FED. AID PROJ. NO.	FISCAL YEAR	SHEET NO.	TOTAL SHEETS
HAWAII	HAW.	IM-HI-1(268)	2013	15	35

(See Plan Sheet No. 18)

(See Plan Sheet No. 14)

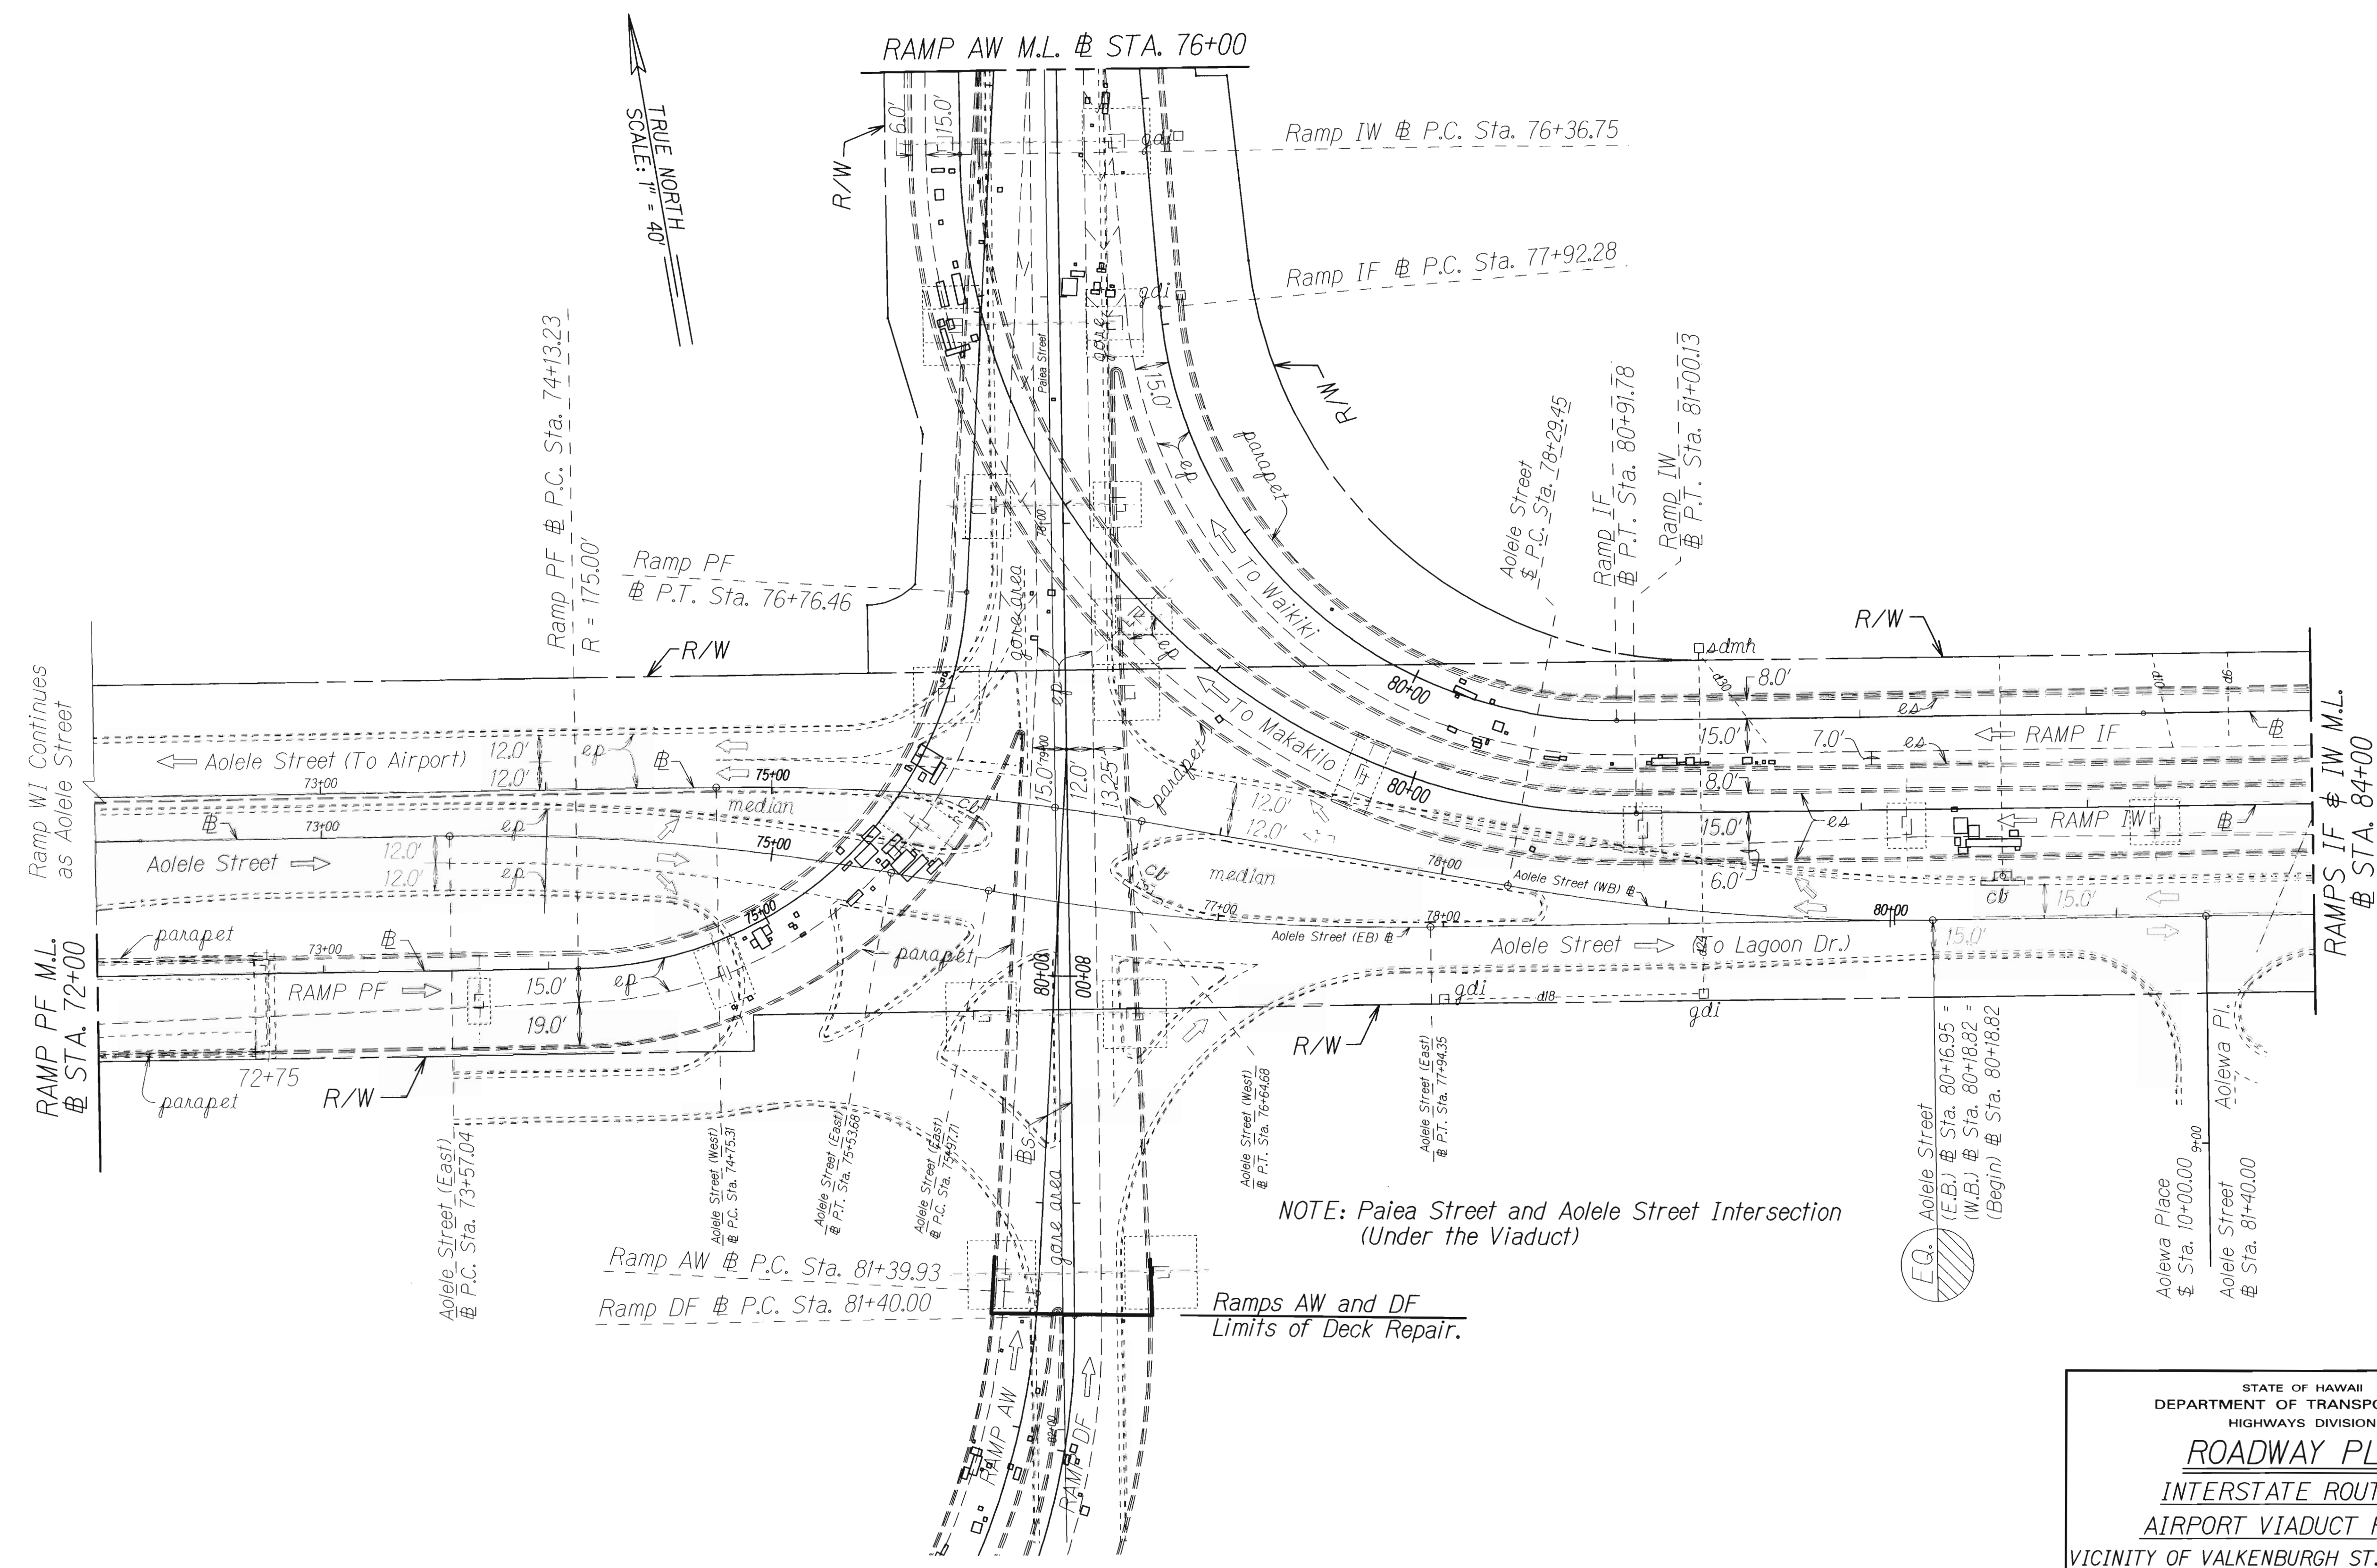

(See Plan Sheet No. 18)

ORIGINAL PLAN	SURVEY PLOTTED BY	DATE
NOTE BOOK	DRAWN BY	
	DESIGNED BY	
	CHECKED BY	

STATE OF HAWAII
DEPARTMENT OF TRANSPORTATION
HIGHWAYS DIVISION

ROADWAY PLAN
INTERSTATE ROUTE H-1
AIRPORT VIADUCT REPAIR
VICINITY OF VALKENBURGH ST. TO MIDDLE ST.
Federal Aid Project No. IM-HI-1(268)

Scale: 1" = 40' Date: Mar, 2013
SHEET No. 8 OF 23 SHEETS

STATE OF HAWAII
DEPARTMENT OF TRANSPORTATION
HIGHWAYS DIVISION

ROADWAY PLAN

INTERSTATE ROUTE H-1


AIRPORT VIADUCT REPAIR

VICINITY OF VALKENBURGH ST. TO MIDDLE ST.

Federal Aid Project No. IM-HI-1(268)


Scale: 1" = 40' Date: Mar, 2013

SHEET No. 9 OF 23 SHEETS

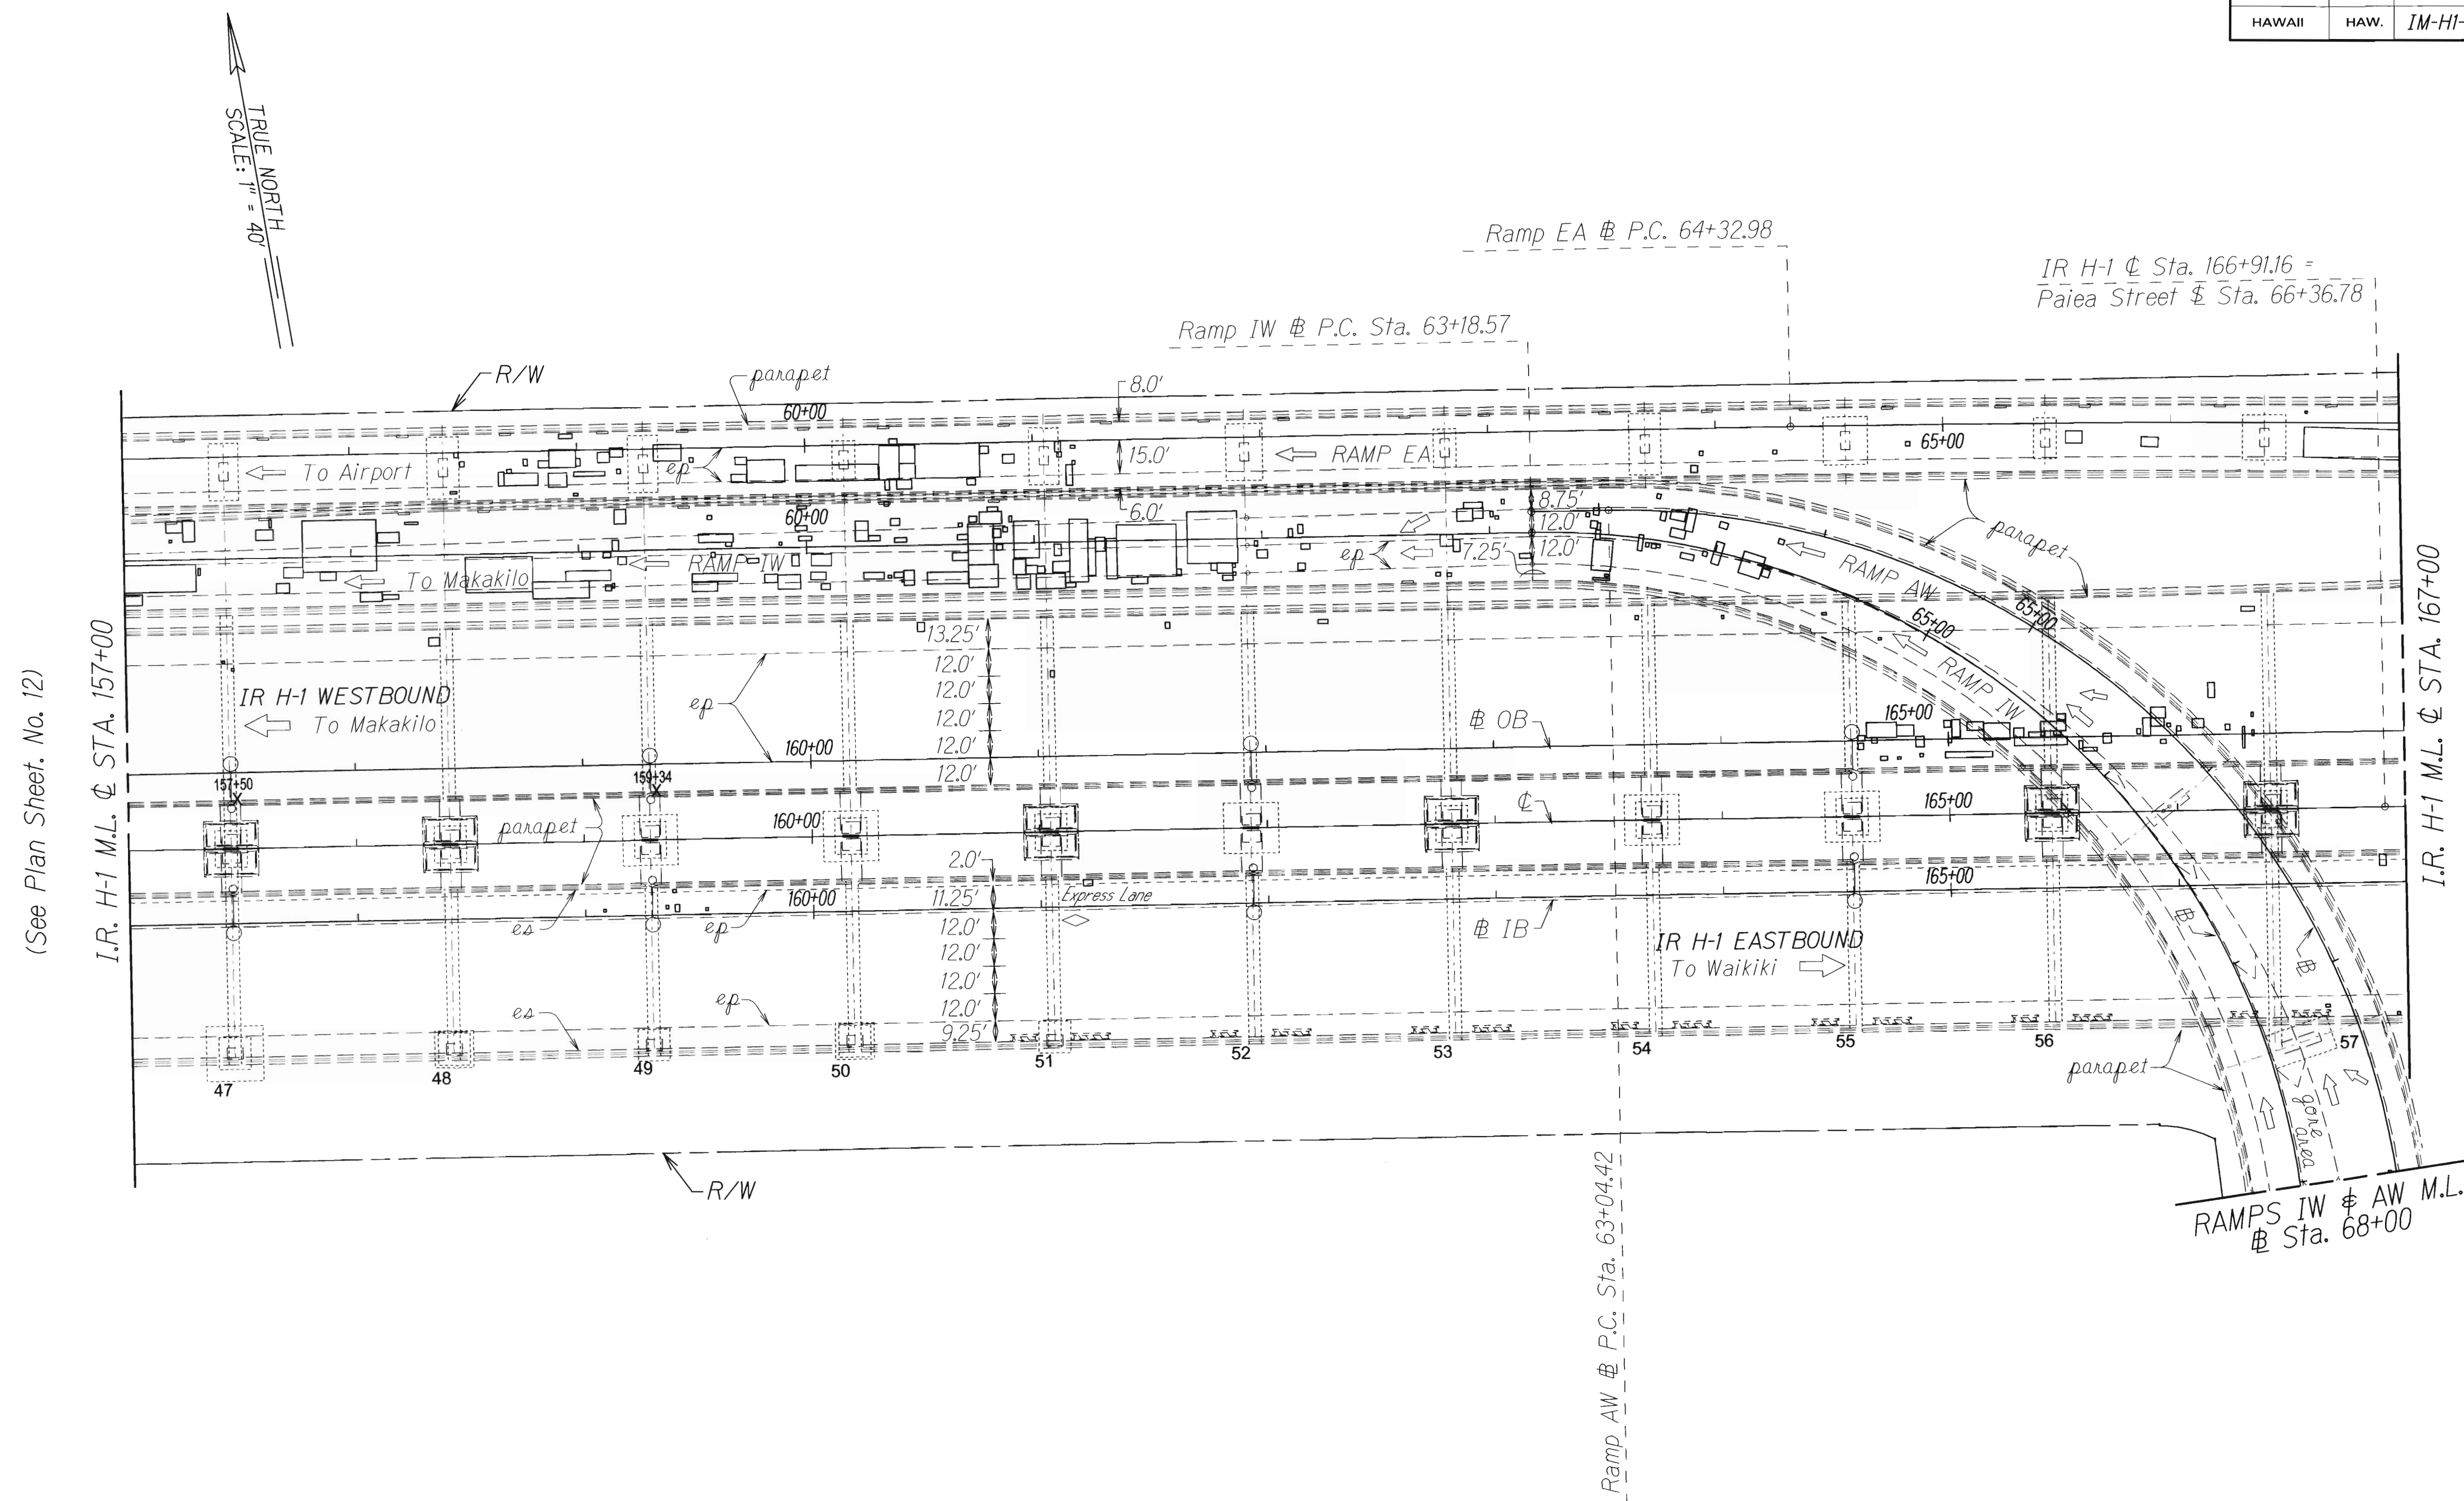

ORIGINAL PLAN	SURVEY PLOTTED BY _____	DATE _____
	DRAWN BY _____	•
	TRACED BY _____	•
NOTE BOOK	DESIGNED BY _____	•
	QUANTITIES BY _____	•
	CHECKED BY _____	•
N _o _____		

FED. ROAD DIST. NO.	STATE	FED. AID PROJ. NO.	FISCAL YEAR	SHEET NO.	TOTAL SHEETS
HAWAII	HAW.	IM-HI-1(268)	2013	17	35

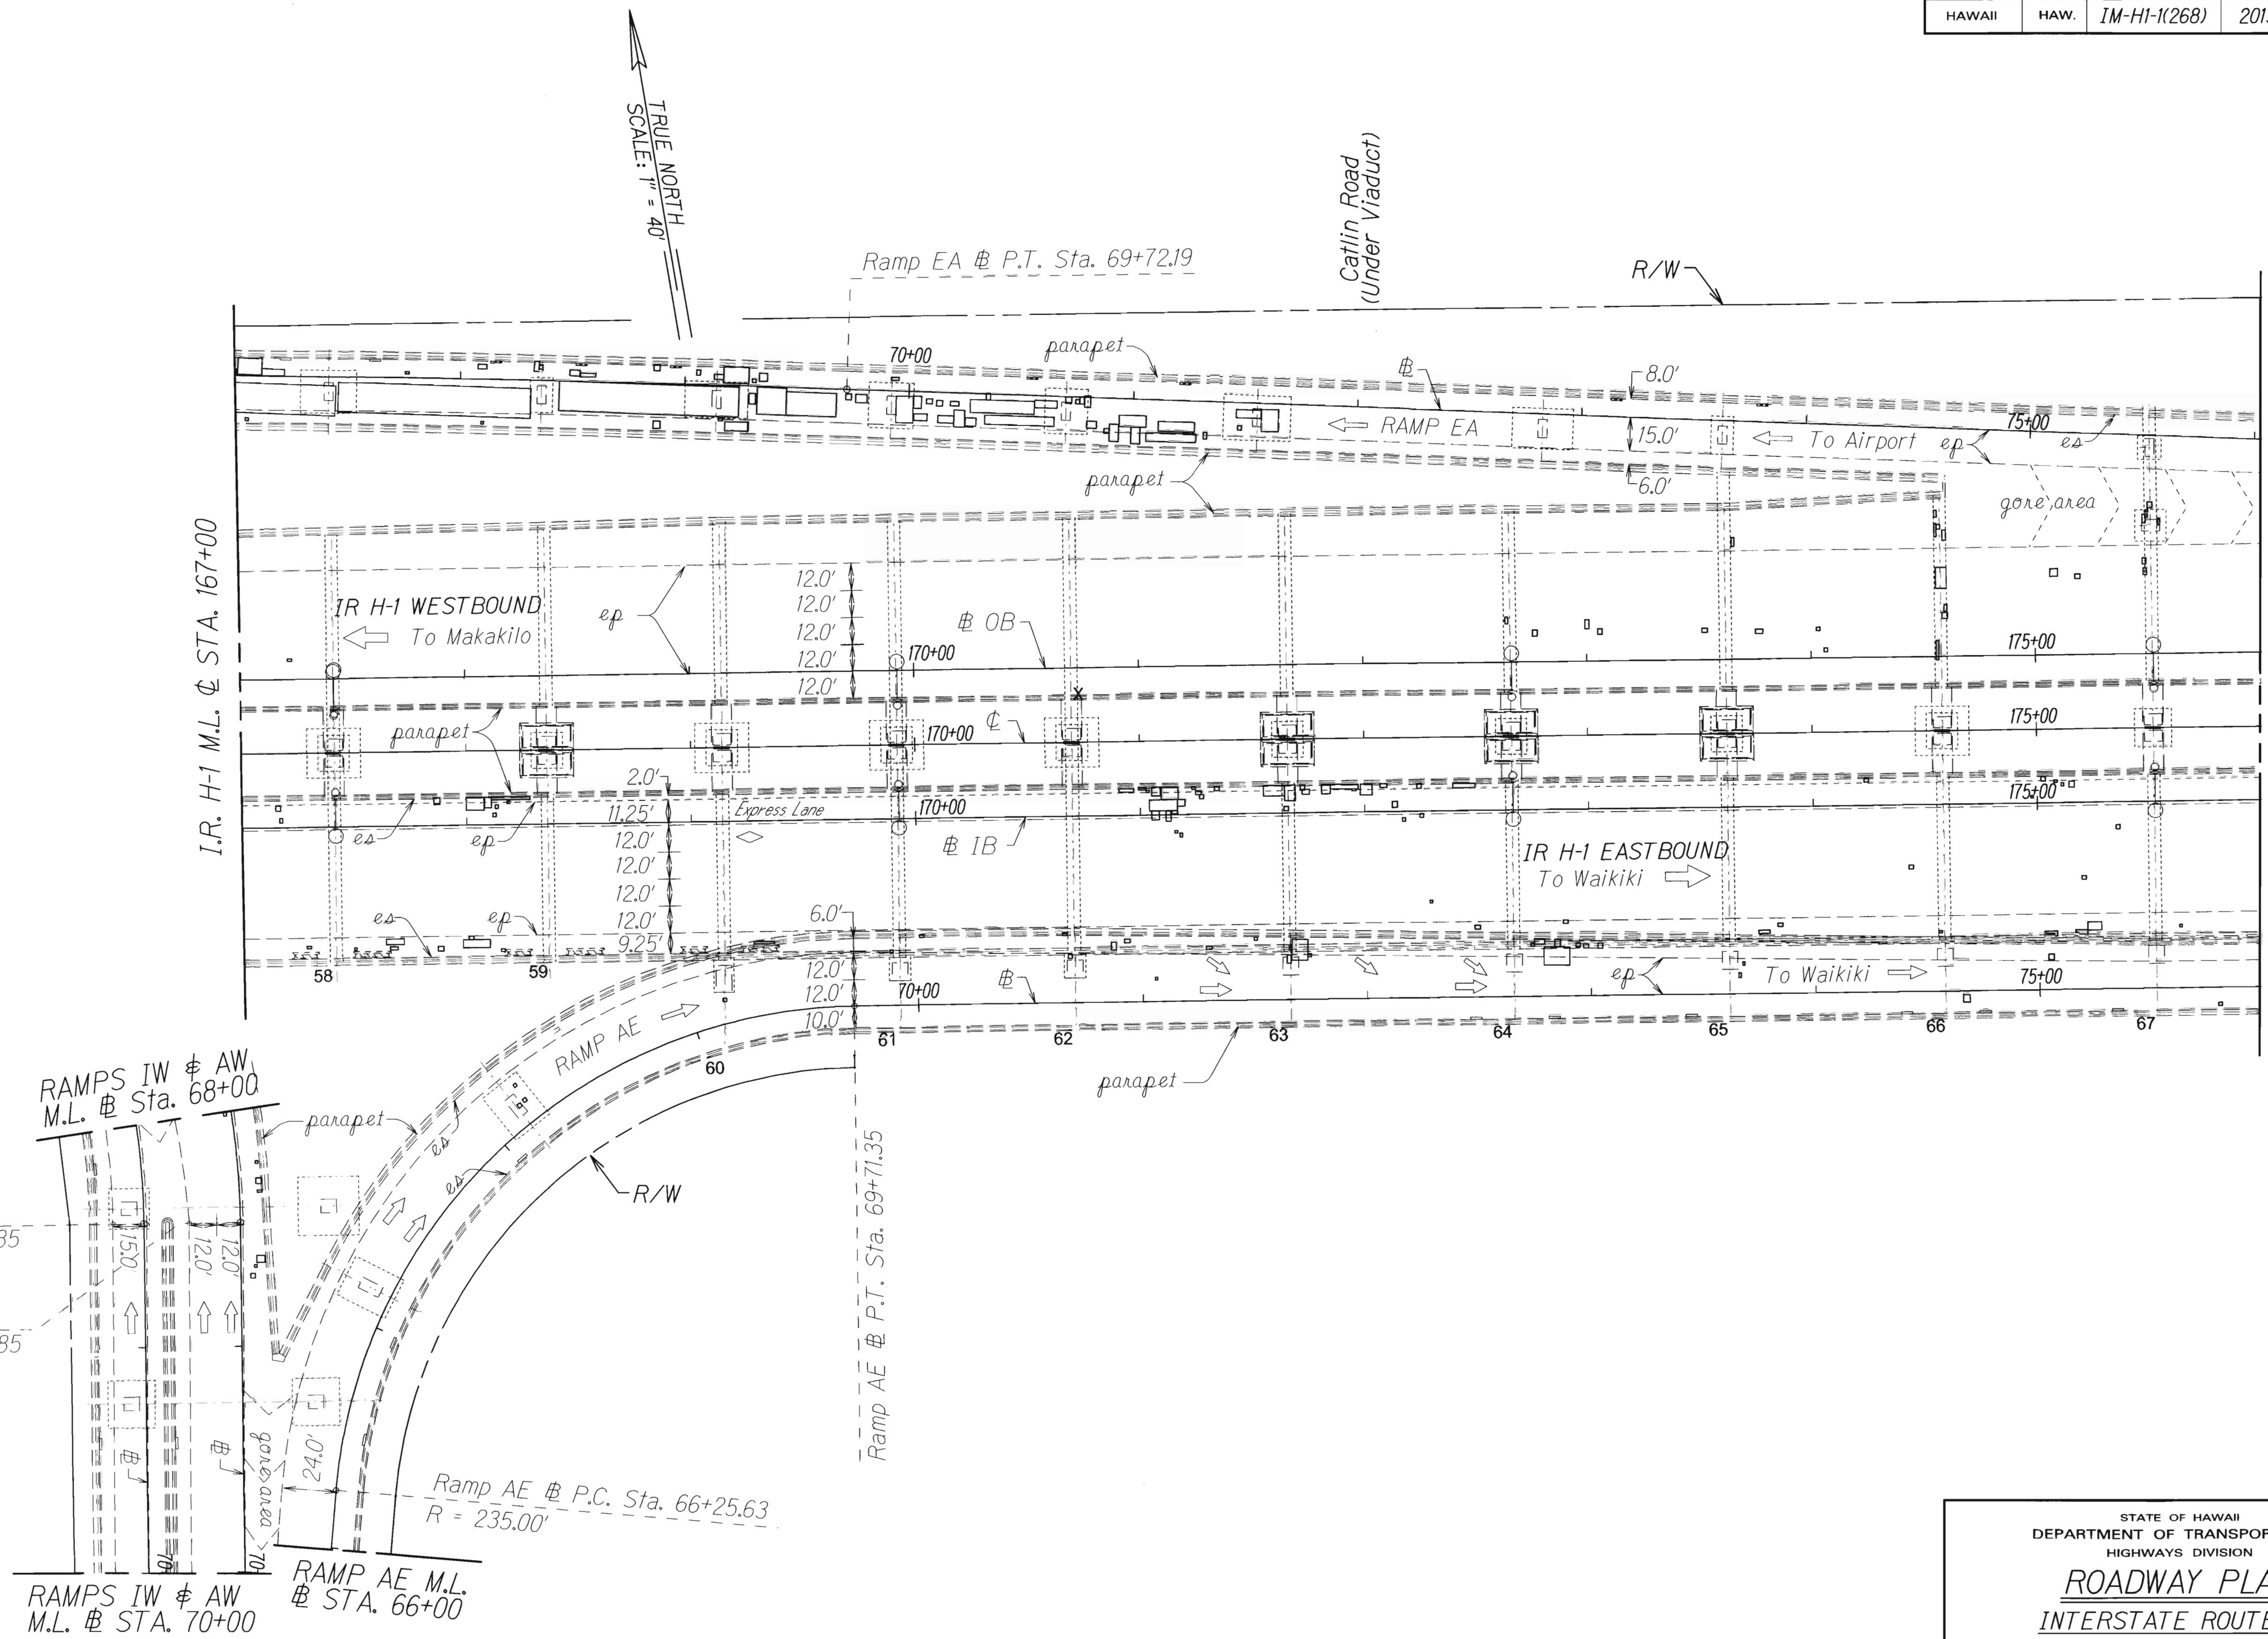

(See Plan Sheet No. 18)

I.R. H-1 M.L. STA. 176+00
(See Plan Sheet No. 19)



ORIGINAL PLAN	SURVEY PLOTTED BY	DATE
NOTE BOOK	DESIGNED BY	
	QUANTITIES BY	
	CHECKED BY	

STATE OF HAWAII
DEPARTMENT OF TRANSPORTATION
HIGHWAYS DIVISION

ROADWAY PLAN
INTERSTATE ROUTE H-1
AIRPORT VIADUCT REPAIR
VICINITY OF VALKENBURGH ST. TO MIDDLE ST.
Federal Aid Project No. IM-HI-1(268)
Scale: 1" = 40'
Date: Mar, 2013

SHEET No. 10 OF 23 SHEETS

FED. ROAD DIST. NO.	STATE	FED. AID PROJ. NO.	FISCAL YEAR	SHEET NO.	TOTAL SHEETS
HAWAII	HAW.	IM-HI-1(268)	2013	18	35

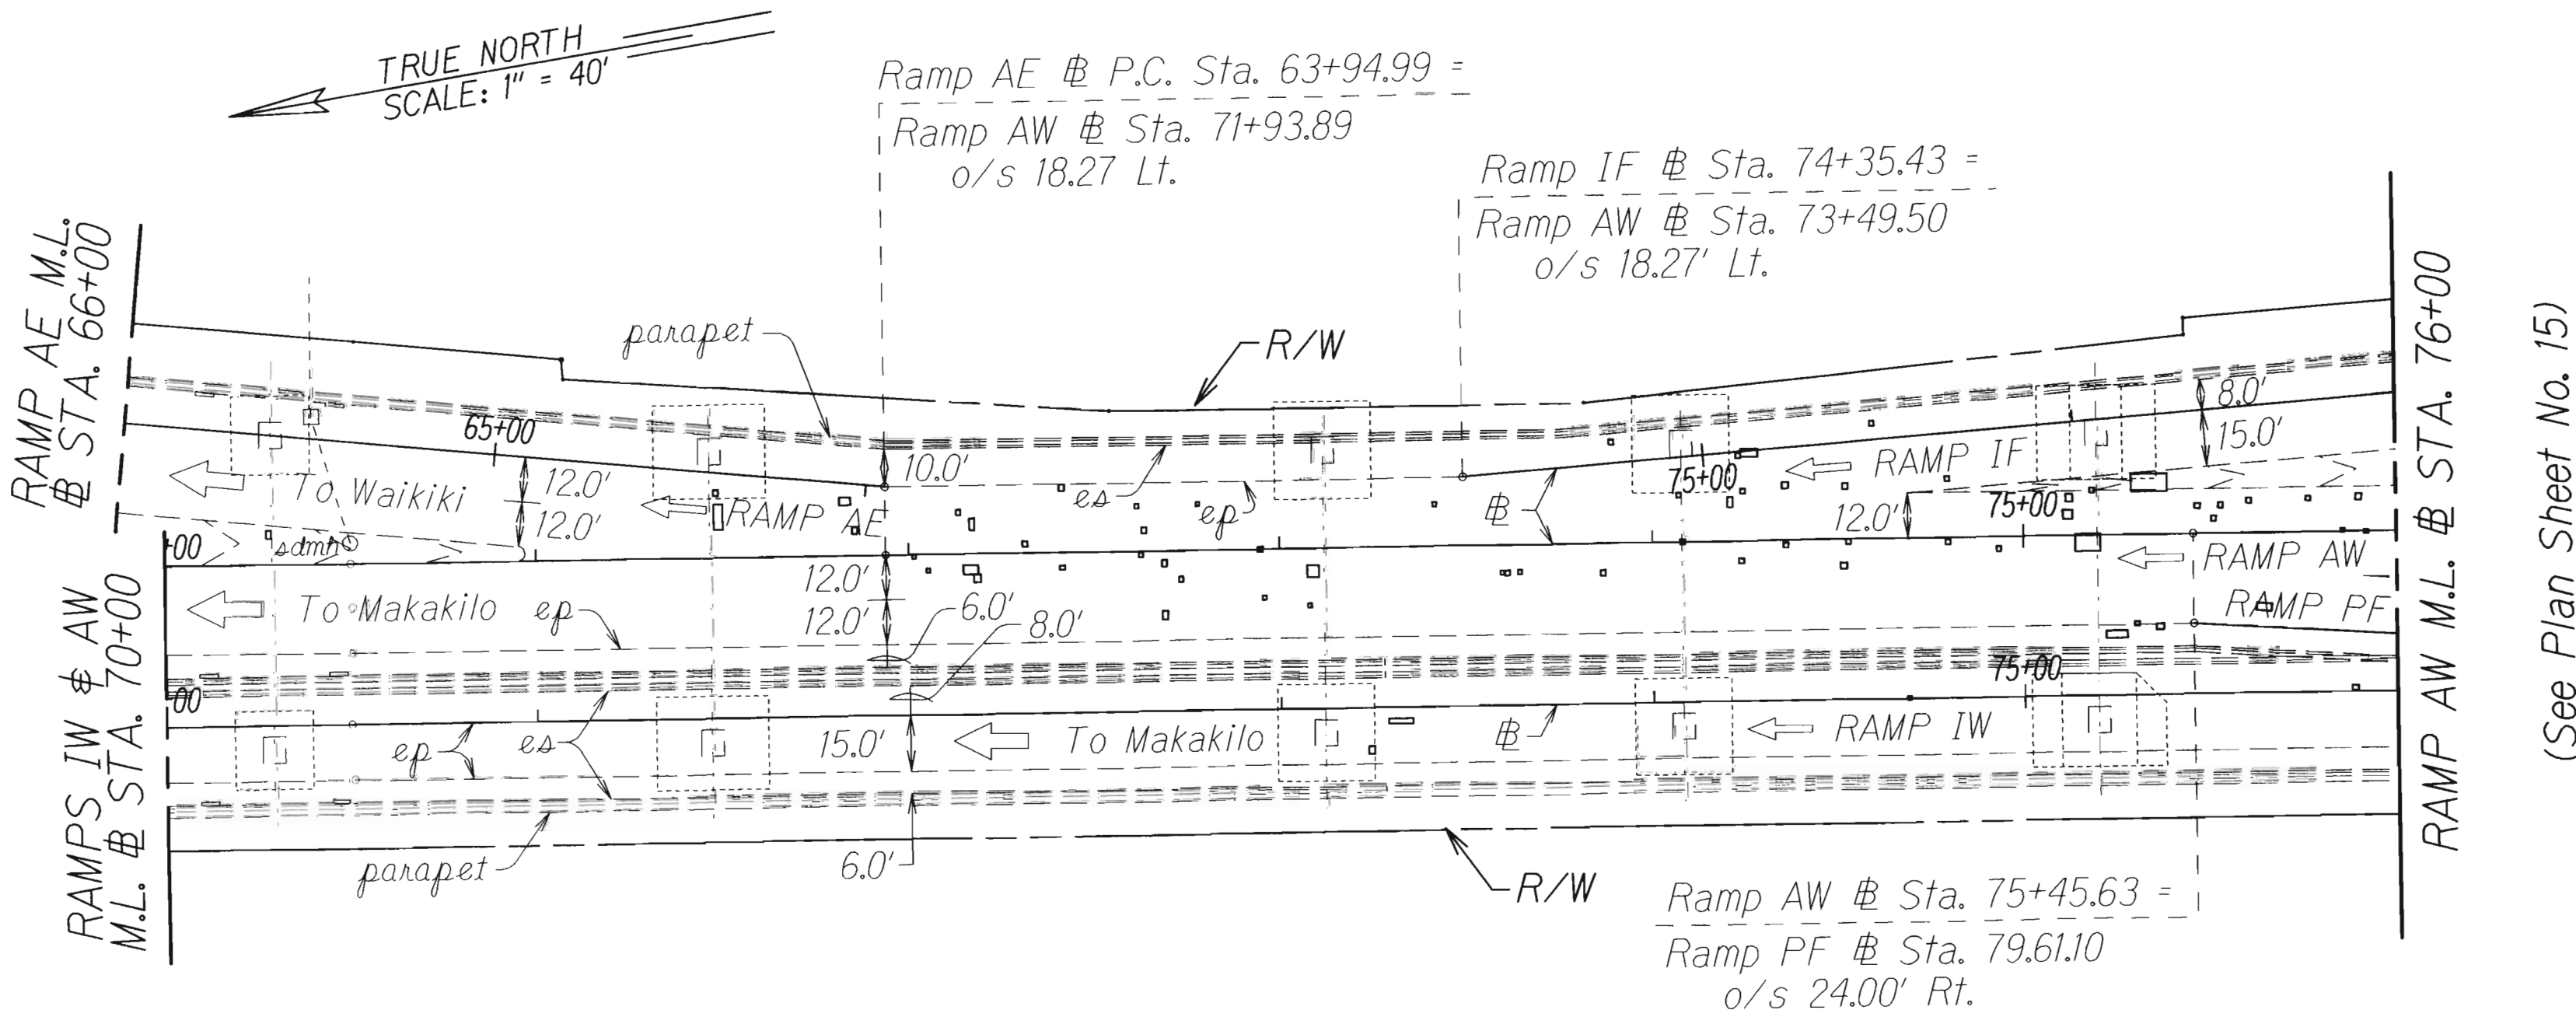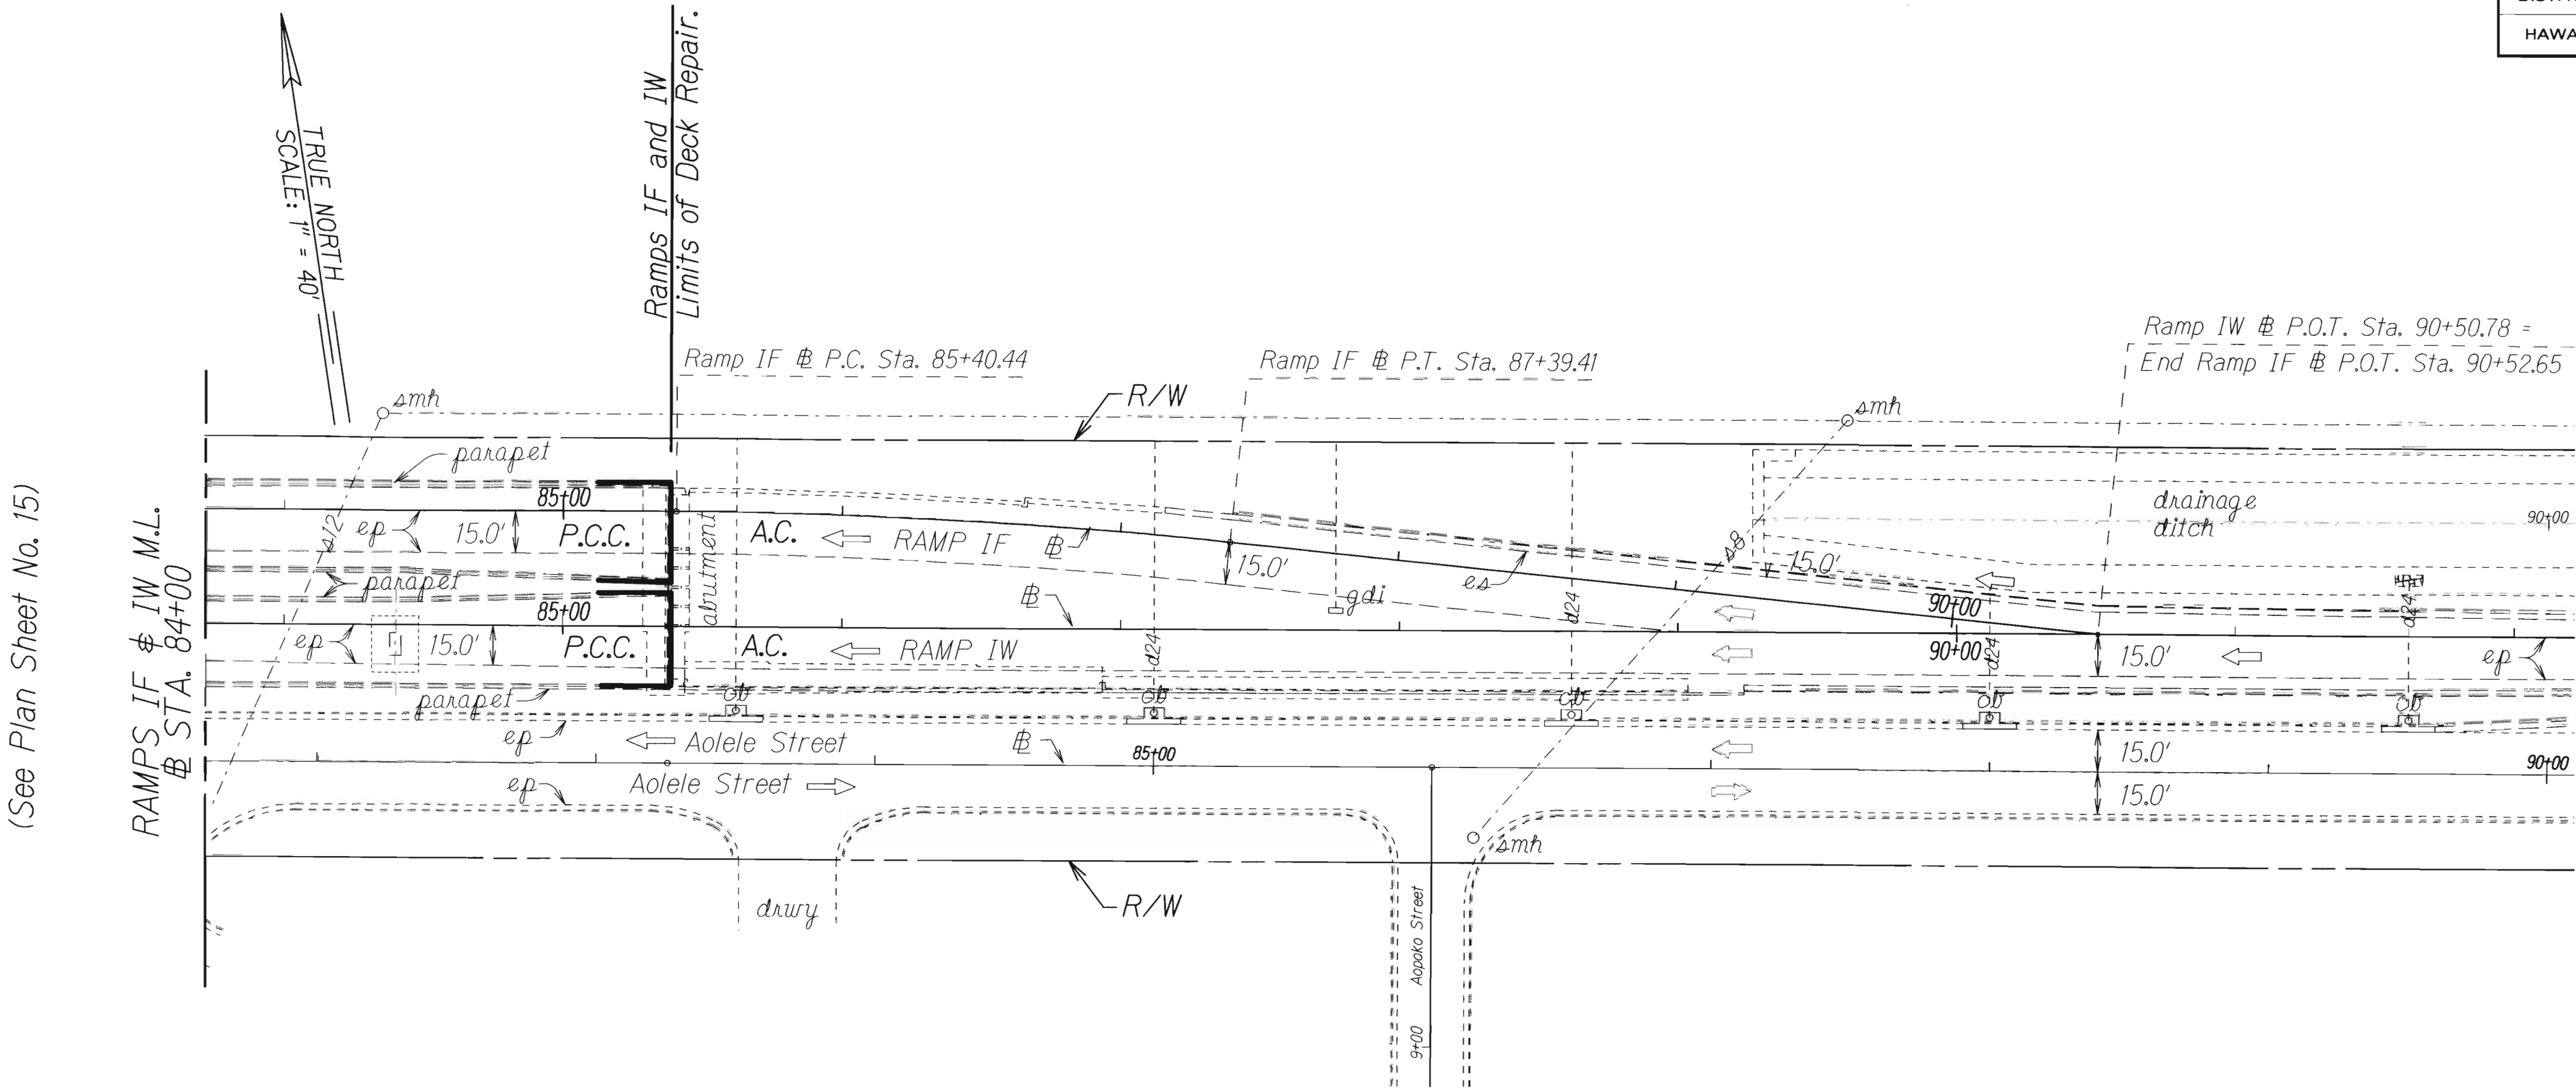

ORIGINAL PLAN	SURVEY PLOTTED BY	DATE
	DRAWN BY	*
	TRACED BY	*
NOTE BOOK	DESIGNED BY	*
	QUANTITIES BY	*
N _e	CHECKED BY	*

STATE OF HAWAII
DEPARTMENT OF TRANSPORTATION
HIGHWAYS DIVISION

ROADWAY PLAN

INTERSTATE ROUTE H-1


AIRPORT VIADUCT REPAIR

VICINITY OF VALKENBURGH ST. TO MIDDLE ST.

Federal Aid Project No. IM-HI-1(268)

Scale: 1" = 40' Date: Mar, 2013

SHEET No. 11 OF 23 SHEETS

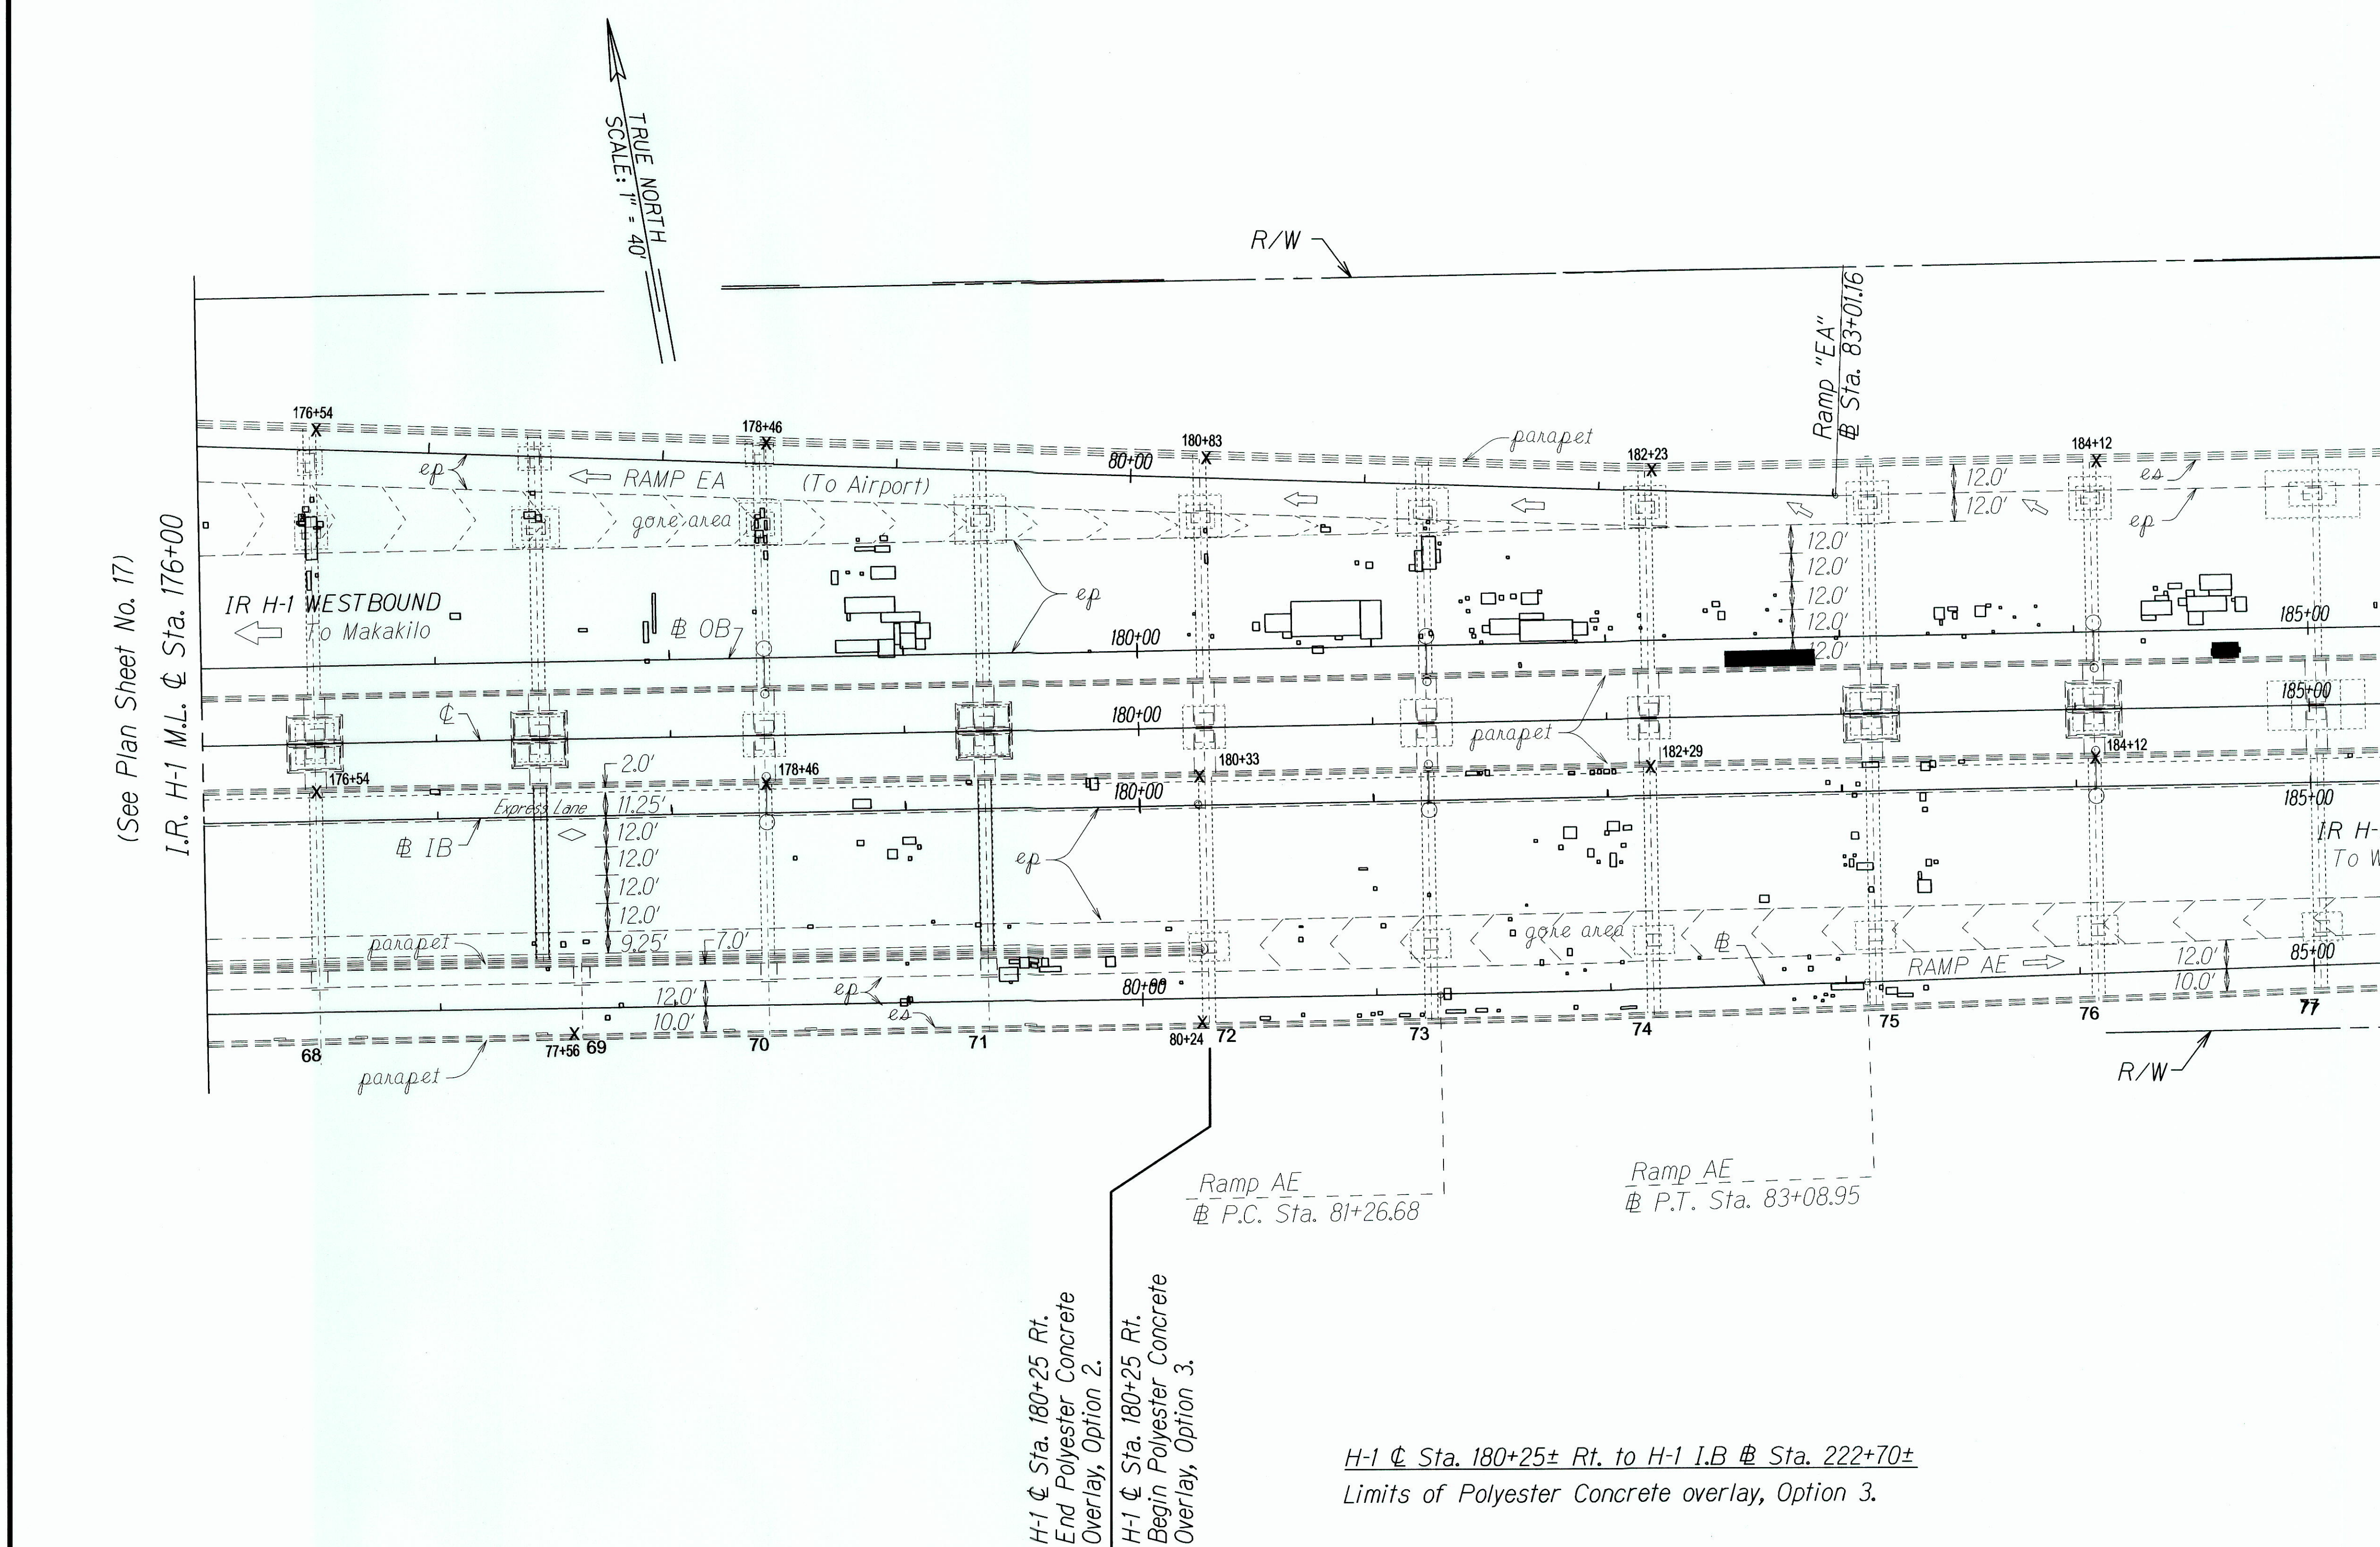[illegible]

Note: Shaded Areas are the Only Work that was done on this page.

LEGEND FOR AS-BUILT POSTINGS	
	Squiggly line for as-built deletion
	Double line for as-built deletion
Roadway	Text for as-built posting

STATE OF HAWAII
DEPARTMENT OF TRANSPORTATION
HIGHWAYS DIVISION

ROADWAY PLAN

INTERSTATE ROUTE H-1

AIRPORT VIADUCT REPAIR


VICINITY OF VALKENBURGH ST. TO MIDDLE ST.

Federal Aid Project No. IM-HI-1(268)

Scale: 1" = 40' Date: April, 2012

SHEET No. 12 OF 22 SHEETS

FED. ROAD DIST. NO.	STATE	FED. AID PROJ. NO.	FISCAL YEAR	SHEET NO.	TOTAL SHEETS
HAWAII	HAW.	1M-HI-1(268)	2013	20	31

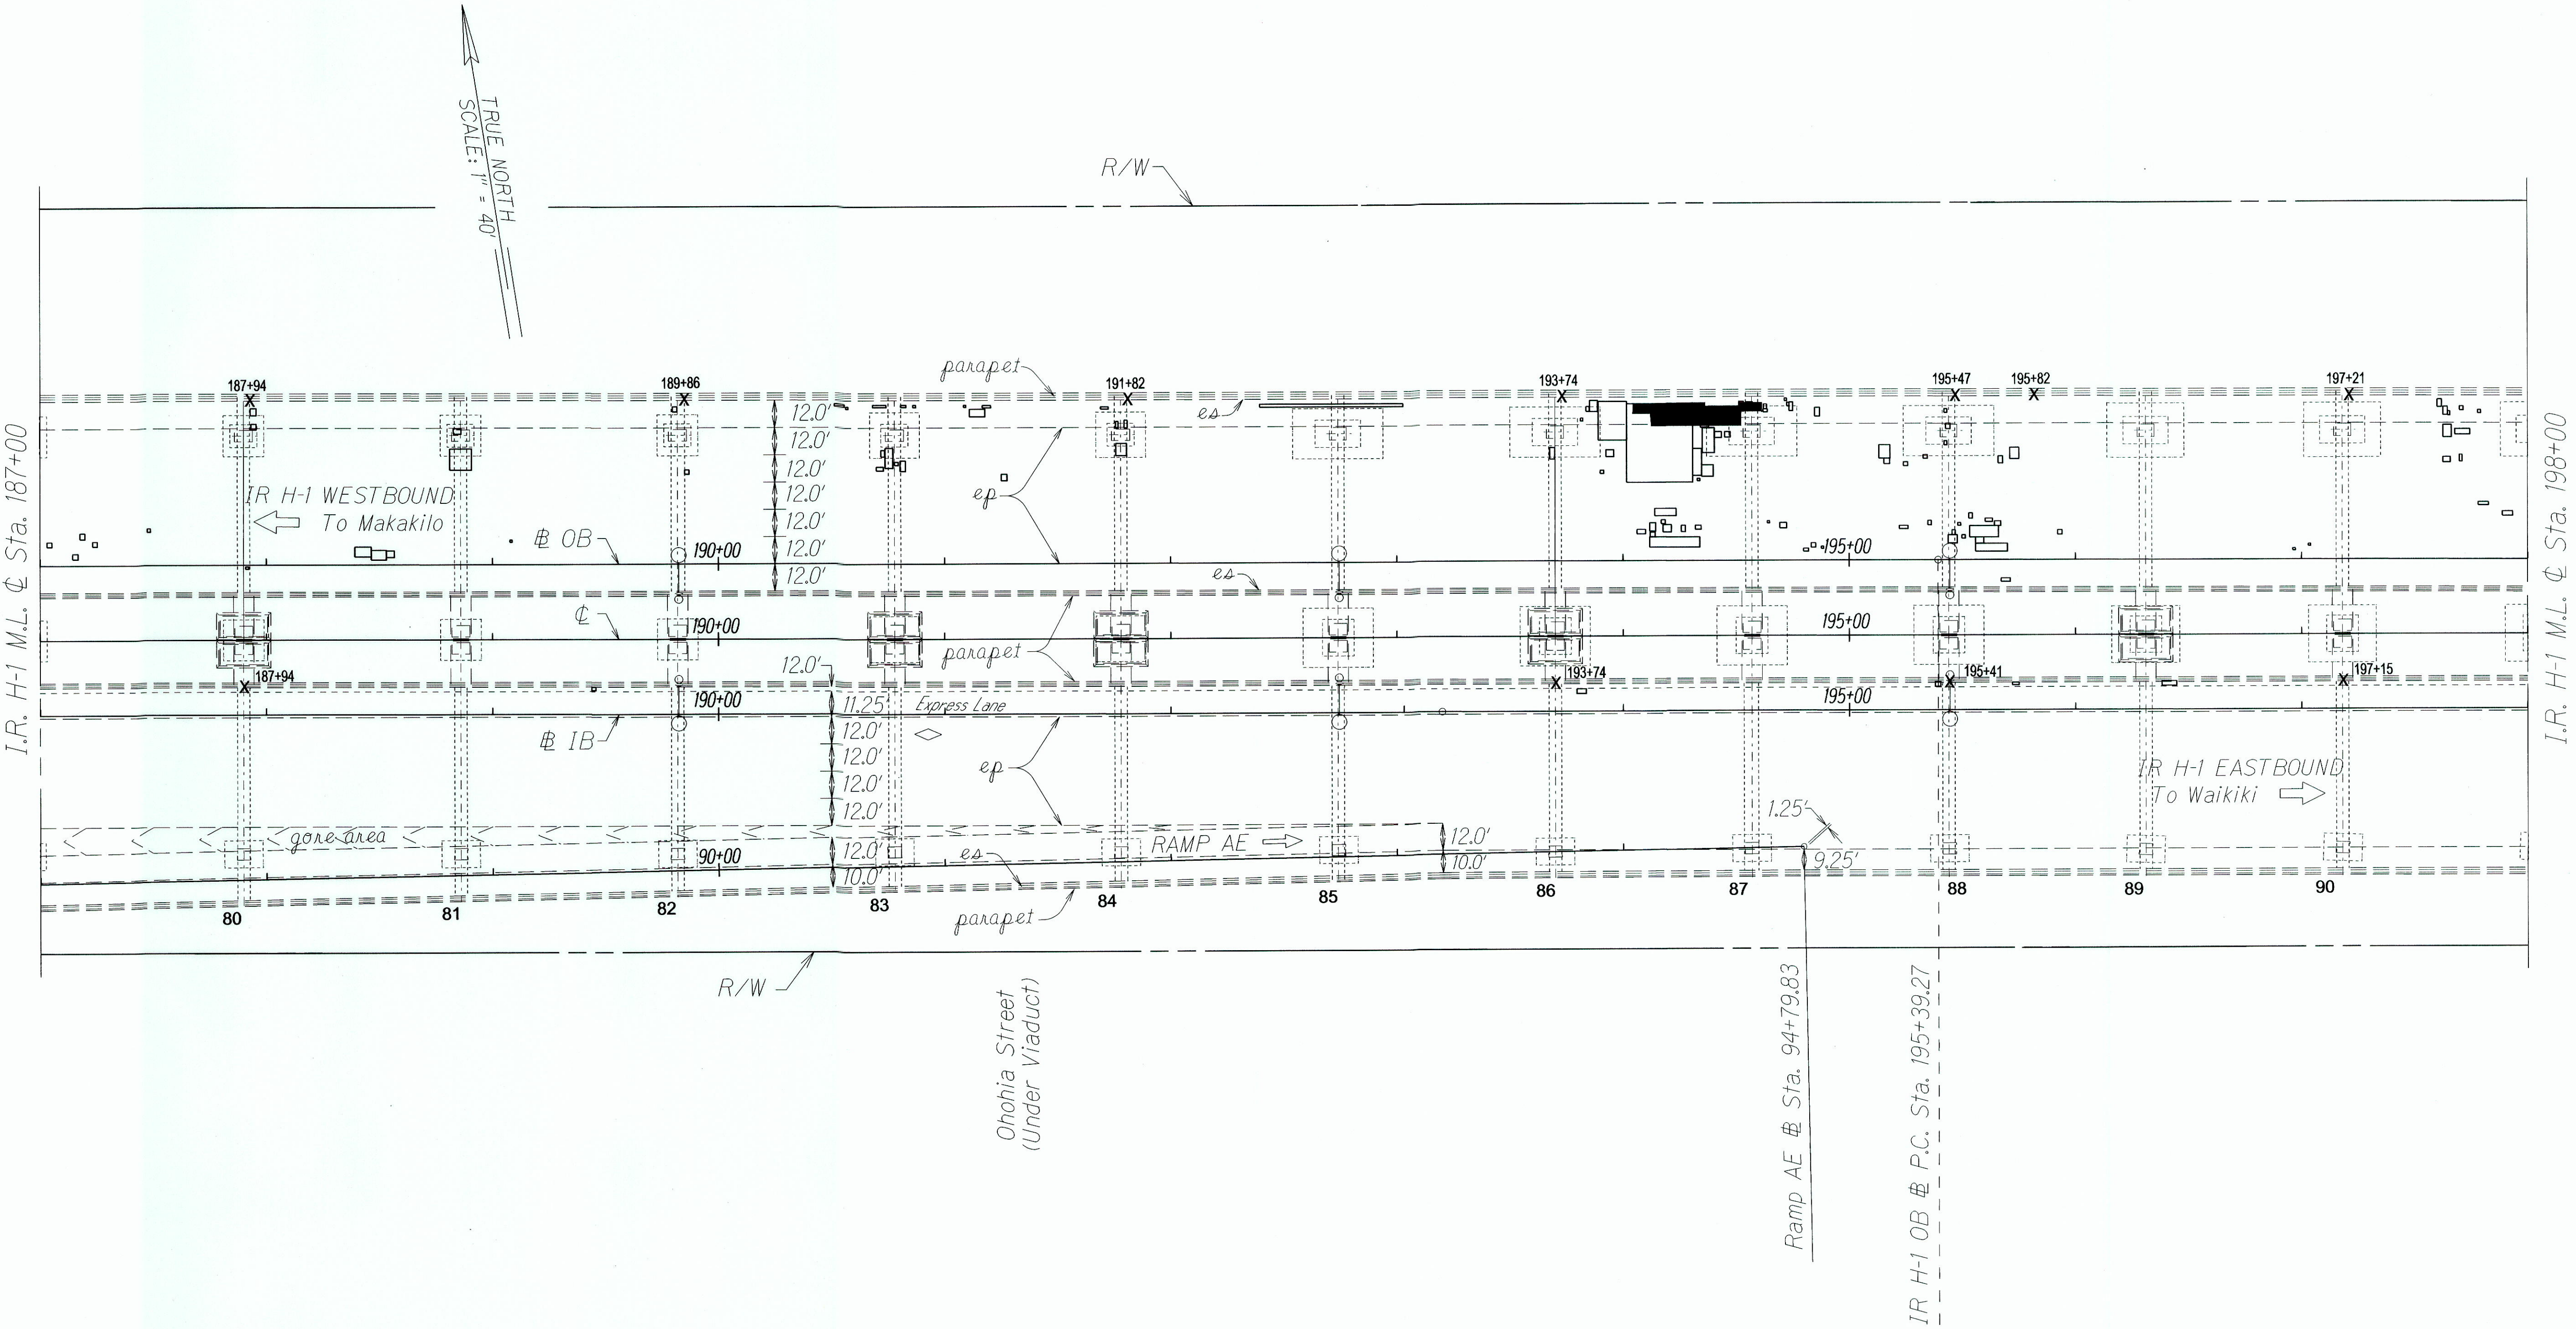

ORIGINAL PLAN	SURVEY PLOTTED BY	DATE
NOTE BOOK	DRAWN BY	10/03/12
DESIGNED BY	CHECKED BY	
CHECKED BY		

LEGEND FOR AS-BUILT POSTINGS	
	Squiggly line for as-built deletion
	Double line for as-built deletion
Roadway	Text for as-built posting


Note: Shaded Areas are the Only Work that was done on this page.

STATE OF HAWAII
DEPARTMENT OF TRANSPORTATION
HIGHWAYS DIVISION

ROADWAY PLAN
INTERSTATE ROUTE H-1
AIRPORT VIADUCT REPAIR
VICINITY OF VALKENBURGH ST. TO MIDDLE ST.
Federal Aid Project No. 1M-HI-1(268)
Scale: 1" = 40'
Date: April, 2012

SHEET No. 13 OF 22 SHEETS

FED. ROAD DIST. NO.	STATE	FED. AID PROJ. NO.	FISCAL YEAR	SHEET NO.	TOTAL SHEETS
HAWAII	HAW.	IM-H1-1(268)	2013	21	31

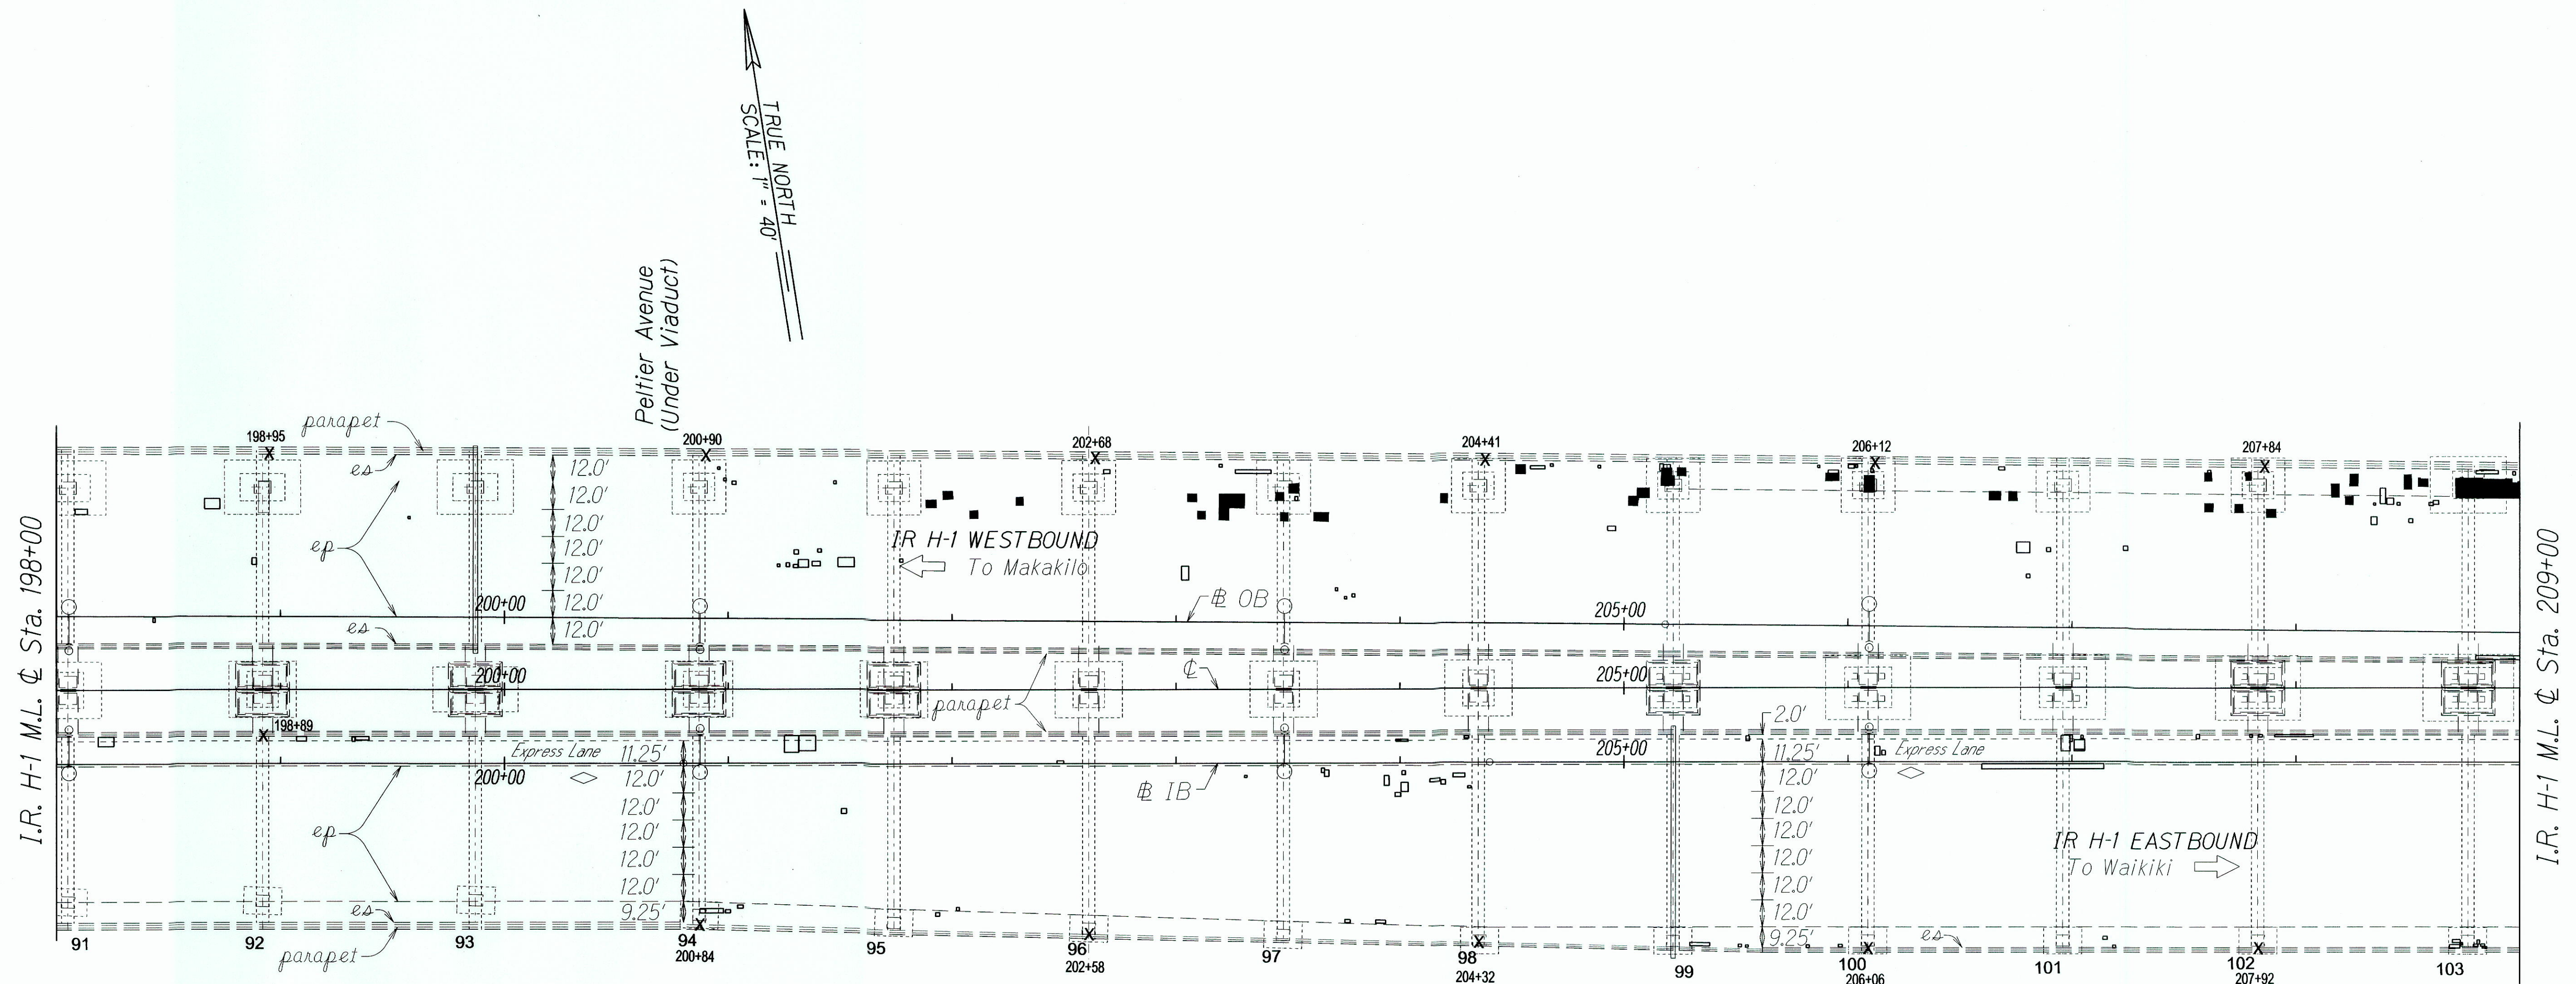

ORIGINAL PLAN	SURVEY PLOTTED BY	DATE
NOTE BOOK	DRAWN BY	10/04/12
DESIGNED BY	CHECKED BY	
NOTED BY		


LEGEND FOR AS-BUILT POSTINGS	
	Squiggly line for as-built deletion
	Double line for as-built deletion
Roadway	Text for as-built posting

Note: Shaded Areas are the Only Work that was done on this page.

STATE OF HAWAII DEPARTMENT OF TRANSPORTATION HIGHWAYS DIVISION
ROADWAY PLAN
INTERSTATE ROUTE H-1
AIRPORT VIADUCT REPAIR
VICINITY OF VALKENBURGH ST. TO MIDDLE ST.
Federal Aid Project No. IM-H1-1(268)
Scale: 1" = 40'
Date: April, 2012
SHEET No. 14 OF 8 SHEETS

"AS-BUILT"

FED. ROAD DIST. NO.	STATE	FED. AID PROJ. NO.	FISCAL YEAR	SHEET NO.	TOTAL SHEETS
HAWAII	HAW.	IM-HI-1(268)	2013	22	31

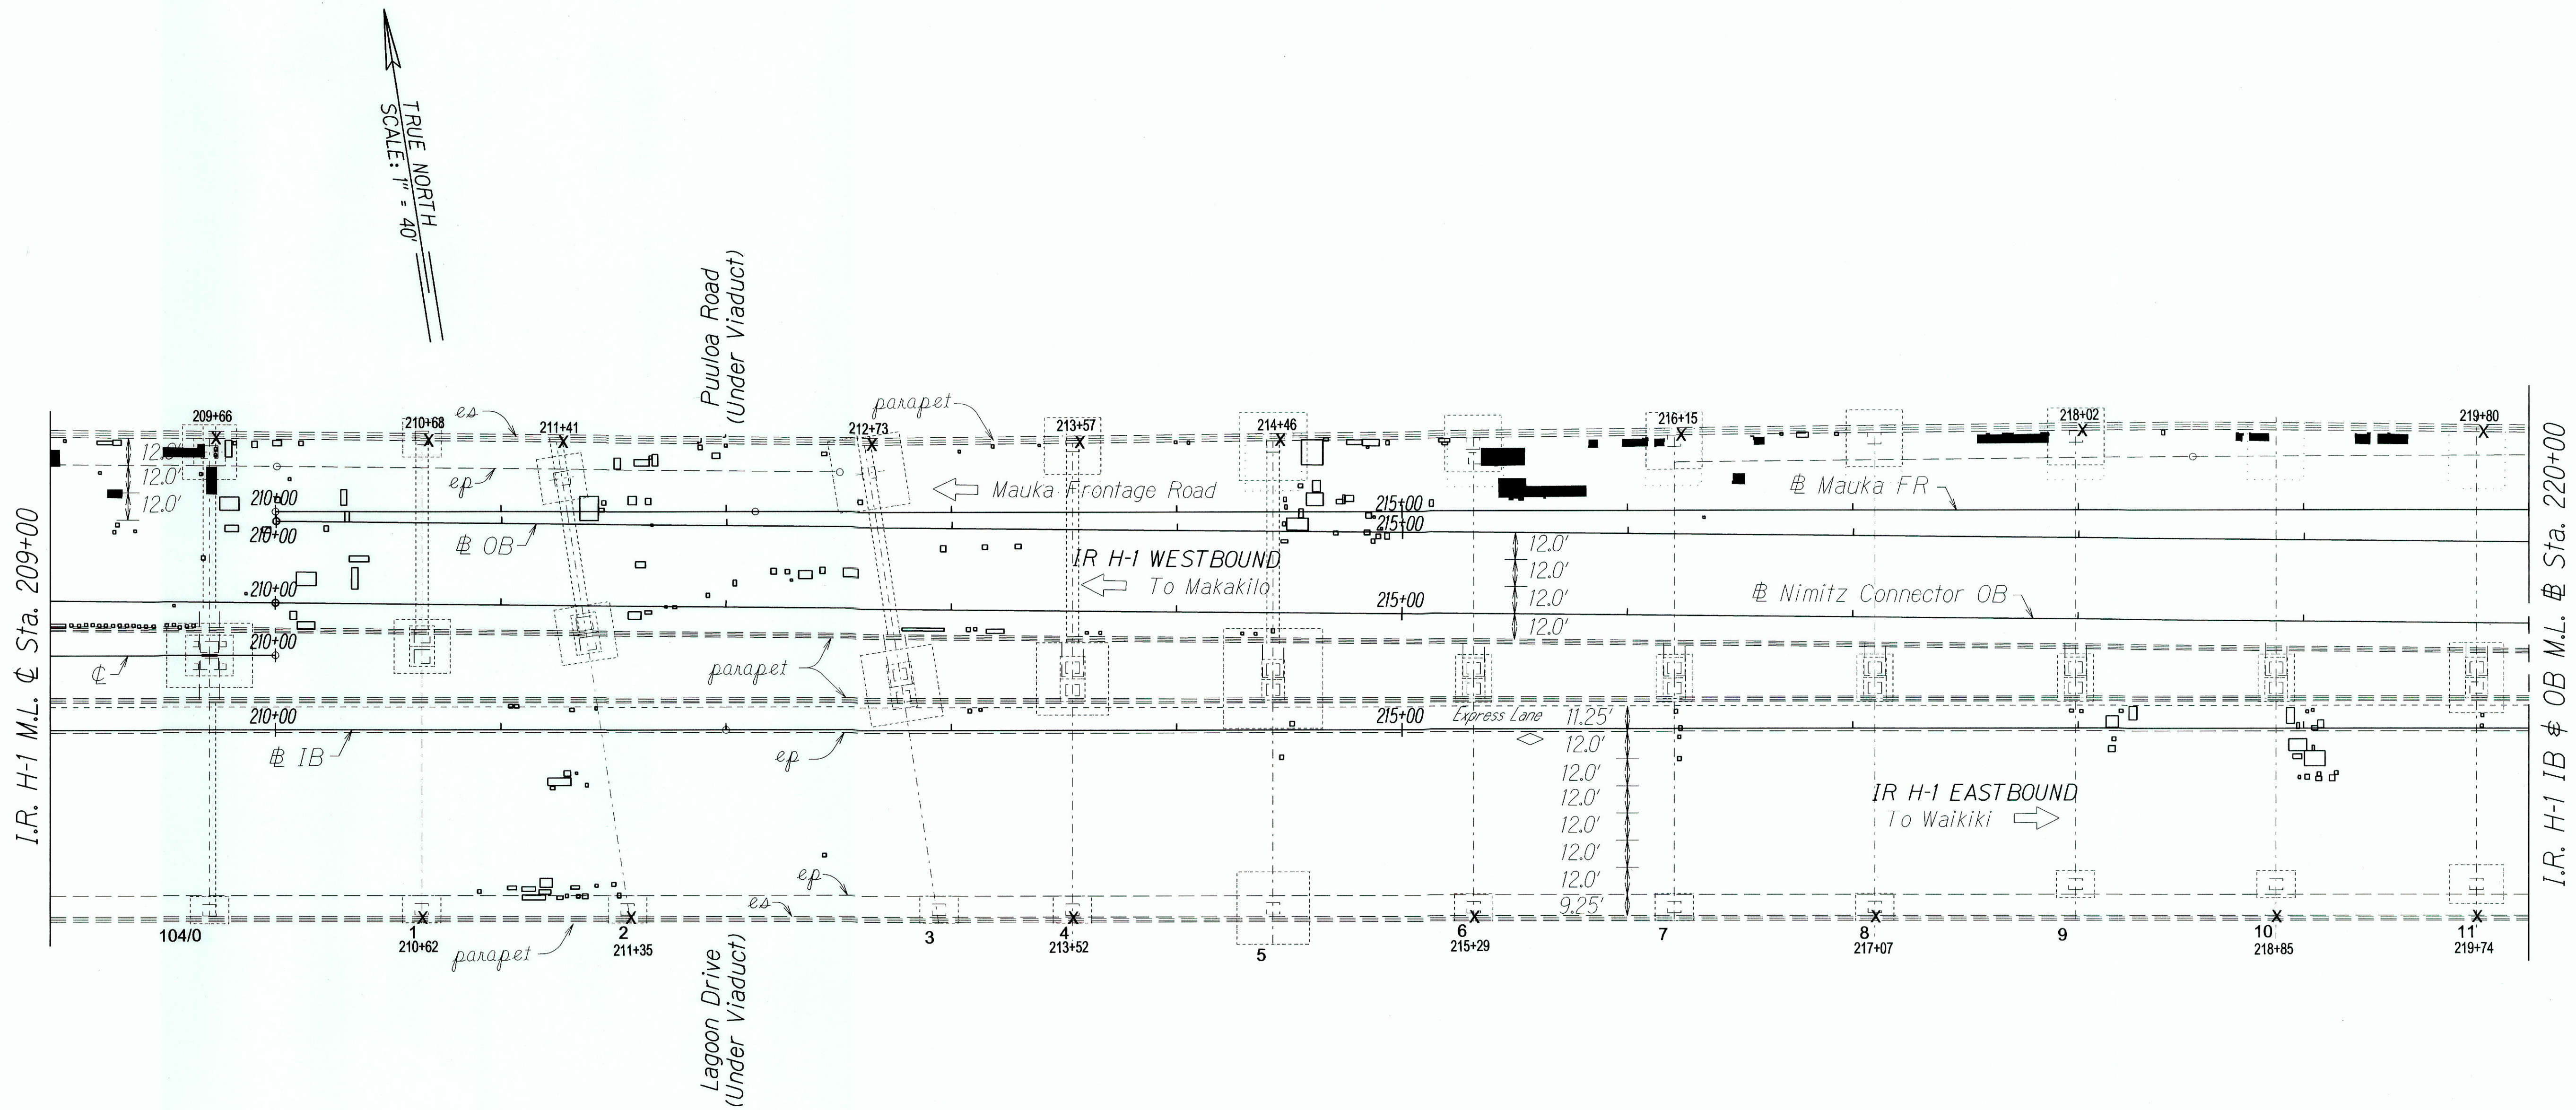


ORIGINAL PLAN	DATE
DESIGNED BY	07/04/12
TRACED BY	
QUANTITIES BY	
CHECKED BY	

LEGEND FOR AS-BUILT POSTINGS	
	Squiggly line for as-built deletion
	Double line for as-built deletion
Roadway	Text for as-built posting

Note: Shaded Areas are the Only Work that was done on this page.

STATE OF HAWAII DEPARTMENT OF TRANSPORTATION HIGHWAYS DIVISION	
ROADWAY PLAN	
INTERSTATE ROUTE H-1 AIRPORT VIADUCT REPAIR	
VICINITY OF VALKENBURGH ST. TO MIDDLE ST.	
Federal Aid Project No. IM-HI-1(268)	
Scale: 1" = 40'	Date: April, 2012
SHEET No. 15 OF 22 SHEETS	

FED. ROAD DIST. NO.	STATE	FED. AID PROJ. NO.	FISCAL YEAR	SHEET NO.	TOTAL SHEETS
HAWAII	HAW.	IM-H1-1(268)	2013	23	35

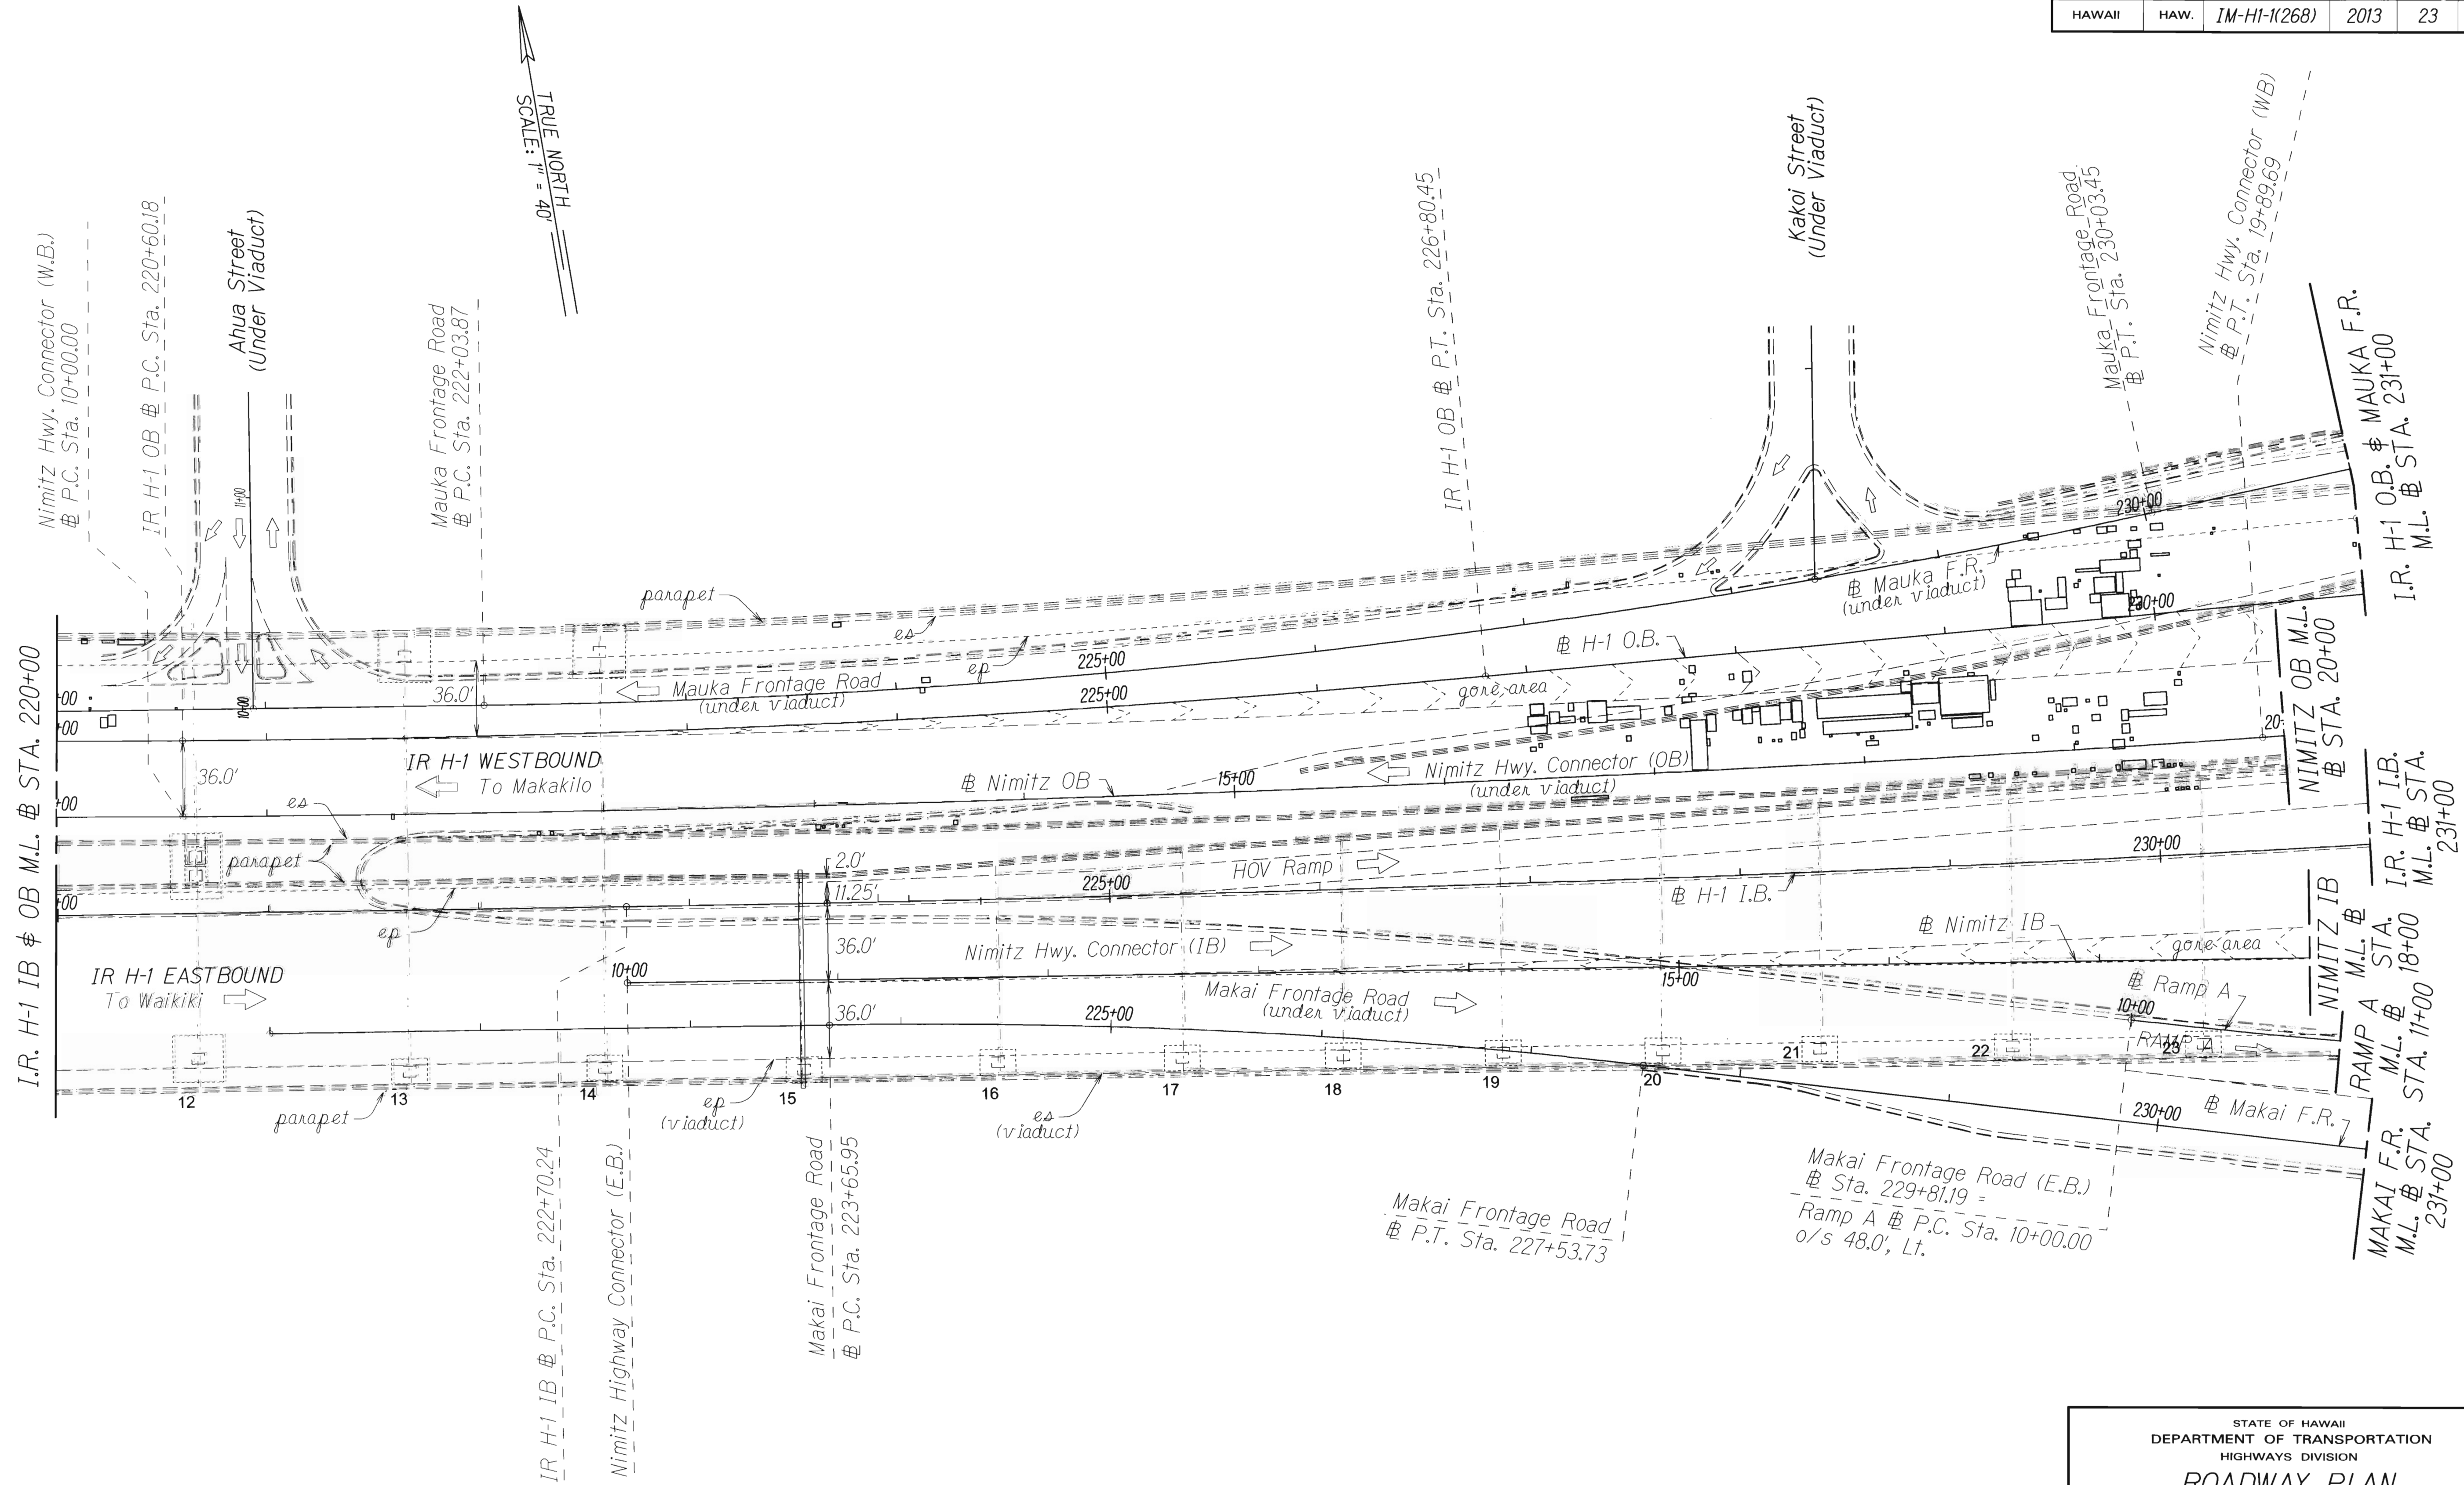

ORIGINAL PLAN	SURVEY PLOTTED BY	DATE
TRACED BY	DRAWN BY	
NOTE BOOK	CHECKED BY	


STATE OF HAWAII
DEPARTMENT OF TRANSPORTATION
HIGHWAYS DIVISION

ROADWAY PLAN
INTERSTATE ROUTE H-1
AIRPORT VIADUCT REPAIR
VICINITY OF VALKENBURGH ST. TO MIDDLE ST.
Federal Aid Project No. IM-H1-1(268)

Scale: 1" = 40' Date: Mar, 2013

SHEET No. 16 OF 22 SHEETS

FED. ROAD DIST. NO.	STATE	FED. AID PROJ. NO.	FISCAL YEAR	SHEET NO.	TOTAL SHEETS
HAWAII	HAW.	IM-HI-1(268)	2013	22	35

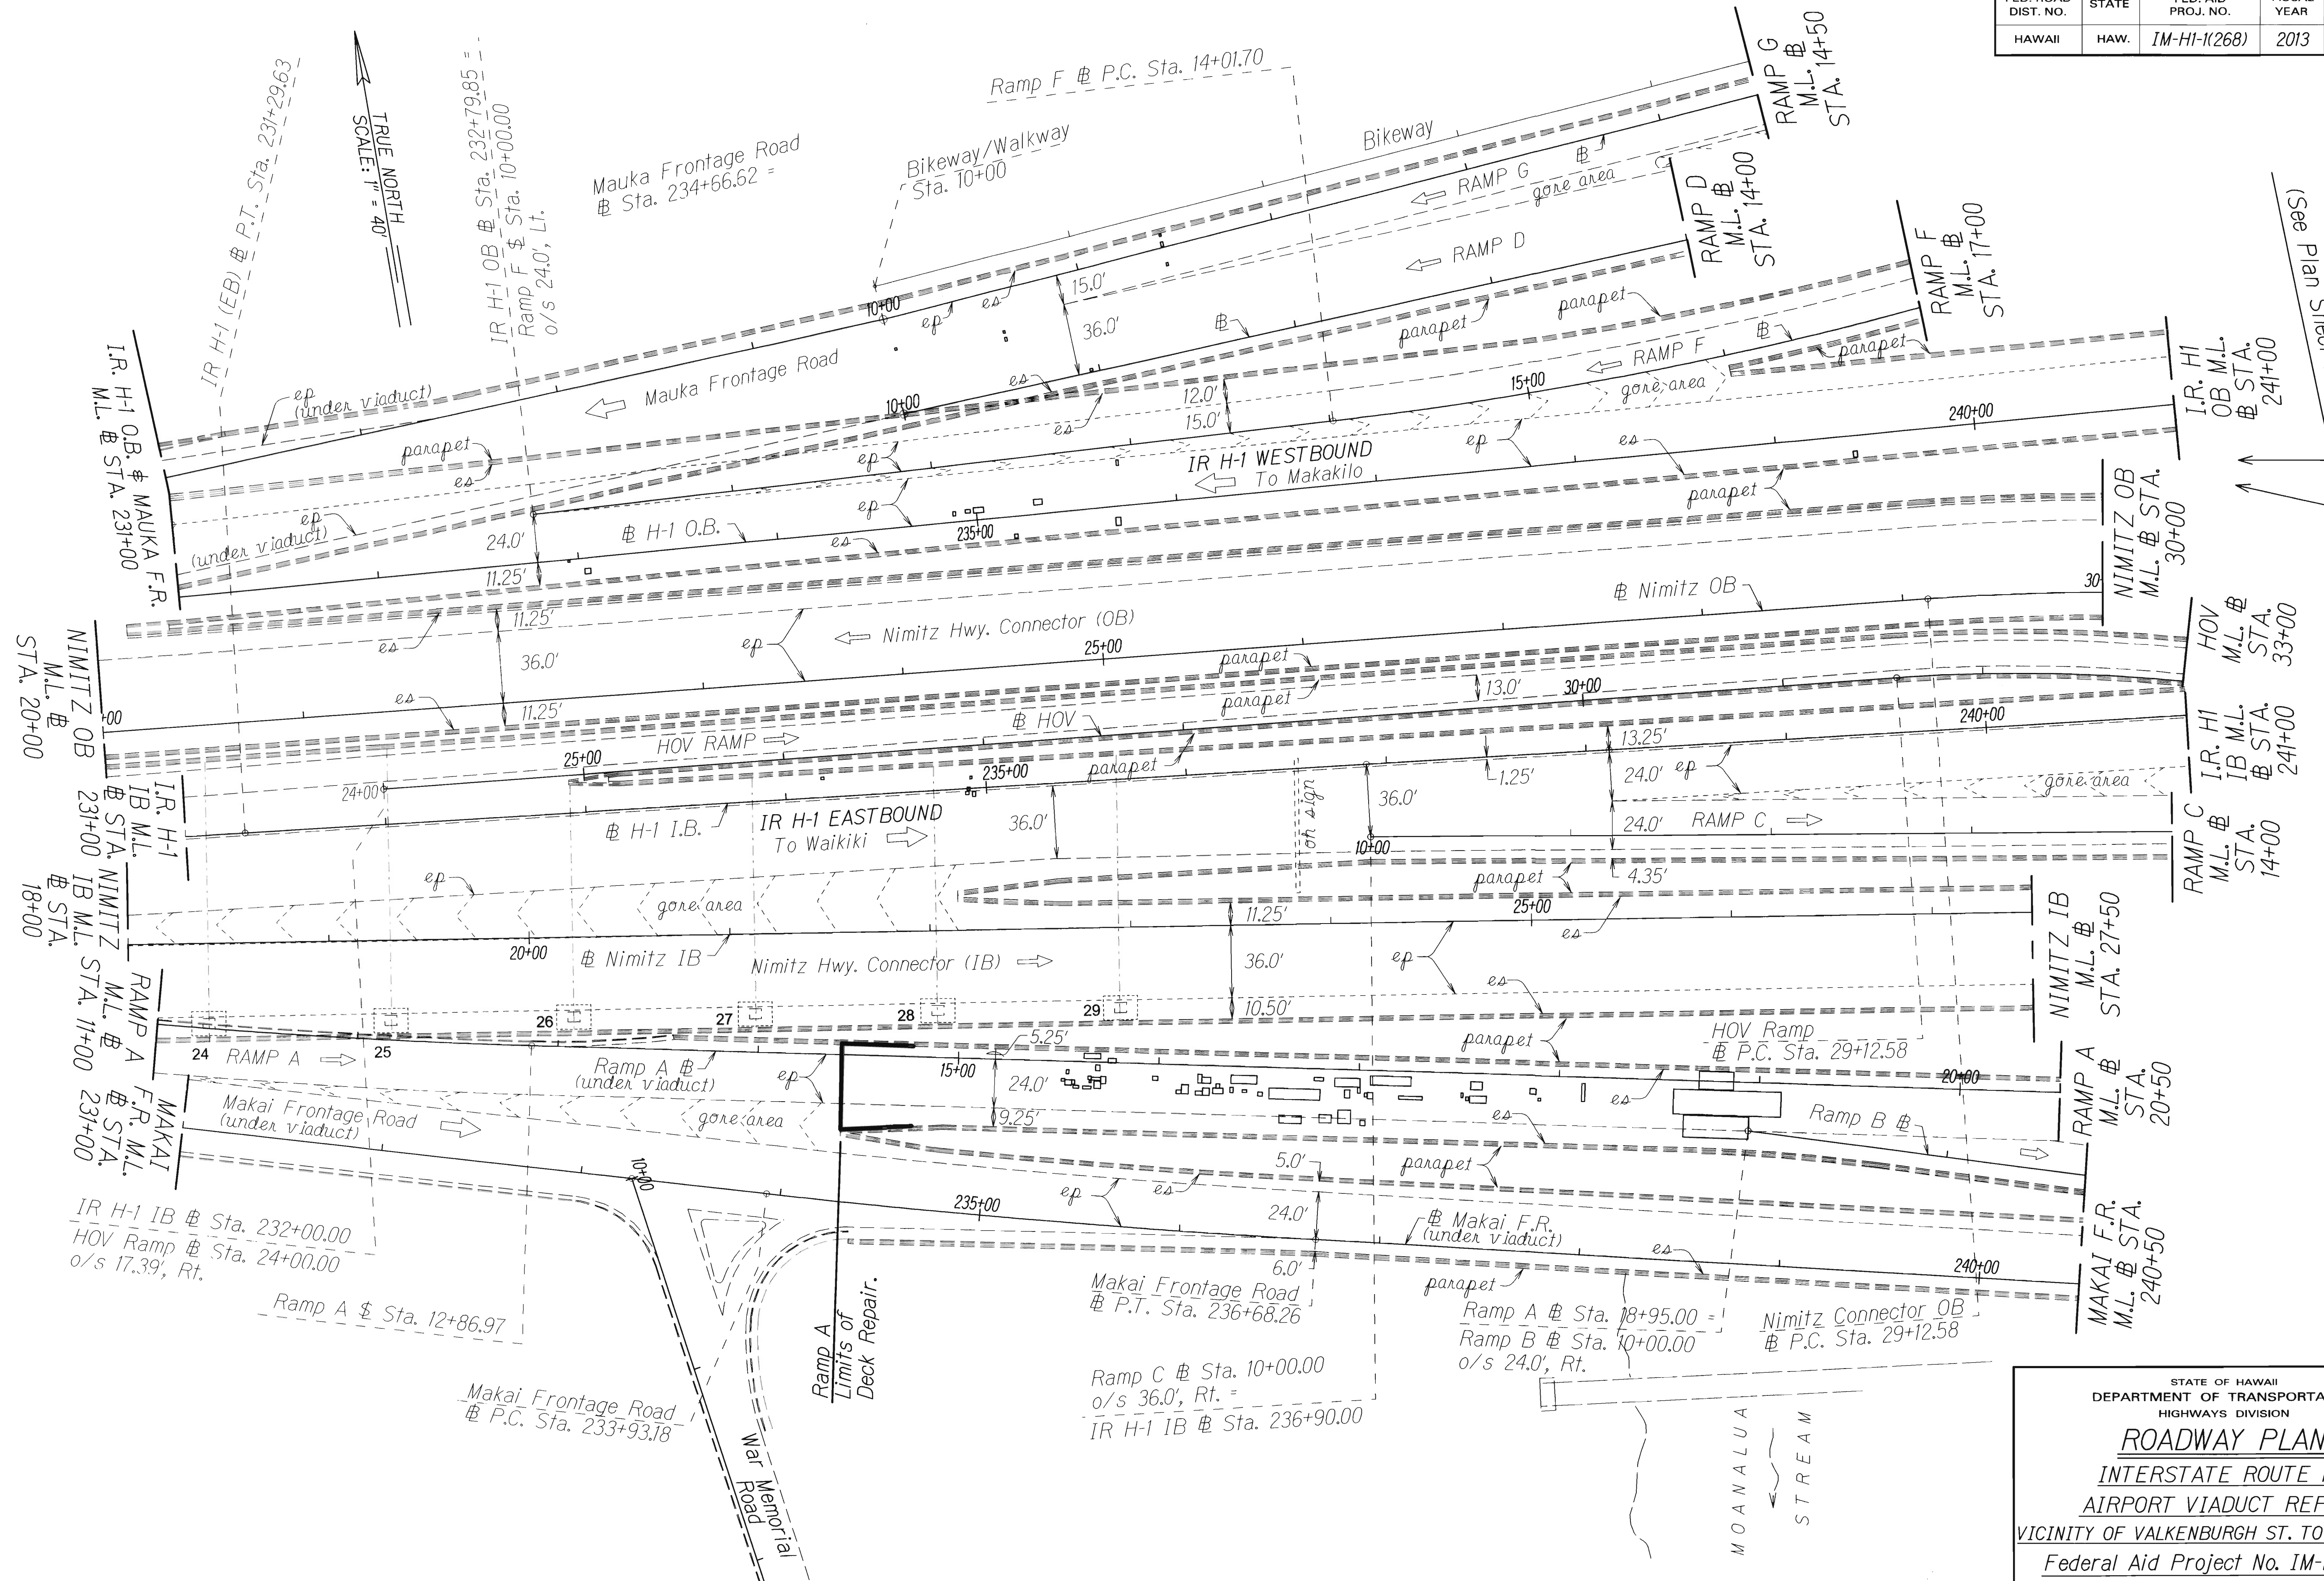

Plan Sheet No. 25)

1000

ORIGINAL PLAN	SURVEY PLOTTED BY _____	DATE _____
NOTE BOOK	DRAWN BY _____	•
	TRACED BY _____	•
	DESIGNED BY _____	•
	QUANTITIES BY _____	•
N _e	CHECKED BY _____	•

STATE OF HAWAII
DEPARTMENT OF TRANSPORTATION
HIGHWAYS DIVISION

ROADWAY PLAN

INTERSTATE ROUTE H-1

AIRPORT VIADUCT REPAIR


VICINITY OF VALKENBURGH ST. TO MIDDLE ST.

Federal Aid Project No. IM-HI-1(268)

Scale: 1" = 40' Date: Mar, 2013

SHEET No. 17 OF 22 SHEETS

FED. ROAD DIST. NO.	STATE	FED. AID PROJ. NO.	FISCAL YEAR	SHEET NO.	TOTAL SHEETS
HAWAII	HAW.	IM-HI-1(268)	2013	26	35

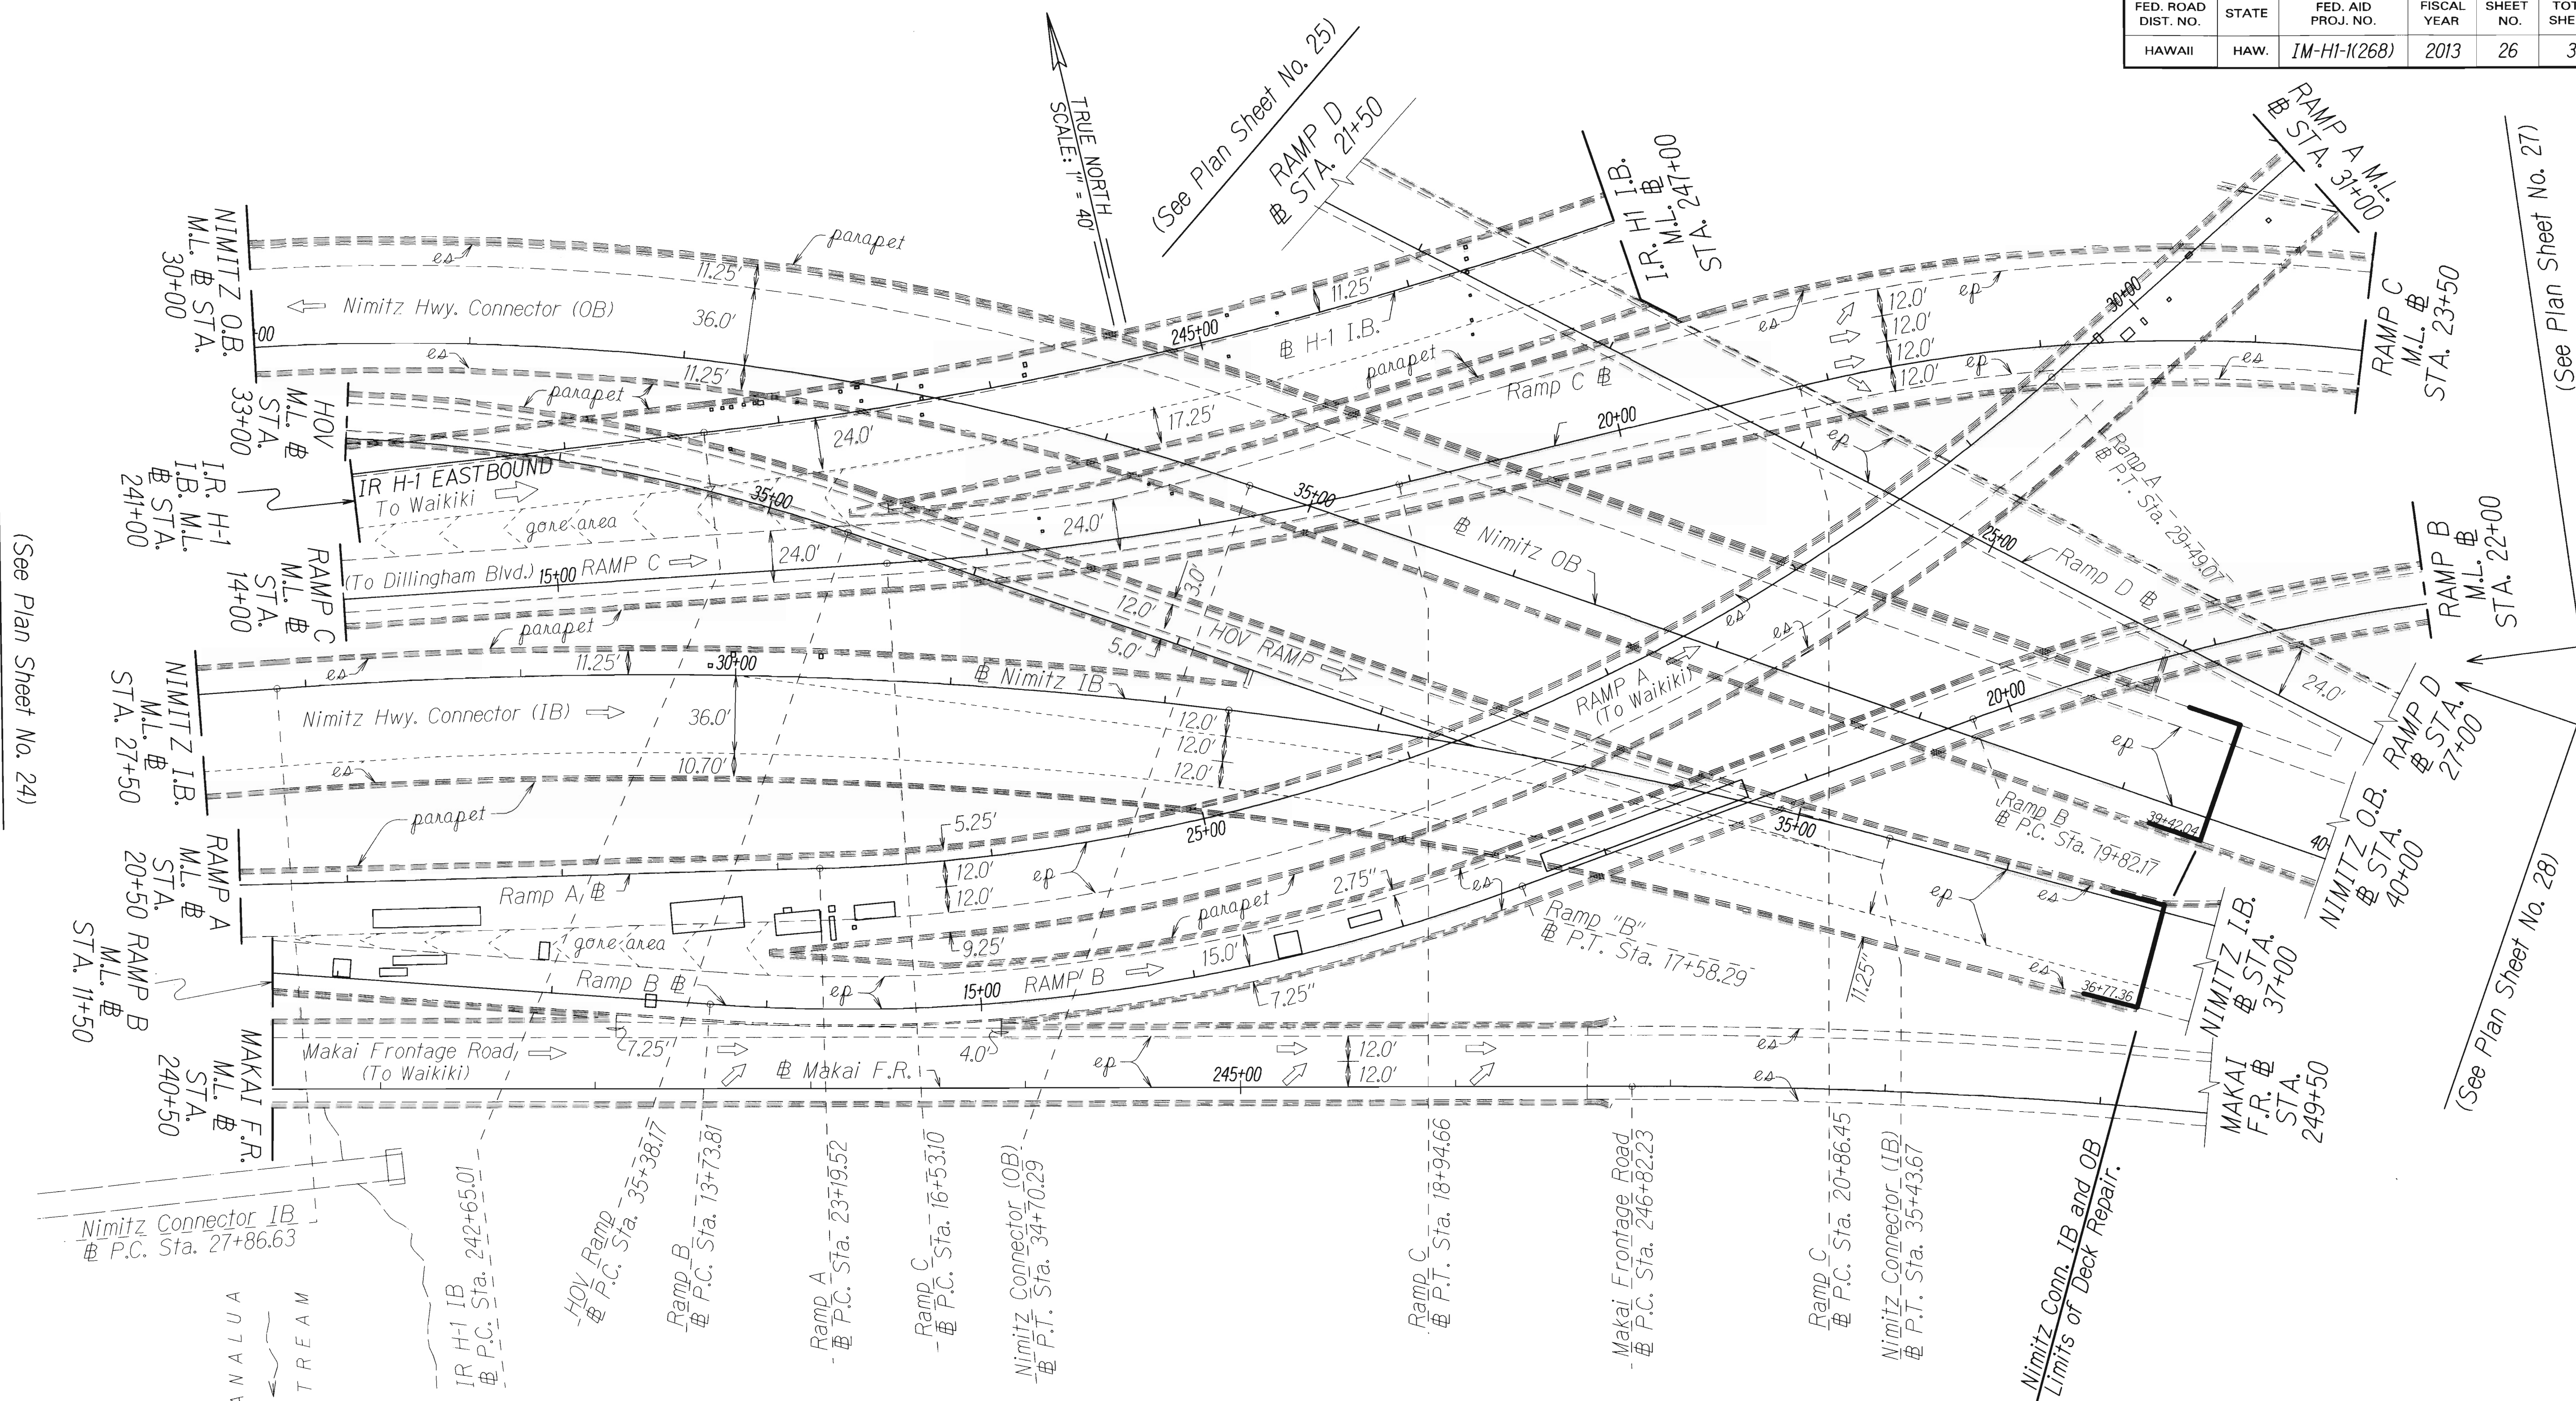

ORIGINAL PLAN	SURVEY PLOTTED BY _____ DATE _____
NOTE BOOK	DRAWN BY _____
	DESIGNED BY _____
	QUANTITIES BY _____
	CHECKED BY _____
No. _____	

STATE OF HAWAII
DEPARTMENT OF TRANSPORTATION
HIGHWAYS DIVISION

ROADWAY PLAN

INTERSTATE ROUTE H-1

AIRPORT VIADUCT REPAIR


VICINITY OF VALKENBURGH ST. TO MIDDLE ST.

Federal Aid Project No. IM-H1-1(268)

Scale: 1" = 40' Date: Mar, 2013

SHEET No. 19 OF 22 SHEETS

FED. ROAD DIST. NO.	STATE	FED. AID PROJ. NO.	FISCAL YEAR	SHEET NO.	TOTAL SHEETS
HAWAII	HAW.	IM-H1-1(268)	2013	27	35

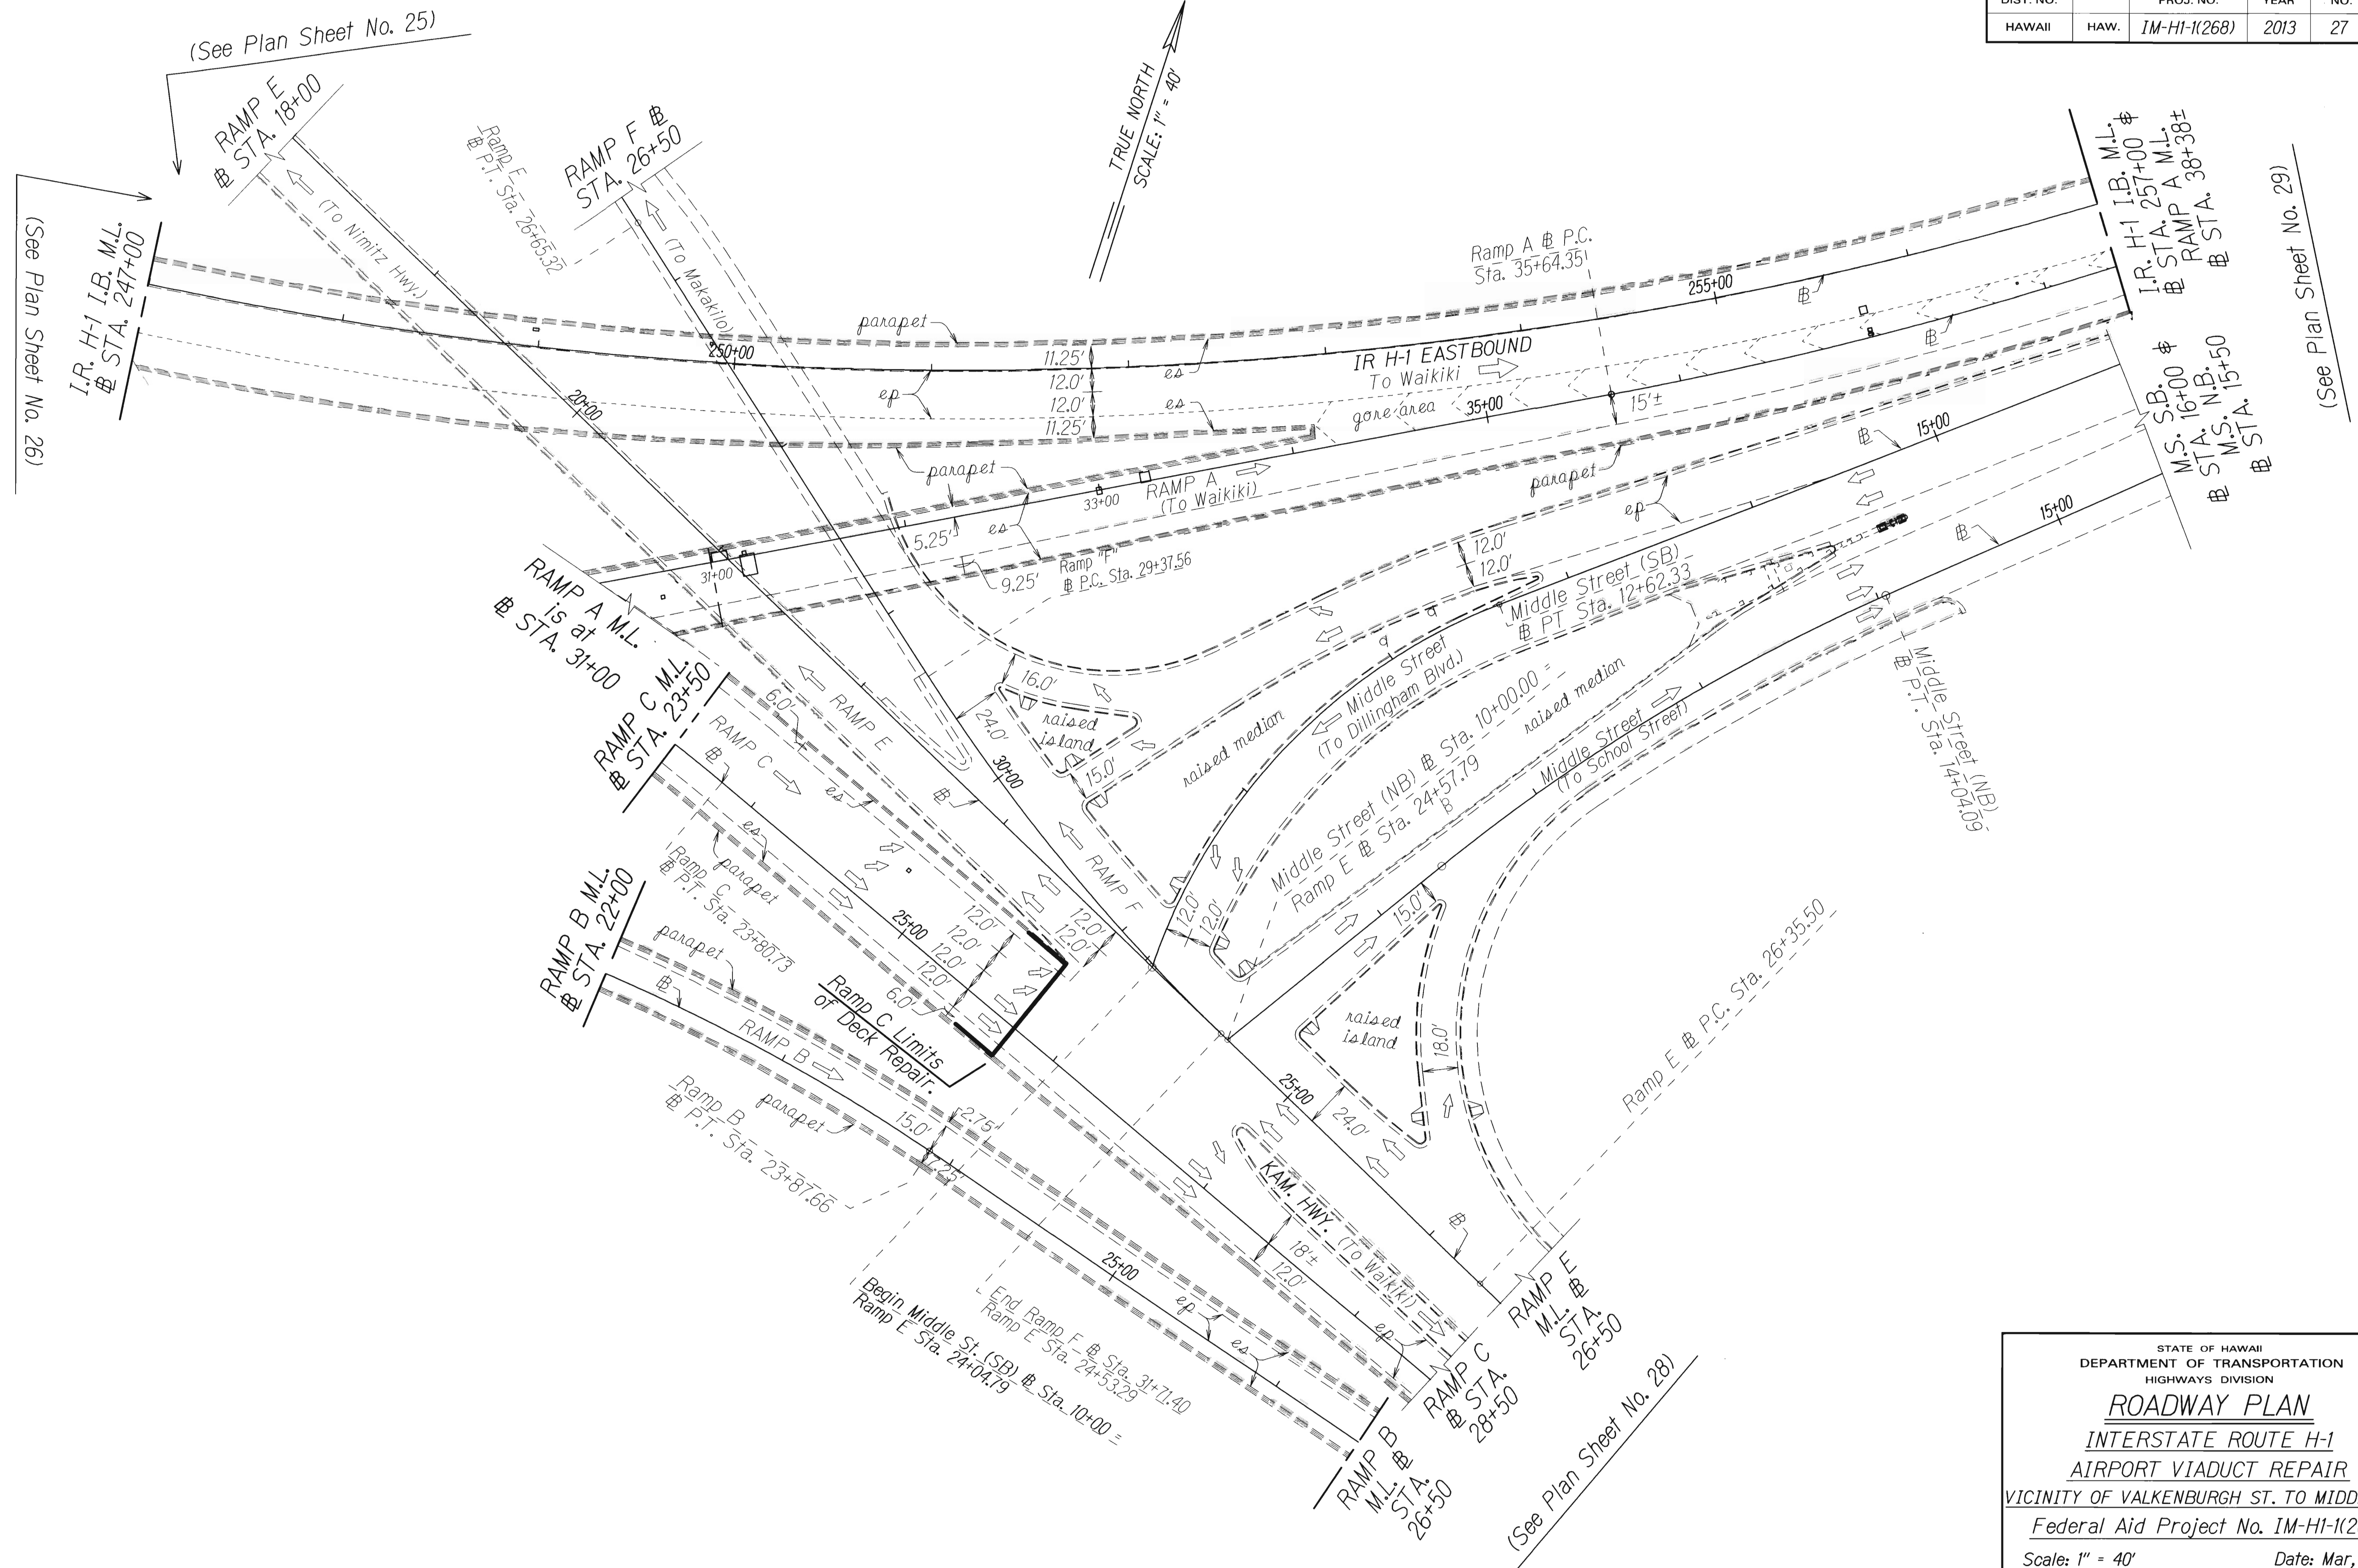


ORIGINAL PLAN	SURVEY PLOTTED BY	DATE
NOTED BY	DRAWN BY	
CHECKED BY	TRACED BY	
	QUANTITIES BY	
	CHECKED BY	

STATE OF HAWAII
DEPARTMENT OF TRANSPORTATION
HIGHWAYS DIVISION

ROADWAY PLAN
INTERSTATE ROUTE H-1
AIRPORT VIADUCT REPAIR
VICINITY OF VALKENBURGH ST. TO MIDDLE ST.
Federal Aid Project No. IM-H1-1(268)
Scale: 1" = 40'
Date: Mar, 2013

SHEET No. 20 OF 22 SHEETS

FED. ROAD DIST. NO.	STATE	FED. AID PROJ. NO.	FISCAL YEAR	SHEET NO.	TOTAL SHEETS
HAWAII	HAW.	IM-H1-1(268)	2013	ADD.29	35

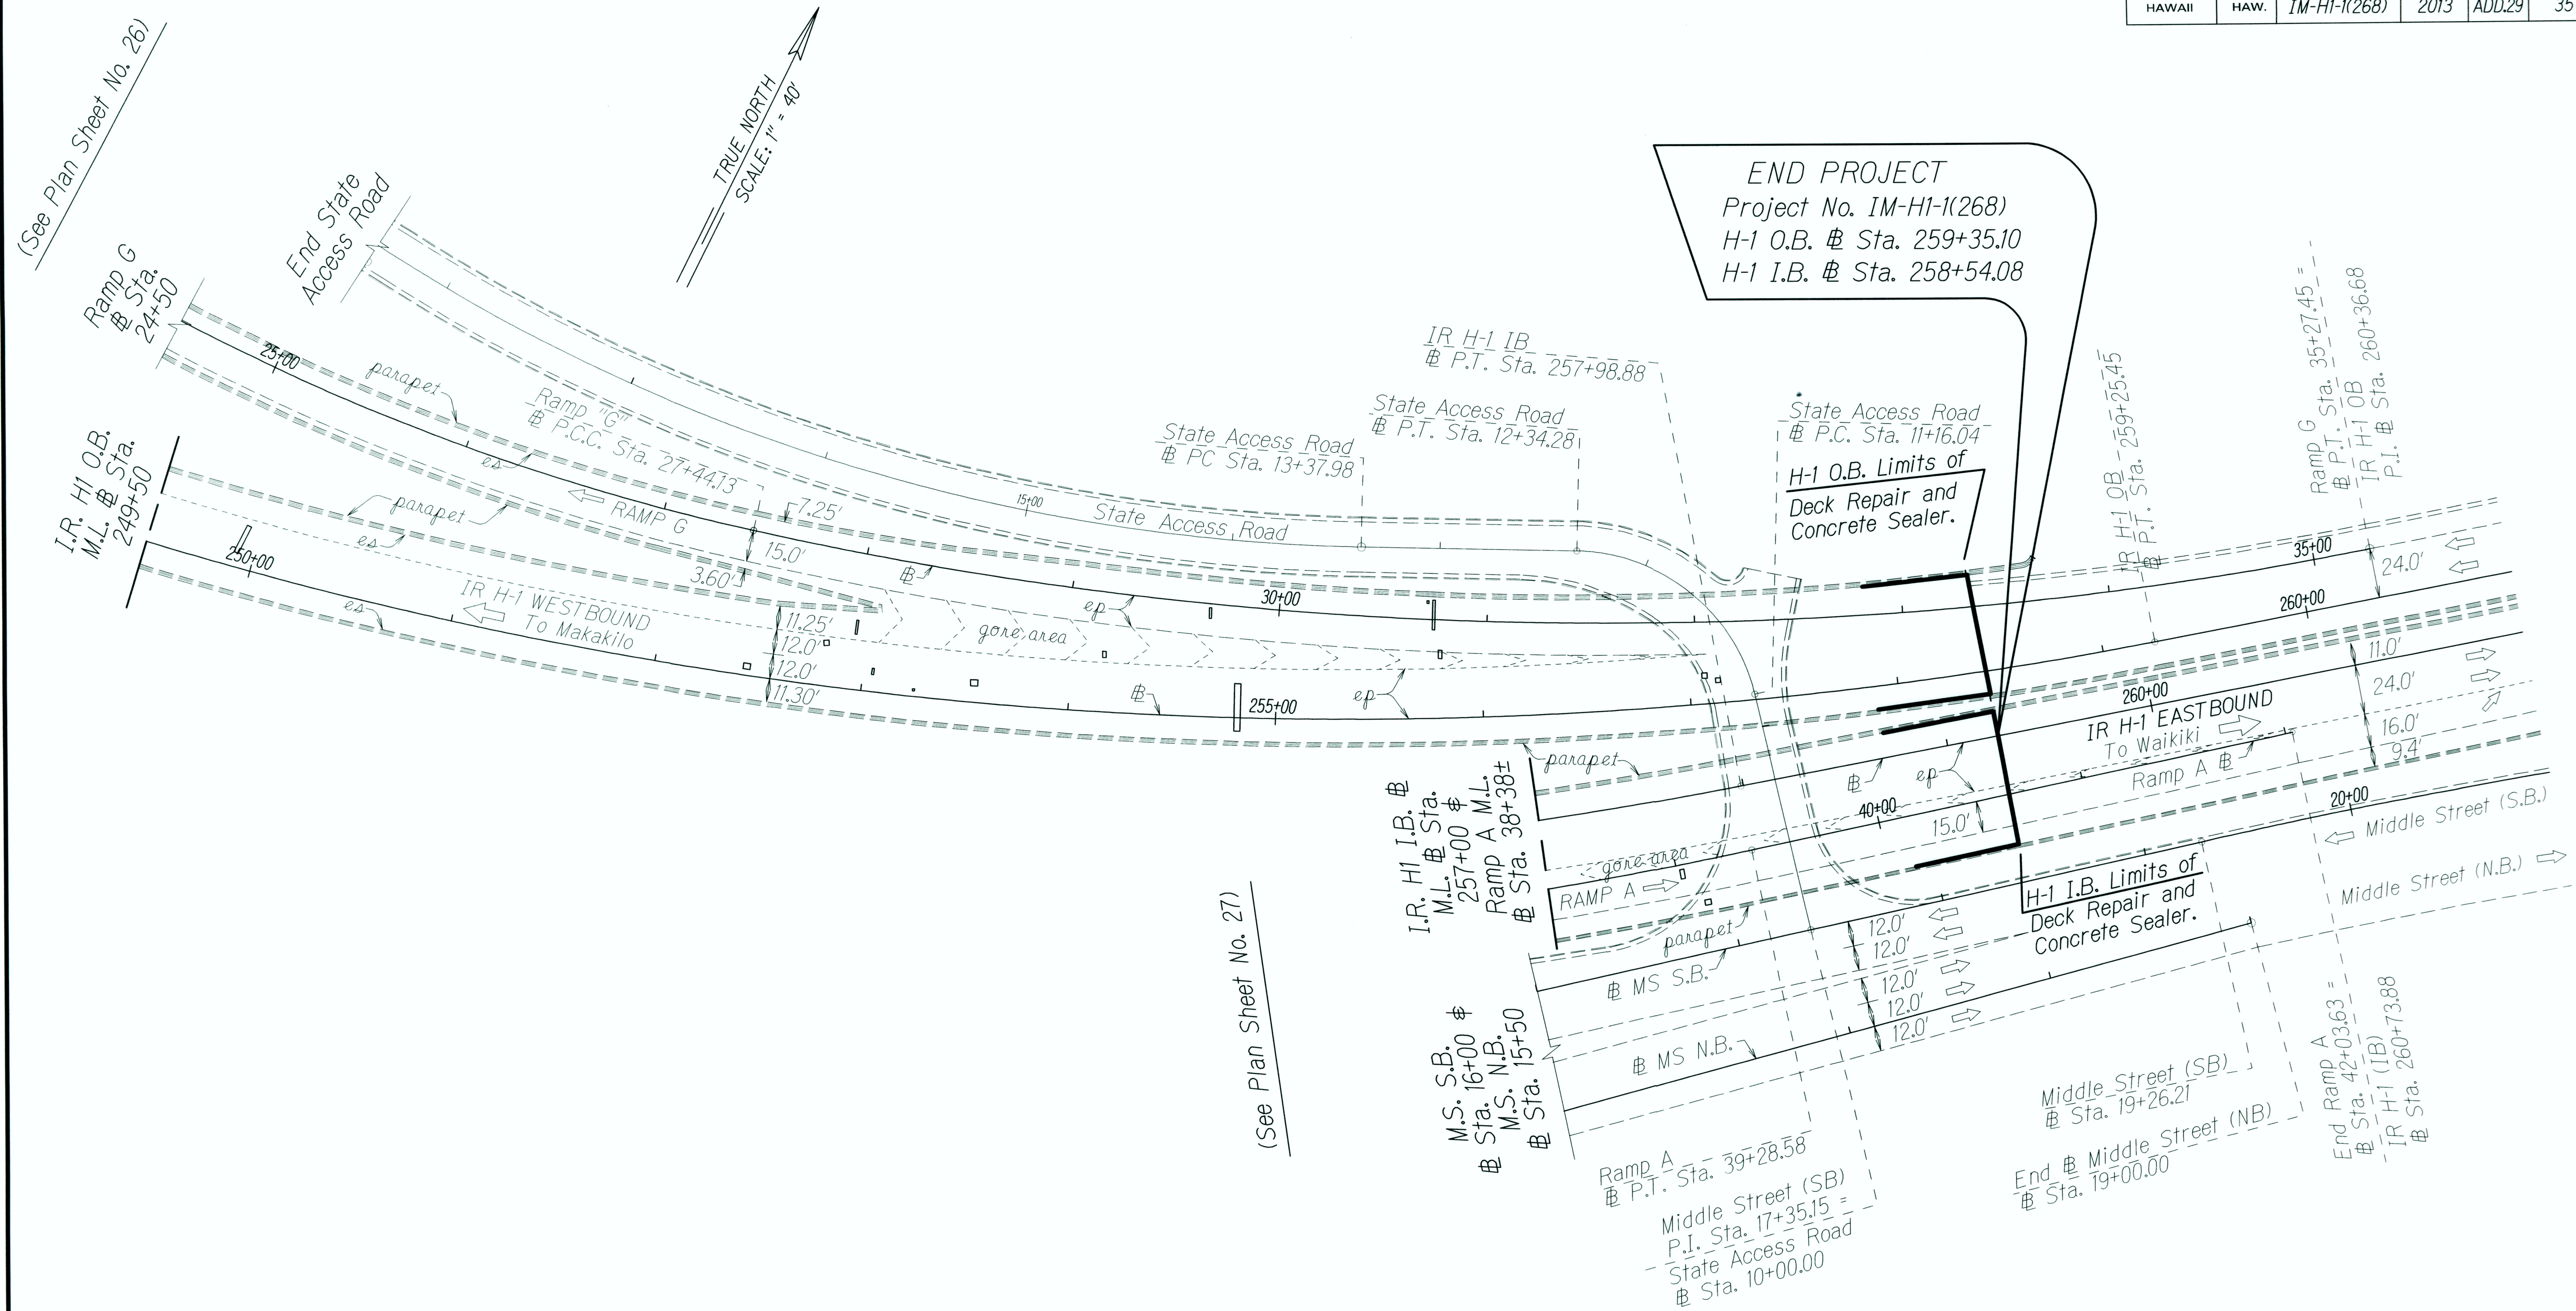

ORIGINAL PLAN	SURVEY PLOTTED BY	DATE
NOTE BOOK	DRAWN BY	
	TRACED BY	
	QUANTITIES BY	
	CHECKED BY	

04/22/13	Added Note "Concrete Sealer" at Project Limits.
DATE	REVISION

STATE OF HAWAII
DEPARTMENT OF TRANSPORTATION
HIGHWAYS DIVISION
ROADWAY PLAN
INTERSTATE ROUTE H-1
AIRPORT VIADUCT REPAIR
VICINITY OF VALKENBURGH ST. TO MIDDLE ST.
Federal Aid Project No. IM-H1-1(268)
Scale: 1" = 40' Date: Mar, 2013
SHEET No. 22 OF 22 SHEETS