

SURVEYED BY \_\_\_\_\_ DRAWN BY \_\_\_\_\_ TRACED BY \_\_\_\_\_ CHECKED BY \_\_\_\_\_ QUADRATED BY \_\_\_\_\_

ORIGINAL PLAN NOTE BOOK




SEE SHEET NO. I-2

CO19




FED. ROAD DIST. NO.	STATE	FED. AID PROJ. NO.	FISCAL YEAR	SHEET NO.	TOTAL SHEETS
HAWAII	HAW.	I-HI-1 (98) 13	1970	21	50

# TRUE NORTH

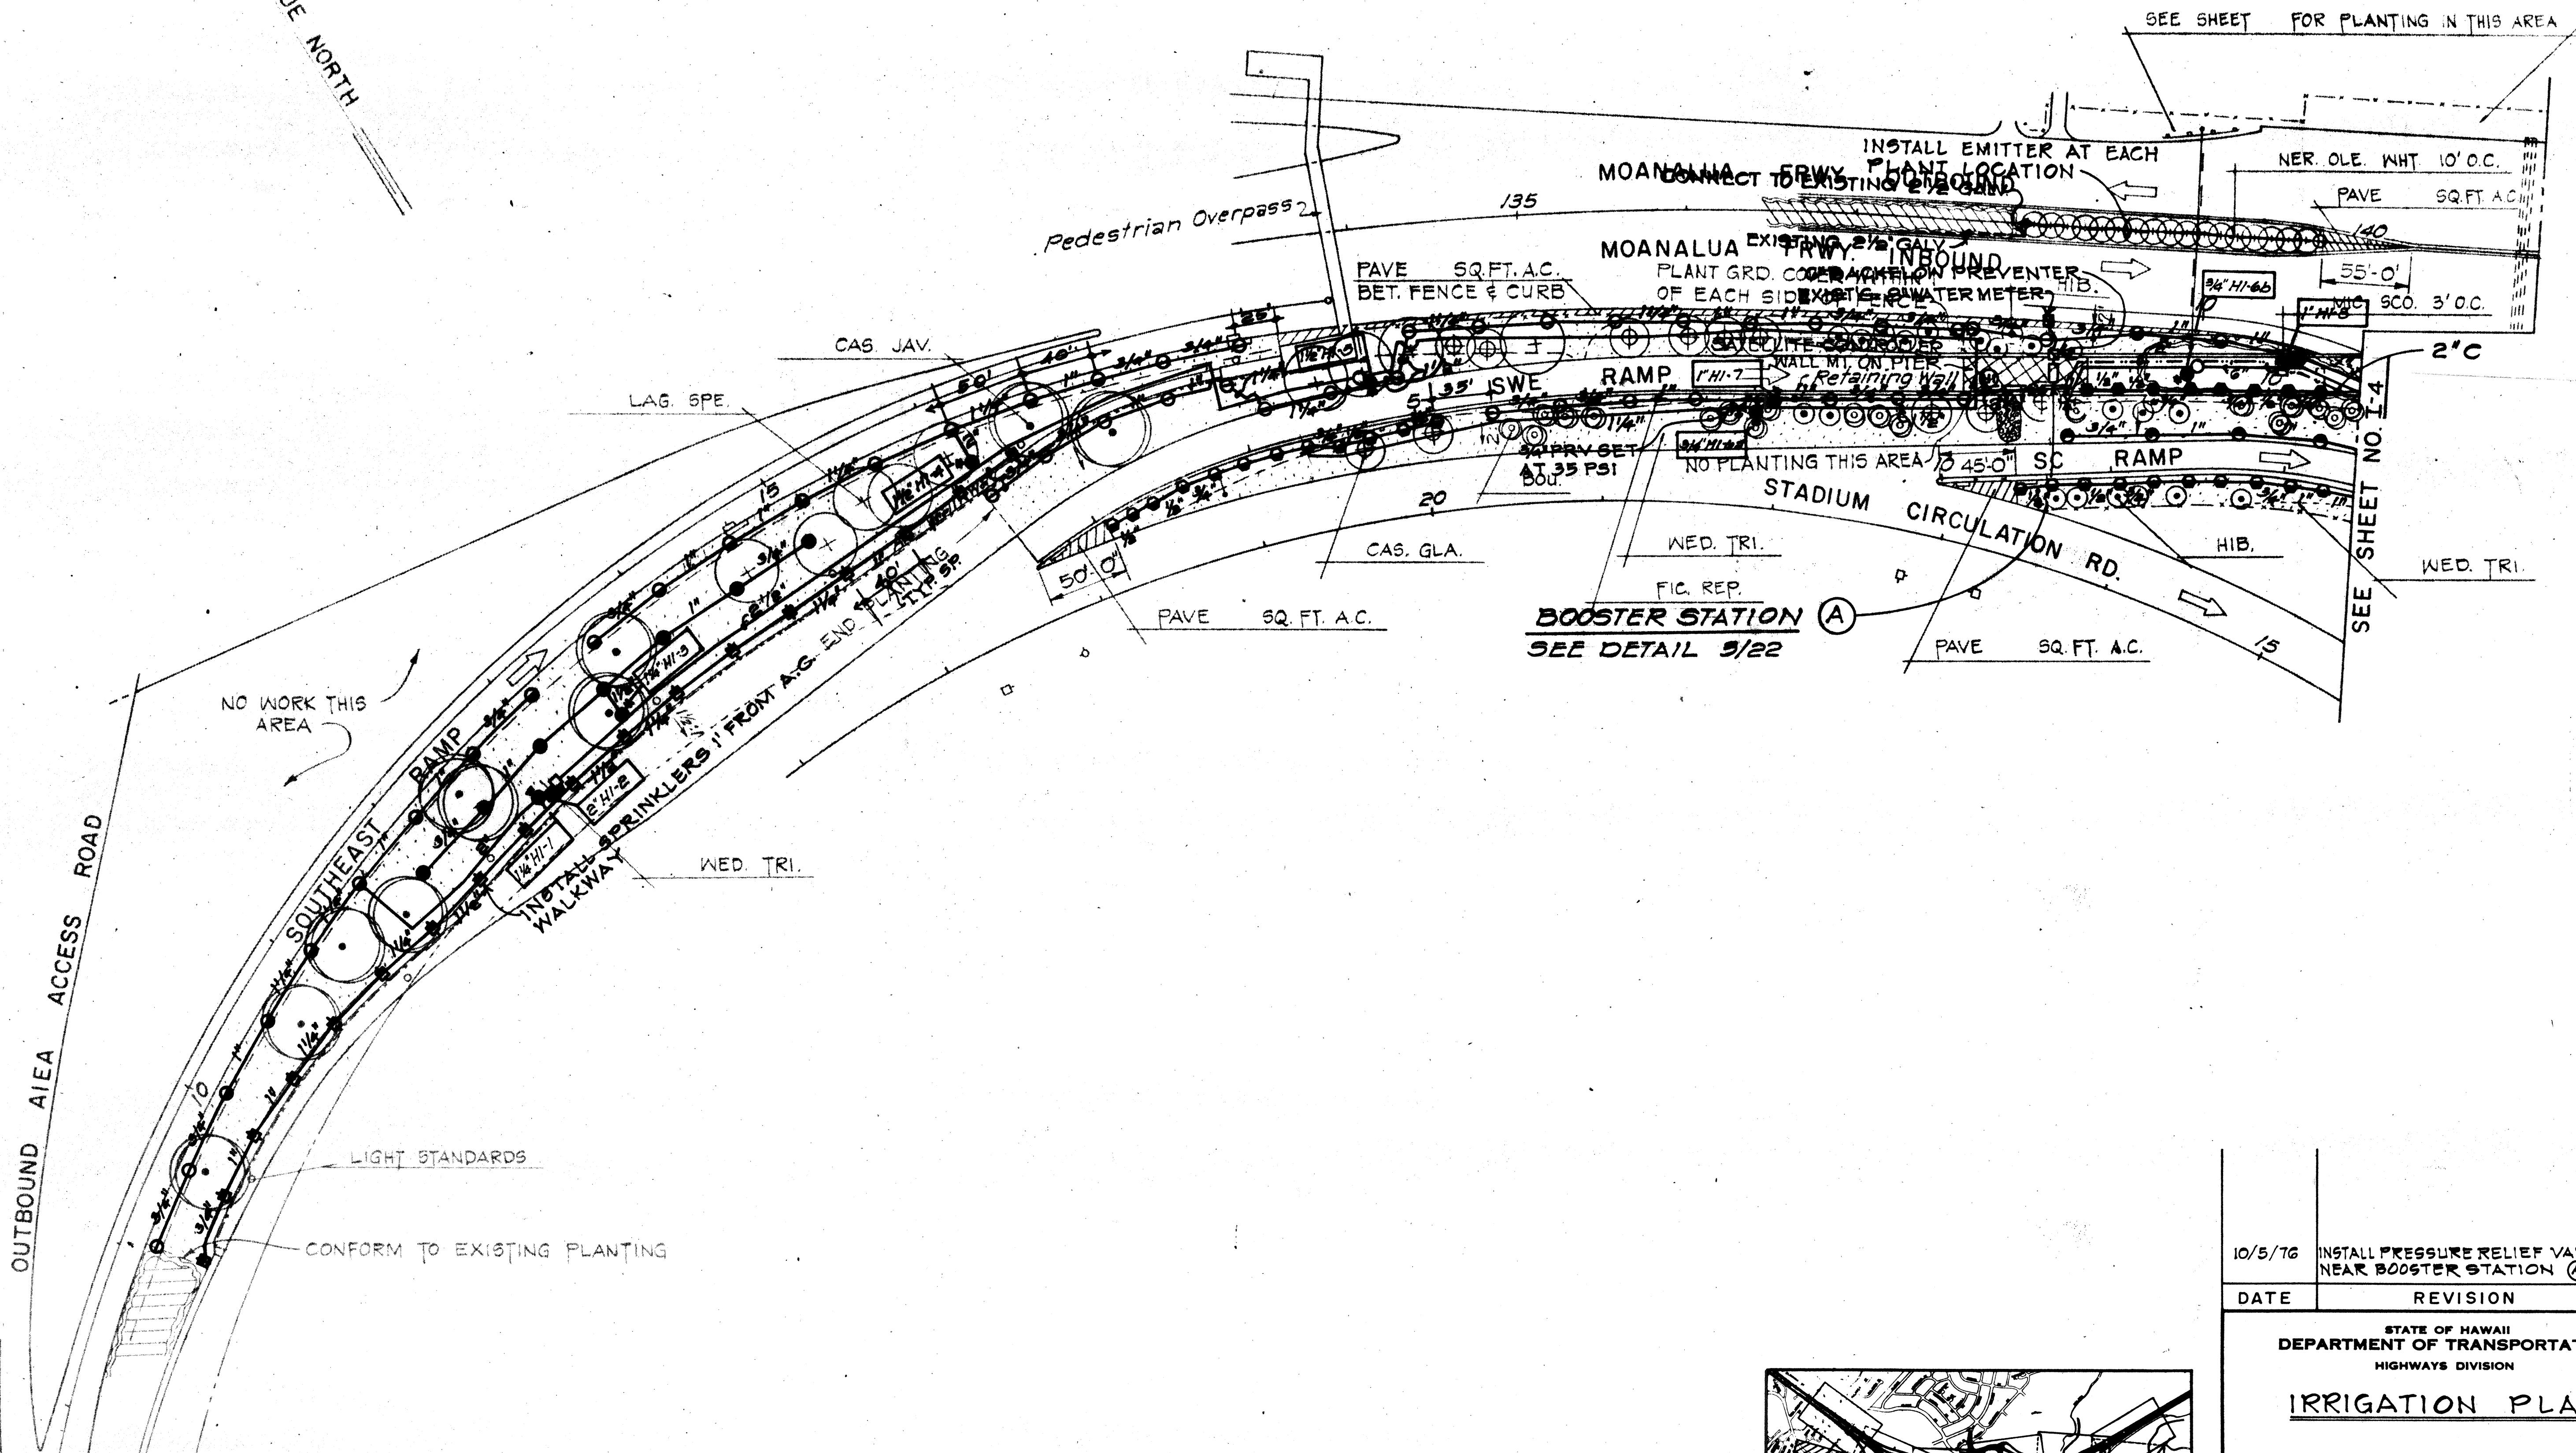

ORIGINAL PLAN	SURVEY PLOTTED BY _____ DRAWN BY _____ TRACED BY _____	DATE _____
NOTE BOOK	DESIGNED BY _____ QUANTITIES BY _____ CHECKED BY _____	No. _____

/5/76	INSTALL PRESSURE RELIEF VALVE NEAR BOOSTER STATION <b>(A)</b>
DATE	REVISION
STATE OF HAWAII DEPARTMENT OF TRANSPORTATION HIGHWAYS DIVISION	
<u>IRRIGATION PLAN</u>	
<u>INTERSTATE ROUTE H-1</u> <u>PROJ. NO. I-H1-1 (92):13</u>	

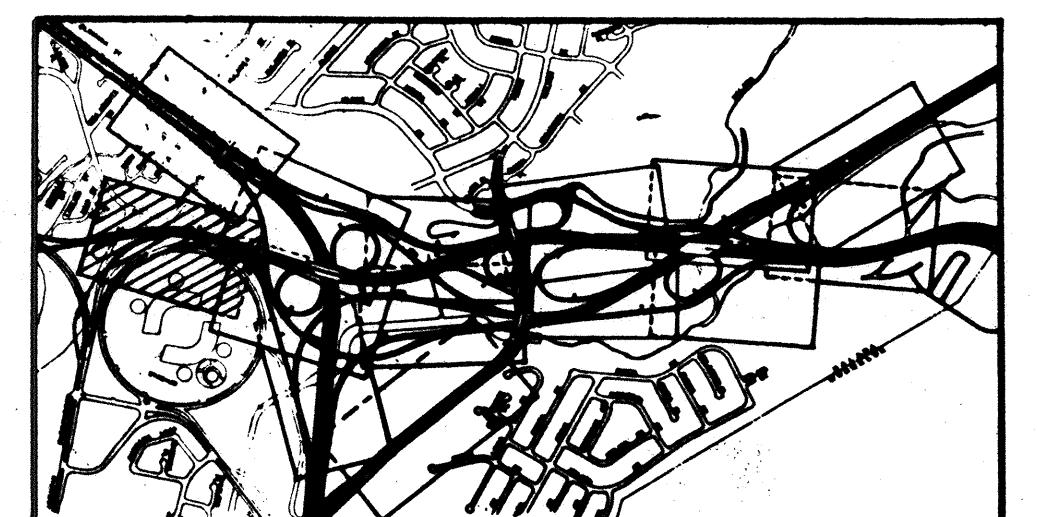


C021

ED. ROAD DIST. NO.	STATE	FED. AID PROJ. NO.	FISCAL YEAR	SHEET NO.	TOTAL SHEETS
HAWAII	HAW.	I- HT-1 (98) 12	1970	22	50

CONNECT TO  
MEDIAN PLANTER  
DRIP SYSTEM

145 SEE SHEET NO. I-2

CONNECT  
INTO MEDIAN  
PLANTER DRAIN SYSTEM  
INSTALL 1" PVC IN  
EXISTING 5" PVC

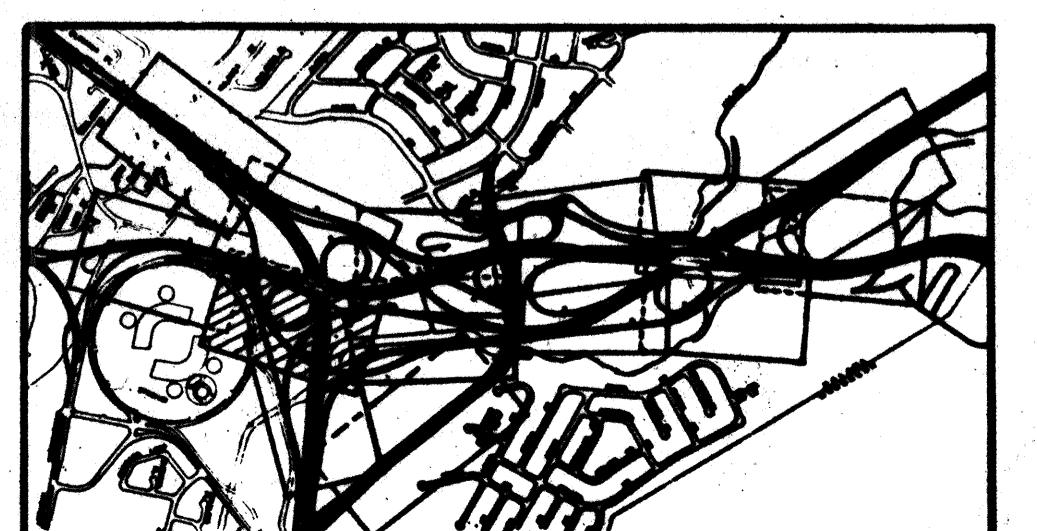

**STATE OF HAWAII  
DEPARTMENT OF TRANSPORTATION  
HIGHWAYS DIVISION**

## IRRIGATION PLAN

INTERSTATE ROUTE H-1  
PROJ. NO. I-HI-1 (92):18


Scale: 1" - 30'      Date: Nov. 1975  
SHEET NO. I-4 OF 32 SHEETS

PROJECT LIMIT  
STA. 241 + 50

TRUE NORTH

2½" GALV. PIPE STRAPPED  
TO BRIDGE

FED. ROAD DIST. NO.	STATE	FED. AID PROJ. NO.	FISCAL YEAR	SHEET NO.	TOTAL SHEETS
HAWAII	HAW.	I-HI-1 (92):19	1976	25	50

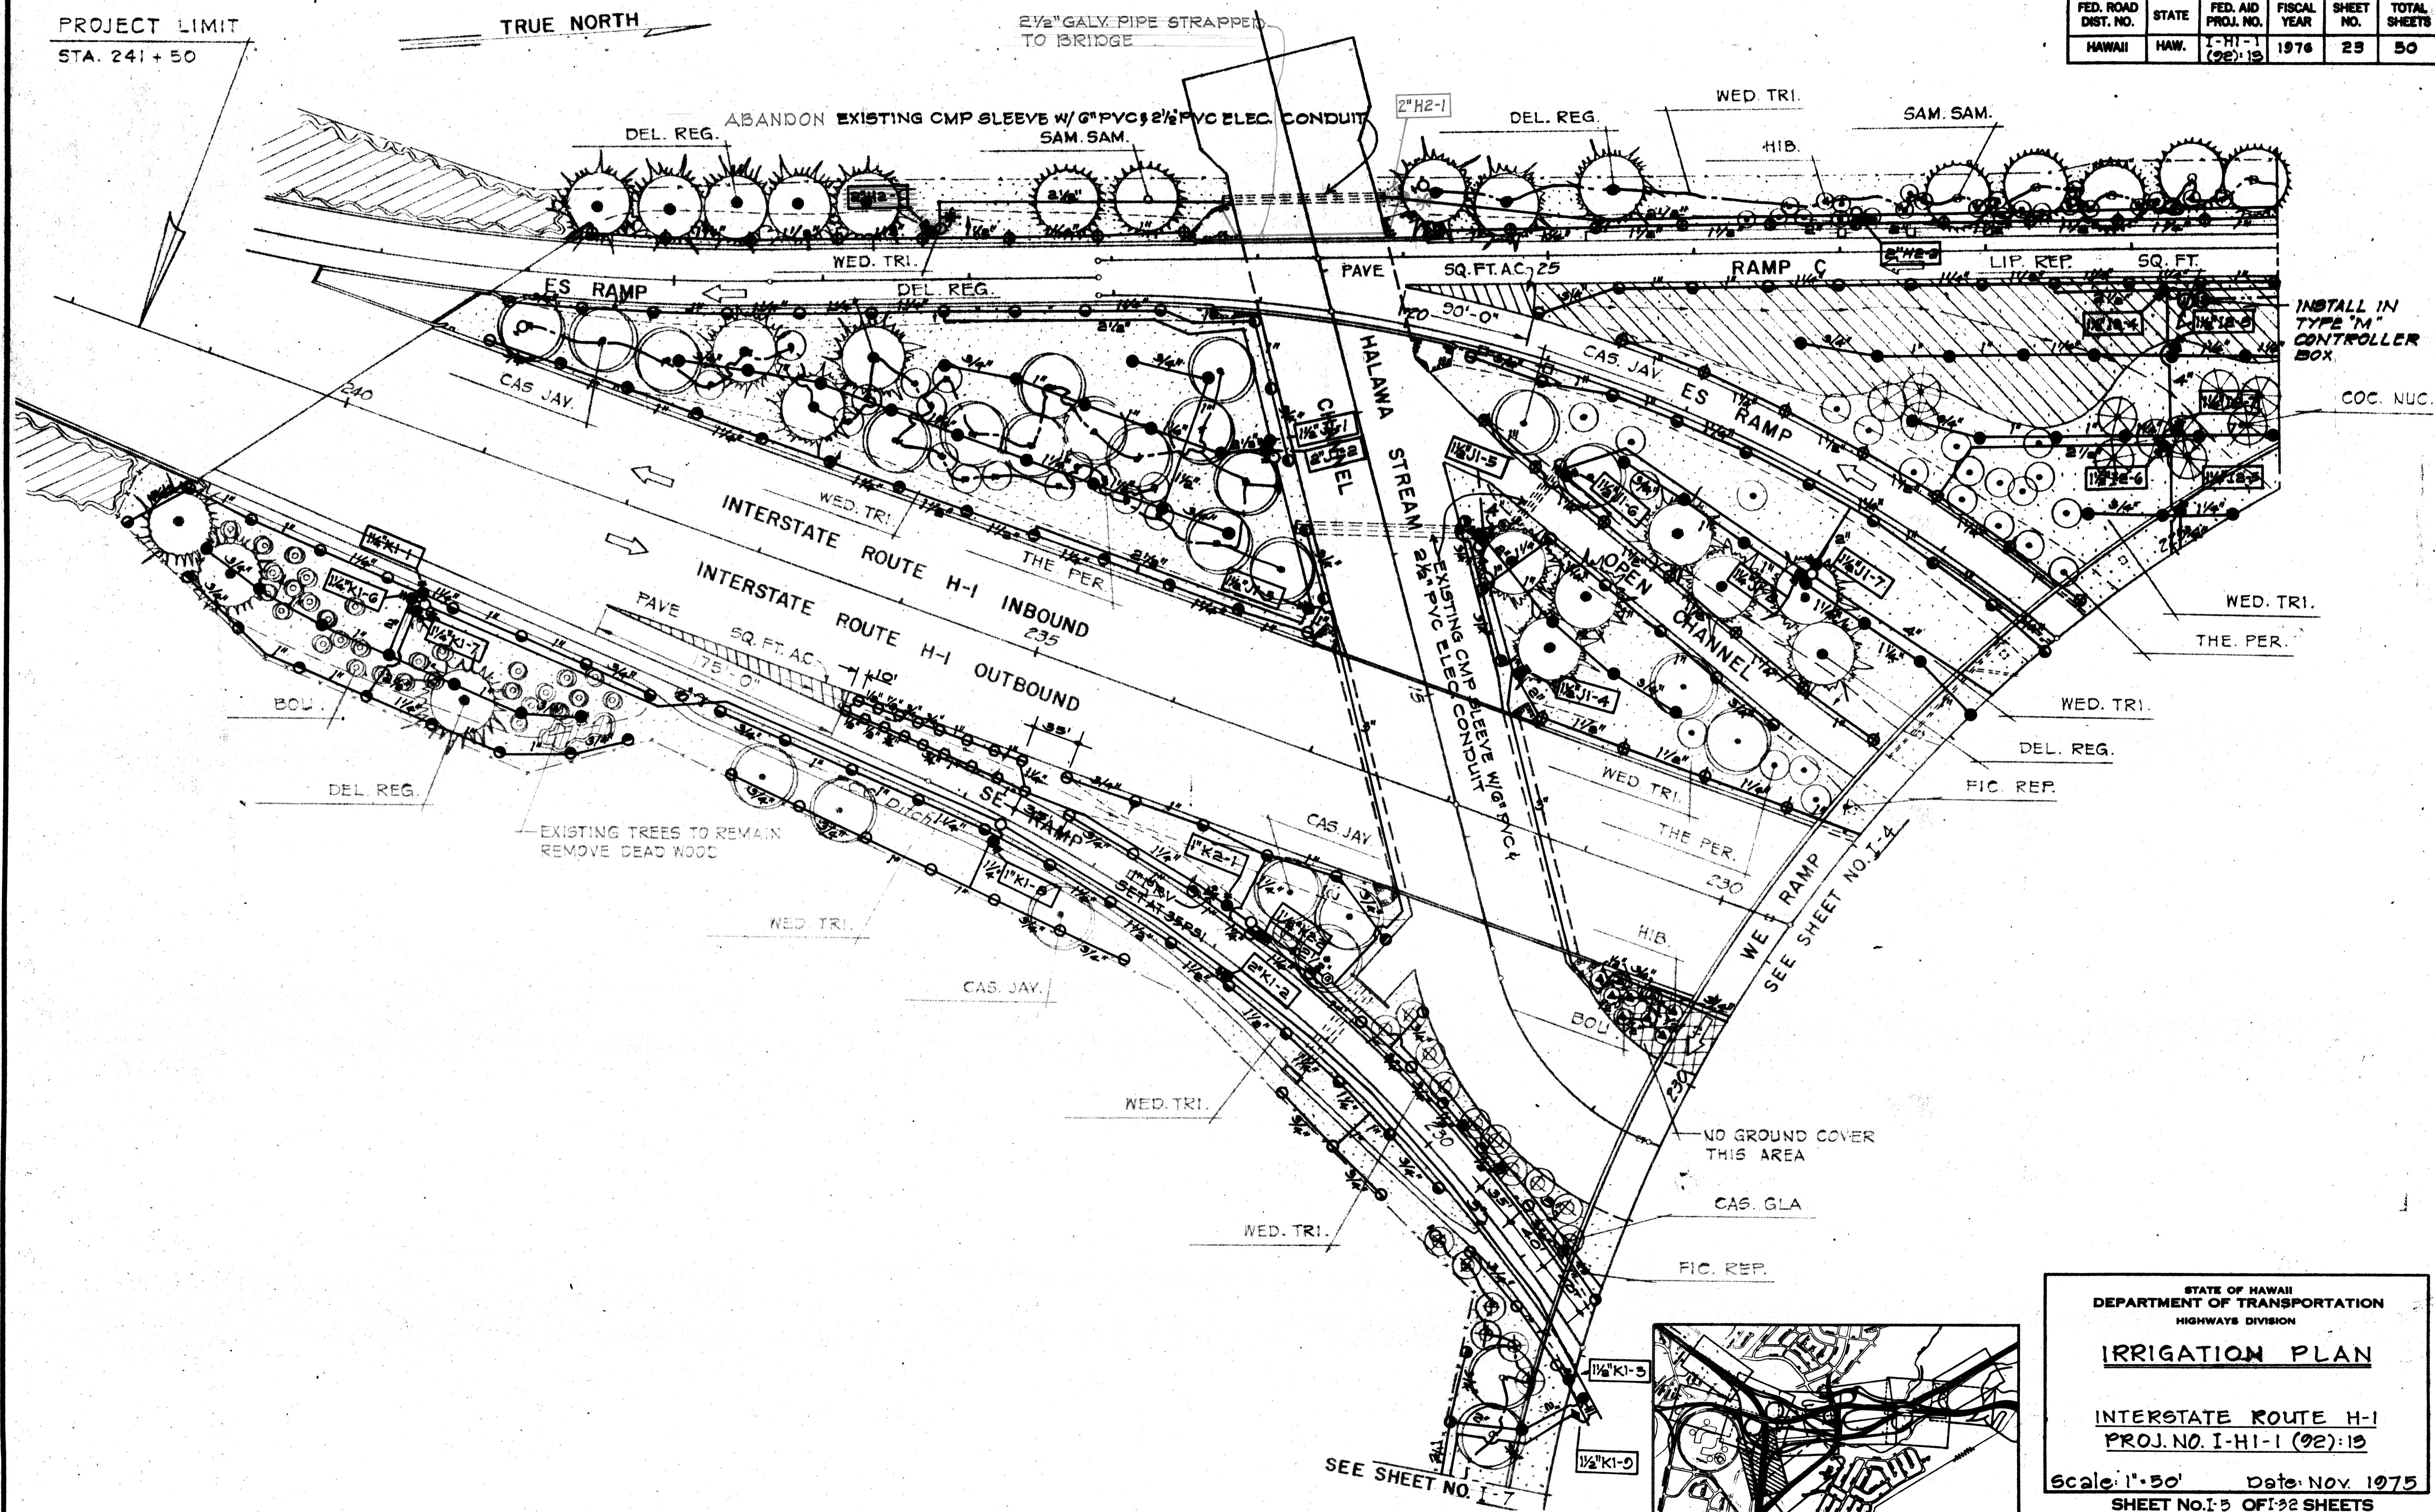

STATE OF HAWAII  
DEPARTMENT OF TRANSPORTATION  
HIGHWAYS DIVISION

### IRRIGATION PLAN

INTERSTATE ROUTE H-1  
PROJ. NO. I-HI-1 (92):19

Scale: 1"=50'  
Date: Nov. 1975  
SHEET NO. 15 OF 32 SHEETS

FED. ROAD DIST. NO.	STATE	FED. AID PROJ. NO.	FISCAL YEAR	SHEET NO.	TOTAL SHEETS
HAWAII	HAW.	I-HI-1 (2B)12	1976	24	50

<img alt="A detailed black and white technical map of an irrigation system for Interstate Route H-1, Project No. I-H1-1 (92)-13. The map shows various roads, ramps, and utility areas. Key features include the HALAWA STREAM CHANNEL, ULUNE STREET, and MOANALUA RD. It includes numerous circular symbols representing irrigation emitters and various pipe sizes (e.g., 1/4", 1/2", 3/4", 1", 2", 3", 4", 6", 8", 2764", 27

**STATE OF HAWAII  
DEPARTMENT OF TRANSPORTATION  
HIGHWAYS DIVISION**

## IRRIGATION PLAN

INTERSTATE ROUTE H-1  
PROJ. NO. I-HJ-1 (92):13



**Scale: 1" - 50'      Date: Nov. 1975**  
**SHEET NO. I-6 OF 32 SHEETS**



10/5/76	INSTALL PRESSURE RELIEF VALVE NEAR G" BACKFLOW PREVENTER
DATE	REVISION

**C024**

FED. ROAD DIST. NO.	STATE	FED. AID PROJ. NO.	FISCAL YEAR	SHEET NO.	TOTAL SHEETS
HAWAII	HAW.	I-H1-1 (92):19	1976	25	50

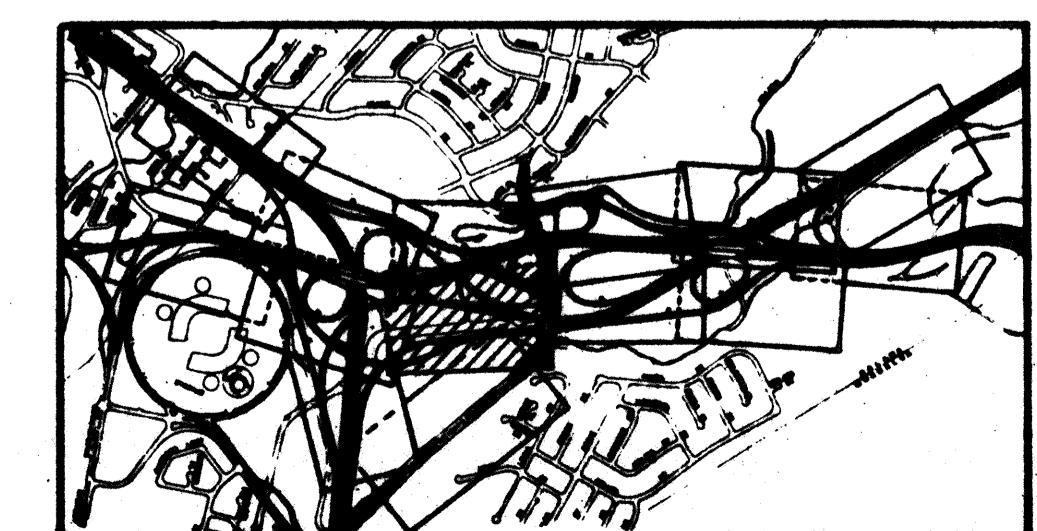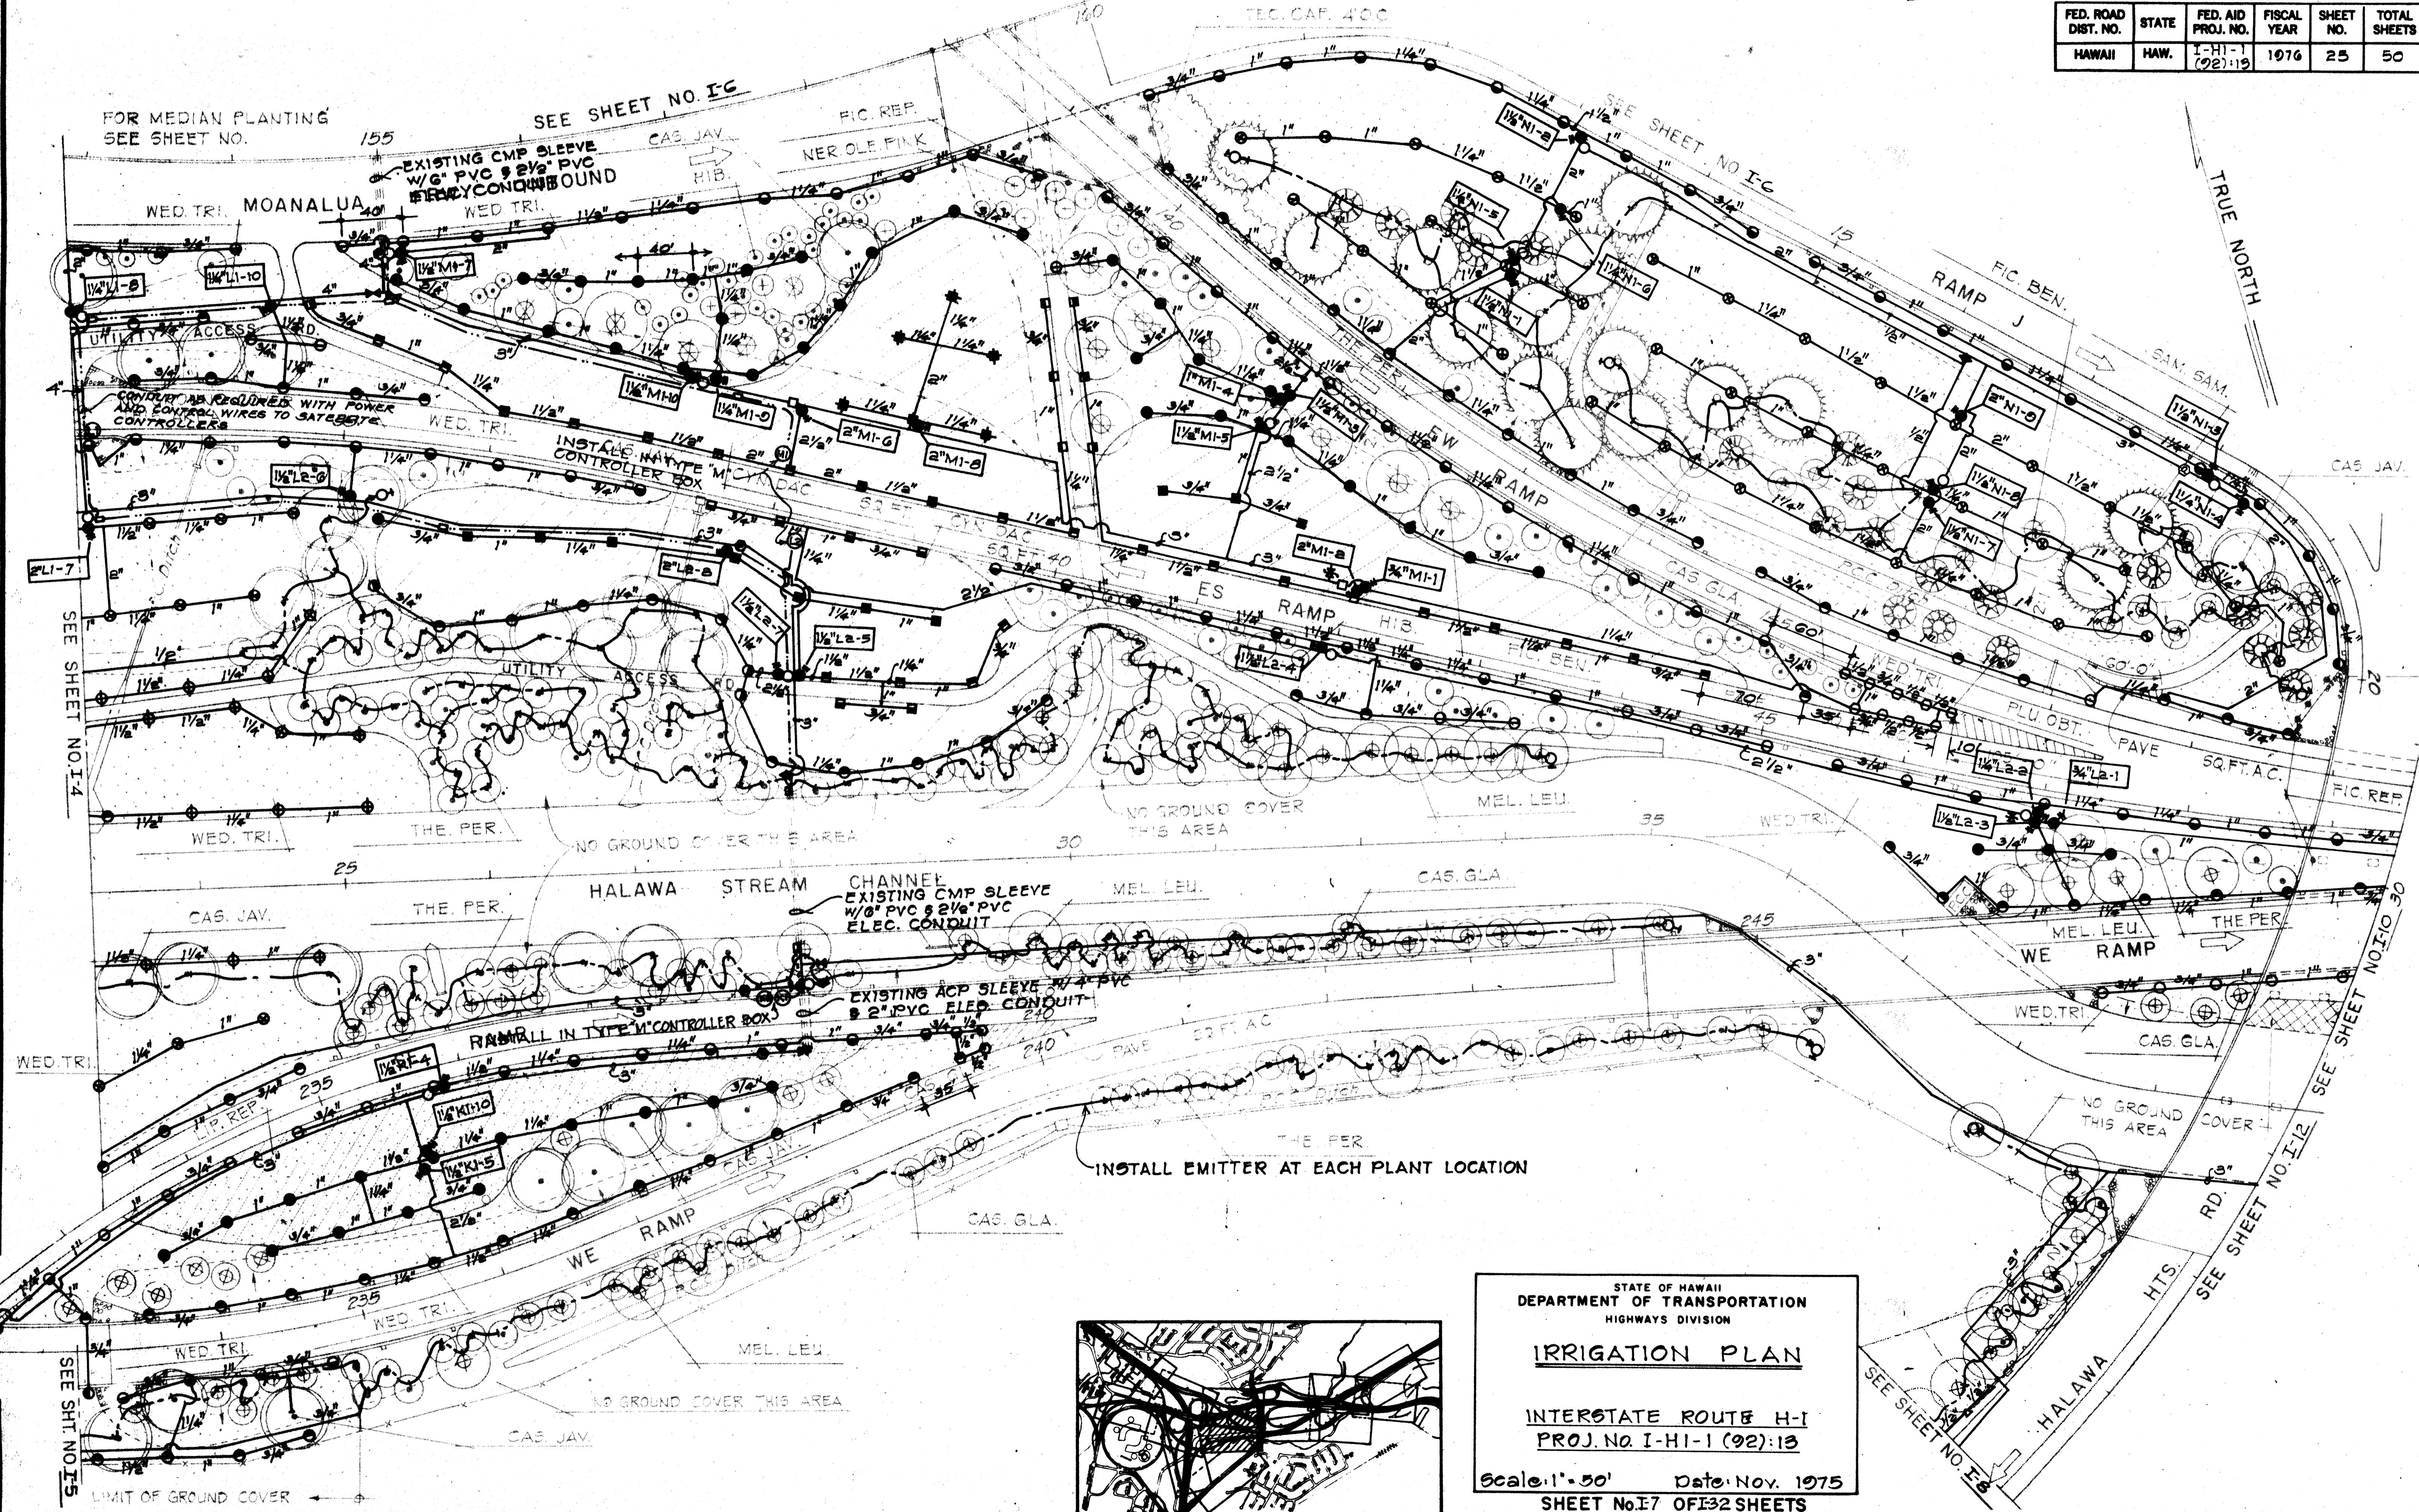

**STATE OF HAWAII  
DEPARTMENT OF TRANSPORTATION  
HIGHWAYS DIVISION**


## IRRIGATION PLAN

INTERSTATE ROUTE H-1  
PROJ. NO. I-HI-1 (92):13

Scale: 1" = 50' Date: Nov. 1975  
SHEET No. E-7 OF 32 SHEETS




FED. ROAD DIST. NO.	STATE	FED. AID PROJ. NO.	FISCAL YEAR	SHEET NO.	TOTAL SHEETS
HAWAII	HAW.	I-HI-1 (92):13	1976	27	50

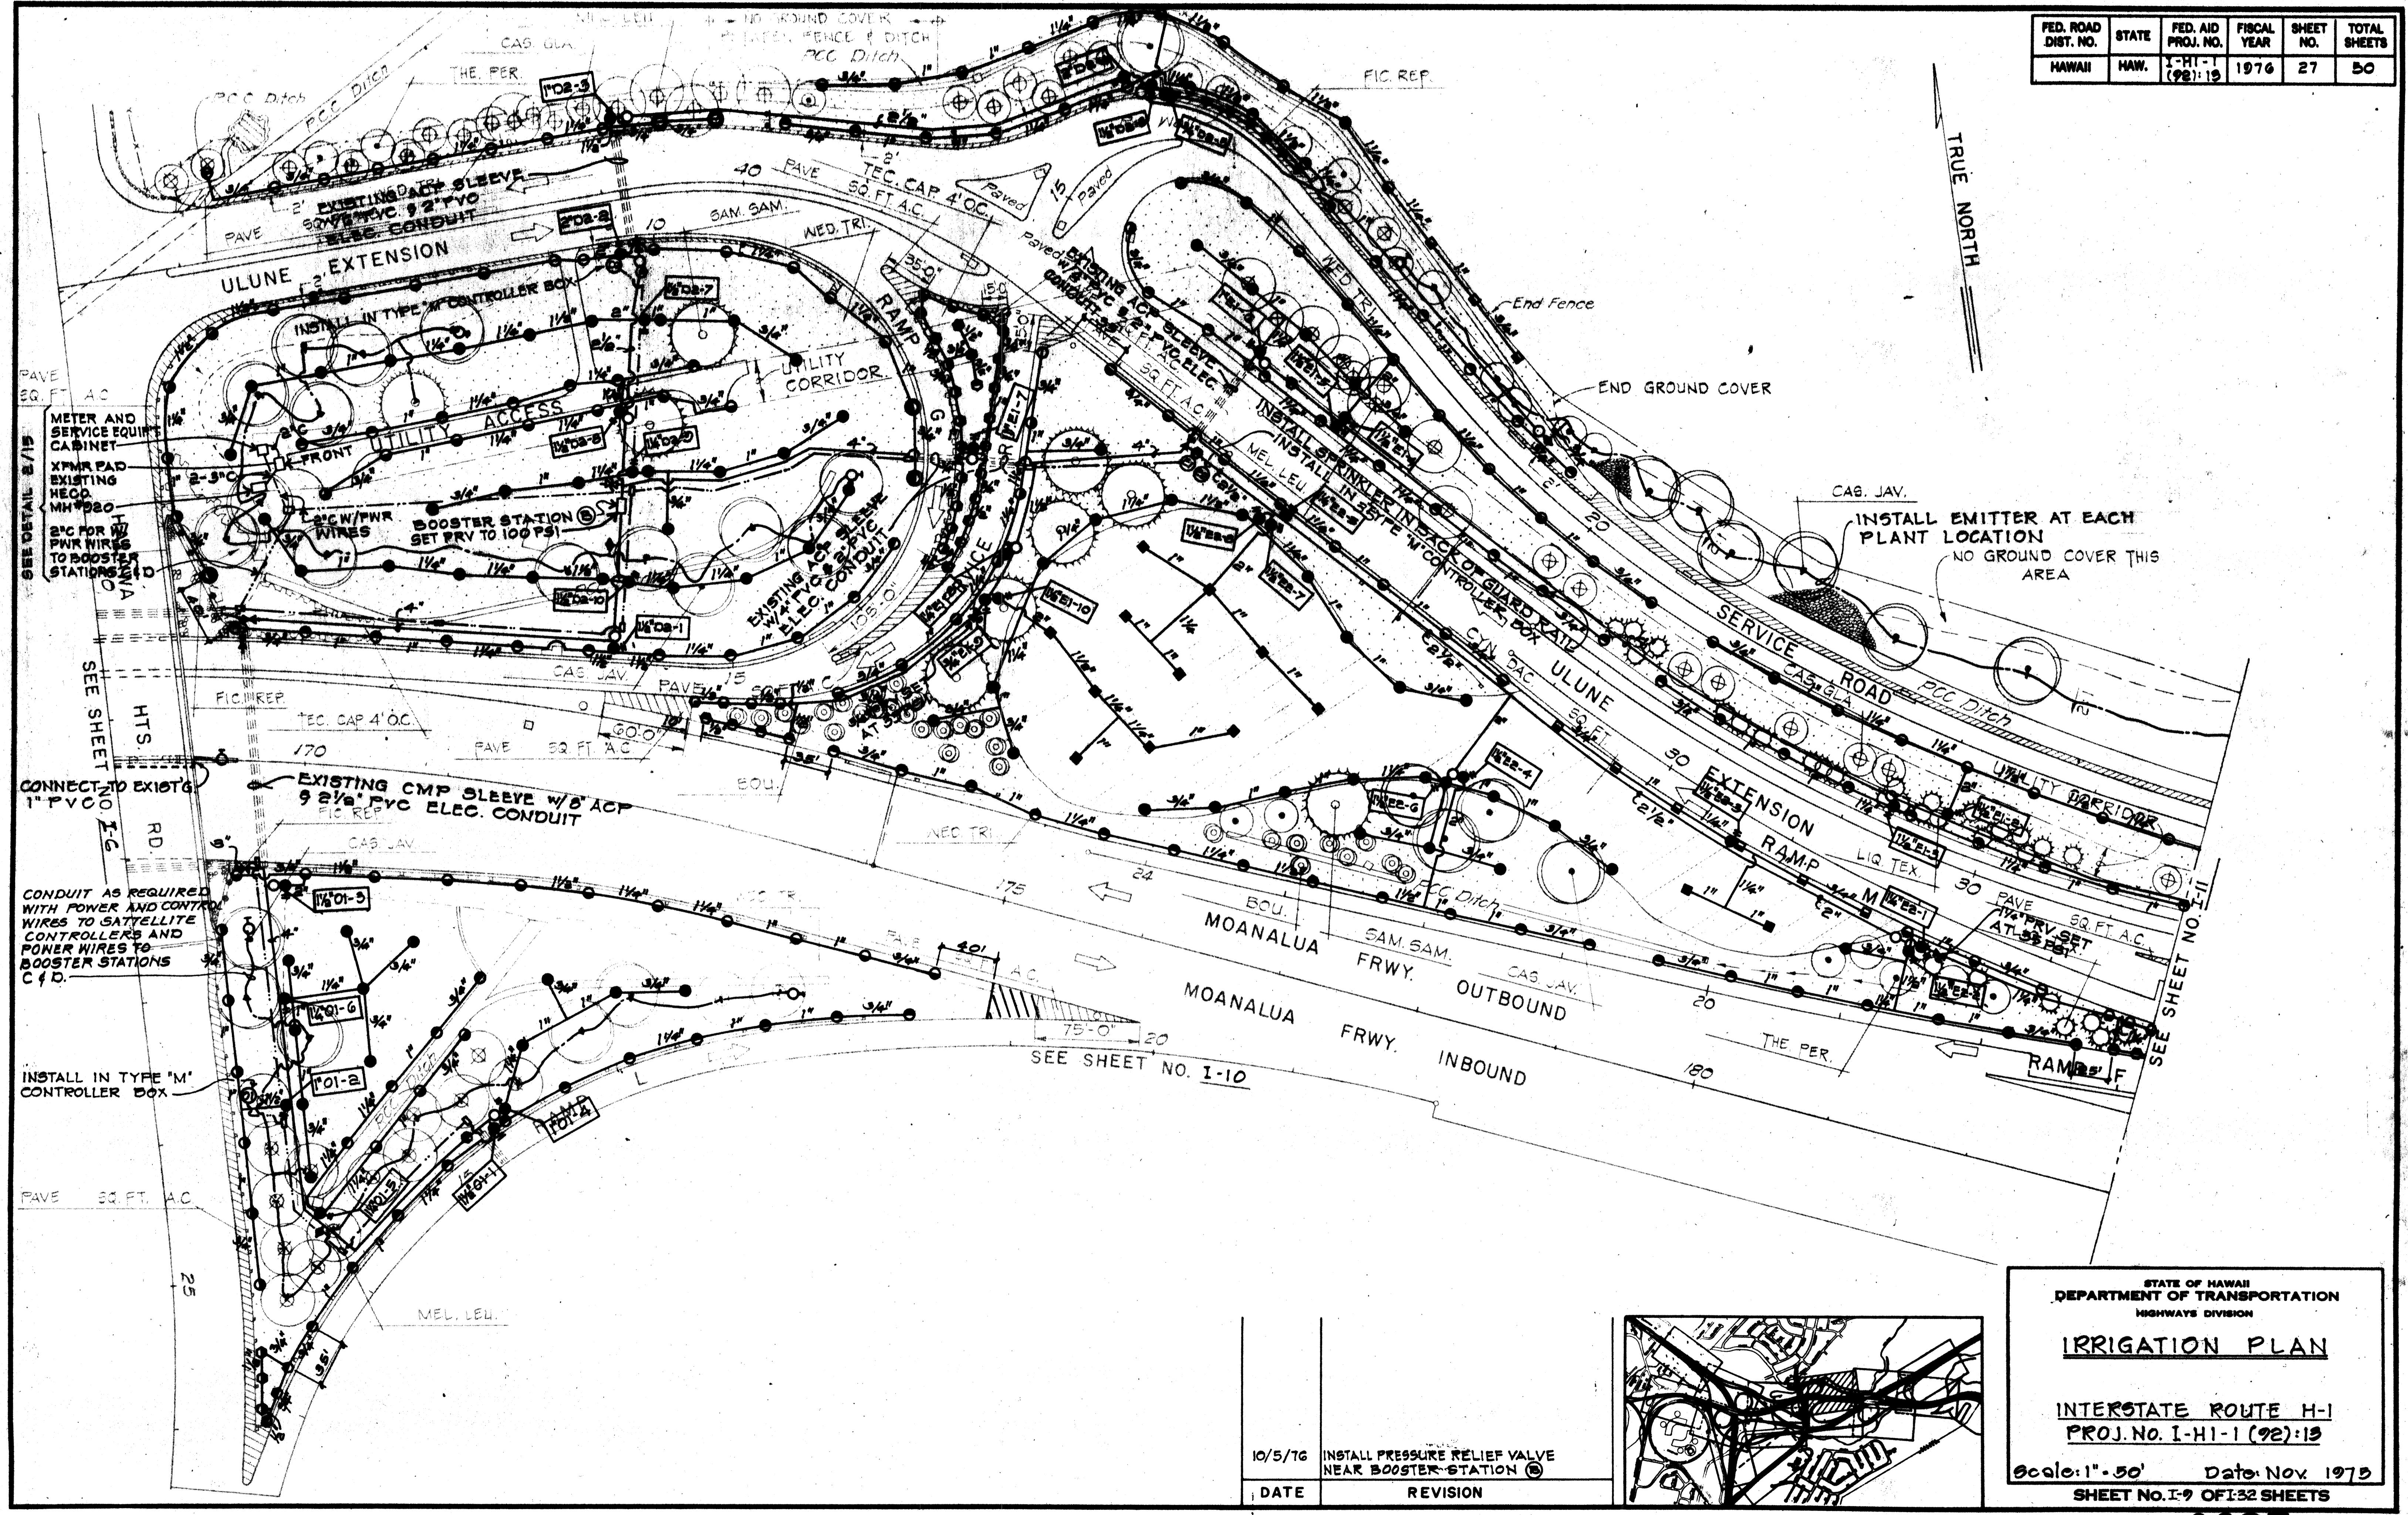

SURVEY PLOTTED BY	DATE
DRAWN BY	
TRACED BY	
DESIGNED BY	
QUANTITY BY	
CHECKED BY	

10/5/76      INSTALL PRESSURE RELIEF VALVE  
NEAR BOOSTER STATION (1)  
DATE            REVISION

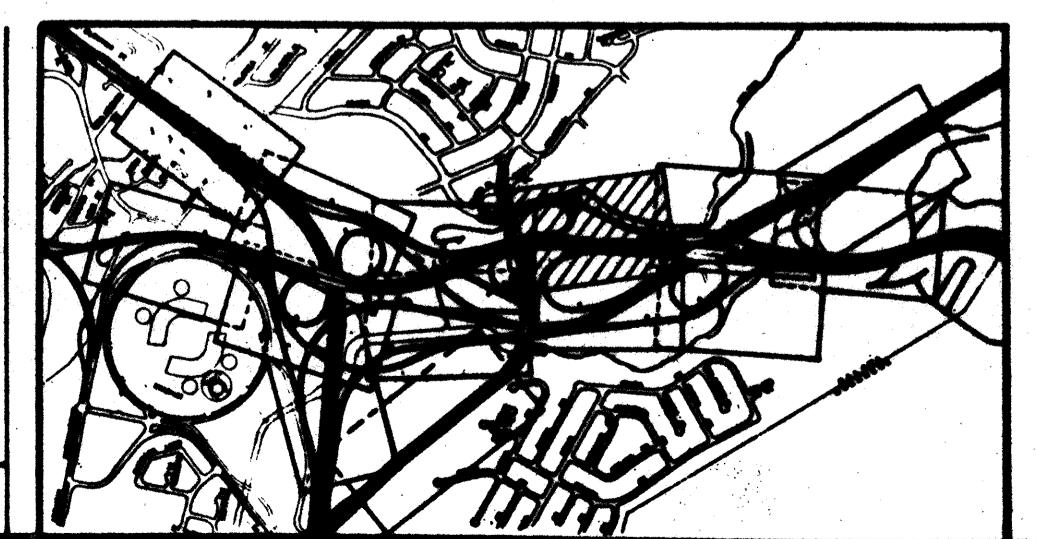

STATE OF HAWAII  
DEPARTMENT OF TRANSPORTATION  
HIGHWAYS DIVISION  
**IRRIGATION PLAN**  
INTERSTATE ROUTE H-1  
PROJ. NO. I-HI-1 (92):13  
Scale: 1"-50' Date: Nov. 1975  
SHEET NO. I-9 OF 32 SHEETS

C027

ED. ROAD DIST. NO.	STATE	FED. AID PROJ. NO.	FISCAL YEAR	SHEET NO.	TOTAL SHEETS
HAWAII	HAW.	I-HI-1 (92) 112	1976	29	50

10/5/76	INSTALL PRESSURE RELIEF VALVE NEAR BOOSTER STATIONS C & D
DATE	REVISION




STATE OF HAWAII  
DEPARTMENT OF TRANSPORTATION  
HIGHWAYS DIVISION

INTERSTATE ROUTE H-1  
PROJ. NO. I-HI-1 (92):13

INTERSTATE ROUTE H-1  
PROJ. NO. I-HI-1 (92):13


GO28

FED. ROAD DIST. NO.	STATE	FED. AID PROJ. NO.	FISCAL YEAR	SHEET NO.	TOTAL SHEETS
HAWAII	HAW.	I-HI-1 (92):13	1976	29	50

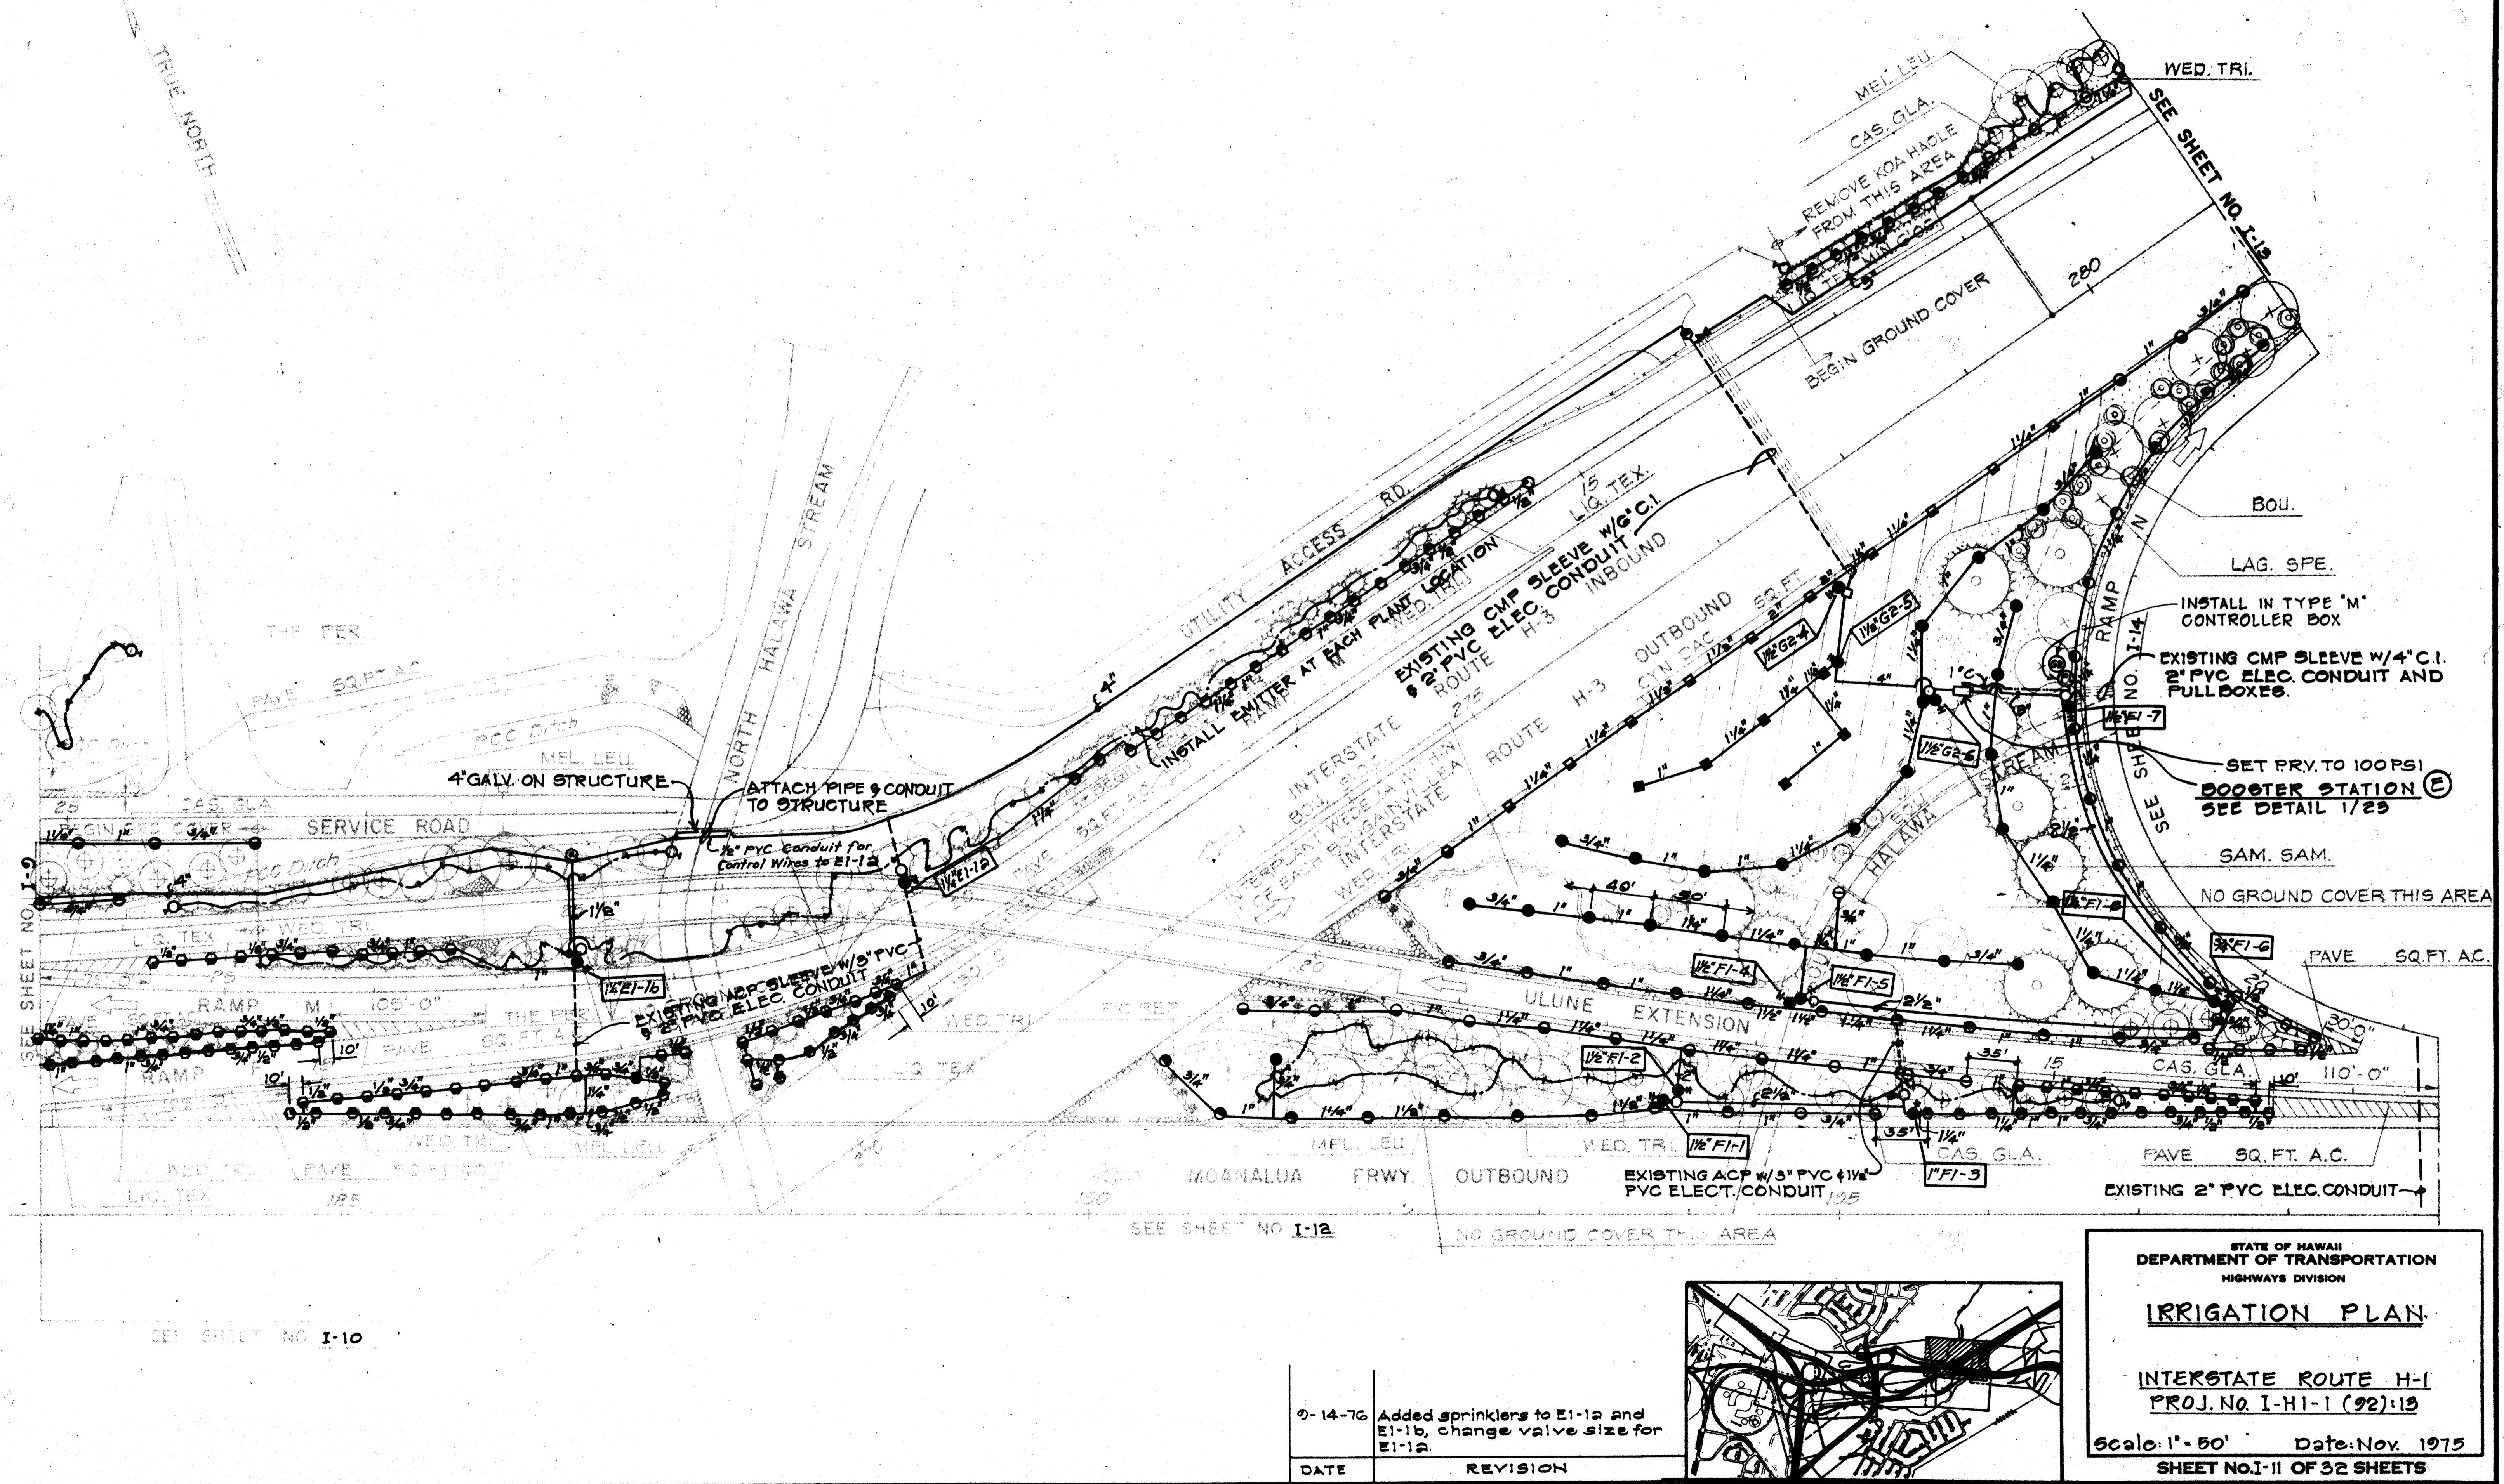

ORIGINAL PLAN	SURVEY PLOTTED BY	DATE
	DRAWN BY	2 2 2 2
	TRACED BY	
	DESIGNED BY	
	QUANTITIES BY	
	CHECKED BY	
NOTE BOOK		
No.		

9-14-76	Added sprinklers to E1-1a and E1-1b, change valve size for E1-1a.
DATE	REVISION

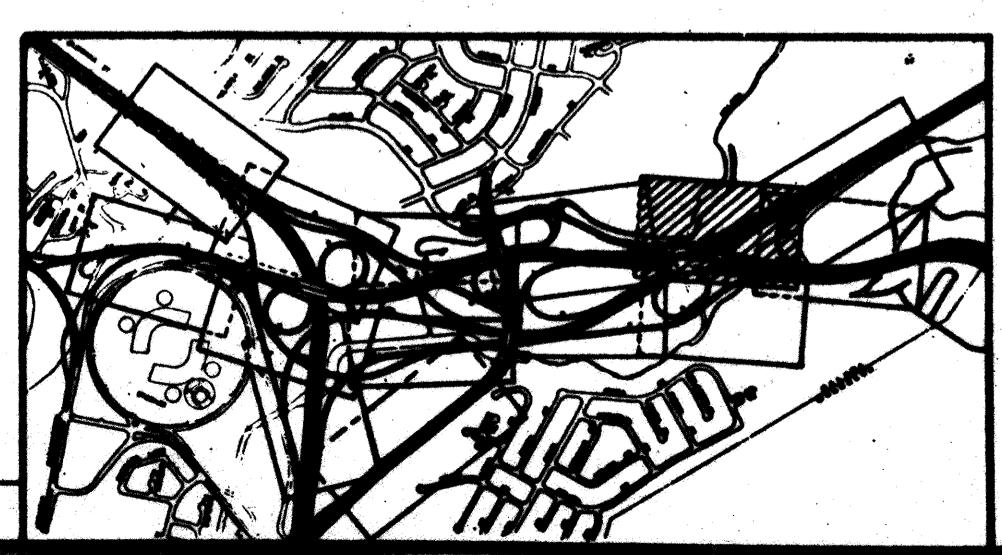


**STATE OF HAWAII  
DEPARTMENT OF TRANSPORTATION  
HIGHWAYS DIVISION**

## IRRIGATION PLAN.

INTERSTATE ROUTE H-1  
PROJ. NO. I-H1-1 (92):13

**Scale: 1" - 50'      Date: Nov. 1975**  
**SHEET NO. I-11 OF 32 SHEETS**


FED. ROAD DIST. NO.	STATE	FED. AID PROJ. NO.	FISCAL YEAR	SHEET NO.	TOTAL SHEETS
HAWAII	HAW.	I-HI-1 (92):15	1976	30	50

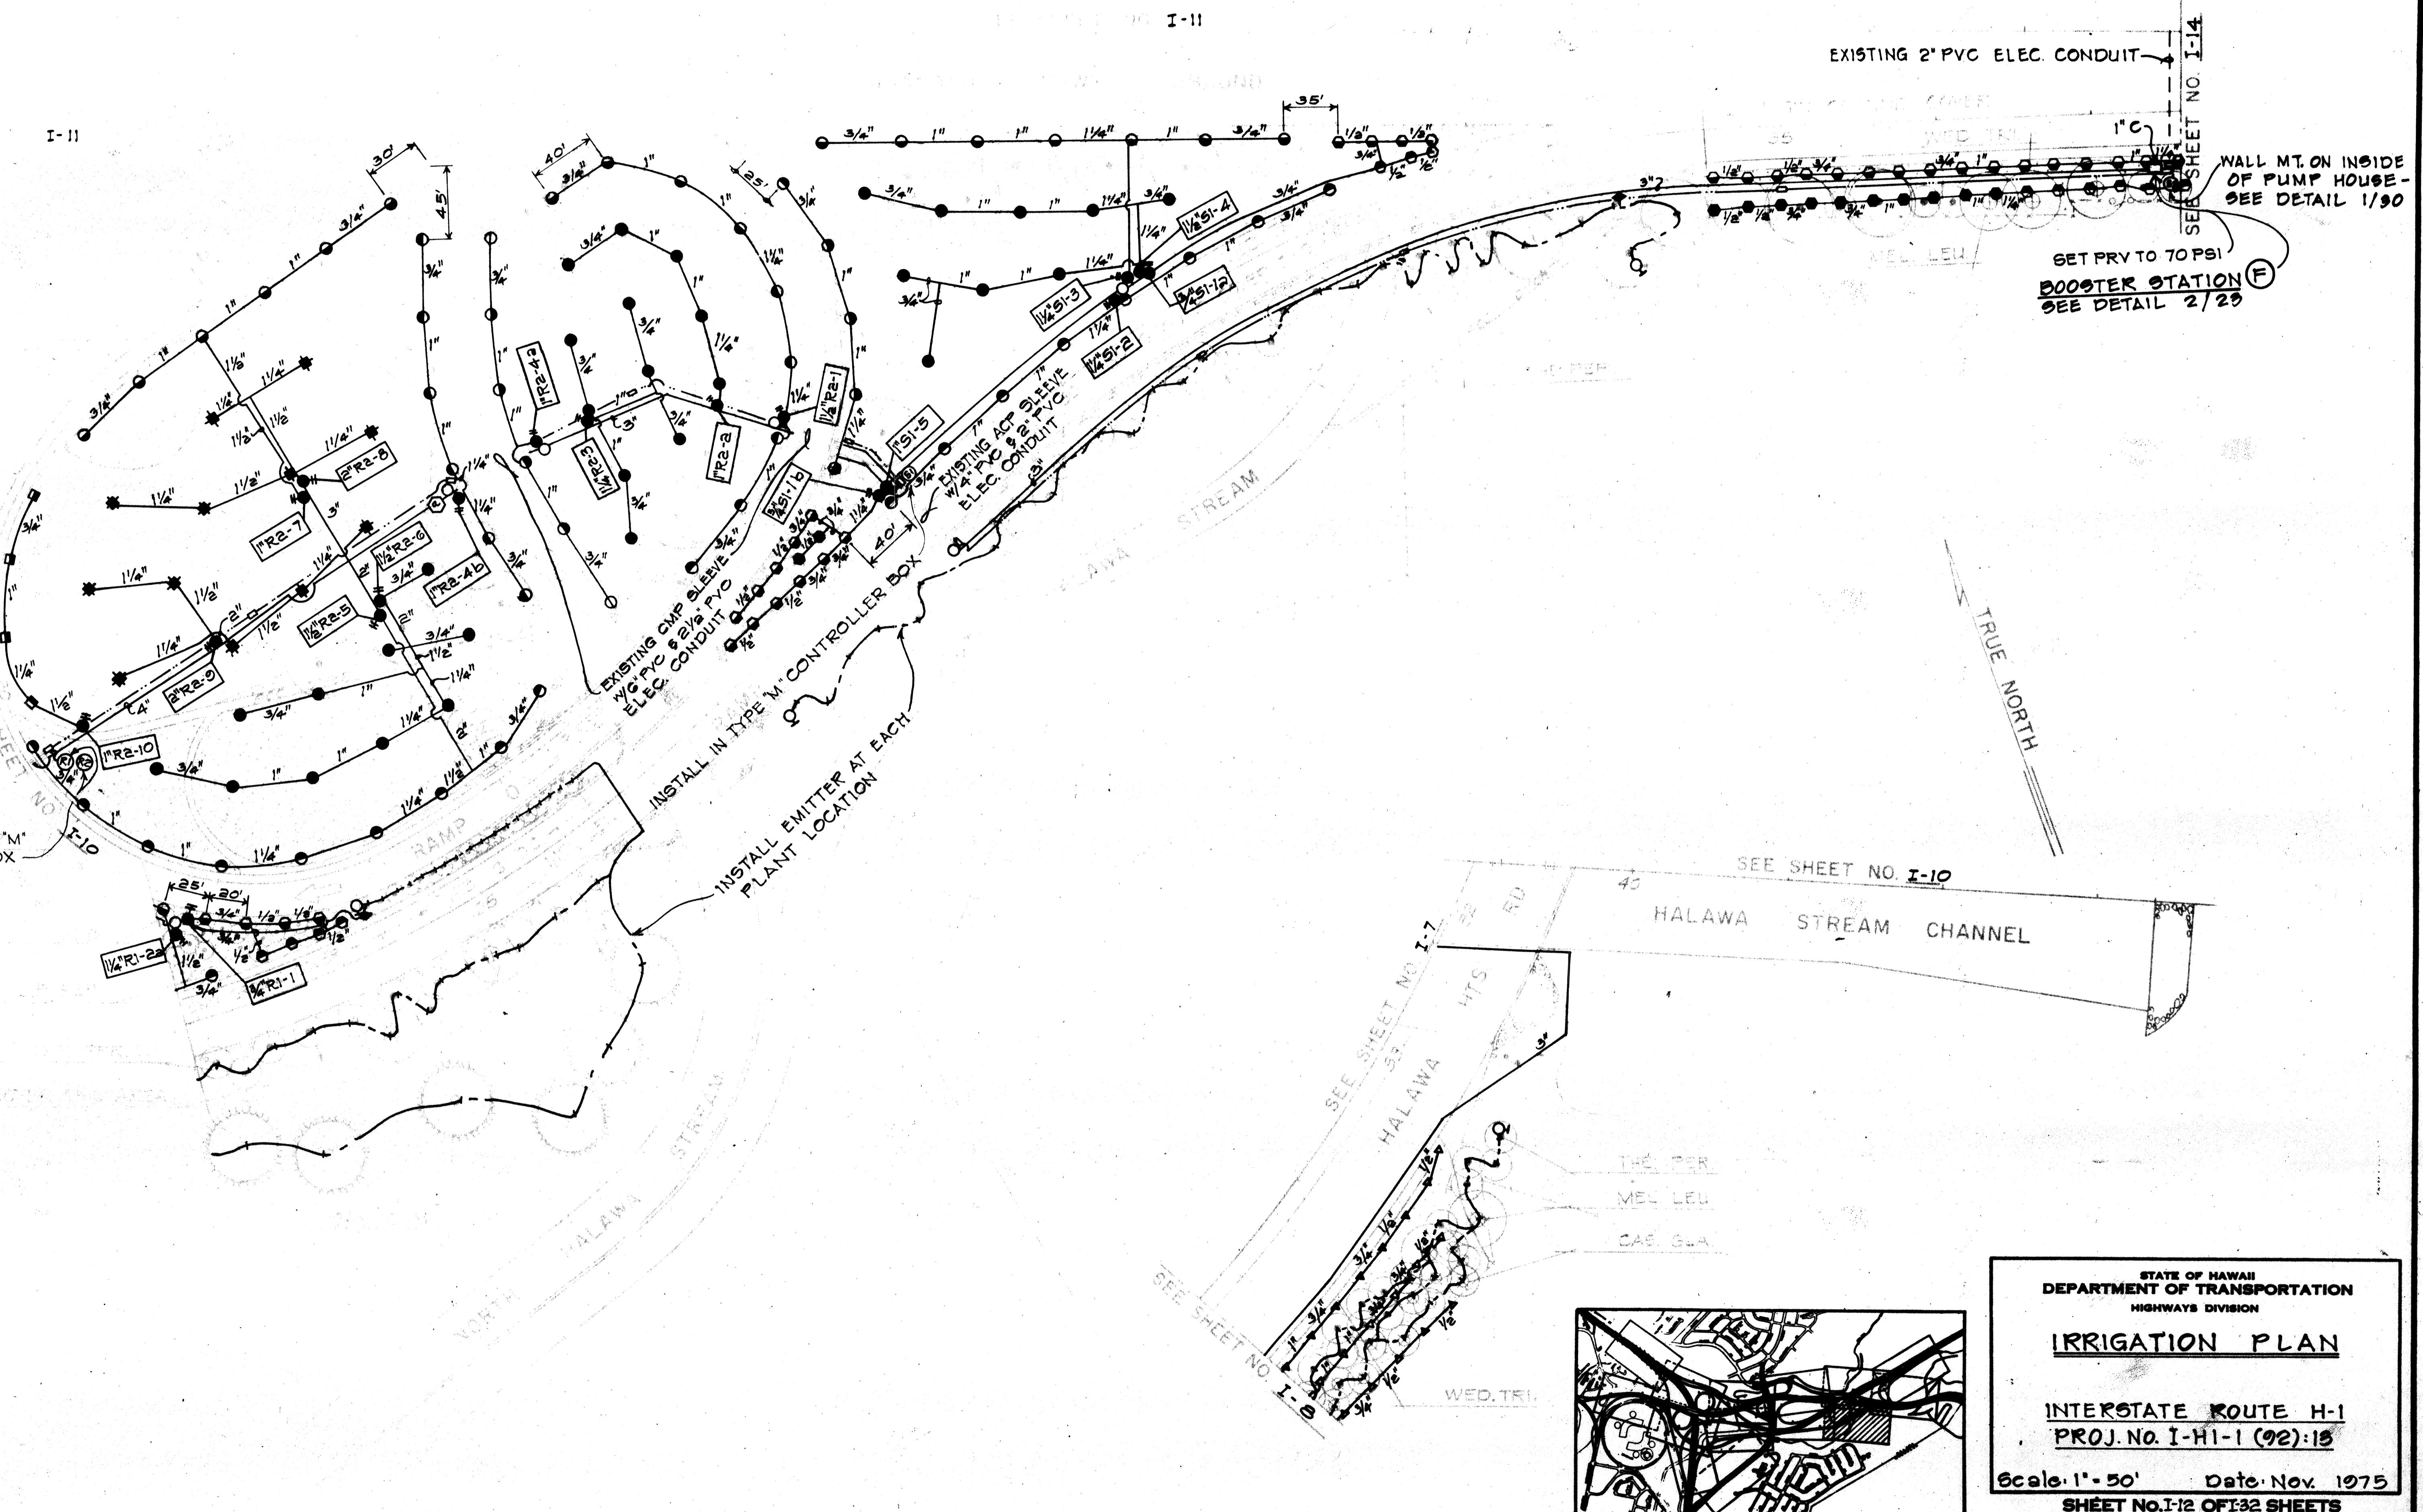

ORIGINAL	SURVEY PLOTTED BY
PLAN	DRAWN BY
NOTE BOOK	TRACED BY
QUADRATICS BY	DESIGNED BY
CHECKED BY	




PED. ROAD DIST. NO.	STATE	FED. AID PROJ. NO.	FISCAL YEAR	SHEET NO.	TOTAL SHEETS
HAWAII	HAW.	1-HI-1 (92)-10	1970	32	50

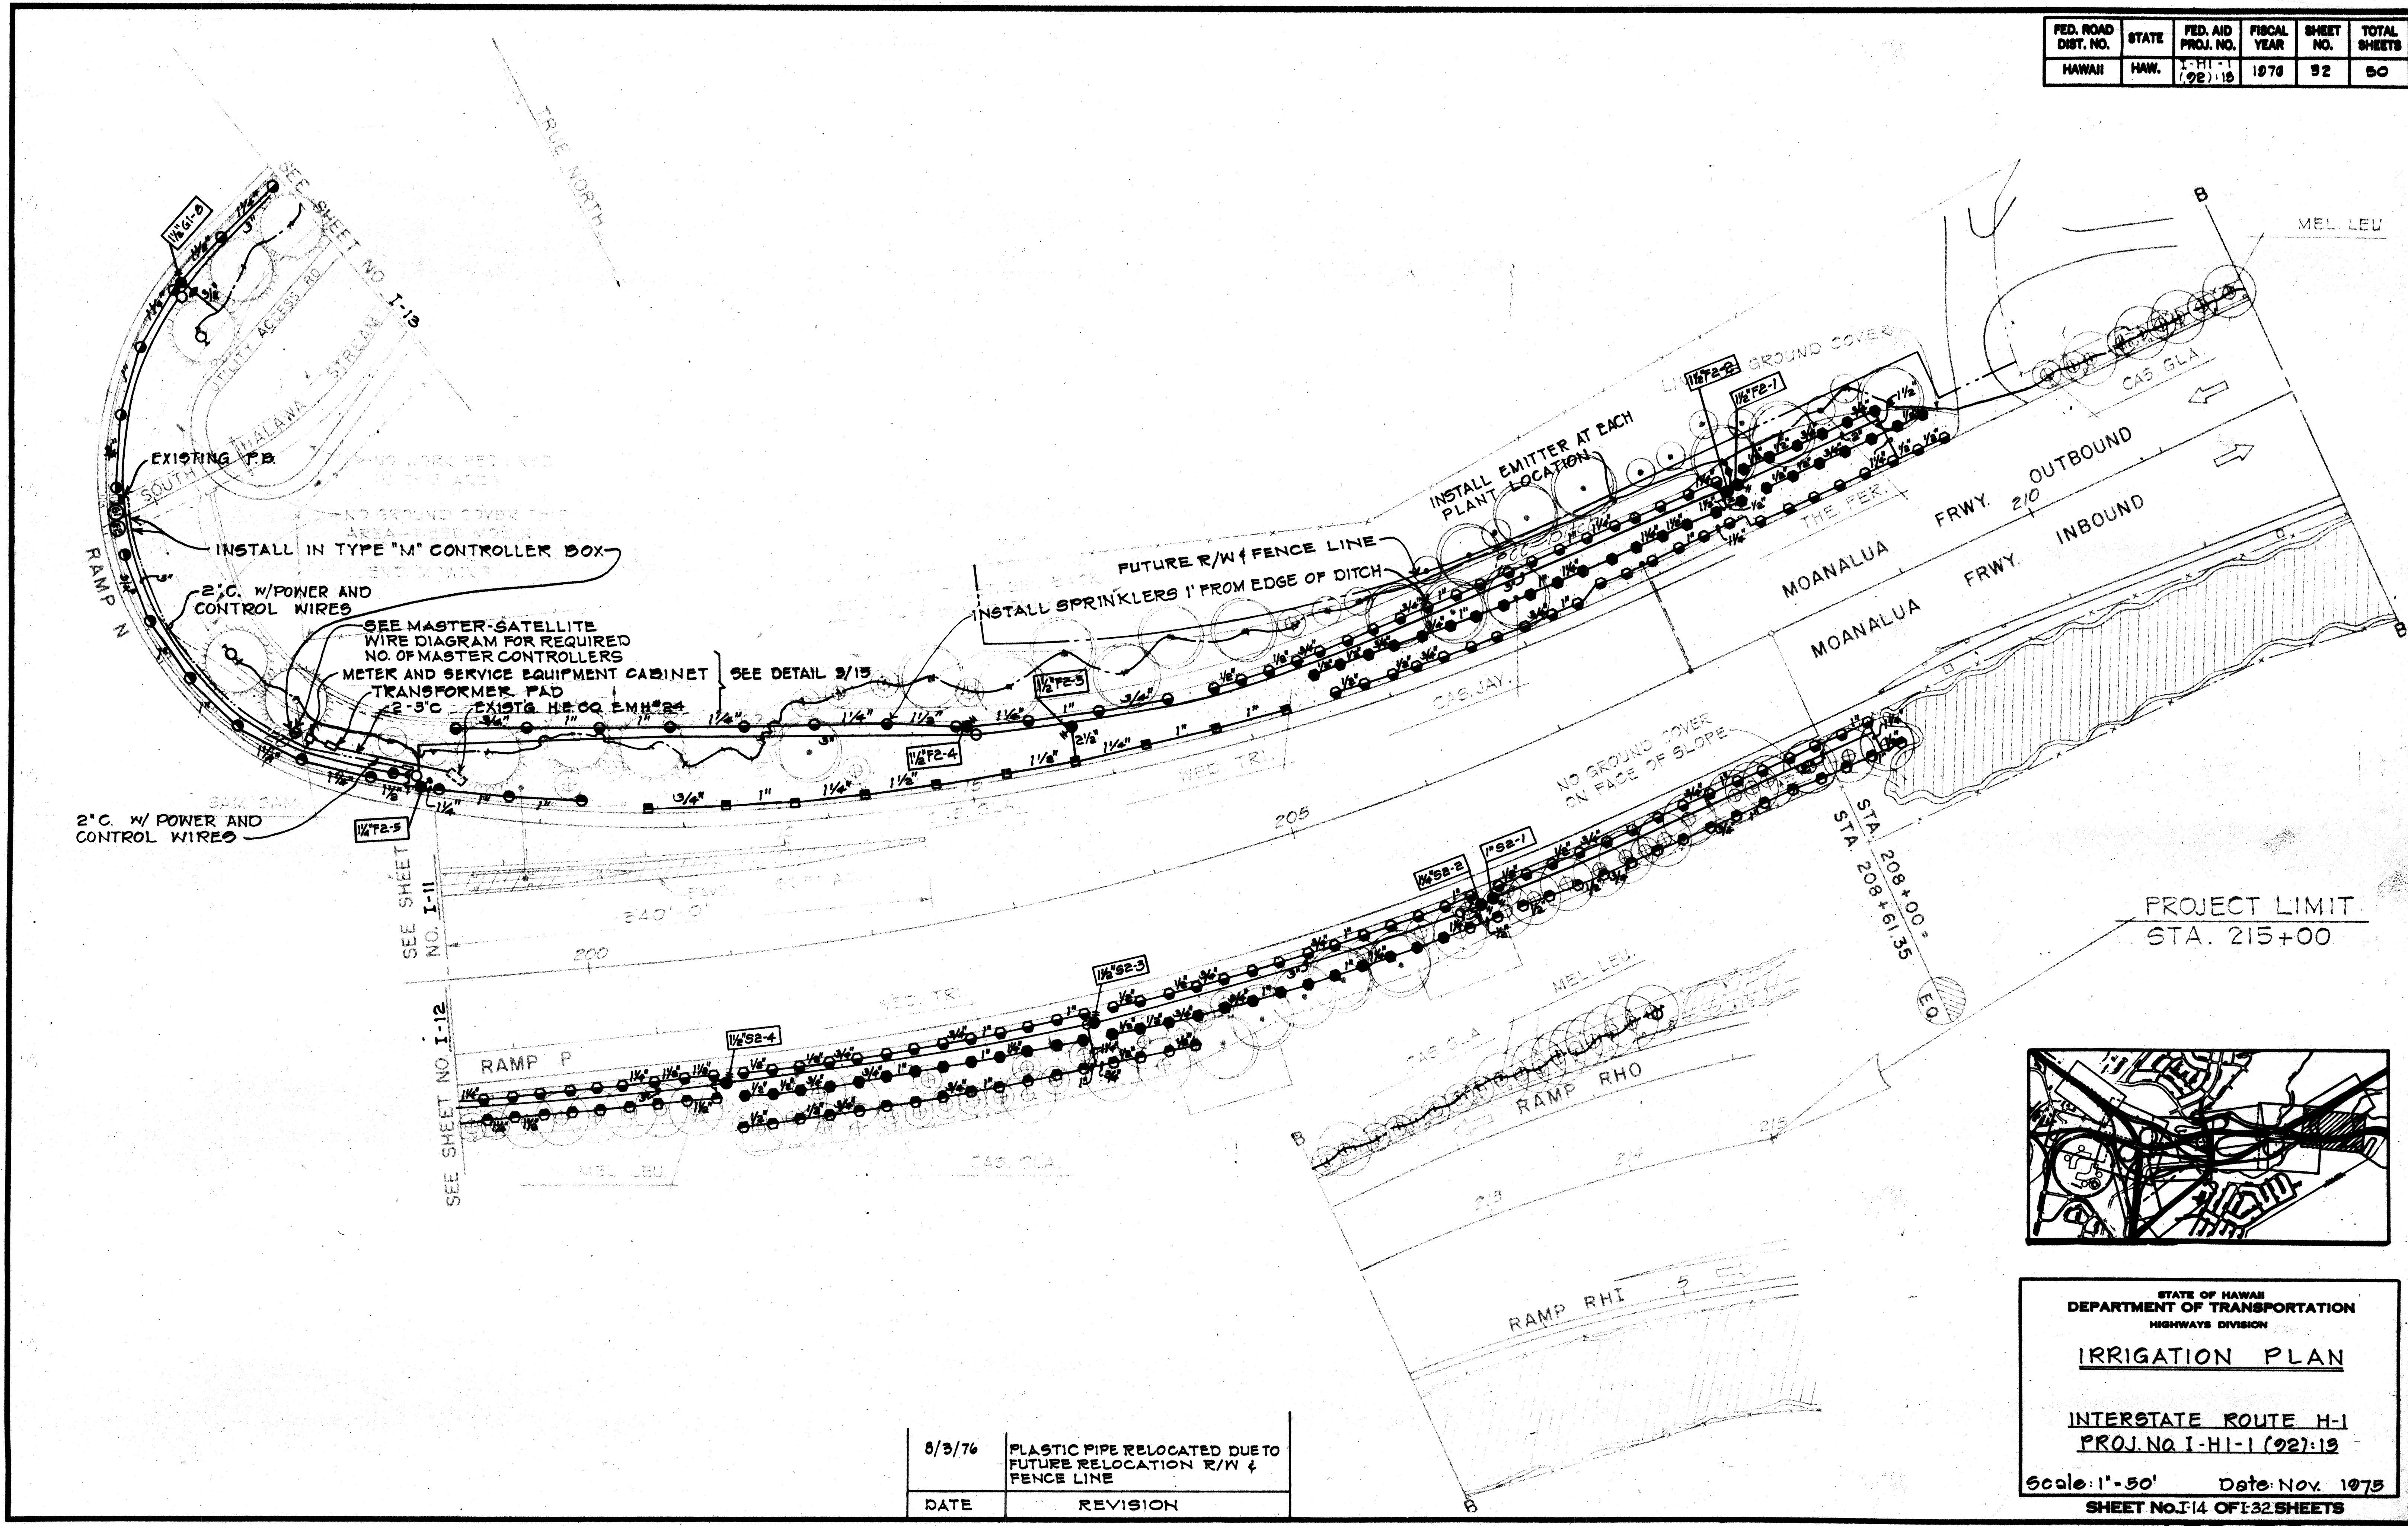

8/3/76	PLASTIC PIPE RELOCATED DUE TO FUTURE RELOCATION R/W & FENCE LINE
DATE	REVISION

FED. ROAD DIST. NO.	STATE	FED. AID PROJ. NO.	FISCAL YEAR	SHEET NO.	TOTAL SHEETS
HAWAII	HAW.	I-HI-(92)13	1976	33	50

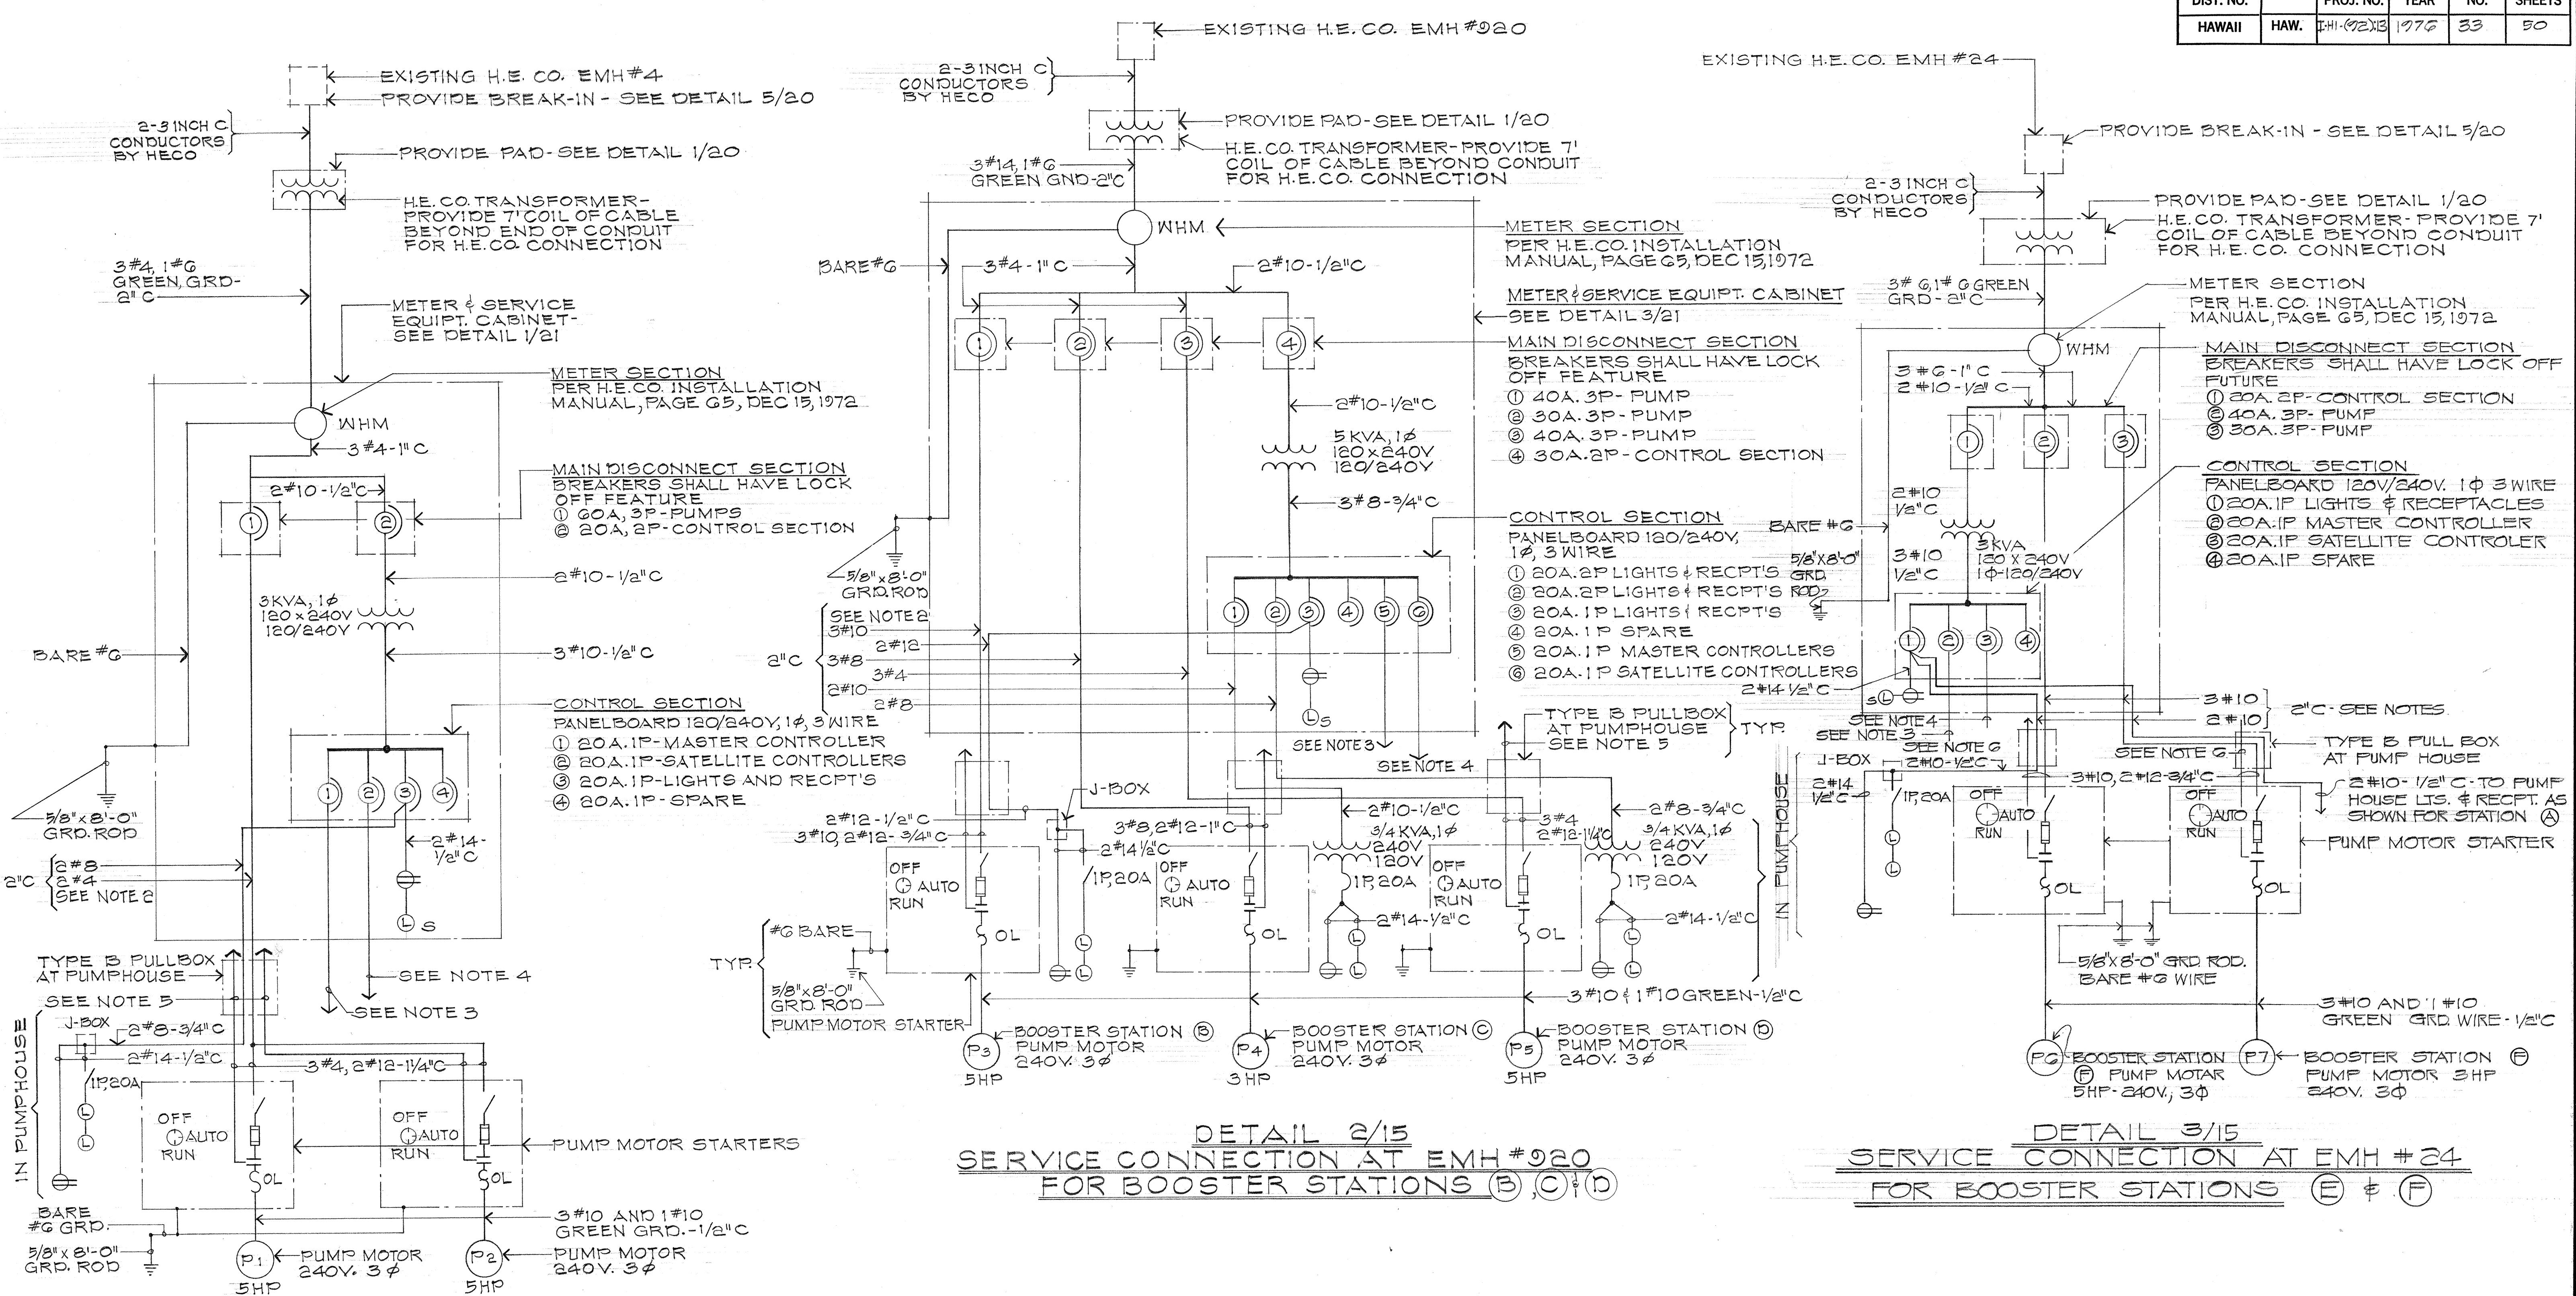

DETAIL 3/15  
SERVICE CONNECTION AT EMH #24  
FOR BOOSTER STATIONS E \$ F


**NOTES:**

1. ALL WIRE SIZES ARE A.W.G., COPPER.
2. PROVIDE CONDUIT OF INDICATED SIZE. UTILIZE EXISTING CONDUIT AS PLAN SHEETS SHOW. RUN OTHER WIRING WITH PUMP FEEDER AS REQUIRED.
3. PROVIDE POWER WIRES TO MASTER AS REQUIRED.
4. PROVIDE POWER WIRES TO SATELLITES AS REQUIRED.
5. PUMP START WIRES TO FLOW SWITCH
6. PUMP START WIRES TO SATELLITE OR MASTER CONTROLLER. SEE MASTER -TO- SATELLITE WIRING DIAGRAM.


DETAIL 1/15  
SERVICE CONNECTION AT EMH #14  
FOR BOOSTER STATION A

STATE OF HAWAII  
DEPARTMENT OF TRANSPORTATION  
HIGHWAYS DIVISION  
IGATION SYSTEM  
E LINE DIAGRAM FOR  
RVICE CONNECTIONS  
D BOOSTER STATIONS  
INTERSTATE ROUTE H-1  
PROJ. NO. I-HI-1(92):13  
DATE JUN 1976


FED. ROAD DIST. NO.	STATE	FED. AID PROJ. NO.	FISCAL YEAR	SHEET NO.	TOTAL SHEETS
HAWAII	HAW.	I-HI-1(92)-13	1976	34	50

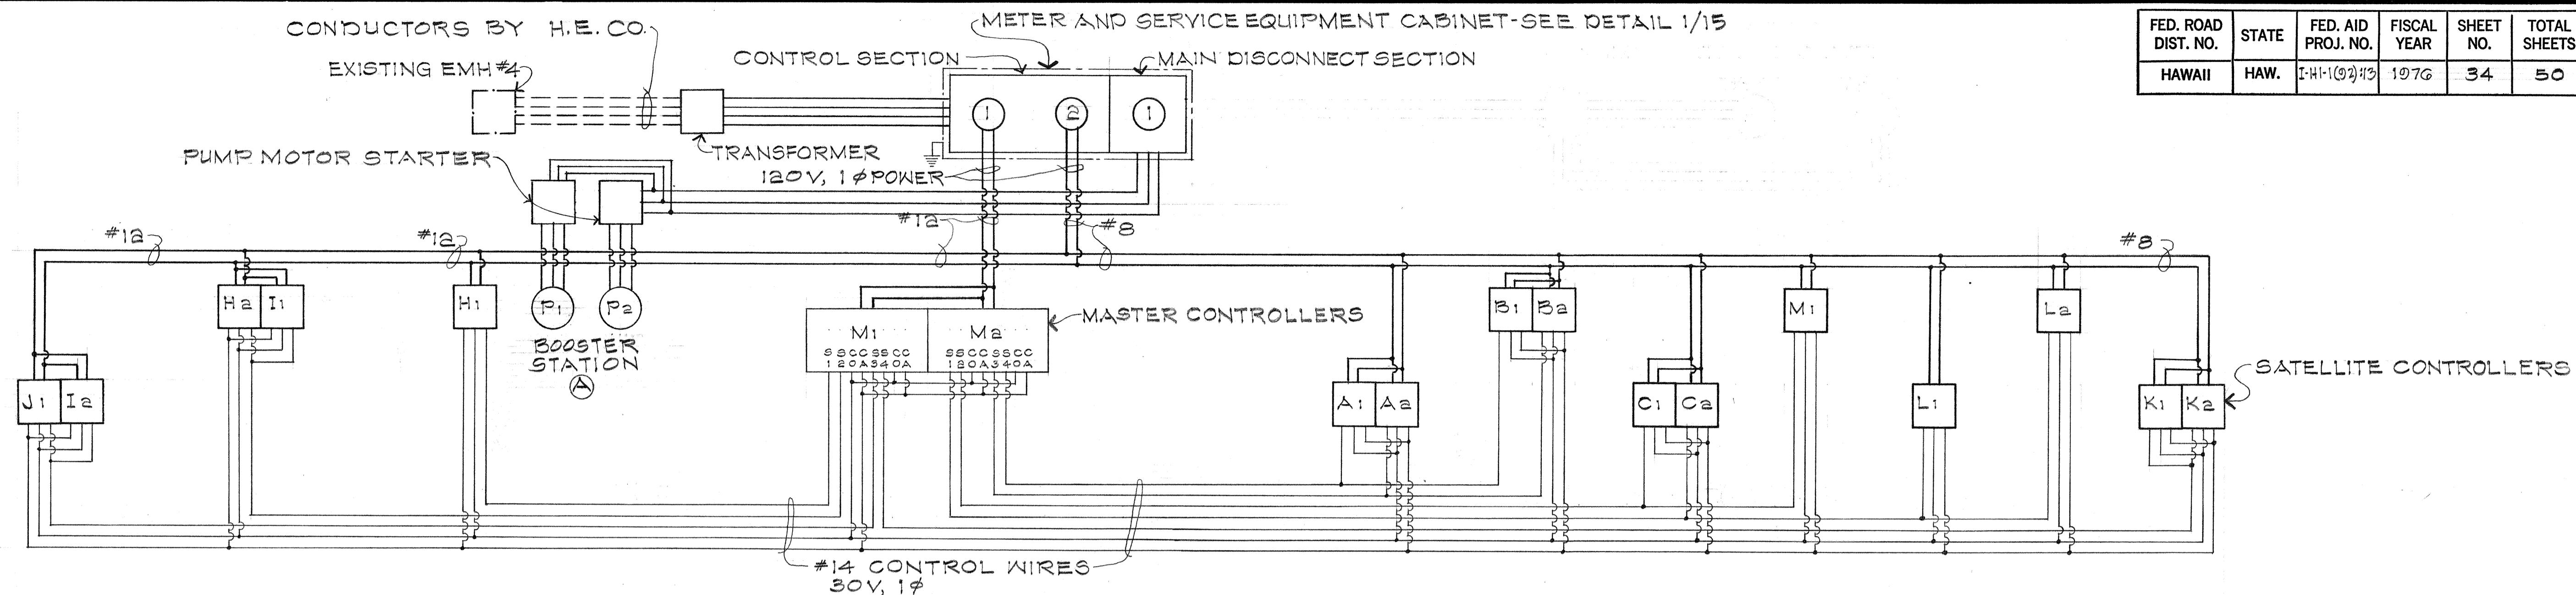

### DETAIL 1/16

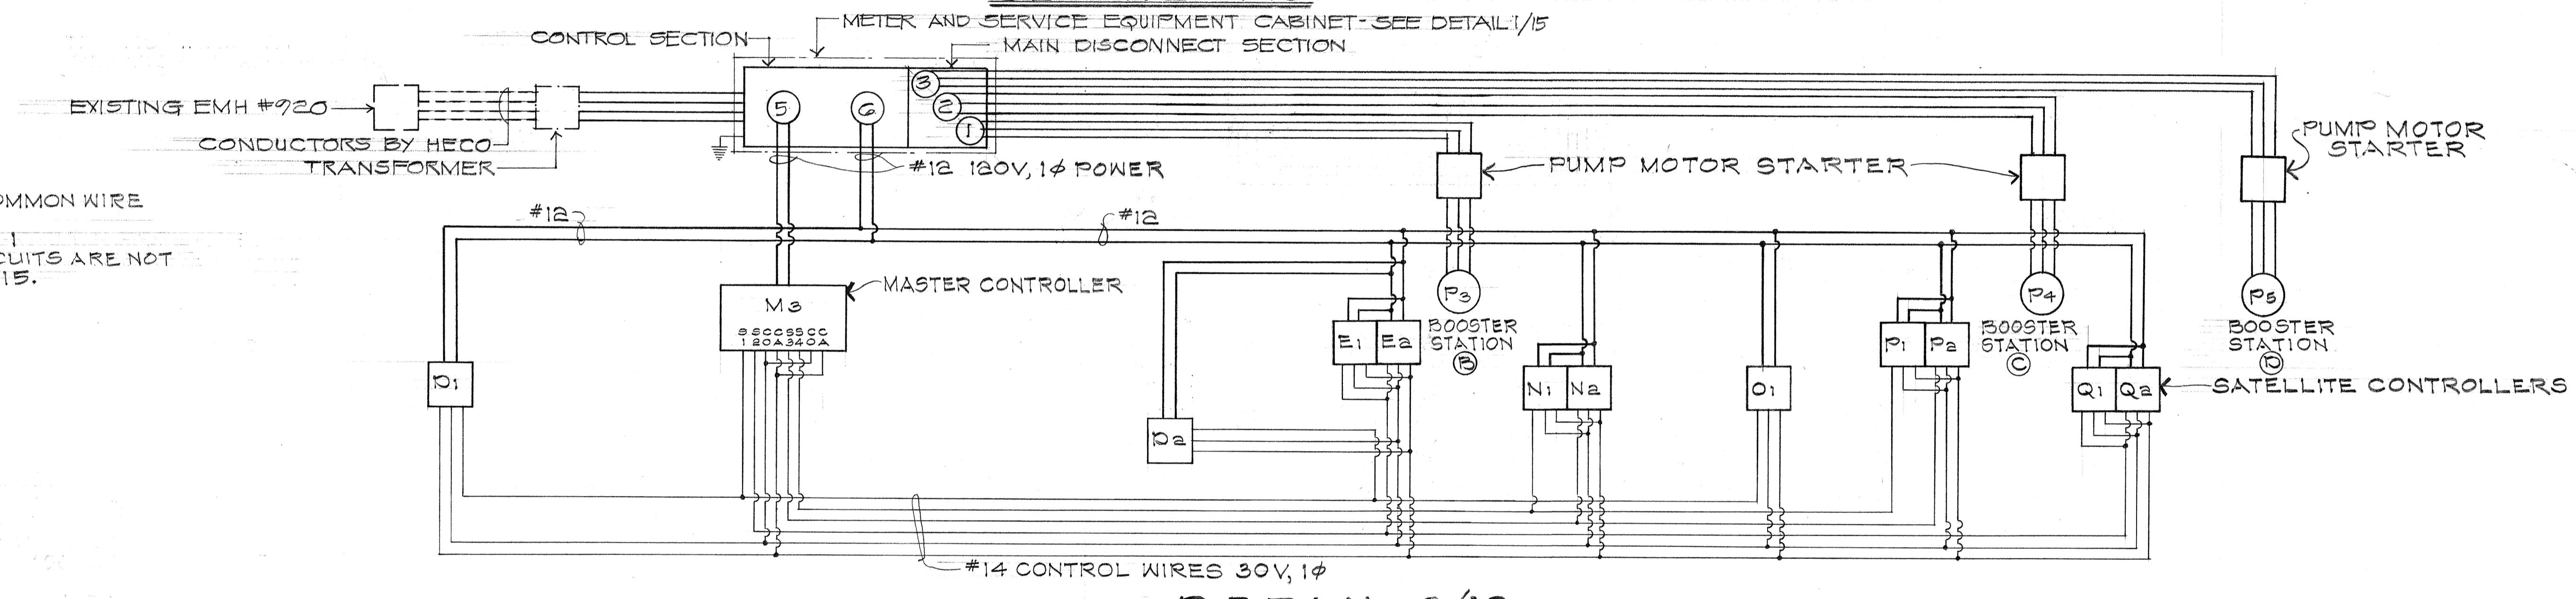

### DETAIL 2/16

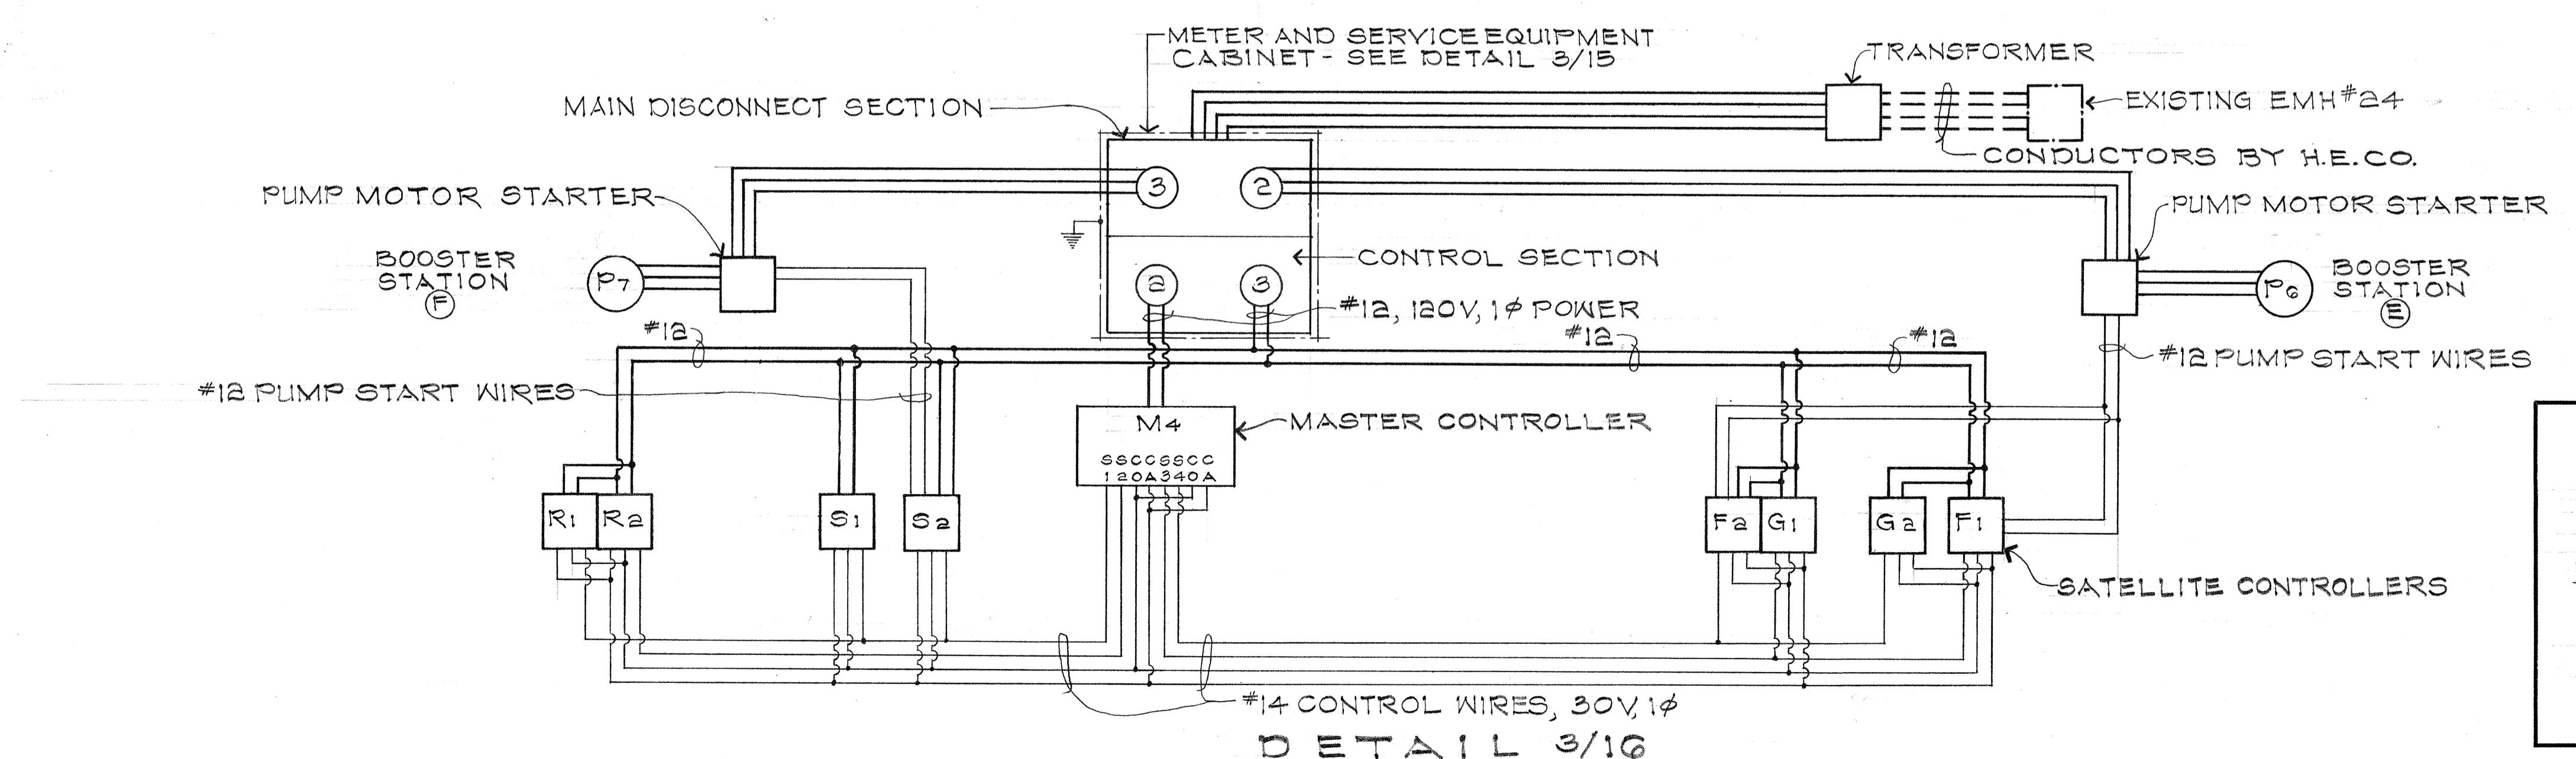

NOTE:  
REVISED OPTION "C" WAS  
INSTALLED BY CONTRACTOR.  
REFER TO PLAN SHT. NOS.  
C.O. 36 AND C.O. 36 S-1.




STATE OF HAWAII  
DEPARTMENT OF TRANSPORTATION  
HIGHWAYS DIVISION  
IRRIGATION SYSTEM  
WIRING DIAGRAMS  
MASTER TO SATELLITE CONTROLLER  
OPTION "A"  
INTERSTATE ROUTE H-1  
PROJ. NO. I-HI-1(92)-13

Date: Mar. 1976

SHEET NO. 16 OF 32 SHEETS

ORIGINAL SURVEY PLOTTED BY
PLAN DRAWN BY
TRACED BY
DESIGNED BY
QUANTITIES BY
CHECKED BY
No. _____



FED. ROAD DIST. NO.	STATE	FED. AID PROJ. NO.	FISCAL YEAR	SHEET NO.	TOTAL SHEETS
HAWAII	HAW.	I-HI-1(02):13	1976	35	50

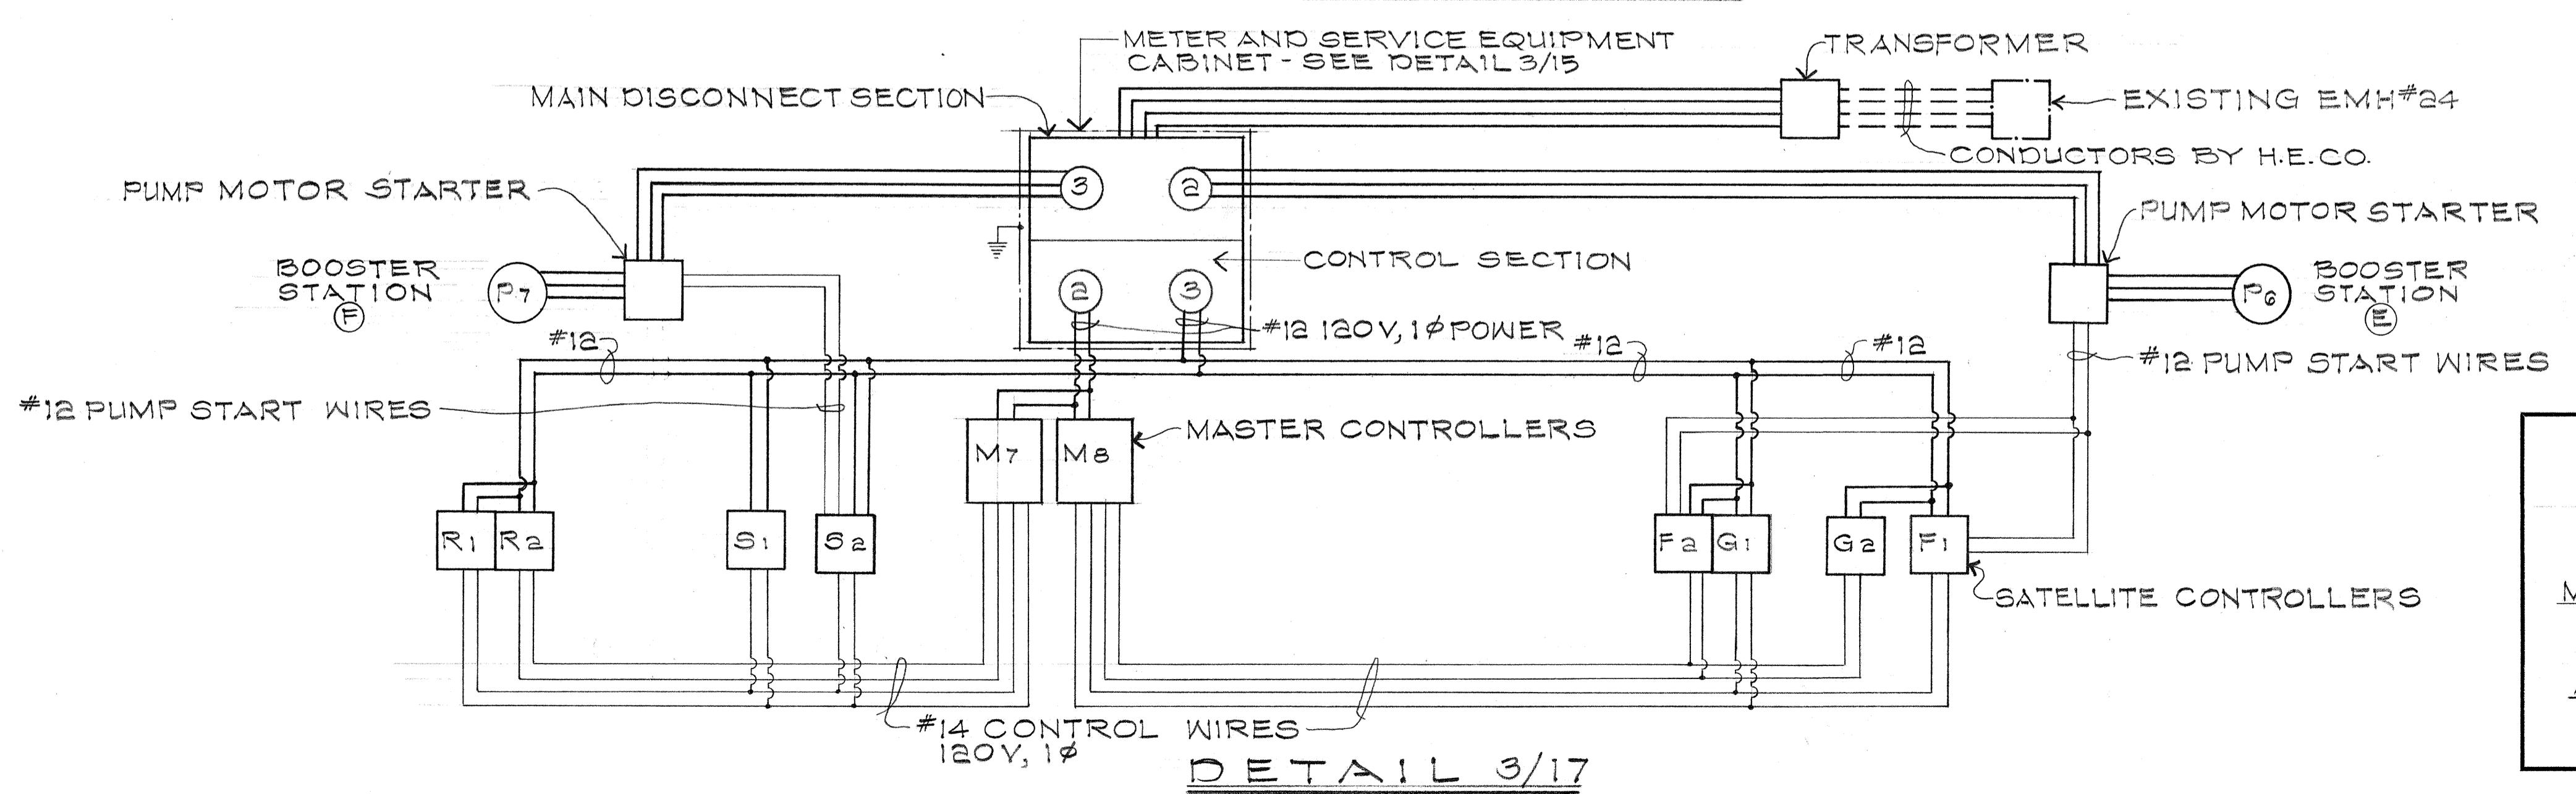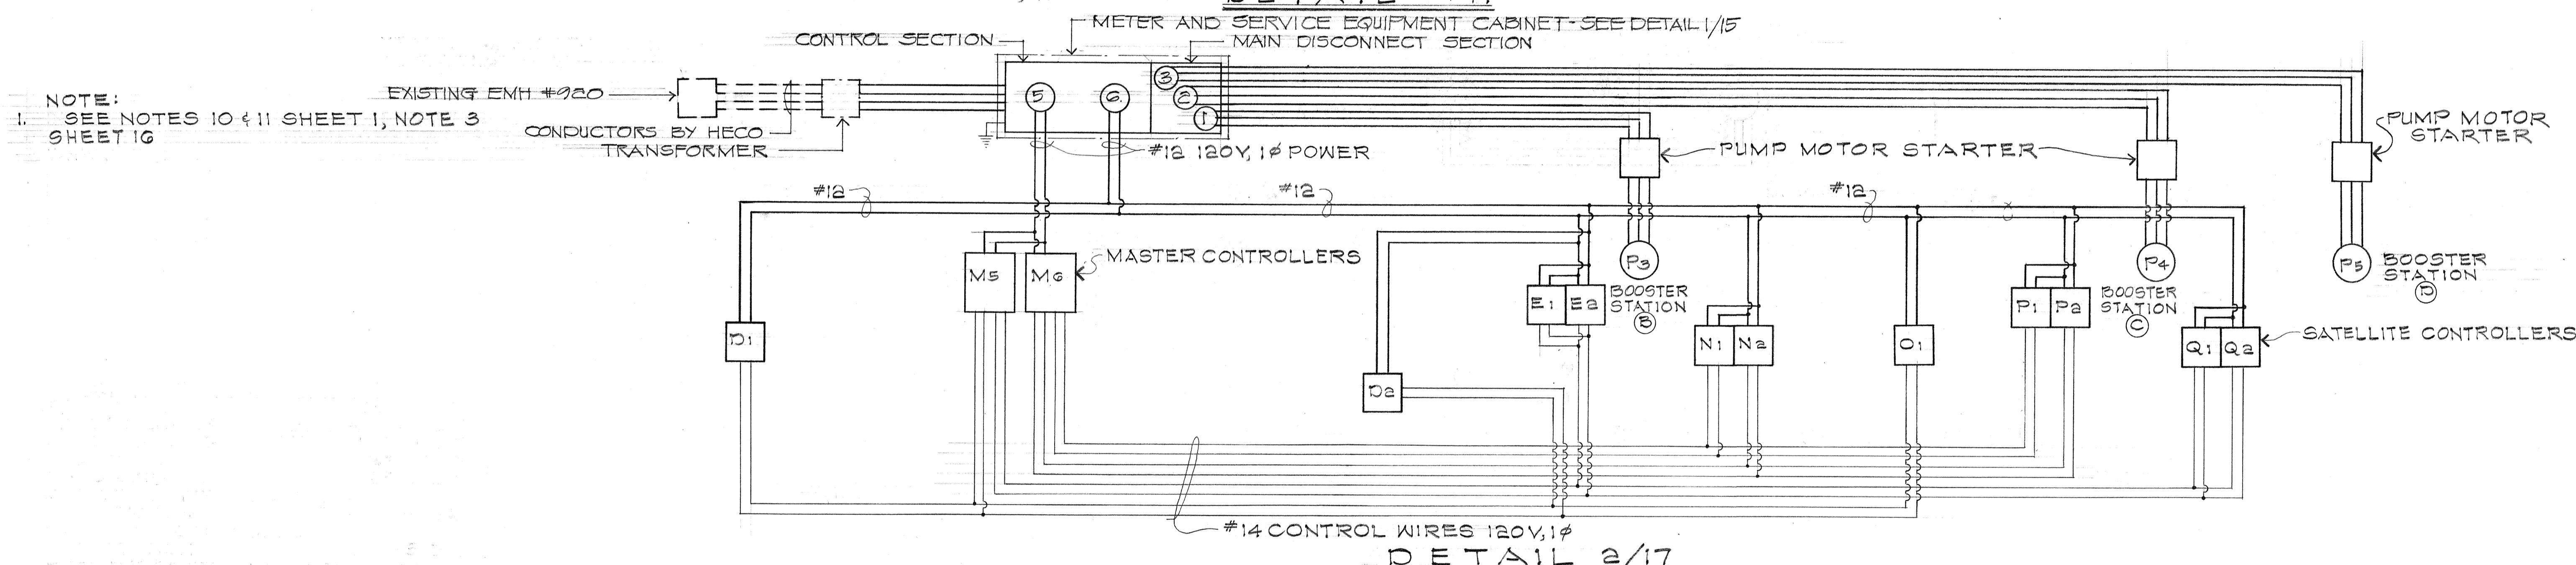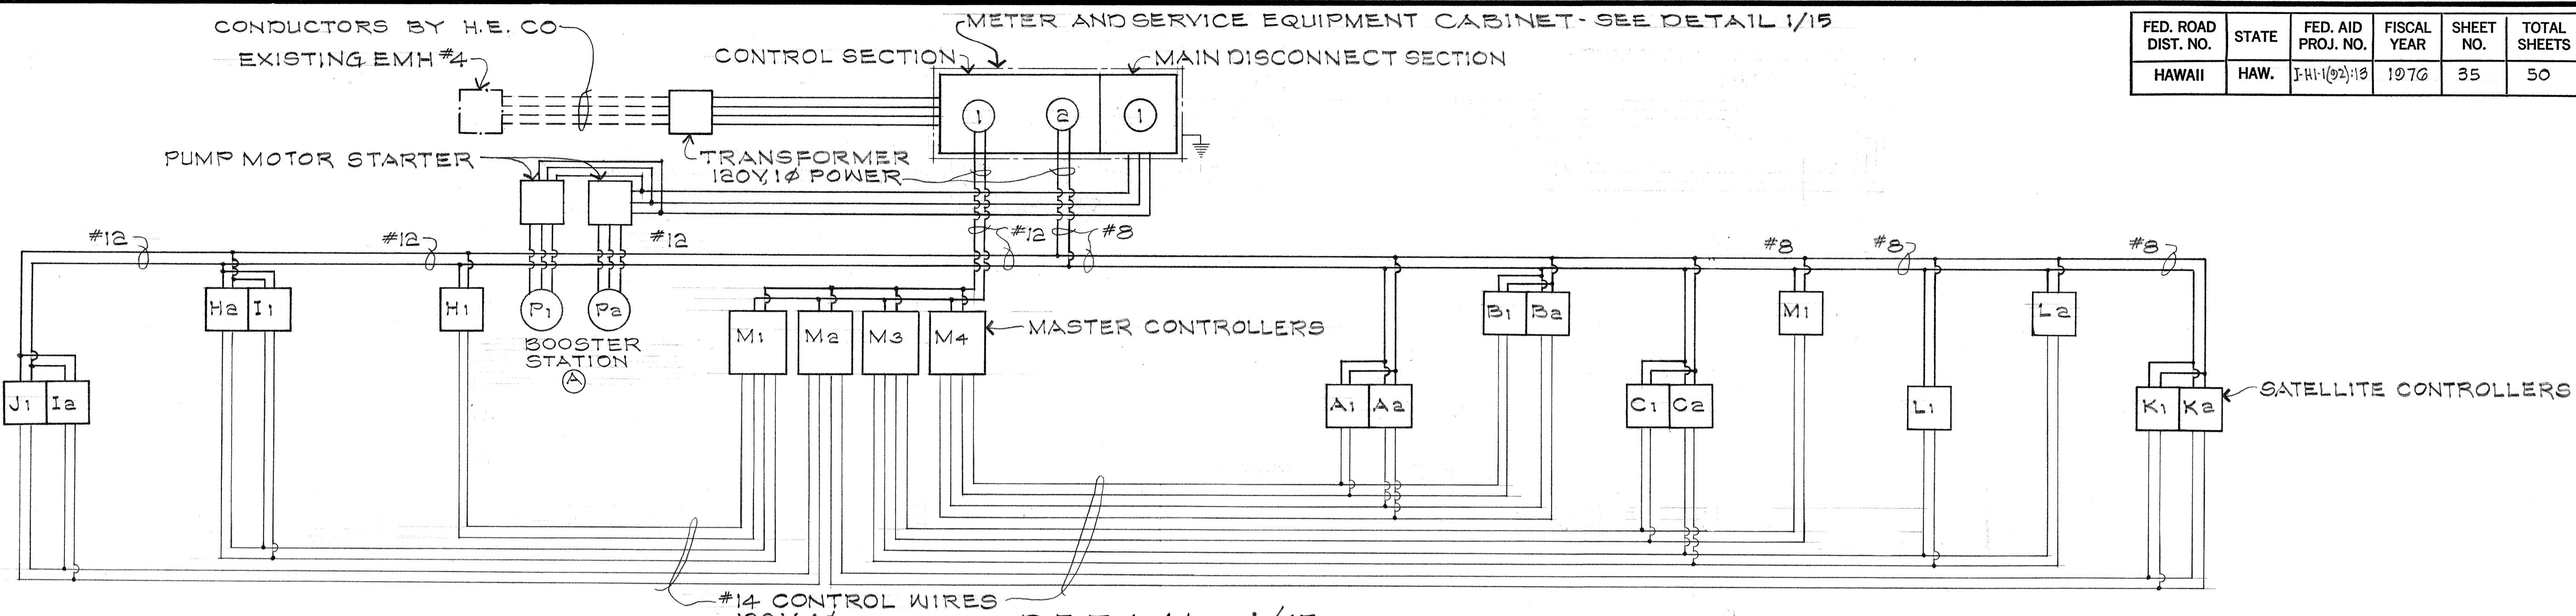


NOTE:  
REVISED OPTION "C" WAS  
INSTALLED BY CONTRACTOR.  
REFER TO PLAN SH. NOS.  
C.O. 36 AND C.O. 36 S-1

STATE OF HAWAII  
DEPARTMENT OF TRANSPORTATION  
HIGHWAYS DIVISION  
IRRIGATION SYSTEM  
WIRING DIAGRAMS  
MASTER TO SATELLITE CONTROLLER  
OPTION "B"  
INTERSTATE ROUTE H-1  
PROJ. NO. I-HI-1(02):13  
Date: Mar 1976  
SHEET NO. I-17 OF 32 SHEETS

FED. ROAD DIST. NO.	STATE	FED. AID PROJ. NO.	FISCAL YEAR	SHEET NO.	TOTAL SHEETS
HAWAII	HAW.	J-HI(92):13	1976	36	50

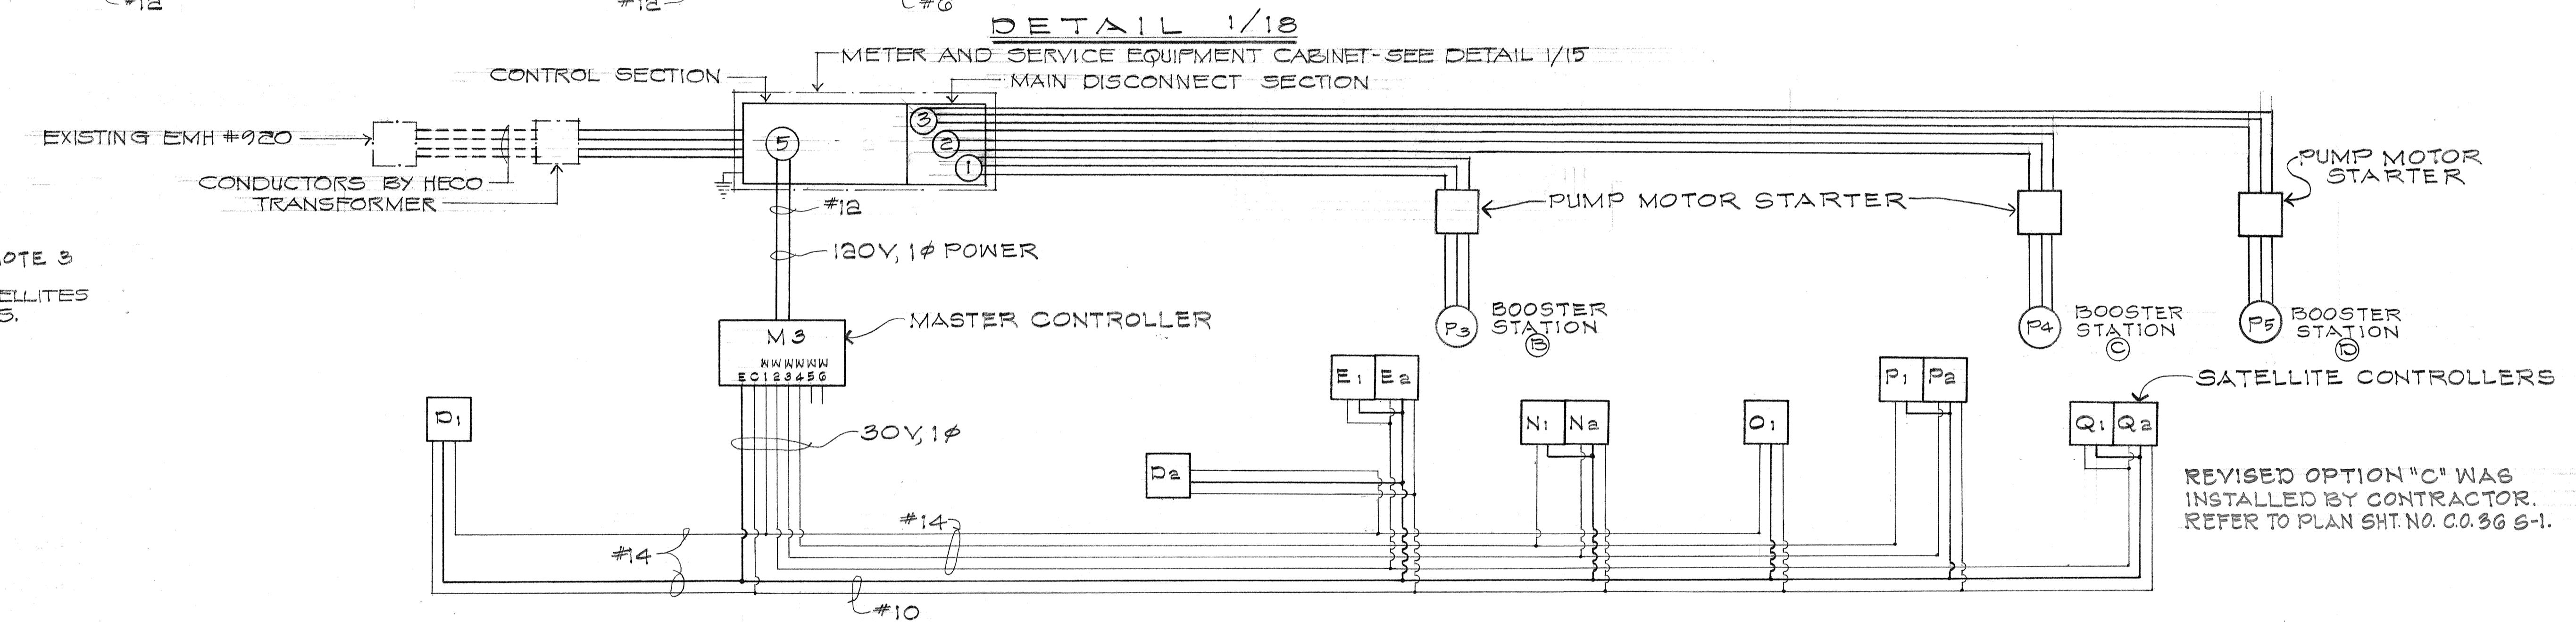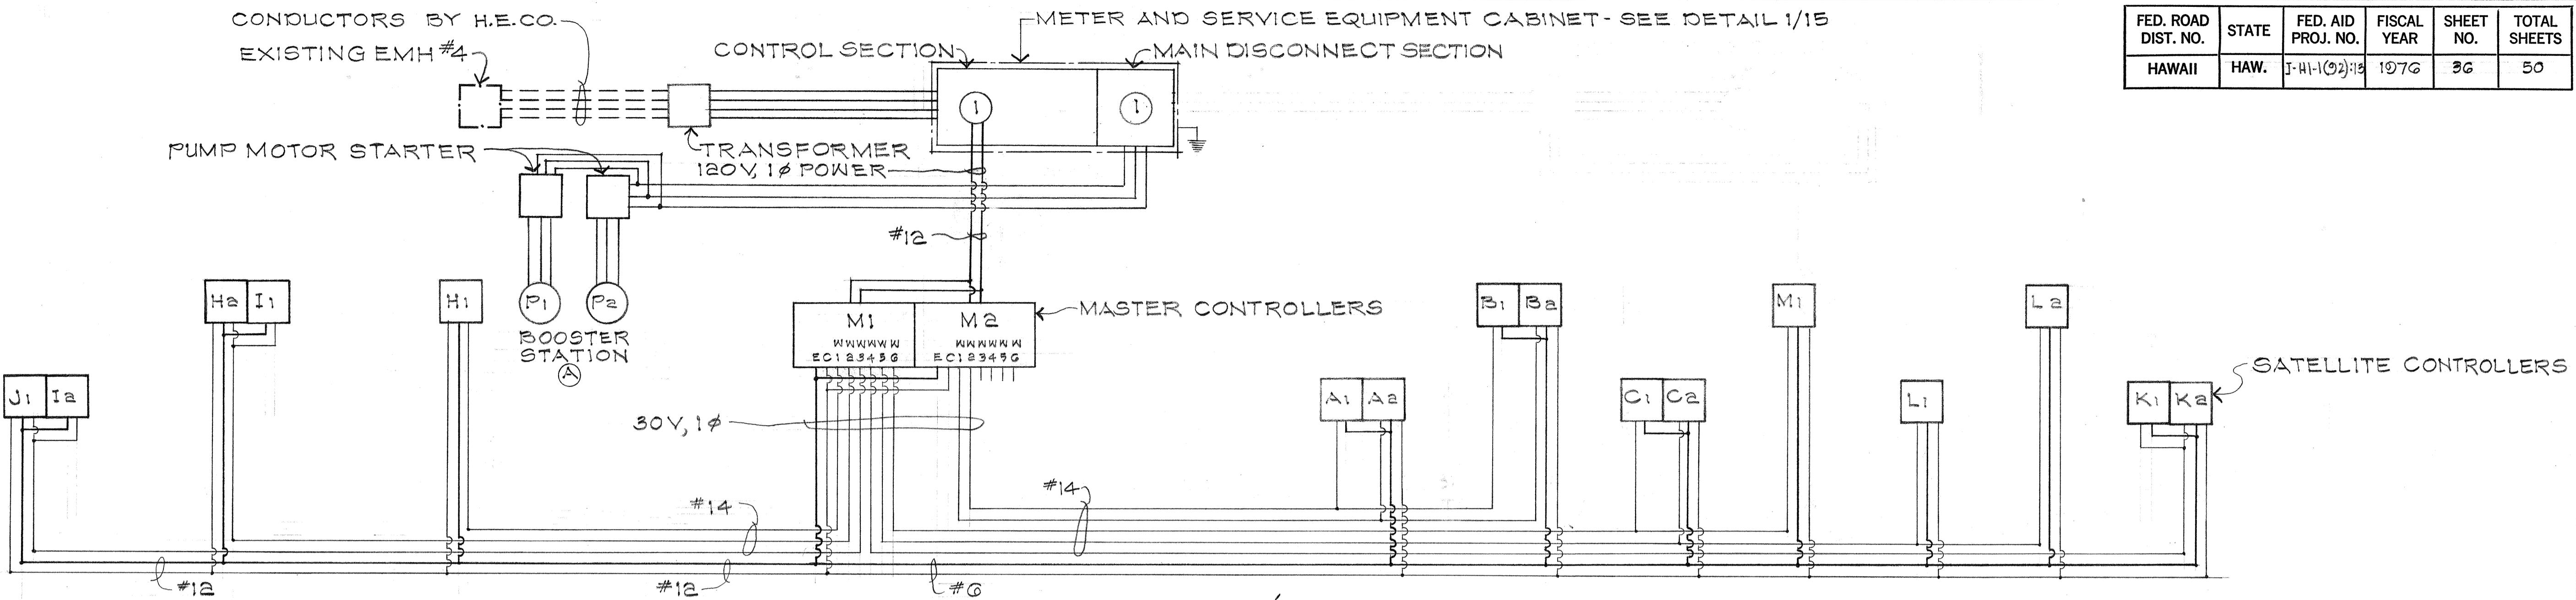

DETAIL 2/18

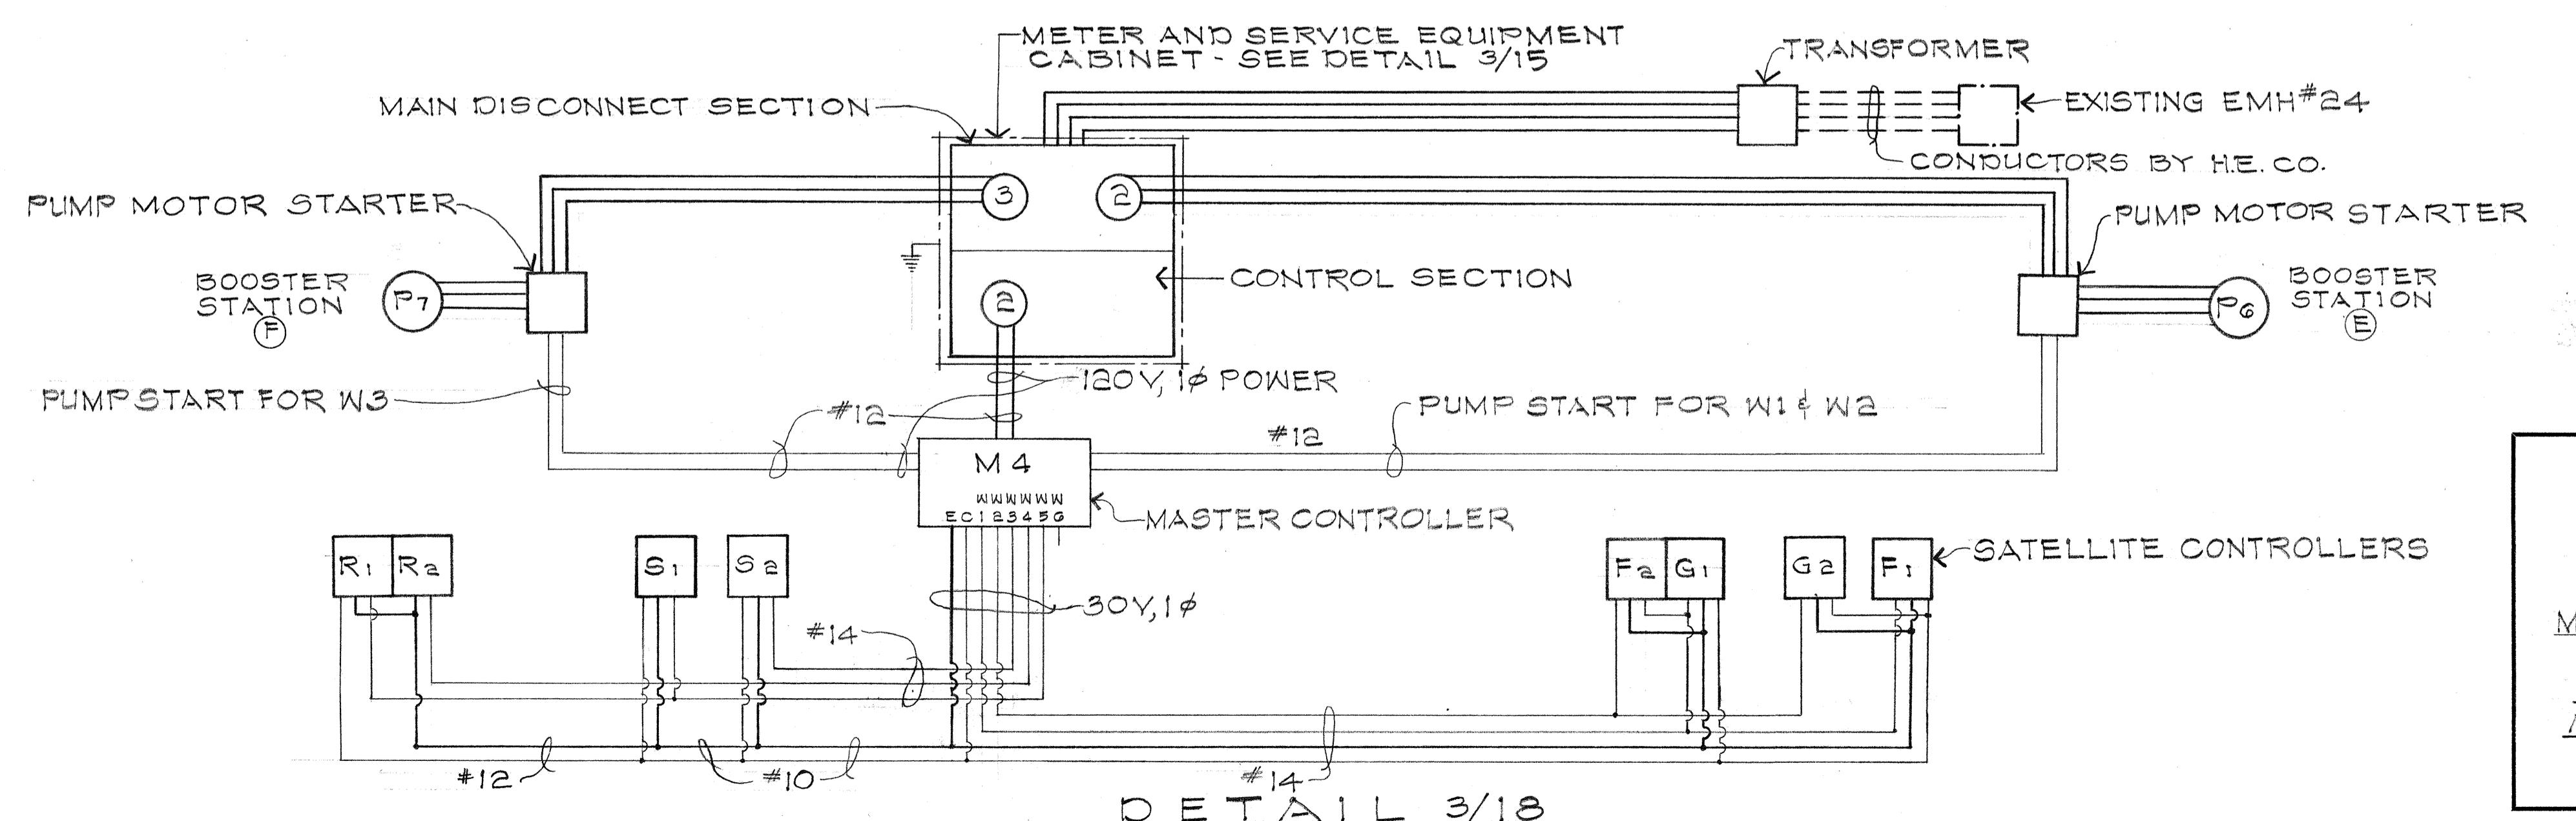

12-3-76 Change #12 wire to #10 from Master M4 to S1. Add #14 wire from Master M4 to control S2 separate from S1 and R1.

DATE REVISION




STATE OF HAWAII  
DEPARTMENT OF TRANSPORTATION  
HIGHWAYS DIVISION  
IRRIGATION SYSTEM  
WIRING DIAGRAMS  
MASTER TO SATELLITE CONTROLLER  
OPTION "C"  
INTERSTATE ROUTE H-1  
PROJ. NO. J-HI-1(92):13

Date: Mar 1976

SHEET NO. I-18 OF 32 SHEETS

C.O.36

FED. ROAD DIST. NO.	STATE	FED. AID PROJ. NO.	FISCAL YEAR	SHEET NO.	TOTAL SHEETS
HAWAII	HAW.	I-HI-1(92):16	1976	0036 S-1	50

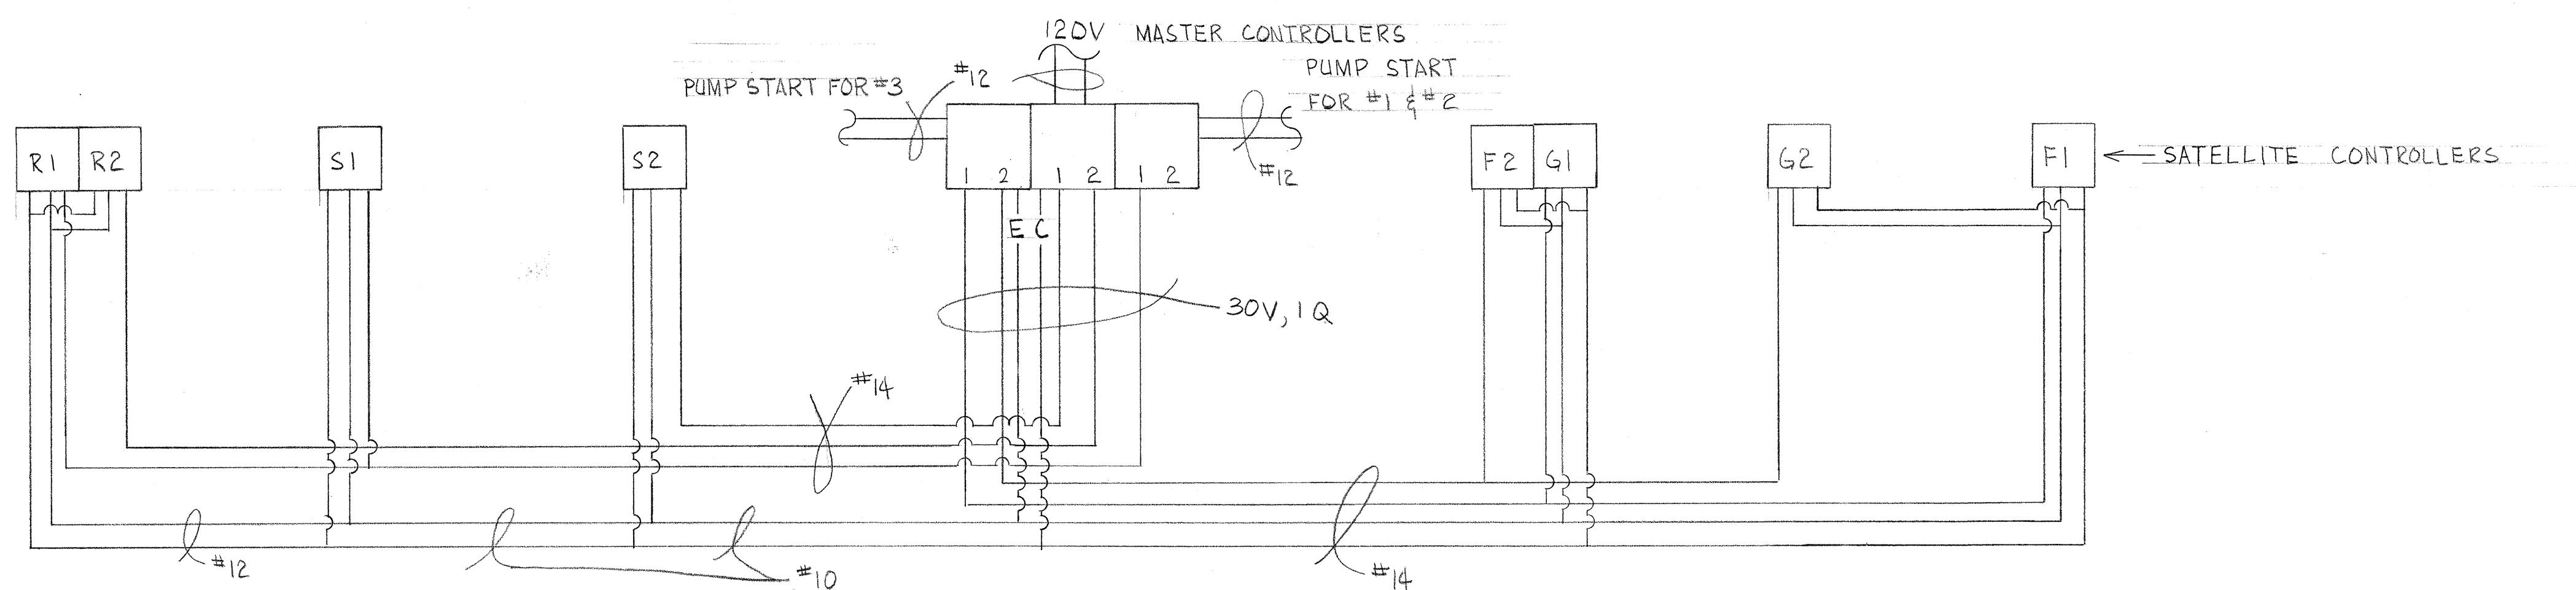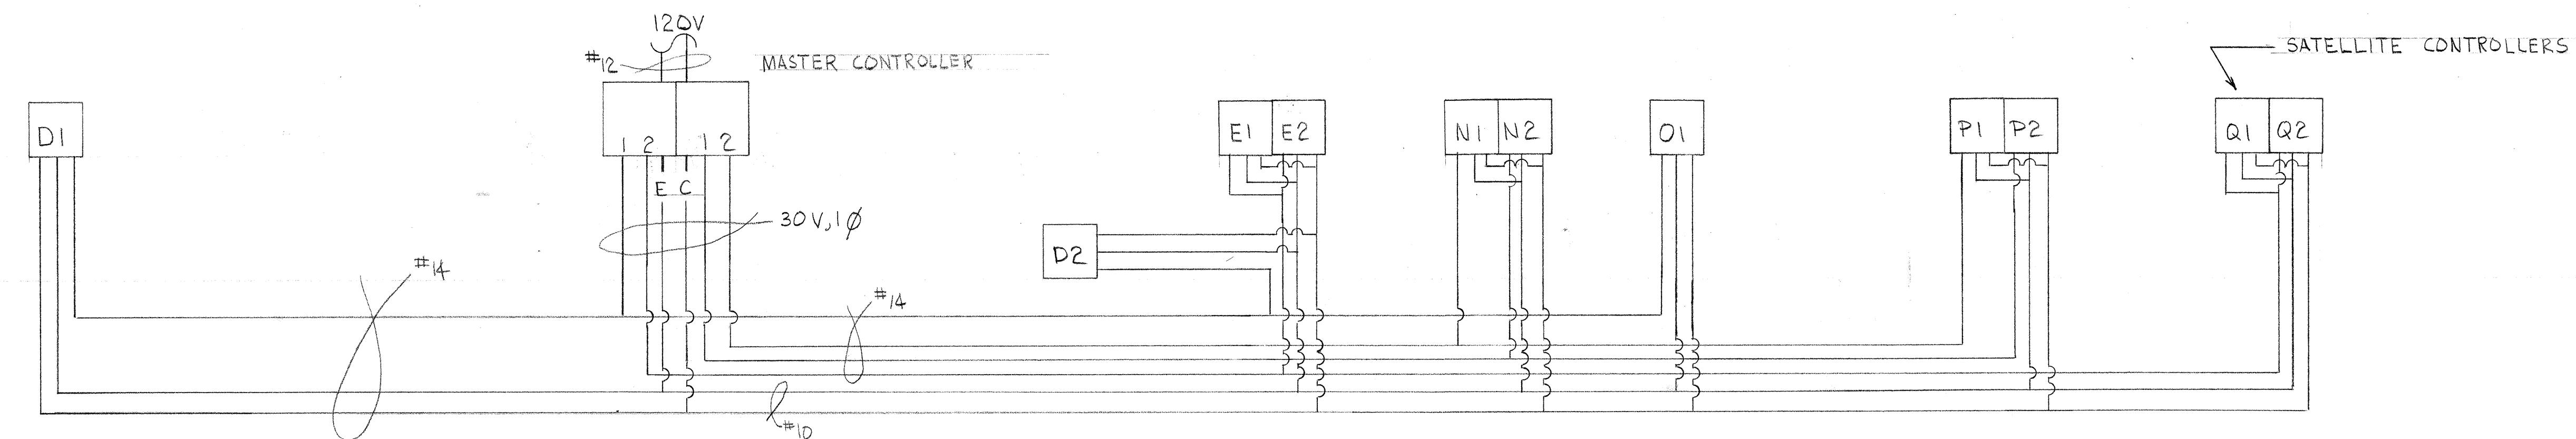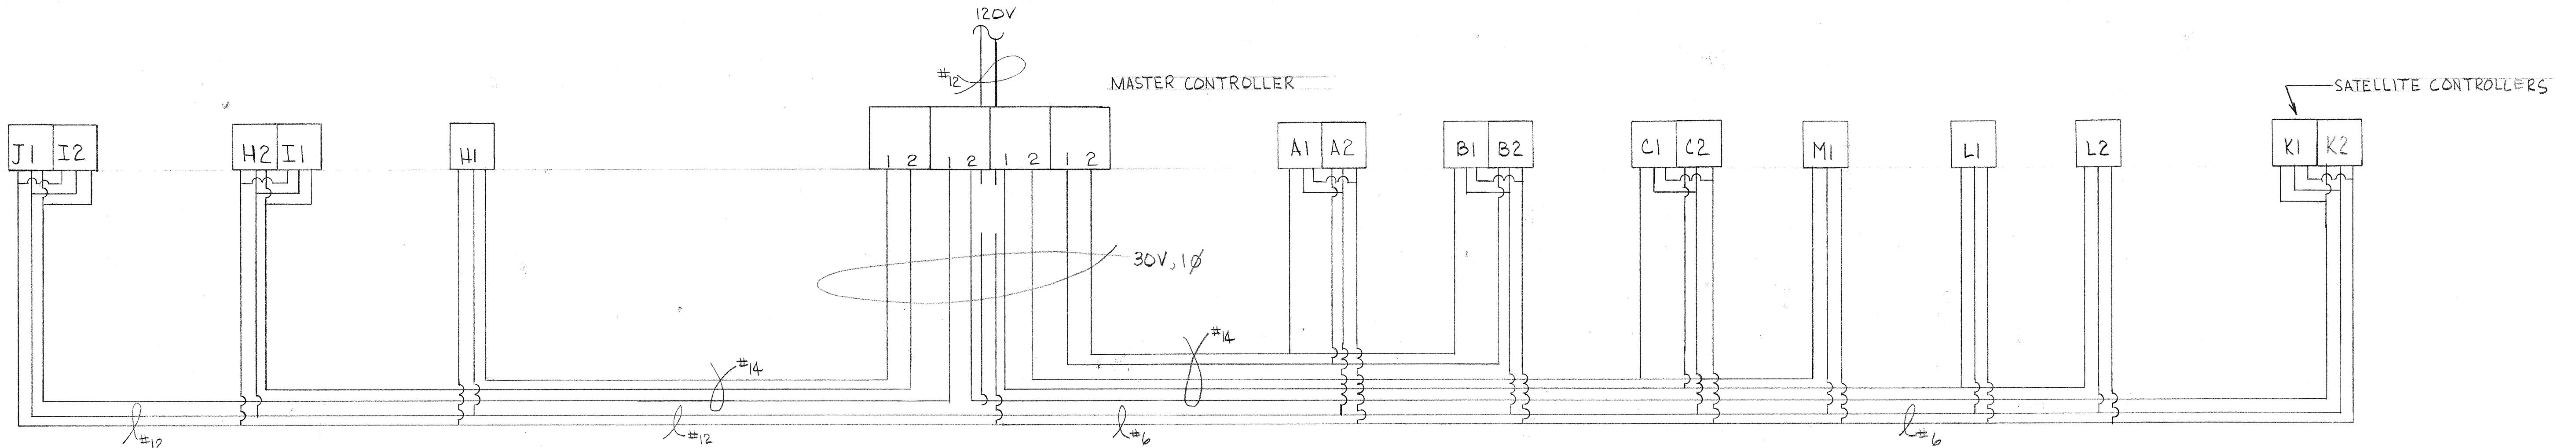


**NOTE:**  
REVISED OPTION "C" WAS INSTALLED BY  
CONTRACTOR. REFER TO PLAN SHT. NO.C.O.36

NOTE: 1) E - POWER WIRE  
C - COMMON WIRE  
2) ELECTRICAL POWER TO SATELLITES  
SUPPLIED BY E & C WIRES


STATE OF HAWAII  
DEPARTMENT OF TRANSPORTATION  
HIGHWAYS DIVISION

MASTER TO SATELLITE  
CONTROLLER WIRING DIAGRAM  
REVISED OPITION "C"  
TERSTATE ROUTE H-1 FAIP NO. I-HI-1(92)13


FED. ROAD DIST. NO.	STATE	FED. AID PROJ. NO.	FISCAL YEAR	SHEET NO.	TOTAL SHEETS
HAWAII	HAW.	I-HI-1(02)-13	1976	37	50

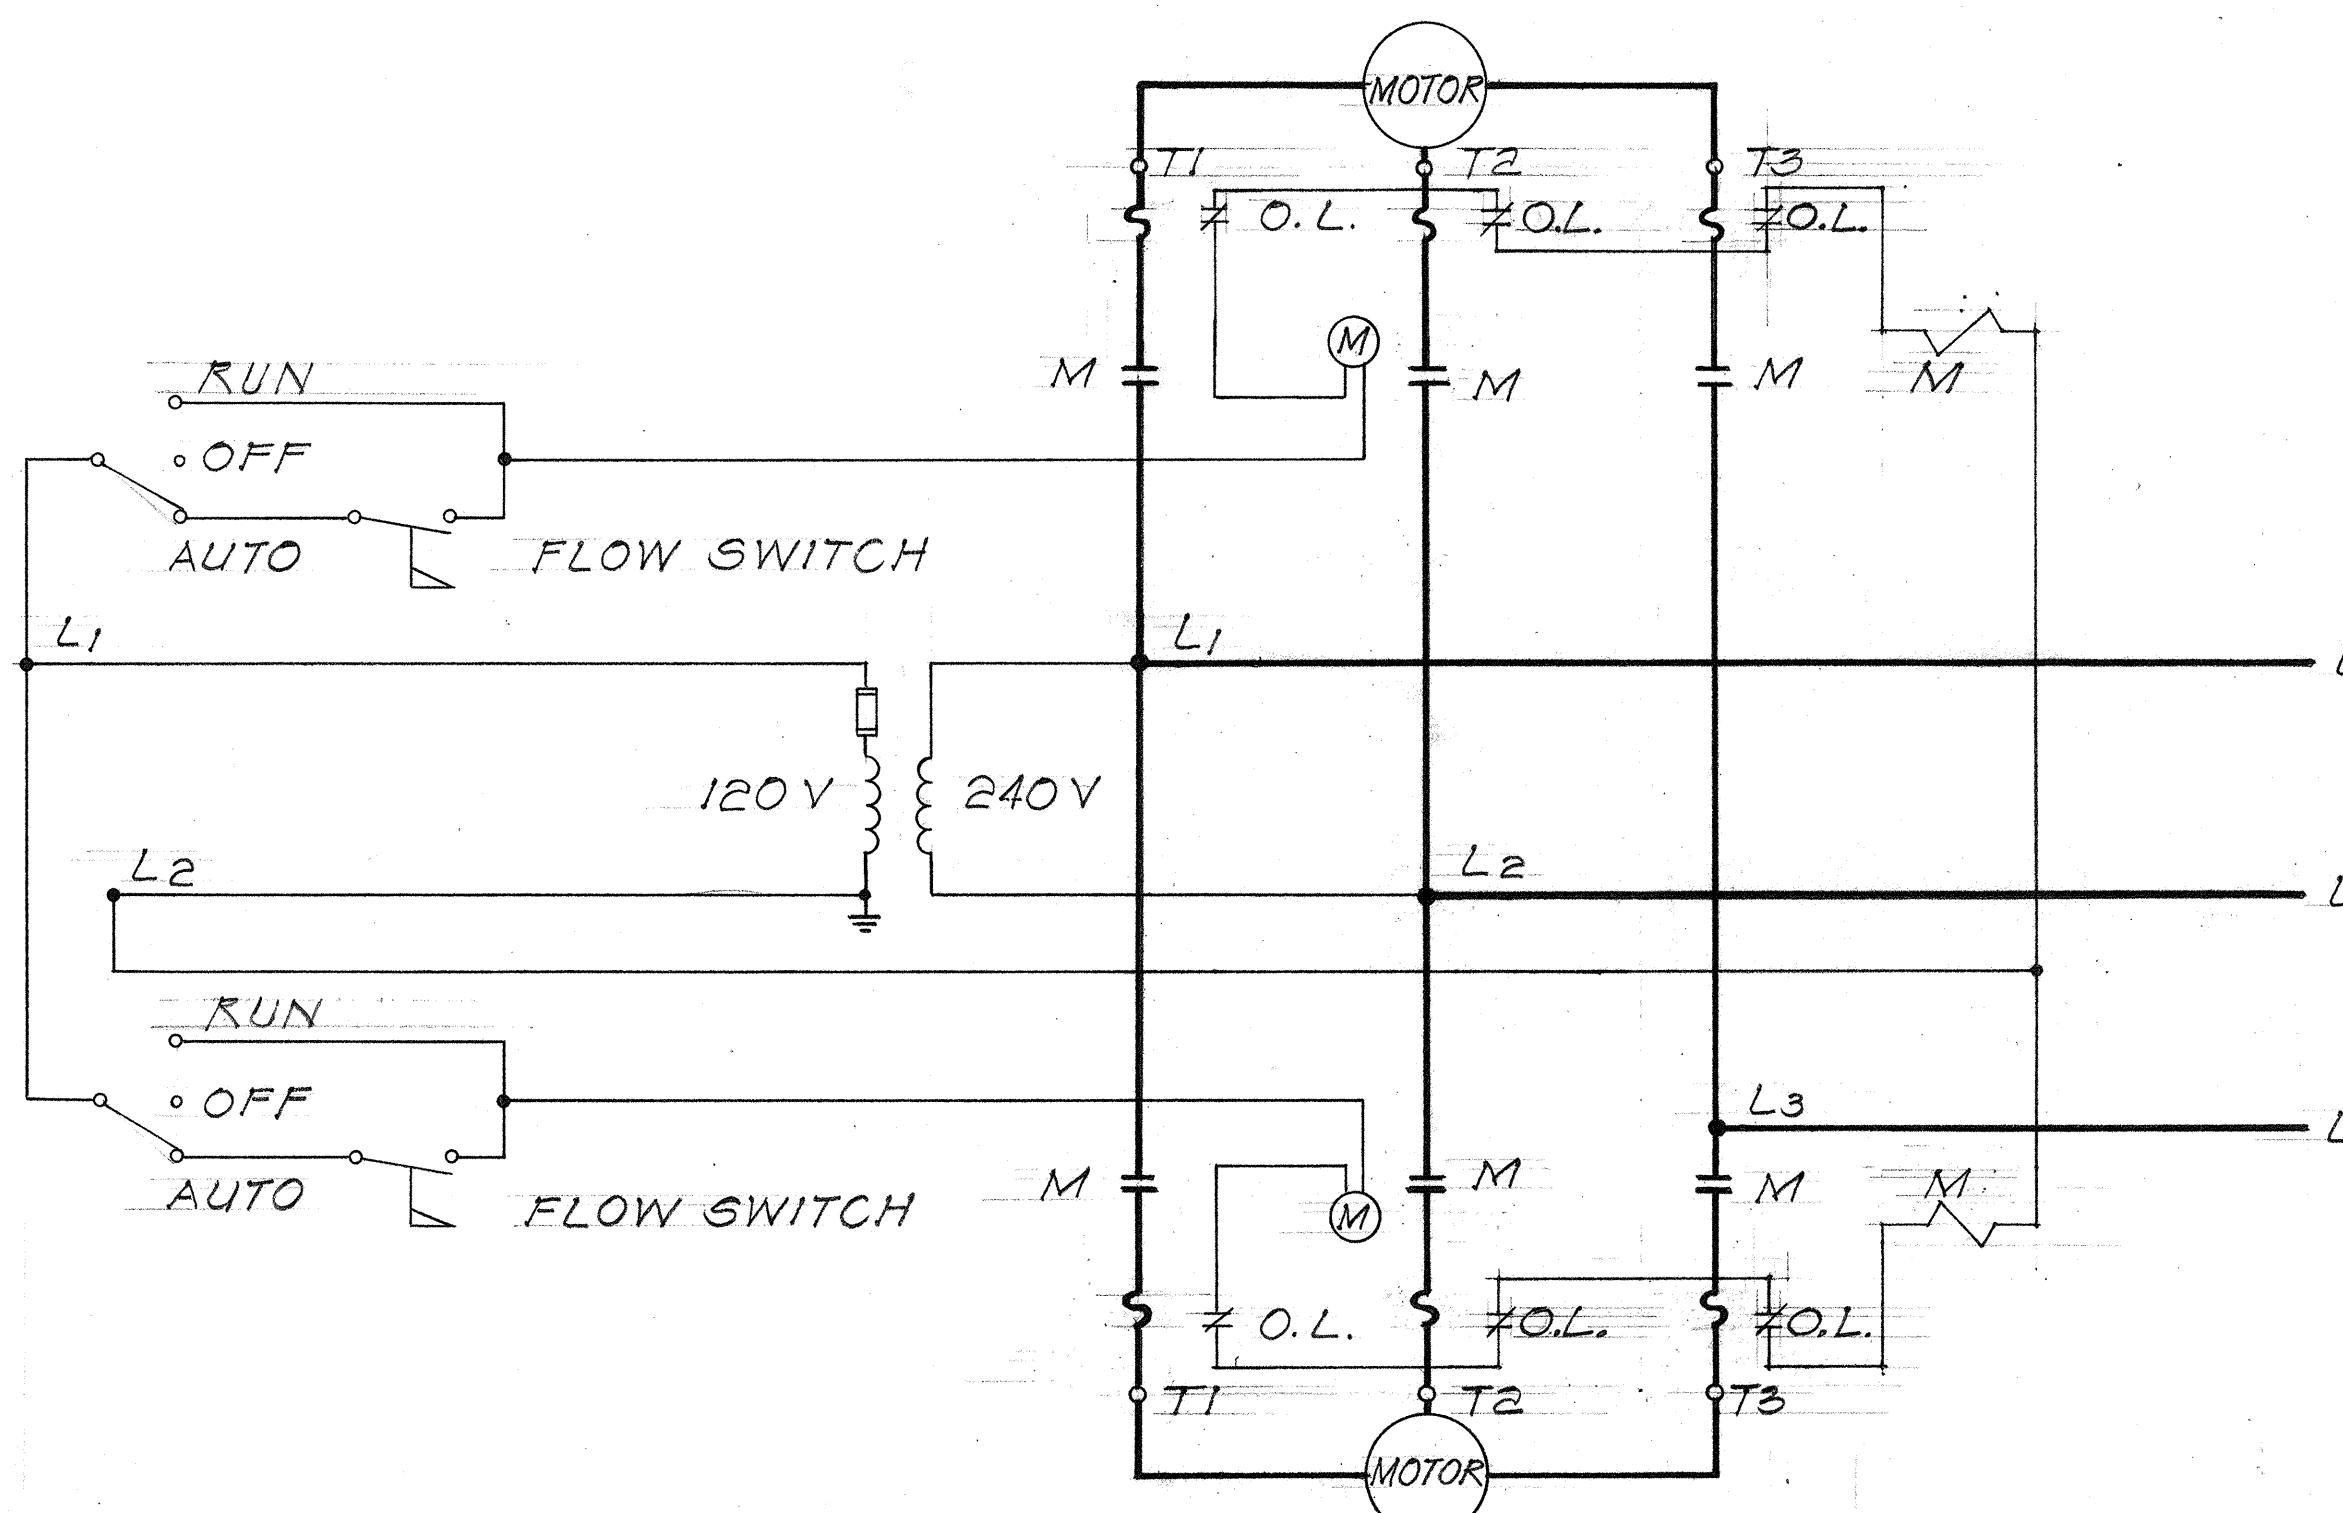

DETAIL 1/10  
CONTROL DIAGRAM FOR PUMPS 1 & 2  
BOOSTER STATION A

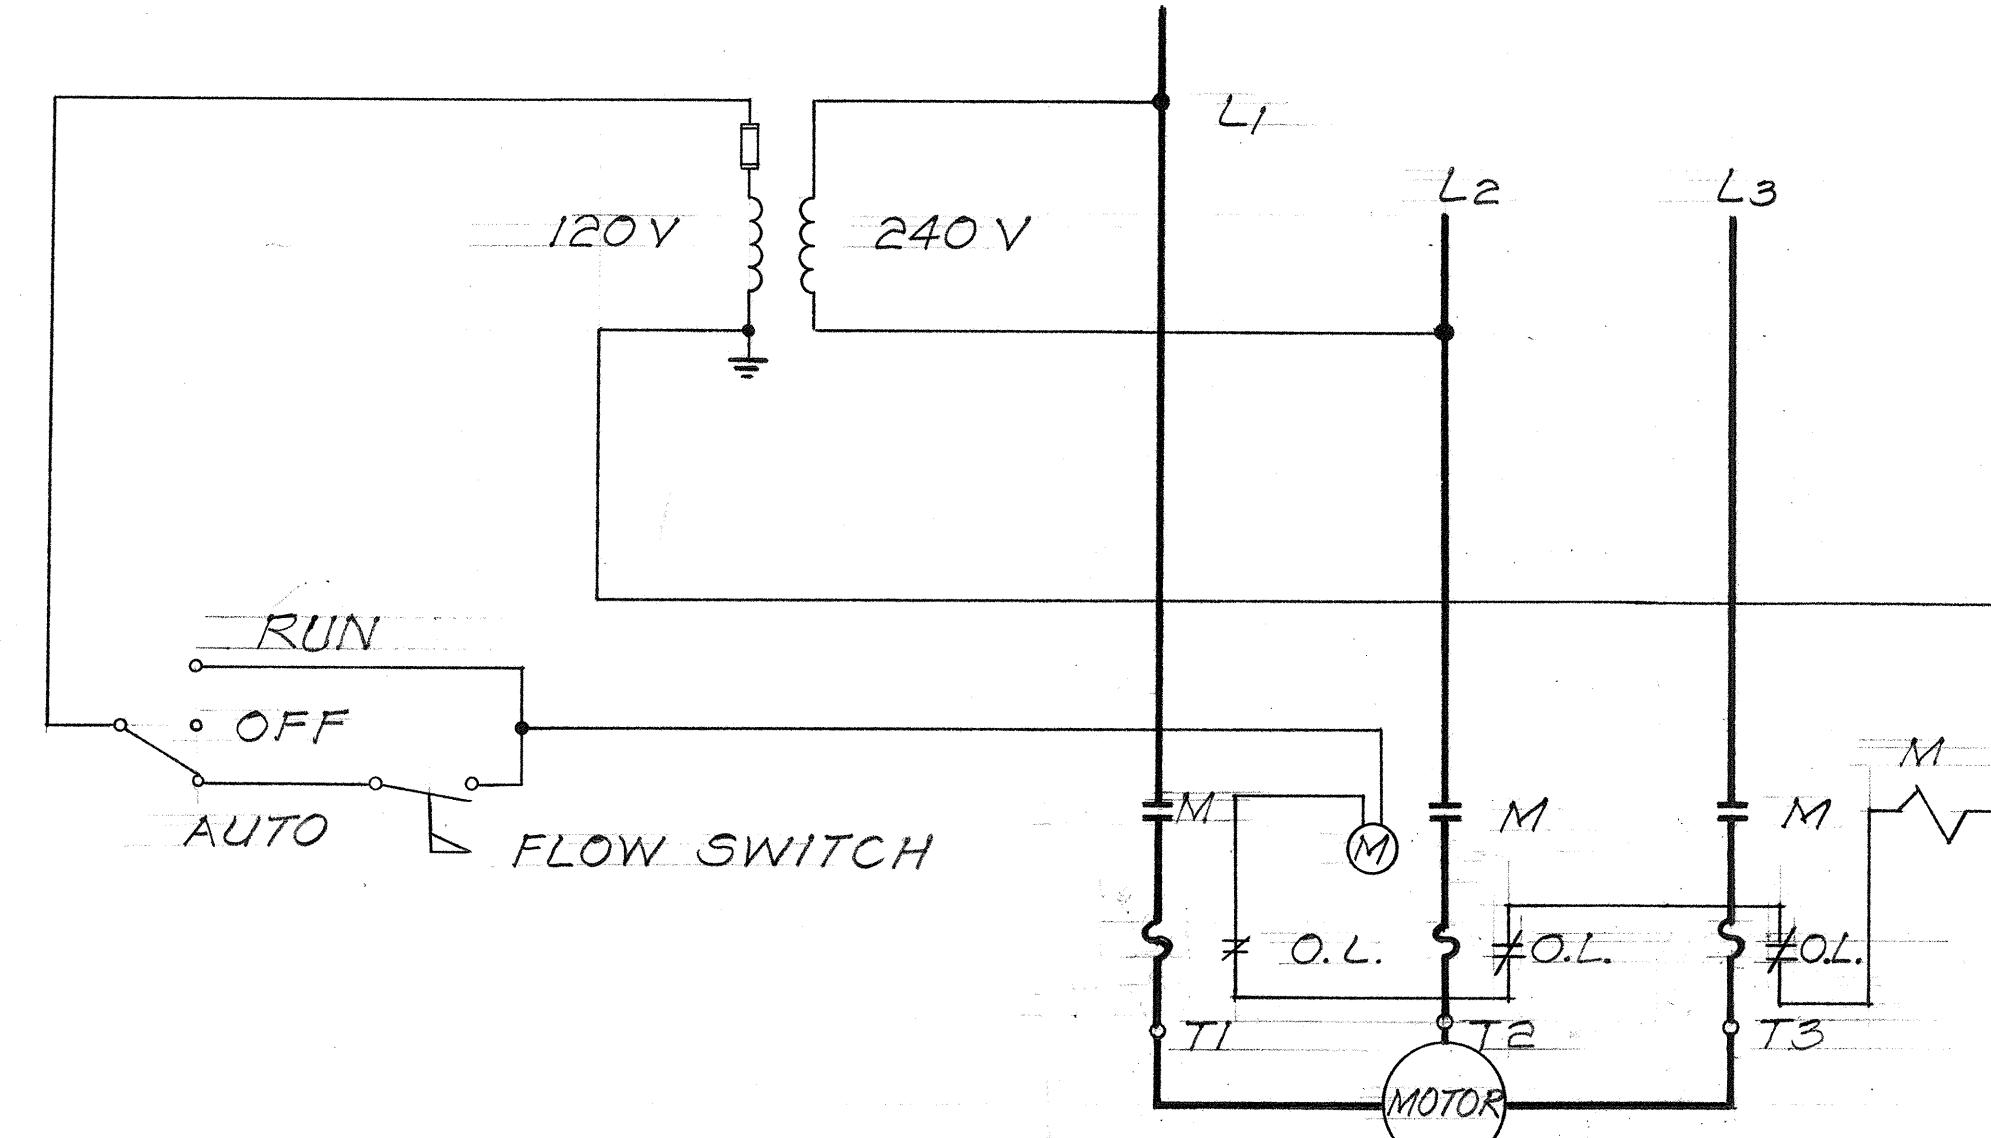






DETAIL 2/10  
CONTROL DIAGRAM FOR PUMPS 3, 4, 5  
BOOSTER STATIONS B, C, D

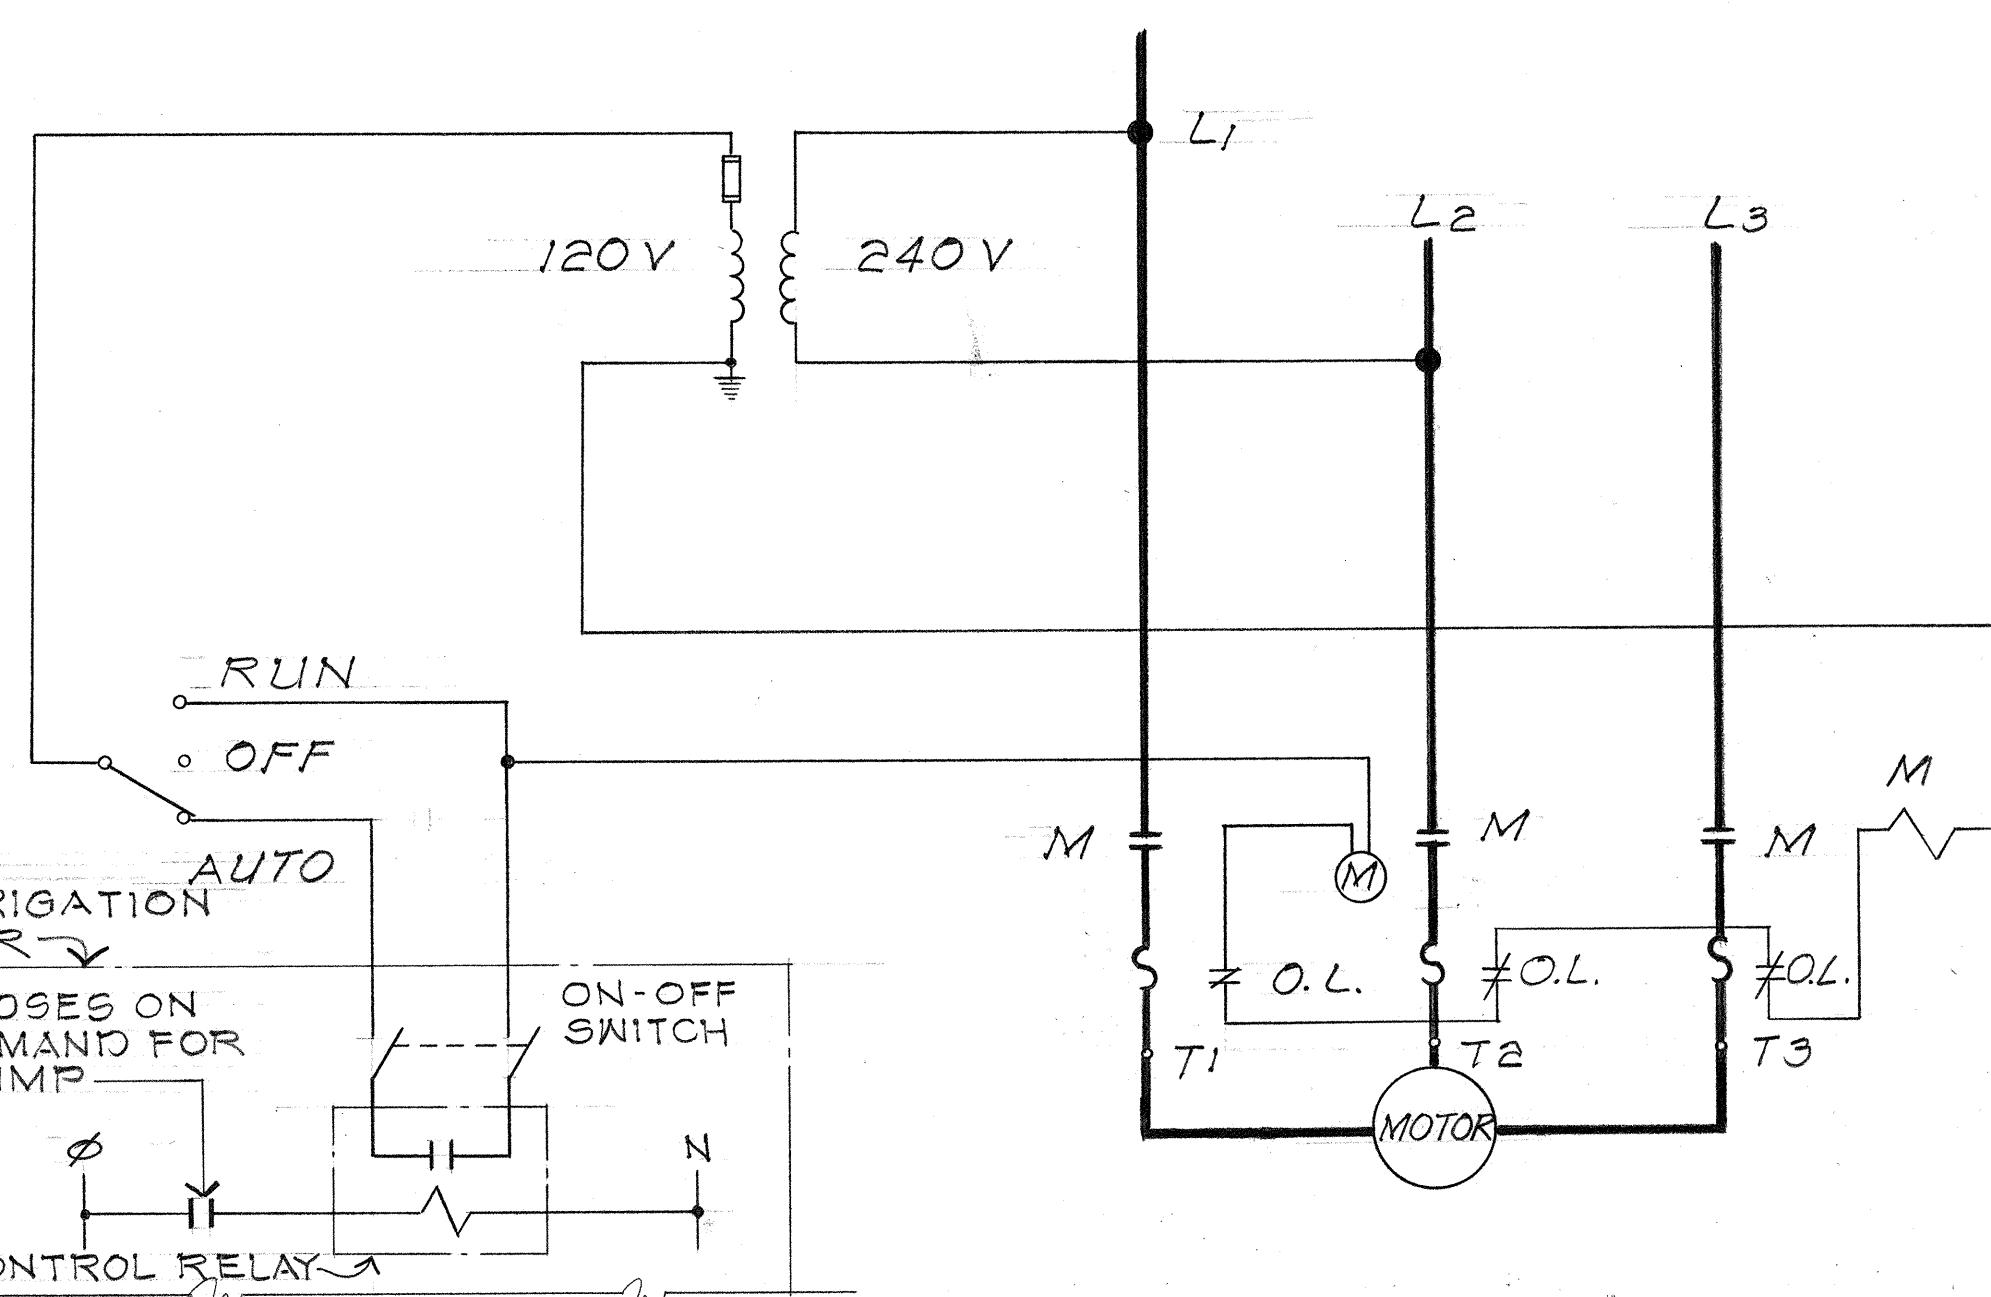



DETAIL 3/10  
BOOSTER PUMP UNIT CONTROL WIRE  
DIAGRAM PUMPS NO. 6 & 7

STATE OF HAWAII  
DEPARTMENT OF TRANSPORTATION  
HIGHWAYS DIVISION  
IRRIGATION SYSTEM  
PUMP CONTROL DIAGRAMS  
INTERSTATE ROUTE H-1  
PROJ. NO. I-HI-1(02)-13  
Date: Mar 1976  
SHEET NO. 3/10 OF 32 SHEETS

FED. ROAD DIST. NO.	STATE	FED. AID PROJ. NO.	FISCAL YEAR	SHEET NO.	TOTAL SHEETS
HAWAII	HAW.	I-HI-1(92):13	1976	38	50

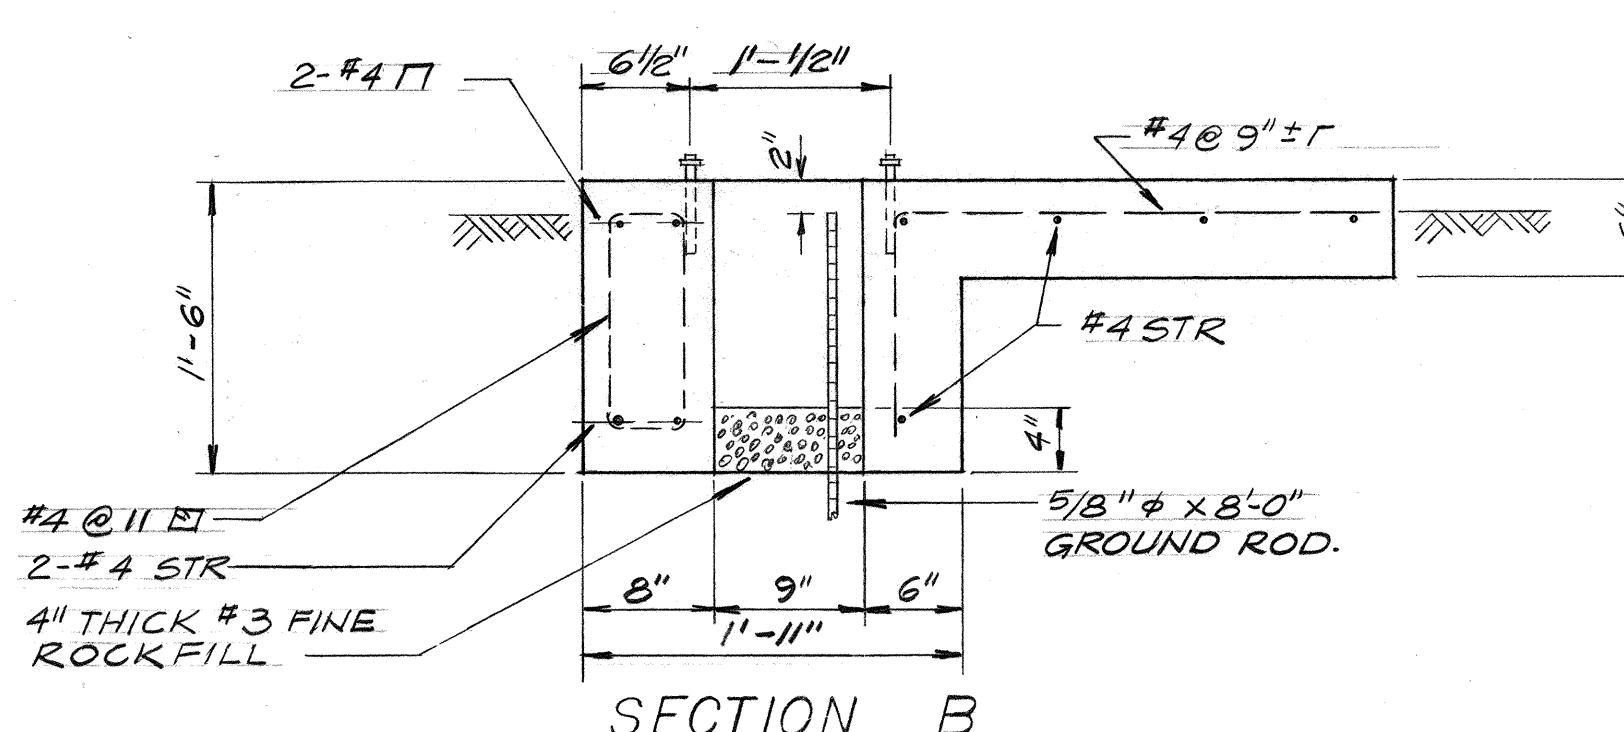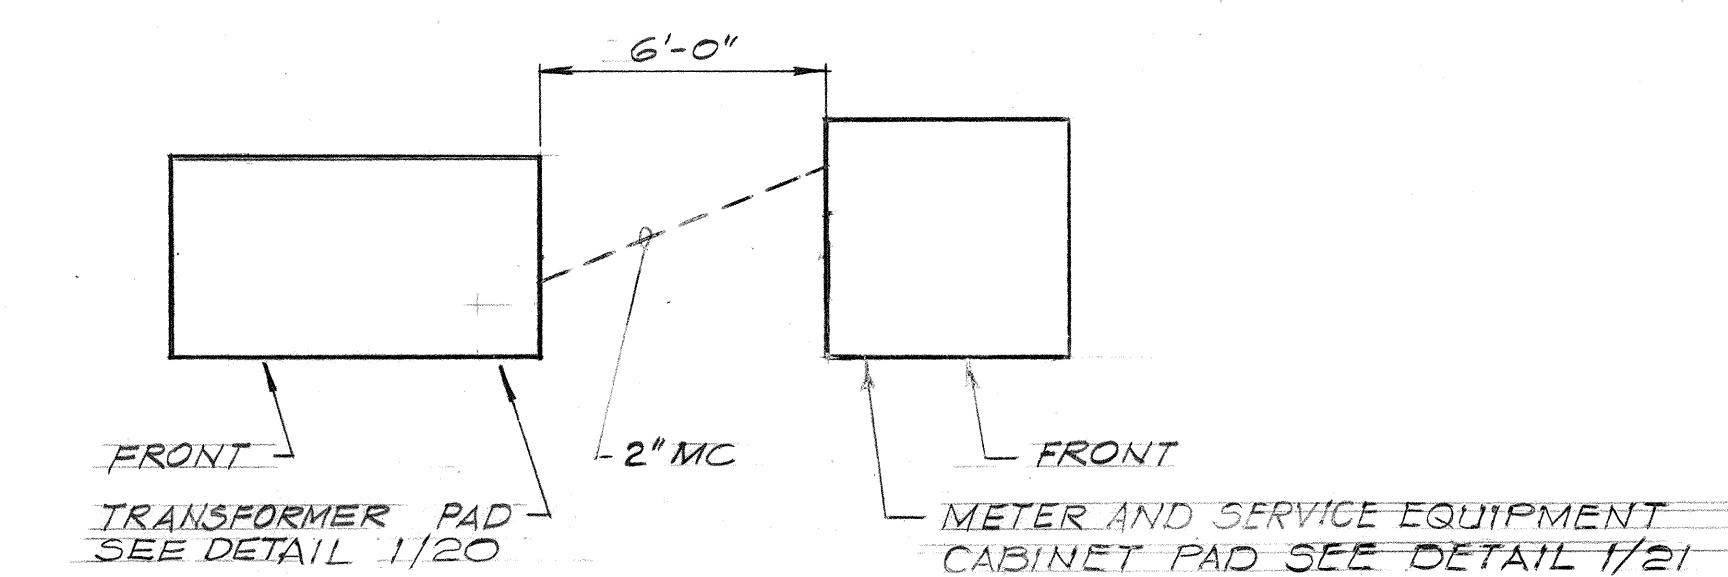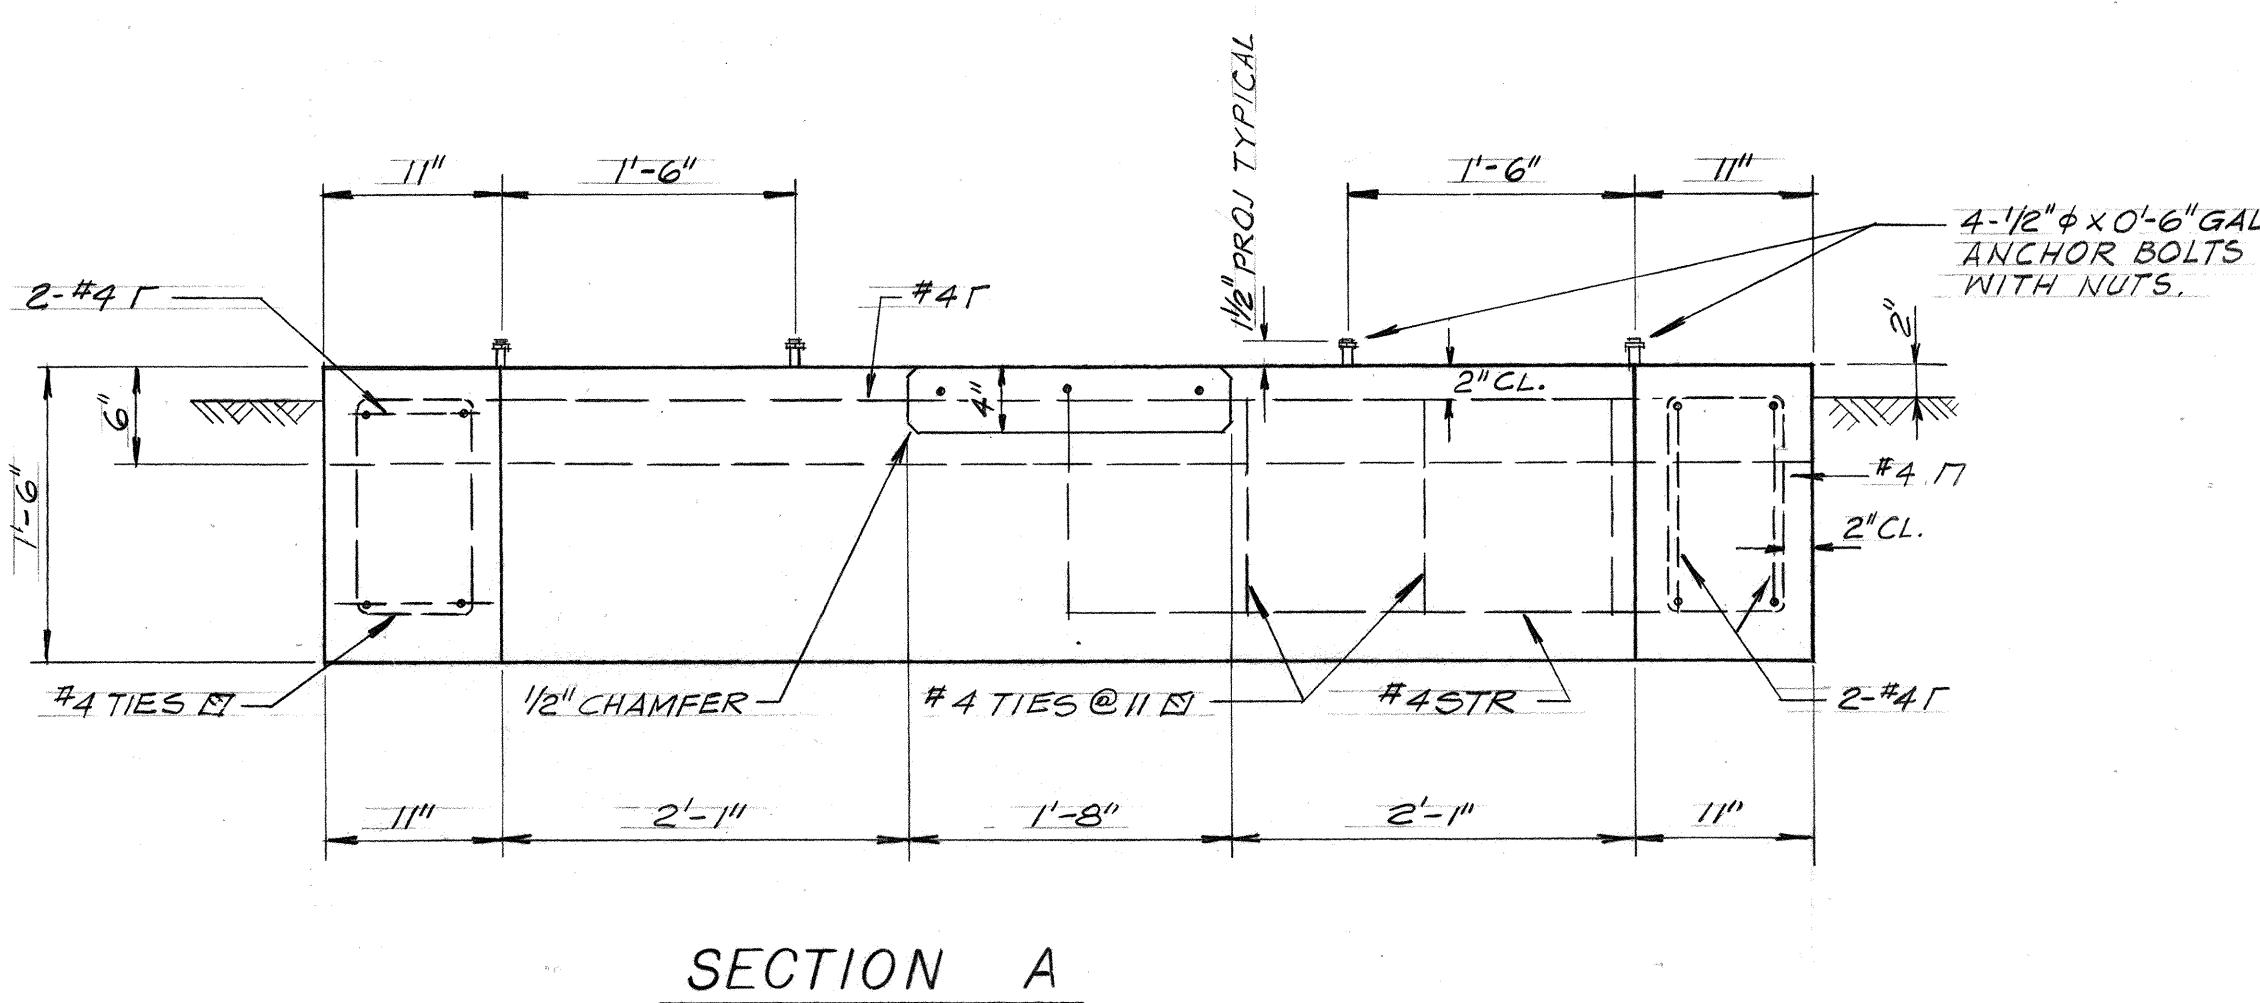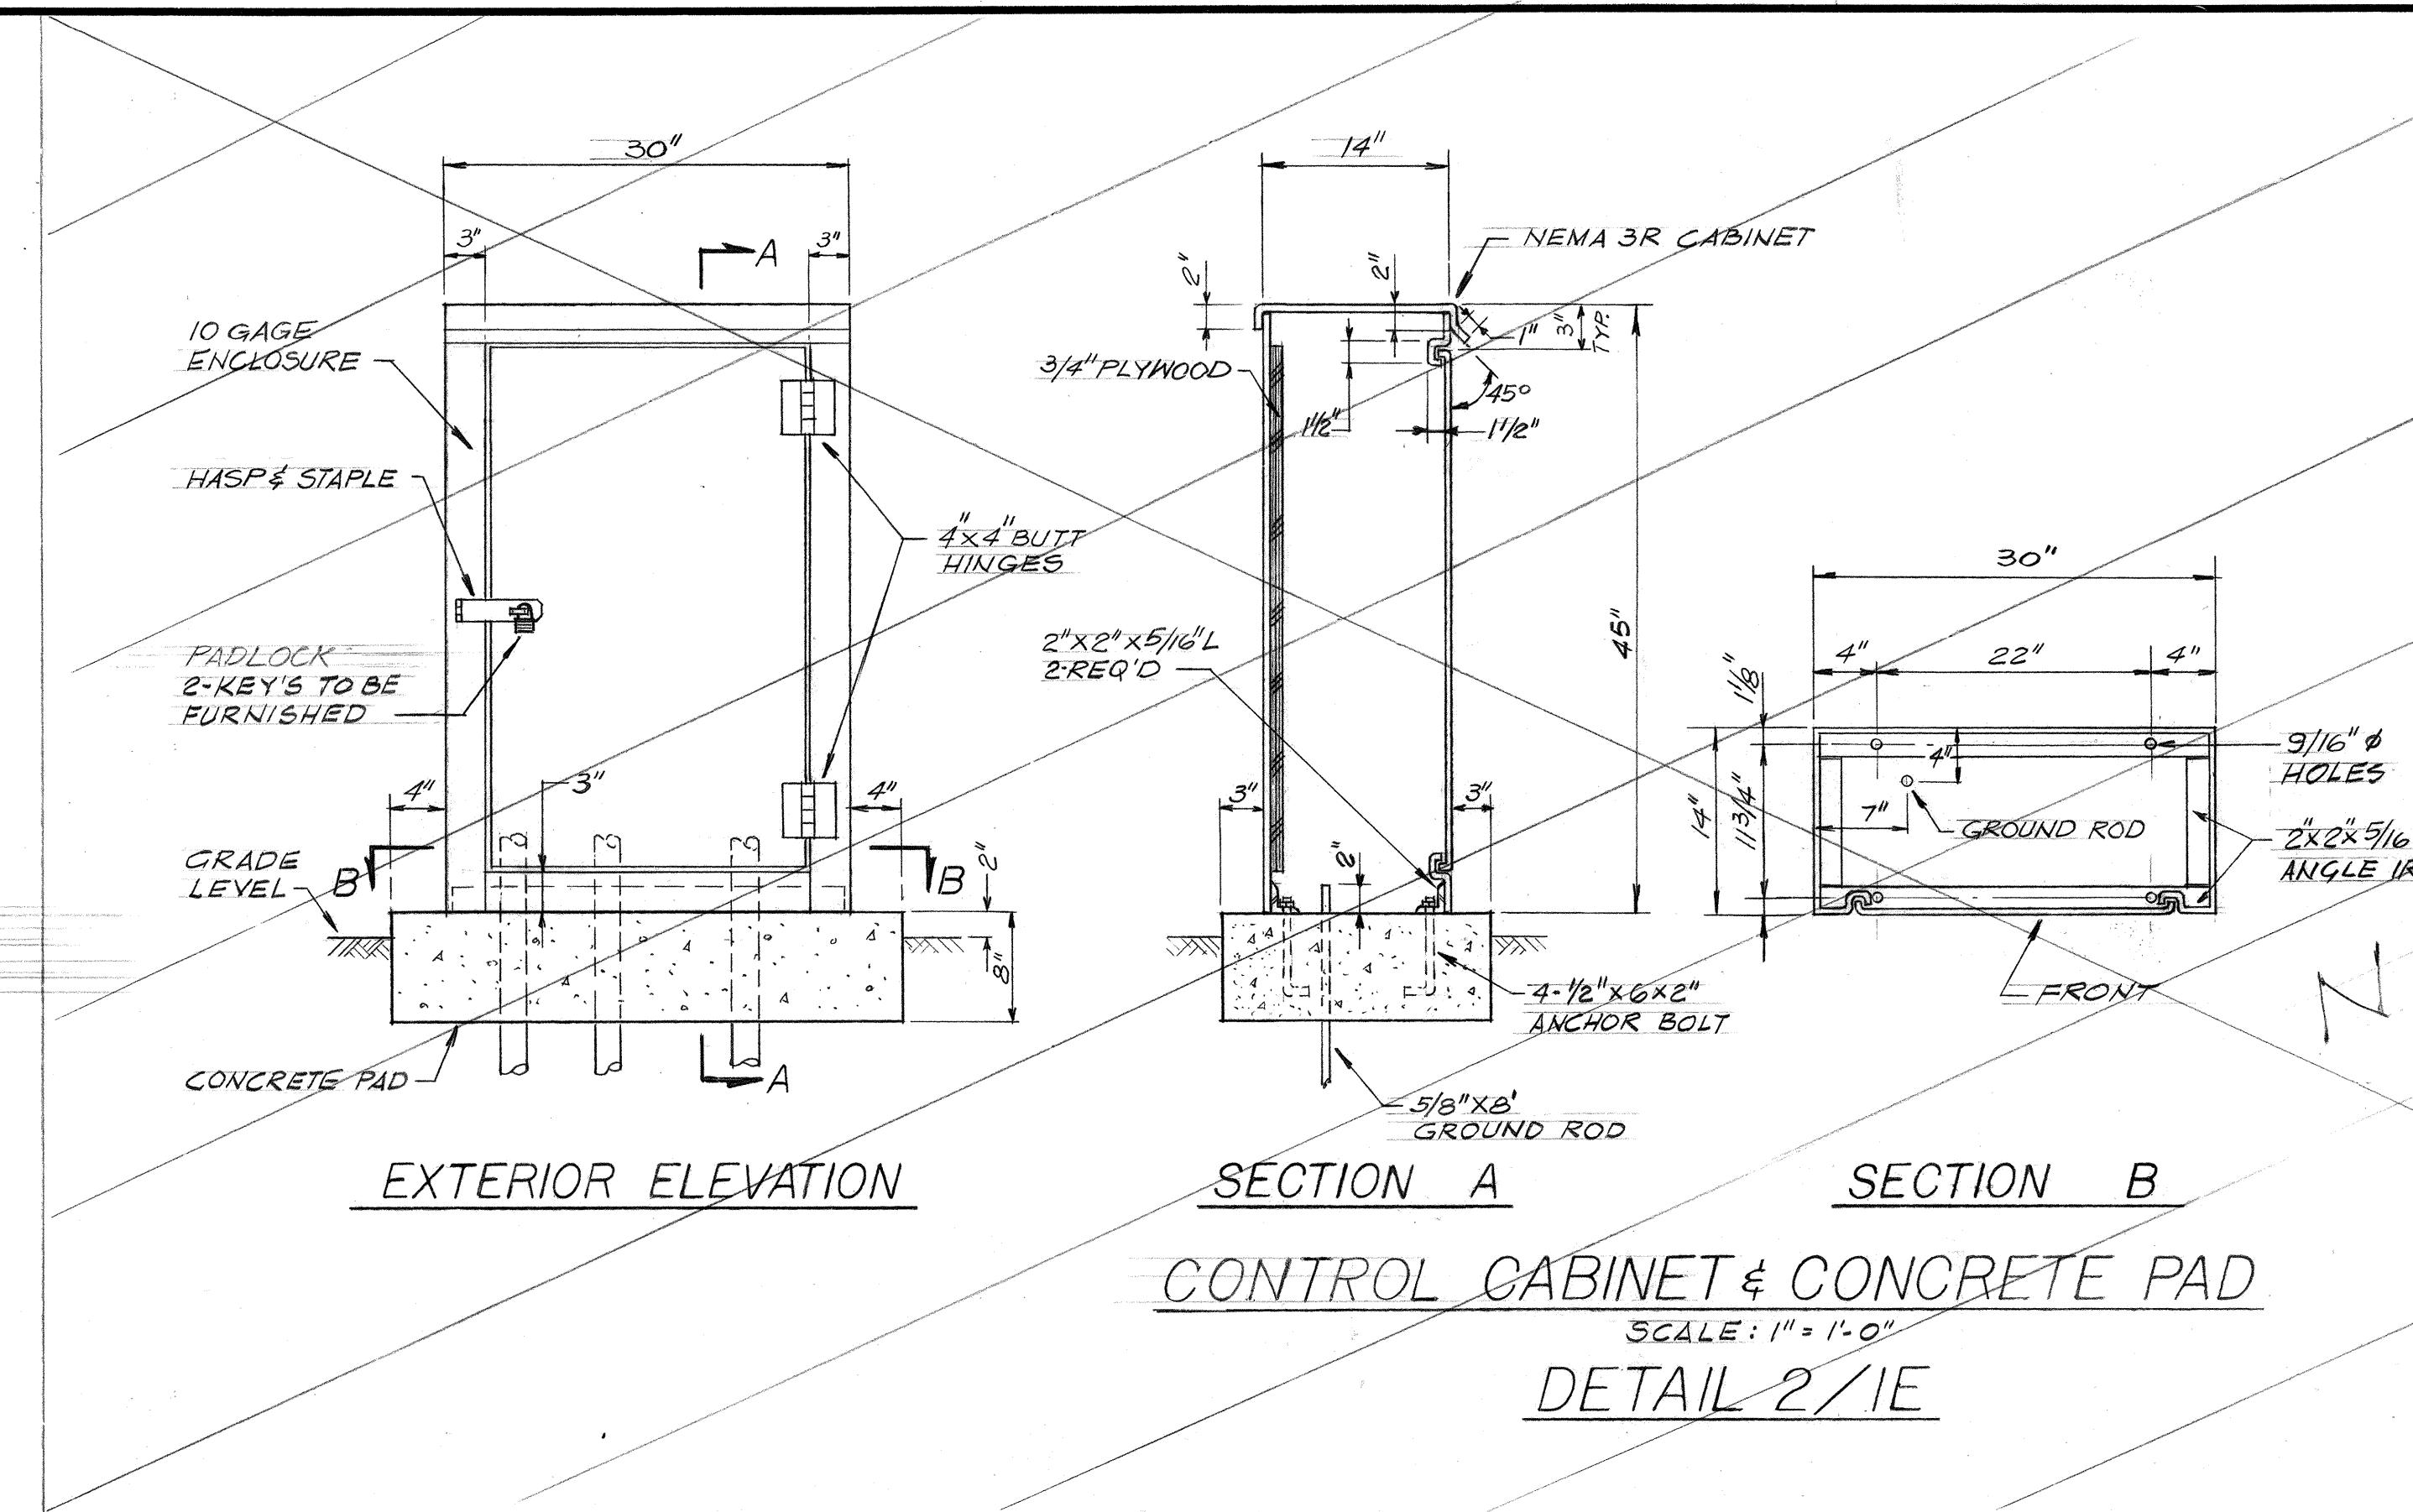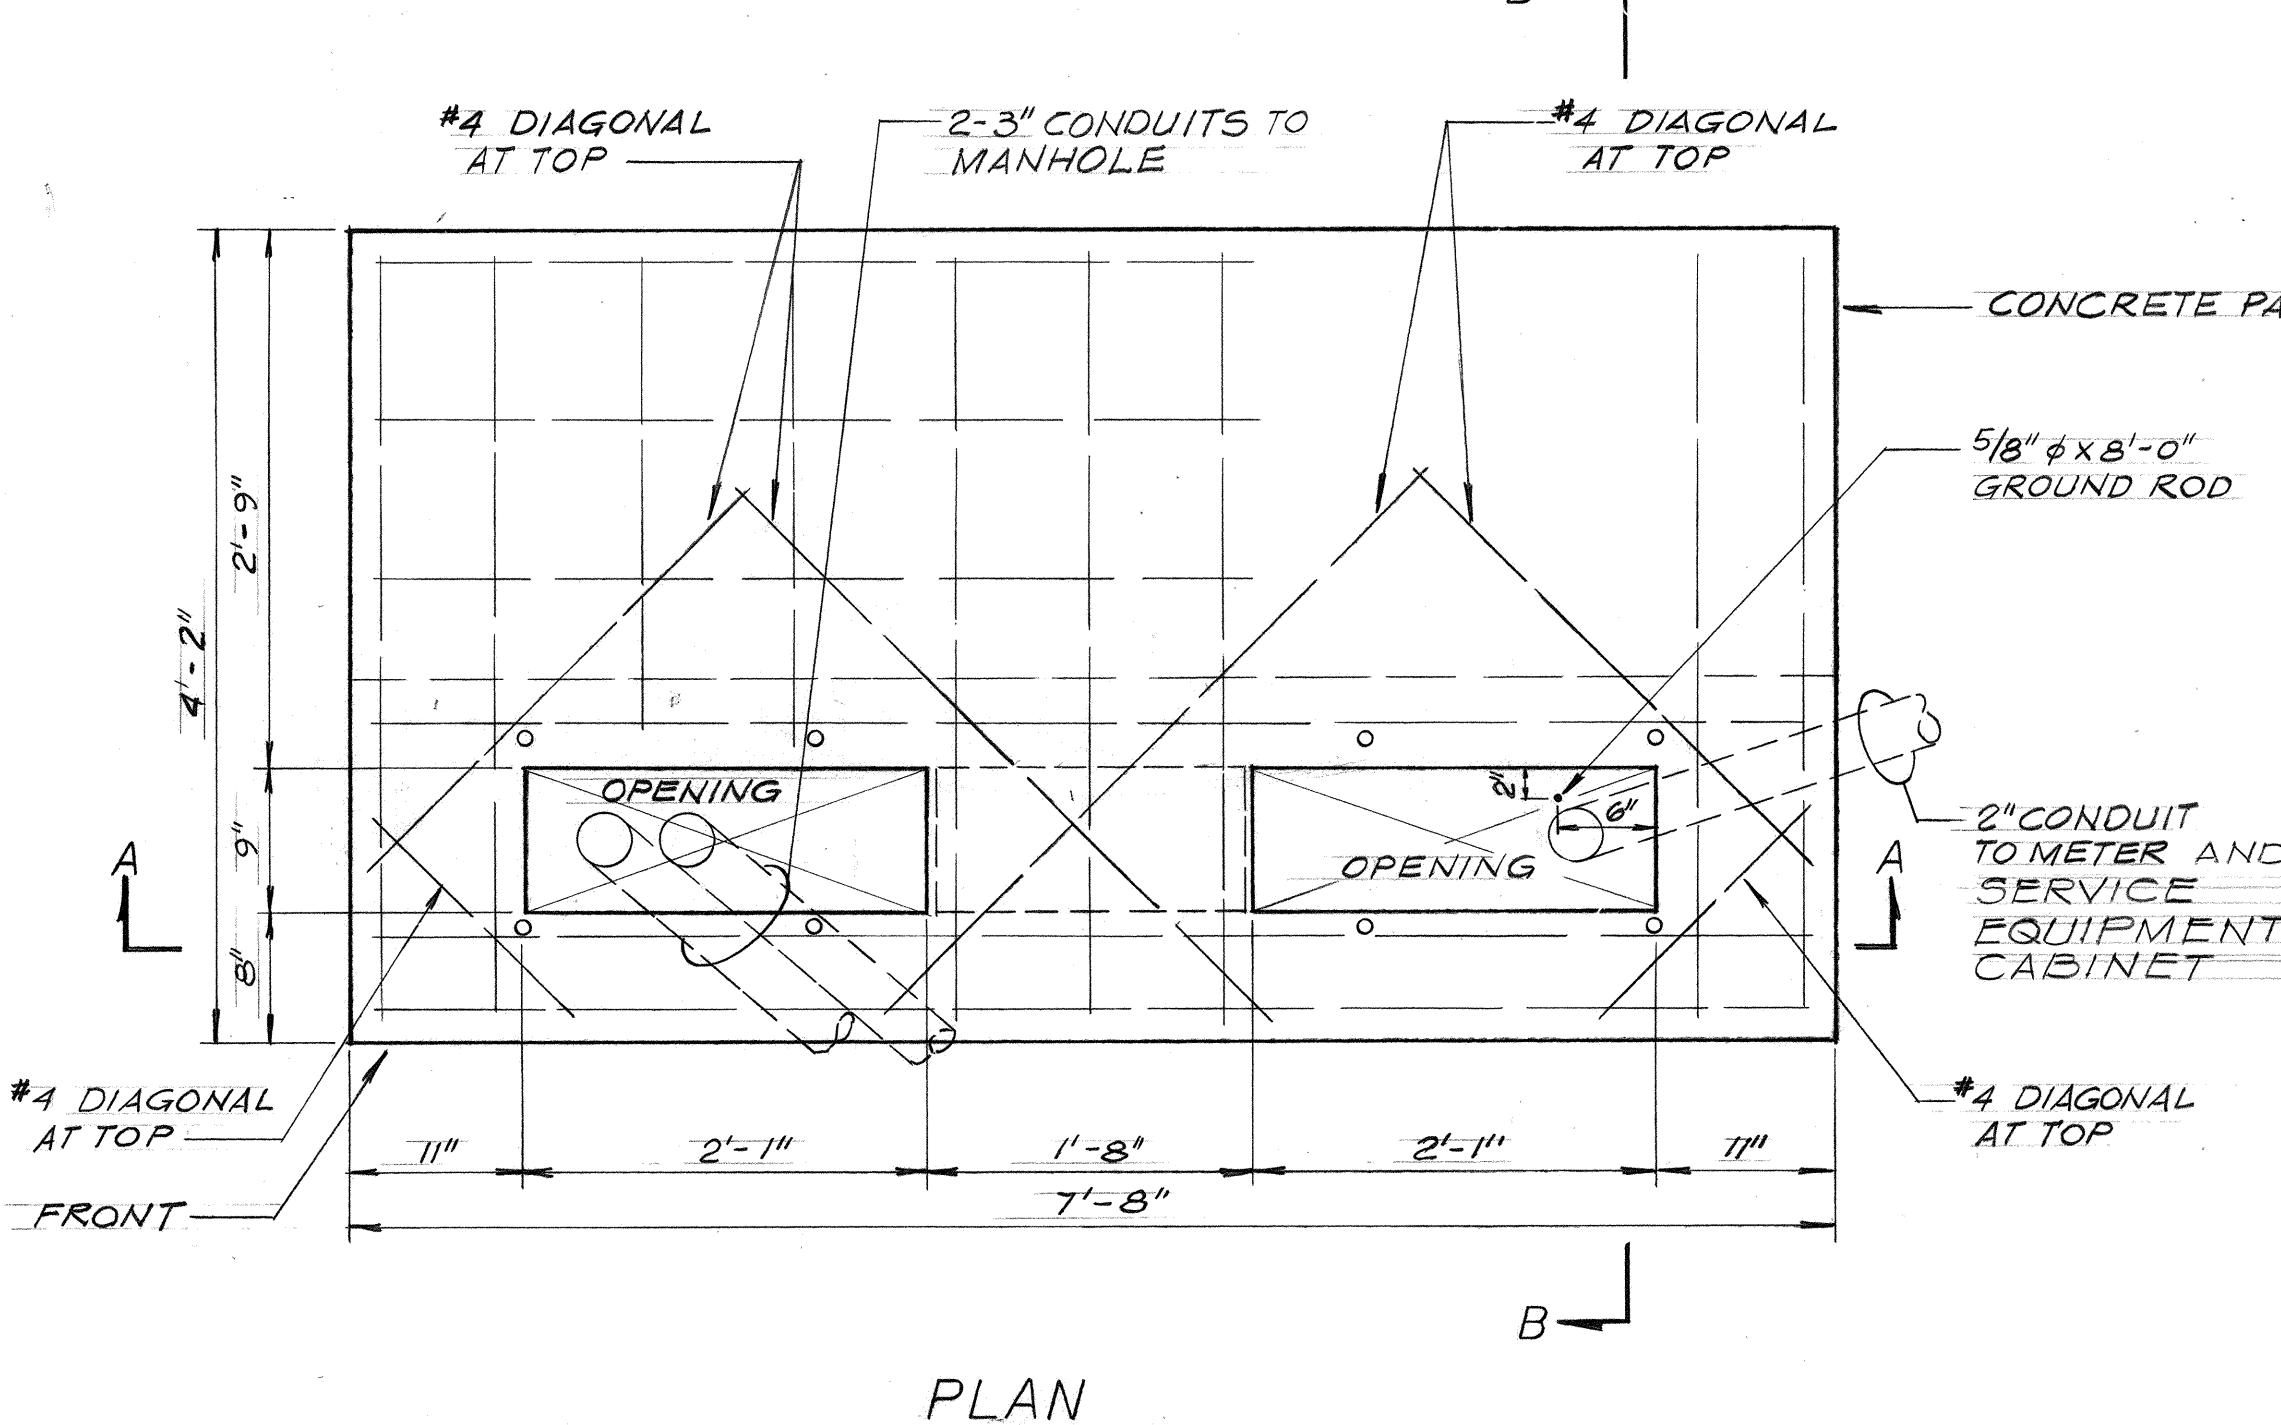


TRANSFORMER PAD  
SCALE: 1" = 1'-0"  
DETAIL 1/20

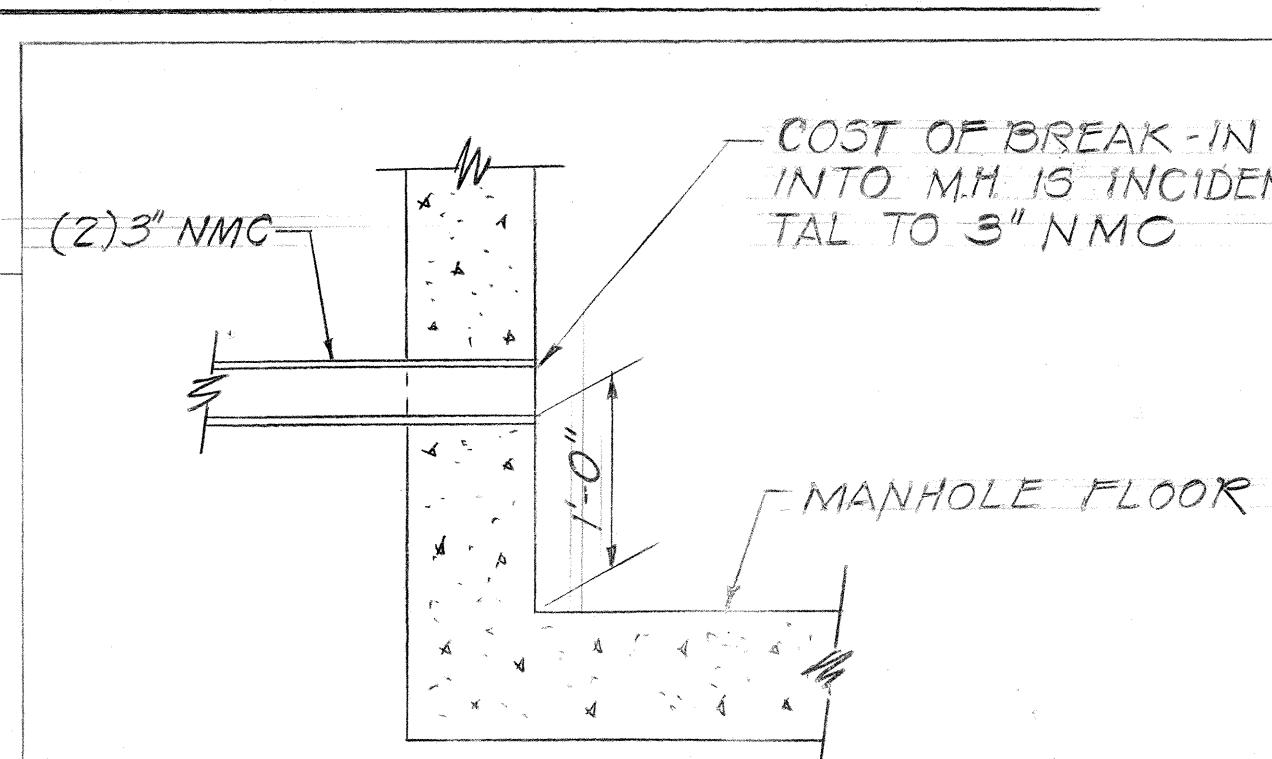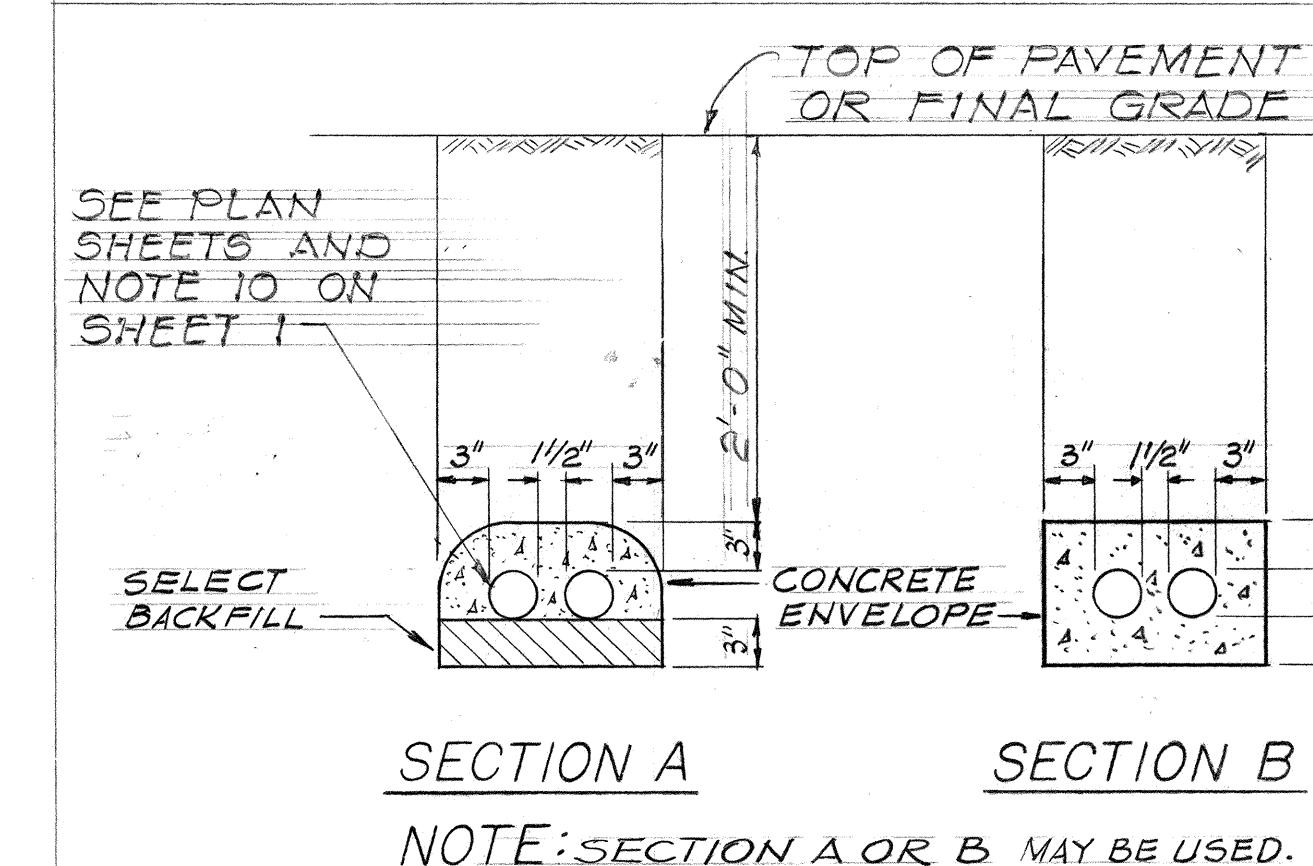

STATE OF HAWAII  
DEPARTMENT OF TRANSPORTATION  
HIGHWAYS DIVISION  
IRRIGATION SYSTEM  
ELECTRICAL DETAILS  
INTERSTATE ROUTE H-1  
PROJ. NO. I-HI-1(92):13  
Scale: As Shown Date: Mar 1976  
SHEET No. 1-200 of 32 SHEETS

ORIGINAL SURVEY PLOTTED BY \_\_\_\_\_  
DATE: \_\_\_\_\_  
DRAWN BY \_\_\_\_\_  
DESIGNED BY \_\_\_\_\_  
QUANTITIES BY \_\_\_\_\_  
CHECKED BY \_\_\_\_\_  
No. \_\_\_\_\_

FED. ROAD DIST. NO.	STATE	FED. AID PROJ. NO.	FISCAL YEAR	SHEET NO.	TOTAL SHEETS
HAWAII	HAW.	I-HI-1(02):13	1976	59	50

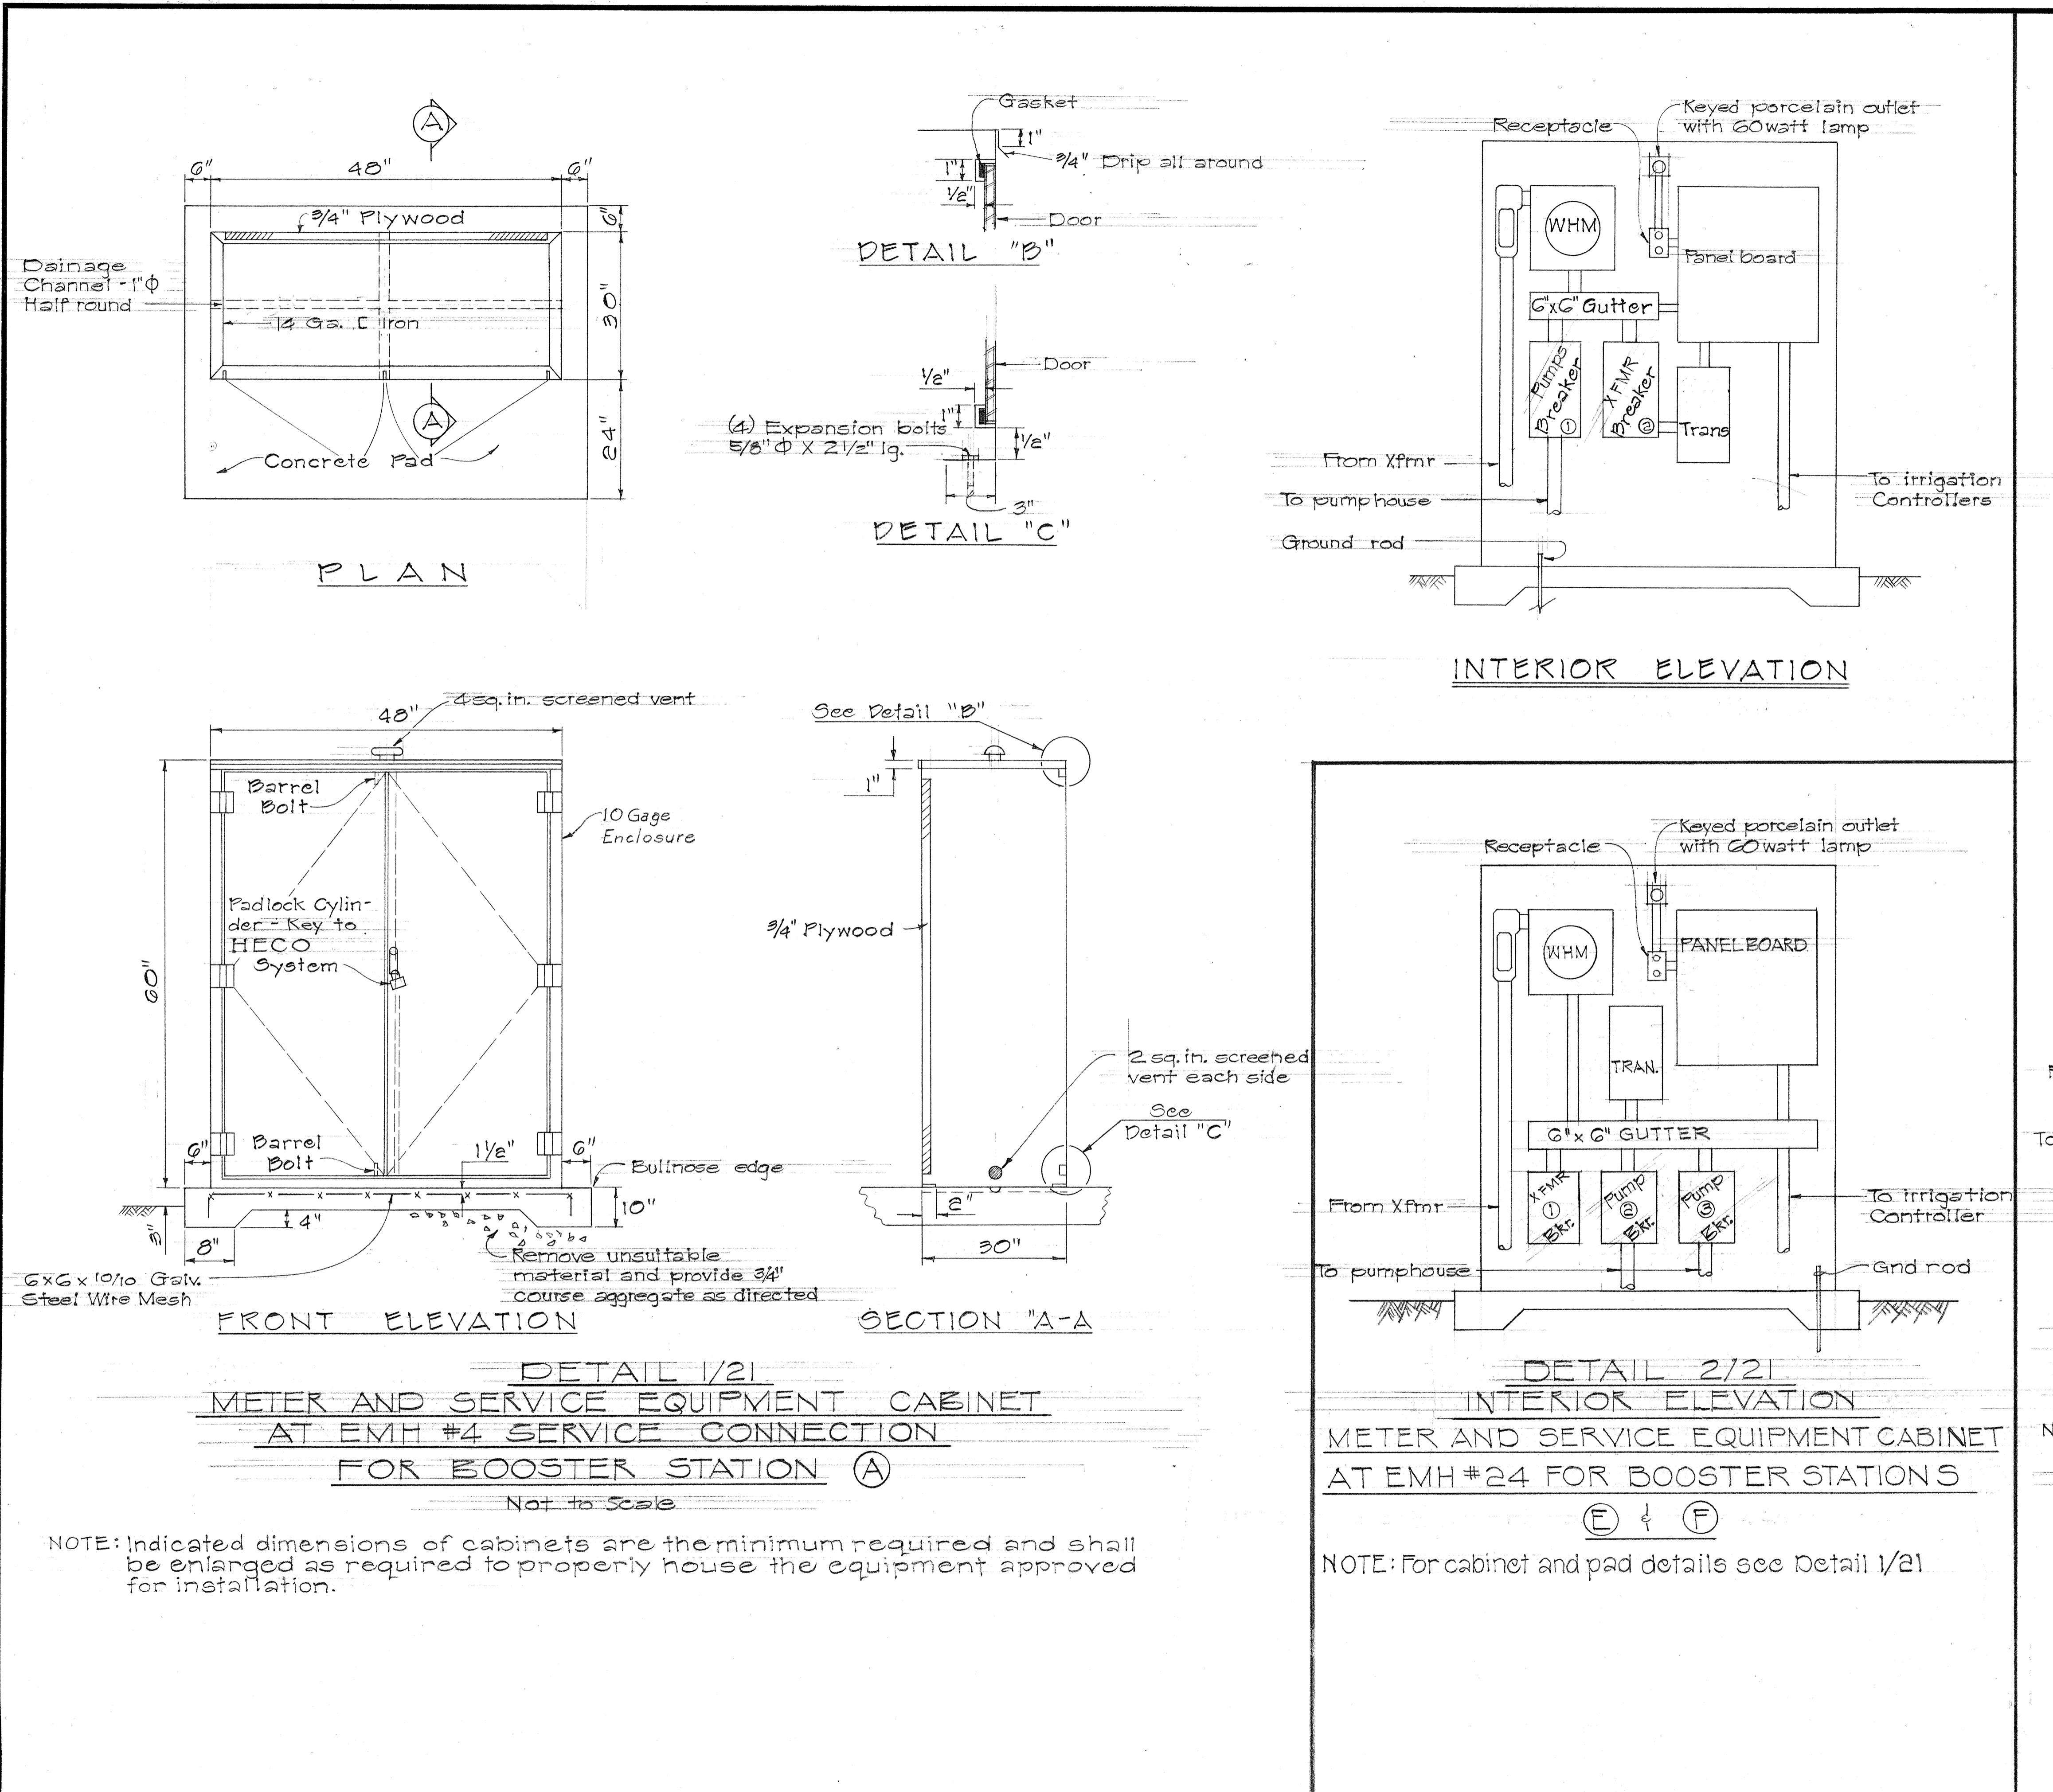


ORIGINAL SURVEY PLOTTED BY \_\_\_\_\_  
DRAWN BY \_\_\_\_\_  
TRACED BY \_\_\_\_\_  
DESIGNED BY \_\_\_\_\_  
QUANTITY BOOK CHECKED BY \_\_\_\_\_  
No. \_\_\_\_\_

NOTE: Indicated dimensions of cabinets are the minimum required and shall be enlarged as required to properly house the equipment approved for installation.


Not to Scale

STATE OF HAWAII  
DEPARTMENT OF TRANSPORTATION  
HIGHWAYS DIVISION  
IRRIGATION SYSTEM  
ELECTRICAL DETAILS  
INTERSTATE ROUTE H-1  
PROJ. NO. I-HI-1(02):13  
Not to Scale Date: Mar. 1976  
SHEET NO. 121 OF 32 SHEETS

FED. ROAD DIST. NO.	STATE	FED. AID PROJ. NO.	FISCAL YEAR	SHEET NO.	TOTAL SHEETS
HAWAII	HAW.	IHH(02)13	1970	40	50

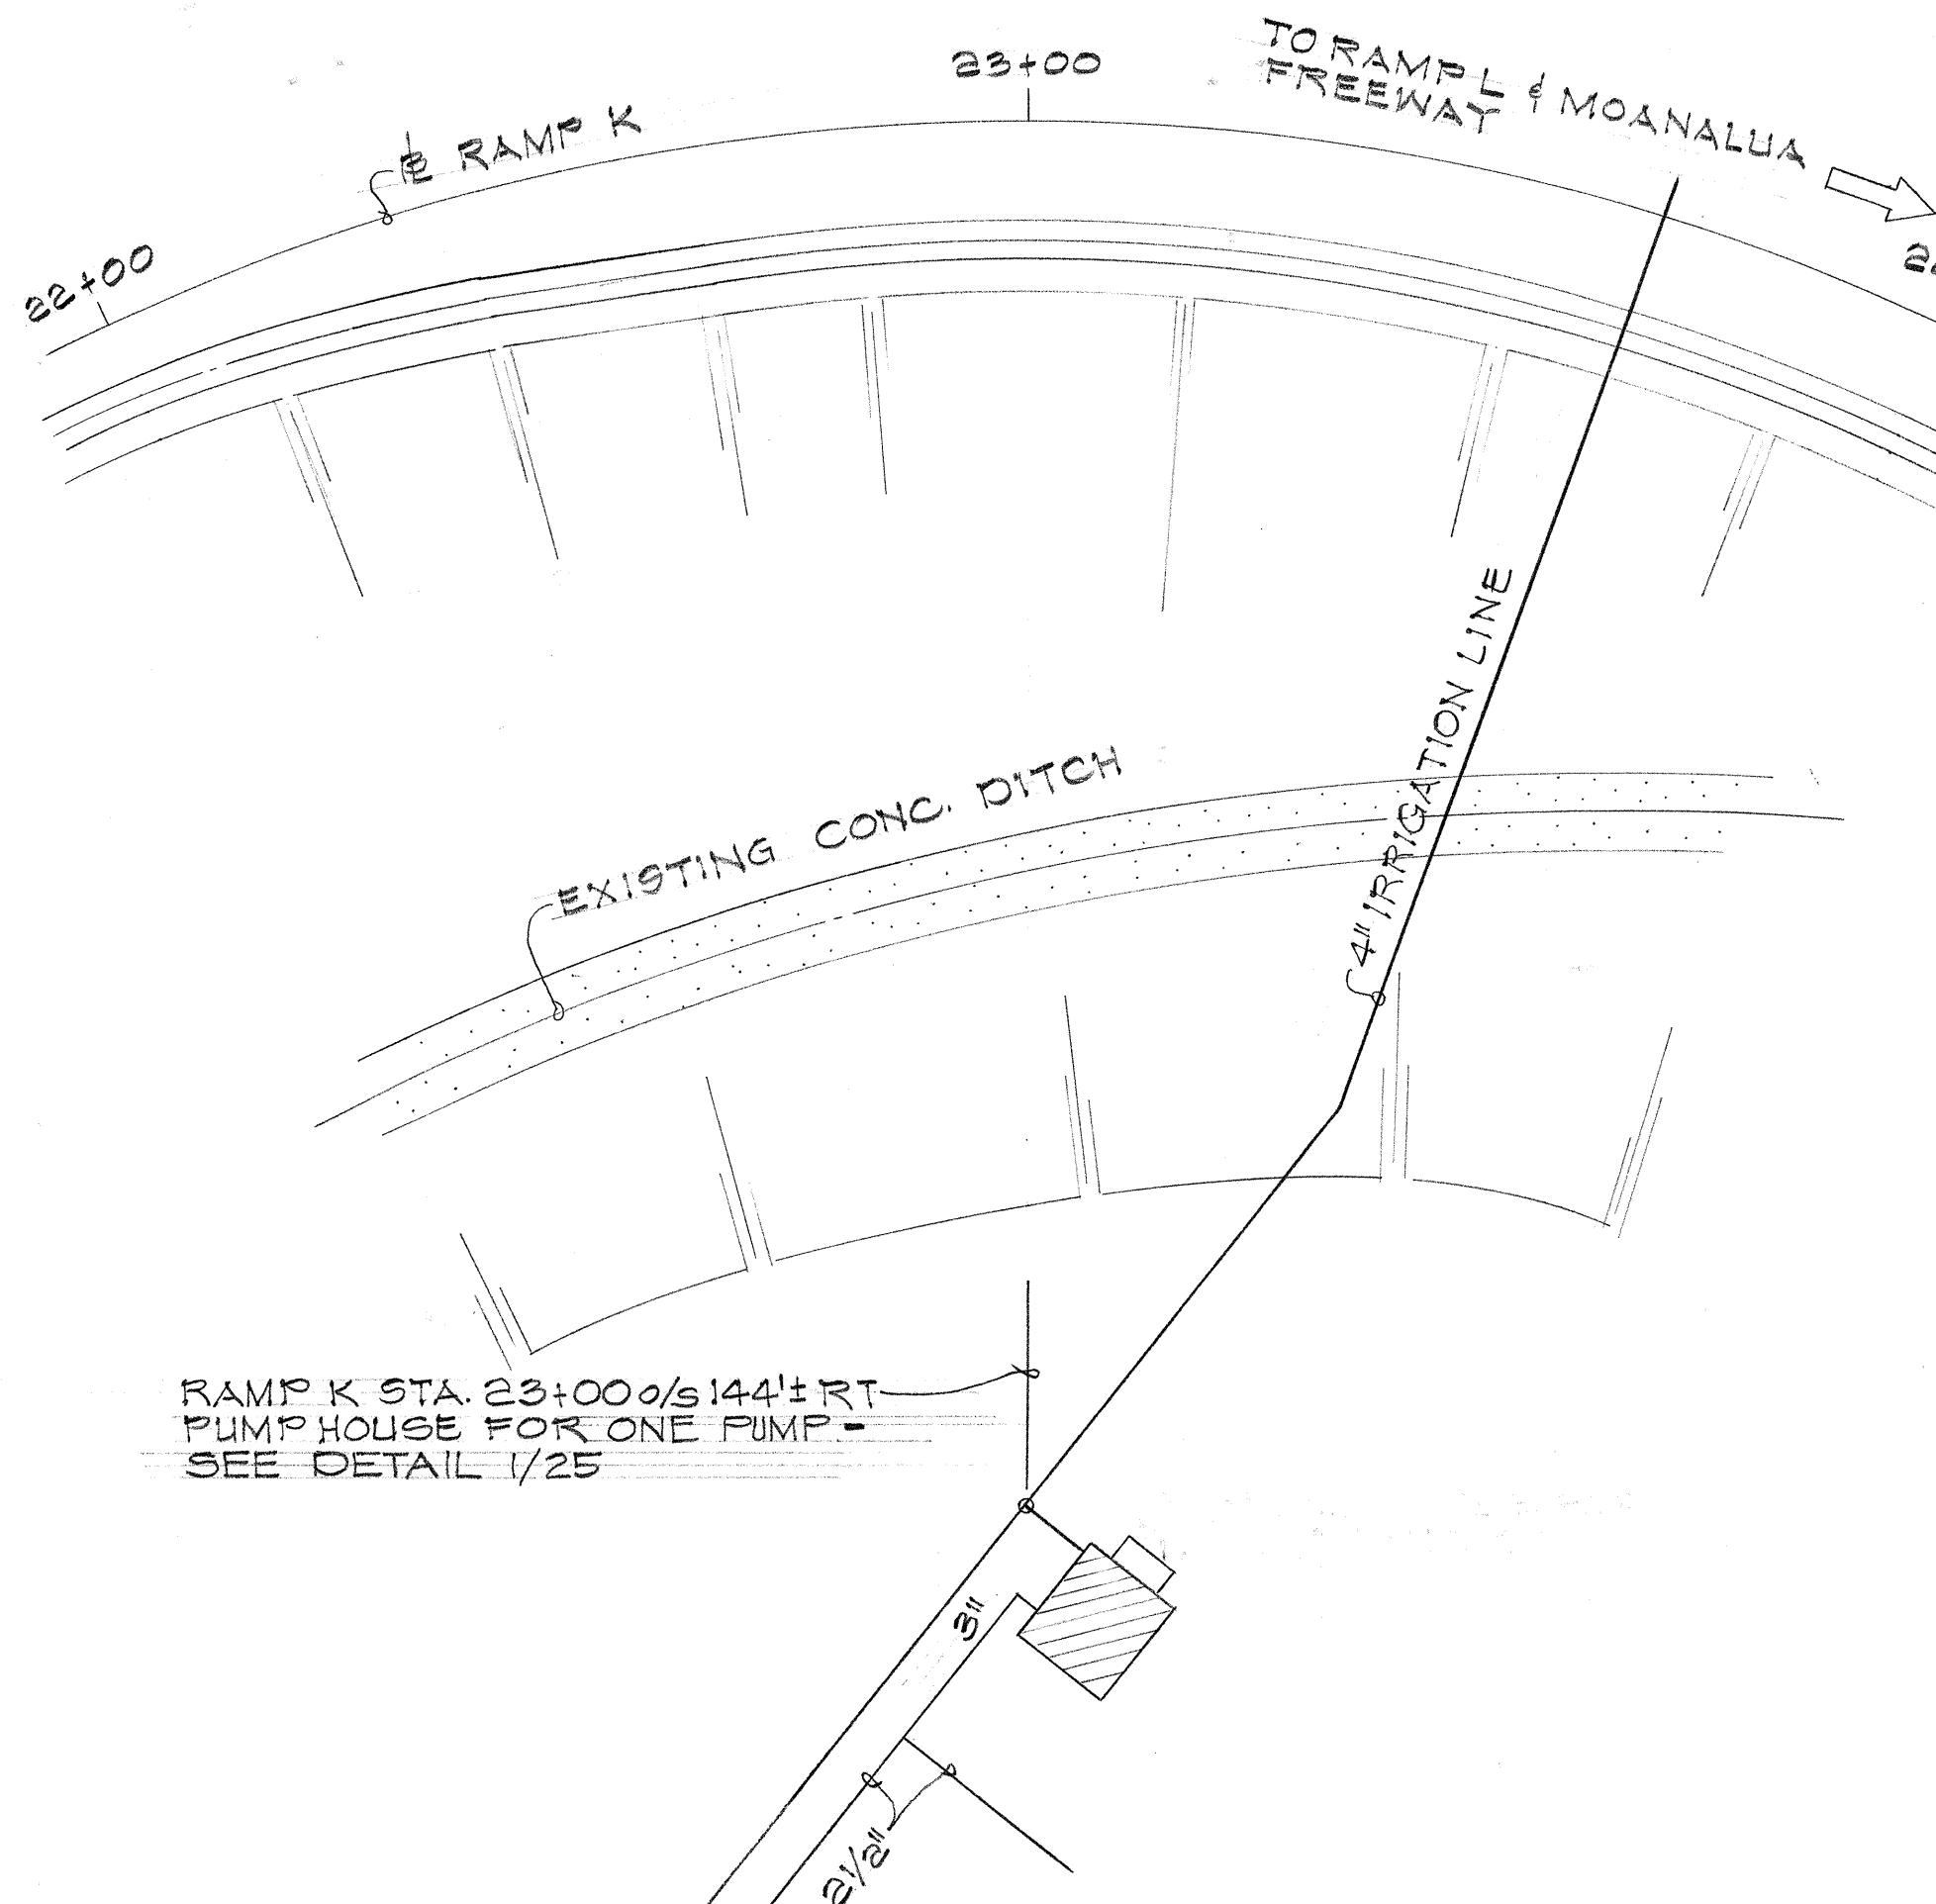

DETAIL 1/22  
BOOSTER STATION C

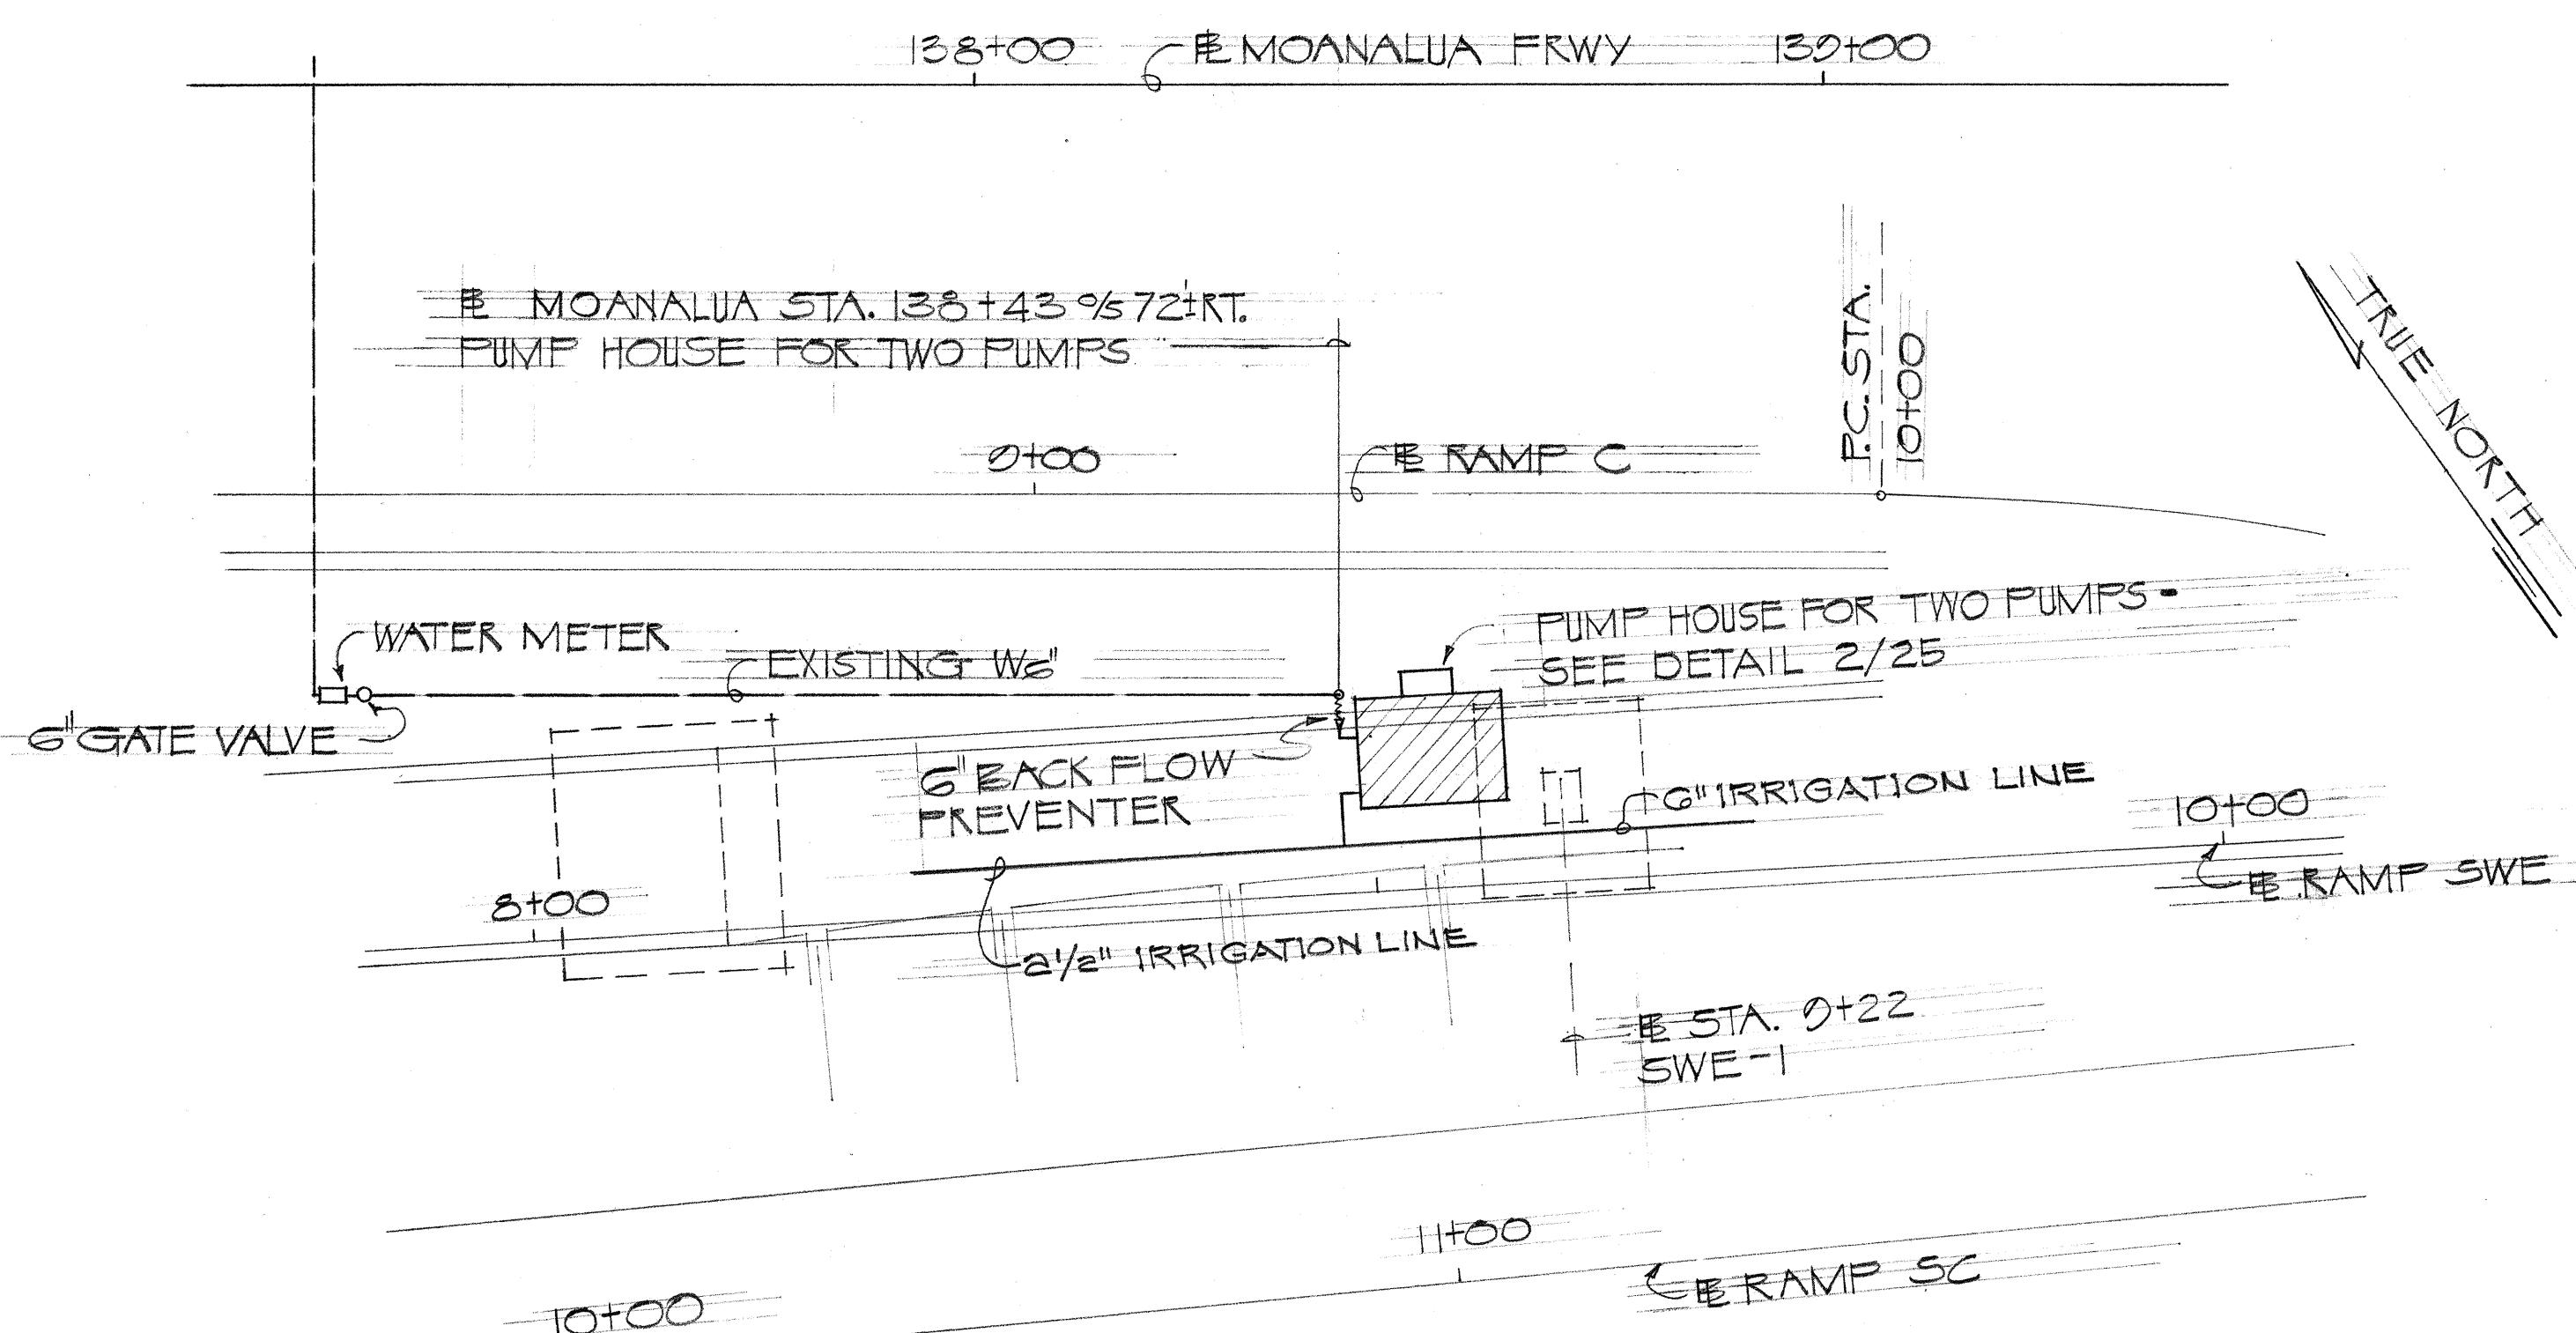

DETAIL 3/22  
BOOSTER STATION A

TRUE NORTH

258+00

259+00

INTERSTATE ROUTE H-3


OUTBOUND LANE →

H-3 STA 257+90 0/S 85' RT  
PUMP HOUSE FOR ONE PUMP - SEE DETAIL 1/25

EXISTING CONC. DITCH

4" IRRIGATION LINE

DETAIL 2/22  
BOOSTER STATION D

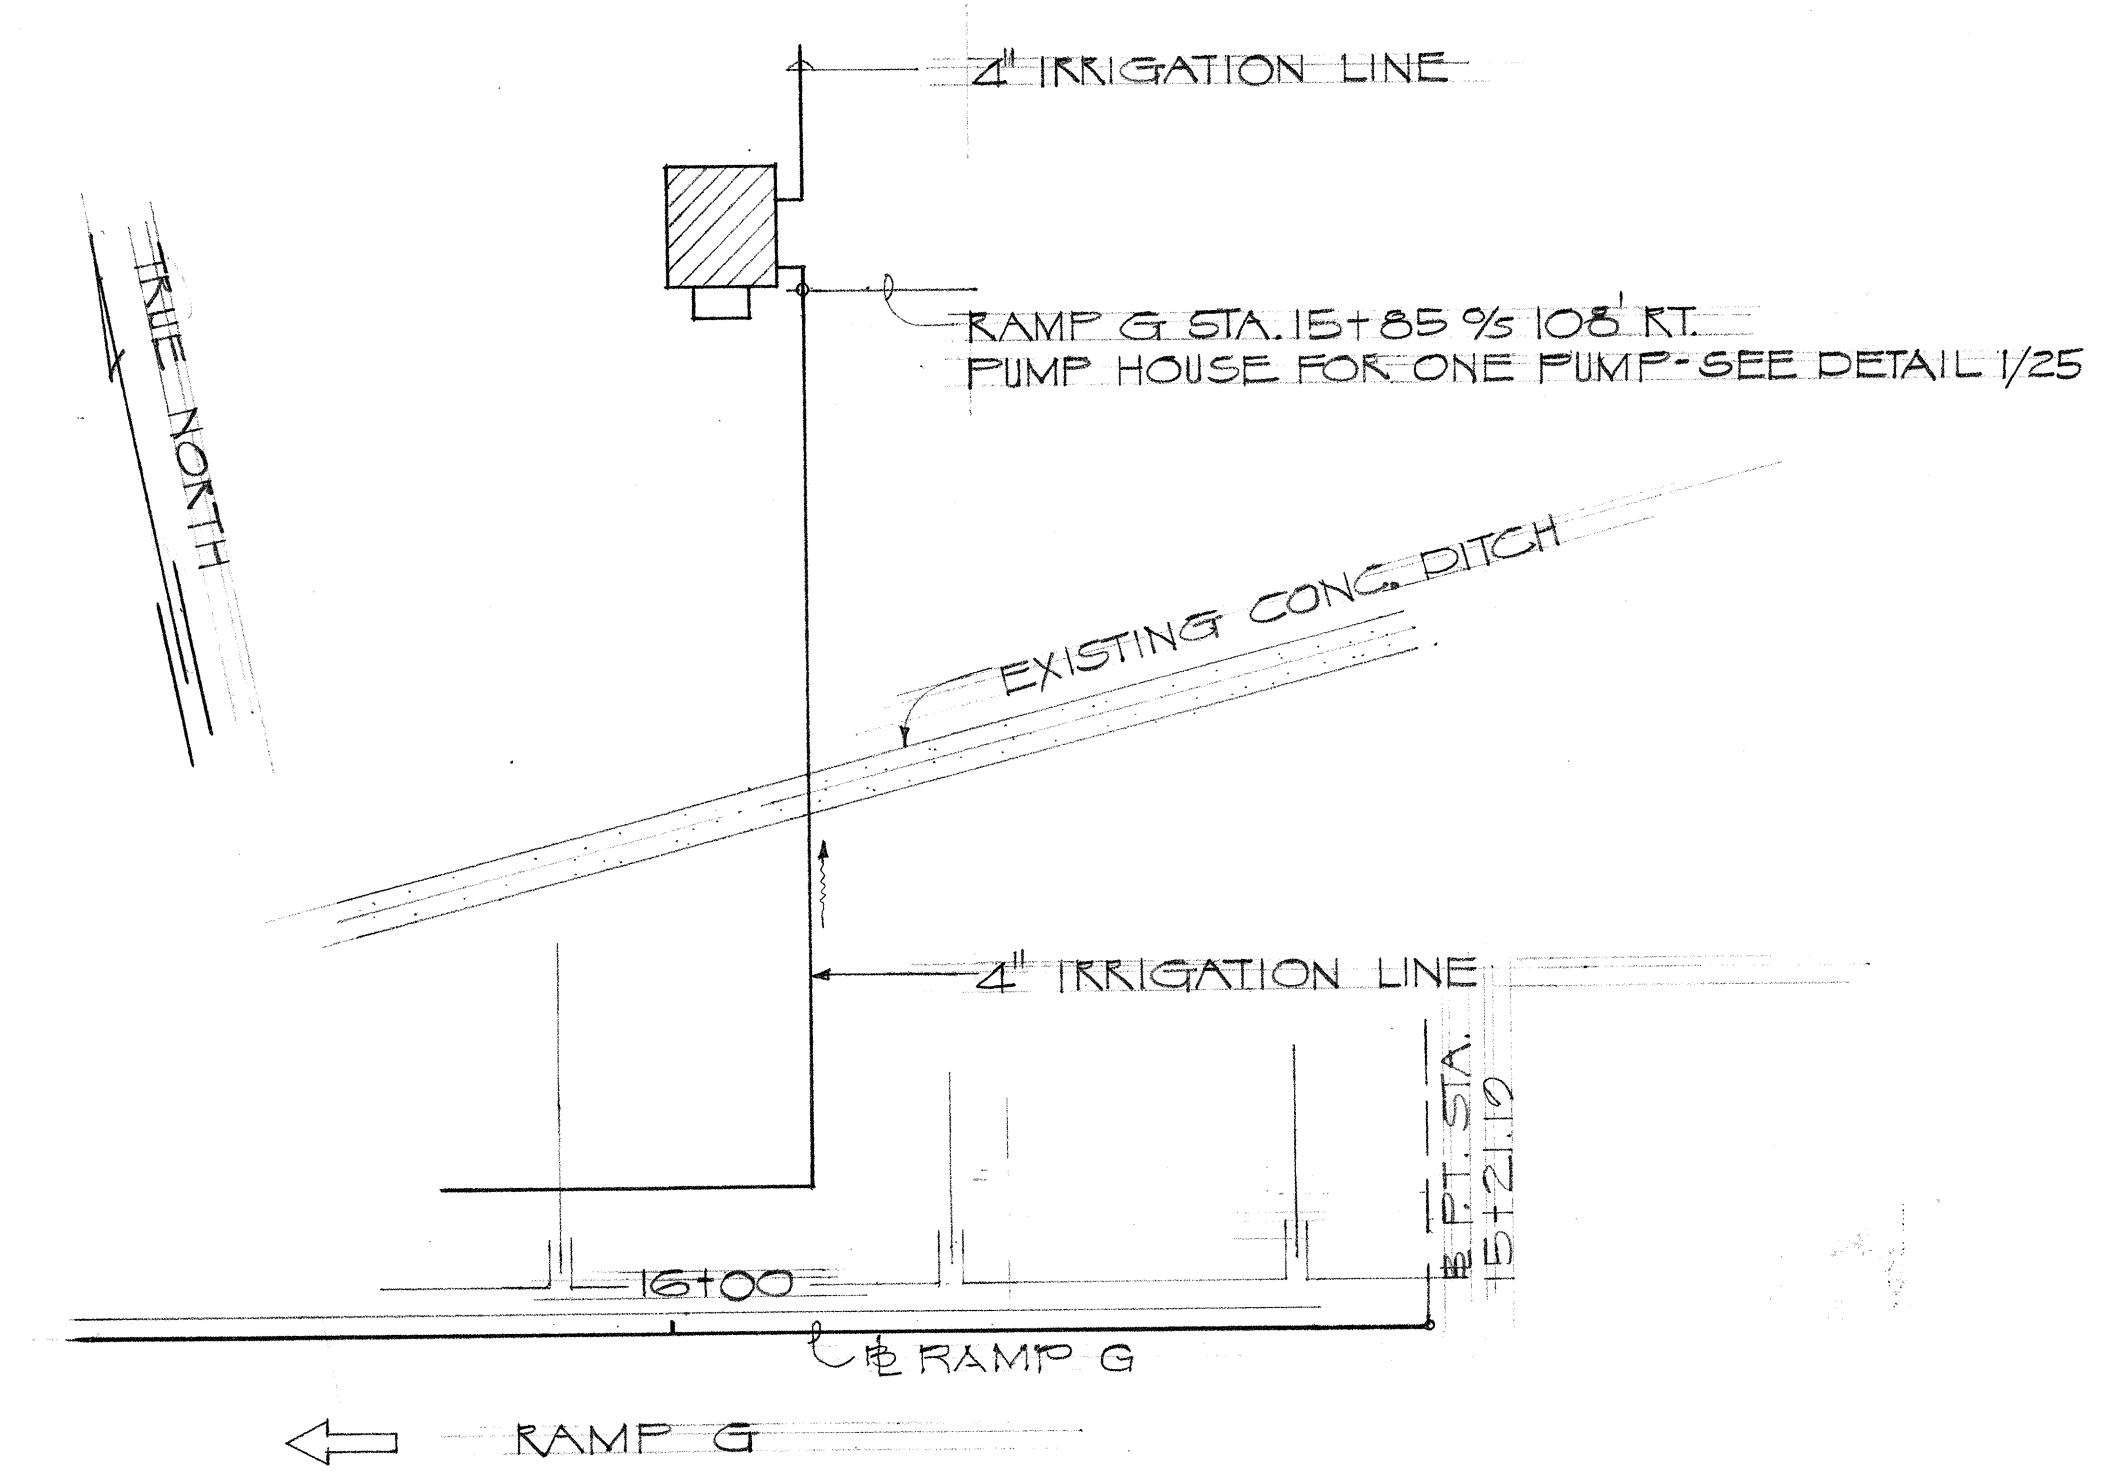



DETAIL 4/22  
BOOSTER STATION E

TRUE NORTH

RAMP G

STATE OF HAWAII  
DEPARTMENT OF TRANSPORTATION  
HIGHWAYS DIVISION  
IRRIGATION SYSTEM  
SITE PLANS FOR PUMP HOUSES  
INTERSTATE ROUTE H-1  
PROJ. NO. I-HI-1(02):13  
Scale: 1" = 20' 0" Date: Mar. 1970  
SHEET NO. E22 OF 32 SHEETS

FED. ROAD DIST. NO.	STATE	FED. AID PROJ. NO.	FISCAL YEAR	SHEET NO.	TOTAL SHEETS
HAWAII	HAW.	I-HI-1(02):13	1976	41	50

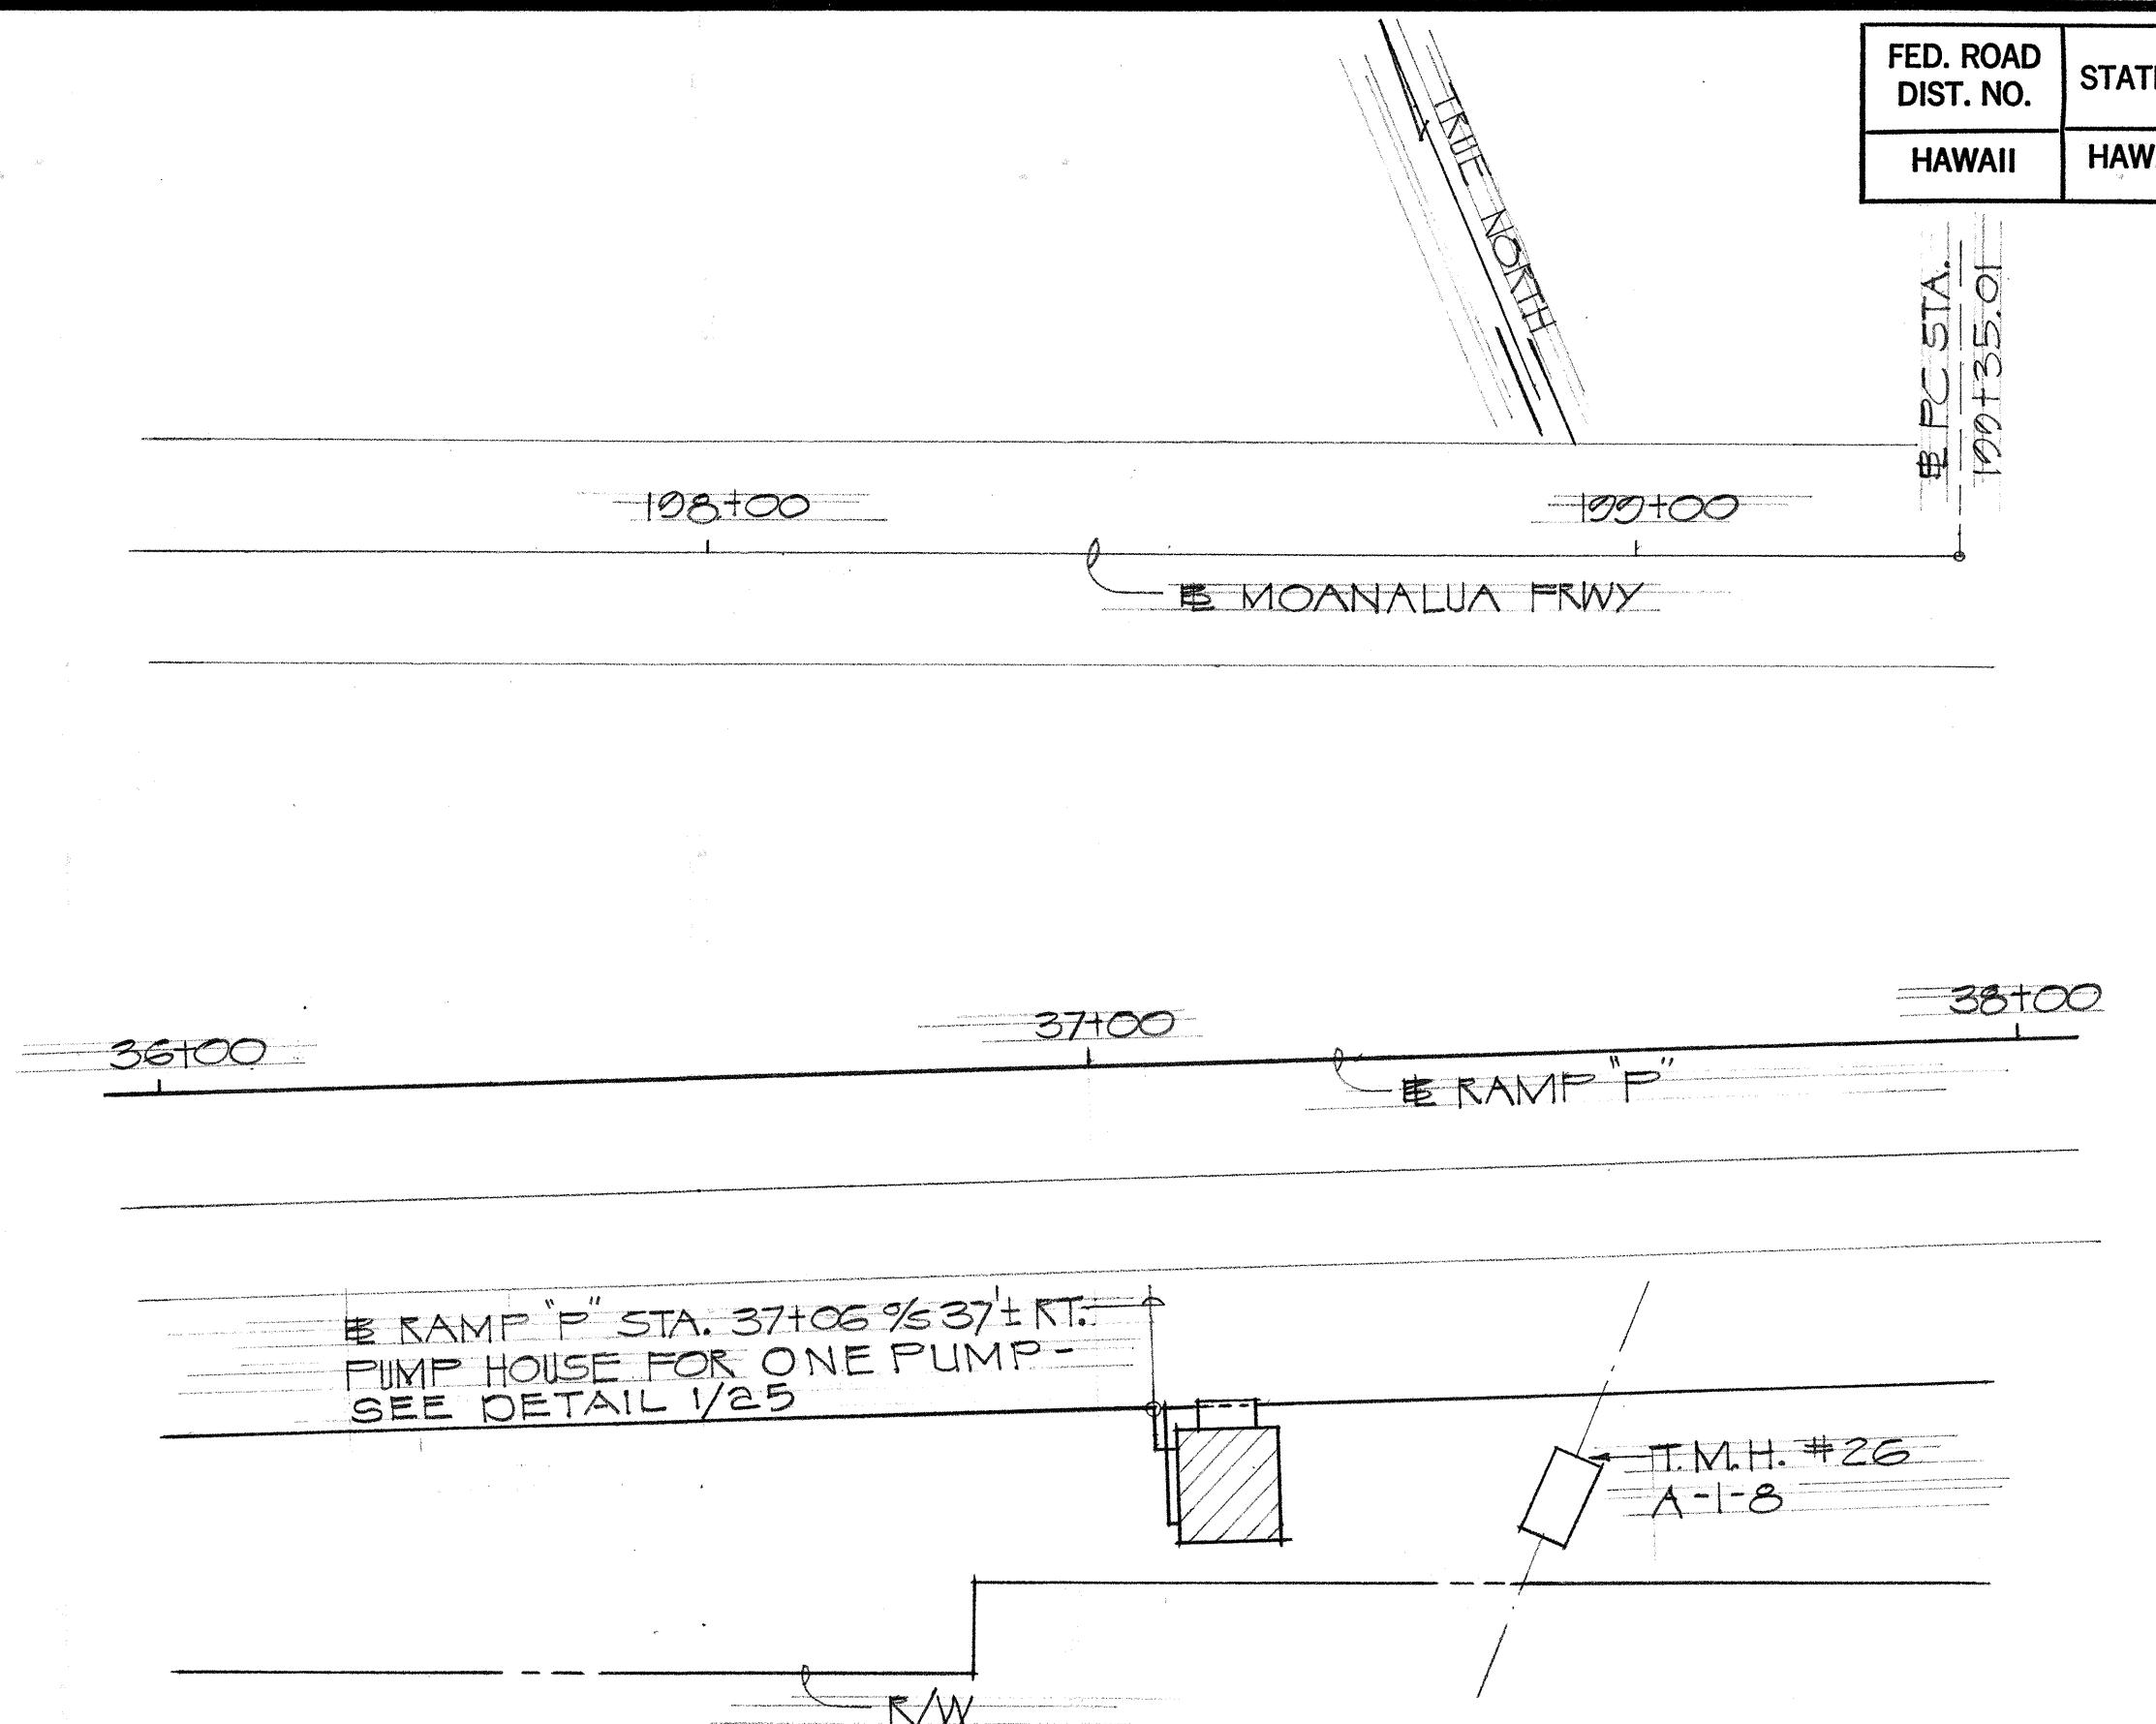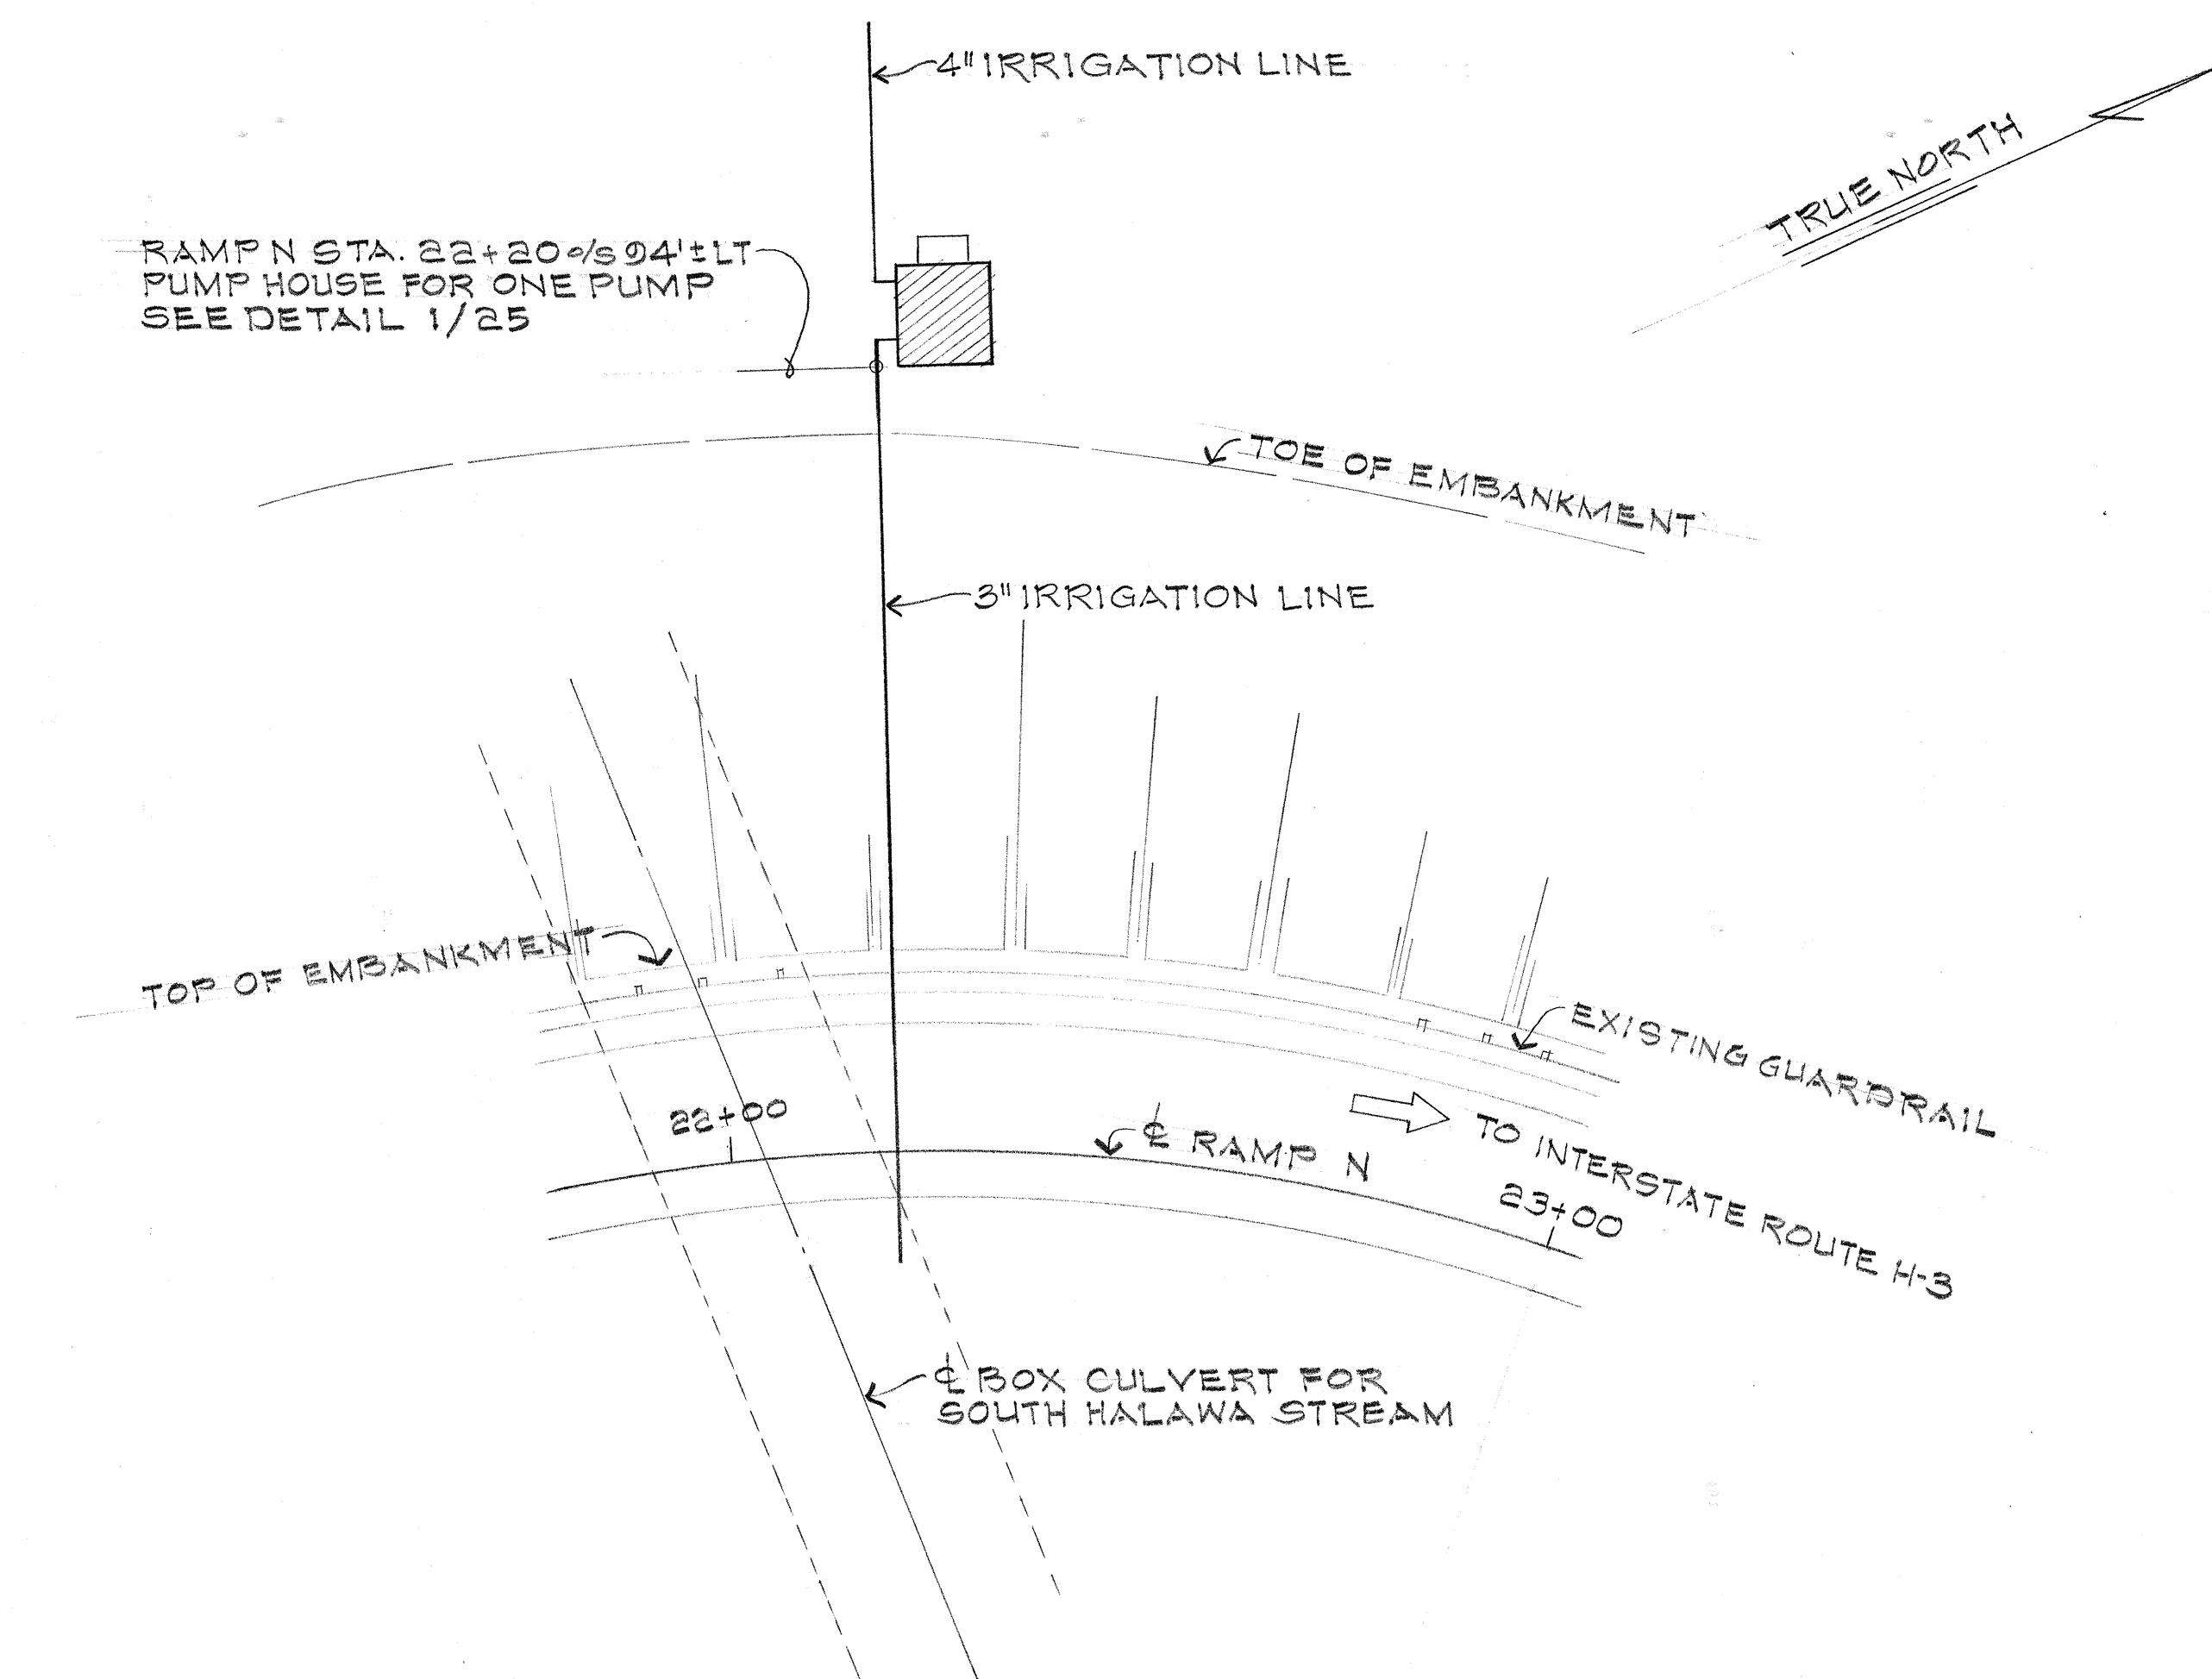

DETAIL 2/23 BOOSTER STATION (F)




DETAIL 1/23 BOOSTER STATION (E)

ORIGINAL SURVEY PLOTTED BY	DATE
DRAWN BY	"
TRACED BY	"
DESIGNED BY	"
QUANTITIES BY	"
CHECKED BY	"

NOTE BOOK No.	
---------------	--

STATE OF HAWAII  
DEPARTMENT OF TRANSPORTATION  
HIGHWAYS DIVISION  
IRRIGATION SYSTEM  
SITE PLANS FOR PUMP HOUSES  
INTERSTATE ROUTE H-1  
PROJ. NO. I-HI-1(02):13  
Scale: 1" = 20'0" Date: Mar. 1976  
SHEET NO. 23 OF 32 SHEETS


FED. ROAD DIST. NO.	STATE	FED. AID PROJ. NO.	FISCAL YEAR	SHEET NO.	TOTAL SHEETS
HAWAII	HAW.	I-HI-1(02):13	197G	42	50

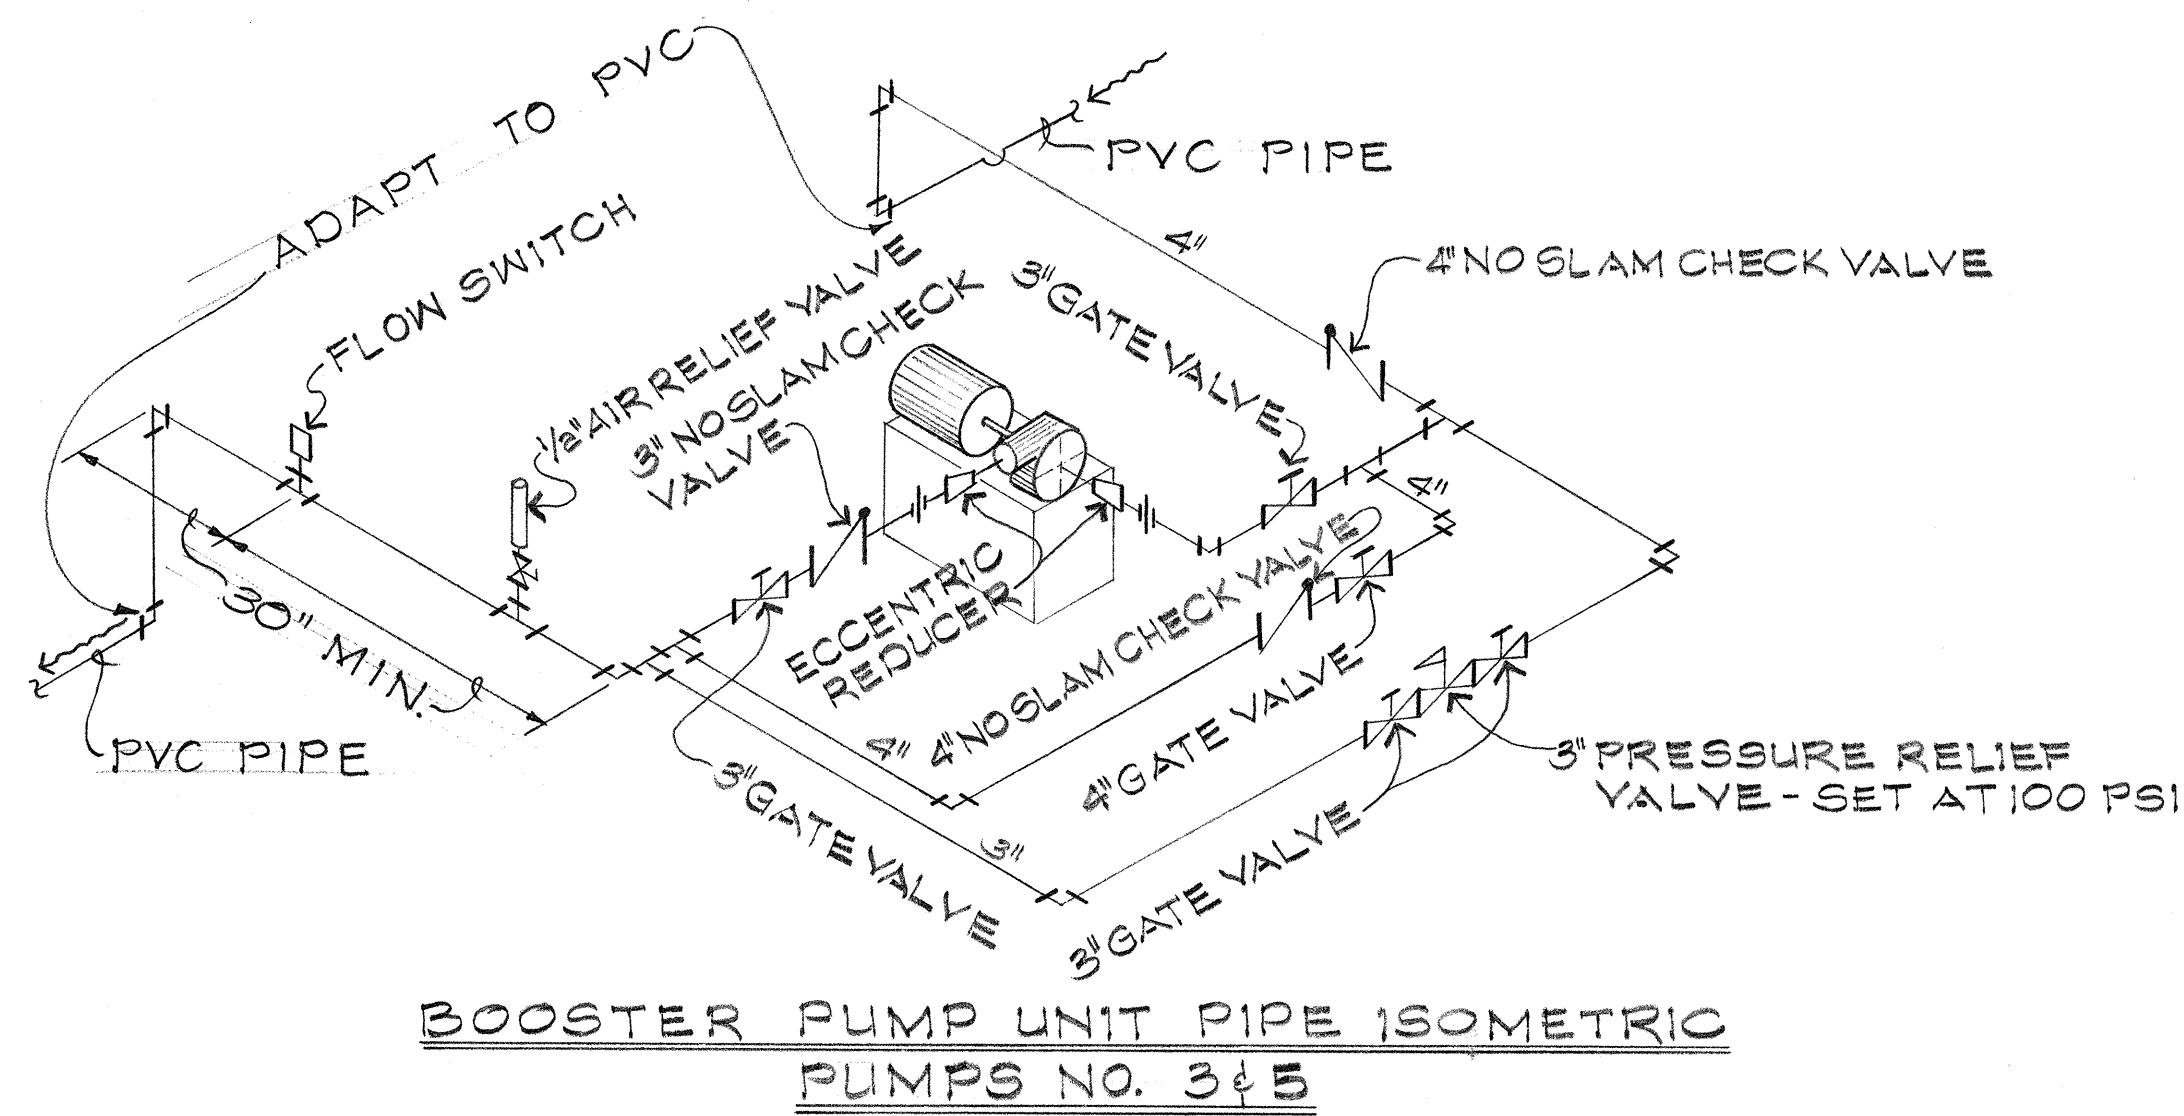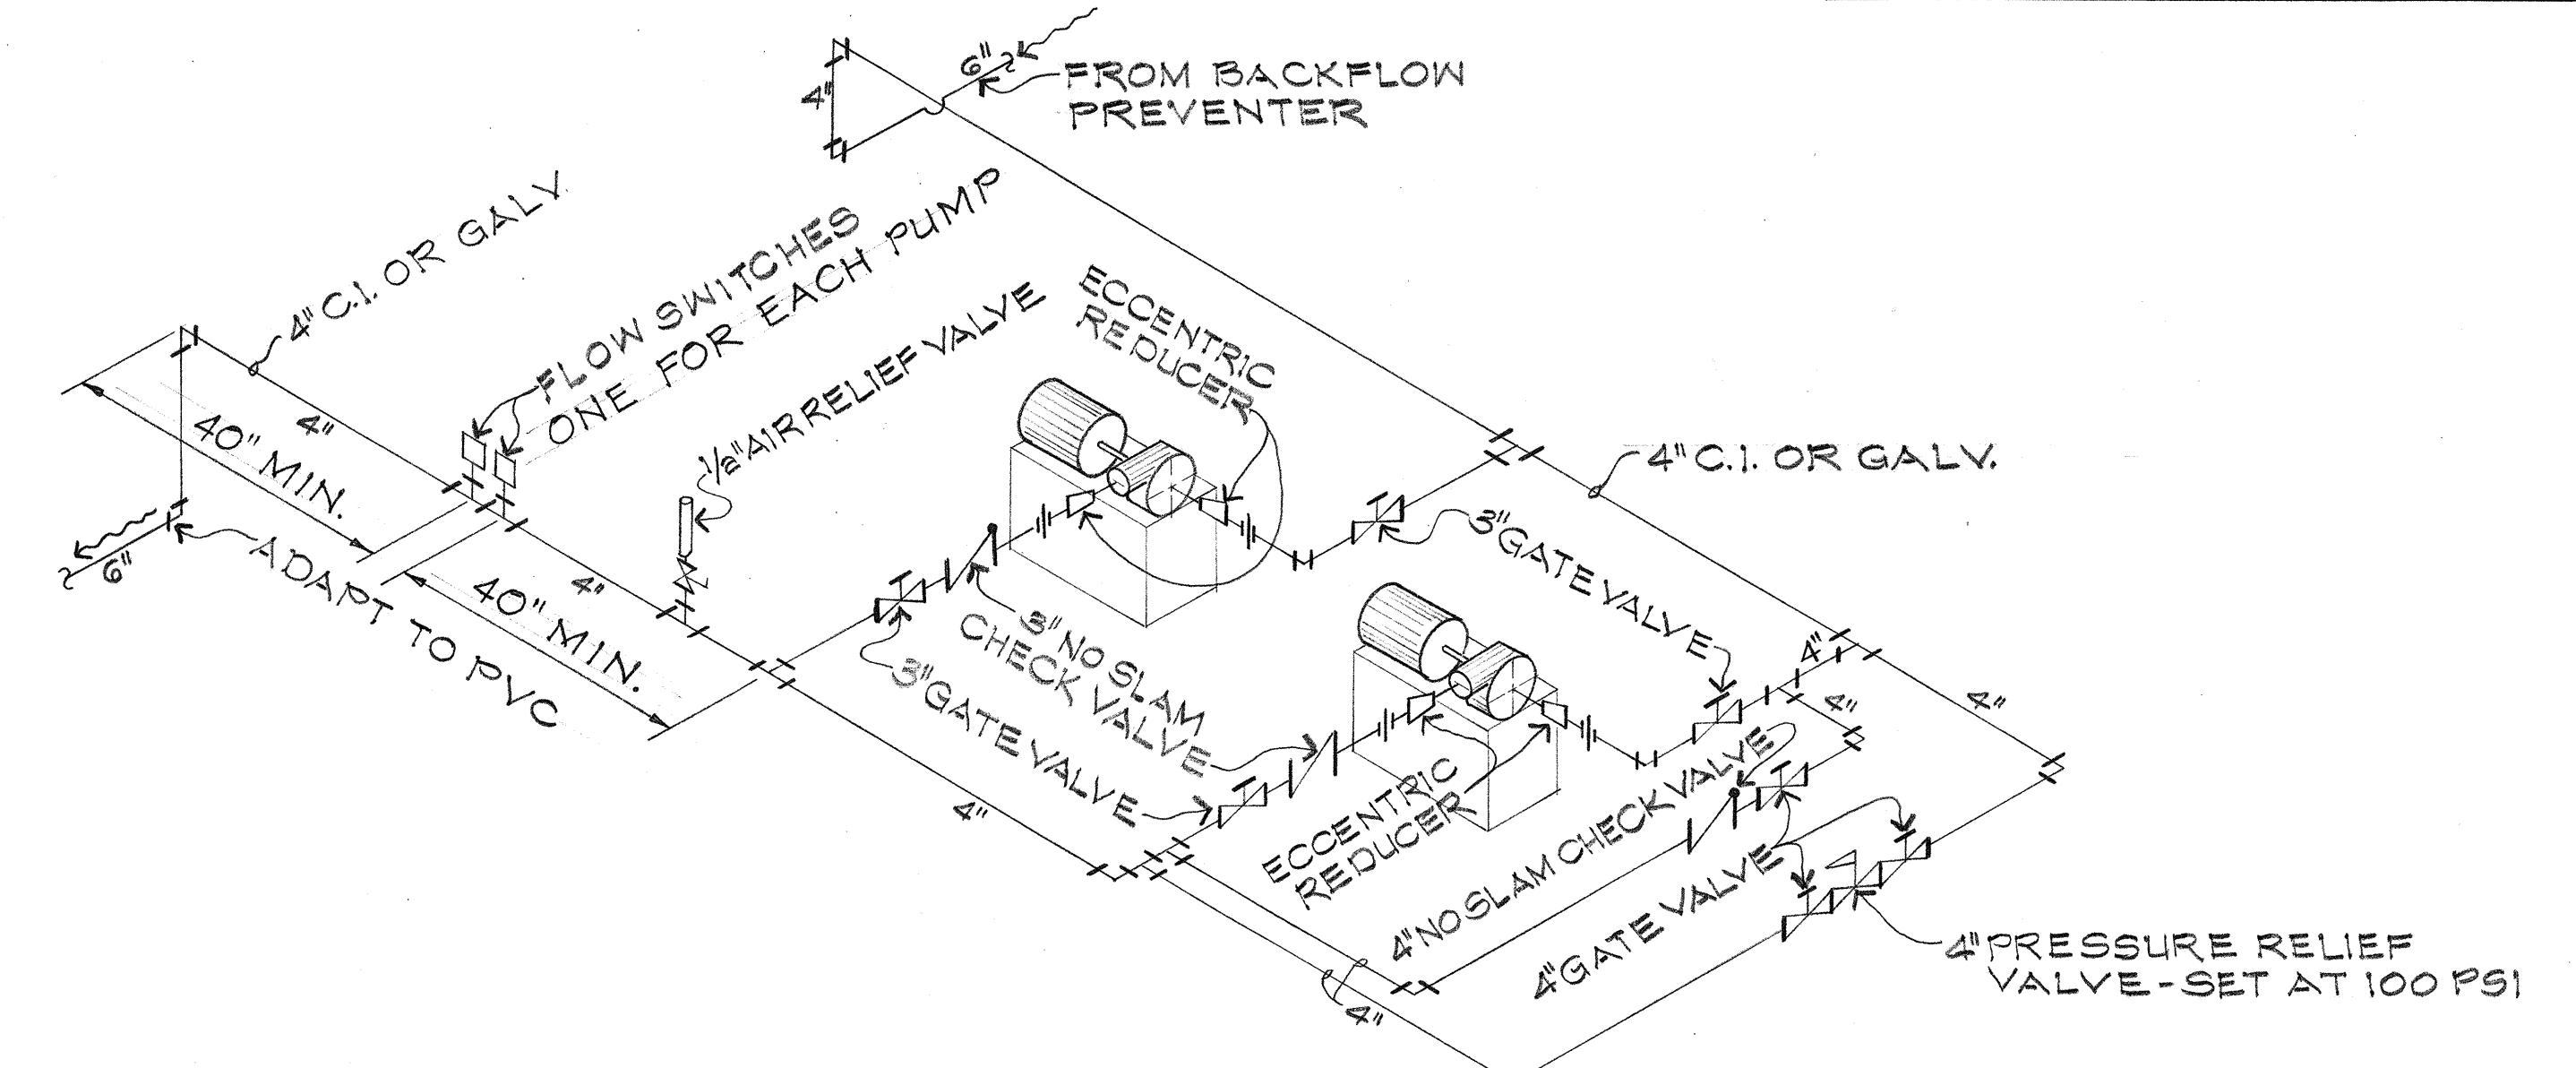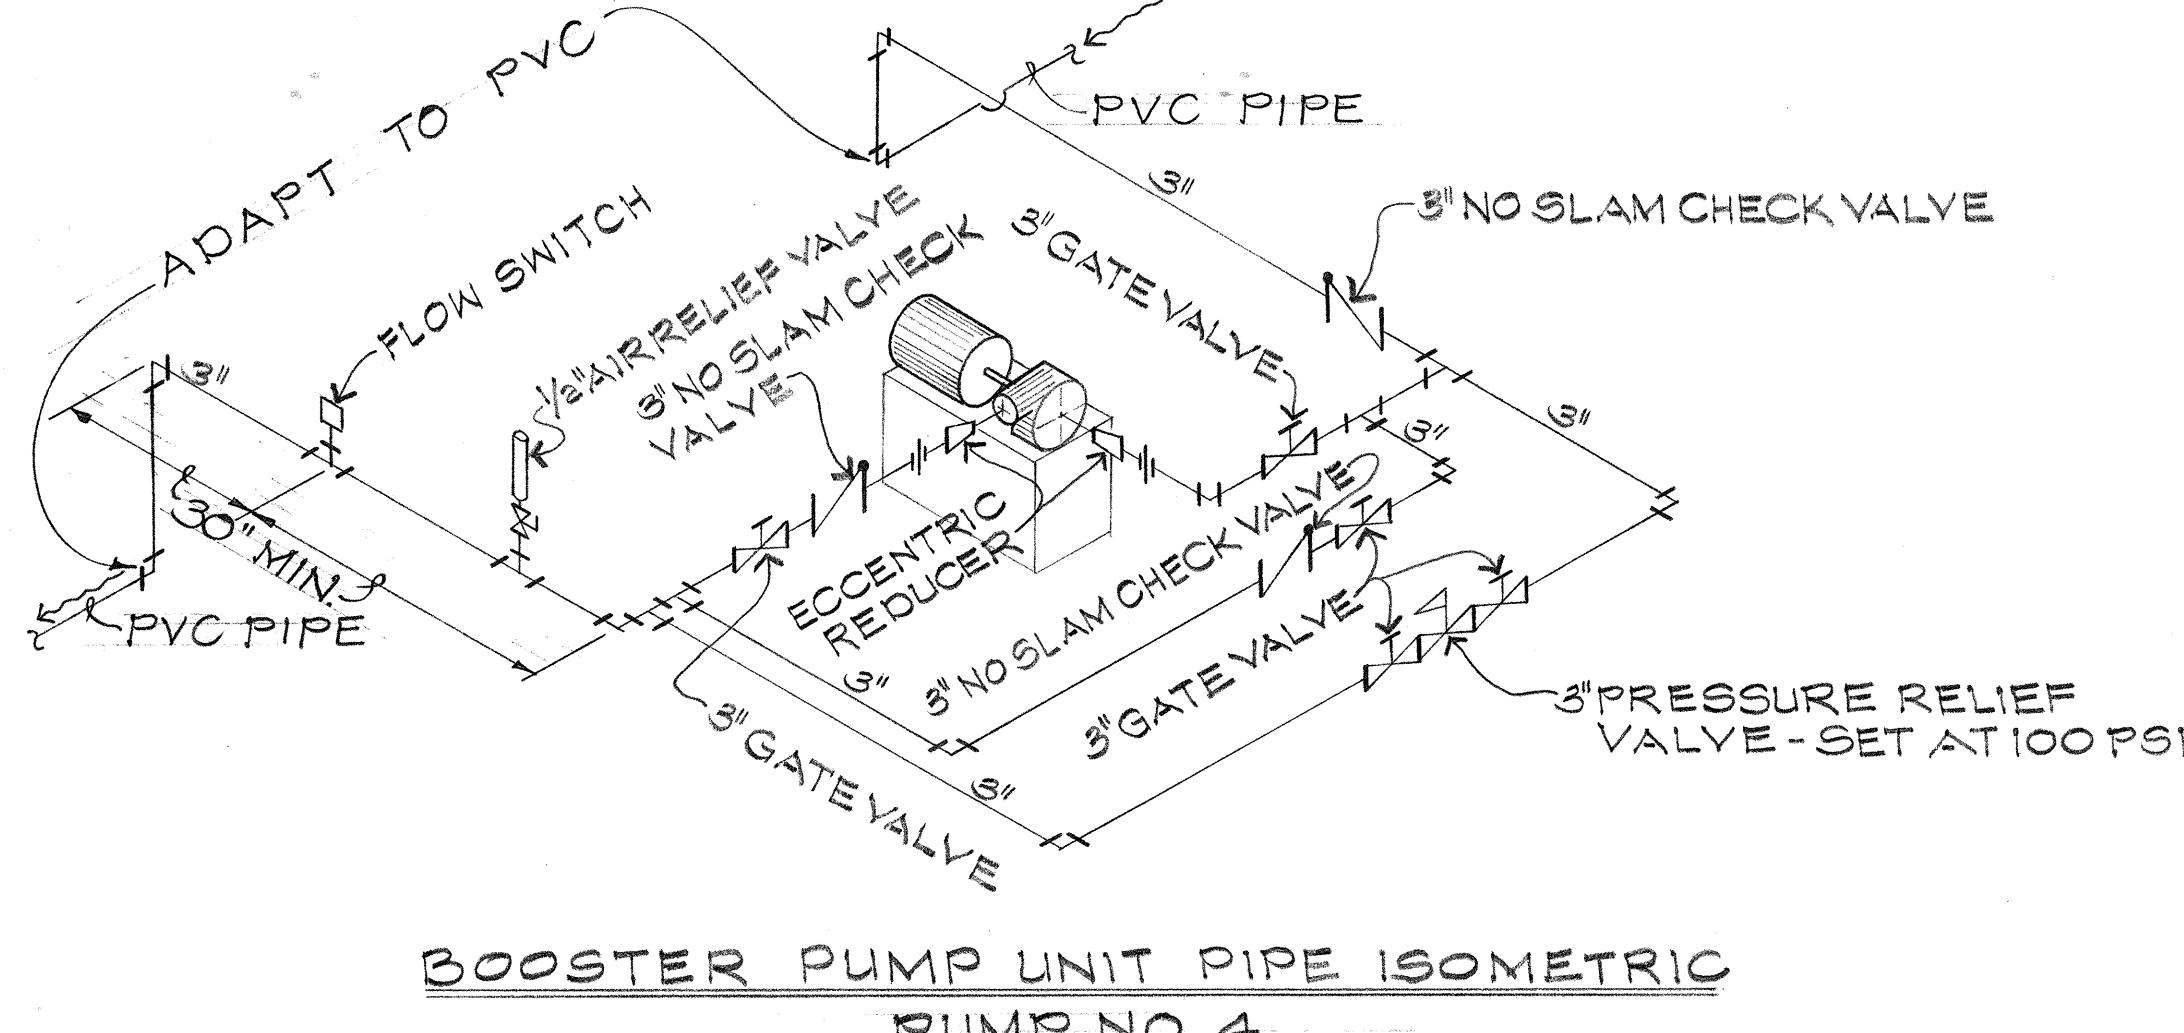

PUMP REQUIREMENTS			
PUMP NO.	BHP	Q.GPM	T.D.H.FT.
1,2,3 & 5	5	200	50
4	3	100	70
6	5	120	90
7	3	50	142


NOTE:

1. Pipe at Pump House shall be cast iron or galvanized steel with screwed or flanged connection.
2. Contractor shall provide the necessary supports for the pipe and valves.

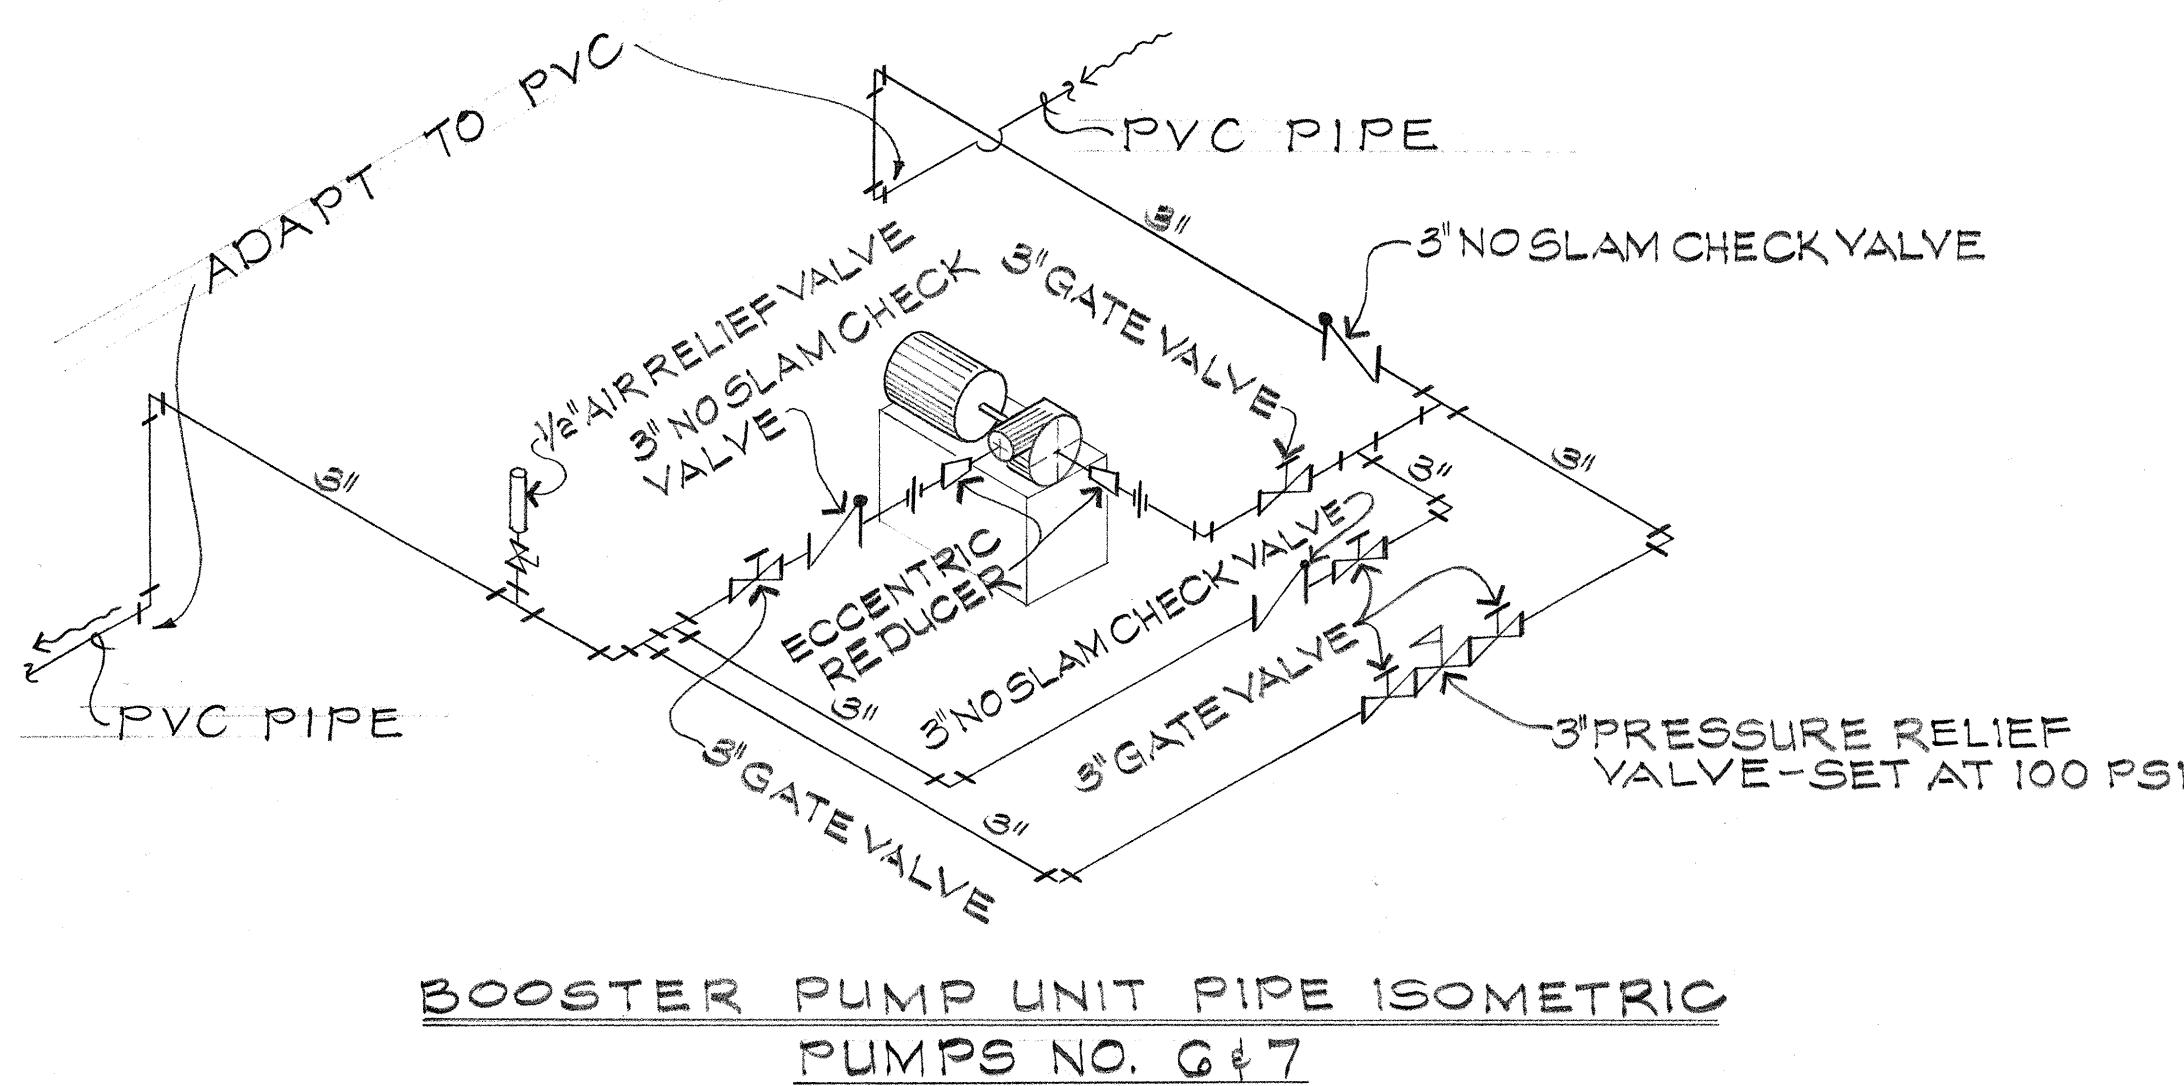


STATE OF HAWAII  
DEPARTMENT OF TRANSPORTATION  
HIGHWAYS DIVISION  
IRRIGATION SYSTEM  
BOOSTER PUMP UNIT PIPE  
ISOMETRIC DETAILS  
INTERSTATE ROUTE H-1  
PROV. NO. I-HI-1(02):13  
Date: Mar 197G  
SHEET NO. 124 OF 32 SHEETS


FED. ROAD DIST. NO.	STATE	FED. AID PROJ. NO.	FISCAL YEAR	SHEET NO.	TOTAL SHEETS
HAWAII	HAW.	I-HI-1(92):13	1976	43	50

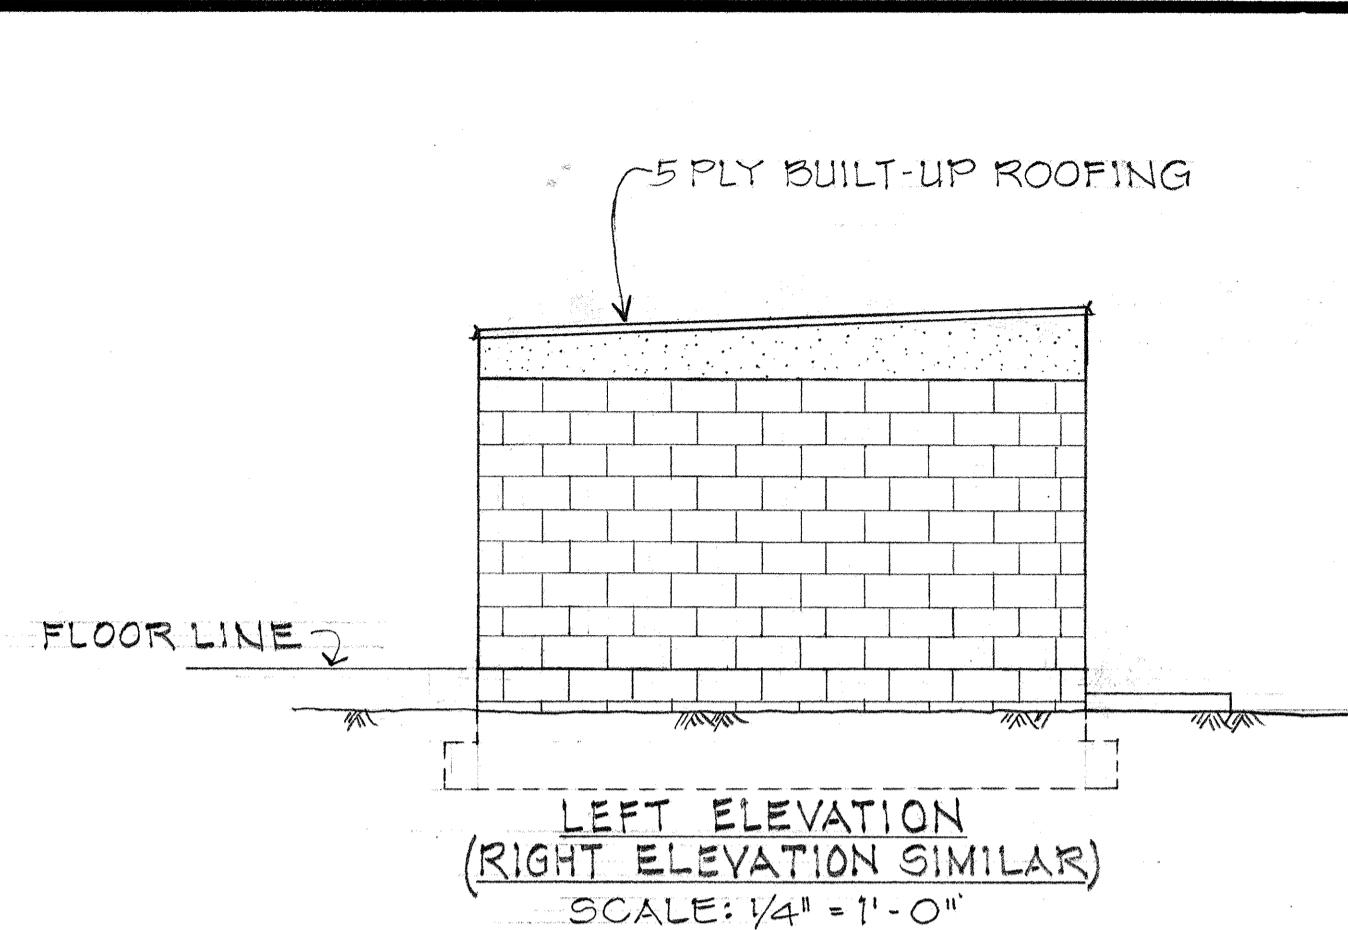


LEFT ELEVATION  
(RIGHT ELEVATION SIMILAR)  
SCALE:  $\frac{1}{4}$ " = 1' - 0"

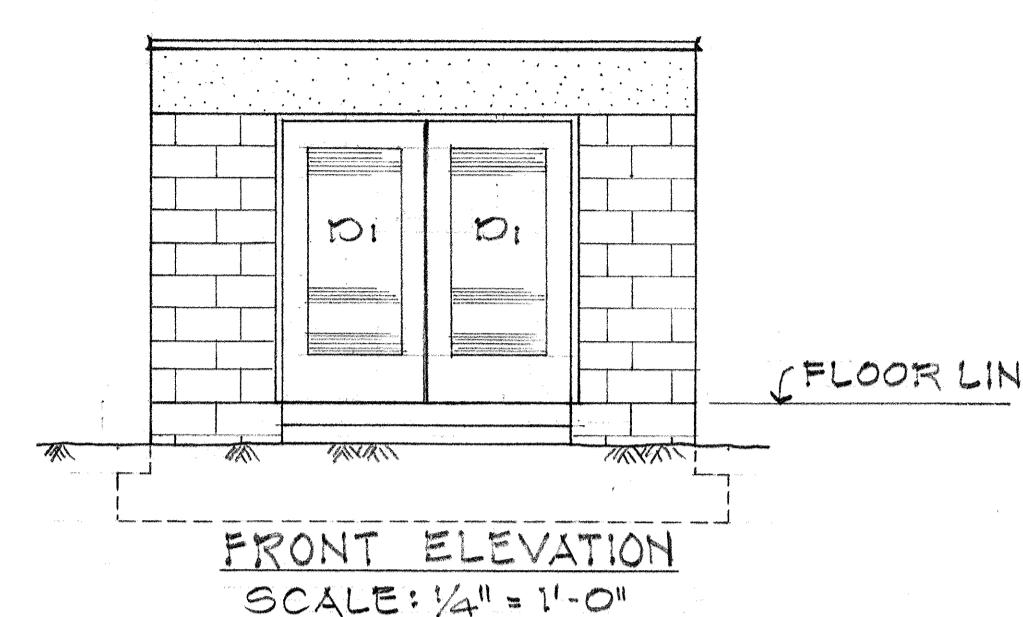


FRONT ELEVATION  
SCALE:  $\frac{1}{4}$ " = 1'-0"

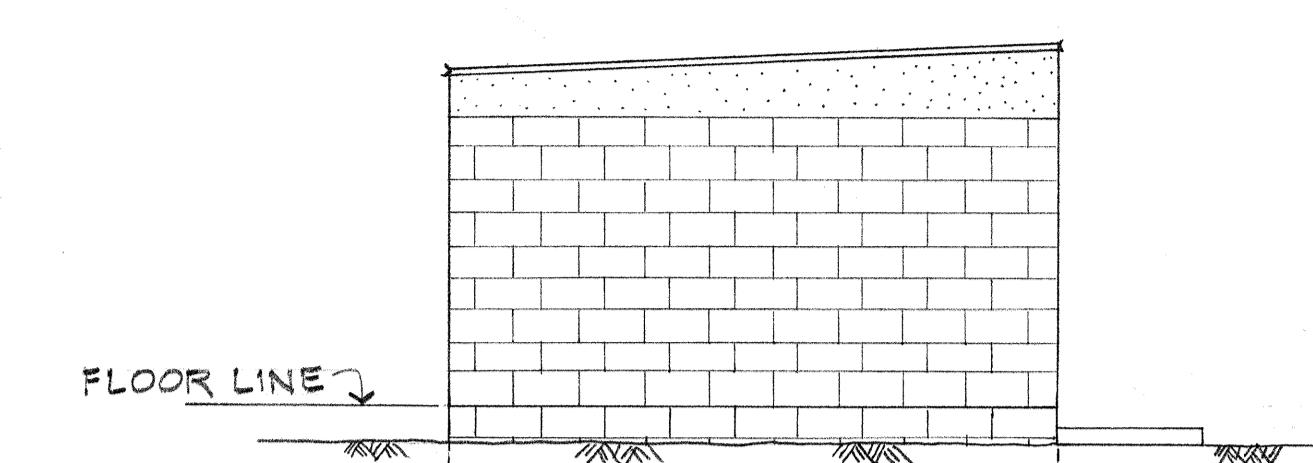


LEFT ELEVATION  
(RIGHT ELEVATION SIMILAR)

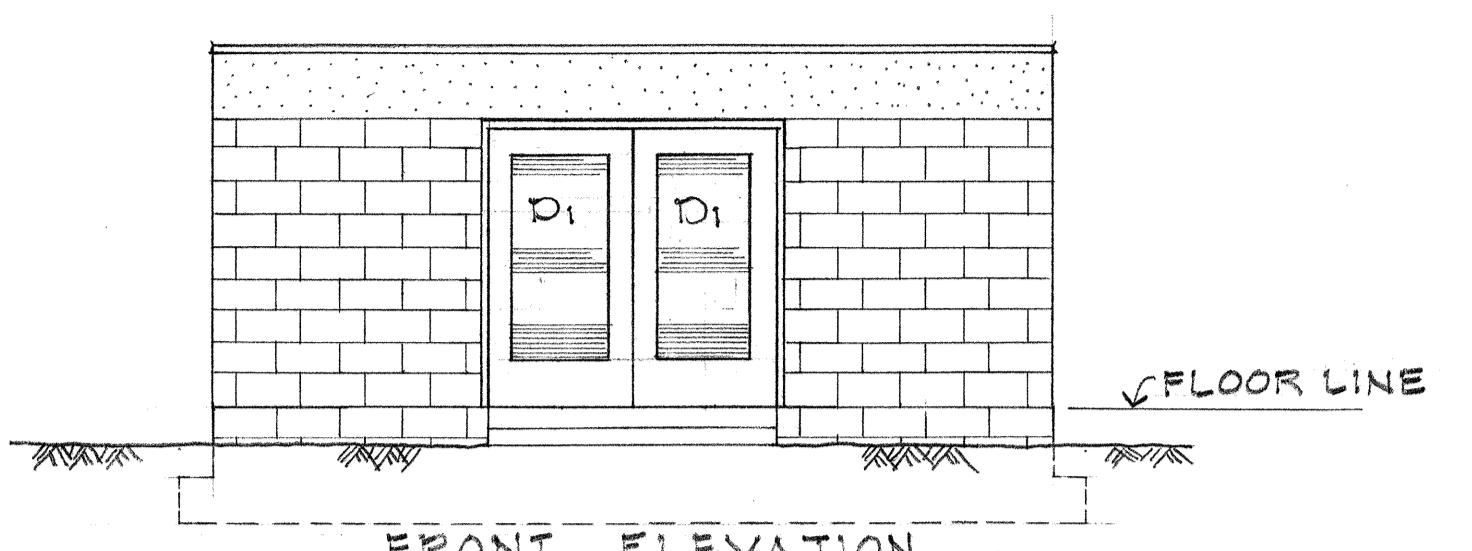


FRONT ELEVATION

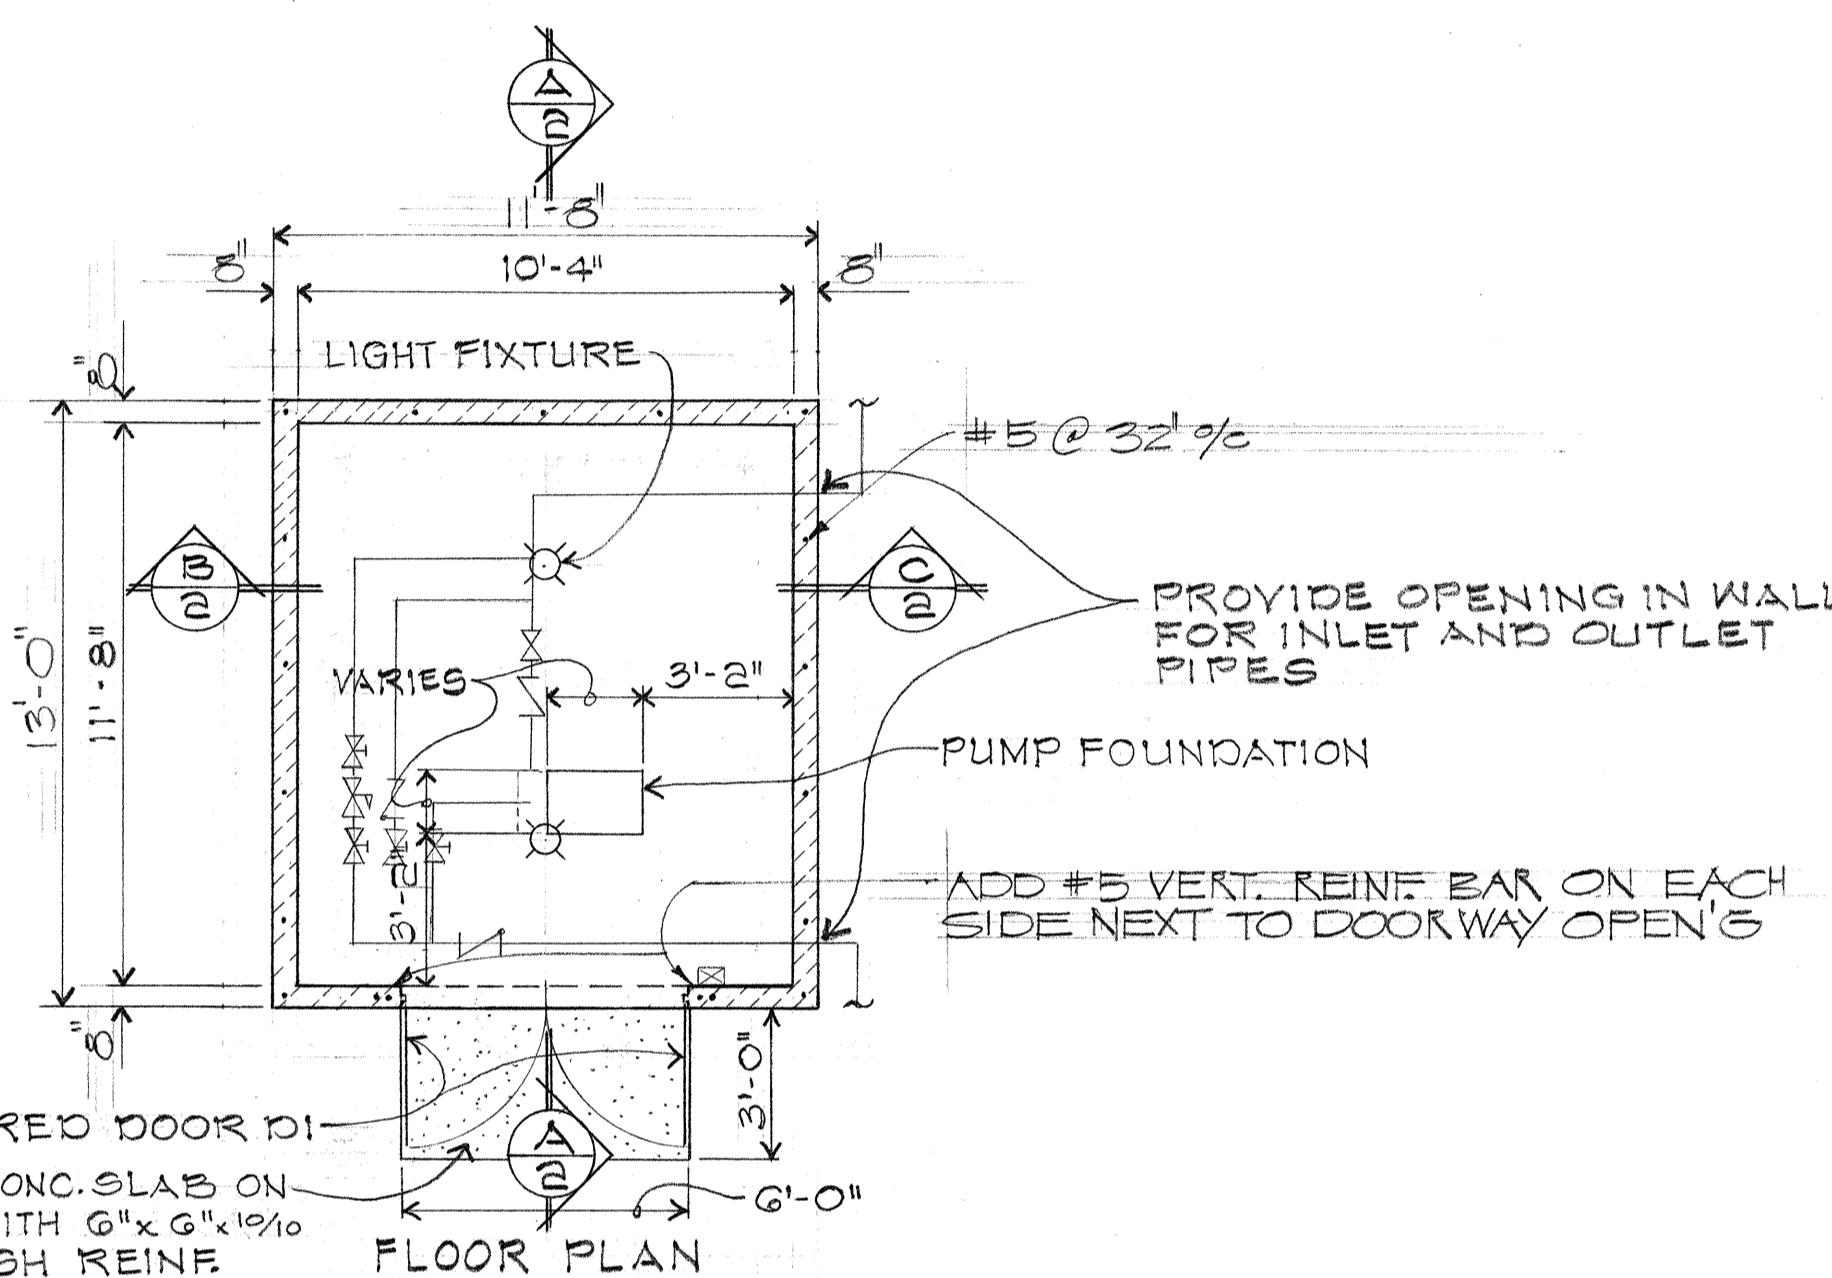


DETAIL 1/25 PUMP HOUSE FOR ONE PUMP  
SCALE:  $\frac{1}{4}$ " = 1'-0"

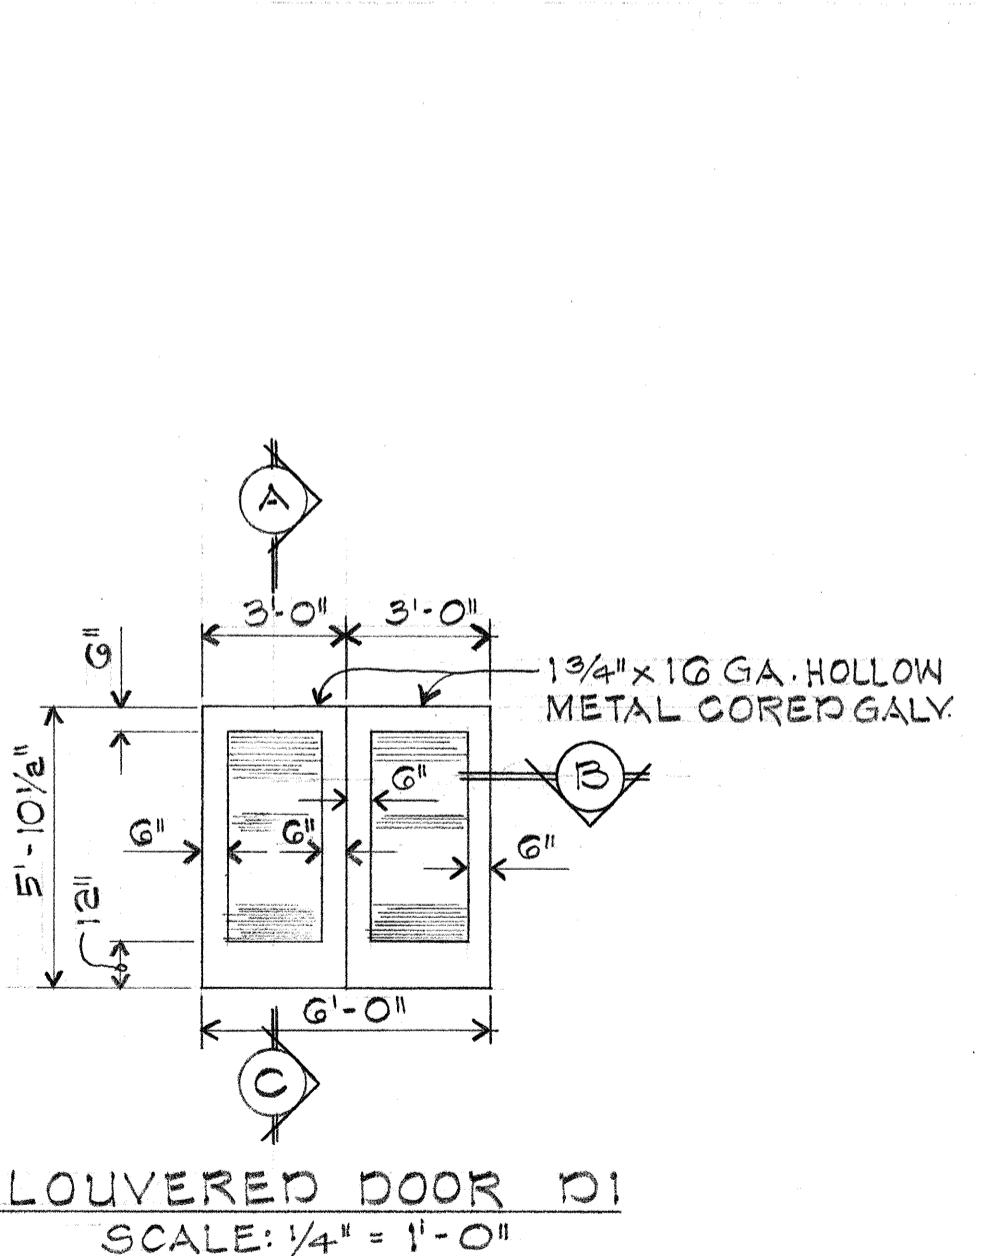


LOUVERED DOOR D1  
SCALE:  $\frac{1}{4}$ " = 1'-0"

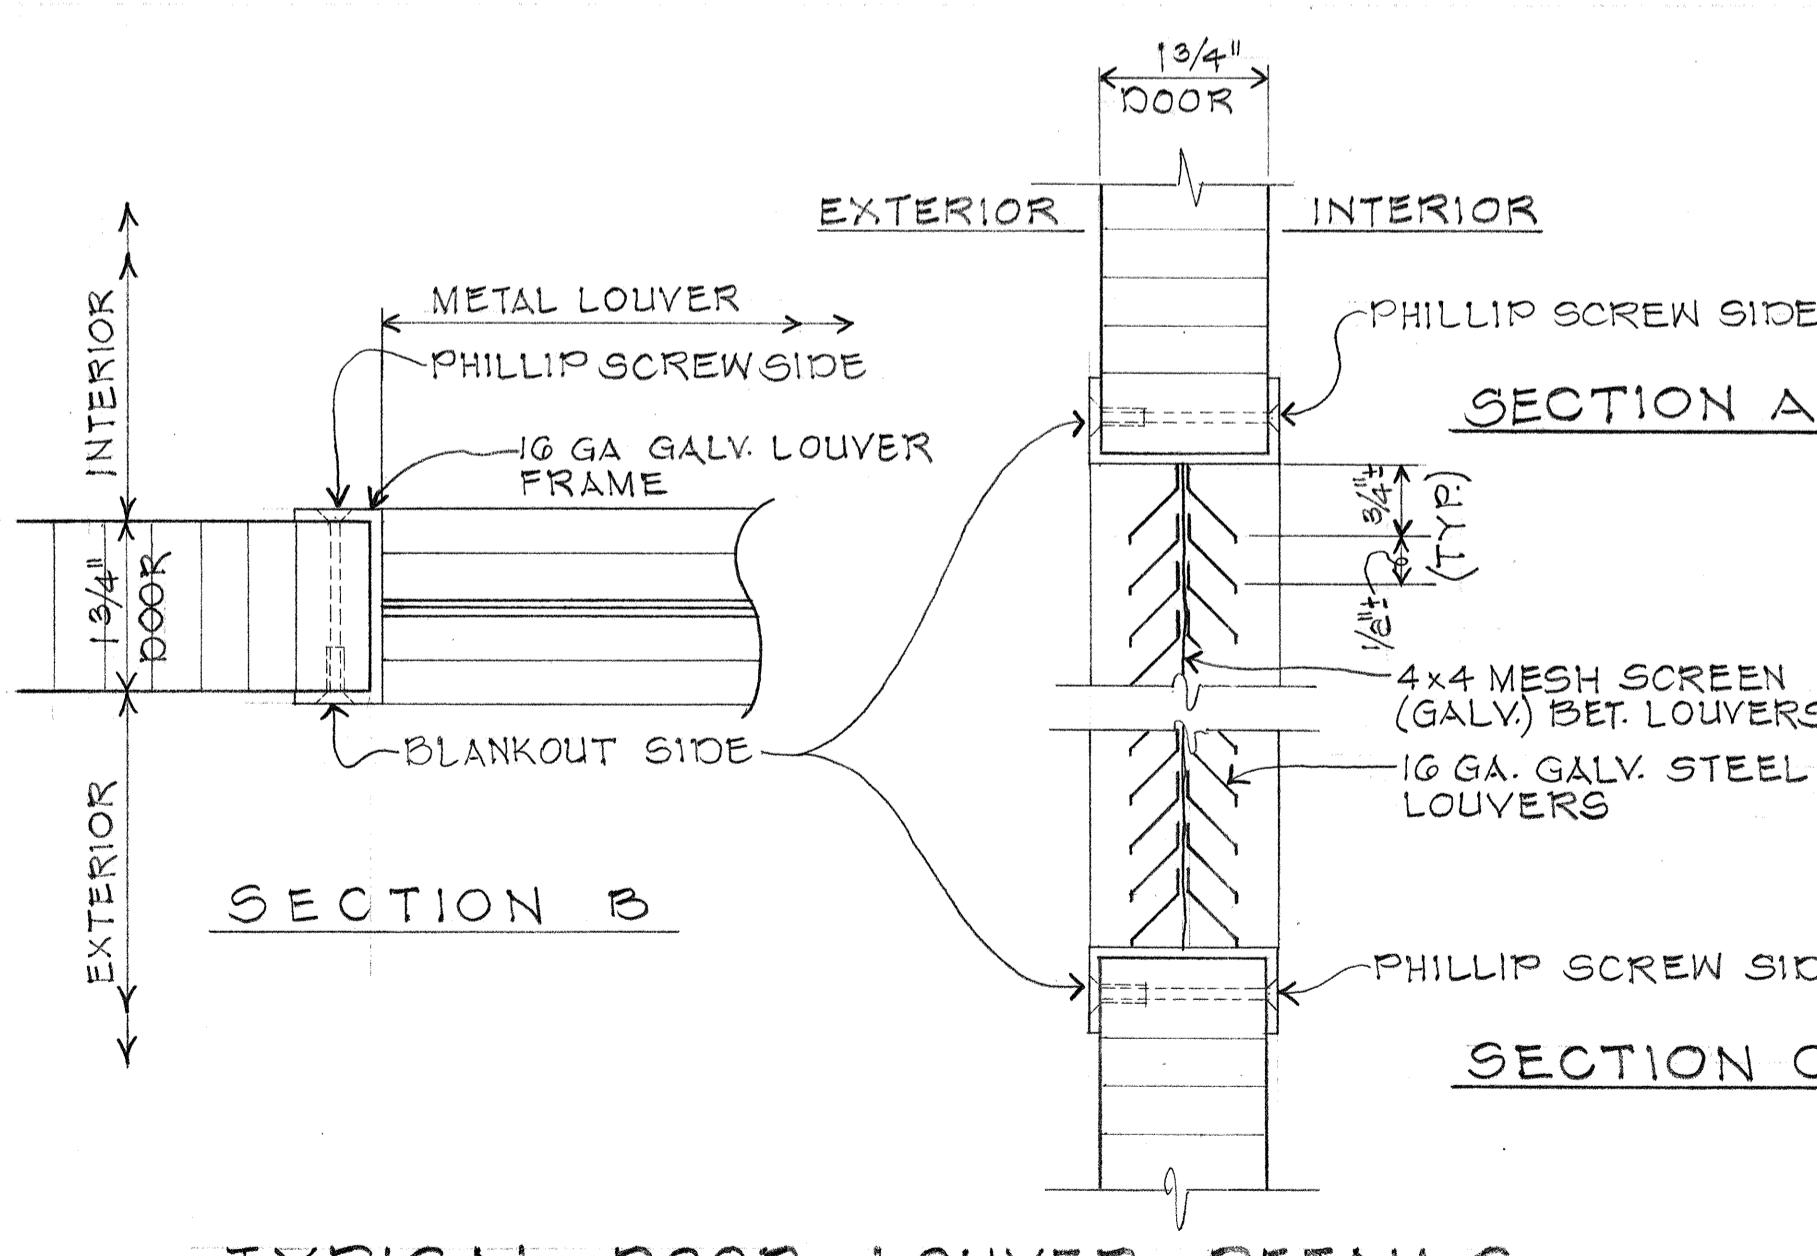

## TYPICAL DOOR LOUVER DETAILS

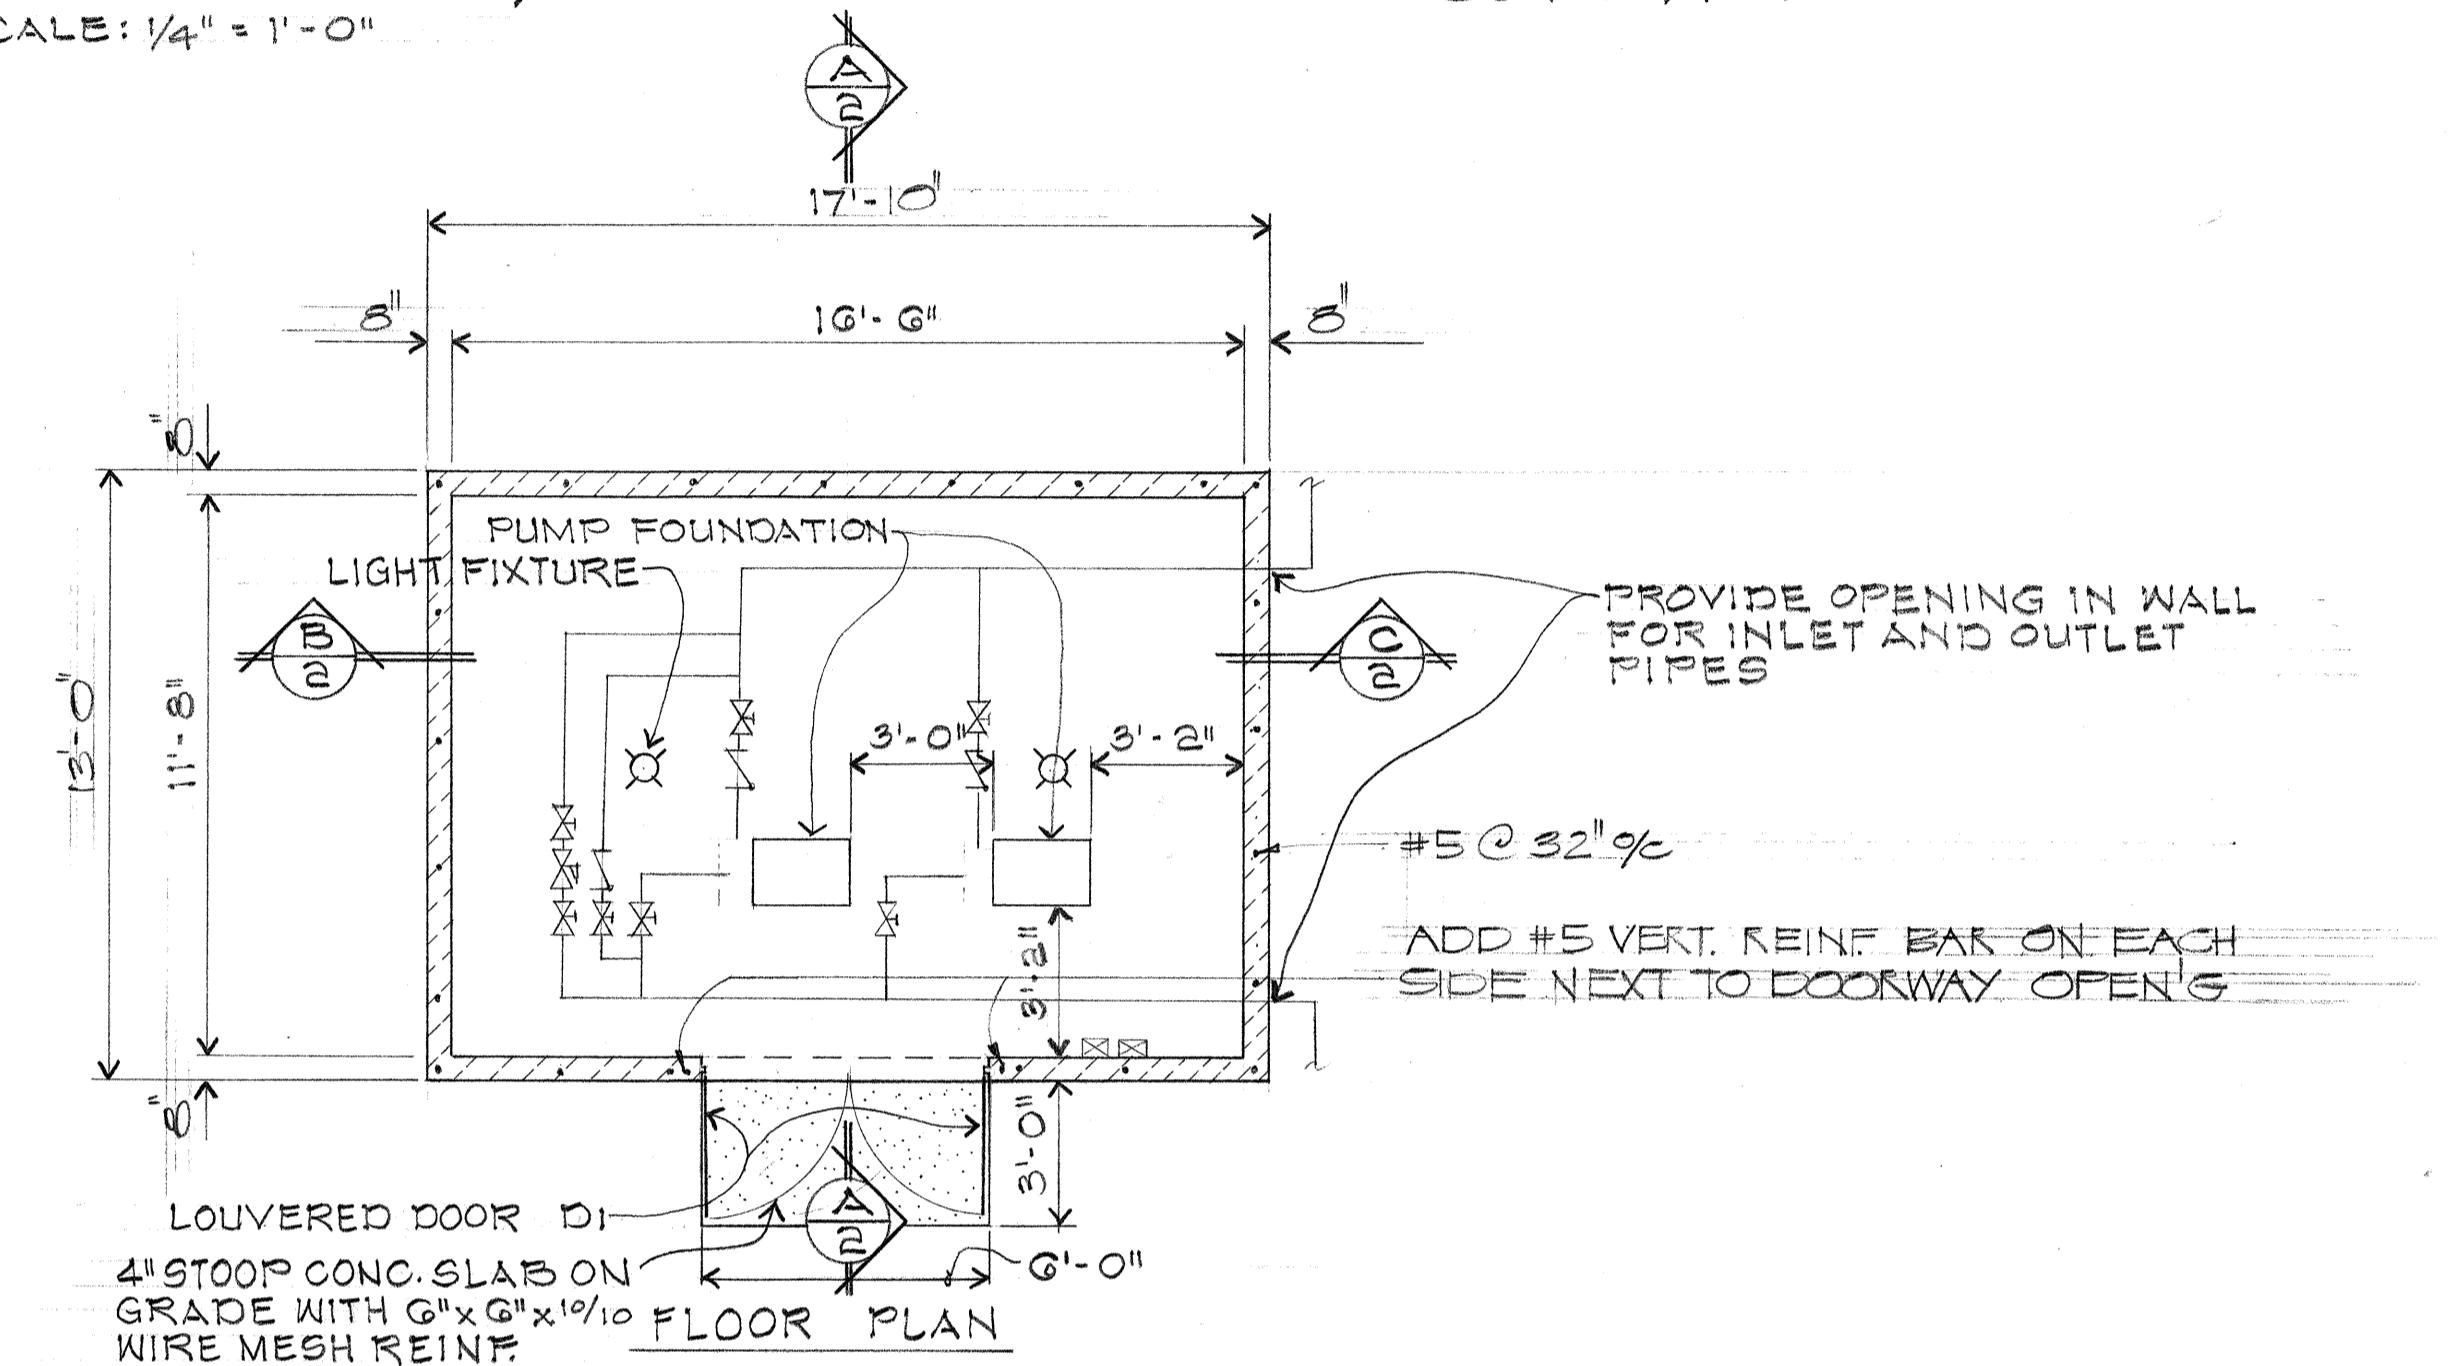





DETAIL 2/25 PUMP HOUSE FOR TWO PUMPS

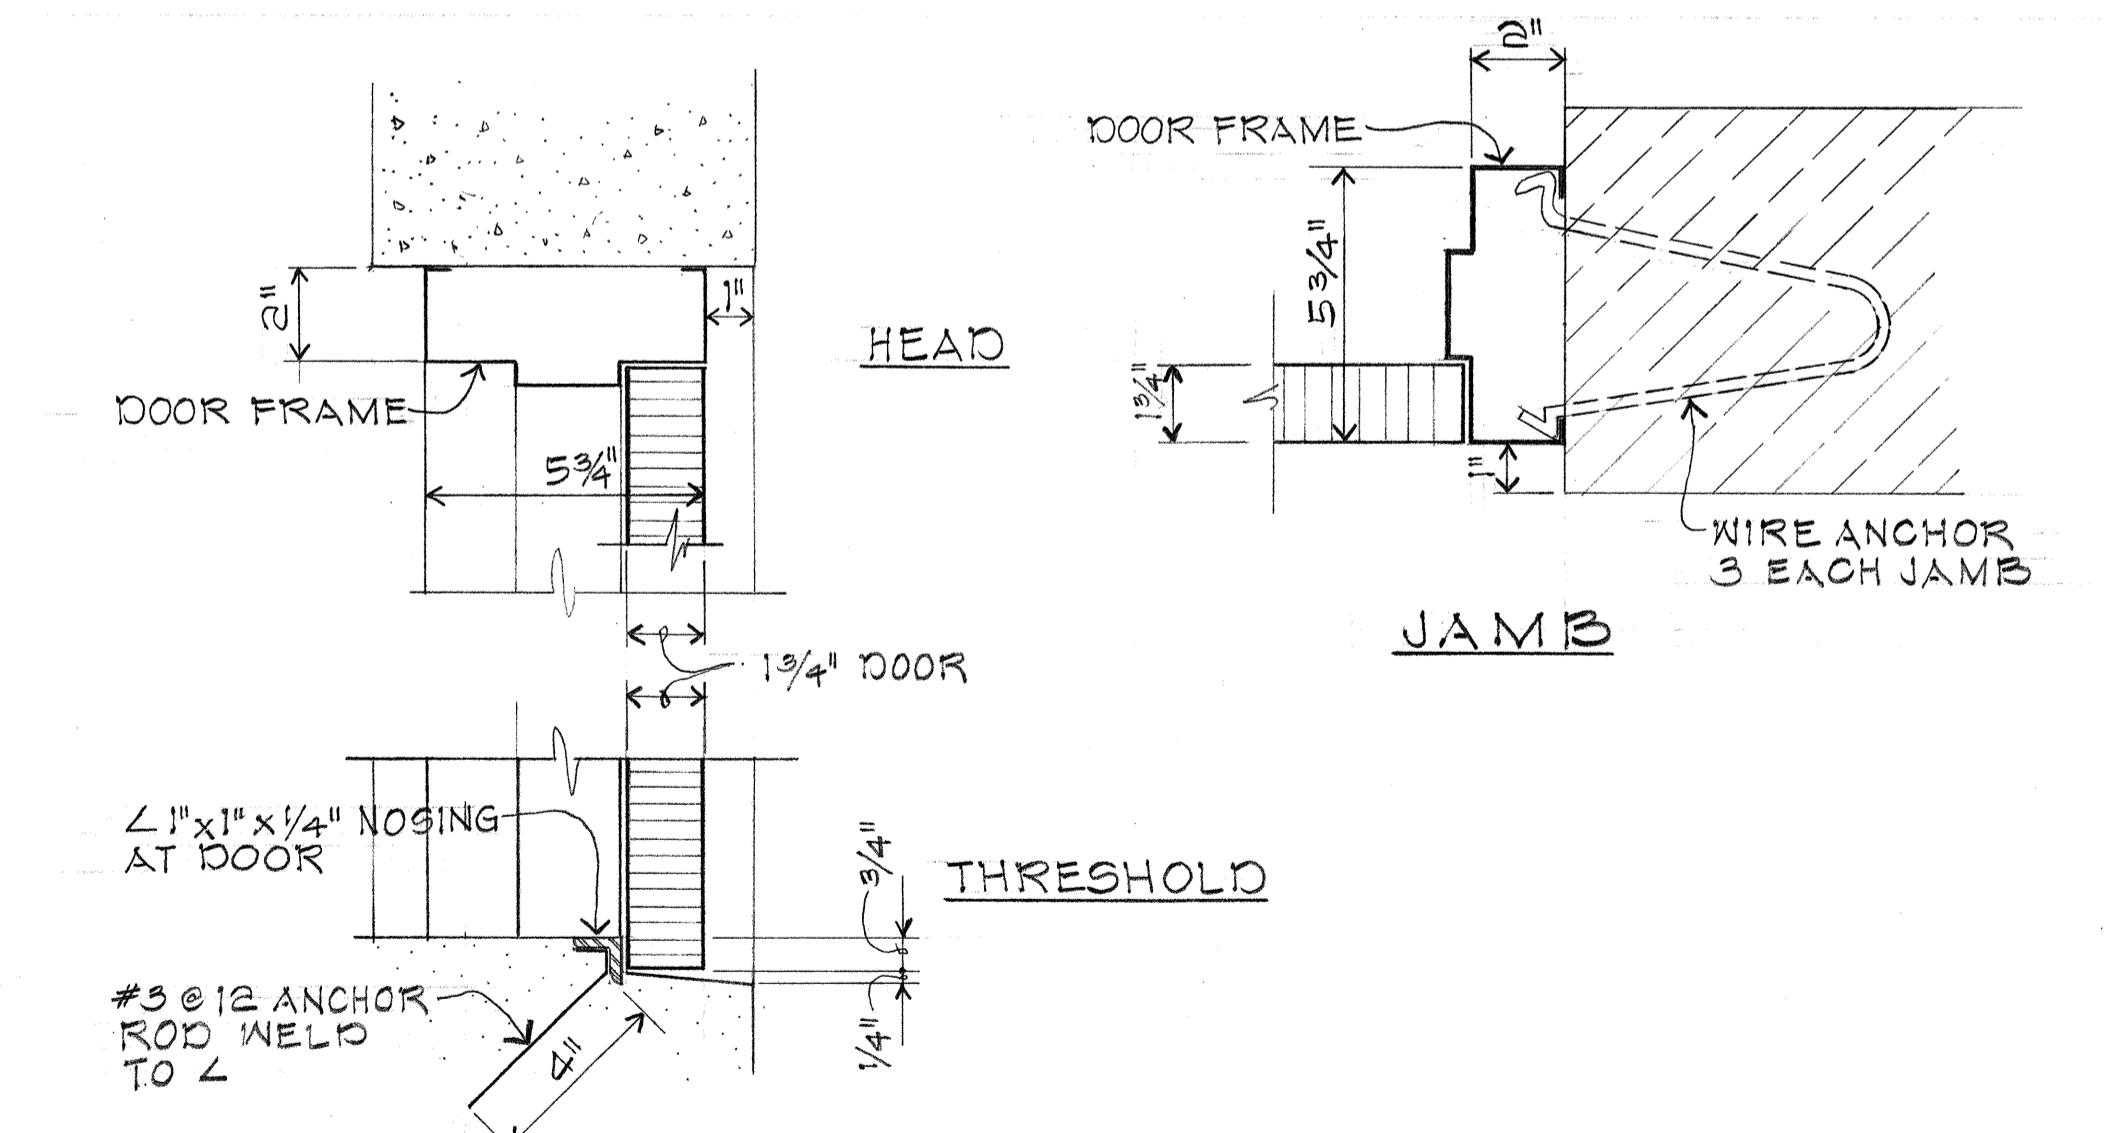


## DOOR PI DETAILS

STATE OF HAWAII  
**DEPARTMENT OF TRANSPORTATION**  
HIGHWAYS DIVISION

FED. ROAD DIST. NO.	STATE	FED. AID PROJ. NO.	FISCAL YEAR	SHEET NO.	TOTAL SHEETS
HAWAII	HAW.	I-H-1(02):13	1976	44	50

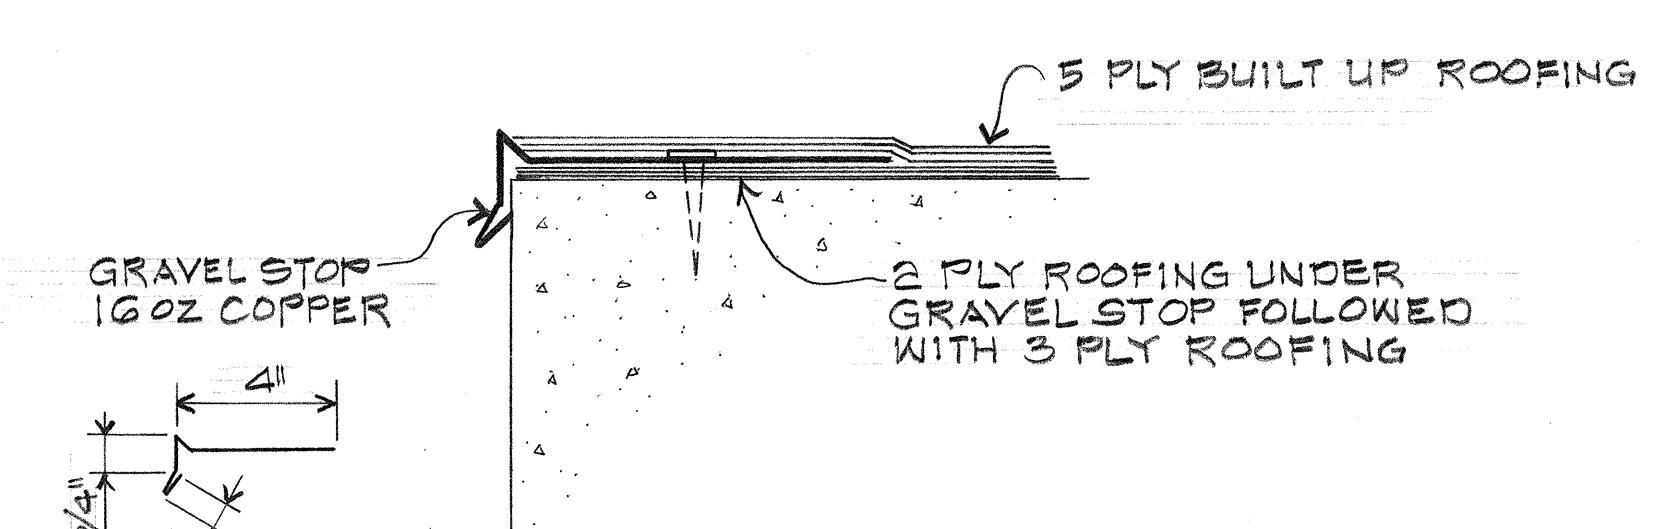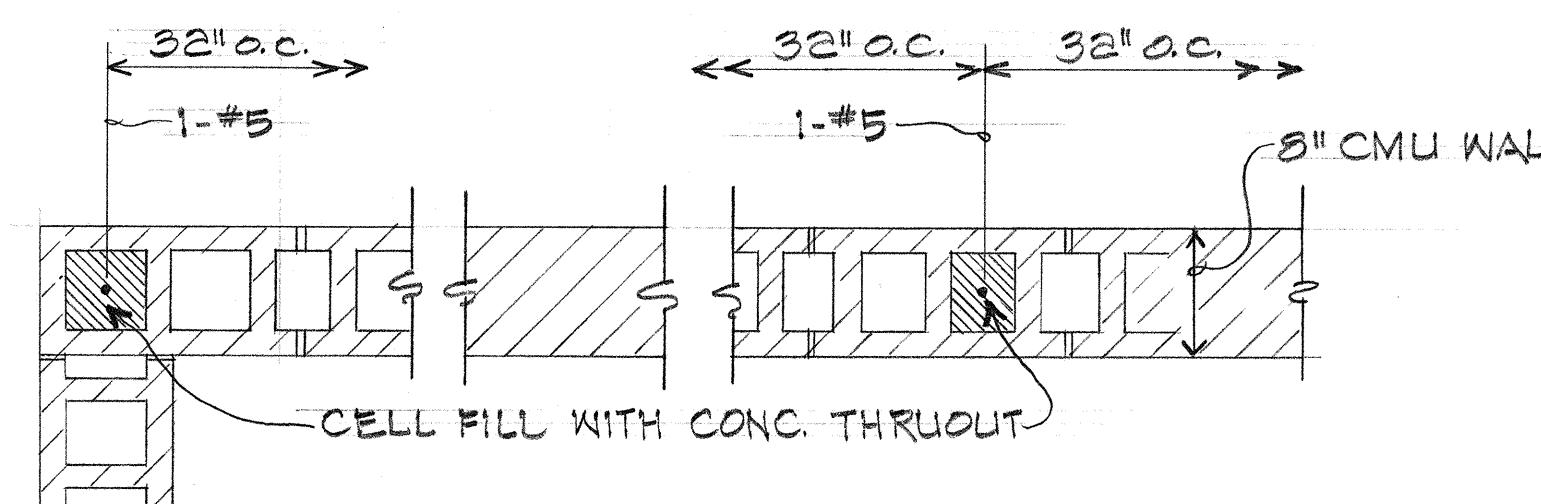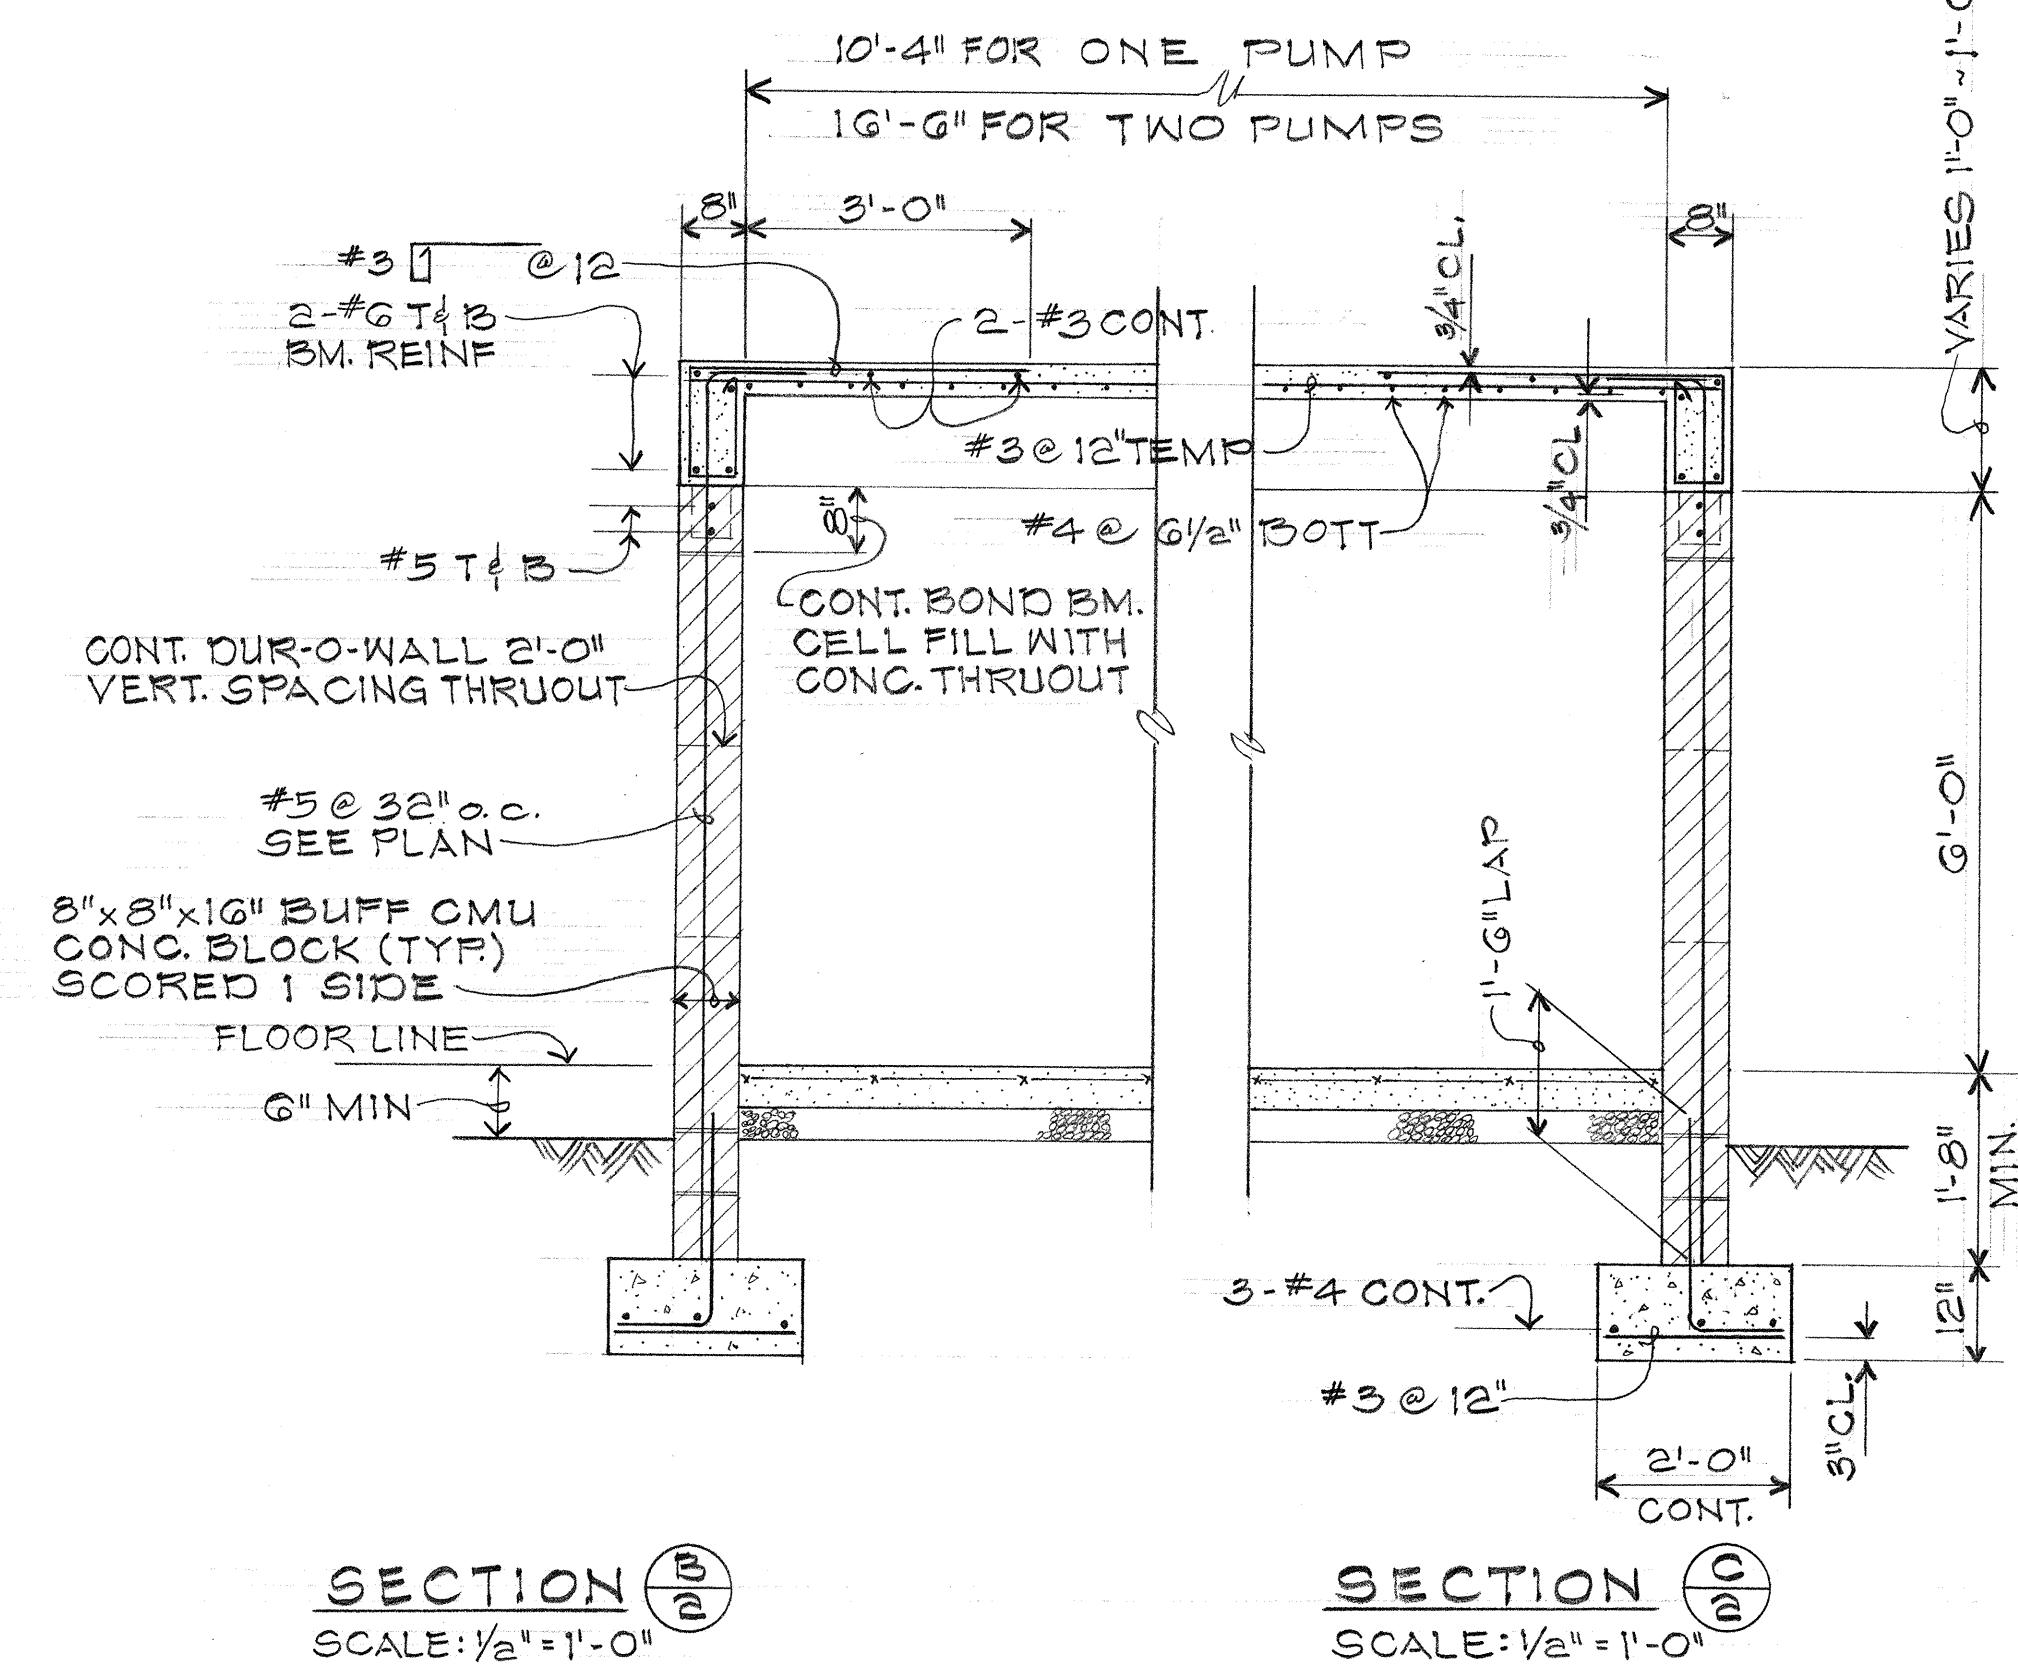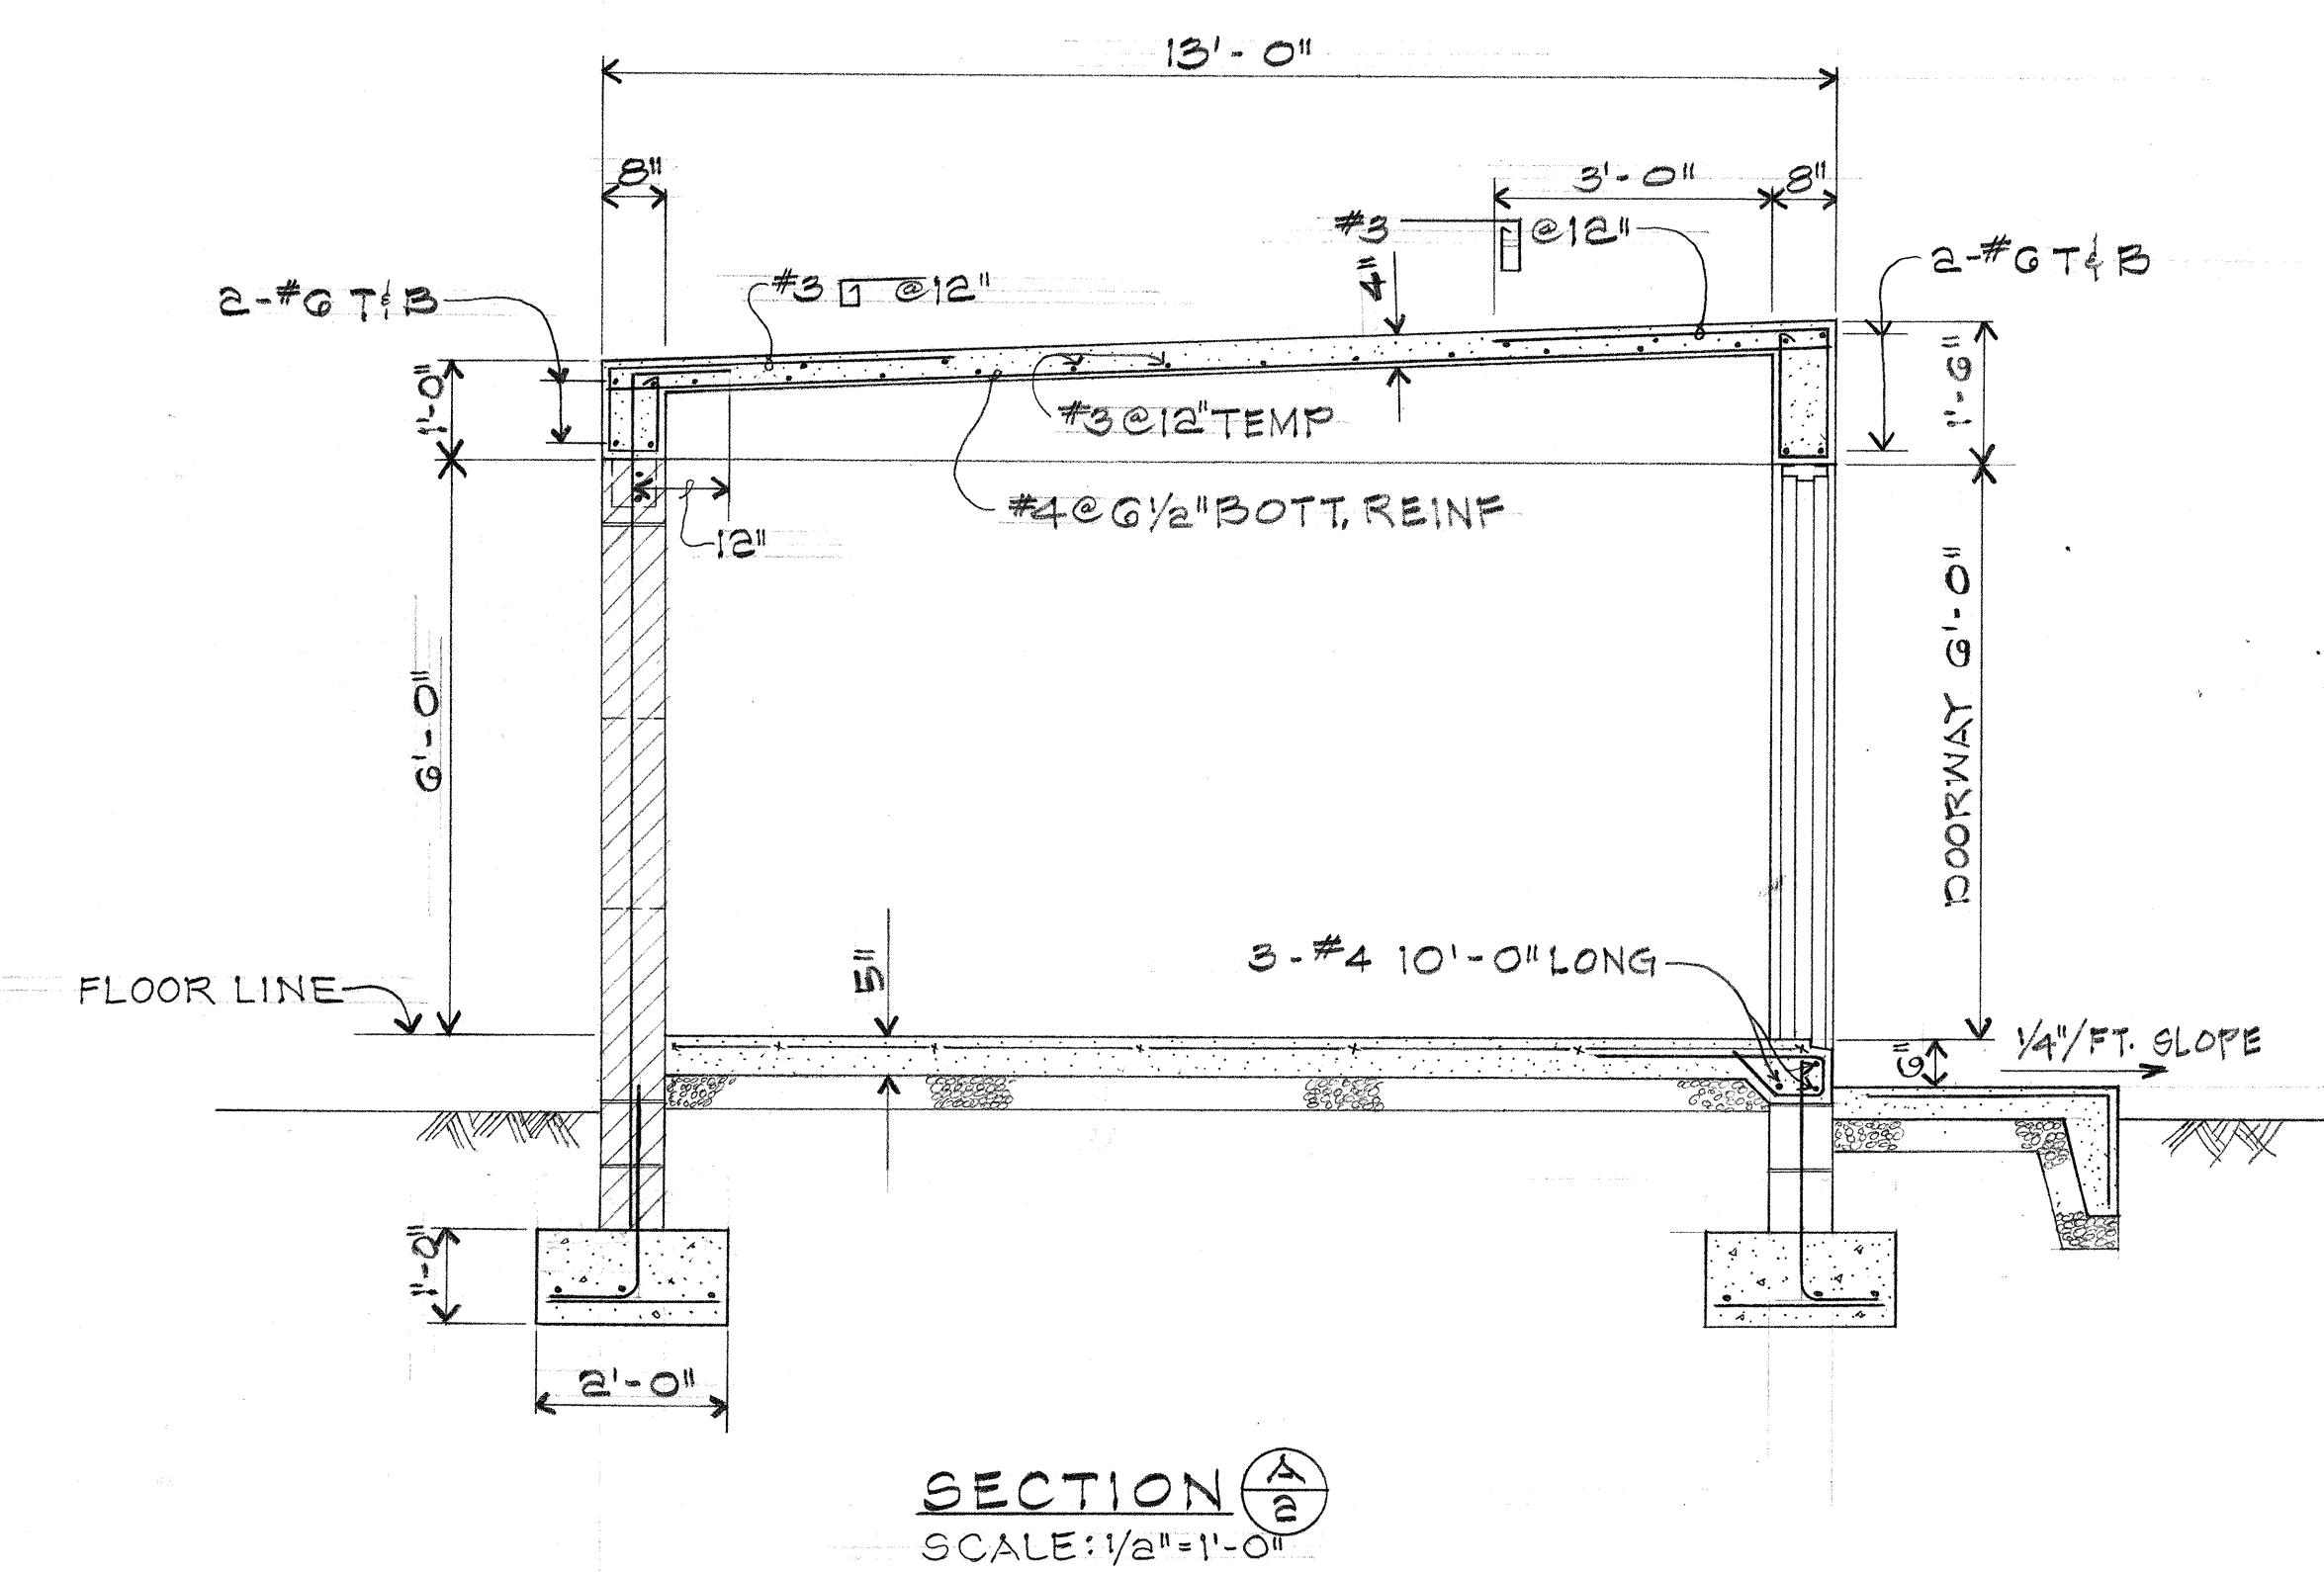

ORIGINAL	PLOTTED BY
PLAN	
DRAWN BY	
TRACED BY	
DESIGNED BY	
QUANTITIES BY	
CHECKED BY	
No.	

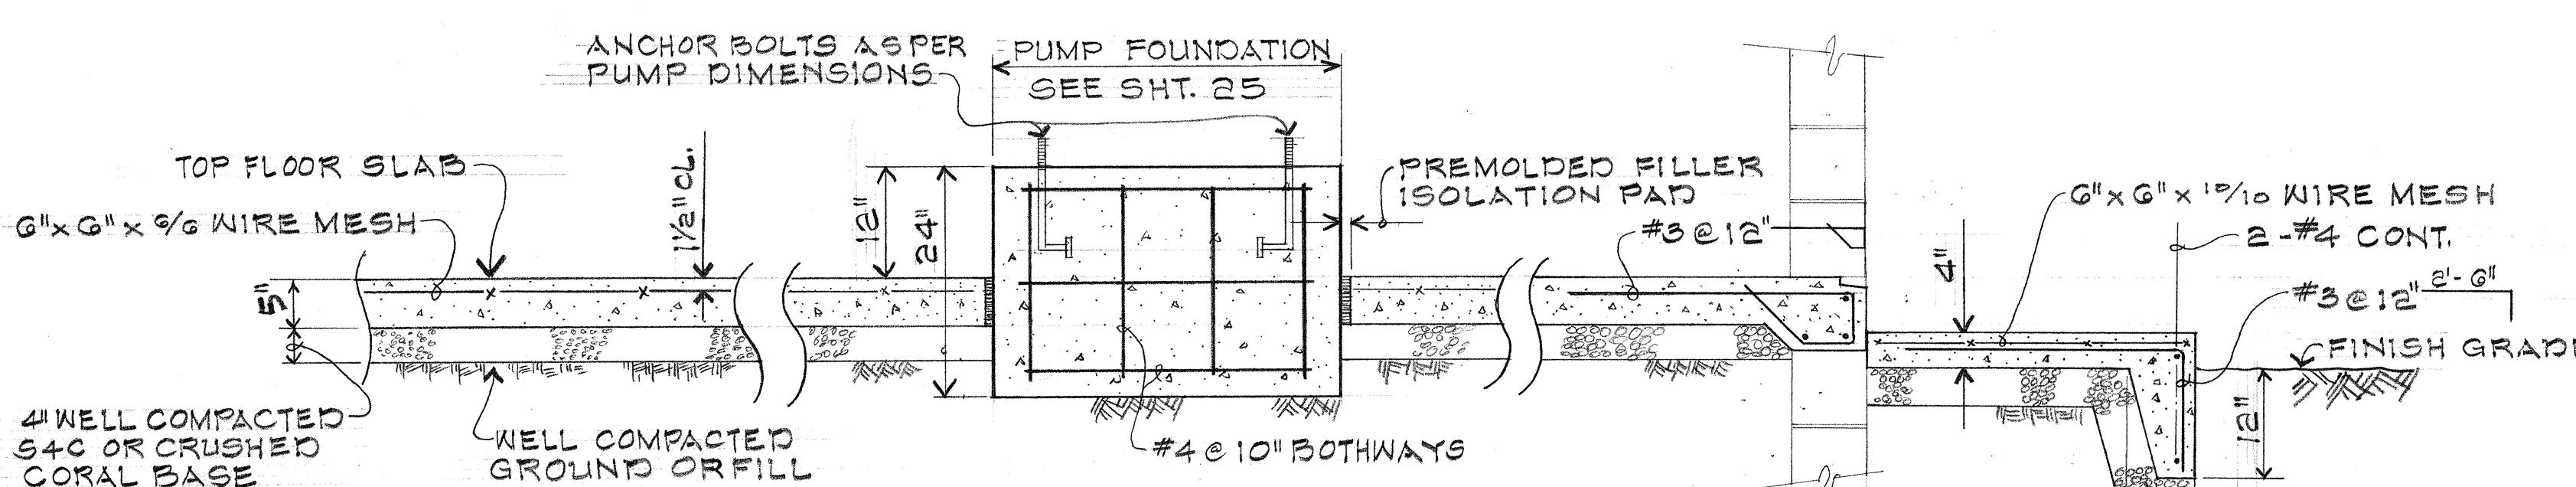

STATE OF HAWAII  
DEPARTMENT OF TRANSPORTATION  
HIGHWAYS DIVISION  
IRRIGATION SYSTEM  
DETAILS FOR PUMP HOUSE  
INTERSTATE ROUTE H-1  
PROJ. NO. I-H-1(02):13  
Scale: As Shown Date: Mar. 1976  
SHEET NO. 12 OF 12 SHEETS

FED. ROAD DIST. NO.	STATE	FED. AID PROJ. NO.	FISCAL YEAR	SHEET NO.	TOTAL SHEETS
HAWAII	HAW.	I-HI-1(02):13	1976	45	50

CONTROLLER NO.	A1	A2	B1	B2	C1	C2	D1	D2	E1	E2	F1	F2	G1	H1	H2
STATION NO.	TIME SPRINKLER														
1	4 S-13	4 S-13	4 S-13	6 P-5G	6 J-35	6 P-37	6 J-35	6 S-13	6 J-35	6 S-13	6 J-35	6 S-13	6 J-35	6 J-35	6 J-65
2	6 J-35	6 J-65													
3	6 J-25	6 J-35	6 J-35	8 J-30	6 J-35	4 P-37	6 J-35	6 J-25	6 J-35	4 P-37	6 S-13	4 P-37	6 J-25	8 J-30	6 J-65
4	6 J-35	8 J-30	6 J-35	6 J-65											
5	2 Nozzle	6 J-30	6 J-30	6 J-35	6 J-35	6 J-35	6 J-35	6 J-25	2 S-51	6 J-35	6 J-30	6 J-35	6 J-35	6 J-35	6 S-13
6	2 Nozzle	6 J-30	8 J-30	6 J-25	6 P-84	8 J-25	6 J-35	6 J-30	8 J-30	6 J-30	6 P-5G	—	6 S-13	6 J-40	6 J-40
7	4 S-13	6 J-30	6 J-35	6 J-25	6 P-84	6 J-35	8 J-30	6 J-30	6 S-13	6 P-41	6 J-35	—	6 J-25	8 J-40	6 J-40
8	6 P-37	6 J-30	6 J-35	6 J-25	6 J-30	6 J-35	6 J-30	6 J-35	8 J-30	6 J-30	—	6 J-35	6 J-35	6 J-35	6 J-35
9	6 P-84	6 P-84	6 J-35	4 S-13	6 J-30	8 J-30	—	6 J-30	6 S-13	—	—	—	—	6 J-35	6 J-35
10	6 P-84	6 J-30	6 P-41	6 P-41	6 J-30	—	—	6 J-30	6 P-41	—	—	—	—	—	—
TOTAL TIME	48	58	60	60	60	58	50	56	60	50	50	28	48	54	58

CONTROLLER NO.	I1	I2	J1	K1	K2	L1	L2	M1	N1	N2	O1	P1	P2	Q1	Q2
STATION NO.	TIME SPRINKLER														
1	4 P-62	6 P-37	6 J-35	6 J-35	6 J-35	6 P-5G	6 J-35	4 S-51	6 P-5G	6 J-35	6 J-35	6 J-35	6 J-35	6 P-84	6 J-35
2	6 J-35	6 S-13	8 J-30	6 J-35	6 J-35	6 J-65	6 J-35	4 P-37	6 J-35	6 J-35	4 P-37	6 J-35	6 J-30	6 J-30	6 J-35
3	4 P-37	8 J-30	6 J-35	6 J-35	6 J-35	6 J-65	6 J-35	8 J-35	6 J-35	6 J-35	6 J-35	6 J-35	8 J-30	6 J-30	6 J-35
4	6 J-35	6 J-35	6 J-35	6 J-65	6 J-35	6 J-40	6 J-65	6 J-25	6 J-30	6 J-35	6 J-30	8 J-30	6 P-84	6 P-84	6 S-13
5	8 J-30	8 J-30	8 J-30	6 J-30	6 J-35	6 J-65	6 J-65	4 P-37	6 J-40	6 S-4	6 J-35	6 P-84	6 P-84	6 J-35	6 J-35
6	6 P-41	6 J-65	6 J-65	6 J-30	—	6 J-30	—	6 J-30	6 J-35	4 P-37	6 J-40	6 J-35	8 J-30	6 P-84	6 J-35
7	6 P-84	8 J-30	6 J-35	6 J-35	—	6 J-40	6 J-35	6 J-35	6 J-40	6 J-40	6 J-35	—	6 J-35	6 P-84	6 J-30
8	6 P-84	8 J-30	8 J-30	6 J-30	6 J-25	—	6 J-35	6 P-41	6 P-84	6 J-40	6 J-35	—	6 J-30	6 P-84	6 J-35
9	8 J-30	—	6 J-65	6 J-65	6 J-35	—	6 J-65	—	6 J-30	6 J-40	6 J-30	—	6 P-84	6 P-84	6 J-35
10	—	—	—	6 J-30	4 S-51										
TOTAL TIME	54	56	60	60	30	60	46	56	54	60	40	58	56	60	58

CONTROLLER NO.	R1	R2	S1	S2	G2	PROPOSED IRRIGATION PROGRAMS - (MAXIMUM OPERATION)		
STATION NO.	TIME SPRINKLER	EVERYDAY WATERING START TIMES 0.30"/DAY @ 0.025"HR.						
1	6 S-13	6 J-35	6 J-35	6 S-13	6 S-13	28	None	
2	6 J-35	6 J-30	6 J-35	6 J-35	6 S-13	6 J-13	A1,B1,I2,J1	370 12,4,8 12,4,8 Sun,Thur Mon,Wed,Fri
3	6 P-84	6 J-30	6 J-35	6 J-35	6 S-13	6 J-25	A2,P2,H2,I1	410 1,5,9 1,5,9 Mon,Fri Tue,Thu,Sat
4	4 P-37	6 J-35	8 J-30	6 J-30	6 S-13	4 P-37	C1,M1,K1,K2	303 2,6,10 2,6,10 Tue,Sat,Wed
5	4 P-37	6 J-35	6 J-35	—	6 P-41	6 C2,L1,I2,H1,T	424 3,7,11 3,7,11 Wed, Sun,Thur,Fri	
6	6 J-35	6 J-30	—	—	8 J-30	6 E1,F1,G1,I1	415 12,4,8 12,4,8 Sun,Thur,Fri,Mon,Wed,Fri	
7	6 P-84	6 J-35	—	—	—	6 F1,G1,P1,N1	311 1,5,9 1,5,9 Mon,Fri,Tue	
8	6 P-84	6 P-84	—	—	—	6 R1,S1,G2,N-2	370 2,6,10 2,6,10 Tue,Sat,Wed	
9	8 J-40	6 P-84	—	—	—	6 O1,D1,O2,R2	331 3,7,11 3,7,11 Wed, Sun,Thur,Fri	
10	6 P-84	4 P-37	—	—	—			
TOTAL TIME	58	58	32	24	58			

EST. CONSUMPTIVE USE MONTH	MEAN DAILY RAINFALL	MEAN DAILY RAINFALL	TIME REQUIRED, HRS/DAY AT 70%
MONTH	FOR MEAN DAILY RAINFALL W/ RAIN	FOR MEAN DAILY RAINFALL W/ NO RAIN	
JAN	.06"	0.15"	~8 16
FEB	.06"	0.15"	~8 16
MAR	.08"	0.15"	8 16
APR	.11"	0.18"	~8 20
MAY	.15"	0.20"	16 20
JUN	.15"	0.18"	16 20
JUL	.18"	0.22"	20 24
AUG	.18"	0.24"	20 24
SEPT	.15"	0.18"	16 20
OCT	.15"	0.18"	16 20
NOV	.07"	0.15"	~8 16
DEC	.01"	0.15"	16

STATION NO.	TIME MIN.	SPRINKLER





<tbl\_r cells="3" ix="5" maxcspan="1" maxrspan="1" usedcols

FED. ROAD DIST. NO.	STATE	FED. AID PROJ. NO.	FISCAL YEAR	HEET NO.	TOTAL SHEETS
HAWAII	HAW.	I-HI-1(92)13	1976	46	50

SPRINKLER		SCHEDULE												
SYMBOL	TYPE SPRINKLER	SPRAY PATTERN	RISER CONNECTION (TIPS)	OPERATING PRESSURE (PSI)	NOZZLE SIZE	APPROXIMATE DISCHARGE (GPM)	RADIUS	ADJ. ARC STOP *	DISCHARGE ADJUSTMENT	BACKSPLASH PREVENTION DEVICE	MATERIAL	ADJ. DIST. CONTROL	TYPIICAL * TYPING	REMARKS
-○-	J-25P ROTARY SIDE IMPACT	P	1/2"	35	9/64"	3.4	38'	✓	-	✓	BB	BAFFLE	40'	
-●-	J-30F ROTARY SIDE IMPACT	F	3/4"	40	9/64" x 3/32"	5.2	41'	-	-	-	BB	-	50'	
-●-	J-35P ROTARY SIDE IMPACT	P	3/4"	40	11/64"	5.4	45'	✓	-	✓	BB	BAFFLE	50'	
-⊗-	J-40F ROTARY SIDE IMPACT	F	3/4"	45	3/16" x 3/32"	8.0	51'	-	-	-	BB	-	50'	
-○-	J-65P ROTARY SIDE IMPACT	P	1"	55	7/32"	10.4	56'	-	-	-	BB	BAFFLE	60'	
-△-	P-30P STREAM ROTOR POP-UP	P	3/4"	35	-	1.4	21'	-	-	-	PL	-	25'	MIN. 3" POP-UP
-■-	P-37P ROTOR POP-UP SIDE IMPACT	P	1"	45	13/64"	7.8	44'	-	-	-	BB	-	50'	MIN. 2" POP-UP, BB, AL OR CI HOUSING
-■-	P-41F ROTOR POP-UP SIDE IMPACT	F	1"	45	AS PER mfg	11.5	51'	-	-	-	BB	-	50'	MIN. 2" POP-UP BB, AL OR CI HOUSING
-○○	P-50FHQ STREAM SPRAY POP-UP	FHQ	1/2" or 3/4"	30-35	-	0.7-2.9	22'	-	-	-	BB or PL	-	20'	MIN. 2" POP-UP
-■-	P-62P ROTOR POP-UP	P	3/4"	50	-	5	43'	-	✓	-	PL	-	40'	MIN. 2 3/8" POP-UP
-■-	P-84F ROTOR POP-UP	F	1"	60	AS PER mfg	17.0	56'	-	-	-	BB	-	60'	MIN. 1" POP-UP, BB, AL OR CI HOUSING
-●○	S-13FHQ STREAM SPRAY	FHQ	1/2"	30	-	0.8-2.1	22'	-	✓	-	BB or PL	-	20'	
-●-	S-4H FAN SPRAY W/NOZZLE ADAPTER 1/2" FEMALE	H	1/2"	15	-	0.3	4'	-	-	-	BB or PL	-	AS SHOWN	
-▲-	S-51F BUBBLE HEAD	FLO	1/2"	30	-	2.4	-	-	✓	-	BB or PL	-	AS SHOWN	
-×-	D Emitter	-	-	-	-	-	-	-	-	-	-	-	SEE SPEC. PROVISION	

P - PART CIRCLE  
F - FULL CIRCLE  
H - HALF CIRCLE  
Q - QUARTER CIRCLE


\* ALL ADJUSTABLE ARC STOPS  
SHALL BE POSITIVE LOCKING  
\*\* UNLESS OTHERWISE NOTED ON PLANS

BB - BRASS OR BRONZE  
PL - PLASTIC  
AL - ALUMINUM  
CI - CAST IRON


ORIGINAL SURVEY PLOTTED BY	DATE
PLAN	"
DRAWN BY	"
TRACED BY	"
DESIGNED BY	"
QUANTITIES BY	"
CHECKED BY	"
No. _____	"

STATE OF HAWAII  
DEPARTMENT OF TRANSPORTATION  
HIGHWAYS DIVISION  
IRRIGATION SYSTEM  
SPRINKLER SCHEDULE  
INTERSTATE ROUTE H-1  
PROJ. NO. I-HI-1(92)13  
Date: Mar 1976  
SHEET NO. 128 OF 32 SHEETS



FED. ROAD DIST. NO.	STATE	FED. AID PROJ. NO.	FISCAL YEAR	SHEET NO.	TOTAL SHEETS
HAWAII	HAW.	I-HI-1(92):13	1976	47	50

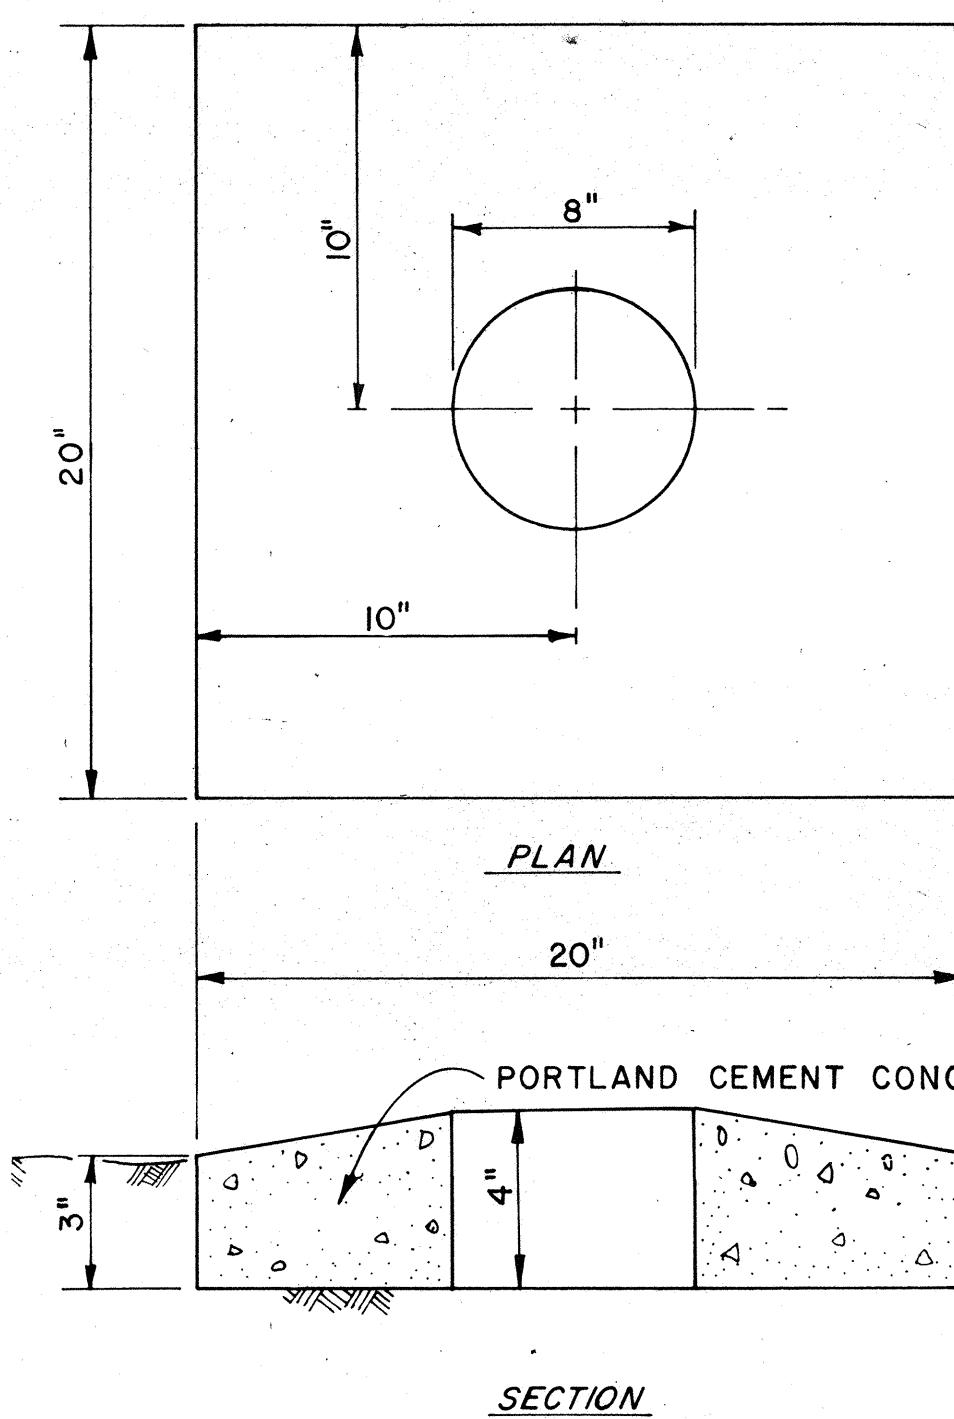

NOTE:  
INSTALL TOP OF  
PROTECTOR  
FLUSH WITH TOP  
OF SPRINKLER  
HEAD OR QUICK COUPLING  
VALVE.  
CONCRETE SHALL  
HAVE 2500 LBS.  
COMPRESSIVE  
STRENGTH AT THE  
AGE OF 28 DAYS.

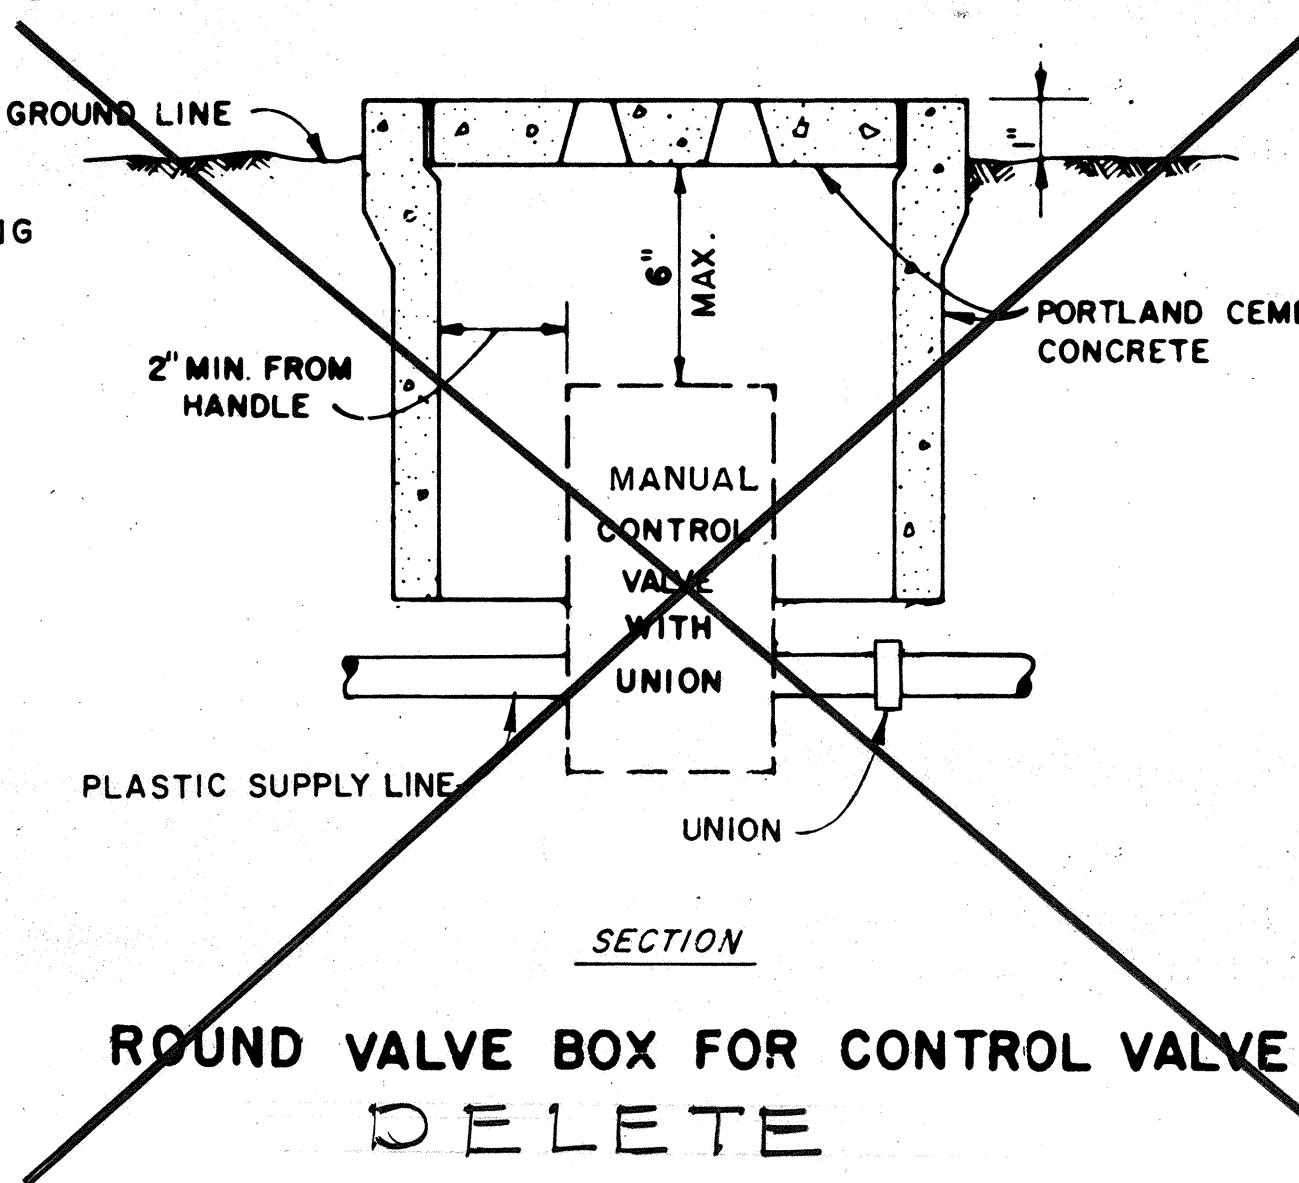

### CONCRETE PROTECTOR FOR TYPE "P-37 P" SPRINKLER

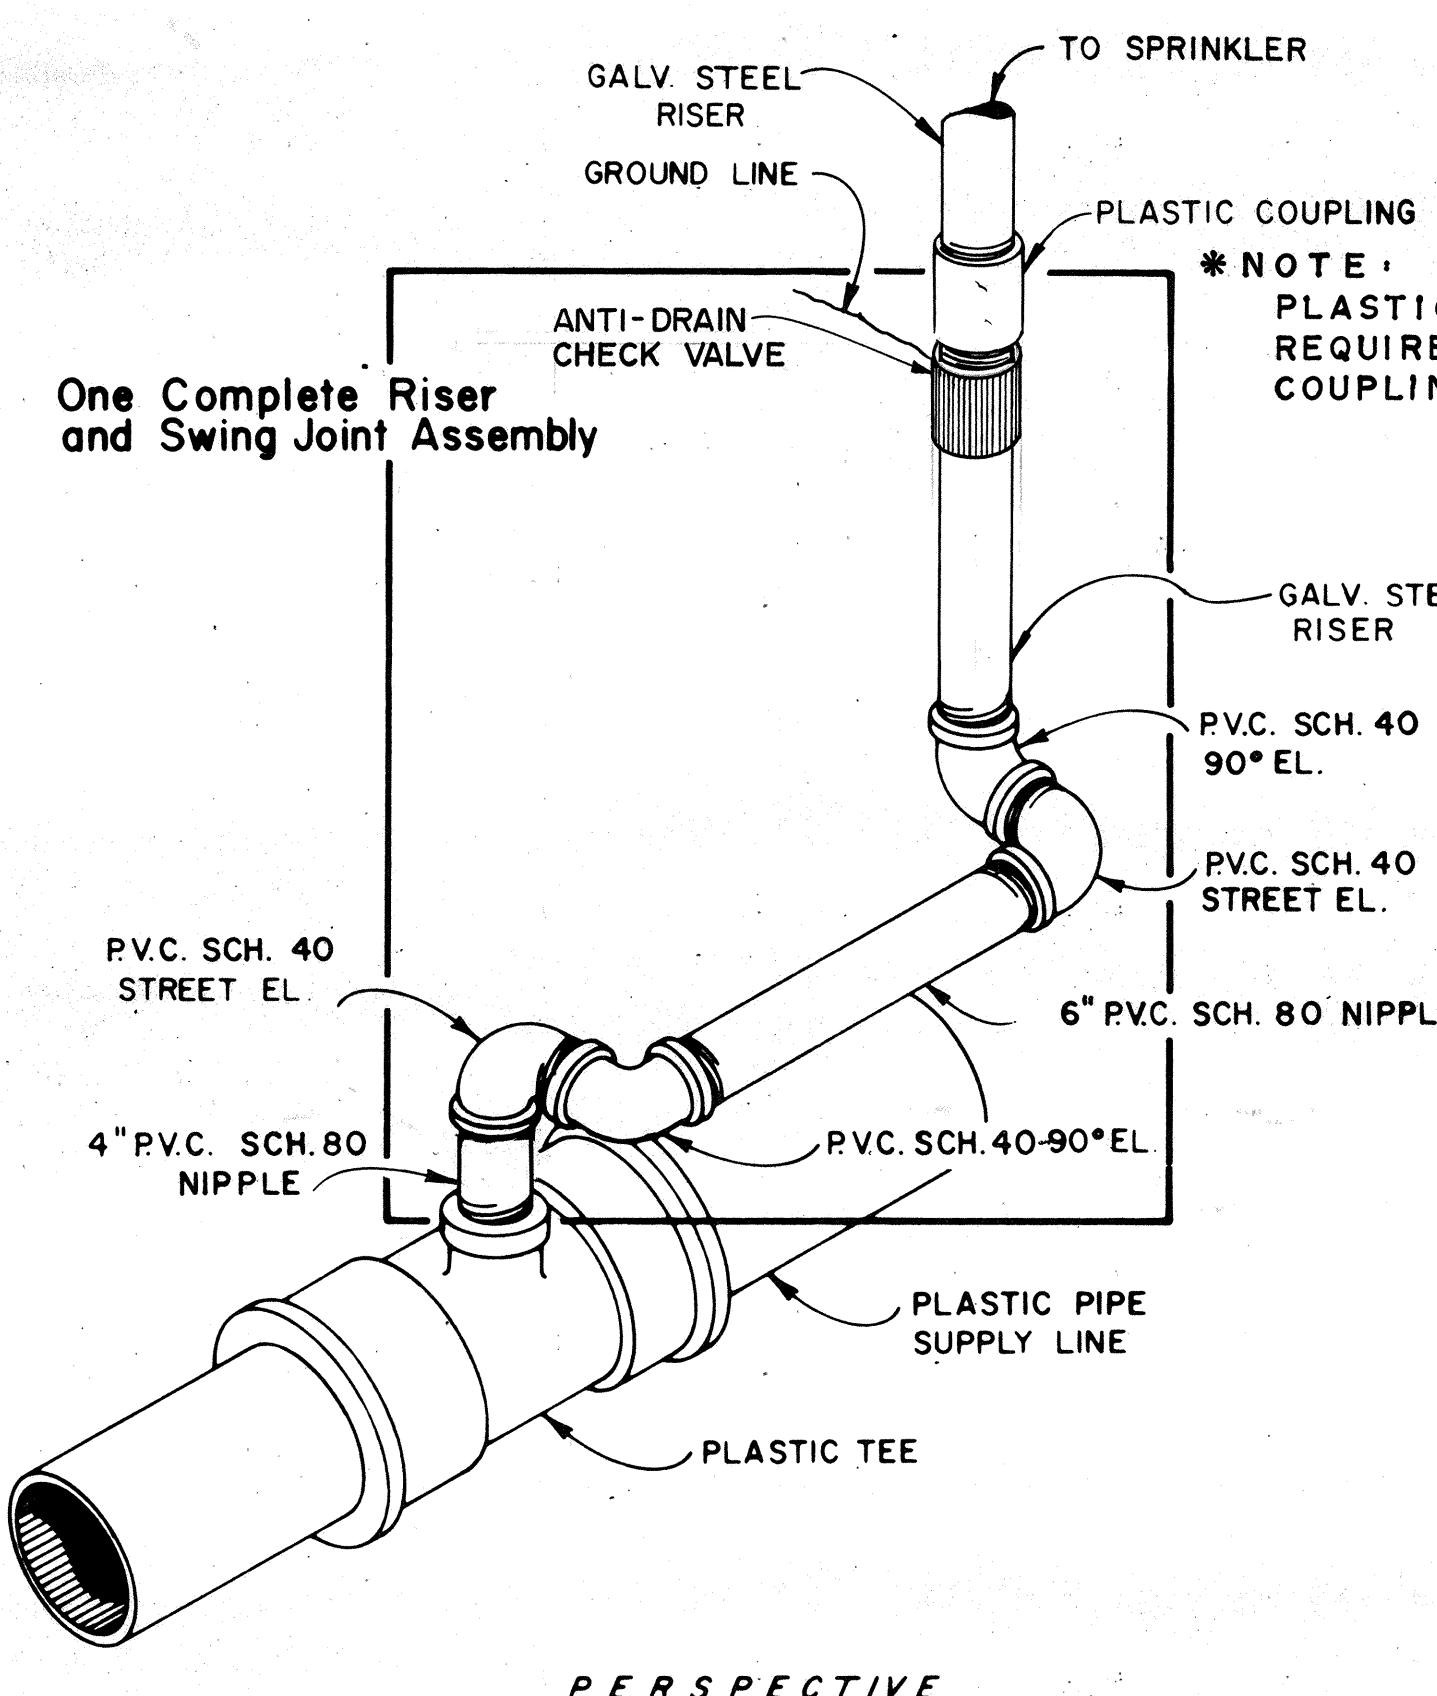
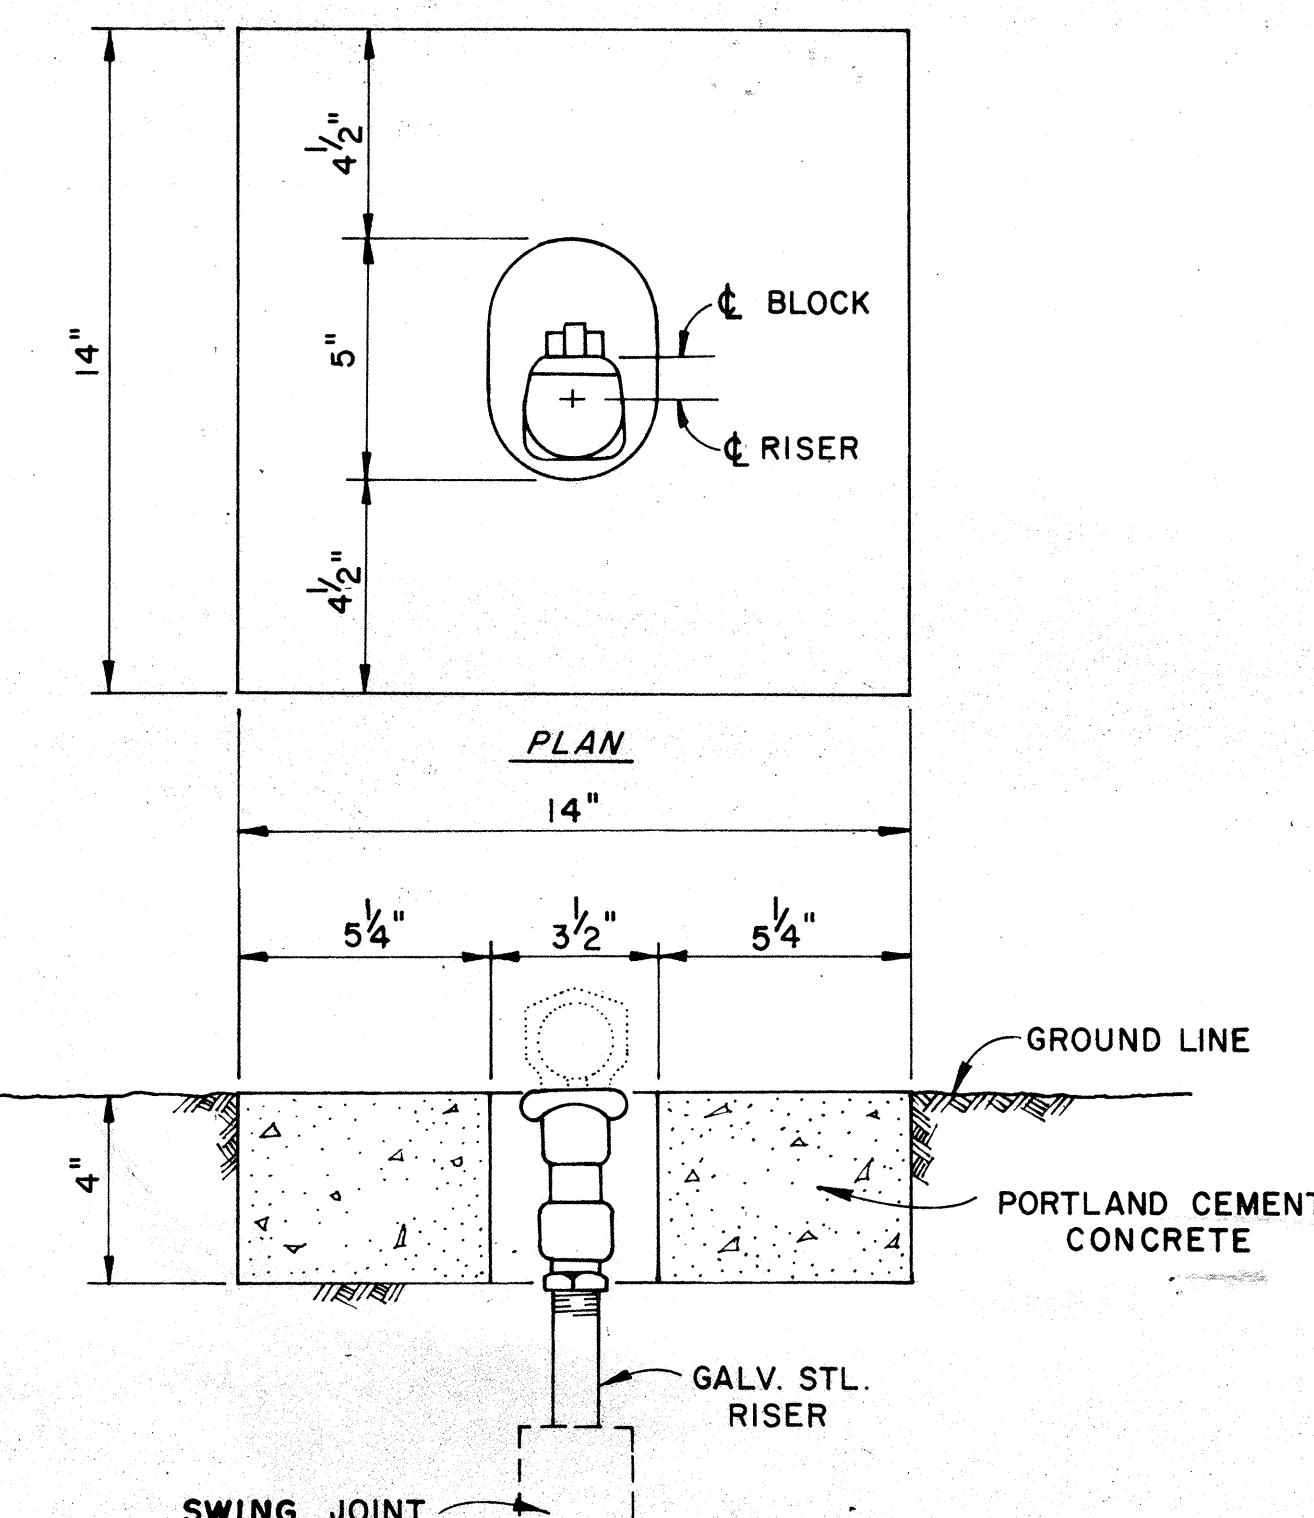


### RISER AND SWING JOINT ASSEMBLY

NOTE: THE SPRINKLER HEAD WITH THE REQUIRED RISER,  
SWING JOINT, ANTI-DRAIN CHECK VALVE AND CONCRETE  
PROTECTOR SHALL BE MEASURED AND PAID FOR AS A  
UNIT.


### VALVE PROTECTOR AND CONNECTION FOR QUICK COUPLING VALVE AND SPRINKLER TYPES P-30 P, P-56 P & P-62 P

ORIGINAL DRAWN BY  
SURVEY PLOTTED BY  
DRAWN BY  
TRACED BY  
DESIGNED BY  
QUANTITIES BY  
CHECKED BY  
NO.

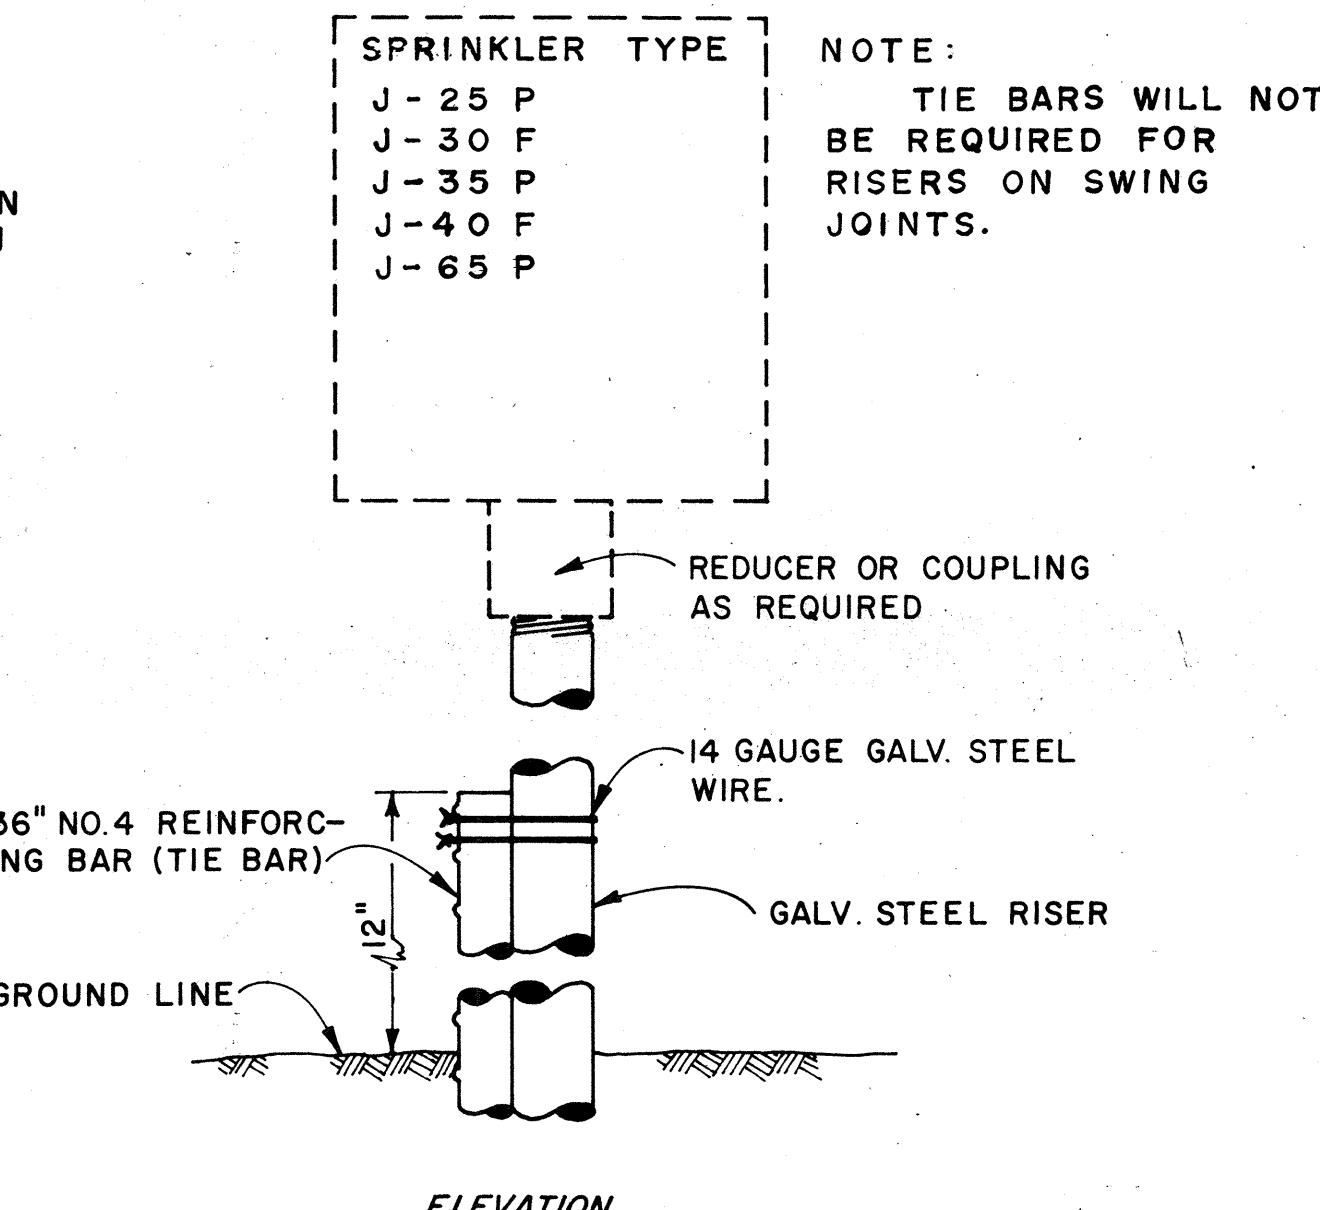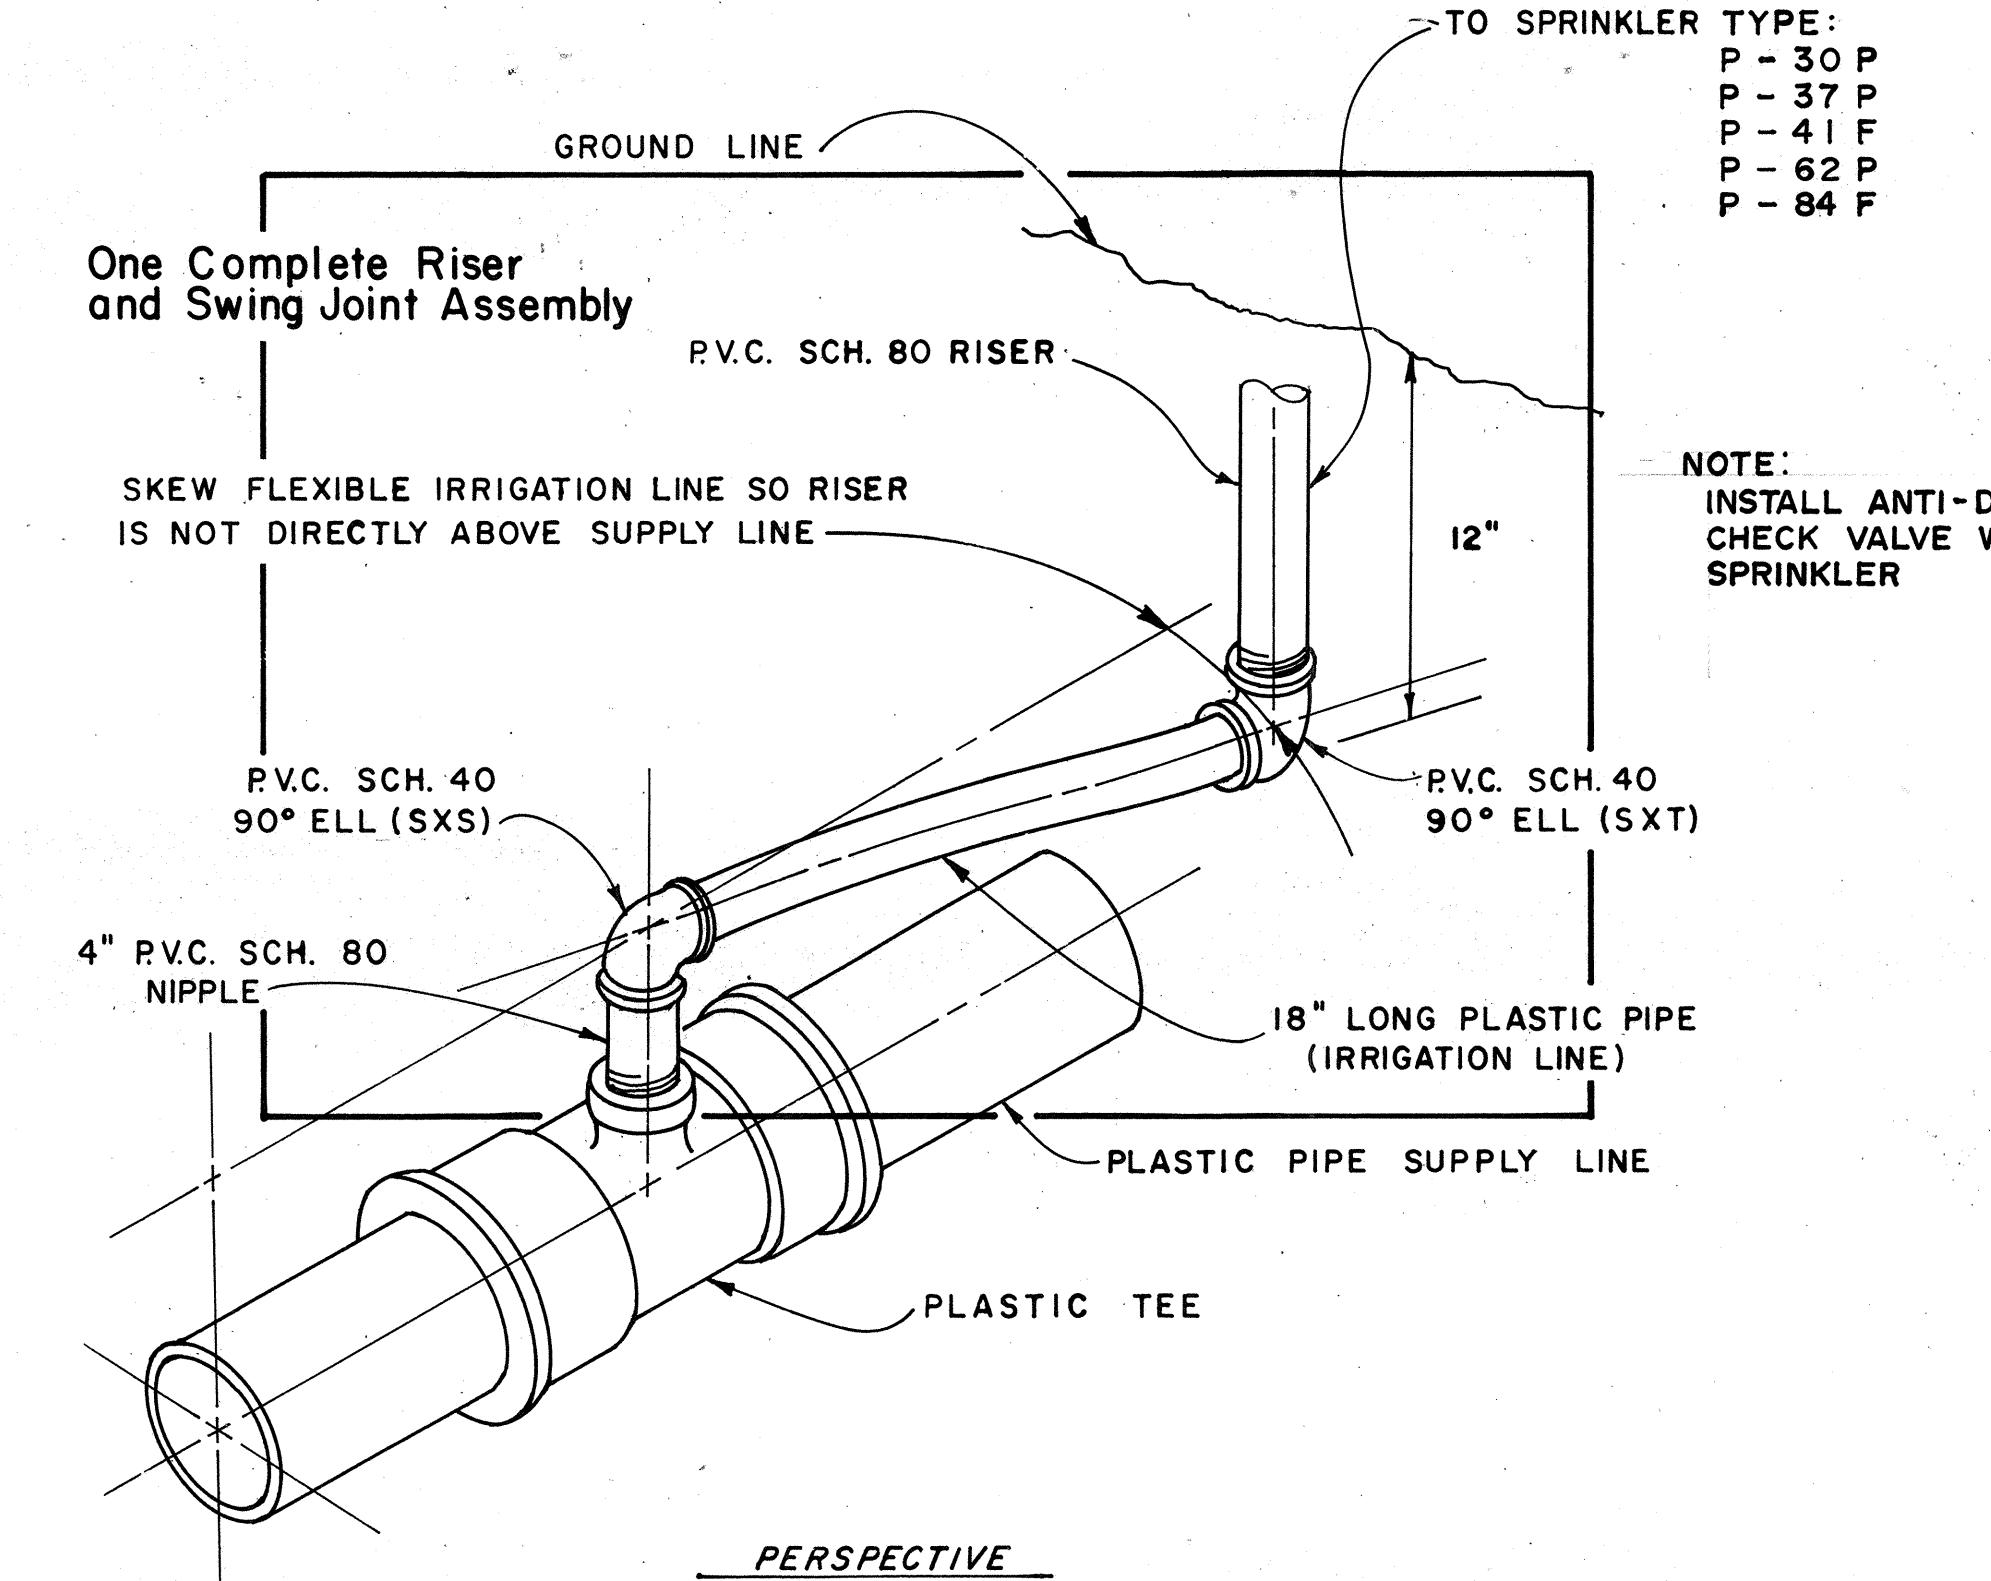

### RISER WITH TIE BAR

### RISER AND FLEXIBLE SWING JOINT ASSEMBLY

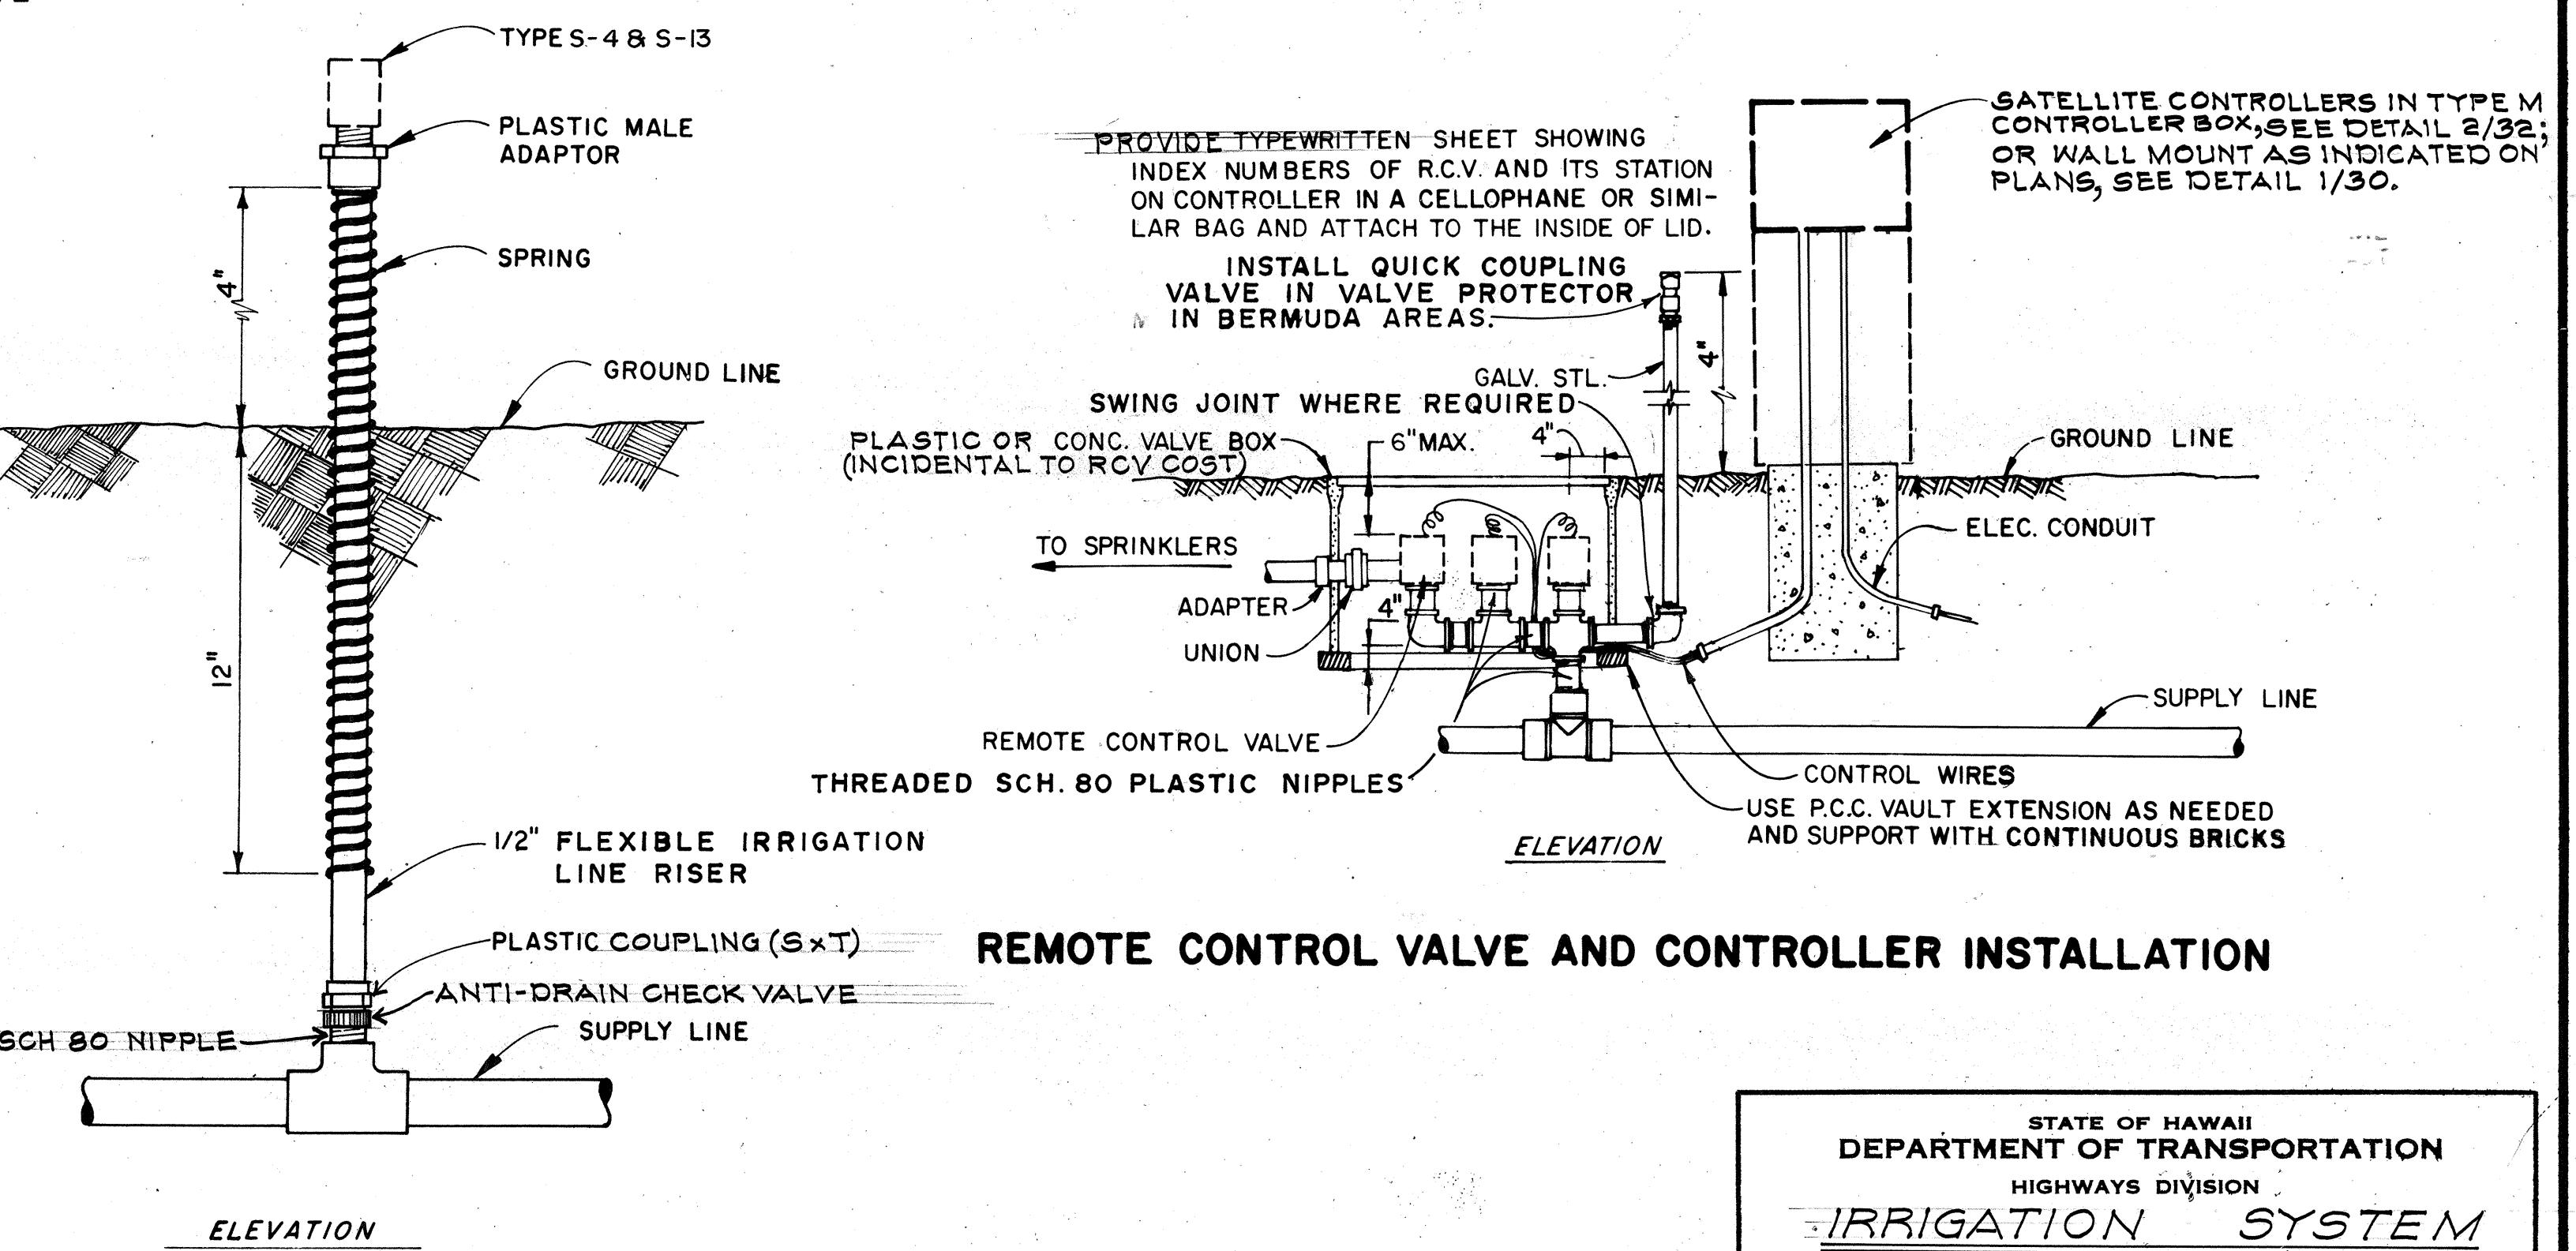


### REMOTE CONTROL VALVE AND CONTROLLER INSTALLATION


### RISER ASSEMBLY FOR TYPE S-4 & S-13 SPRINKLER

STATE OF HAWAII  
DEPARTMENT OF TRANSPORTATION  
HIGHWAYS DIVISION  
IRRIGATION SYSTEM  
DETAILS  
INTERSTATE ROUTE H-1  
PROJ. NO. I-HI-1(92):13  
Not to Scale Date: Mar 1976  
SHEET NO. I-29 OF 32 SHEETS


FED. ROAD DIST. NO.	STATE	FED. AID PROJ. NO.	FISCAL YEAR	SHEET NO.	TOTAL SHEETS
HAWAII	HAW.	I-HI-(02)-13	1976	48	50

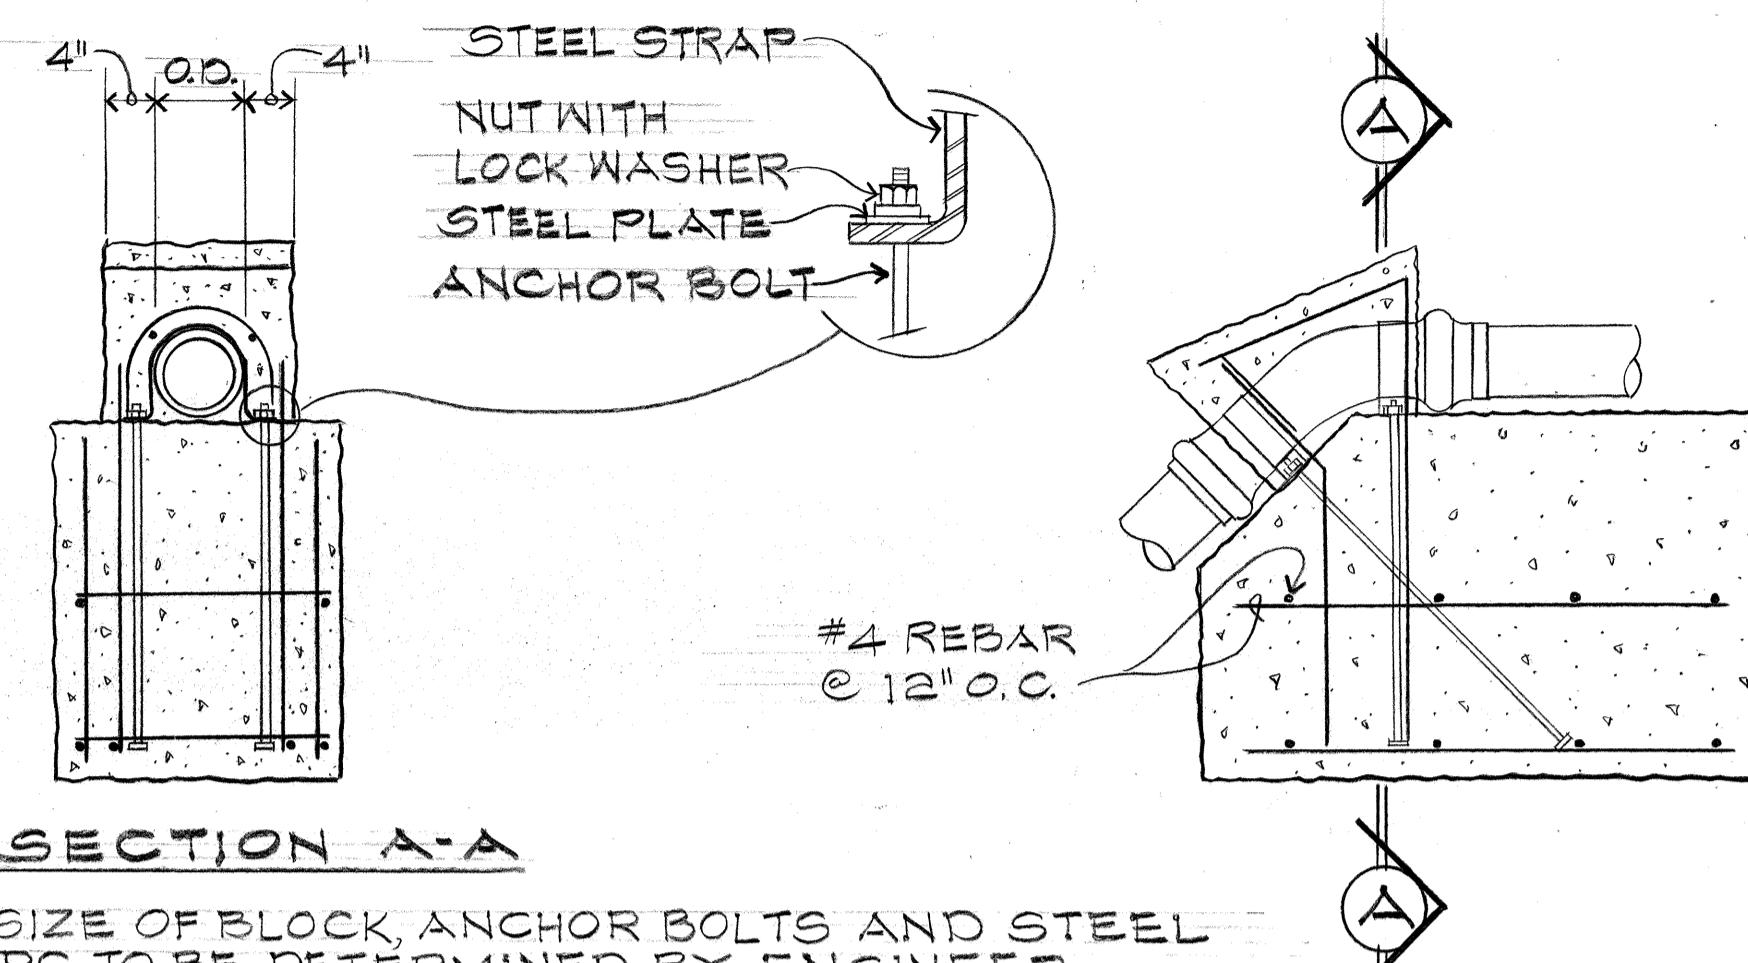

DETAILS AT VERTICAL BEND

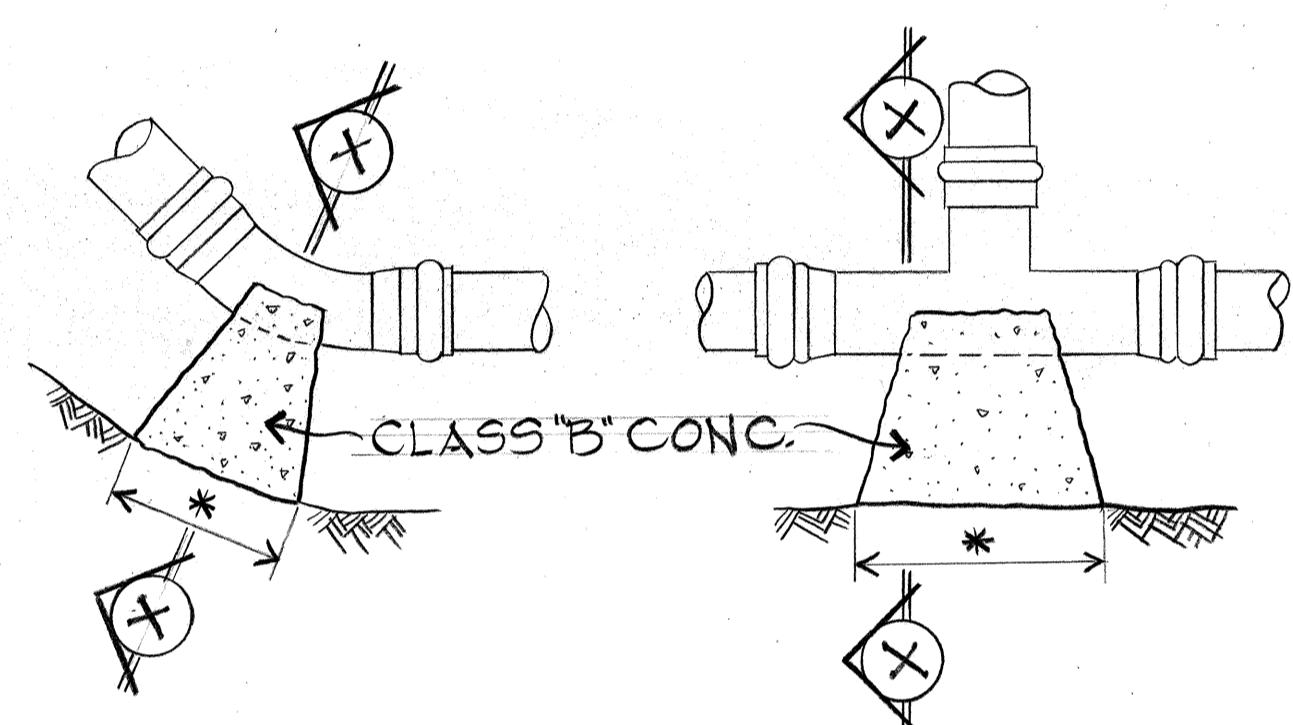

PLAN - TEES


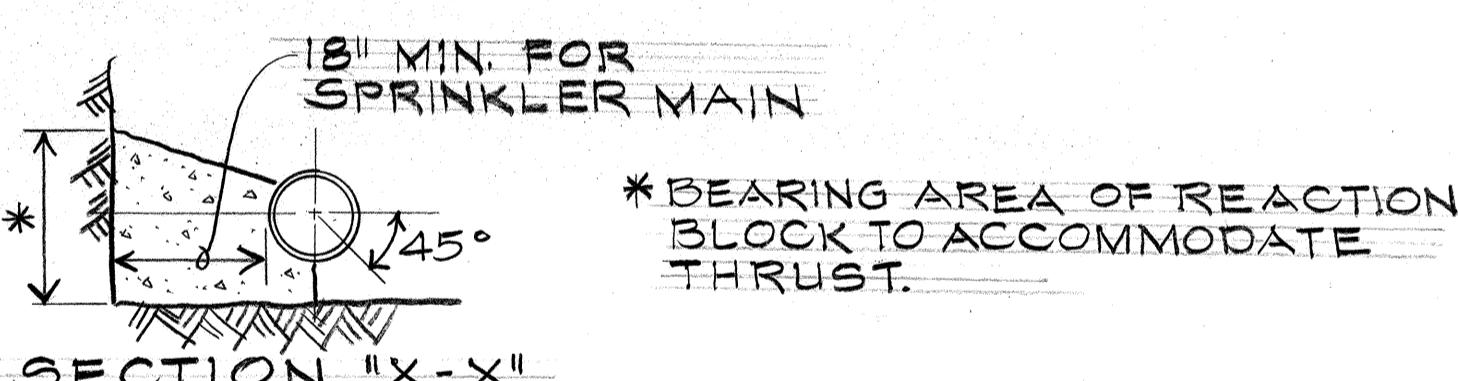


DETAILS AT HORIZONTAL BEND

SPRINKLER WATER MAIN			
THRUST AT FITTINGS, LBS. AT 100 PSI 120 PSI AWWA WATER HAMMER			
PIPE SIZE	90° EL	45° EL	TEE
2 1/2"	1,725	930	1,220
3"	2,550	1,380	1,880
4"	4,230	2,290	3,000
6"	9,150	5,000	6,470


SPRINKLER WATER LATERAL			
THRUST AT FITTINGS, LBS. AT 100 PSI			
PIPE SIZE	90° EL	45° EL	TEE
1 1/2"	345	185	245
2"	535	235	380
2 1/2"	785	425	555
3"	1,160	630	820

DETAILS OF REACTION BLOCKS

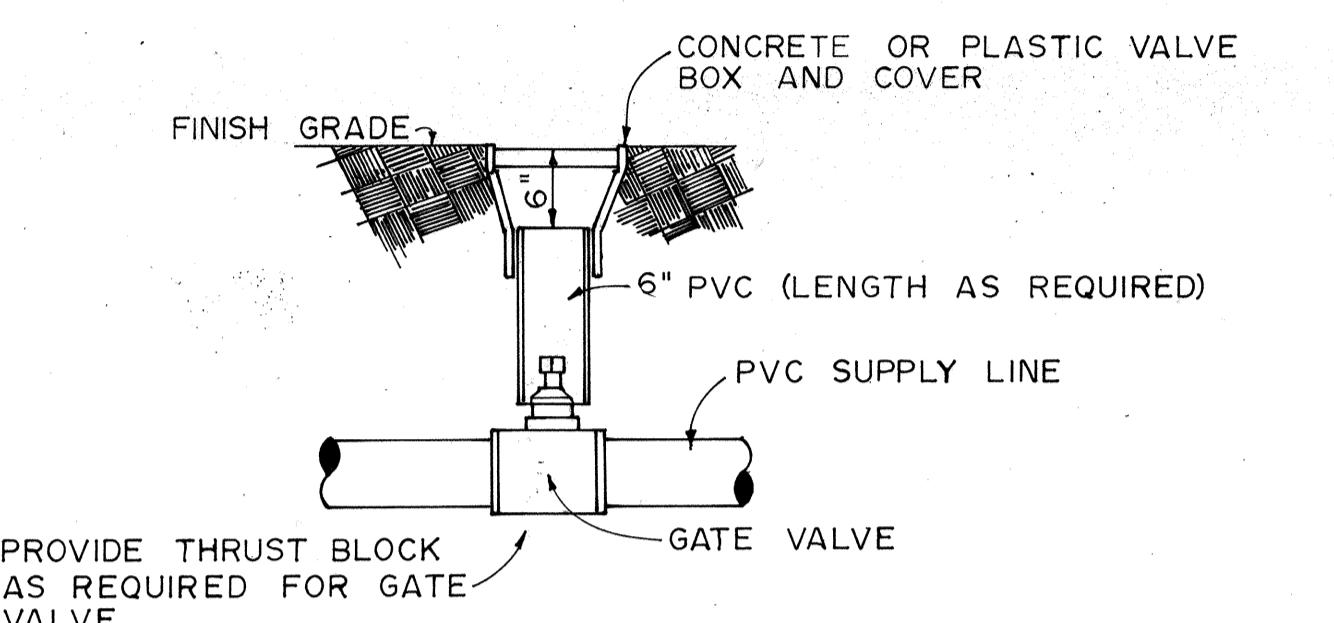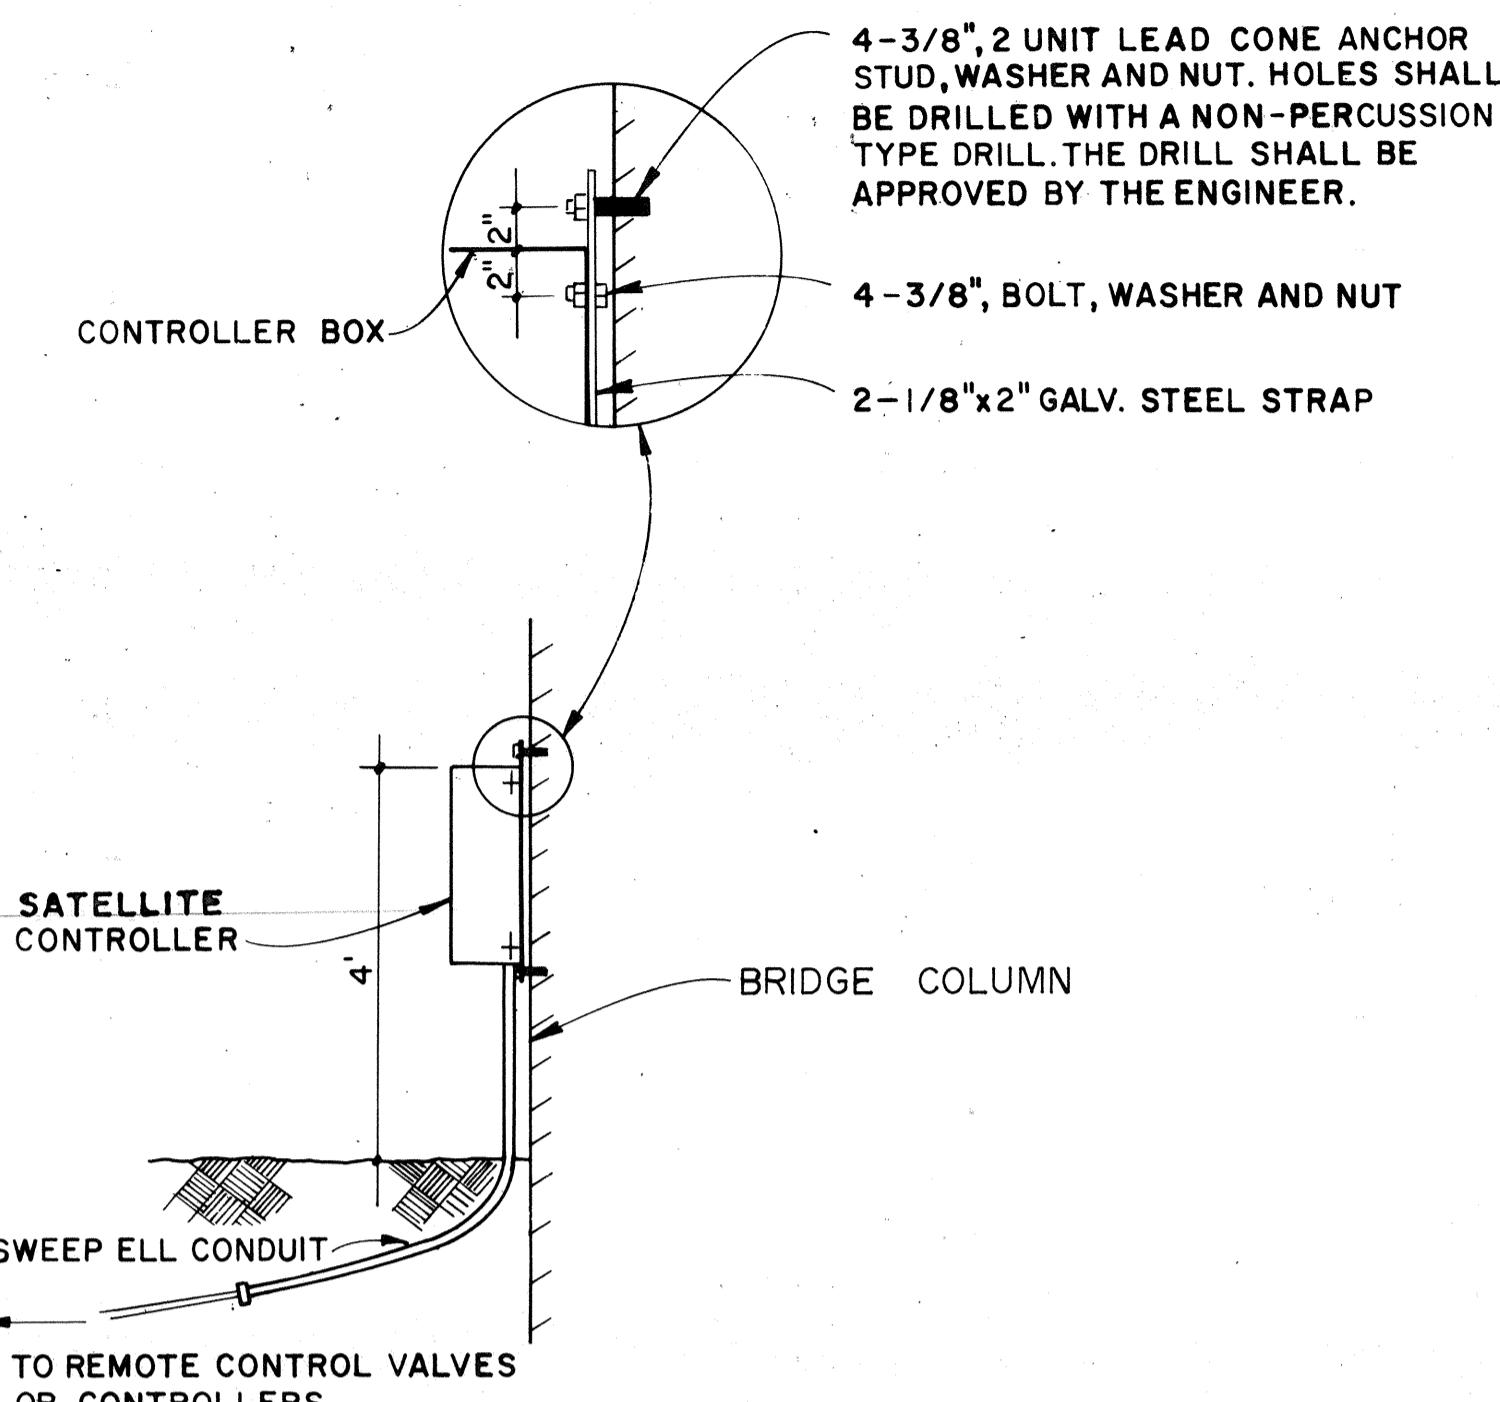


SECTION  
GATE VALVE INSTALLATION

SECTION  
DETAIL 1/30  
SATELLITE CONTROLLERS ANCHORED TO WALL

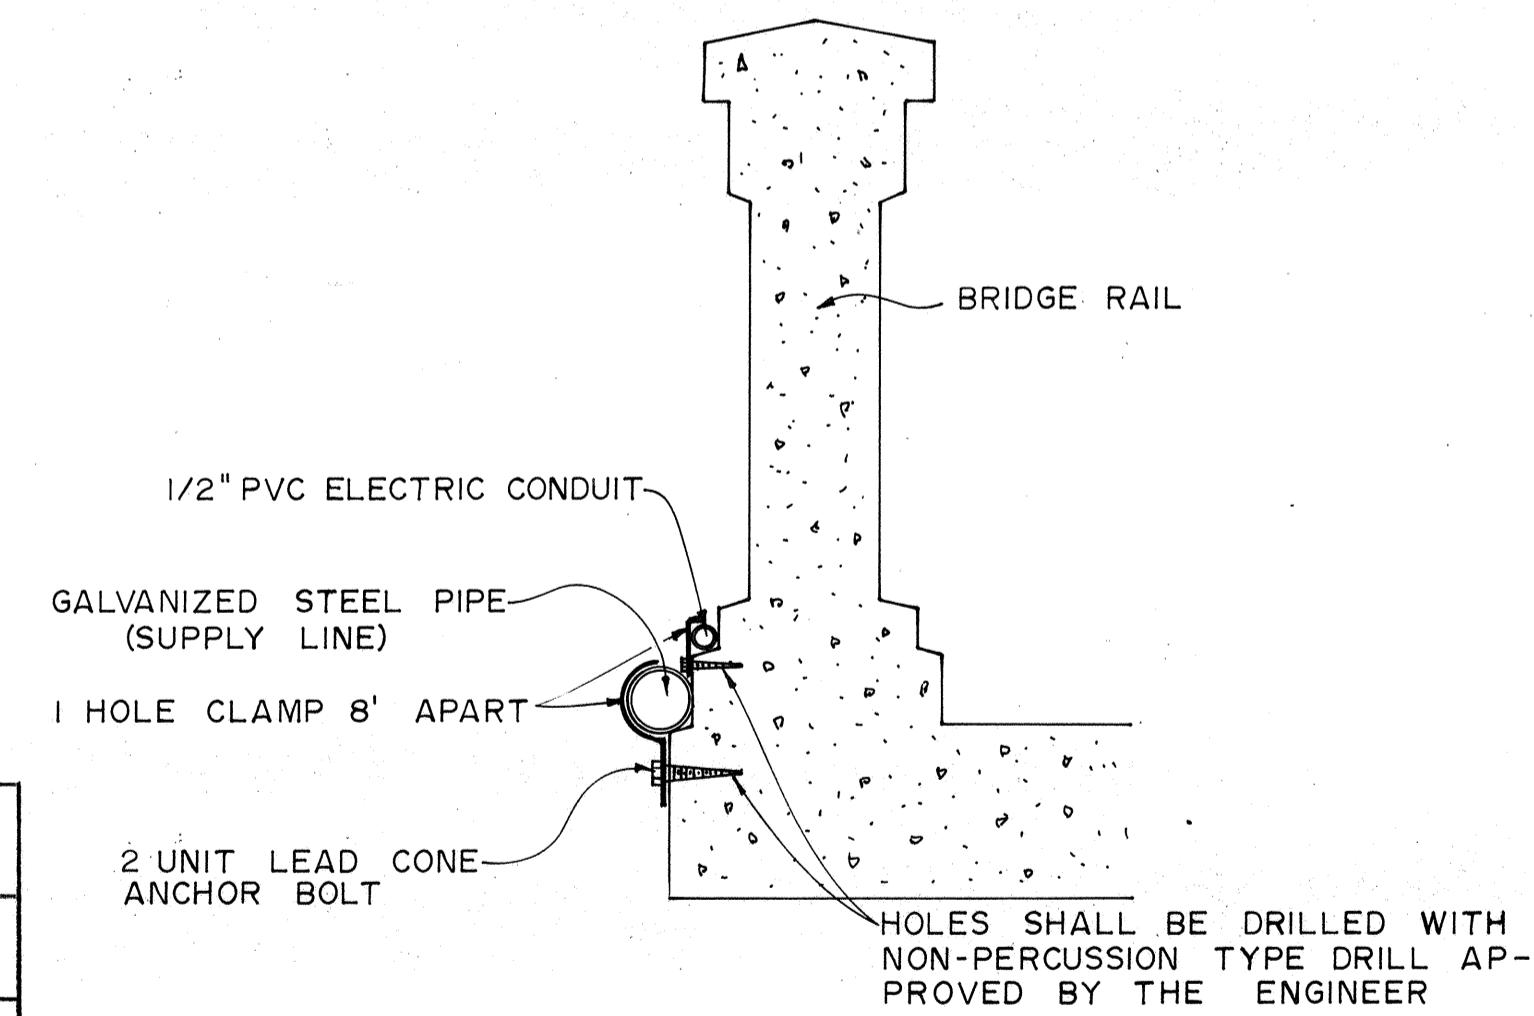

SUPPLY LINE ON BRIDGE RAIL




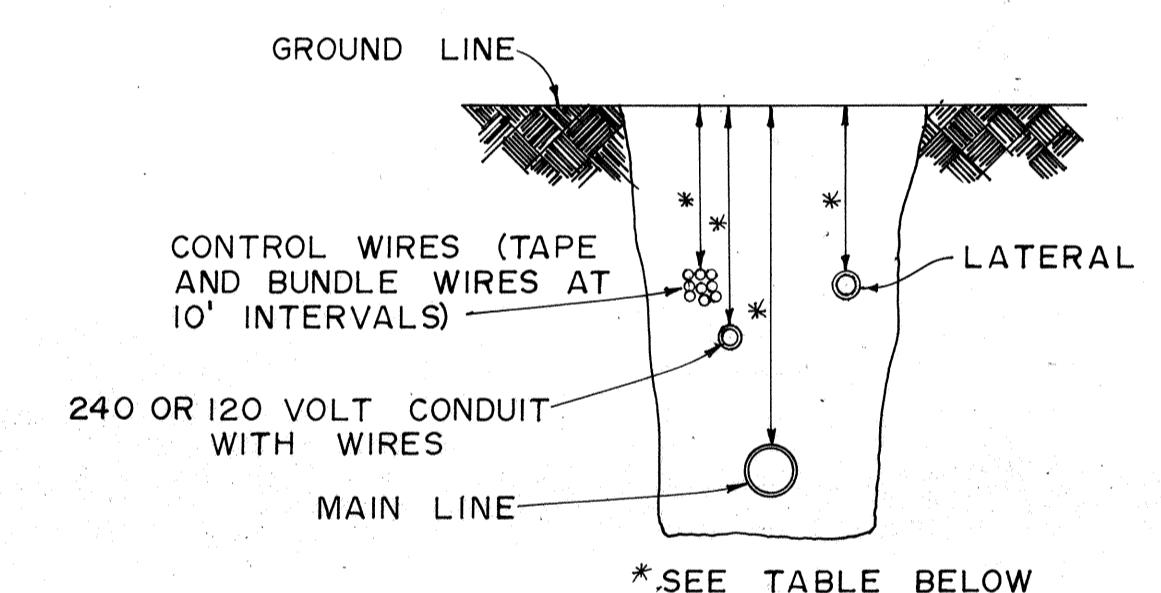


	*MINIMUM COVER
SPRINKLER LATERALS	18"
SPRINKLER MAINS	
4" AND SMALLER	24"
6"	30"
ELECTRICAL CONDUITS	24"
CONTROL WIRES	24"




SECTION  
TRENCH DETAIL

STATE OF HAWAII  
DEPARTMENT OF TRANSPORTATION  
HIGHWAYS DIVISION  
IRRIGATION SYSTEM  
DETAILS  
  
INTERSTATE ROUTE H-1  
PROJ. NO. I-HI-(02)-13  
Not to Scale Date: Mar 1976  
SHEET NO. 1-30 OF 132 SHEETS

FED. ROAD DIST. NO.	STATE	FED. AID PROJ. NO.	FISCAL YEAR	SHEET NO.	TOTAL SHEETS
HAWAII	HAW.	I-HI-1(02):13	1976	49	50

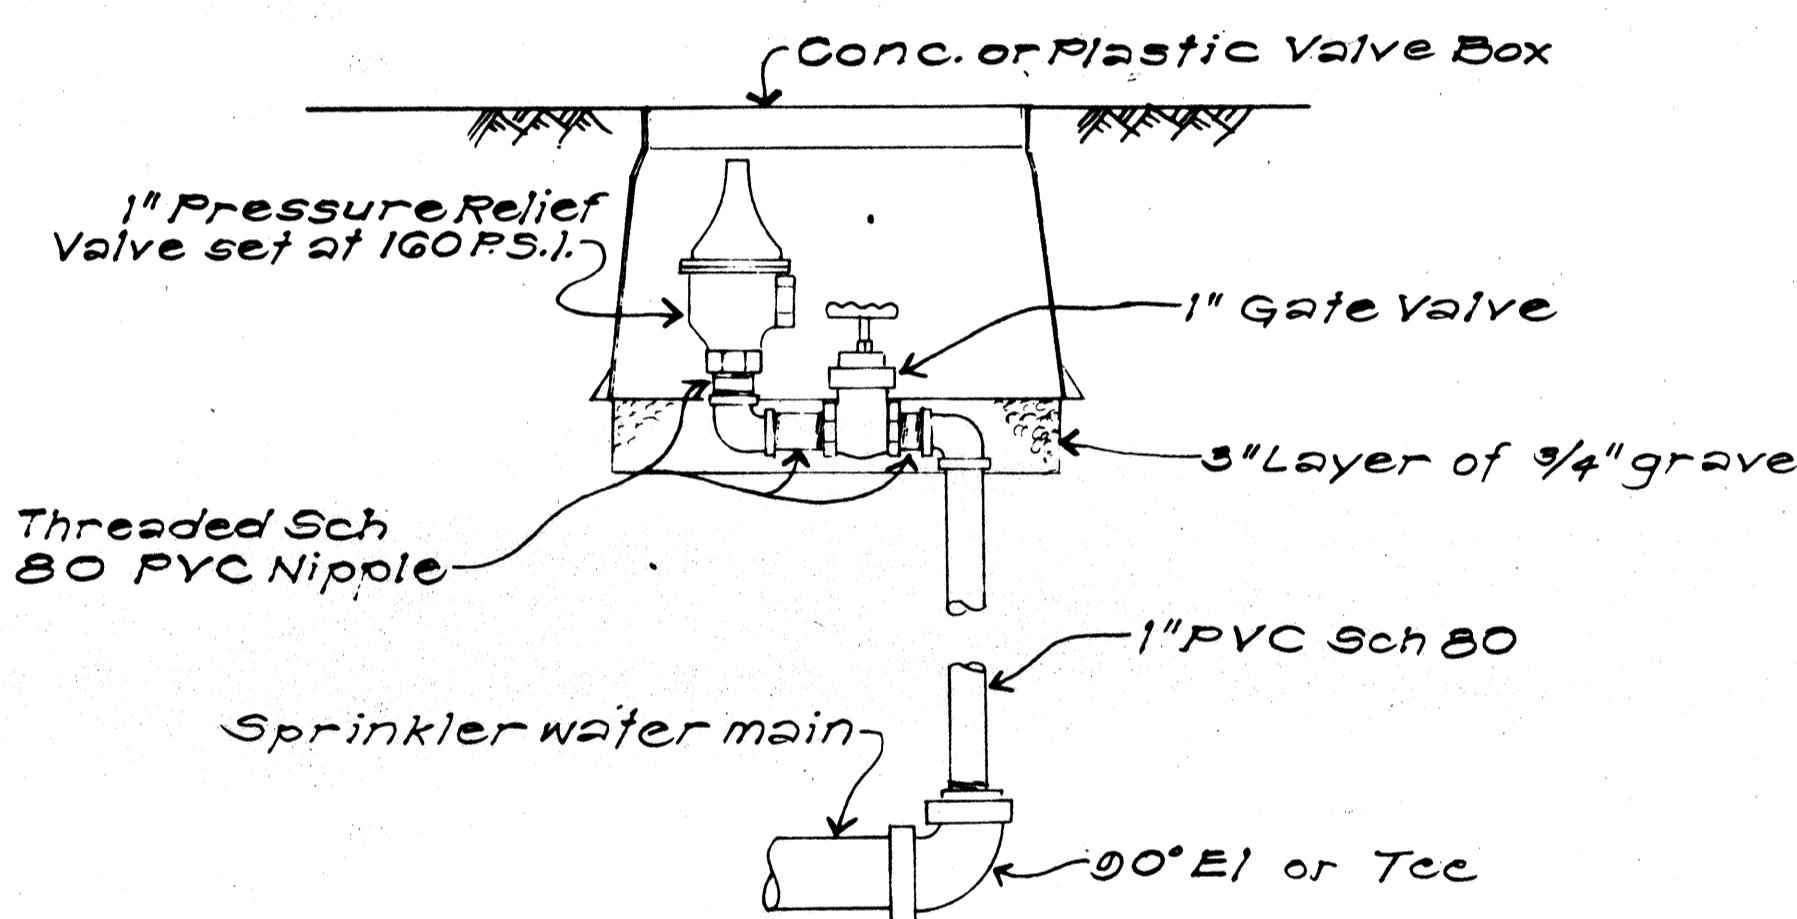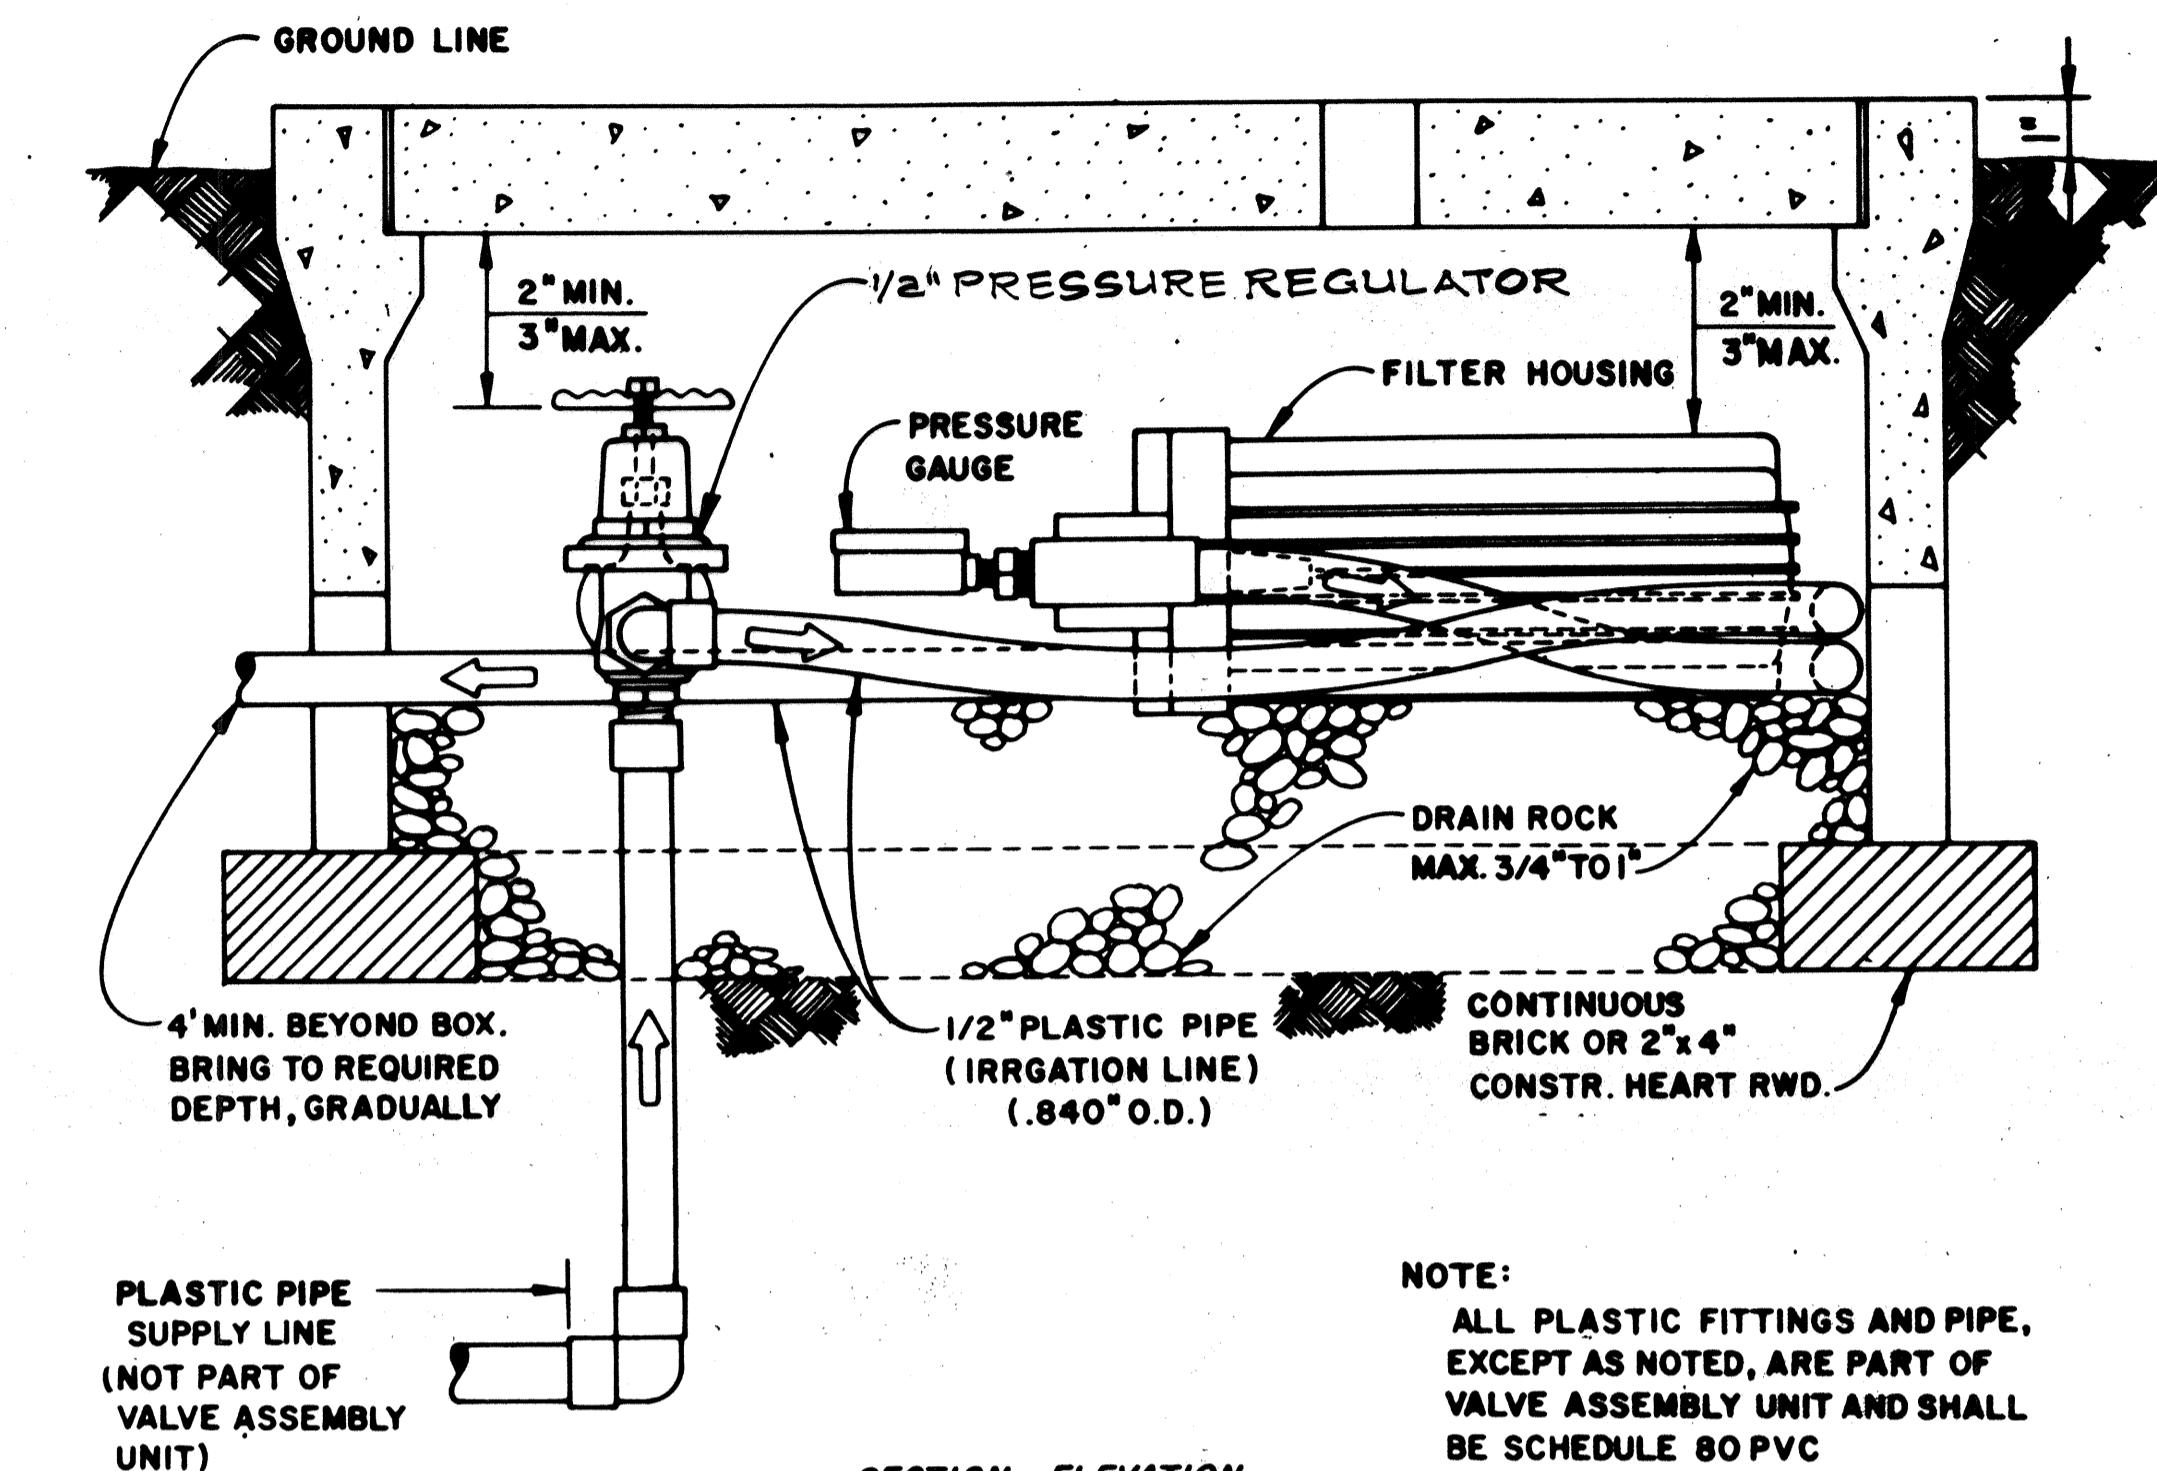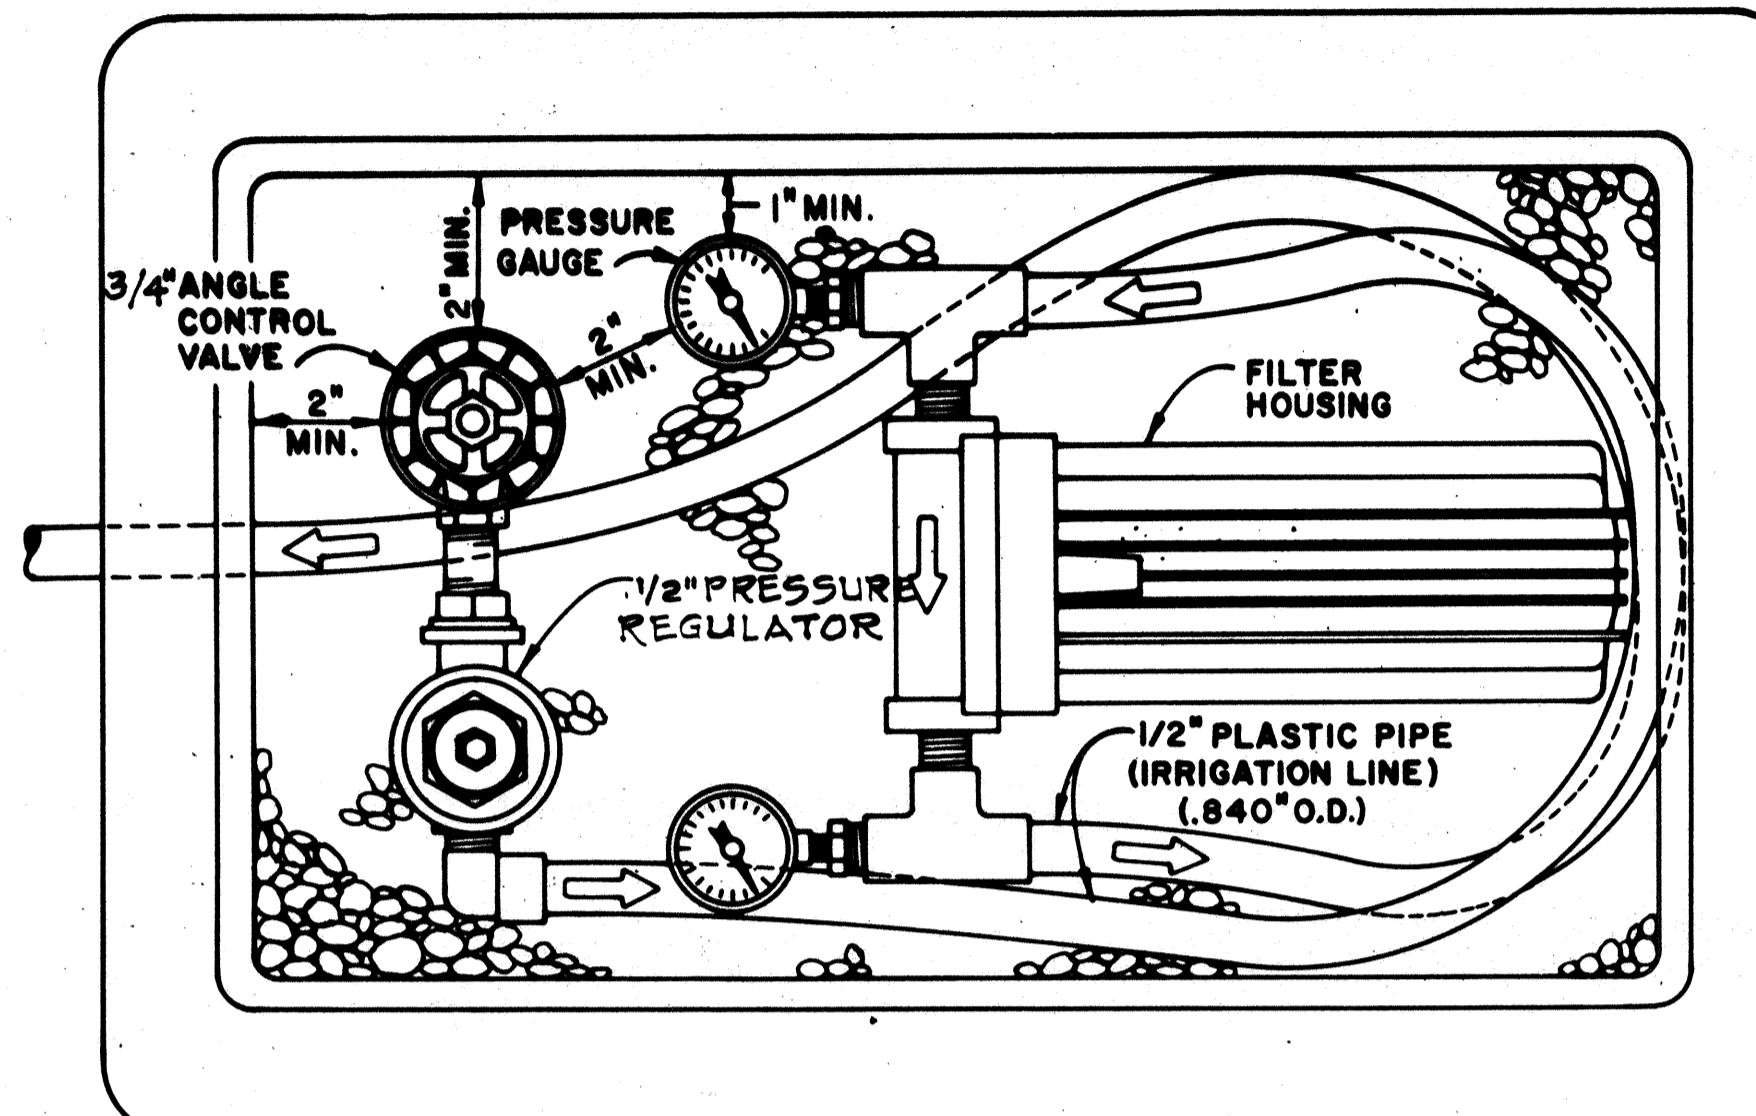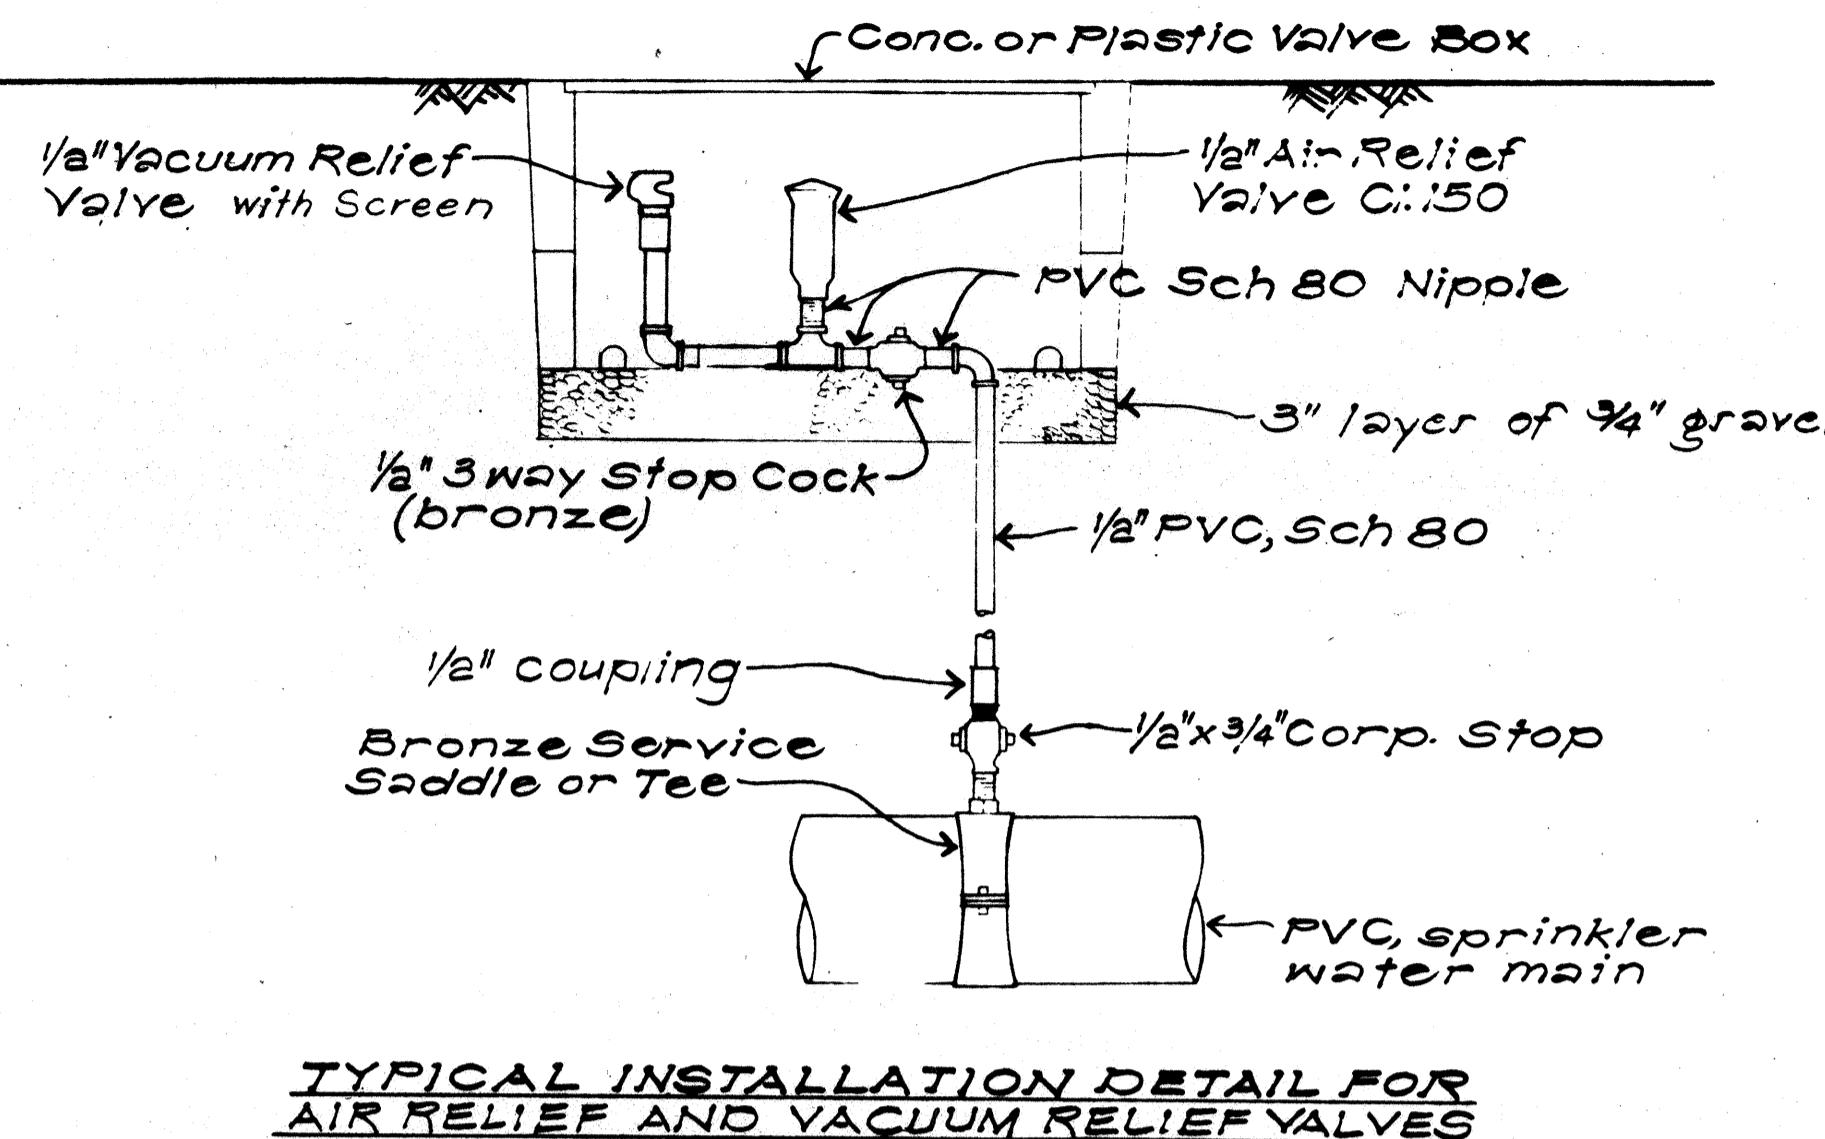


PRESSURE RELIEF VALVE ASSEMBLY CONNECTION DETAILS

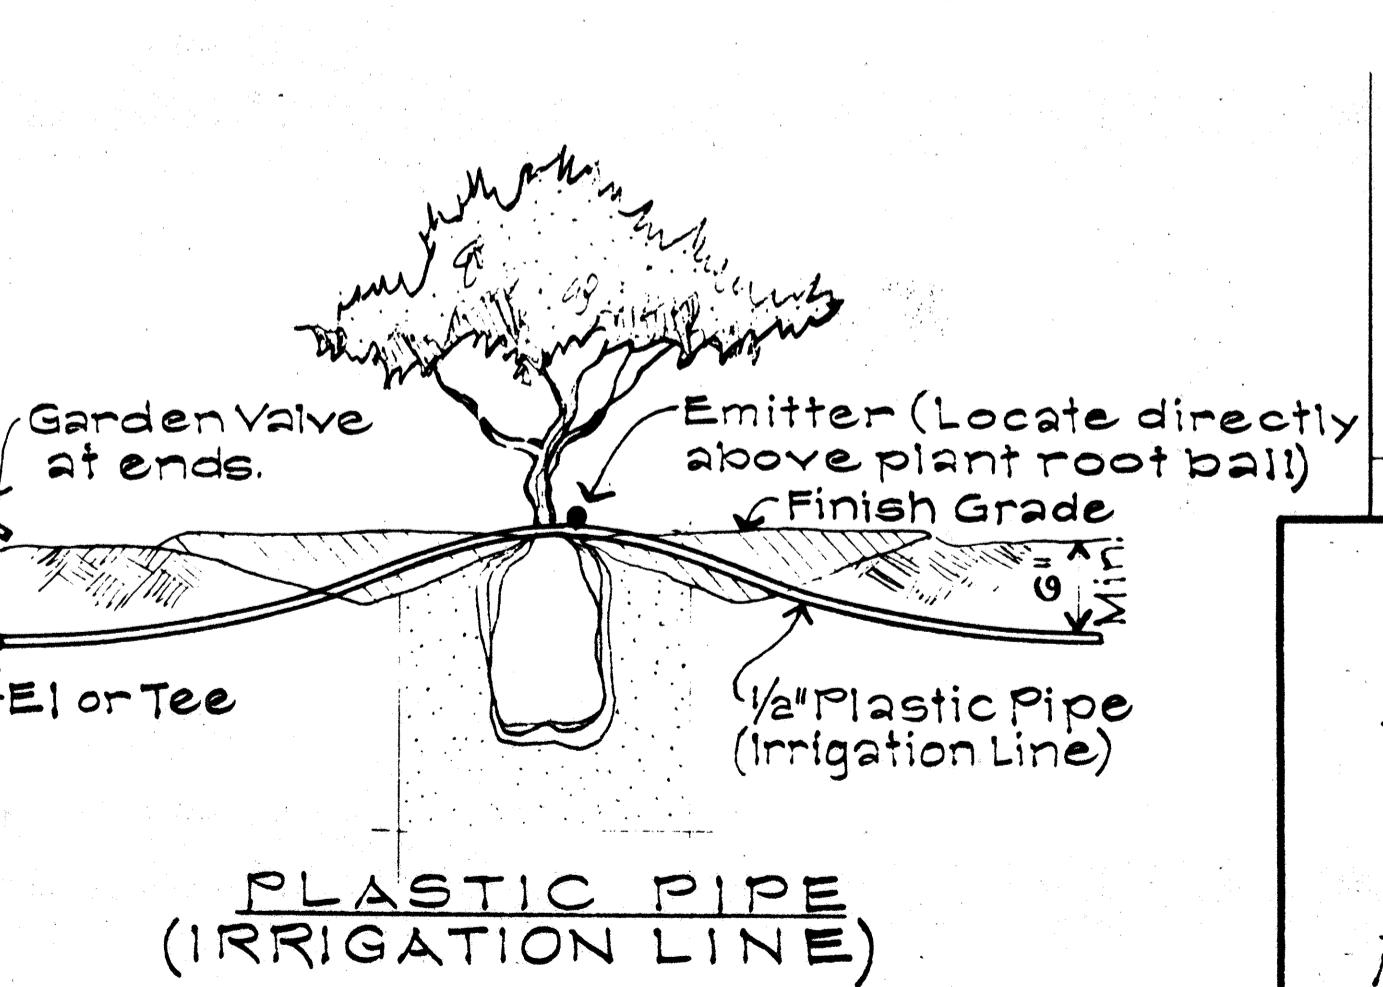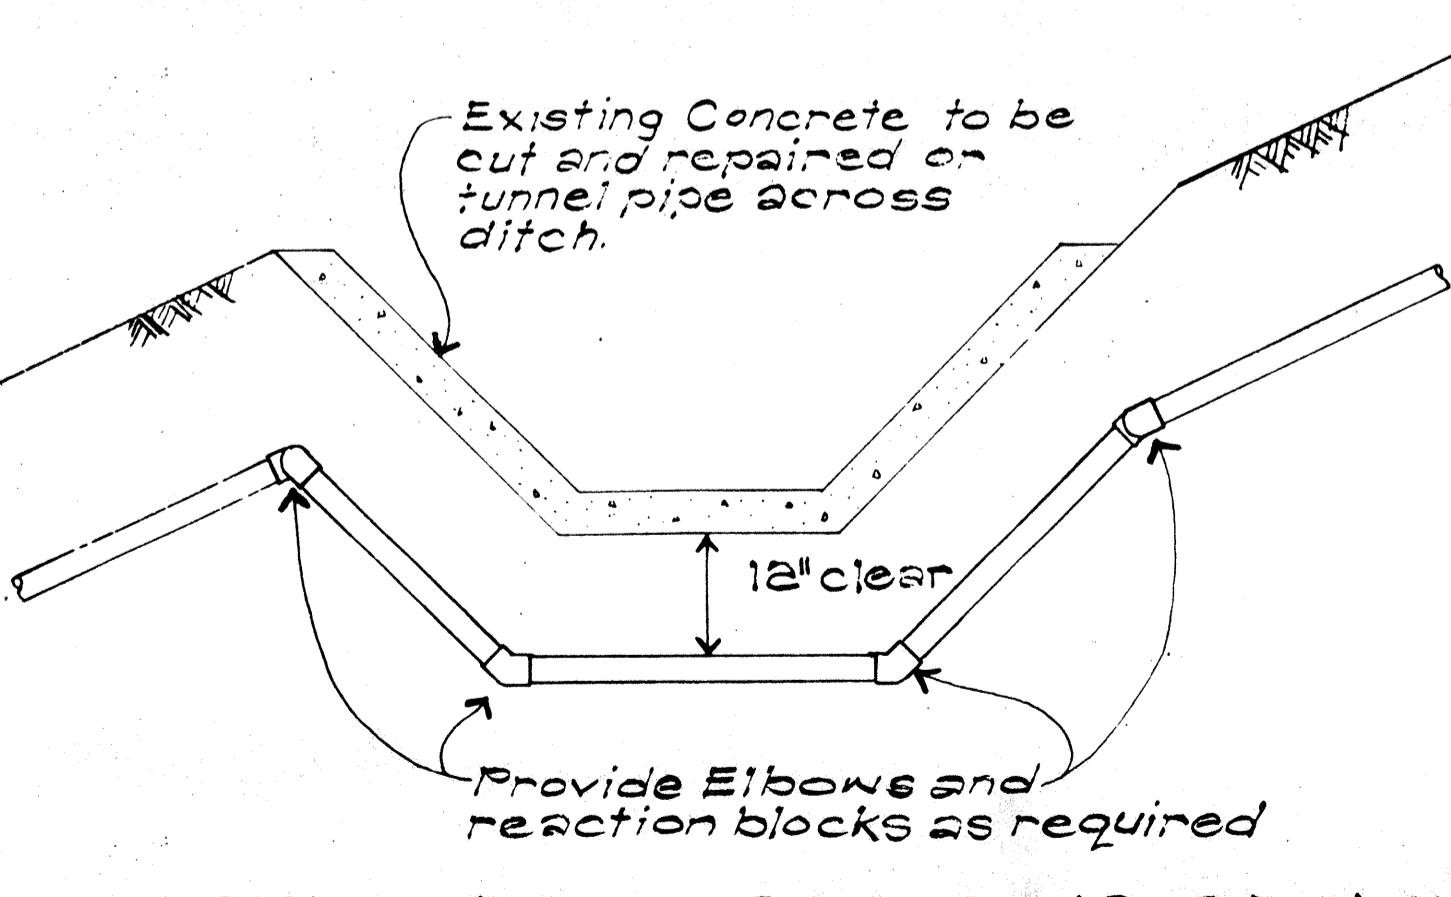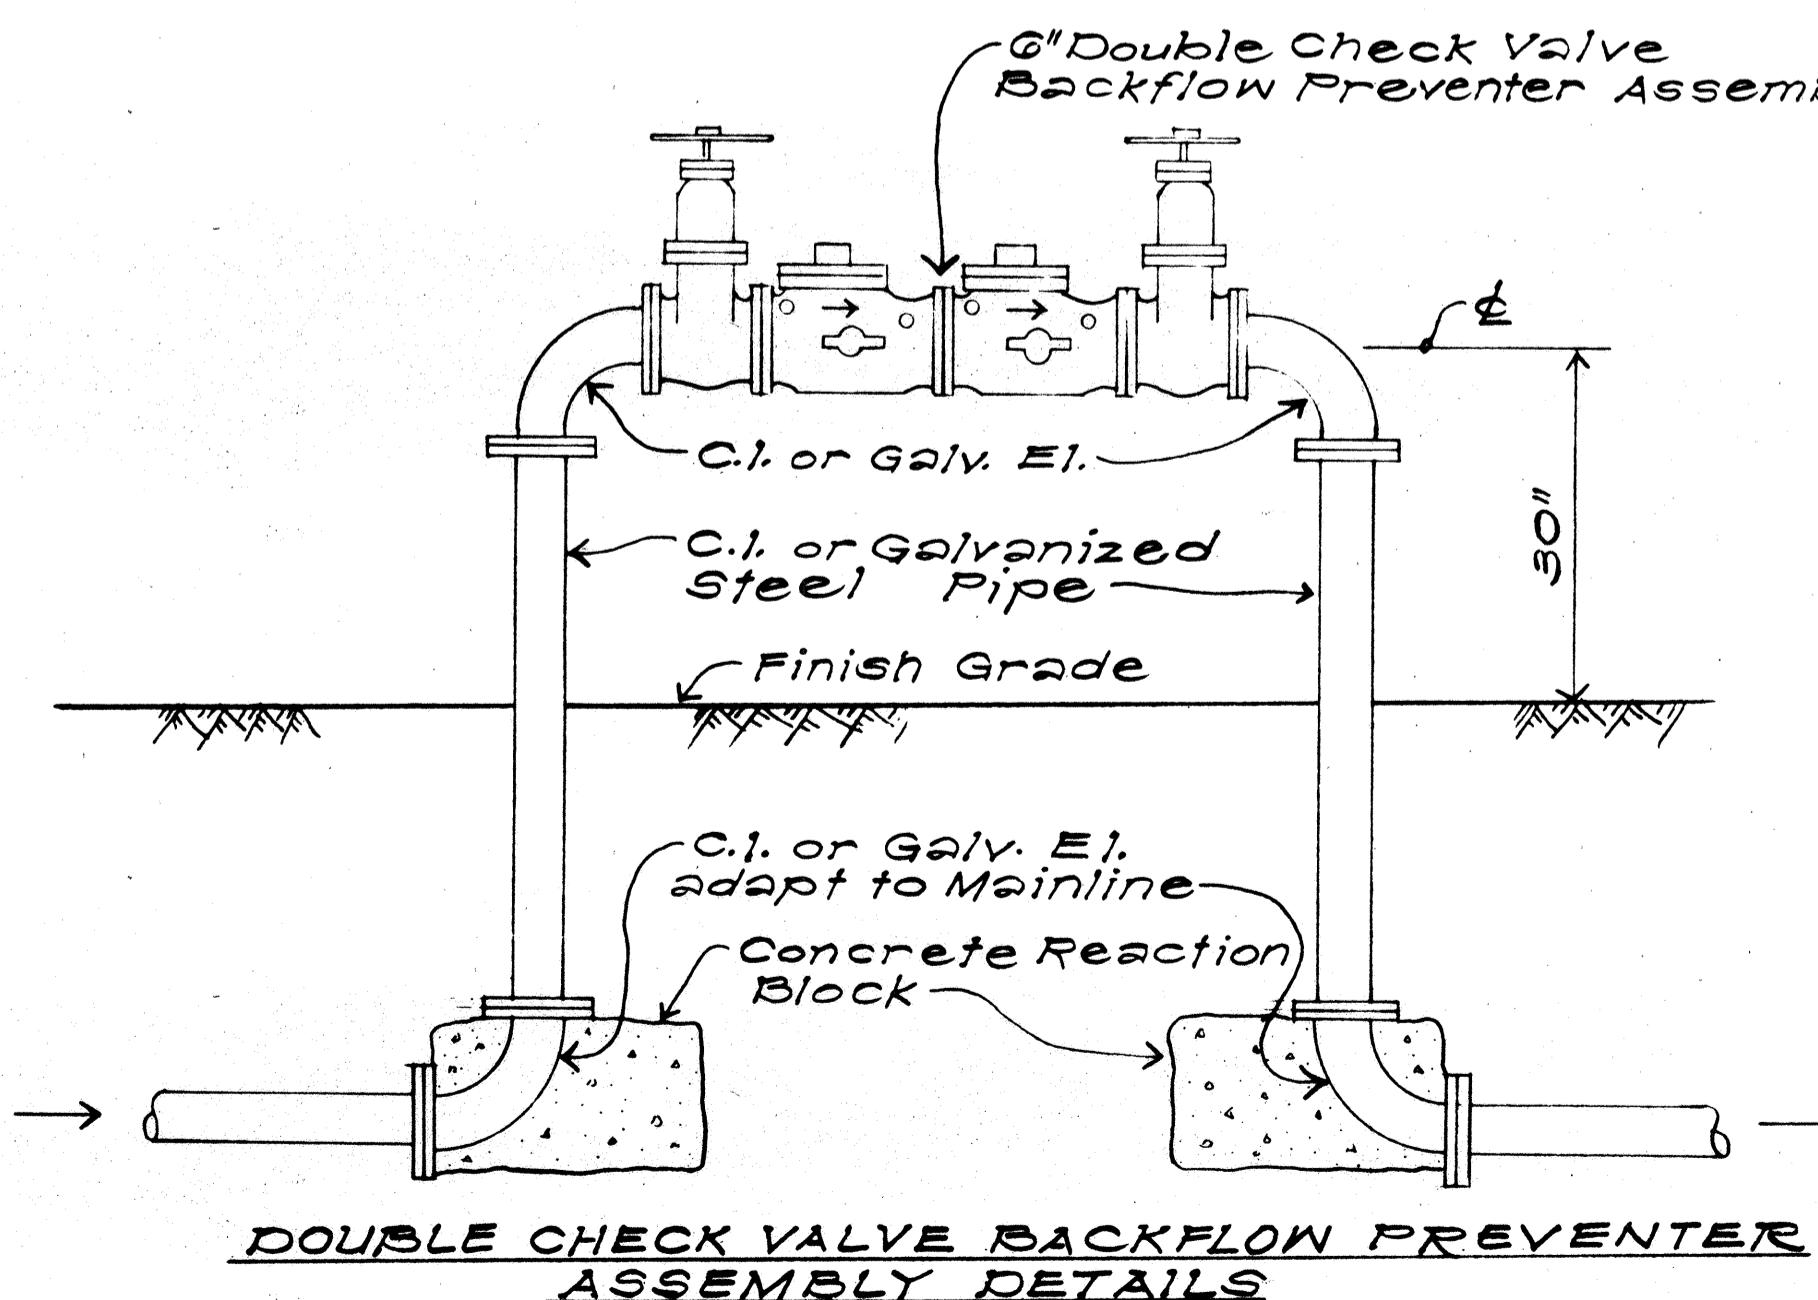


ORIGINAL SURVEY PLOTTED BY \_\_\_\_\_ DATE \_\_\_\_\_  
DRAWN BY \_\_\_\_\_ DRAWN DATE \_\_\_\_\_  
TRACED BY \_\_\_\_\_ TRACED DATE \_\_\_\_\_  
MAILED BY \_\_\_\_\_ MAILED DATE \_\_\_\_\_  
CIRCLED BY \_\_\_\_\_ CIRCLED DATE \_\_\_\_\_

FED. ROAD DIST. NO.	STATE	FED. AID PROJ. NO.	FISCAL YEAR	SHEET NO.	TOTAL SHEETS
HAWAII	HAW.	I-HI-1(92):13	1976	50	50

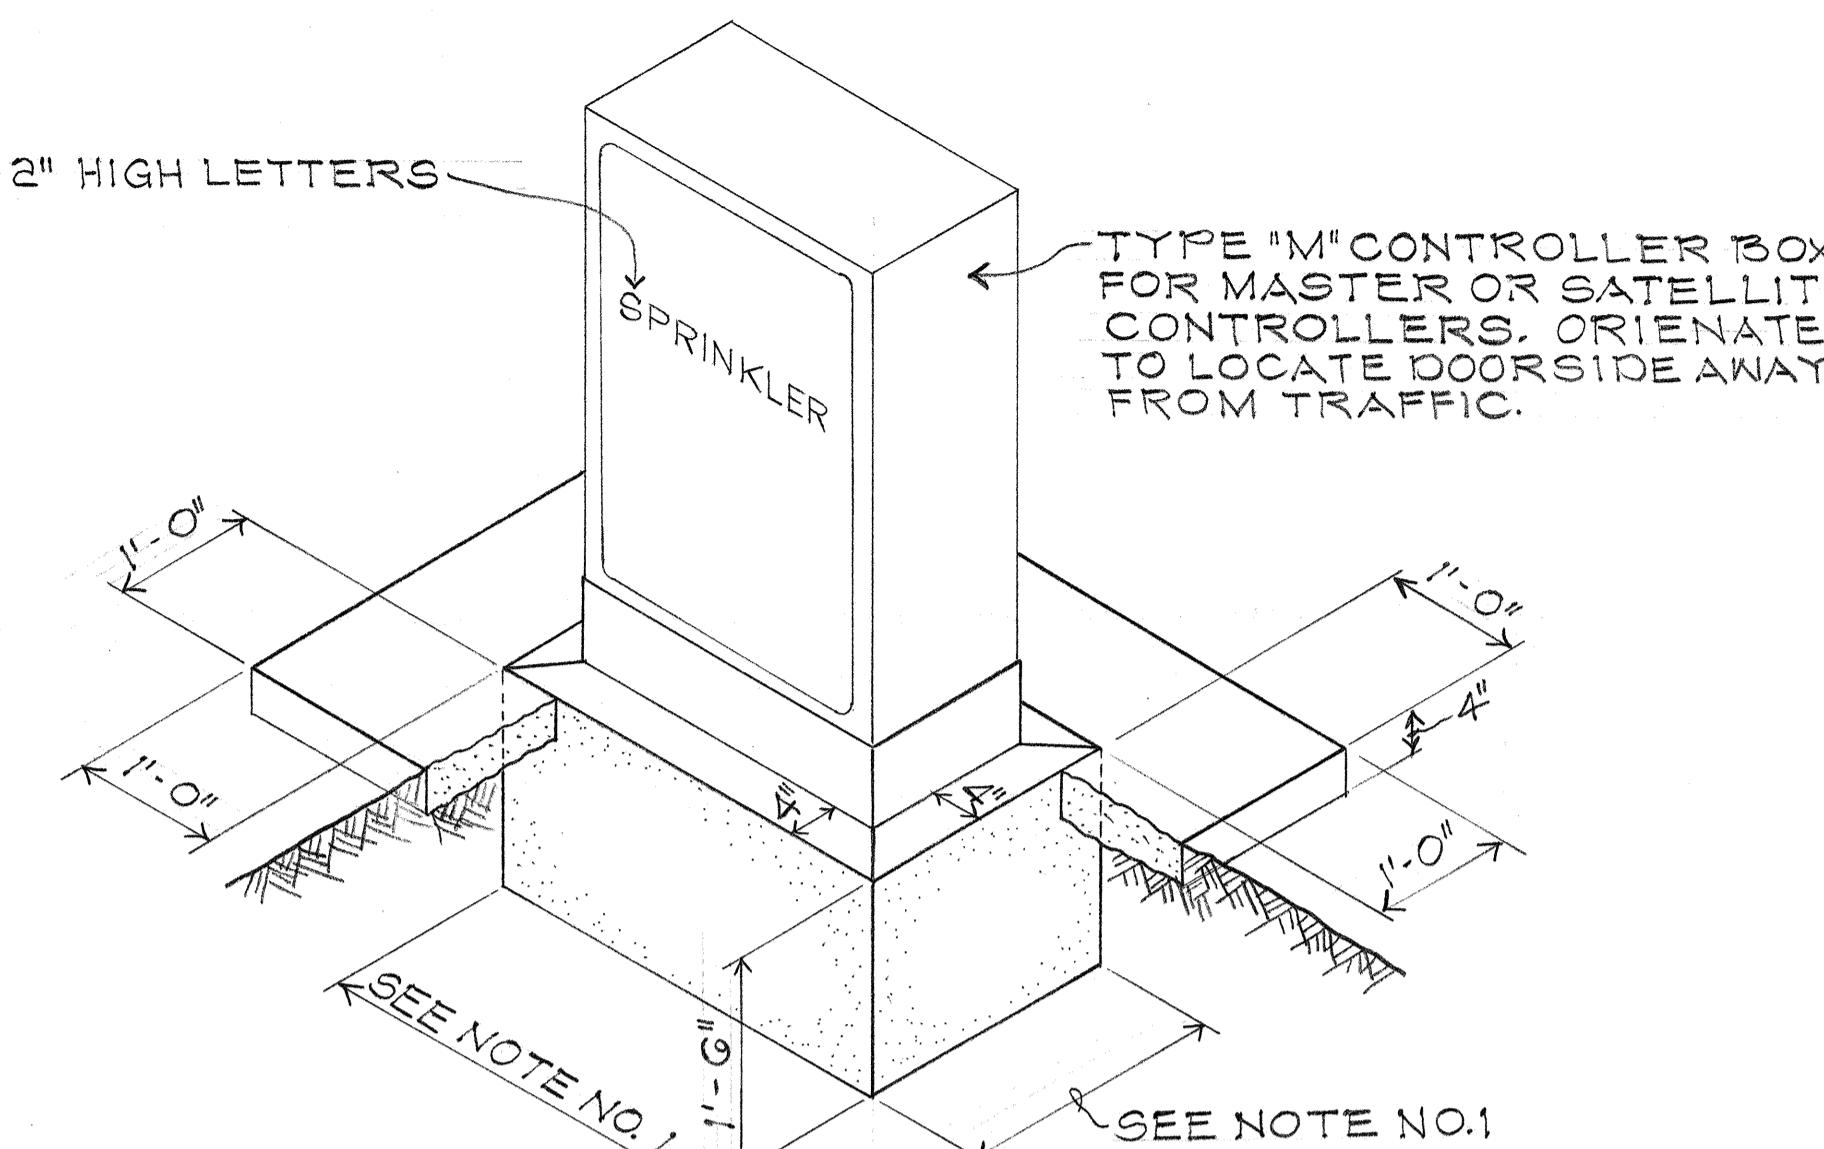

# ISOMETRIC VIEW OF CONCRETE BASE


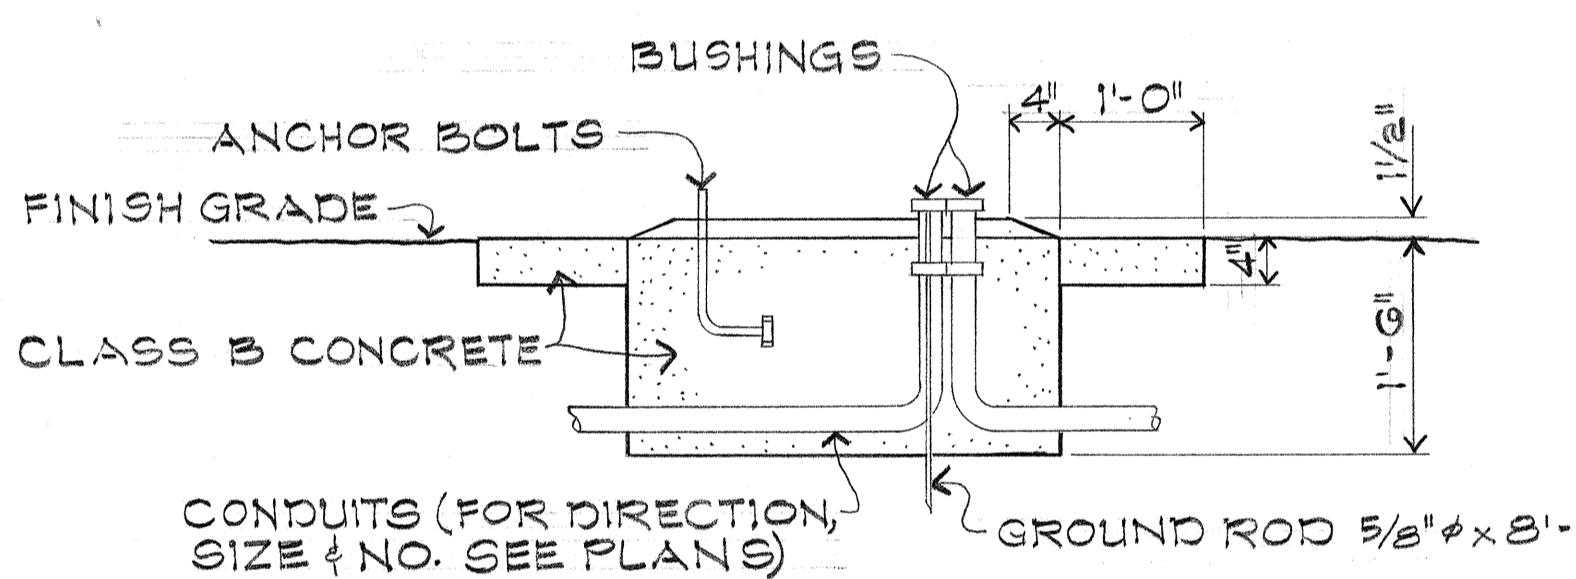


## TYPICAL SECTION

NOTES:

1. DIMENSIONS TO BE DETERMINED BY THE SIZE OF THE TYPE "M" CONTROLLER BOX.  
2. SIZE AND LOCATION OF ANCHOR BOLTS TO BE DETERMINED BY THE SIZE OF THE TYPE "M" CONTROLLER BOX.


DETAIL 1/32 CONCRETE BASE FOR  
TYPE "M" CONTROLLER BOX

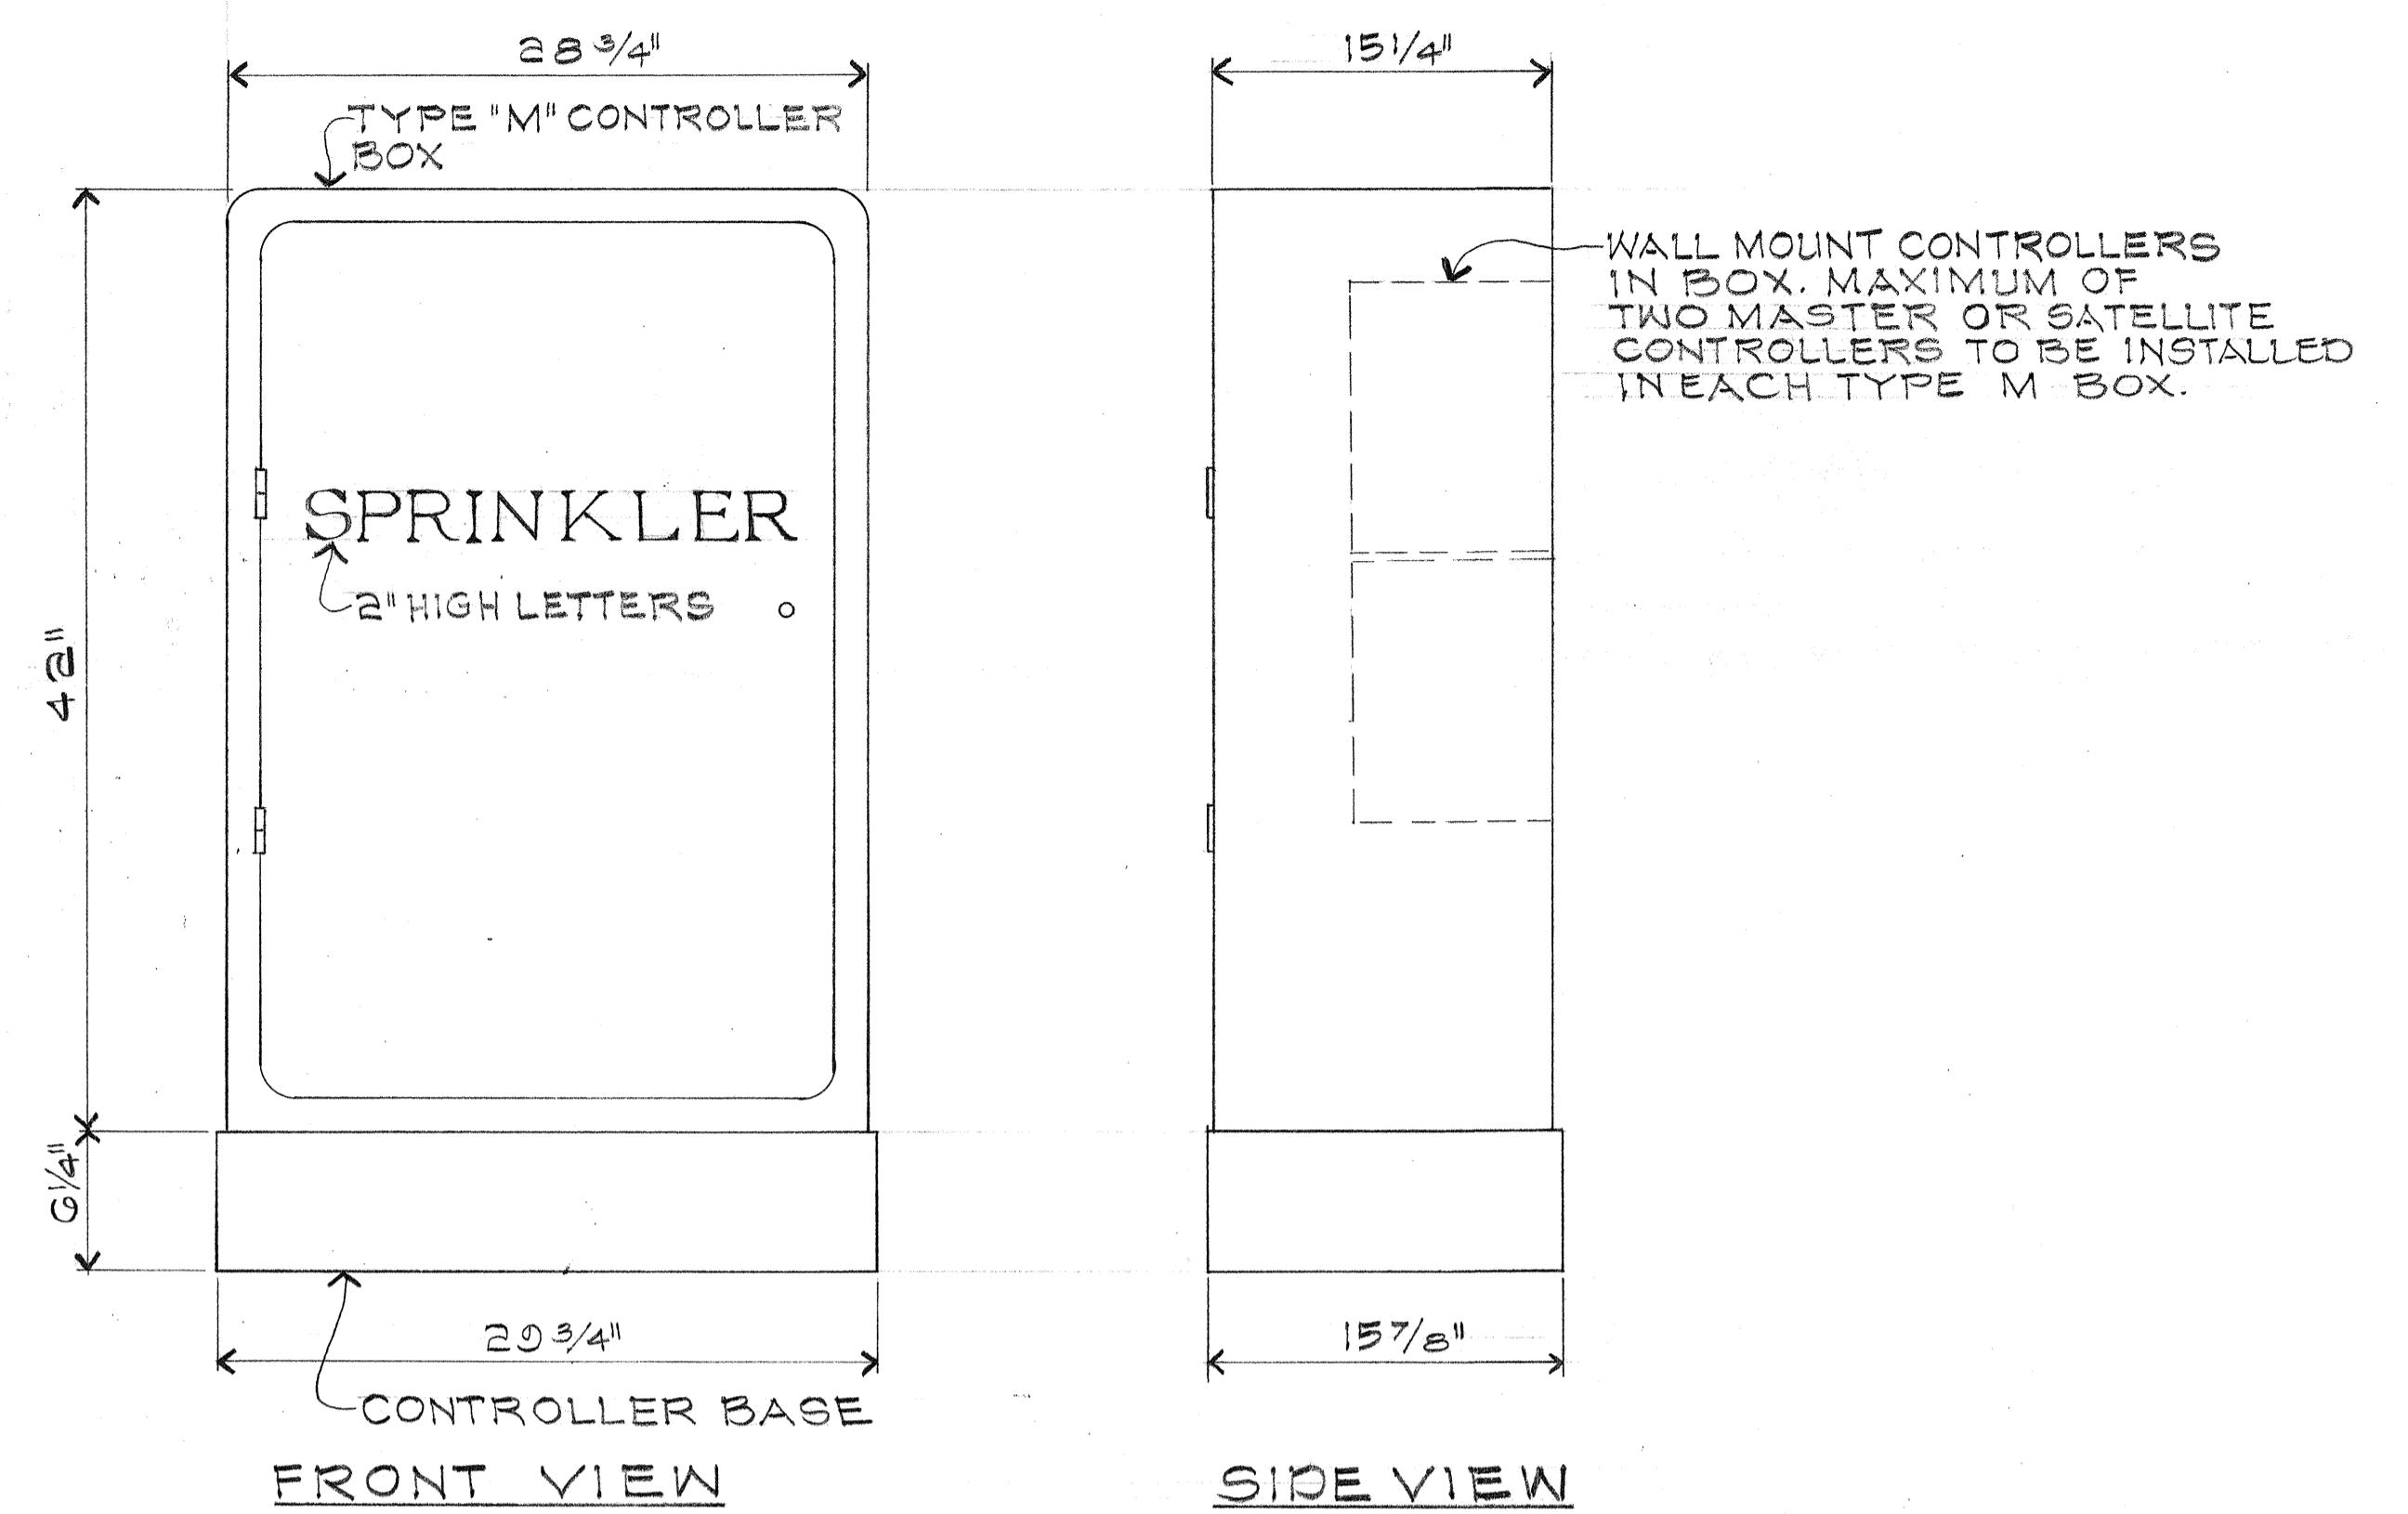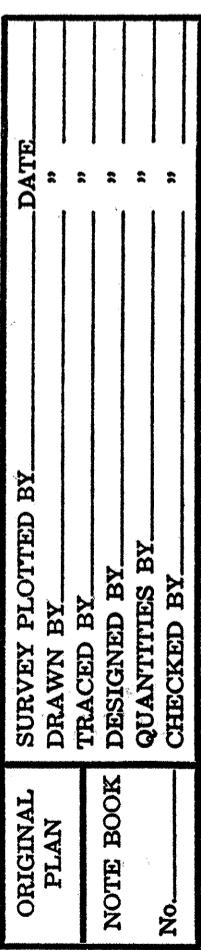

DETAIL 2/32 TYPE "M" CONTROLLER BOX

SCALE:  $1\frac{1}{2}'' = 1' - 0'$

NOTE: DIMENSIONS AND DETAILS ARE APPROXIMATE ONLY. EXACT DETAILS AND DIMENSIONS SHALL BE FURNISHED BY THE MANUFACTURER AND AS DIRECTED BY THE ENGINEER.

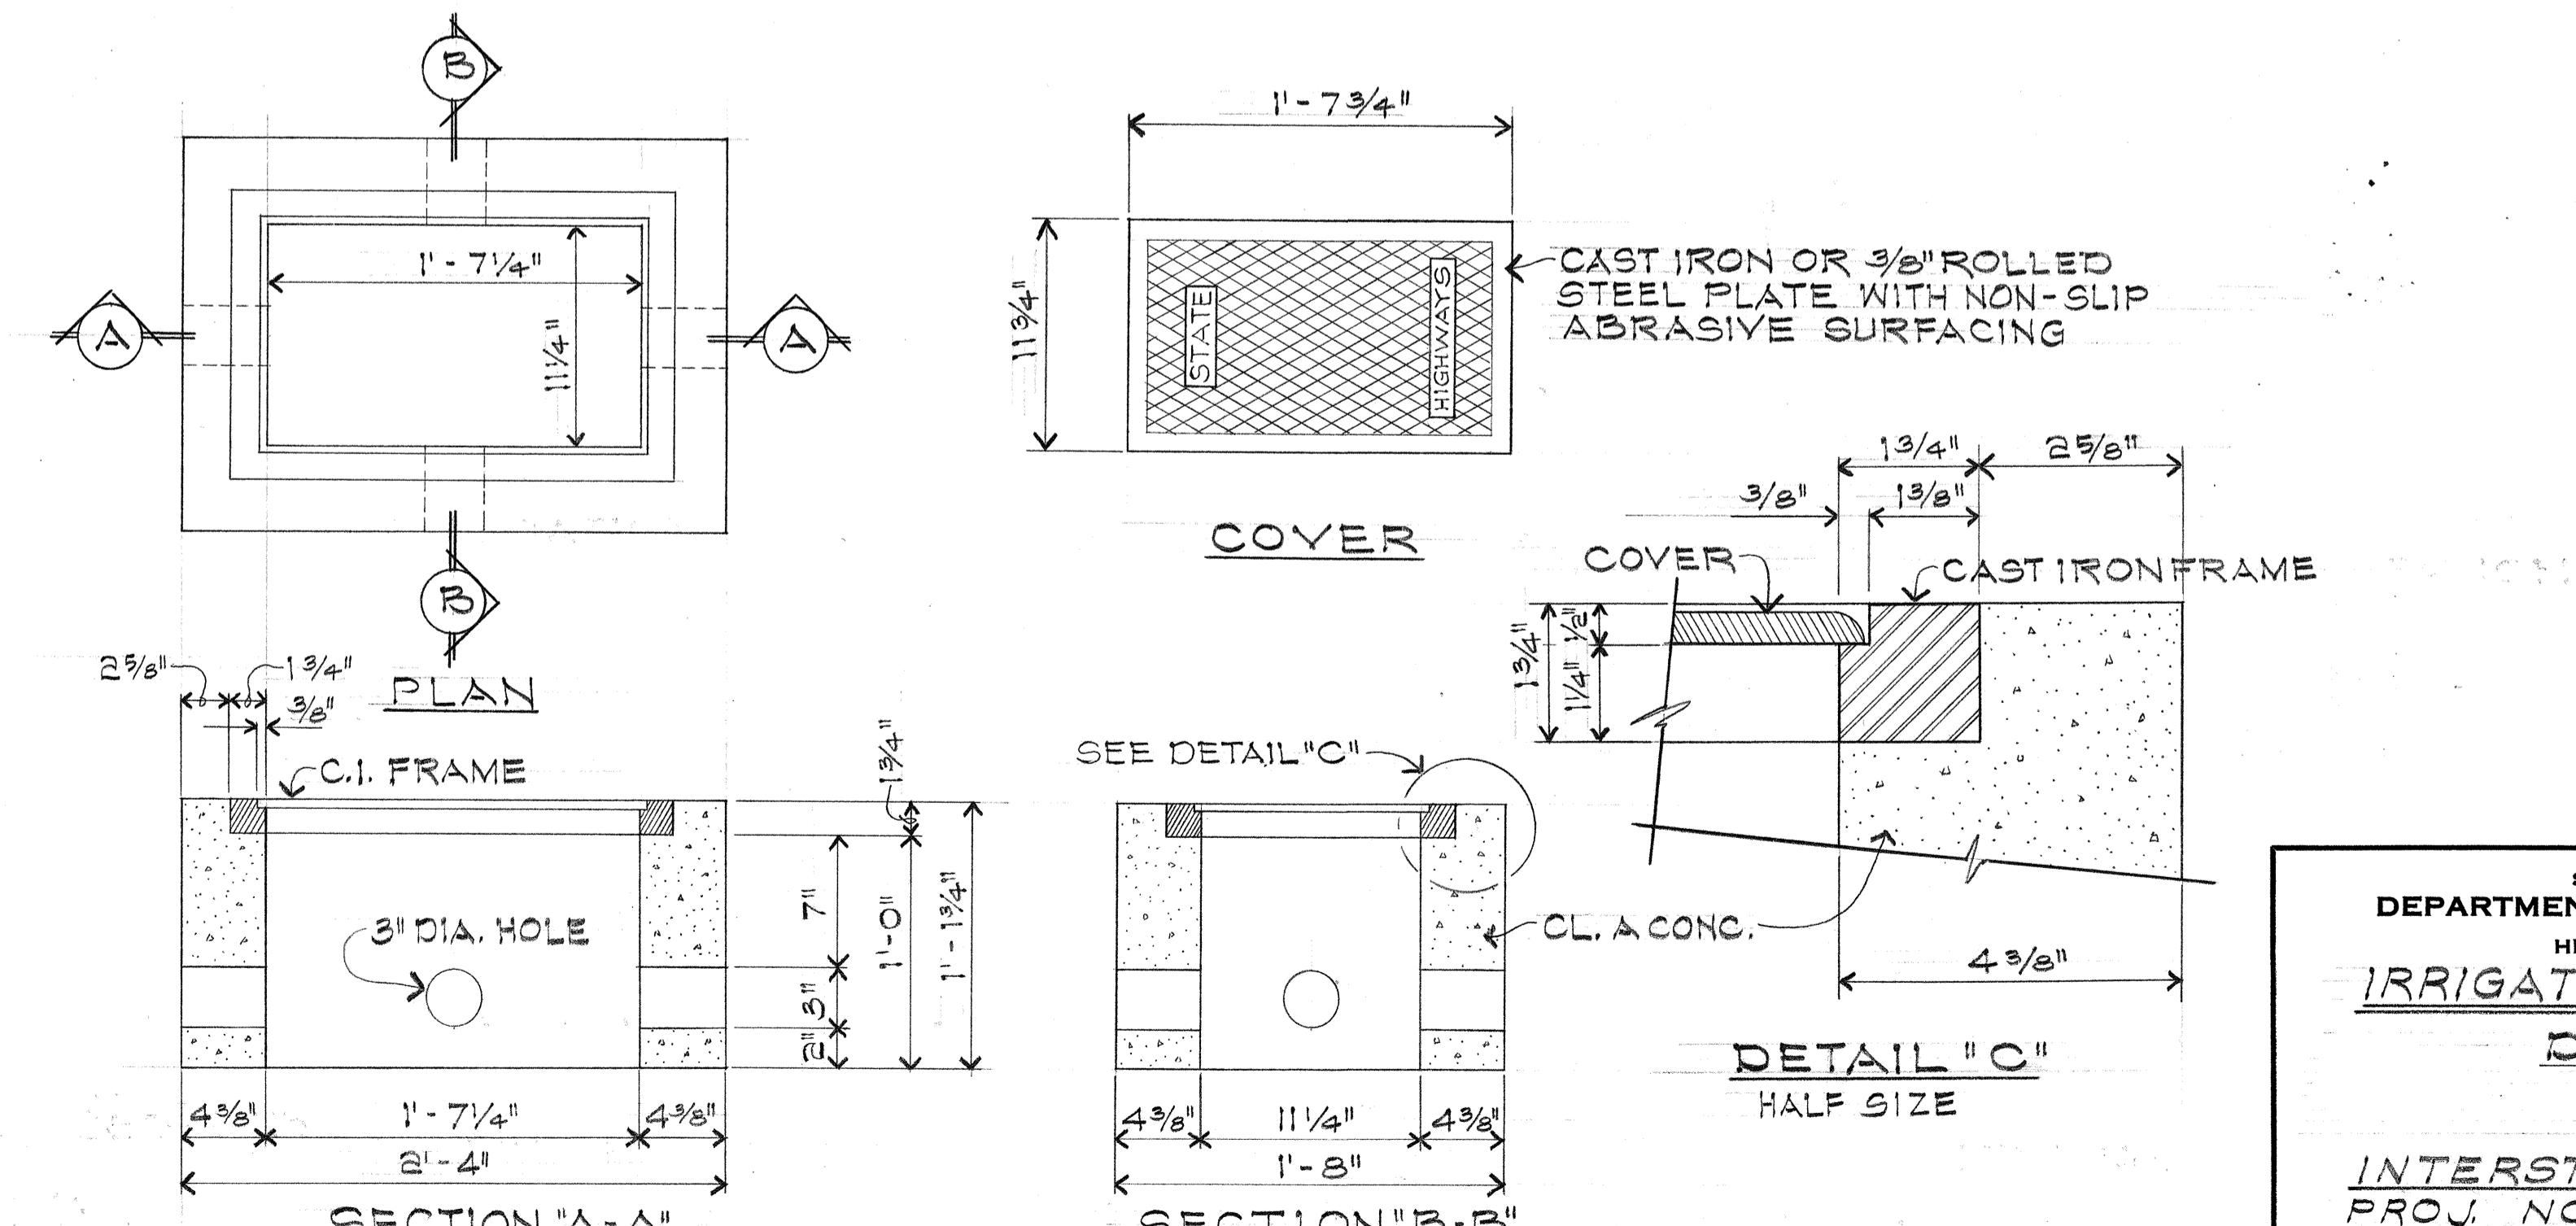

DETAIL 3/32 TYPE "B" PULL BOX


**STATE OF HAWAII  
DEPARTMENT OF TRANSPORTATION  
HIGHWAYS DIVISION**

**IRRIGATION SYSTEM**

INTERSTATE ROUTE H-1  
PROJ. NO. I-H1-1(92):13



Scale: As Shown Date: Mar 1976  
**SHEET NO.132 OF 132 SHEETS**

FED. ROAD DIST. NO.	STATE	FED. AID PROJ. NO.	FISCAL YEAR	SHEET NO.	TOTAL SHEETS
HAWAII	HAW.	I-HI-1(02):13	1076	A.DD. 50 S-1	50

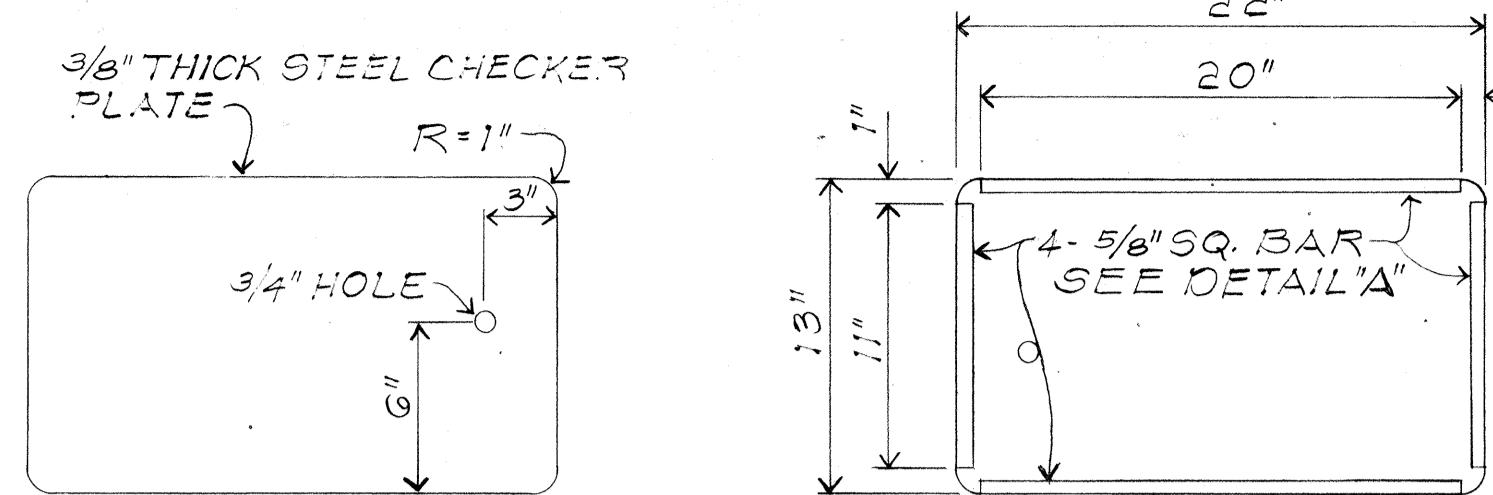


TOP

BOTTOM

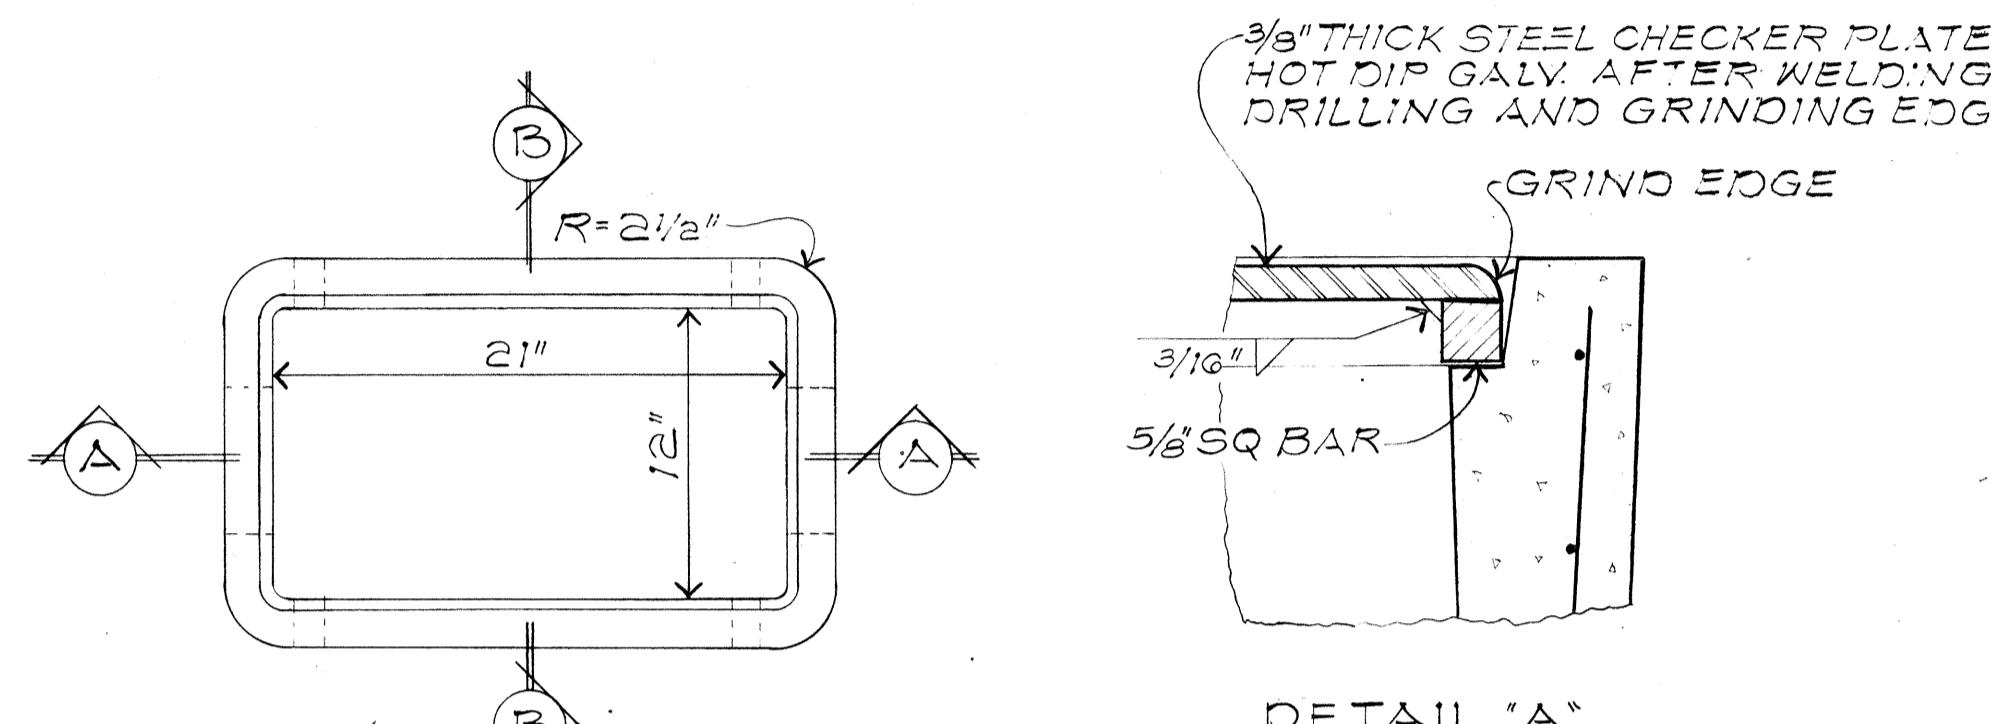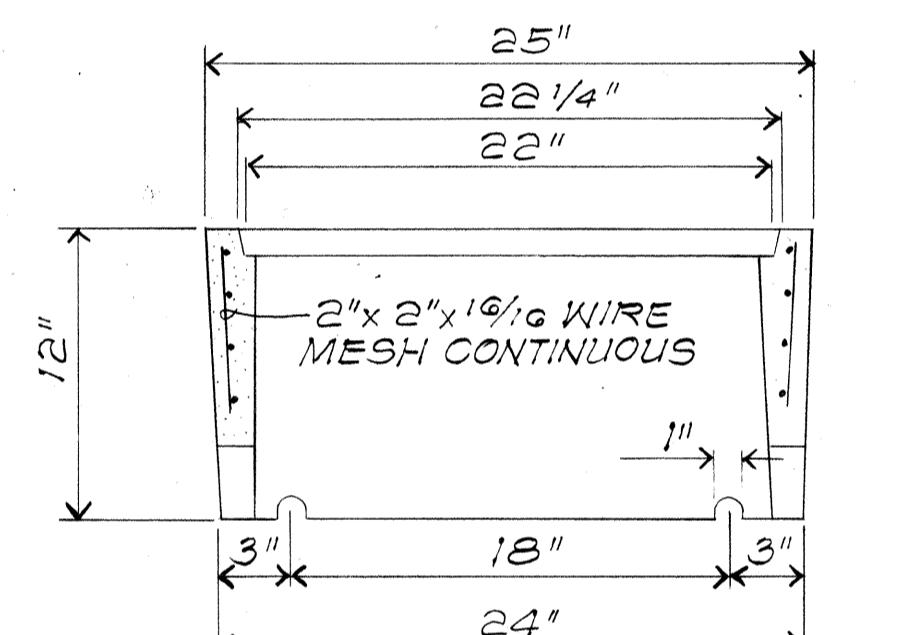DETAIL OF COVERDETAIL "A"  
HALF SIZE

SECTION A-A

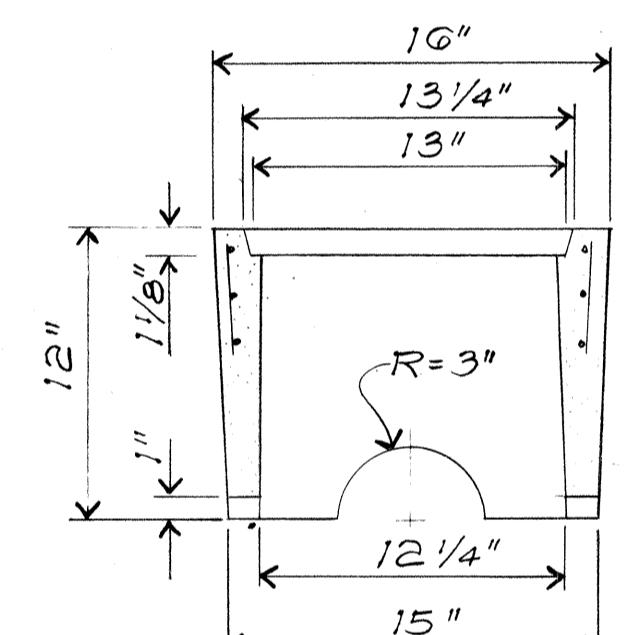


SECTION B-B

DETAIL OF BOX  
DETAILS OF TYPE "A" VALVE BOXGENERAL NOTES:



1. THE TYPE "A" VALVE BOX IS SIMILAR TO A HONOLULU BOARD OF WATER SUPPLY TYPE "X" METER BOX.
2. THE VALVE COVER MAYBE SUBSTITUTED WITH THE BWS METER COVER, BUT THE WORDS "BOARD OF WATER SUPPLY" AND "WATER METER" SHALL BE GROUNDED OFF. IMPRINT THE WORDS "SPRINKLER VALVE" ON THE COVER.
3. PLASTIC VALVE BOXES MAY BE SUBSTITUTED FOR THE TYPE "A" VALVE BOXES. PLASTIC VALVE BOXES SHALL BE COMMERCIALLY MANUFACTURED PRODUCTS AND SHALL BE A RIGID COMBINATION OF POLYOLEFIN AND FIBROUS INORGANIC COMPONENTS. PHYSICAL PROPERTIES SHALL BE AS FOLLOWS:

	ASTM TEST METHOD	MINIMUM TEST VALUE
TENSILE STRENGTH	D 638	3,400 PSI
IMPACT STRENGTH	D 256	1.5 LB/IN
DUROMETER HARDNESS	D 676	63
DEFLECTION TEMPERATURE	D 648	230° F
SPECIFIC GRAVITY	D 792	1.15



ORIGINAL	PLOTTED BY
PLAN	
DRAWN BY	
NOTE BOOK	QUANTITY BY
No.	CHECKED BY

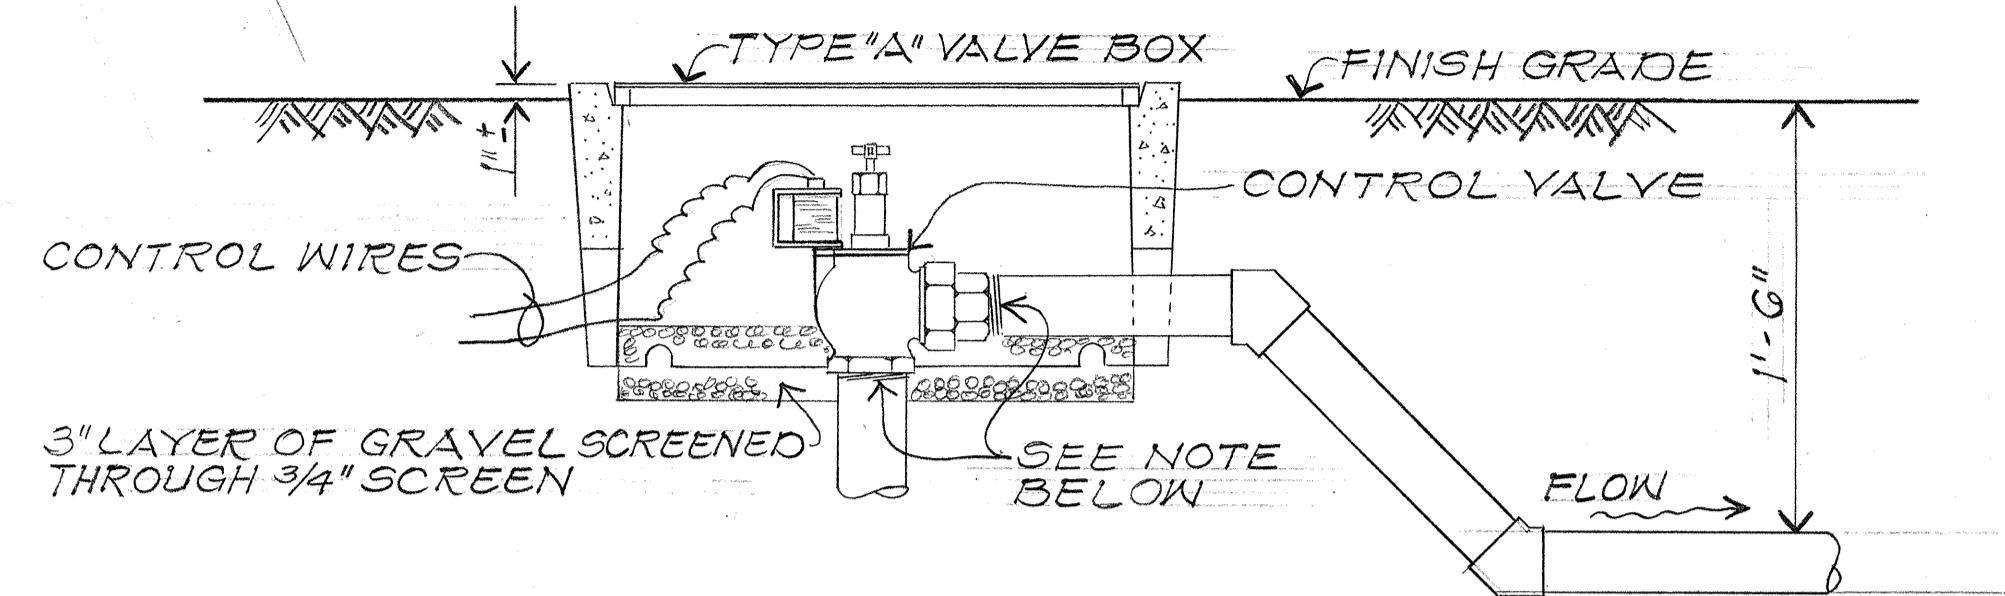TYPE "A" VALVE BOX INSTALLATION FOR CONTROL VALVE

NOTE: WHERE THE CONTROL VALVE IS SMALLER THAN THE PIPE INDICATED ON PLANS, THE CONTRACTOR SHALL PROVIDE THE NECESSARY FITTINGS TO REDUCE THE PIPE AT THE CONTROL VALVE.

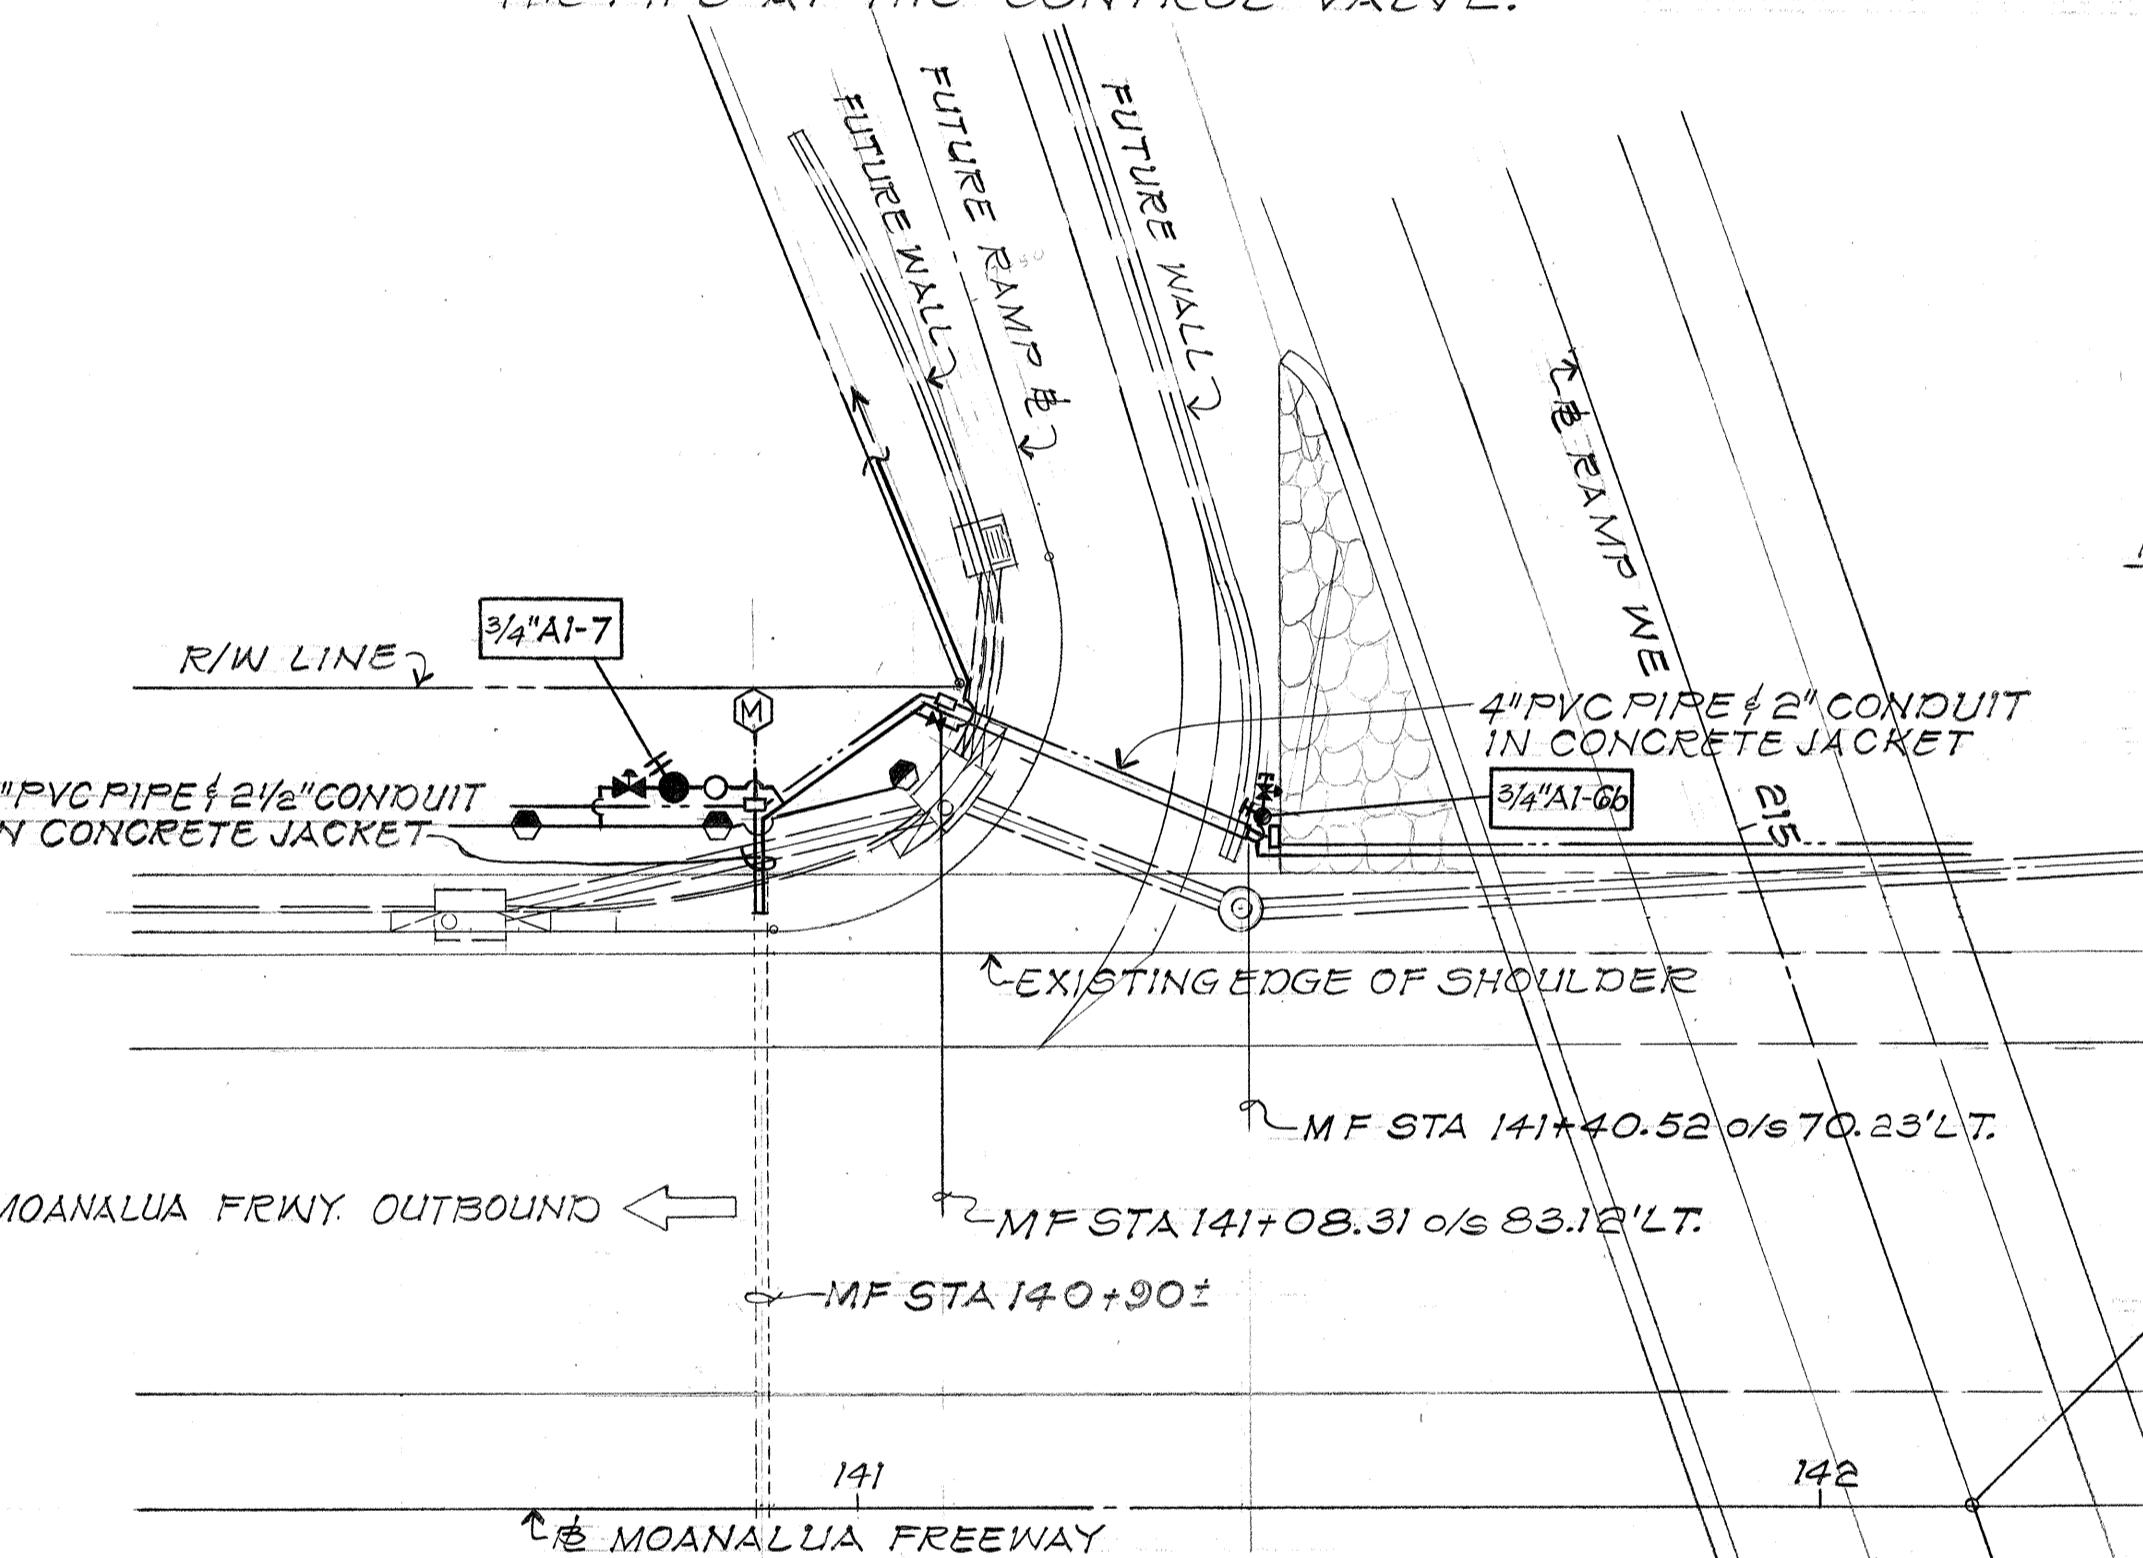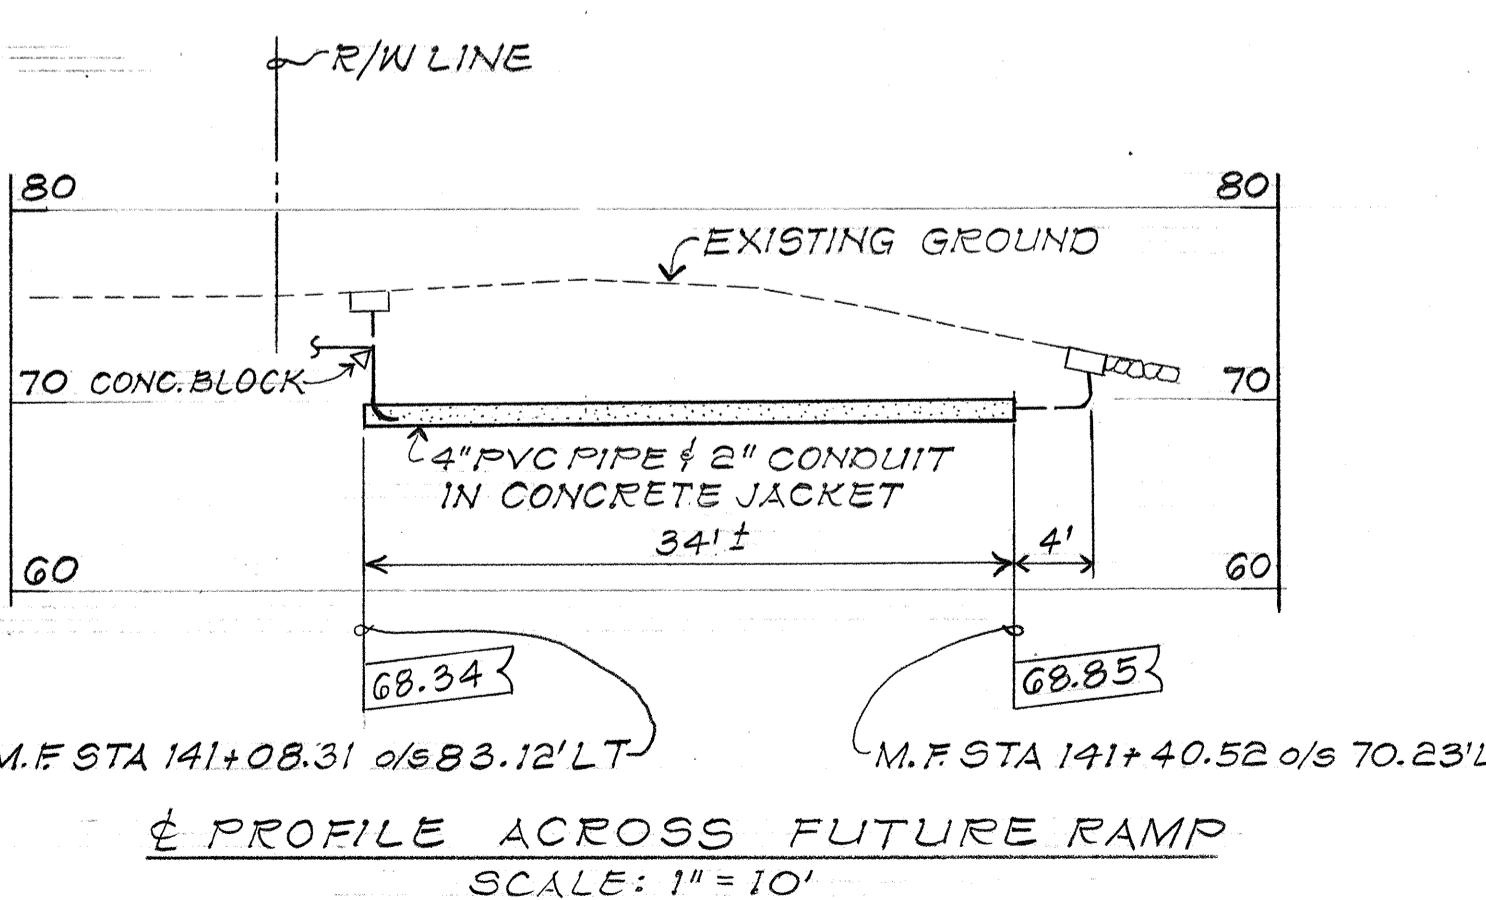PLAN  
SCALE: 1" = 20'

E PROFILE ACROSS FUTURE RAMP  
SCALE: 1" = 10'

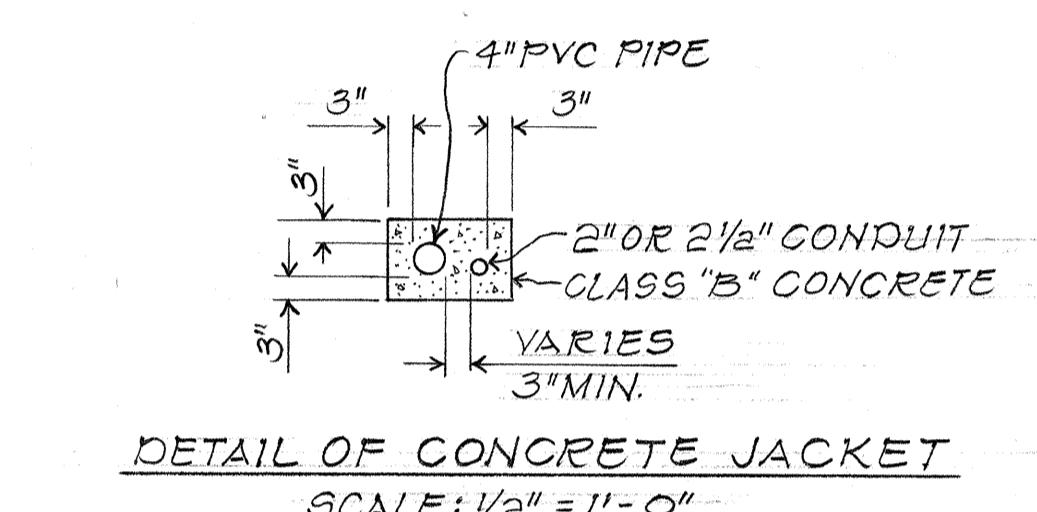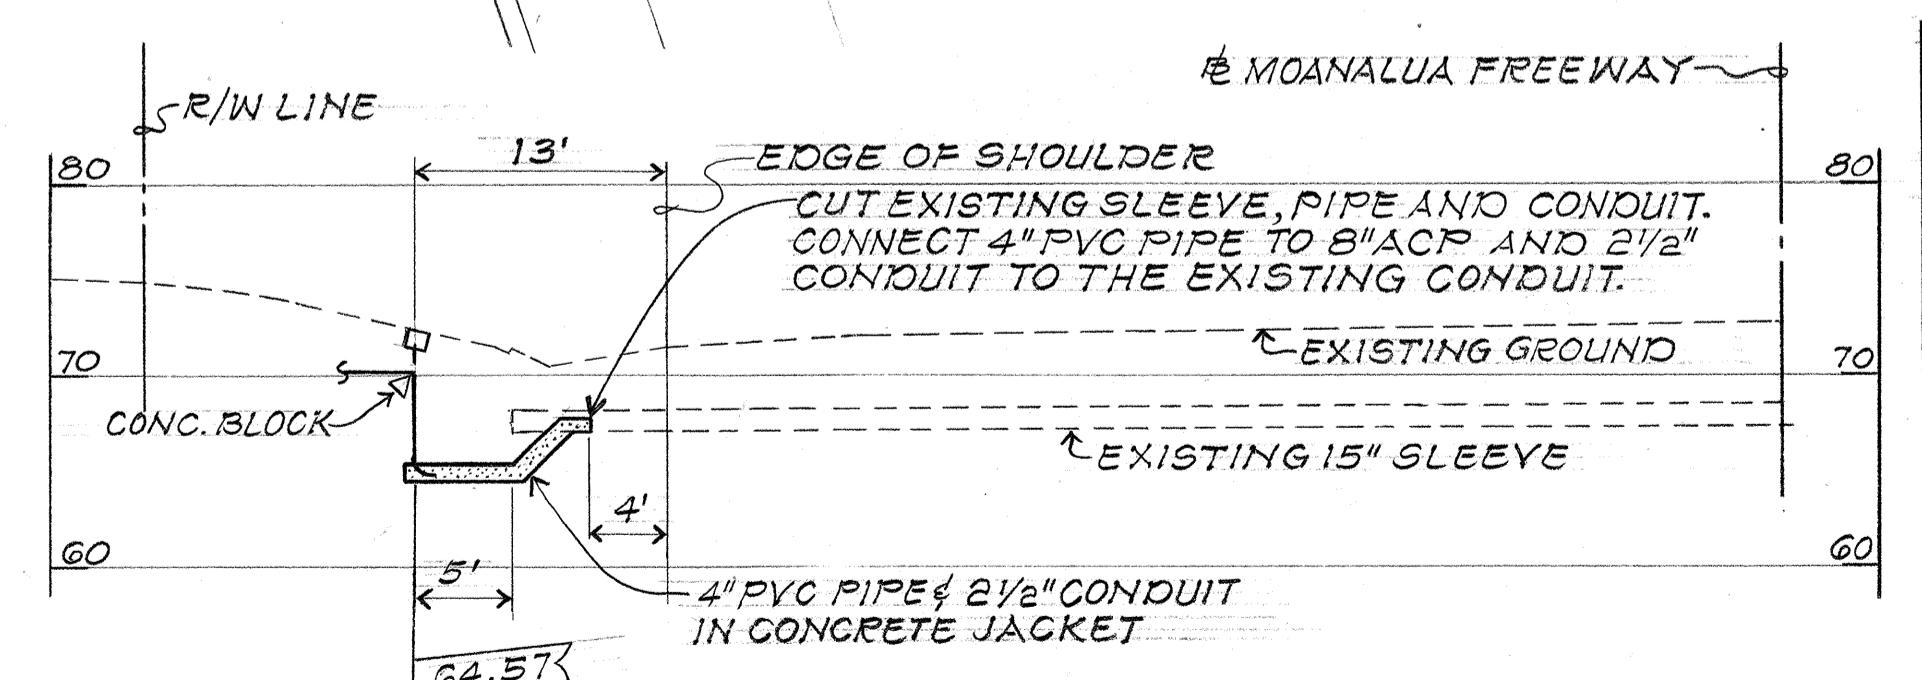DETAIL OF CONCRETE JACKET  
SCALE: 1/2" = 1'-0"

E PROFILE AT MF STA 140+90  
SCALE: 1" = 10'

JUN 77 DETAILS OF PIPE CROSSING IN VICINITY OF RAMP WE AND MOANALUA FREEWAY

8/3/76 Sheet added to contract plan to show details of Type "A" Valve Box.

DATE REVISION

STATE OF HAWAII  
DEPARTMENT OF TRANSPORTATION  
HIGHWAYS DIVISION

IRRIGATION SYSTEM  
DETAILS

INTERSTATE ROUTE H-1  
PROJ. NO. I-HI-1(02):13

Not to Scale Date: AUG. 1976

SHEET NO. OF SHEETS

COADD. 50 S-1