

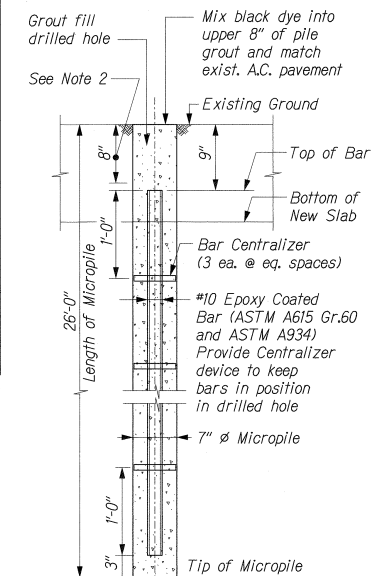


ROW #	TOTAL NO. OF PILES	PILE SPACING	ROW DIST.
①	14 Piles	@ 4'-9 $\frac{1}{8}$ " \pm	61'-10 $\frac{3}{4}$ "
②	14 Piles	@ 4'-8" \pm	60'-7 $\frac{1}{2}$ "
③	13 Piles	@ 4'-11 $\frac{3}{8}$ " \pm	59'-4 $\frac{1}{8}$ "
④	13 Piles	@ 4'-10 $\frac{1}{8}$ " \pm	58'-0 $\frac{7}{8}$ "
⑤	13 Piles	@ 4'-8 $\frac{3}{4}$ " \pm	56'-9 $\frac{1}{2}$ "
⑥	12 Piles	@ 5'-0 $\frac{5}{8}$ " \pm	55'-6 $\frac{1}{4}$ "
⑦	12 Piles	@ 4'-11 $\frac{1}{8}$ " \pm	54'-2 $\frac{7}{8}$ "
⑧	12 Piles	@ 4'-9 $\frac{3}{4}$ " \pm	52'-11 $\frac{5}{8}$ "
⑨	12 Piles	@ 4'-8 $\frac{3}{8}$ " \pm	51'-8 $\frac{1}{4}$ "
⑩	11 Piles	@ 5'-0 $\frac{1}{2}$ " \pm	50'-5 $\frac{1}{8}$ "
⑪	11 Piles	@ 4'-10 $\frac{7}{8}$ " \pm	49'-1 $\frac{5}{8}$ "
⑫	11 Piles	@ 4'-9 $\frac{3}{8}$ " \pm	47'-10 $\frac{1}{4}$ "
⑬	10 Piles	@ 4'-10 $\frac{1}{8}$ " \pm	43'-7 $\frac{1}{4}$ "
⑭	9 Piles	@ 4'-11"	39'-4 $\frac{1}{8}$ "
⑮	8 Piles	@ 5'-11 $\frac{1}{8}$ "	35'-8 $\frac{1}{4}$ "
⑯	8 Piles	@ 4'-6 $\frac{7}{8}$ "	32'-0 $\frac{3}{8}$ "
⑰	7 Piles	@ 4'-8 $\frac{3}{4}$ "	28'-4 $\frac{3}{8}$ "
⑱	6 Piles	@ 4'-11 $\frac{3}{8}$ "	24'-8 $\frac{5}{8}$ "

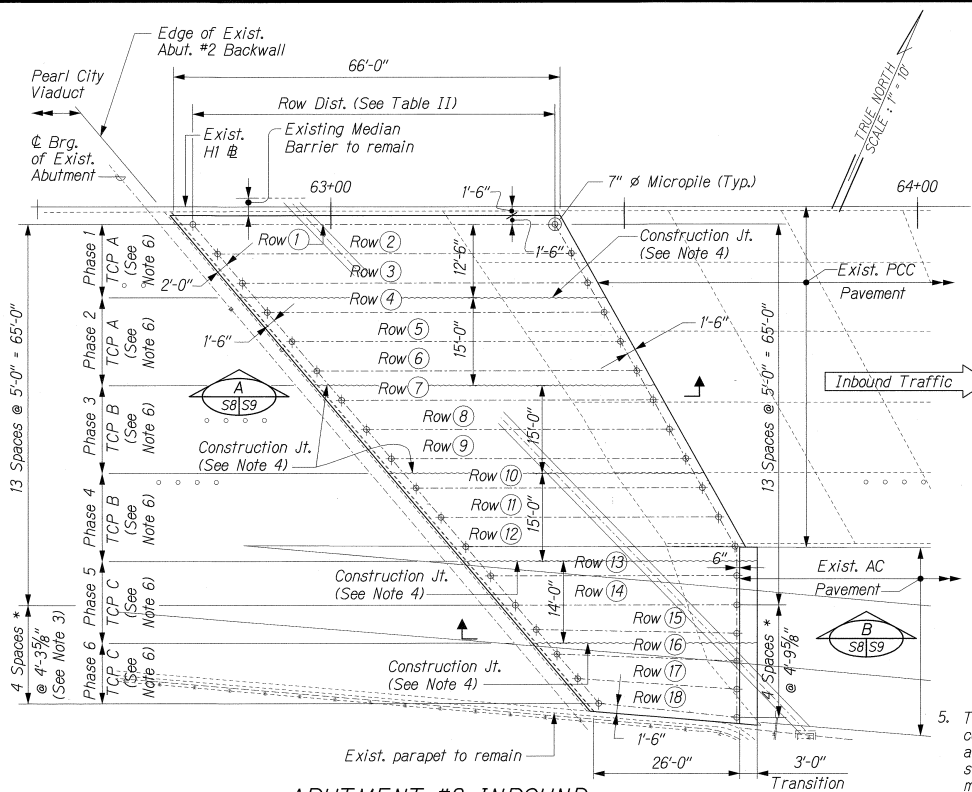

Scale: $1\frac{1}{2}''=1'-0''$

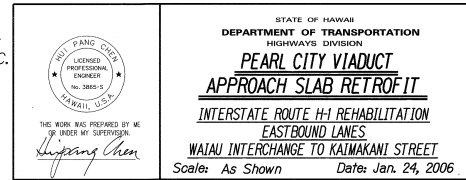

ABUTMENT #2 INBOUND
APPROACH SLAB RETROFIT FOUNDATION PLAN

Scale: 1"=10'-0"

NOTES:

1. Drill holes for micropiles from existing ground, install Bars with centralizer, and fill grout up to top of existing ground. See Note 1 on Sht. SI.
2. Remove the existing approach slab and upper 8" grout fill of micropile. Clean the upper portion of micropile to be embedded in slab prior to slab installation. The removal of the existing approach slab and upper 8" grout fill of micropiles shall be incidental to structural excavation and will not be paid separately. Do not damage the #10 epoxy coated rebar. Repair any damage to the epoxy coating and rebar.
- *3. Verify dimensions in field and adjust spacings accordingly.
4. Approach slab retrofit shall be constructed in 6 phases as shown. Each Phase shall include the existing slab removal stated in Note 2 this sheet, provisions of threaded couplers stated in Note 2 of Sheet S9, and the slab retrofit as shown. For traffic control and construction lane closure time limitation for each phase, see traffic control plans and Special Provisions Section 645. Maturity meters shall be installed to monitor concrete temperature. The results from maturity meter may be used by the Engineer to determine concrete strength. The Contractor shall provide data and temperature/strength relationship charts and submit temperature/strength relationship charts for review and acceptance.
5. Contractor shall provide joint reinforcement consisting of joint reinforcement bars welded to the existing slab reinforcement bars at no additional cost to the State.
6. TCP indicates work to be completed in specified traffic control phase. See Traffic Control Plans.
7. For spot elevations of approach slab, see Sheet C17. When the finish grade of the new approach slab is higher than existing pavement at construction joint of each phase, the Contractor shall pave a temporary 2 feet wide A.C. transition ramp over the existing A.C. pavement to provide a smooth riding surface. When the finish grade of the new approach slab is lower than existing pavement at construction joint of each phase, the Contractor shall grind a temporary 2 feet wide transition ramp on the existing A.C. pavement to provide a smooth riding surface.