

INDEX TO DRAWINGS	
SHEET NO.	DESCRIPTION
1	TITLE SHEET
2	STANDARD PLANS SUMMARY
3	GENERAL NOTES & LEGEND
4 - 5	WATER POLLUTION & EROSION CONTROL NOTES
6 - 7	TYPICAL SECTION & DETAILS
8 - 17	ROADWAY PLANS
18 - 32	PAVEMENT MARKING, LEGEND, DETAILS, NOTES & STRIPING PLANS

STATE OF HAWAII

DEPARTMENT OF TRANSPORTATION

HIGHWAYS DIVISION

HONOLULU, HAWAII

"AS-BUILT"

PLANS FOR

INTERSTATE ROUTE H-1

PAVEMENT PREVENTIVE MAINTENANCE




WAIKELE STREAM BRIDGE TO WAIPAHU STREET

FEDERAL-AID PROJECT NO. IM-H1-1(256)

DISTRICT OF EWA

ISLAND OF OAHU

FED. ROAD DIST. NO.	STATE	FED. AID PROJ. NO.	FISCAL YEAR	SHEET NO.	TOTAL SHEETS
HAWAII	HAW.	IM-H1-1(256)	2007	1	32

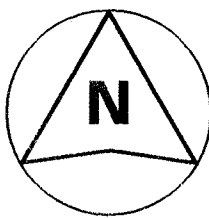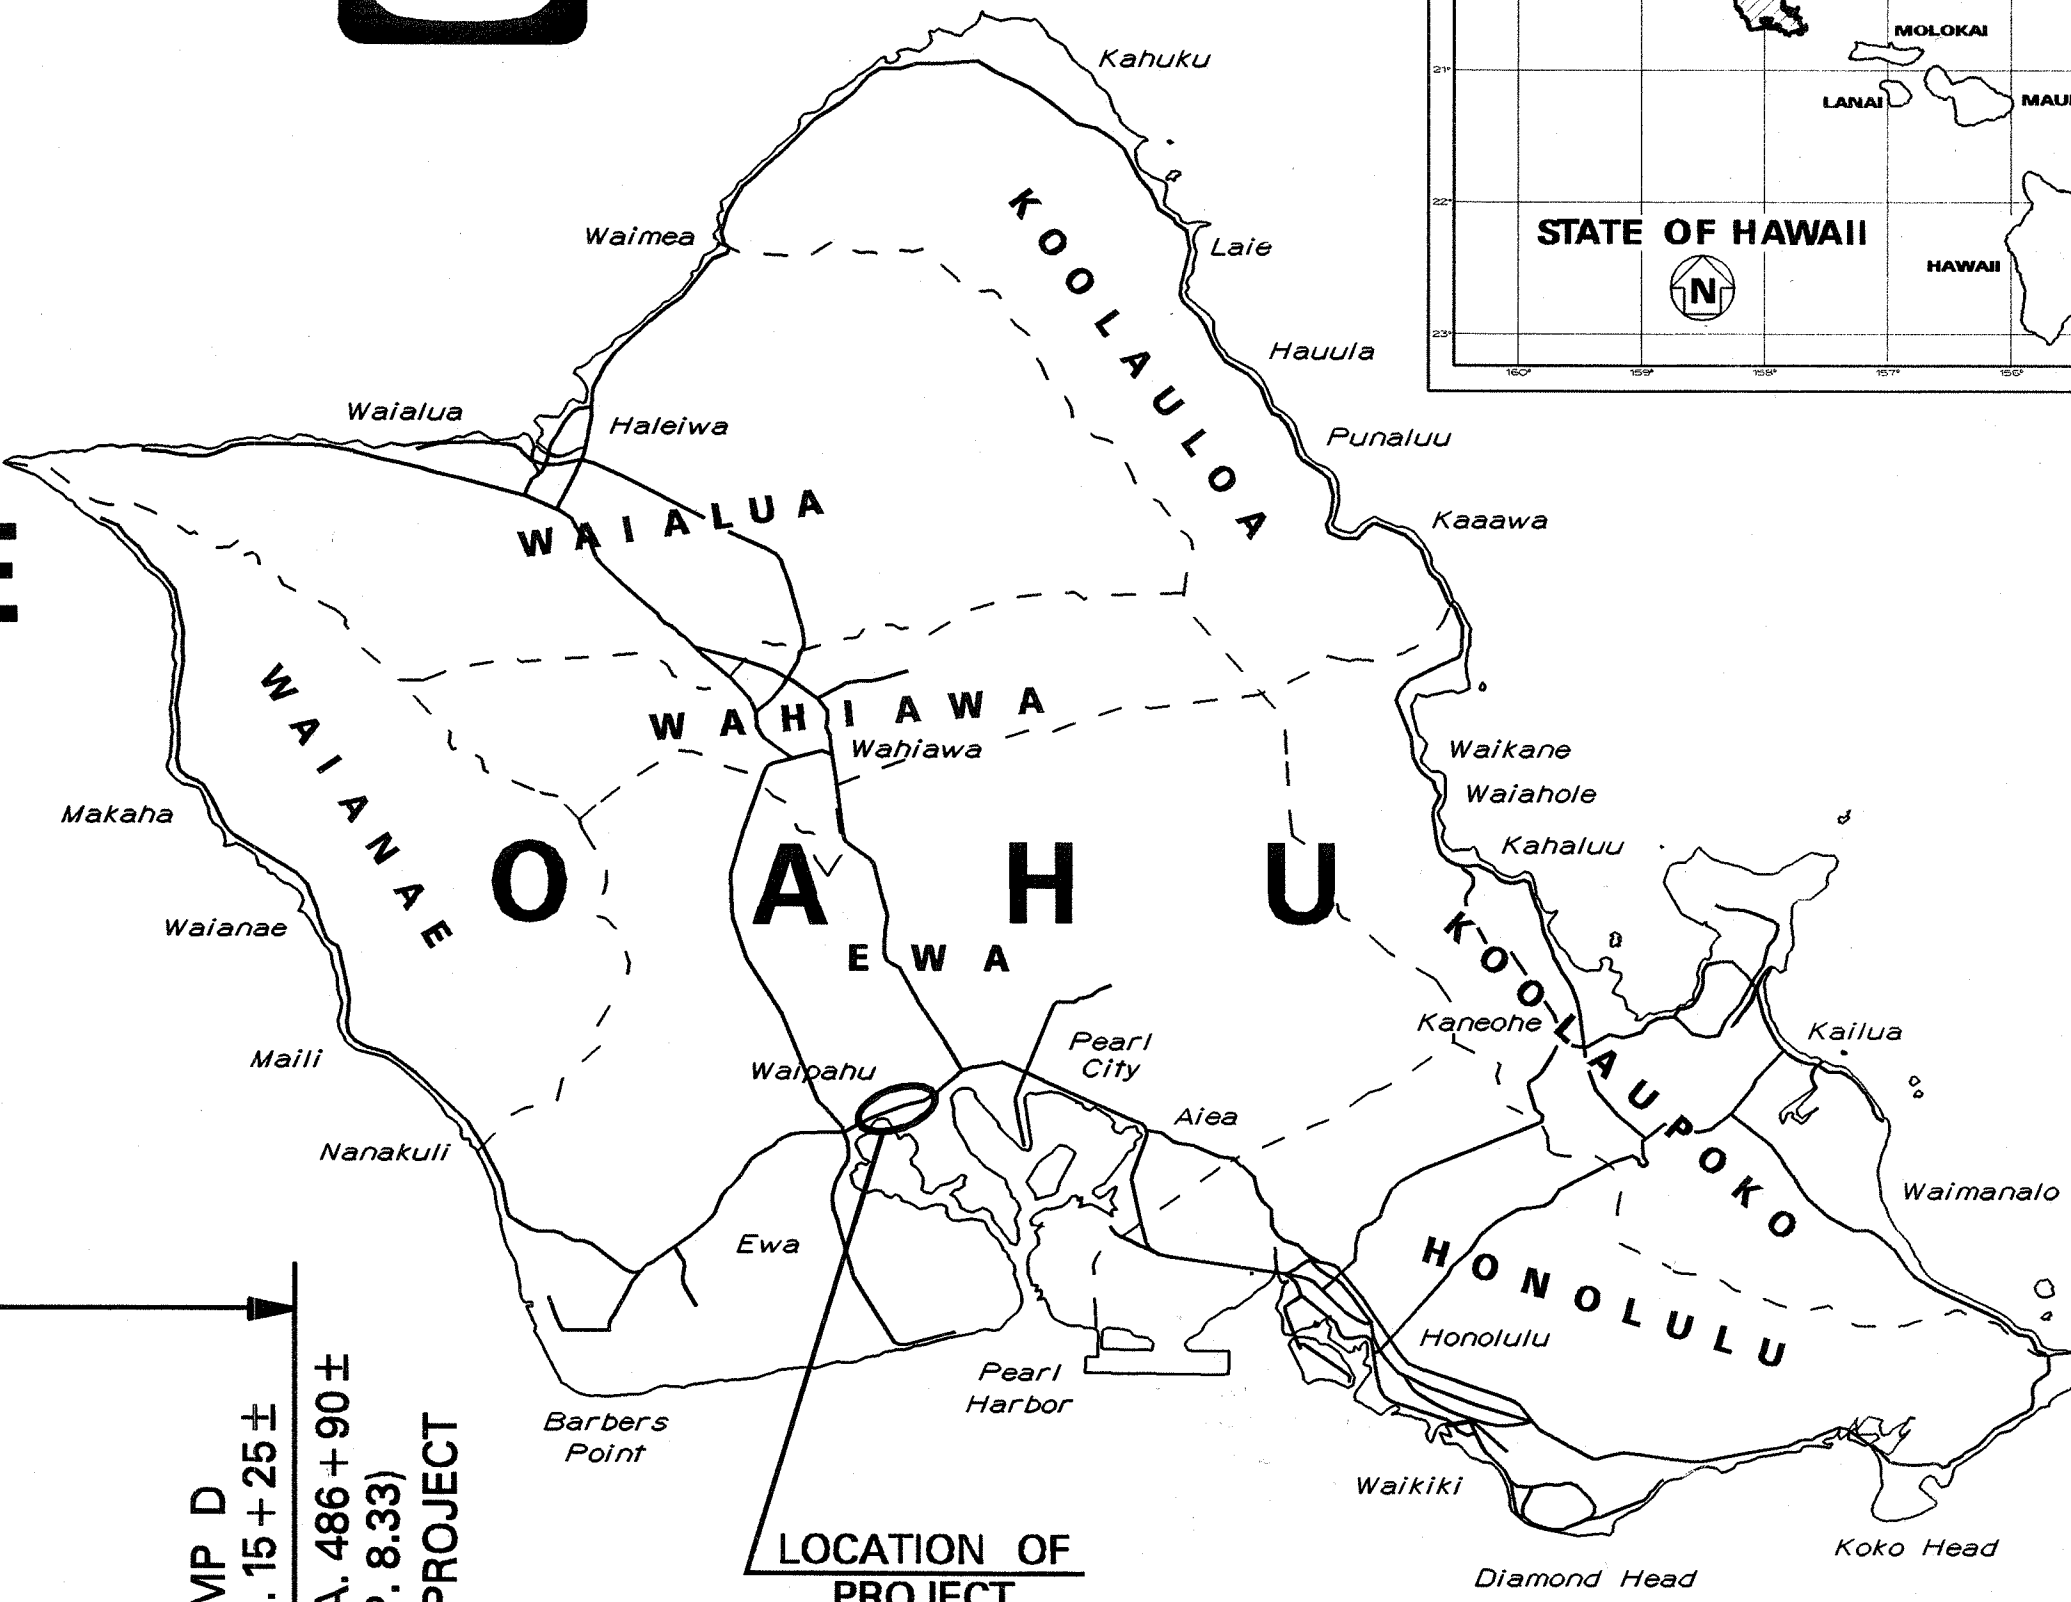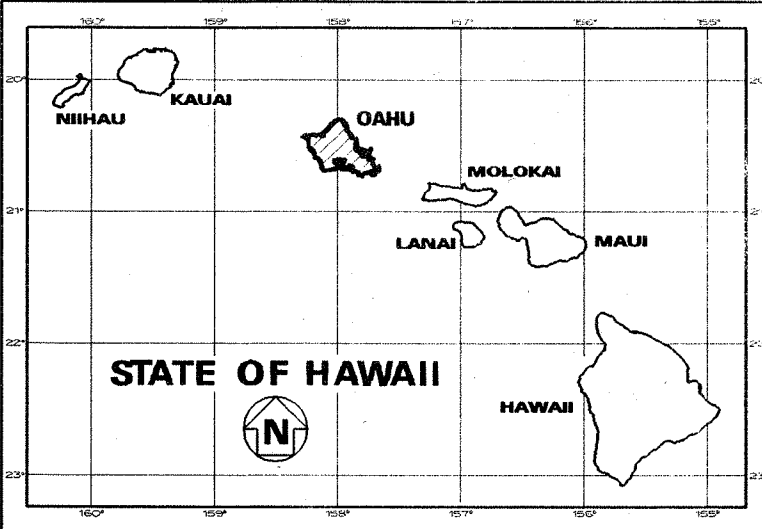

SCALE IN MILES

MILE POST 6.50 TO MILE POST 8.33

DESIGN DESIGNATION

ADT (2006)	157,000
ADT (2016)	196,000
DHV	14,700
V	55/45 M.P.H.
T	2.5

CHANGES MADE DURING CONSTRUCTION HAVE BEEN INCORPORATED ON THESE PLANS EXCEPT CHANGES IN THE ORIGINAL THEORETICAL QUANTITIES. FOR ACTUAL QUANTITIES, REFER TO PROJECT LEDGER AND/OR COMPUTATION BOOK.

RESIDENT ENGINEER


3/11
DATE

DEPARTMENT OF TRANSPORTATION
STATE OF HAWAII

APPROVED:

DIR. OF TRANSPORTATION

3-13-07
 DATE

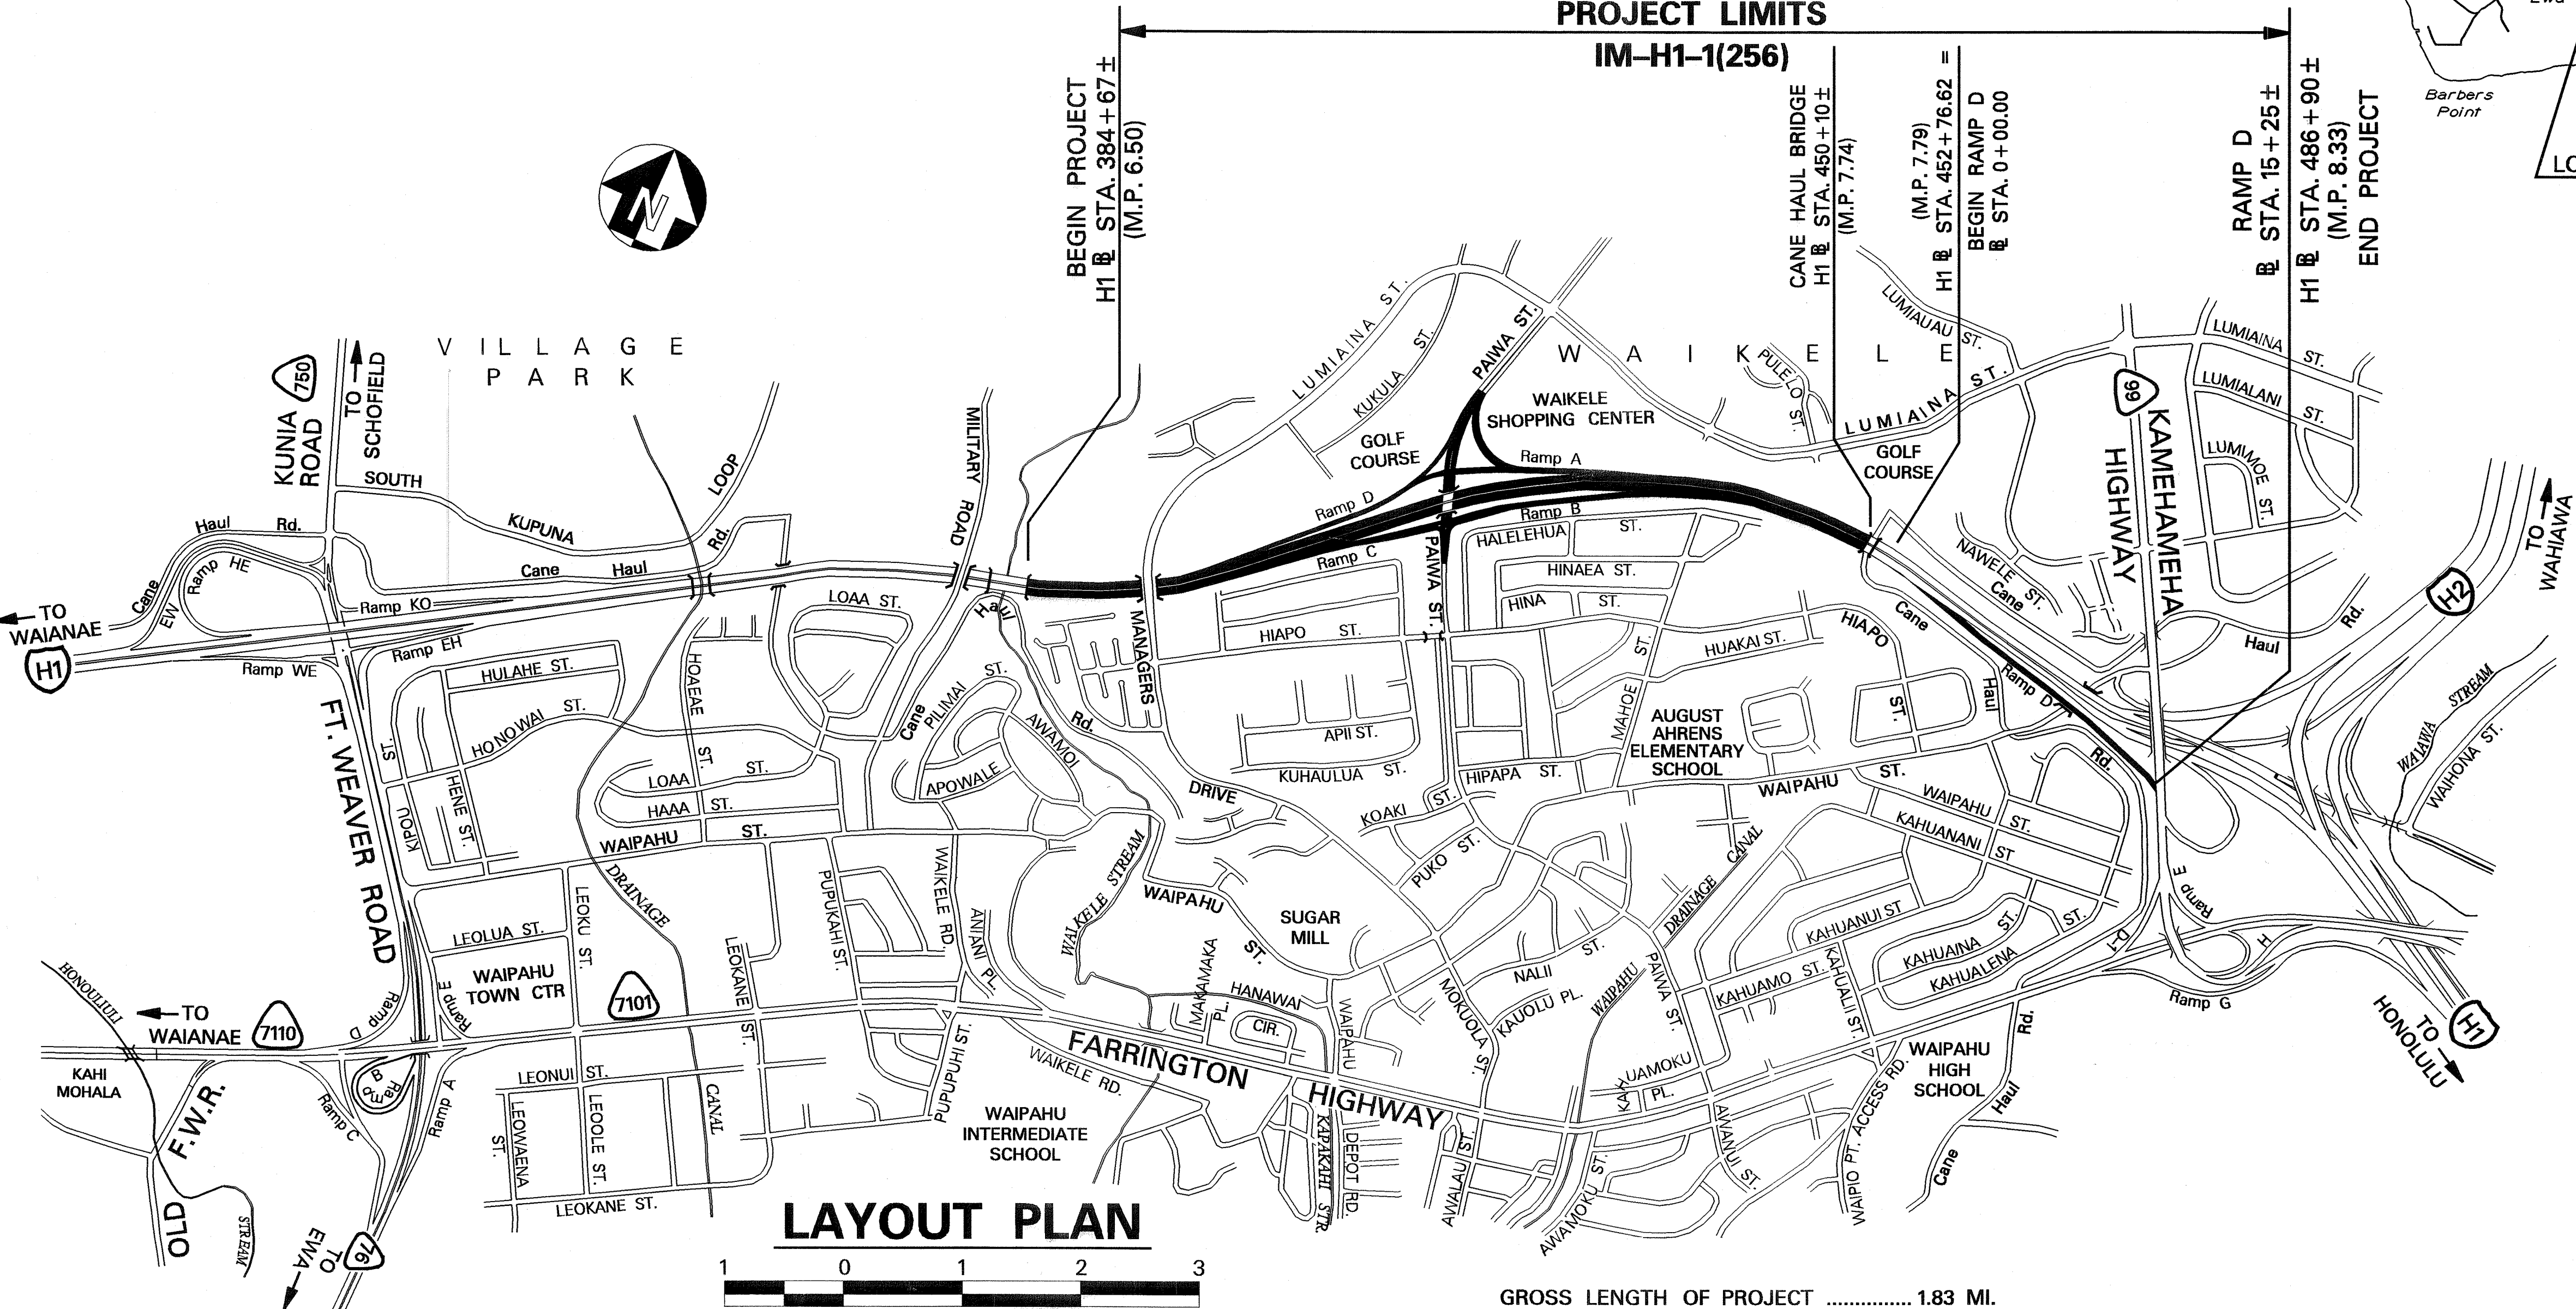

LAYOUT PLAN

1 0 1 2 3

SCALE IN THOUSAND FEET

GROSS LENGTH OF PROJECT 1.83 MI.
NET LENGTH OF PROJECT 1.78 MI.

HWY-DD
 MANAGED BY
 692-7570
 PHONE
 March 2007
 DATE

HWY-D
 DESIGNED BY

03-07-07

mg

MG

dd5usr2.mq3rnl
019h1d1sh1.dgn