
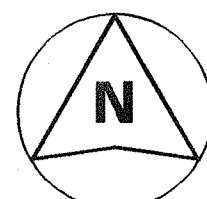
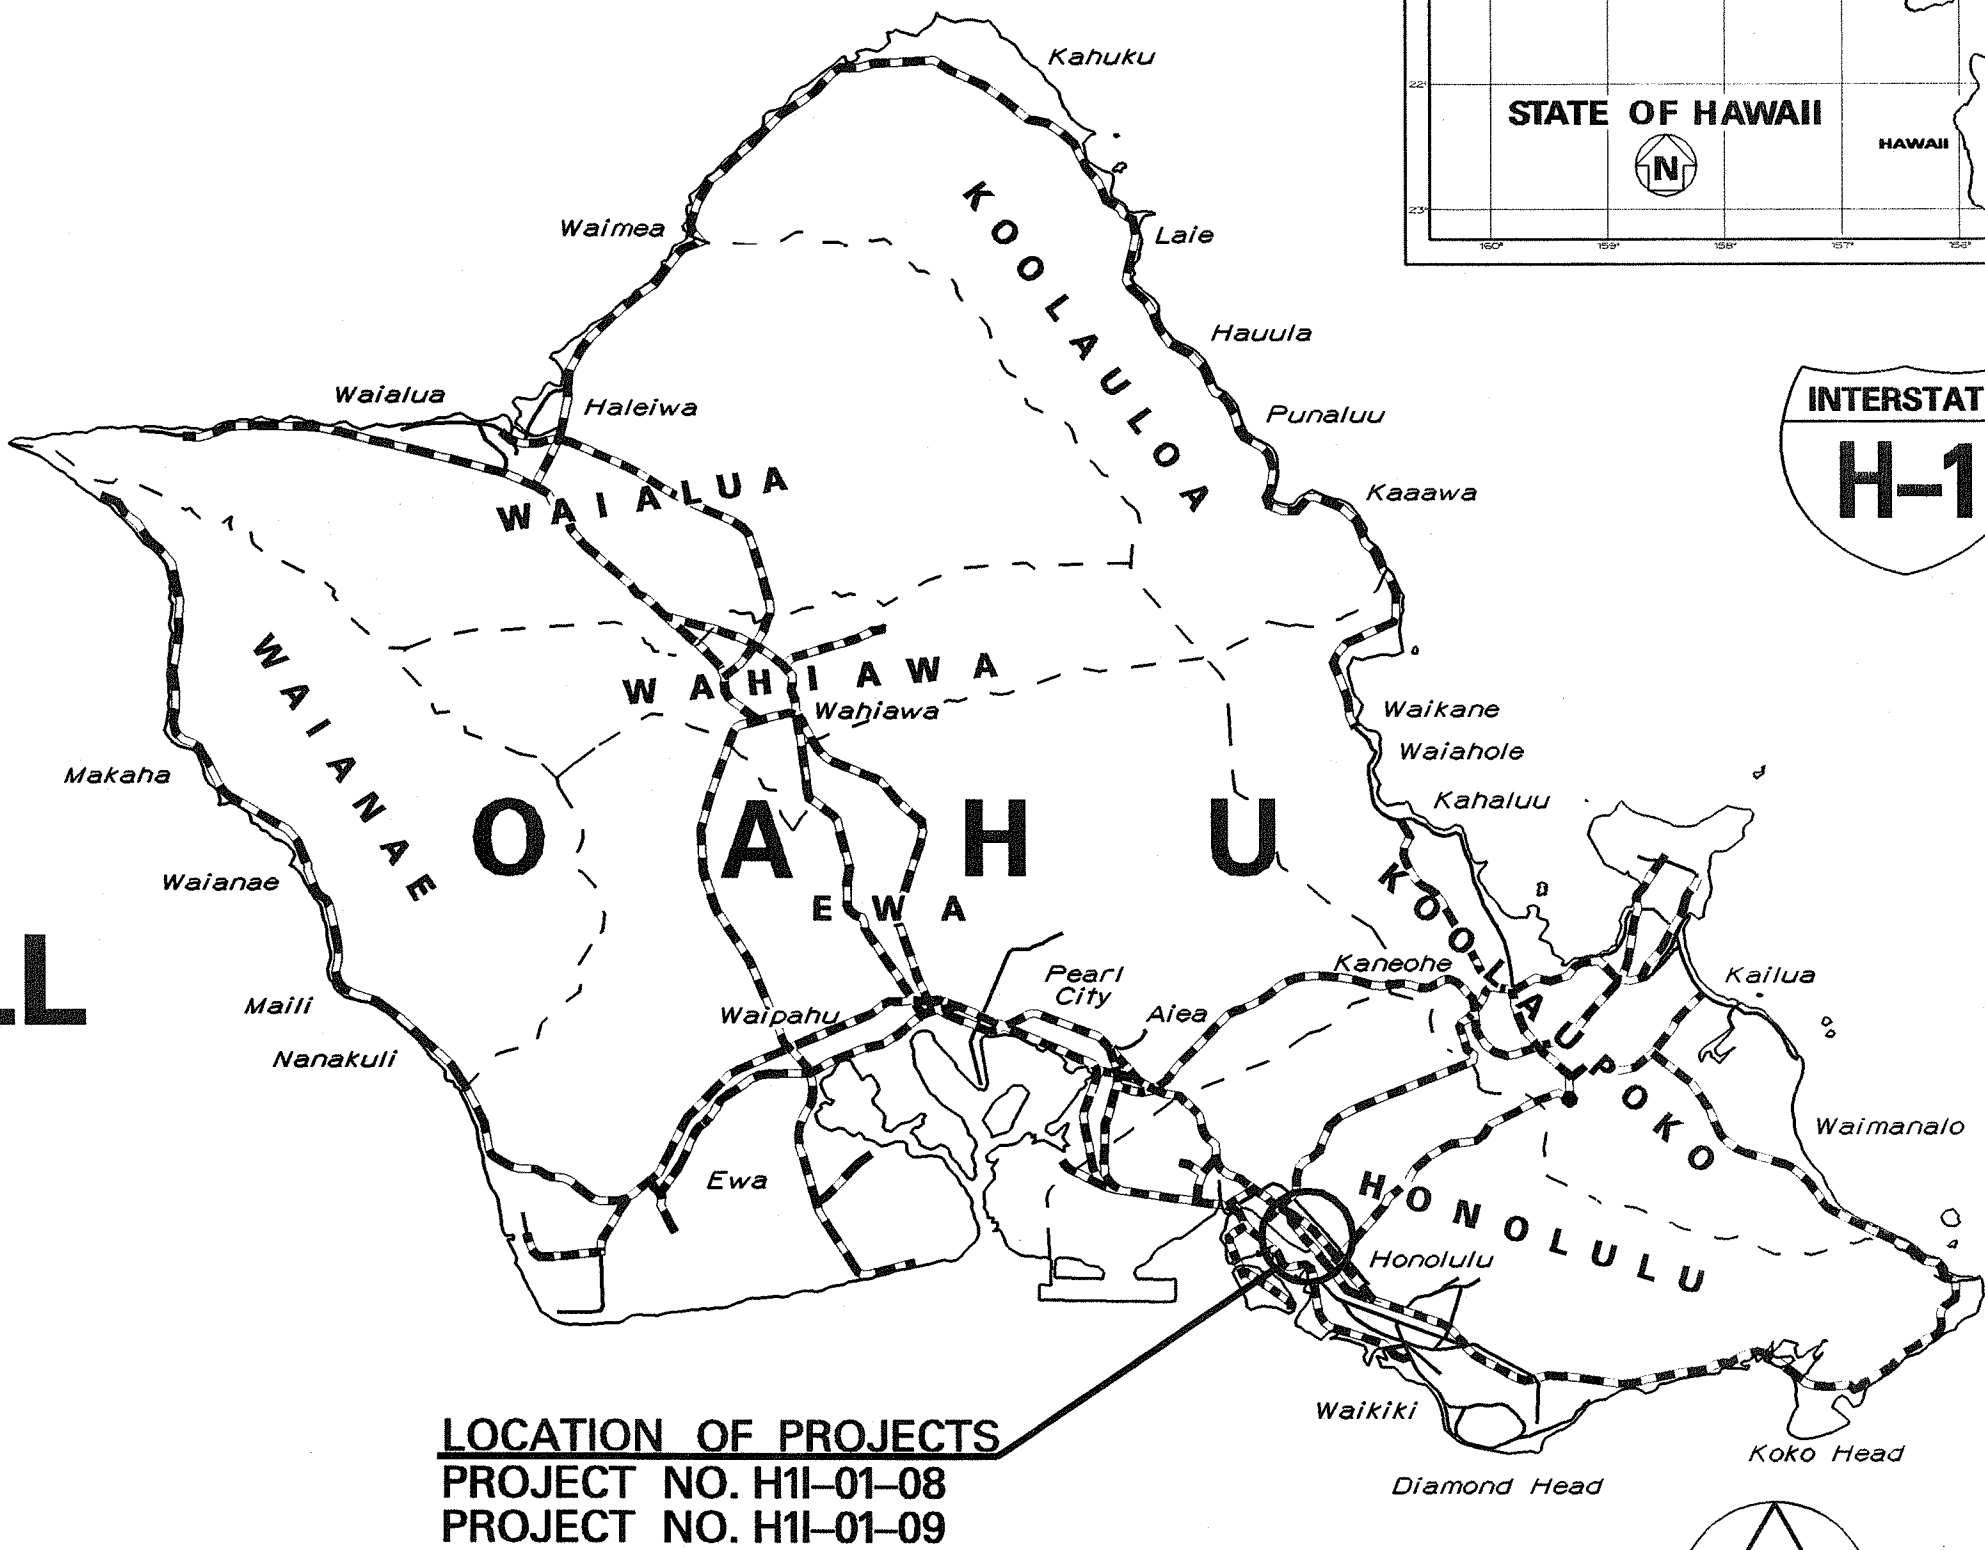


INDEX TO DRAWINGS	
SHEET NO.	DESCRIPTION
1	TITLE SHEET
2 - 55	PROJECT NO. H1I-01-08
56 - 73	PROJECT NO. H1I-01-09

FED. ROAD DIST. NO.	STATE	FED. AID PROJ. NO.	FISCAL YEAR	SHEET NO.	TOTAL SHEETS
HAWAII	HAW.	H1I-01-08 H1I-01-09	2009	1	73

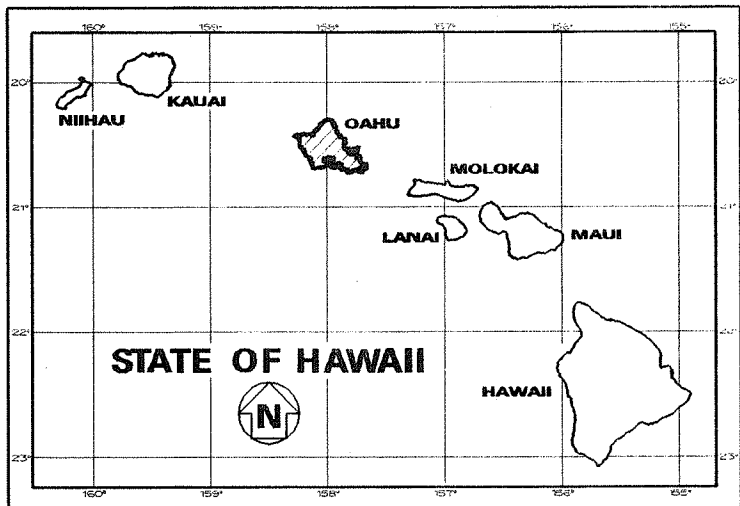

----- FEDERAL AID PROJECTS PREVIOUSLY CONSTRUCTED OR UNDER CONSTRUCTION

STATE OF HAWAII
DEPARTMENT OF TRANSPORTATION
HIGHWAYS DIVISION
HONOLULU, HAWAII
"AS-BUILT"
PLANS FOR
INTERSTATE ROUTE H-1
EXTENSION AND REPAIR OF
SCHOOL STREET ON-RAMP RETAINING WALL
PROJECT NO. H1I-01-08
AND
INTERSTATE ROUTE H-1
DRAINAGE IMPROVEMENTS
VICINITY OF SCHOOL STREET OFF-RAMP
PROJECT NO. H1I-01-09

DISTRICT OF HONOLULU
ISLAND OF OAHU

DESIGNED BY _____ HWY-D
MANAGED BY _____ HWY-DD
692-7570 PHONE
Feb. 2009 DATE

CHANGES MADE DURING CONSTRUCTION HAVE BEEN INCORPORATED ON THESE PLANS EXCEPT CHANGES IN THE ORIGINAL THEORETICAL QUANTITIES. FOR ACTUAL QUANTITIES, REFER TO PROJECT LEDGER AND/OR COMPUTATION BOOK.
Resident Engineer 3/20/13
RESIDENT ENGINEER DATE