



FED. ROAD DIST. NO.	STATE	FED. AID PROJ. NO.	FISCAL YEAR	SHEET NO.	TOTAL SHEETS
HAWAII	HAW.	HII-01-08	2009	7	73

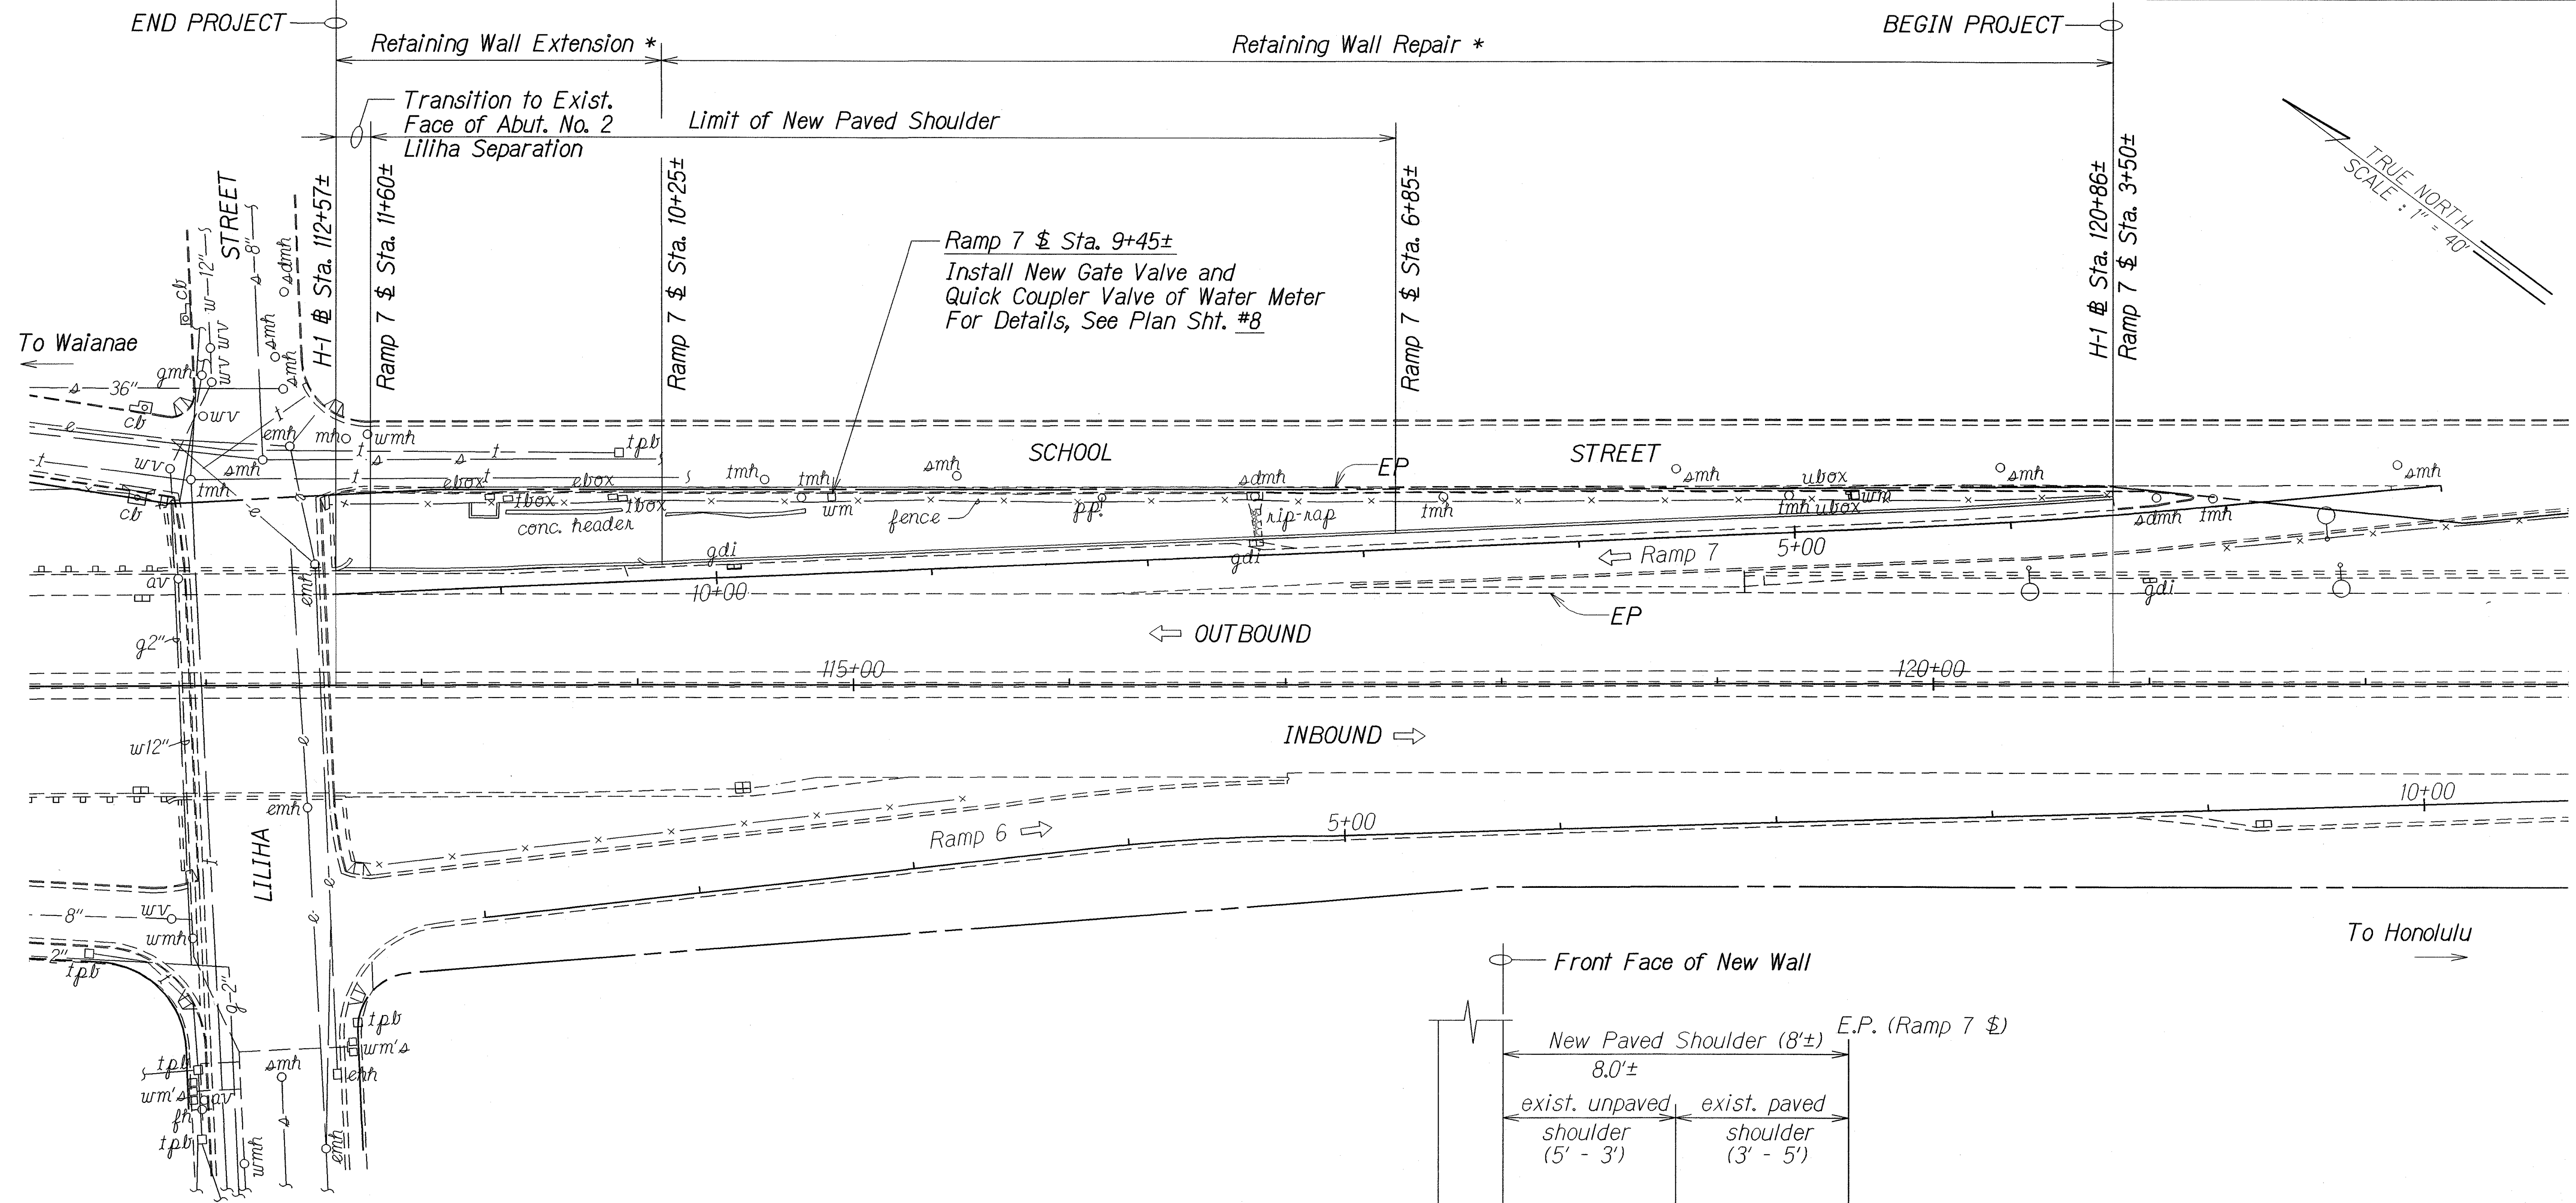

* For Details, See Structural Plan Sheets.

See Plan Sht. #16
for Excavation &
Backfill Details

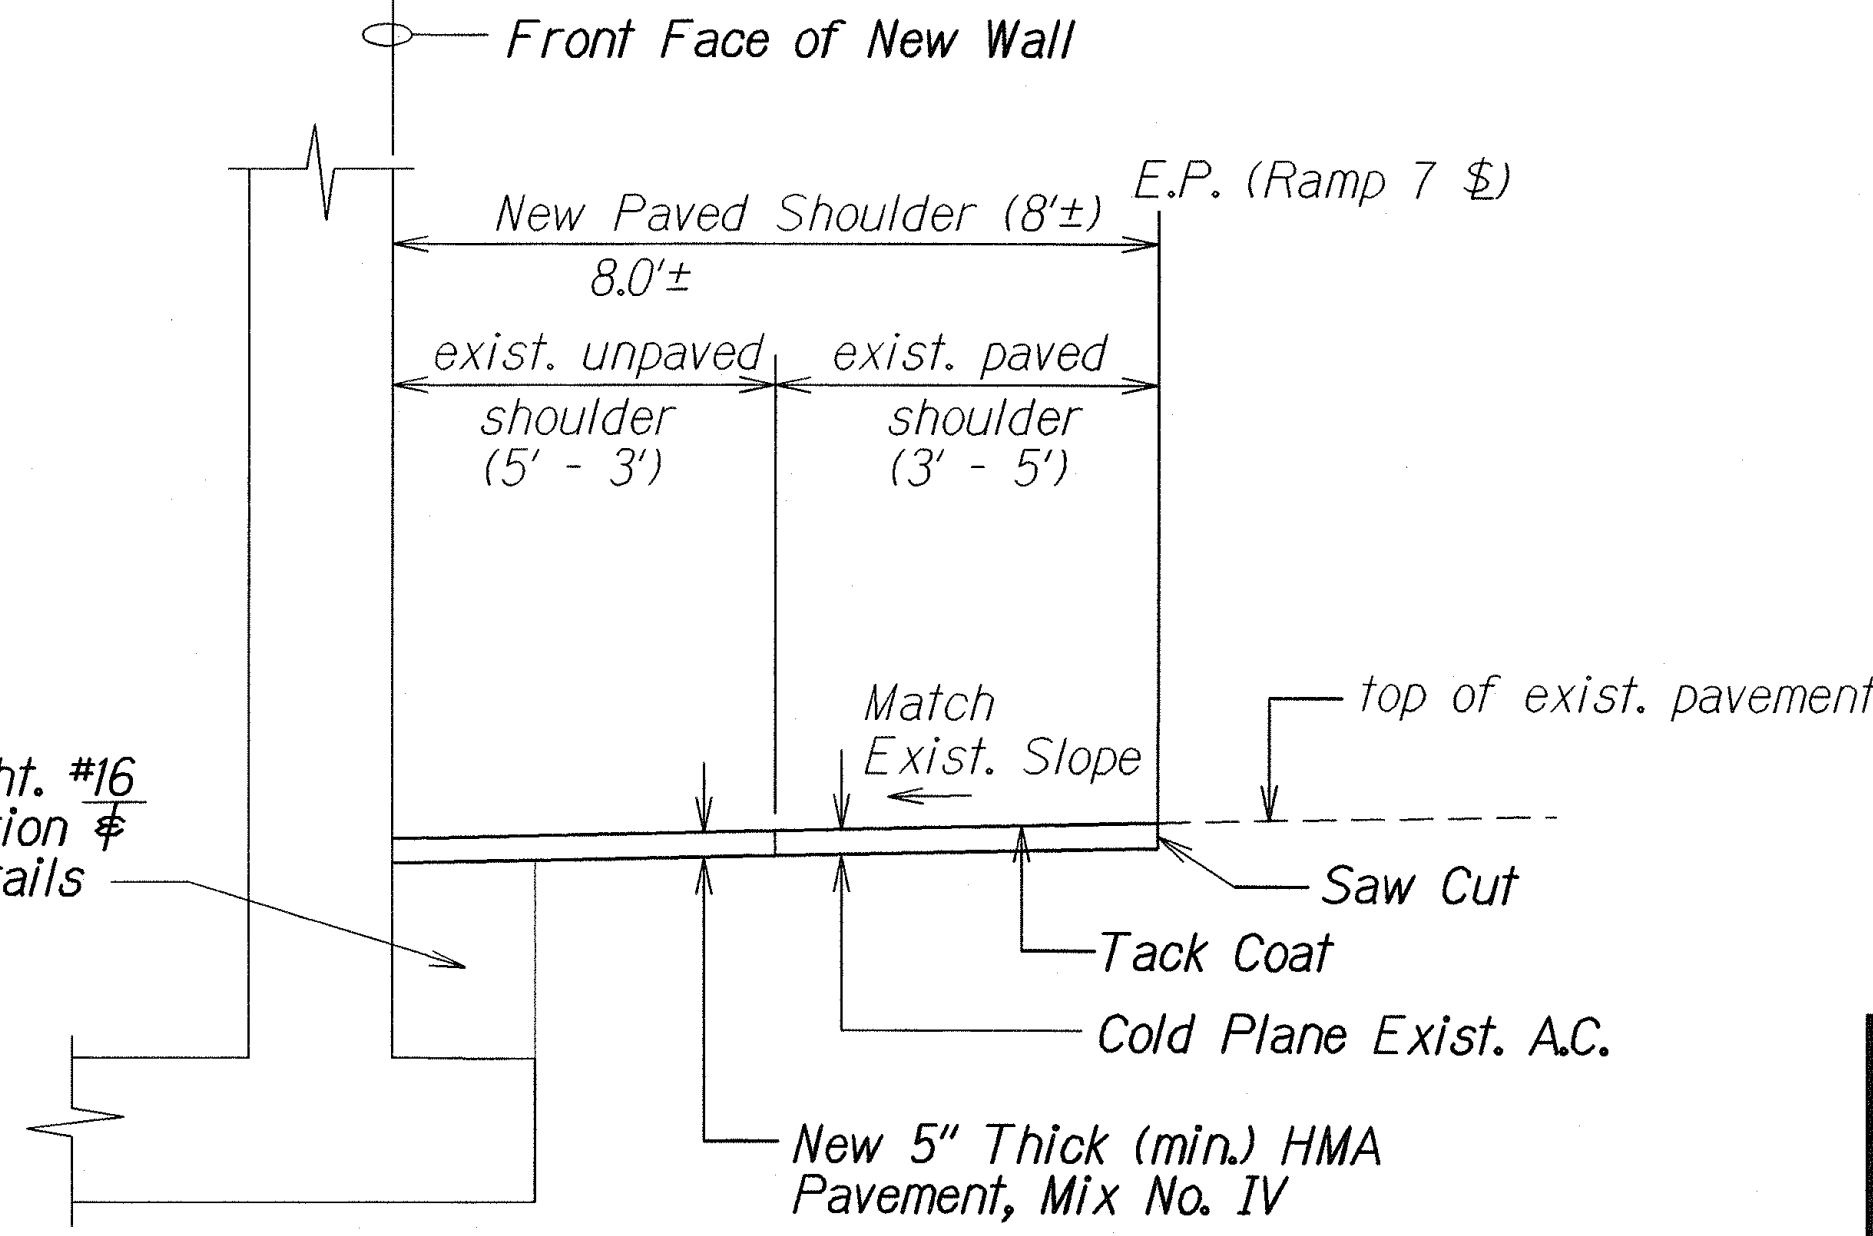

TYPICAL SECTION FOR A.C. SHOULDER
RAMP 7 \$ Sta. 6+85± to \$ Sta. 11+60±
Not to Scale

STATE OF HAWAII
DEPARTMENT OF TRANSPORTATION
HIGHWAYS DIVISION

ROADWAY PLAN
INTERSTATE ROUTE H-1
Extension and Repair of
School Street On-Ramp Retaining Wall
Project No. HII-01-08

Scale: 1" = 40' Date: Feb., 2009

SHEET No. 1 OF 1 SHEETS

ORIGINAL PLAN	SURVEY PLOTTED BY	DATE
NOTES BOOK	DRAWN BY	
ad/ken/ahh	DESIGNED BY	
ahh/oludon	CHECKED BY	