

FED. ROAD DIST. NO.	STATE	PROJ. NO.	FISCAL YEAR	SHEET NO.	TOTAL SHEETS
HAWAII	HAW.	H11-01-08	2009	ADD. 10	73

CONSTRUCTION NOTES (Cont.):

- (M) Location of drilled holes shown in plans are approximate. Prior to placing holes in concrete, the Contractor shall locate all reinforcing steel, anchor bolts, thru bolts holes, etc. and adjust the location of the drilled holes to clear them. Final hole locations are subject to the approval of the Engineer. Locations of 5"Ø holes for anchors shall be as shown in these Plans.
- (N) Existing guardrail and posts shall be removed and disposed of as directed by the Engineer and shall be incidental to Pay Item 202.0100.
- (O) When only portions of concrete are to be demolished, the intersections between the demolished concrete and the concrete that is to remain shall have a 3/4 inch deep sawcut around the entire perimeter of the demolished area.
- (P) At the time concrete is placed, reinforcing shall be free from mud, oil, laitance or other coatings adversely affecting bond capacity.
- (Q) The concrete surfaces which new concrete is poured against shall be roughened to a full amplitude of 1/4 of an inch and cleaned.
- (R) All exposed existing reinforcing shall remain in place and shall not be damaged in any way unless otherwise noted.
- (S) All existing reinforcing that is to remain in place shall have a minimum concrete cover of 2".
- (T) New concrete surfaces shall match the finish of the existing structure. Any reveals, patterns, or decorative features shall also match the existing structure.
- (U) All existing walls shall be braced to prevent failure during all phases of construction until rock anchors have been tensioned and the lock-off load is in place. See Section 681 of the Special Provisions.
- (V) Backfilling of all new or built-up retaining walls shall not take place until the concrete 28 day strength is attained and rock-anchor lock-off loads are in place.
- (W) For all walls being repaired, expansion and contraction joint locations shall be extended and maintained.
- (X) Final wall appearance shall present a continuous surface without any deflections except for the transition areas specified in these plans. Additional wall thickness shall vary according to the existing wall deflections.
- (Y) Existing protruding drips on all walls shall be demolished at the top of all existing walls that are being thickened. New and heightened retaining walls shall have the top of the wall sloped 1/4:12 toward the backfill.

GENERAL:


- (A) All items noted incidental will not be paid for separately.
- (B) Standard Plans refer to all structures in general, except for modifications as may be required for special conditions. For such modifications refer to the corresponding detailed drawings.
- (C) Plans of the existing walls are available for review from the Highways Division Design Branch located at the State Department of Transportation, Highways Division Kakuhihewa Building, Room 609, 601 Kamokila Boulevard, Kapolei, HI 96707 (phone number 692-7586).
- (D) Temporarily relocate highway lighting conduit, pullboxes, etc. obstructing contract items. Care shall be taken to not damage existing tree roots and the existing retaining wall.
- (E) Located approximately 2'-0" in back of the existing retaining wall is a 2" PVC Schedule 40 Conduit supplying power to Highway Lighting. It is at a depth of 3'-0"± because the exact depth is unknown. The Contractor is advised to use extreme caution in drilling the anchor holes. Existing Lighting Standard Supports are located at Ramp 7 Sta. 11+37, Sta. 10+09, Sta. 8+57, Sta. 7+05 and Sta. 5+57.
- (F) All cracked and loose concrete portions of the existing retaining wall shall be removed prior to the placing of new concrete facing.

SURVEY PLOTTED BY	DATE
DRAWN BY	XXX 2009
TRACED BY	XXX 2009
CHECKED BY	XXX 2009
QUANTITIES BY	XXX 2009
CHECKED BY	XXX 2009

ORIGINAL PLAN
NOTE BOOK
NO. 1011042-0109

	3/31/09	Added General Note (F)
DATE	REVISION	
STATE OF HAWAII DEPARTMENT OF TRANSPORTATION HIGHWAYS DIVISION BRIDGE GENERAL NOTES INTERSTATE ROUTE H-1 EXTENSION AND REPAIR OF SCHOOL STREET ON-RAMP RETAINING WALL Project No. H11-01-08 Scale: As Noted Date: Feb., 2009		

FED. ROAD DIST. NO.	STATE	PROJ. NO.	FISCAL YEAR	SHEET NO.	TOTAL SHEETS
HAWAII	HAW.	H11-01-08	2009	ADD. 11	73

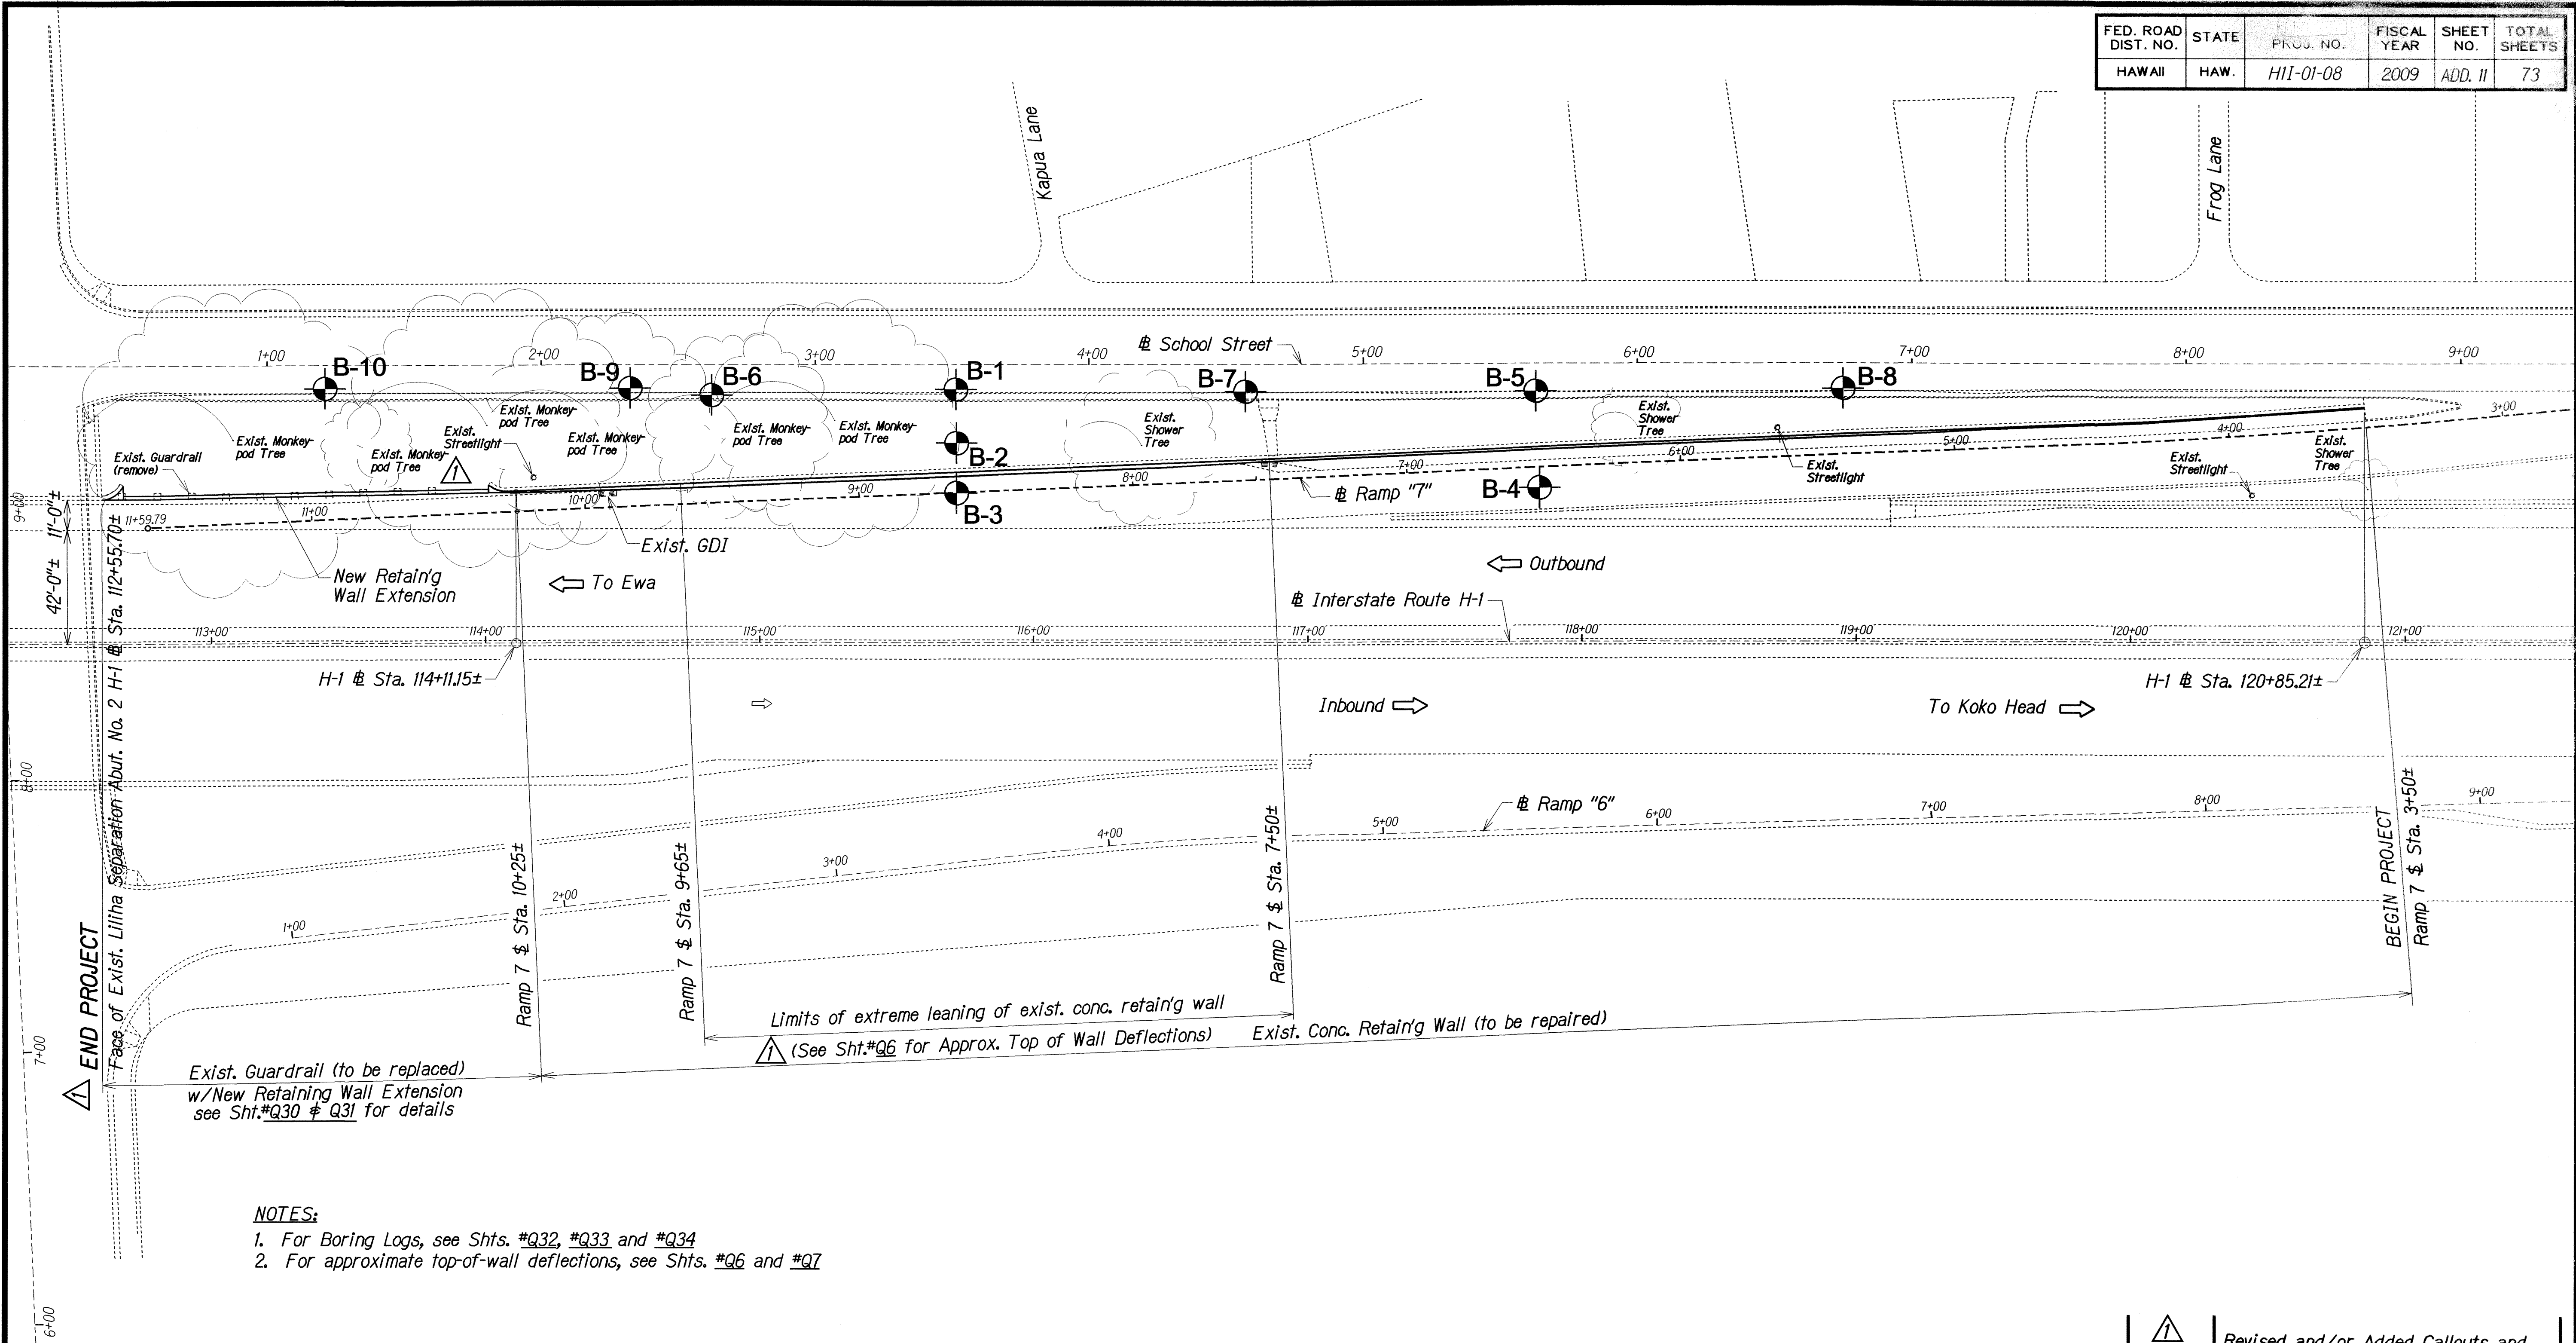

- NOTES:**
1. For Boring Logs, see Shts. #Q32, #Q33 and #Q34
 2. For approximate top-of-wall deflections, see Shts. #Q6 and #Q7

LEGEND

Approximate Boring Location

3/31/09	Revised and/or Added Callouts and Legend
DATE	REVISION
STATE OF HAWAII DEPARTMENT OF TRANSPORTATION HIGHWAYS DIVISION RETAINING WALL REPAIR and EXTENSION EXISTING SITE PLAN INTERSTATE ROUTE H-1 EXTENSION and REPAIR of SCHOOL STREET ON-RAMP RETAINING WALL Project No. H11-01-08	
Scale: As Noted	Date: Feb, 2009
SHEET No. Q3 OF 34 SHEETS	

FED. ROAD DIST. NO.	STATE	PROJ. NO.	FISCAL YEAR	SHEET NO.	TOTAL SHEETS
HAWAII	HAW.	H11-01-08	2009	ADD. 12	73

True North

REPAIR RETAINING WALL

Pyramat installation on slope

Ramp 7 & Sta. 5+15± @ expansion joint

FROG LANE

BEGIN PROJECT
H-1 @ Sta. 120+86±
Ramp 7 & Sta. 3+50±

SCHOOL STREET

INTERSTATE ROUTE H-1

OUTBOUND

INBOUND

LEGEND FOR AS-BUILT POSTINGS

PARTIAL LOCATION PLAN

Scale: 1"=20'-0"

3/31/09 Added New Light Standard and Callout

DATE REVISION

SHEET No. 04 OF 34 SHEETS

STATE OF HAWAII
DEPARTMENT OF TRANSPORTATION
HIGHWAYS DIVISION

RETAINING WALL REPAIR and EXTENSION

PARTIAL LOCATION PLAN

H1 @ Sta. 120+86± to Sta. 117+00

INTERSTATE ROUTE H-1

EXTENSION AND REPAIR OF

SCHOOL STREET ON-RAMP RETAINING WALL

Project No. H11-01-08

Date: Feb, 2009

Scale: As Noted

FED. ROAD DIST. NO.	STATE	PROJ. NO.	FISCAL YEAR	SHEET NO.	TOTAL SHEETS
HAWAII	HAW.	H11-01-08	2009	ADD. 12	73

True North

REPAIR RETAINING WALL

Pyramat installation on slope

BEGIN PROJECT
H-1 @ Sta. 120+86±
Ramp 7 @ Sta. 3+50±

5+00 6+00 7+00 8+00 9+00 10+00

SCHOOL STREET

Centerline

7+00 6+00 5+00

INTERSTATE ROUTE H-1

2+00 3+00

OUTBOUND

INBOUND

Baseline

118+00 119+00 120+00 121+00 122+00

5+00 6+00 7+00 8+00 9+00 10+00

5+00 6+00 7+00 8+00 9+00 10+00

117+00

118+00 119+00 120+00 121+00 122+00

117+00

117+00

118+00 119+00 120+00 121+00 122+00

117+00

117+00

FED. ROAD DIST. NO.	STATE	PROJ. NO.	FISCAL YEAR	SHEET NO.	TOTAL SHEETS
HAWAII	HAW.	H11-01-08	2009	ADD. 13	73

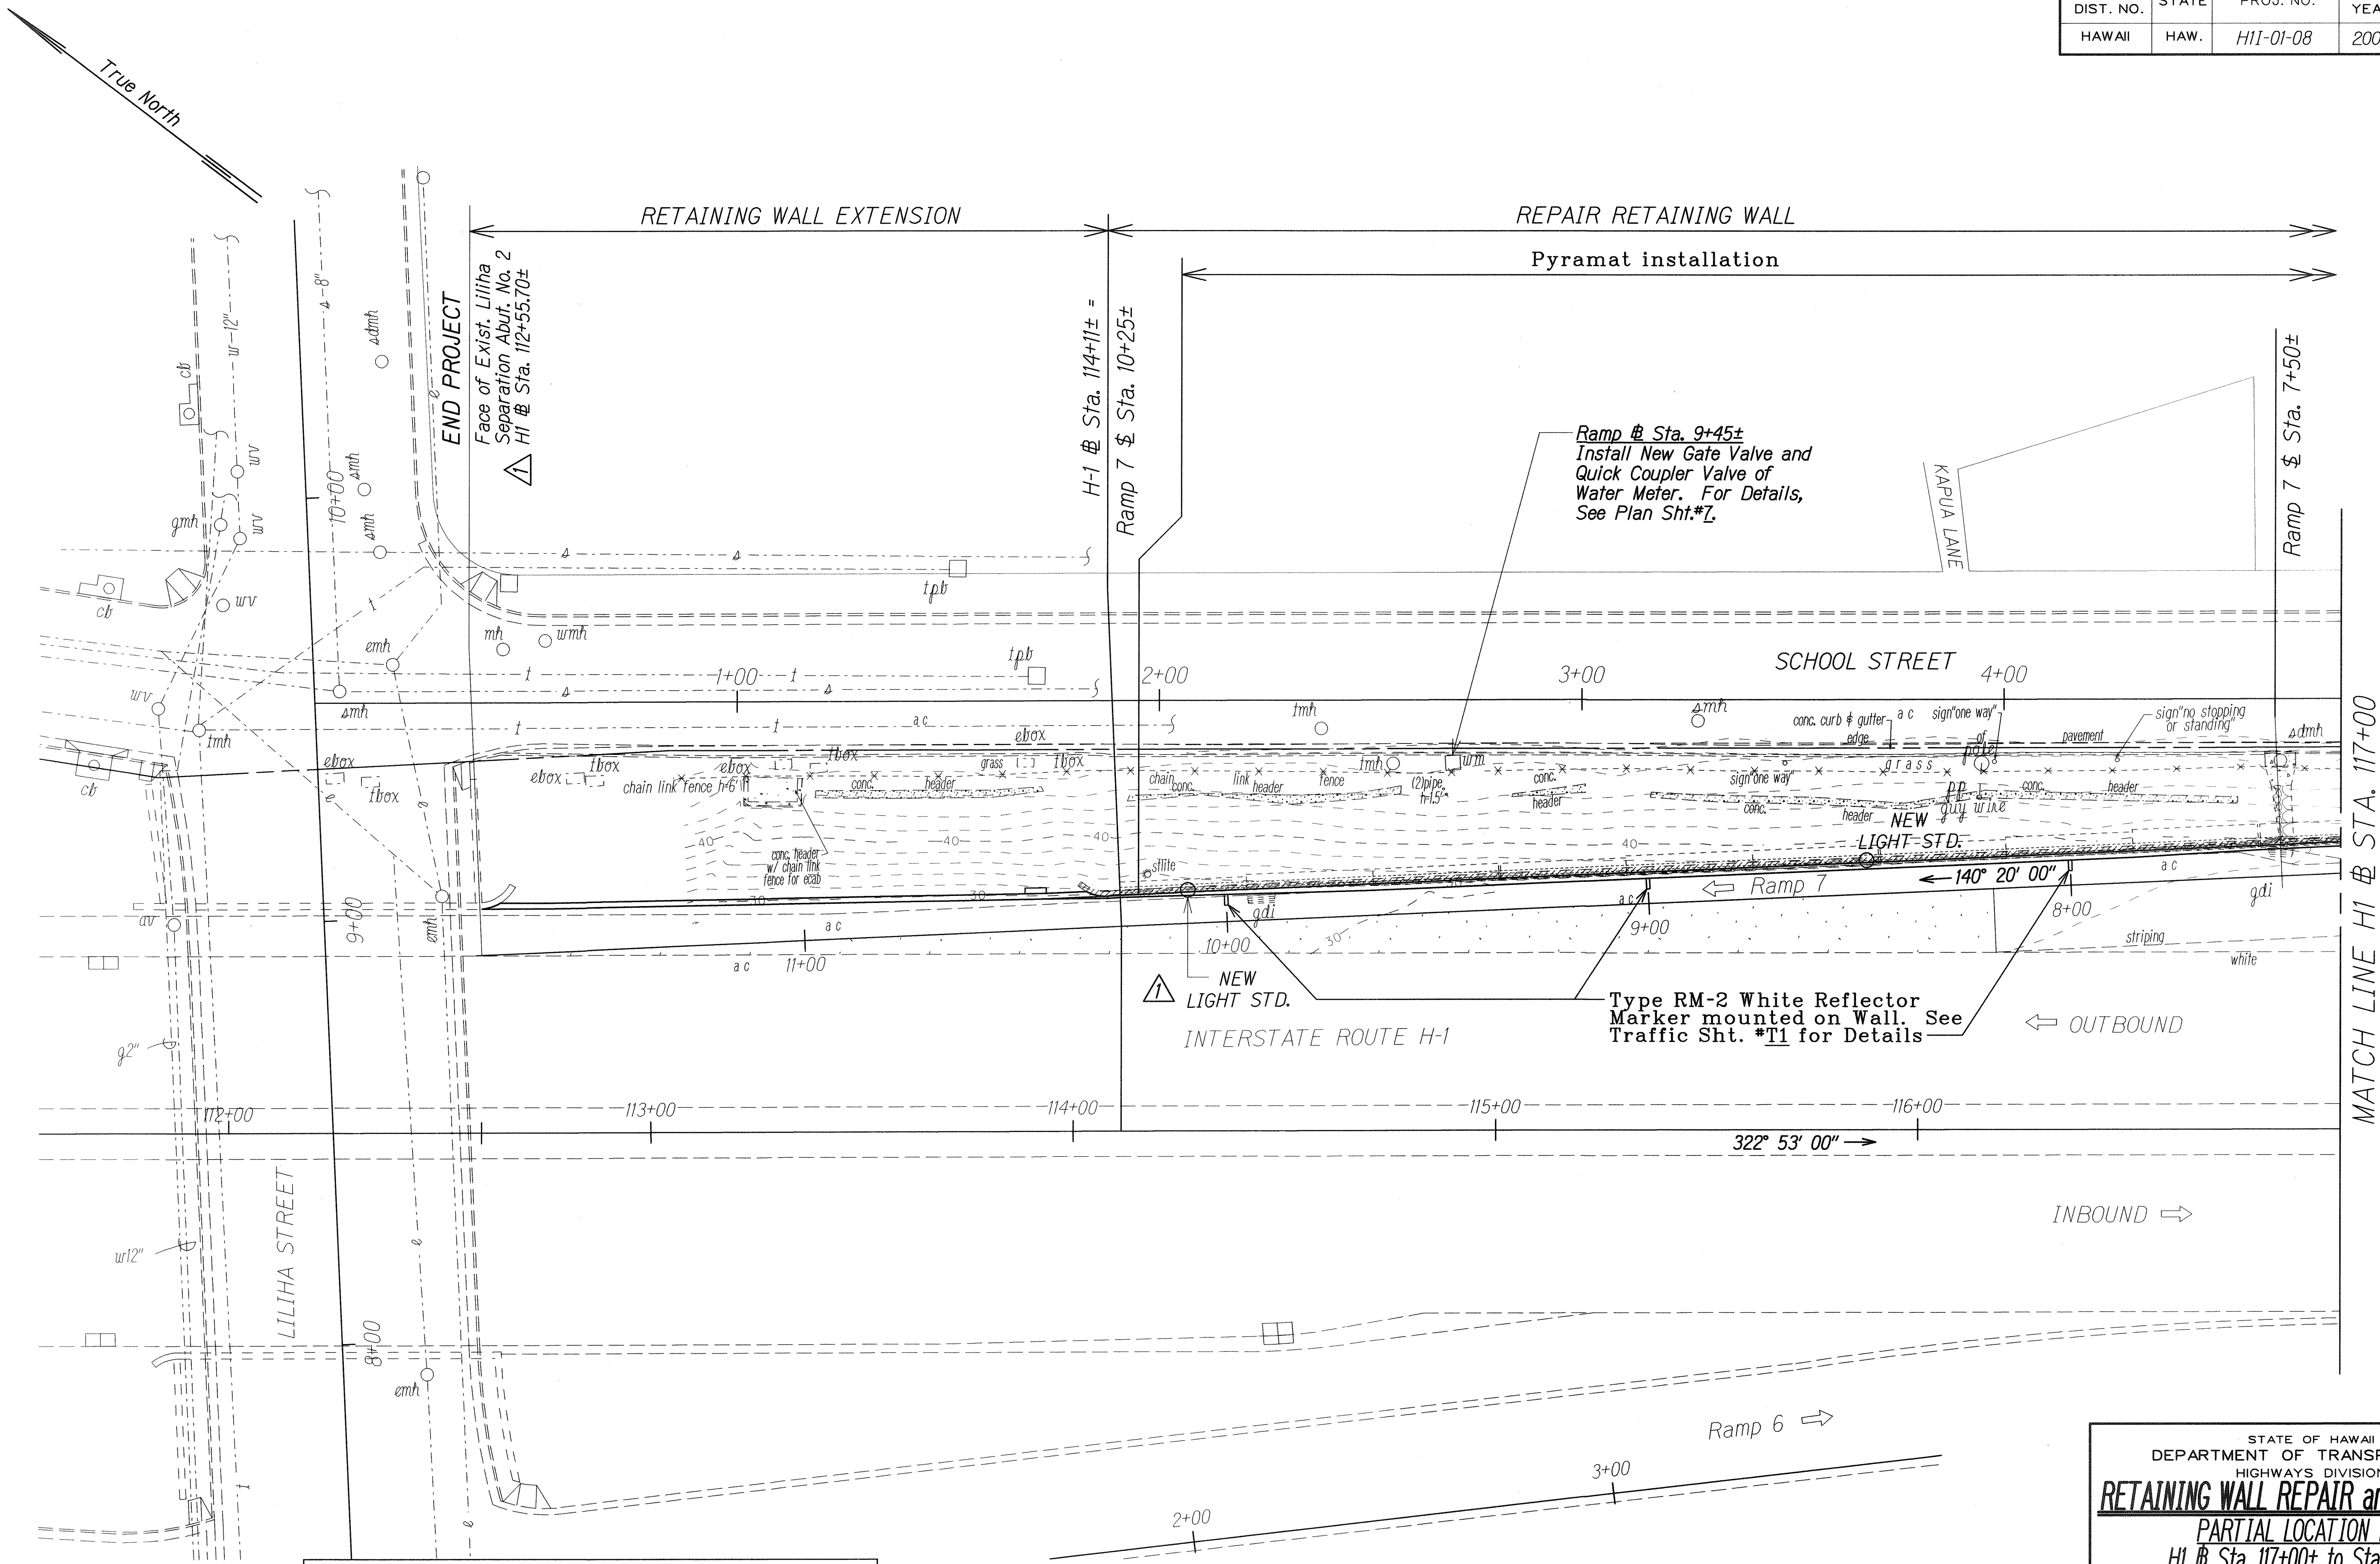

SURVEY PLOTTED BY	DATE
DRAWN BY	XXX 2009
DESIGNED BY	XXX 2009
QUANTITIES BY	XXX 2009
CHECKED BY	XXX 2009

LEGEND FOR AS-BUILT POSTINGS	
	Squiggly line for as-built deletion
	Double line for as-built deletion
Roadway	Text for as-built posting

PARTIAL LOCATION PLAN
Scale: 1"=20'-0"

	Revised End Project Station Number, Added New Light Standard and Callout
3/31/09	
DATE	REVISION

STATE OF HAWAII
DEPARTMENT OF TRANSPORTATION
HIGHWAYS DIVISION

RETAINING WALL REPAIR and EXTENSION
PARTIAL LOCATION PLAN
H1 @ Sta. 117+00± to Sta. 113+40±
INTERSTATE ROUTE H-1
EXTENSION AND REPAIR OF
SCHOOL STREET ON-RAMP RETAINING WALL
Project No. H11-01-08


Scale: As Noted Date: Feb. 2009

SHEET No. Q5 OF 34 SHEETS


"AS-BUILT"

ADD. 13


FED. ROAD DIST. NO.	STATE	PROJ. NO.	FISCAL YEAR	SHEET NO.	TOTAL SHEETS
HAWAII	HAW.	H11-01-08	2009	ADD. 15	73

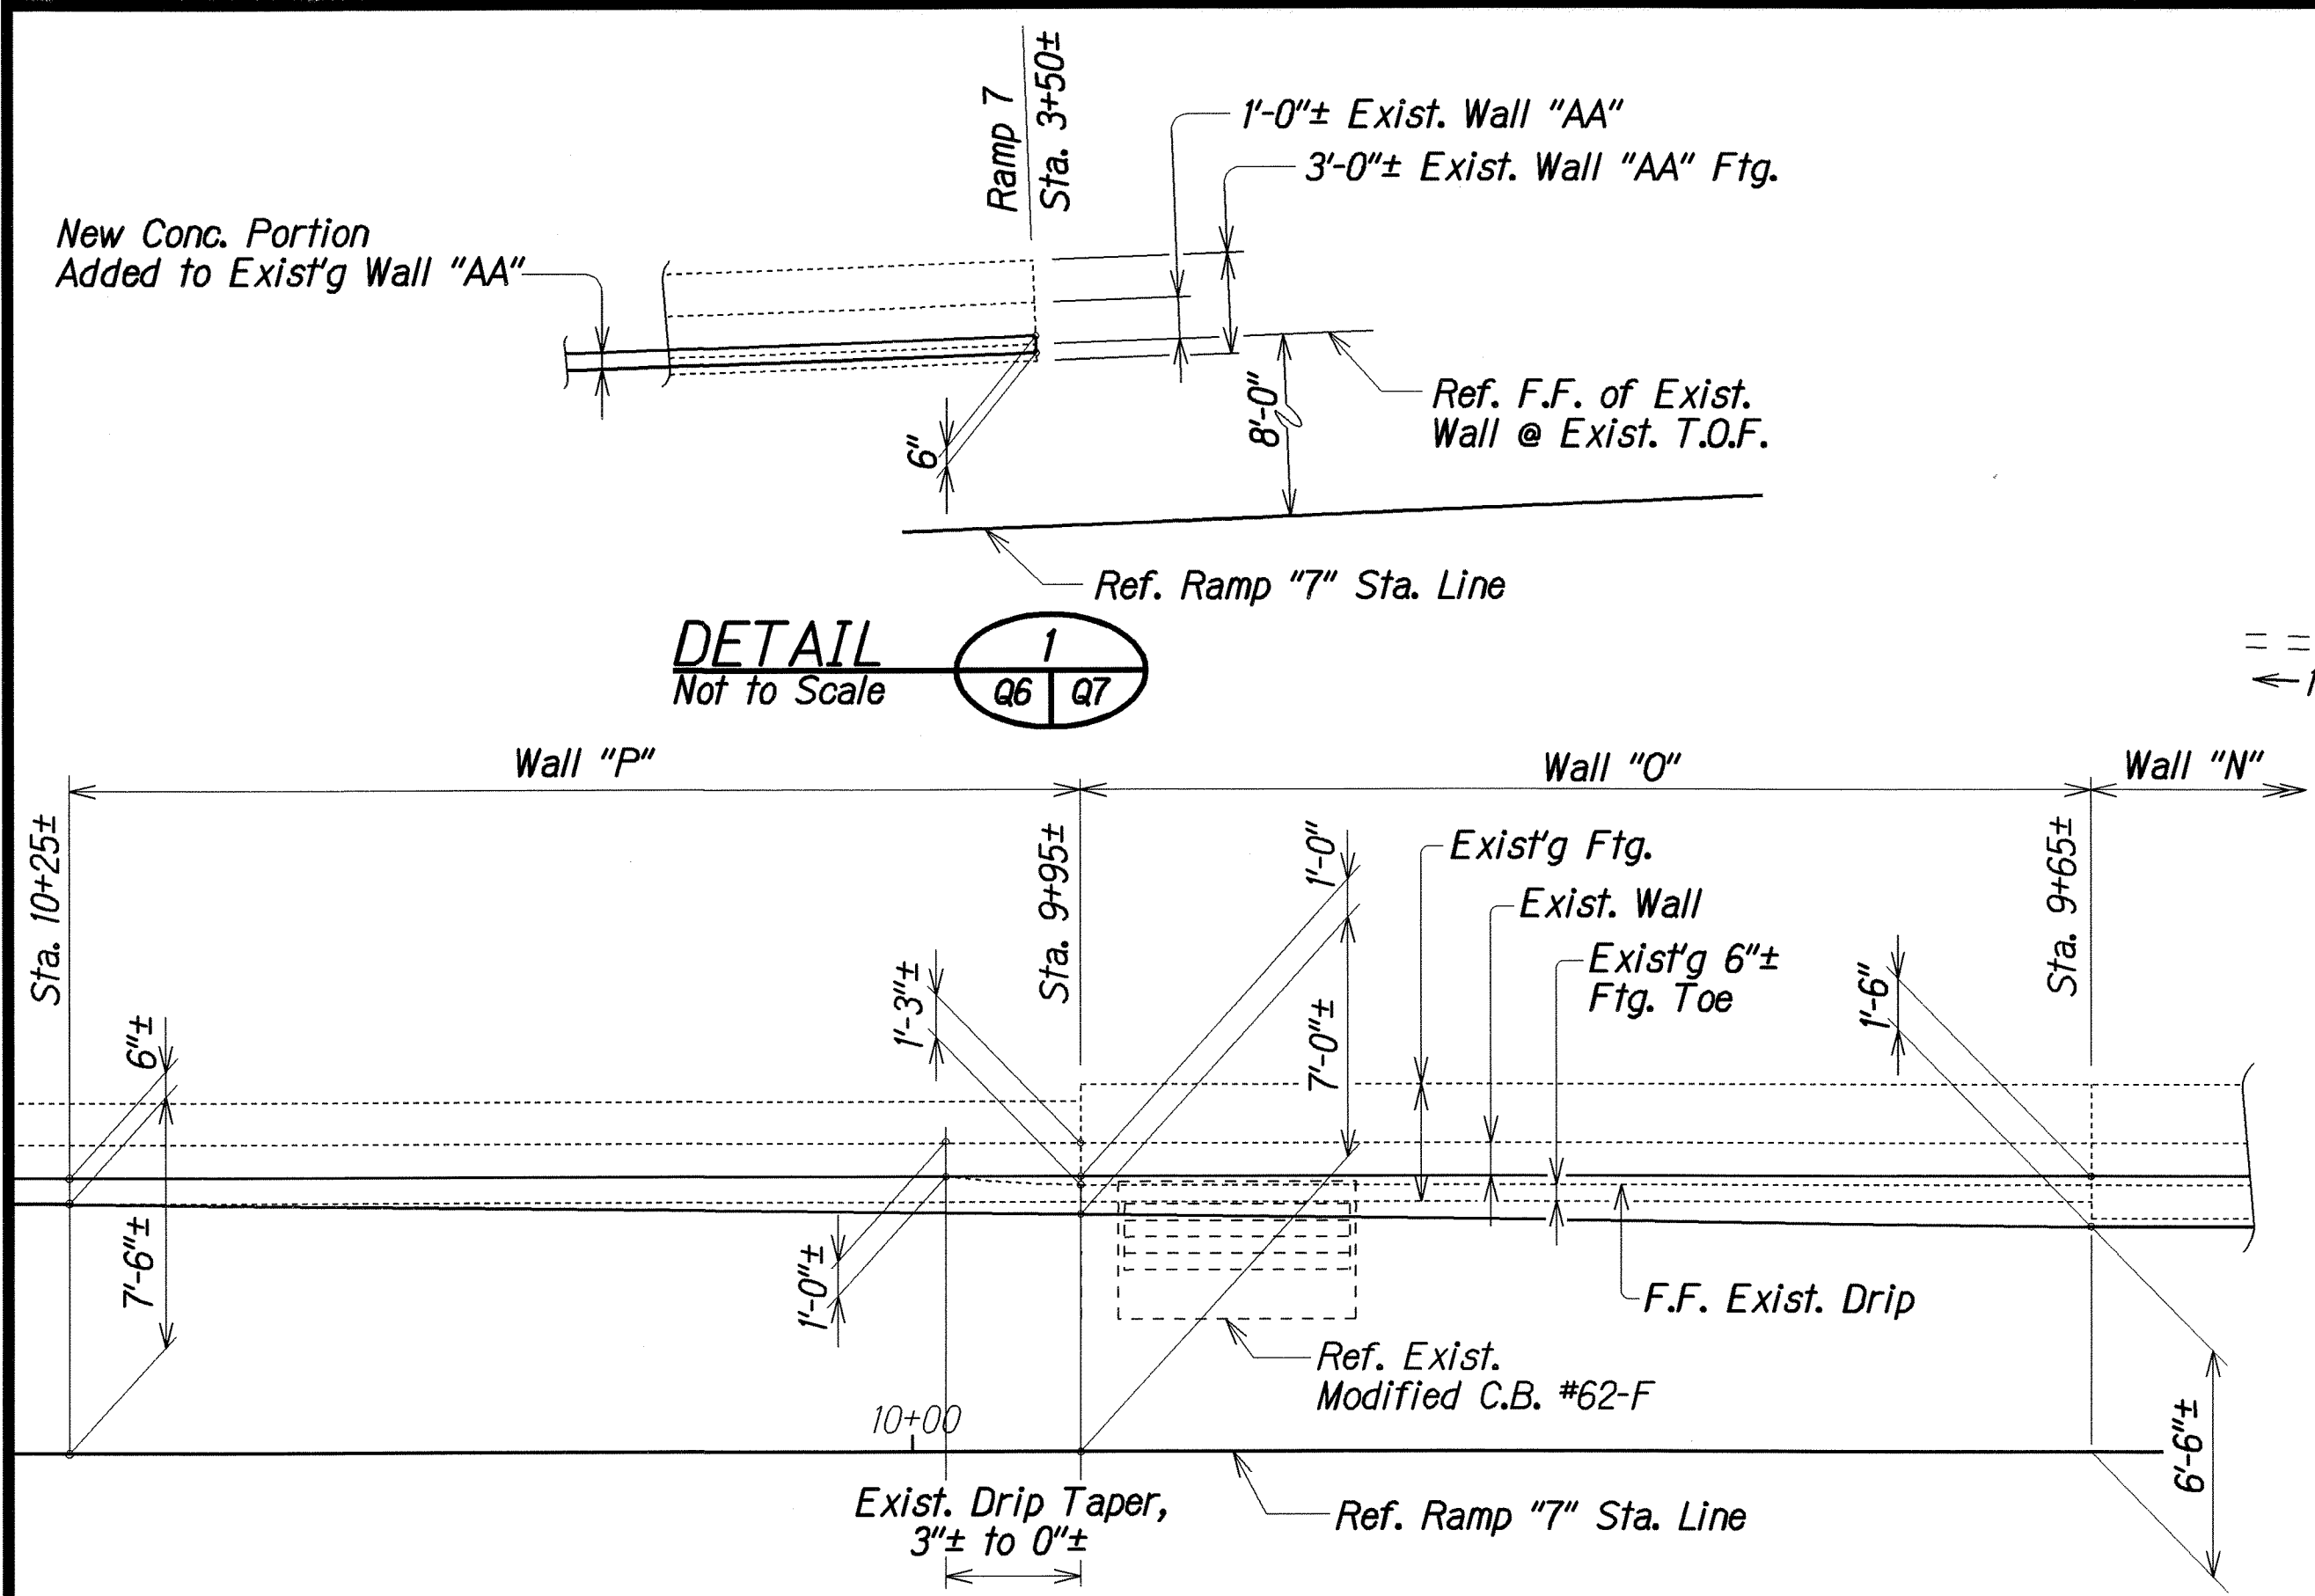


DETAIL 1
Not to Scale
Q6 Q7

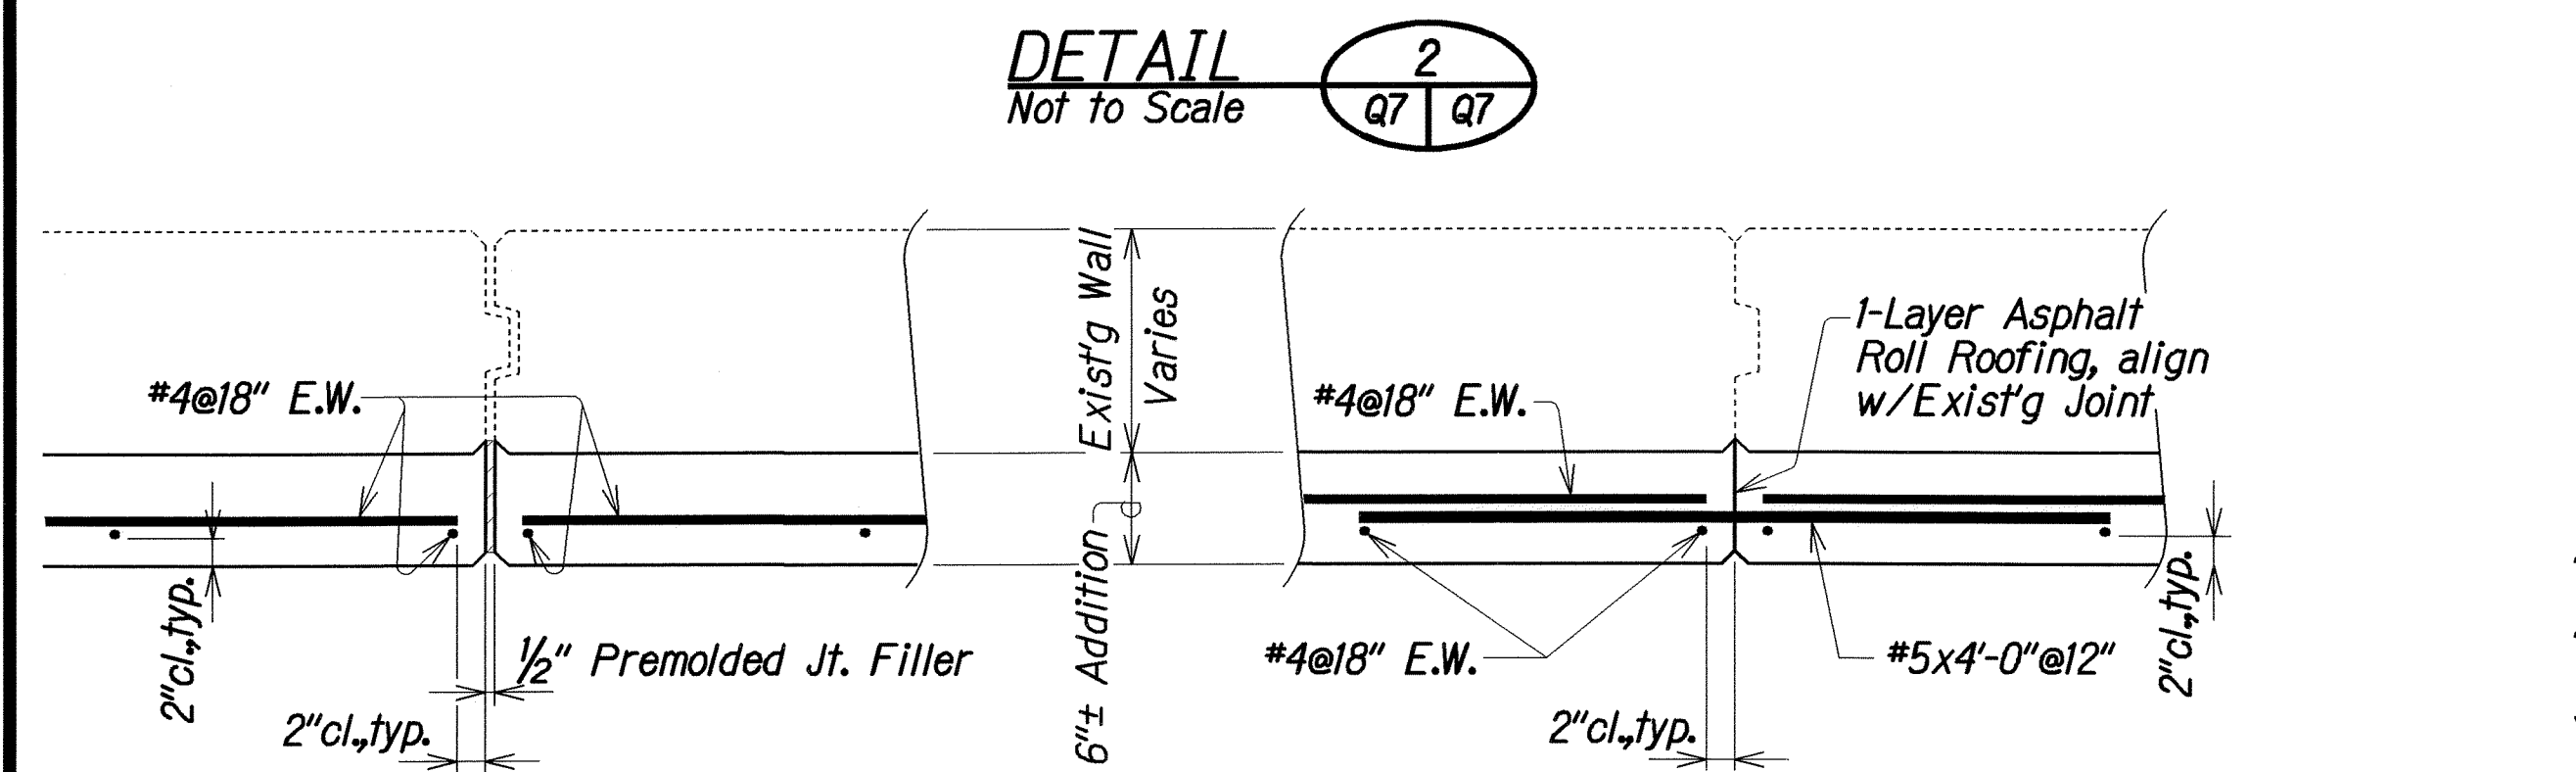

AT EXPANSION JOINT
AT CONTRACTION JOINT
JOINT DETAILS FOR WALL "AA" TO WALL "FF"
Not to Scale

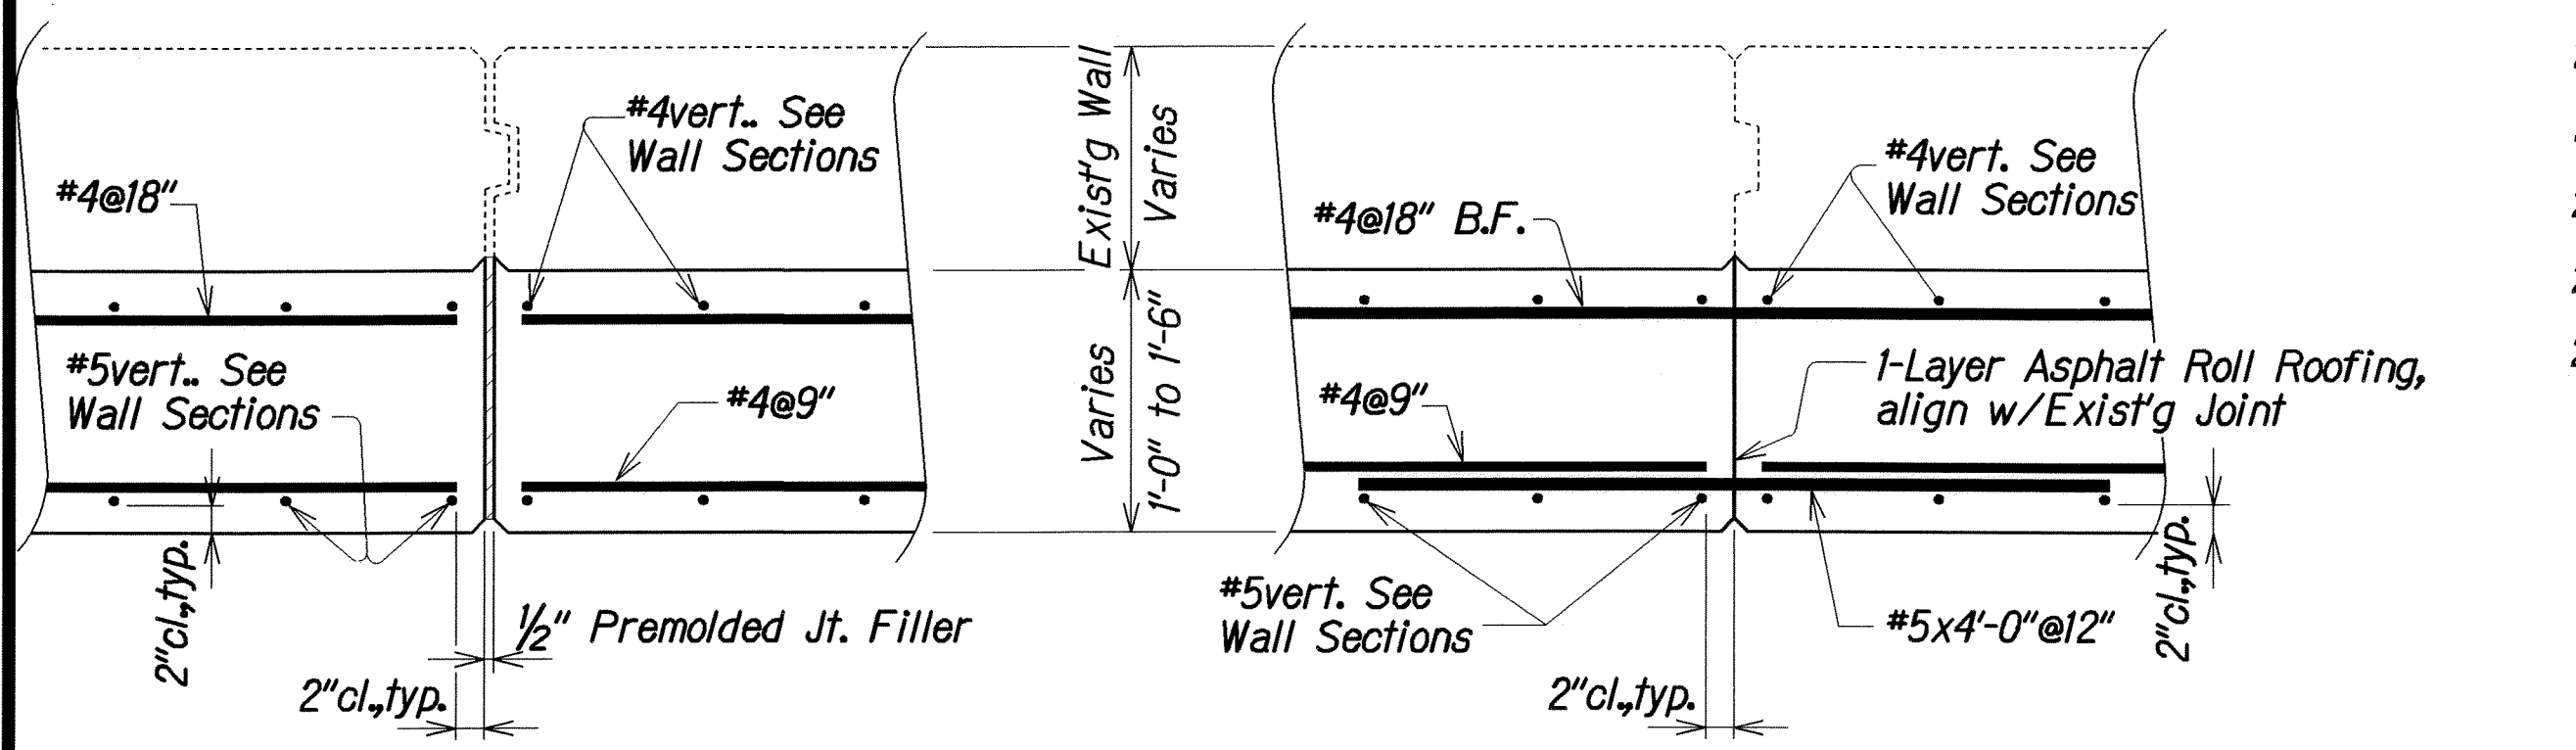


AT EXPANSION JOINT
AT CONTRACTION JOINT
JOINT DETAILS FOR WALL "A" TO WALL "P"
Not to Scale

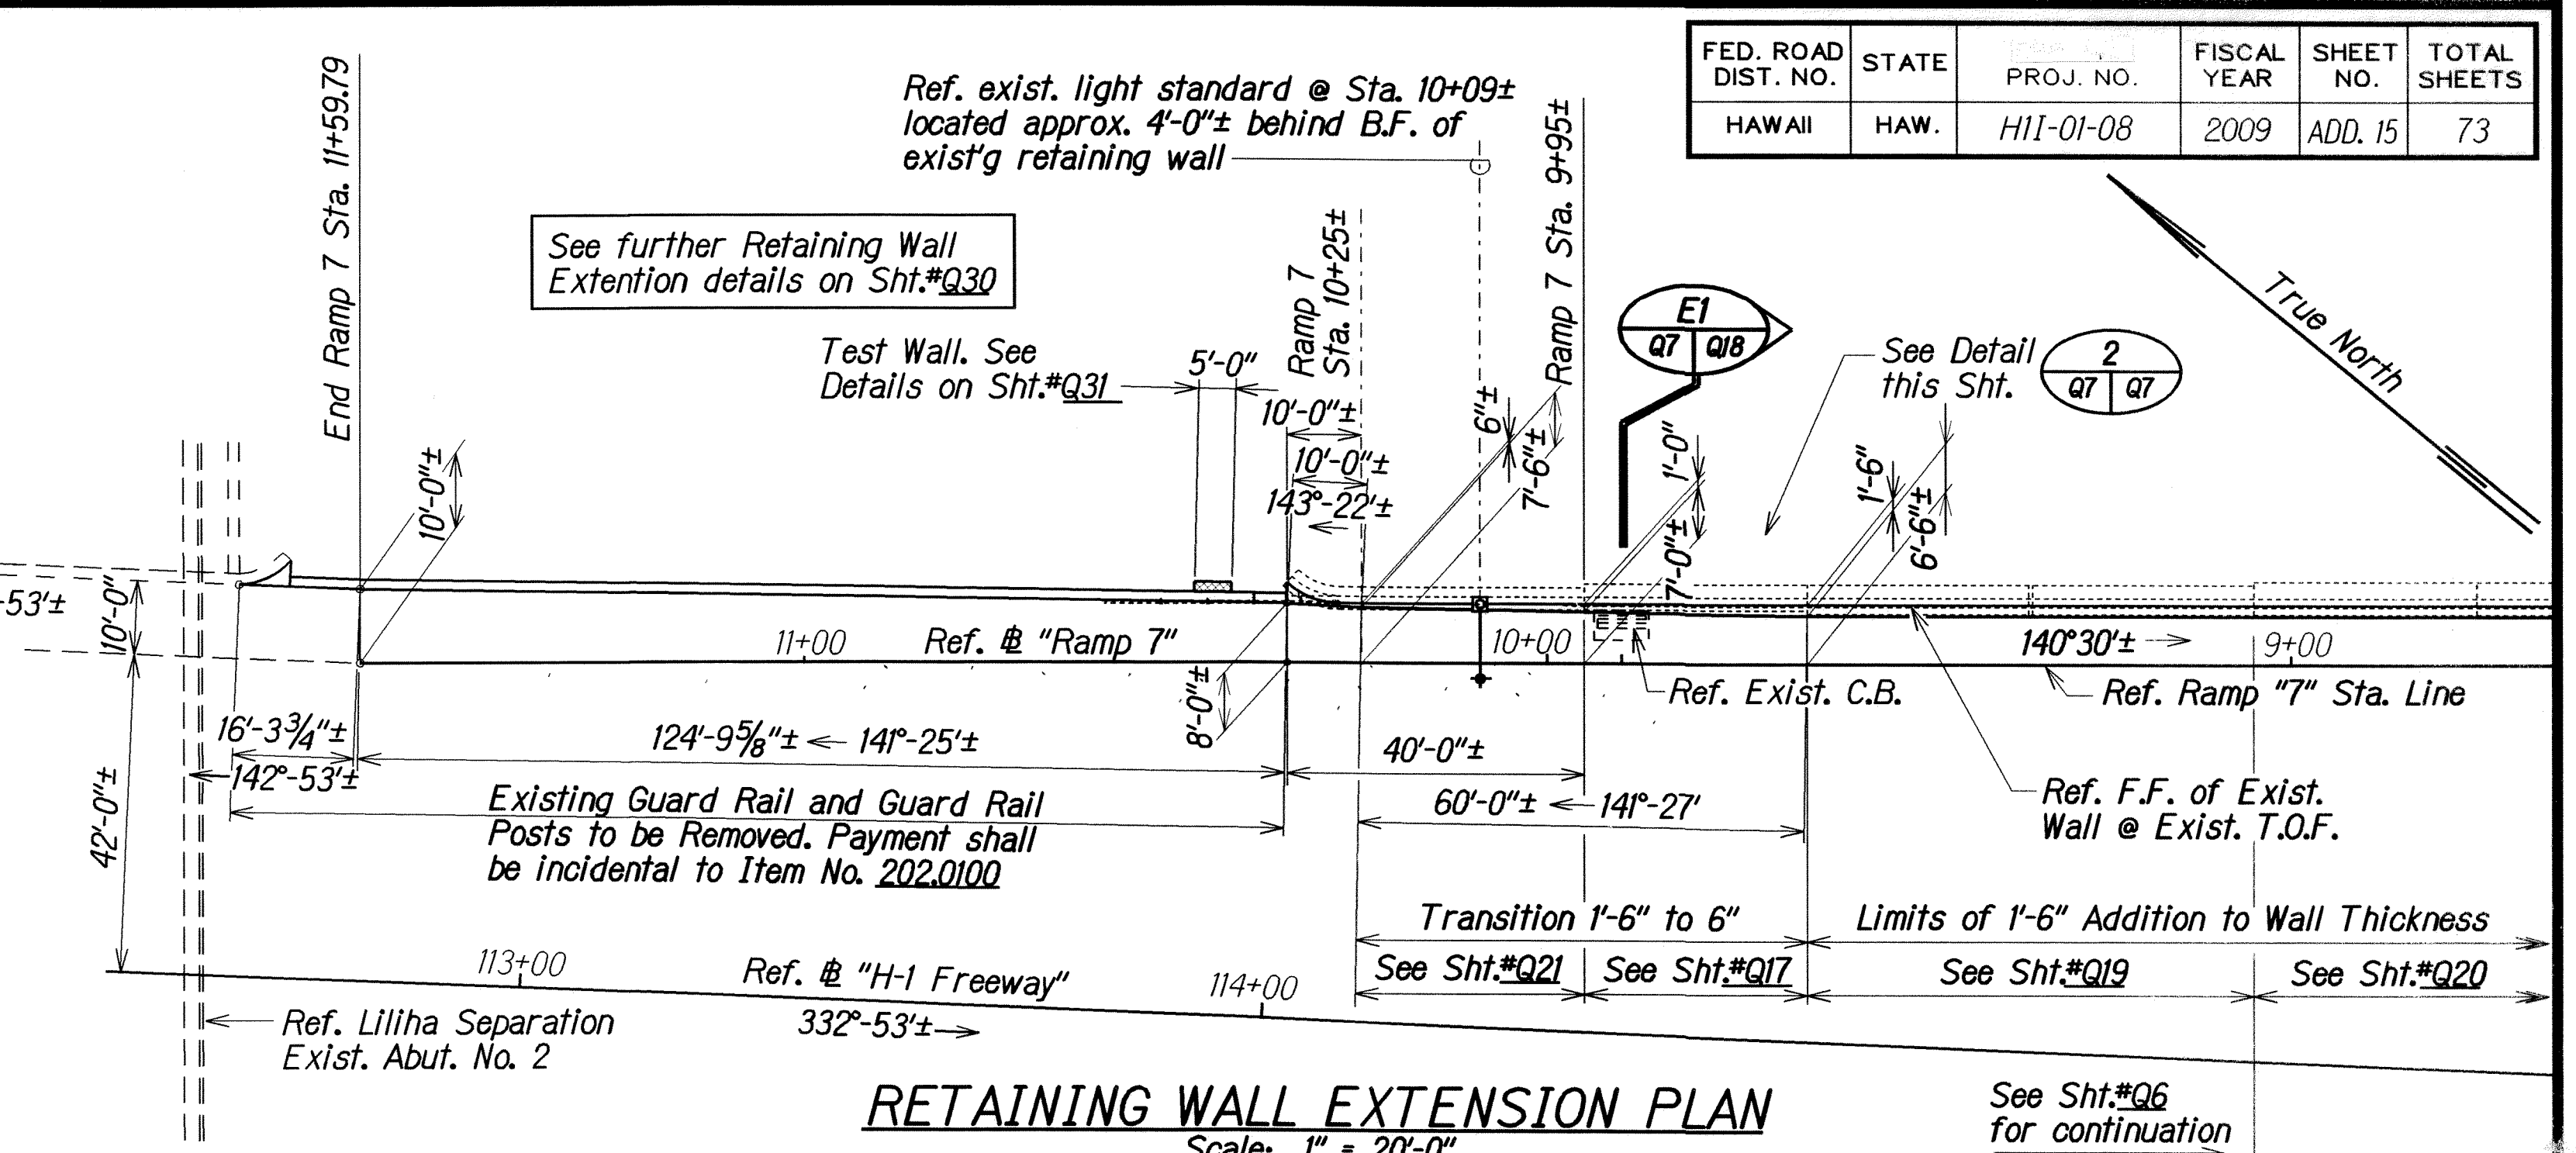

RETAINING WALL EXTENSION PLAN
Scale: 1" = 20'-0"

Note: Expansion and Contraction Joint locations on the existing walls shall be maintained in the repair of the walls. See this sheet for details. See Standard Plan B-01 for Joint details for Retaining Wall Extension.

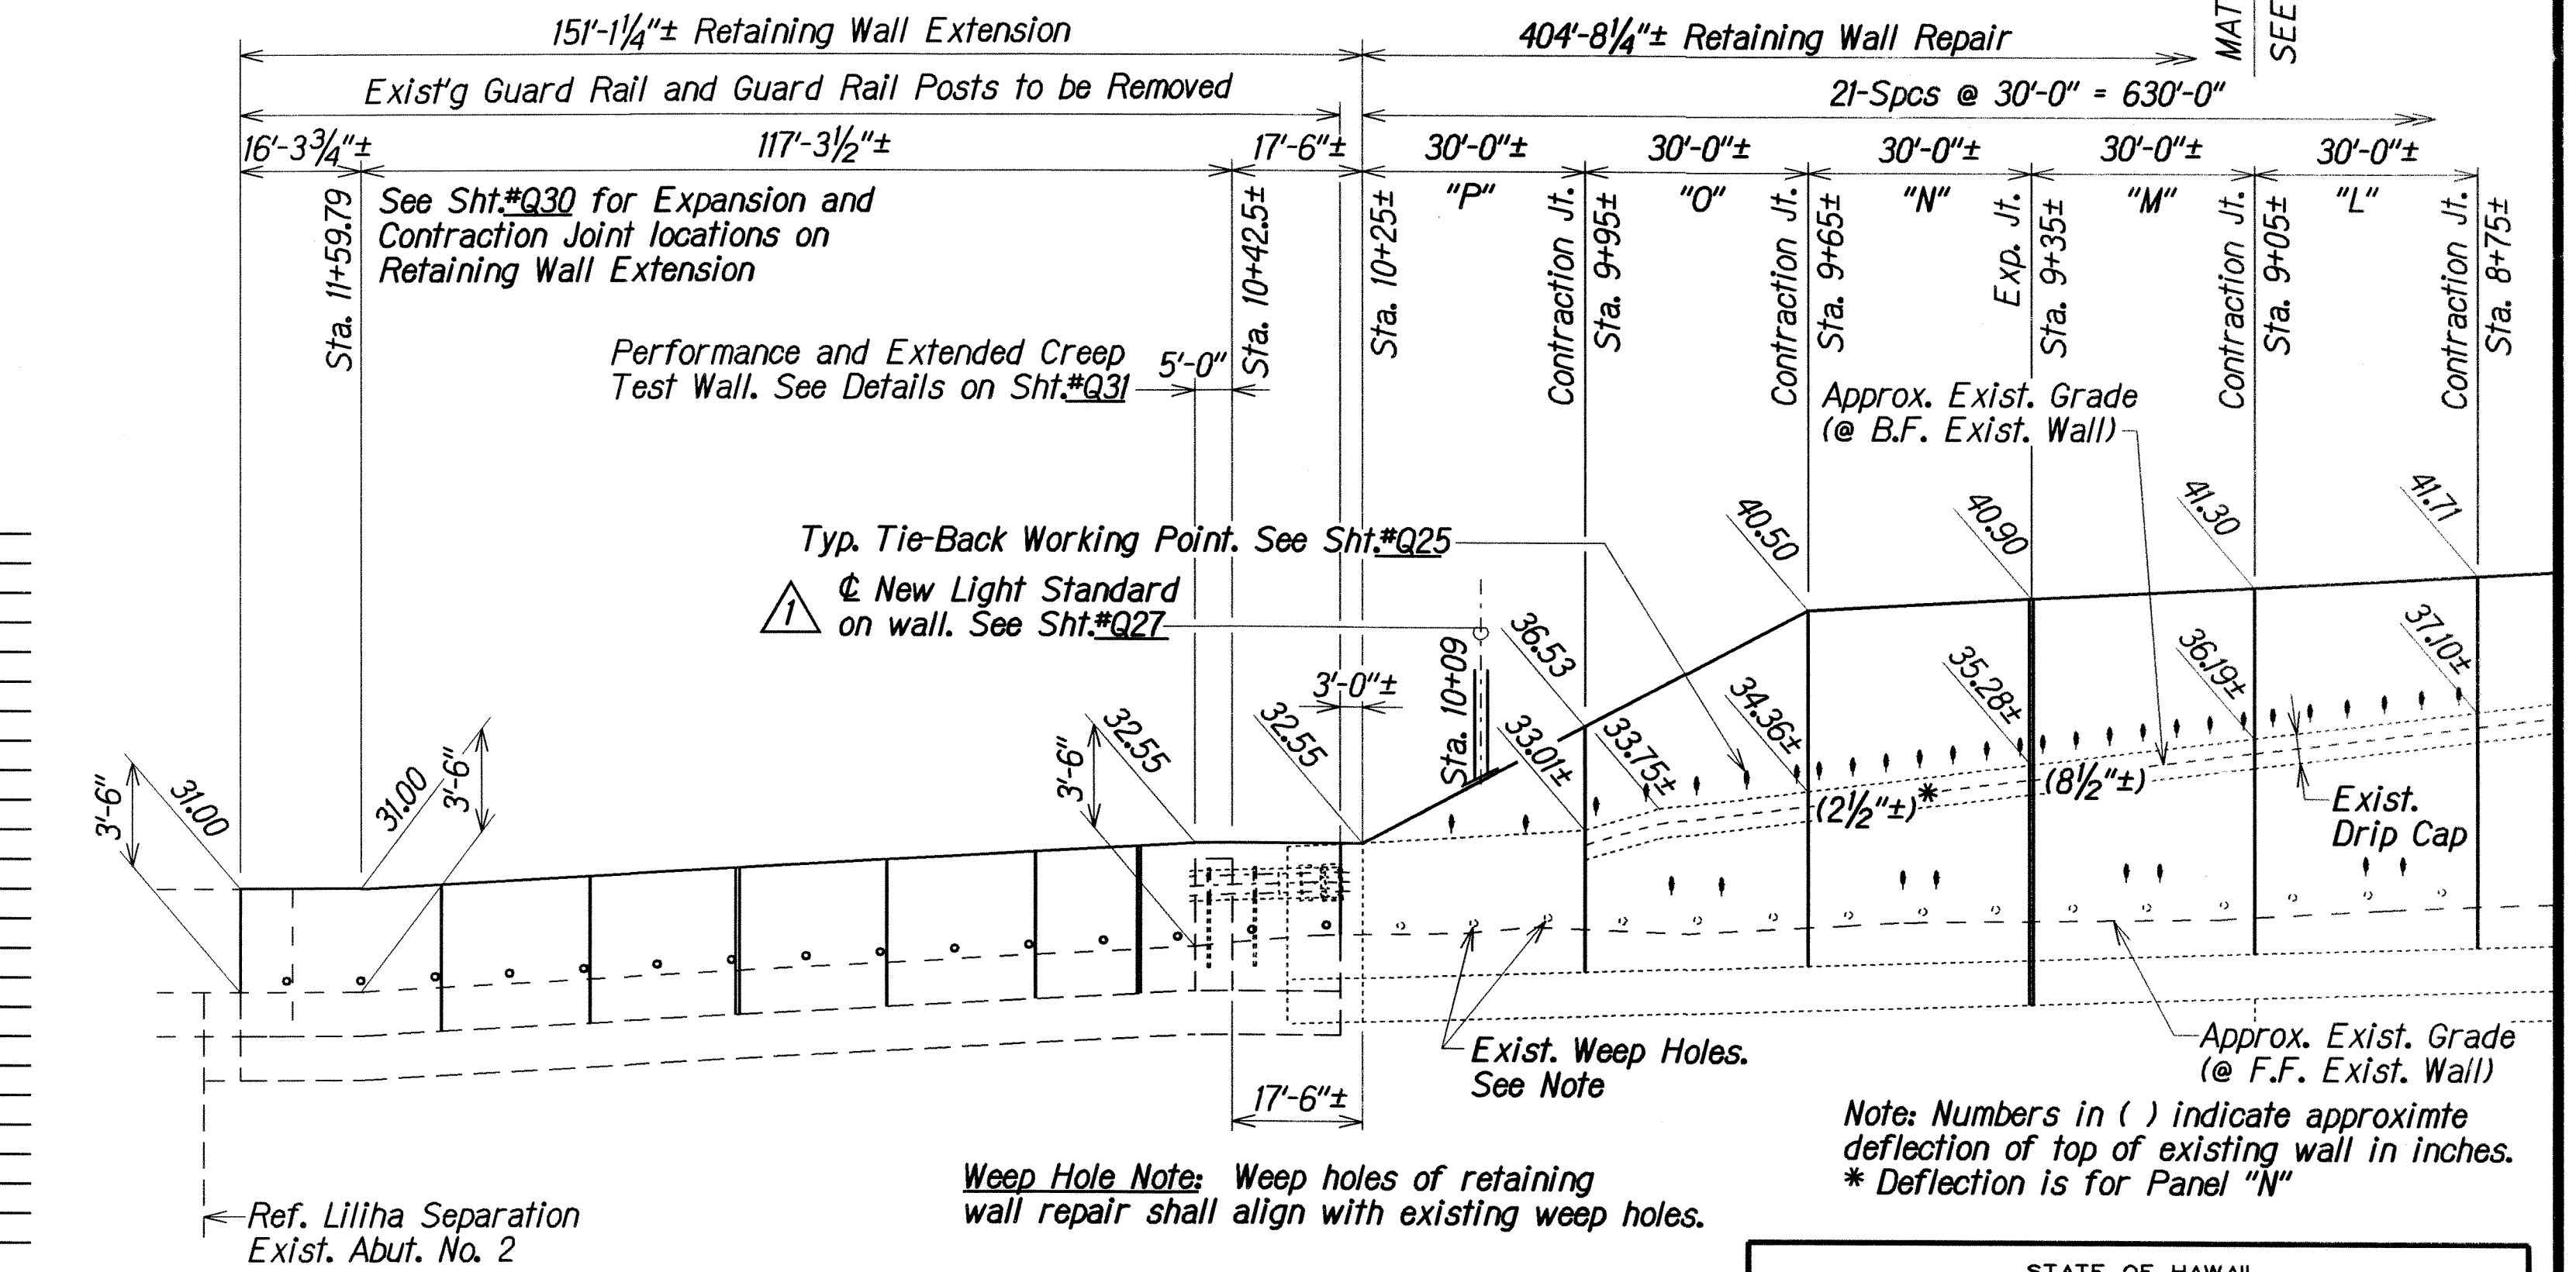

RETAINING WALL EXTENSION ELEVATION
Scale: Horizontal 1" = 20'-0" Vertical 1" = 5'-0"


- LEGEND**
- Indicates Permanent Tie-back Anchor
 - Indicates Existing Weep Hole
 - Indicates New Weep Hole

Added Legend for Permanent Tie-Back Anchor & Exist. Weep Hole and Revised New Light Standard Callout


STATE OF HAWAII
DEPARTMENT OF TRANSPORTATION
HIGHWAYS DIVISION
RETAINING WALL REPAIR and EXTENSION
PARTIAL PLAN, ELEVATION and DETAILS
INTERSTATE ROUTE H-1 EXTENSION and REPAIR
of SCHOOL STREET ON-RAMP RETAINING WALL
Project No. H11-01-08

Scale: As Noted Date: Feb. 2009
SHEET No. Q7 OF 34 SHEETS


FED. ROAD DIST. NO.	STATE	PROJ. NO.	FISCAL YEAR	SHEET NO.	TOTAL SHEETS
HAWAII	HAW.	H11-01-08	2009	16	73

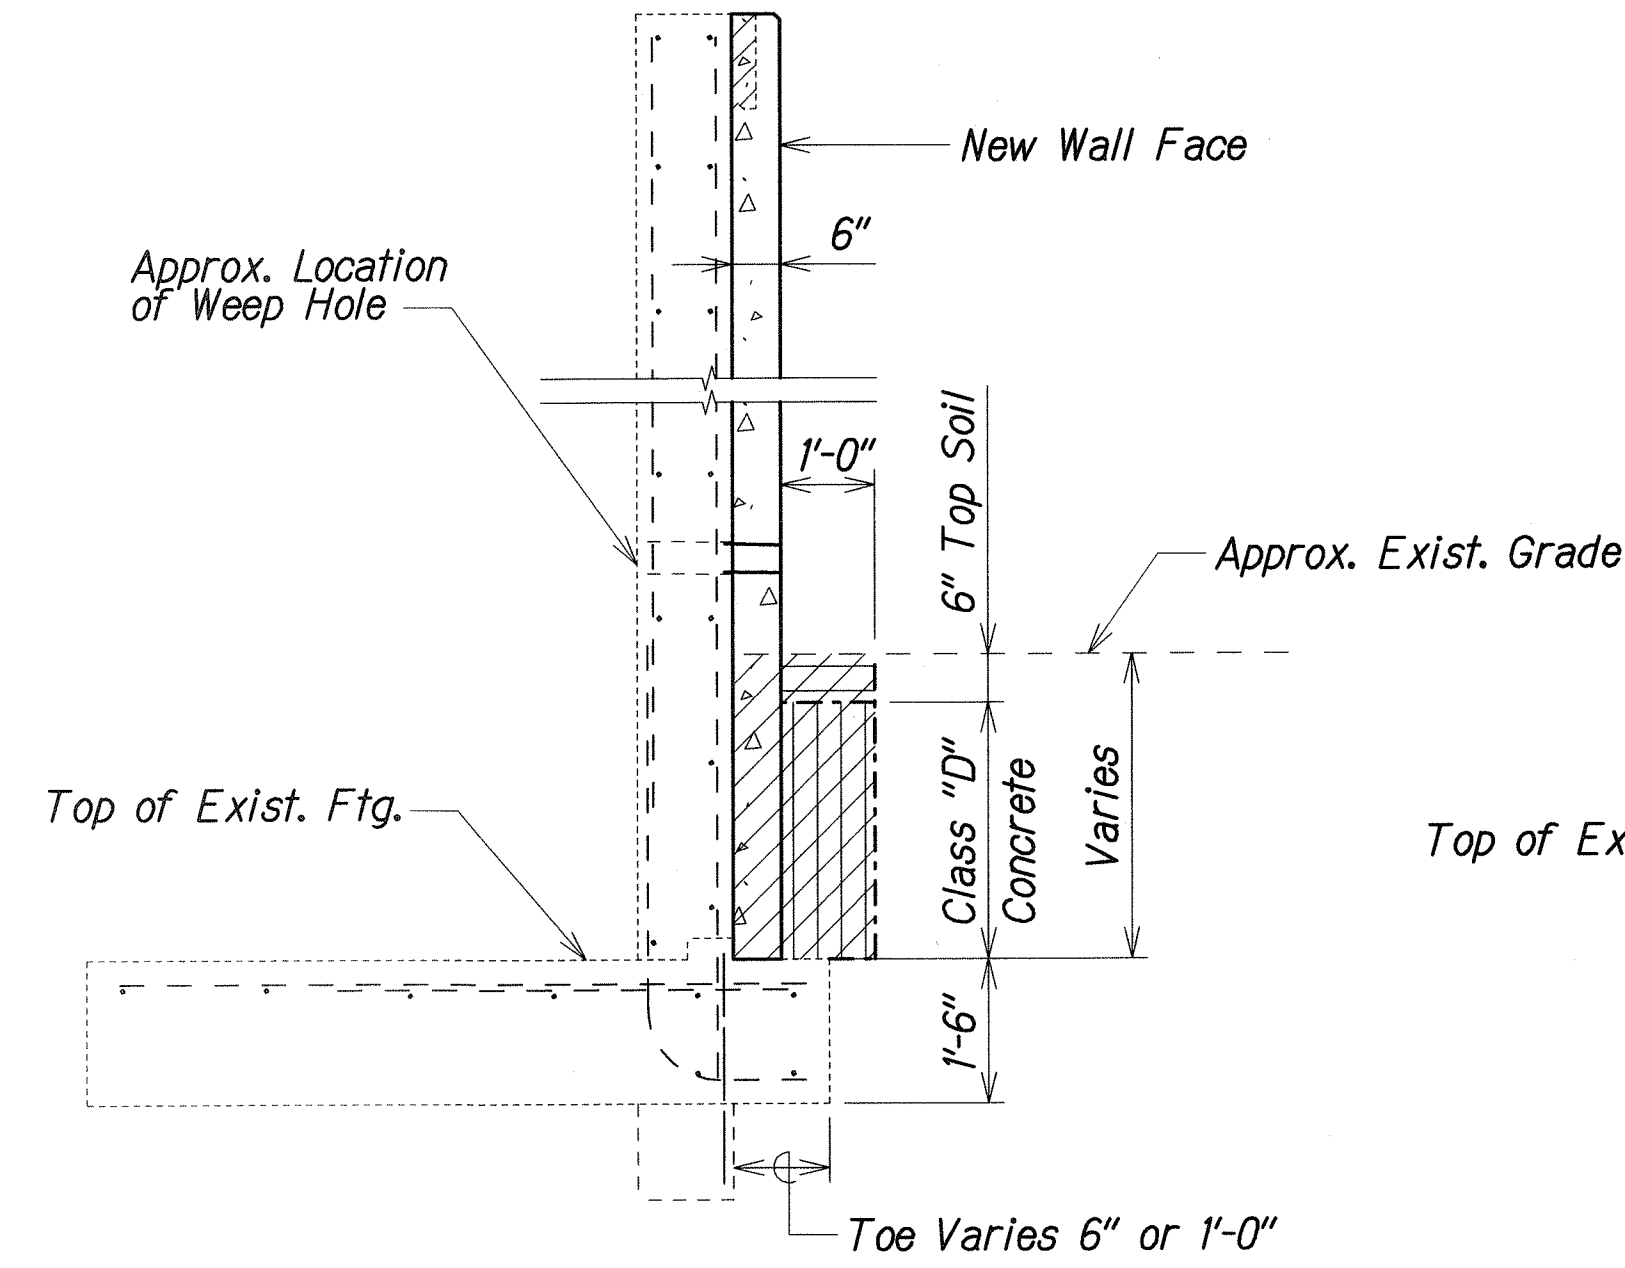

WALLS AA to EE
Scale: 1/2"=1'-0"

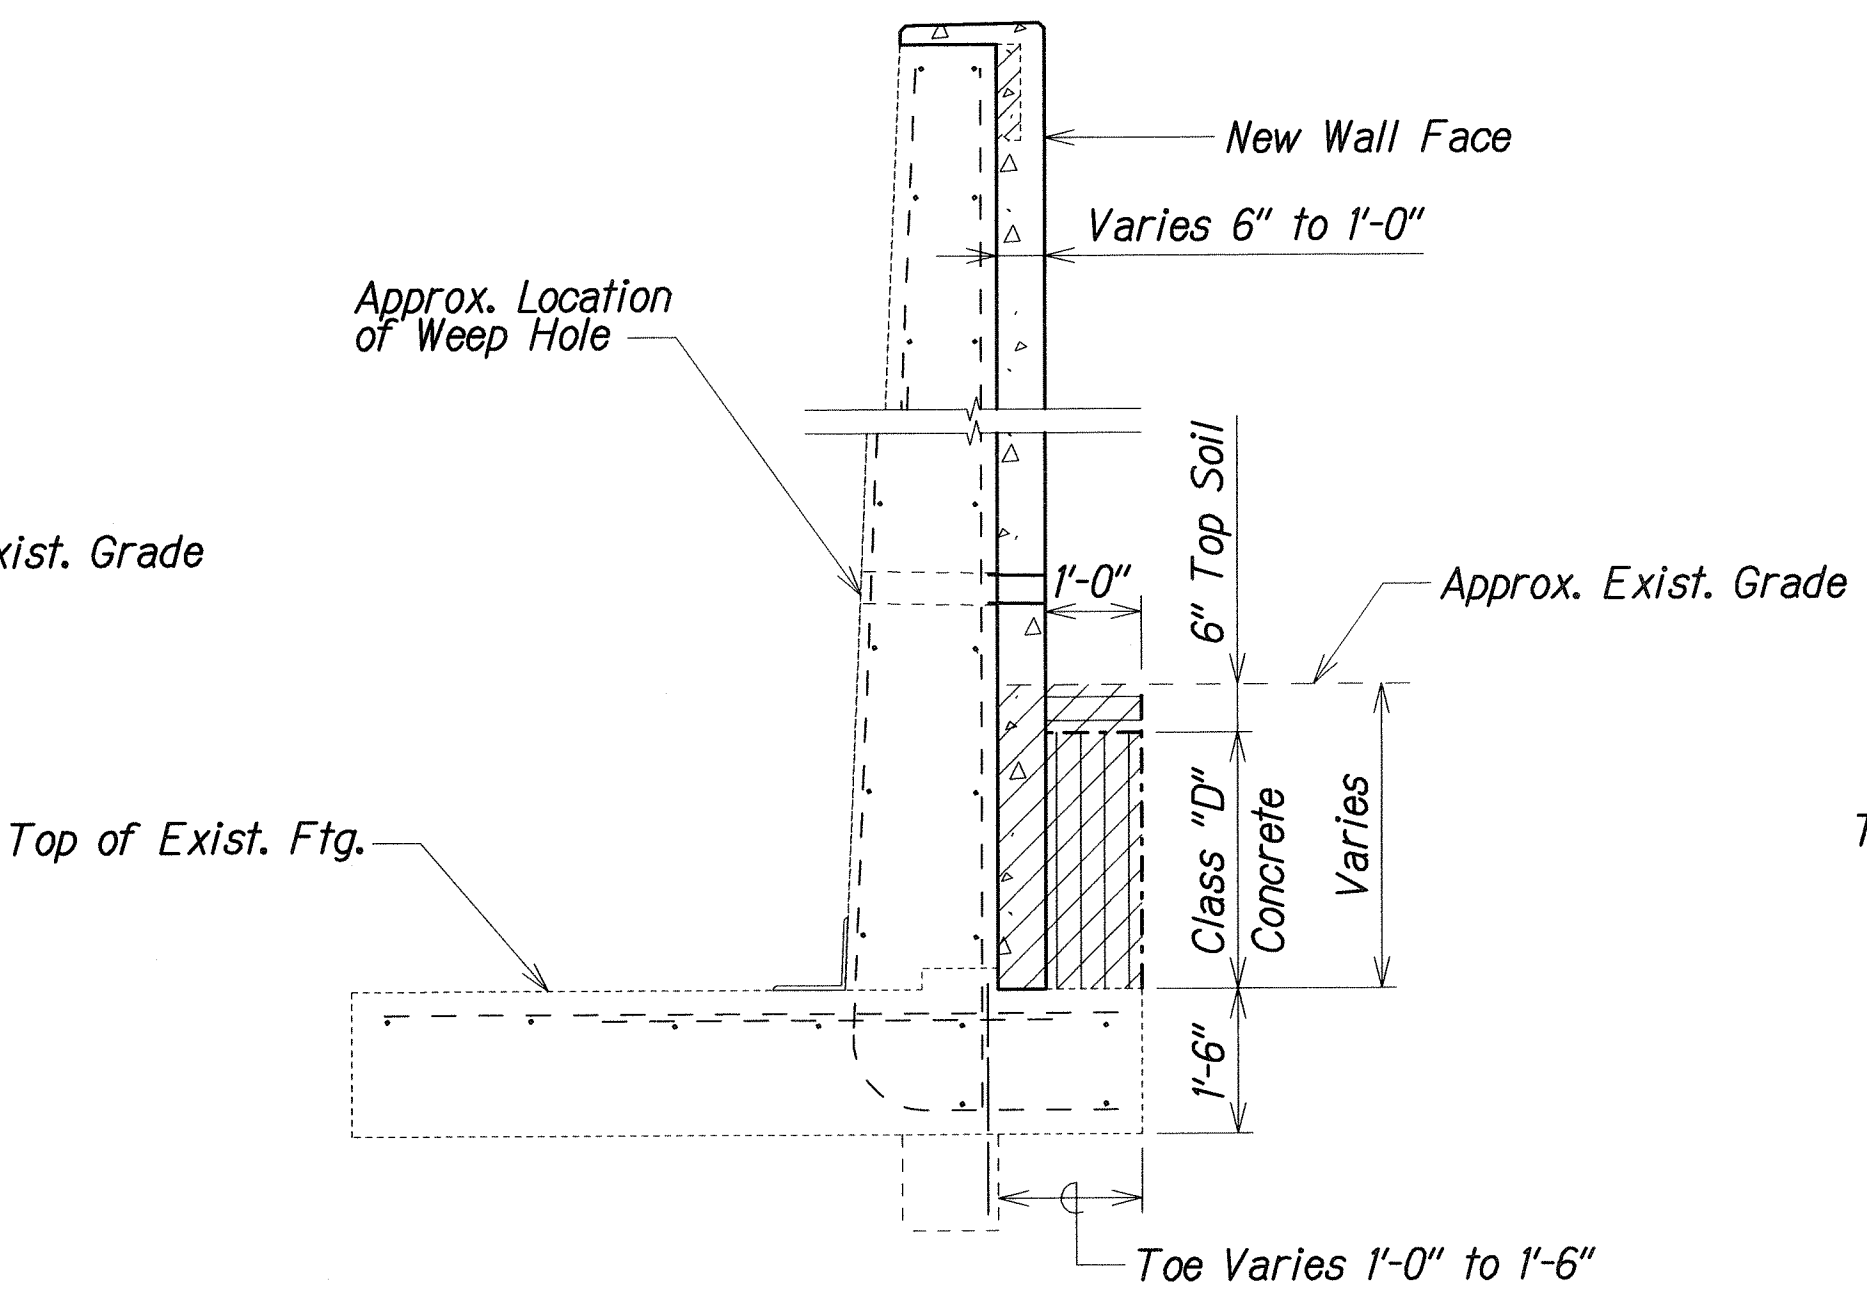


WALLS FF & GG
Scale: 1/2"=1'-0"

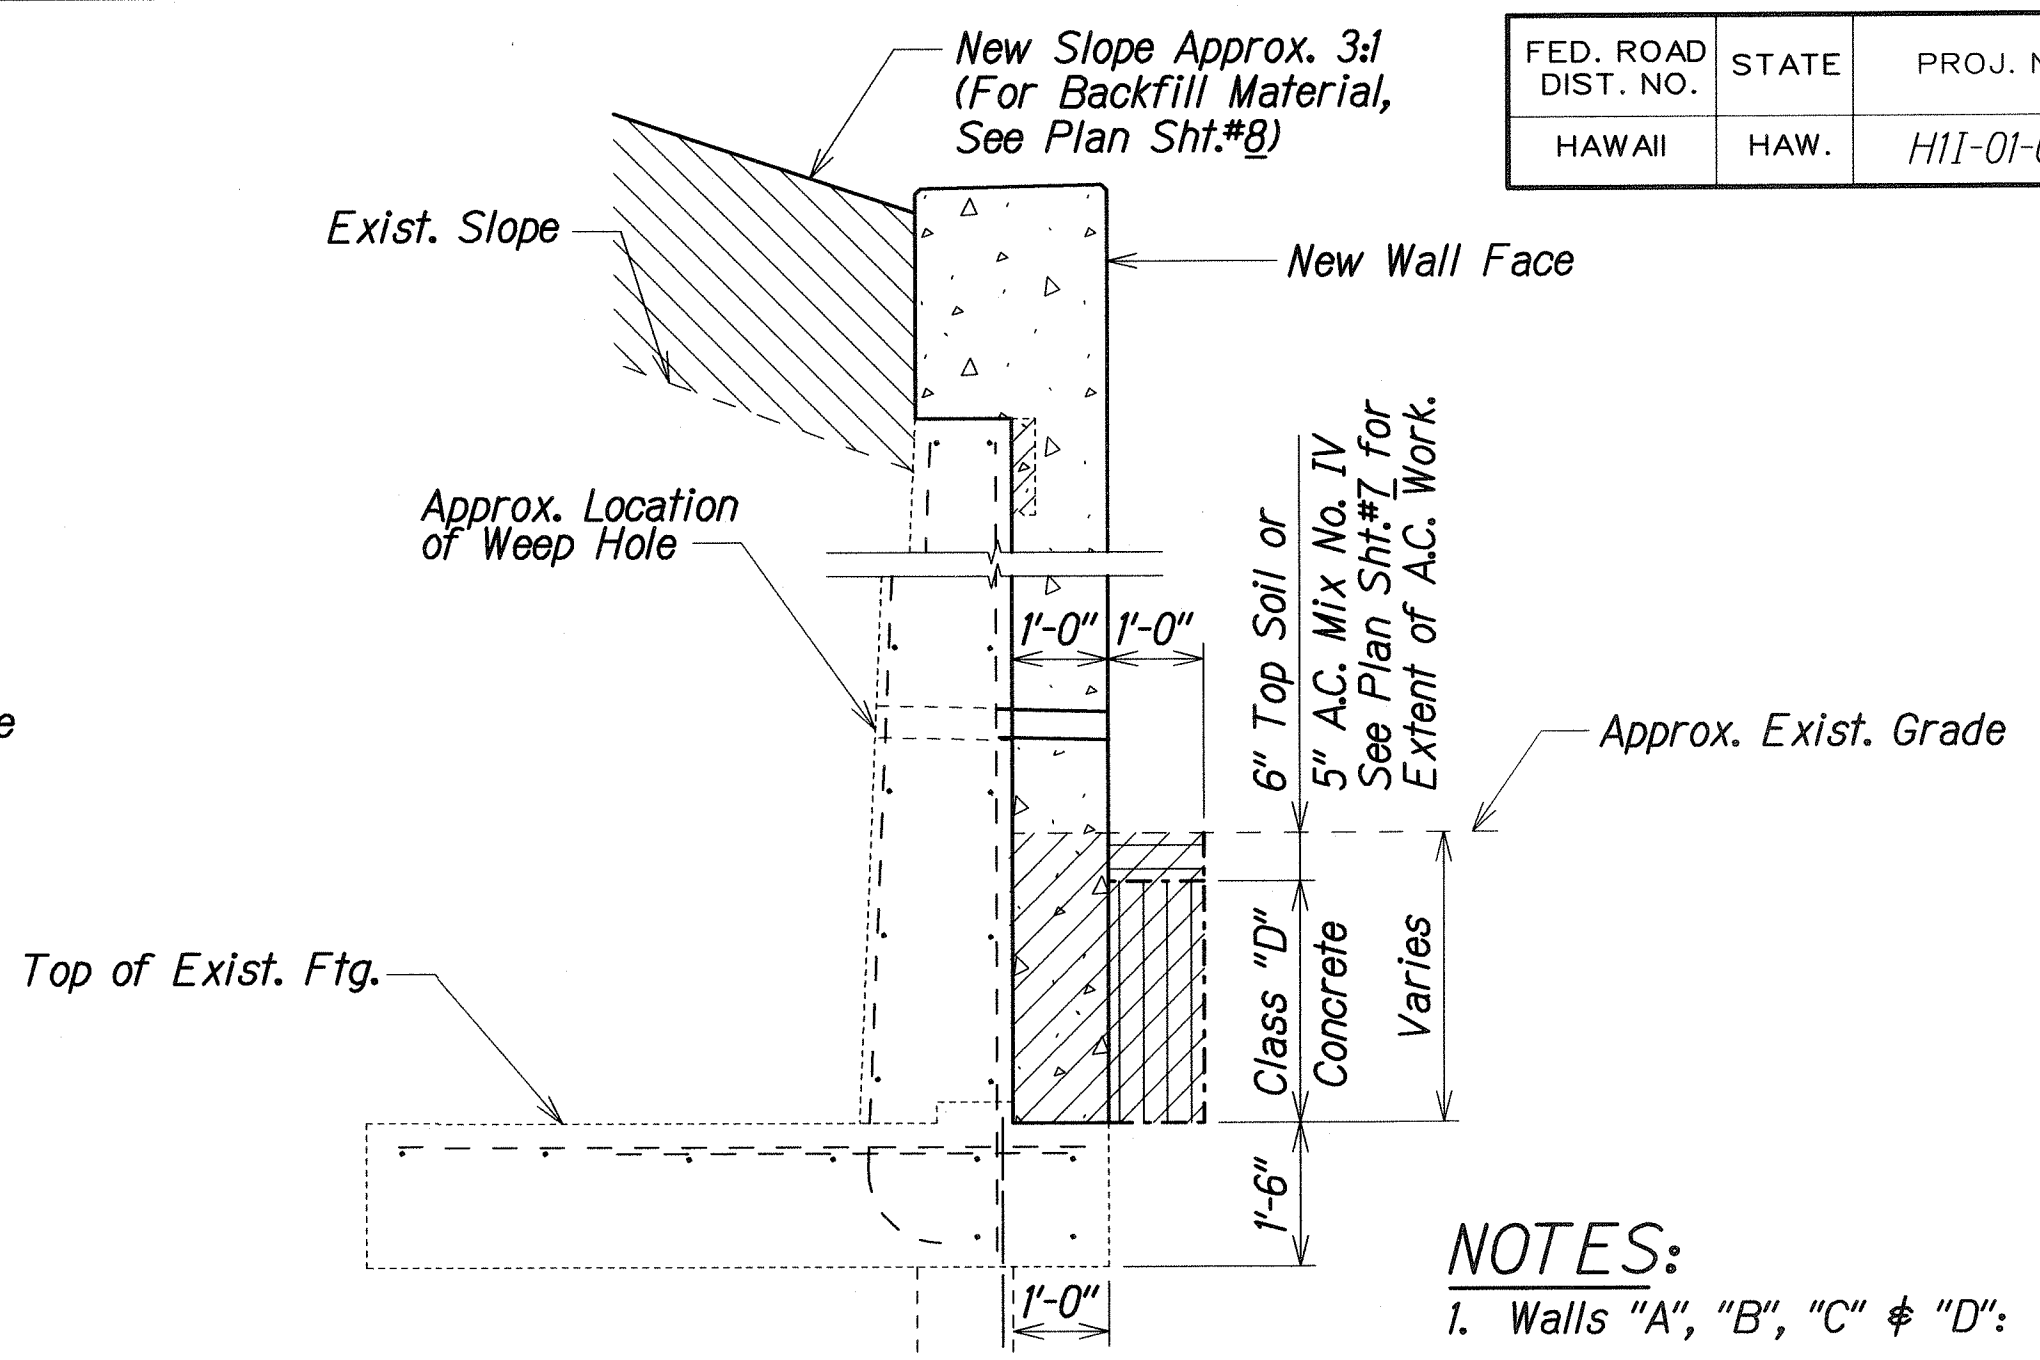


WALLS A to G
Scale: 1/2"=1'-0"


- NOTES:**
1. Walls "A", "B", "C" & "D": 6" Top Soil.
 2. Wall "E": Transition Top Soil (Sta. 6+65) to 6" Top Soil (Sta. 6+85), Balance A.C.
 3. Walls "F" & "G": A.C.
 4. Backfill Slope for Wall "P", Backfill Slope shall vary from Approximately 3:1 to Existing Slope (Approximately 1 1/2:1)

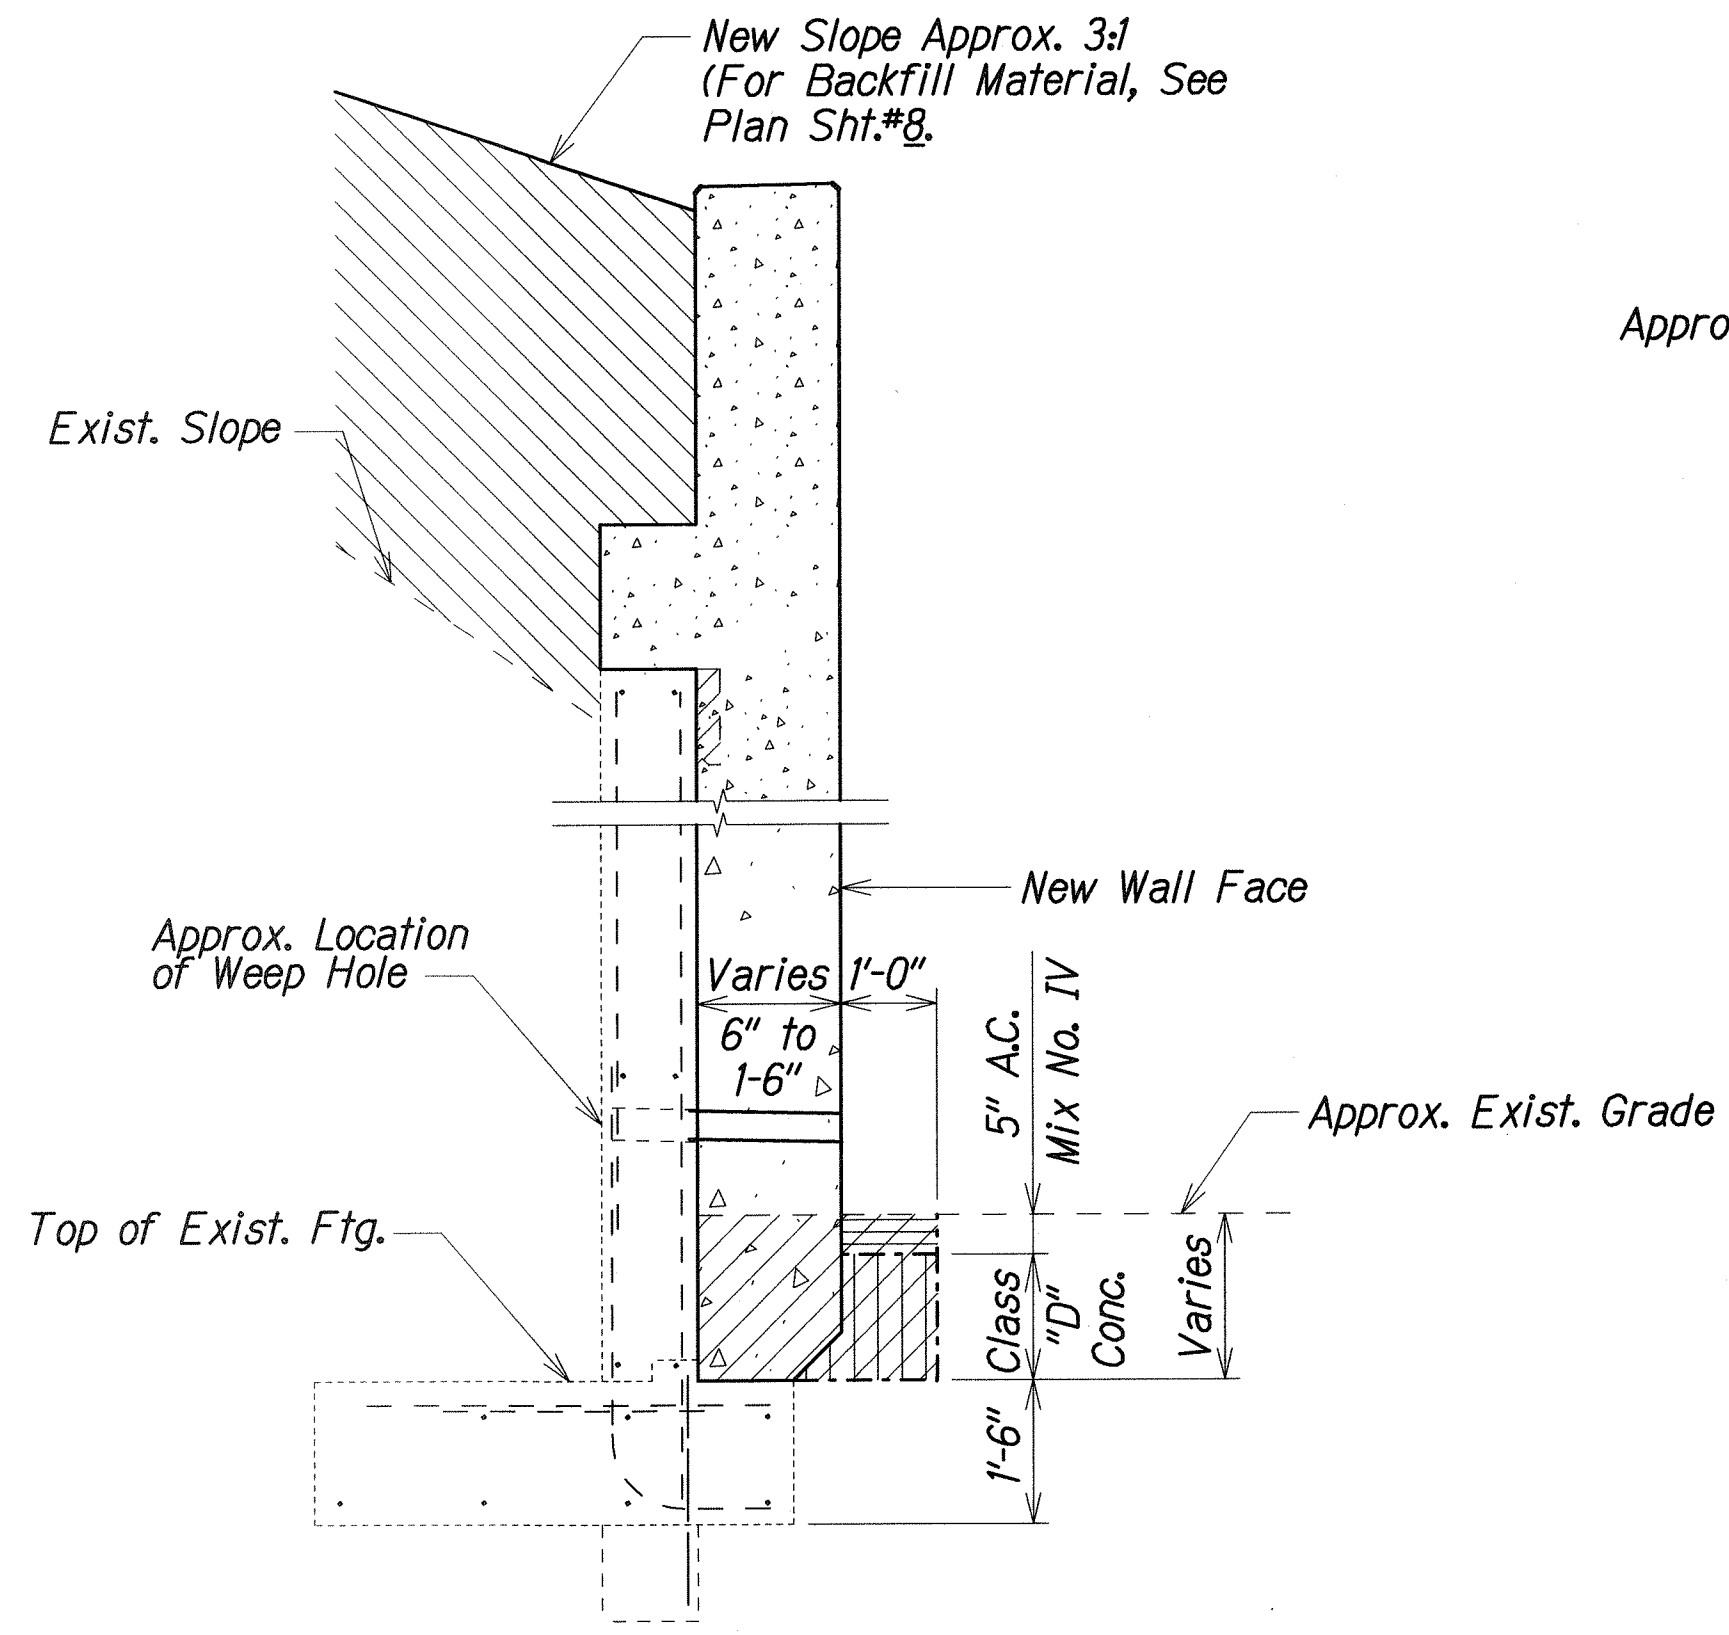

WALLS H to P
Scale: 1/2"=1'-0"

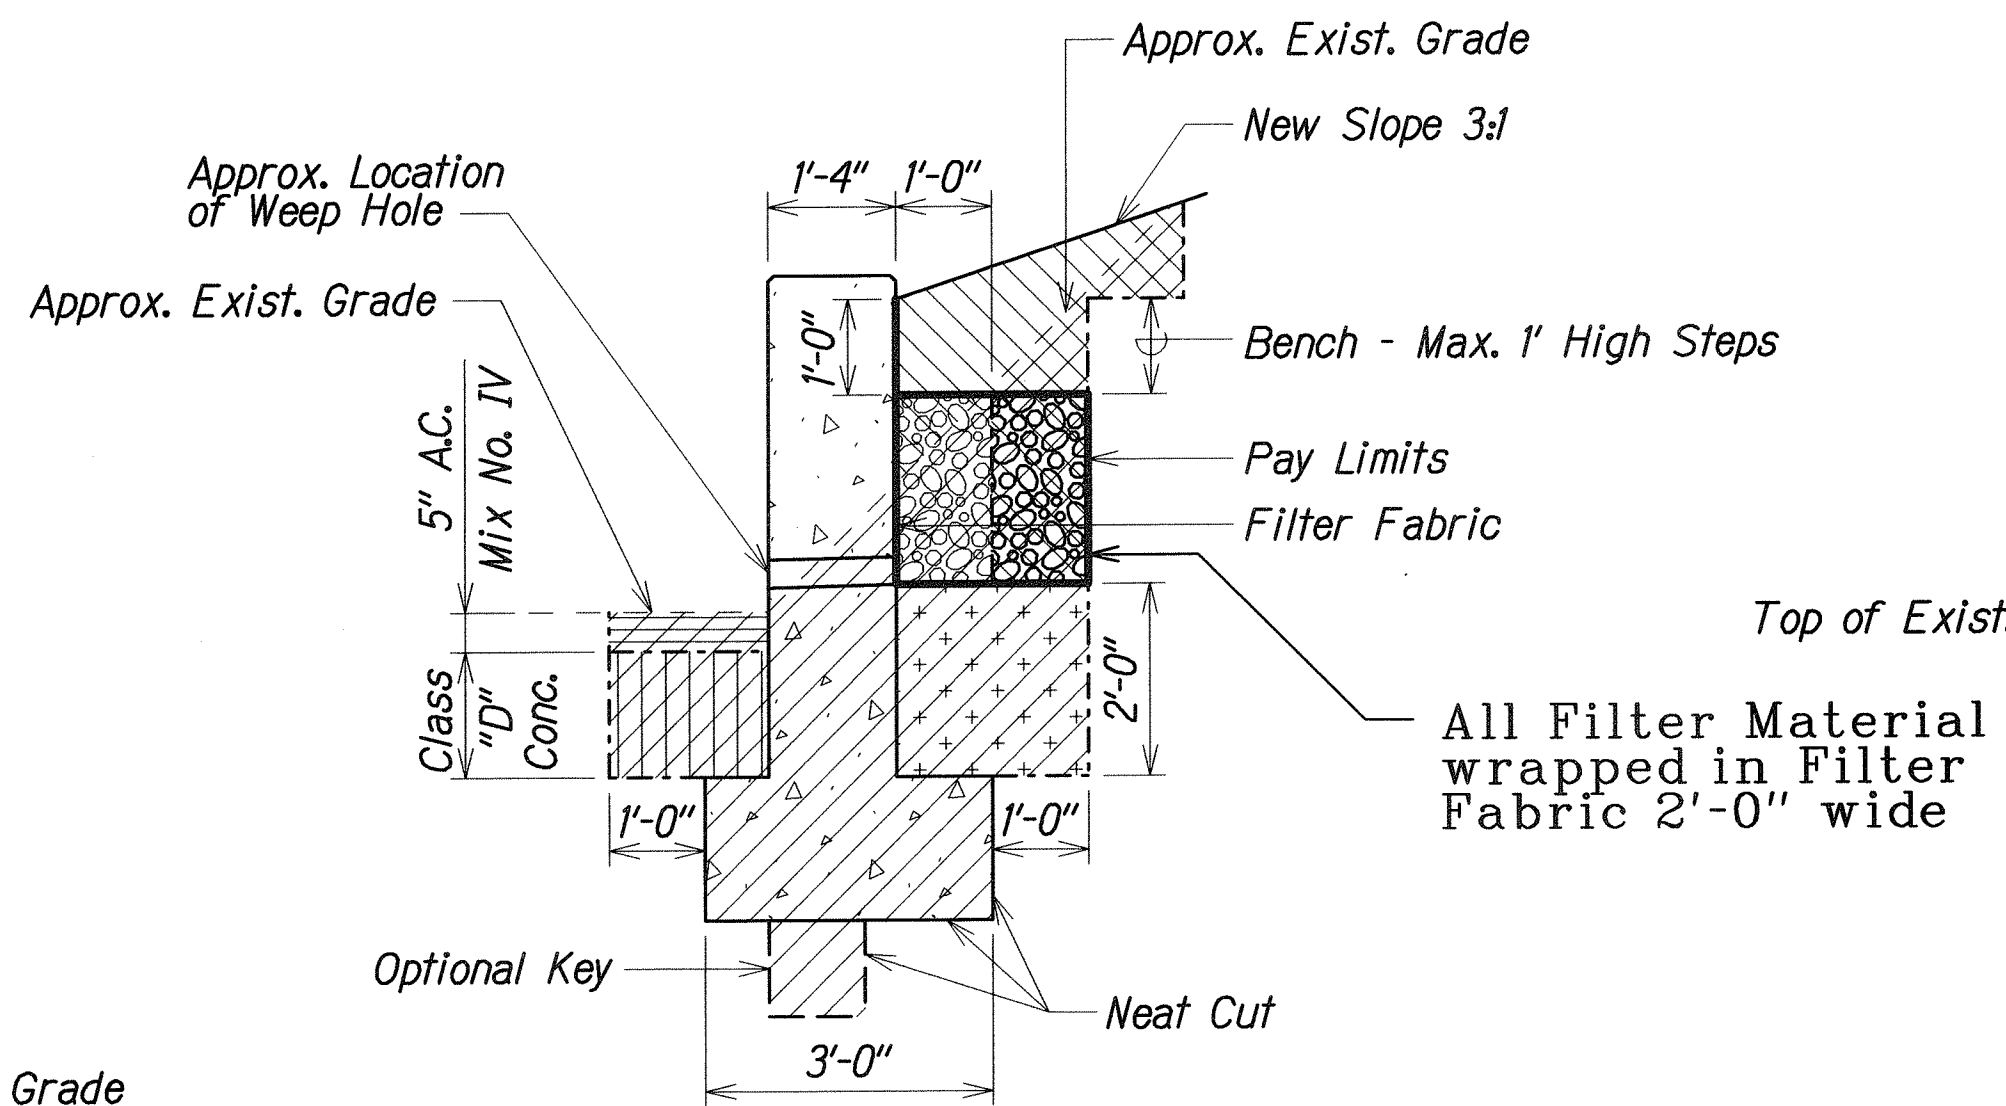

NEW WALL
(STA. 10+35± TO STA. 11+69.09±)
Scale: 1/2"=1'-0"

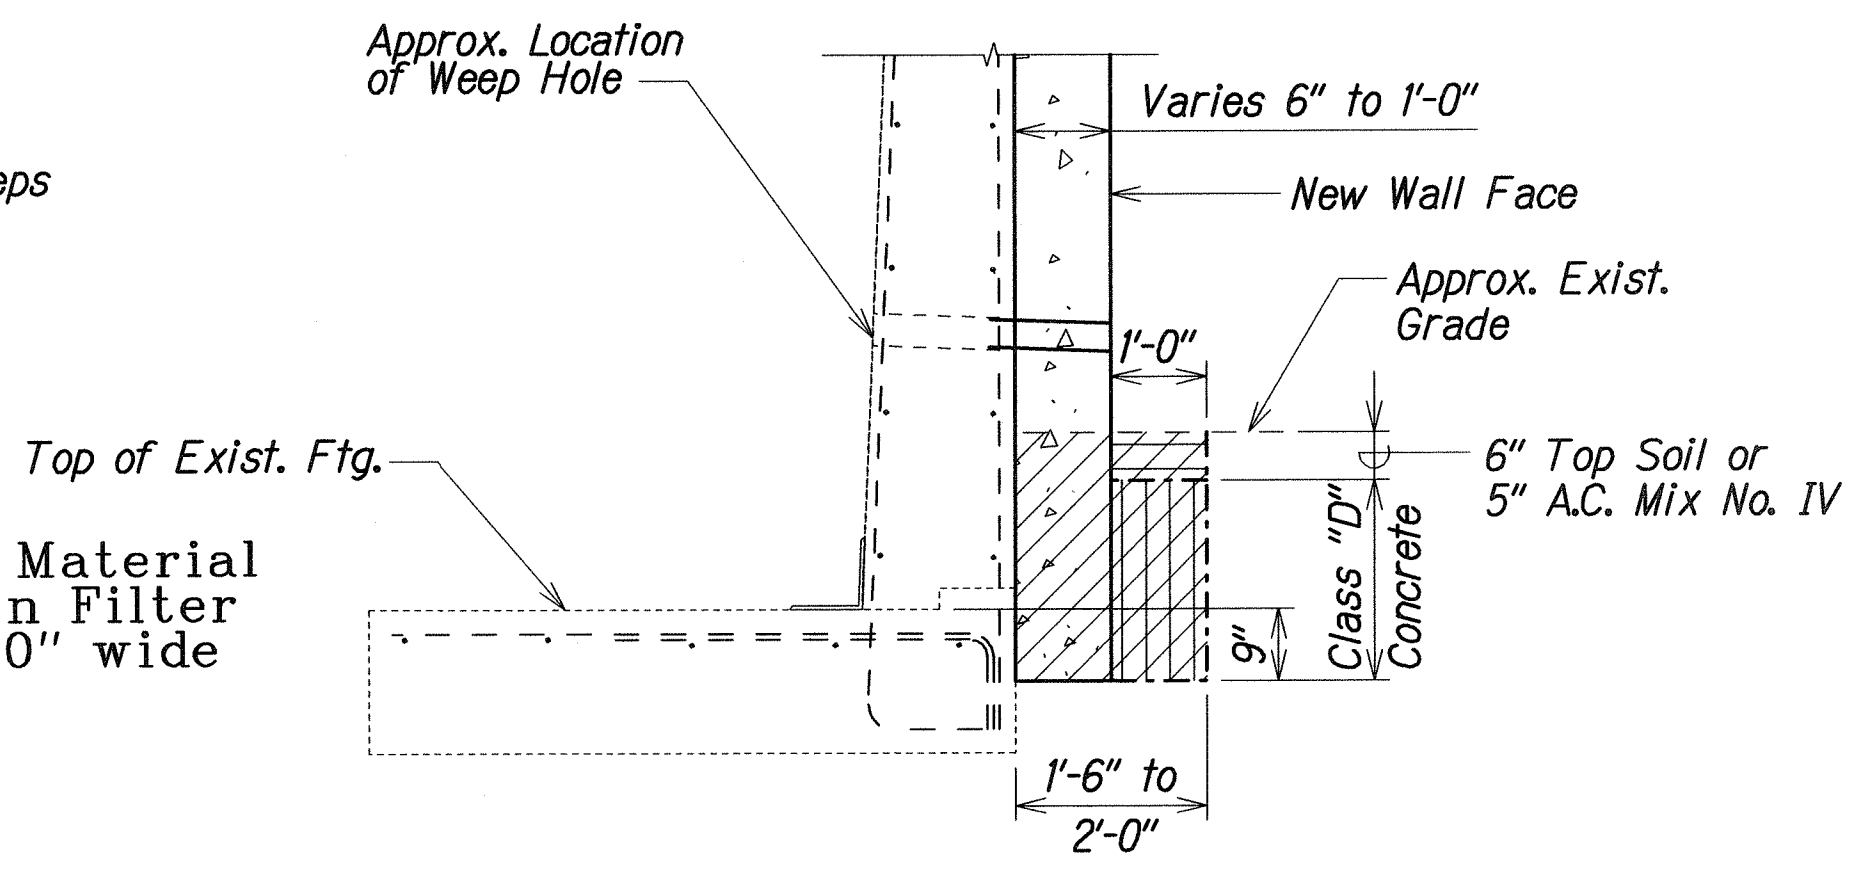

FOR FOOTING WITHOUT TOES
Scale: 1/2"=1'-0"

LEGEND

- | | | | |
|--|----------------------|--|--|
| | Limits of Excavation | | Filter Material |
| | Limits of Backfill | | Limits of Backfill (In Back of Walls - 50/50 Mix of 2" Gravel and Topsoil) |
| | Impervious Material | | Class "D" Concrete |

LEGEND FOR AS-BUILT POSTINGS

- | | |
|--|-------------------------------------|
| | Squiggly line for as-built deletion |
| | Double line for as-built deletion |
| | Text for as-built posting |

STATE OF HAWAII
DEPARTMENT OF TRANSPORTATION
HIGHWAYS DIVISION

RETAINING WALL REPAIR and EXTENSION
STRUCTURE EXCAVATION PAY LIMITS
INTERSTATE ROUTE H-1
EXTENSION AND REPAIR OF
SCHOOL STREET ON-RAMP RETAINING WALL
Project No. H11-01-08
Scale: As Noted Date: Feb., 2009

SHEET No. Q8 OF 34 SHEETS

SURVEY PLOTTED BY	DATE
PLAN	XXX 2009
DRAWN BY	XXX
DESIGNED BY	XXX
QUANTITIES BY	XXX
CHECKED BY	XXX

"AS-BUILT"

FED. ROAD DIST. NO.	STATE	PROJ. NO.	FISCAL YEAR	SHEET NO.	TOTAL SHEETS
HAWAII	HAW.	H11-01-08	2009	ADD. 17	73

WALL SCHEDULE									
PANEL	STATION	NO. OF ANCHOR ****		∠ OF ANCHORS FROM HORIZ. ***	APPROX. O/S FROM SCHOOL ST. CURB TO FACE OF EXISTING RETAINING WALLS	TOP OF OLD WALL ELEV.	TOP OF NEW WALL ELEV.	DIFF. IN HEIGHT	ELEV. TOP OF EXIST. FTG.
		UPPER	LOWER						
	5+15				12.27'	45.84'	46.24'	0.40'	31.97'
"GG"	STA. 5+15 to STA. 5+45	-	-	-					
	5+45				13.56'	45.08'	45.89'	0.81'	31.73'
"A"	STA. 5+45 to STA. 5+75	4	-	60°					
	5+75				14.83'	44.31'	45.54'	1.23'	31.50'
"B"	STA. 5+75 to STA. 6+05	5	-	60°					
	6+05				16.11'	43.55'	45.18'	1.63'	31.27'
"C"	STA. 6+05 to STA. 6+35	5	-	60°					
	6+35				17.39'	42.79'	44.82'	2.03'	31.03'
"D"	STA. 6+35 to STA. 6+65	5	-	60°					
	6+65				18.67'	42.03'	44.46'	2.43'	30.80'
"E"	STA. 6+65 to STA. 6+95	3	-	45°					
	6+95				19.94'	41.26'	44.11'	2.85'	30.57'
"F"	STA. 6+95 to STA. 7+25	4	-	45°					
	7+25				21.22'	40.50'	43.75'	3.25'	30.33'
"G"	STA. 7+25 to STA. 7+55	4	-	45°					
	7+55				22.50'	39.50'	43.34'	3.84'	30.10'
"H"	STA. 7+55 to STA. 7+85	5	2	30°					
	7+85				23.78'	38.50'	42.94'	4.44'	29.87'
"I"	STA. 7+85 to STA. 8+15	7	2	30°					
	8+15				24.06'	37.50'	42.53'	5.03'	29.63'
"J"	STA. 8+15 to STA. 8+45	6	2	20°					
	8+45				25.34'	37.30'	42.12'	4.82'	29.40
"K"	STA. 8+45 to STA. 8+75	6	2	20°					
	8+75				26.62'	37.10'	41.71'	4.61'	29.17'
"L"	STA. 8+75 to STA. 9+05	6	2	20°					
	9+05				27.90'	36.19'	41.30'	5.11'	28.93'
"M"	STA. 9+05 to STA. 9+35	7	2	20°					
	9+35				29.18'	35.28'	40.90'	5.62'	28.70'
"N"	STA. 9+35 to STA. 9+65	7	2	20°					
	9+65				30.46'	34.36'	40.50'	6.14'	28.47'
"O"	STA. 9+65 to STA. 9+95	5	2	20°					
	9+95				31.74'	33.01'	36.53'	3.52'	28.23'
"P"	STA. 9+95 to STA. 10+25	2	-	20°					
	10+25				33.02'	32.55'	32.55'	-	28.00'

NOTE:
Elevations shown are +/-.

- NOTE:
- ① One (1) Tieback Anchor added on Wall "F" between Anchors No. 1 and No. 2, Standard depth. See Sht. *Q13.
- ② One (1) Tieback Anchor added on Wall "G" between Anchors No. 3 and No. 4, Standard depth. See Sht. *Q13.
- ③ Tieback Anchor No. 5 length extended to 37'-0". See Sht. *Q20.

LEGEND

- (39.75') Indicates Proof Test Anchors
- [33.00'] Lower Anchors 1/2 Proof Test Loaded in conjunction with Proof Test.
- * For Walls "A" through "G" Anchor Elevation Location, See Tieback Anchor Placement Detail on Sht.*Q25.
- ** For Walls "H" through "P" Anchor Elevation Location, See Tieback Anchor Placement Detail on Sht.*Q25.
- *** ∠ of All Lower Anchors from Horizontal Shall Be 20°.
- **** For Location & Dimension of Anchors on Walls, See Sht.*Q6 & Q7 which refers to the sht. where the details are drawn.

LEGEND FOR AS-BUILT POSTINGS

- ~~~~~ Squiggly line for as-built deletion
- ~~=====~~ Double line for as-built deletion
- Roadway Text for as-built posting

⊕ ELEVATION LOCATION OF TIE-BACK AT BEARING PLATE (W.P.)*					
PANEL	ANCHOR				
	NO. 1	NO. 2	NO.3	NO. 4	NO. 5
"A"	44.89'	44.99'	(45.09')	45.19'	
"B"	44.54'	44.61'	(44.69')	44.76'	44.83'
"C"	44.18'	44.25'	(44.33')	44.40'	44.48'
"D"	43.82'	43.90'	(43.97')	44.04'	44.12'
"E"	43.47'	(43.62')	43.76'		
See Note ①					
"F"	43.11'	43.21'	(43.31')	43.42'	
		See Note ②			
"G"	42.70'	42.82'	(42.93')	43.05'	

⊕ ELEVATION LOCATION OF TIE-BACK AT WORKING POINT (W.P.)**								
PANEL	ANCHOR							
		NO. 1	NO. 2	NO. 3	NO. 4	NO. 5	NO. 6	NO. 7
"H"	UPPER	39.30'	39.53'	(39.75')	39.98'	40.20'		
	LOWER	[33.00']	[33.00']					
"I"	UPPER	38.32'	38.46'	38.61'	(38.75')	38.89'	39.04'	39.18'
	LOWER	[32.75']	[32.75']					
"J"	UPPER	38.07'	38.10'	38.13'	See Note ③ (38.17')	38.20'	38.23'	
	LOWER	[32.50']	[32.50']					
"K"	UPPER	37.87'	37.90'	37.93'	(37.97')	38.00'	38.03'	
	LOWER	[32.25']	[32.25']					
"L"	UPPER	37.02'	37.17'	37.32'	(37.47')	37.62'	37.77'	
	LOWER	[32.00']	[32.00']					
"M"	UPPER	36.08'	36.22'	36.35'	(36.49')	36.63'	36.76'	36.89'
	LOWER	[31.75']	[31.75']					
"N"	UPPER	35.16'	35.29'	35.43'	(35.57')	35.71'	35.85'	35.98'
	LOWER	[31.50']	[31.50']					
"O"	UPPER	33.91'	34.39'	(34.65')	34.85'	35.05'		
	LOWER	[31.25']	[31.25']					
"P"	UPPER	33.30'	33.30'					
	LOWER							

ORIGINAL PLAN	SURVEY PLOTTED BY	DATE
	DRAWN BY	XXX 2009
	DESIGNED BY	XXX 2009
	CHECKED BY	XXX 2009
NOTE BOOK	QUANTITIES BY	XXX 2009
	CHECKED BY	XXX 2009

△	Revised Top of New Wall Elevation and Difference in Height
3/31/09	
DATE	REVISION

STATE OF HAWAII
DEPARTMENT OF TRANSPORTATION
HIGHWAYS DIVISION

RETAINING WALL REPAIR
WALL, ANCHOR AND BEARING PLATE
SCHEDULES
INTERSTATE ROUTE H-1 EXTENSION AND
REPAIR OF SCHOOL STREET ON-RAMP RETAINING WALL
Project No. H11-01-08



Scale: As Noted Date: Feb., 2009

SHEET No. Q9 OF 34 SHEETS

"AS-BUILT"

ADD. 17

FED. ROAD DIST. NO.	STATE	FED. AID PROJ. NO.	FISCAL YEAR	SHEET NO.	TOTAL SHEETS
HAWAII	HAW.	HII-01-08	2009	18	73

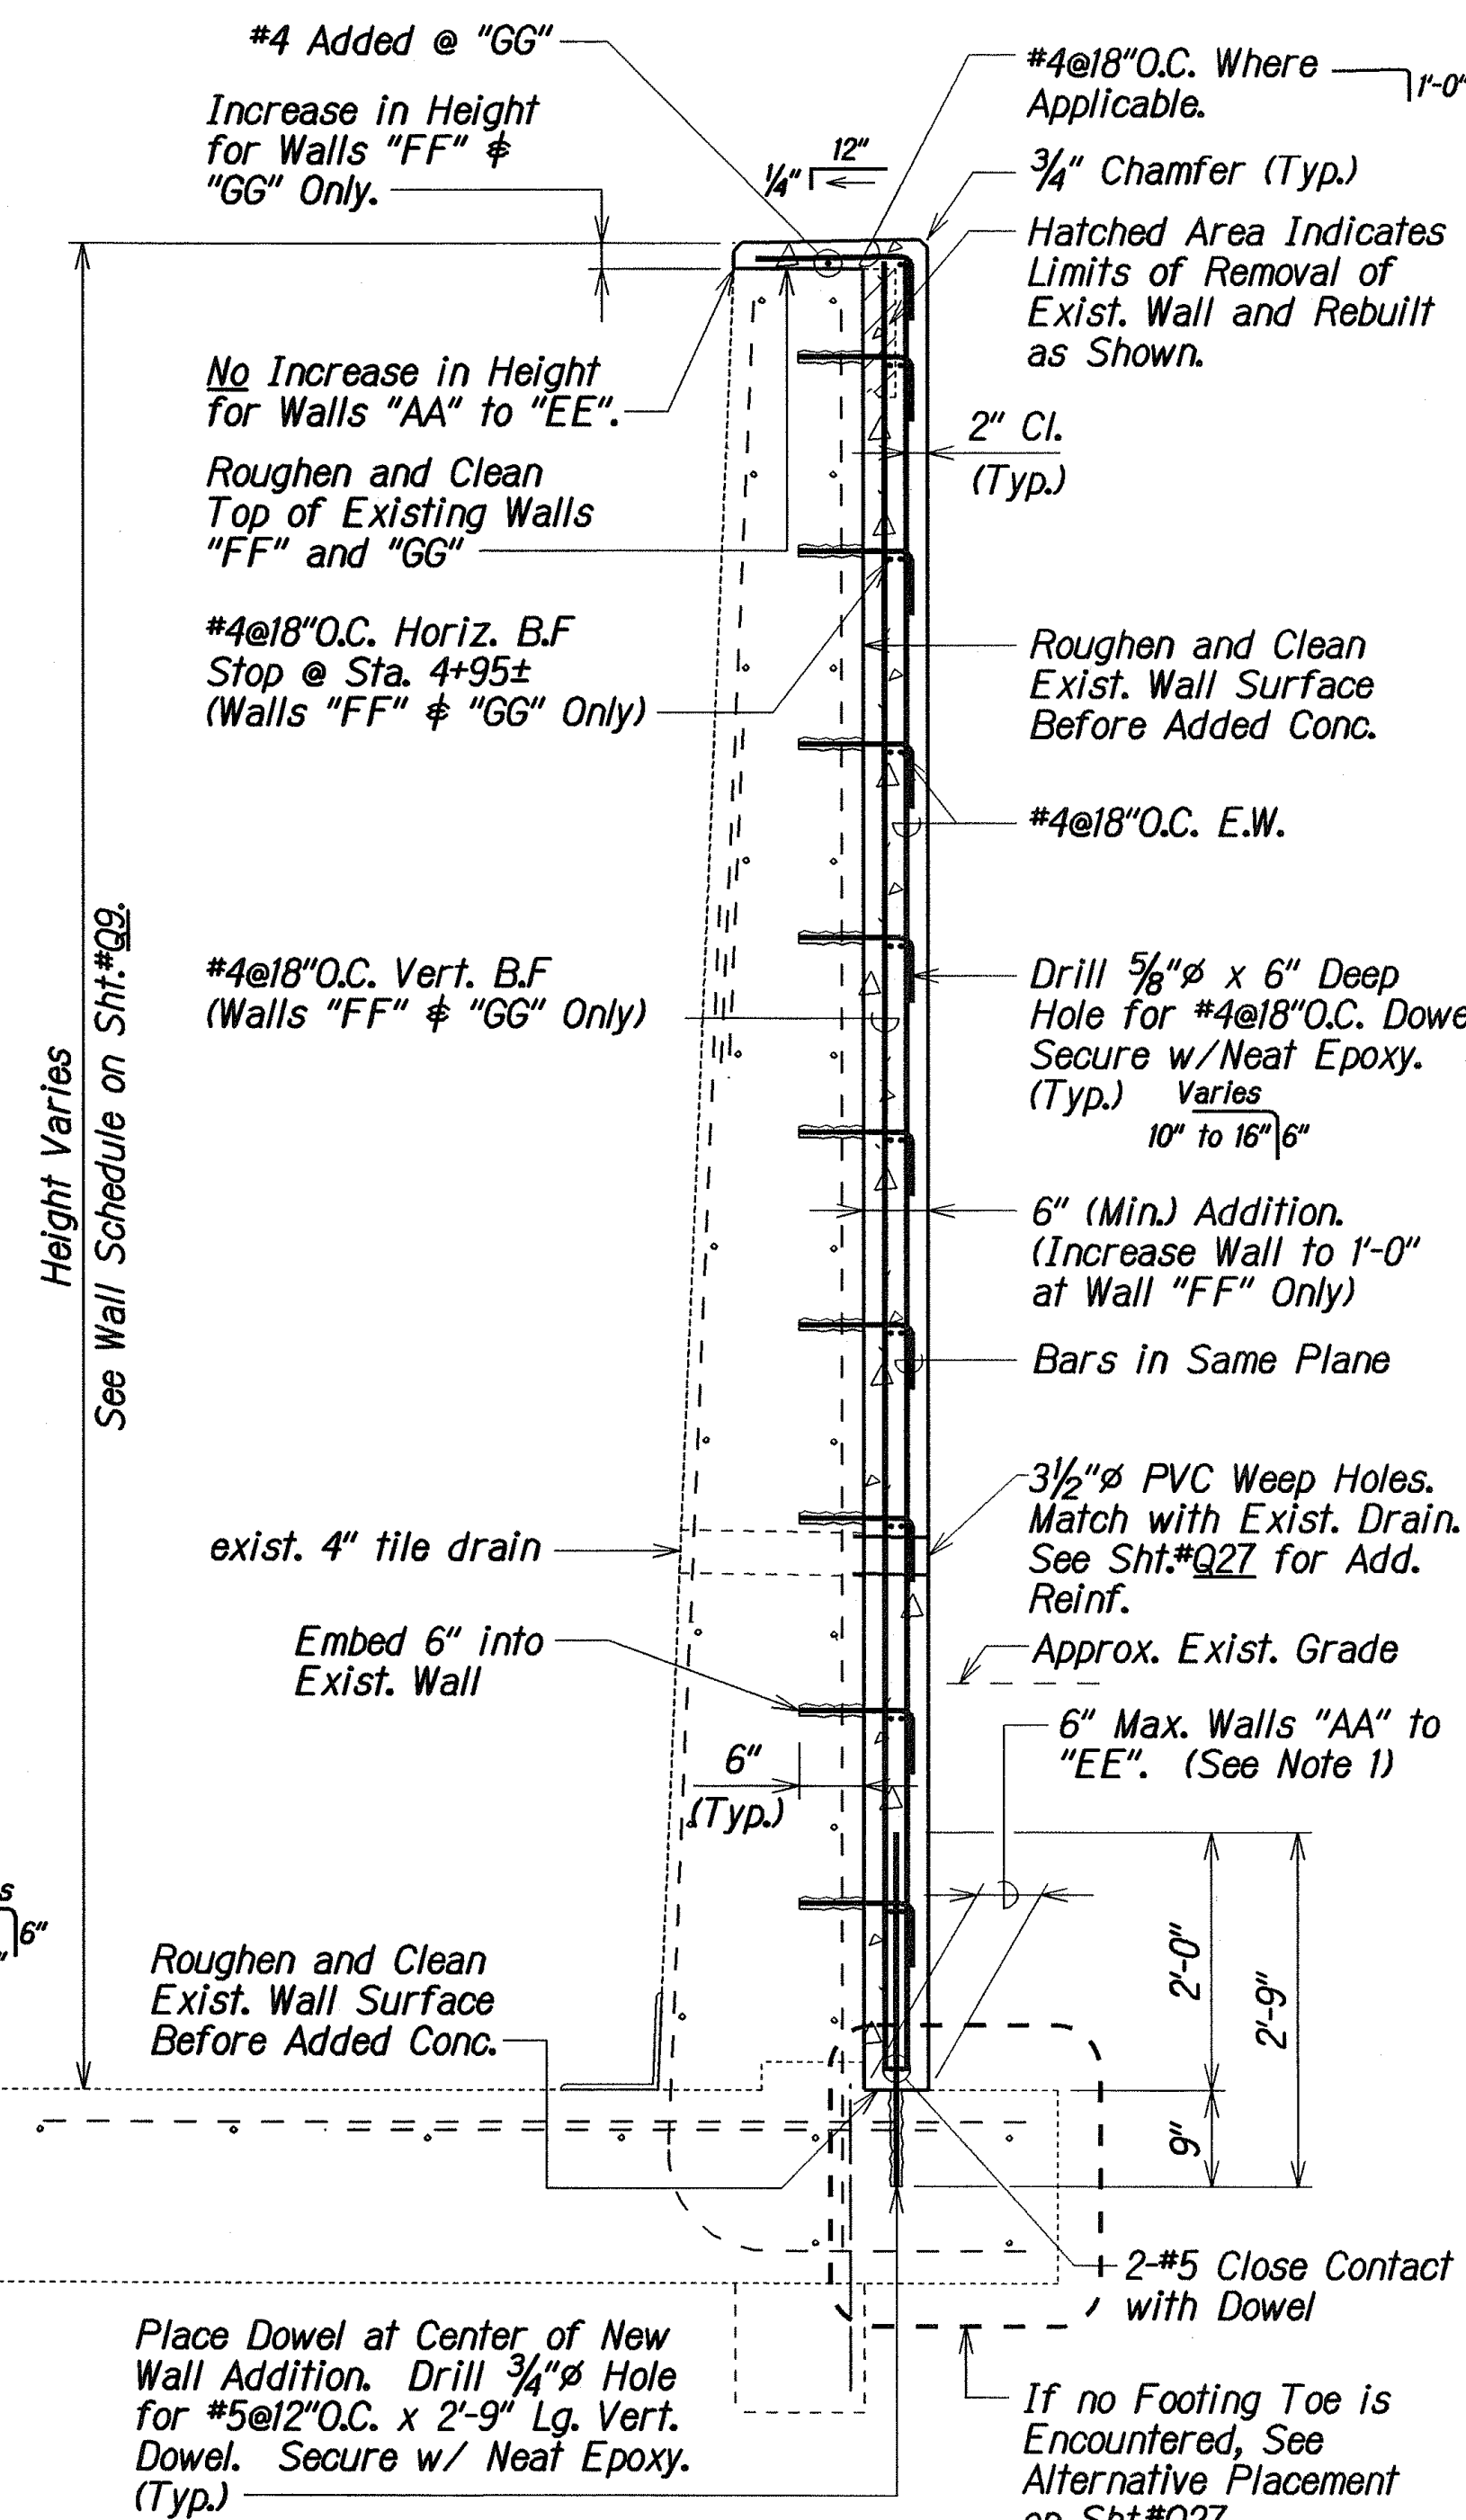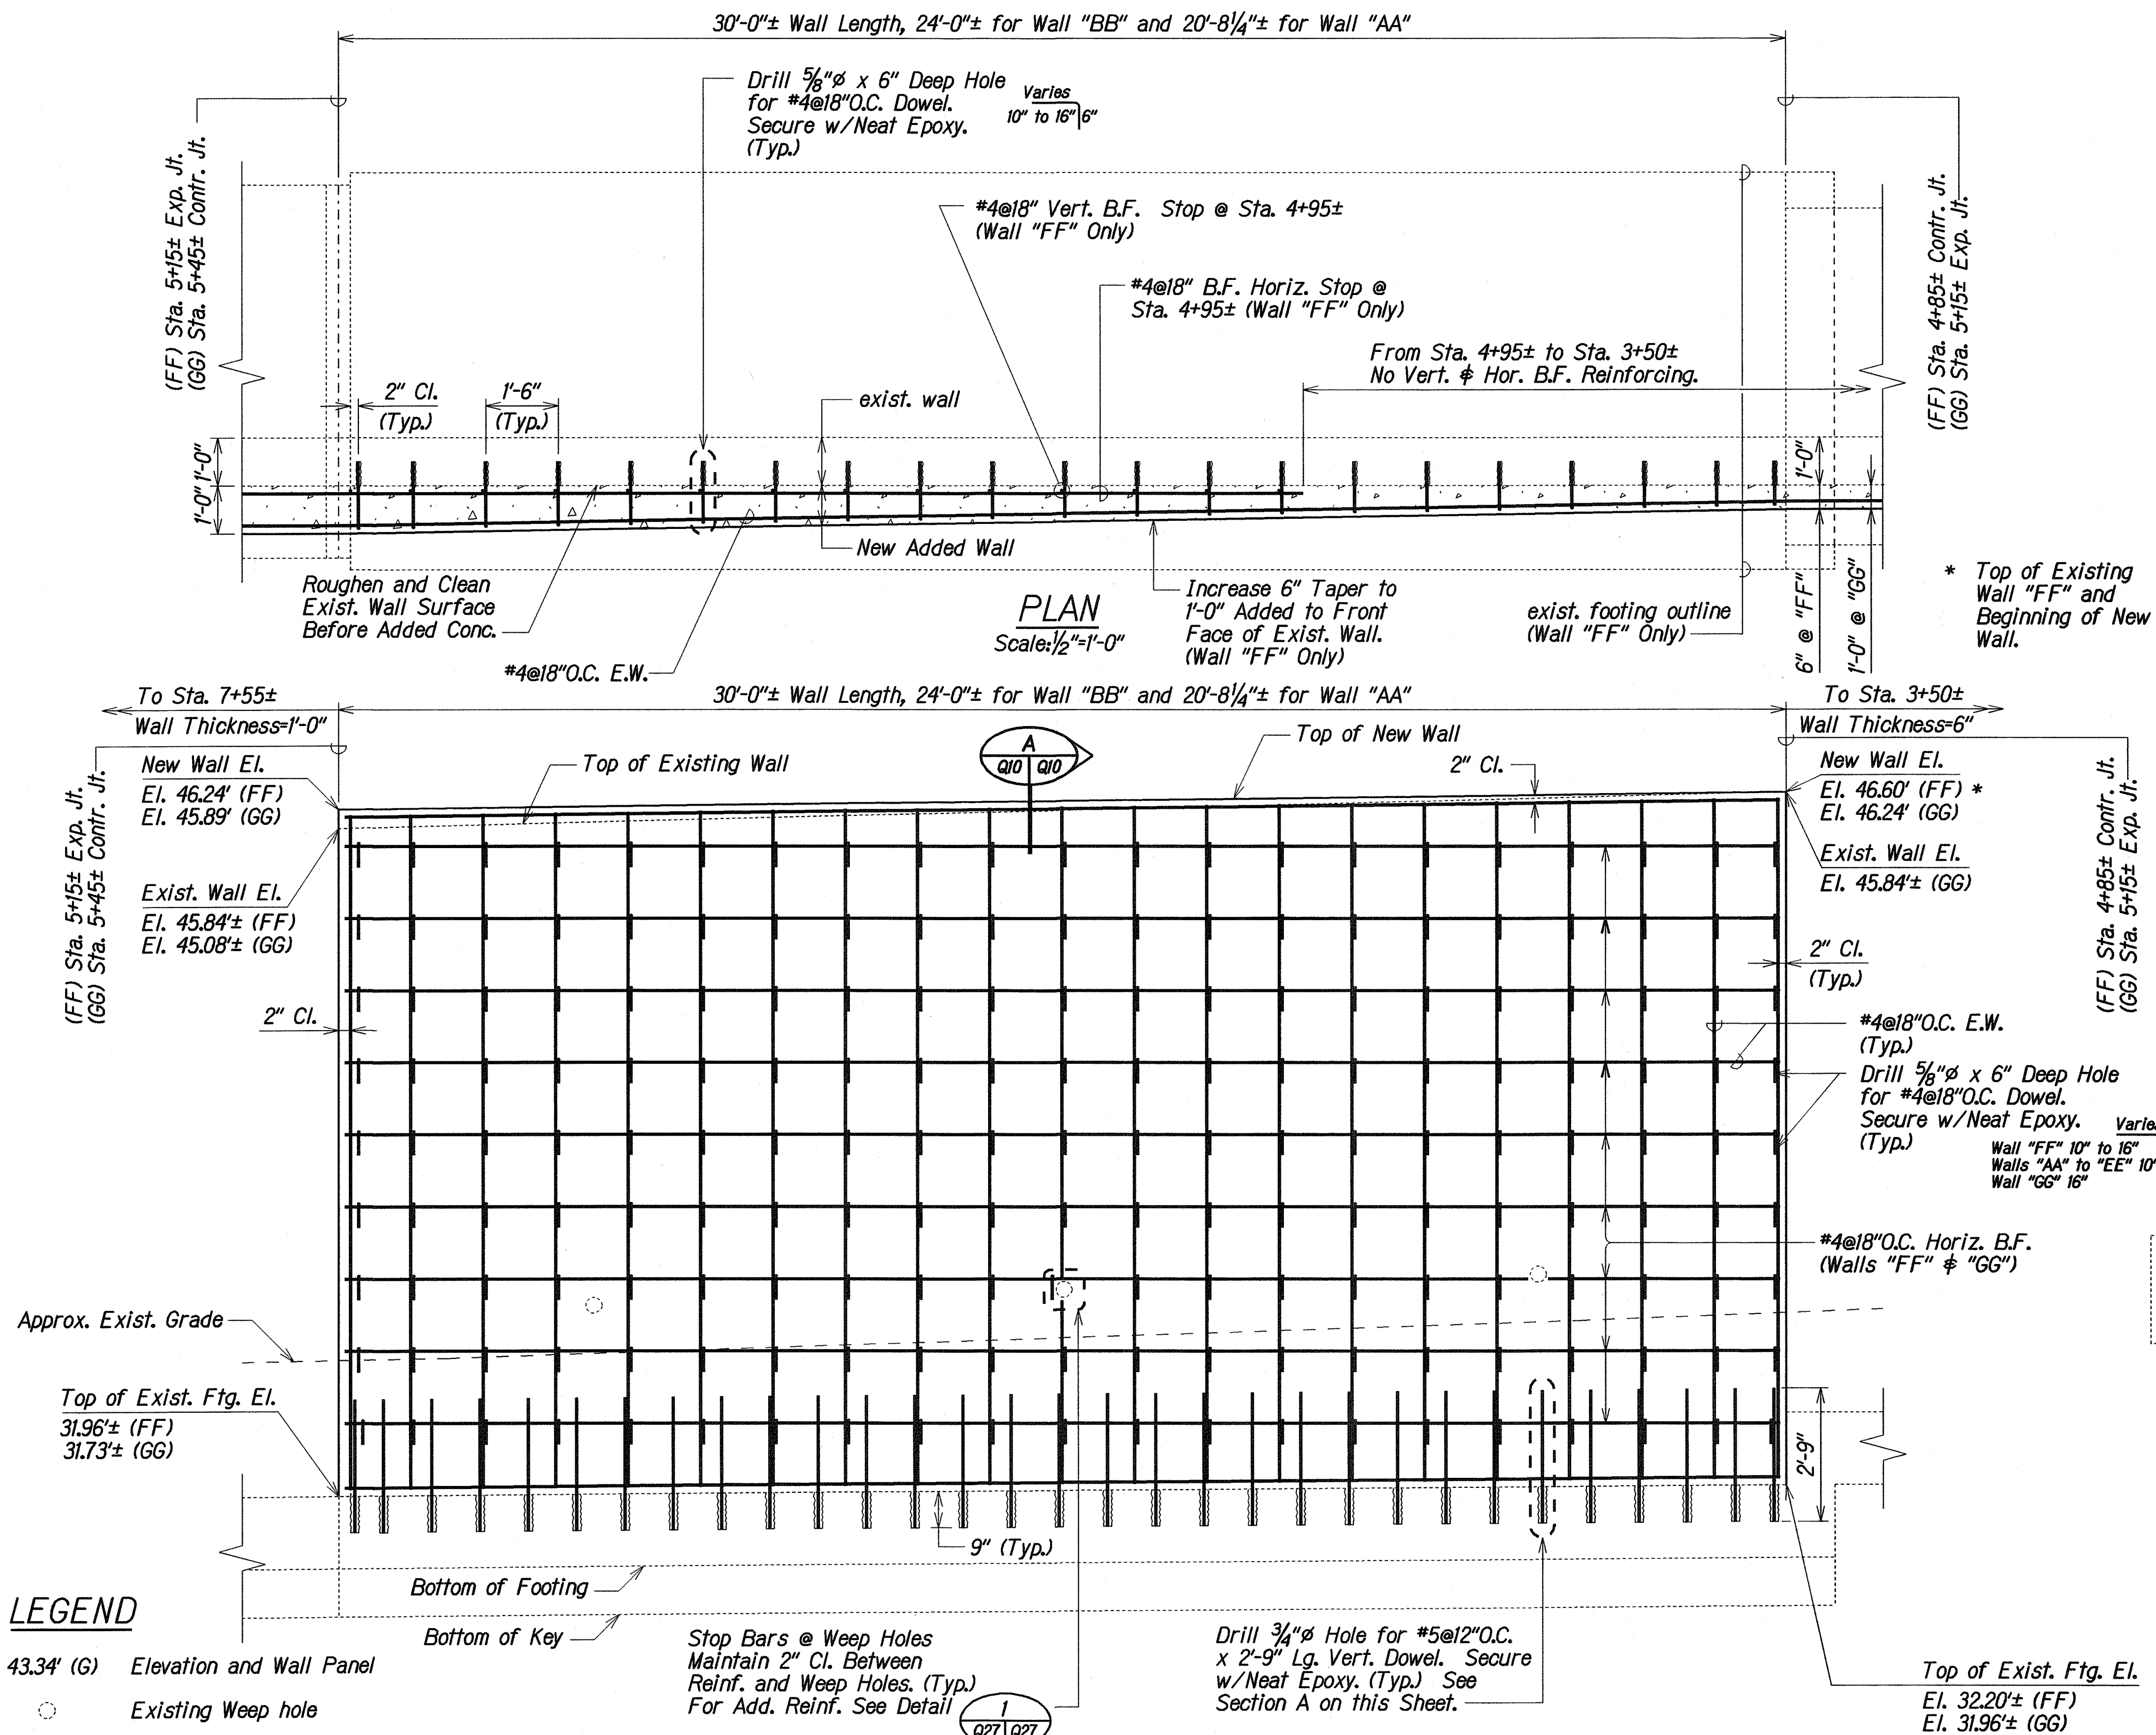

WALL "FF" DETAILS WALL "AA" TO "GG" SIMILAR EXCEPT AS NOTED


STATE OF HAWAII
DEPARTMENT OF TRANSPORTATION
HIGHWAYS DIVISION

RETAINING WALL REPAIR
WALL "AA" TO "GG" DETAILS
INTERSTATE ROUTE H-1
EXTENSION AND REPAIR OF
SCHOOL STREET ON-RAMP RETAINING WALL
Project No. HII-01-08

Scale: As Noted Date: Feb., 2009


SHEET No. Q10 OF 34 SHEETS

FED. ROAD DIST. NO.	STATE	PROJ. NO.	FISCAL YEAR	SHEET NO.	TOTAL SHEETS
HAWAII	HAW.	H11-01-08	2009	19	73

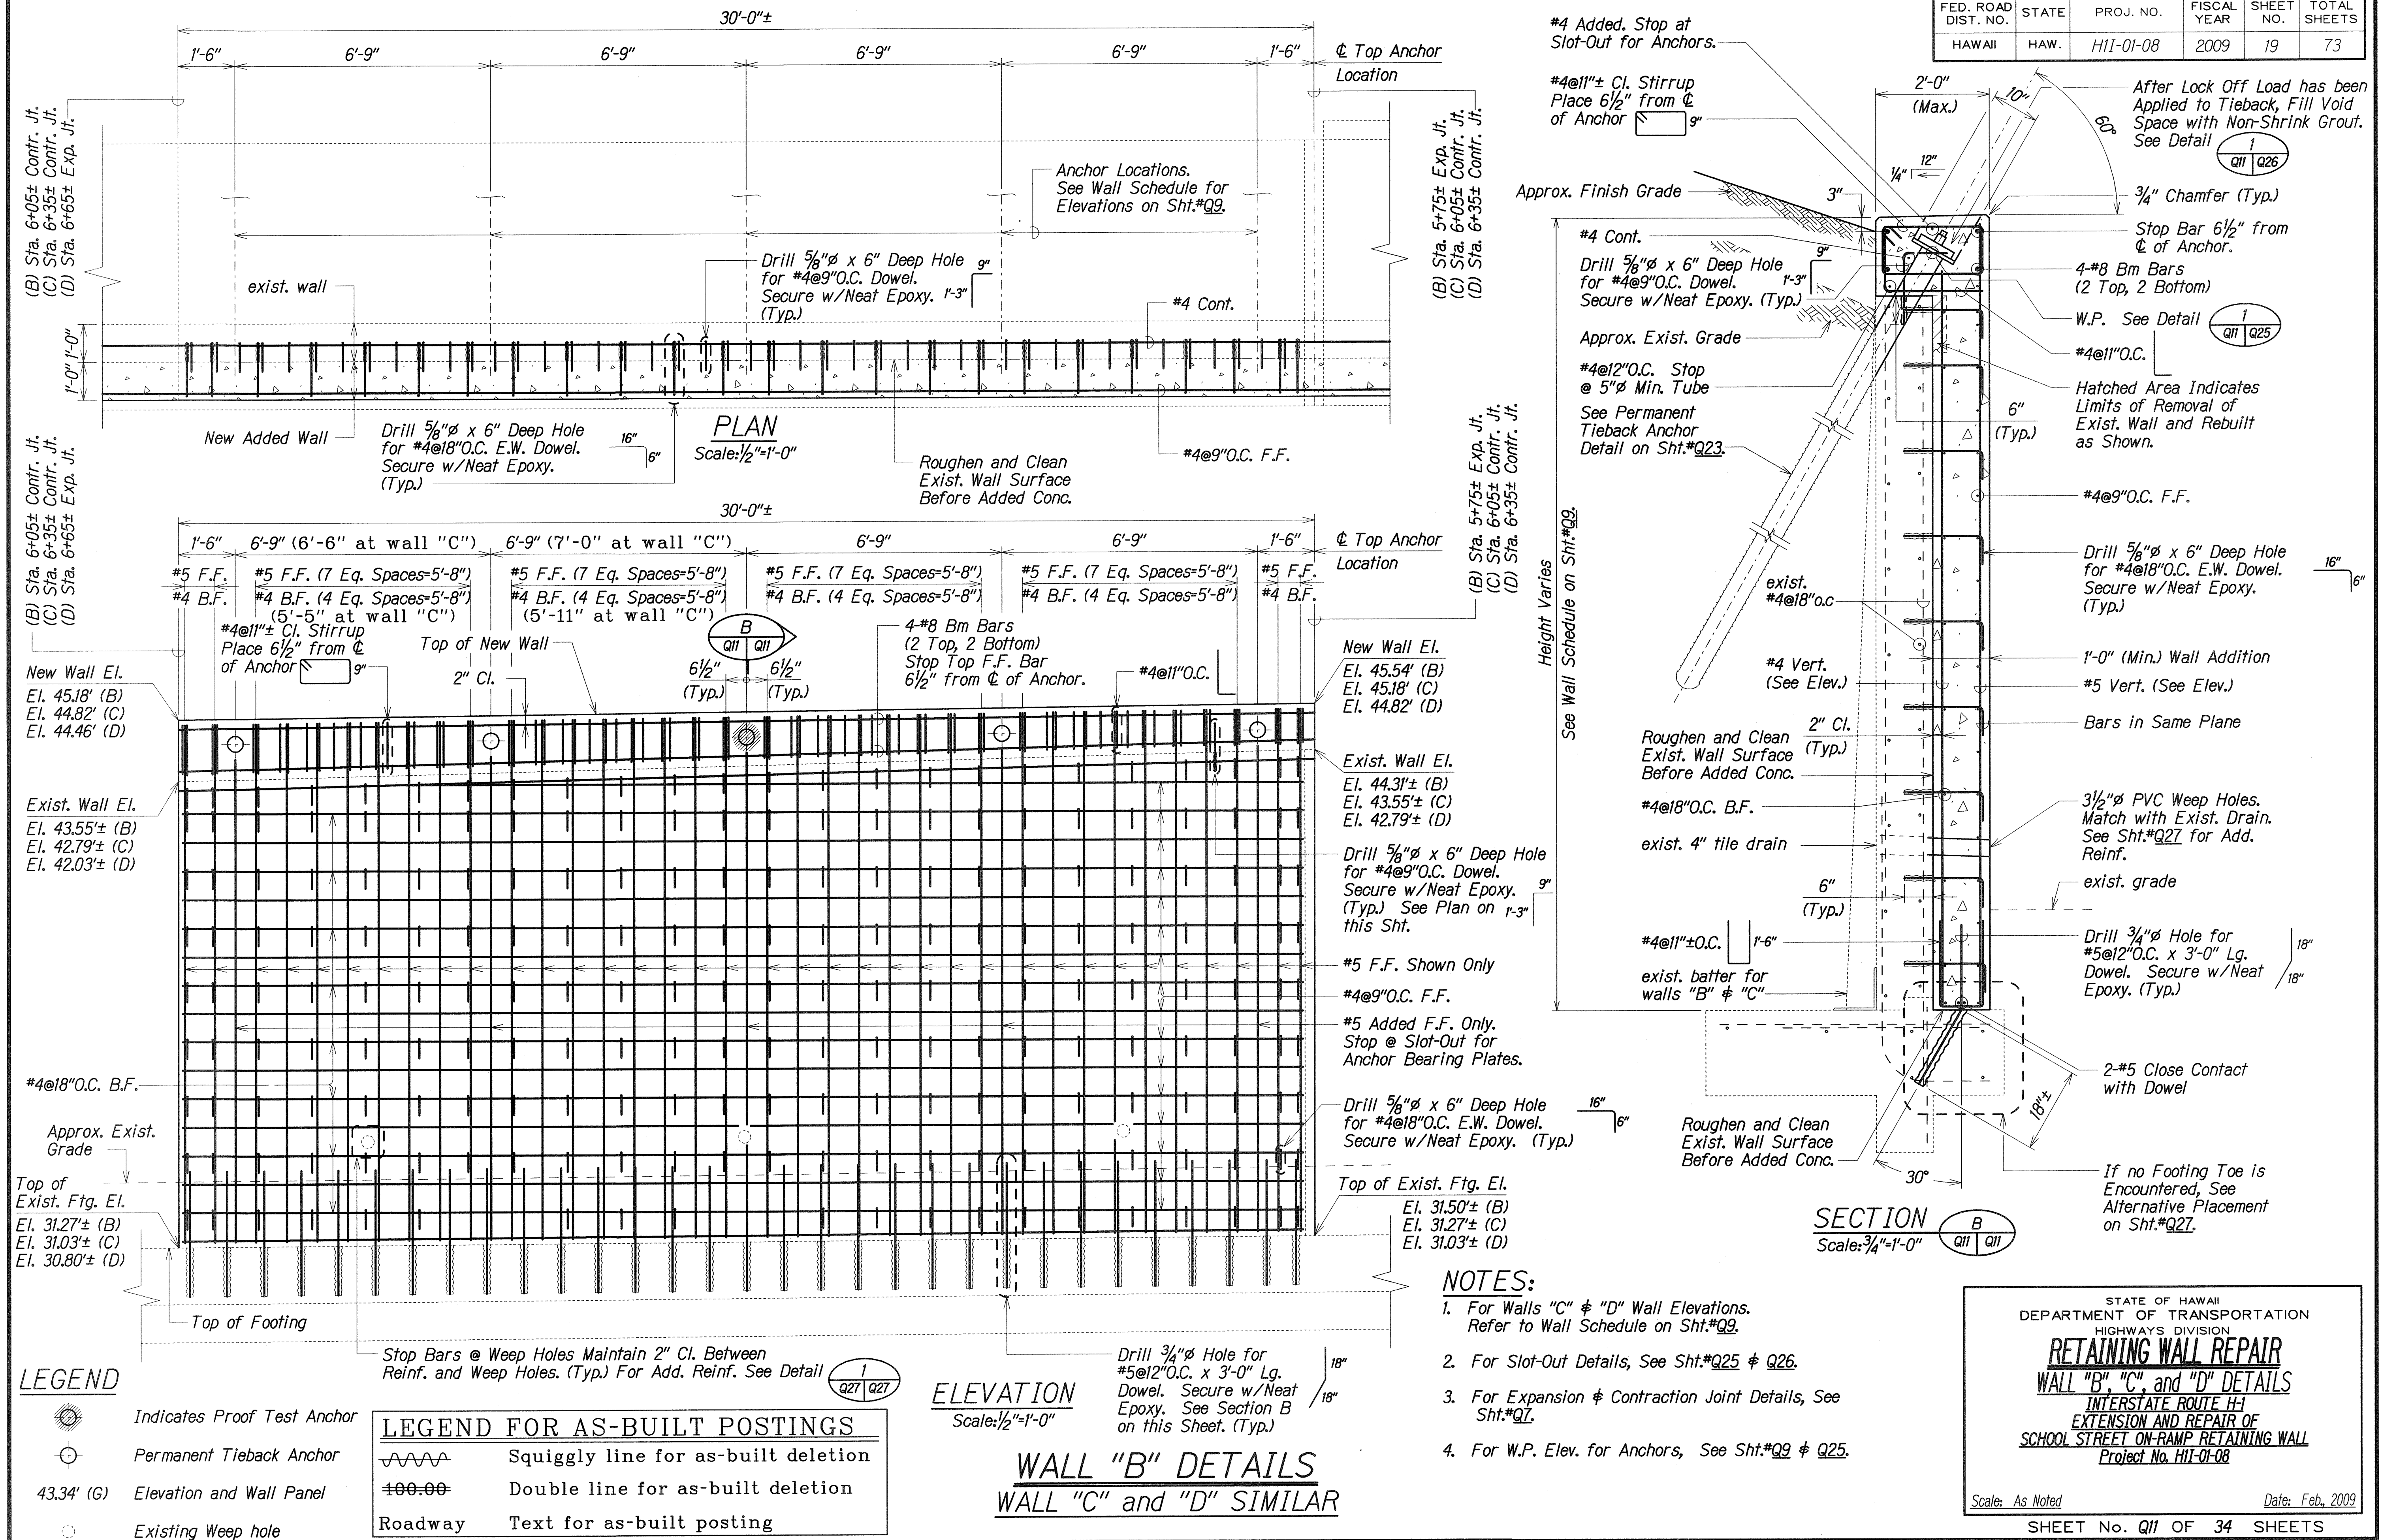

"AS-BUILT"

FED. ROAD DIST. NO.	STATE	FED. AID PROJ. NO.	FISCAL YEAR	SHEET NO.	TOTAL SHEETS
HAWAII	HAW.	H11-01-08	2009	20	73

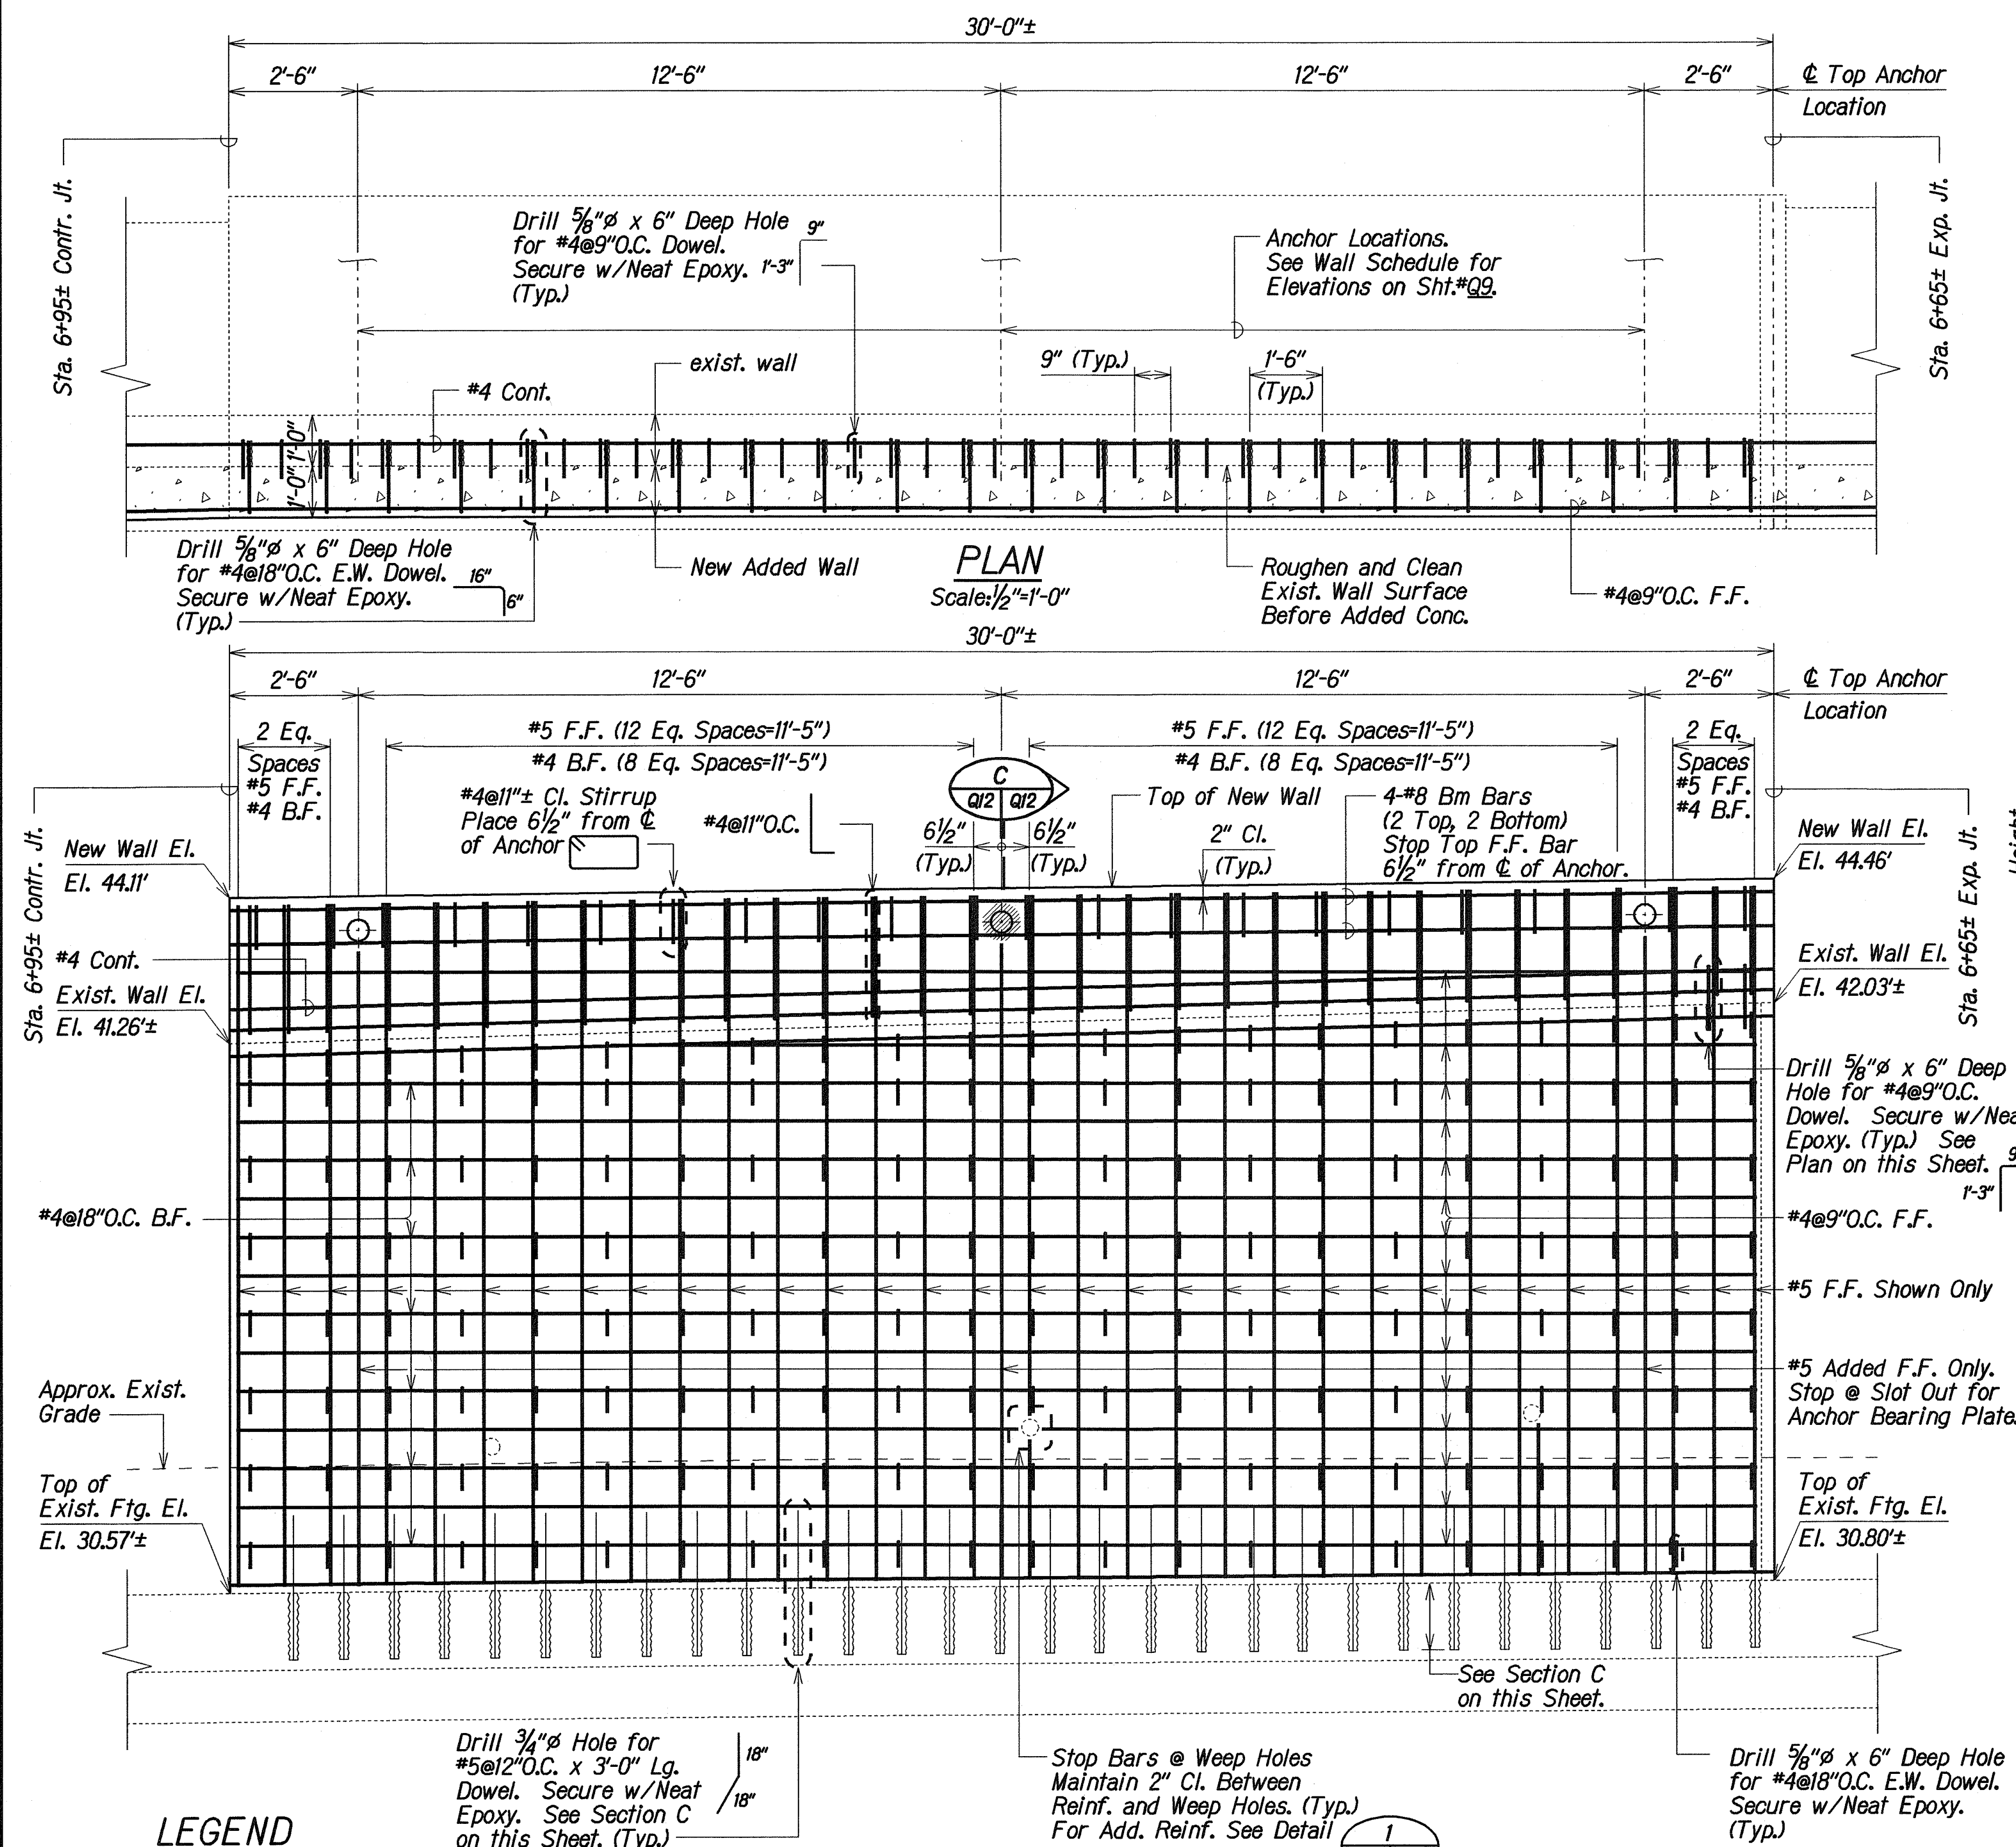


LEGEND

- Indicates Proof Test Anchor
- Permanent Tieback Anchor
- 43.34' (G) Elevation and Wall Panel
- Existing Weep hole

ELEVATION

Scale: 1/2"=1'-0"

WALL "E" DETAILS

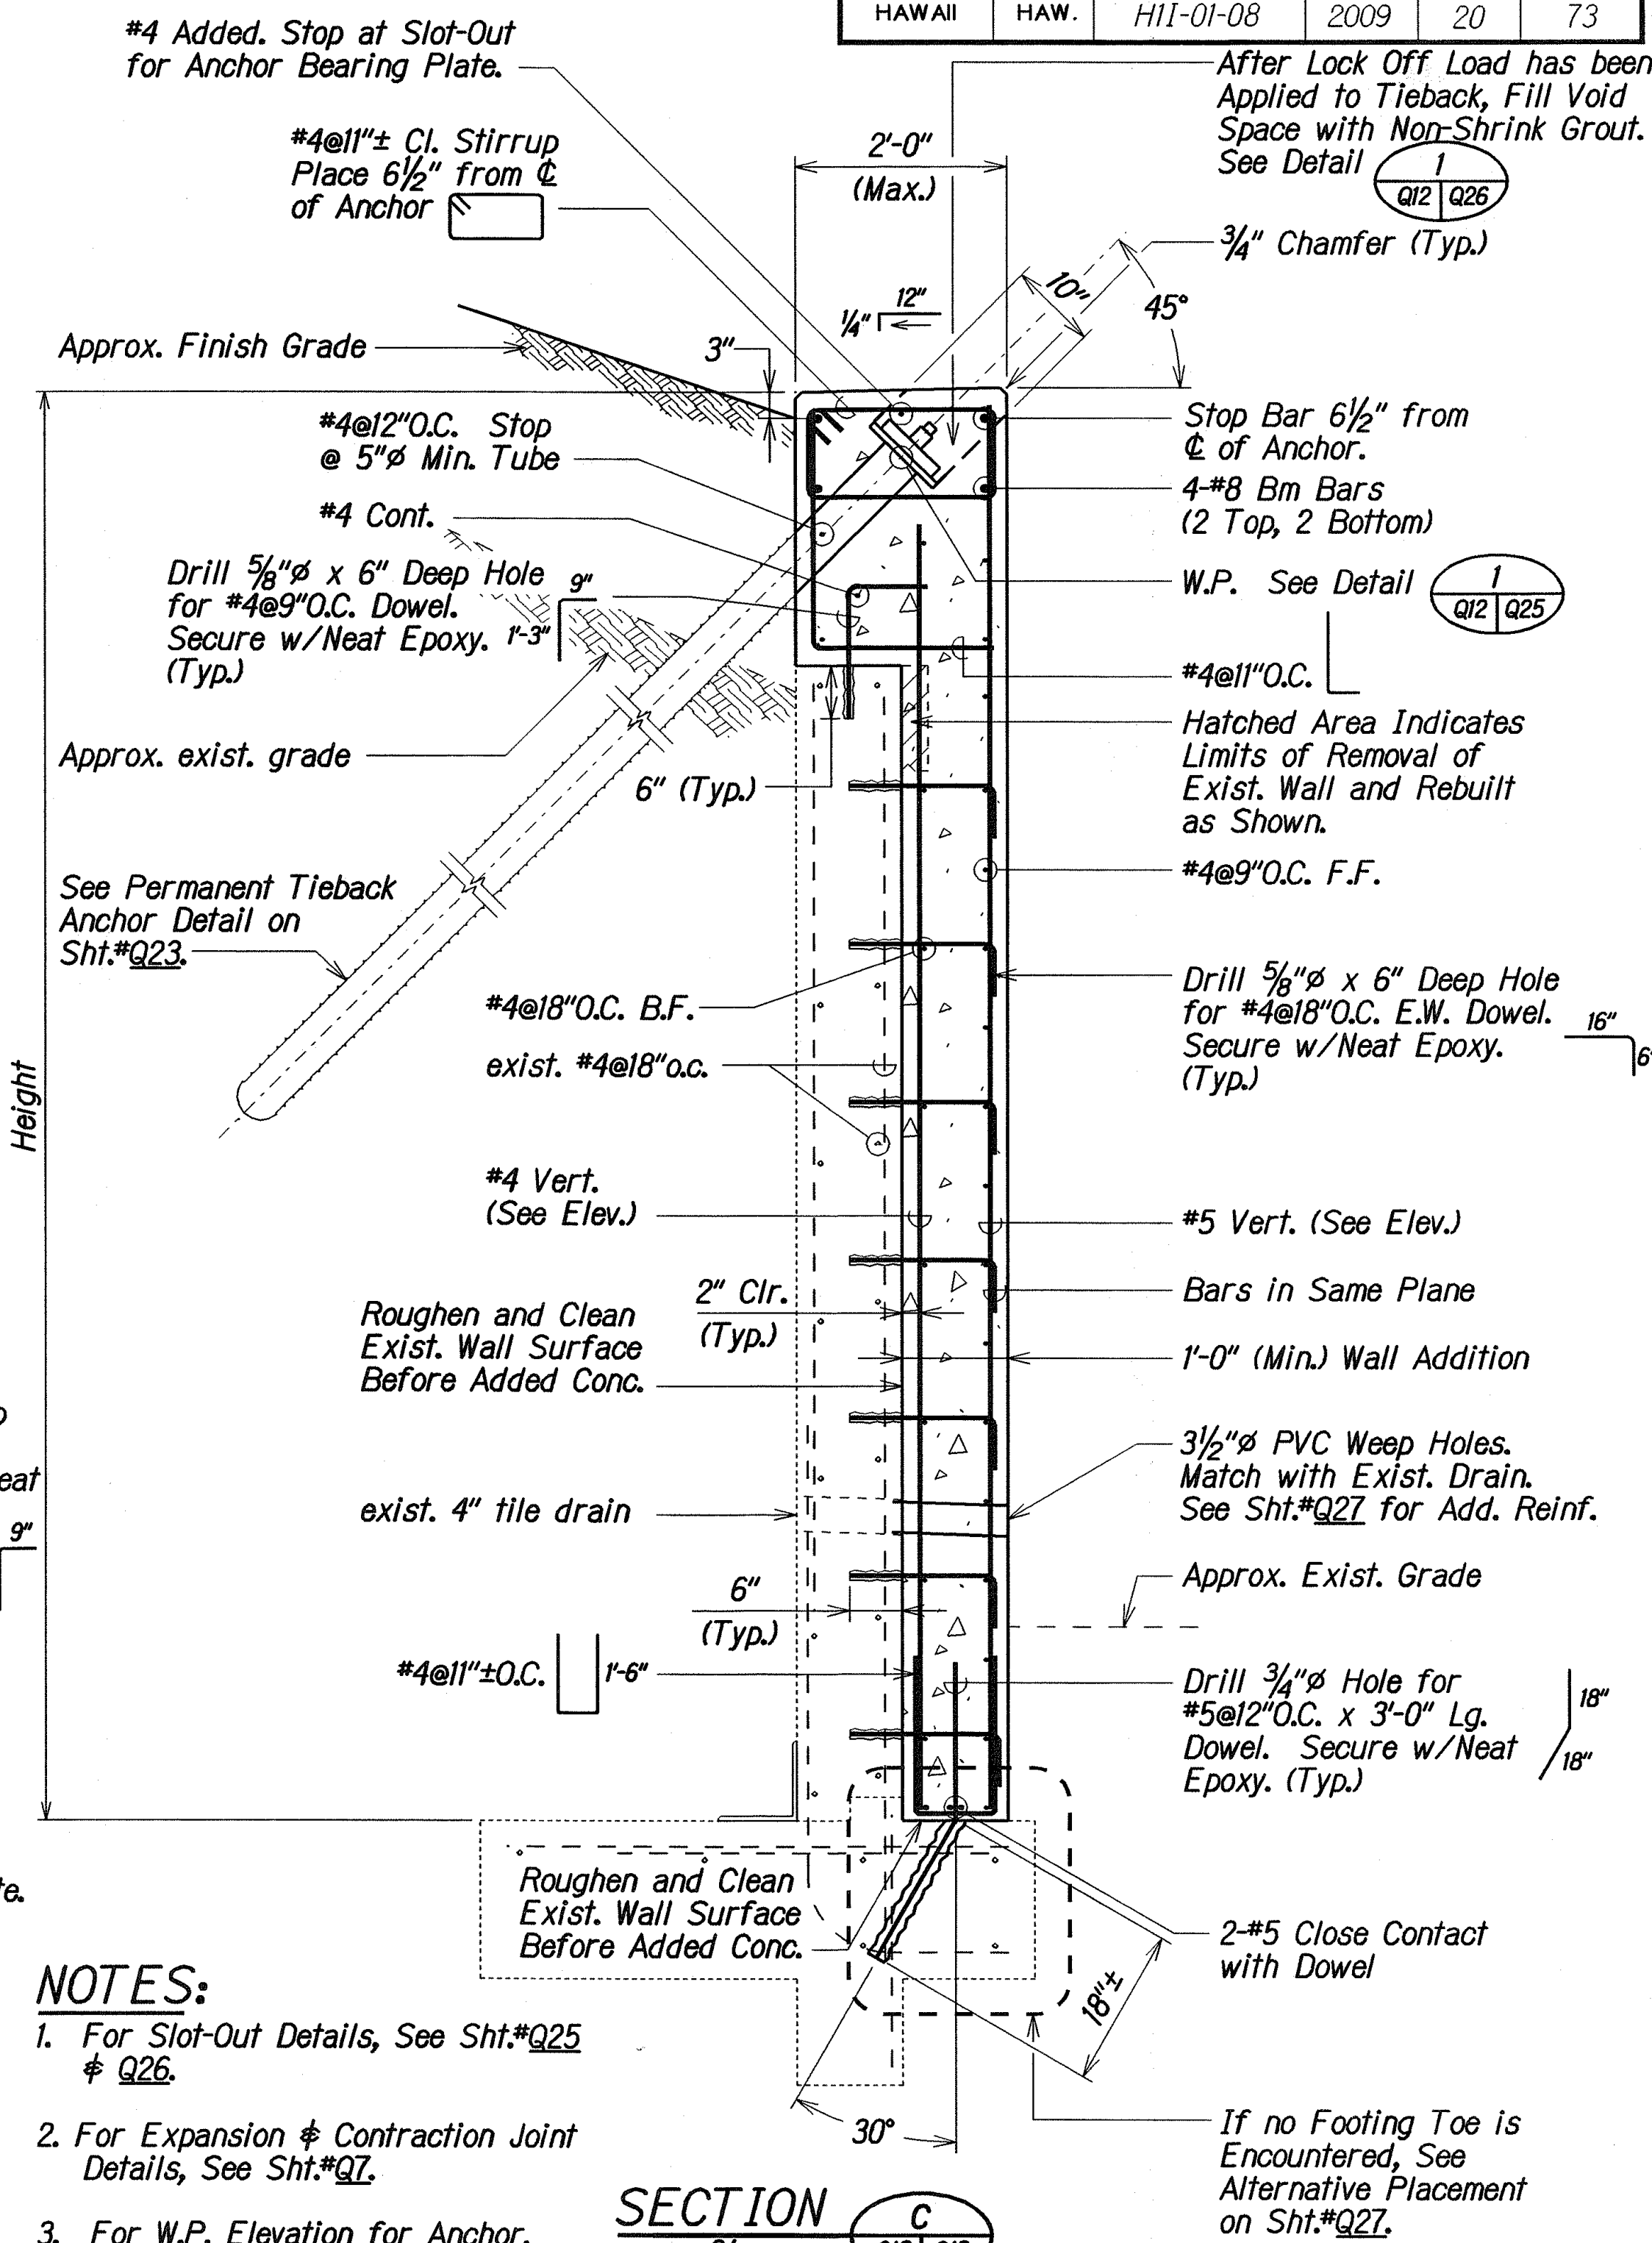

NOTES:

- For Slot-Out Details, See Sht.*Q25 & Q26.
- For Expansion & Contraction Joint Details, See Sht.*Q7.
- For W.P. Elevation for Anchor, See Sht.*Q9 & Q25.


STATE OF HAWAII
DEPARTMENT OF TRANSPORTATION
HIGHWAYS DIVISION
RETAINING WALL REPAIR
WALL "E" DETAILS
INTERSTATE ROUTE H-1
EXTENSION AND REPAIR OF
SCHOOL STREET ON-RAMP RETAINING WALL
Project No. H11-01-08

Scale: As Noted

Date: Feb, 2009

SHEET No. Q12 OF 34 SHEETS

FED. ROAD DIST. NO.	STATE	PROJ. NO.	FISCAL YEAR	SHEET NO.	TOTAL SHEETS
HAWAII	HAW.	H11-01-08	2009	ADD. 21	73

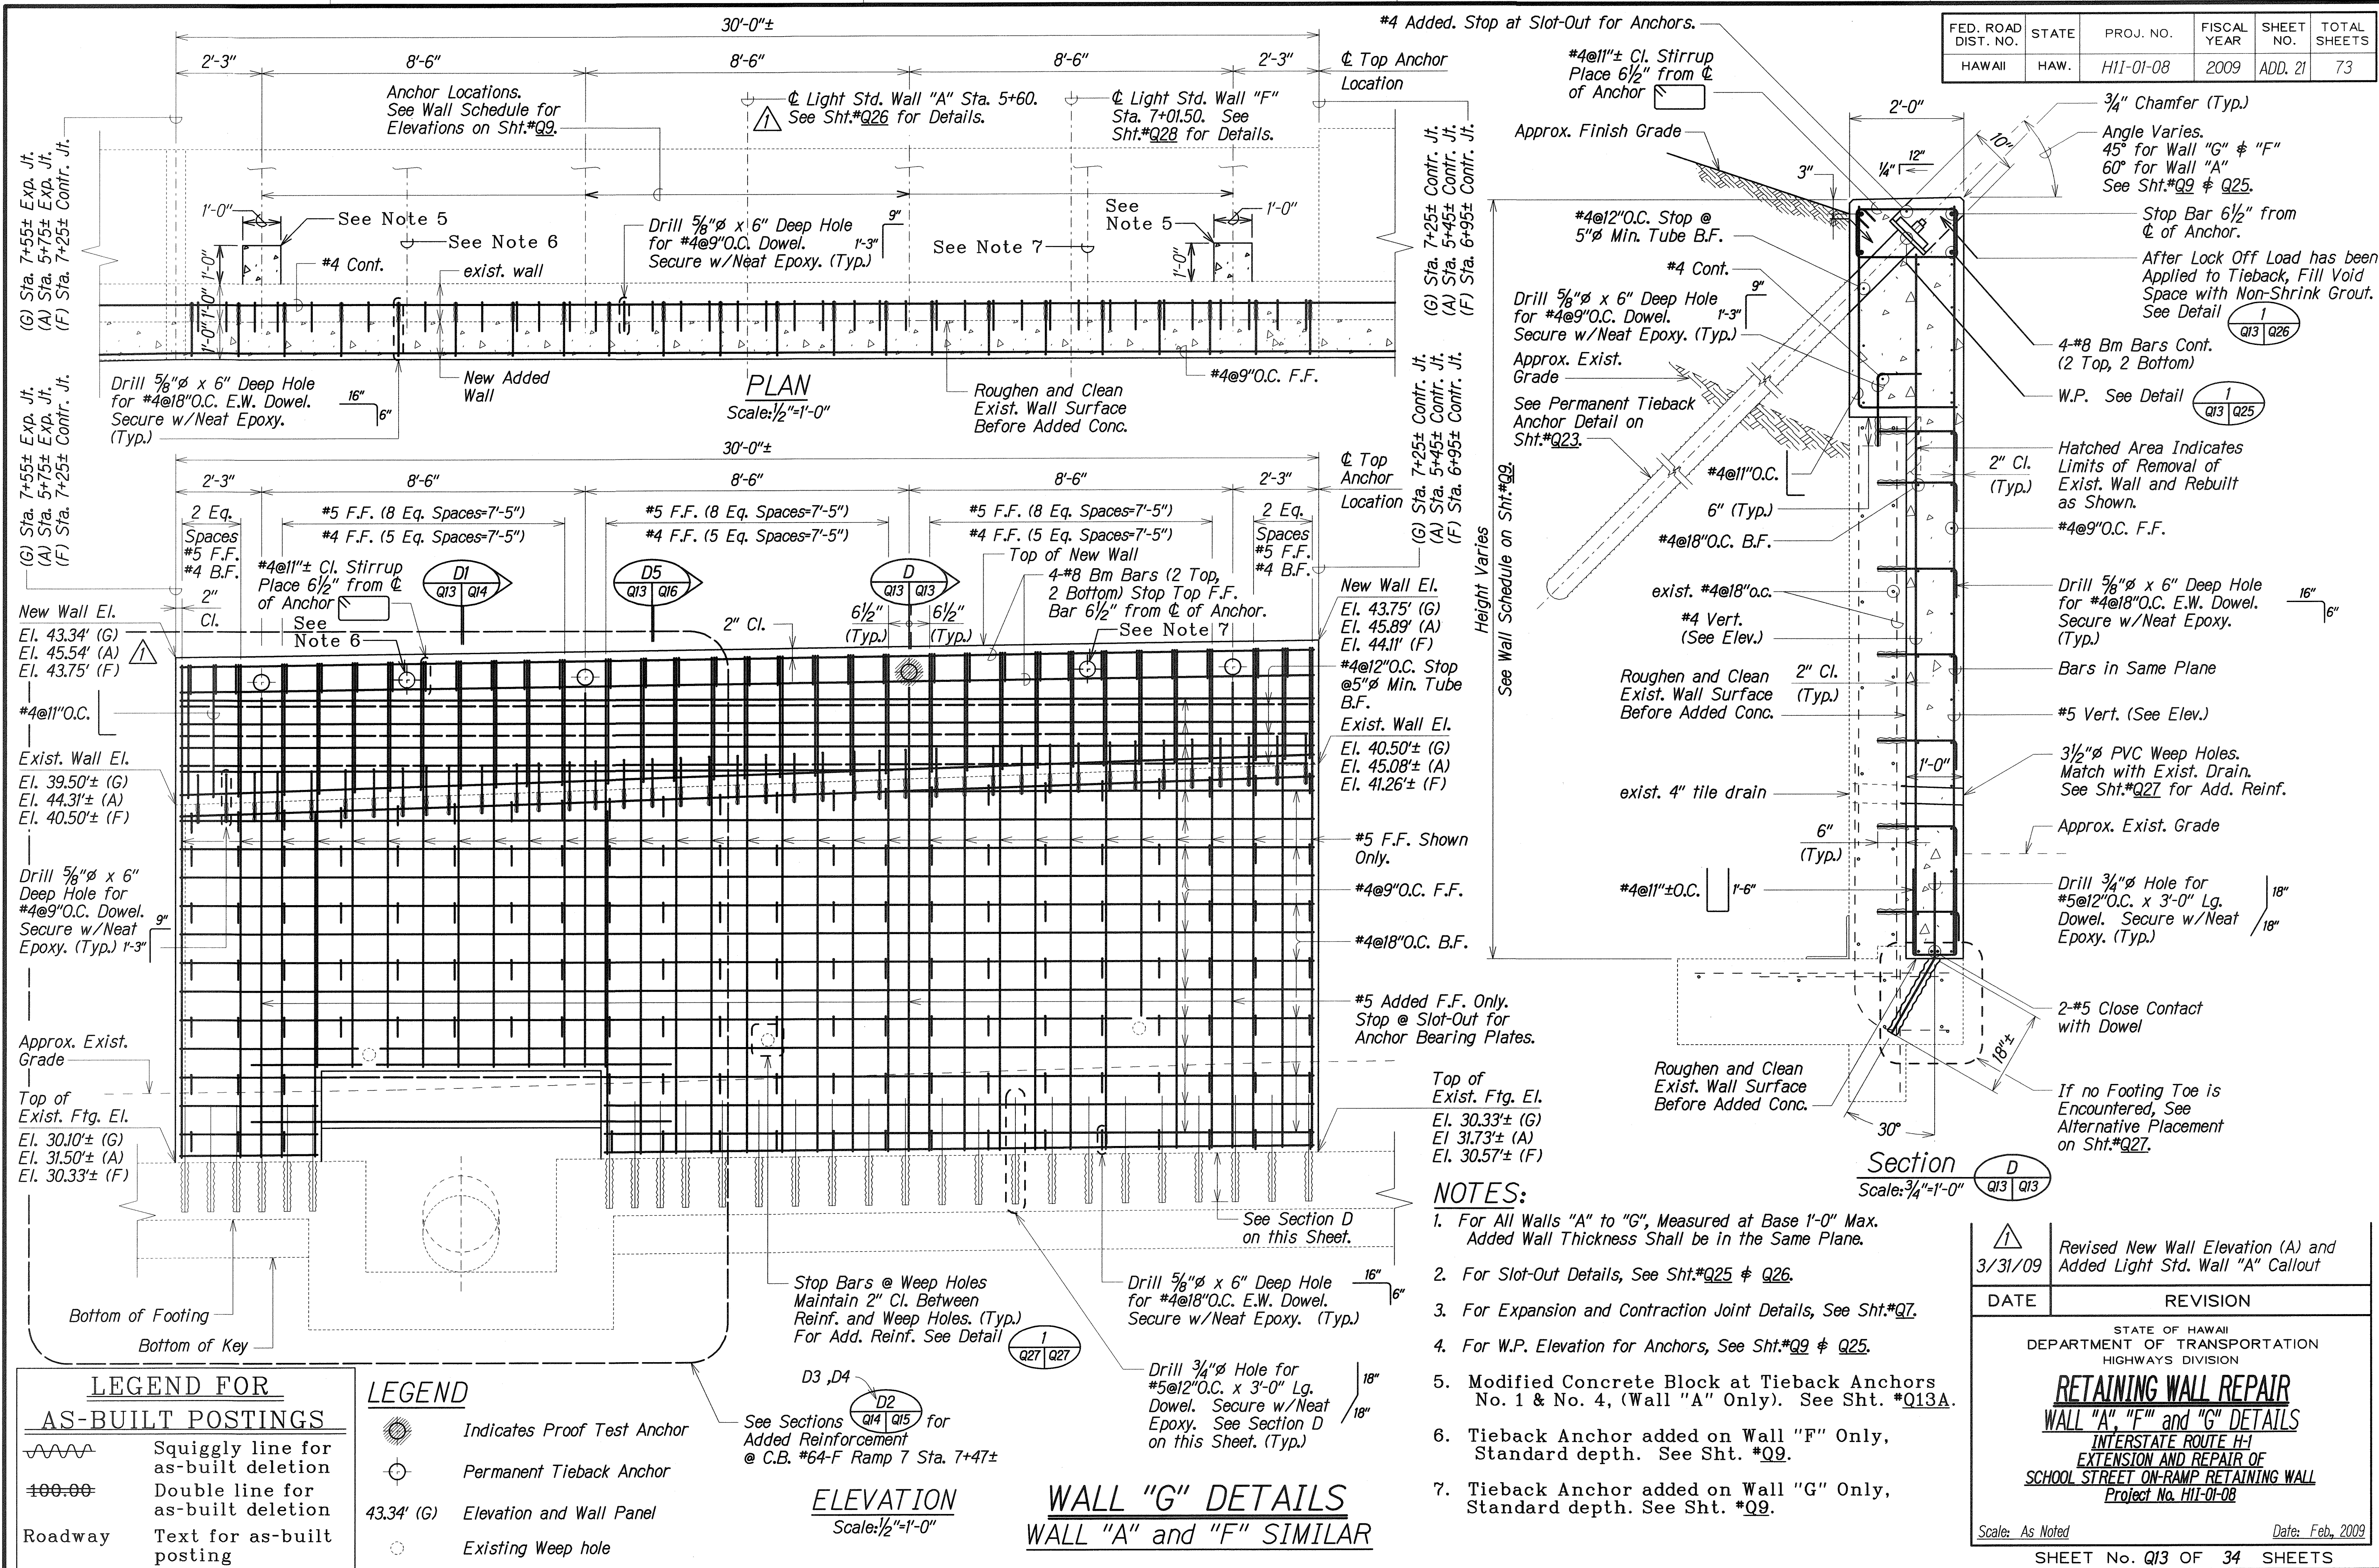


"AS-BUILT"


ADD. 21

FED. ROAD DIST. NO.	STATE	PROJ. NO.	FISCAL YEAR	SHEET NO.	TOTAL SHEETS
HAWAII	HAW.	H11-01-08	2009		73

C.O. ADD. 21 S-1

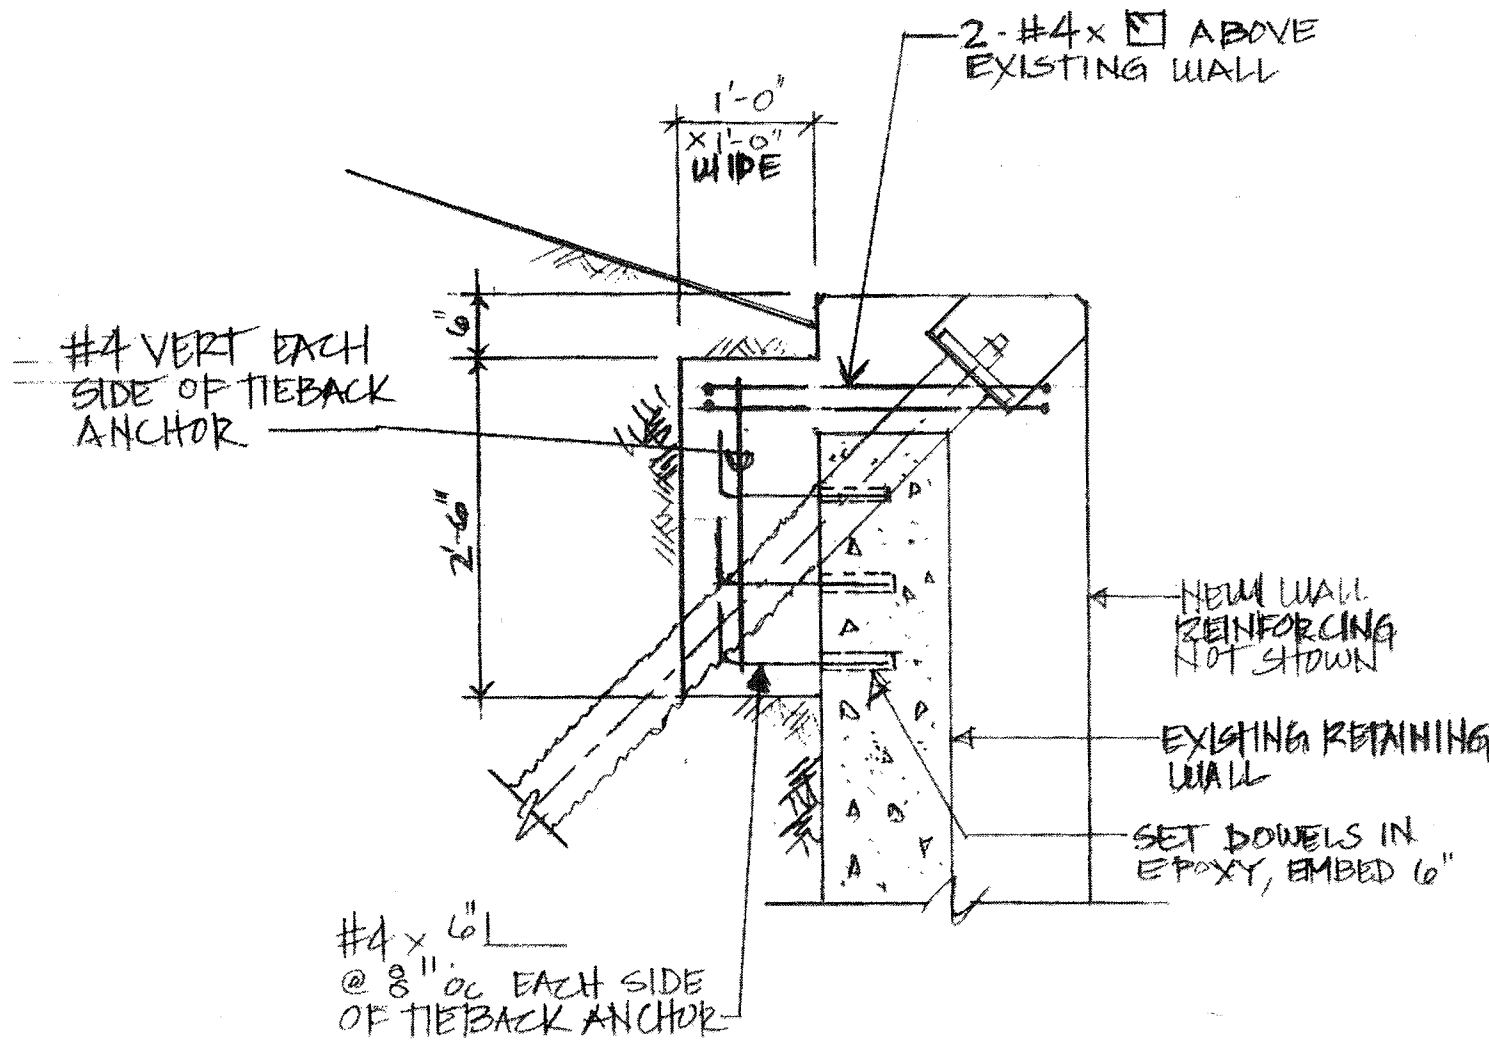

WALL PANEL "A"
ADDED CONCRETE BLOCK at
TIEBACK ANCHOR (2 LOCATIONS)
RETAINING WALL SHORING Scale: N.T.S.
INTERSTATE ROUTE H-1
EXTENSION and REPAIR of SCHOOL STREET
ON-RAMP RETAINING WALL
PROJECT No. H11-01-08

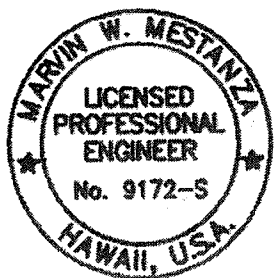

Expires April 30, 2010

Marvin W. Mantanza

THIS WORK WAS PREPARED BY
ME OR UNDER MY SUPERVISION

SEPTEMBER 15, 2009

Note: This tracing prepared during "As-Built" posting.

LEGEND FOR AS-BUILT POSTINGS	
	Squiggly line for as-built deletion
	Double line for as-built deletion
Roadway	Text for as-built posting


STATE OF HAWAII DEPARTMENT OF TRANSPORTATION HIGHWAYS DIVISION	
RETAINING WALL REPAIR	
WALL "A" DETAIL	
ADDED CONCRETE BLOCK AT TIEBACK ANCHOR	
INTERSTATE ROUTE H-1	
EXTENSION AND REPAIR OF	
SCHOOL STREET ON-RAMP RETAINING WALL	
Project No. H11-01-08	
Scale: As Noted	Date: Feb., 2009

SHEET No. Q13A OF 34 SHEETS


"AS-BUILT"

C.O. ADD. 21 S-1

FED. ROAD DIST. NO.	STATE	PROJ. NO.	FISCAL YEAR	SHEET NO.	TOTAL SHEETS
HAWAII	HAW.	H11-01-08	2009	ADD. 22	73

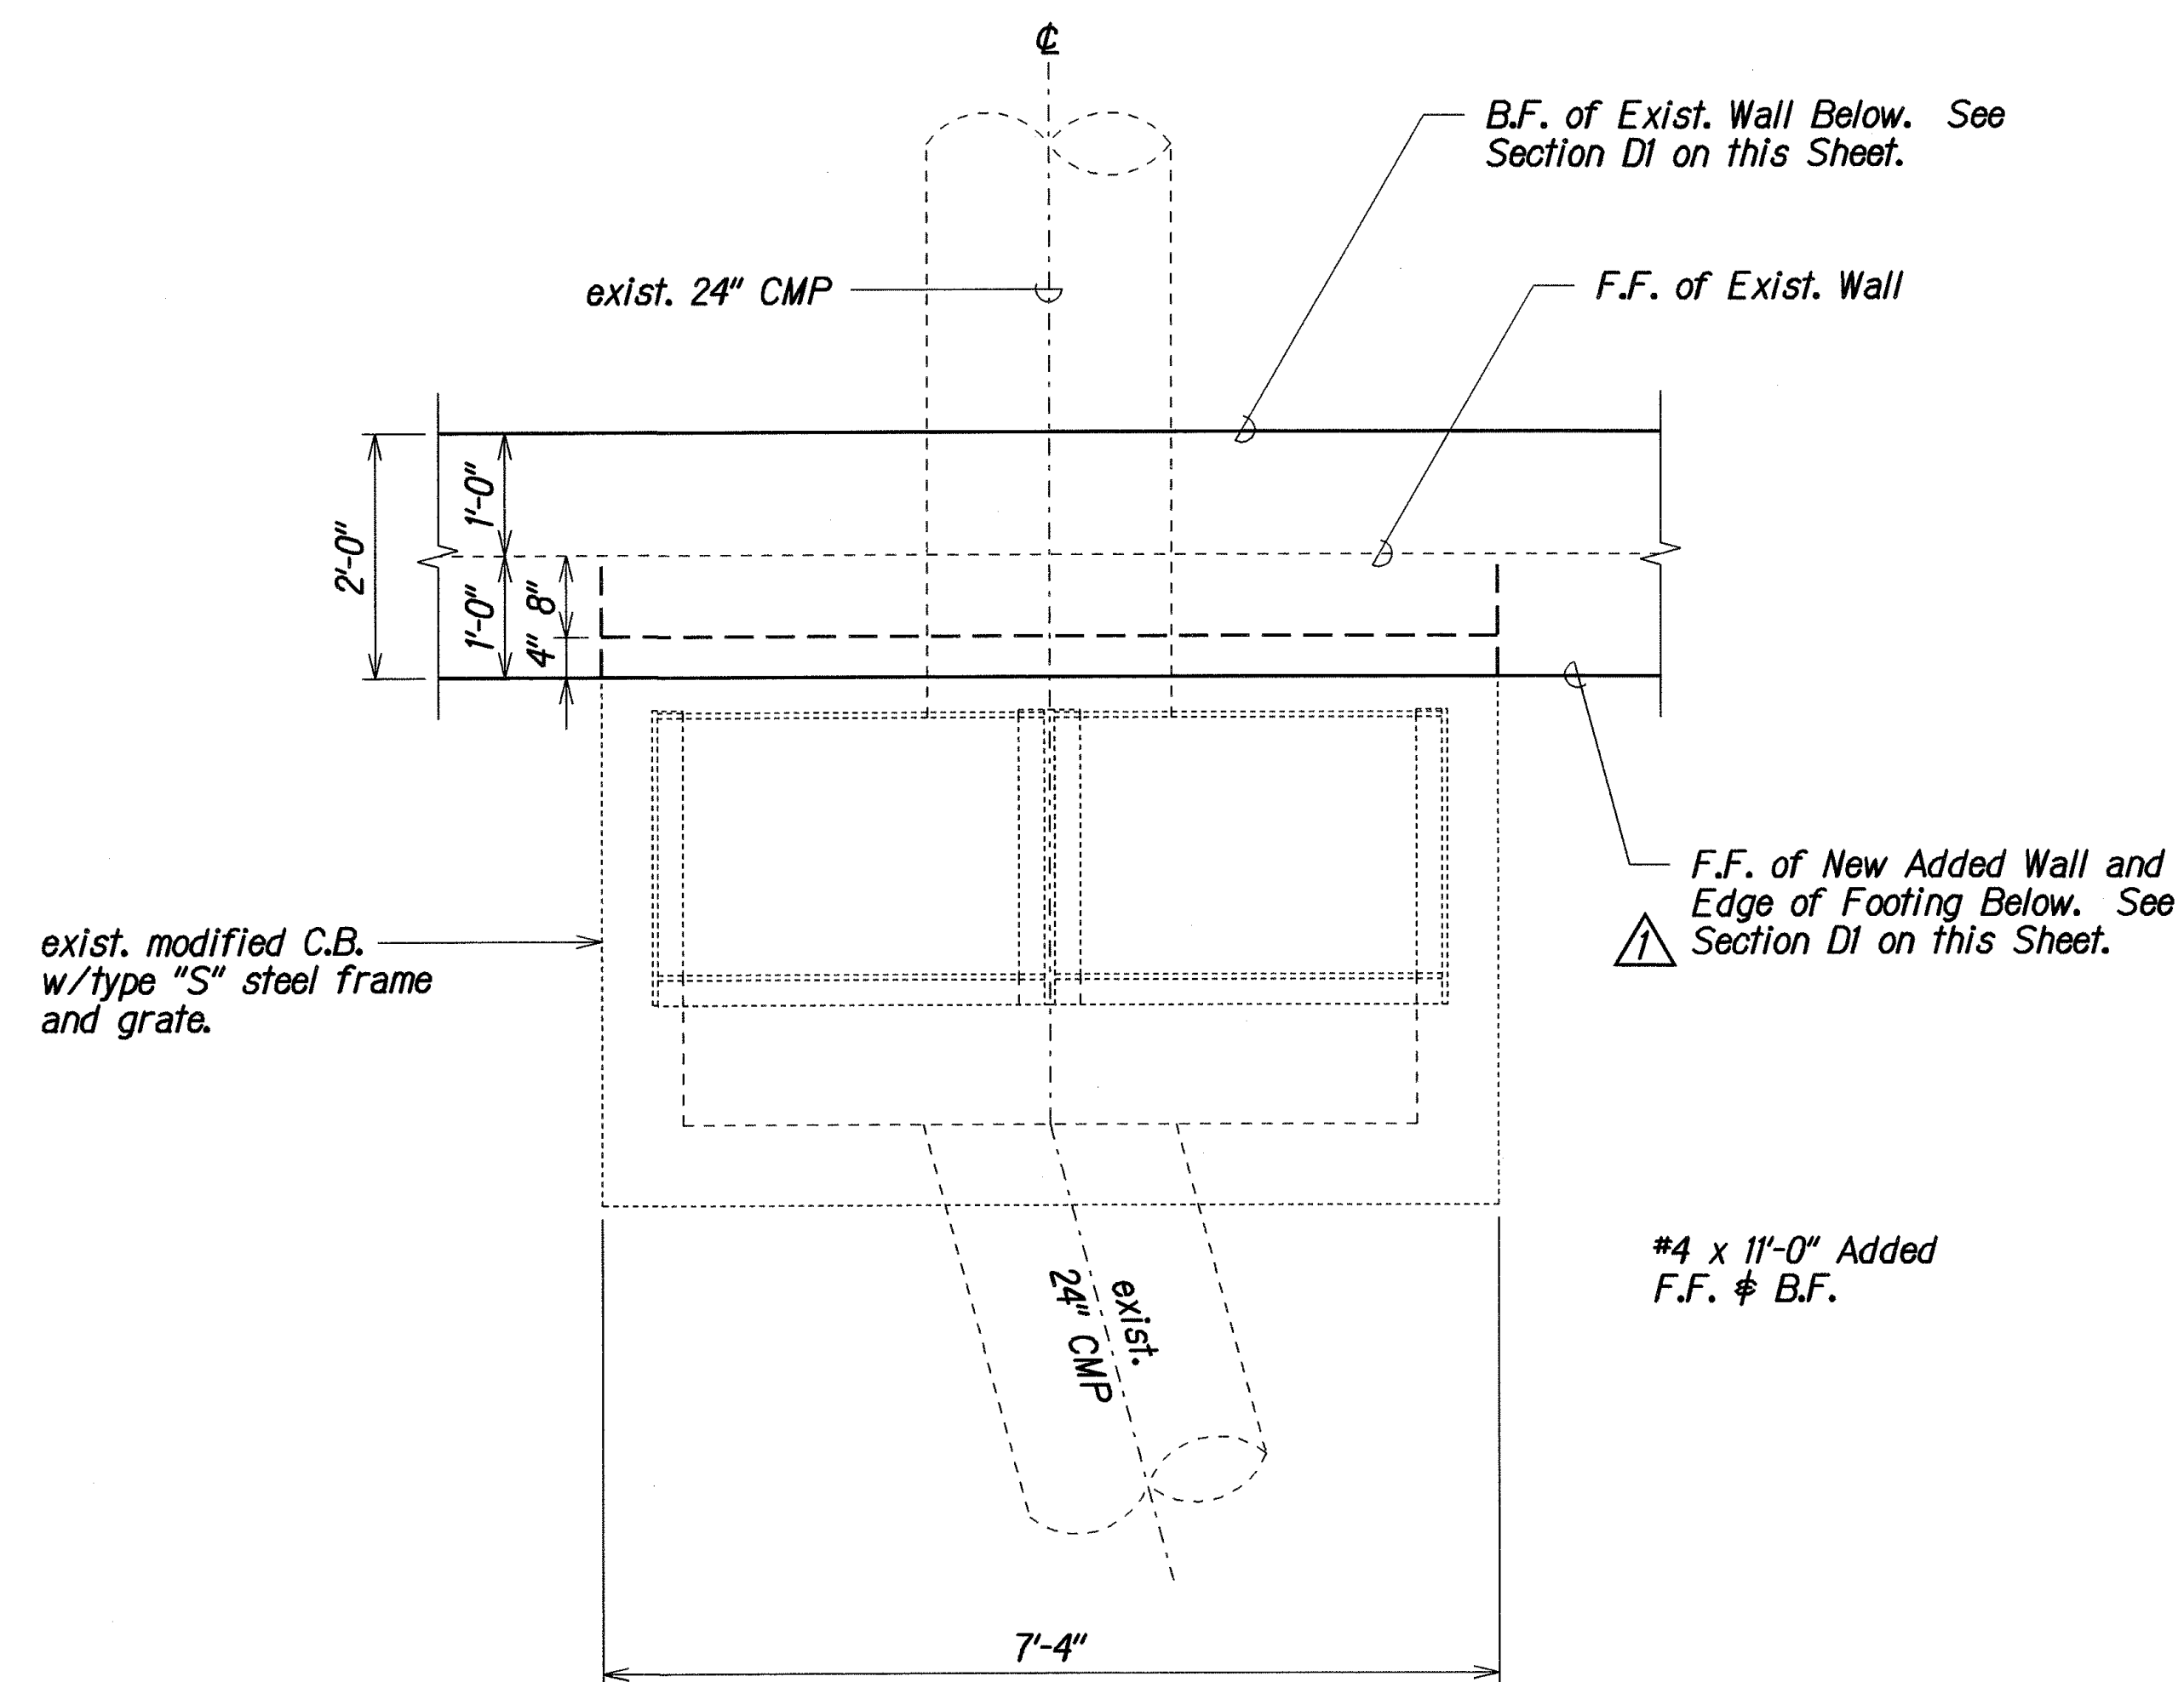

PLAN
Scale: 3/4"=1'-0"

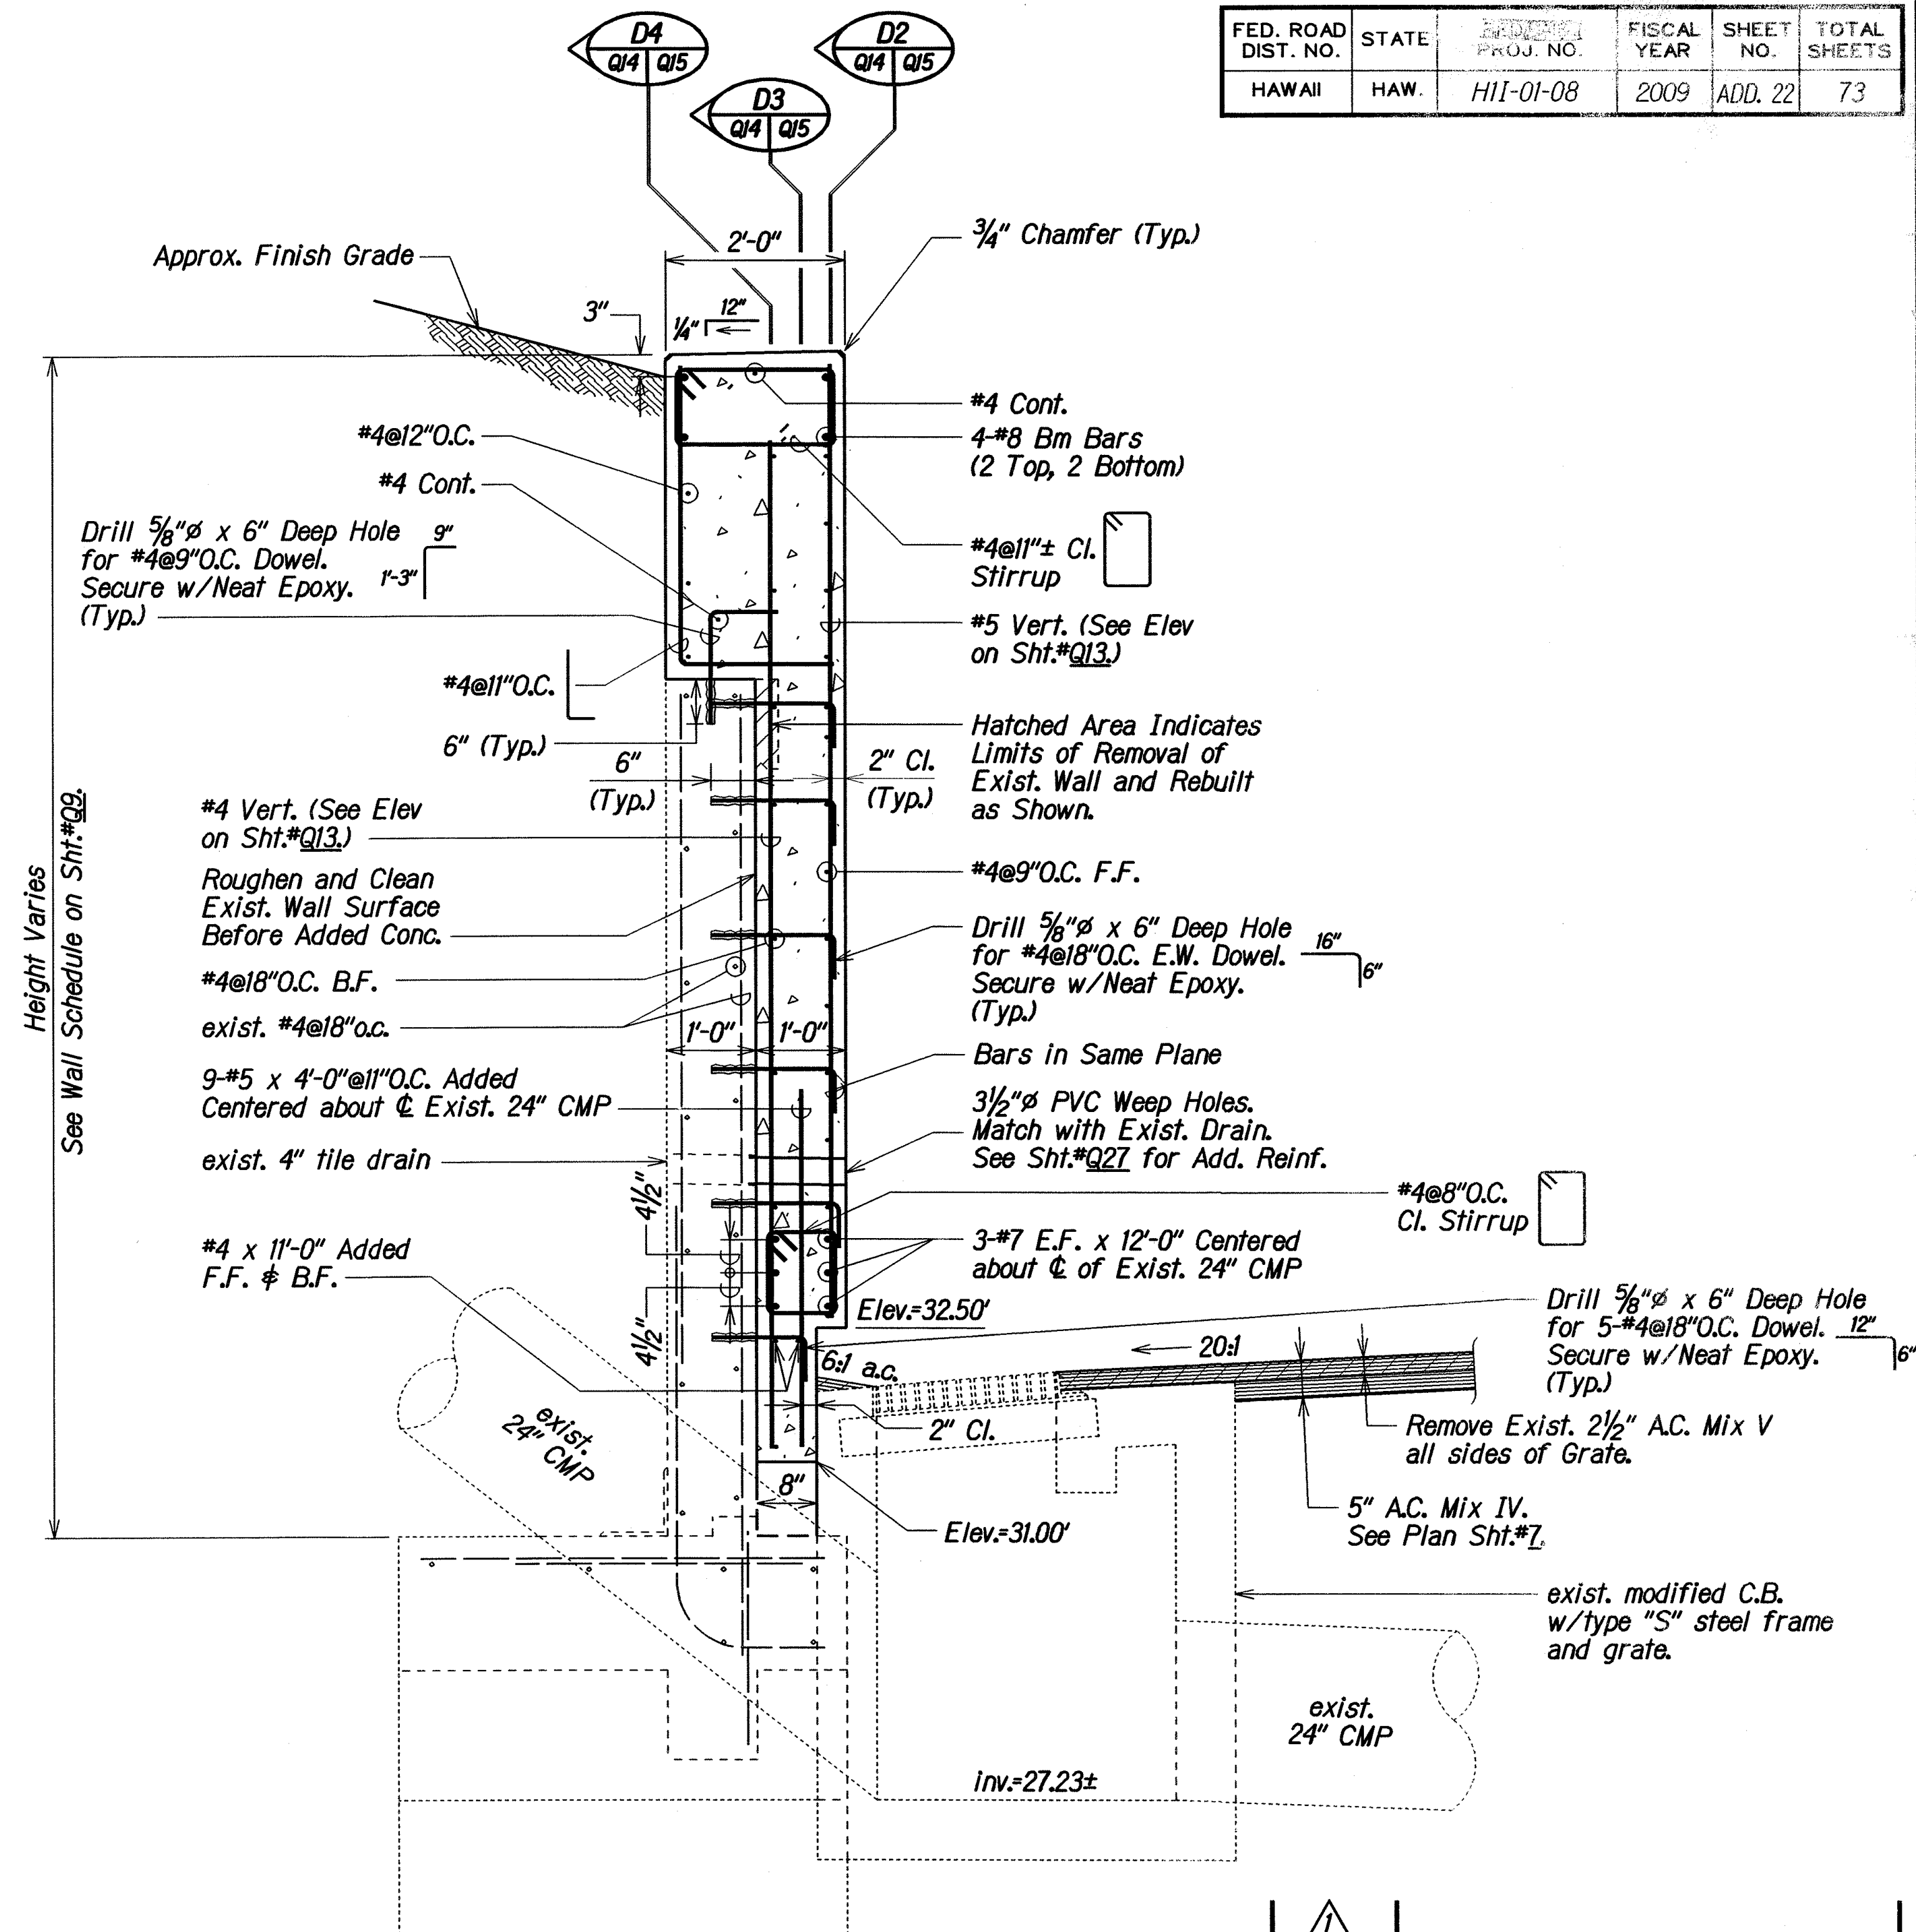

SECTION DI
Scale: 3/4"=1'-0"
Q6


WALL "G" AT MODIFIED C.B.#64-F - RAMP 7 & STA. 7+47±

3/31/09	Revised Section Designation
DATE	REVISION
STATE OF HAWAII DEPARTMENT OF TRANSPORTATION HIGHWAYS DIVISION RETAINING WALL REPAIR WALL "G" AT MODIFIED C.B. #64-F PLAN AND SECTION INTERSTATE ROUTE H1 EXTENSION AND REPAIR OF SCHOOL STREET ON-RAMP RETAINING WALL Project No. H11-01-08 Scale: As Noted Date: Feb. 2009	
SHEET No. Q14 OF 34 SHEETS	

ADD. 22

ORIGINAL PLAN	DATE
DESIGNED BY	XXX 2008
CHECKED BY	XXX 2008
NOTED BY	XXX 2008
QUANTITIES BY	XXX 2008
CHECKED BY	XXX 2008

FED. ROAD DIST. NO.	STATE	FED. AID PROJ. NO.	FISCAL YEAR	SHEET NO.	TOTAL SHEETS
HAWAII	HAW.	H11-01-08	2009	24	73

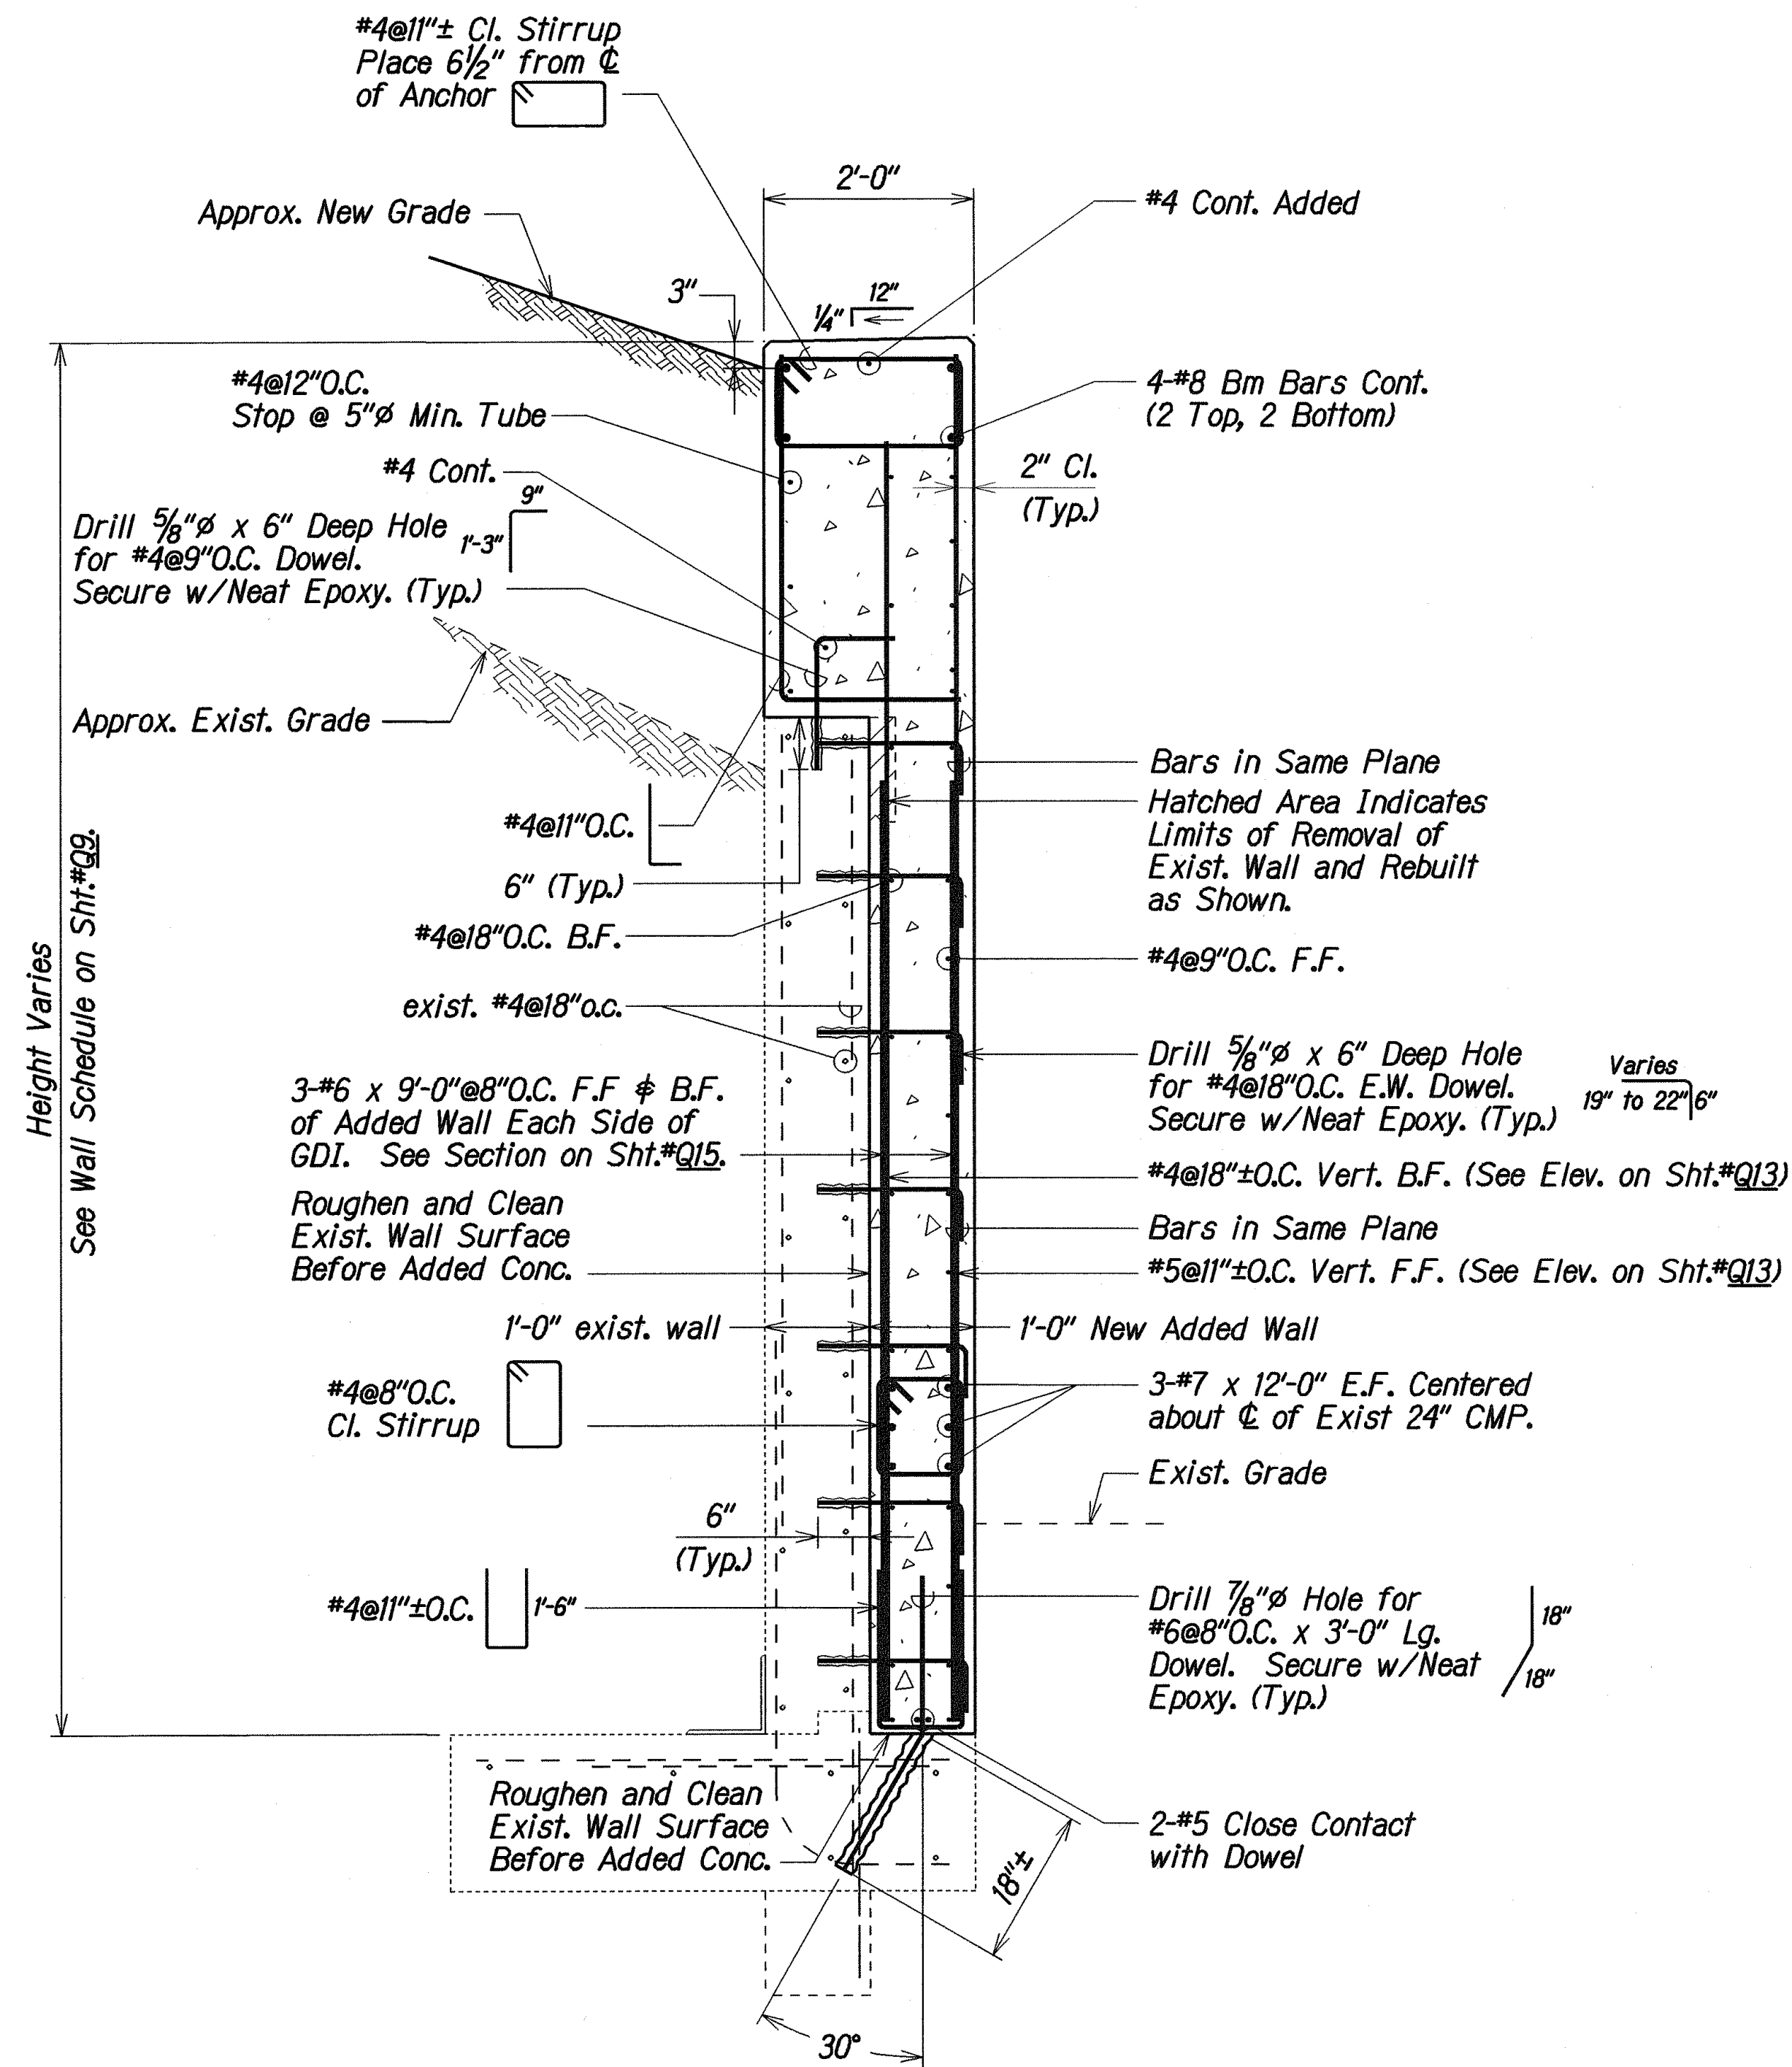

(Wall "G" at Sta. 7+42.50±)

SECTION D5
Scale: 3/4"=1'-0" Q13 Q16

ORIGINAL PLAN	DATE
DESIGNED BY	XXX 2008
TRACED BY	XXX 2008
NOTED BY	XXX 2008
CHECKED BY	XXX 2008

STATE OF HAWAII
DEPARTMENT OF TRANSPORTATION
HIGHWAYS DIVISION

RETAINING WALL REPAIR
SECTION D5
INTERSTATE ROUTE H-1
EXTENSION AND REPAIR OF
SCHOOL STREET ON-RAMP RETAINING WALL
Project No. H11-01-08


Scale: As Noted Date: Feb. 2009

SHEET No. Q16 OF 34 SHEETS


FED. ROAD DIST. NO.	STATE	PROJ. NO.	FISCAL YEAR	SHEET NO.	TOTAL SHEETS
HAWAII	HAW.	H11-01-08	2009	ADD. 25	73

LEGEND FOR AS-BUILT POSTINGS

Squiggly line for as-built deletion
 Double line for as-built deletion
 Roadway Text for as-built posting

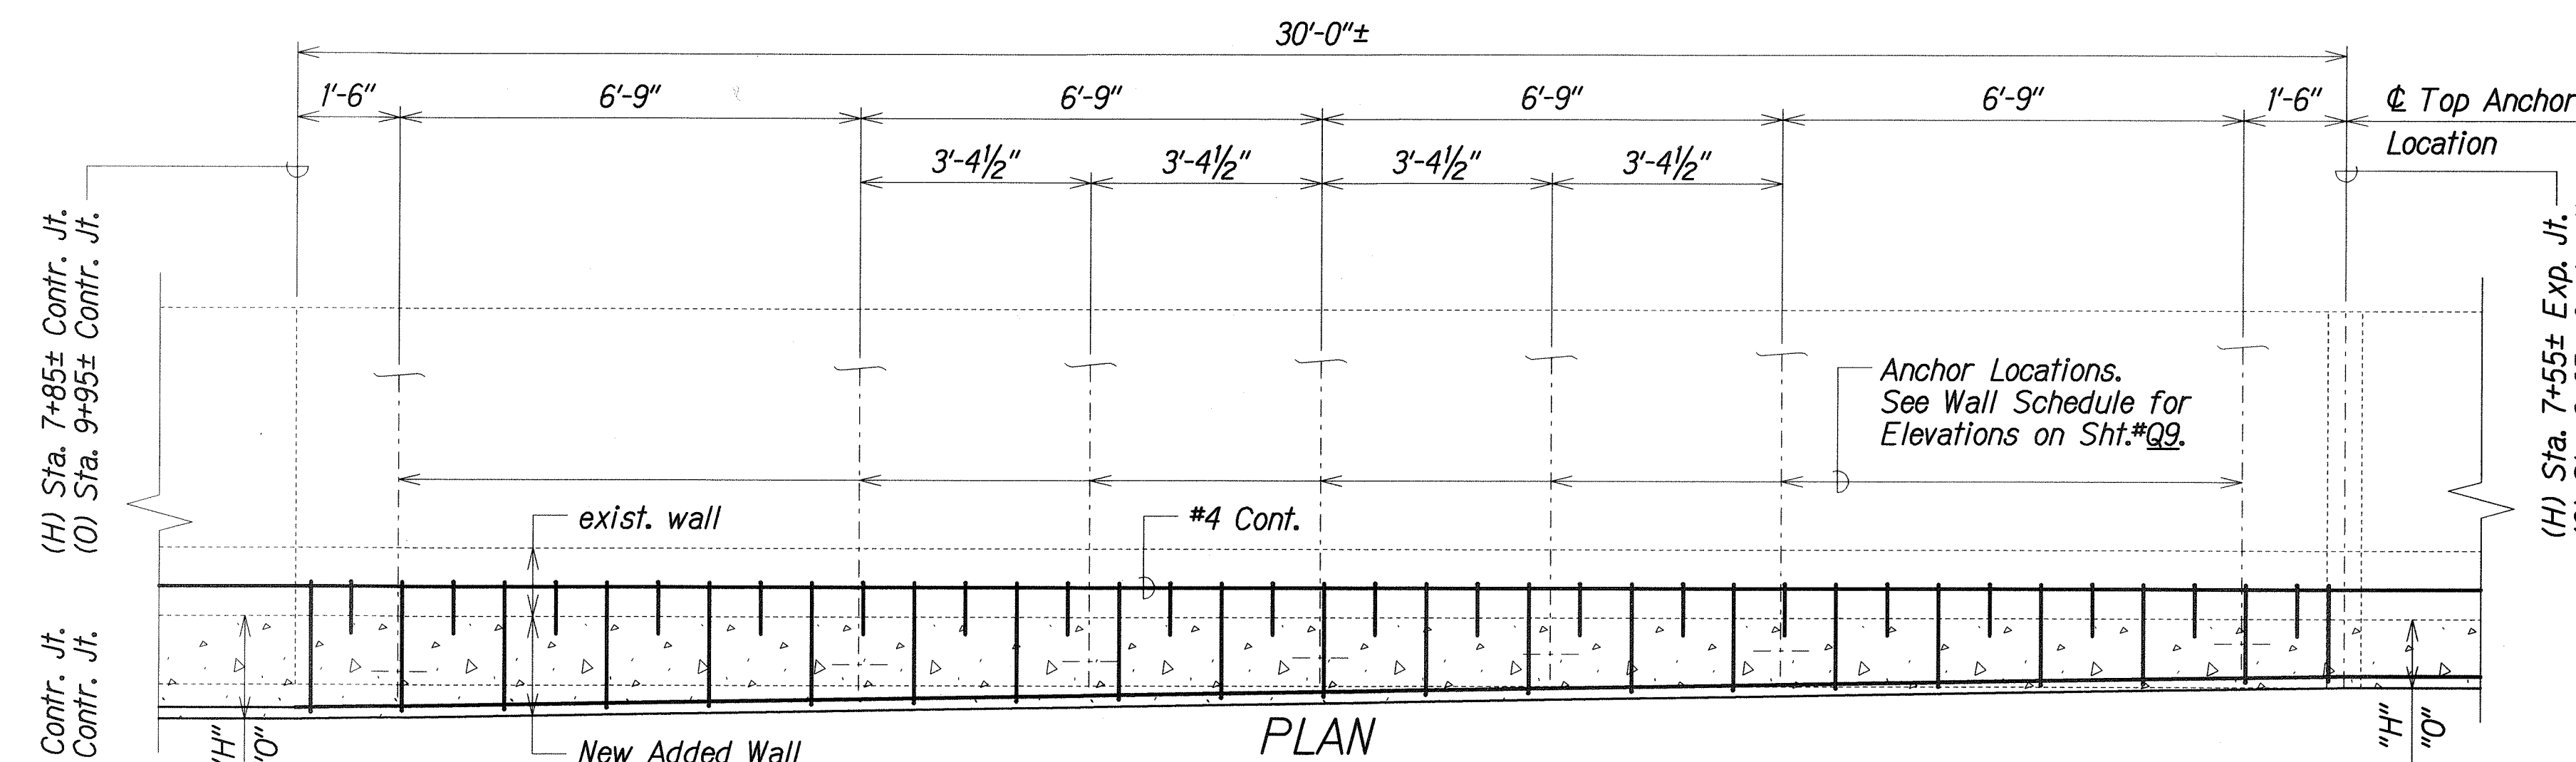

PLAN
Scale: 1/2"=1'-0"

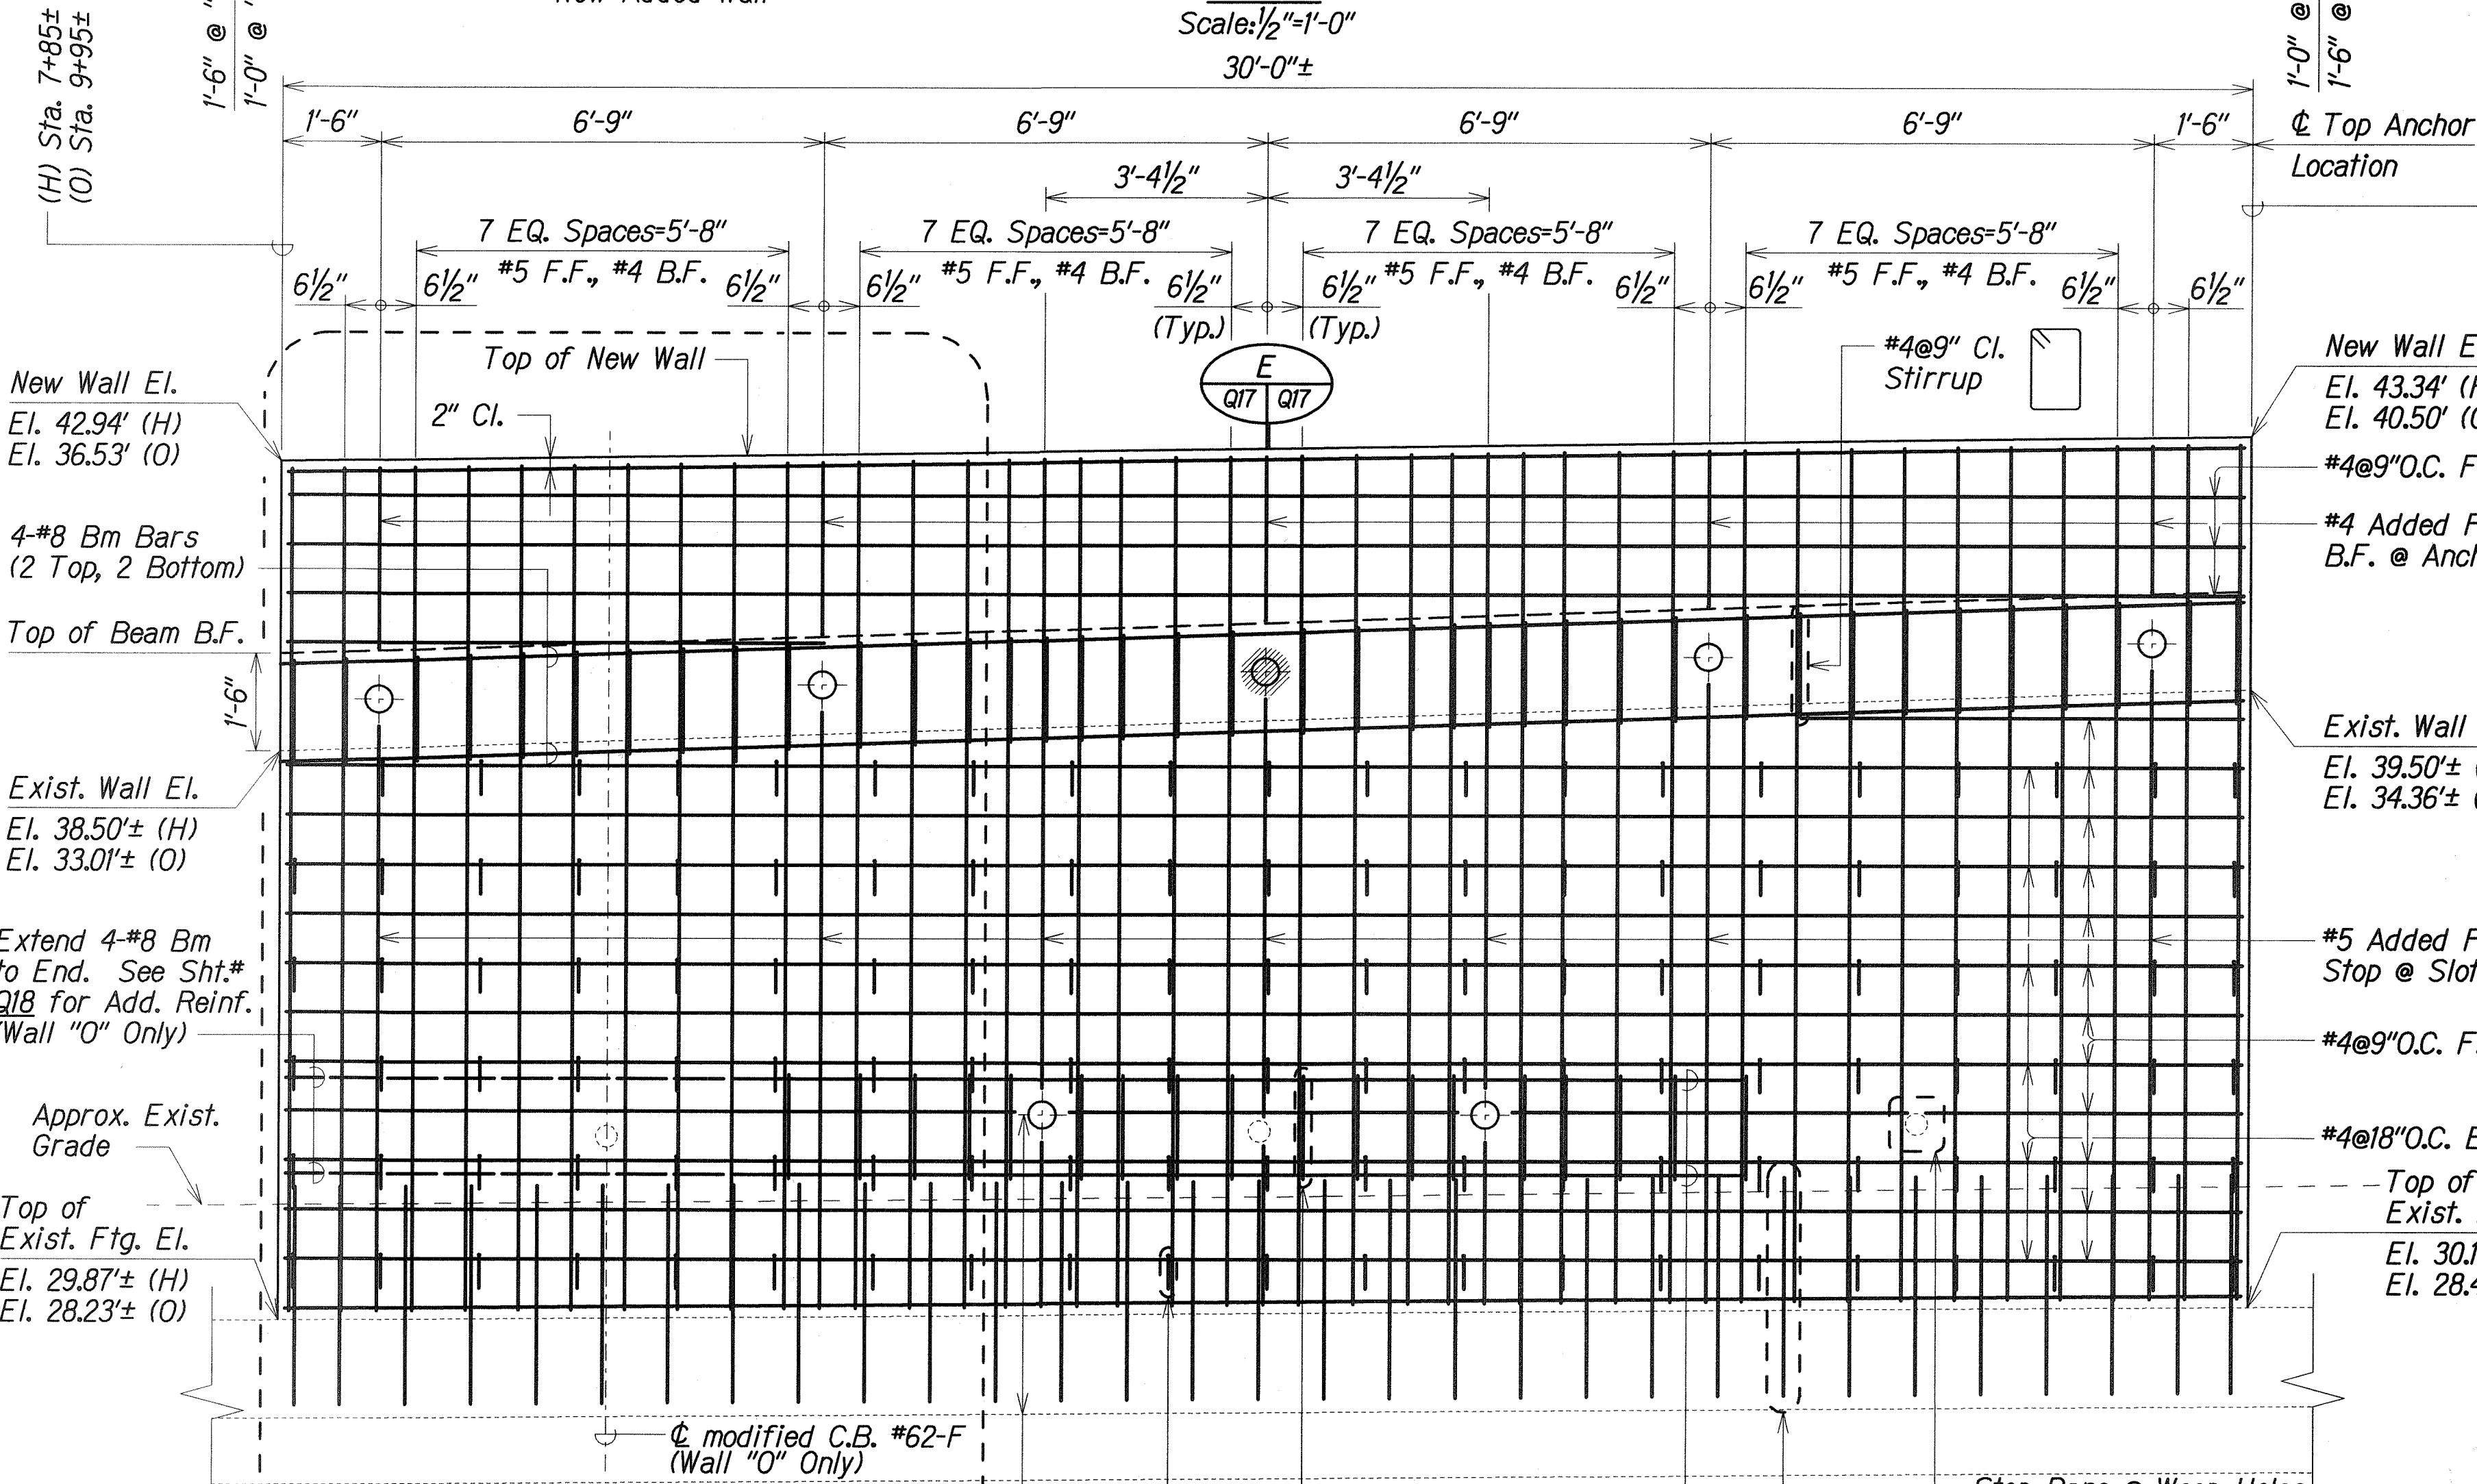

LEGEND

- Indicates Proof Test Anchor
- Permanent Tieback Anchor
- Existing Weep hole
- 43.34' (G) Elevation and Designated Wall Panel

ELEVATION
Scale: 1/2"=1'-0"


WALL "H" DETAILS WALL "O" SIMILAR EXCEPT AS NOTED

NOTES:

- For Slot-Out Details, See Sht.#Q25 & Q26.
- of All Lower Anchors from Horizontal Shall be 20°.
- For Expansion & Contraction Joint Details, See Sht.#Q1.
- For W.P. Elevations for Anchor, See Sht.#Q9 & Q25.
- Refer to Sht.#Q18 for Additional Reinf. at Exist. Modified C.B. #62-F.

DATE	REVISION
3/31/09	Revised Detail Designation

SECTION Scale: 3/4"=1'-0"

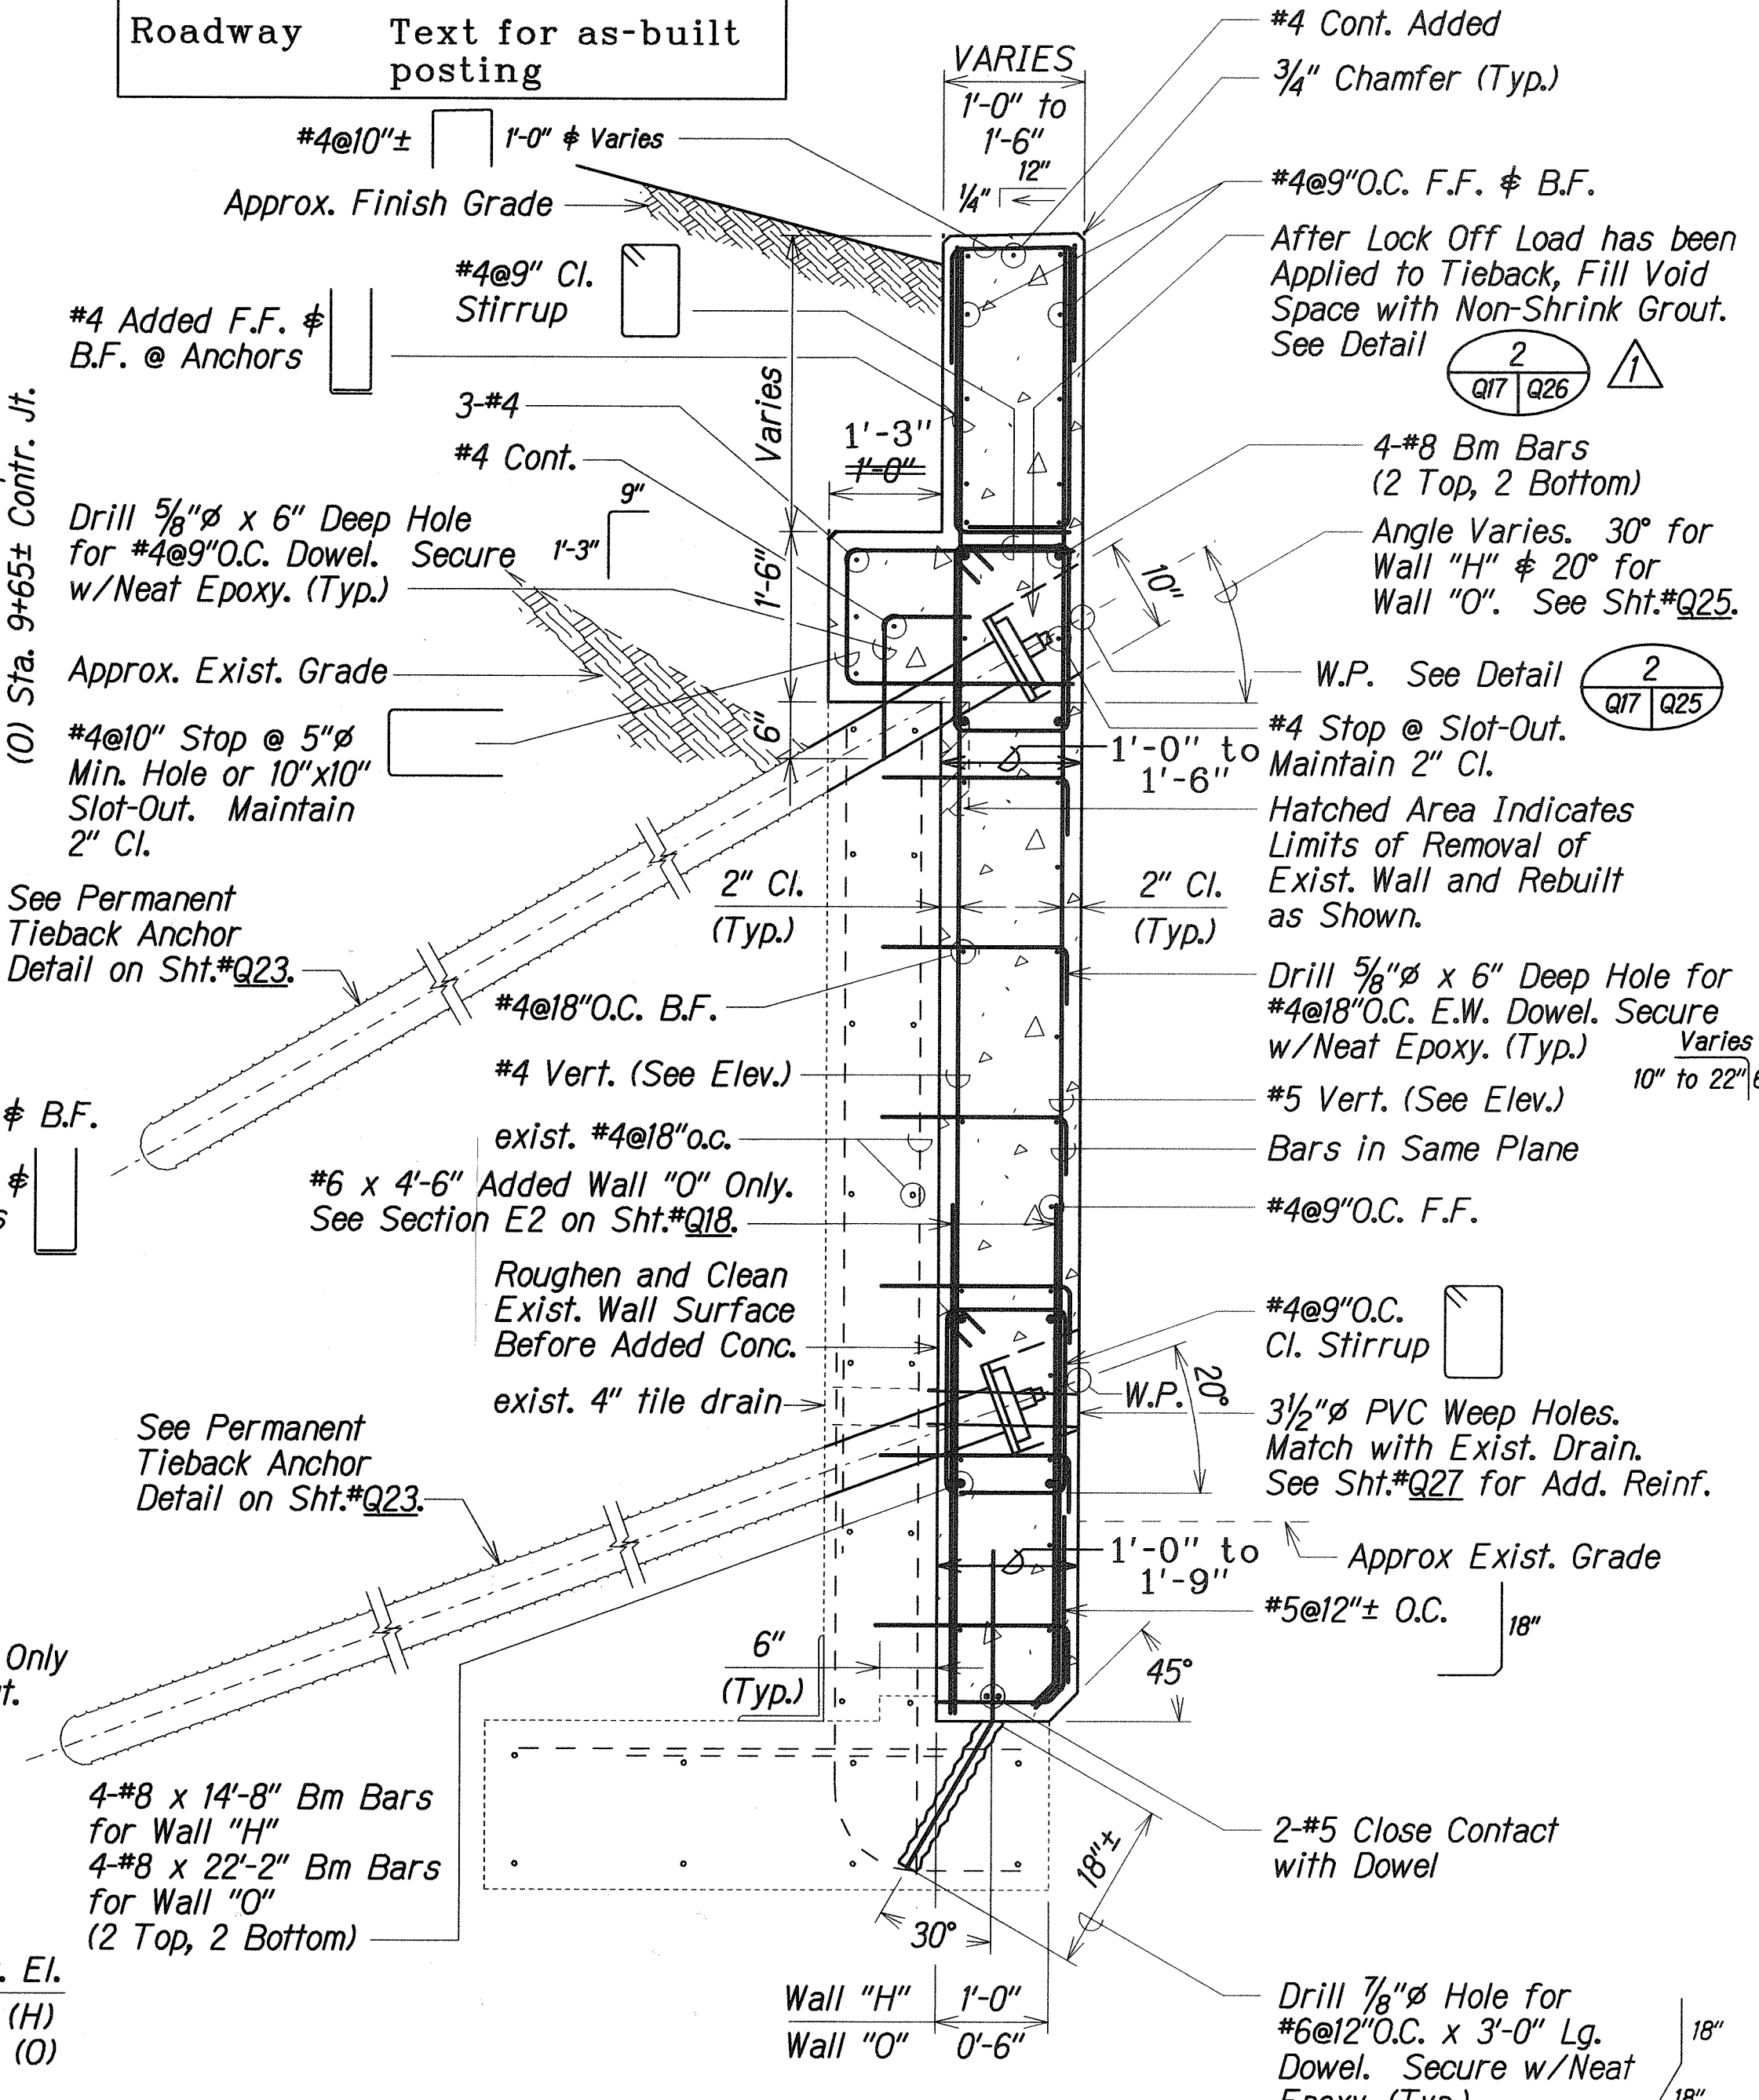

STATE OF HAWAII
 DEPARTMENT OF TRANSPORTATION
 HIGHWAYS DIVISION
RETAINING WALL REPAIR
 WALL "H" & "O" DETAILS
 INTERSTATE ROUTE H-1
 EXTENSION AND REPAIR OF
 SCHOOL STREET ON-RAMP RETAINING WALL
 Project No. H11-01-08

Scale: As Noted
 Date: Feb. 2009
 SHEET No. Q17 OF 34 SHEETS


"AS-BUILT"

ADD. 25

Drill $\frac{3}{4}" \phi$ x 15" Deep Hole
for 9-#5@12"O.C. Dowel.
Secure w/Neat Epoxy. (Typ.)

B.F. of New Added Wall and
B.F. of Exist. Wall Below. See
Section E1 on this Sheet.

B.F. of New Added Wall and
F.F. of Exist. Wall Below. See
Section E1 on this Sheet.

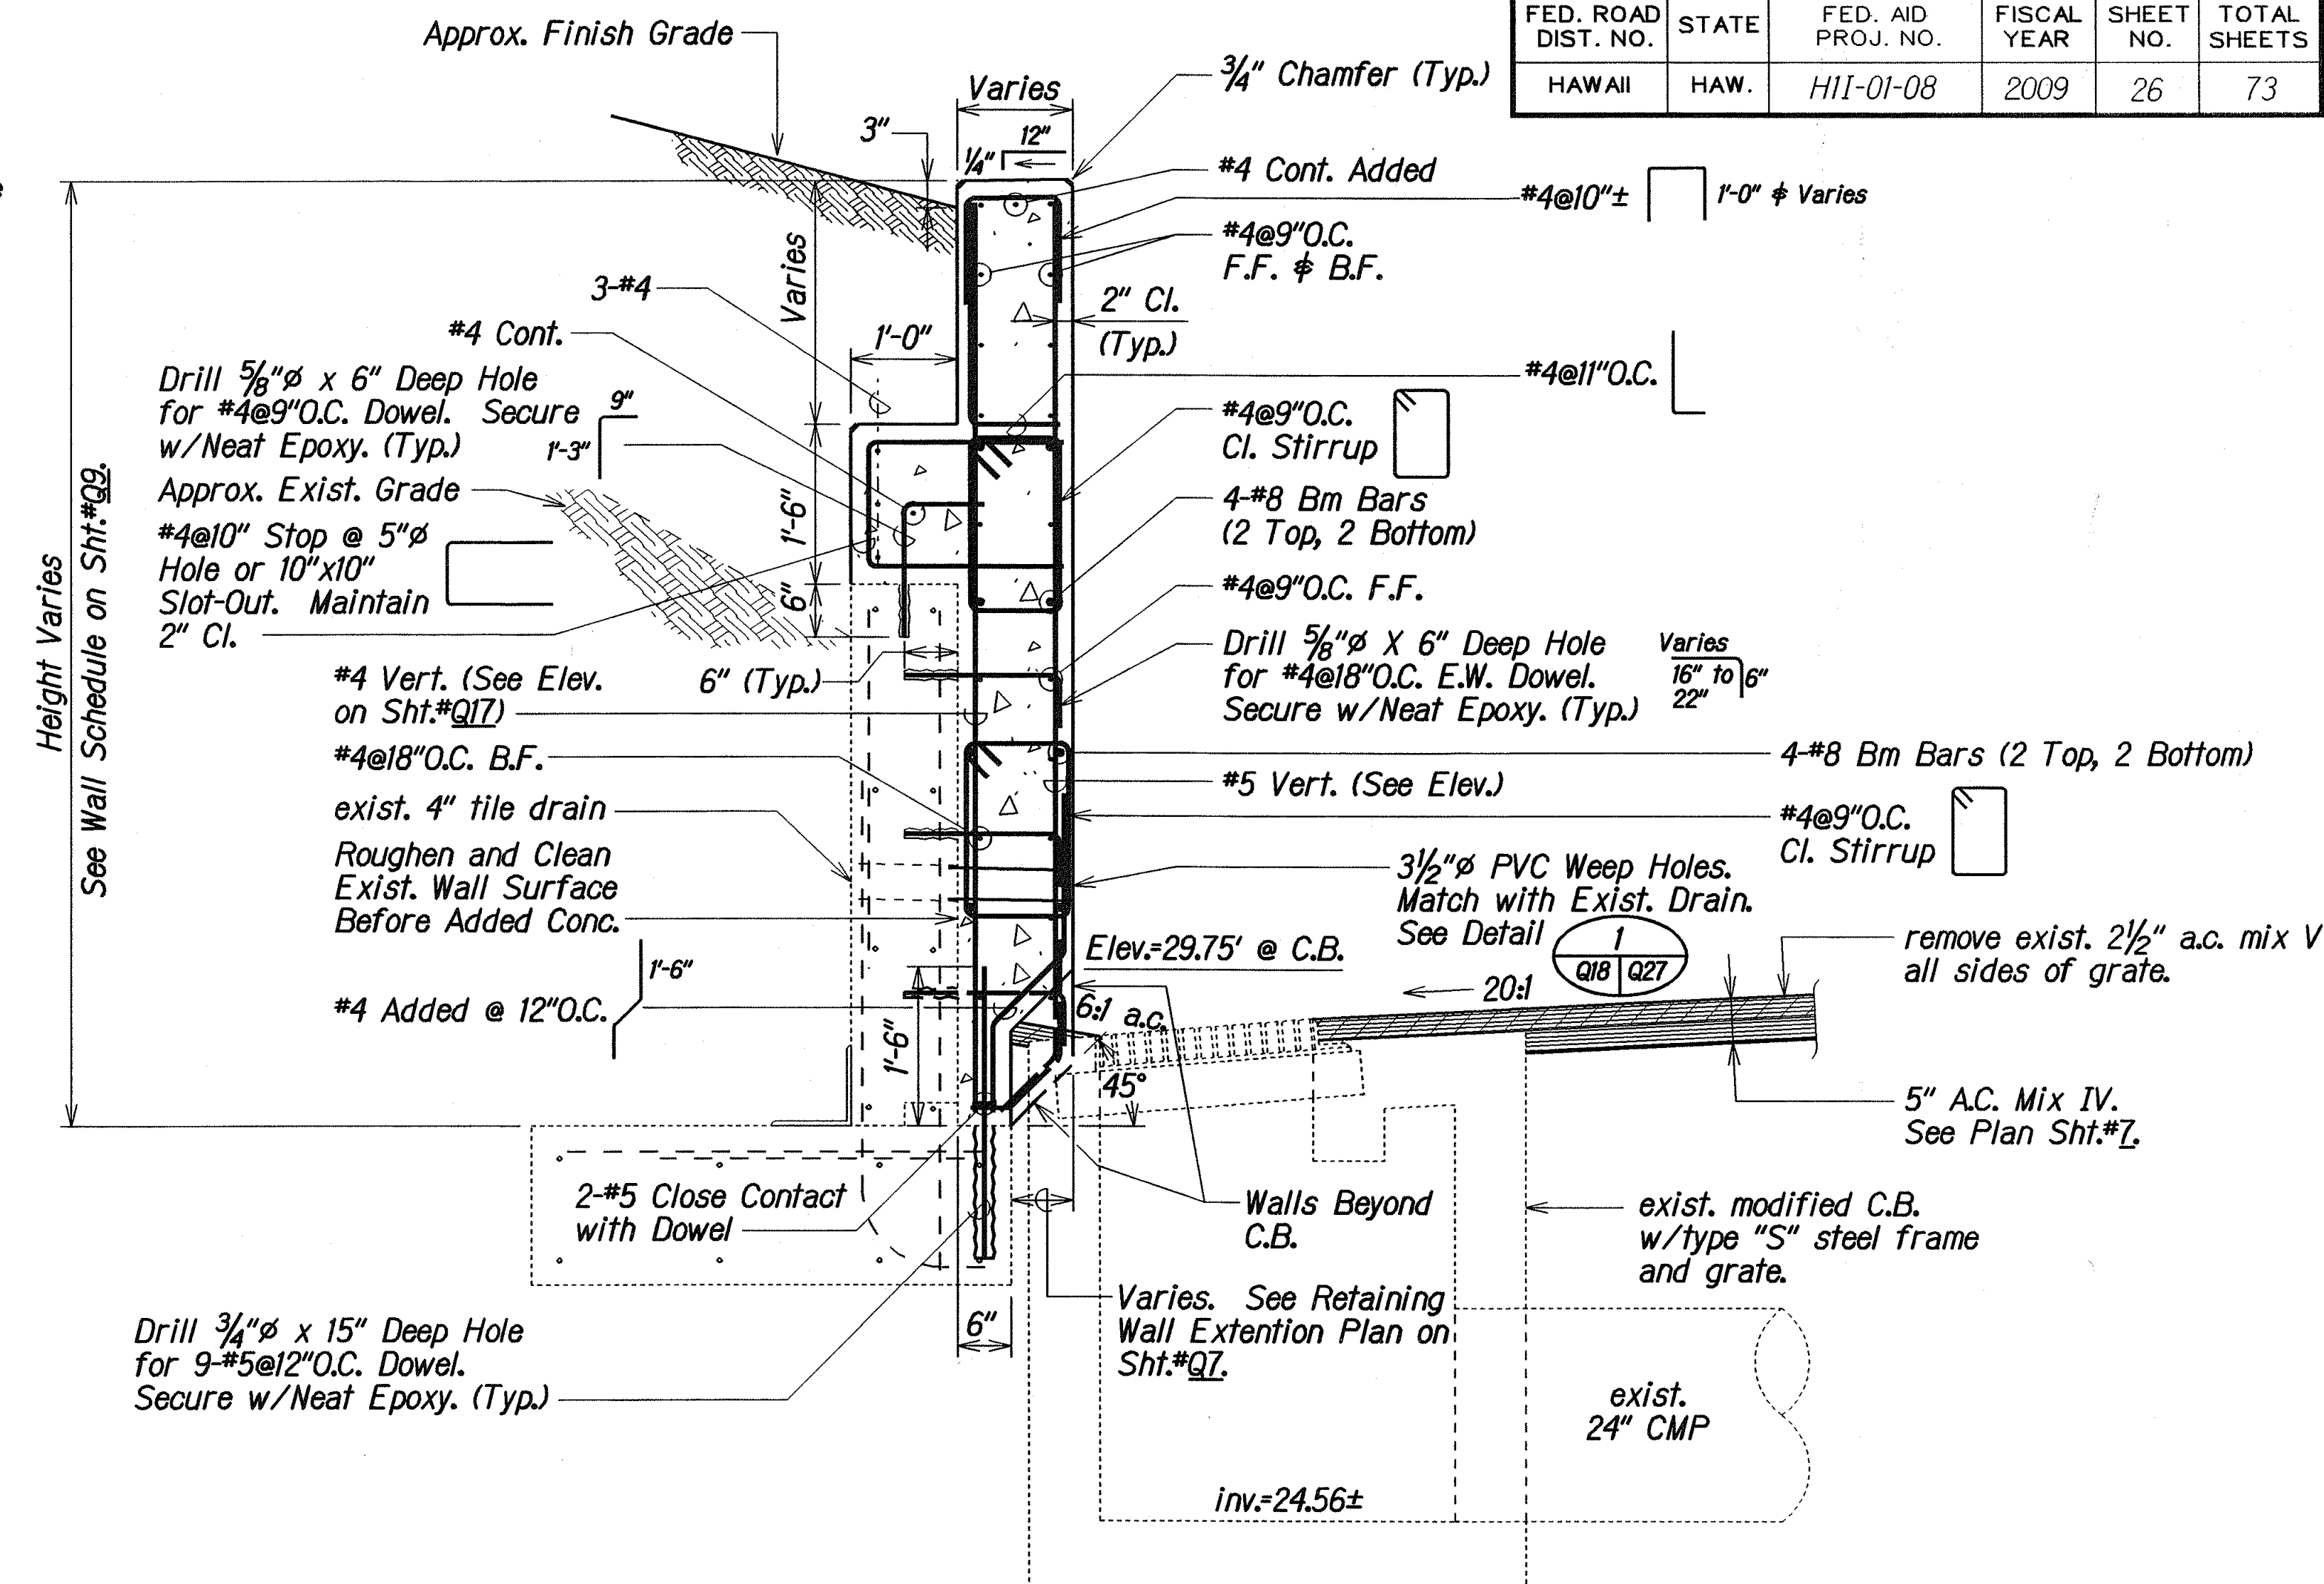

Extend 4-#8 Bm Bars to End.
(2 Top, 2 Bottom)

#6 x 4'-6" Added
F.F. # B.F. of Added
Wall. Each side of C.B.
Bundled to #5 F.F. #
#4 B.F.

2-#5 Close Contact
with Dowel

Top of Exist. Ftg.

Bottom of Exist. Ftg.

C exist. modified
C.B. #62-F
@ Sta. 9+90±

#4@9"O.C.
Cl. Stirrup

SECTION **E2**
Q18 Q18
Scale: 3/4"=1'-0"

WALL


STATE OF HAWAII
DEPARTMENT OF TRANSPORTATION
HIGHWAYS DIVISION

RETAINING WALL REPAIR
WALL "O" AT MODIFIED C.B. #62-F
PLAN, PARTIAL ELEVATION AND SECTION
INTERSTATE ROUTE H-1
EXTENSION AND REPAIR OF
SCHOOL STREET ON-RAMP RETAINING WALL
Project No. H11-01-08


Scale: As Noted Date: Feb., 20

SHEET No. 018 OF 34 SHEETS

FED. ROAD DIST. NO.	STATE	PROJ. NO.	FISCAL YEAR	SHEET NO.	TOTAL SHEETS
HAWAII	HAW.	H11-01-08	2009	ADD. 27	73

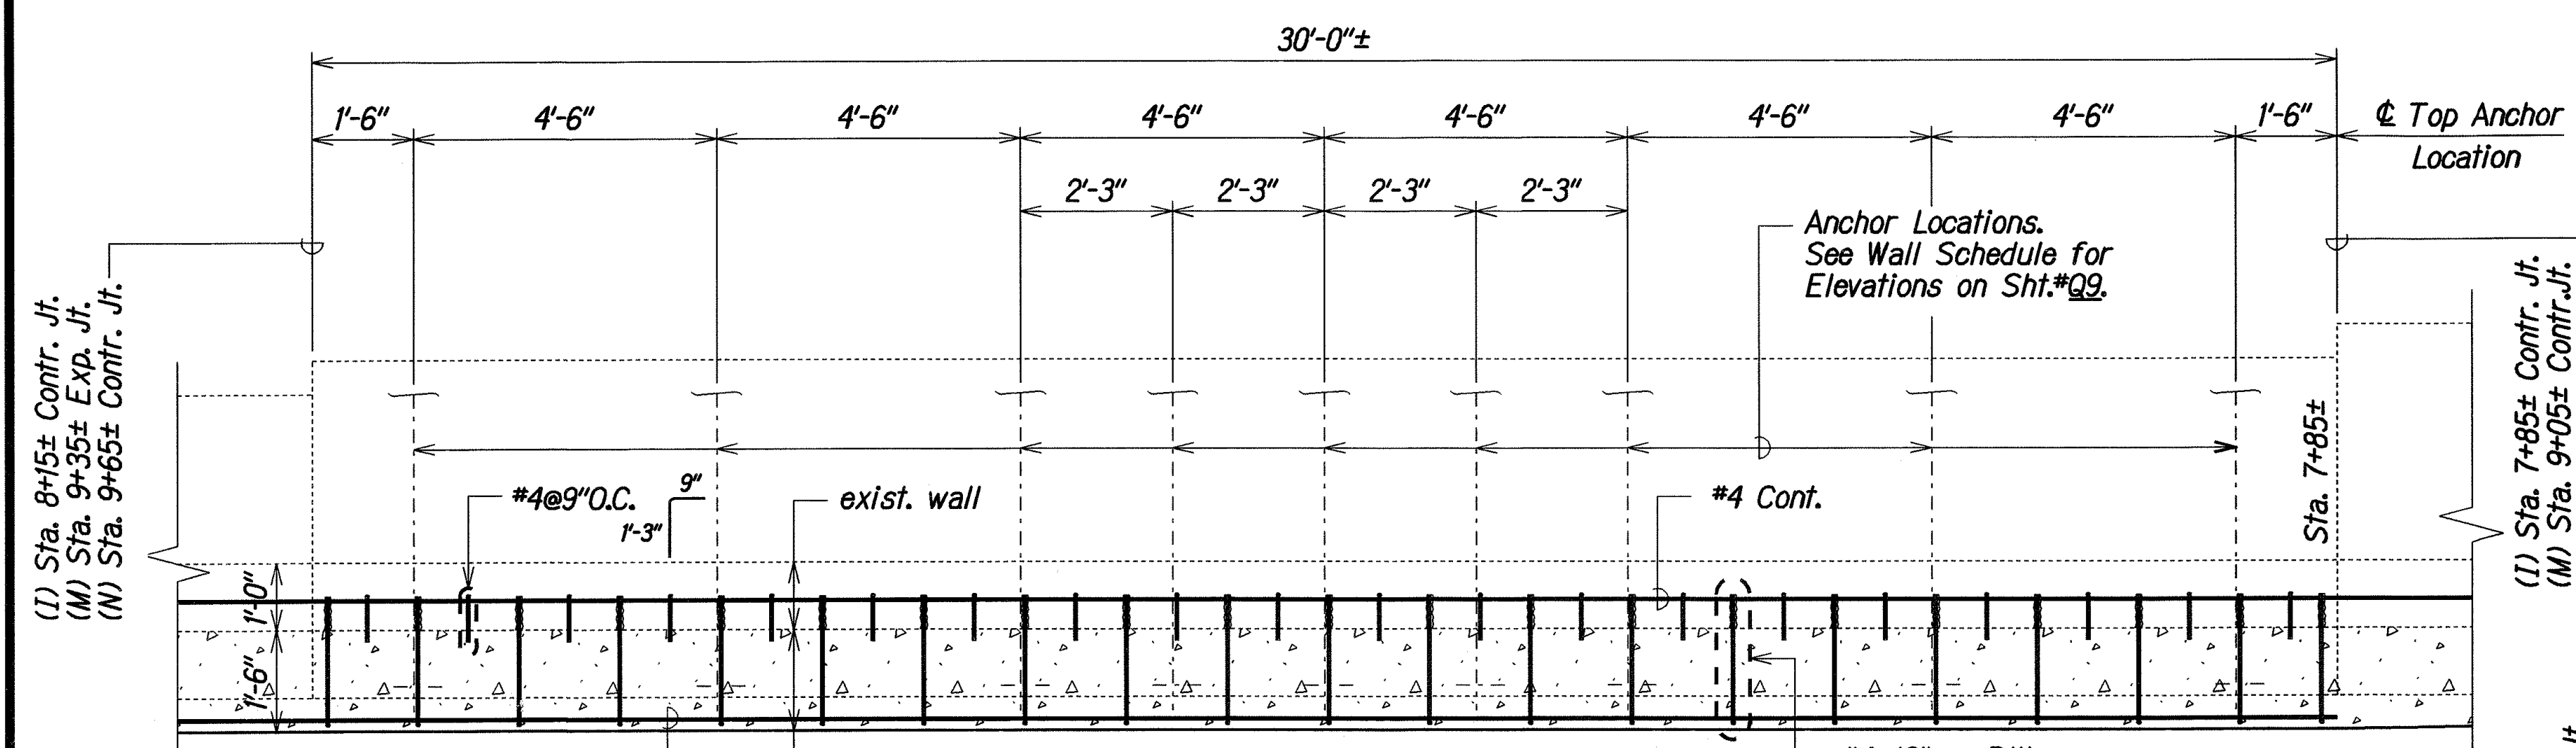

PLAN
Scale: 1/2"=1'-0"
30'-0"±

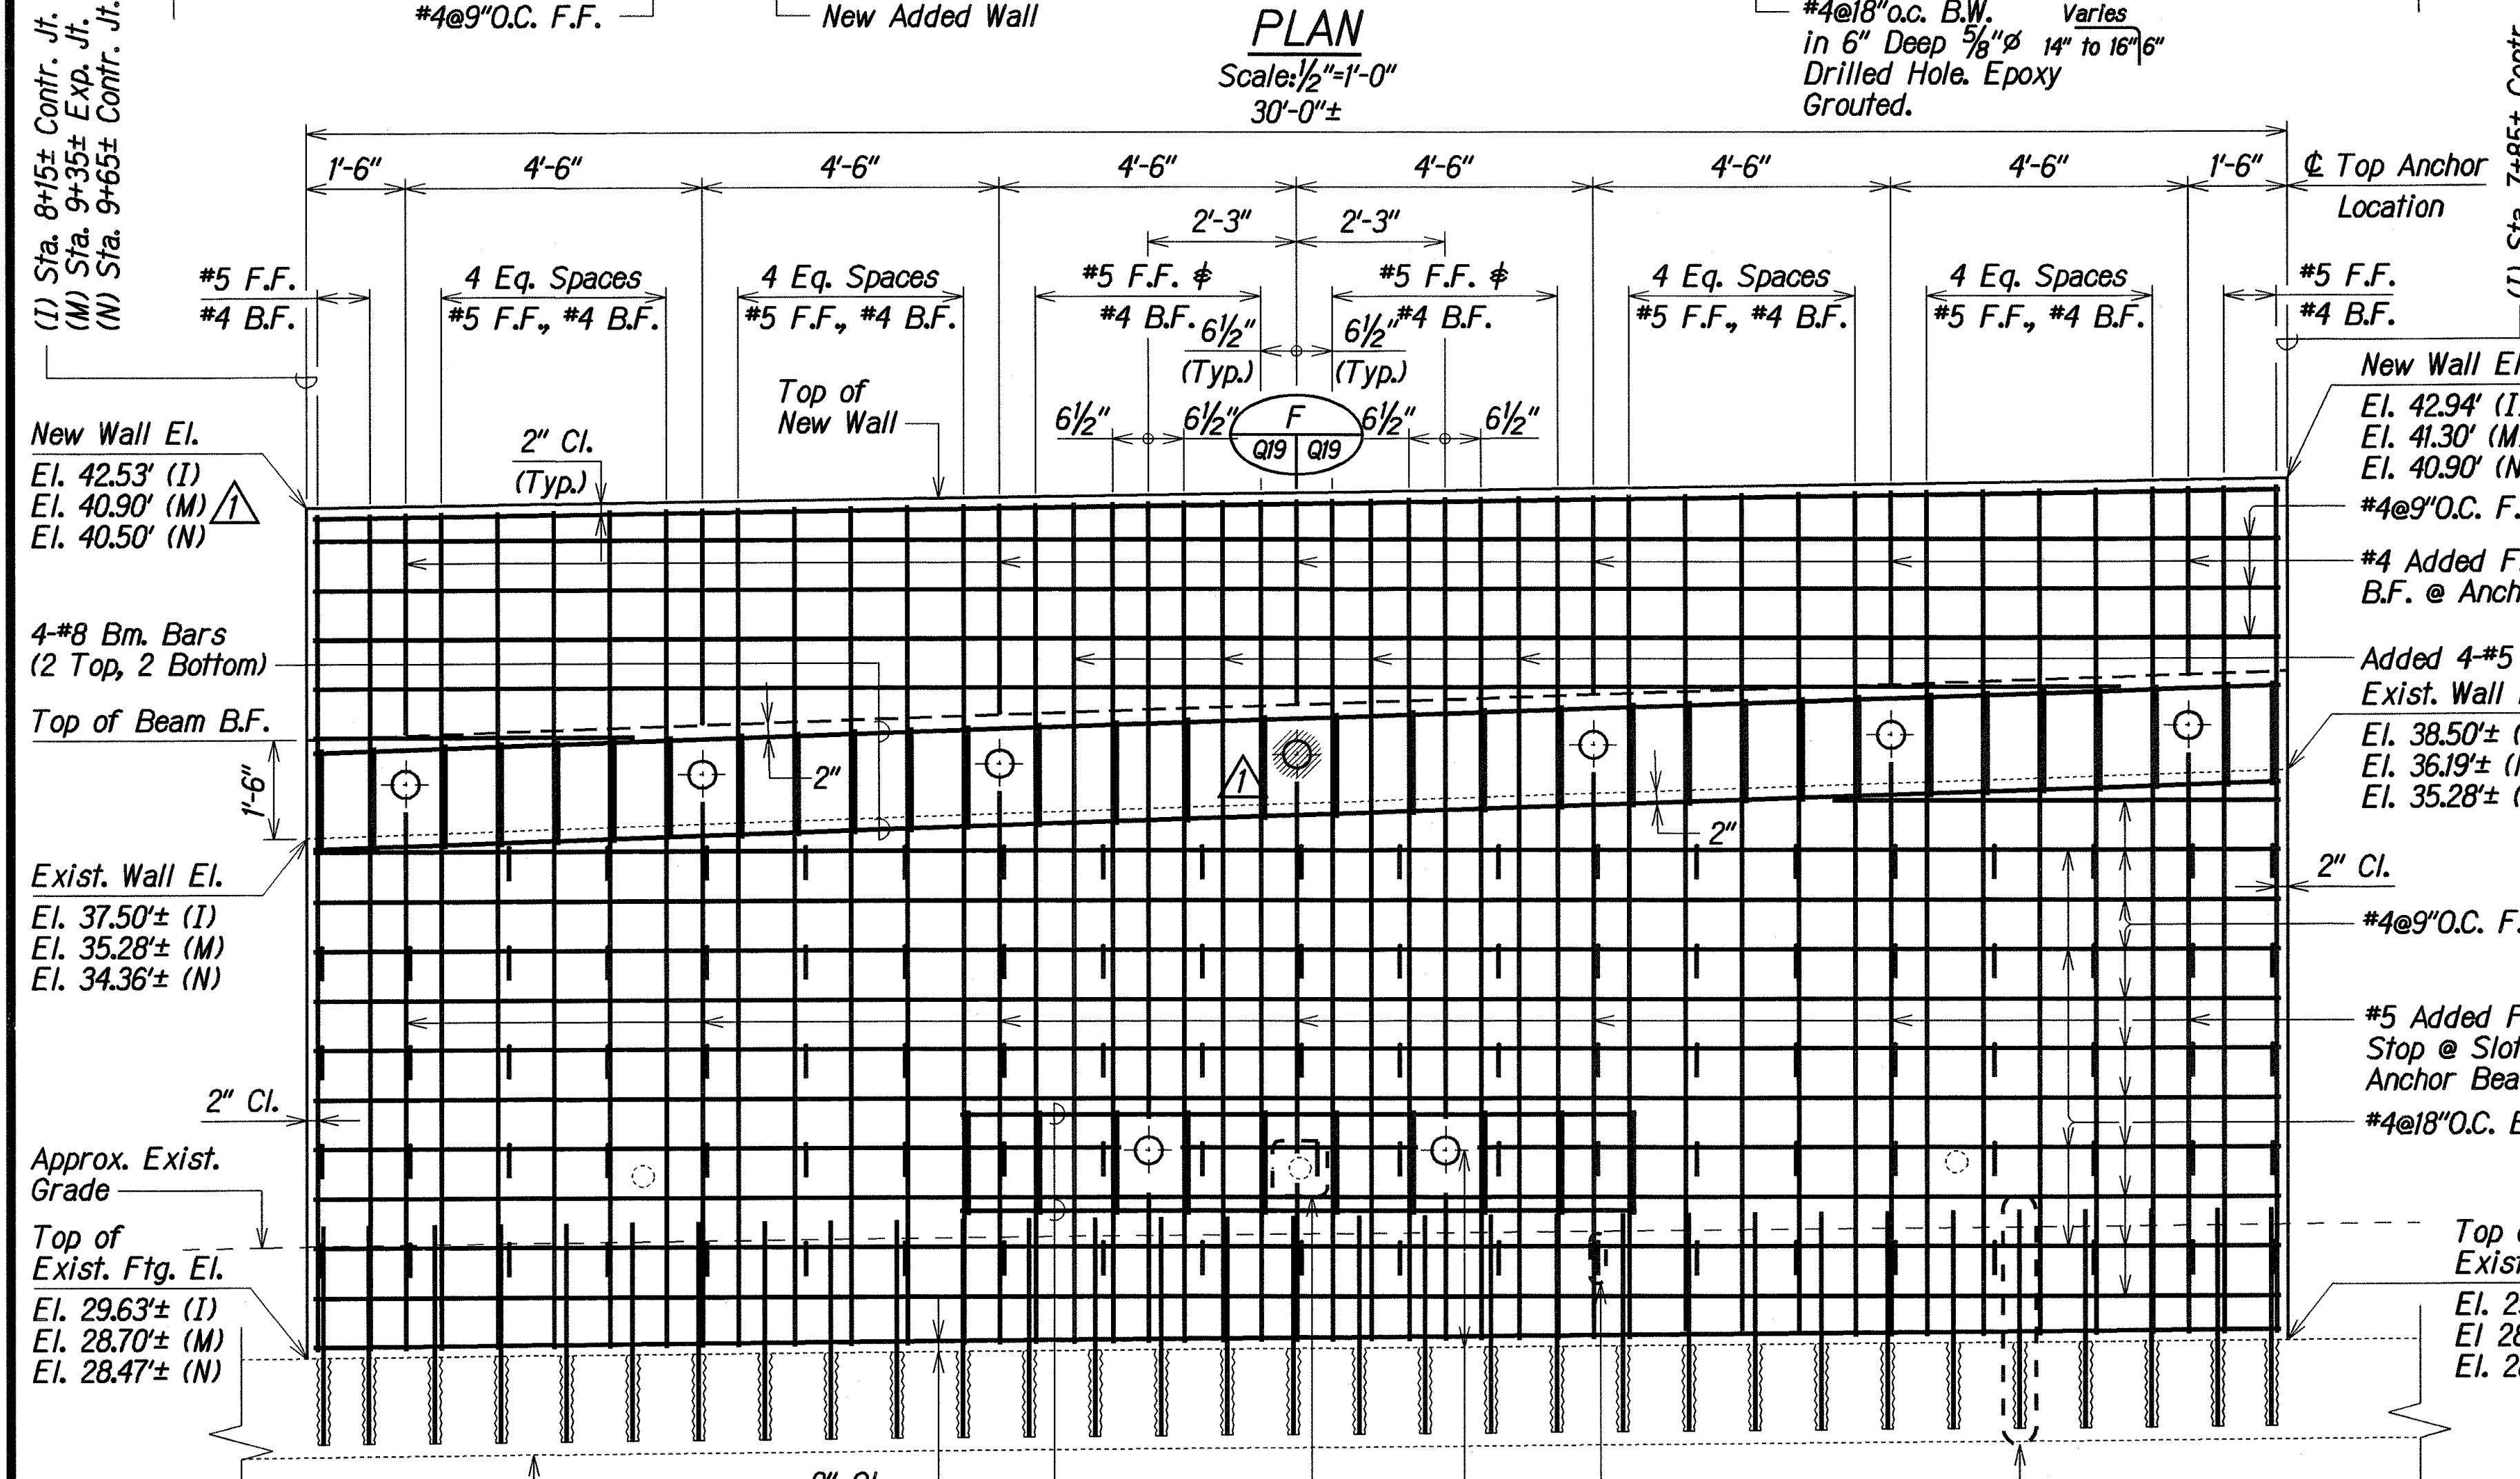

ELEVATION
Scale: 1/2"=1'-0"


LEGEND

- Indicates Proof Test Anchor
- Permanent Tieback Anchor
- 43.34' (G) Elevation and Designated Wall Panel
- Existing Weep hole

WALL "I" DETAILS
WALL "M" and "N" SIMILAR

NOTES:

1. $\angle$ of All Lower Anchors from Horizontal Shall be 20°.
2. For Slot-Out Details, See Sheets Q25 & Q26.
3. For Expansion & Contraction Joint Details, See Sht.#Q7.

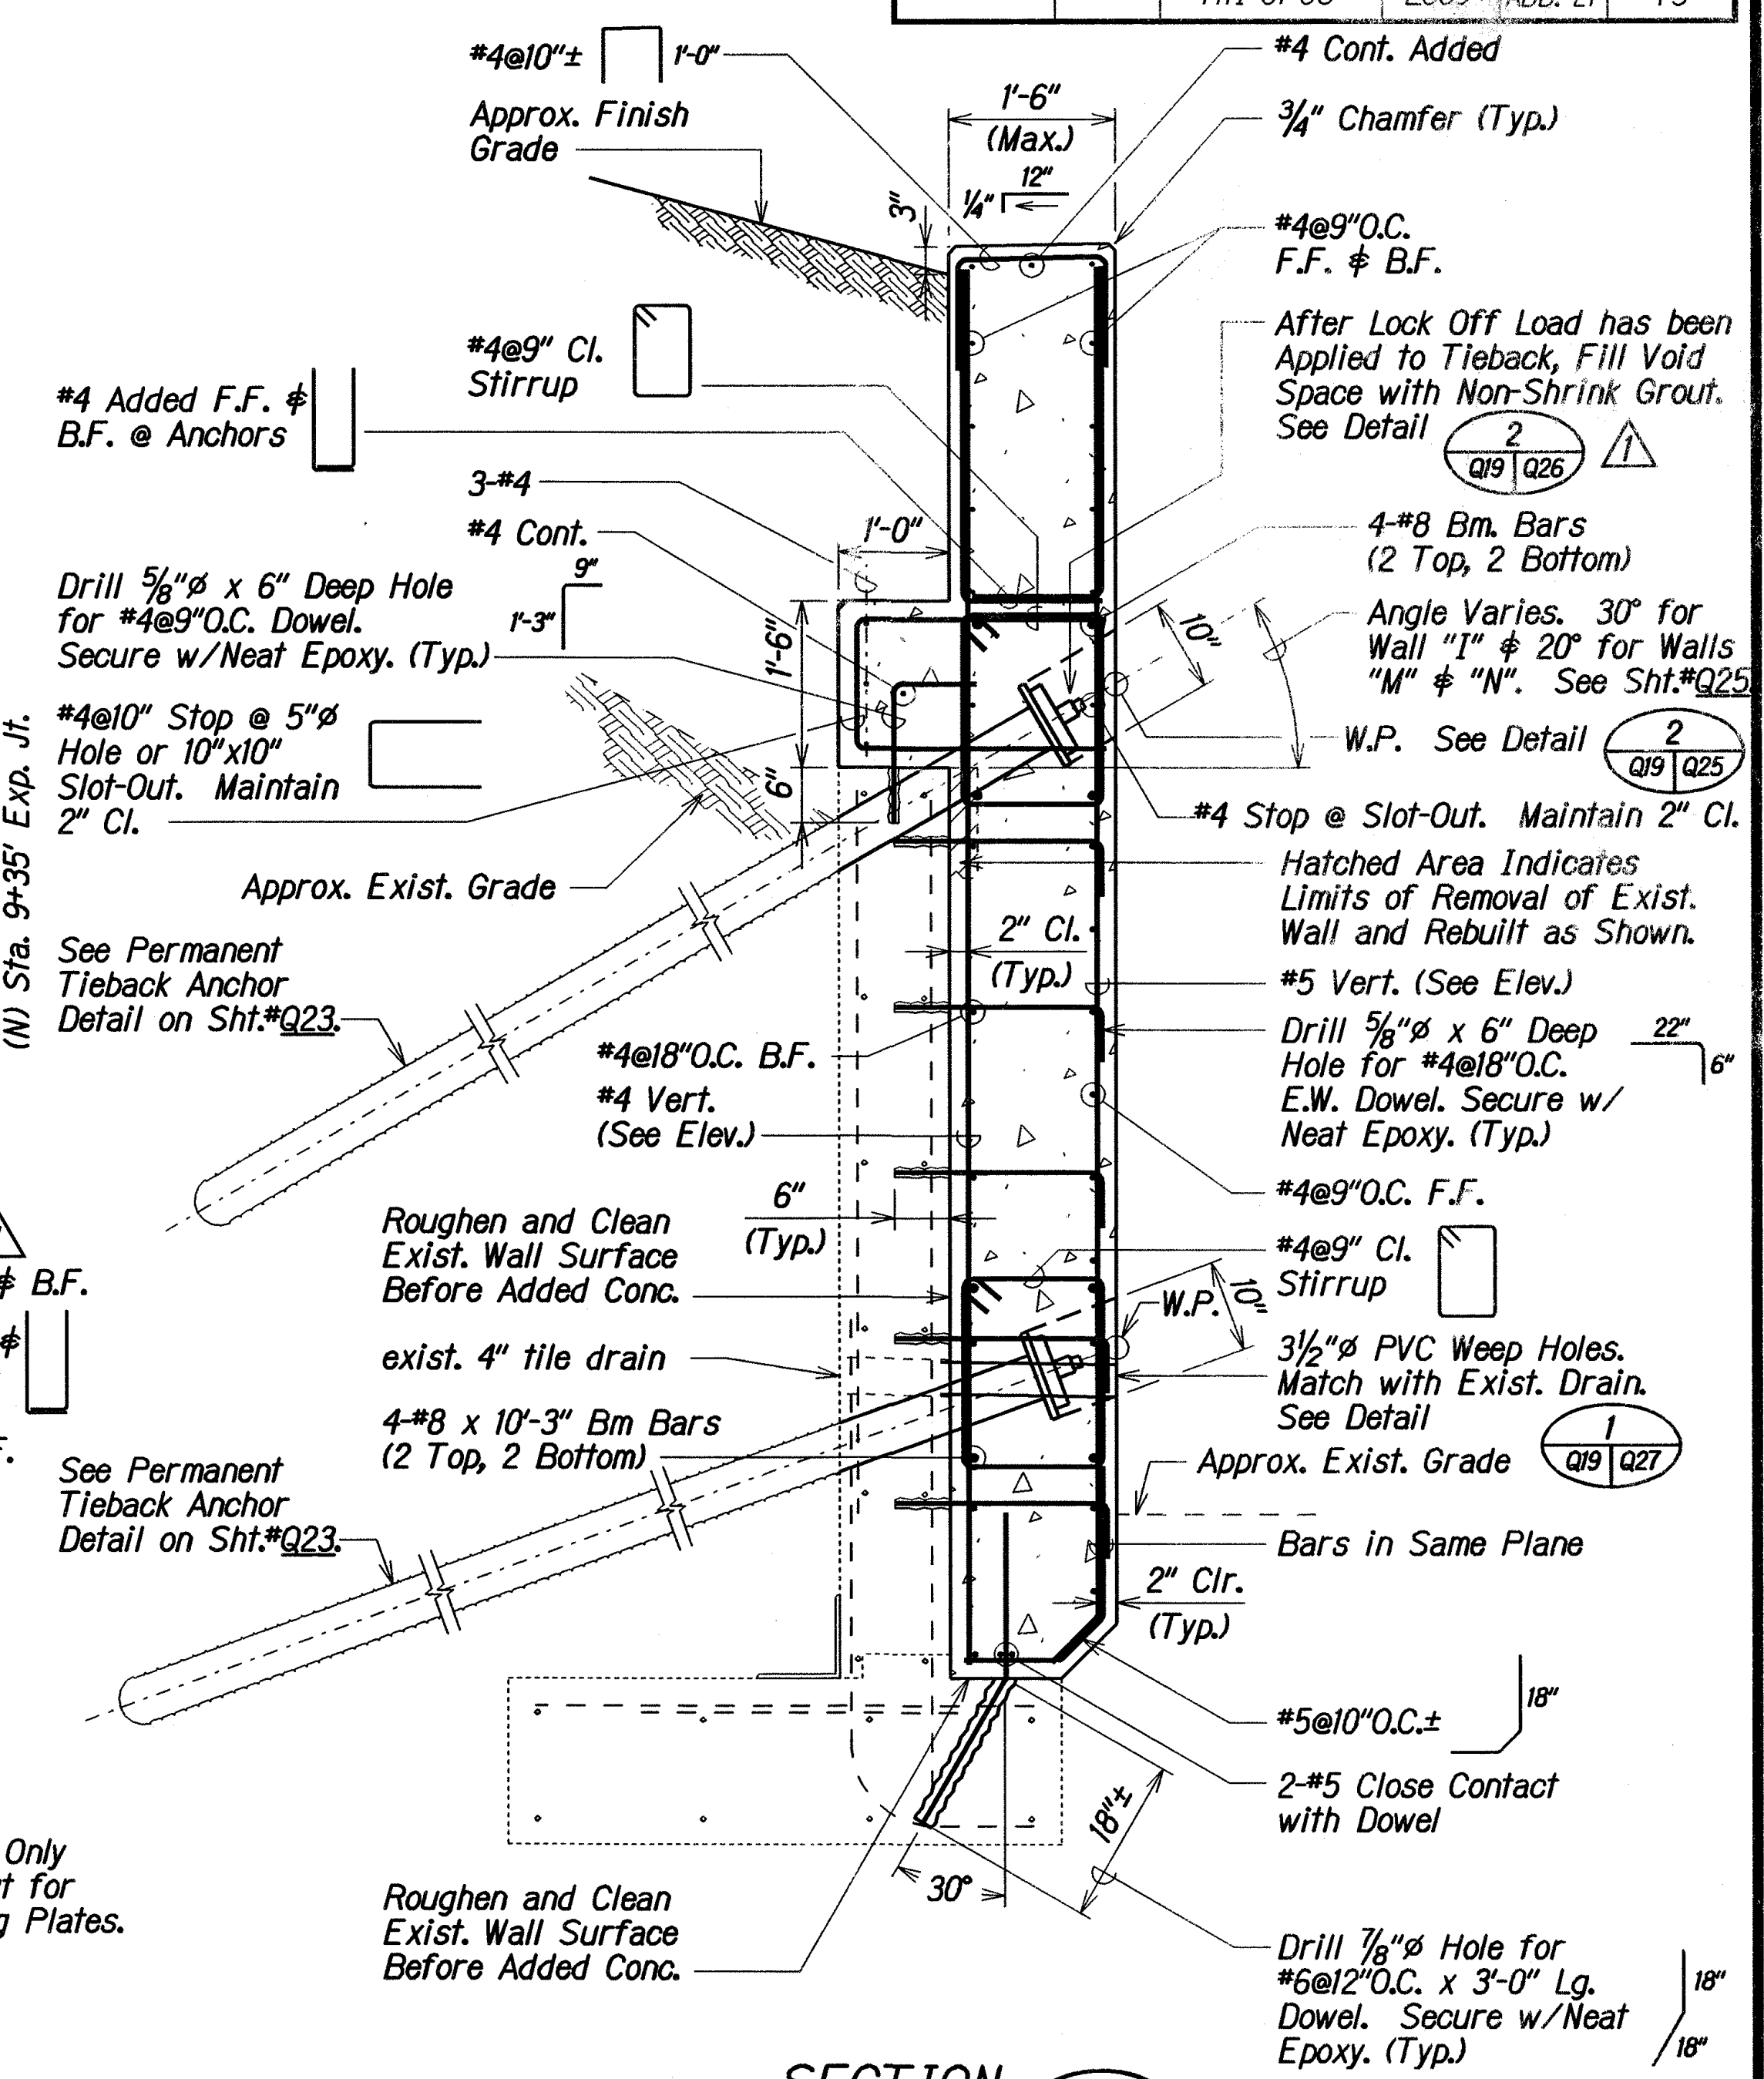



SECTION
Scale: 3/4"=1'-0"
Q6

DATE	REVISION
3/31/09	Revised New Wall Elevations (M) & (N), Revised Detail Designation and Hatched Proof Test Anchor

STATE OF HAWAII
DEPARTMENT OF TRANSPORTATION
HIGHWAYS DIVISION
RETAINING WALL REPAIR
WALL "I" "M" AND "N" DETAILS
INTERSTATE ROUTE H1
EXTENSION AND REPAIR OF
SCHOOL STREET ON-RAMP RETAINING WALL
Project No. H11-01-08

Scale: As Noted Date: Feb. 2009
SHEET No. Q19 OF 34 SHEETS

FED. ROAD DIST. NO.	STATE	PROJ. NO.	FISCAL YEAR	SHEET NO.	TOTAL SHEETS
HAWAII	HAW.	H11-01-08	2009	C.O. ADD. 27	73

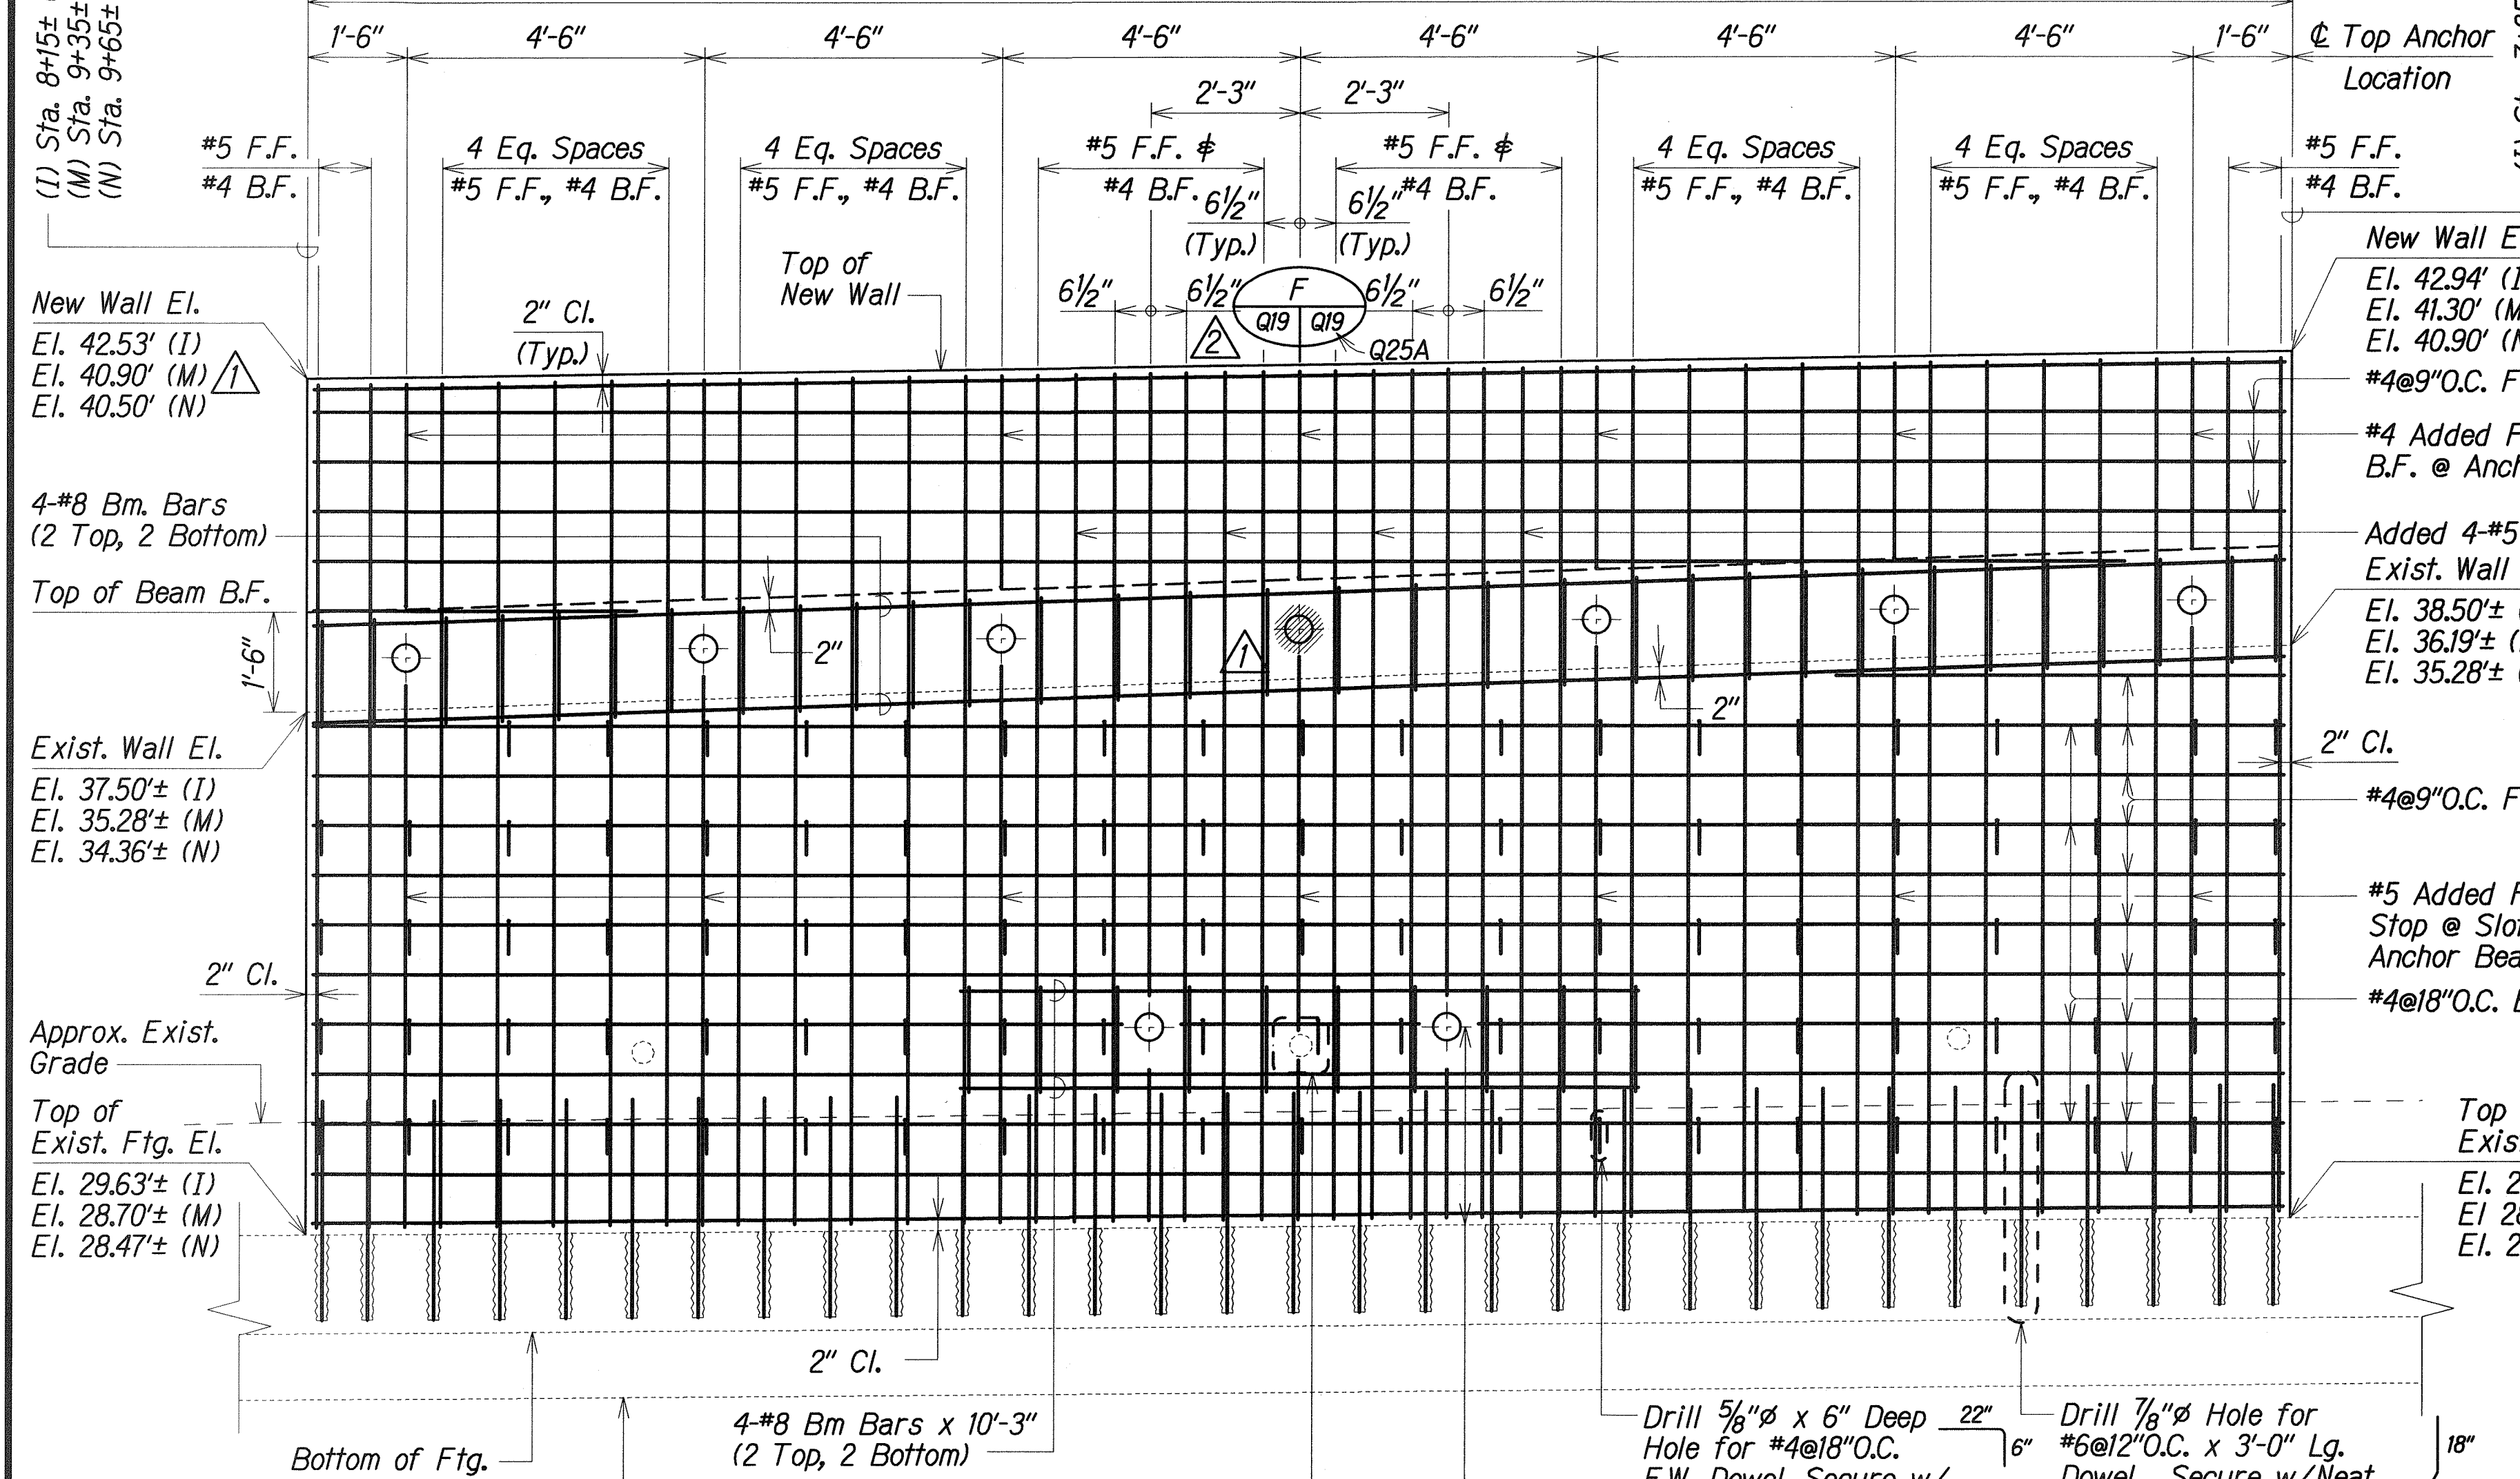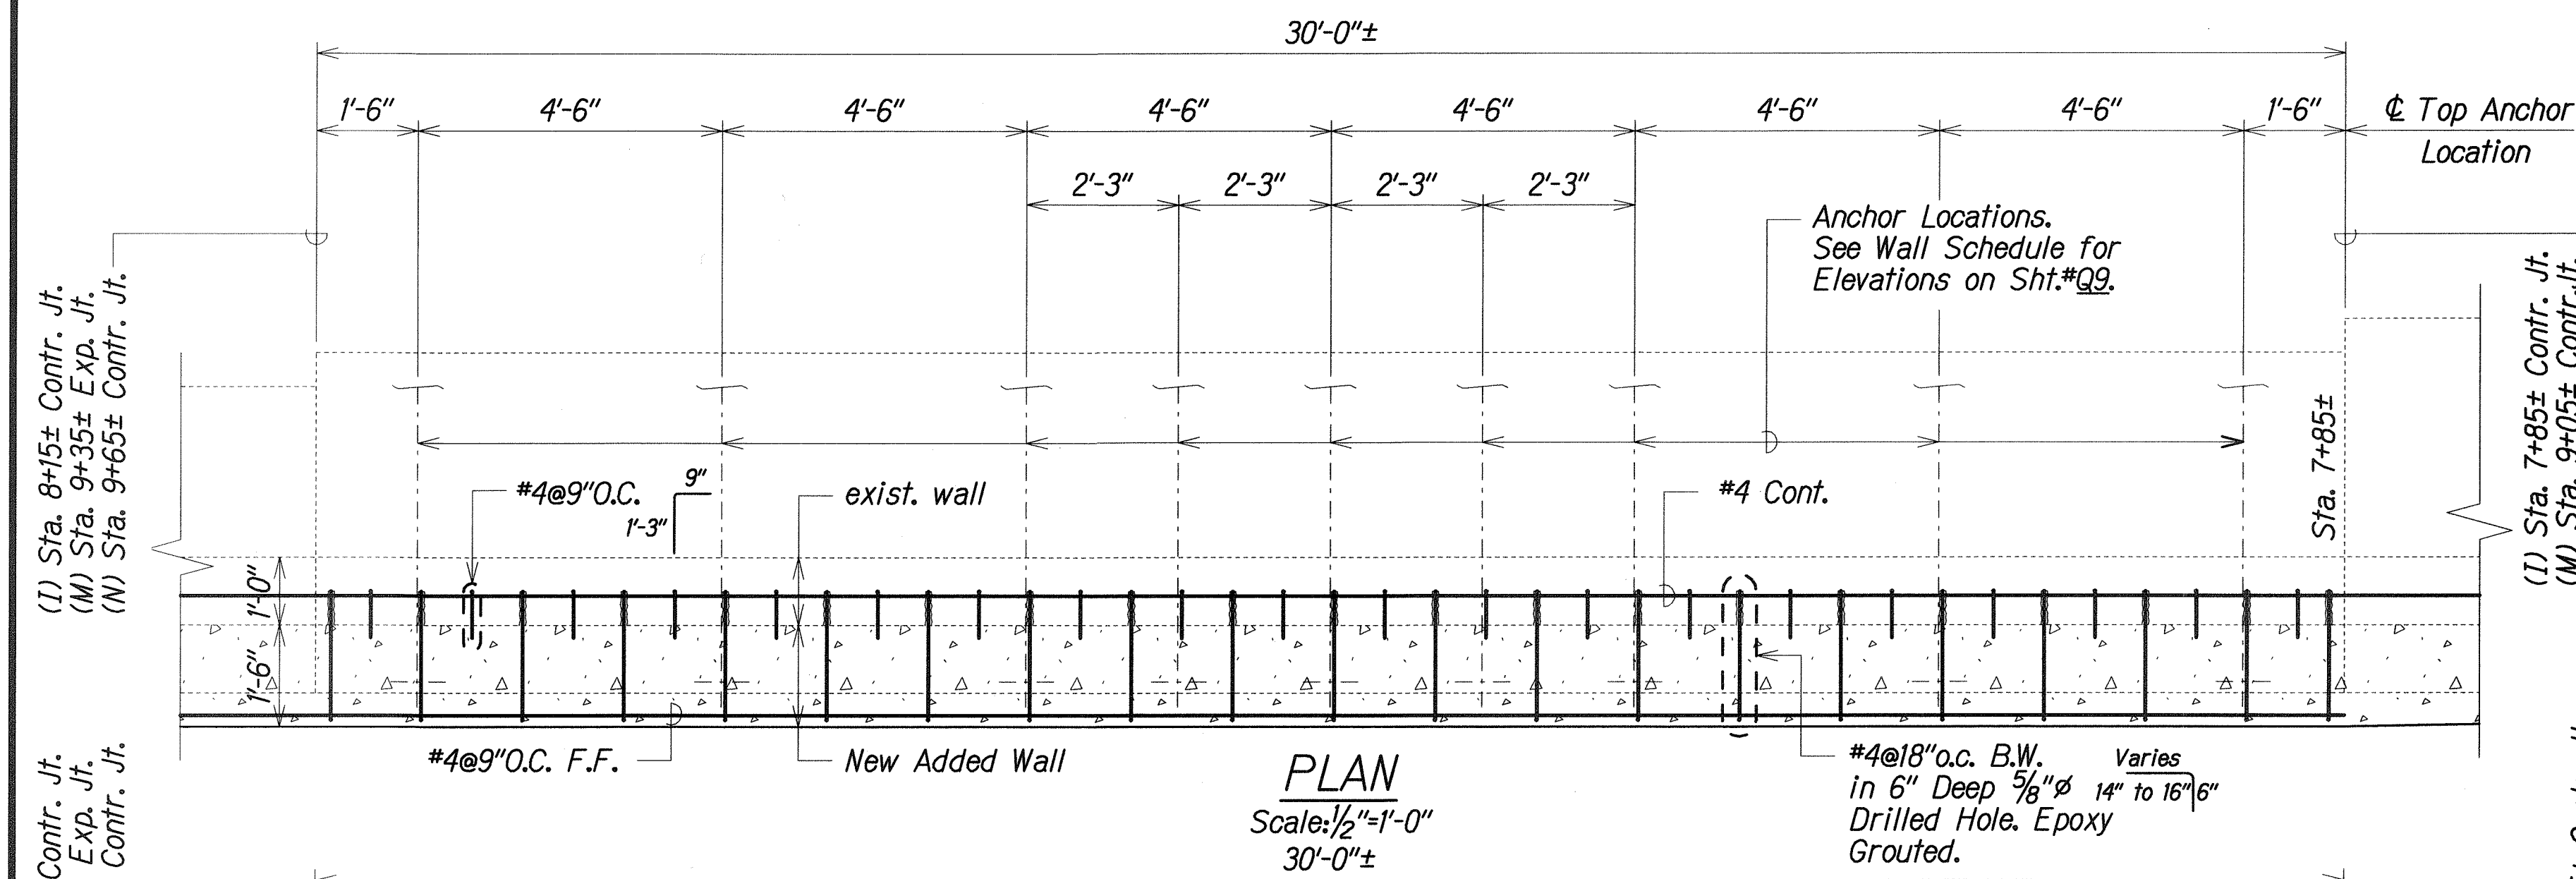


- LEGEND**
- Indicates Proof Test Anchor
 - Permanent Tieback Anchor
 - 43.34' (G) Elevation and Designated Wall Panel
 - Existing Weep hole

Stop Bars @ Weep Holes Maintain 2" Cl. Between Reinf. and Weep Holes. (Typ.) For Add. Reinf. See Detail Q27 Q27

Lower Anchor Location See Sht.*Q9 for Elevation.

**WALL "I" DETAILS
WALL "M" and "N" SIMILAR**

- NOTES:**
1. $\angle$ of All Lower Anchors from Horizontal Shall be 20°.
 2. For Slot-Out Details, See Sheets Q25 & Q26.
 3. For Expansion & Contraction Joint Details, See Sht.*Q7.
 4. Additional Reinf. @ Wall "M" Only, See Sht.*Q25A.



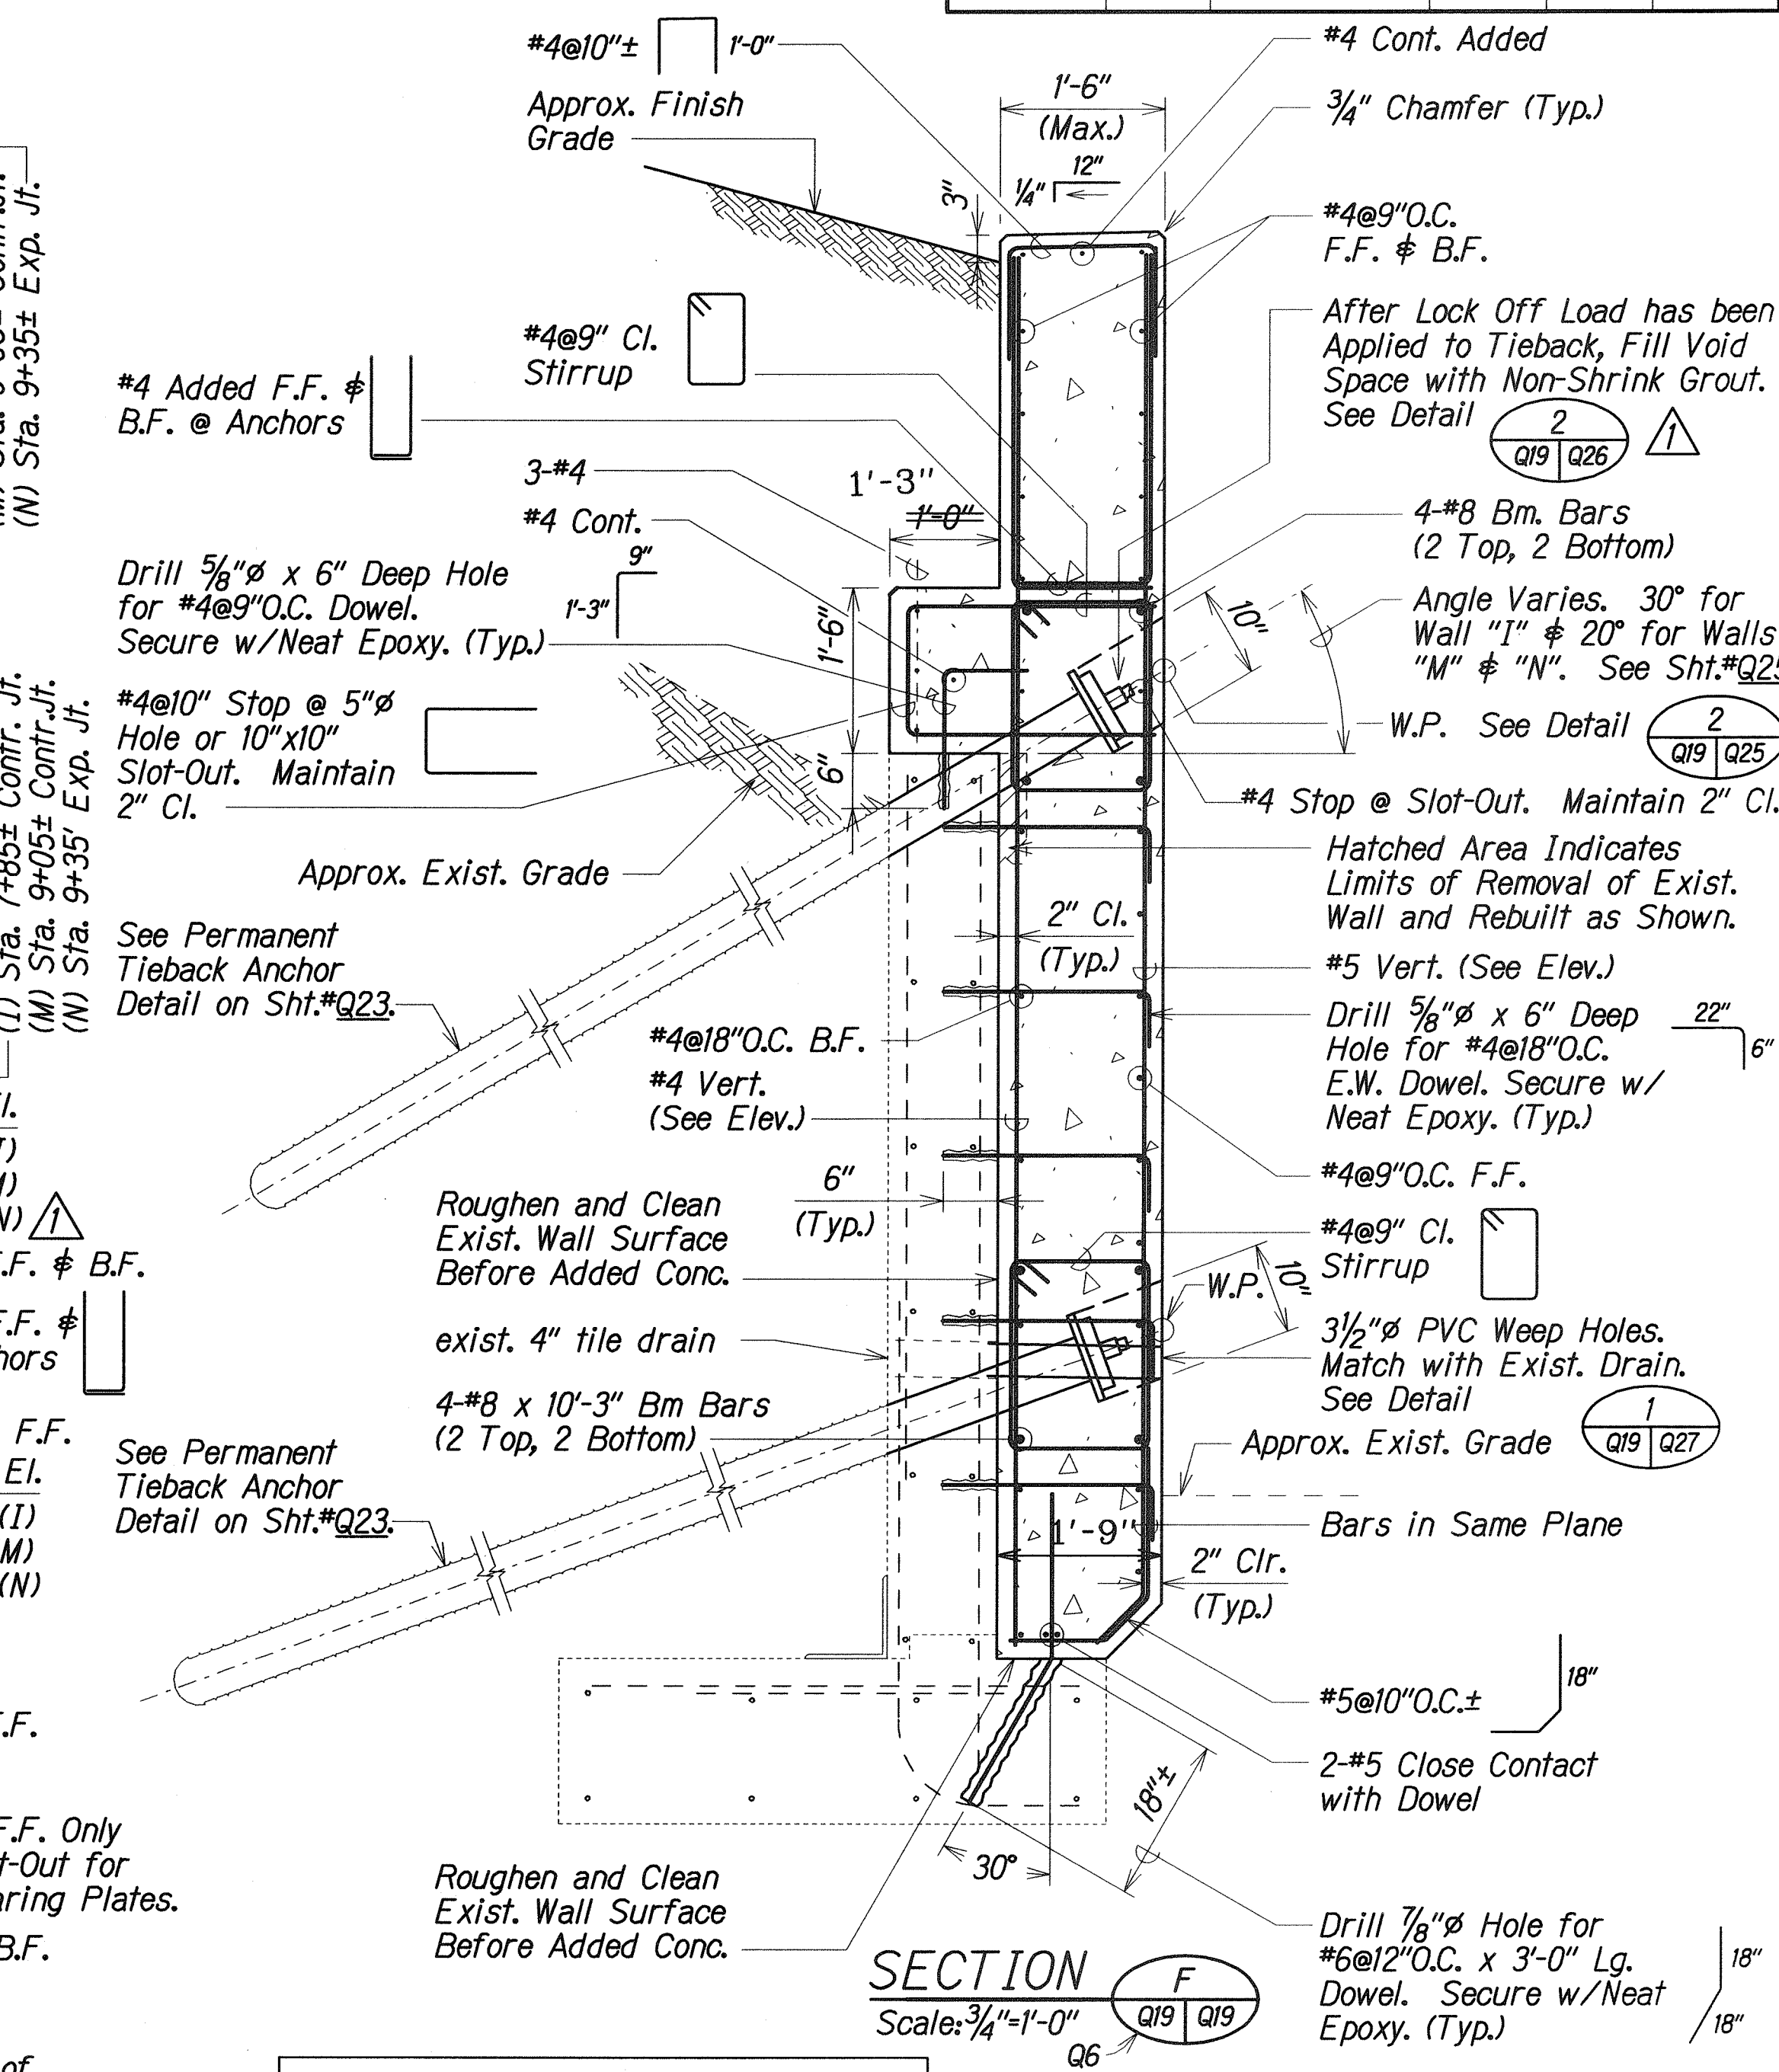


- LEGEND FOR AS-BUILT POSTINGS**
- Squiggly line for as-built deletion
 - Double line for as-built deletion
 - Roadway Text for as-built posting

- Added Note No. 4, for Wall "M" Only and Added Sheet Number to Detail Symbol**
- 8/17/09
- 3/31/09
- Revised New Wall Elevations (M) & (N), Revised Detail Designation and Hatched Proof Test Anchor

DATE	REVISION
8/17/09	Added Note No. 4, for Wall "M" Only and Added Sheet Number to Detail Symbol
3/31/09	Revised New Wall Elevations (M) & (N), Revised Detail Designation and Hatched Proof Test Anchor

FED. ROAD DIST. NO.	STATE	PROJ. NO.	FISCAL YEAR	SHEET NO.	TOTAL SHEETS
HAWAII	HAW.	H11-01-08	2009	ADD. 28	73

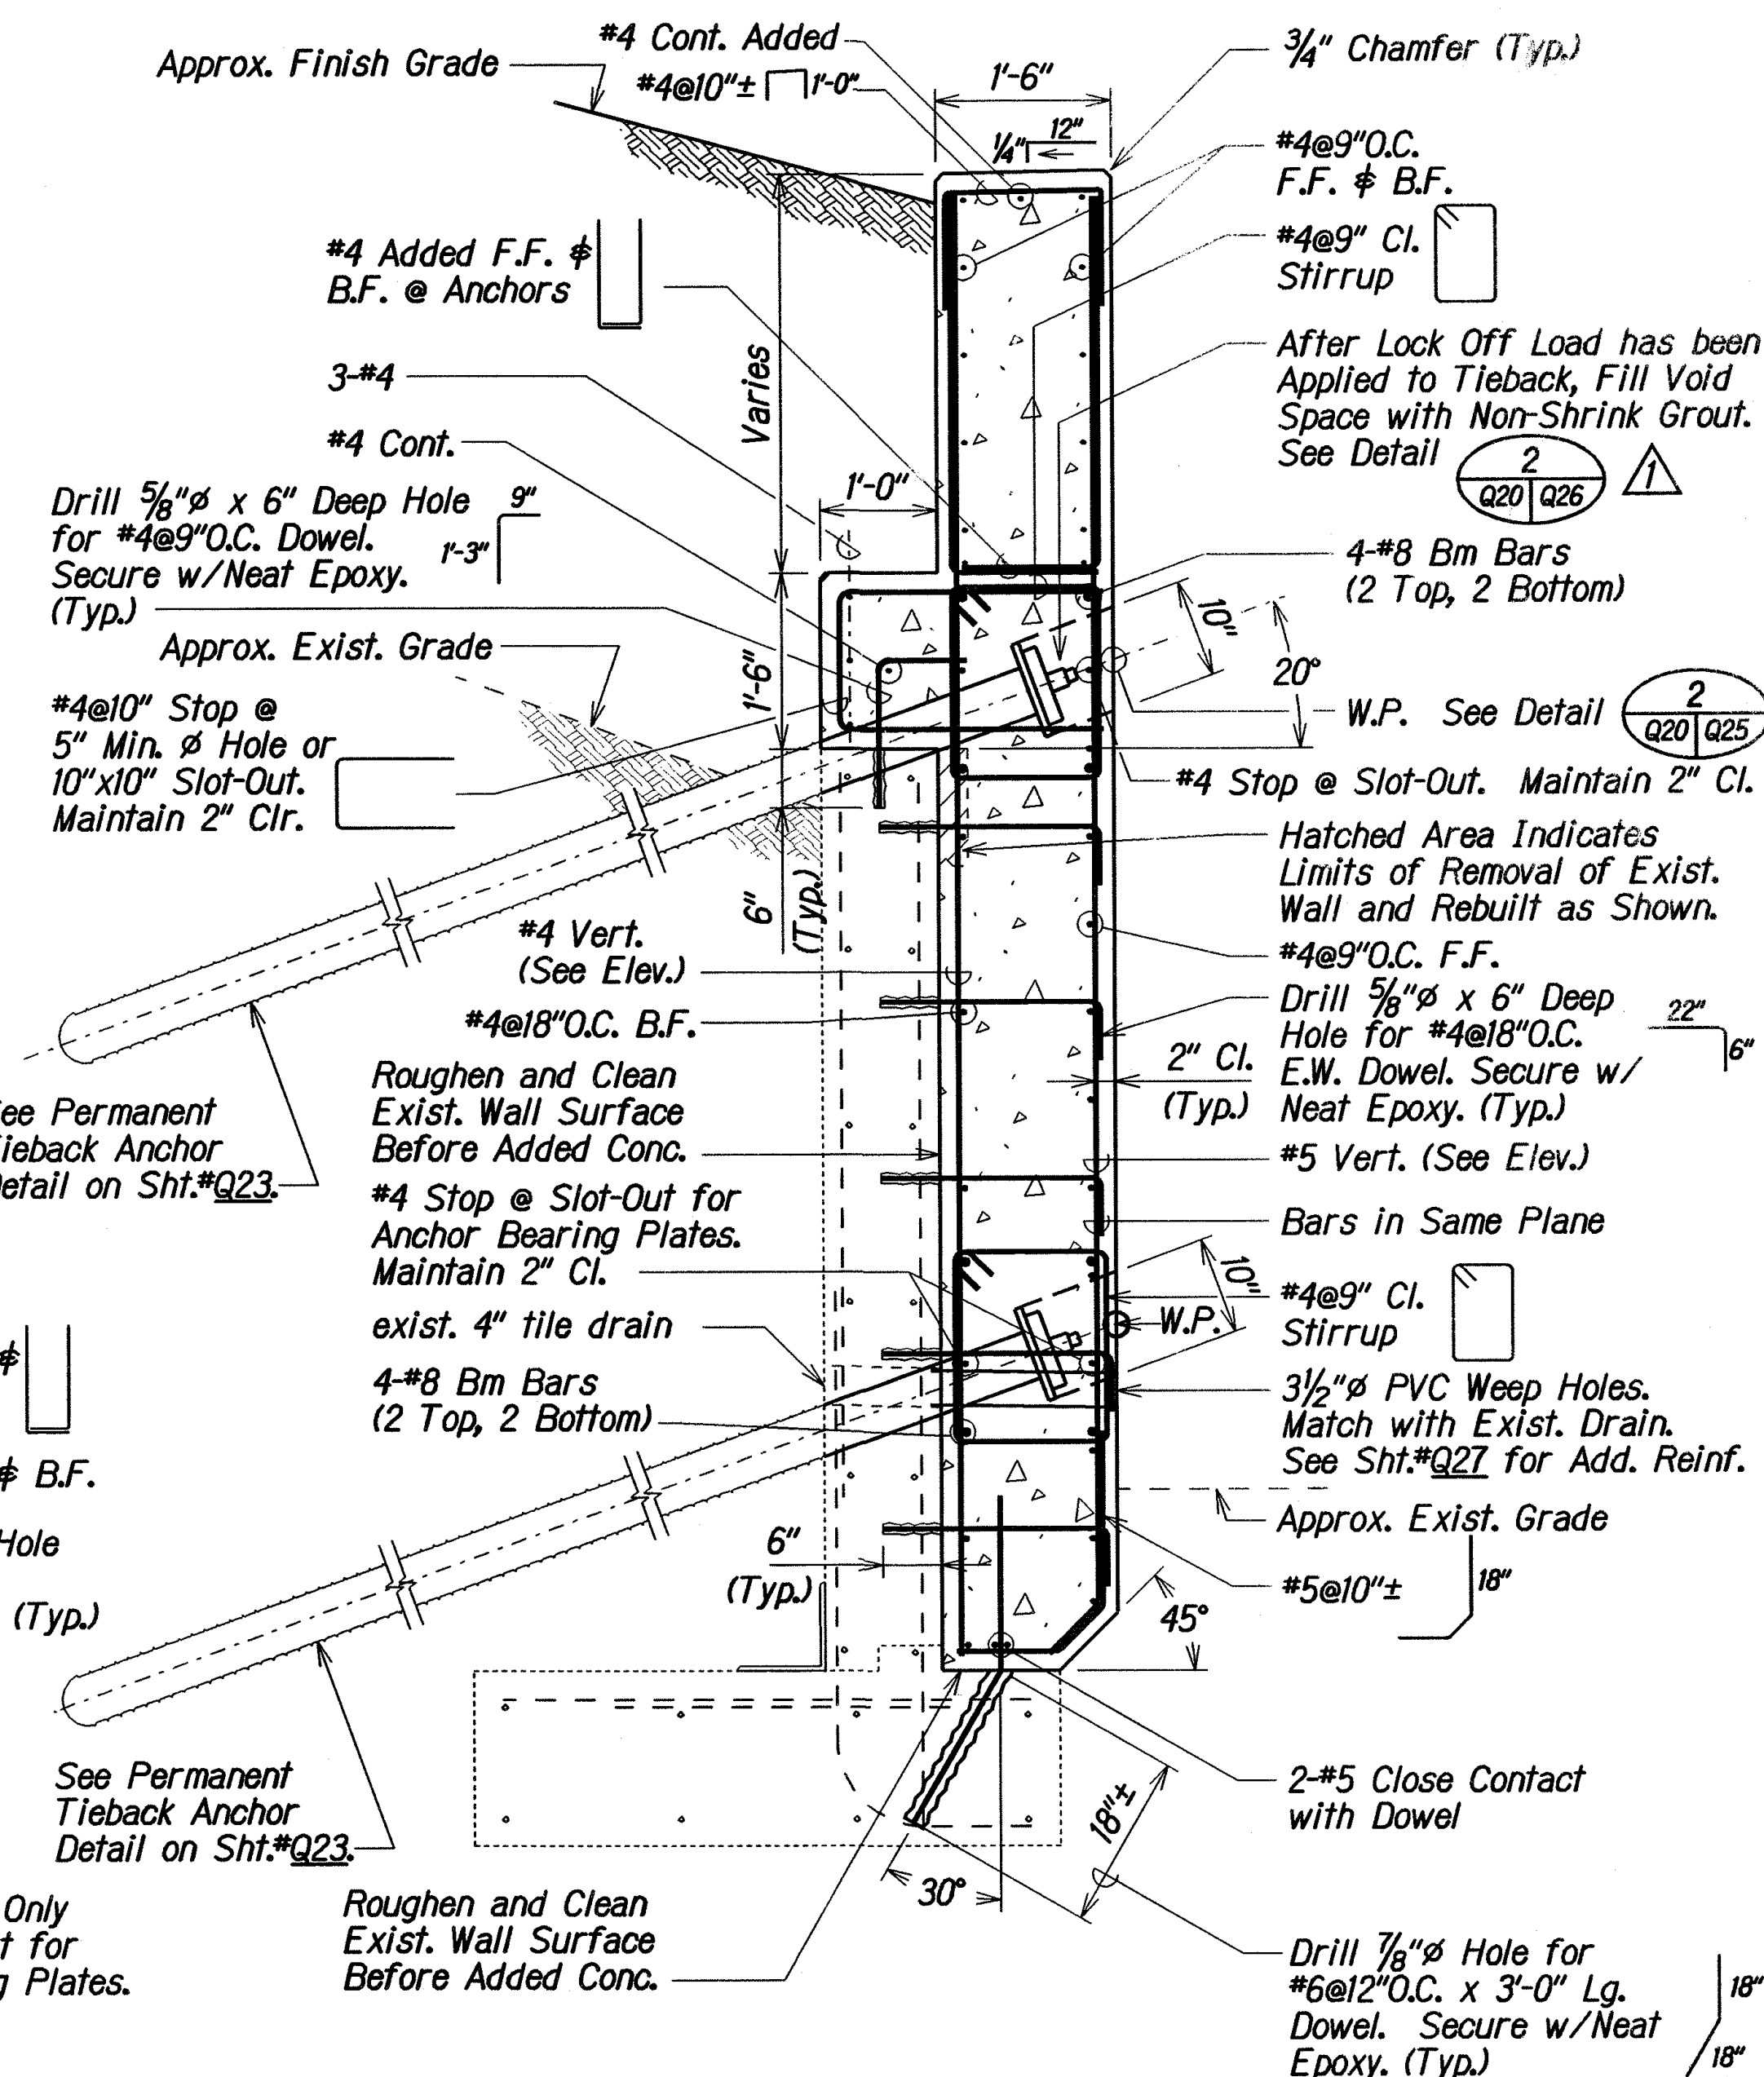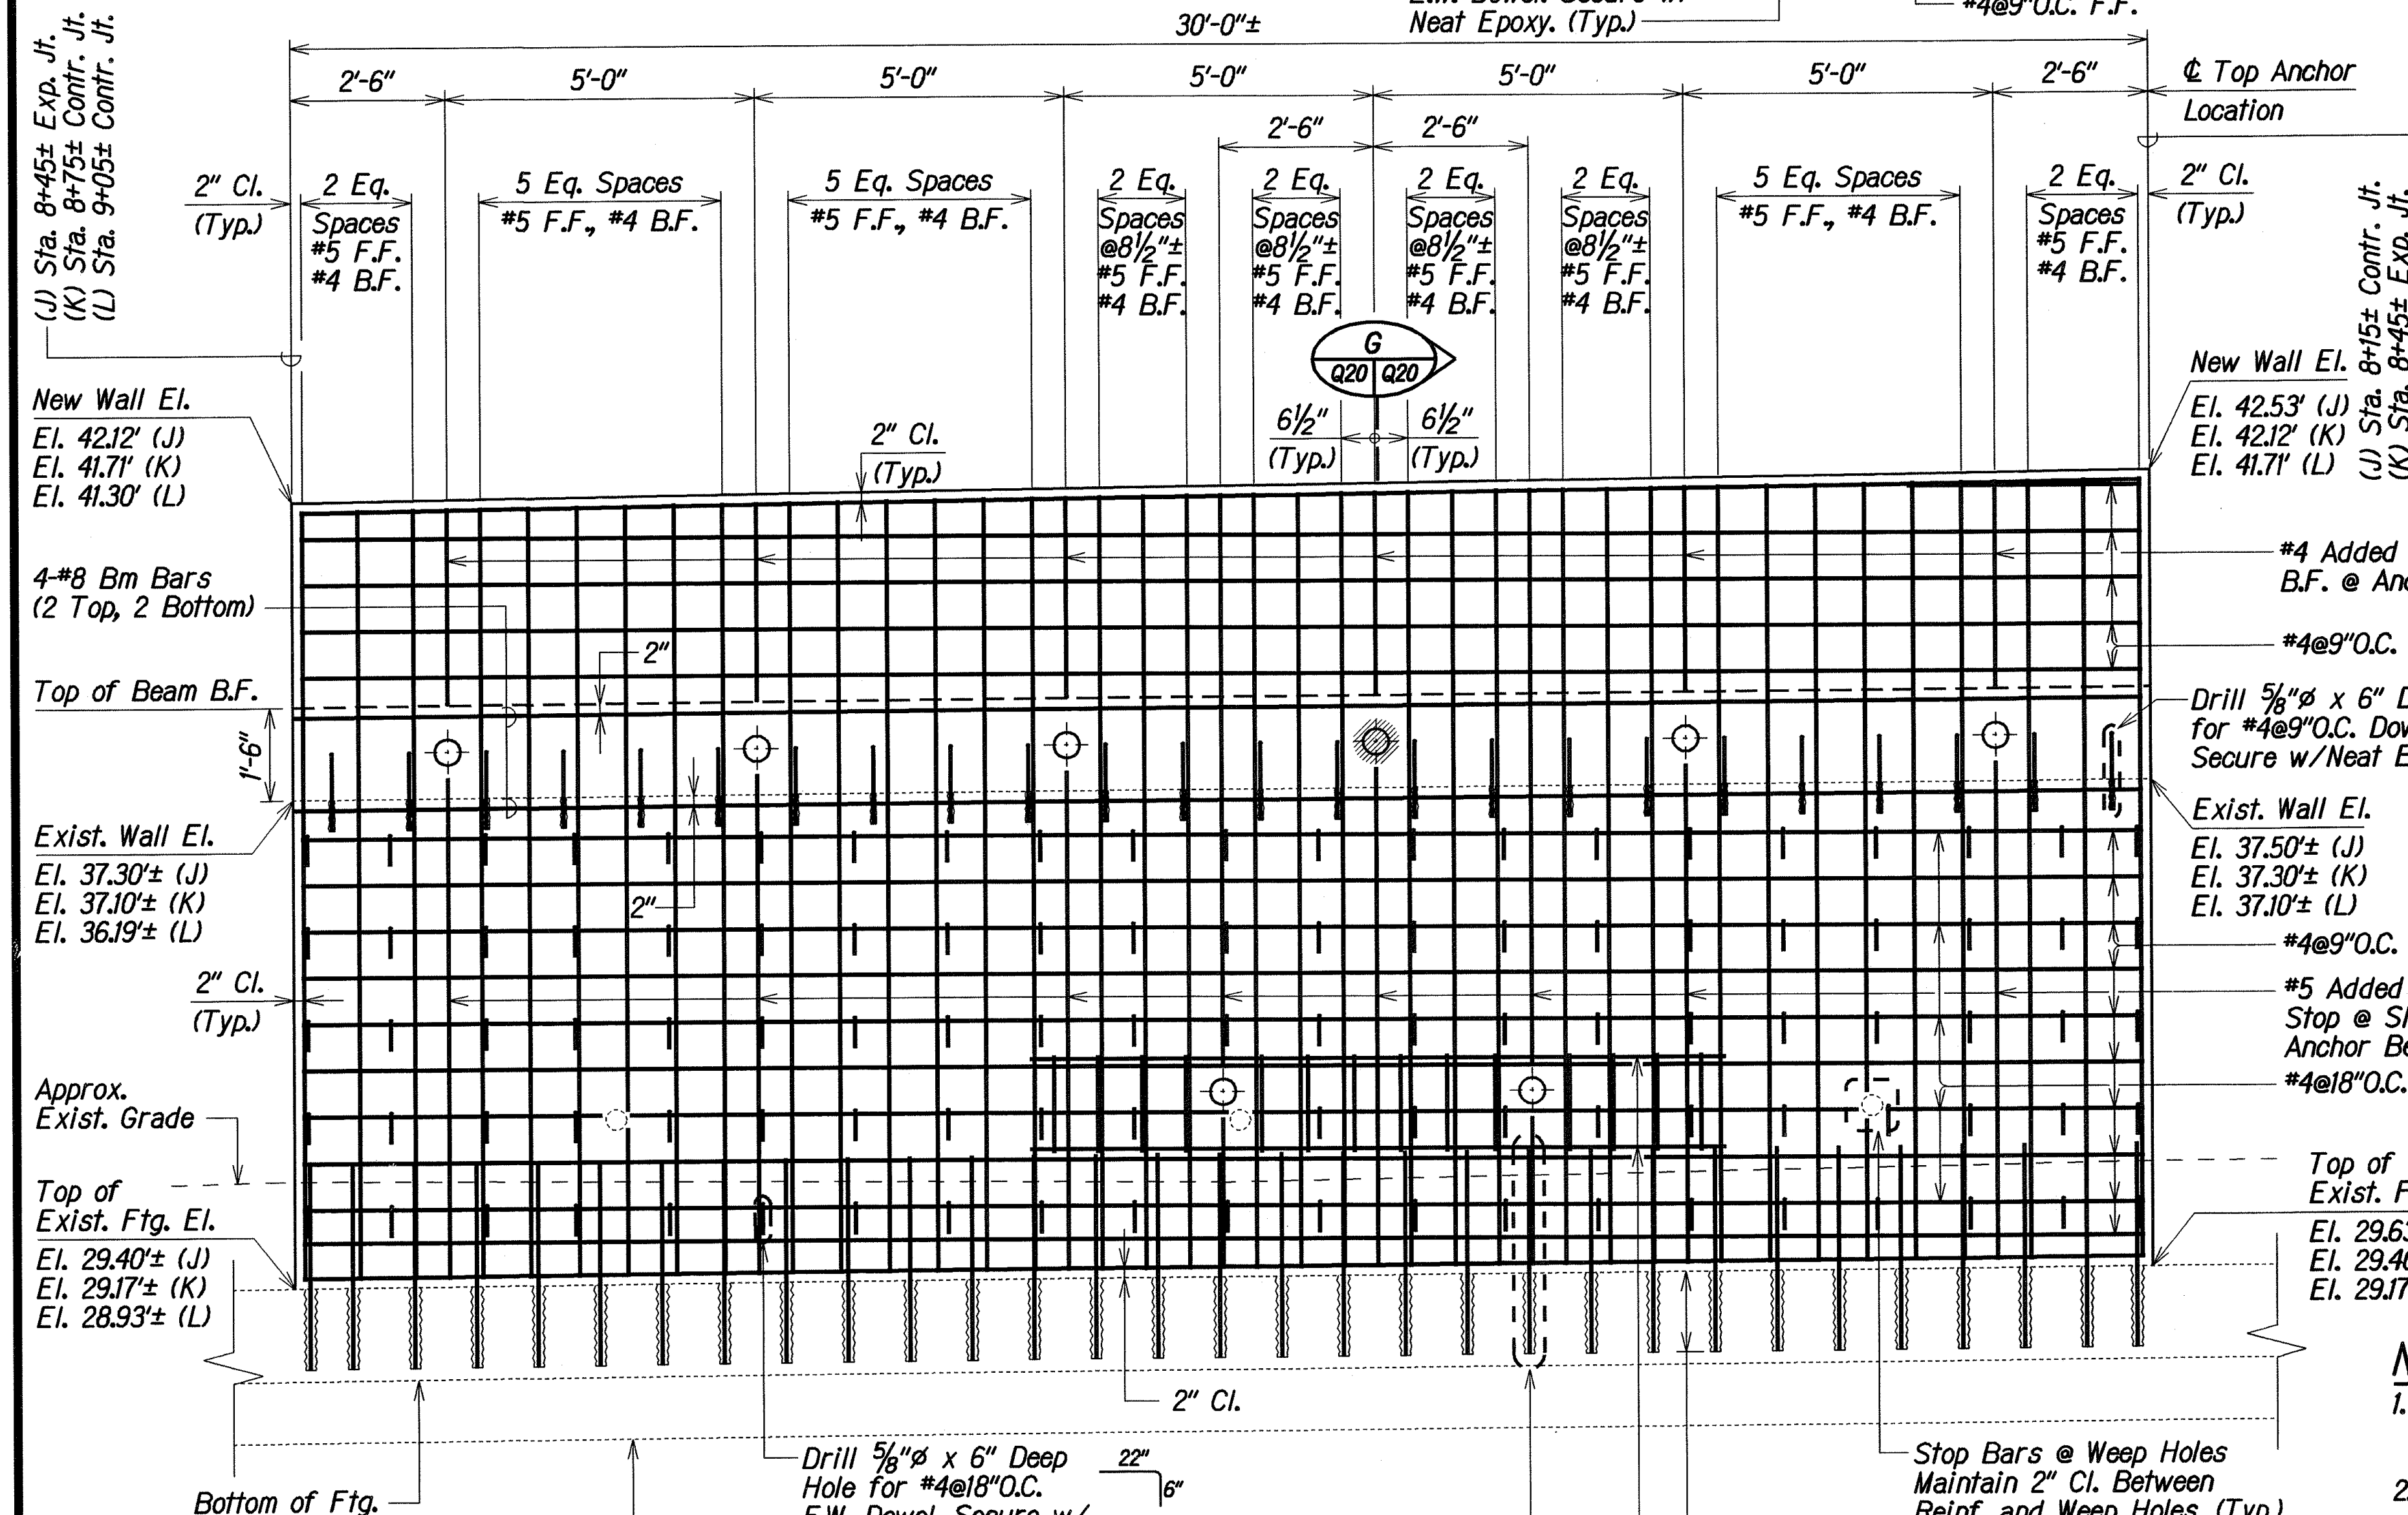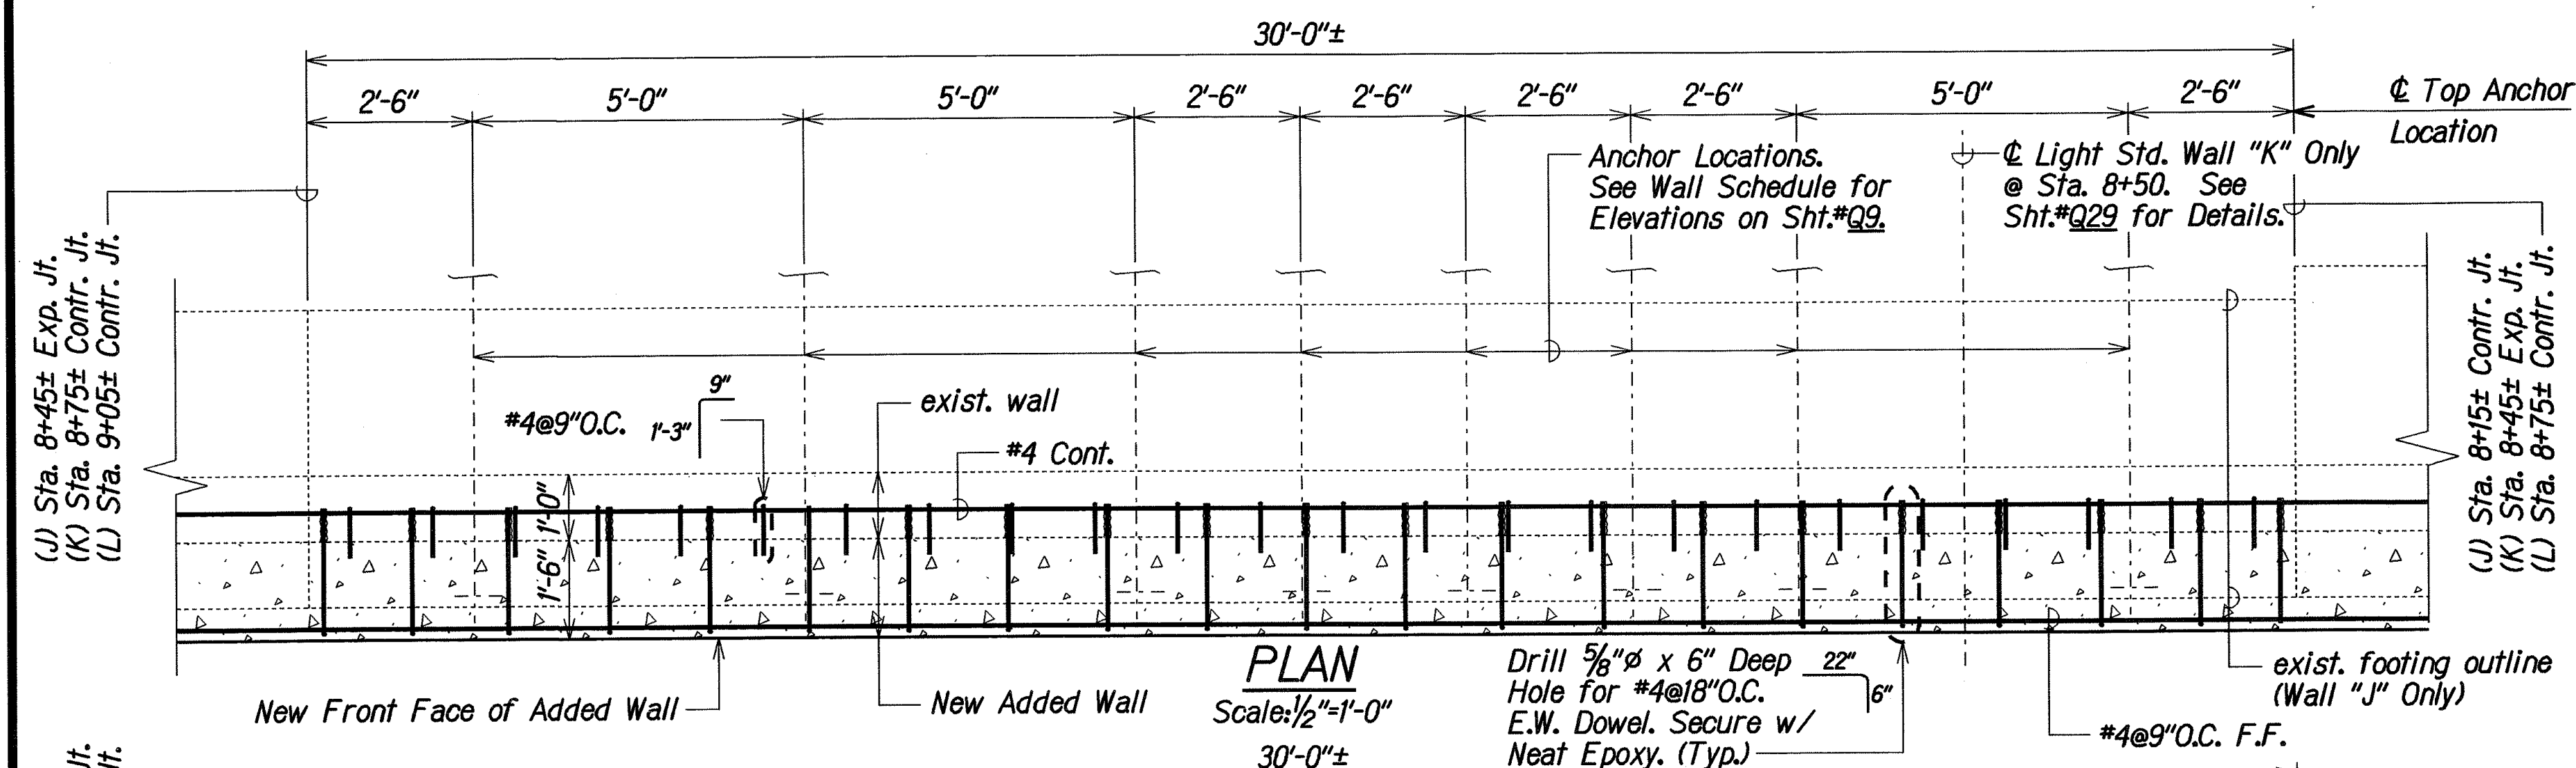

NOTES:

- For Walls "K" & "L" Wall Elevations. Refer to Wall Schedule on Sht.*Q9.
- of All Lower Anchors from Horizontal Shall be 20°.
- For Expansion & Contraction Joint Details. See Sht.*Q7.

LEGEND

- Indicates Proof Test Anchor
- Permanent Tieback Anchor
- 43.34' (G) Elevation and Wall Panel
- Existing Weep hole

ELEVATION

Scale: 1/2" = 1'-0"


WALL "J" DETAILS

WALLS "K" and "L" SIMILAR EXCEPT AS NOTED

3/31/09	Revised Detail Designation
DATE	REVISION
STATE OF HAWAII DEPARTMENT OF TRANSPORTATION HIGHWAYS DIVISION RETAINING WALL REPAIR WALL "J", "K" AND "L" DETAILS INTERSTATE ROUTE H-1 EXTENSION AND REPAIR OF SCHOOL STREET ON-RAMP RETAINING WALL Project No. H11-01-08	
Scale: As Noted	Date: Feb. 2009
SHEET No. Q20 OF 34 SHEETS	

ADD. 28

FED. ROAD DIST. NO.	STATE	PROJ. NO.	FISCAL YEAR	SHEET NO.	TOTAL SHEETS
HAWAII	HAW.	H11-01-08	2009	ADD. 29	73

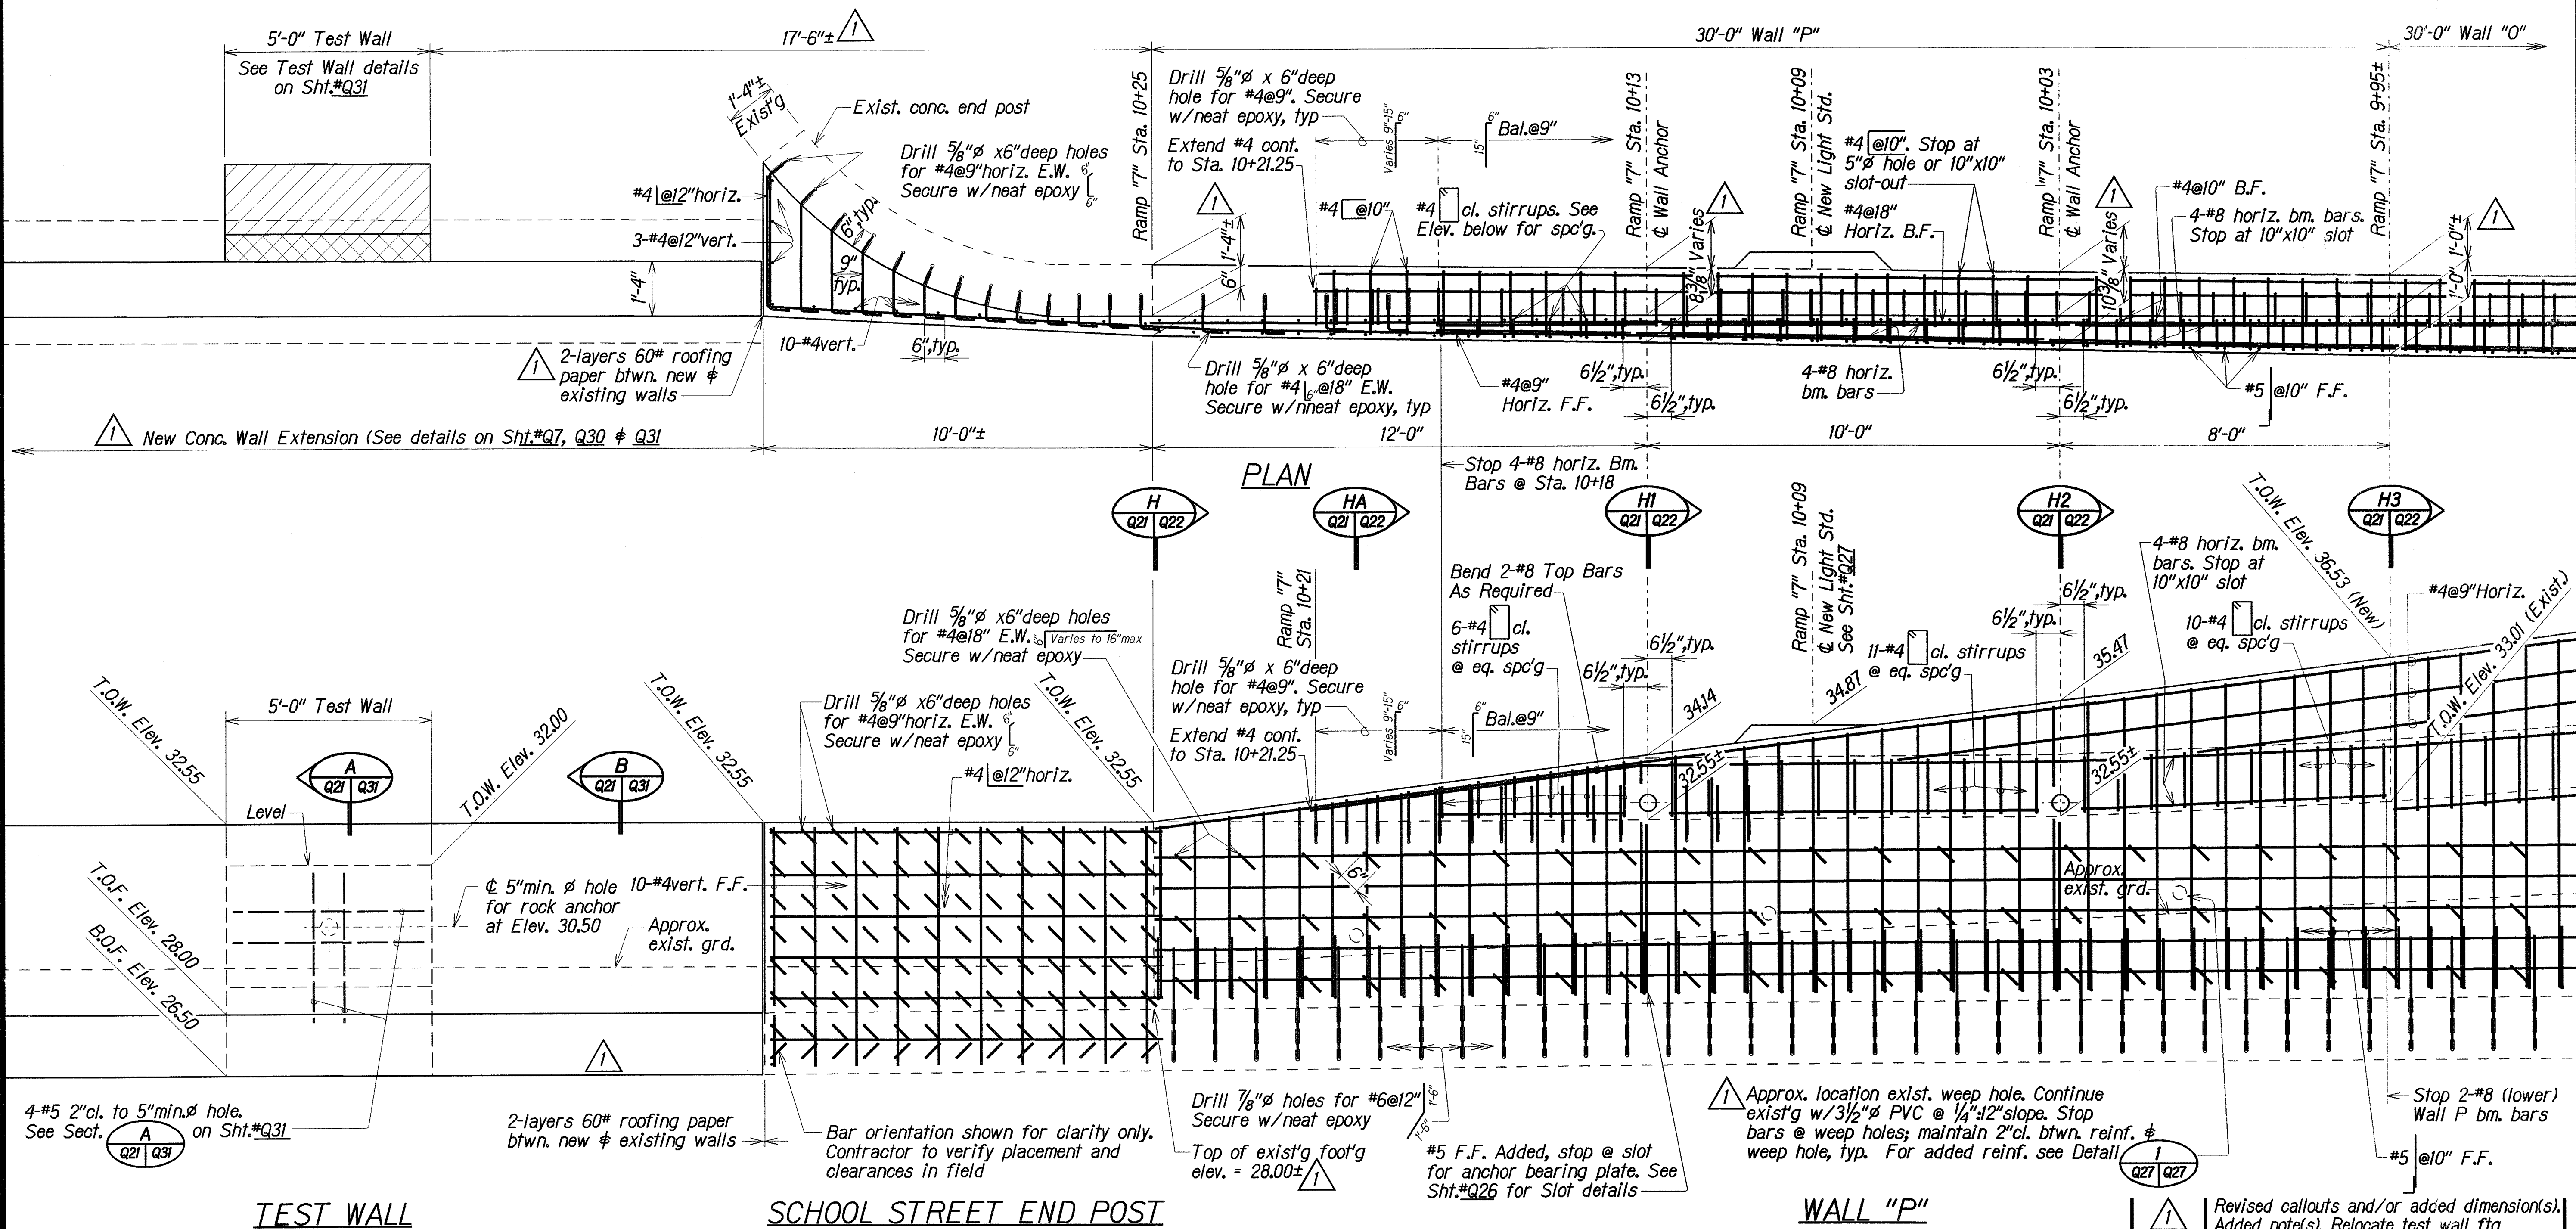

- LEGEND**
- Indicates Permanent Tieback Anchor
 - Indicates Existing Weep Hole


TEST WALL, SCHOOL STREET END POST and WALL "P" DETAILS
REPAIR of SCHOOL STREET ON-RAMP RETAINING WALL

Scale: 1/2" = 1'-0"

3/31/09	Revised callouts and/or added dimension(s). Added note(s). Relocate test wall ftg. lines. Added legend. Added Sec
DATE	DESCRIPTION
STATE OF HAWAII DEPARTMENT OF TRANSPORTATION HIGHWAYS DIVISION RETAINING WALL REPAIR TEST WALL, SCHOOL ST. END POST and WALL "P" DETAILS INTERSTATE ROUTE H-1 EXTENSION and REPAIR of SCHOOL STREET ON-RAMP RETAINING WALL Project No. H11-01-08	
Scale: As Noted	Date: Feb. 2009

SHEET No. Q21 OF 34 SHEETS


FED. ROAD DIST. NO.	STATE	PROJECT NO.	FISCAL YEAR	SHEET NO.	TOTAL SHEETS
HAWAII	HAW.	H11-01-08	2009	ADD. 30	73

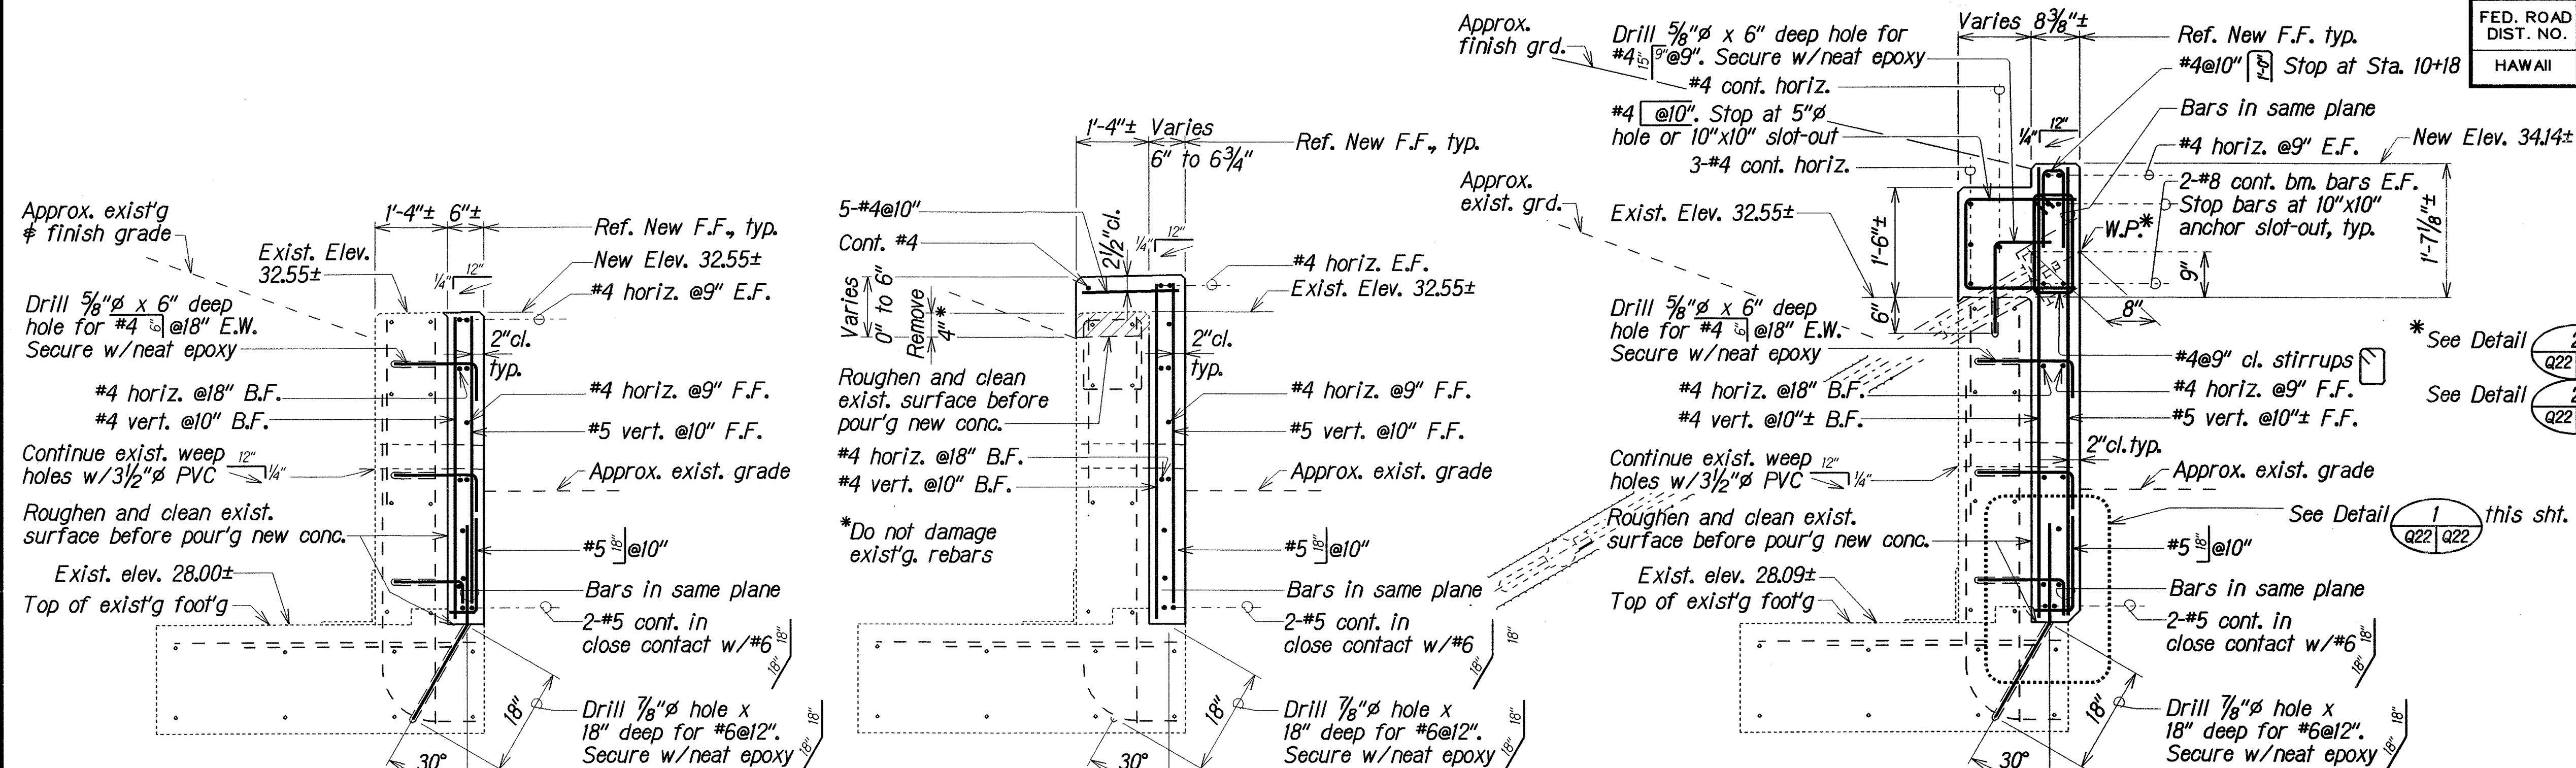


SECTION at RAMP 7 STA. 10+25±
Scale: 3/4" = 1'-0"

SECTION at RAMP 7 STA. 10+25± to 10+21.25
Scale: 3/4" = 1'-0"


SECTION at RAMP 7 STA. 10+13±
Scale: 3/4" = 1'-0"

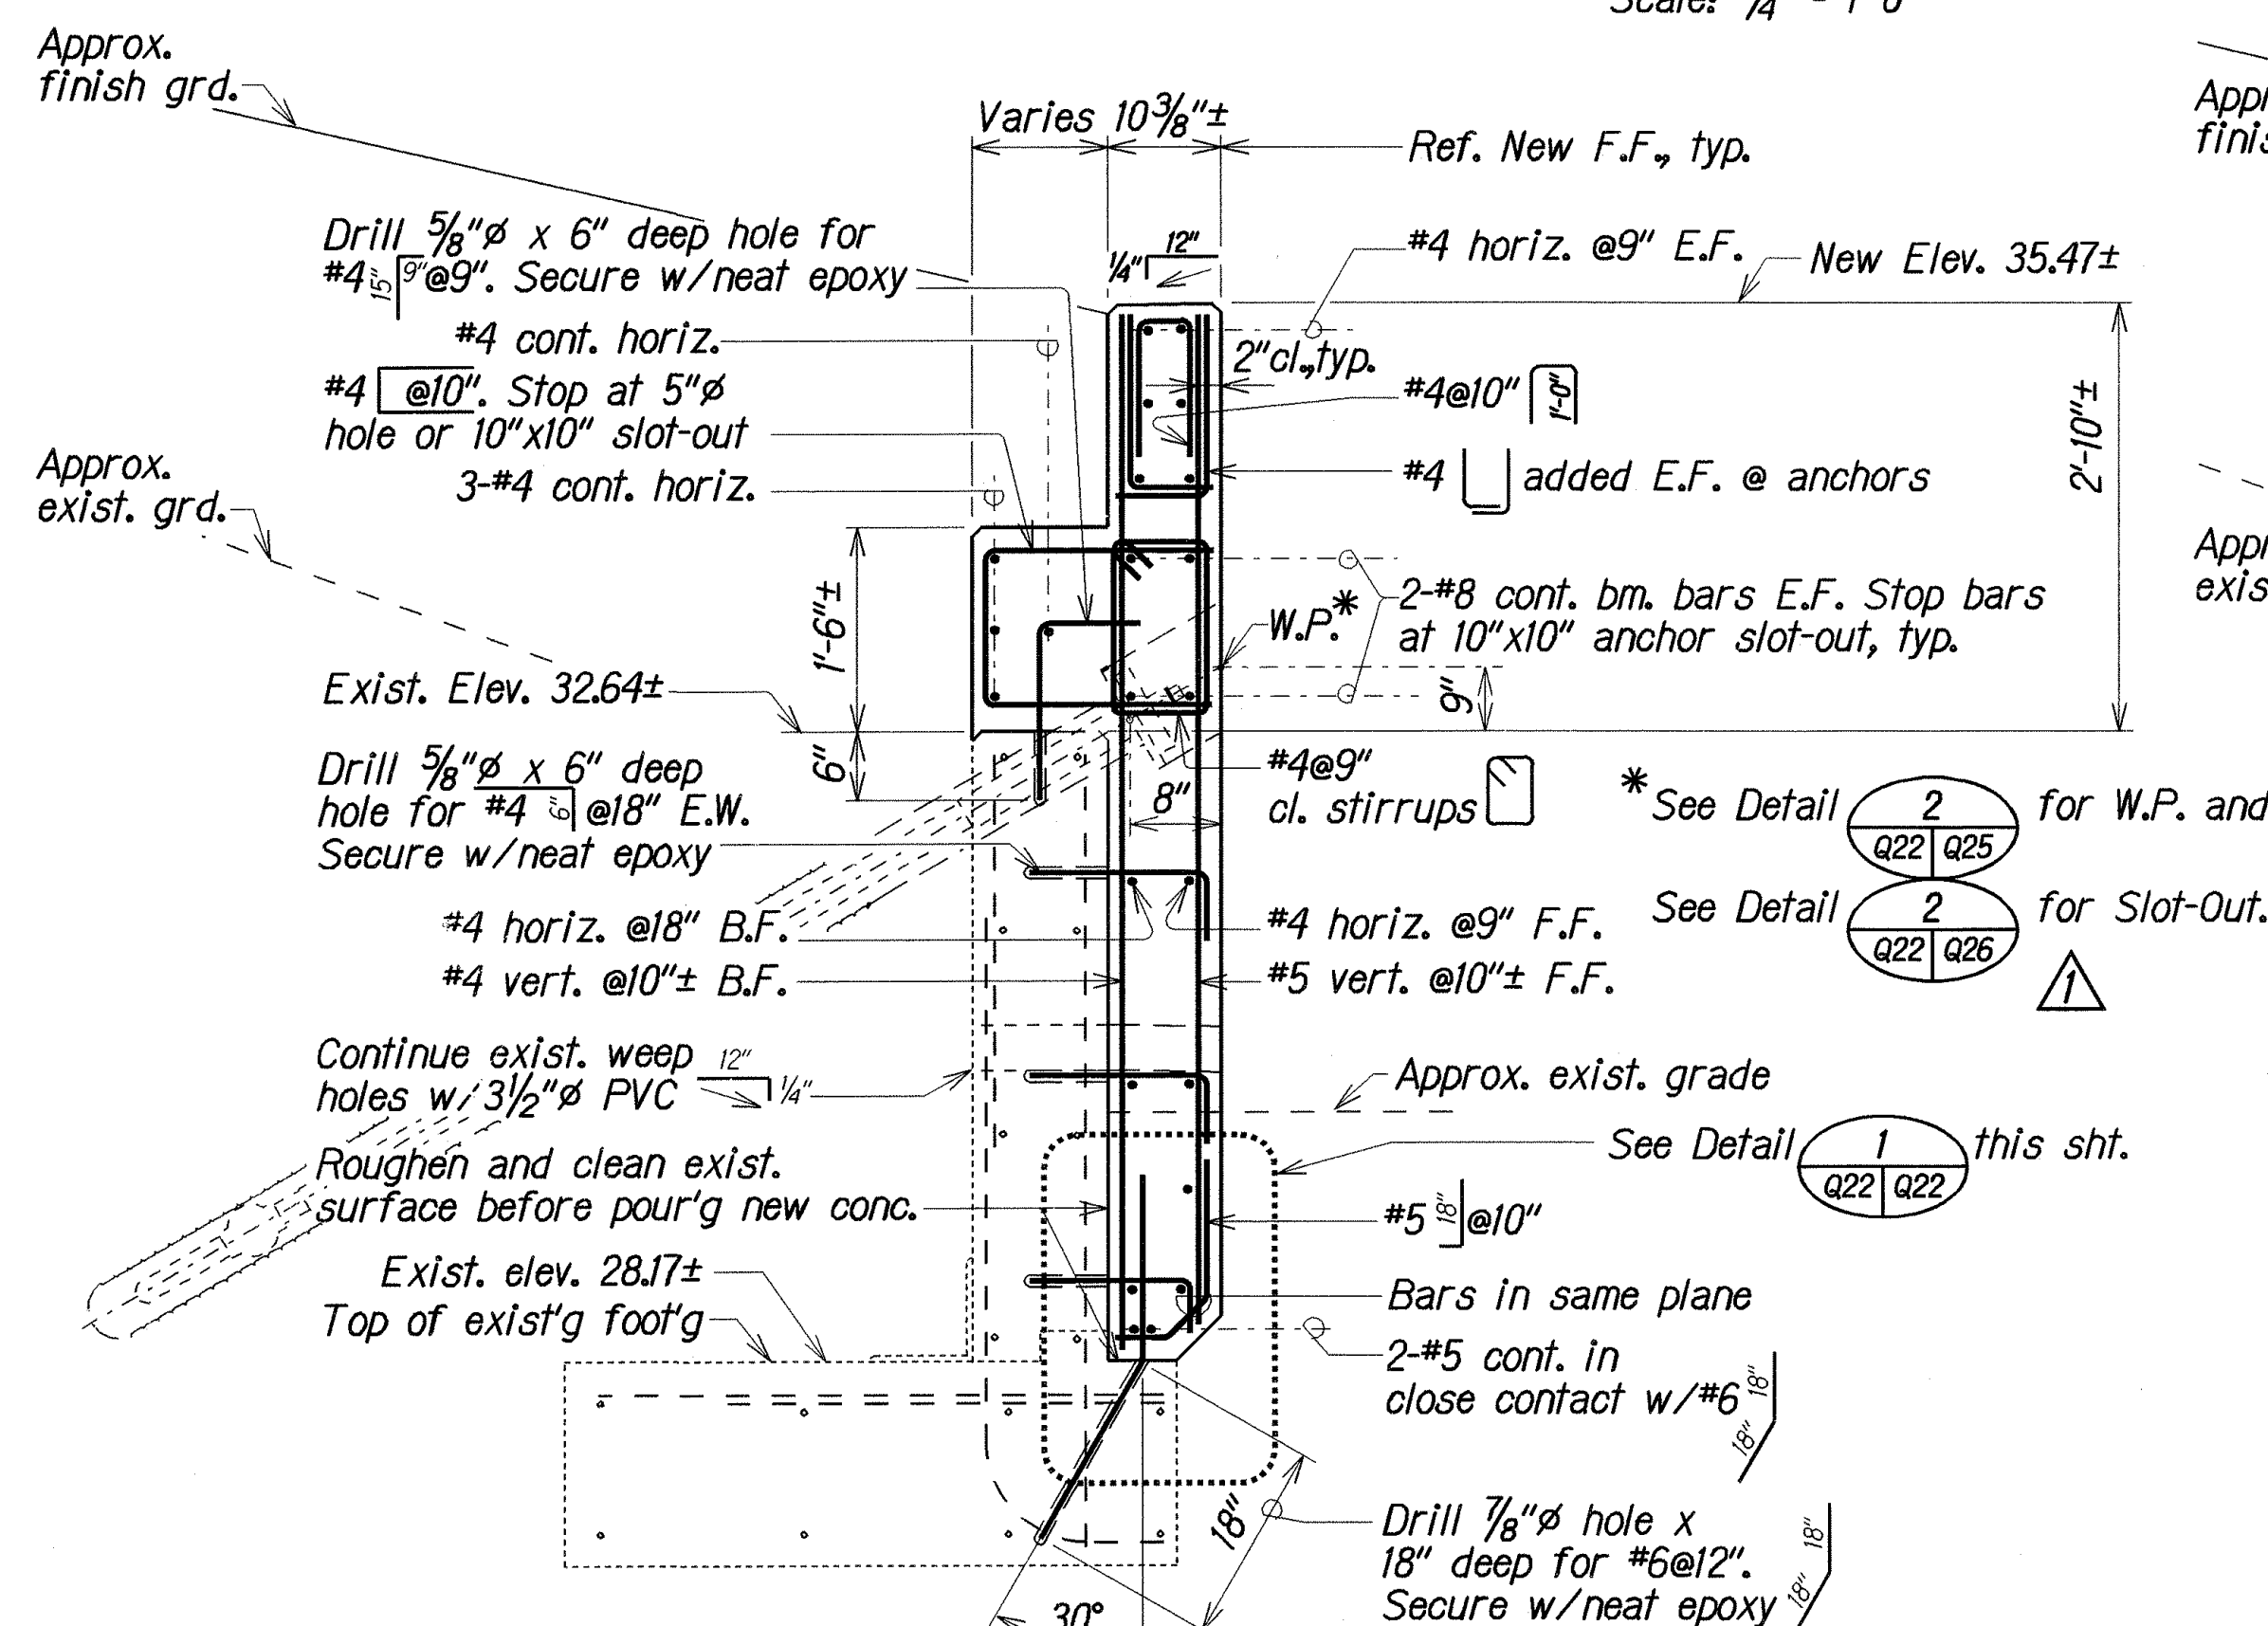

SECTION at RAMP 7 STA. 10+03±
Scale: 3/4" = 1'-0"

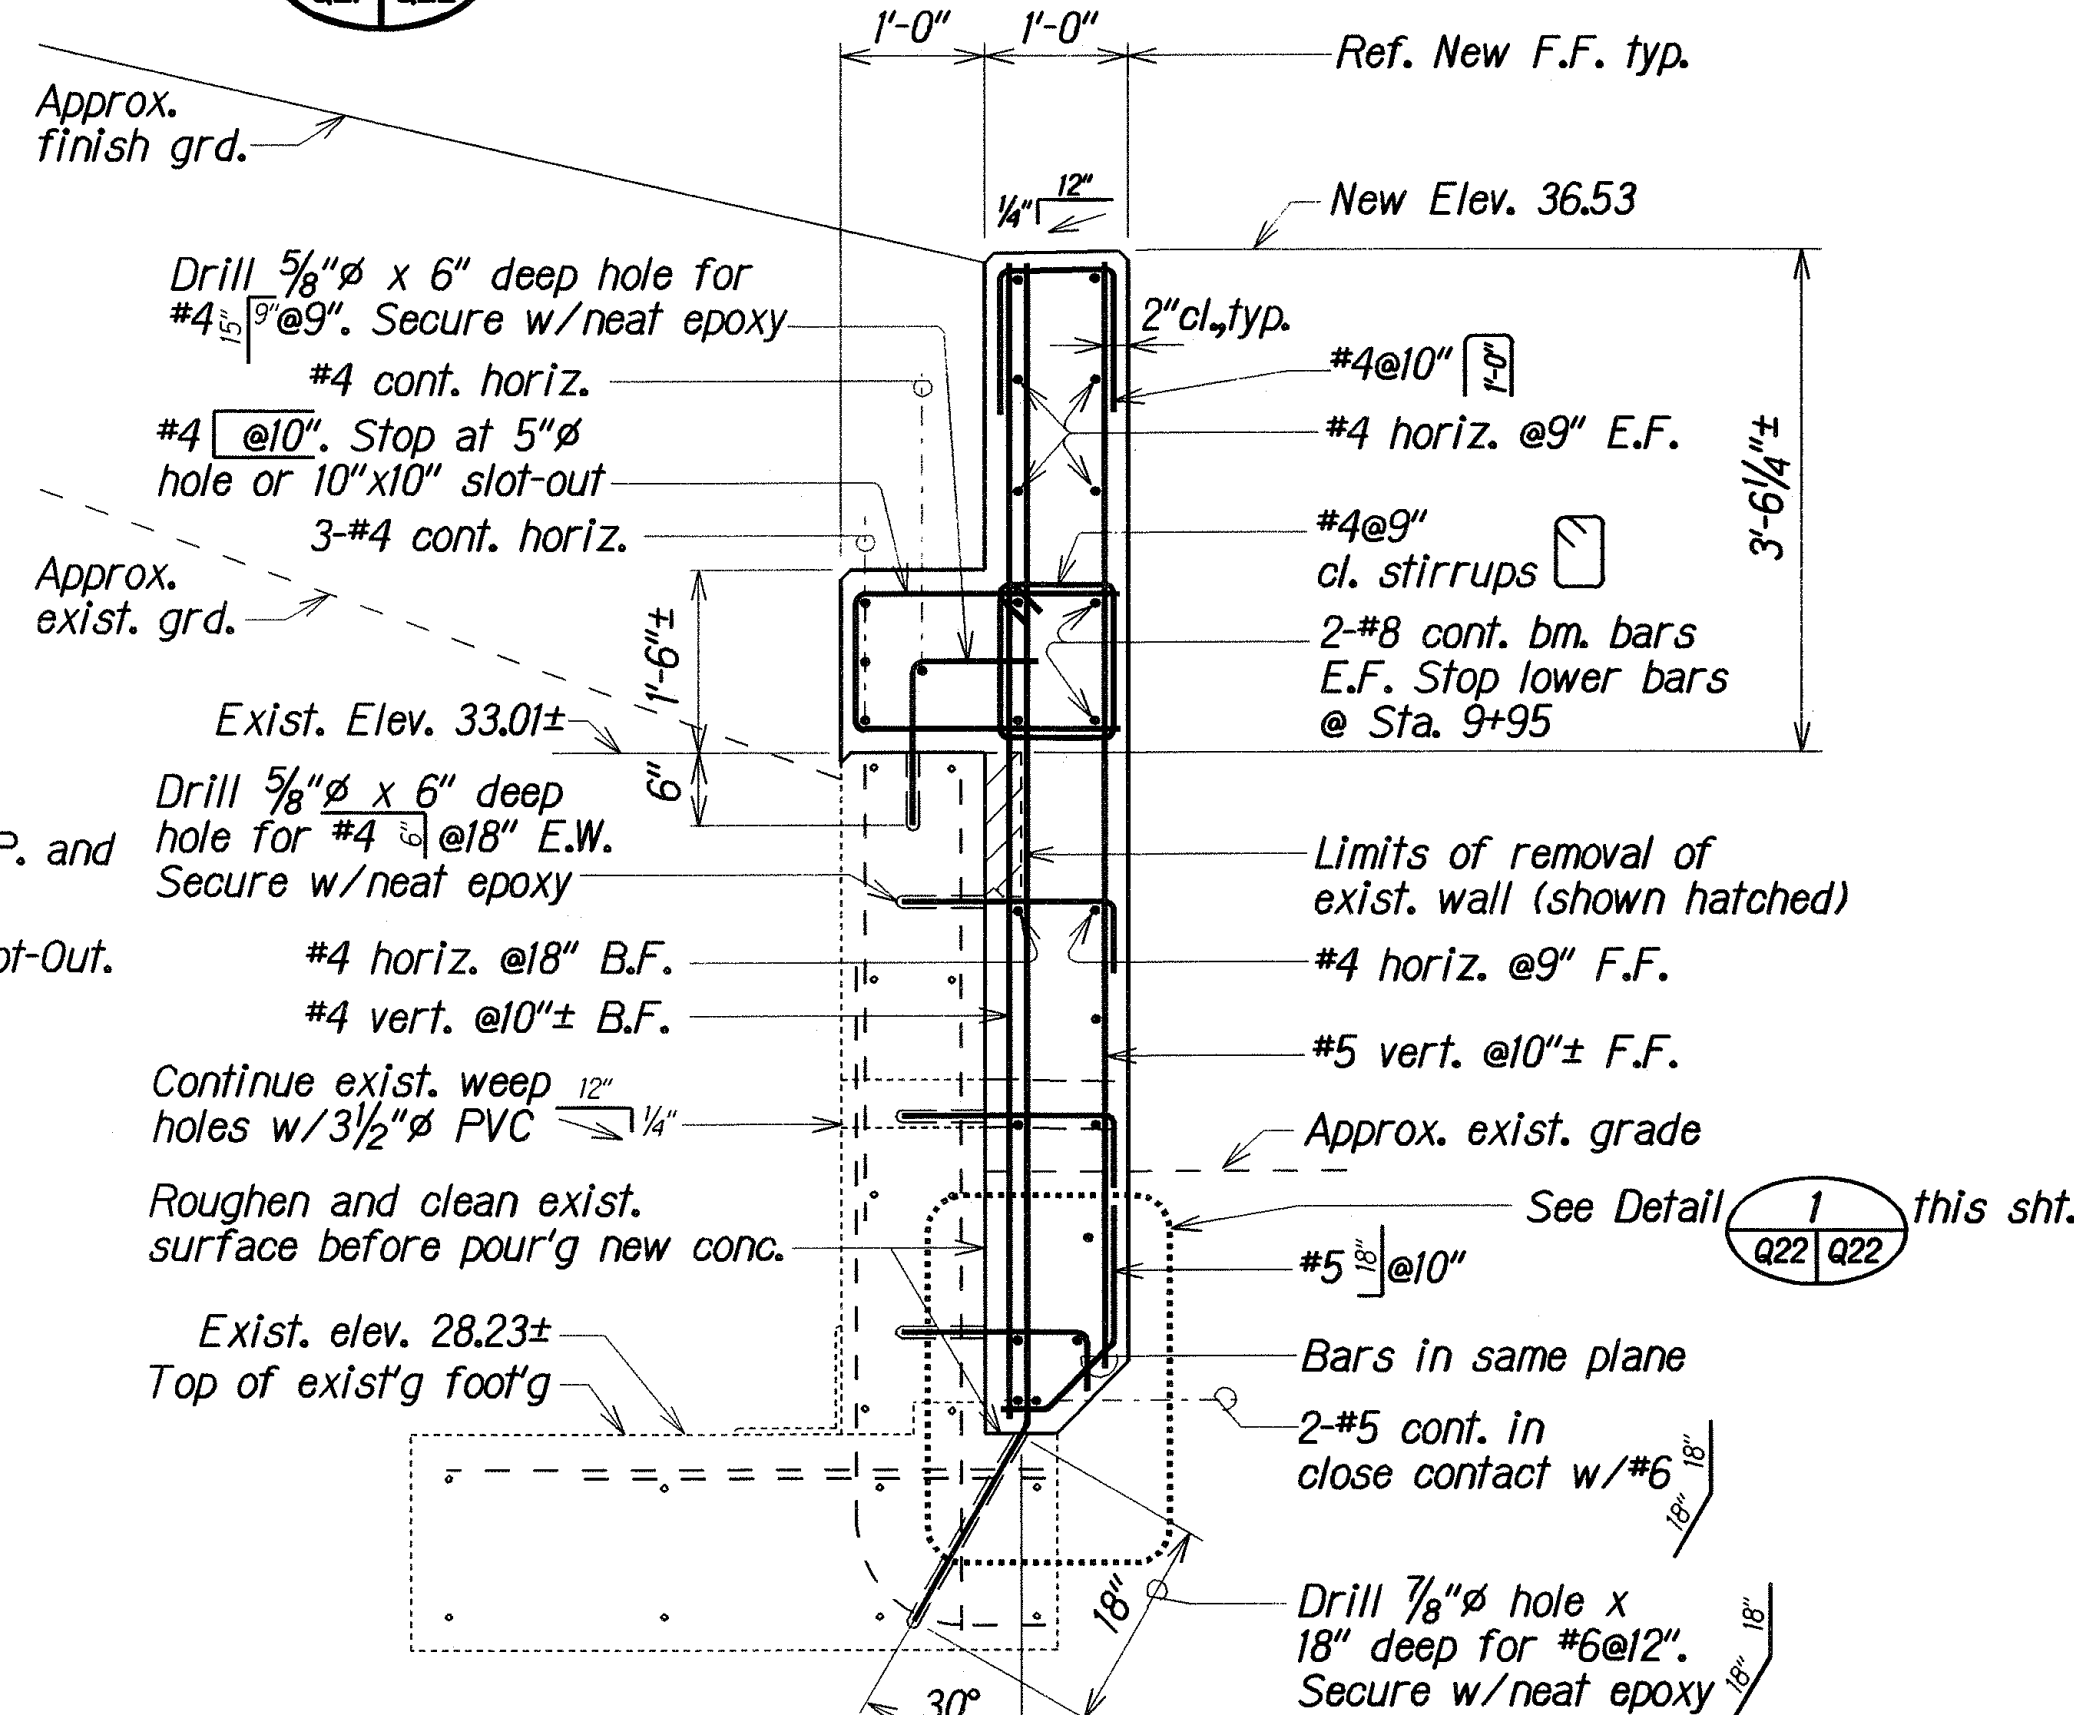

SECTION at RAMP 7 STA. 9+95±
Scale: 3/4" = 1'-0"

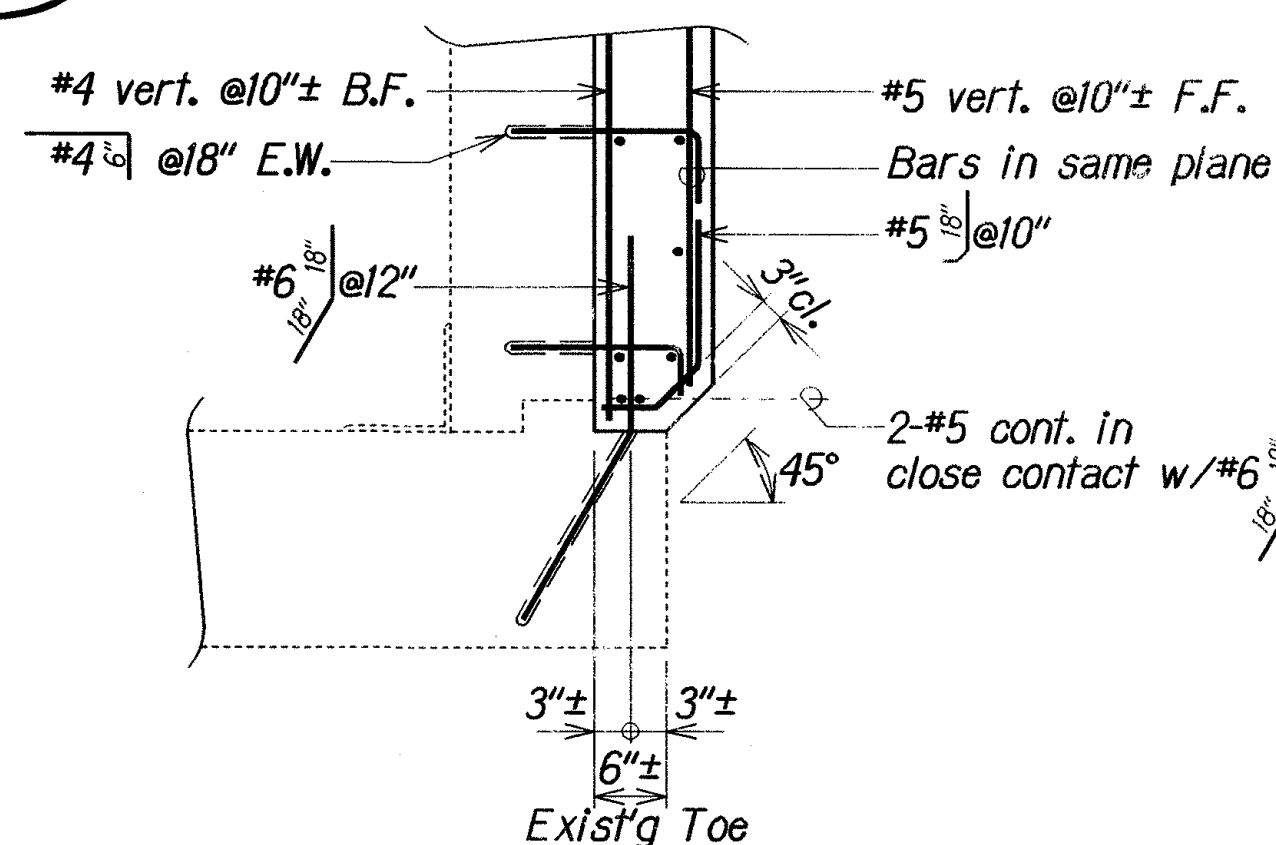

DETAIL
Scale: 3/4" = 1'-0"


Added Detail Symbol and Section	HA Q21/Q22
DATE	DESCRIPTION
3/31/09	STATE OF HAWAII DEPARTMENT OF TRANSPORTATION HIGHWAYS DIVISION RETAINING WALL REPAIR WALL "P" SECTIONS INTERSTATE ROUTE H-1 EXTENSION AND REPAIR OF SCHOOL STREET ON-RAMP RETAINING WALL Project No. H11-01-08
Scale: As Noted	Date: Feb. 2009
SHEET No. Q22 OF 34 SHEETS	

FED. ROAD DIST. NO.	STATE	FED. AID PROJ. NO.	FISCAL YEAR	SHEET NO.	TOTAL SHEETS
HAWAII	HAW.	H11-01-08	2009	31	73

PHYSICAL PROPERTIES OF ASTM A722 1" GR. 150 DYWIDAG THREADBAR OR APPROVED EQUAL	
Effective Area:	0.85 SQ. IN.
Ultimate Strength:	150 KSI
Ultimate Load:	127.5 KIPS
Yield Load:	102.8 KIPS
Max. Test Load:	102.0 KIPS
Weight:	3.01 LBS/FT
TOTAL NO. OF ANCHORS = 98 EACH	

NOTE:

- Refer to Contract Drawings for Anchor Locations & Details not shown.
 - For Walls "A" to "D", Drilling Thru Exist. Footing may be Required & Reinforcing Steel may be encountered.
- * Includes Both Top & Lower Anchors. Also Performance Test Panel Anchor.
- ** For Walls "B" to "D"
- *** For Walls "E" to "P" and Performance Test Wall

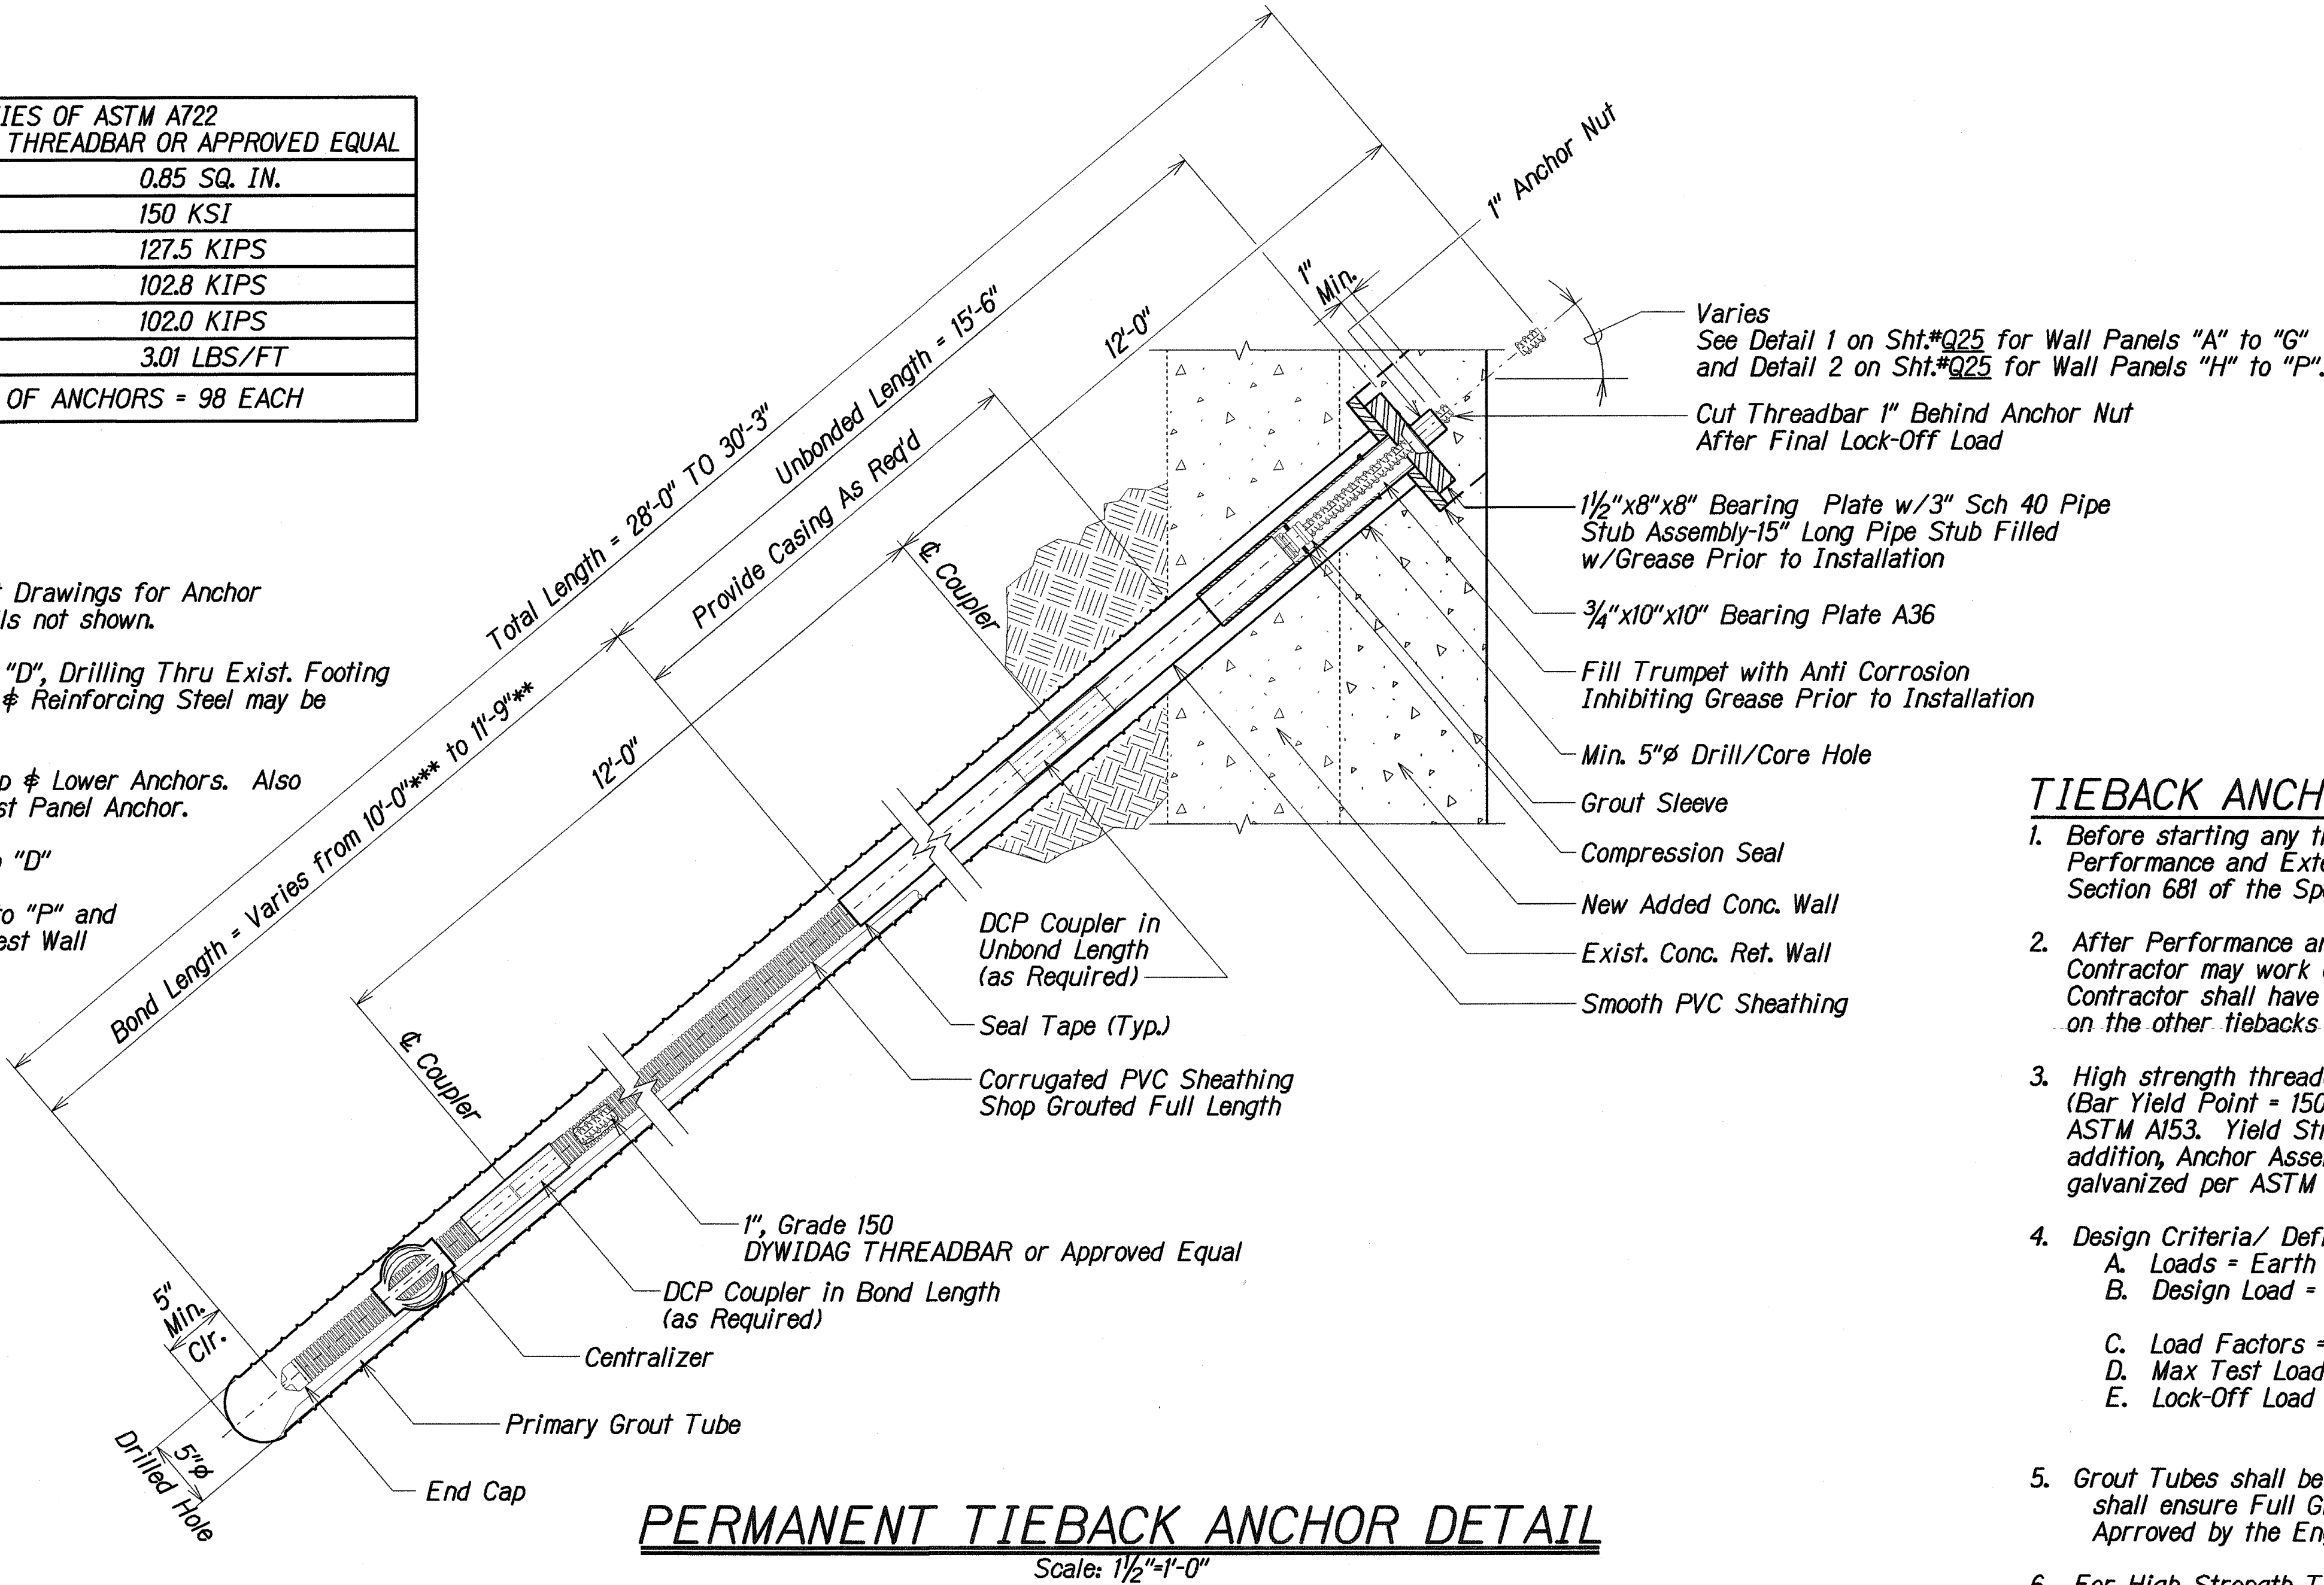

TIEBACK ANCHOR NOTES:

- Before starting any tieback work, Contractor shall have successfully completed the Performance and Extended Creep Test on the Test Panel located at Sta. 10+42.5±. See Section 681 of the Special Provisions.
- After Performance and Extended Creep Tests have been successfully completed, Contractor may work on the various retaining wall panels. For each wall panel (A through P), Contractor shall have successfully completed the specified proof tests before doing any work on the other tiebacks for that wall panel. See Section 681 of the Special Provisions.
- High strength threaded bar shall be 1" diameter per ASTM A722, Type II, Grade 150 (Bar Yield Point = 150 KIPS/in.² and Ultimate Load = 127.5 KIPS) and Galvanized Per ASTM A153. Yield Strength shall not be reduced by more than 5% after galvanized. In addition, Anchor Assembly, including angle compensating nuts or bevel washers shall be galvanized per ASTM A153.
- Design Criteria/ Definitions
 - Loads = Earth Pressure + Live Load Surcharge + Fluid Pressure of Undrained Water
 - Design Load = Earth Pressure (E.P.) - 100 lb./ft.³; Live Load Surcharge - 2.0 x E.P.; Fluid Pressure(Undrained Water) - 62.4 lb./ft.³
 - Load Factors = Earth Pressure 1.5; Live Load Surcharge - 1.75 & Fluid Pressure - 1.0
 - Max Test Load = 1.5 Time Design Load
 - Lock-Off Load = Min. 5% of Design Load
Max. 10% of Design Load
- Grout Tubes shall be placed through the Bearing Steel Plate. Size and Locations shall ensure Full Grouting of Hole. The Contractor Shall Submit Grouting Details for Approved by the Engineer.
- For High Strength Threaded Bar or Equal.
 - Do Not Weld Bar.
 - Do Not Use Bar as Ground Connection for Welding
 - Do not Allow Hot Slag or Sparks to Touch Bar.
 - Do Not Damage Bar Surface
- Provide Casing for Unbonded portion of bored hole until rock is encountered.

TIEBACK TABLE				
ANCHOR LOCATION	DESIGN LOAD (KIPS) 0.53 f's MAX.	PERFORMANCE TEST LOAD AND EXTENDED CREEP (KIPS) *	TRANSFER (LOCKOFF) LOAD (KIPS) MIN. - MAX.	PROOF LOAD (KIPS)
TOP ROW	68	102	3.4 - 6.8	68
BOTTOM ROW	34	-	1.7 - 3.4	34

f's = ULTIMATE TENSILE STRENGTH OF THE TENDON
TRANSER (LOCKOFF) LOAD SHOWN IS AFTER SATISFACTORY PROOF LOAD IS COMPLETED.

* See sheet #Q31.


ORIGINAL PLAN	SURVEY PLOTTED BY	DATE
DESIGNED BY	DRAWN BY	XXX 2009
CHECKED BY	TRACED BY	XXX 2009
NOTED BY	DESIGNED BY	XXX 2009
CHECKED BY	CHECKED BY	XXX 2009

STATE OF HAWAII
DEPARTMENT OF TRANSPORTATION
HIGHWAYS DIVISION

RETAINING WALL REPAIR
PERMANENT TIEBACK ANCHOR DETAIL AND NOTES
INTERSTATE ROUTE H-1
EXTENSION AND REPAIR OF
SCHOOL STREET ON-RAMP RETAINING WALL
Project No. H11-01-08

Scale: As Noted
Date: Feb., 2009

FED. ROAD DIST. NO.	STATE	FED. AID PROJ. NO.	FISCAL YEAR	SHEET NO.	TOTAL SHEETS
HAWAII	HAW.	H11-01-08	2009	32	73

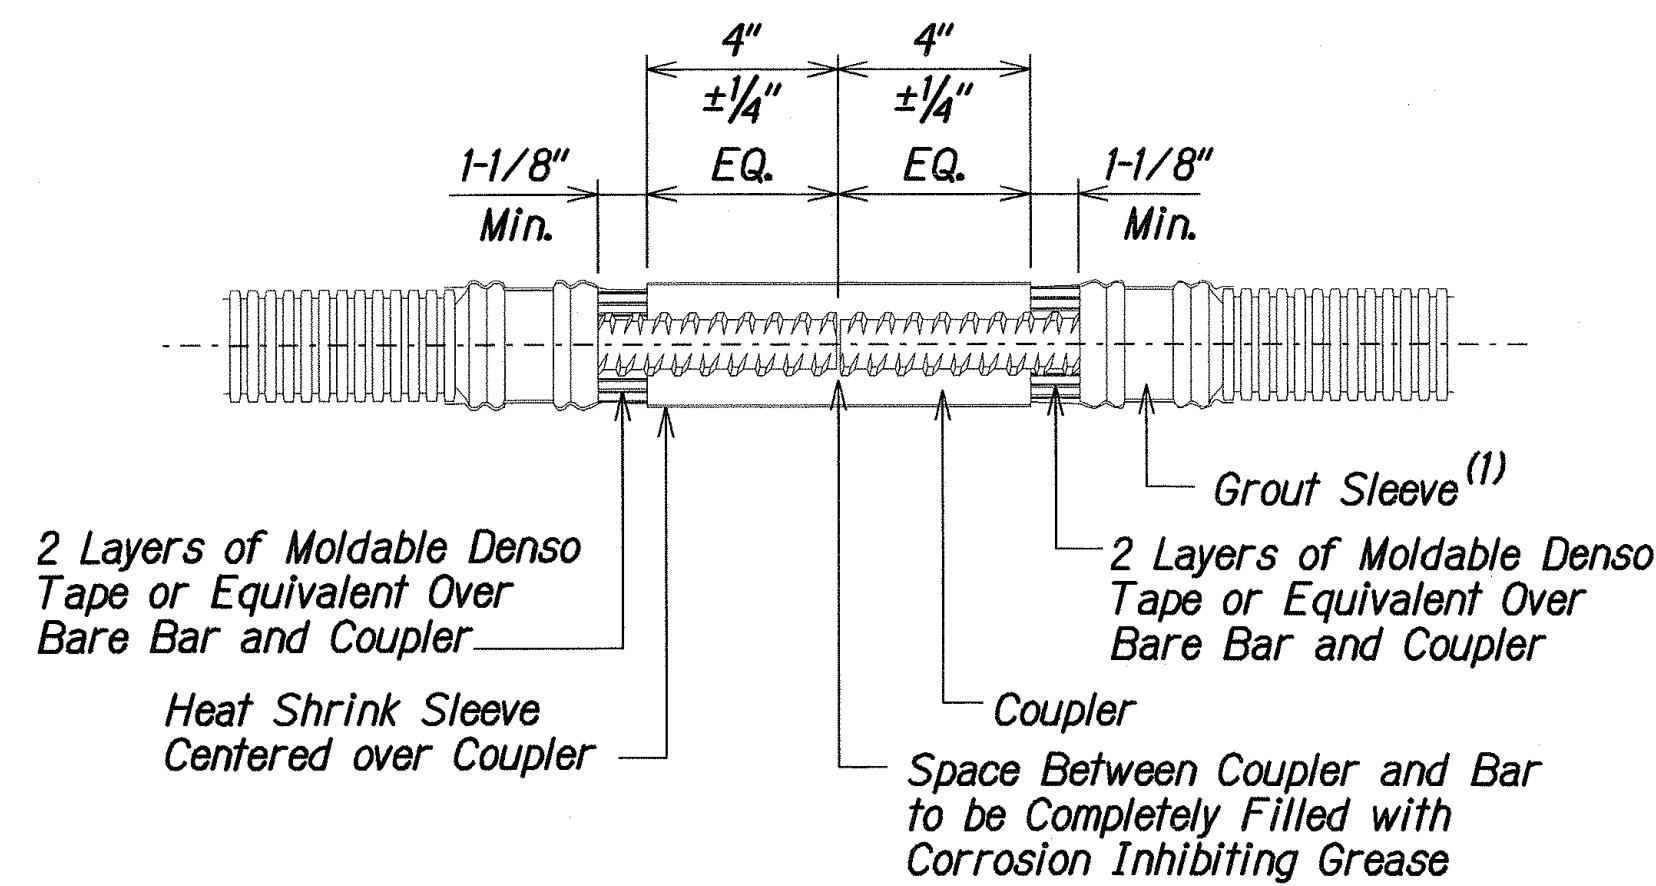

COUPLER INSTALLATION PROCEDURE:


1. Apply Corrosion Inhibiting Grease to the bare ends of the bars and the inside of the coupler.
2. Connect the two bar ends with the coupler. Each end shall be screwed into the coupler half the length of the coupler.
3. Torque bar ends together (200 FT. LBS.).
4. Add another coat of grease to bare bar and coupler and wrap with two layers of Denso Tape or equivalent.
5. Center heat shrink sleeve over coupler and apply heat until sleeve is fully recovered.

PREPARATION FOR FIELD CUT BARS:

1. Cut corrosion protection and thread bar with abrasive saw (Do Not Use a Torch).
2. Carefully remove 4" $\pm 1/4$ " of corrugated PVC and cement grout from end of the new cut.

(1) Delete Grout Sleeve on Field Cut Tendons

1" DOUBLE CORROSION PROTECTED COUPLER FOR BONDED LENGTH

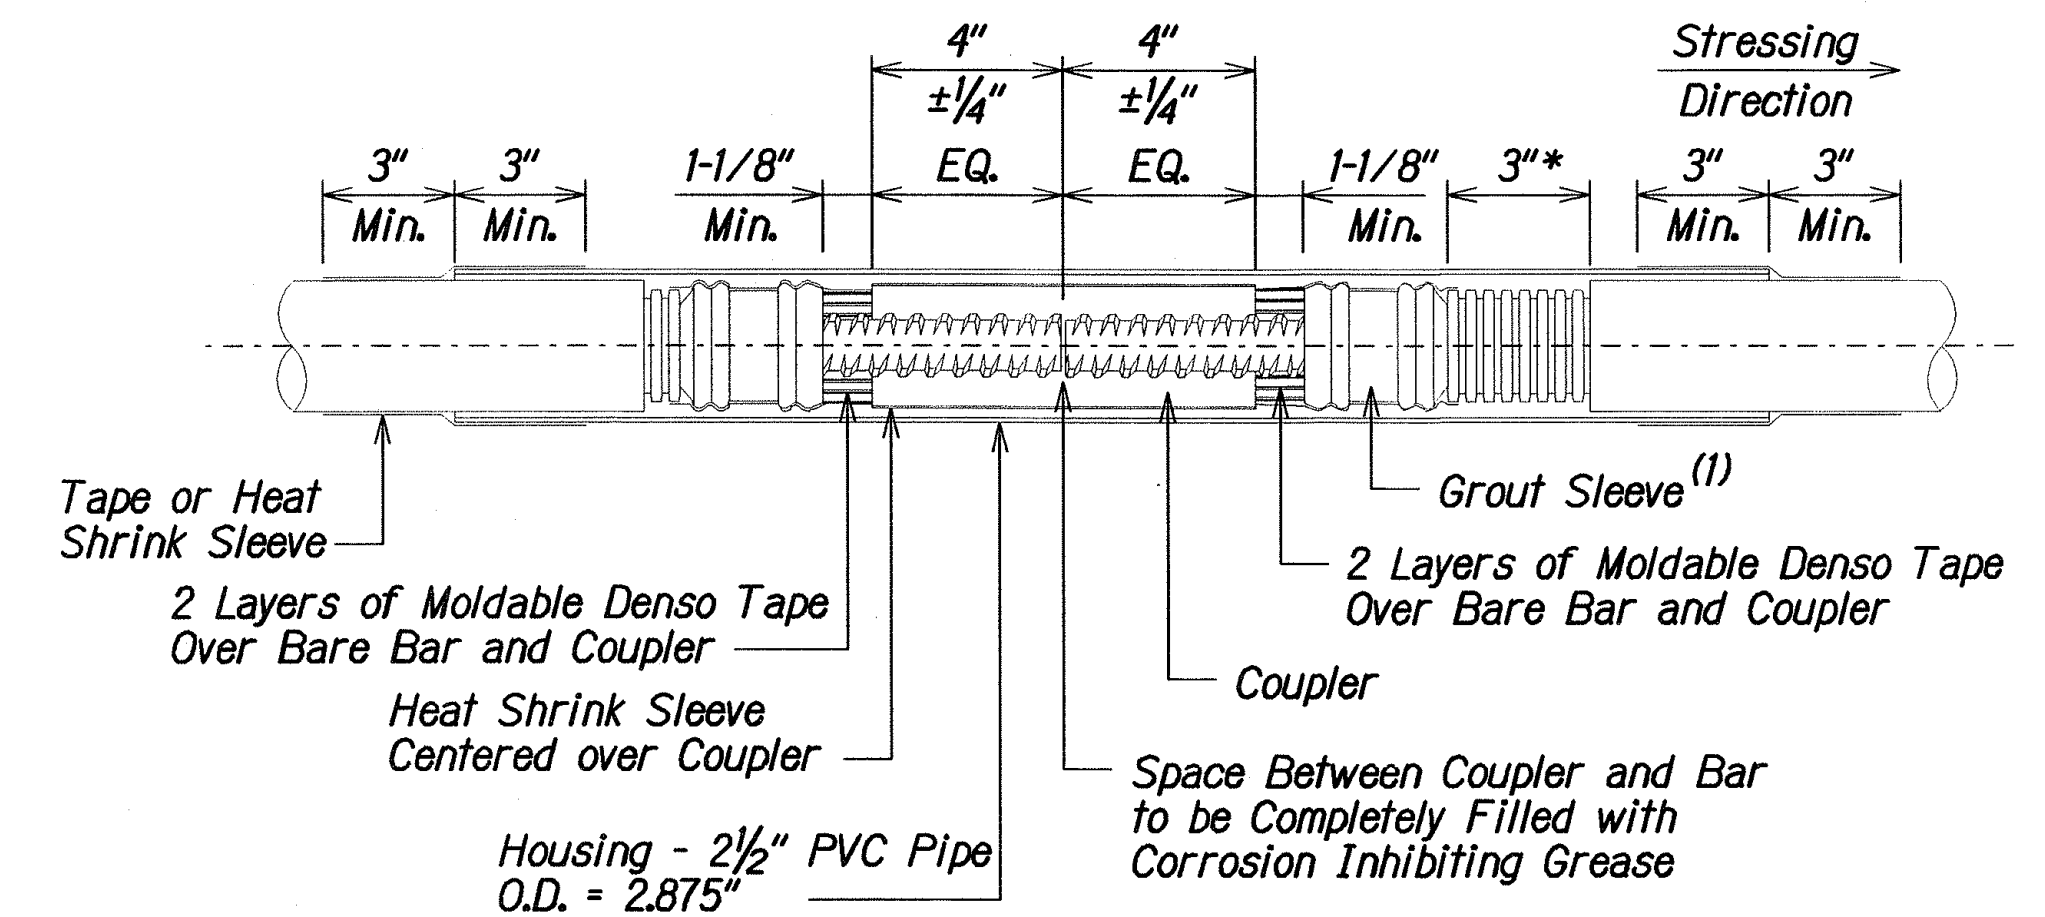

COUPLER INSTALLATION PROCEDURE:

1. Apply Corrosion Inhibiting Grease to the bare ends of the bars and the inside of the coupler.
2. Connect the two bar ends with the coupler. Each end shall be screwed into the coupler half the length of the coupler.
3. Torque bar ends together (200 FT. LBS.).
4. Add another coat of grease to bare bar and coupler and wrap with two layers of Denso Tape or equivalent.
5. Center heat shrink sleeve over coupler and apply heat until sleeve is fully recovered.
6. Slide the coupler and apply tape or heat shrink sleeve at each side.

PREPARATION FOR FIELD CUT BARS:

1. Cut corrosion protection and thread bar with abrasive saw (Do Not Use a Torch).
2. Carefully remove 4" $\pm 1/4$ " of corrugated PVC and cement grout from end of the new cut.

(1) Delete Grout Sleeve on Field Cut Tendons


* This dimension is necessary for coupler movement during stressing with Max. 1/2" elastic stressing elongation for every 10 ft. of bar 3" are adequate to accommodate the elastic elongation for 60' of bar length, measured from the coupler to the center of the bonded length. This dimension must be increased, if more than 3" of moment are expected.

1" DOUBLE CORROSION PROTECTED COUPLER FOR UNBONDED LENGTH

ORIGINAL PLAN	DATE
DESIGNED BY	XXX 2009
TRACED BY	XXX 2009
NOTE BOOK	XXX 2009
QUANTITIES BY	XXX 2009
CHECKED BY	XXX 2009


STATE OF HAWAII DEPARTMENT OF TRANSPORTATION HIGHWAYS DIVISION
RETAINING WALL REPAIR PERMANENT TIEBACK ANCHOR DETAIL AND NOTES INTERSTATE ROUTE H-1 EXTENSION AND REPAIR OF SCHOOL STREET ON-RAMP RETAINING WALL Project No. H11-01-08
Scale: As Noted Date: Feb, 2009
SHEET No. Q24 OF 34 SHEETS

FED. ROAD DIST. NO.	STATE	PROJ. NO.	FISCAL YEAR	SHEET NO.	TOTAL SHEETS
HAWAII	HAW.	H11-01-08	2009	C.O. 33	73

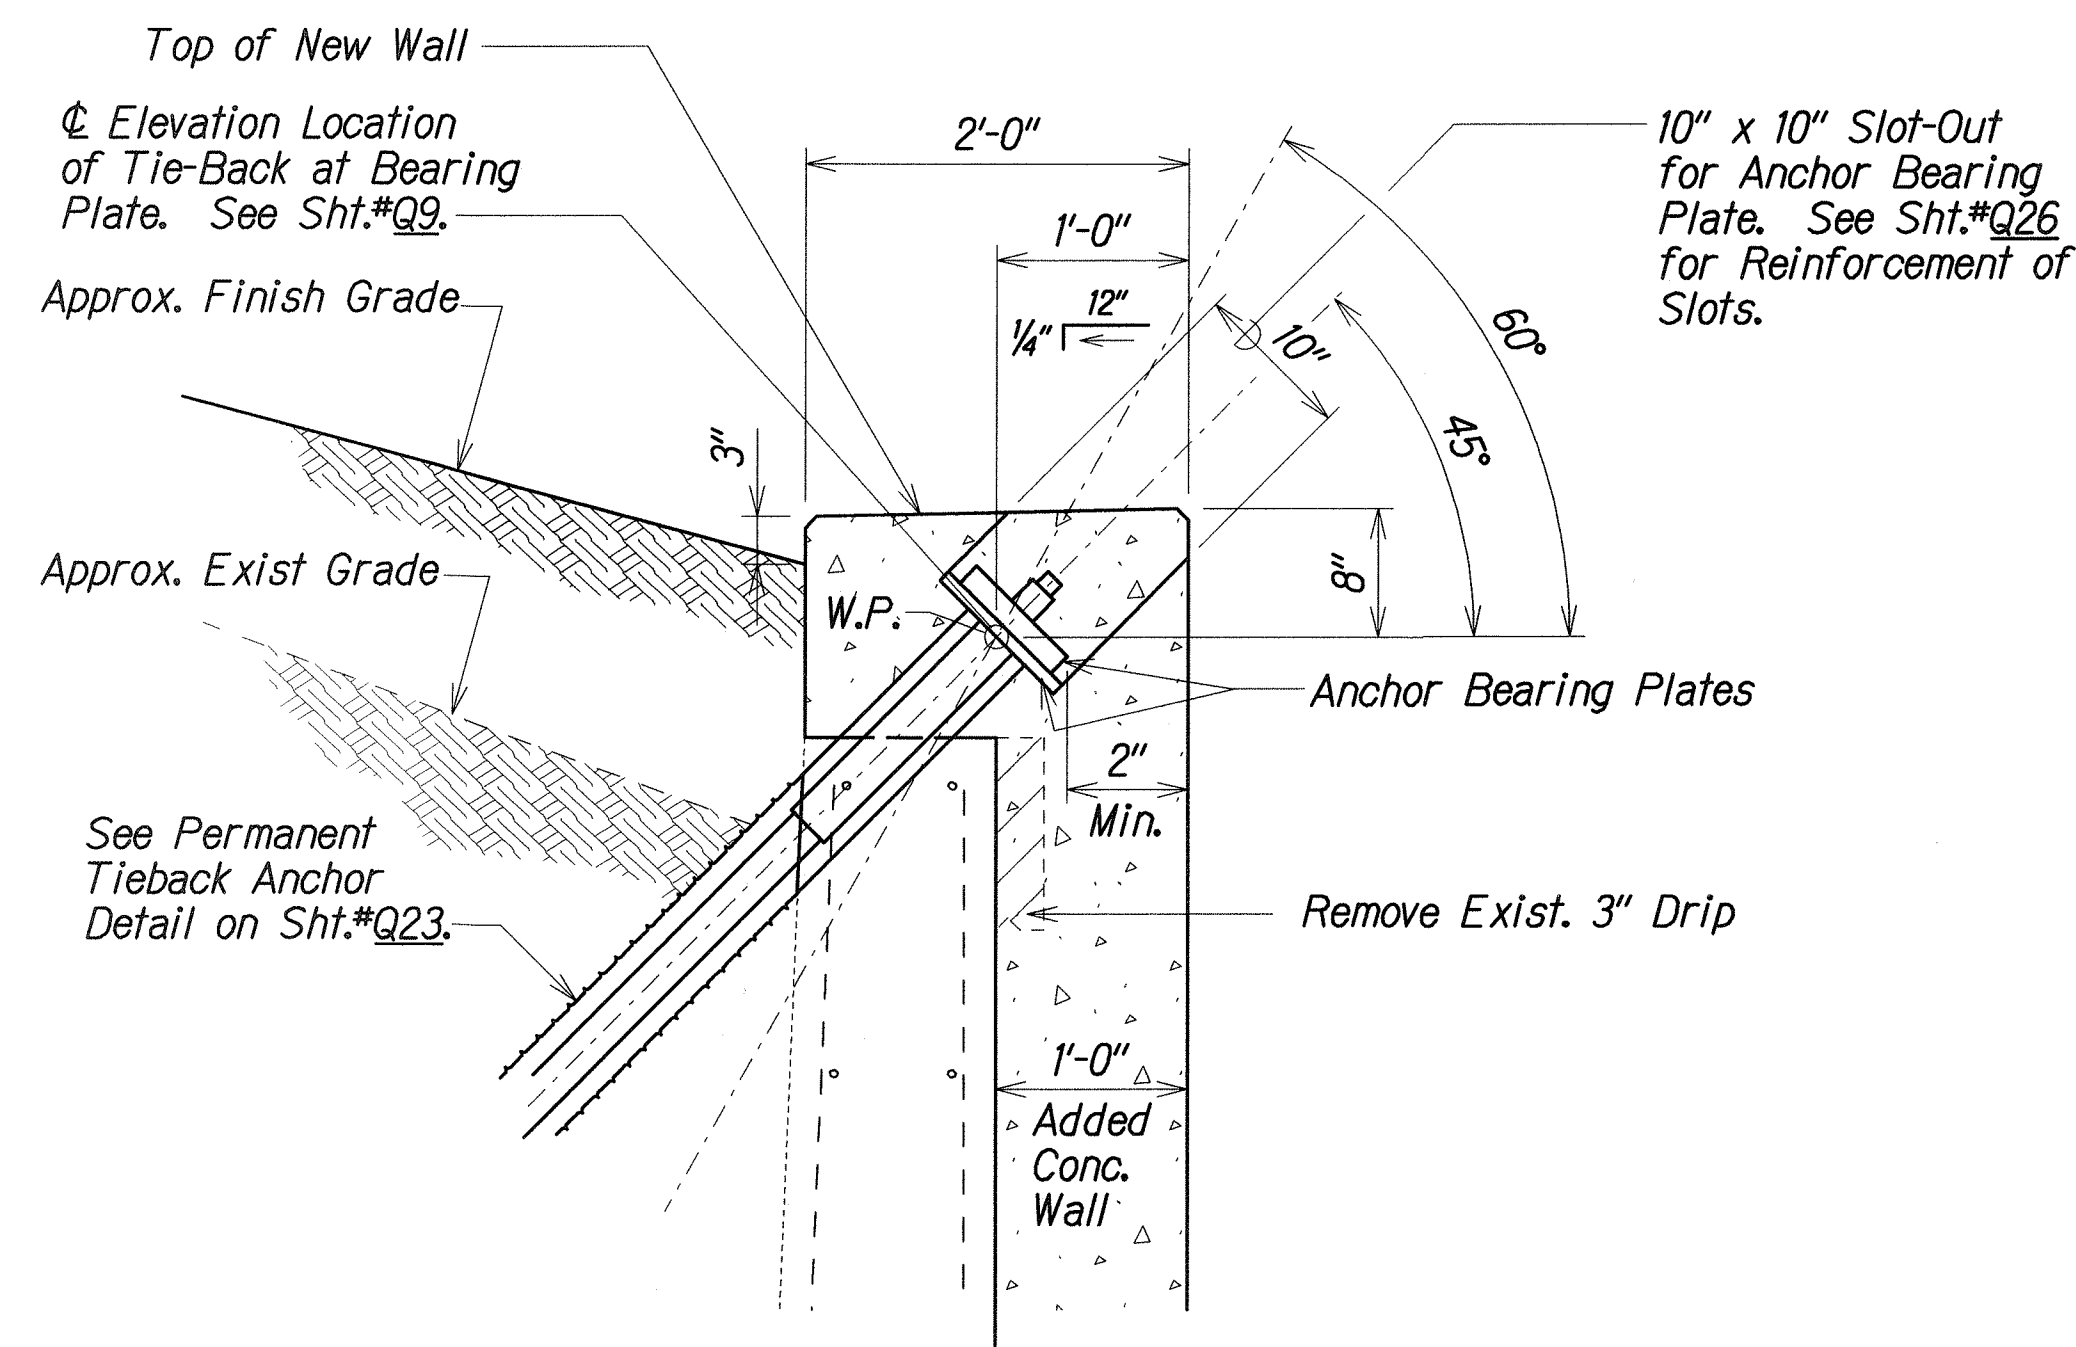


Walls A to G

DETAIL 1
Scale: 1"=1'-0"
Q11, Q12

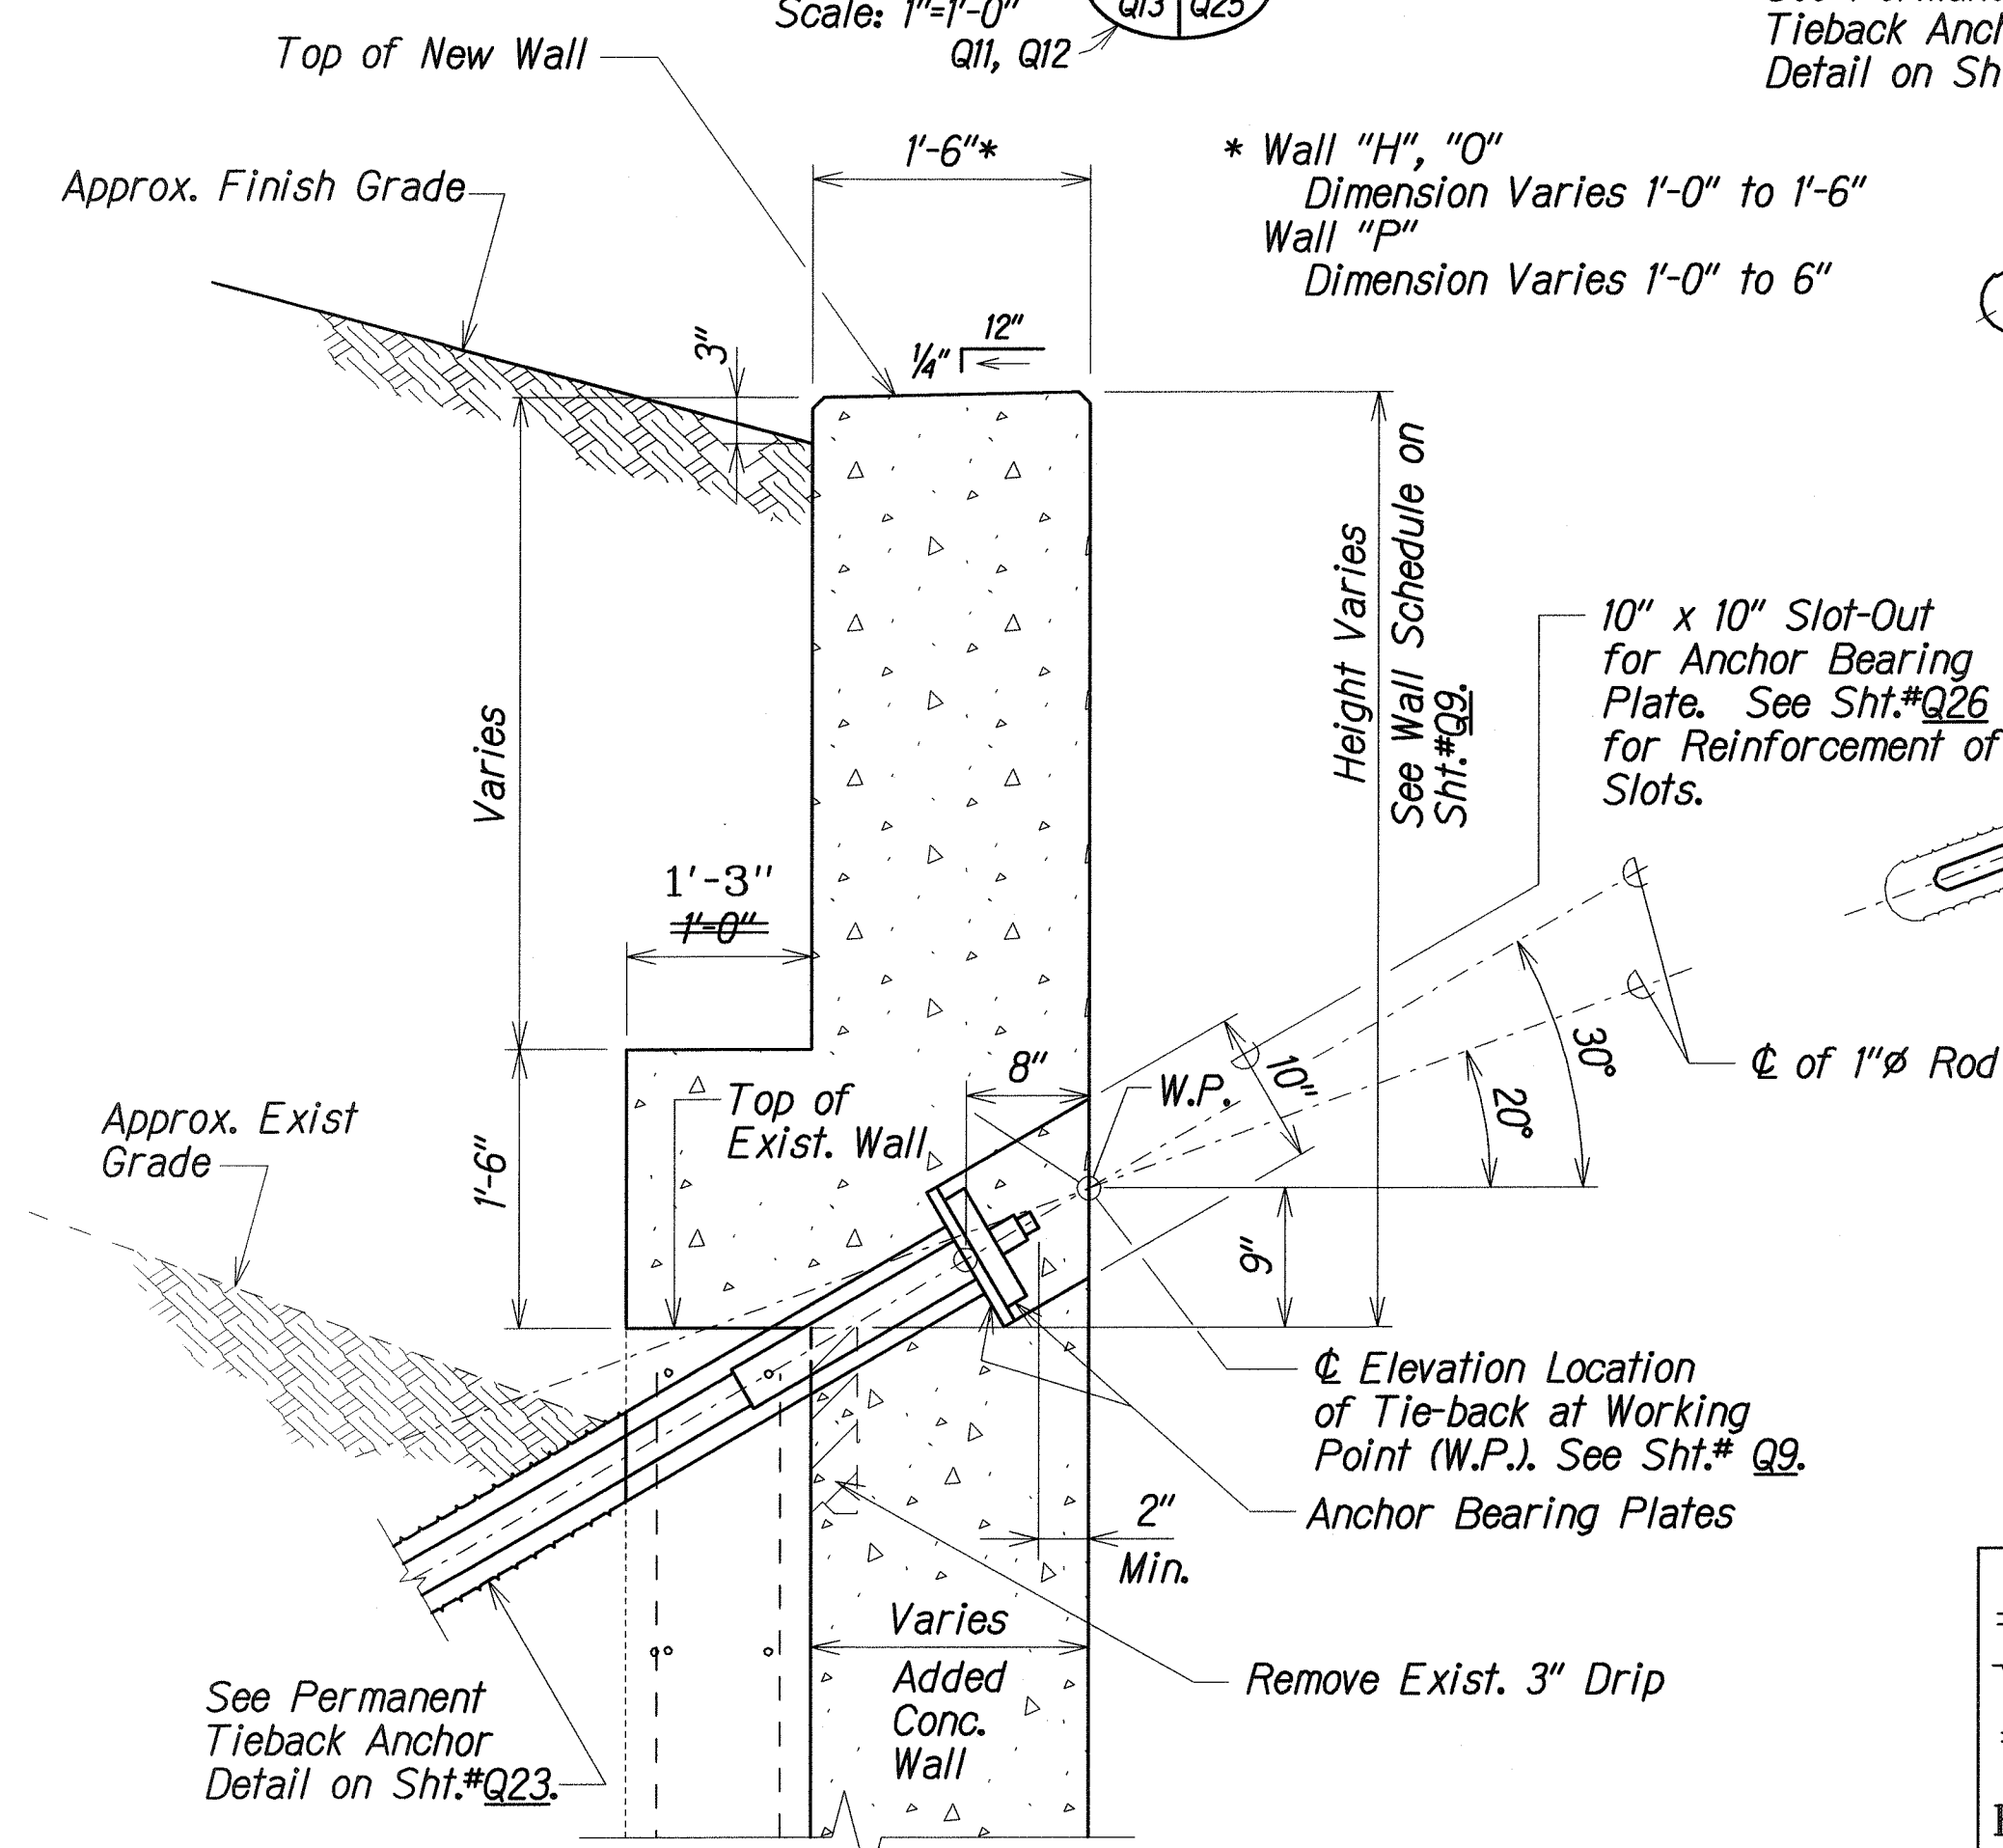

Walls H to P

DETAIL 2
Scale: 1"=1'-0"
Q17, Q19, Q20, Q25A

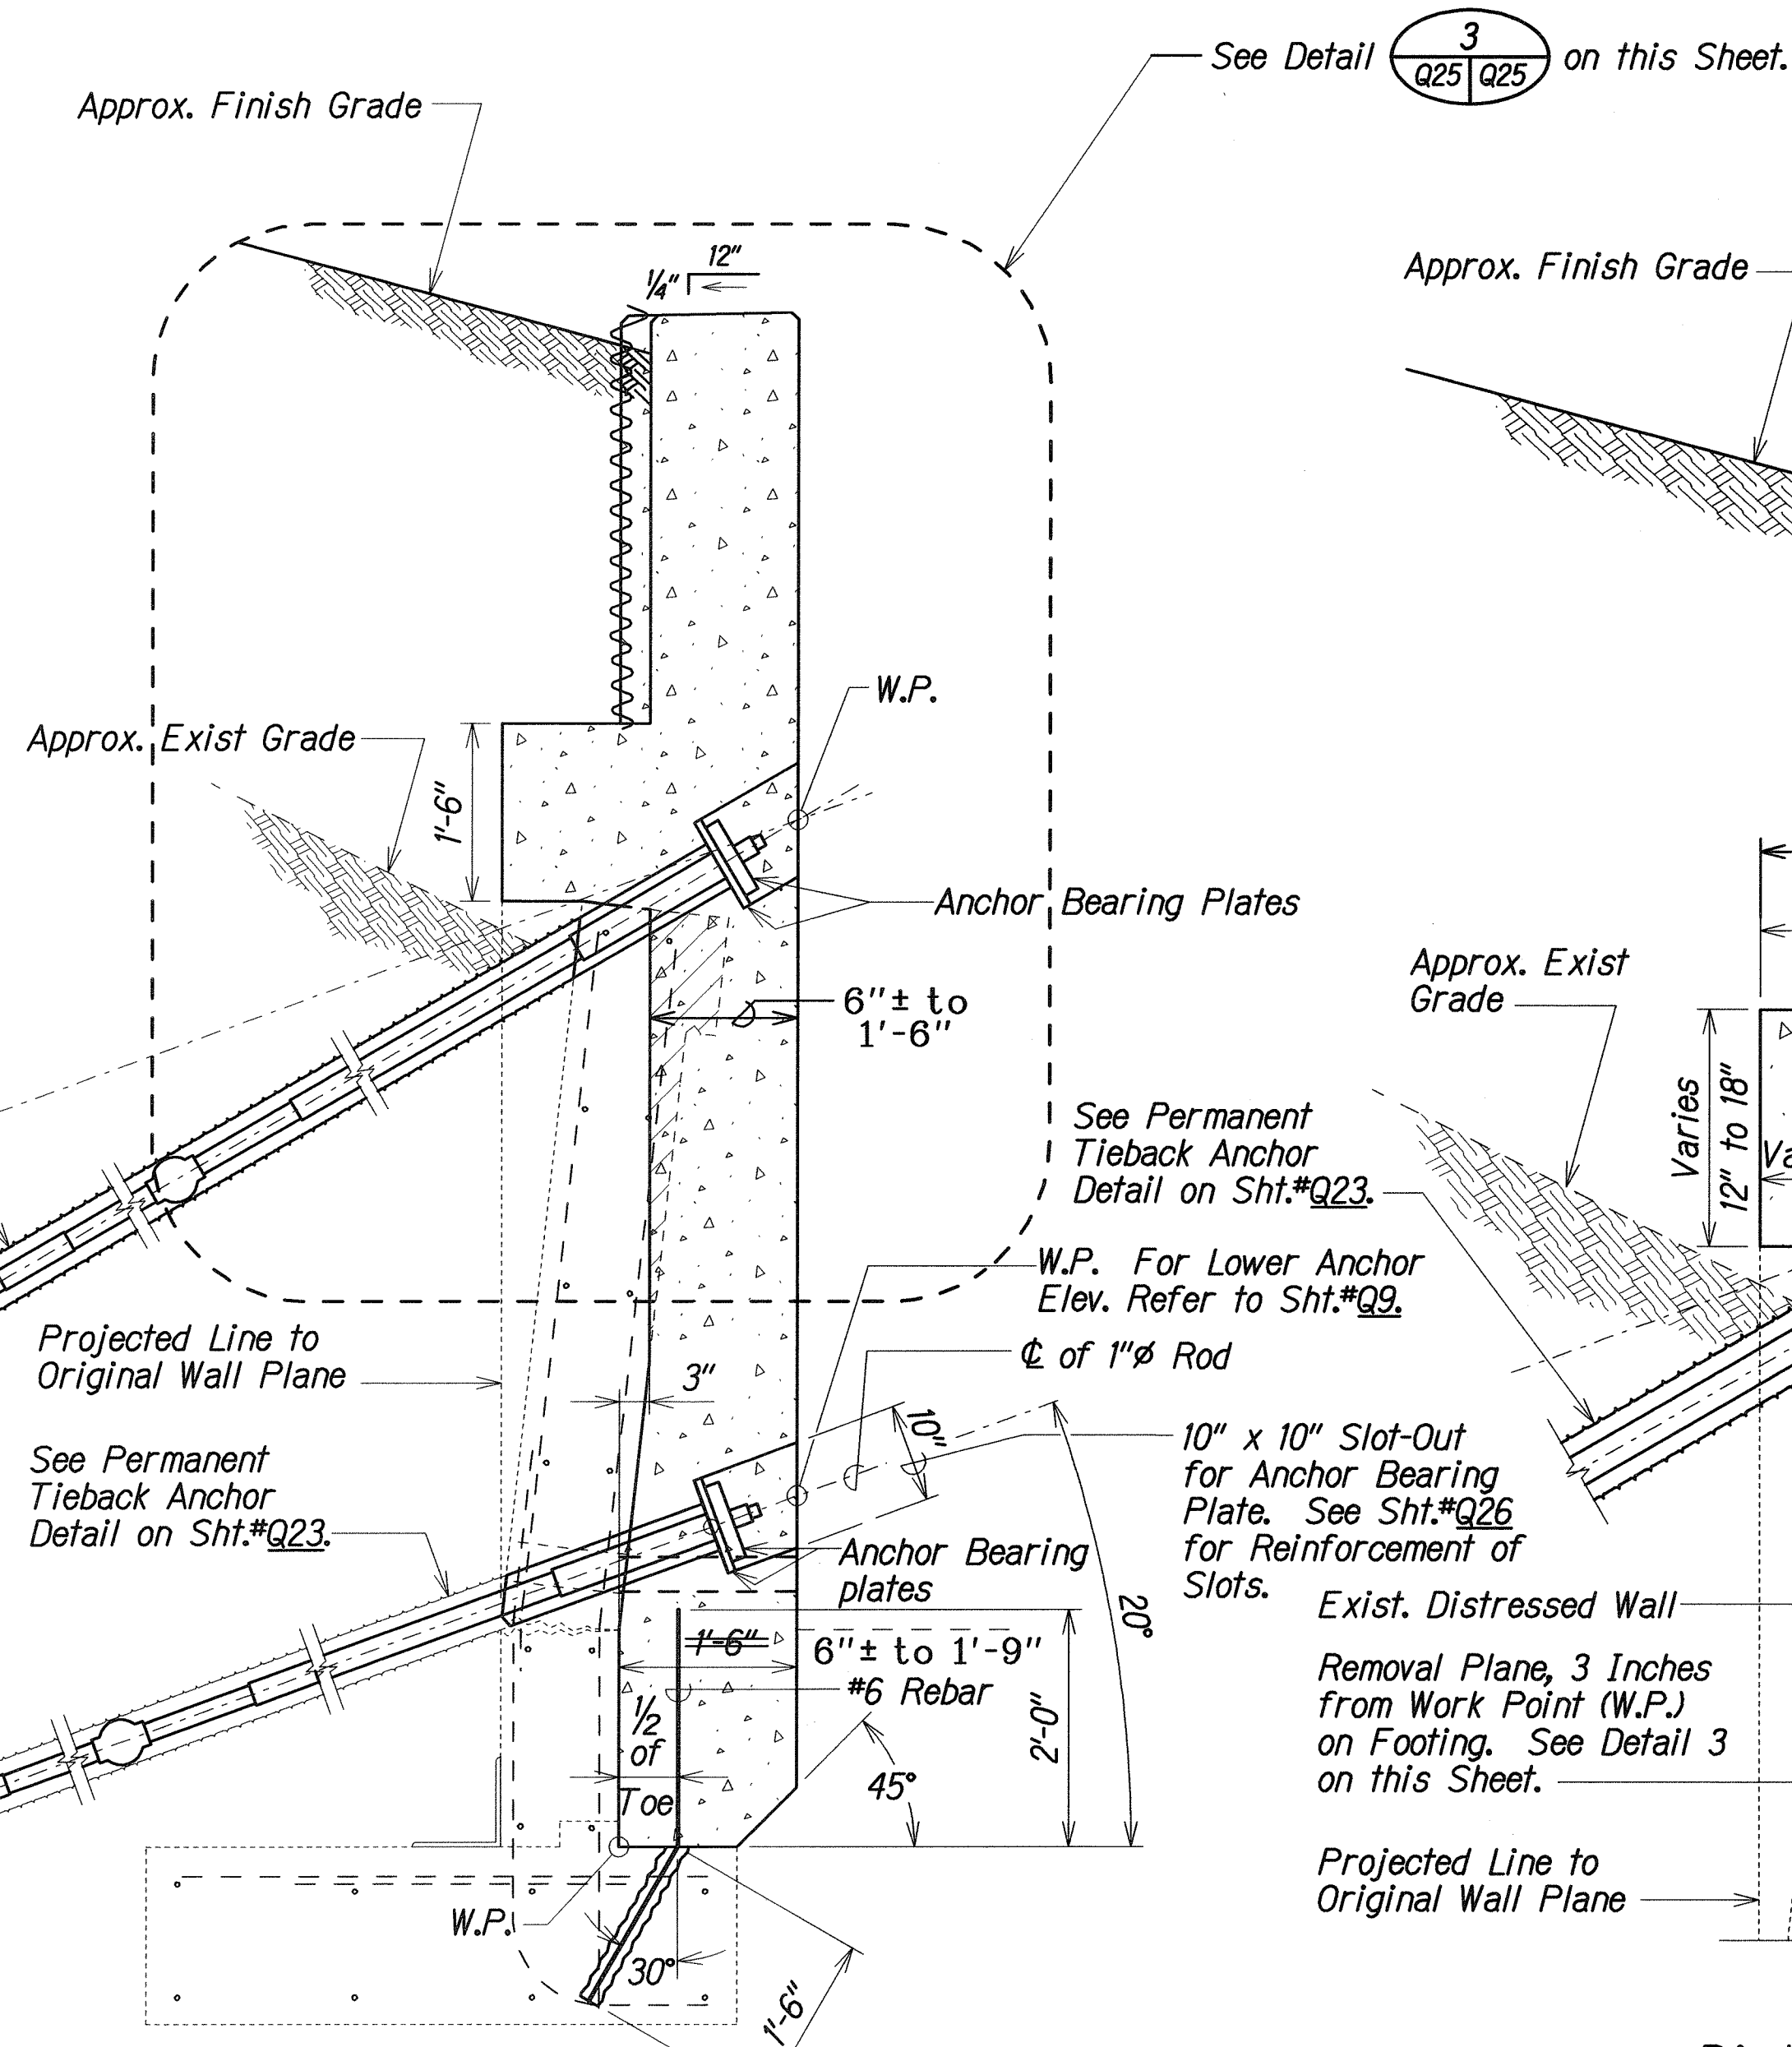


Distressed Walls H to P

TYPICAL WALL SECTION AT DISTRESSED WALL
Scale: 3/4"=1'-0"

LEGEND FOR AS-BUILT POSTINGS	
	Squiggly line for as-built deletion
	Double line for as-built deletion
Roadway	Text for as-built posting

TIEBACK ANCHOR PLACEMENT DETAILS

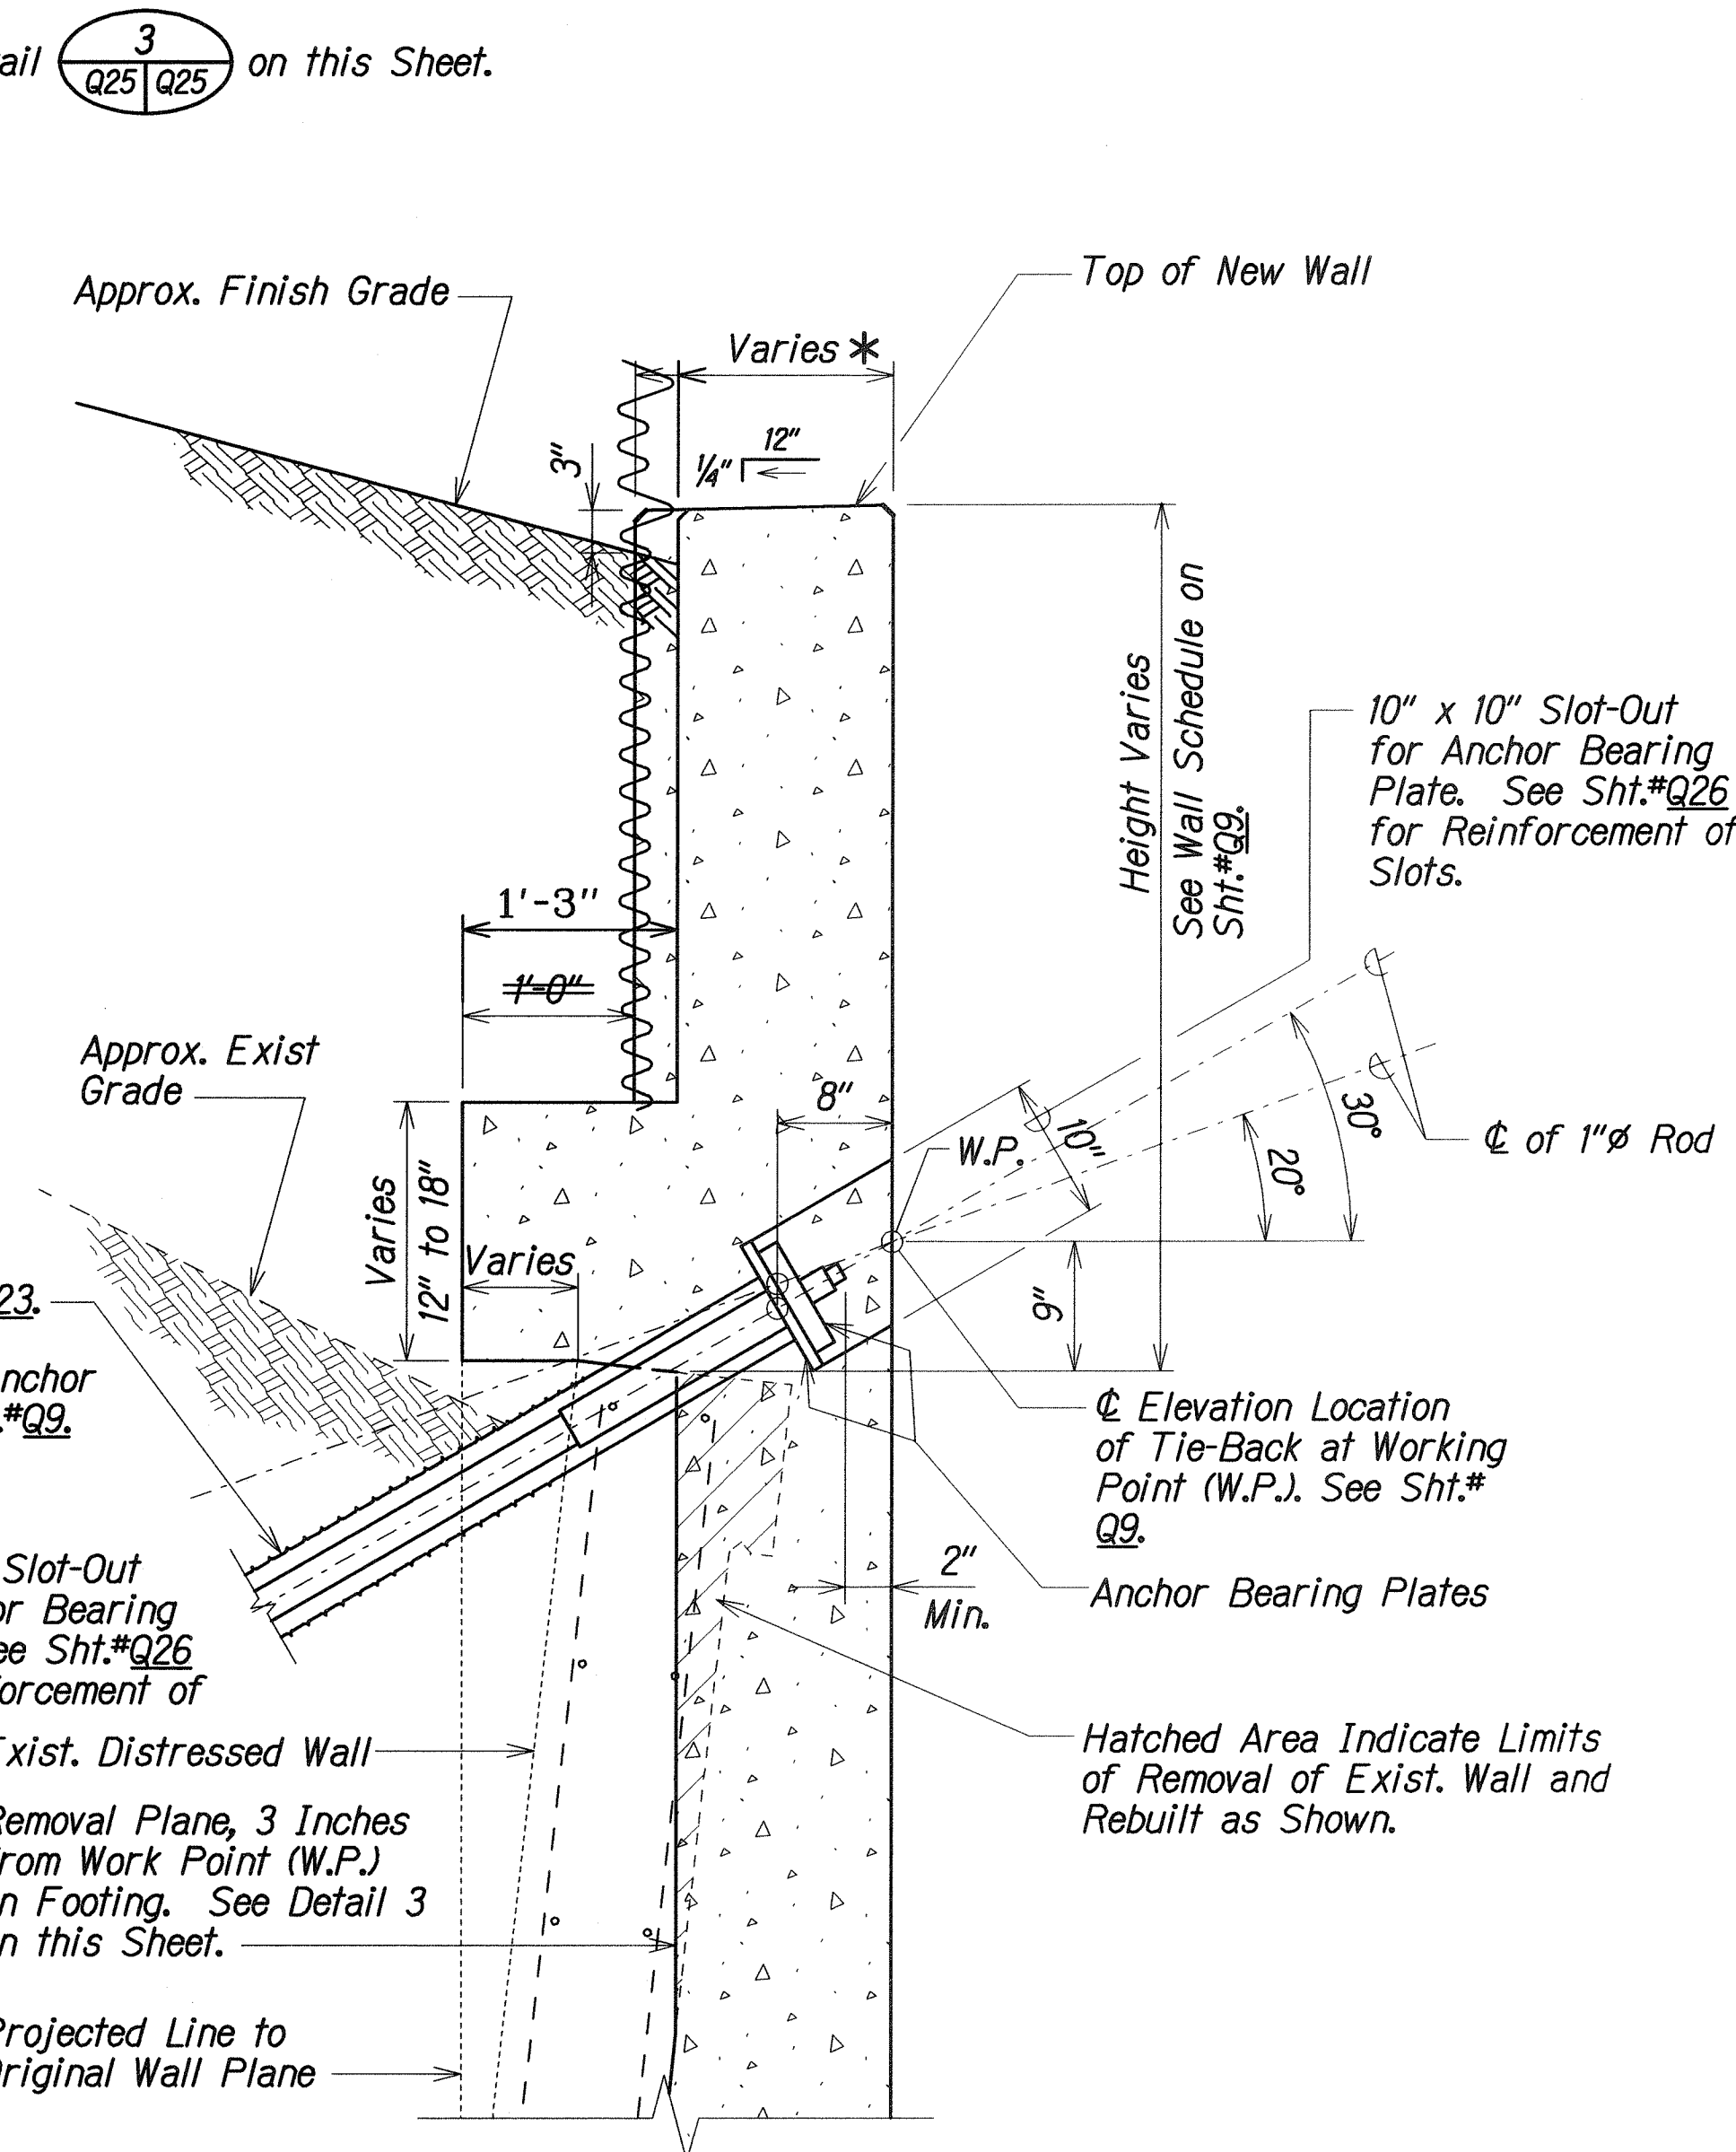

Distressed Walls H to P

DETAIL 3
Scale: 1"=1'-0"
Q25, Q25

- NOTES:
- After Anchors have been Proof Tested and Lockoff Loads Applied, Reinforce Slot and Seal with Concrete, similar in Strength and Texture to Added Wall Concrete. Appearance shall be acceptable to the Engineer with no tell tales of Slot-Outs.
 - For Distressed Walls K, L & M, Refer Sht.#Q25A.
 - * See Det. 2 for dimensions.

Added Note No. 2 for Walls K, L & M. Added Sheet Number to Section Symbol	8/17/09
DATE	REVISION
	STATE OF HAWAII DEPARTMENT OF TRANSPORTATION HIGHWAYS DIVISION
	RETAINING WALL REPAIR TIEBACK ANCHOR PLACEMENT DETAIL INTERSTATE ROUTE H-1 EXTENSION AND REPAIR OF SCHOOL STREET ON-RAMP RETAINING WALL Project No. H11-01-08
Scale: As Noted	Date: Feb, 2009
SHEET No. Q25 OF 34 SHEETS	


SURVEY PLOTTED BY	DATE
DESIGNED BY	XXX 2009
TRACED BY	XXX 2009
NOTE BOOK	XXX 2009
QUANTITIES BY	XXX 2009
CHECKED BY	XXX 2009

"AS-BUILT"

C.O. 33

FED. ROAD DIST. NO.	STATE	PROJ. NO.	FISCAL YEAR	SHEET NO.	TOTAL SHEETS
HAWAII	HAW.	H11-01-08	2009	73	73

C.O. ADD. 33 S-1

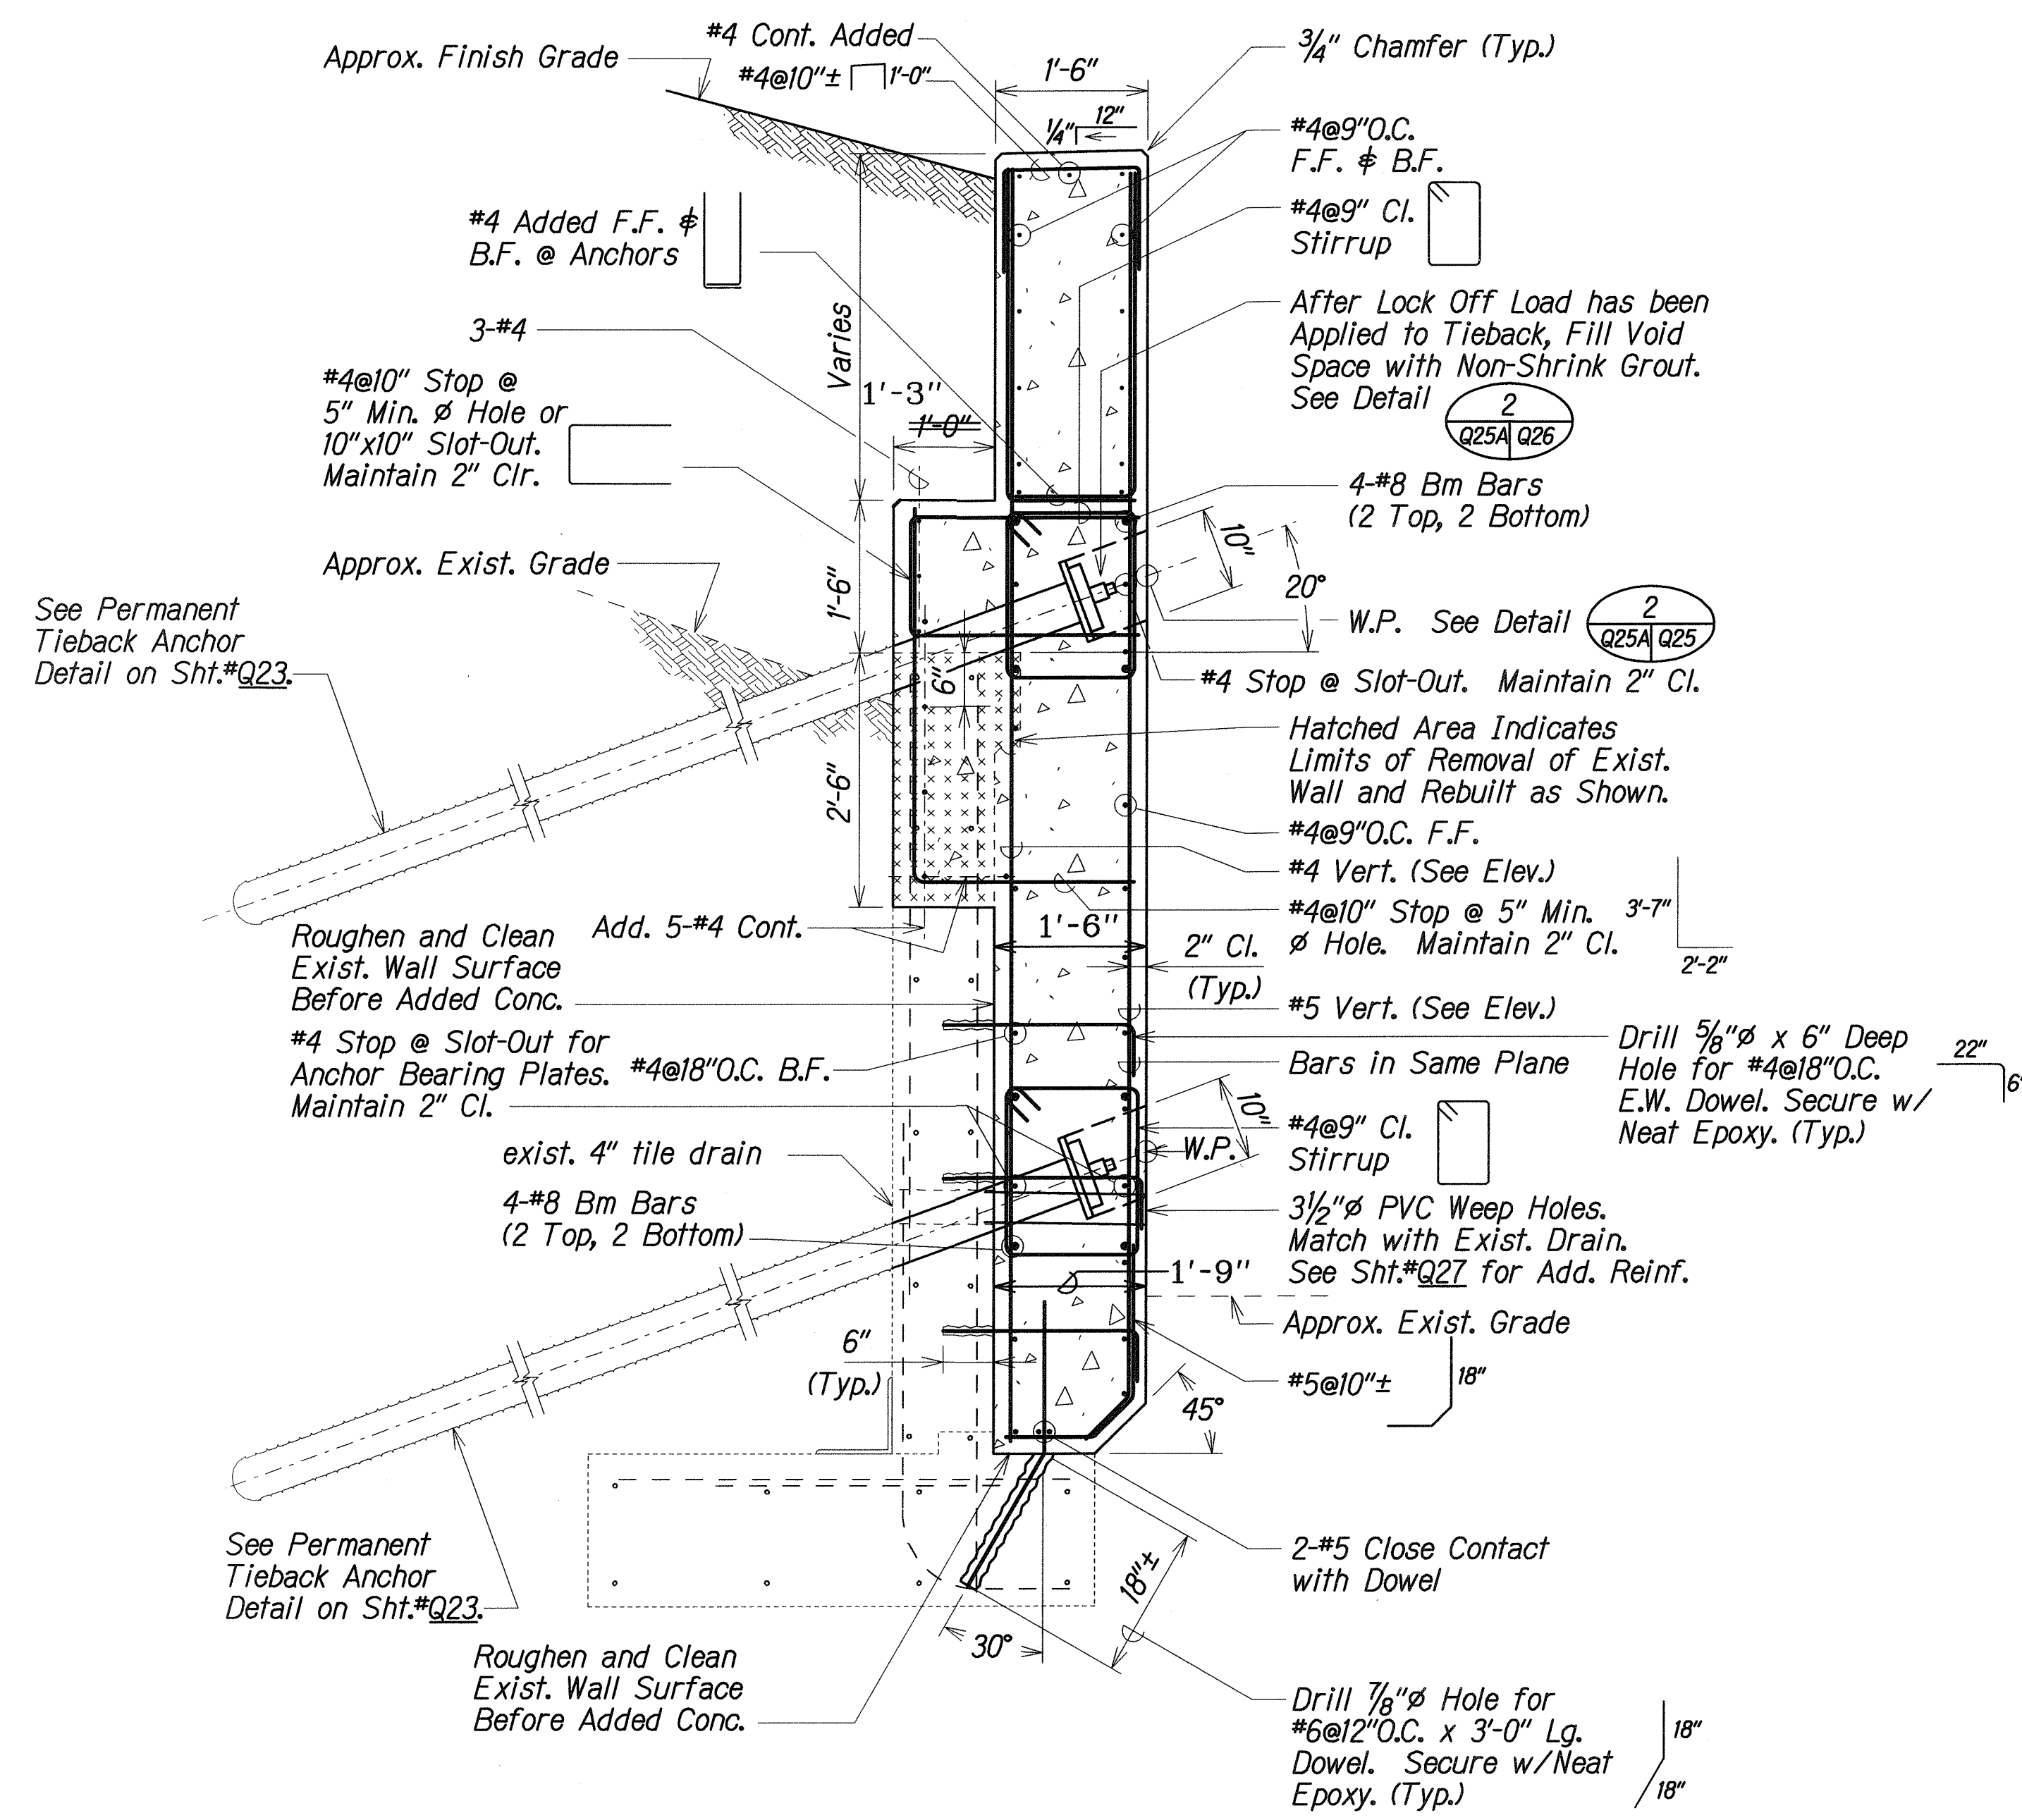


SECTION F G
Q19 Q25A Q20 Q25A

Legend

- Limits of Excavation
- Demolition
- Limits of Backfill

LEGEND FOR AS-BUILT POSTINGS	
	Squiggly line for as-built deletion
	Double line for as-built deletion
Roadway	Text for as-built posting

WALLS "K", "L" AND "M" SECTIONS 1
Scale: 3/4"=1'-0"

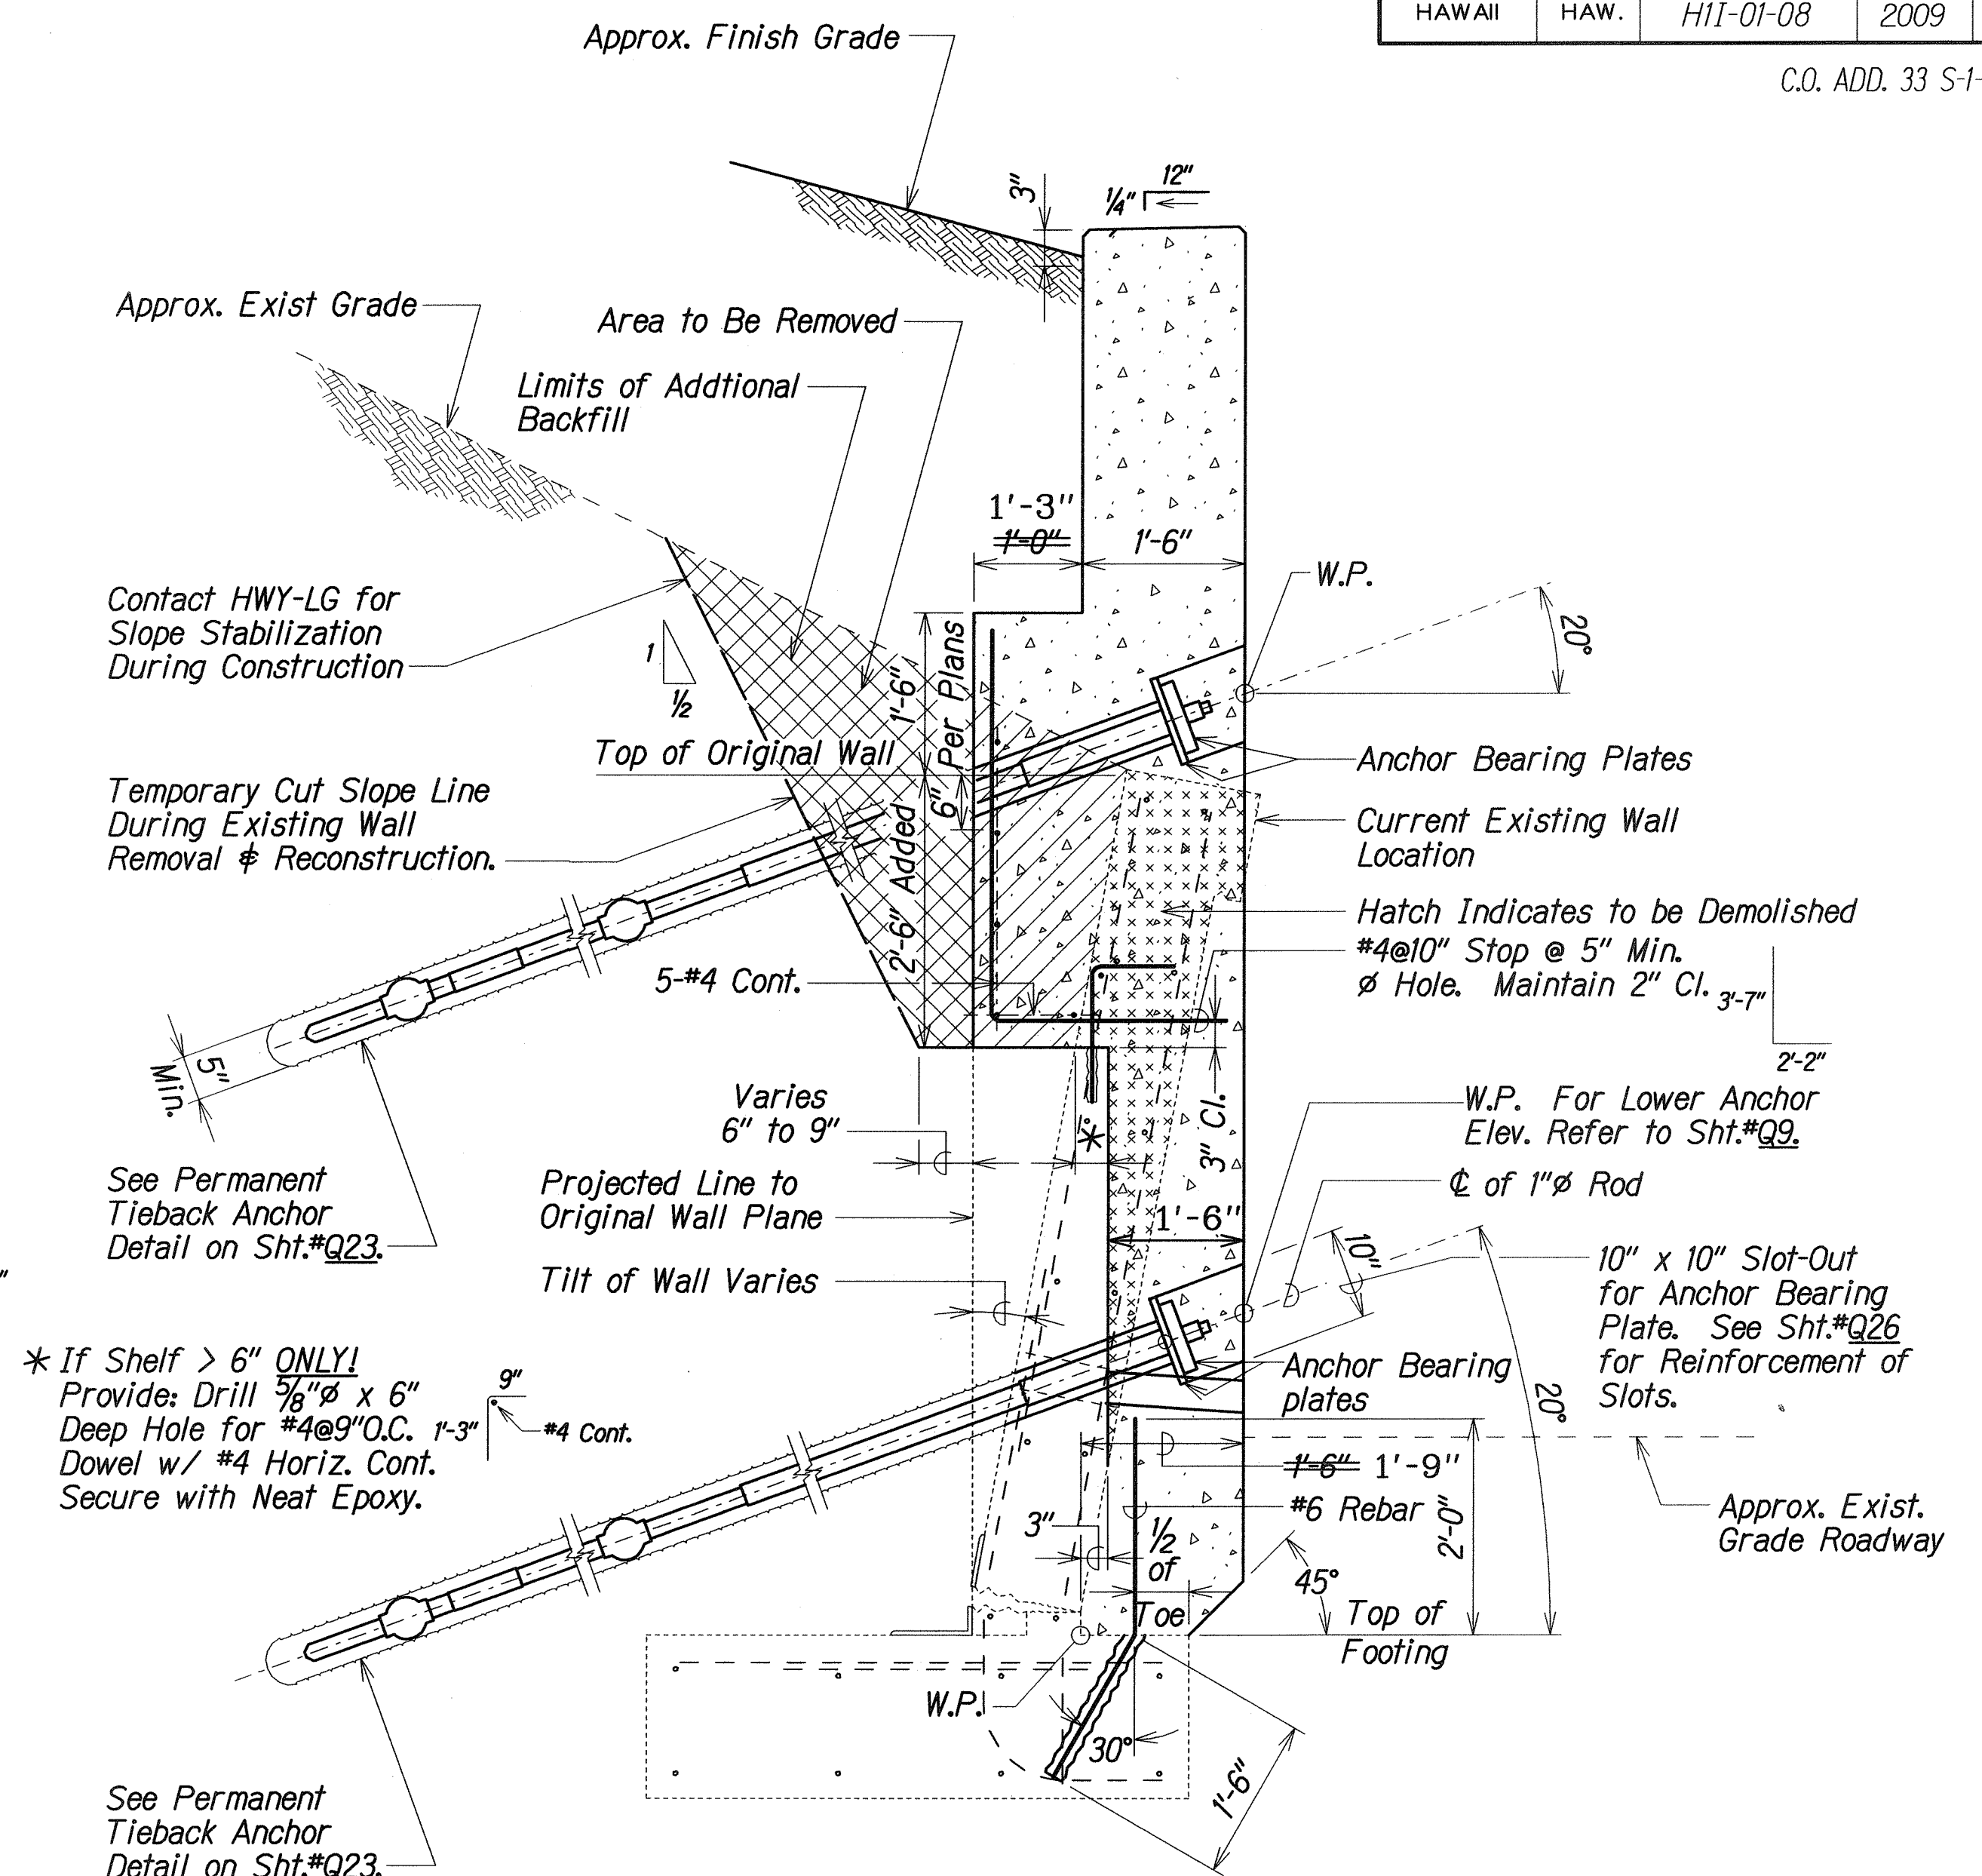

Distressed Walls K, L & M
TYPICAL WALL SECTION AT DISTRESSED WALL

- NOTES:
- For Wall "M" Reinforcements, See Sht.#Q19.
 - For Walls "K" & "L" Reinforcements, See Sht.#Q20.


8/17/09	This Sheet was Added as a Change Order
DATE	REVISION
STATE OF HAWAII DEPARTMENT OF TRANSPORTATION HIGHWAYS DIVISION	
RETAINING WALL REPAIR WALLS "K", "L" AND "M" SECTIONS INTERSTATE ROUTE H-1 EXTENSION AND REPAIR OF SCHOOL STREET ON-RAMP RETAINING WALL Project No. H11-01-08	
Scale: As Noted	Date: Feb., 2009
SHEET No. Q25A OF 34 SHEETS	

"AS-BUILT"


C.O. ADD. 33 S-1

SURVEY PLOTTED BY	DATE
DESIGNED BY	XXX 2002
TRACED BY	XXX 2002
NOTE BOOK	XXX 2002
QUANTITIES BY	XXX 2002
CHECKED BY	XXX 2002


FED. ROAD DIST. NO.	STATE	PROJ. NO.	FISCAL YEAR	SHEET NO.	TOTAL SHEETS
HAWAII	HAW.	H11-01-08	2009	ADD. 34	73

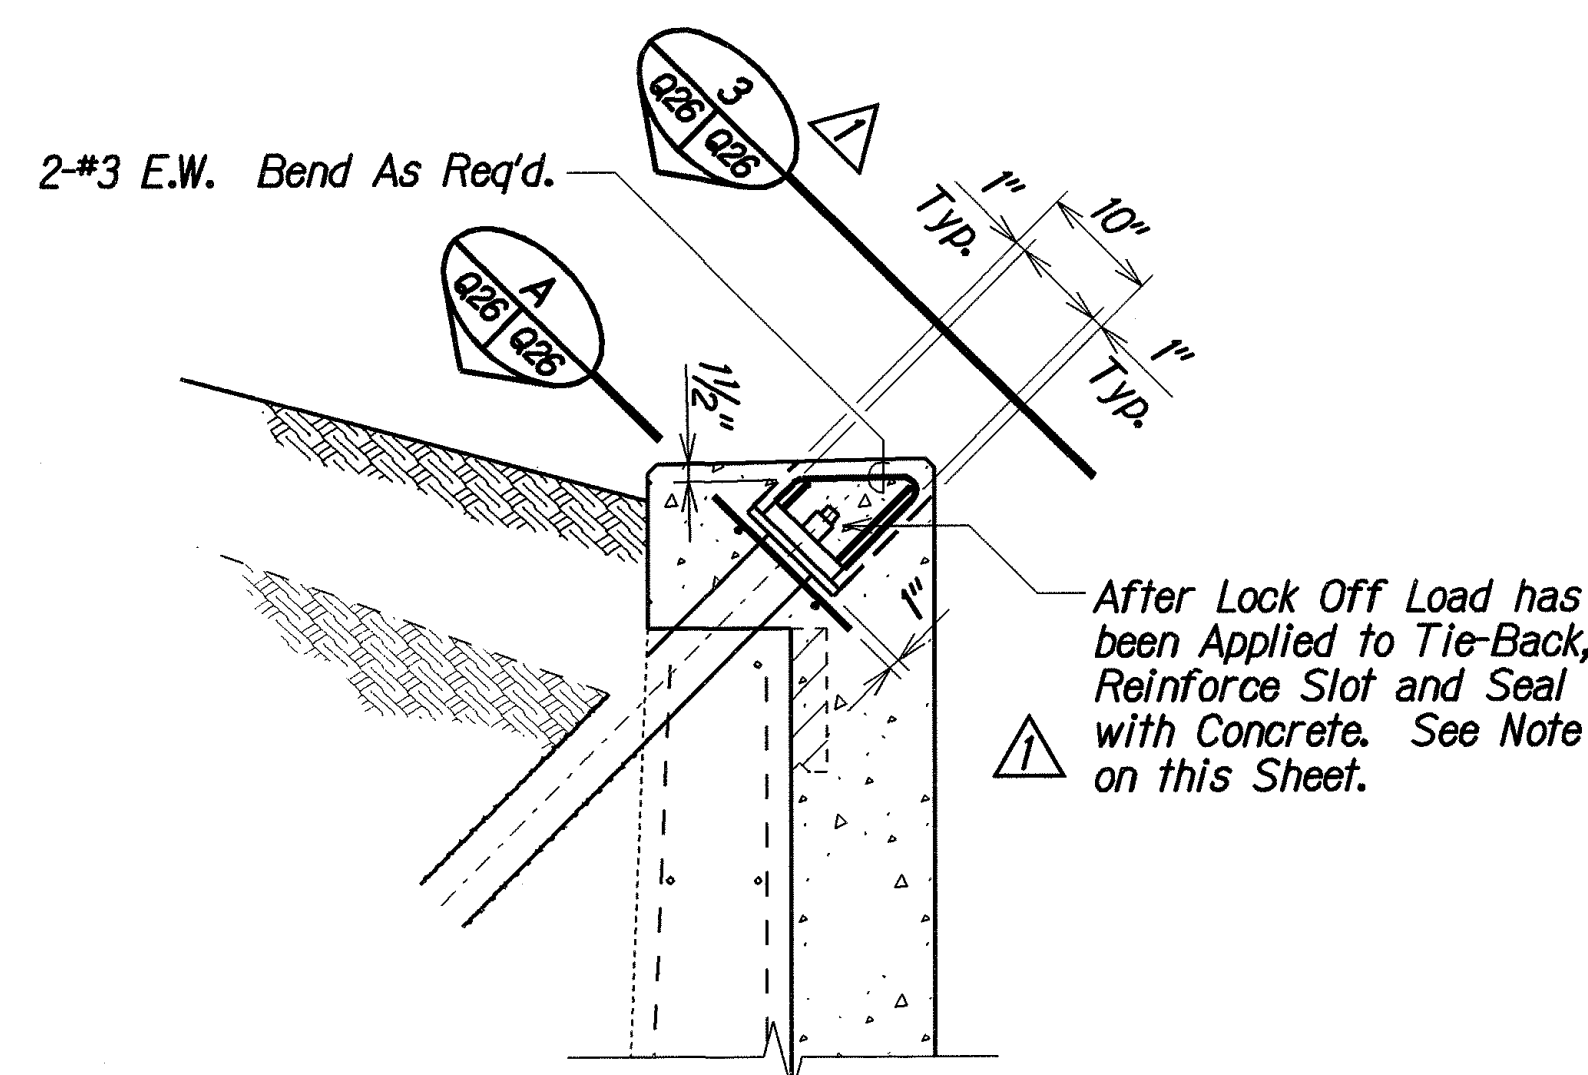


DETAIL 1
Scale: 3/4"=1'-0"
Q11, Q12

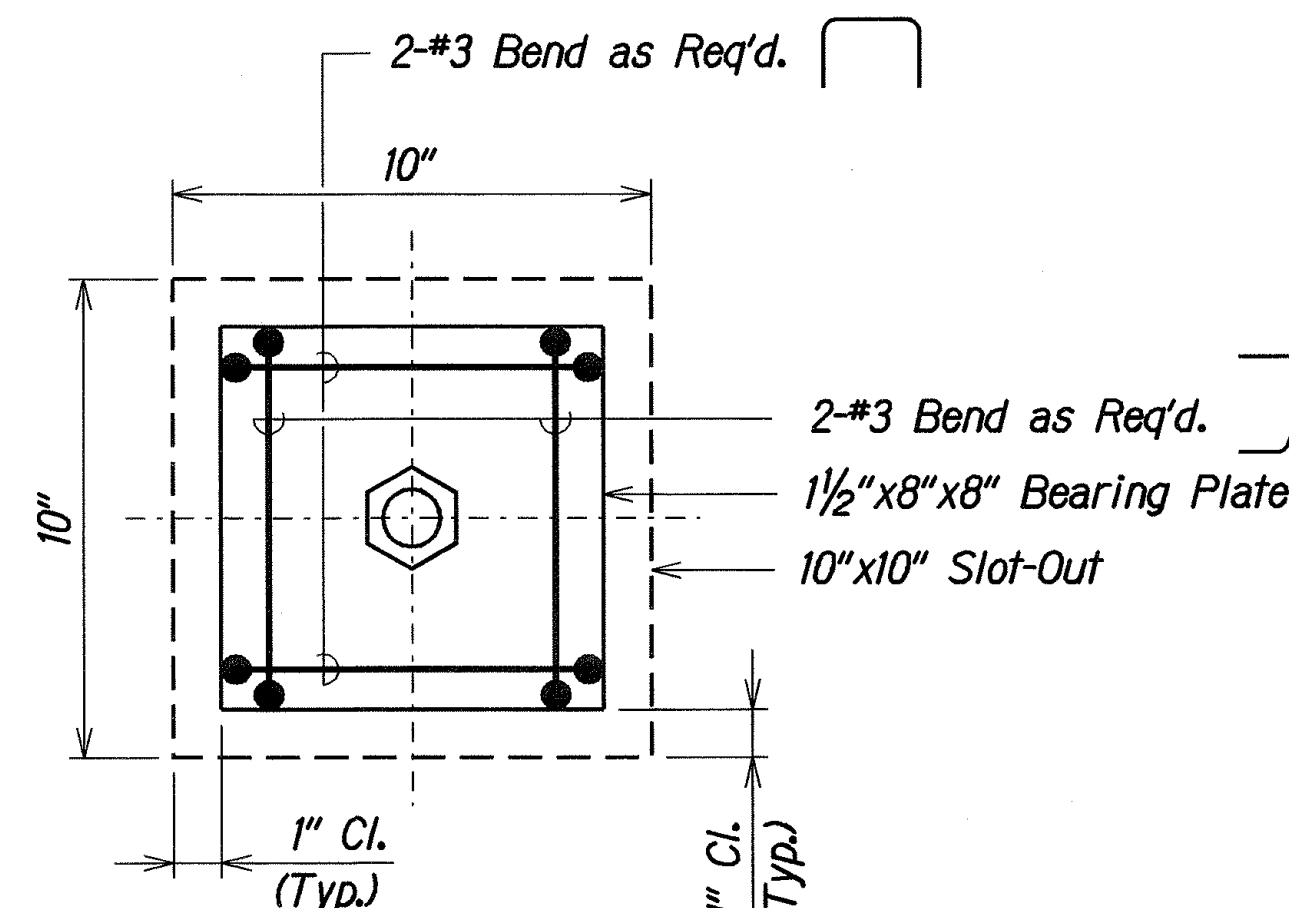

DETAIL 3
Scale: 3/4"=1'-0"
Q26, Q26

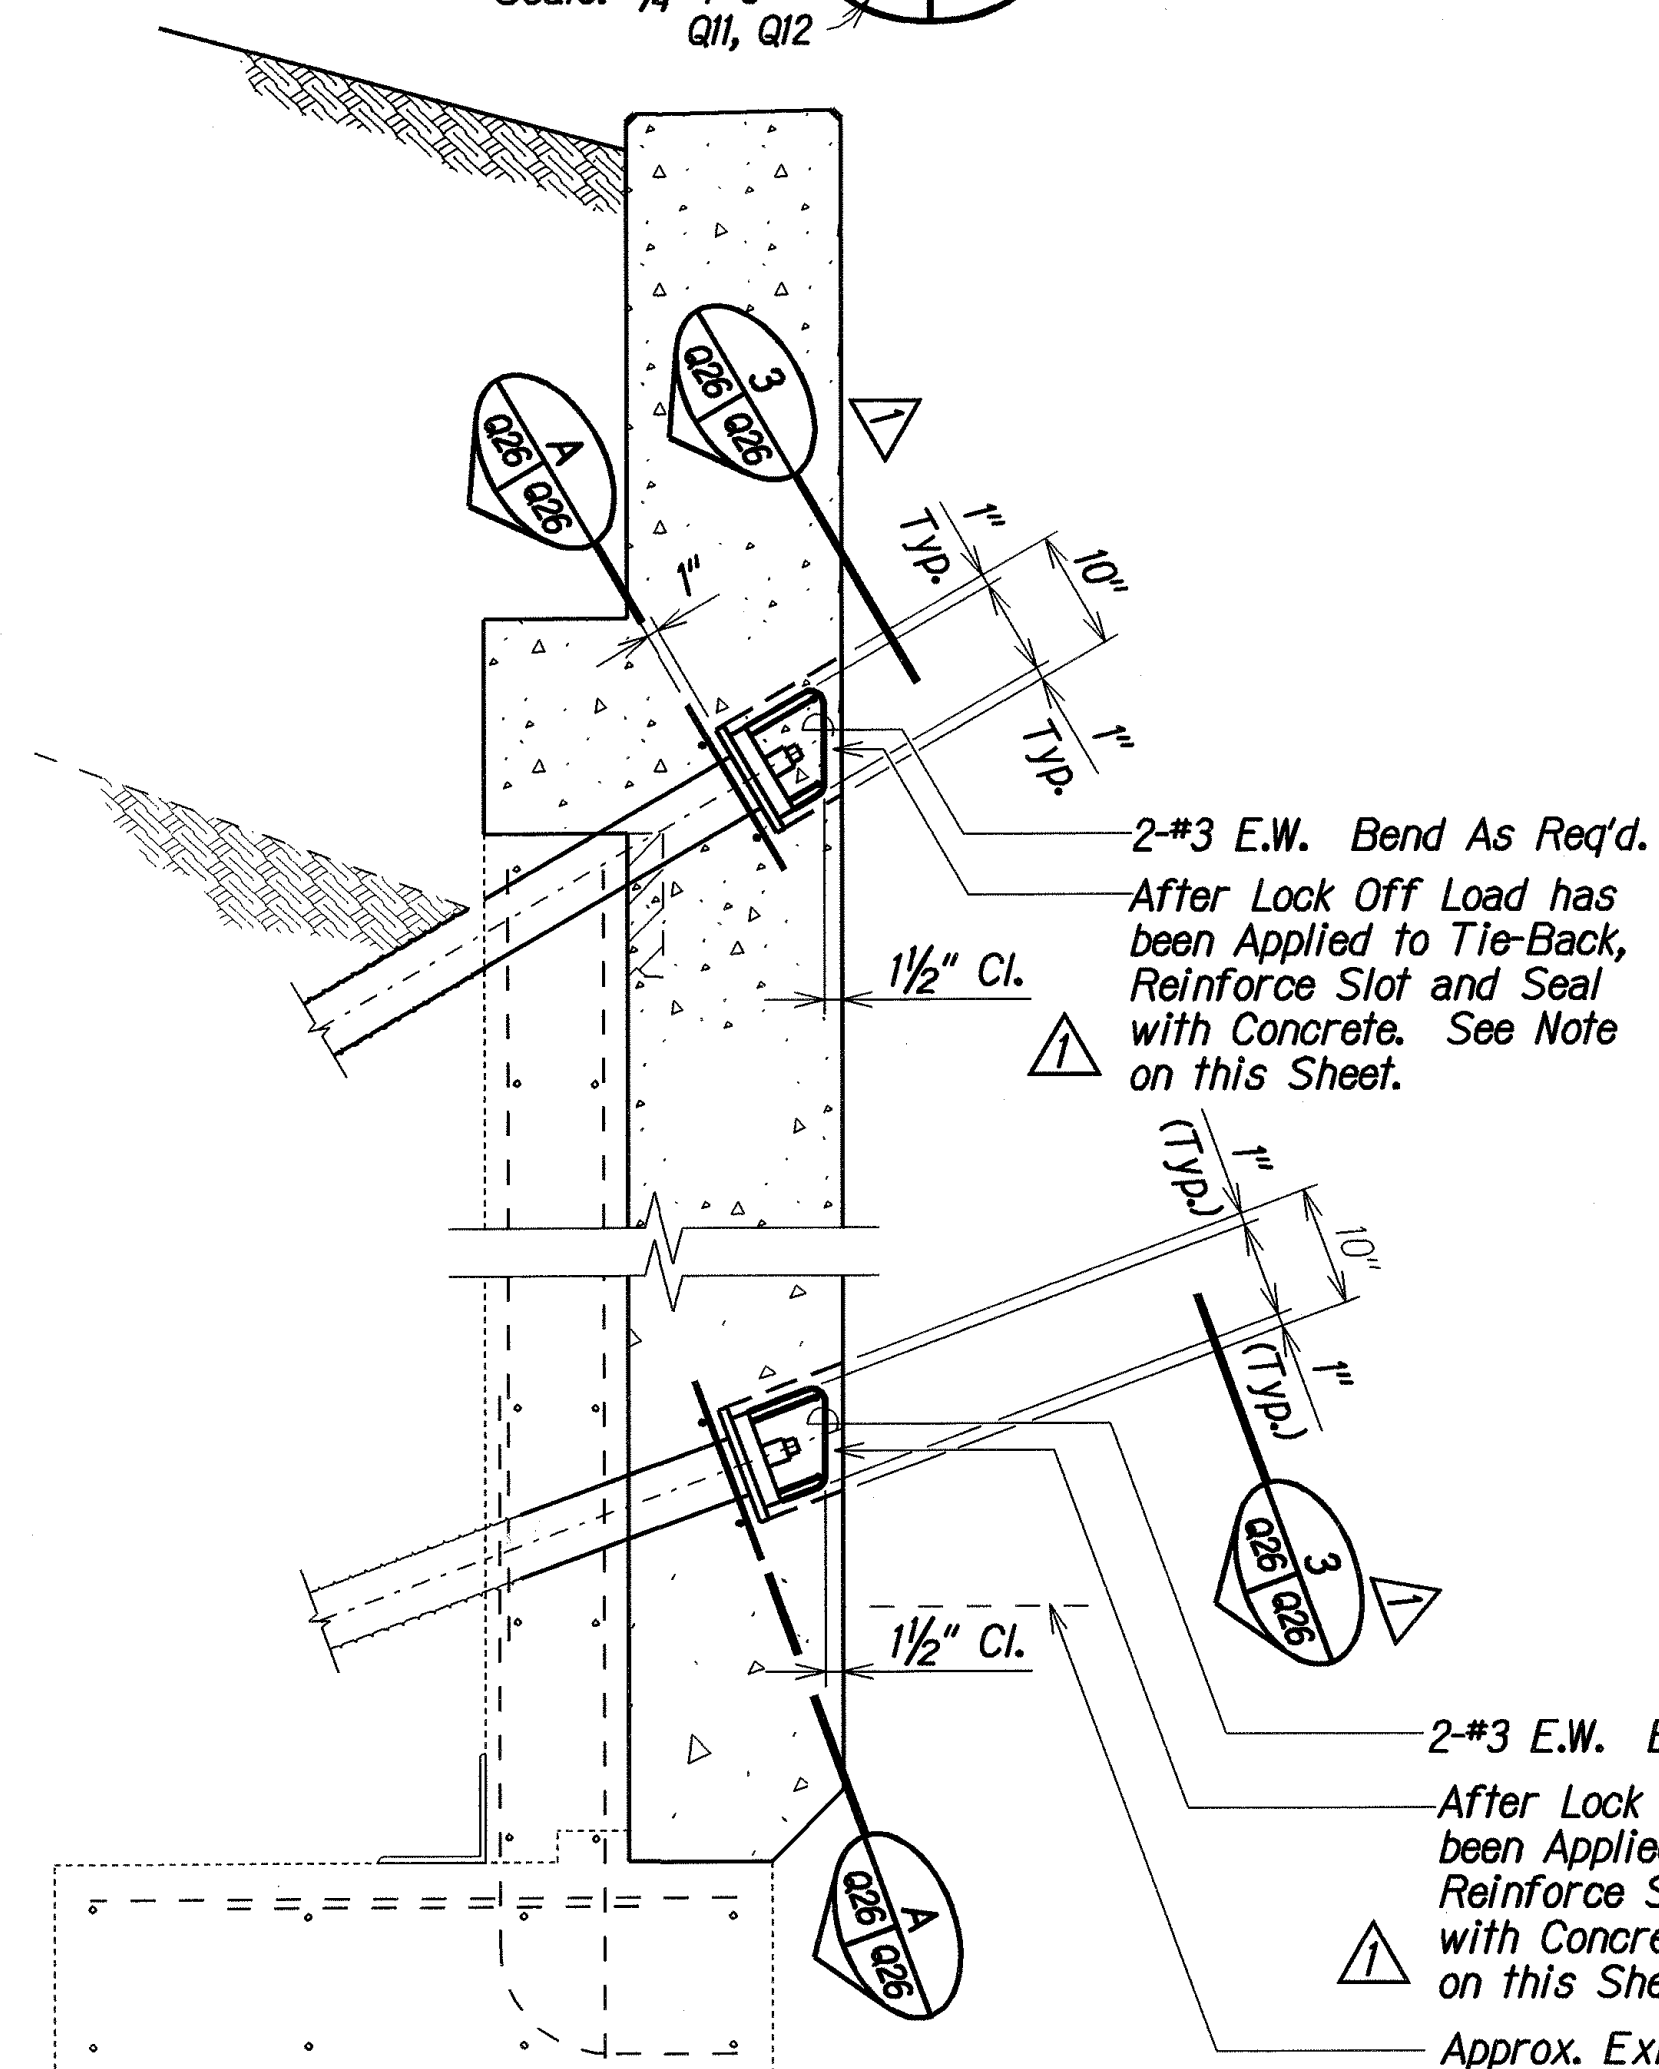



DETAIL 2
Scale: 3/4"=1'-0"
Q17, Q19, Q20

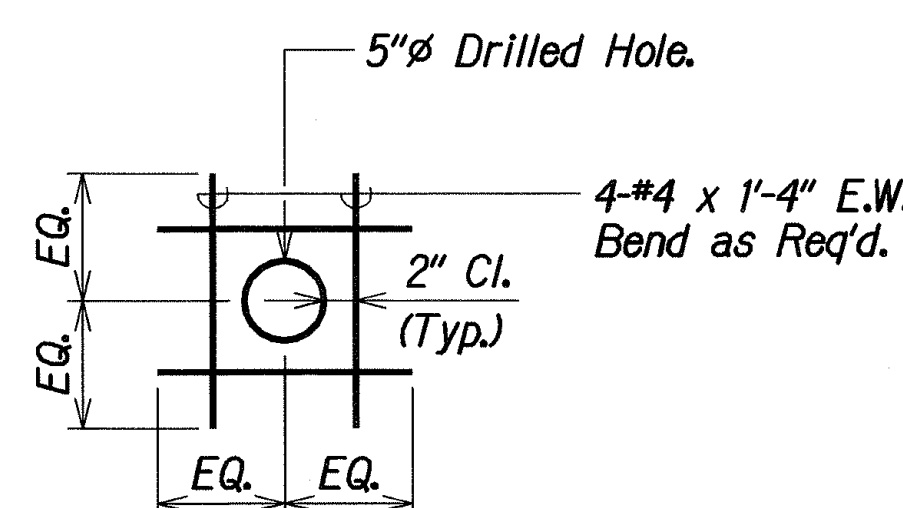

SECTION A
Scale: 1"=1'-0"
Q26, Q26

Note:
No Lower Anchors for Wall "P".

△ SLOT-OUT DETAILS FOR TIEBACK ANCHORS

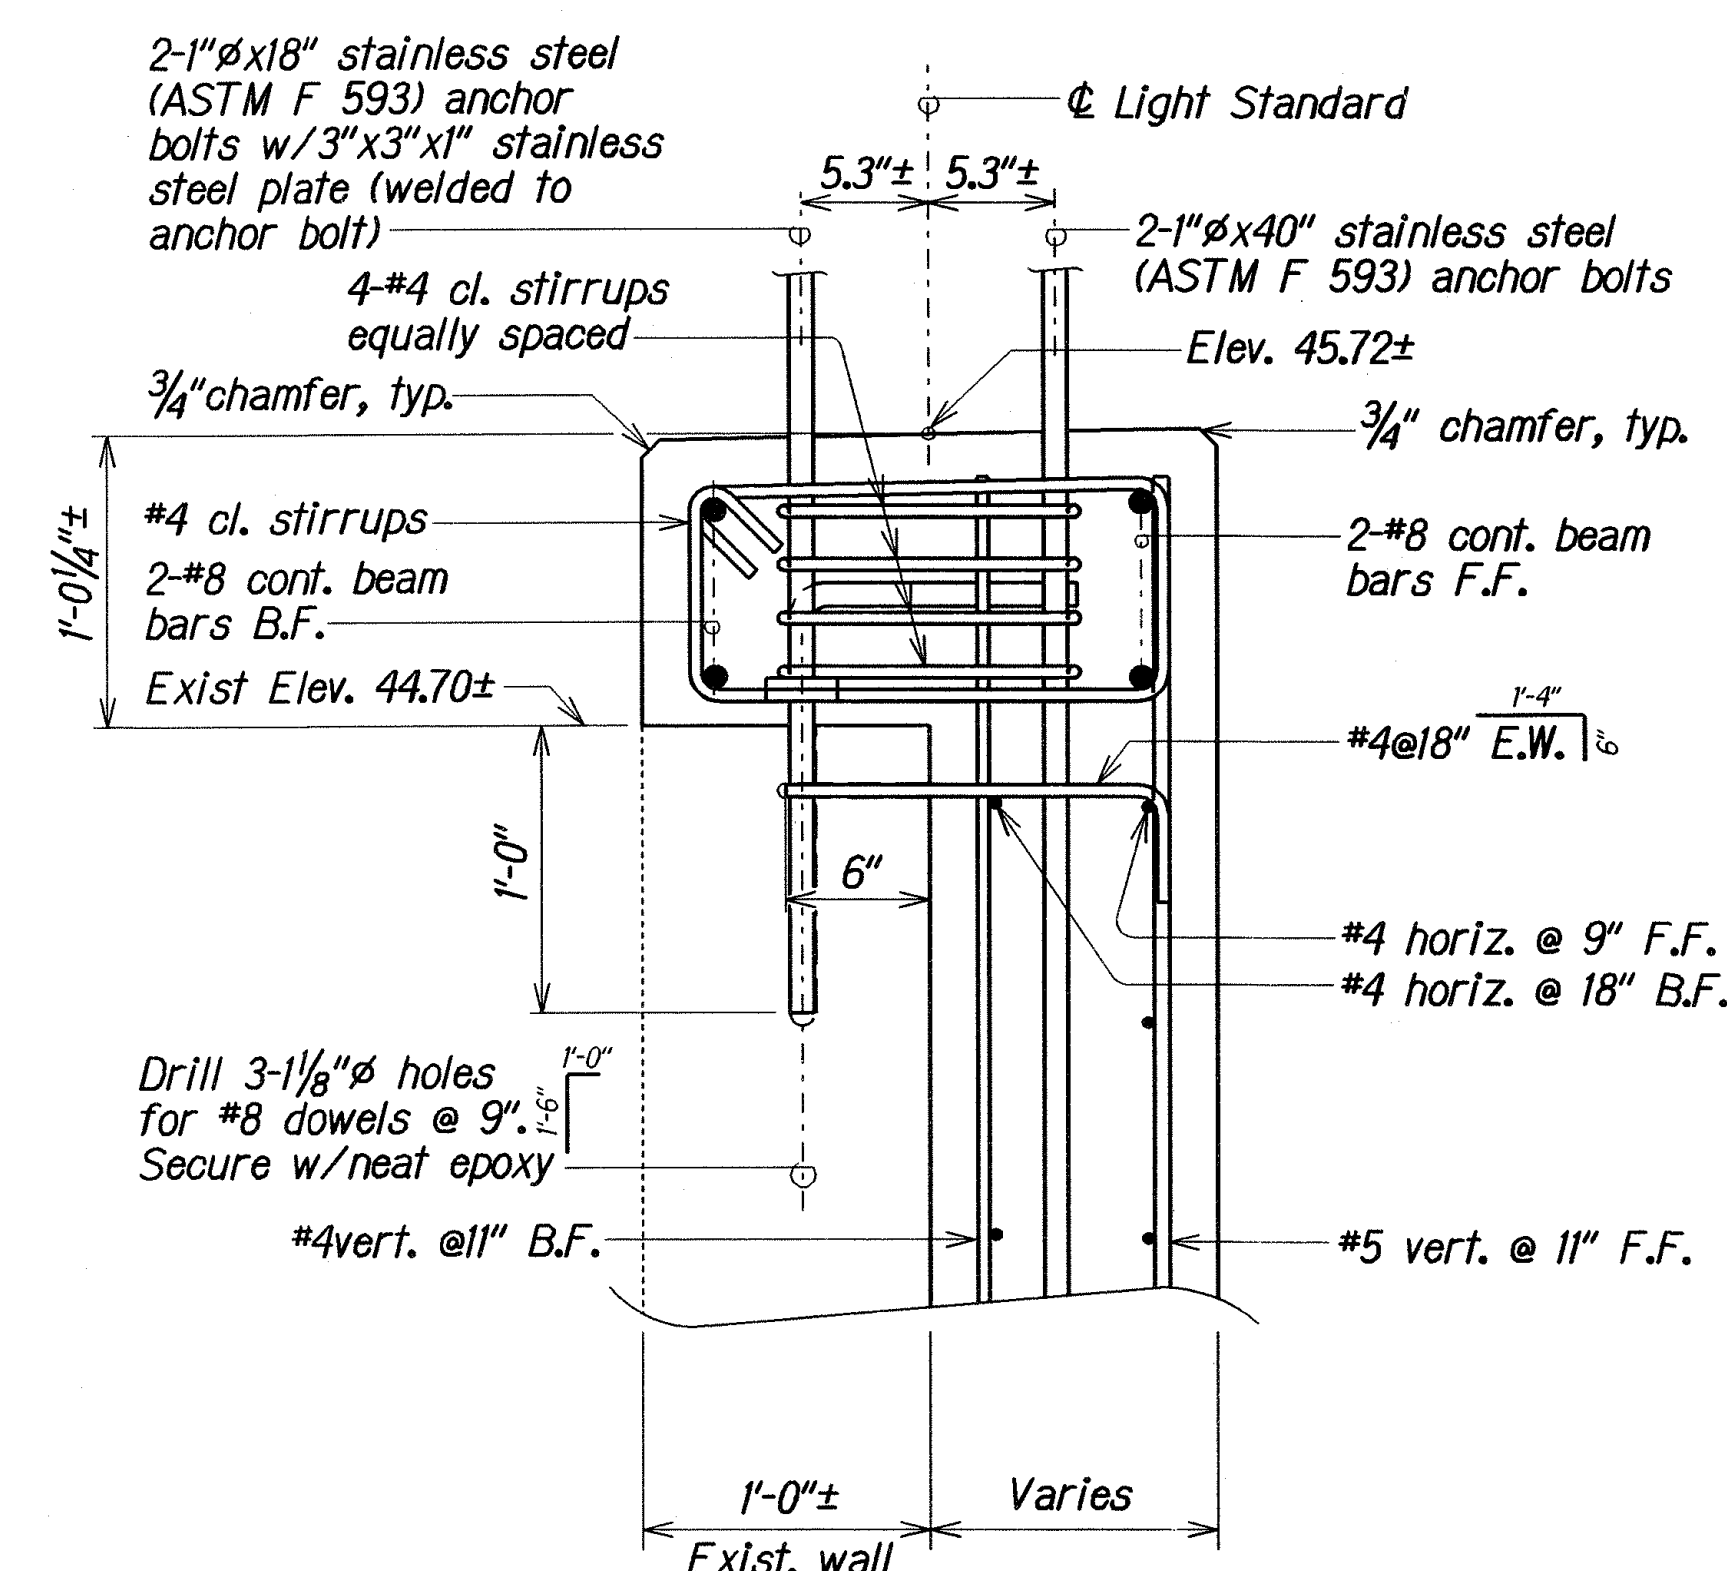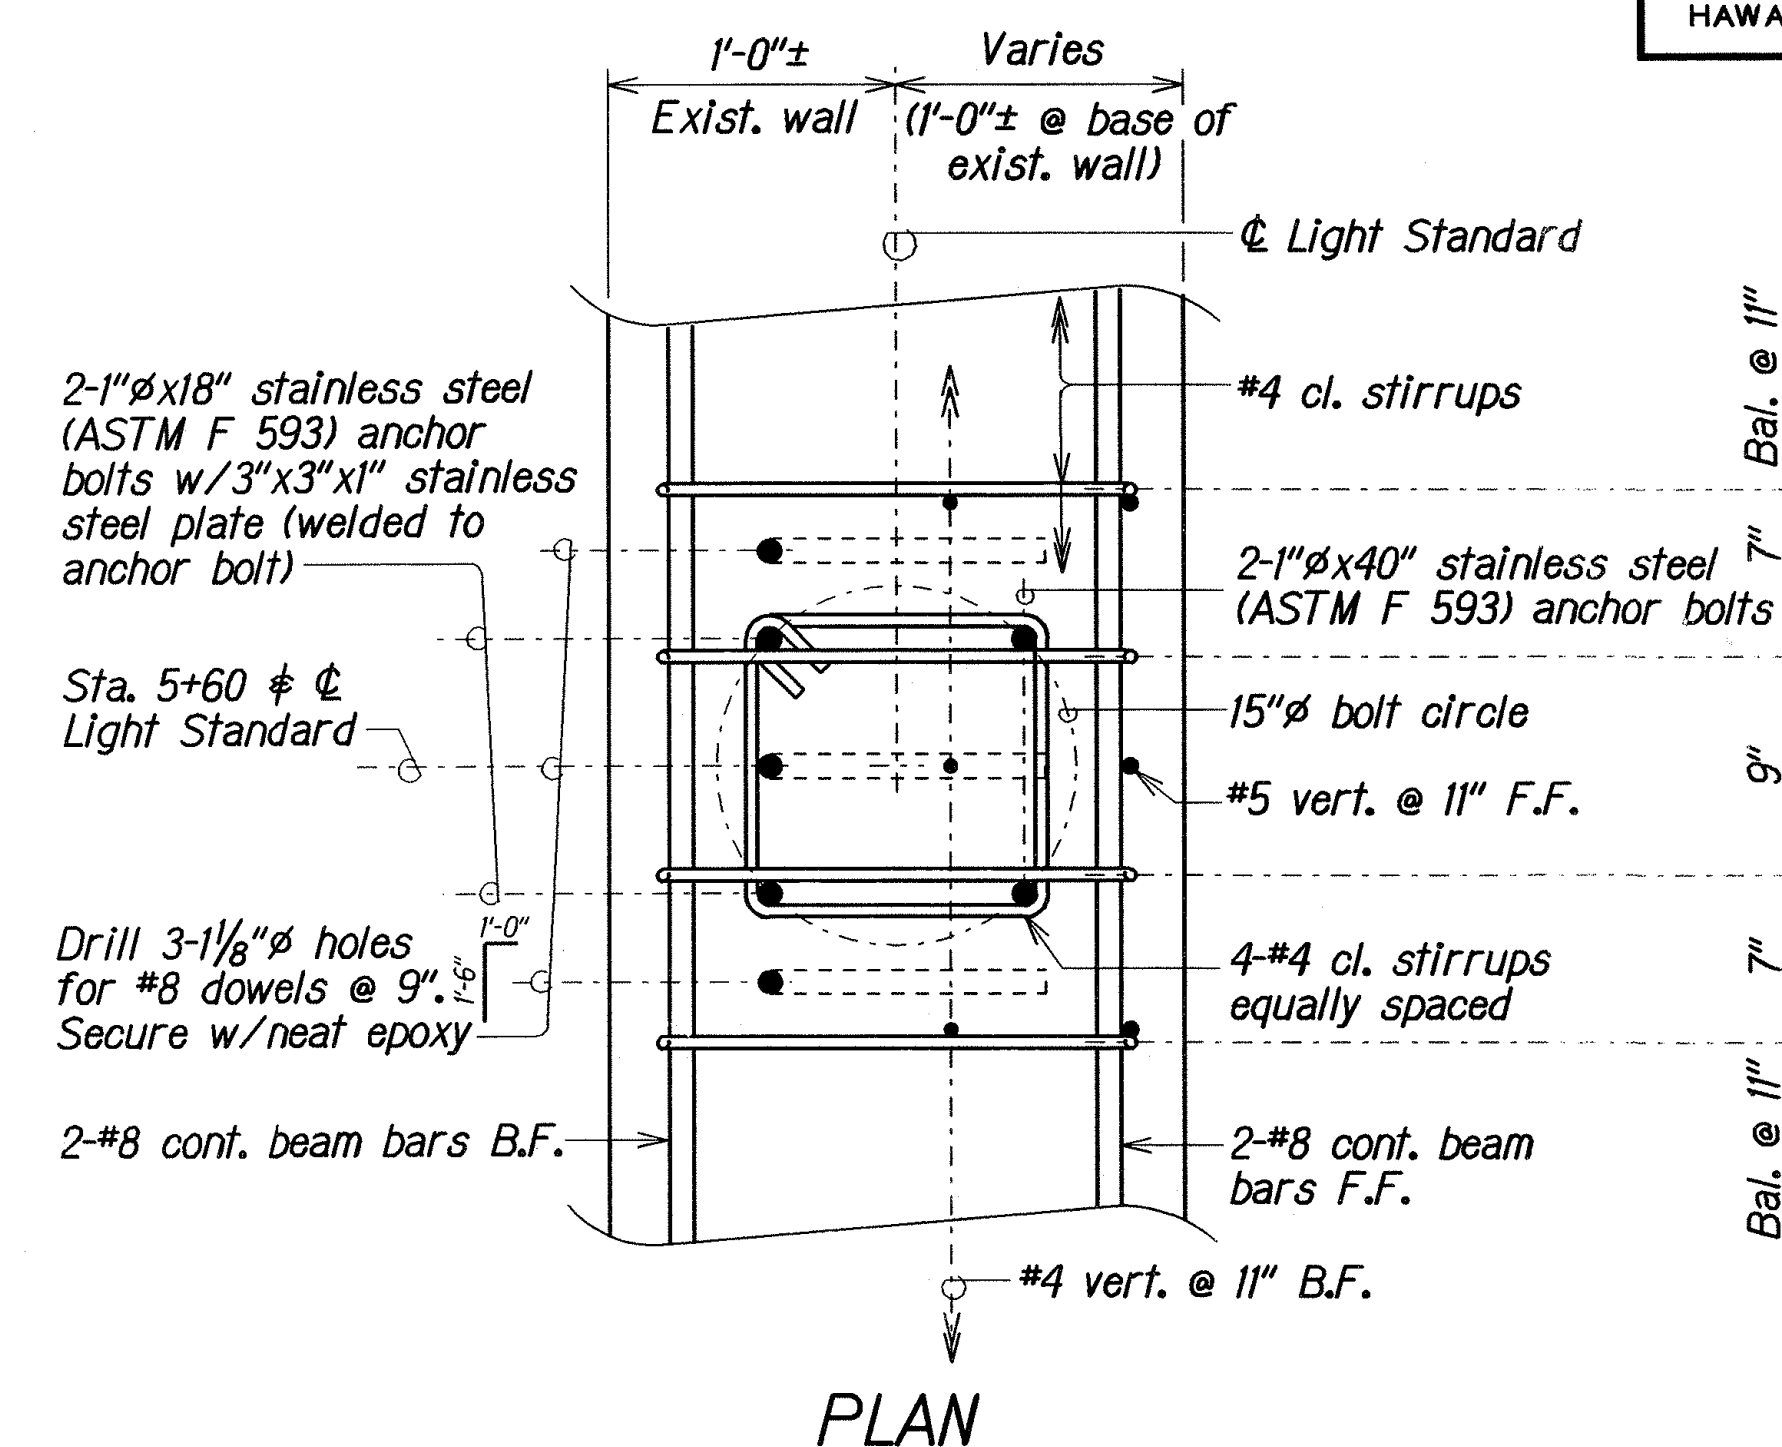

NOTE: For wall reinforcing not shown here, see Sht#Q13

TYPICAL SECTION

△ LIGHT STANDARD CONCRETE SEAT on WALL "A" at RAMP 7 STA. 5+60

Added Light Standard Details @ Sta. 5+60, Detail Symbols & Detail Sheet Numbers, Revised Callouts & Detail Designation, Rearranged Slot-Out Details for Tieback Anchors





DATE	REVISION
3/31/09	
STATE OF HAWAII DEPARTMENT OF TRANSPORTATION HIGHWAYS DIVISION	
RETAINING WALL REPAIR	
SLOT-OUT DETAILS FOR TIEBACK ANCHOR AND LIGHT STD. @ STA. 5+60 DETAILS	
INTERSTATE ROUTE H1	
EXTENSION AND REPAIR OF SCHOOL STREET ON RAMP RETAINING WALL	
Scale: As Noted	Project: H11-01-08 Date: Feb. 2009

SHEET No. Q26 OF 34 SHEETS

ADD. 34



SURVEY PLOTTED BY	DATE
DRAWN BY	XXX 2009
TRACED BY	XXX 2009
CHECKED BY	XXX 2009
NOTED BY	XXX 2009
QUANTITIES BY	XXX 2009
CHECKED BY	XXX 2009
ORIGINAL PLAN	
NOTE BOOK	
DATE	2/27/09

FED. ROAD DIST. NO.	STATE	PROJ. NO.	FISCAL YEAR	SHEET NO.	TOTAL SHEETS
HAWAII	HAW.	HII-01-08	2009	ADD. 35	73

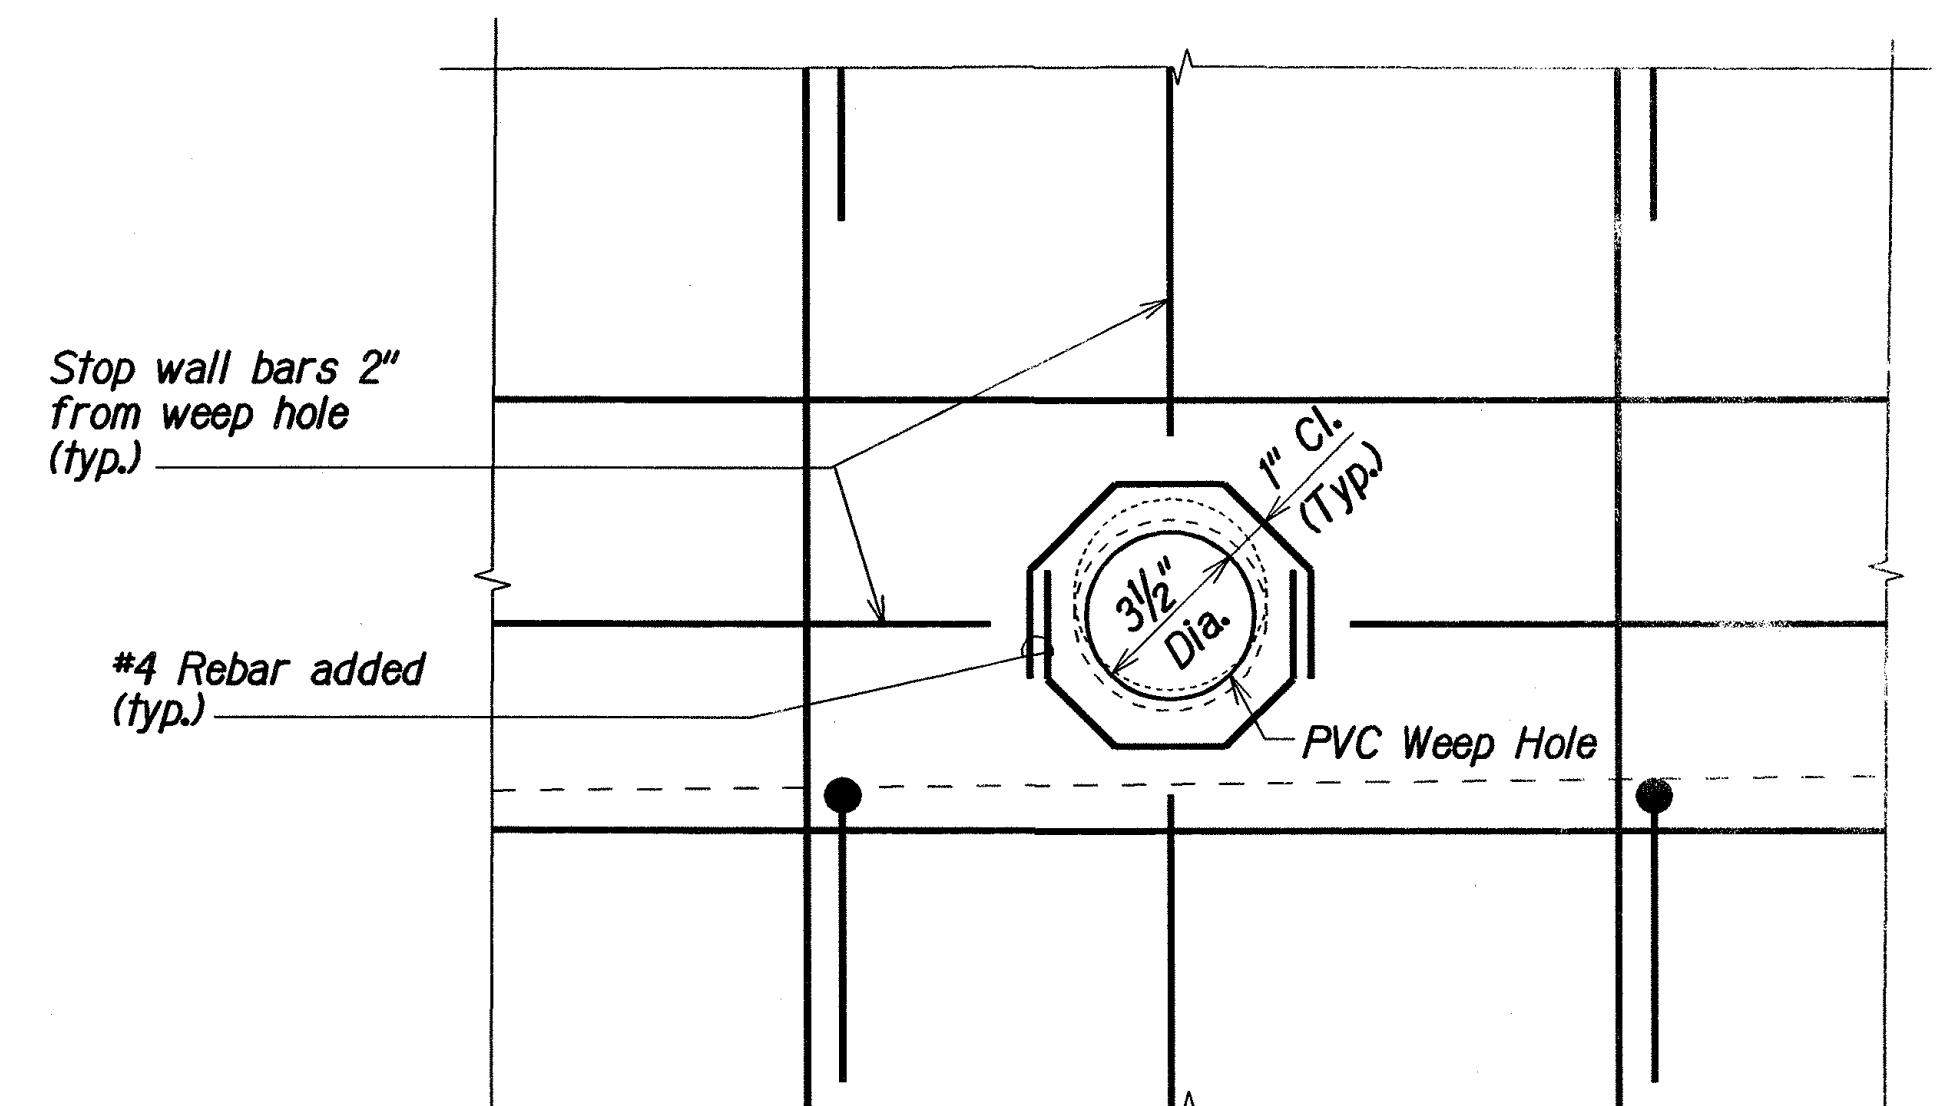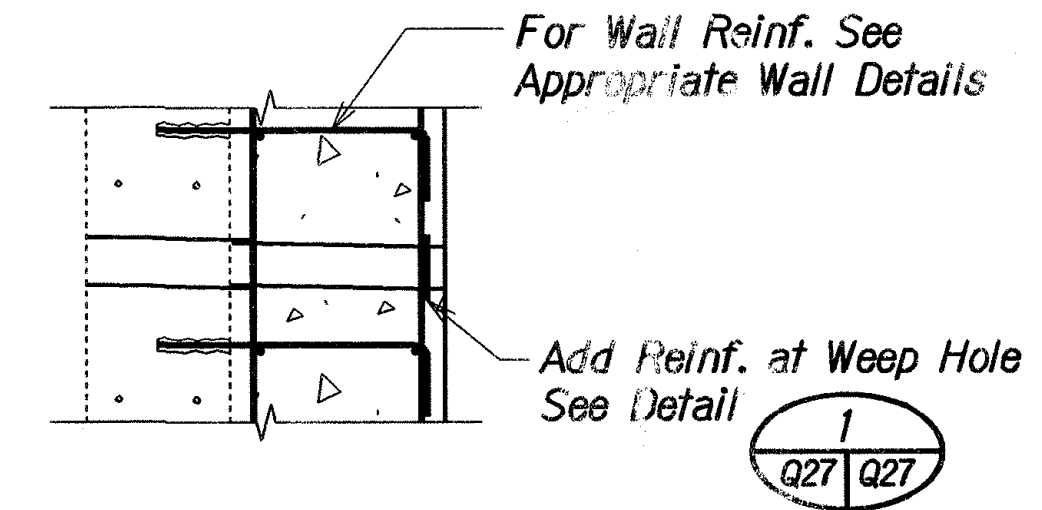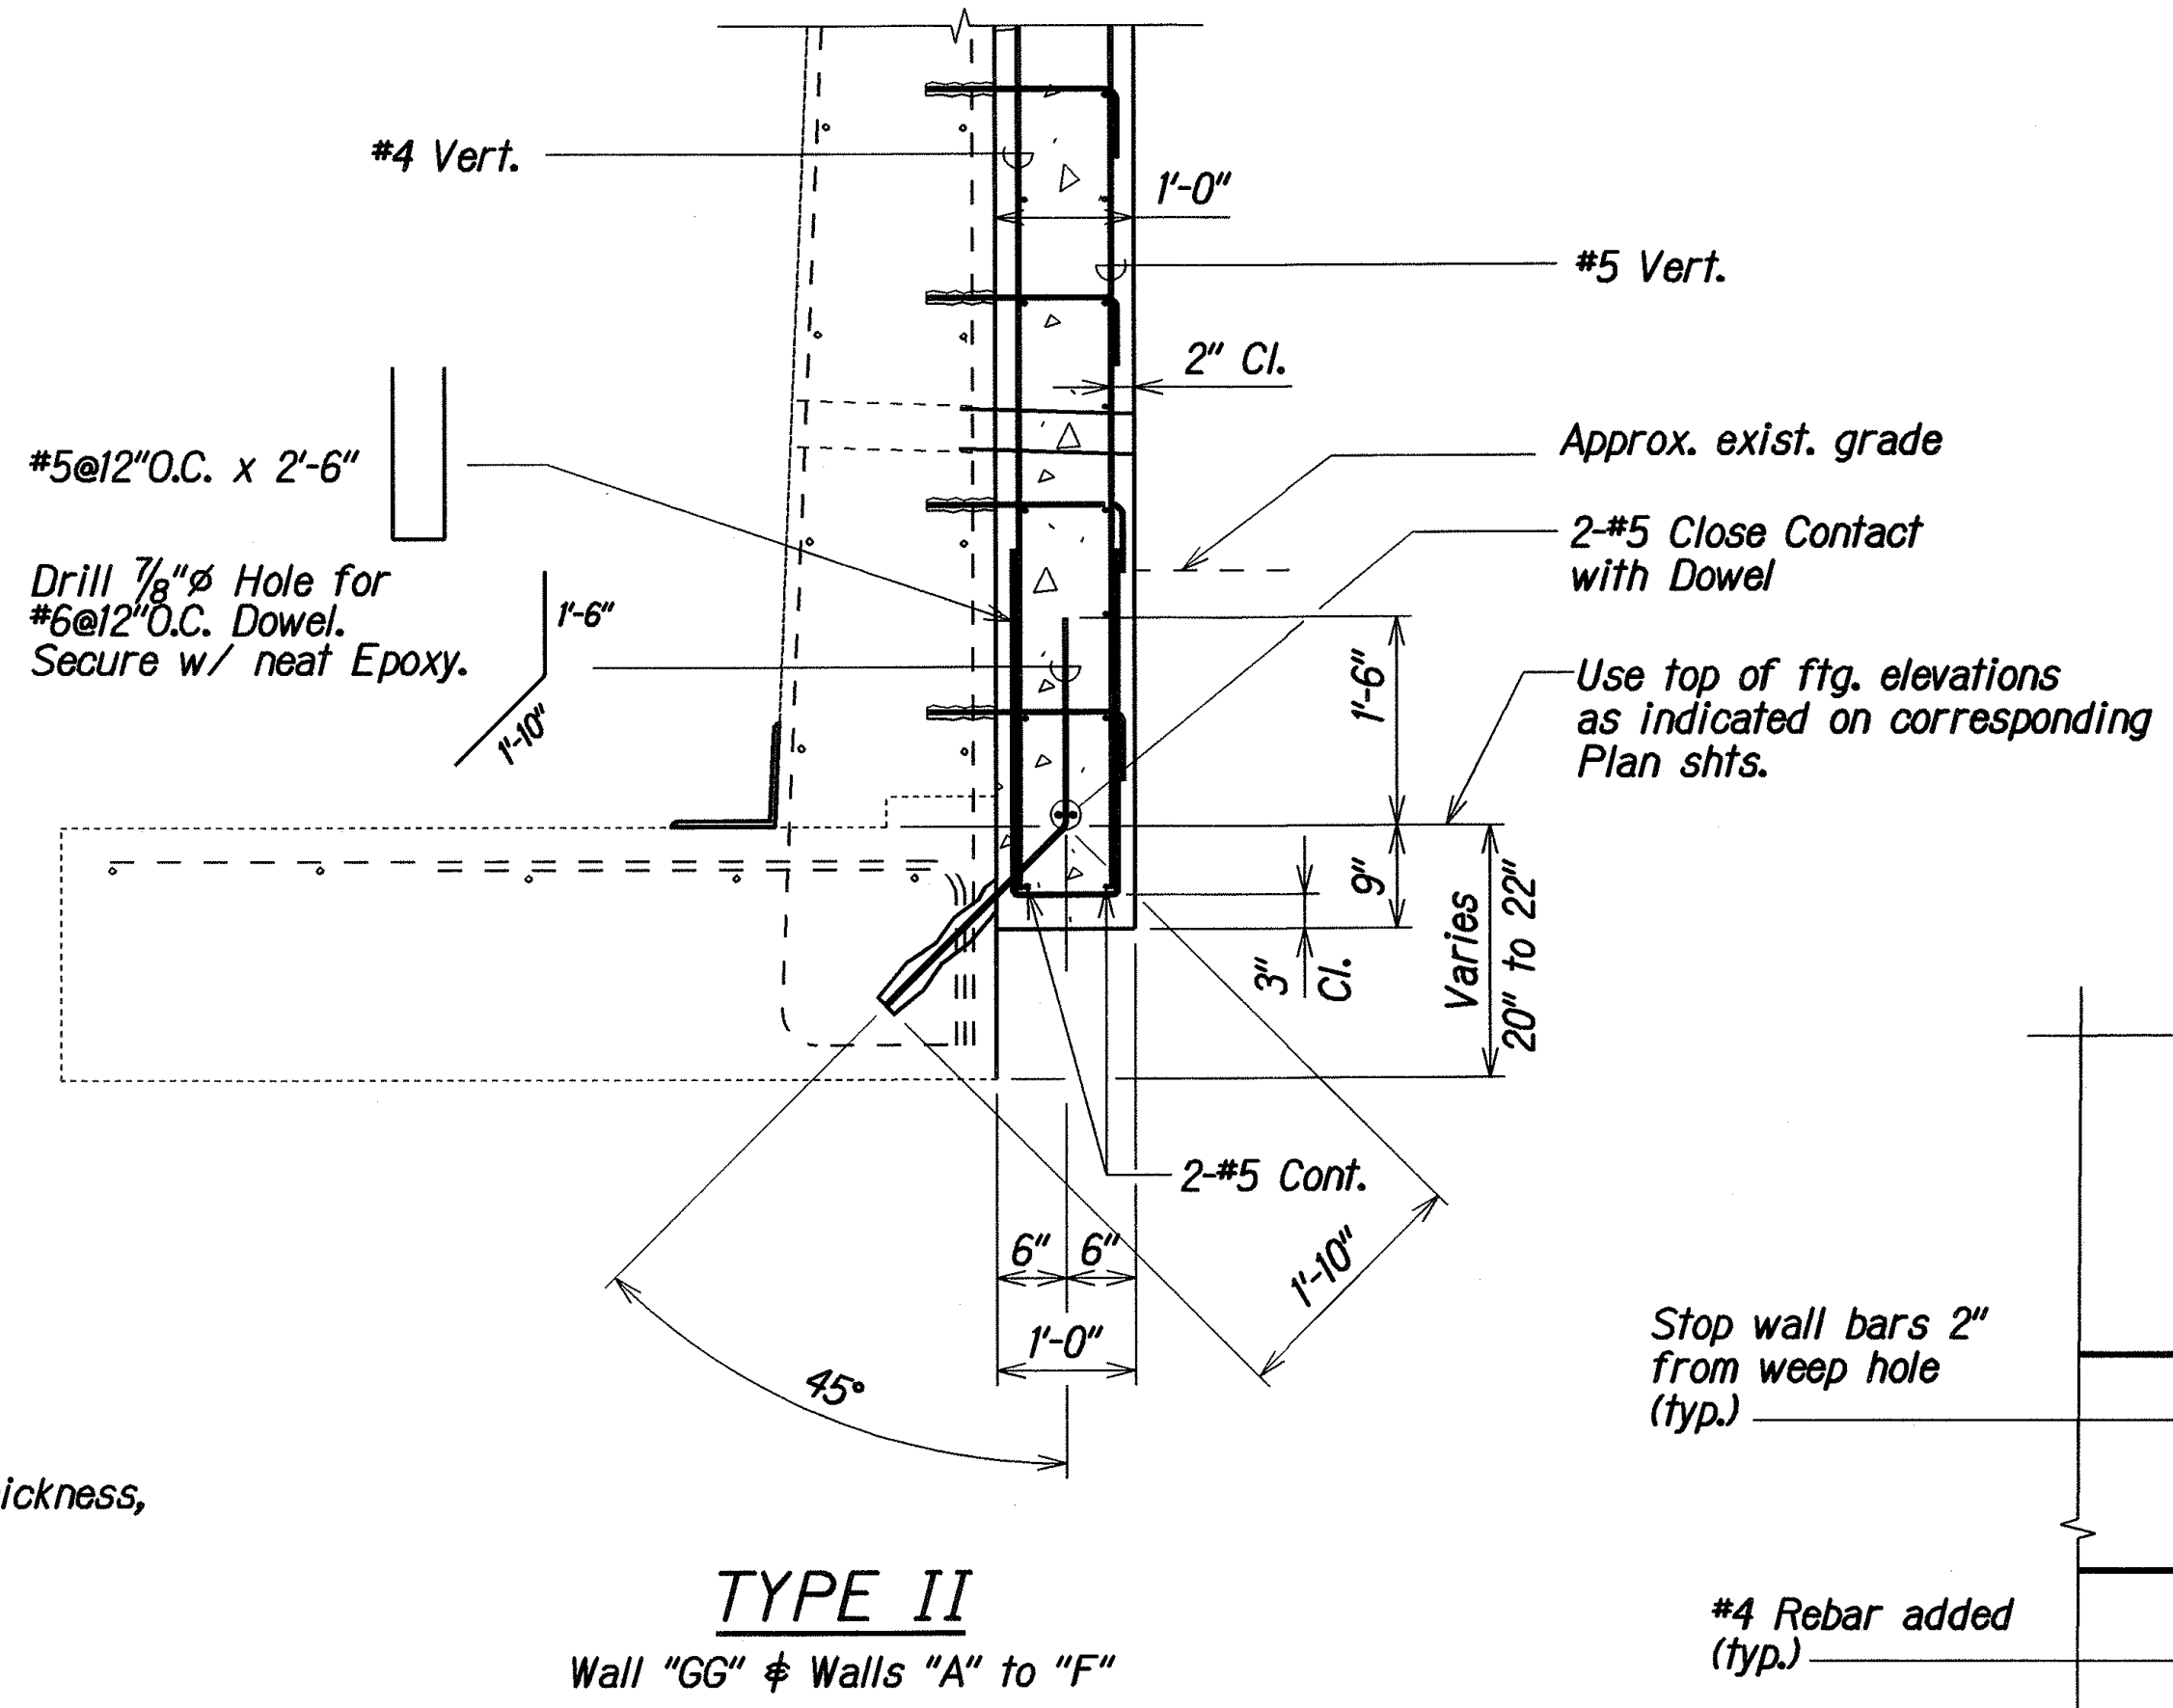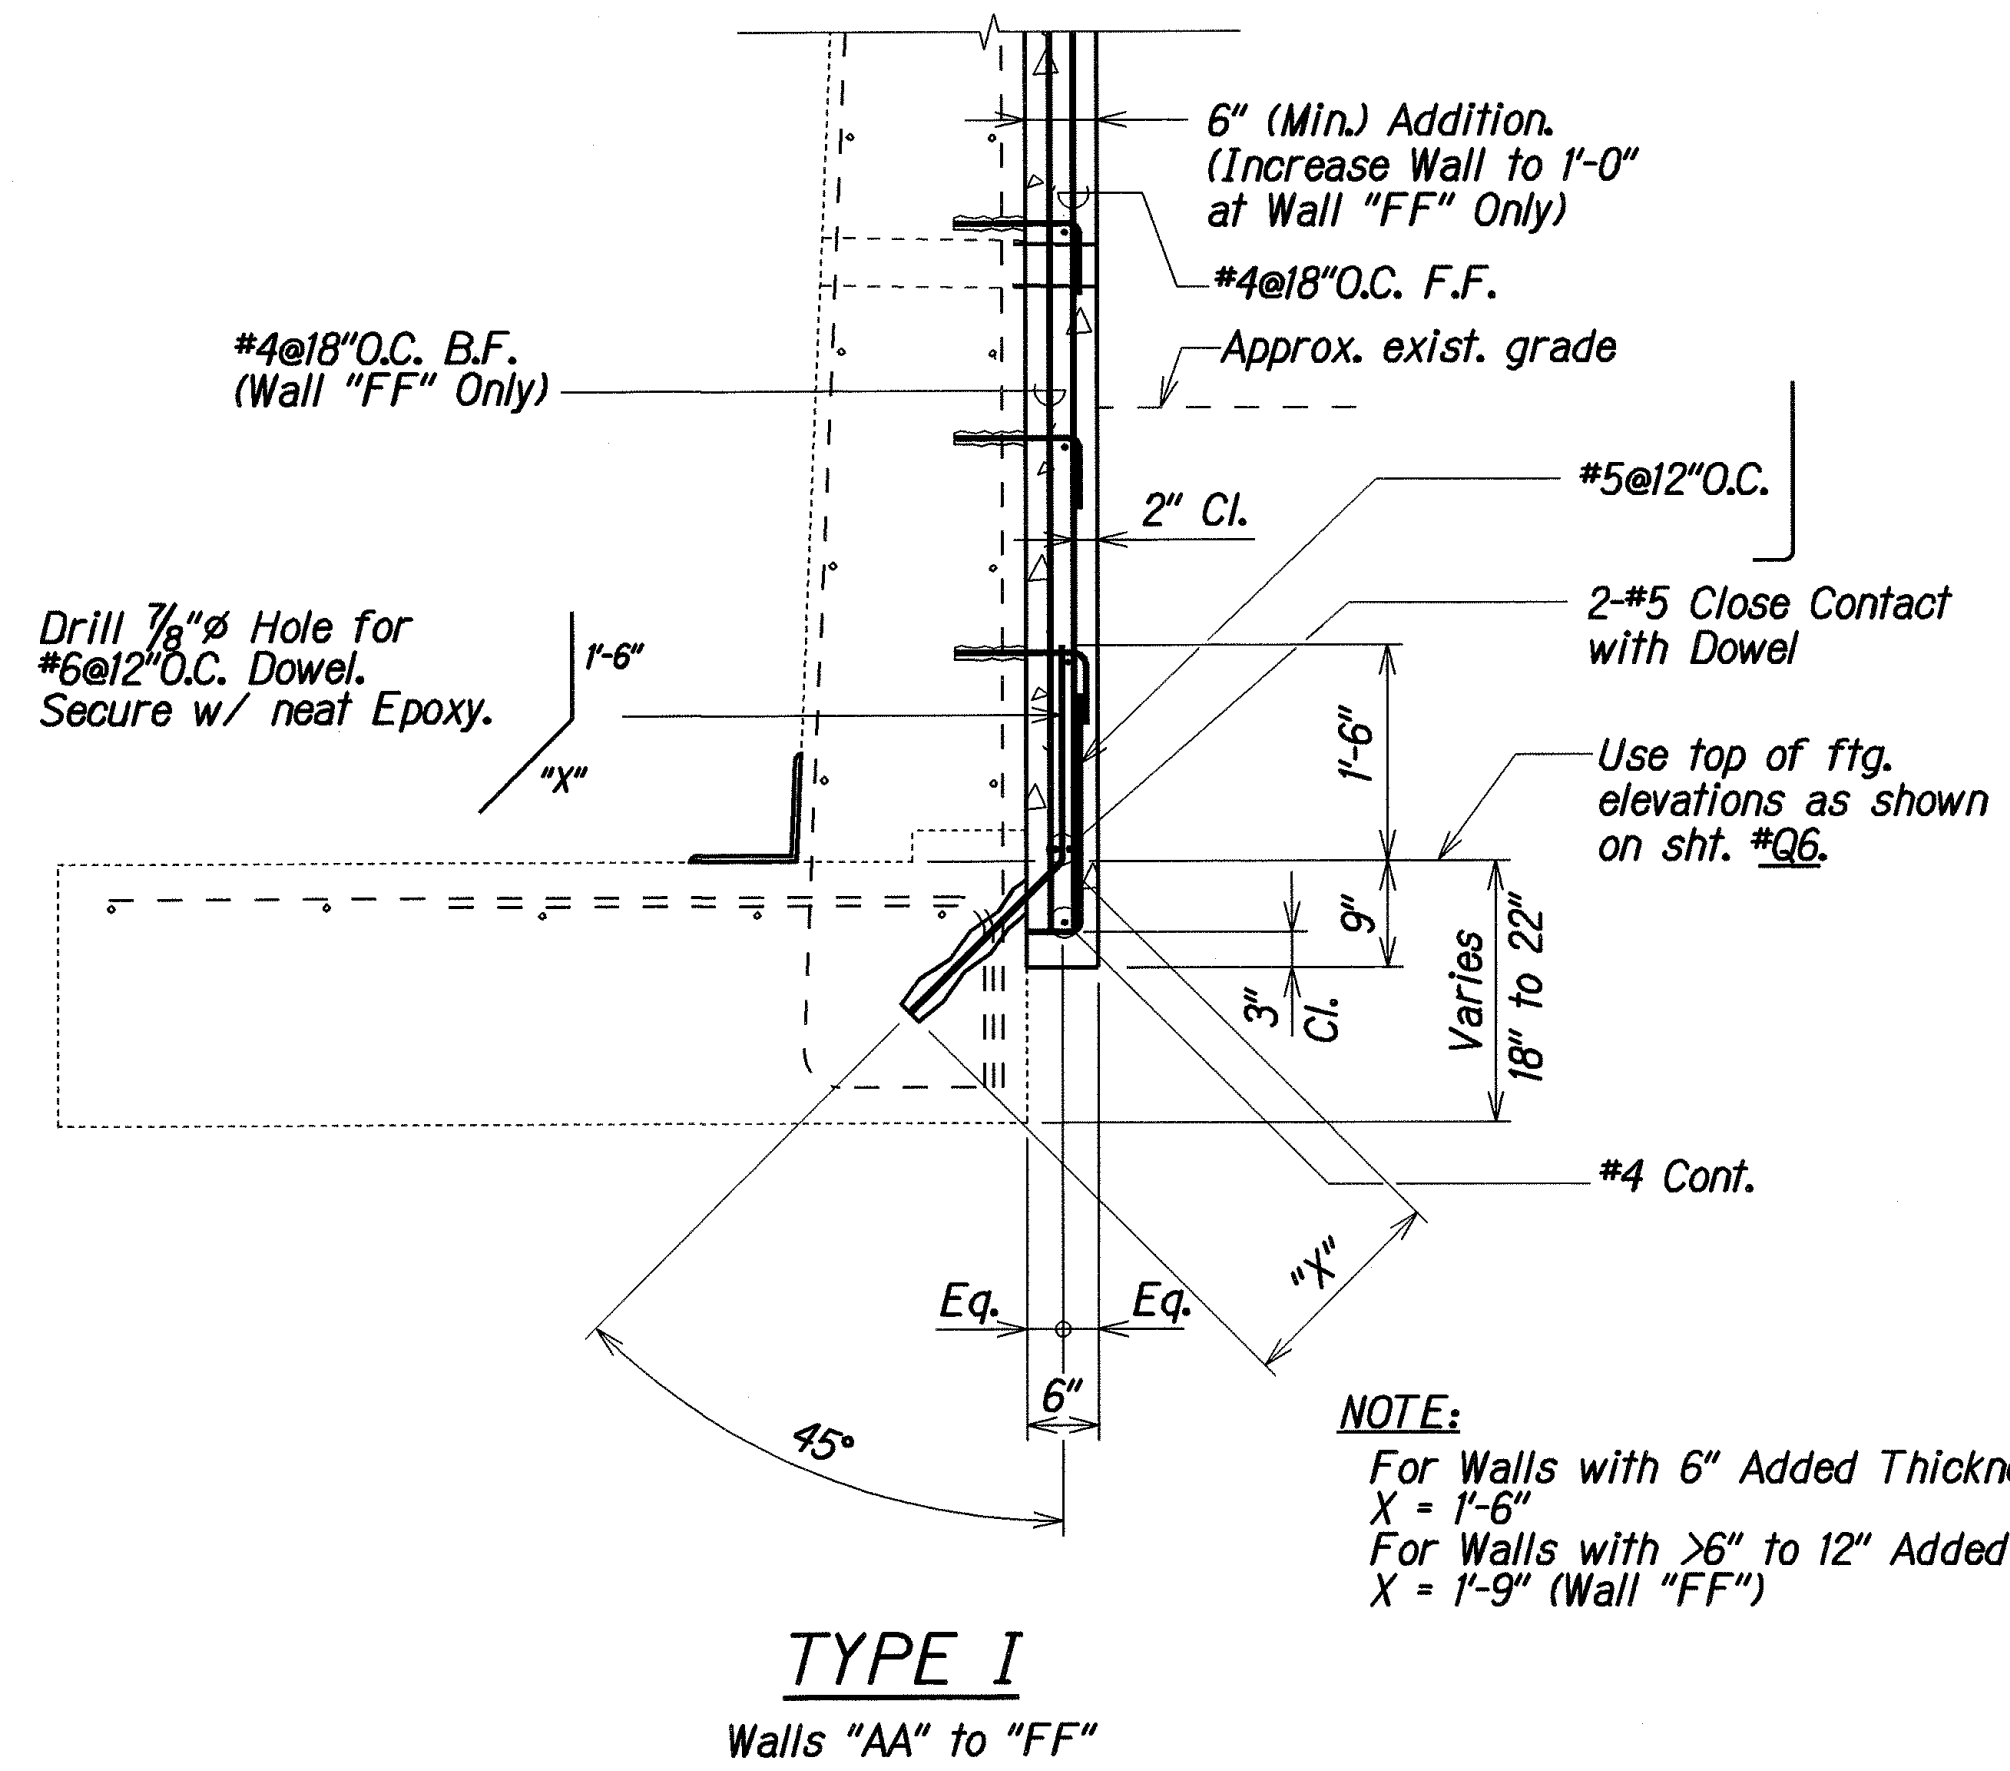

ALTERNATE FOOTING DOWEL PLACEMENT DETAILS FOR NO FOOTING TOE

Scale: 3/4"=1'-0"
NOTE: See sht. #Q6 for limits.

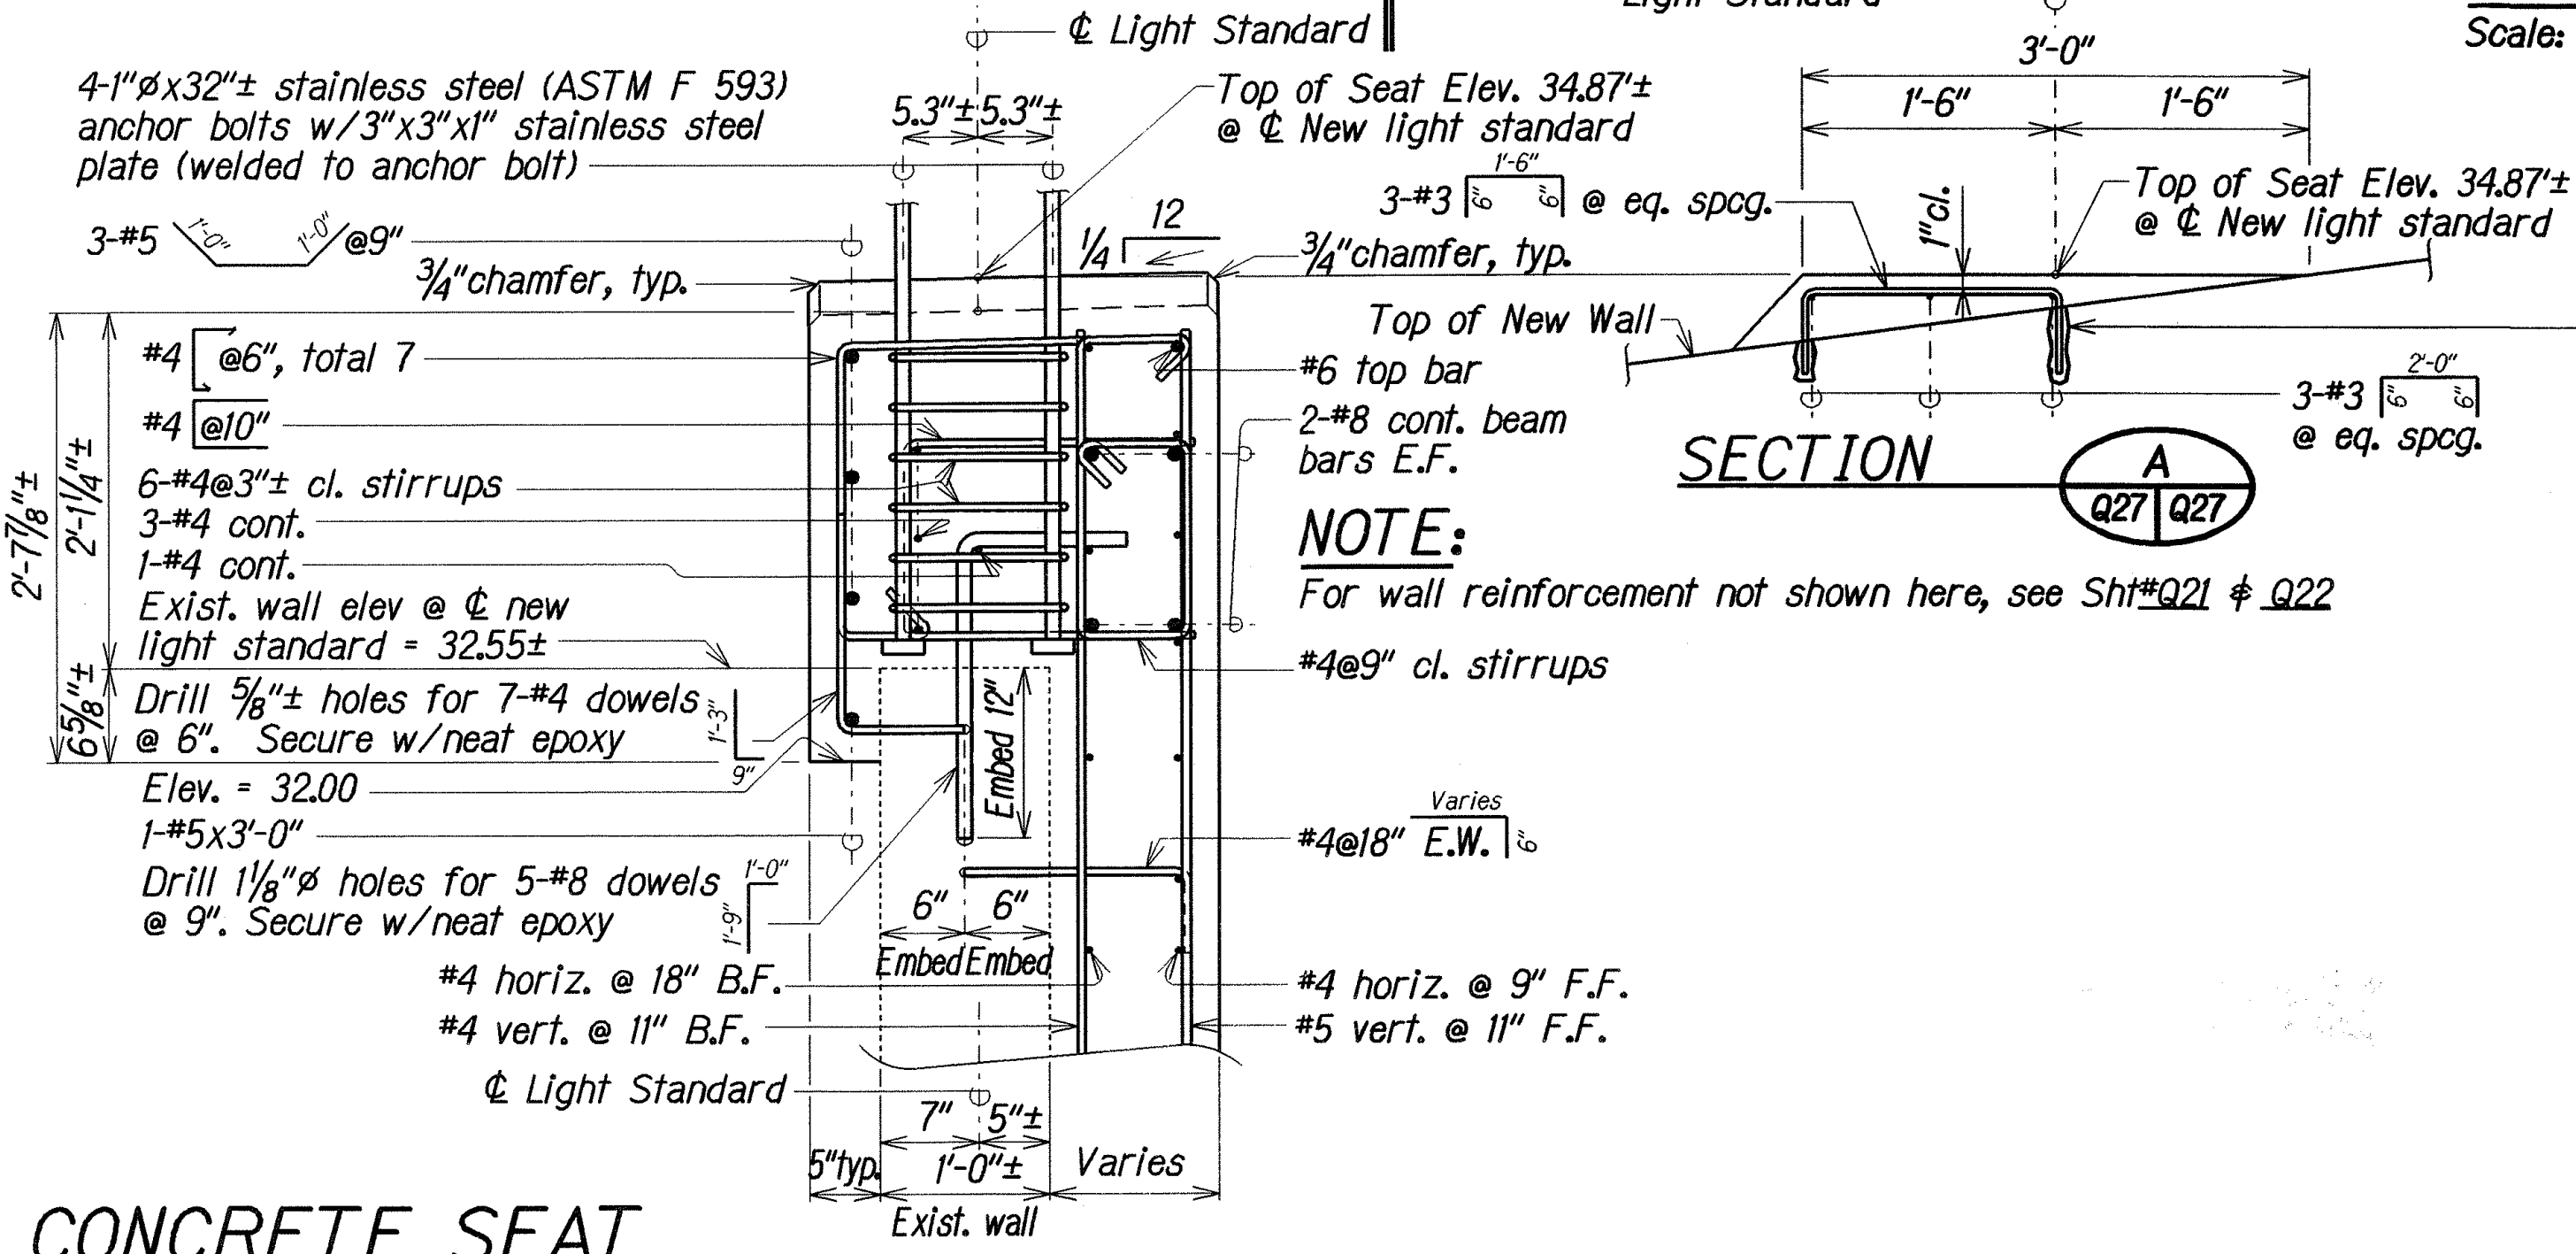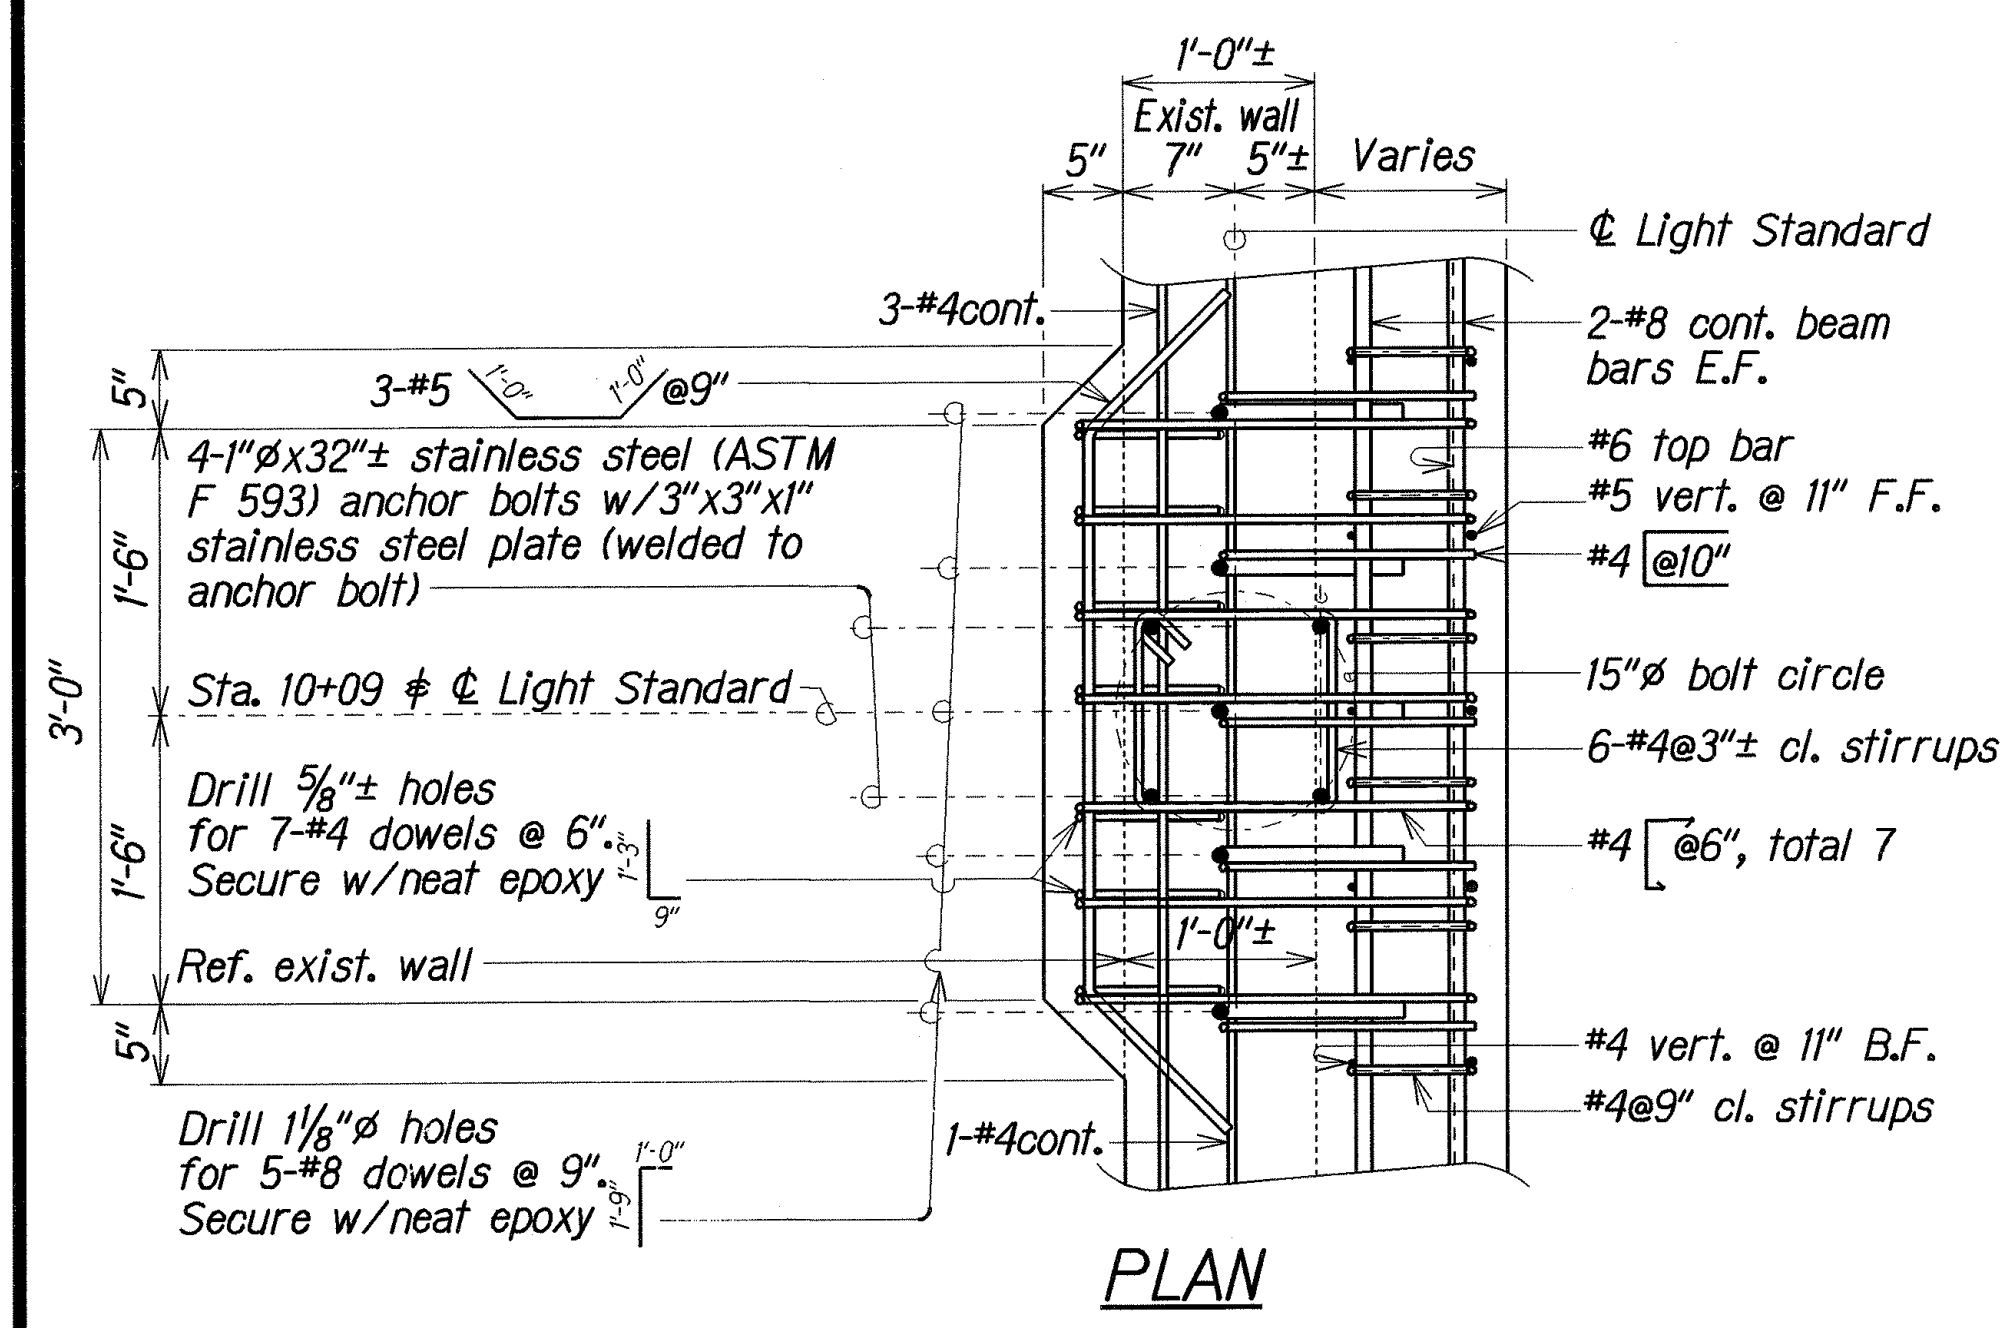

△ LIGHT STANDARD CONCRETE SEAT on WALL "P" at RAMP 7 STA. 10+09
Scale: 1" = 1'-0"

DATE	REVISION
3/31/09	Added Light Standard Concrete Seat on Wall "P" at Ramp 7 Sta. 10+09 Details
STATE OF HAWAII DEPARTMENT OF TRANSPORTATION HIGHWAYS DIVISION RETAINING WALL REPAIR ALTERNATE FOOTING DOWEL PLACEMENT, WEEP HOLE AND LIGHT STD. @ STA. 10+09 DETAILS INTERSTATE ROUTE HI EXTENSION AND REPAIR OF SCHOOL STREET RAMP RETAINING WALL Scale: As Noted Project No. HII-01-08 Date: Feb. 2009	
SHEET No. Q27 OF 34 SHEETS	

Provide Additional $\frac{3}{4}" \phi \times 10'-0"$ Copperweld Gnd. Rod. if gnd. resistance on Main Gnd. Rod exceed 25 OHMS Max.

2" PVC Sch. 80 Conduit

2-#5 x

Back Face

$\frac{1}{2}" \phi$ Weep Hole

Grd. Rod

1'-0"

2'-0" Sq.

6-#5 Reinf. Bars Equally Spaced x 2'-10"

4- $\frac{1}{2}" \phi$ Weep Hole (Typ.)



4-1" ϕ Stainless Steel Anchor Bolts to suit Trans. Base (Typ.)

Front Face of New Added Concrete Wall

PLAN







Scale: 1"=1'-0"

1'-0"

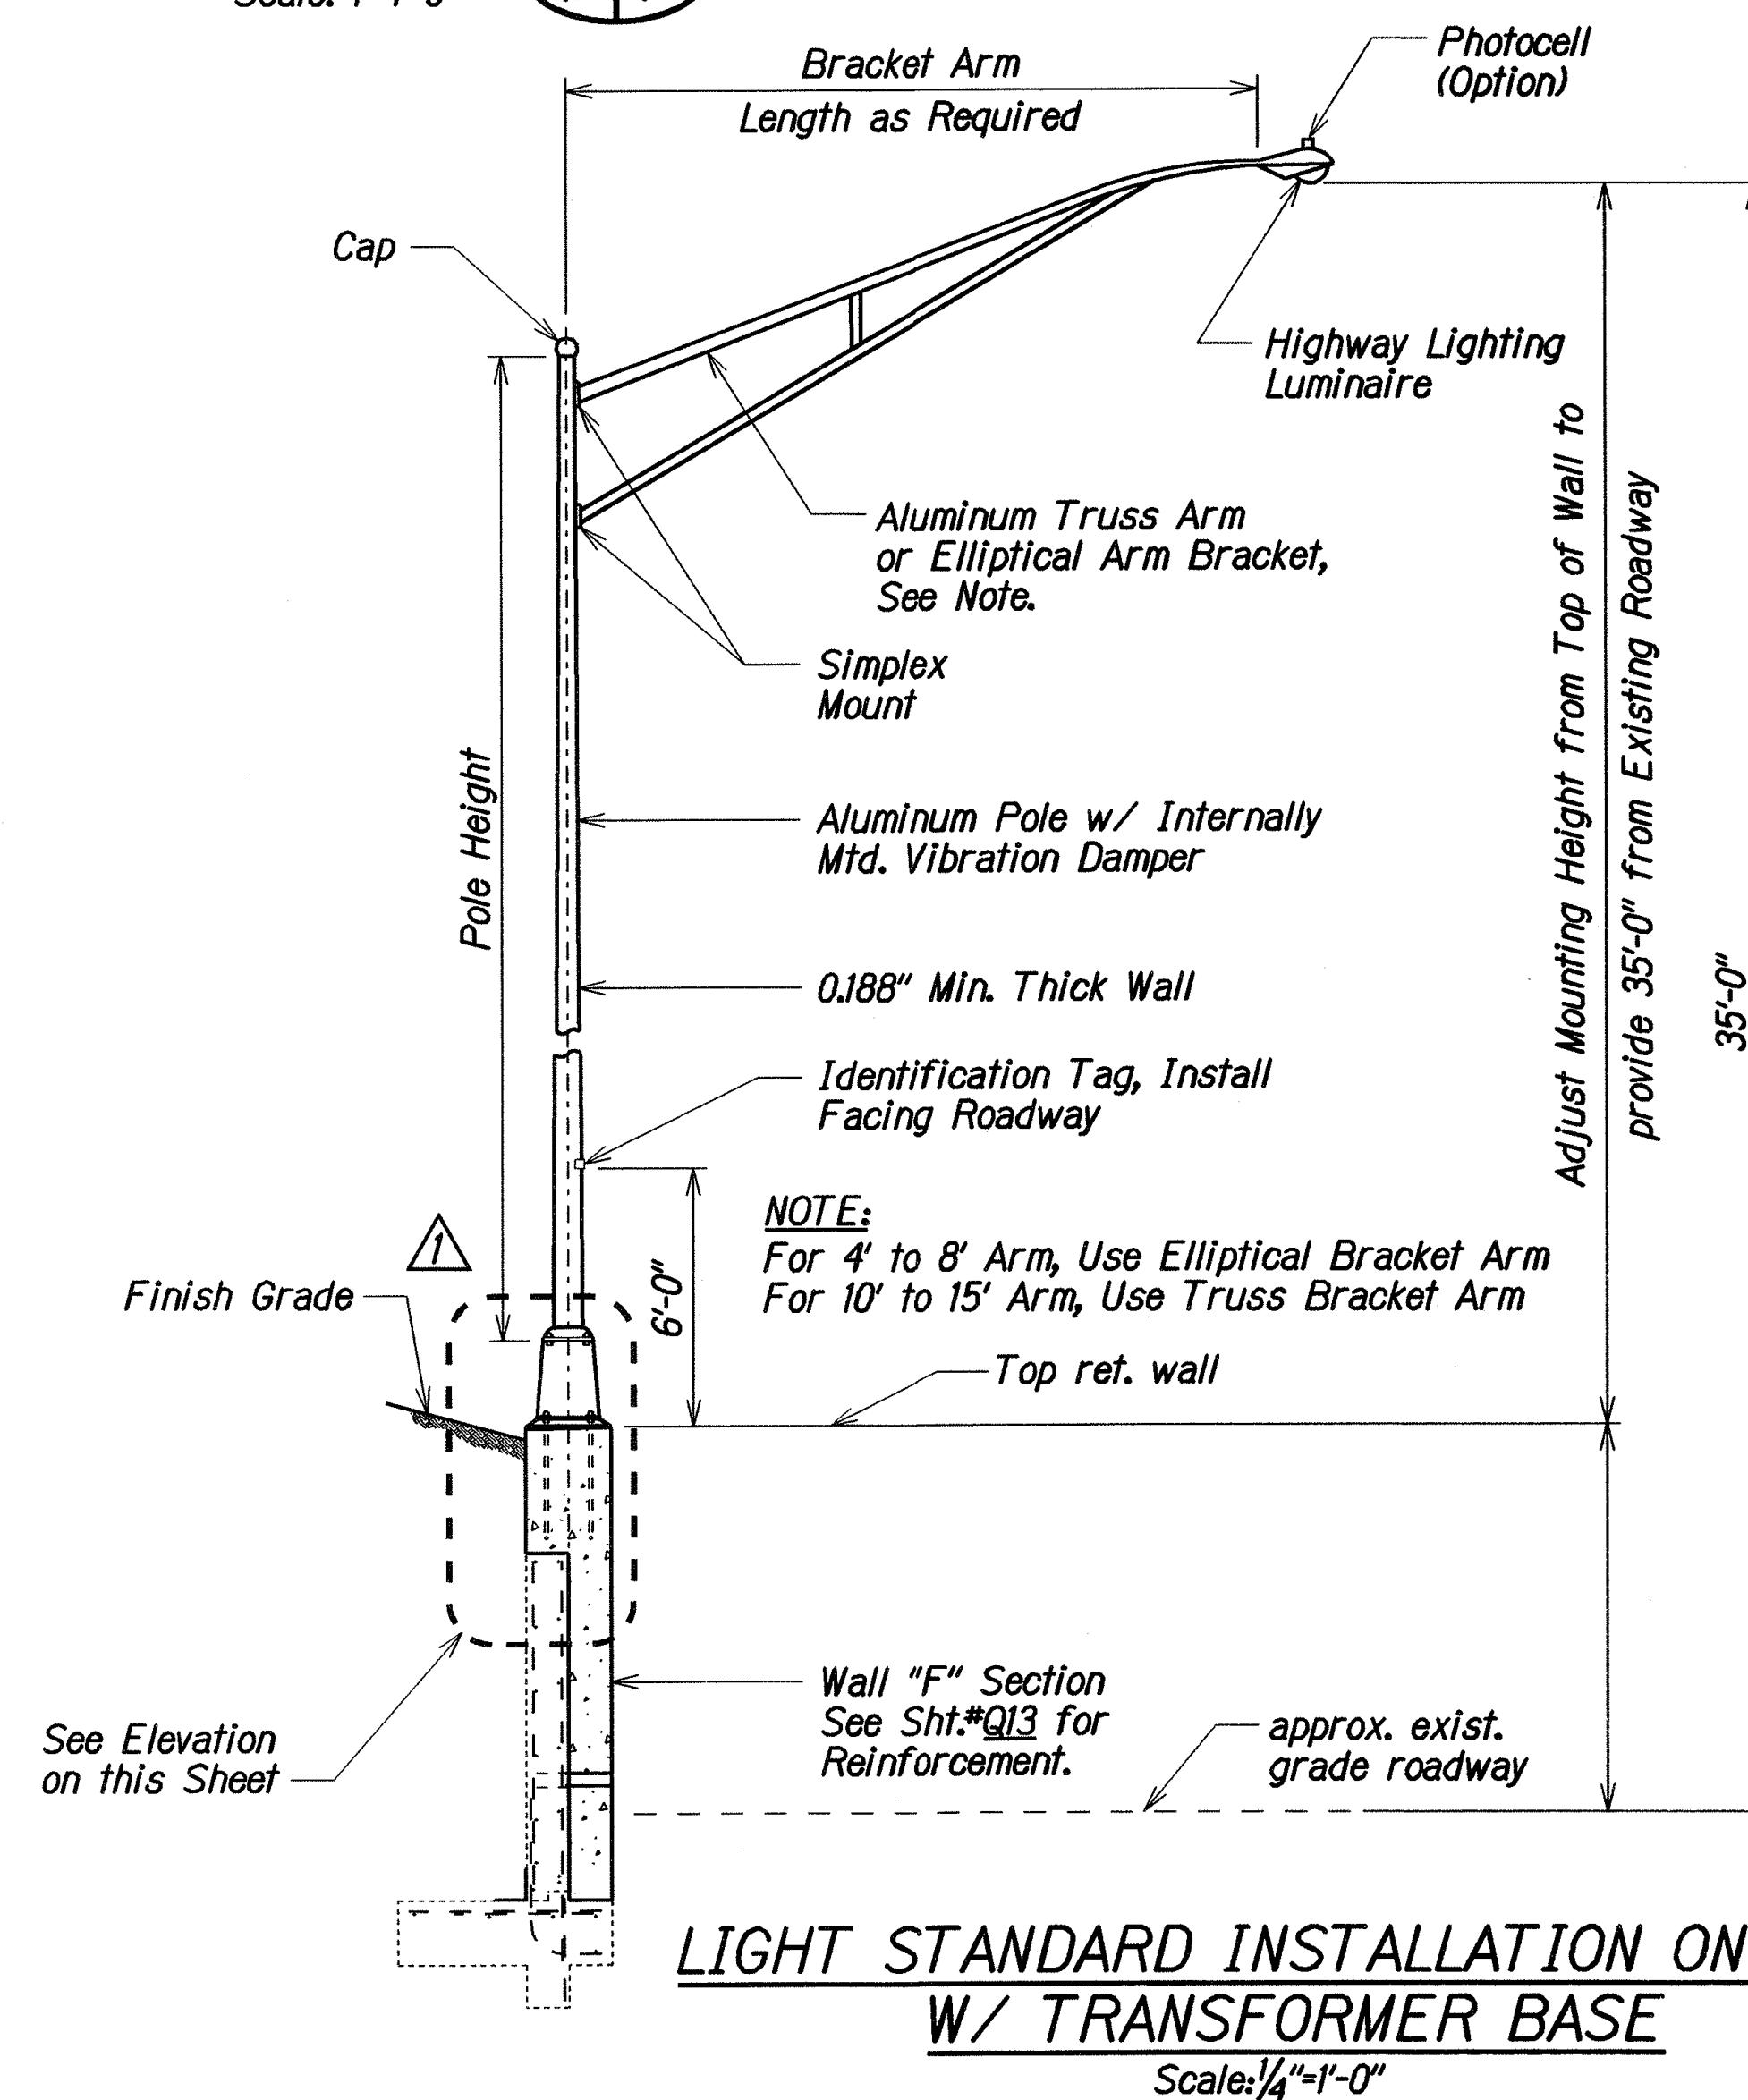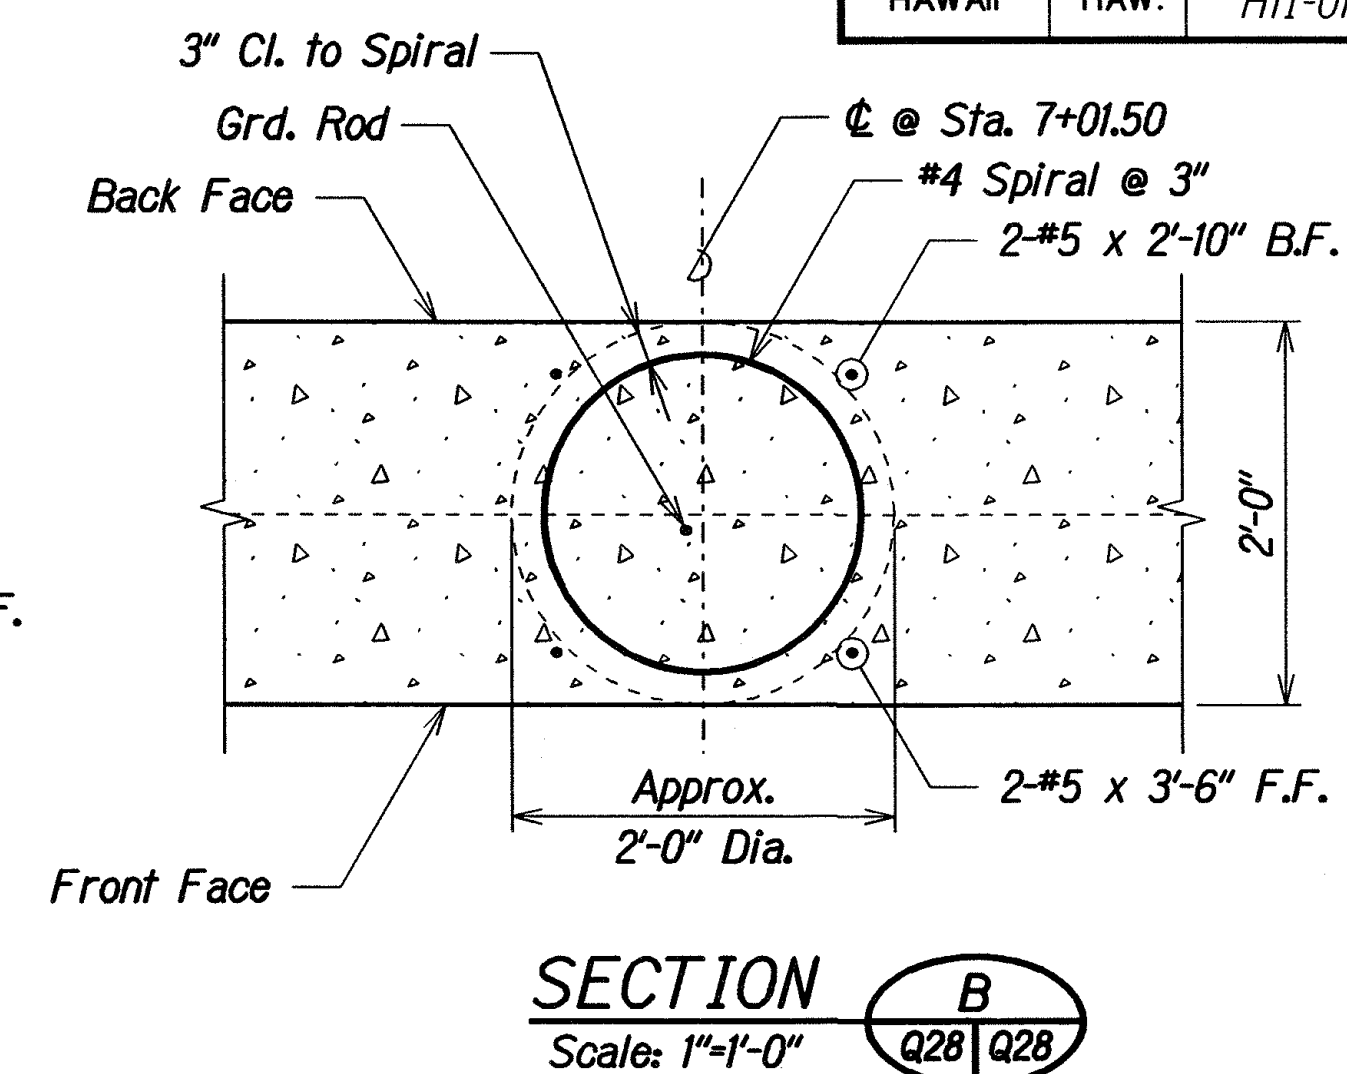

ADD. 36

FED. ROAD DIST. NO.	STATE	FED. AID PROJ. NO.	FISCAL YEAR	SHEET NO.	TOTAL SHEET
HAWAII	HAW.	H11-01-08	2009	37	73

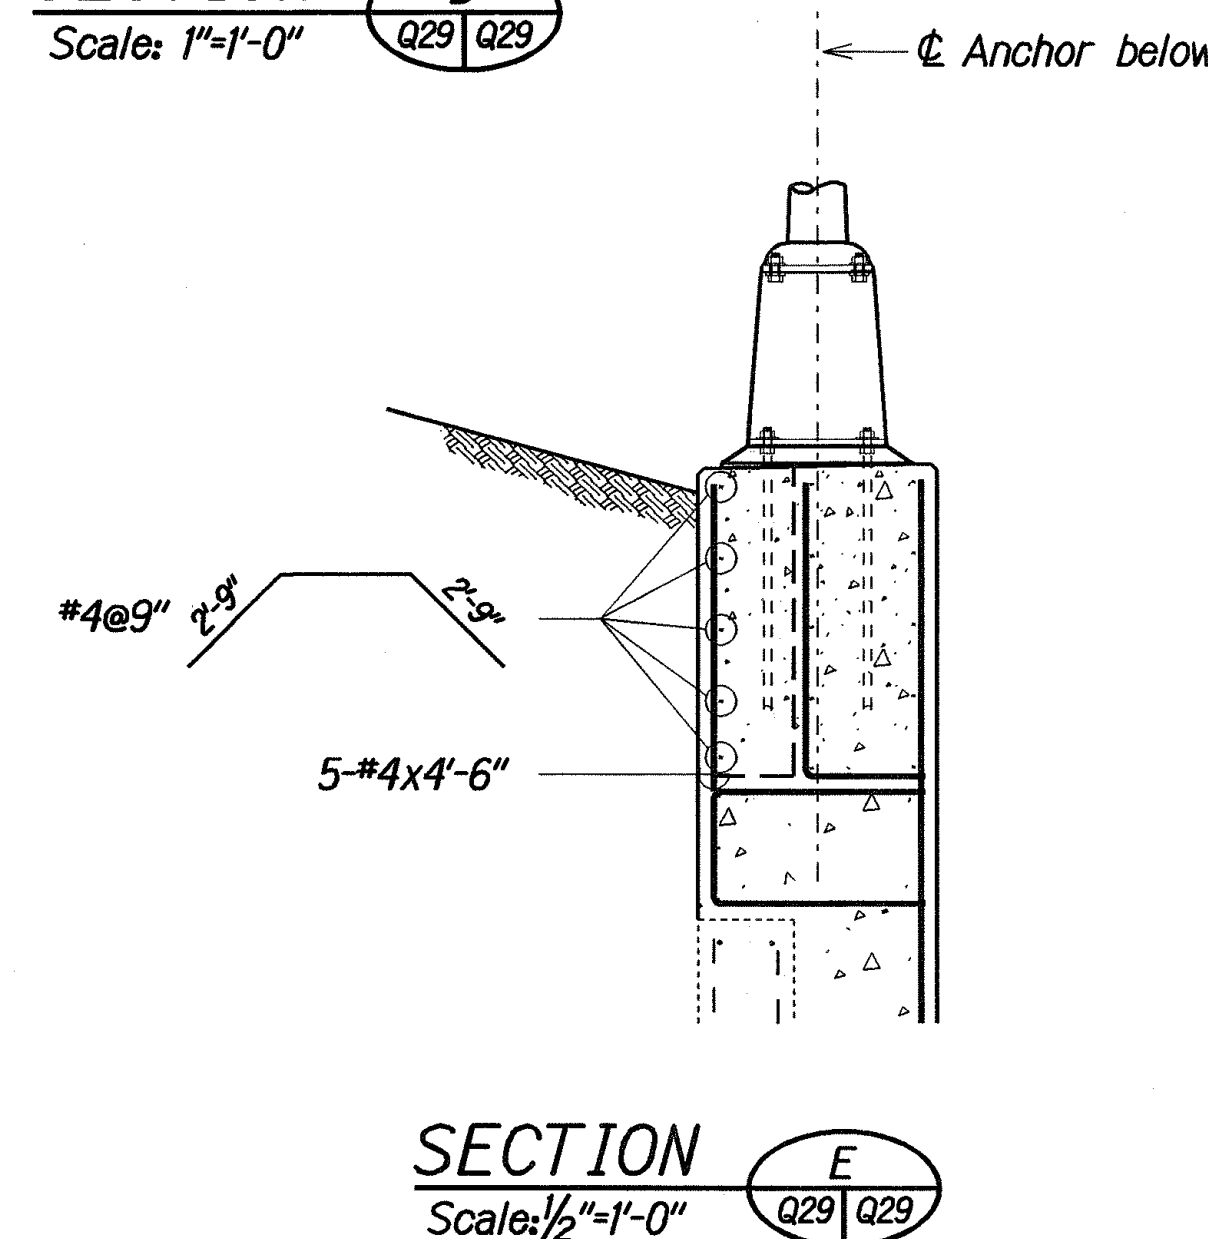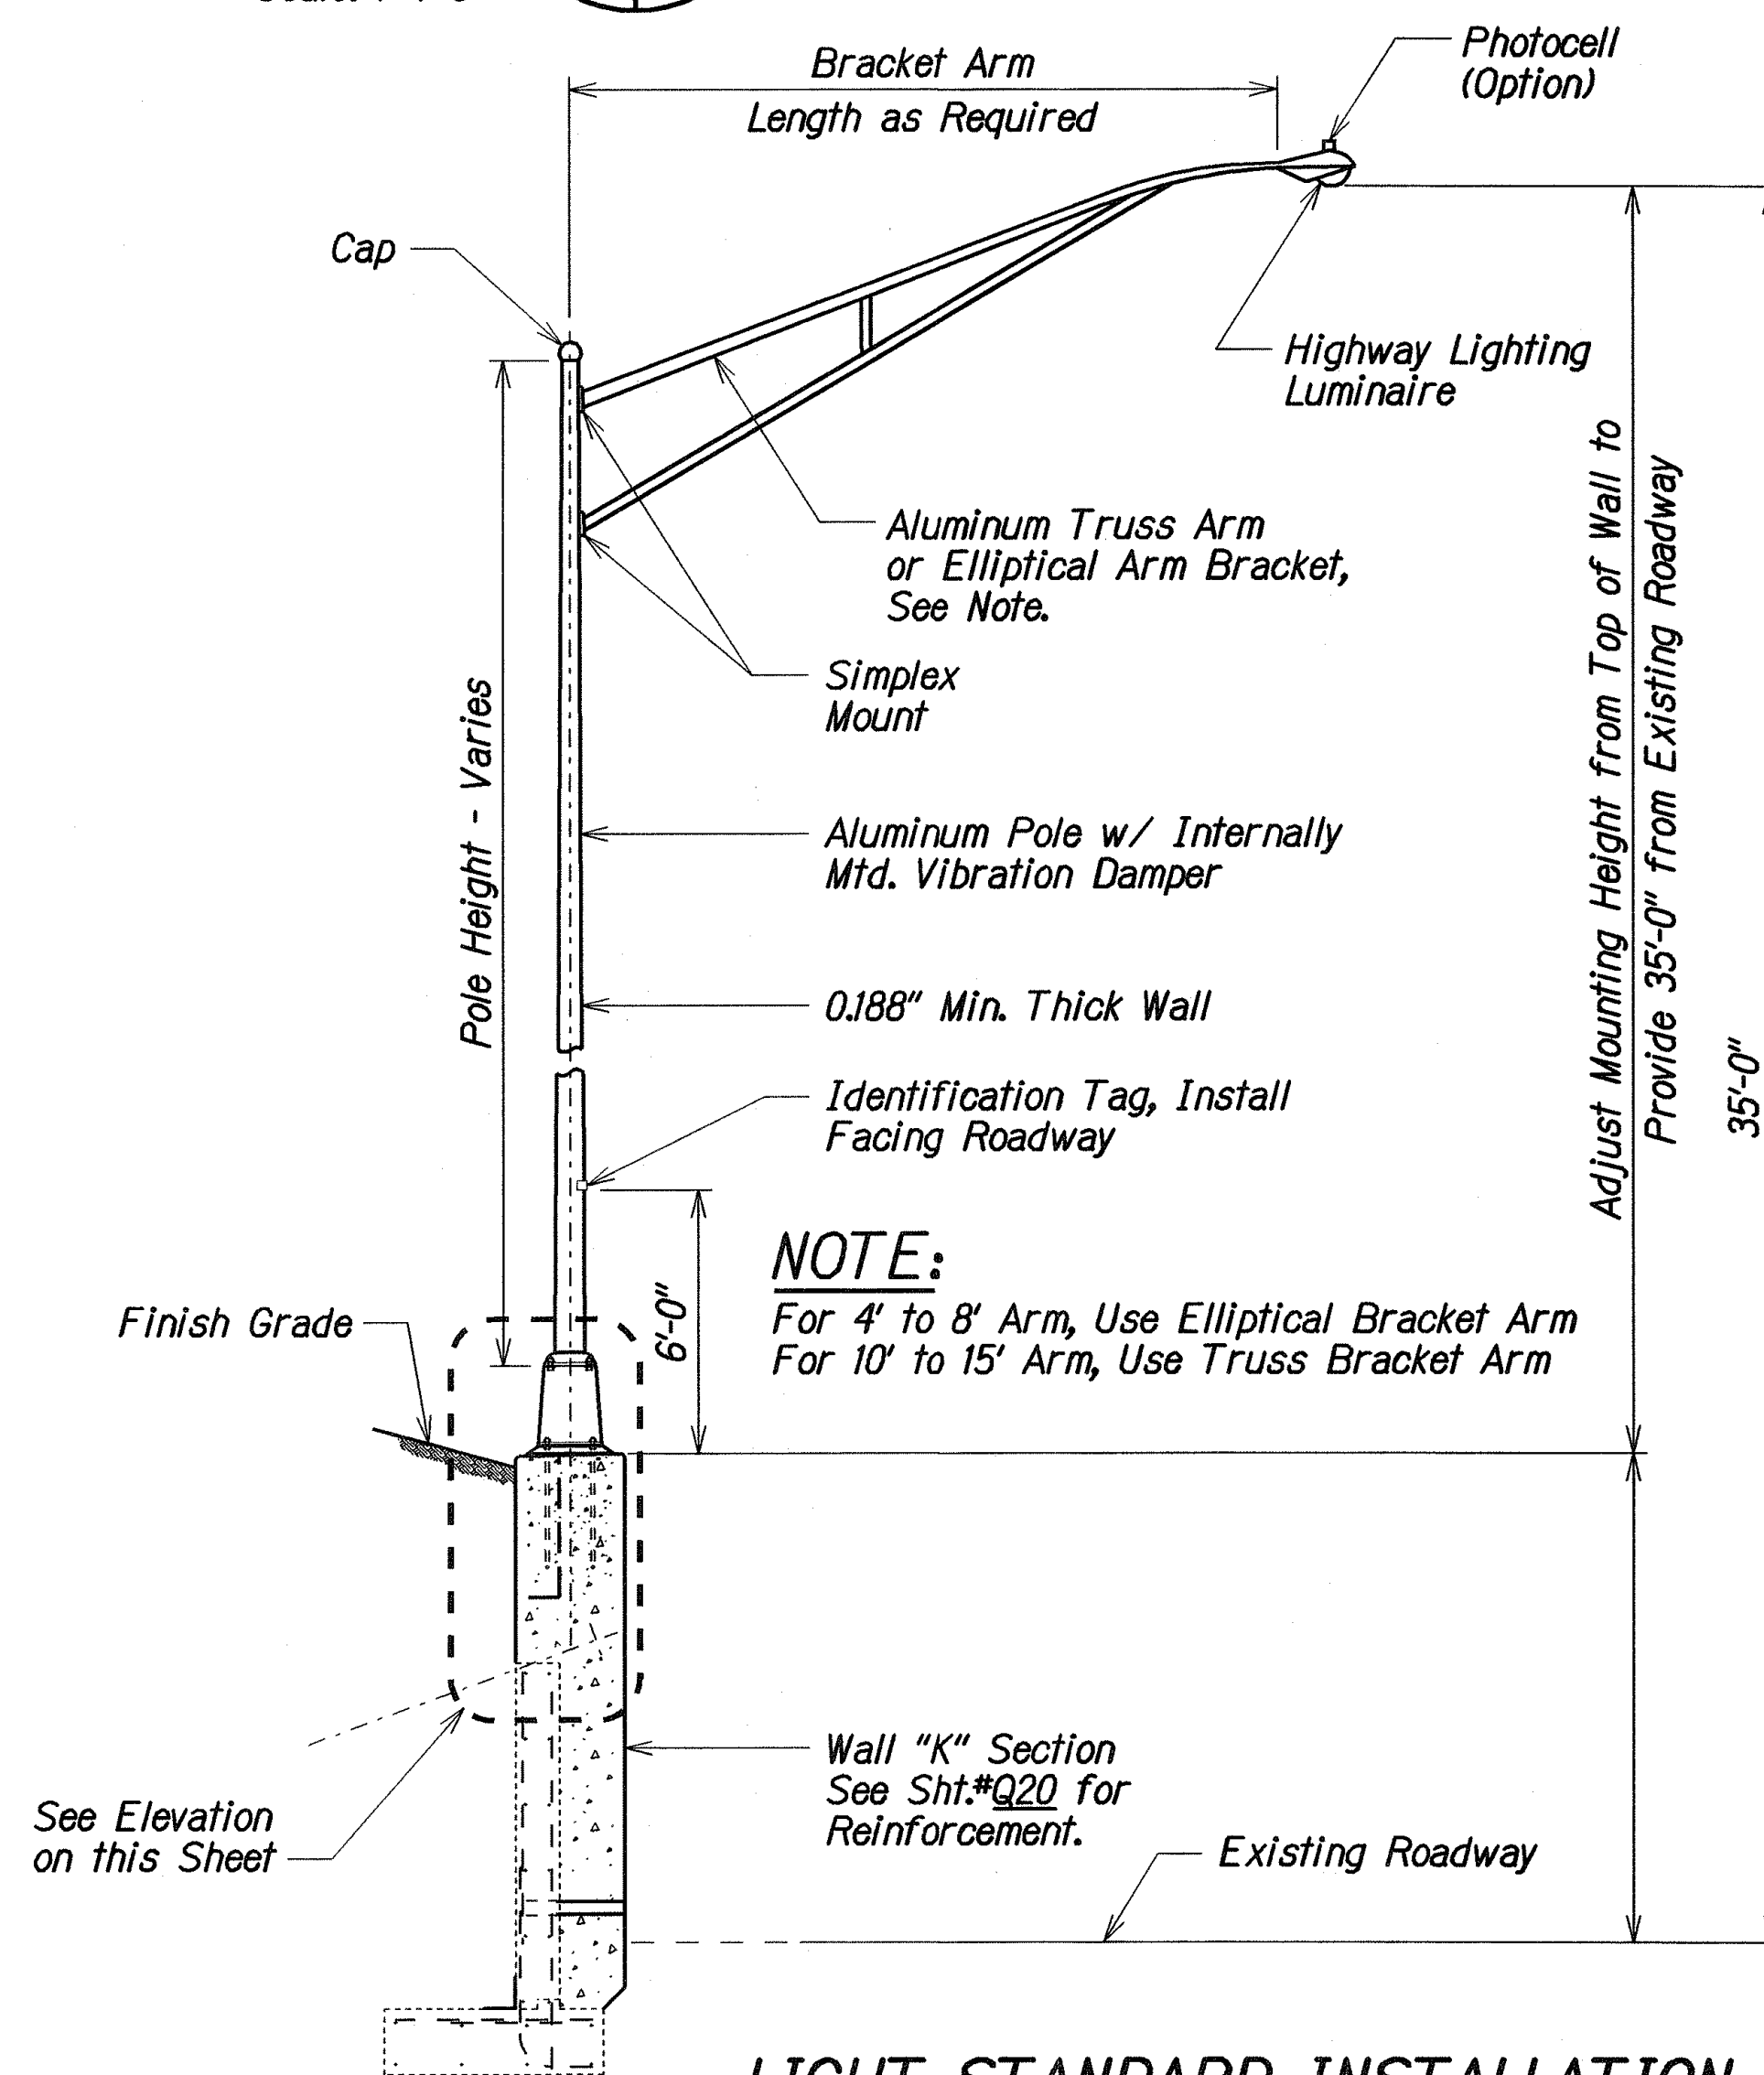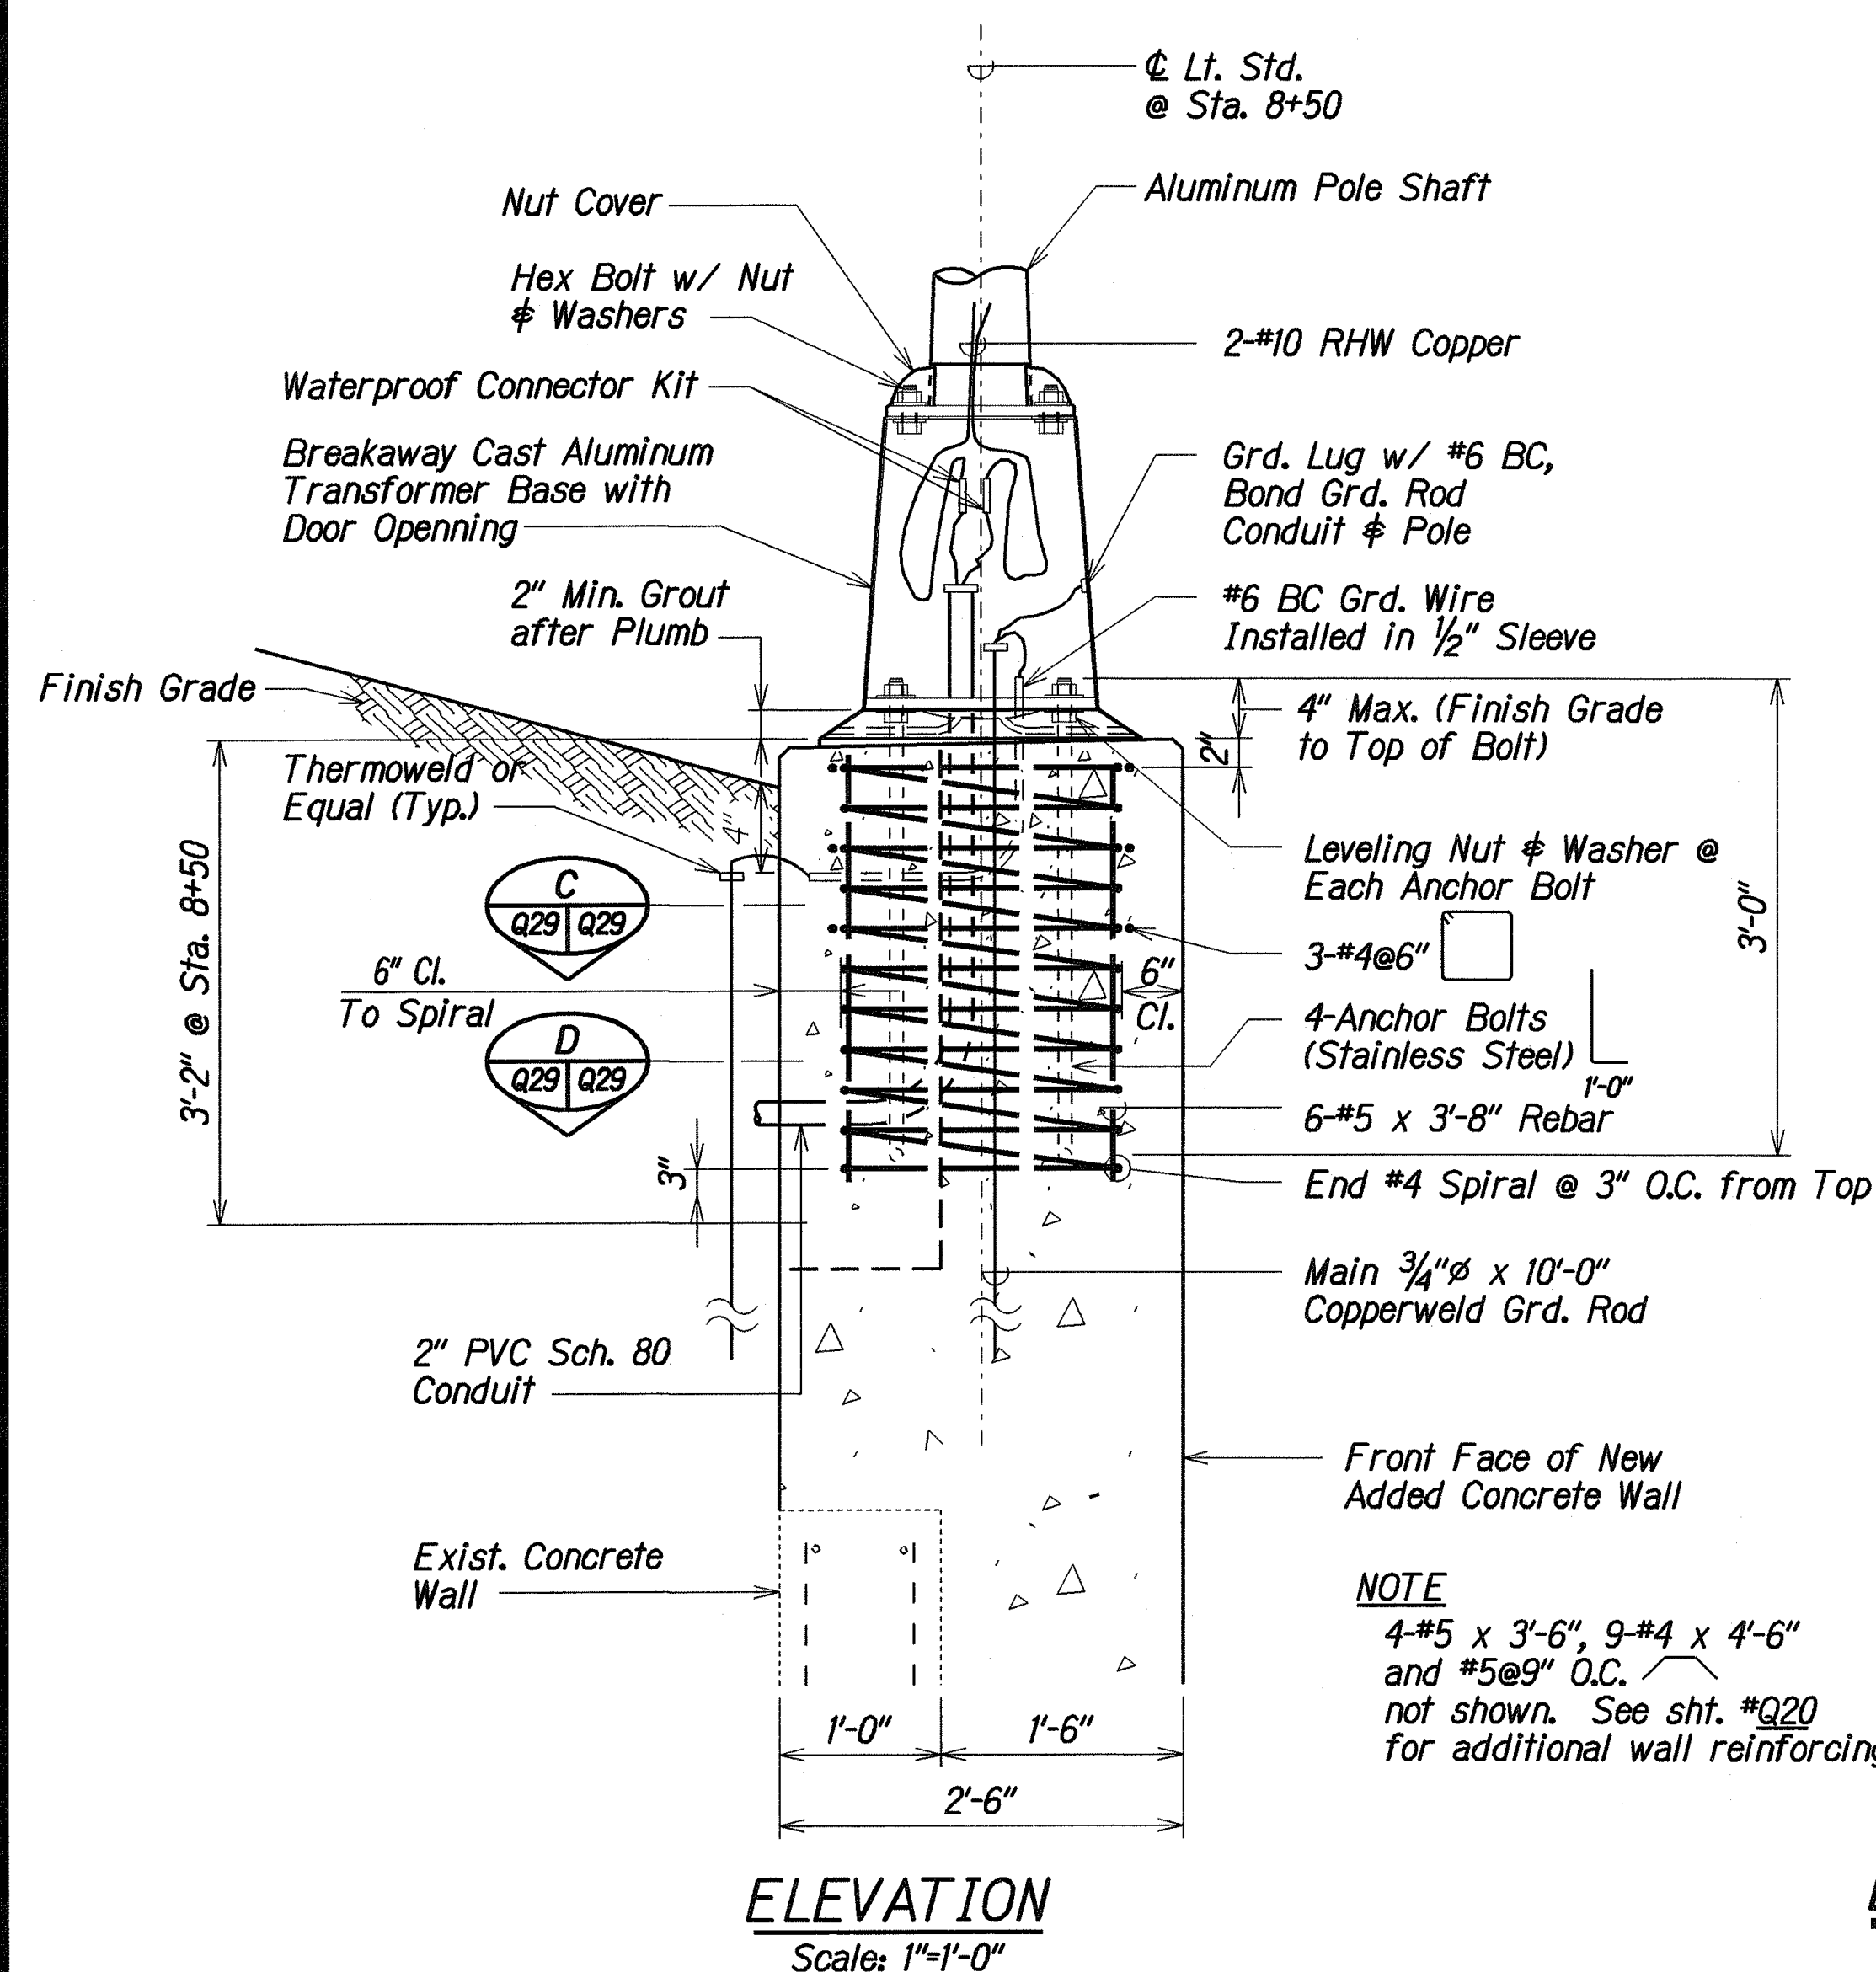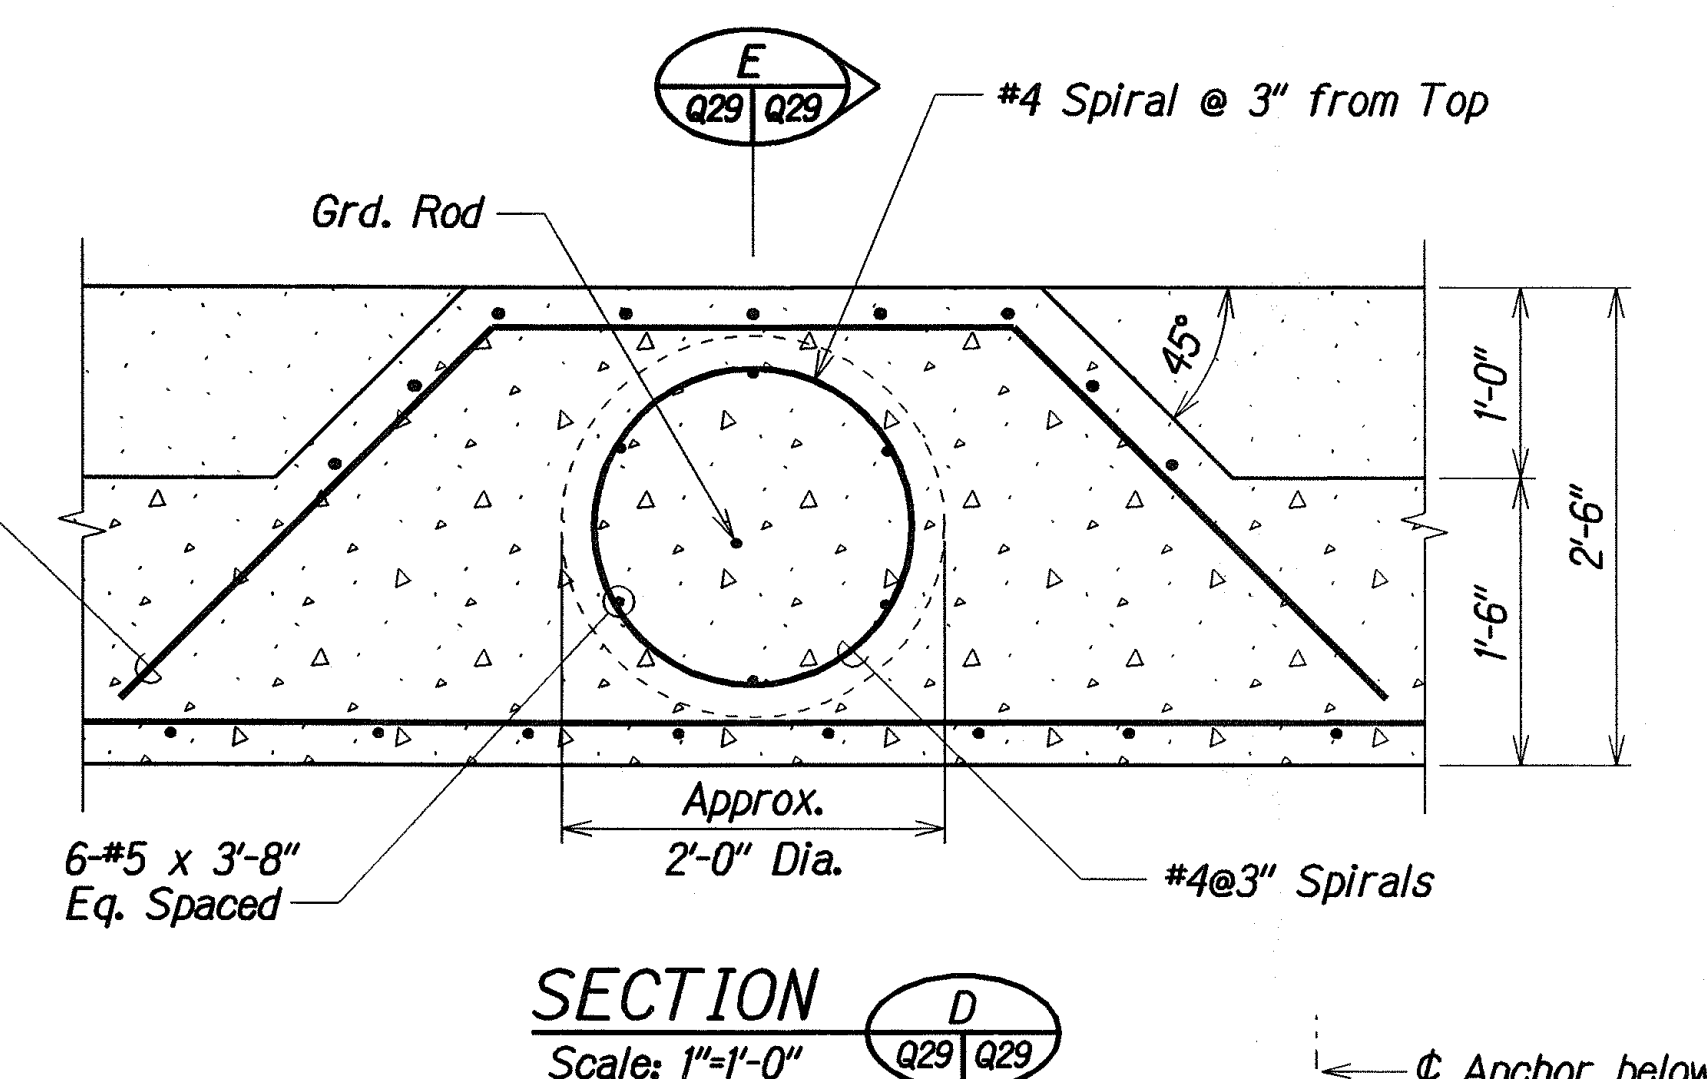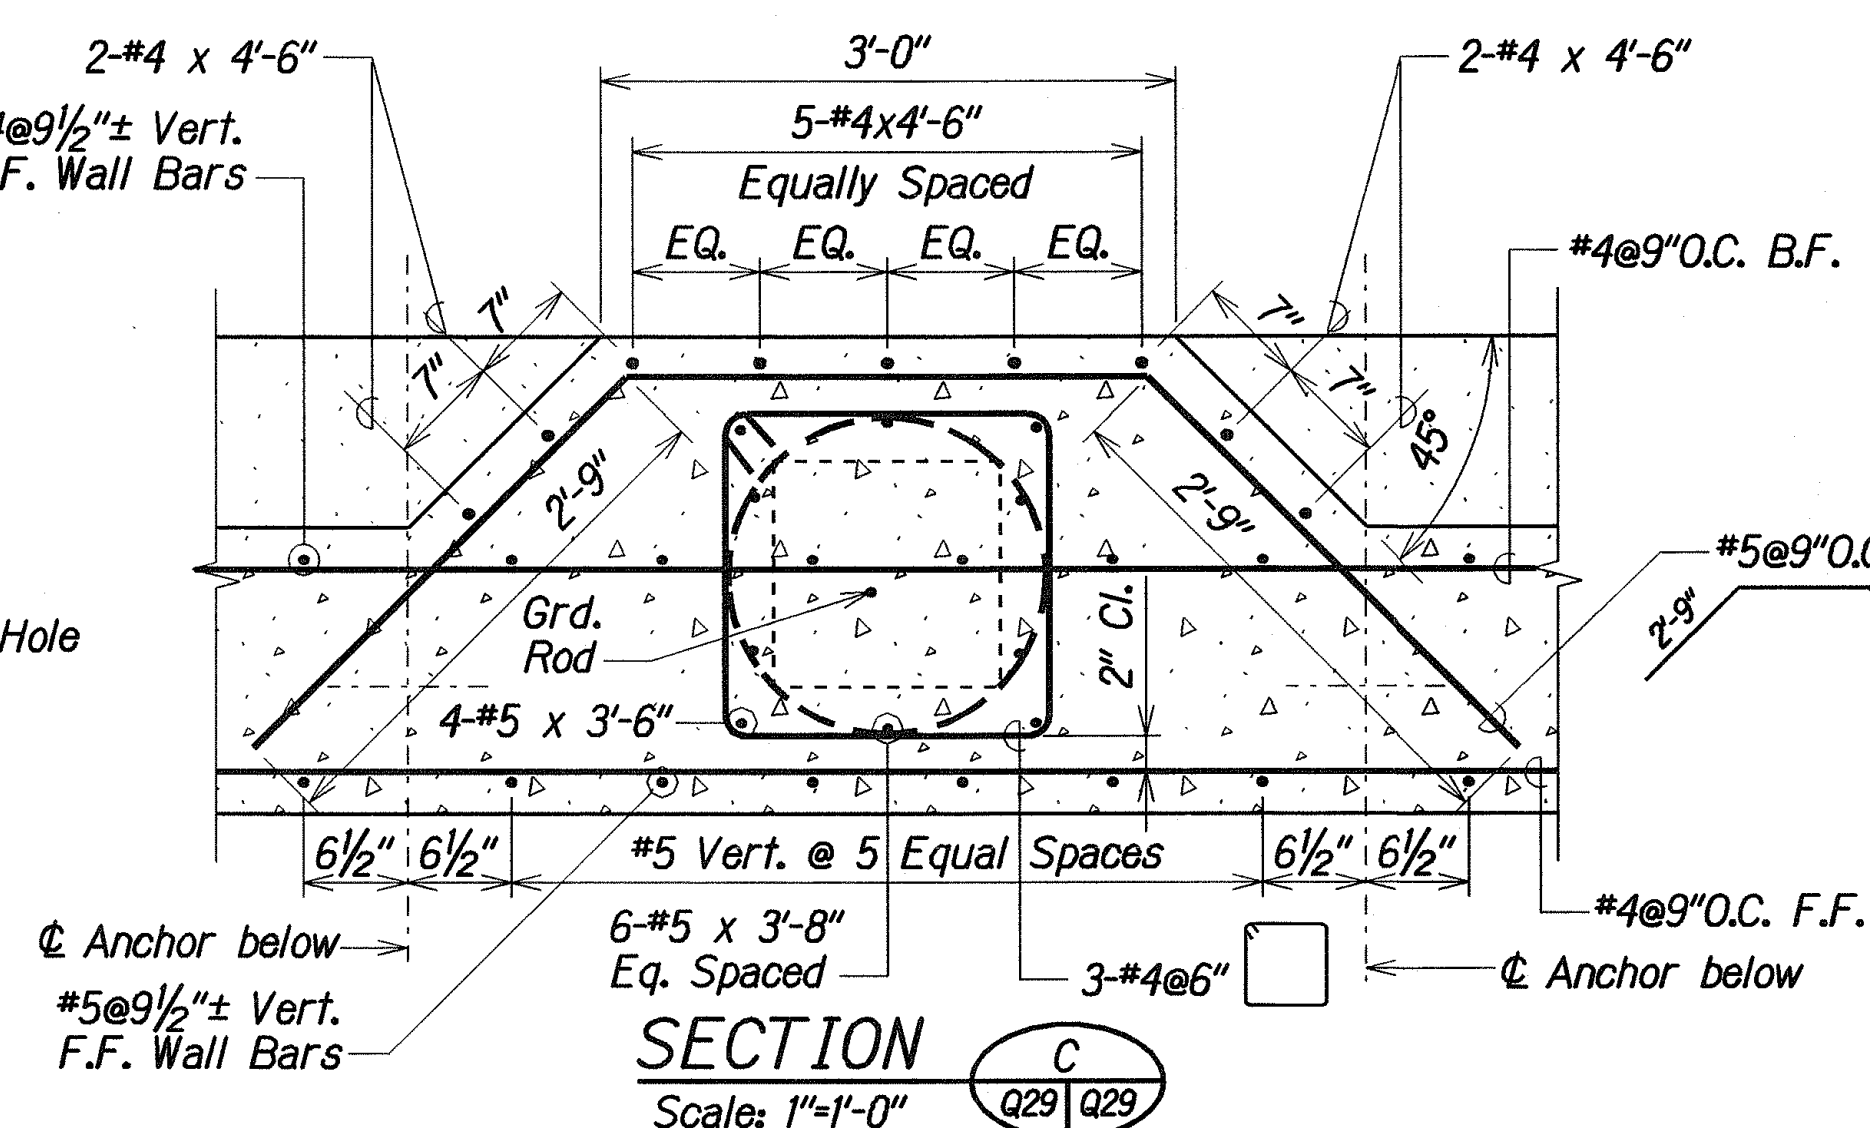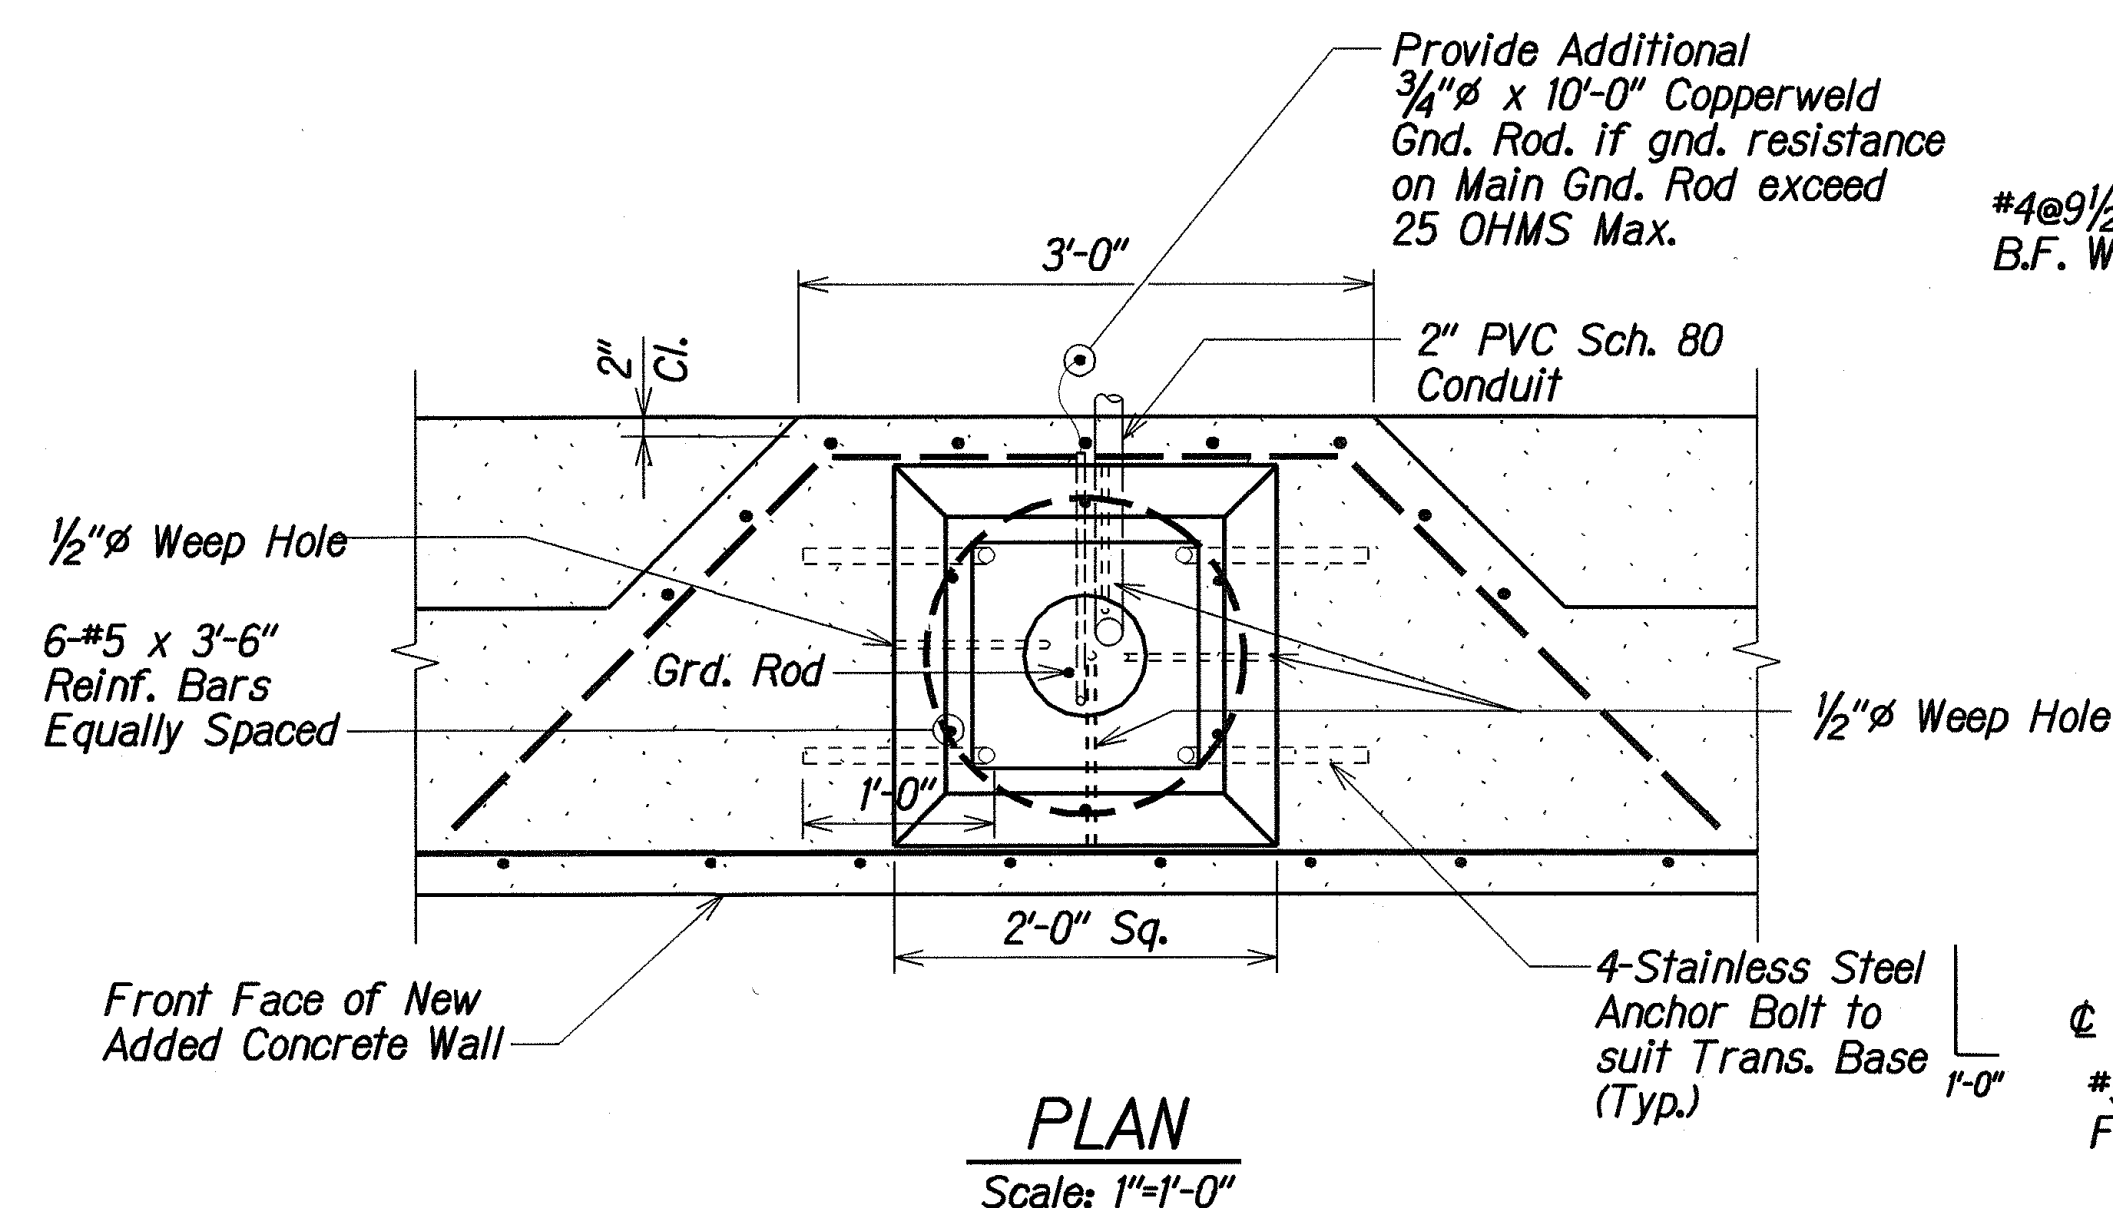

NOTES:

1. *Design of Light Standard & Foundation Shall Conform to Latest AASHTO "Standard Specifications for Structural Supports for Highway Signs, Luminaires and Traffic Signals", subsequent interims, and latest HDOT Memorandum with subject title "Design Criteria for Bridges and Structures".*
2. *See B-01 for Additional Notes.*

LIGHT STANDARD INSTALLATION ON WALL
W/ TRANSFORMER BASE
Scale: 1/4"=1'-0"

LIGHT STANDARD DETAILS
@ WALL "K" STA. 8+50

STATE OF HAWAII
DEPARTMENT OF TRANSPORTATION
HIGHWAYS DIVISION



RETAINING WALL EXTENSION
LIGHT STANDARD DETAILS at STA. 8+50
INTERSTATE ROUTE H-1
EXTENSION AND REPAIR OF
SCHOOL STREET ON-RAMP RETAINING WALL
Project No. H1T-01-08

Scale: As Noted

Date: Feb. 2009

SHEET No. 029 OF 34 SHEETS

FED. ROAD DIST. NO.	STATE	PROJ. NO.	FISCAL YEAR	SHEET NO.	TOTAL SHEETS
HAWAII	HAW.	H11-01-08	2009	ADD. 38	73

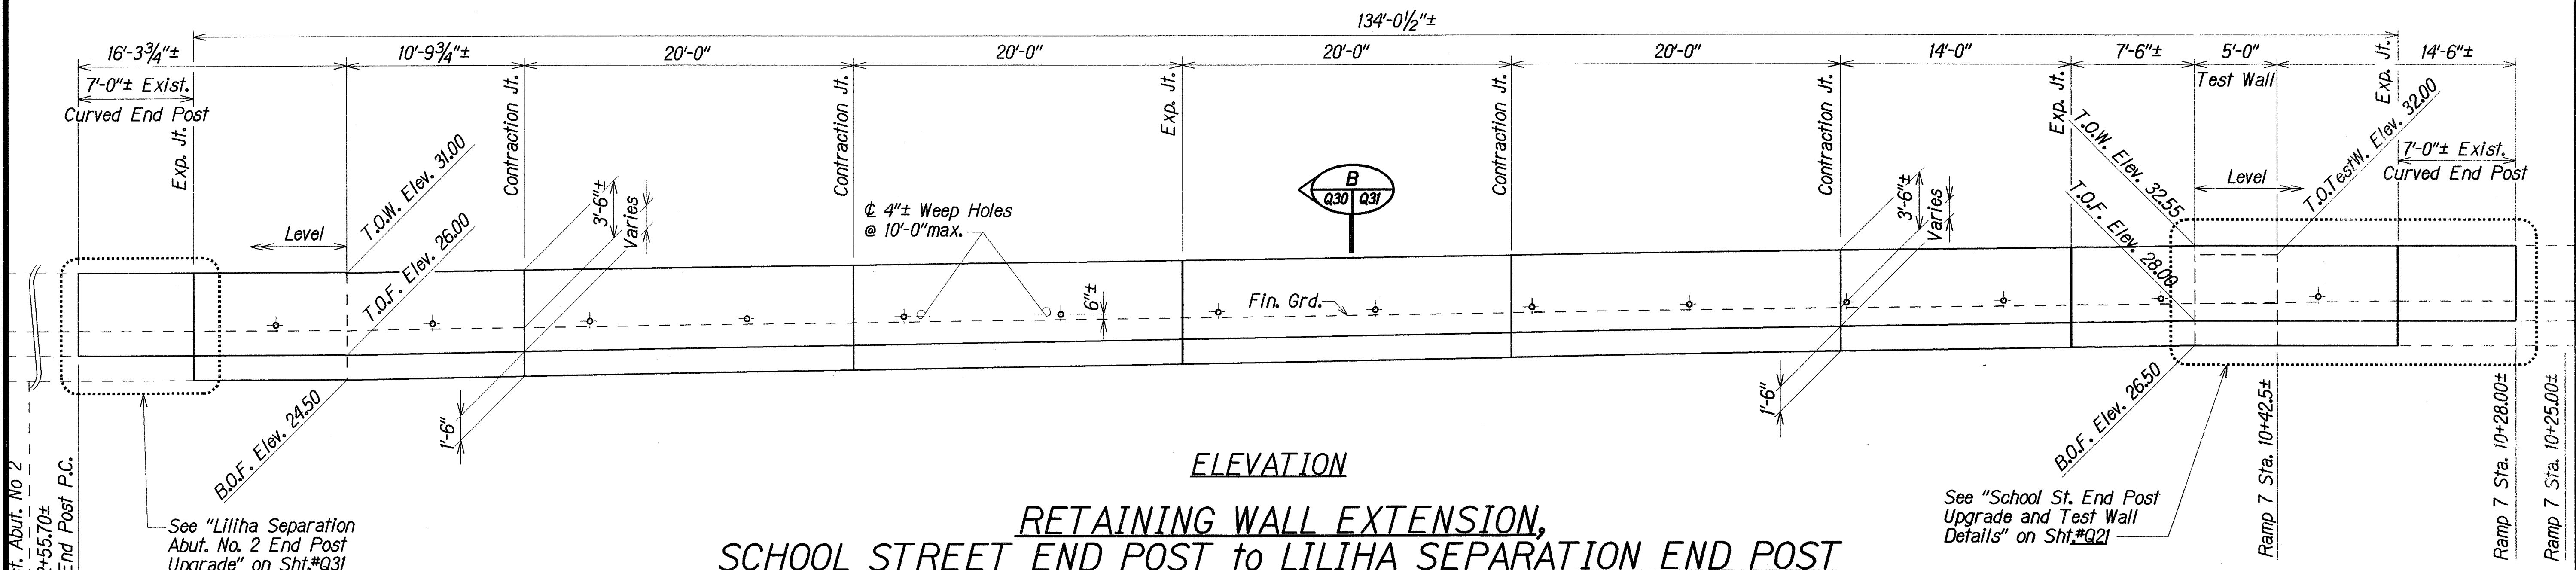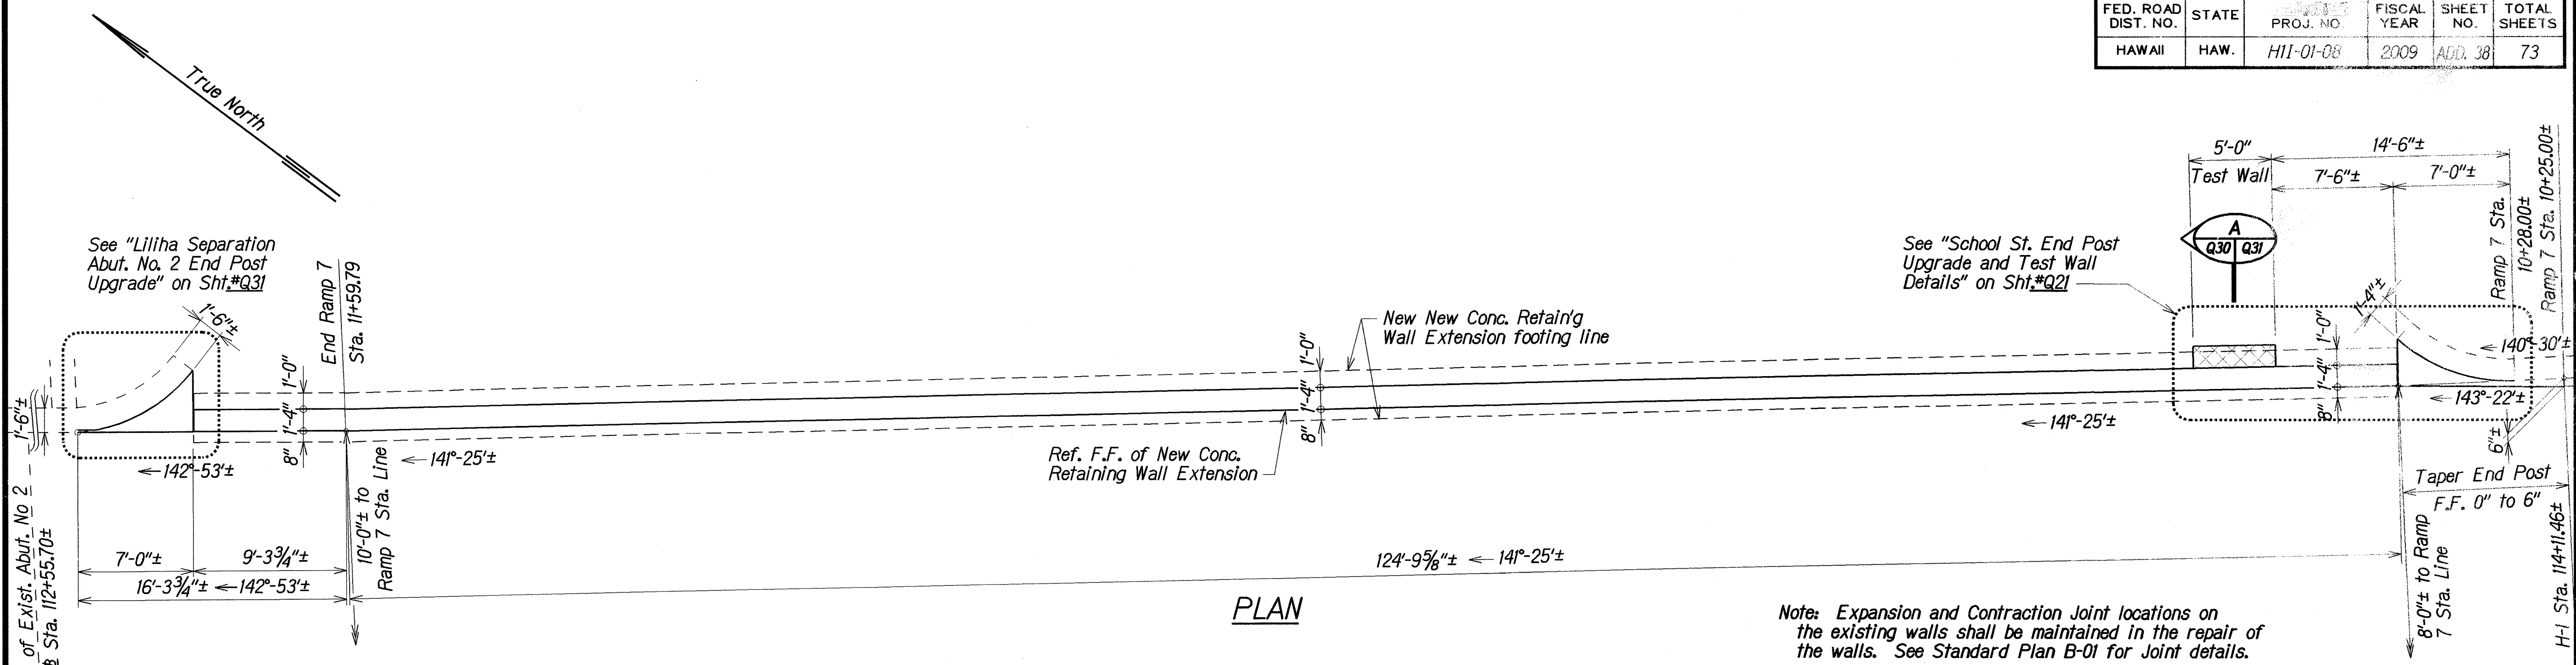

**RETAINING WALL EXTENSION,
SCHOOL STREET END POST to LILIHA SEPARATION END POST**

Scale: 1" = 5'-0"

SURVEY PLOTTED BY	DATE
DRAWN BY	XXX/1991
TRACED BY	XXX/1991
NOTE BOOK	XXX/1991
QUANTITIES BY	XXX/1991
CHECKED BY	XXX/1991
N.	XXXXXXXXXX


STATE OF HAWAII
DEPARTMENT OF TRANSPORTATION
HIGHWAYS DIVISION

RETAINING WALL EXTENSION
SCHOOL STREET END POST to LILIHA SEPARATION END POST PLAN and ELEVATION
INTERSTATE ROUTE H-1 EXTENSION and REPAIR of SCHOOL STREET ON RAMP RETAINING WALL
Project No. H11-01-08


Scale: As Noted
Date: Feb. 2009

3/31/09	Revised Face of Exist. Abut. No. 2 Station Number
DATE	REVISION

FED. ROAD DIST. NO.	STATE	PROJECT NO.	FISCAL YEAR	SHEET NO.	TOTAL SHEETS
HAWAII	HAW.	H11-01-08M	2009	ADD. 39	73

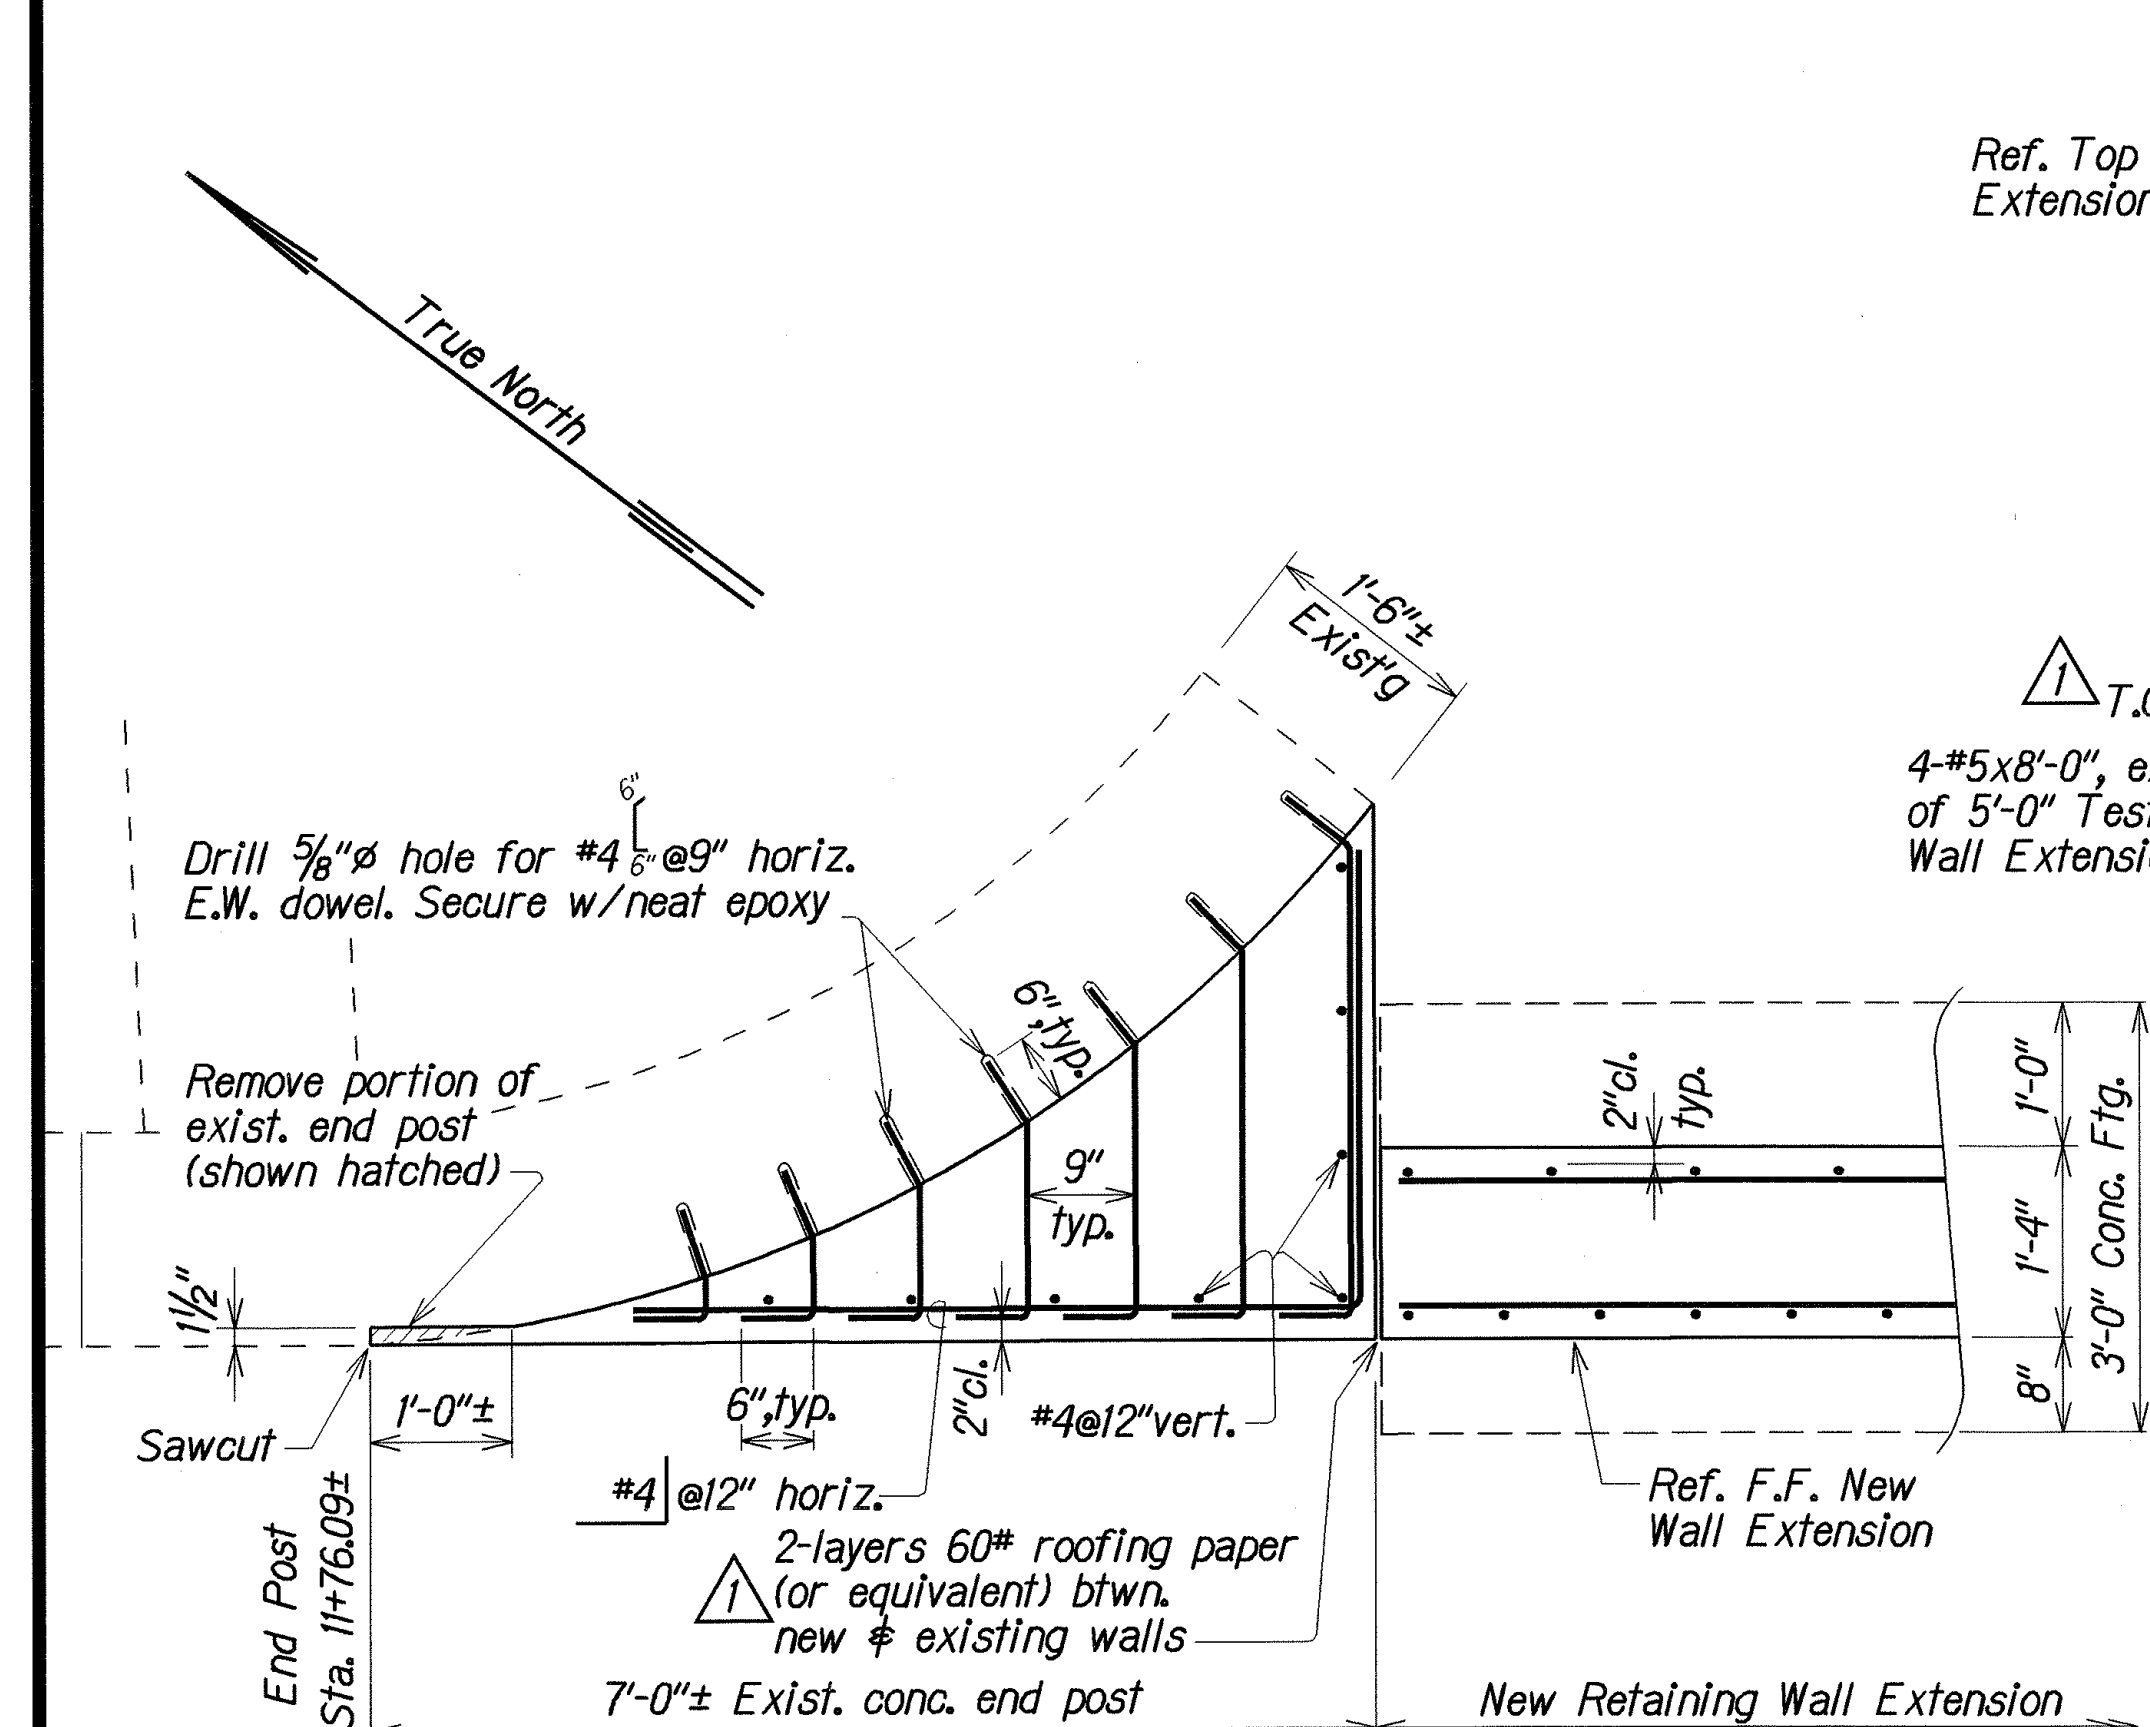


PLAN

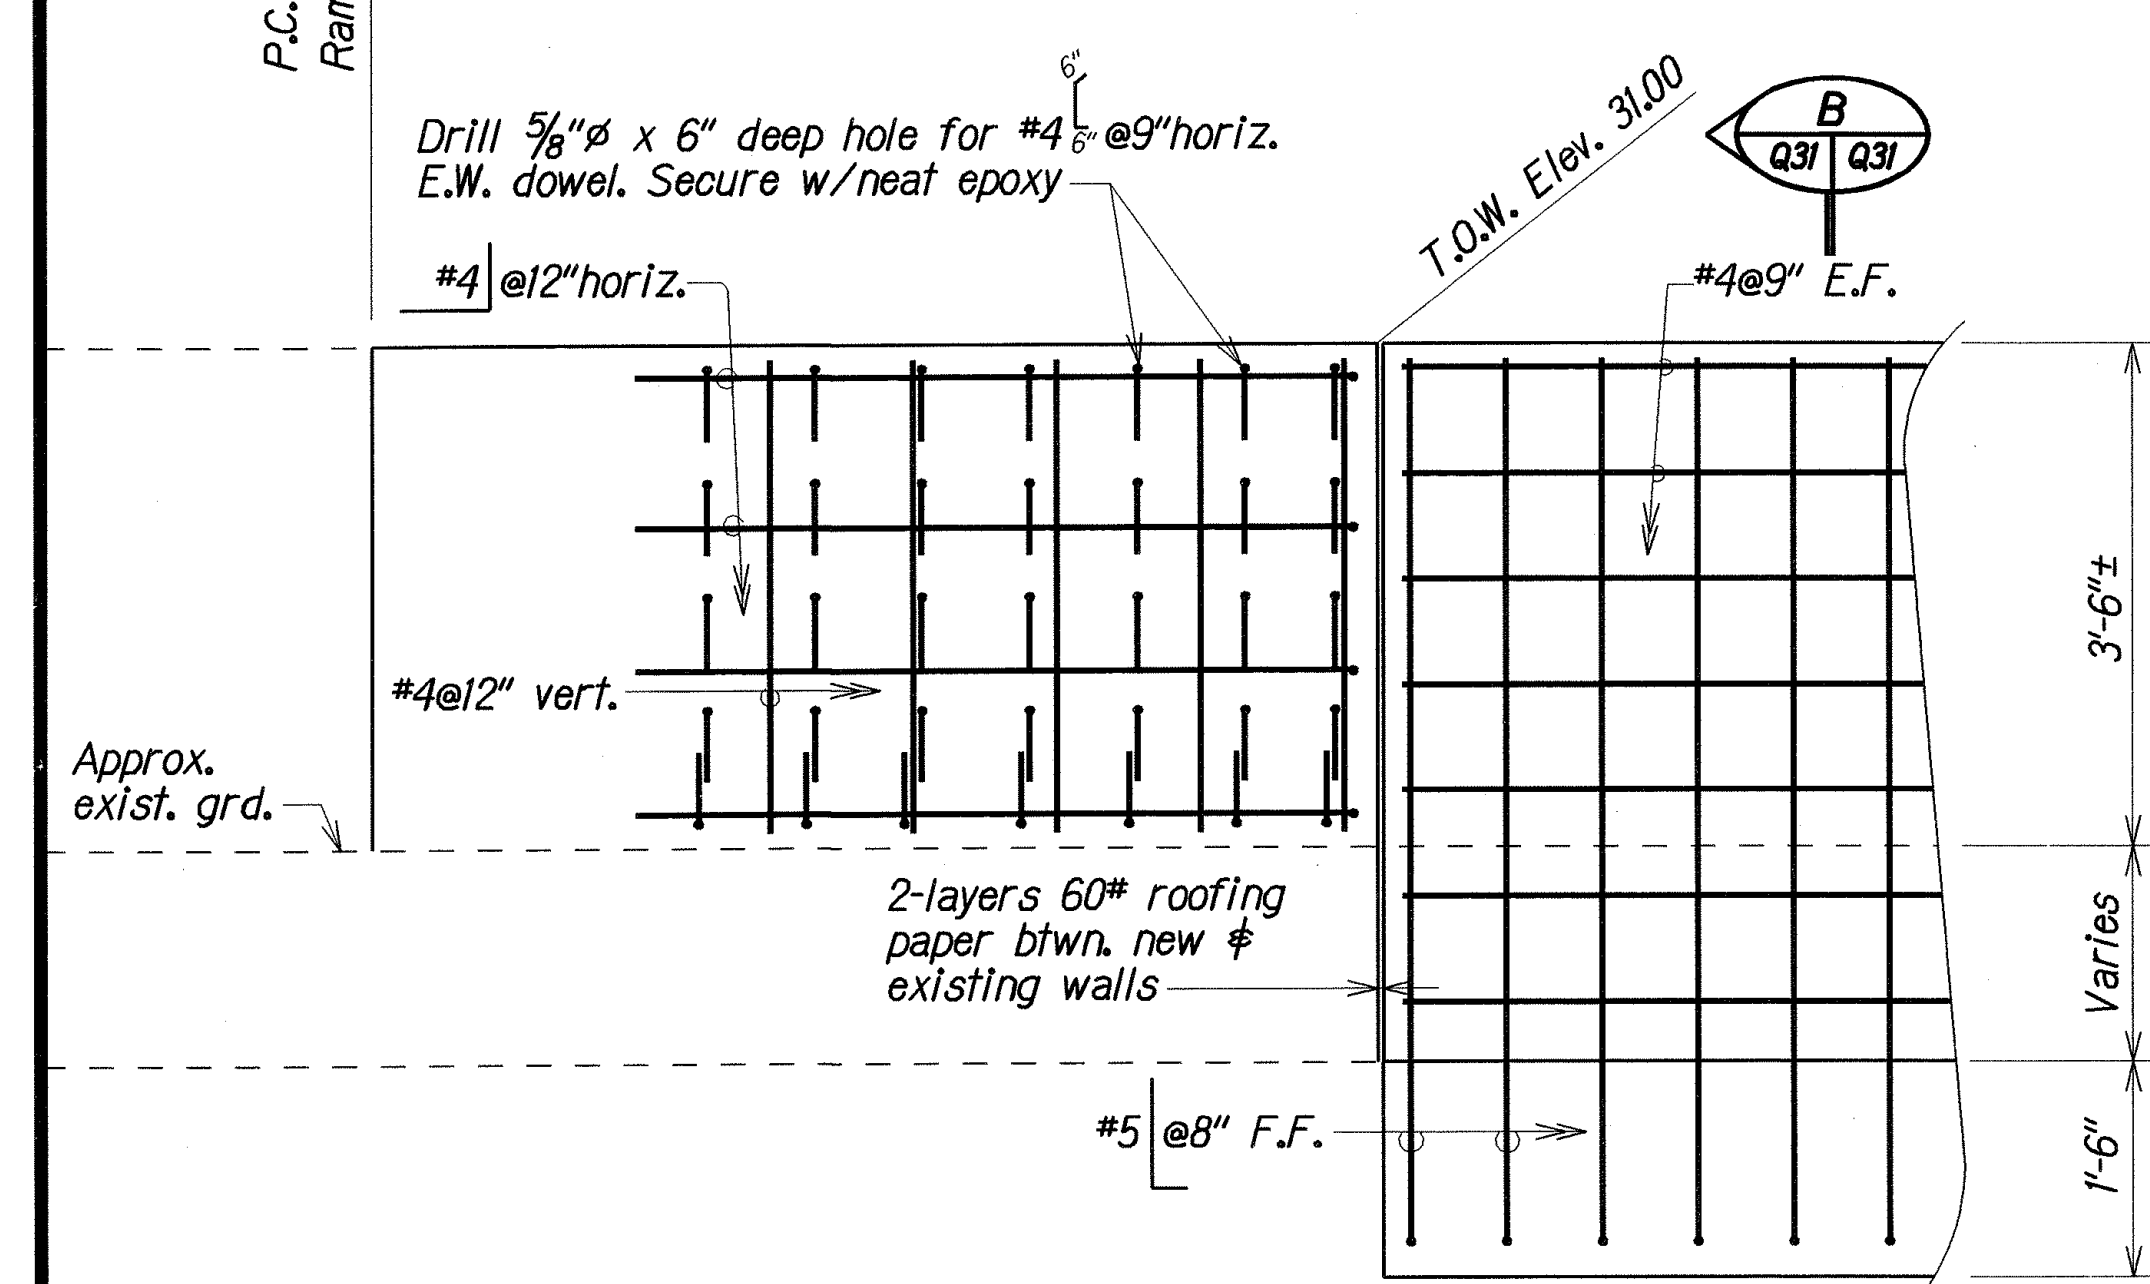

ELEVATION
Scale: 3/4" = 1'-0"

LILIHA SEPARATION ABUT NO. 2
END POST UPGRADE


NEW RETAINING WALL
EXTENSION DETAILS

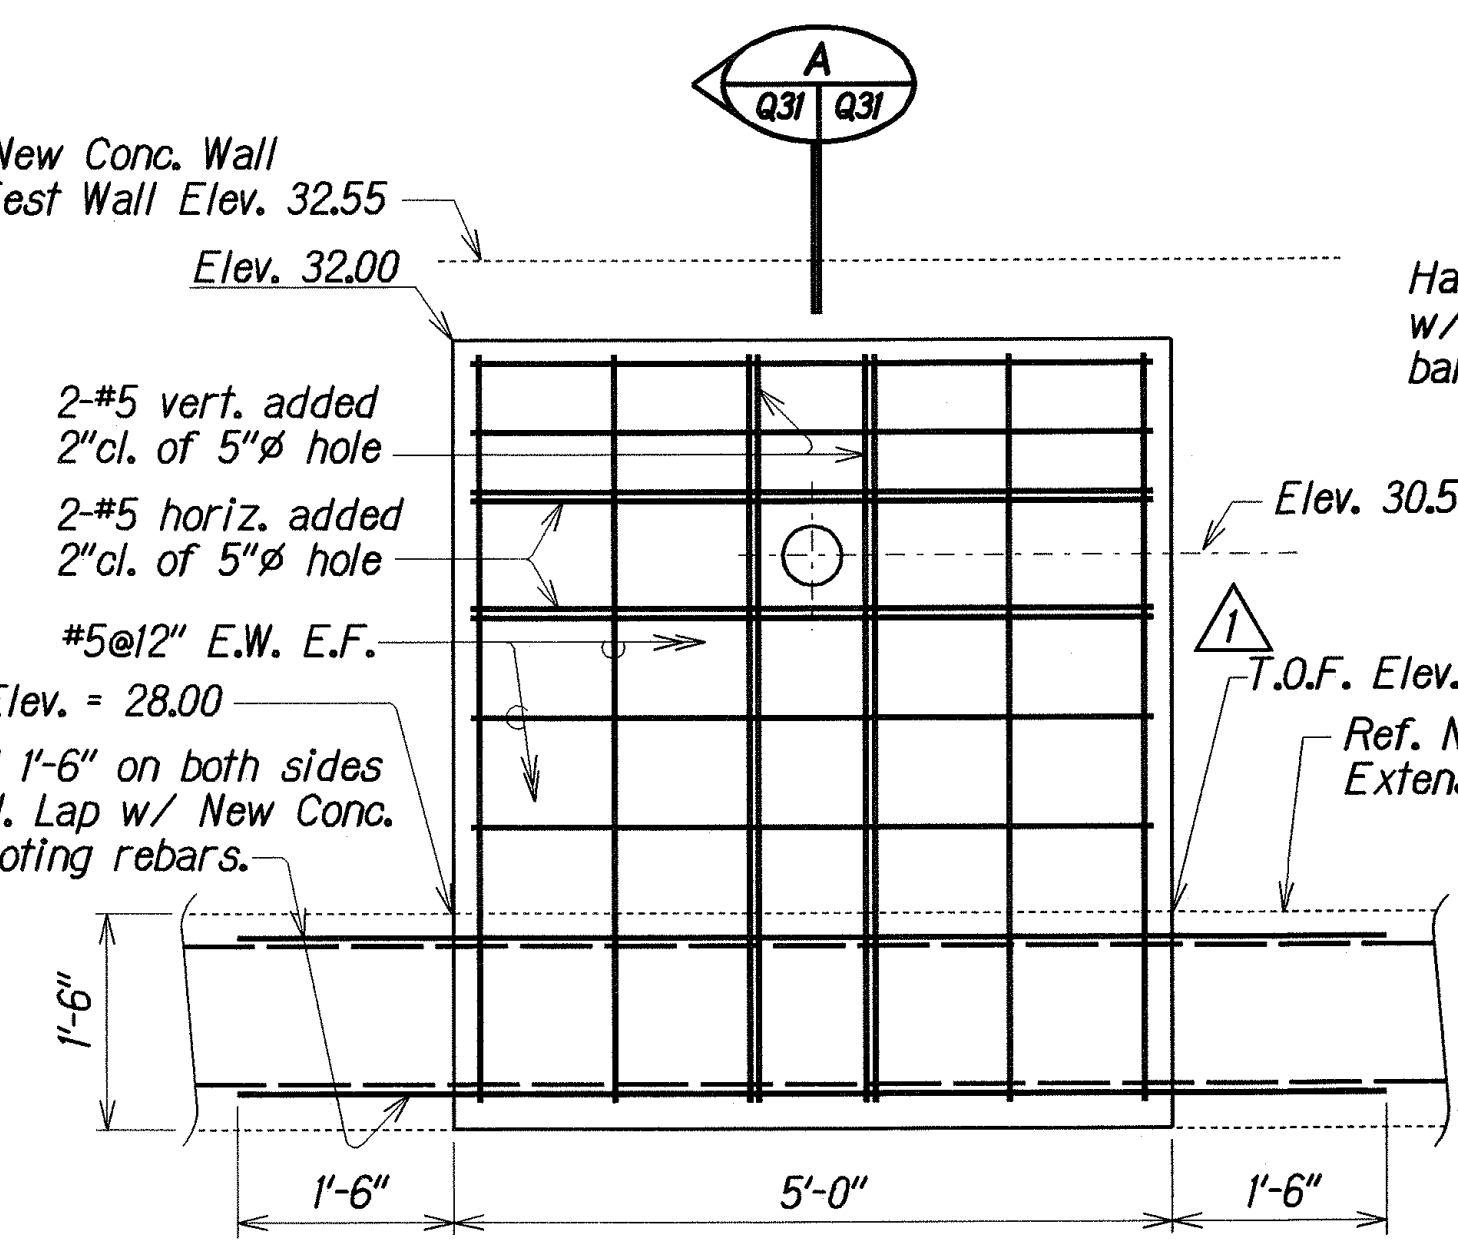

ELEVATION


TEST WALL TYPICAL DETAILS

Scale: 3/4" = 1'-0"

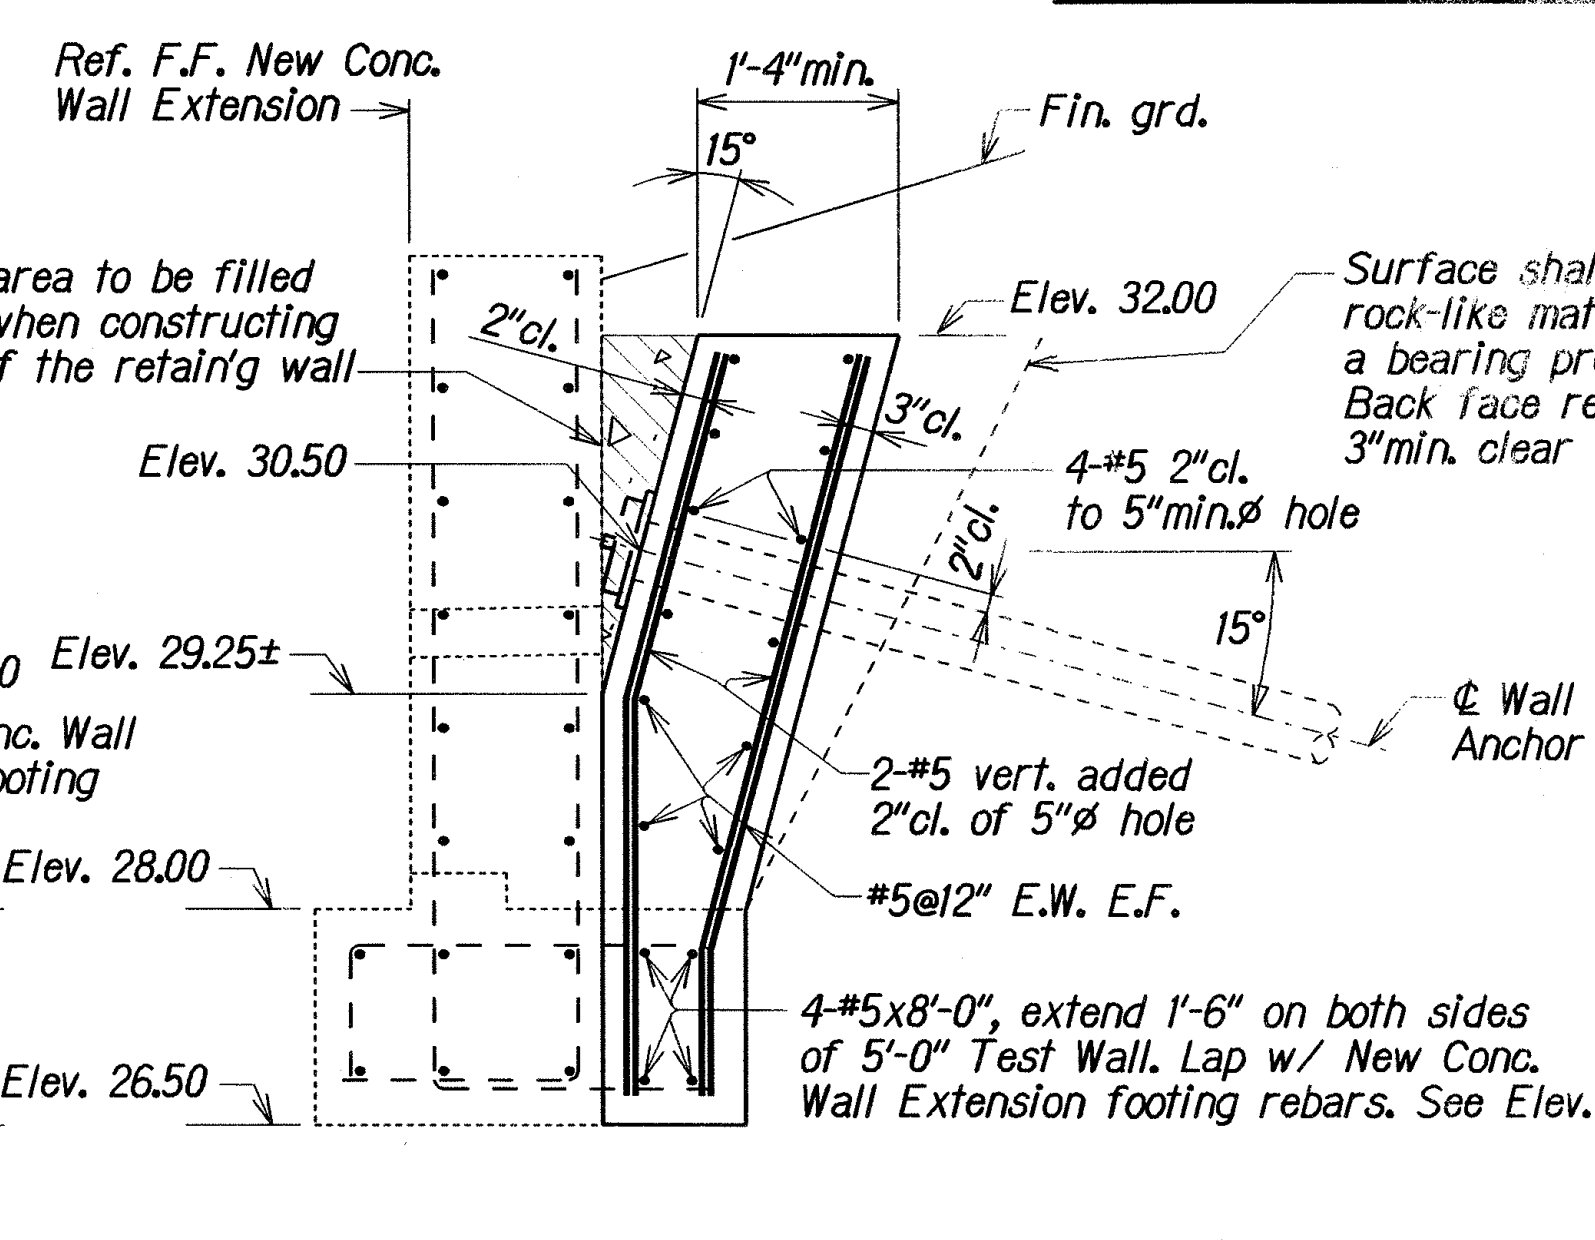


TYPICAL SECTION

Scale: 3/4" = 1'-0"

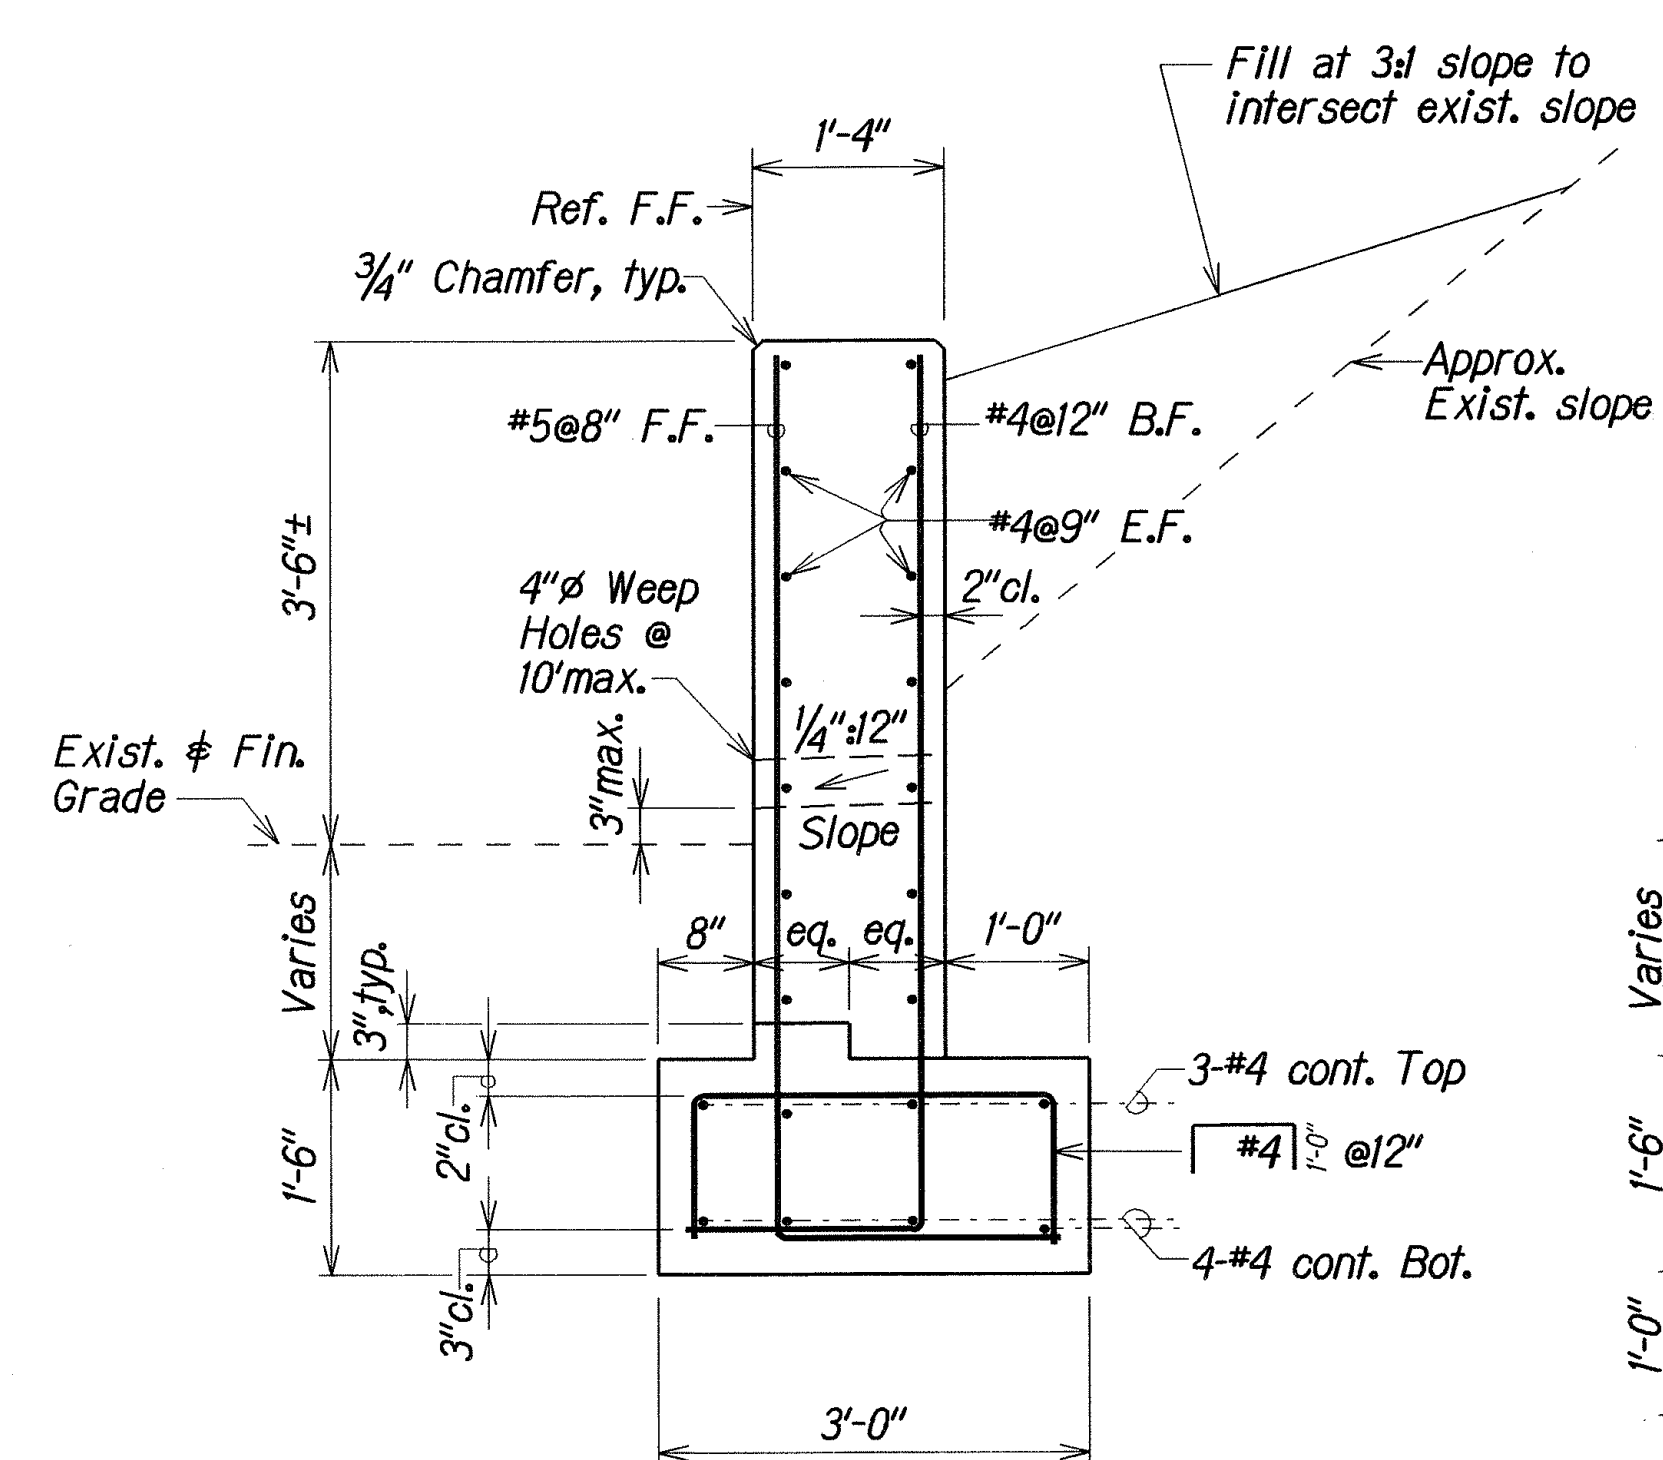

NEW RETAINING WALL EXTENSION
TYPICAL SECTION

Scale: 3/4" = 1'-0"














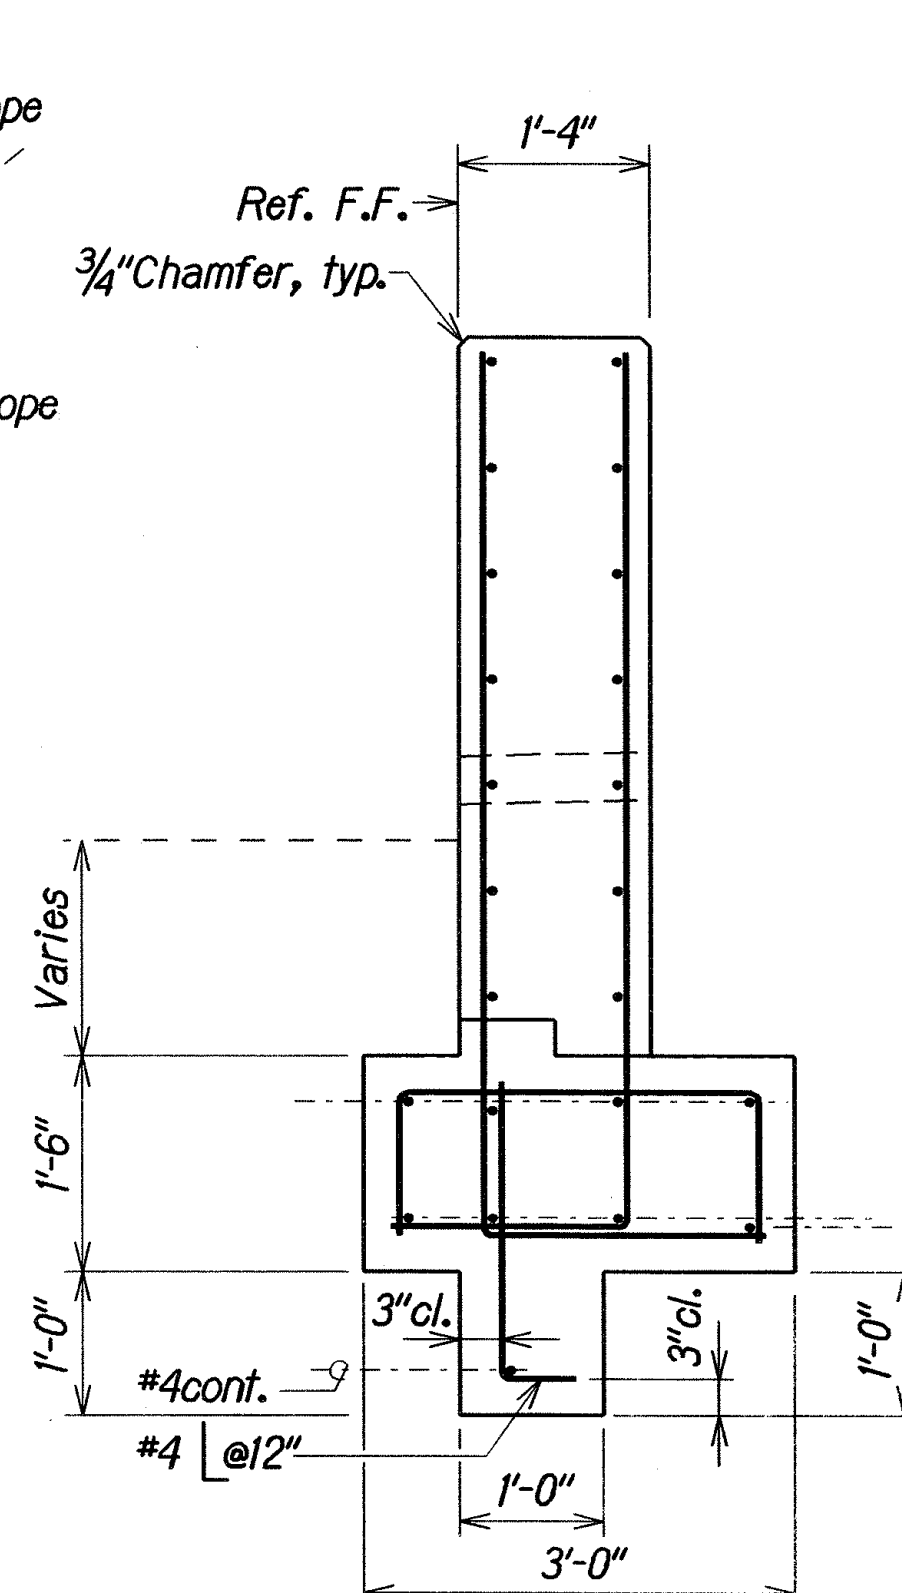


OPTIONAL FOOTING KEY

(To be used only if foundation material is not rock)
Scale: 3/4" = 1'-0"

DATE	DESCRIPTION
3/31/09	Added & Modified Callouts for Details and Added Section Sheet Numbers.
STATE OF HAWAII DEPARTMENT OF TRANSPORTATION HIGHWAYS DIVISION RETAINING WALL EXTENSION LILIHA SEPARATION ABUTMENT NO. 2 UPGRADE and TYPICAL RETAINING WALL EXTENSION DETAILS INTERSTATE ROUTE H-11 EXTENSION and REPAIR of SCHOOL STREET ON RAMP RETAINING WALL Project No. H11-01-08 Scale: As Noted Date: Feb. 2009	
SHEET No. Q31 OF 34 SHEETS	

UNIFIED SOIL CLASSIFICATION SYSTEM (USCS)

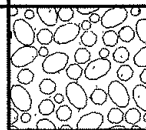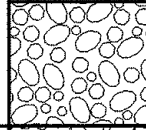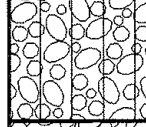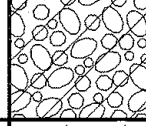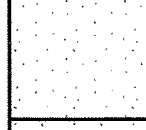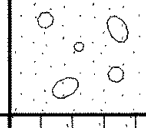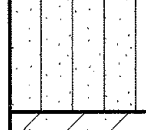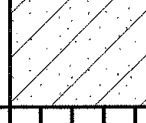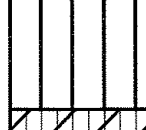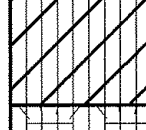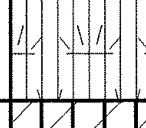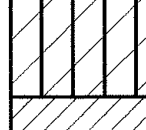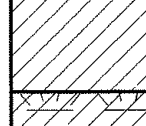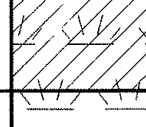MAJOR DIVISIONS			USCS	TYPICAL DESCRIPTIONS
COURSE GRAINED SOILS MORE THAN 50% OF MATERIAL RETAINED ON NO. 200 SIEVE	GRAVELS MORE THAN 50% OF COURSE FRACTION RETAINED ON NO. 4 SIEVE	CLEAN GRAVELS LESS THAN 5% FINES	 GW	WELL-GRADED GRAVELS, GRAVEL-SAND MIXTURES, LITTLE OR NO FINES
		GRAVELS WITH FINES MORE THAN 12% FINES	 GP	POORLY-GRADED GRAVELS, GRAVEL-SAND MIXTURES, LITTLE OR NO FINES
			 GM	SILTY GRAVELS, GRAVEL-SAND-SILT MIXTURES
			 GC	CLAYEY GRAVELS, GRAVEL-SAND-CLAY MIXTURES
	SANDS 50% OR MORE OF COURSE FRACTION PASSING THROUGH NO. 4 SIEVE	CLEAN SANDS LESS THAN 5% FINES	 SW	WELL-GRADED SANDS, GRAVELLY SANDS, LITTLE OR NO FINES
		SANDS WITH FINES MORE THAN 12% FINES	 SP	POORLY-GRADED SANDS, GRAVELLY SANDS, LITTLE OR NO FINES
			 SM	SILTY SANDS, SAND-SILT MIXTURES
			 SC	CLAYEY SANDS, SAND-CLAY MIXTURES
FINE-GRAINED SOILS 50% OR MORE OF MATERIAL PASSING THROUGH NO. 200 SIEVE	SILTS AND CLAYS LIQUID LIMIT LESS THAN 50		 ML	INORGANIC SILTS AND VERY FINE SANDS, ROCK FLOUR, SILTY OR CLAYEY FINE SANDS OR CLAYEY SILTS WITH SLIGHT PLASTICITY
			 CL	INORGANIC CLAYS OF LOW TO MEDIUM PLASTICITY, GRAVELLY CLAYS, SANDY CLAYS, SILTY CLAYS, LEAN CLAYS
			 OL	ORGANIC SILTS AND ORGANIC SILTY CLAYS OF LOW PLASTICITY
			SILTS AND CLAYS LIQUID LIMIT 50 OR MORE	 MH
	 CH	INORGANIC CLAYS OF HIGH PLASTICITY		
	 OH	ORGANIC CLAYS OF MEDIUM TO HIGH PLASTICITY, ORGANIC SILTS		
	HIGHLY ORGANIC SOILS			 PT

NOTE: DUAL SYMBOLS ARE USED TO INDICATED BORDERLINE SOIL CLASSIFICATIONS


LEGEND

	(2-INCH) Q.D. STANDARD PENETRATION TEST	LL	LIQUID LIMIT (NP=NON-PLASTIC)
	(3-INCH) Q.D. MODIFIED CALIFORNIA SAMPLE	PI	PLASTICITY INDEX (NP=NON-PLASTIC)
	SHELBY TUBE SAMPLE	TV	TORVANE SHEAR (tsf)
	GRAB SAMPLE	PEN	POCKET PENETROMETER (tsf)
	CORE SAMPLE	UC	UNCONFINED COMPRESSION (psf)
	WATER LEVEL OBSERVED IN BORING	UU	UNCONSOLIDATED UNDRAINED TRIAXIAL COMPRESSION (ksf)


GEOTECHNICAL NOTES

- A geotechnical engineering report entitled "Geotechnical Engineering Exploration of Retaining Wall Distress at School Street On-Ramp, Interstate Route H-1 Highway, Honolulu, Oahu, Hawaii", dated March 7, 2008, has been prepared by Geolabs, Inc. A copy of the report is on file at the office of the Engineer for review by the Contractor.
- For boring locations, see Sheet 39.
- The information presented in the logs of borings depict the subsurface conditions encountered at that specified location and at the time of the field exploration only. Variations of subsol conditions from those depicted in the logs of borings may occur between and beyond the borings.
- The penetration resistance shown on the logs of borings indicate the number of blows required for the specific sampler type used. The blow counts may need to be factored to obtain the Standard Penetration Test (SPT) blow counts.
- The data given is for general information only. Bidders shall examine the site and the boring data and draw their own conclusions therefrom as to the character of materials to be encountered. The Engineer will not assume responsibility for variation of subsol quality or conditions other than at the boring locations shown and at the time the borings were taken.

BORING 1

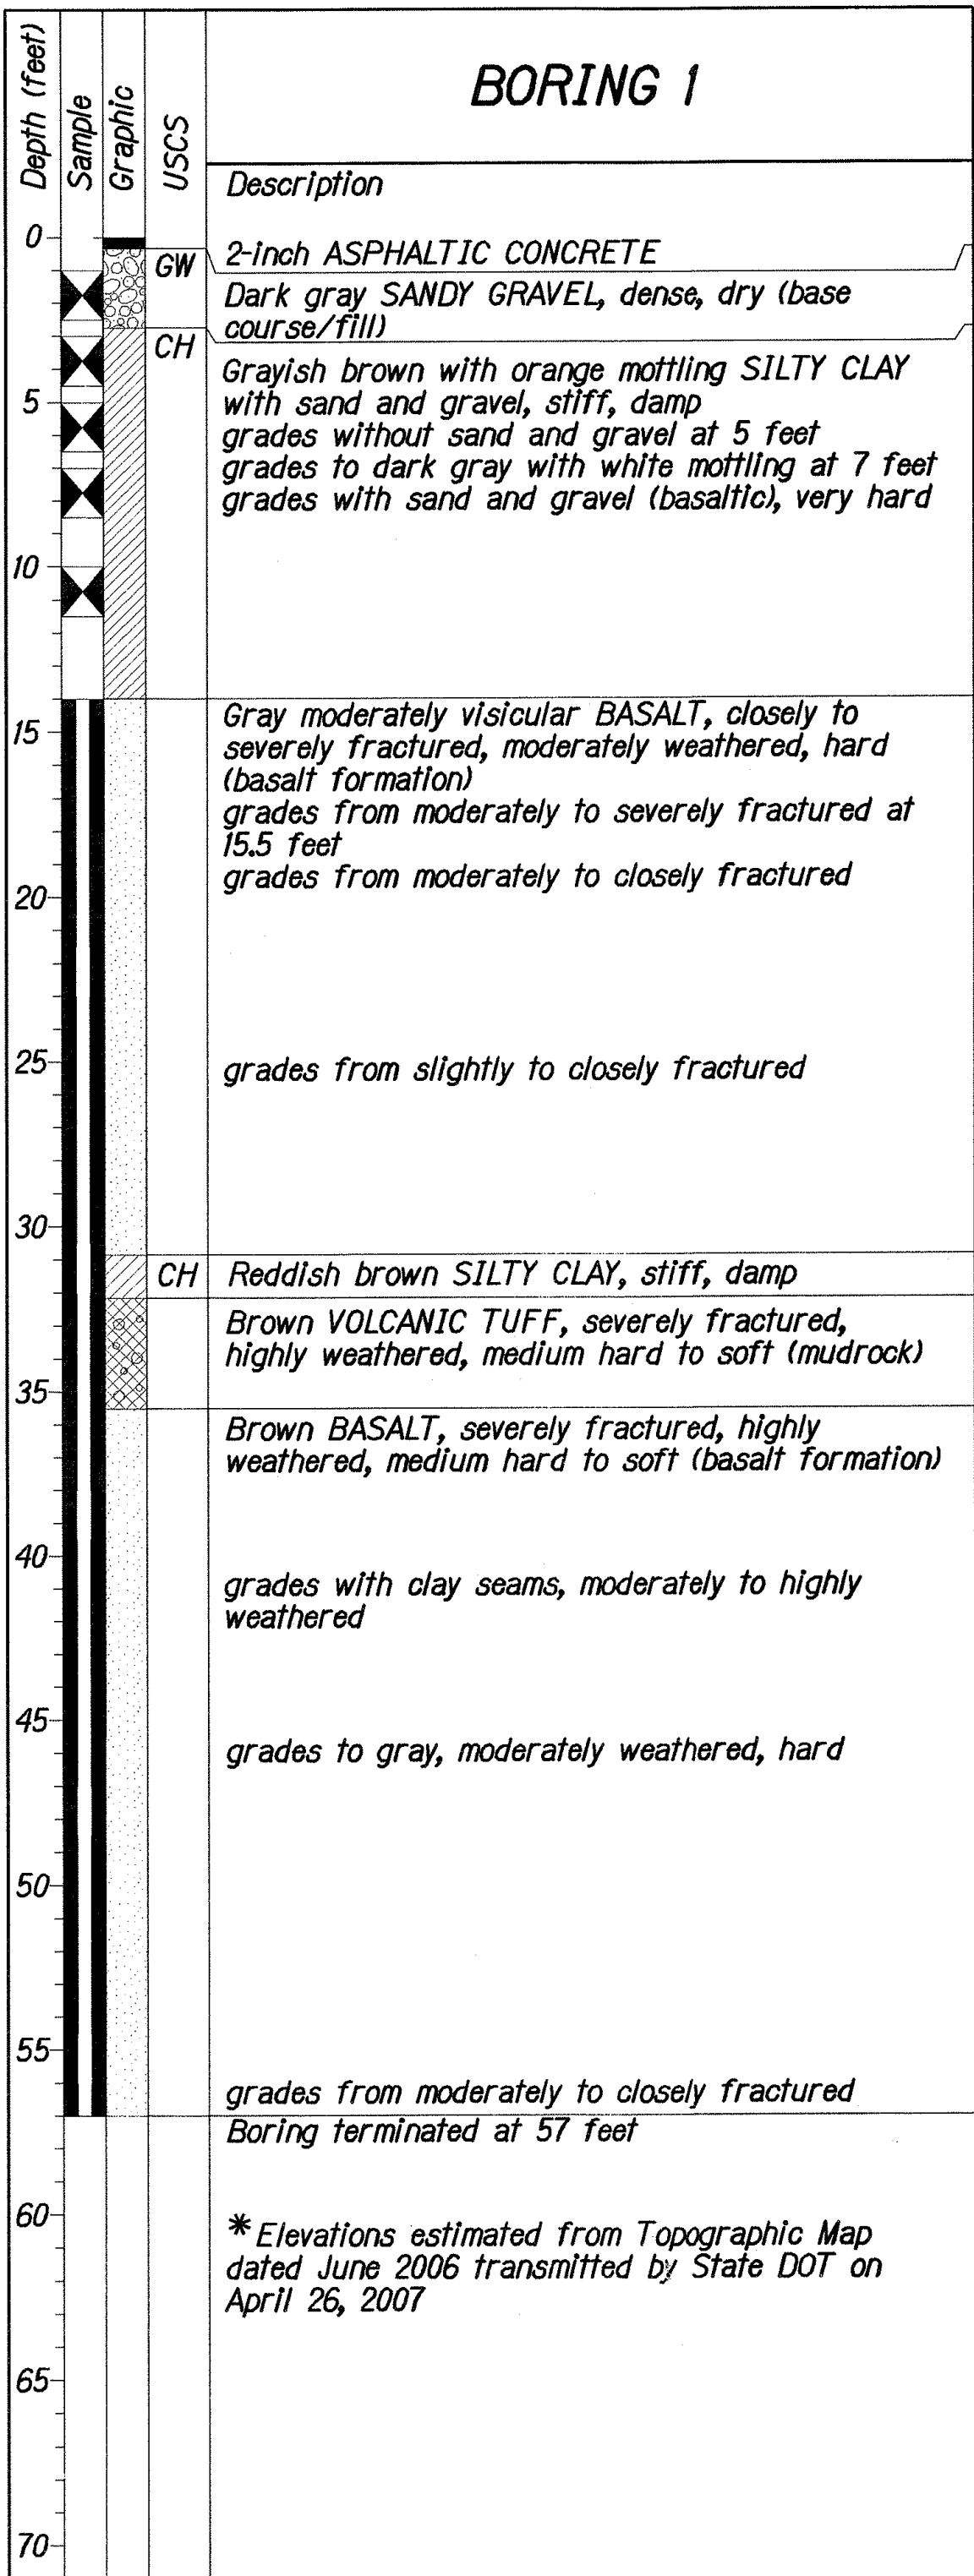

BORING 2

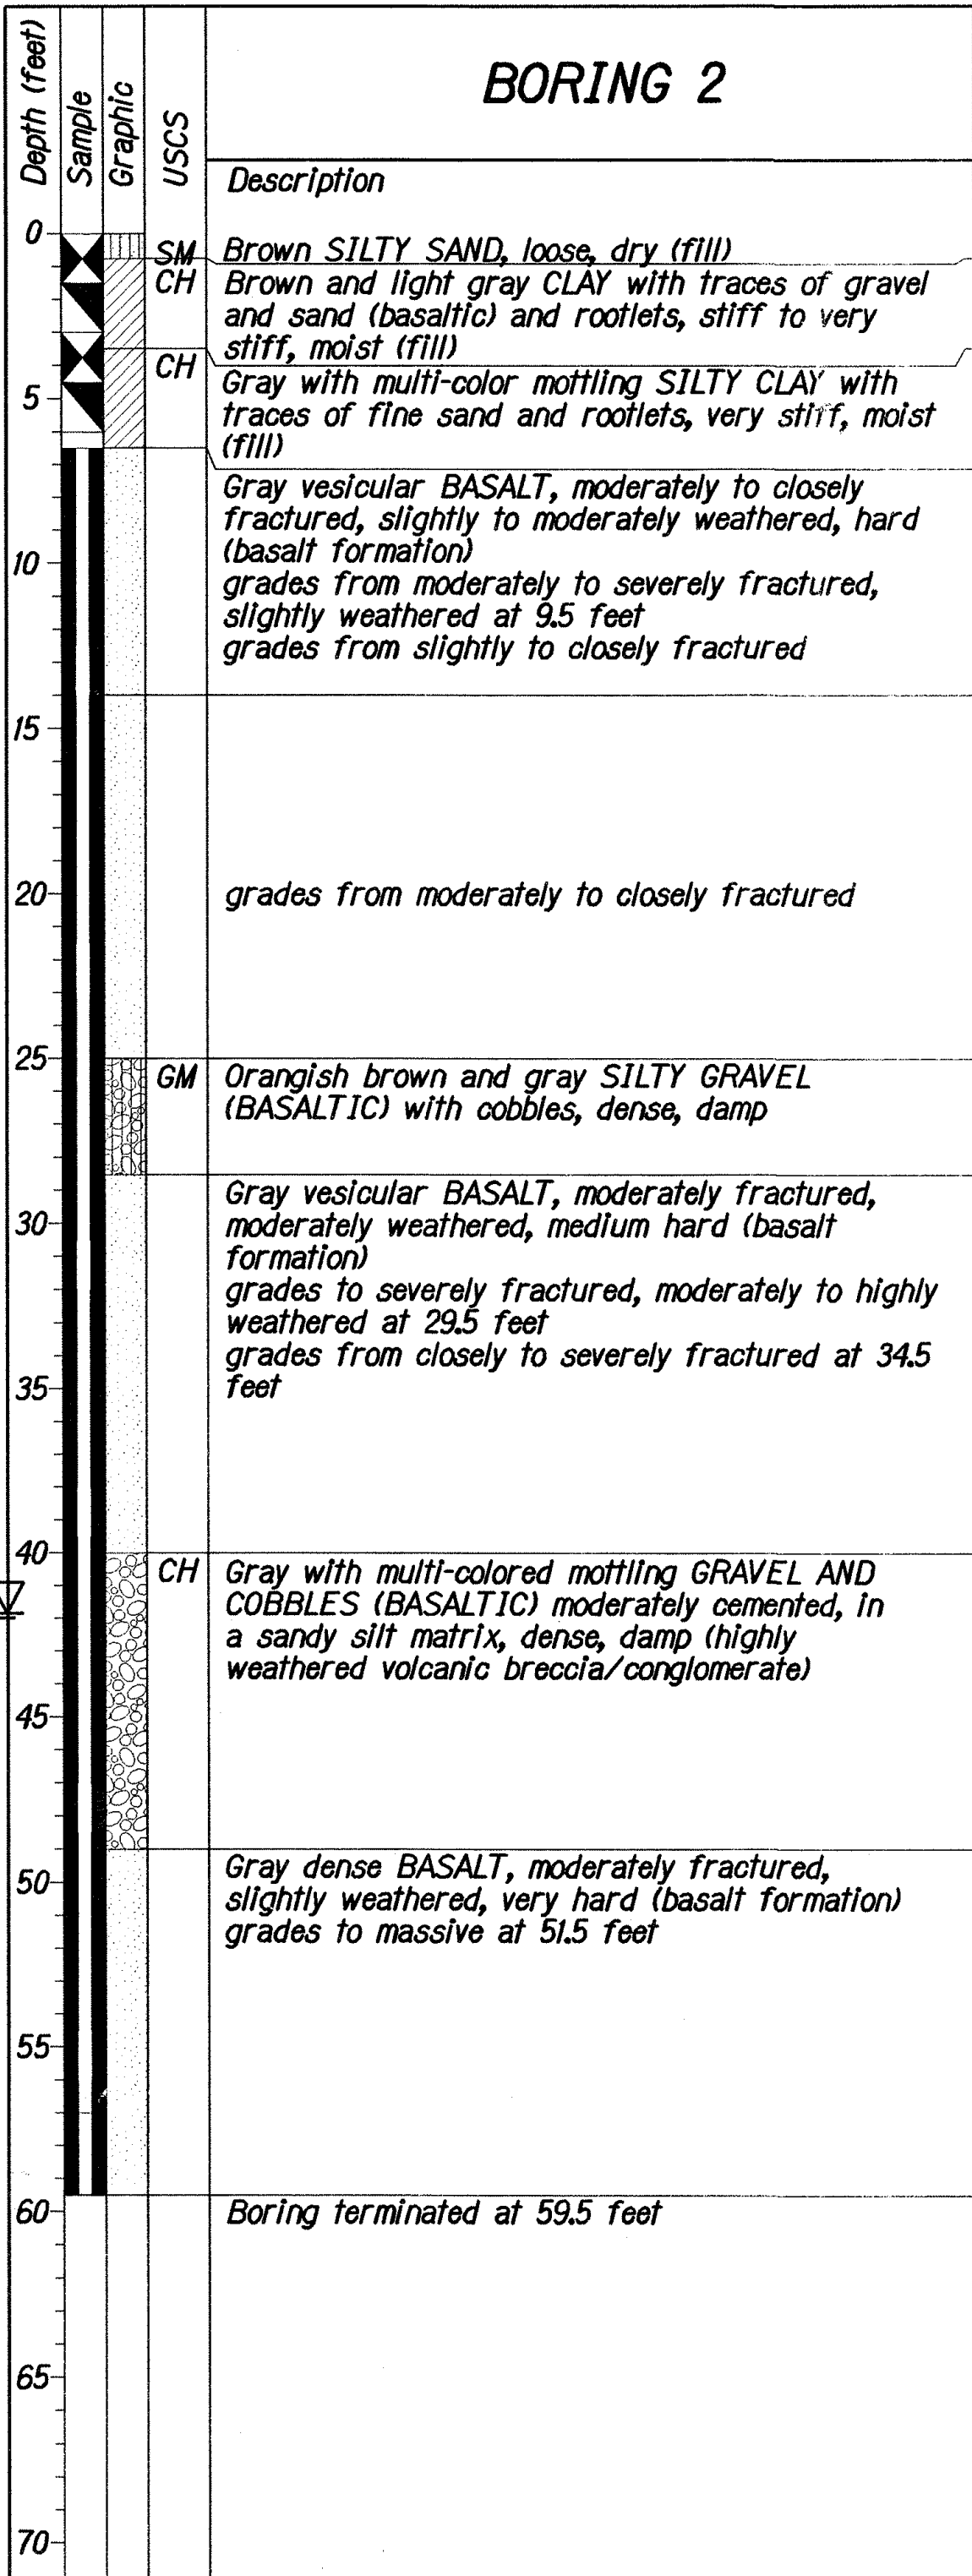

3/31/09 Revised Boring Location Sheet Number

DATE REVISION

STATE OF HAWAII
DEPARTMENT OF TRANSPORTATION
HIGHWAYS DIVISION

RETAINING WALL REPAIR and EXTENSION

UNIFIED SOIL CLASSIFICATION SYSTEM (USCS)

GEOTECHNICAL NOTES & BORING LOGS

INTERSTATE ROUTE H-1 EXTENSION and REPAIR





of SCHOOL STREET ON-RAMP RETAINING WALL

Project No. H11-01-08 Date: Feb. 2009

Scale: As Noted

SHEET No. Q32 OF 34 SHEETS

FED. ROAD DIST. NO.	STATE	FED. AID PROJ. NO.	FISCAL YEAR	SHEET NO.	TOTAL SHEETS
HAWAII	HAW.	H11-01-08	2009	41	73

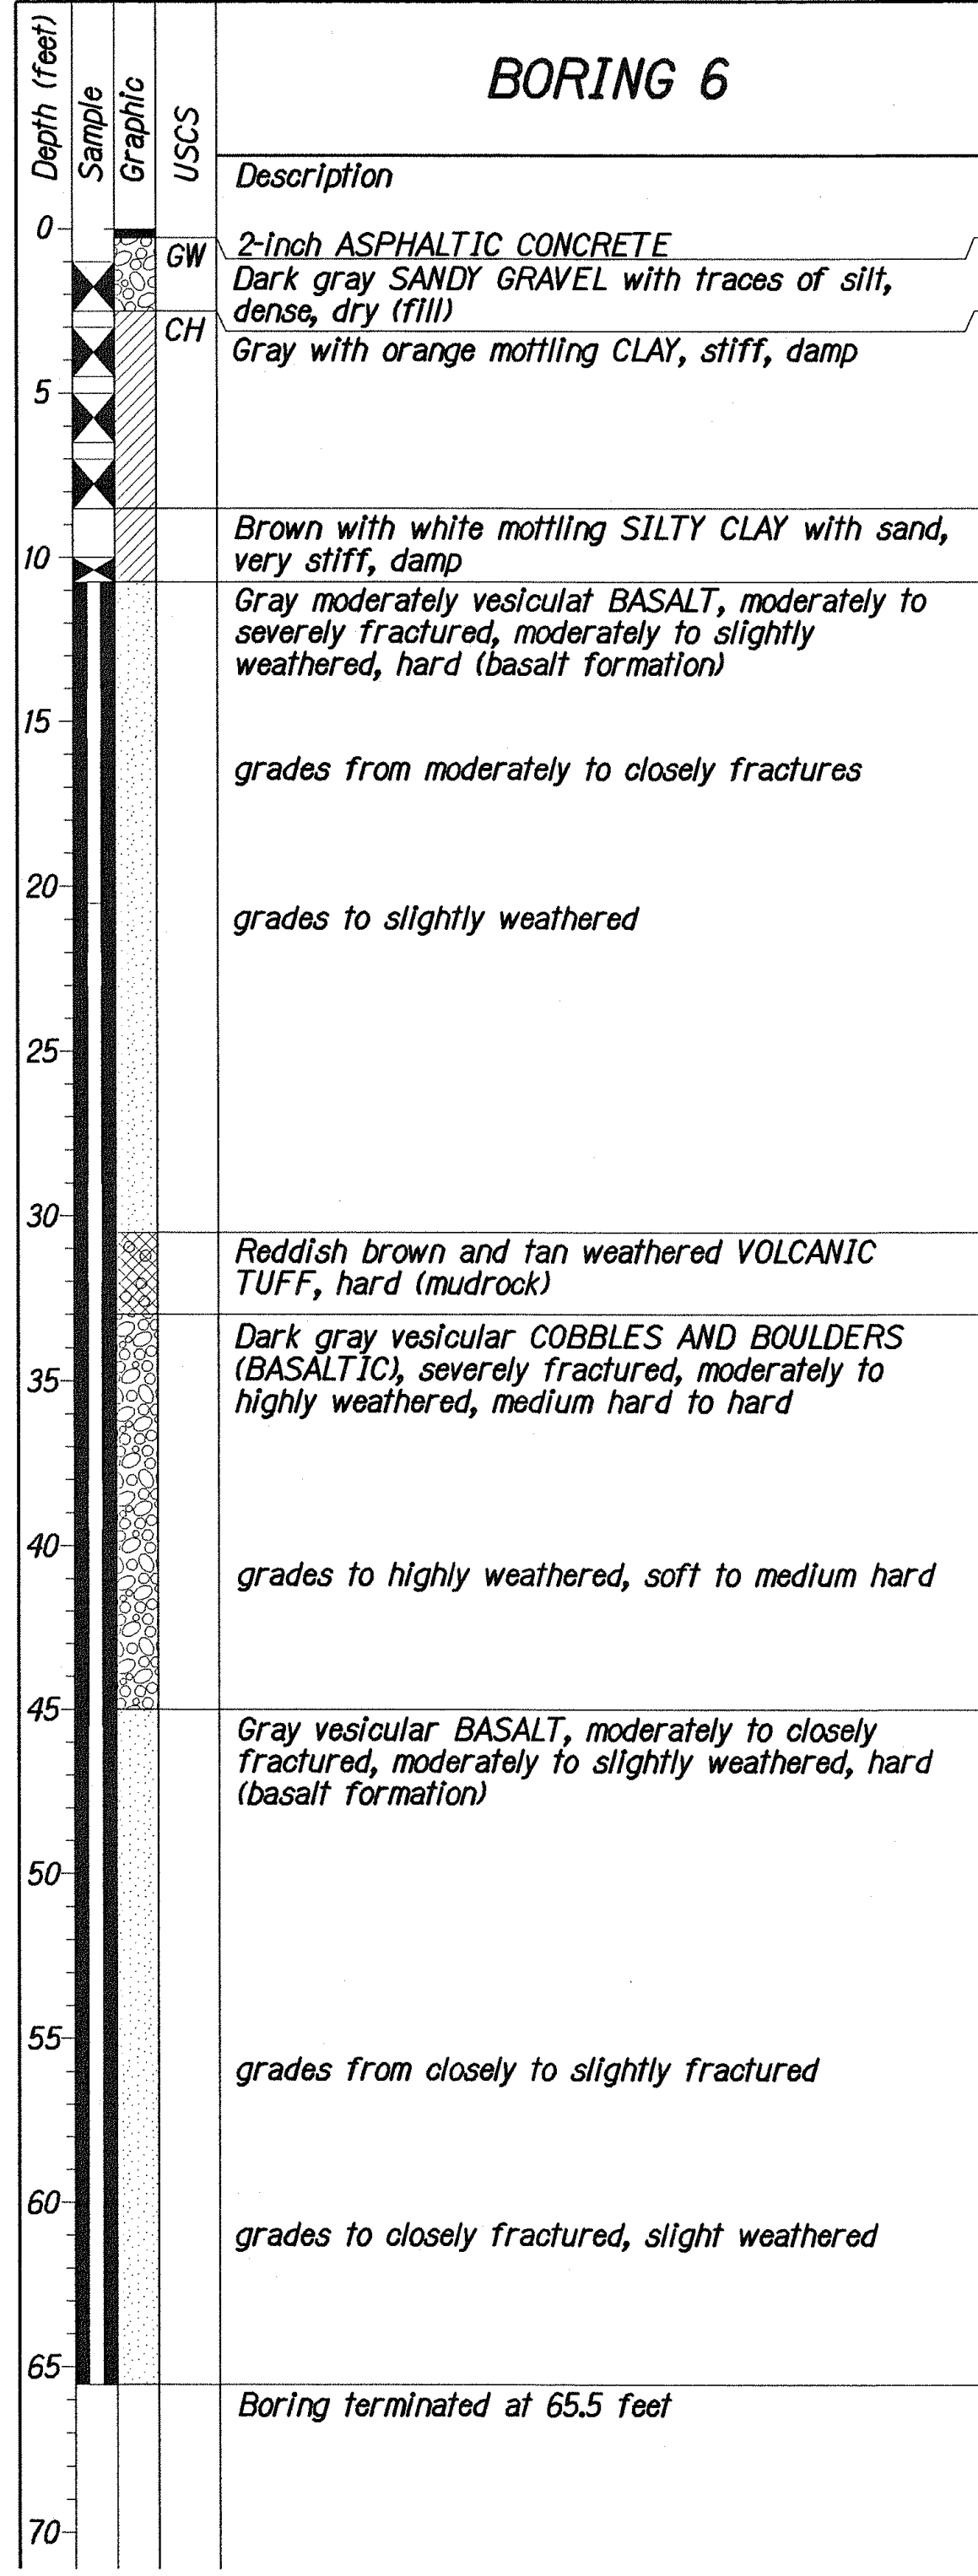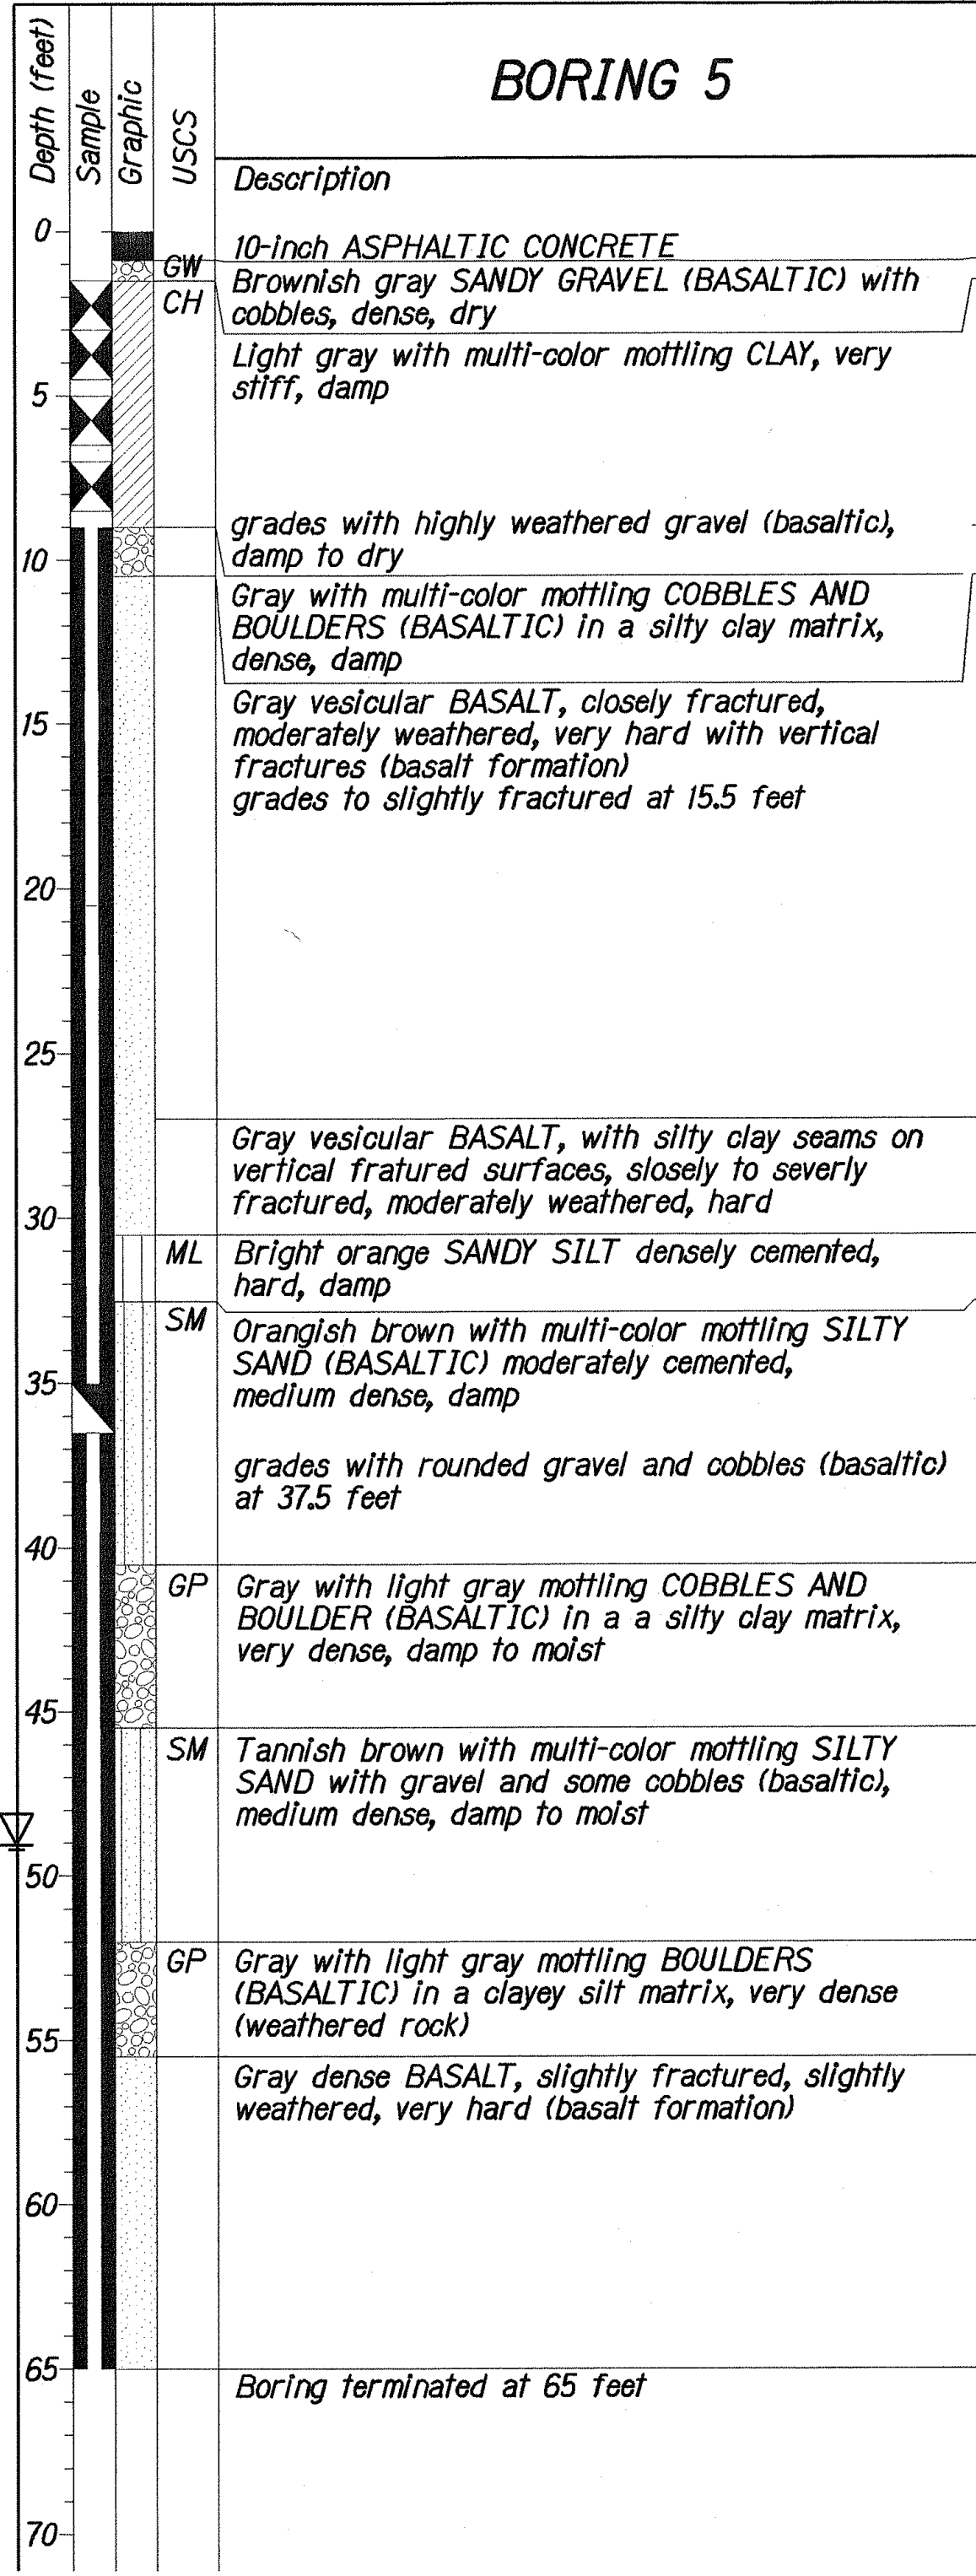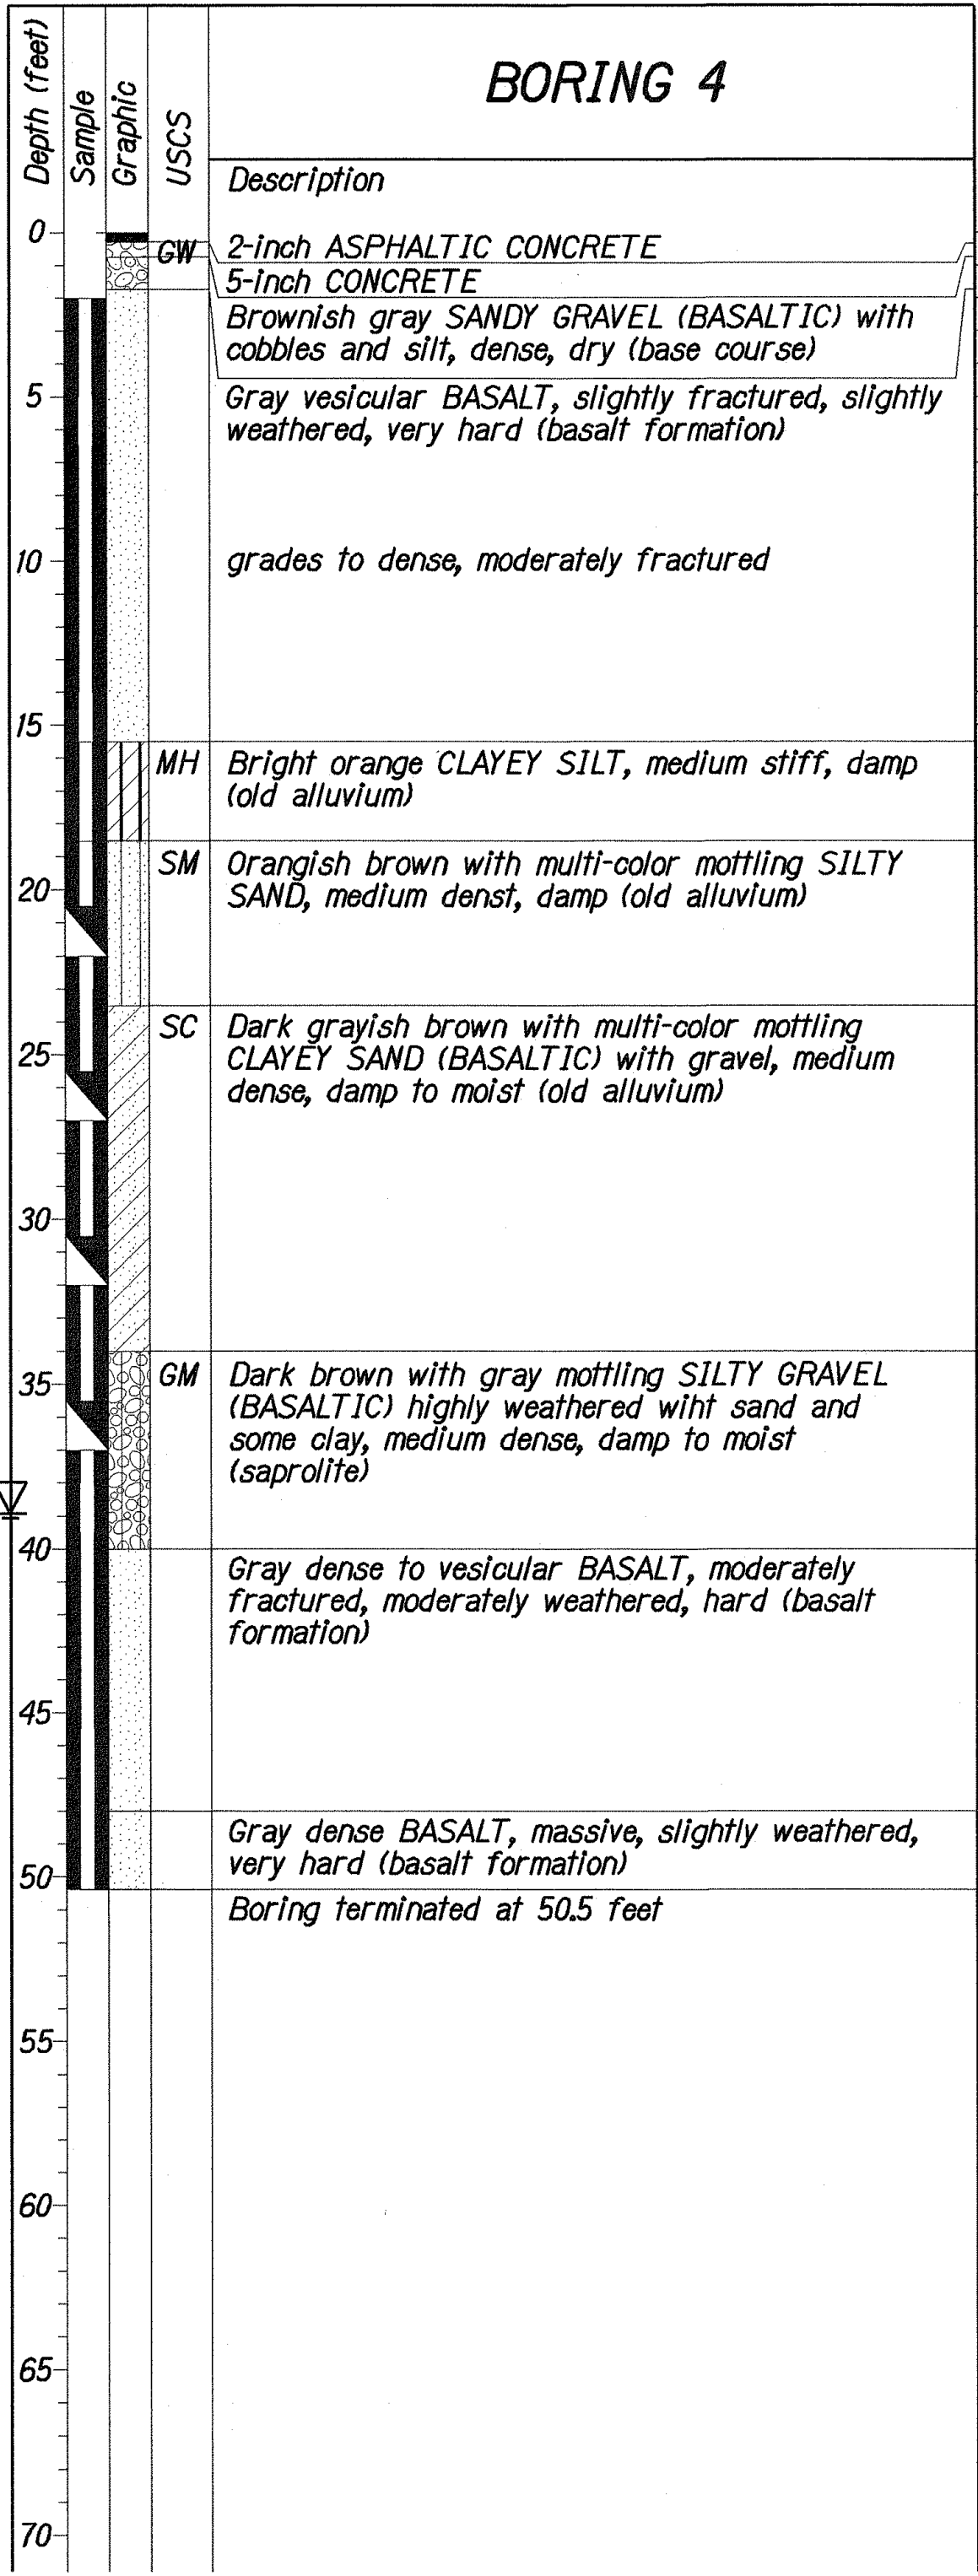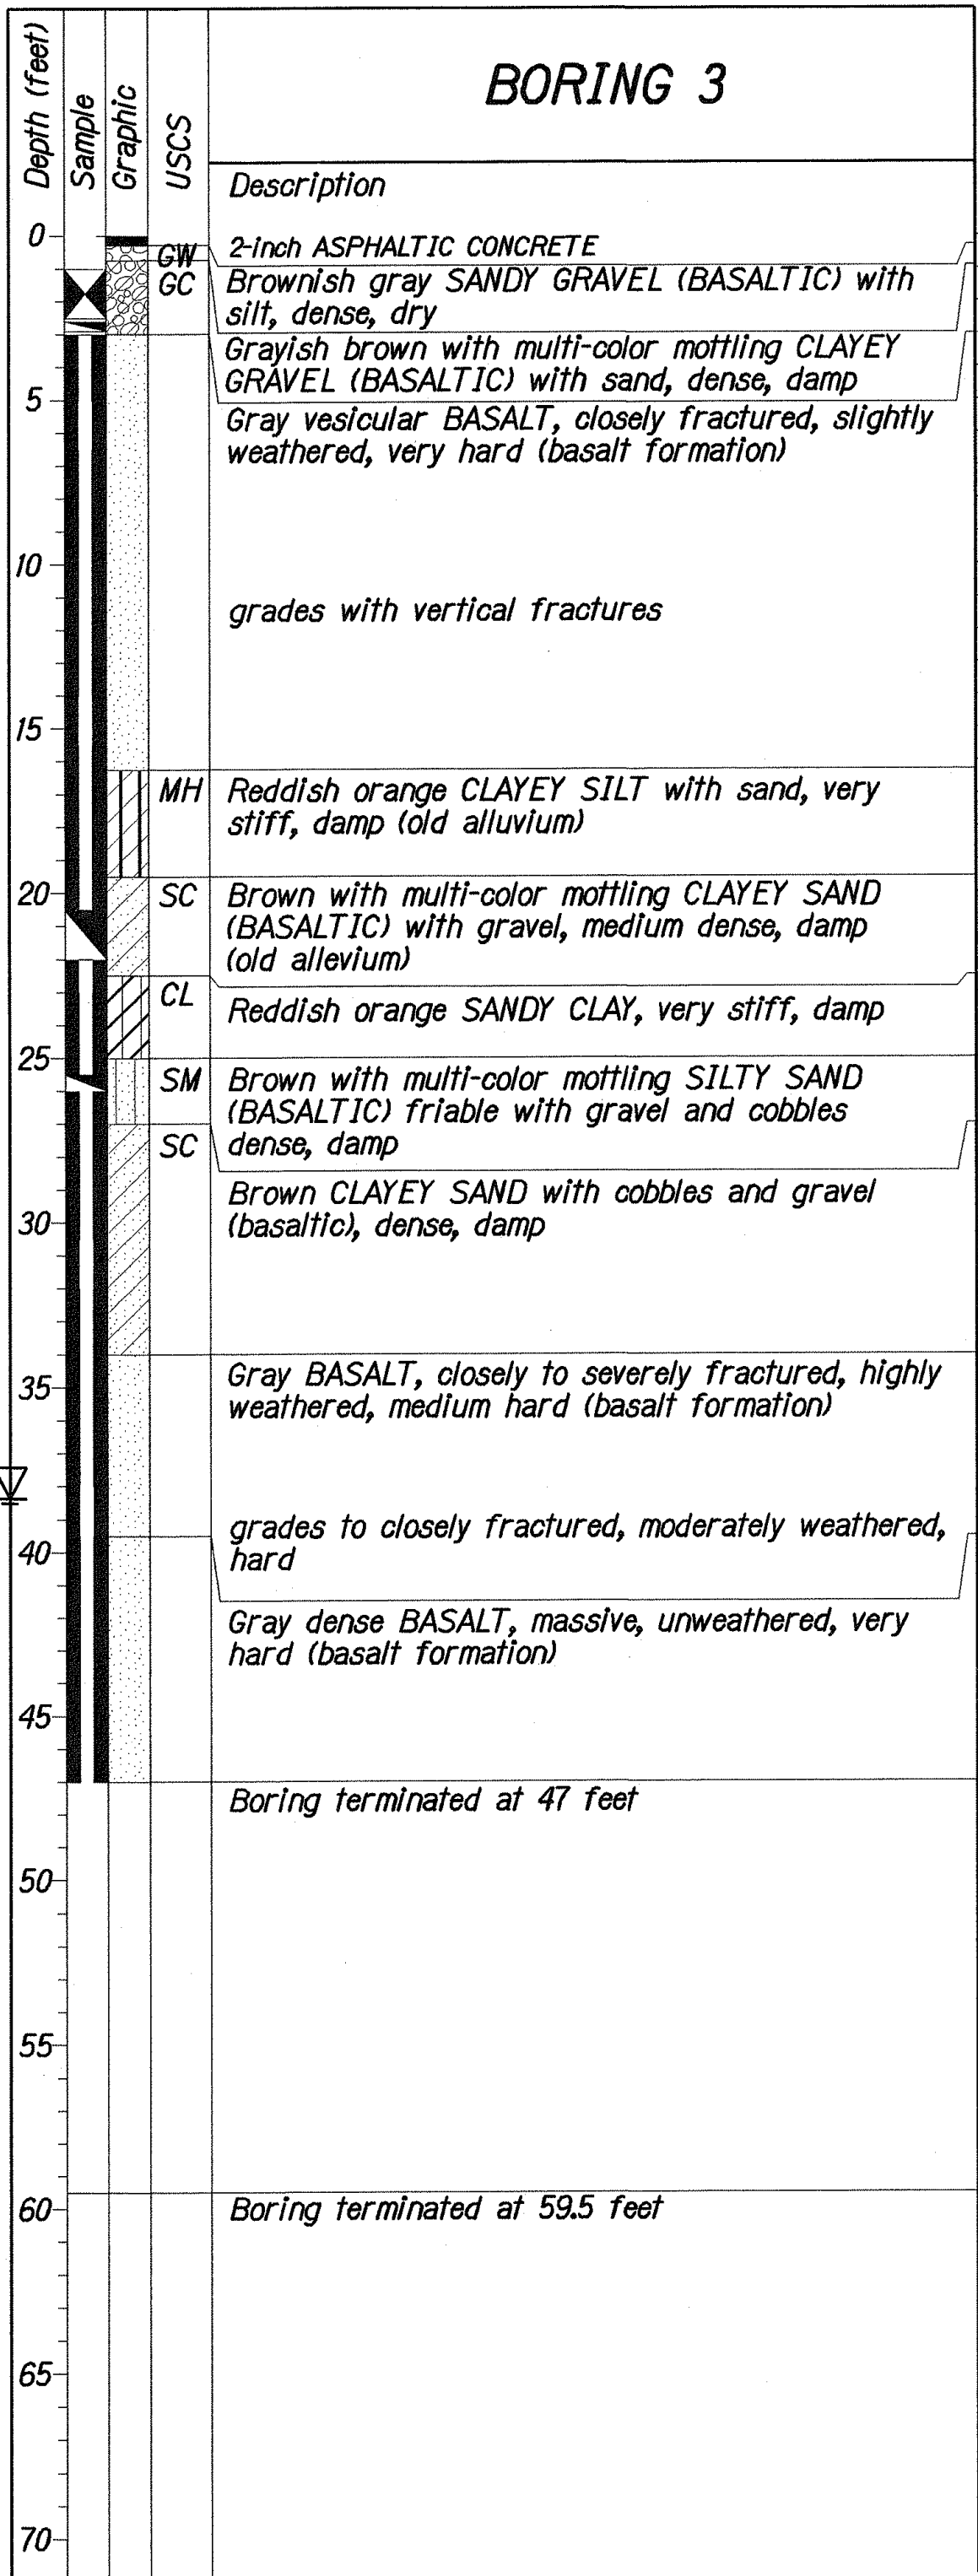

ORIGINAL PLAN	DATE	XXX/XX/XX
DESIGNED BY	DATE	XXX/XX/XX
CHECKED BY	DATE	XXX/XX/XX
NOTED BY	DATE	XXX/XX/XX
QUANTITIES BY	DATE	XXX/XX/XX
REVISIONS	DATE	XXX/XX/XX

STATE OF HAWAII
DEPARTMENT OF TRANSPORTATION
HIGHWAYS DIVISION

RETAINING WALL REPAIR and EXTENSION

BORING LOGS





**INTERSTATE ROUTE H-1 EXTENSION and REPAIR
of SCHOOL STREET ON-RAMP RETAINING WALL**

Project No. H11-01-08

Scale: As Noted Date: Feb. 2009

SHEET No. Q33 OF 34 SHEETS

FED. ROAD DIST. NO.	STATE	FED. AID PROJ. NO.	FISCAL YEAR	SHEET NO.	TOTAL SHEETS
HAWAII	HAW.	H11-01-08	2009	42	73

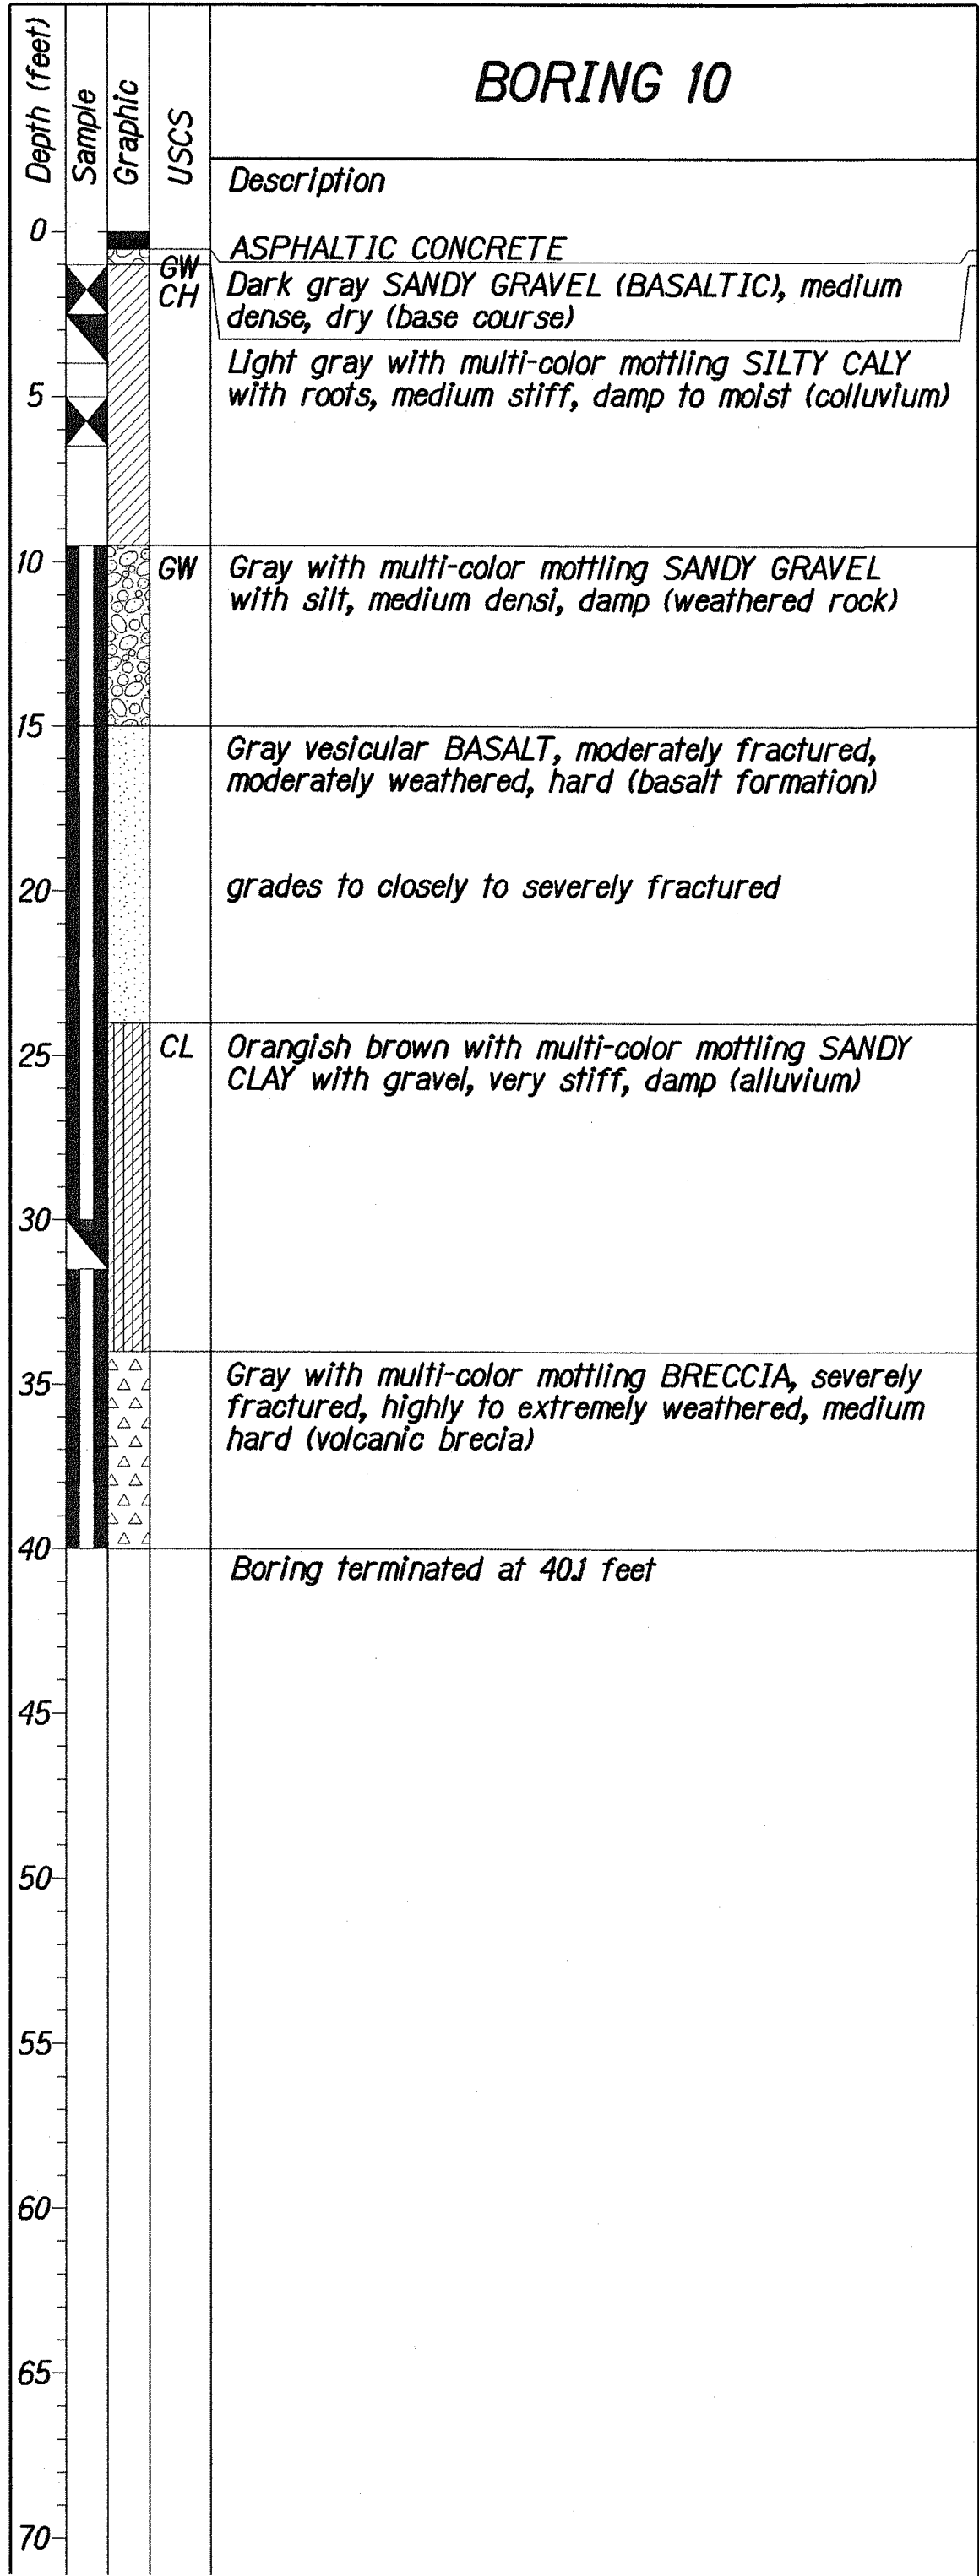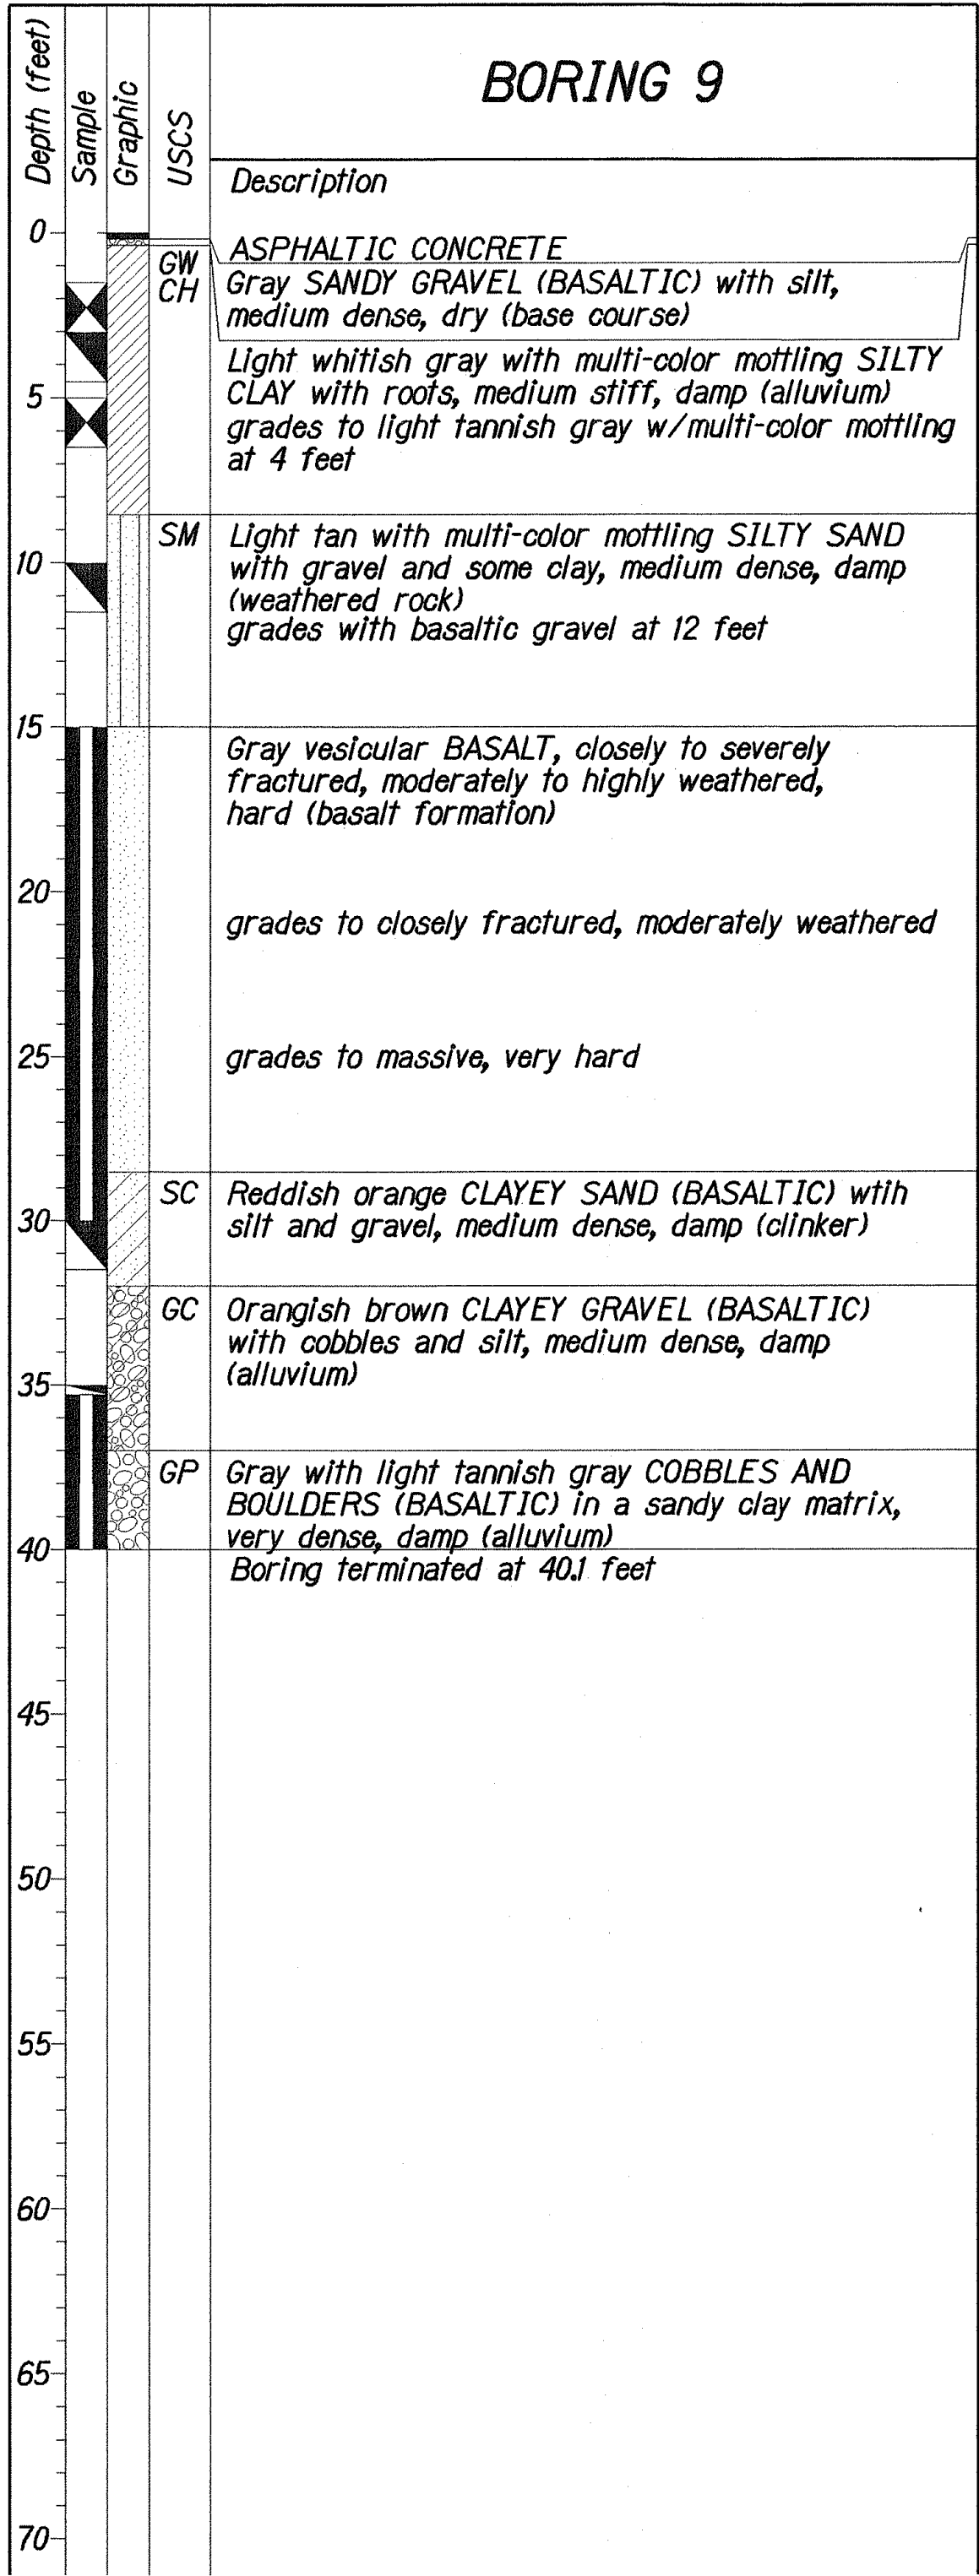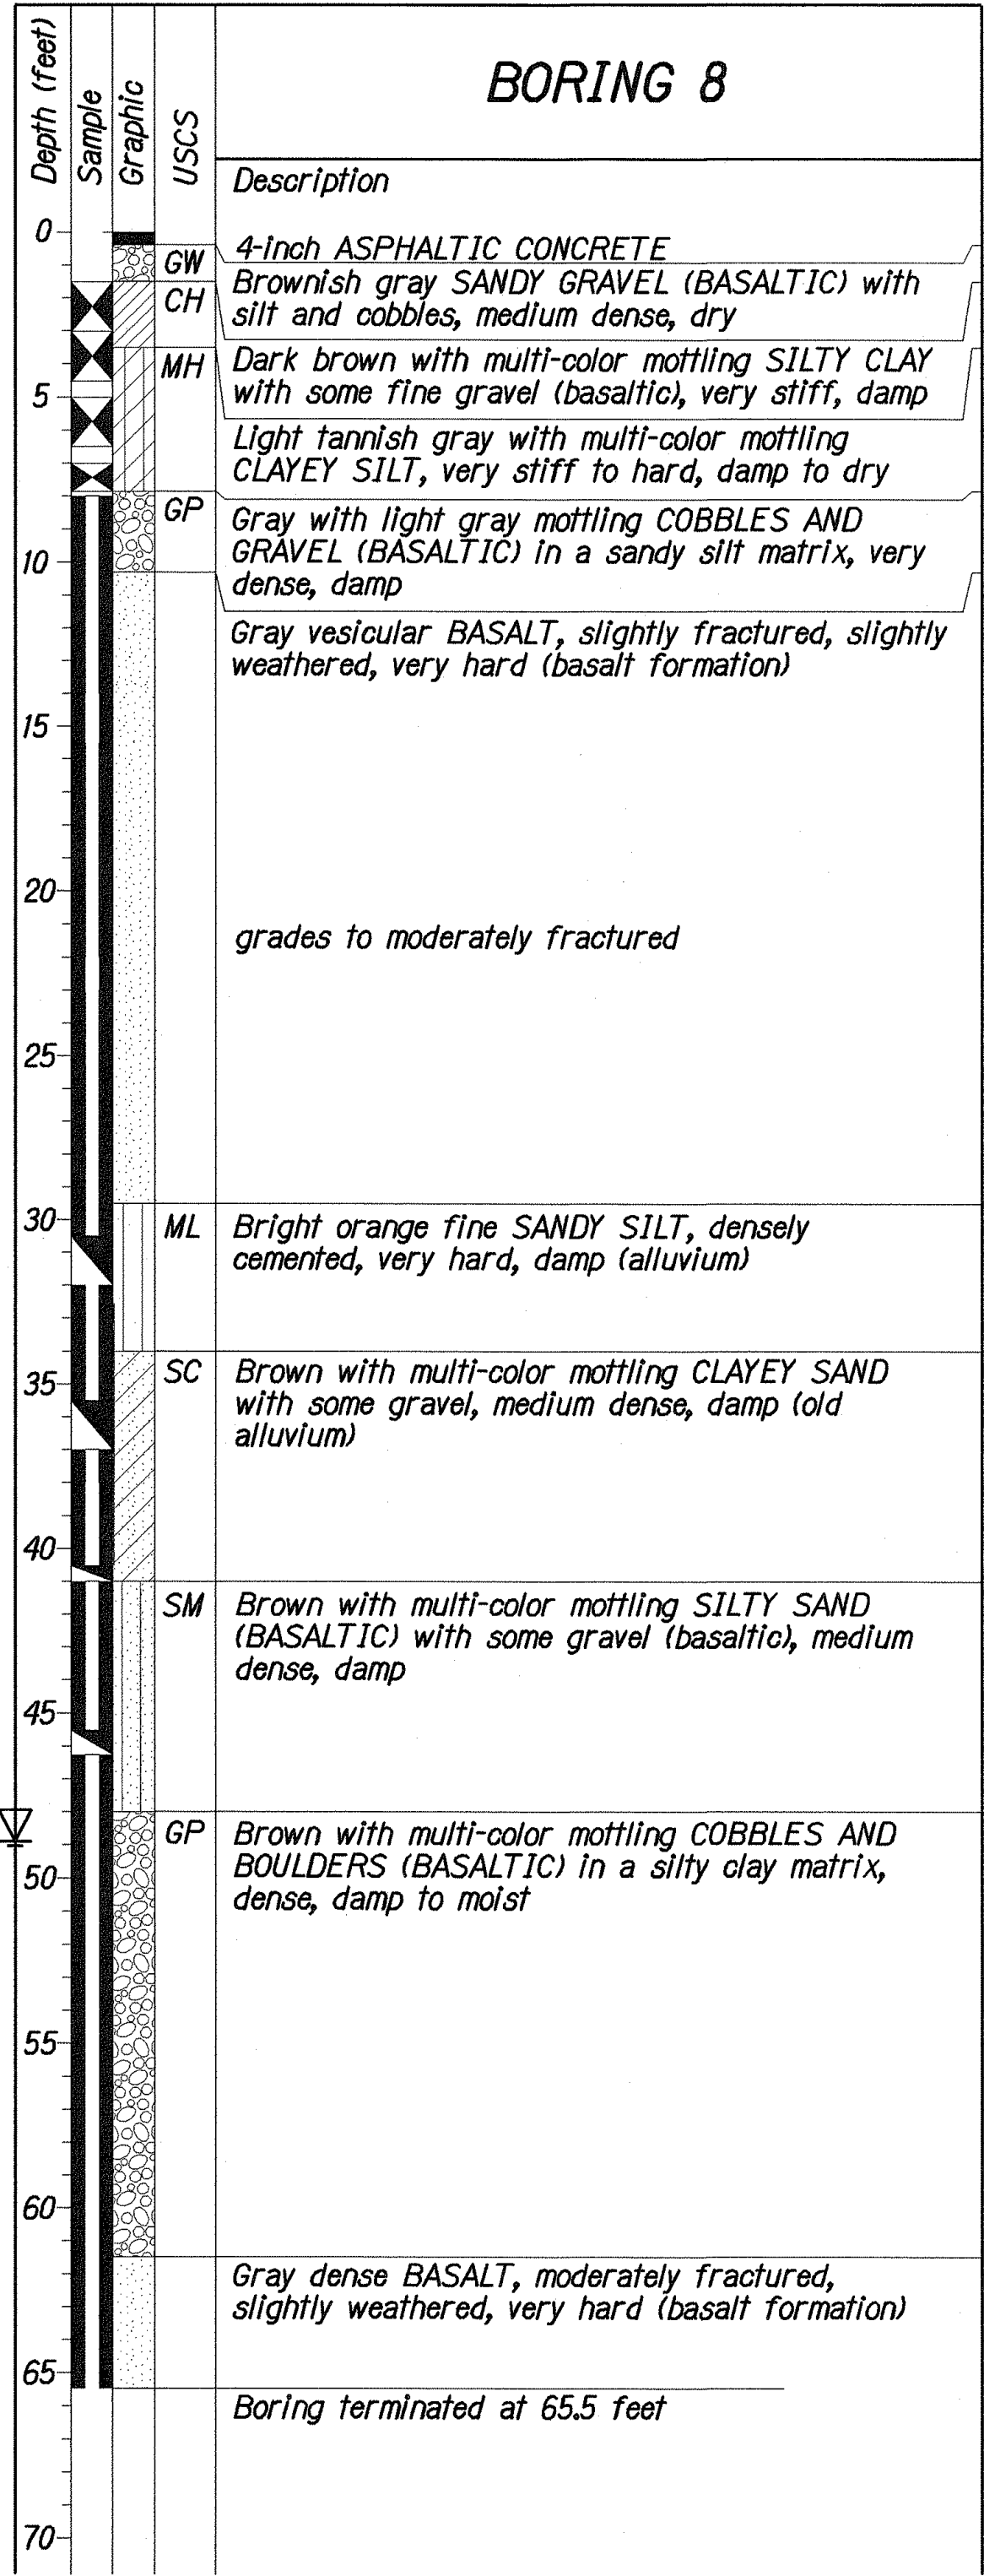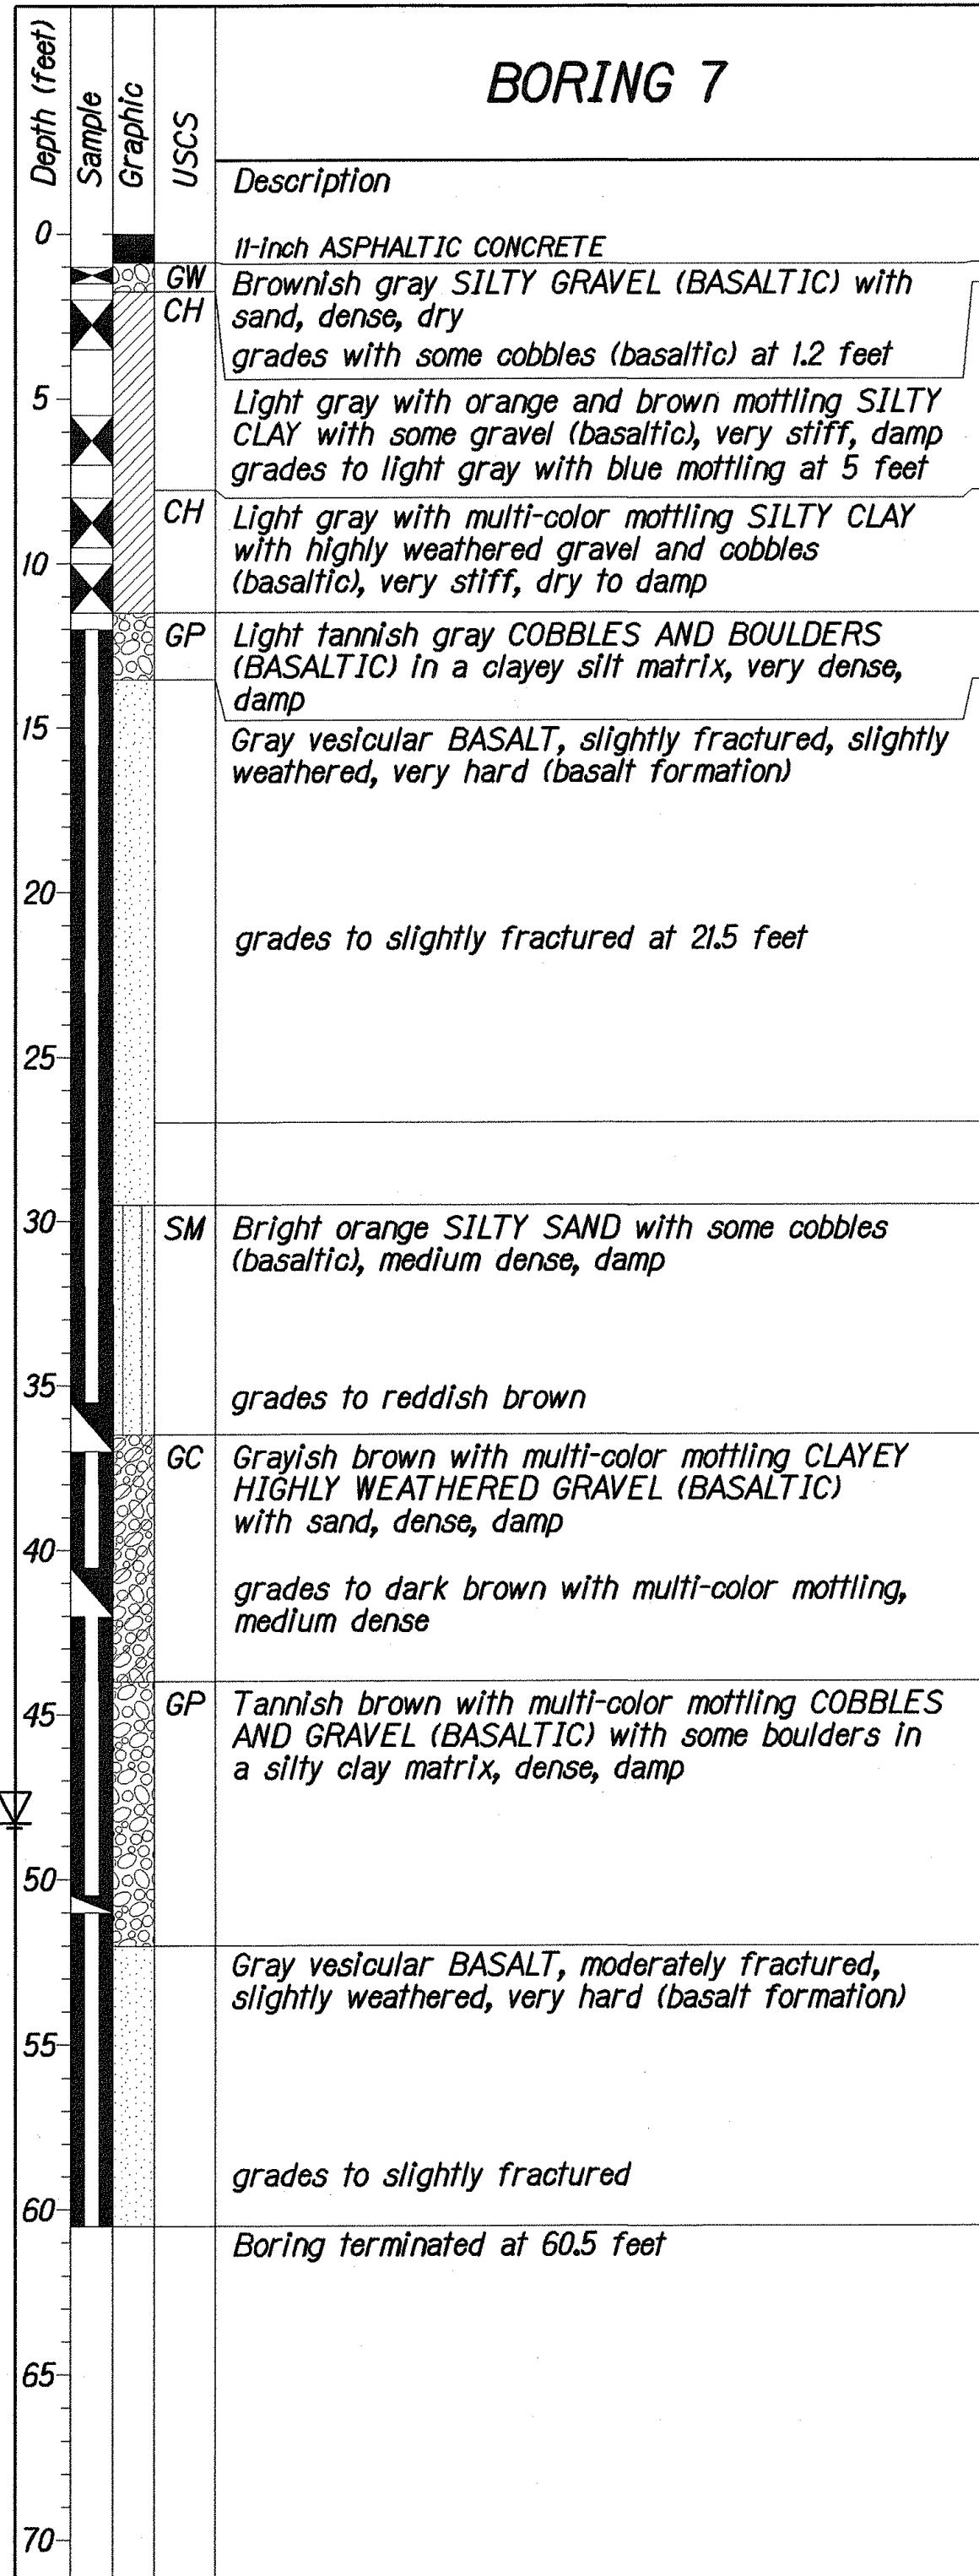

DESIGNED BY	DATE
XXX	XXX/XXX/XXX
TRACED BY	
XXX	XXX/XXX/XXX
DESIGNED BY	
XXX	XXX/XXX/XXX
QUANTITIES BY	
XXX	XXX/XXX/XXX
CHECKED BY	
XXX	XXX/XXX/XXX

STATE OF HAWAII
DEPARTMENT OF TRANSPORTATION
HIGHWAYS DIVISION

RETAINING WALL REPAIR and EXTENSION

BORING LOGS

INTERSTATE ROUTE H-1 EXTENSION and REPAIR
of SCHOOL STREET ON-RAMP RETAINING WALL
Project No. H11-01-08

Scale: As Noted Date: Feb. 2009

SHEET No. Q34 OF 34 SHEETS