

INDEX TO DRAWINGS	
SHEET NO.	DESCRIPTION
56	TITLE SHEET
57	STANDARD PLANS SUMMARY
58	NOTES
59 - 60	WATER POLLUTION & EROSION CONTROL NOTES
61 - 62	DRAINAGE PLANS
63 - 64	DRAINAGE PROFILES
65 - 67	DRAINAGE DETAILS
68 - 73	TRAFFIC PLANS

STATE OF HAWAII

DEPARTMENT OF TRANSPORTATION

HIGHWAYS DIVISION

HONOLULU, HAWAII

"AS-BUILT"


PLANS FOR

INTERSTATE ROUTE H-1

DRAINAGE IMPROVEMENTS

VICINITY OF SCHOOL STREET OFF-RAMP

PROJECT NO. H1I-01-09

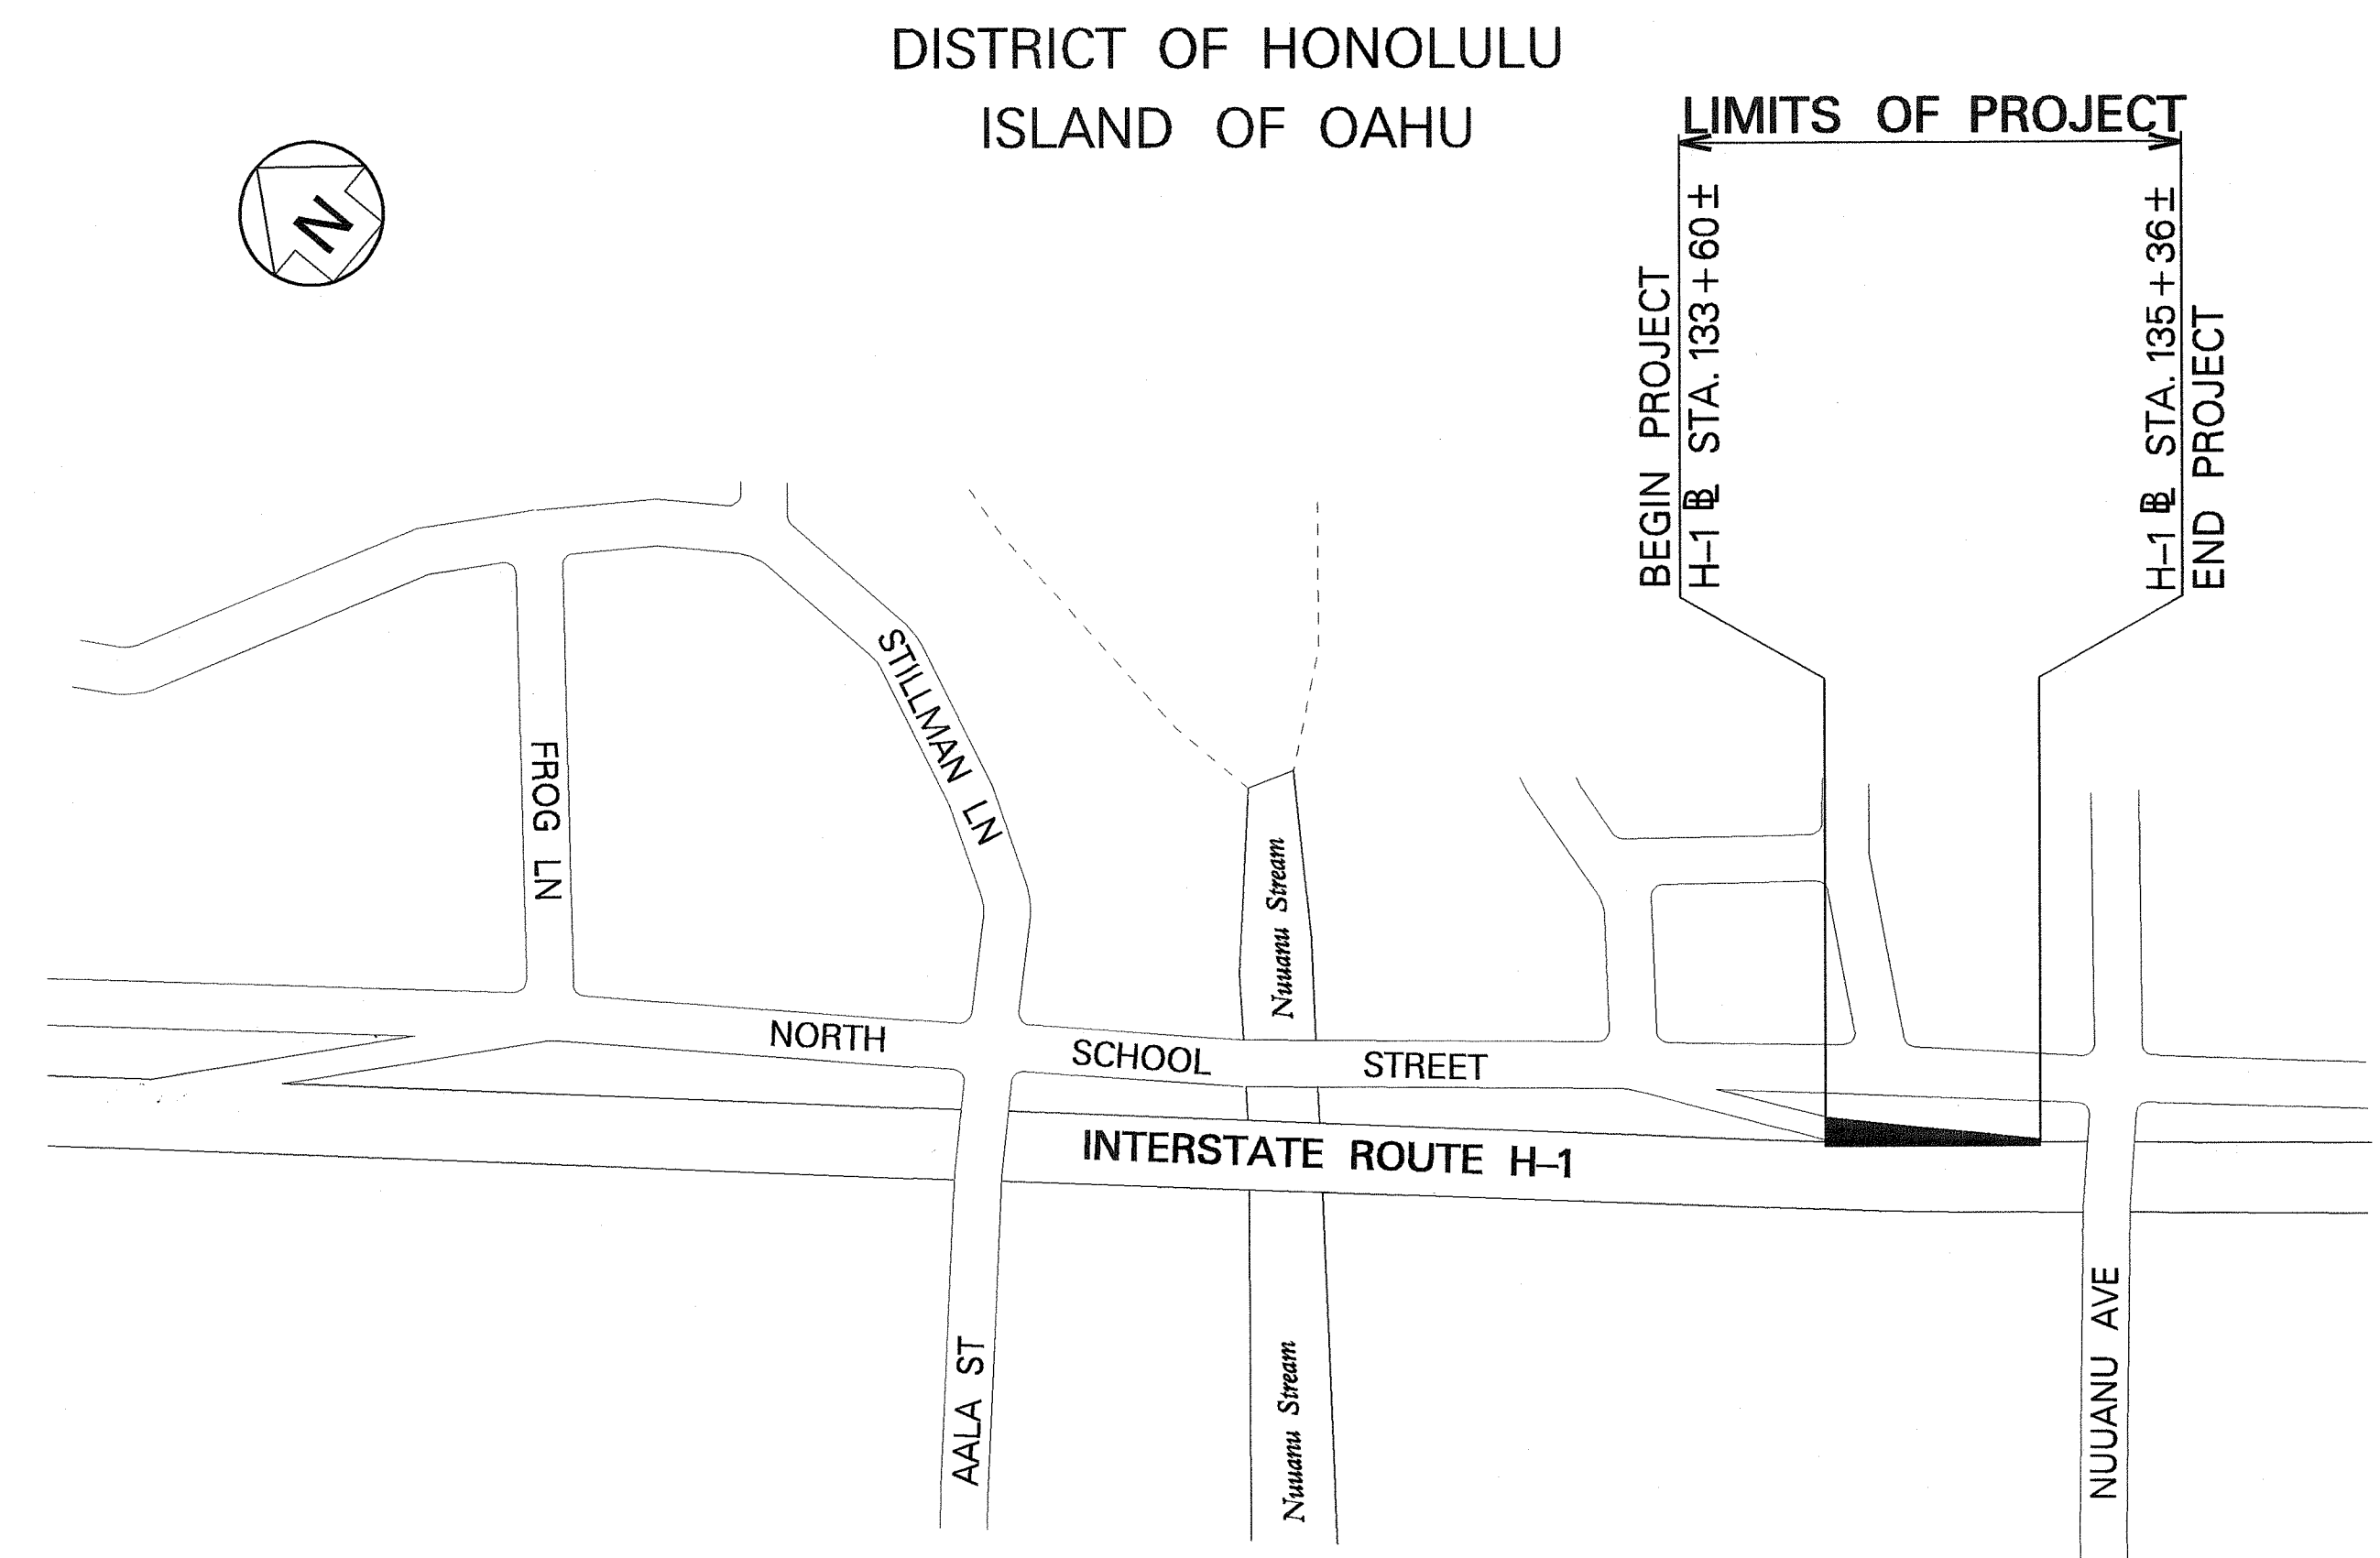

LAYOUT PLAN


GROSS LENGTH OF PROJECT.....0.05 MILES

NET LENGTH OF PROJECT.....0.05 MILES

1.5 0 1.5 3 4.5

SCALE IN HUNDRED FEET

FED. ROAD DIST. NO.	STATE	PROJ. NO.	FISCAL YEAR	SHEET NO.	TOTAL SHEETS
HAWAII	HAW.	H1I-01-09	2009	56	73

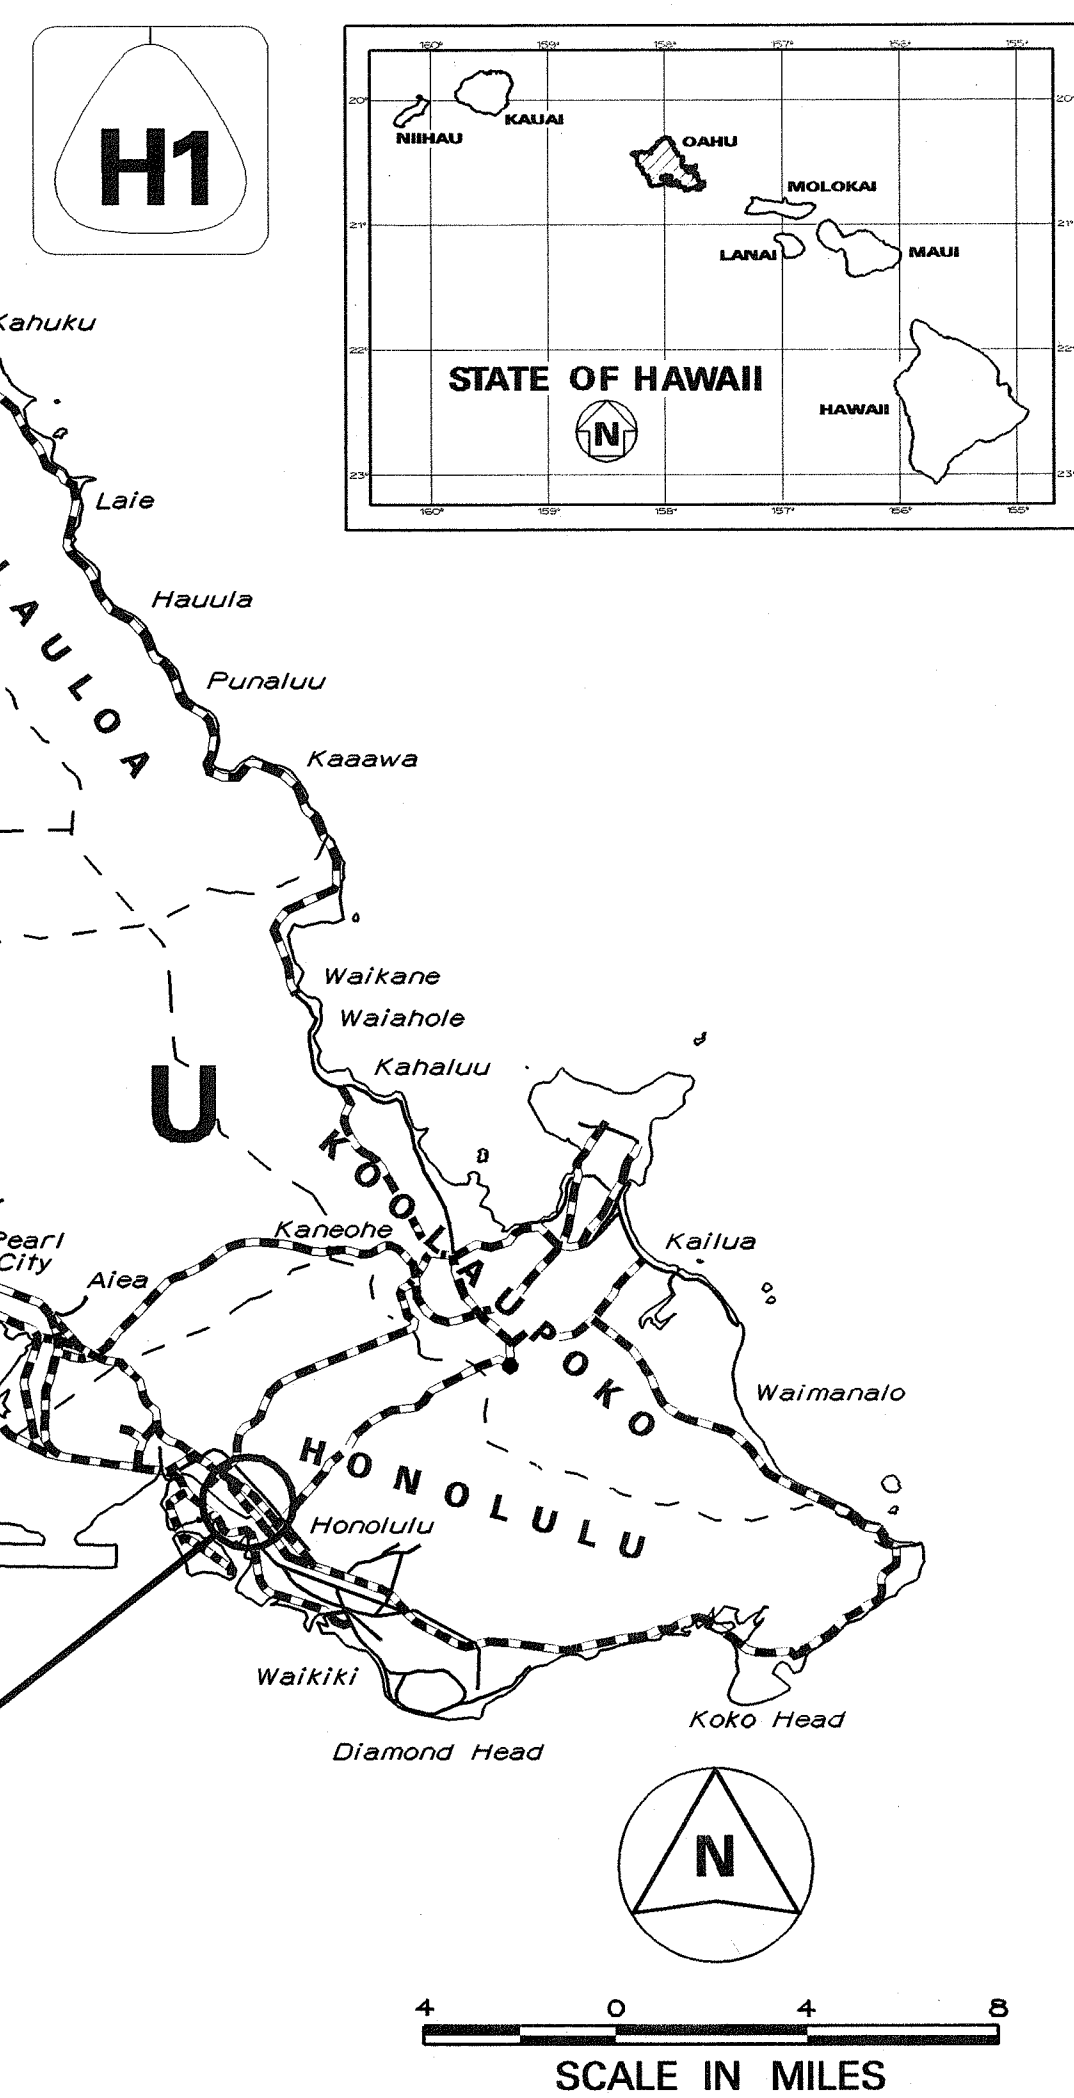

FEDERAL AID PROJECTS PREVIOUSLY CONSTRUCTED OR UNDER CONSTRUCTION

MILE POST 21.22 TO MILE POST 21.27

CHANGES MADE DURING CONSTRUCTION HAVE BEEN INCORPORATED ON THESE PLANS EXCEPT CHANGES IN THE ORIGINAL THEORETICAL QUANTITIES. FOR ACTUAL QUANTITIES, REFER TO PROJECT LEDGER AND/OR COMPUTATION BOOK.

Samuel P. Rombaut

RESIDENT ENGINEER

3/23/09

DATE

DEPARTMENT OF TRANSPORTATION

STATE OF HAWAII

APPROVED:

Deane M. Gami

DIR. OF TRANSPORTATION

3-17-09

DATE

HWY-D

DESIGNED BY

HWY-DH

P. S. & E. BY

692-7561

PHONE

Mar. 2009

DATE