

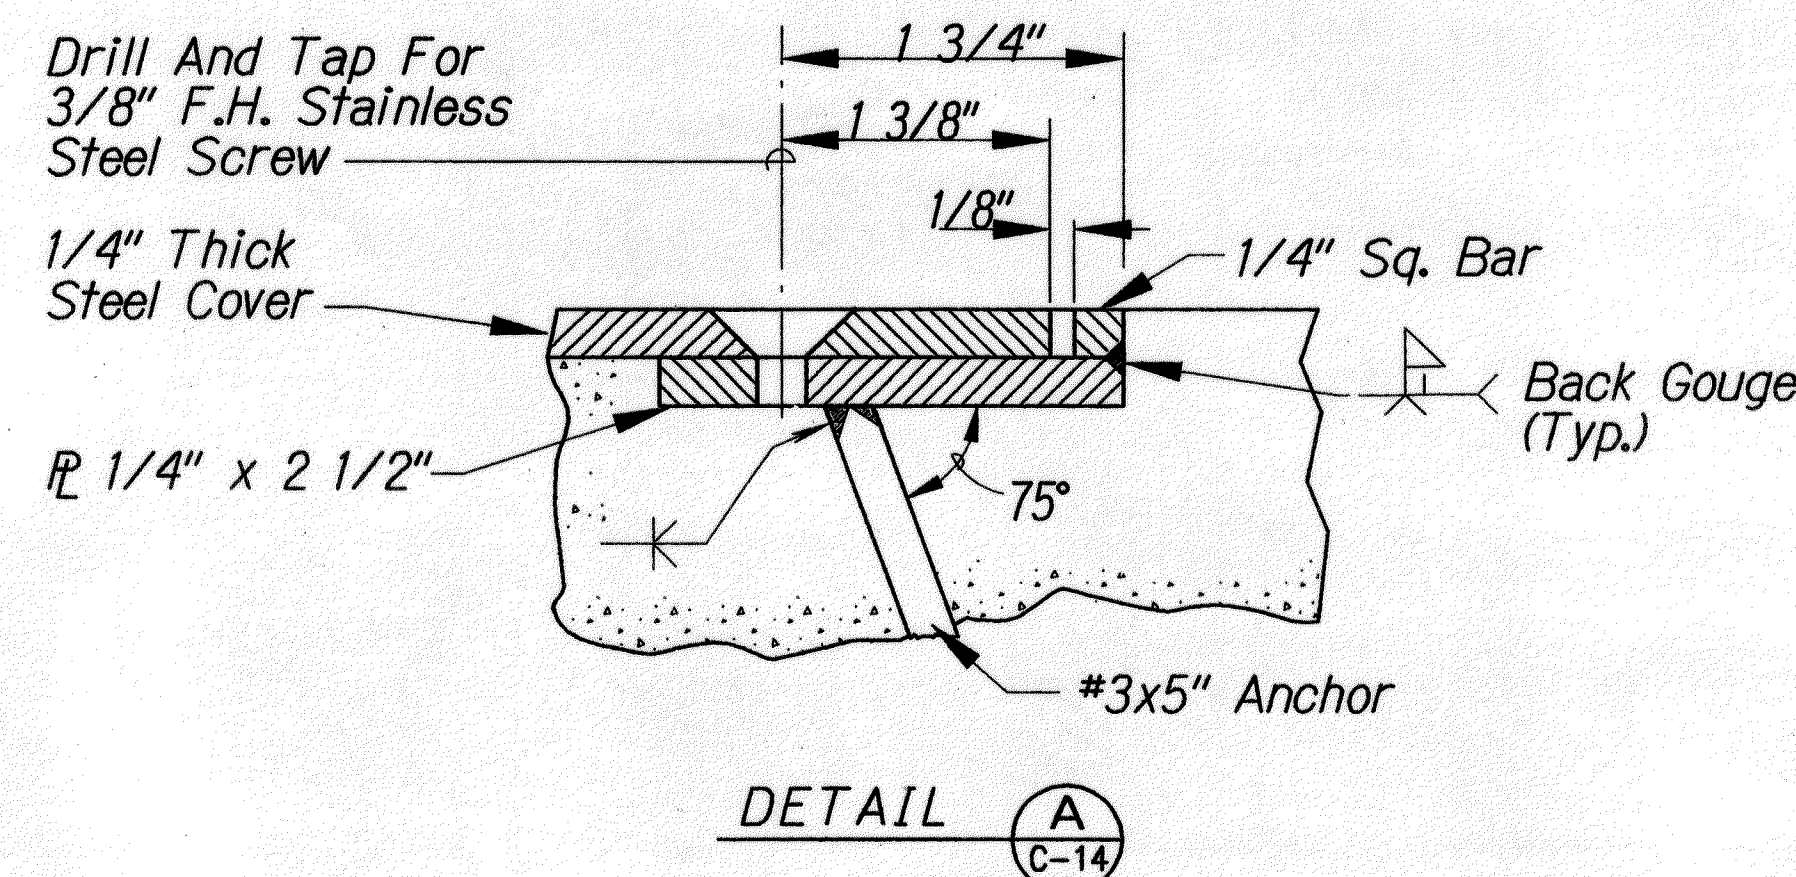
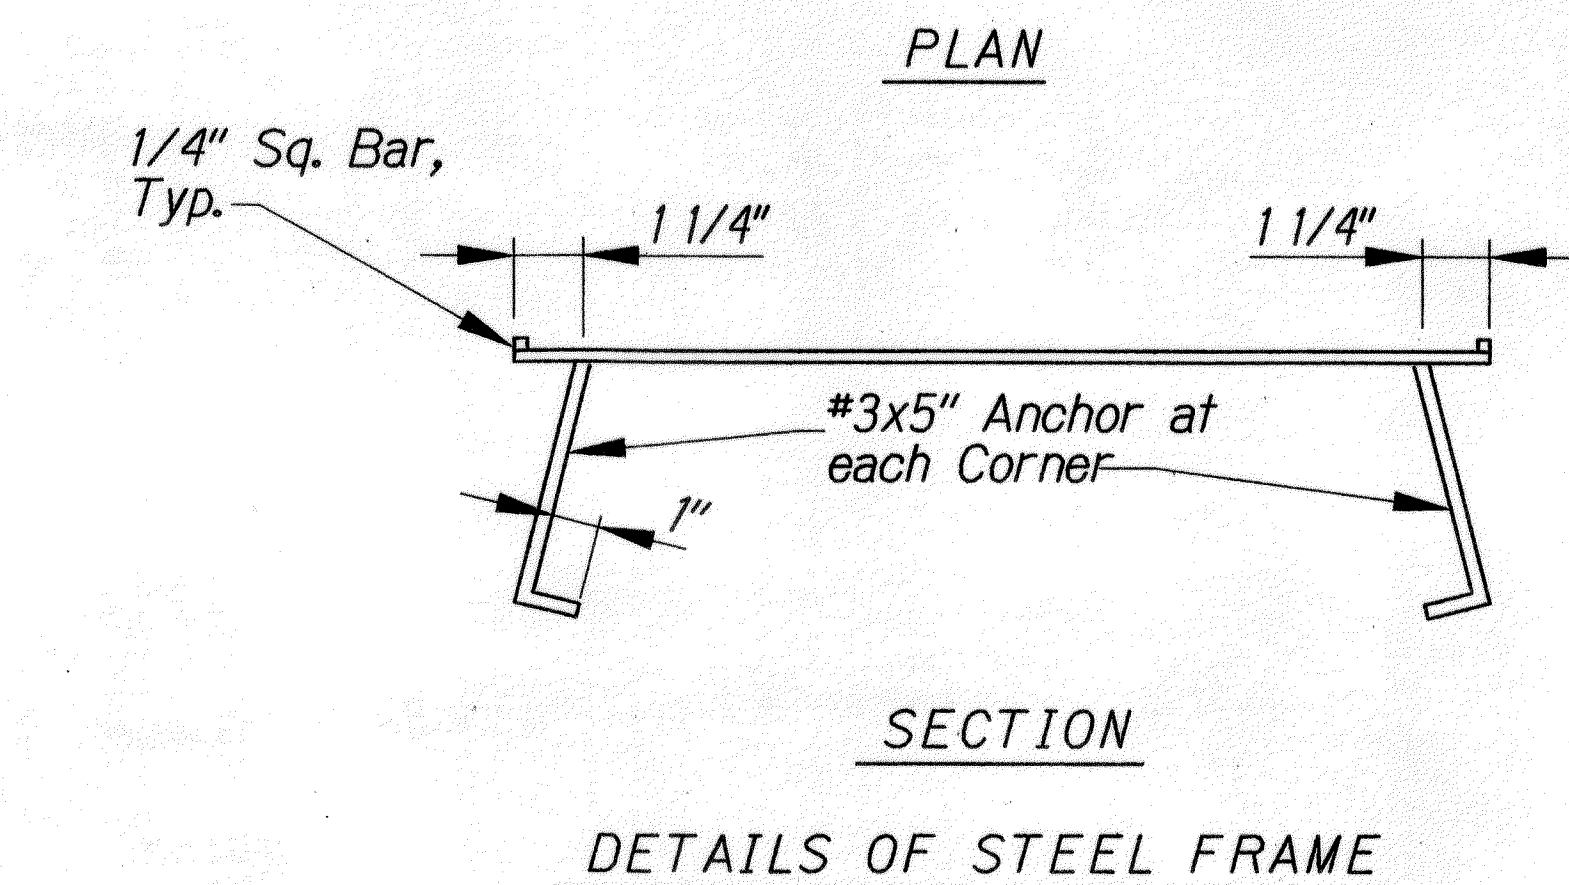
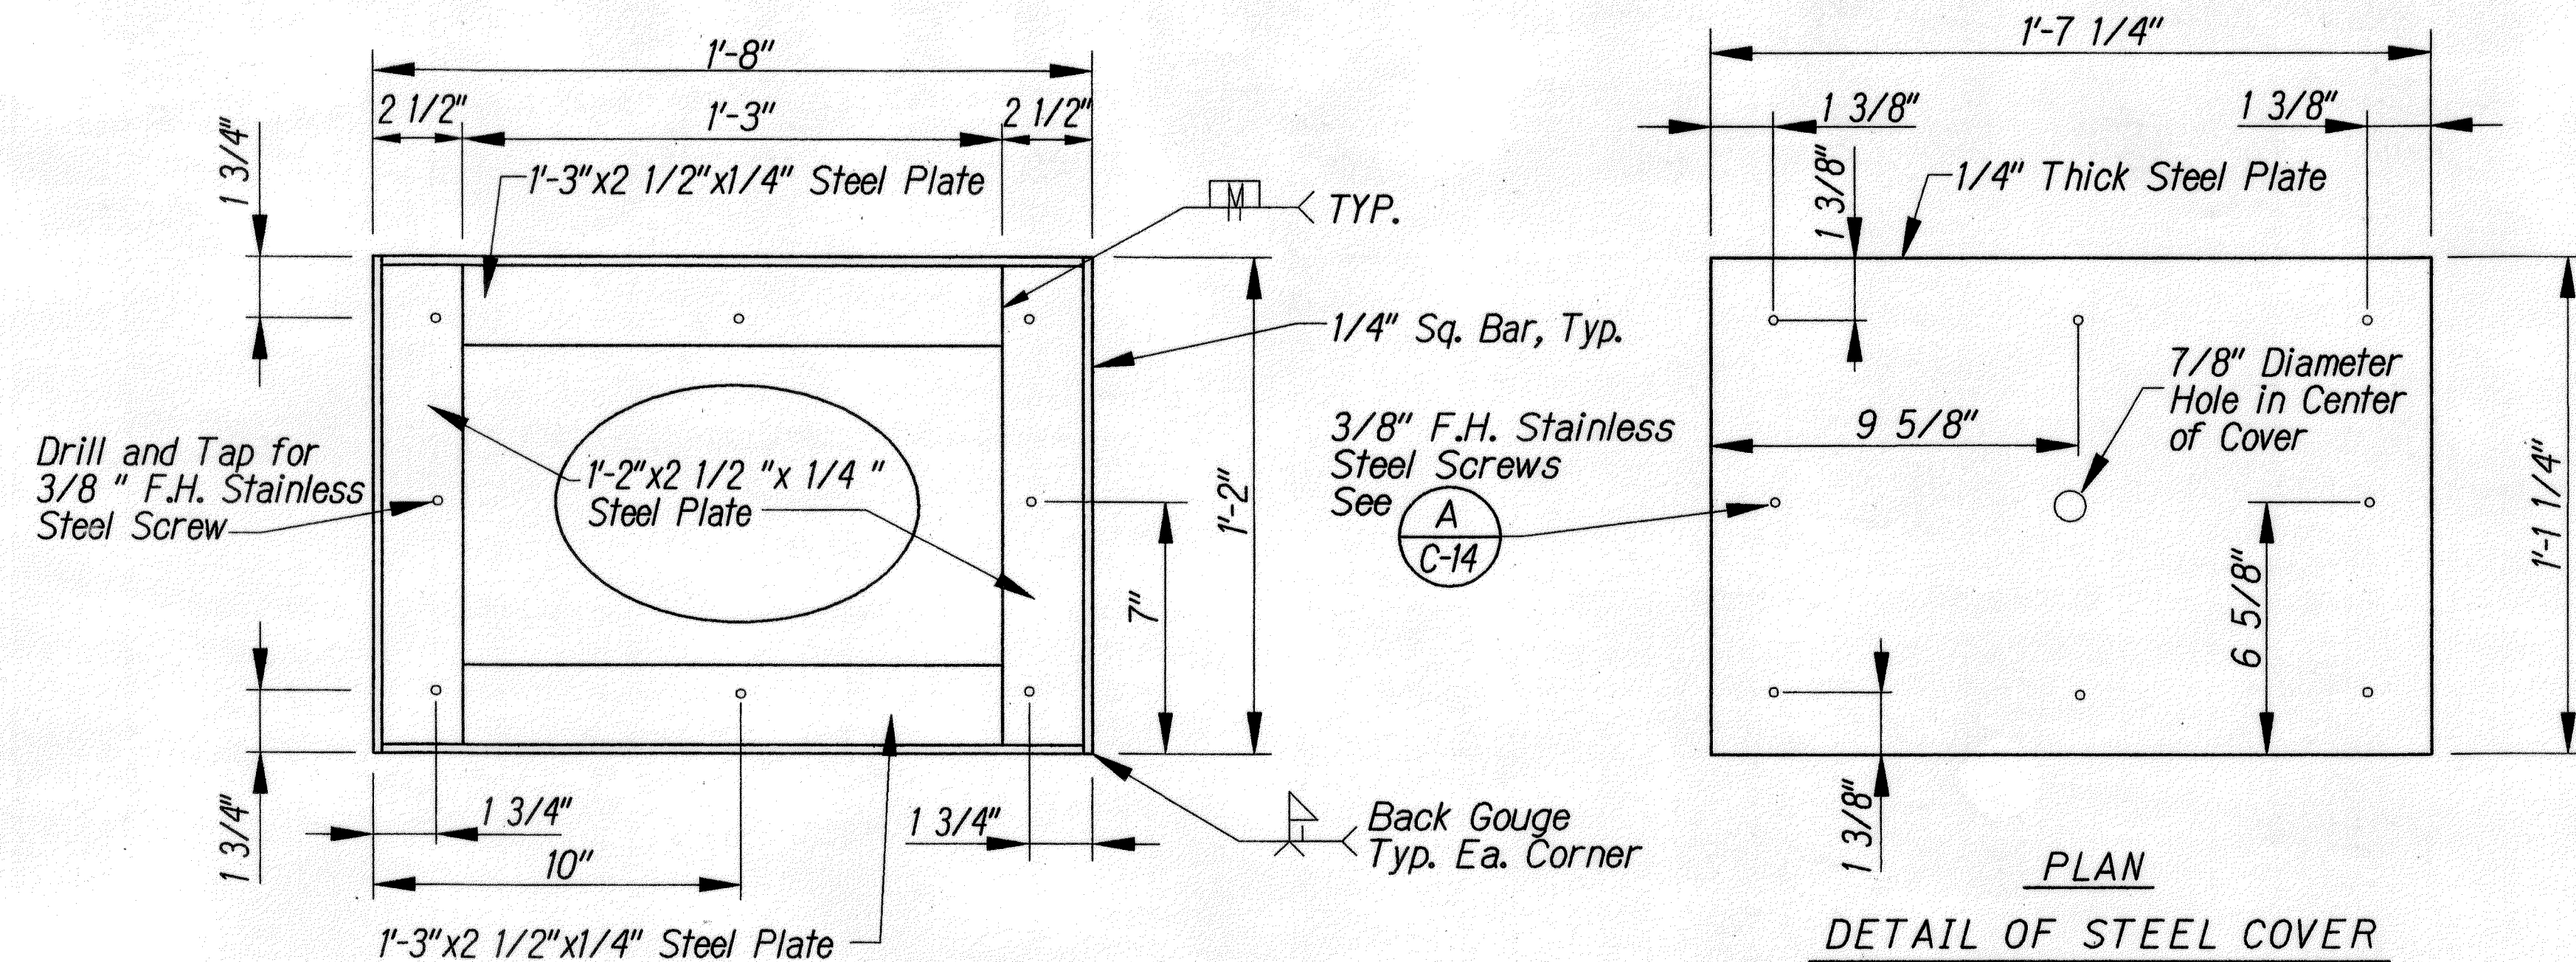


FED. ROAD DIST. NO.	STATE	FED. AID PROJ. NO.	FISCAL YEAR	SHEET NO.	TOTAL SHEETS
HAWAII	HAW.	TC-HI-1(258)	2006	28	89


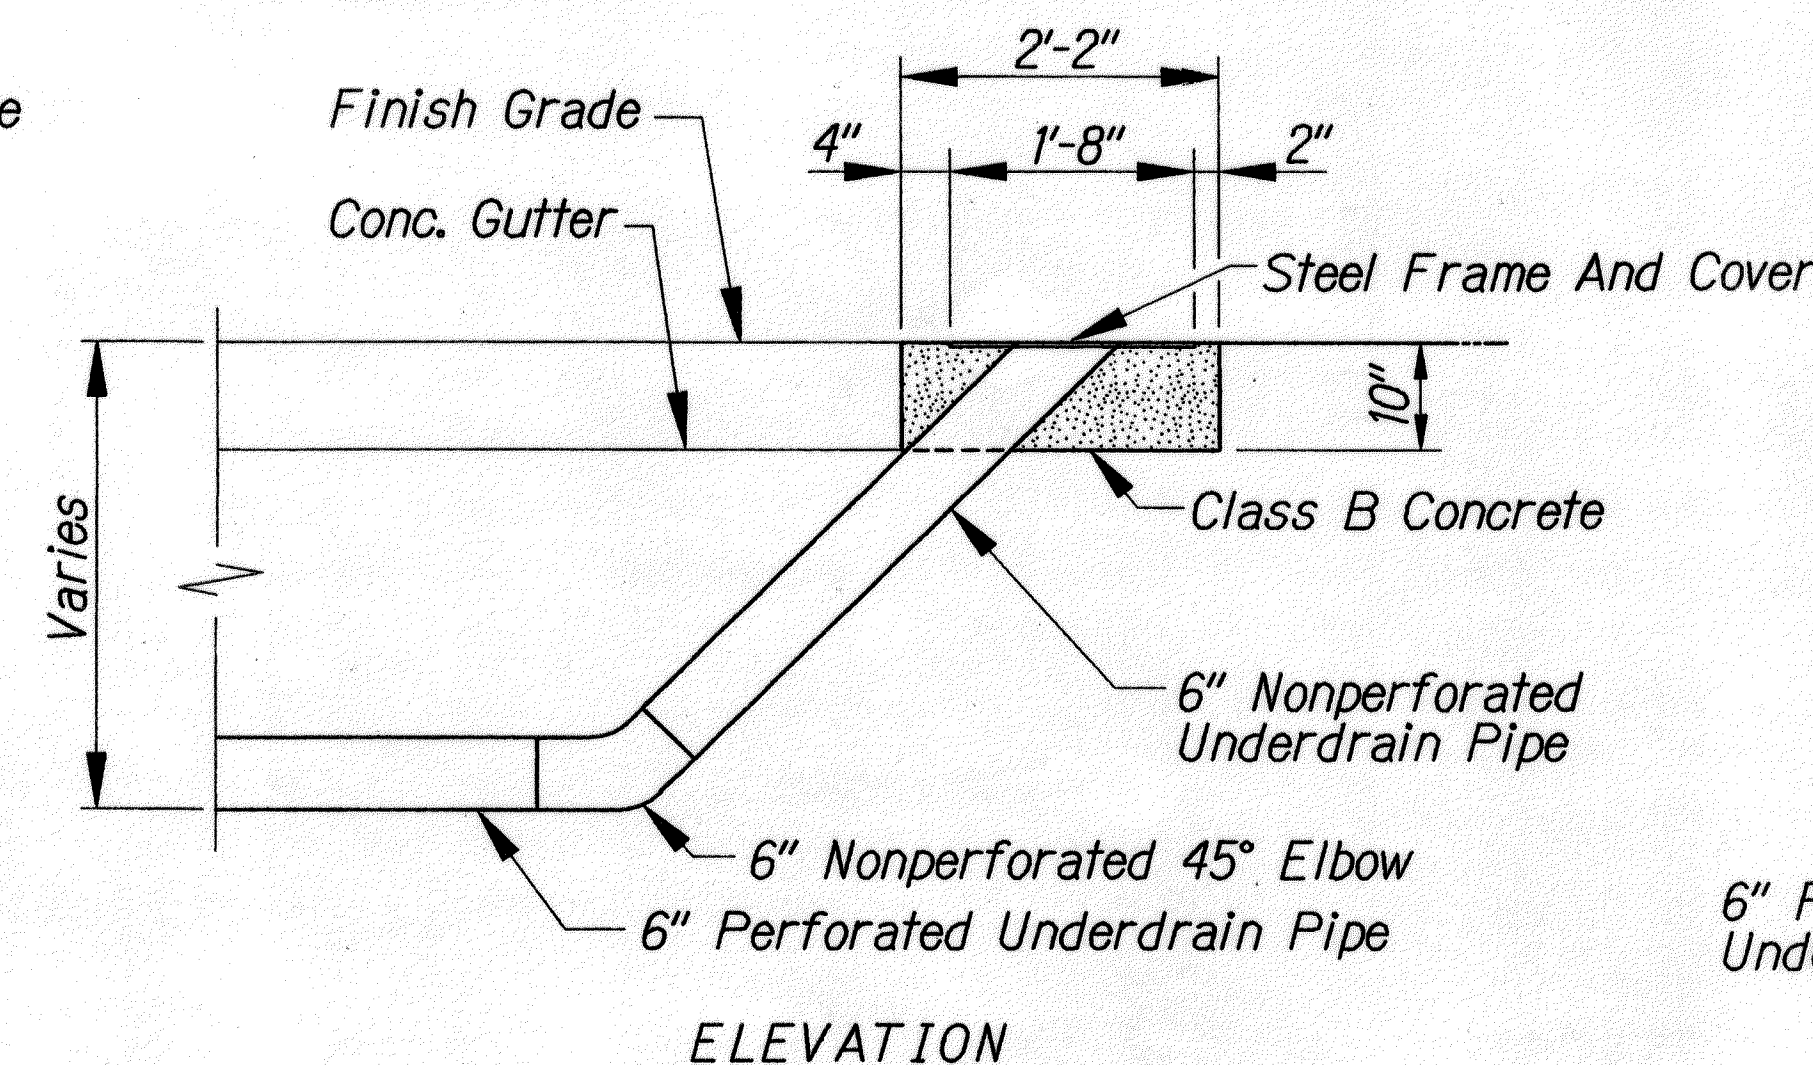


Note:
All Steel Parts shall be Galvanized in
Accordance with the Requirements of ASTM A123.


DETAILS OF STEEL FRAME AND COVER FOR CLEANOUT

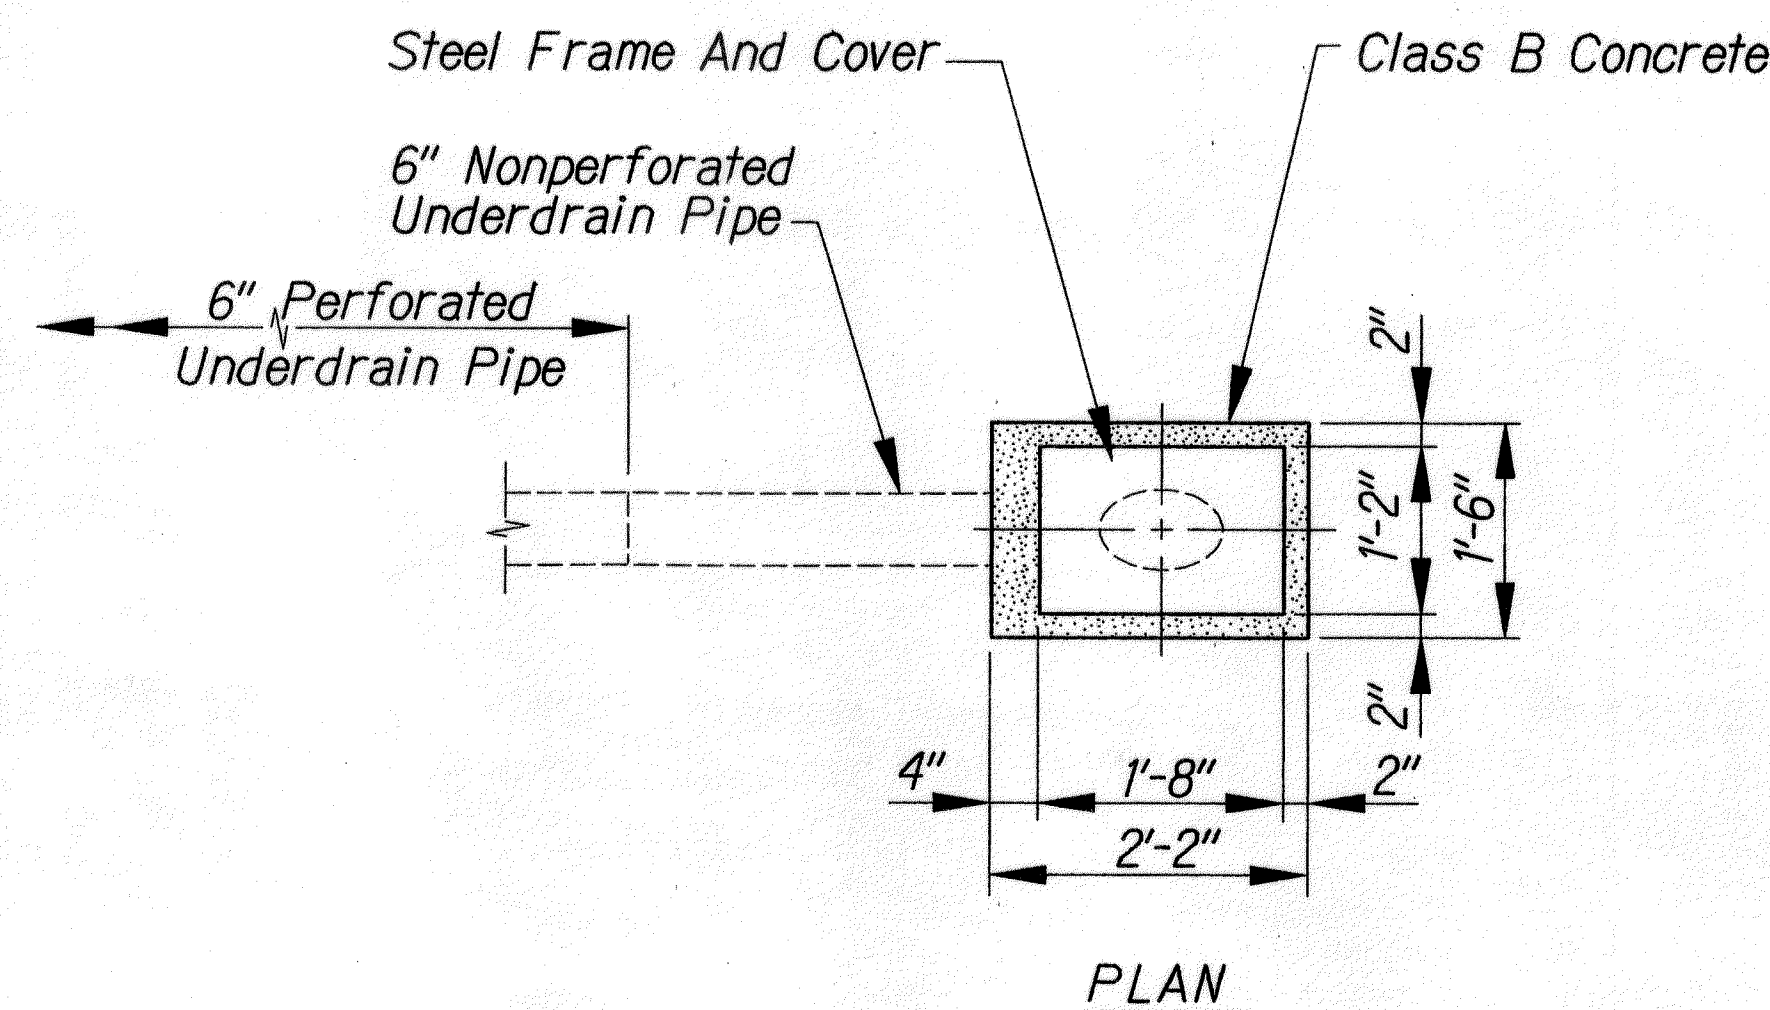


TYPICAL DETAILS OF CLEANOUT

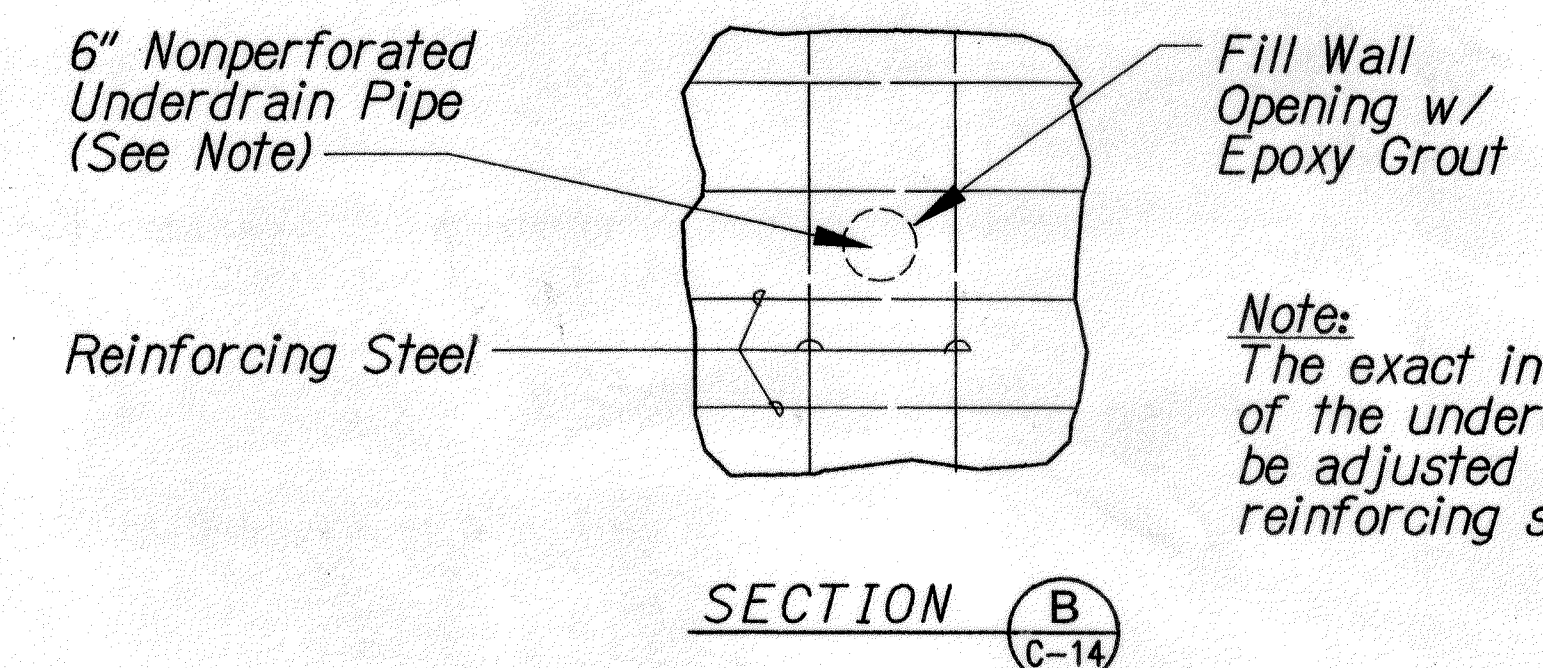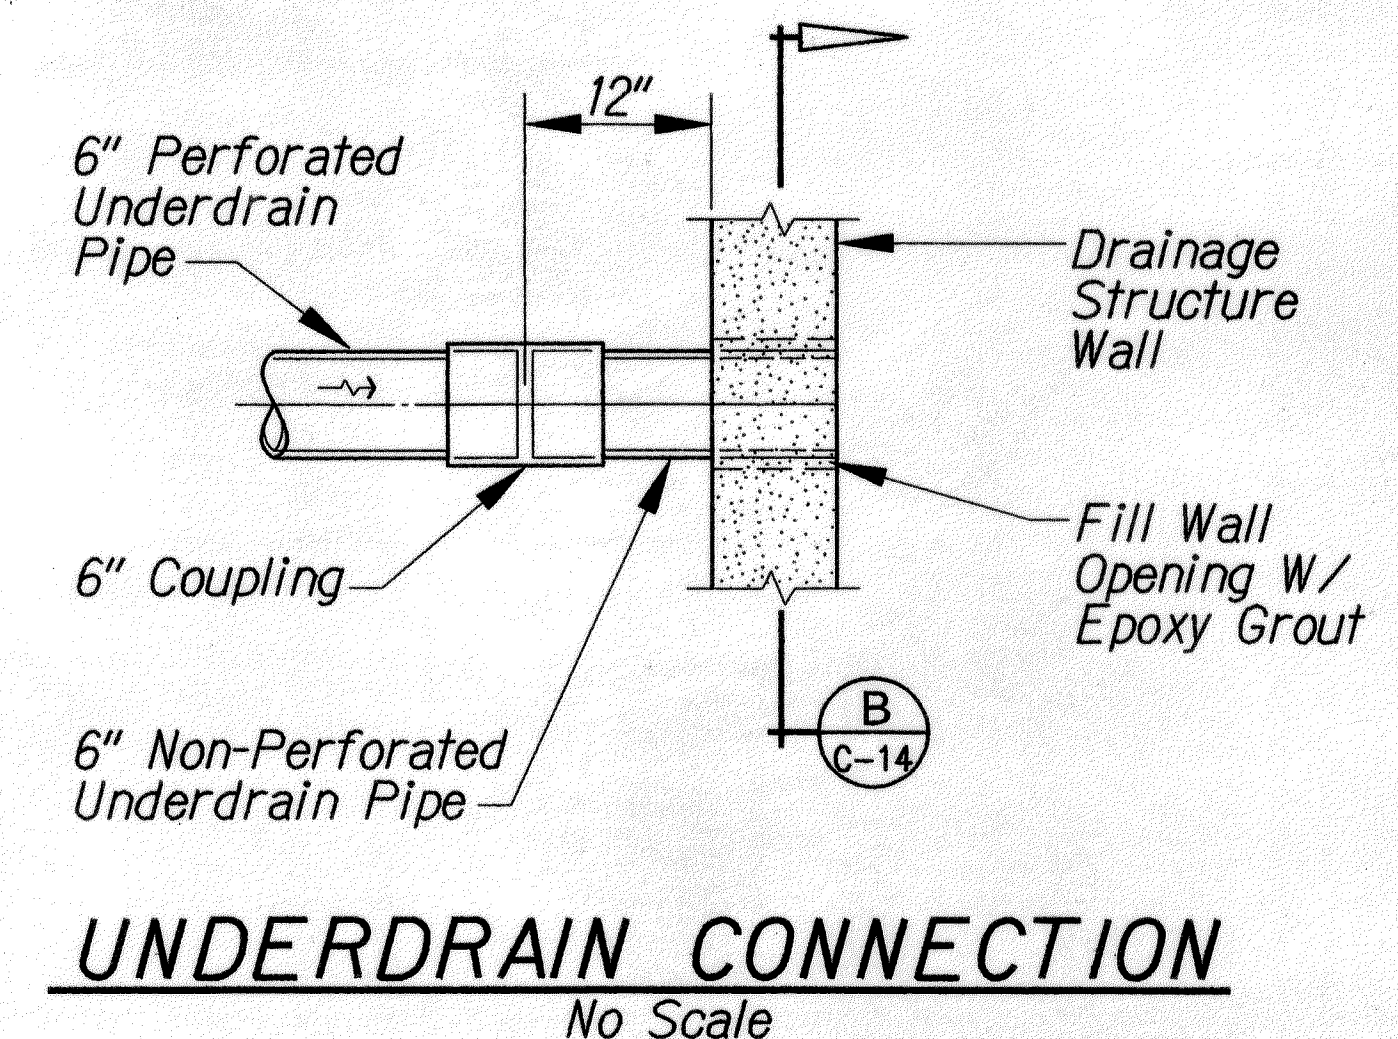

TYPICAL DETAILS OF 6" UNDERDRAIN CONNECTION TO DRAINAGE STRUCTURES

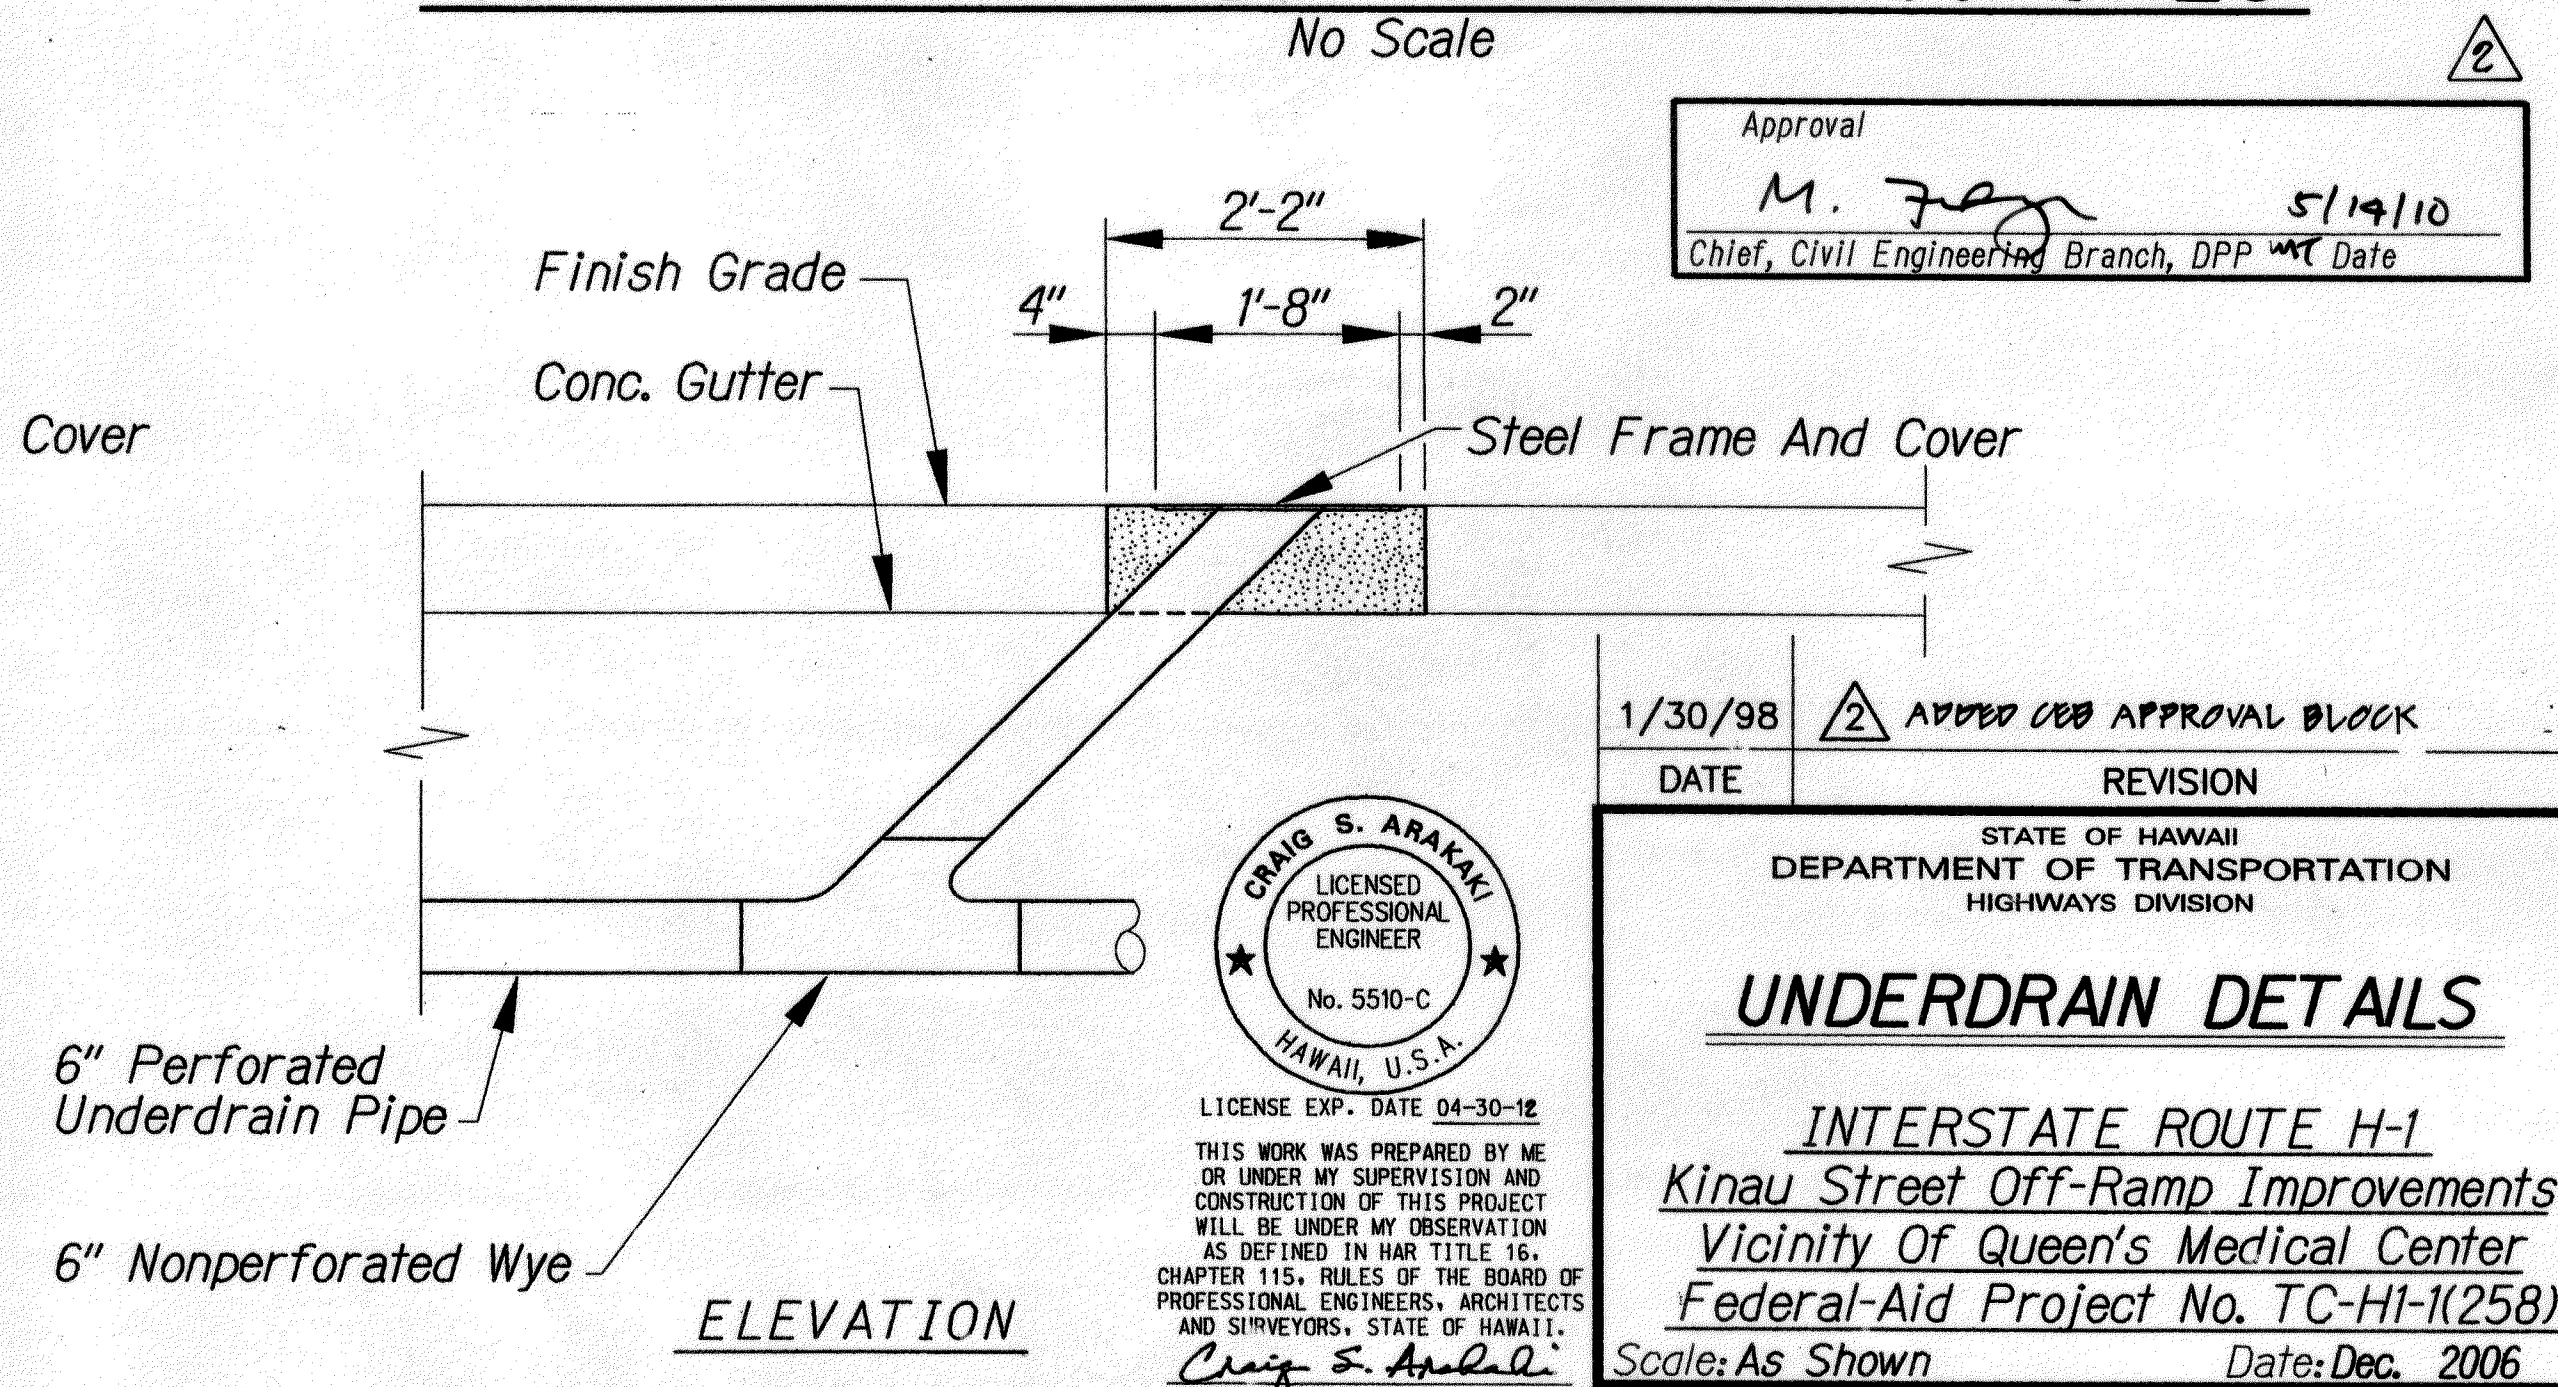


Approval
M. 709 5/14/10
Chief, Civil Engineering Branch, DPP Date

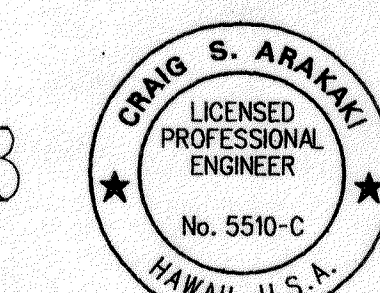

LICENSE EXP. DATE 04-30-12
THIS WORK WAS PREPARED BY ME
OR UNDER MY SUPERVISION AND
CONSTRUCTION OF THIS PROJECT
WILL BE UNDER MY OBSERVATION
AS DEFINED IN H.A.R. TITLE 16,
CHAPTER 115, RULES OF THE BOARD OF
PROFESSIONAL ENGINEERS, ARCHITECTS
AND SURVEYORS, STATE OF HAWAII.
Craig S. Arakaki

DATE	REVISION
1/30/98	2 ADDED CCB APPROVAL BLOCK
STATE OF HAWAII DEPARTMENT OF TRANSPORTATION HIGHWAYS DIVISION	
UNDERDRAIN DETAILS	
INTERSTATE ROUTE H-1 Kinaiu Street Off-Ramp Improvements Vicinity Of Queen's Medical Center Federal-Aid Project No. TC-HI-1(258)	
Scale: As Shown	Date: Dec. 2006
SHEET No. 1 OF 1 SHEETS	

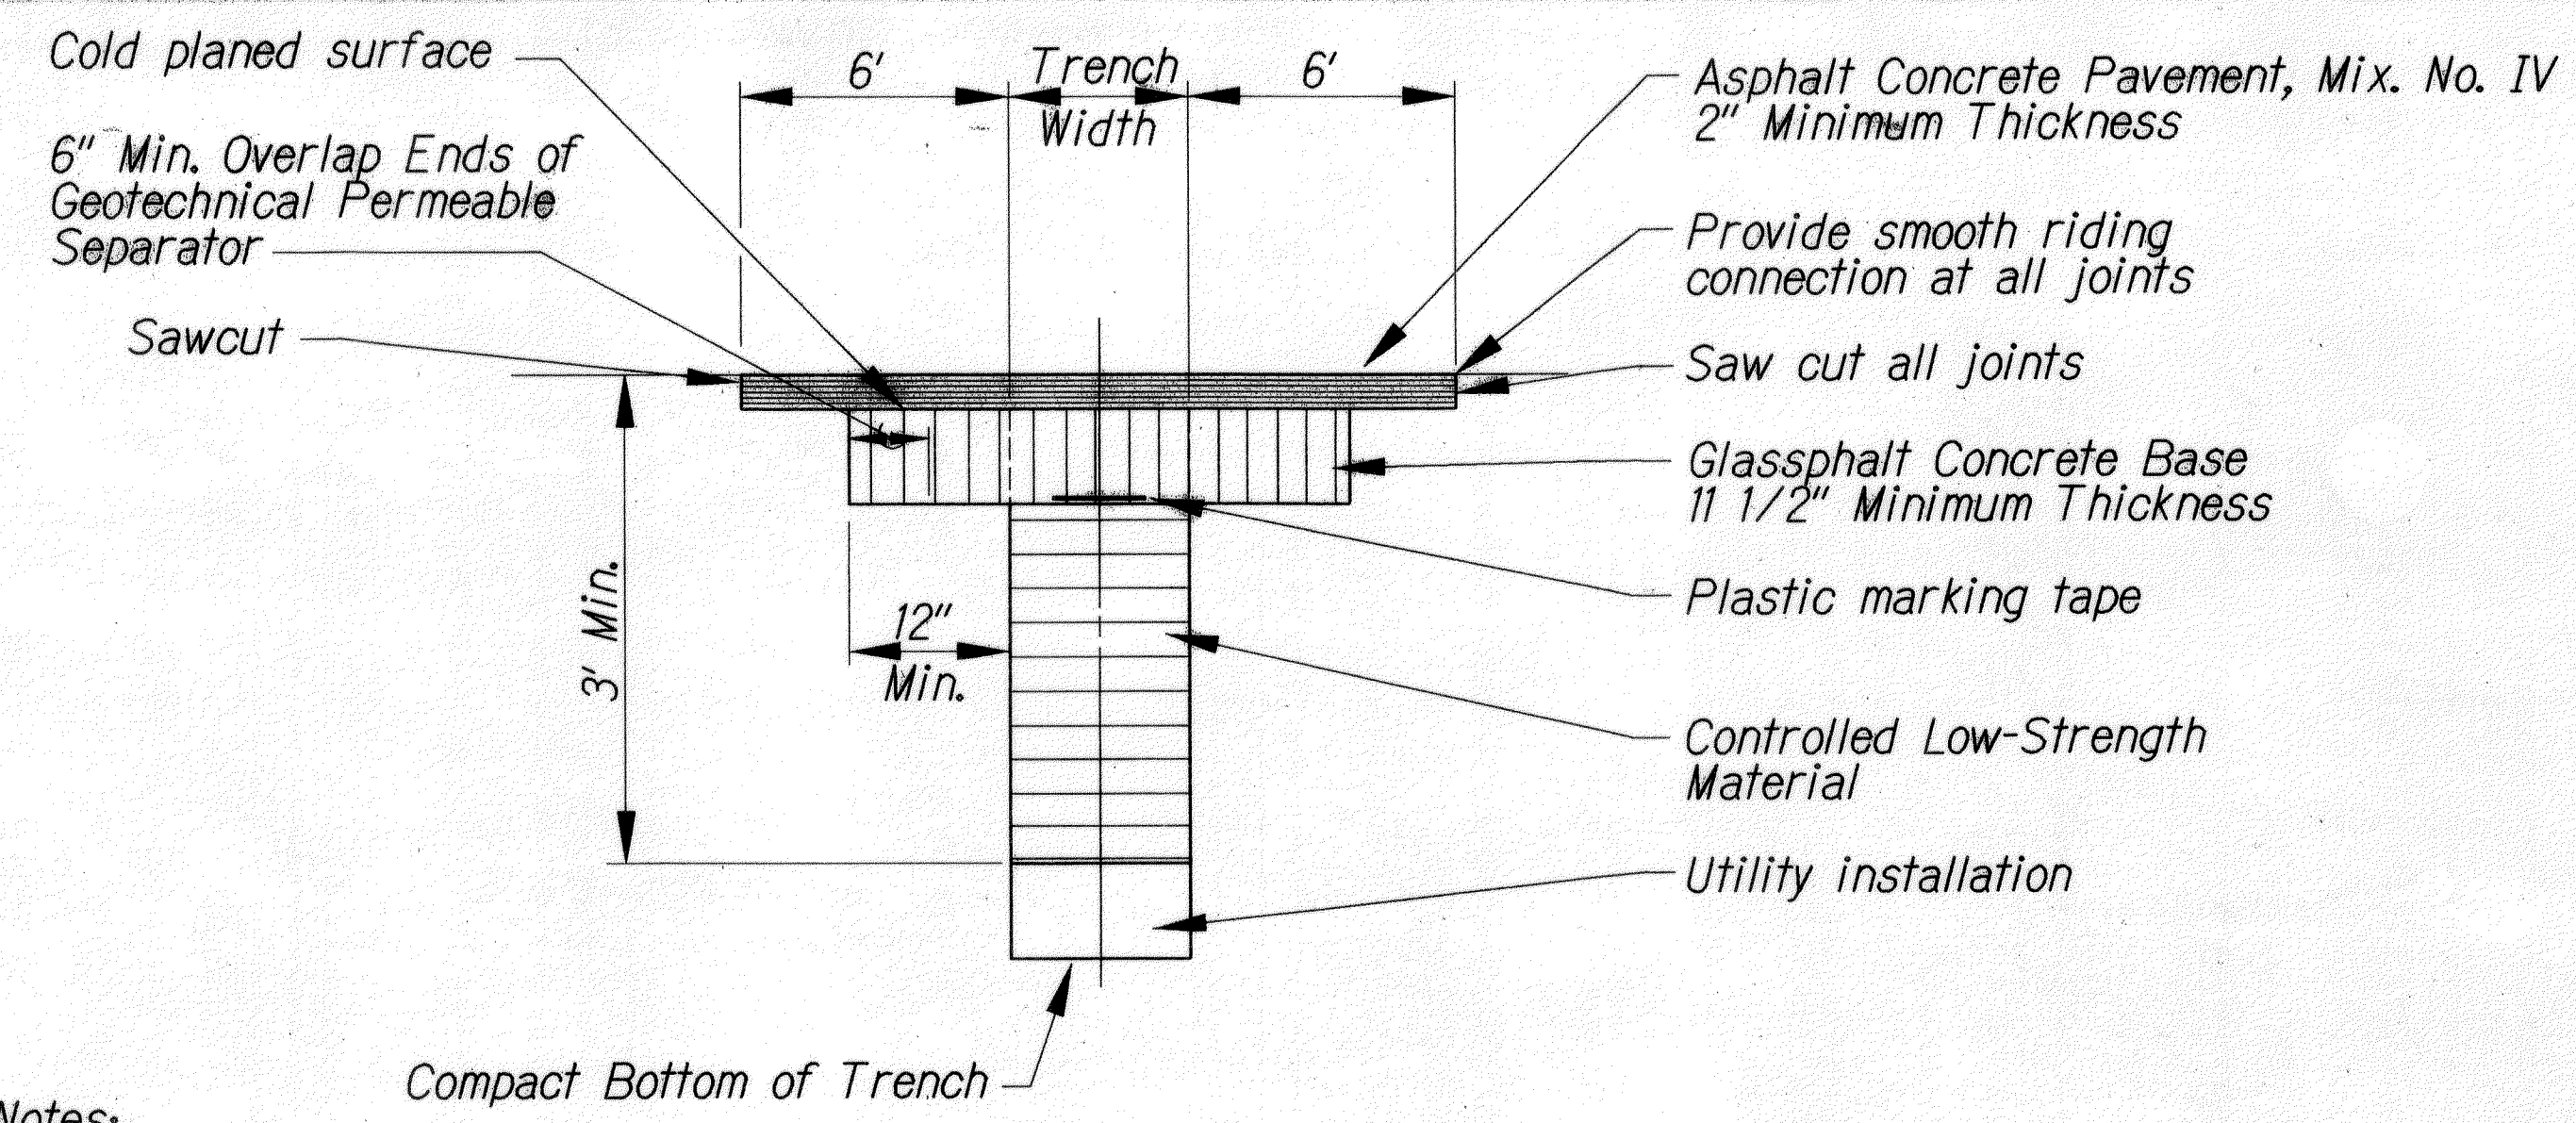

Notes:


1. Tack coat faces of existing asphalt bound materials prior to filling excavation with new asphalt bound materials.
2. All work performed shall be subject to inspection by the State and shall be to the State's satisfaction.
3. Construct the trench restoration in accordance with the Hawaii Standard Specifications for Road, Bridge, and Public Works Construction and its special provisions, and the specification of Installation of Miscellaneous Improvements within State Highways.
4. Pavement Smoothness
 - A. Obtain a profile of the existing roadway surface that is to have a new surface as a result of the Restoration of the trench excavation and submit the profile to the District Engineer before any work for trench excavation begins.
 - B. Obtain a profile of the roadway surface after the roadway surface has been repaved and submit the profile to the District Engineer. The profile of the roadway surface after repaving shall be equal to or smoother than the profile obtained before trench excavation began.
 - C. The distance from the paved surface to the testing edge of ten-foot long straight edge between two points of contact shall not exceed 3/16 Inch.
5. Place all unbound materials in the trench as follows:
 - A. Compaction by water jetting or ponding is not permitted.
 - B. All unbound materials, except the permeable base and ASTM C-33 Size 67:
 - Place material in accordance with Subsection 206.03 (E) Structure and Trench Backfill of the Hawaii Standard Specifications for Road, Bridge, and Public Works Construction.
 - Take one compaction test for 300 lineal feet of trench. Submit compaction test results to the District Engineer.
 - C. Permeable Base:
 - Place permeable material in uniform horizontal layer not exceeding 9 Inches in compacted thickness.
 - Compact each layer with 8 passes of a vibrating plate compactor. Use hand tamper if trench too narrow to accommodate the vibrating plate compactor.
 - D. ASTM C-33, Size 67:
 - I. Material placed under water need not be compacted.
 - II. Material Placed Above Water:
 - I. Place material in uniform horizontal layer not exceeding 9 inches in loose thickness.
 - II. Compact each layer with 8 passes of a vibrating plate compactor. Use hand tamper if trench too narrow to accommodate the vibrating plate compactor.

**ASPHALT PAVEMENT RESTORATION
OVER TRENCH EXCAVATION (CITY & STATE)**

No Scale

RE-APPROVAL
M. [Signature] 5/14/10
CHIEF, CIVIL ENGINEERING BRANCH, DPP WY DATE

Approved By:
M. [Signature] 6/8/07
Chief, Civil Engineering Branch, DPP WY Date

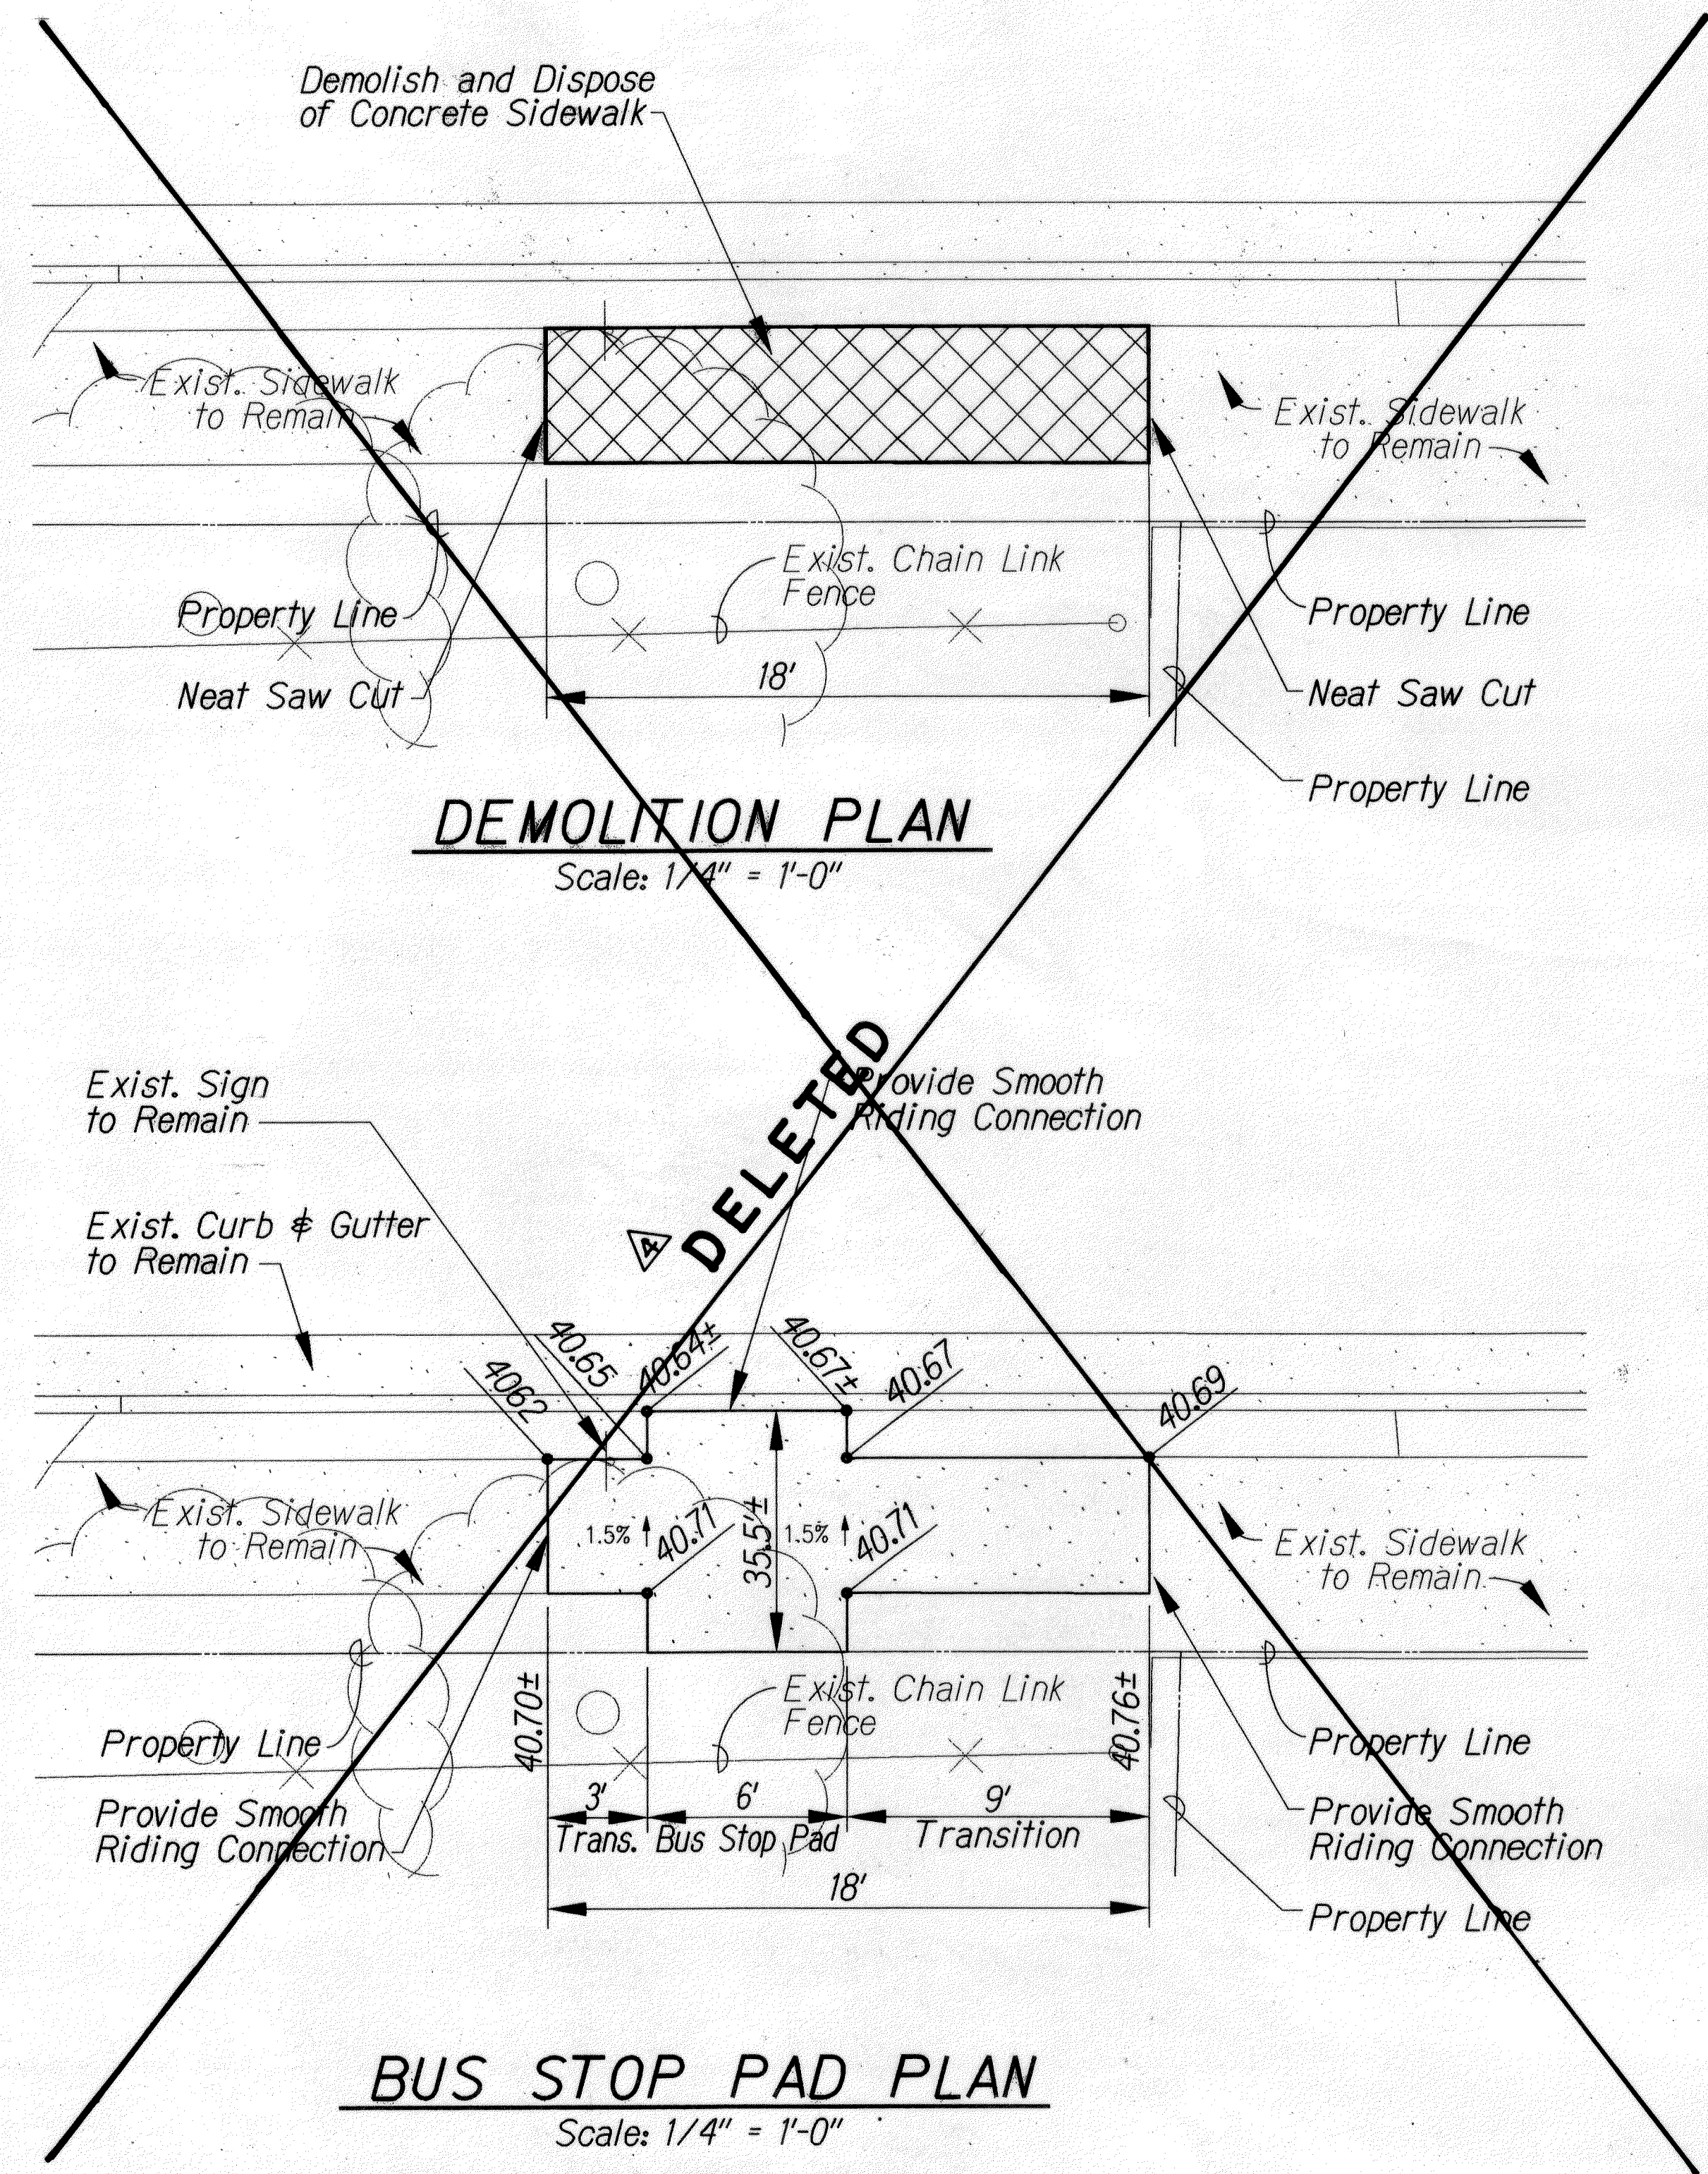

REV.	DATE	DESCRIPTION	BY	TRD	NWB	CEB	BNS
1	10-27-10	DELETED BUS STOP PAD DETAILS	ECI				
2	11/24/10	RE-APPROVAL DUE TO TIME LAPS UPDATE STAMP	ECI				
3	04-30-12	BRIEF	BY	TRD	NWB	CEB	BNS

Craig S. Araki
LICENSED PROFESSIONAL ENGINEER
No. 5510-C
HAWAII, U.S.A.

LICENSE EXP. DATE 04-30-12
THIS WORK WAS PREPARED BY ME OR UNDER MY SUPERVISION AND CONSTRUCTION OF THIS PROJECT WILL BE UNDER MY OBSERVATION AS DEFINED IN HAWAII TITLE 16, CHAPTER 115, RULES OF THE BOARD OF PROFESSIONAL ENGINEERS, ARCHITECTS AND SURVEYORS, STATE OF HAWAII.
Craig S. Araki


STATE OF HAWAII
DEPARTMENT OF TRANSPORTATION
HIGHWAYS DIVISION

MISCELLANEOUS DETAILS


INTERSTATE ROUTE H-1
Kalihi Street Off-Ramp Improvements
Vicinity Of Queen's Medical Center
Federal-Aid Project No. TC-HI-K(258)
Scale: As Shown
Date: Dec. 2006

SHEET No. 1 OF 2 SHEETS

FED. ROAD DIST. NO.	STATE	FED. AID PROJ. NO.	FISCAL YEAR	SHEET NO.	TOTAL SHEETS
HAWAII	HAW.	TC-H1-1(258)	2006	C.O. 29 S-1	89

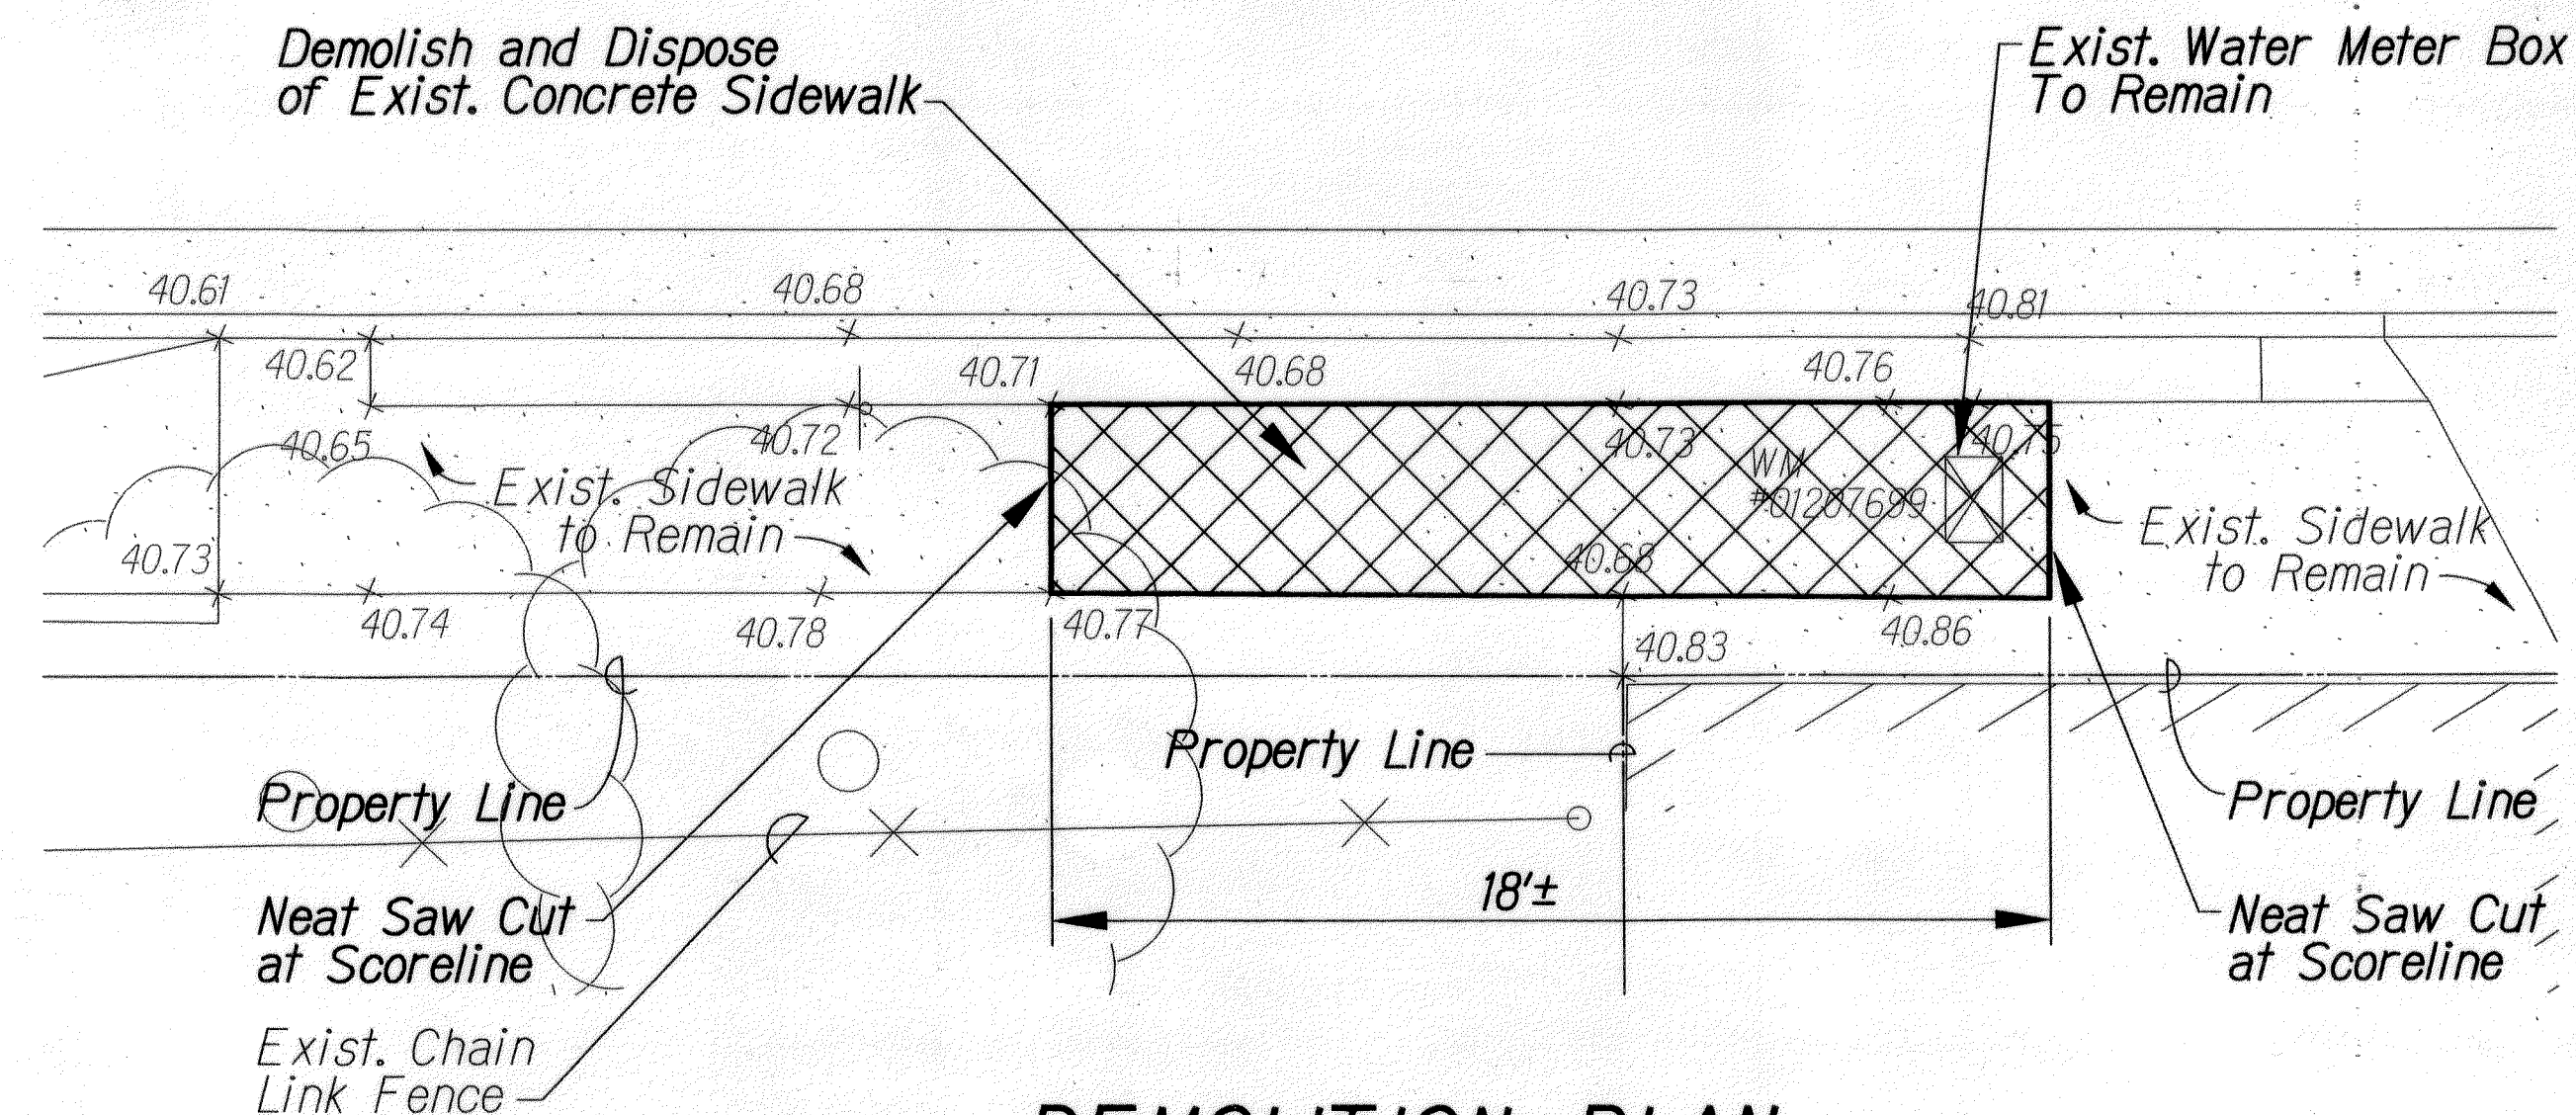

DEMOLITION PLAN
Scale: 1/4" = 1'-0"

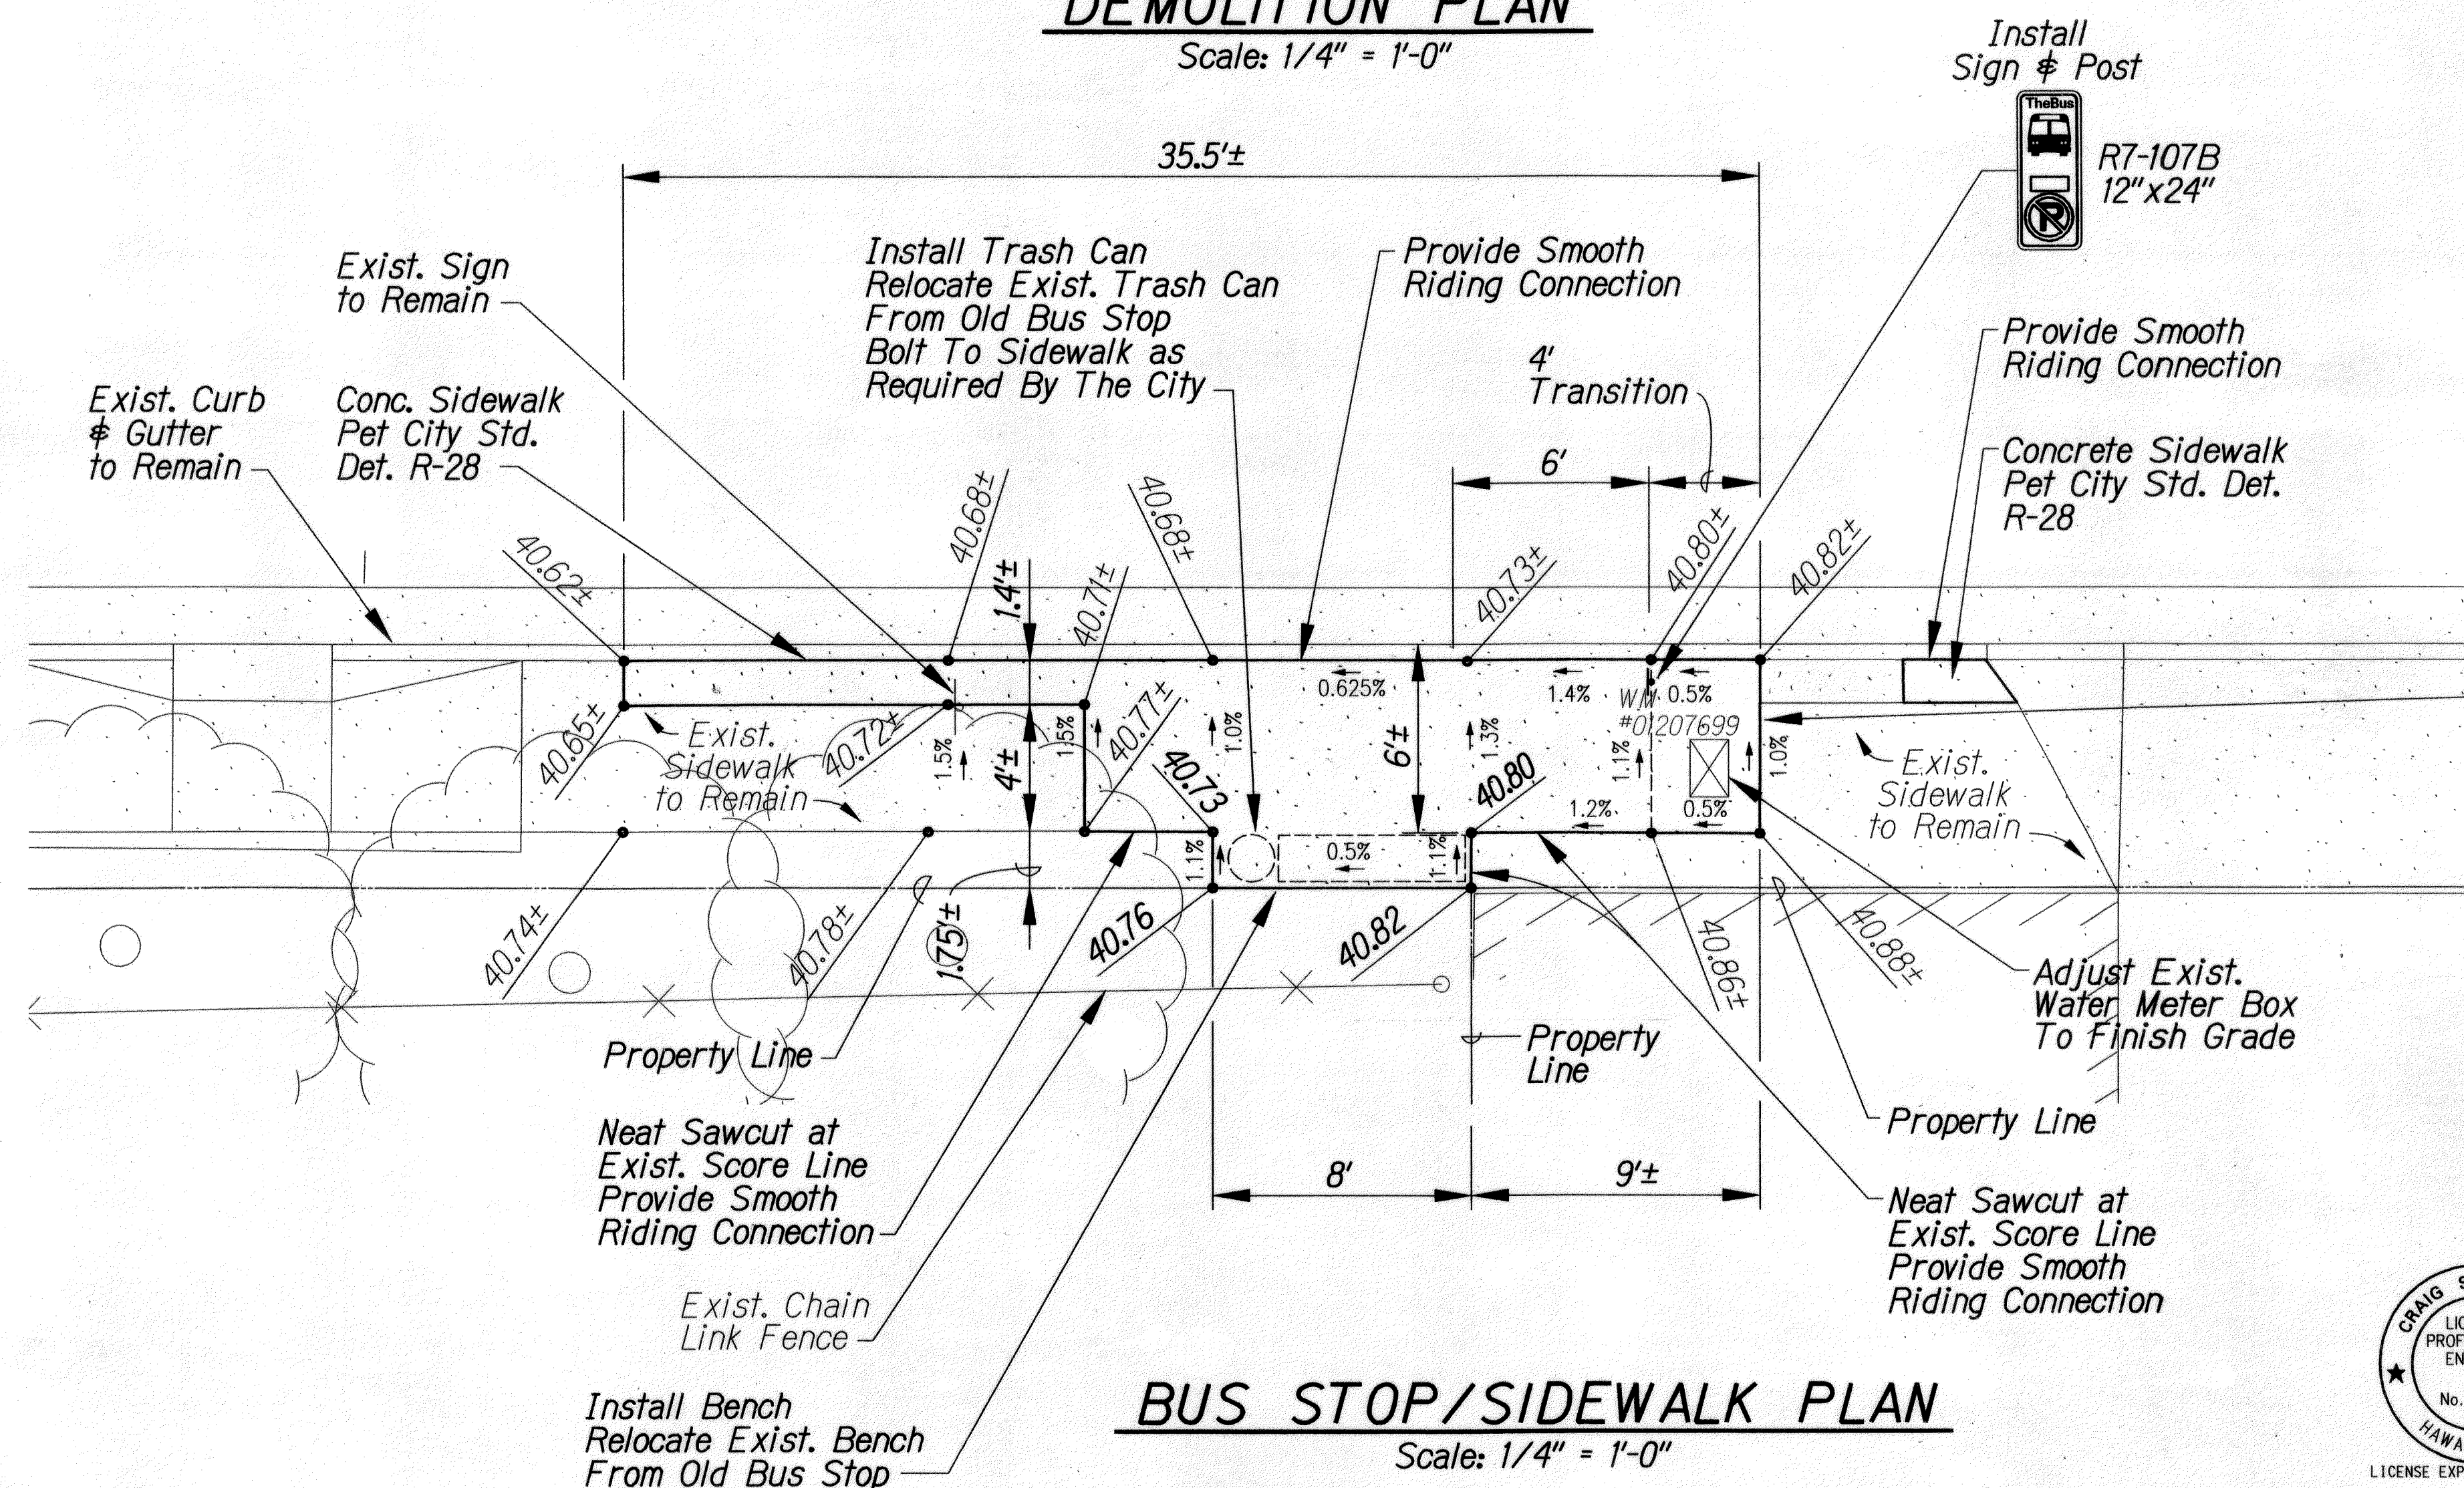

BUS STOP/SIDEWALK PLAN
Scale: 1/4" = 1'-0"

Note:
The Contractor Shall Verify Location Of Trash Can And Bench With Lowell Tom Prior To Installation.



SURVEY PLOTTED BY	DATE
DRAWN BY	
DESIGNED BY	
QUANTITIES BY	
CHECKED BY	
ORIGINAL PLAN	
NOTE BOOK	
No.	

Approved By:
M. J. [Signature] 11/26/10
Chief, Civil Engineering Branch, DPP and Date

CRAIG S. ARAKAWA
LICENSED PROFESSIONAL ENGINEER
No. 5510-C
HAWAII, U.S.A.
LICENSE EXP. DATE 04-30-12
THIS WORK WAS PREPARED BY ME OR UNDER MY SUPERVISION AND CONSTRUCTION OF THIS PROJECT WILL BE UNDER MY OBSERVATION AS DEFINED IN HAWAII TITLE 16, CHAPTER 115, RULES OF THE BOARD OF PROFESSIONAL ENGINEERS, ARCHITECTS AND SURVEYORS, STATE OF HAWAII.
Craig S. Arakawa



10/27/10	REVISED BUS STOP PAD PLAN
REV. DATE	REVISION
STATE OF HAWAII DEPARTMENT OF TRANSPORTATION HIGHWAYS DIVISION	
BUS STOP/SIDEWALK PLAN	
INTERSTATE ROUTE H-1 Kinai Street Off-Ramp Improvements Vicinity Of Queen's Medical Center Federal-Aid Project No. TC-H1-1(258)	
Scale: As Shown	Date: Dec. 2006
SHEET No. 1 OF 2 SHEETS	

FED. ROAD DIST. NO.	STATE	FED. AID PROJ. NO.	FISCAL YEAR	SHEET NO.	TOTAL SHEETS
HAWAII	HAW.	TE-HI-K(258)	2006	30	89

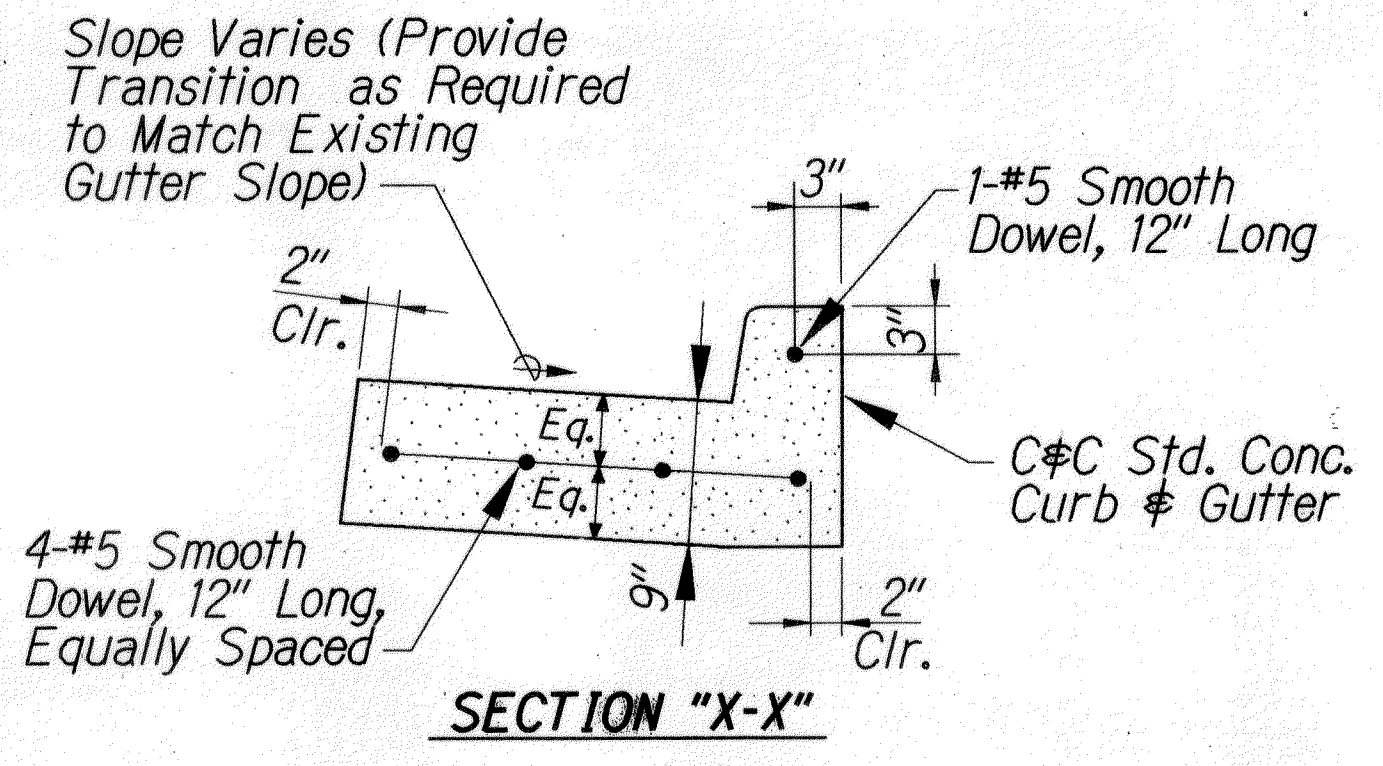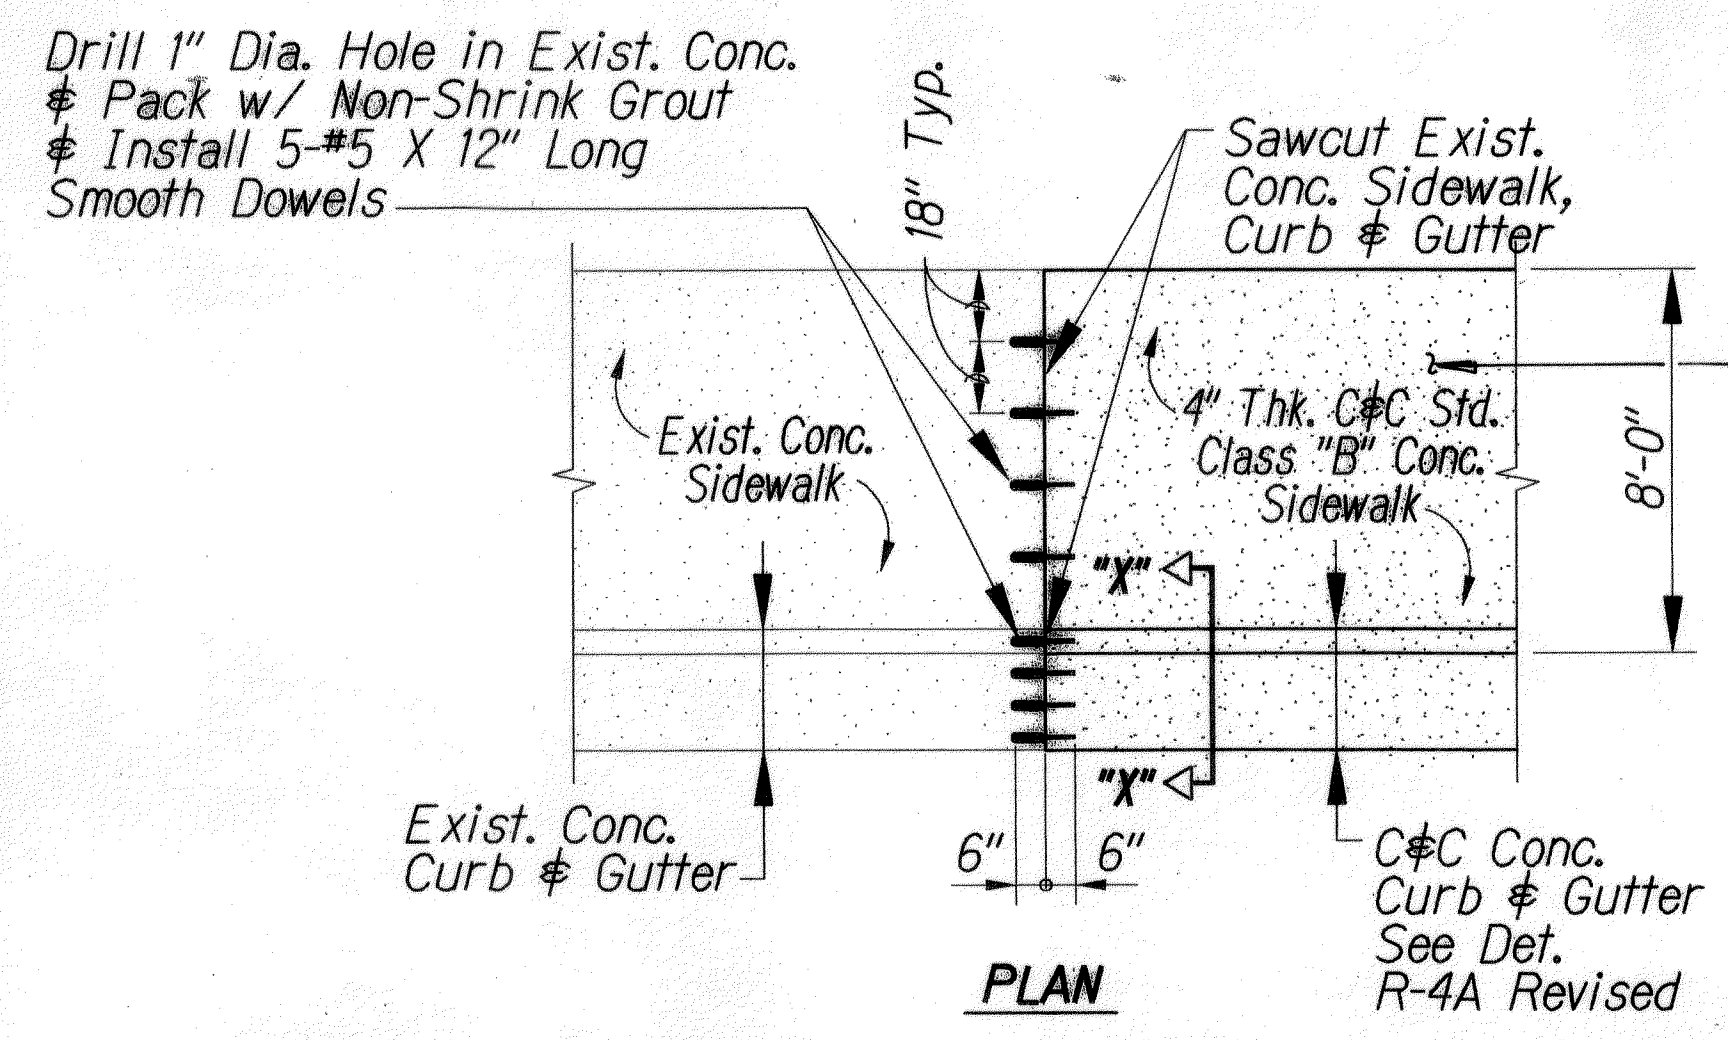


CONNECTION TO EXISTING SIDEWALK, CURB & GUTTER (W/IN CITY ROW)

No Scale

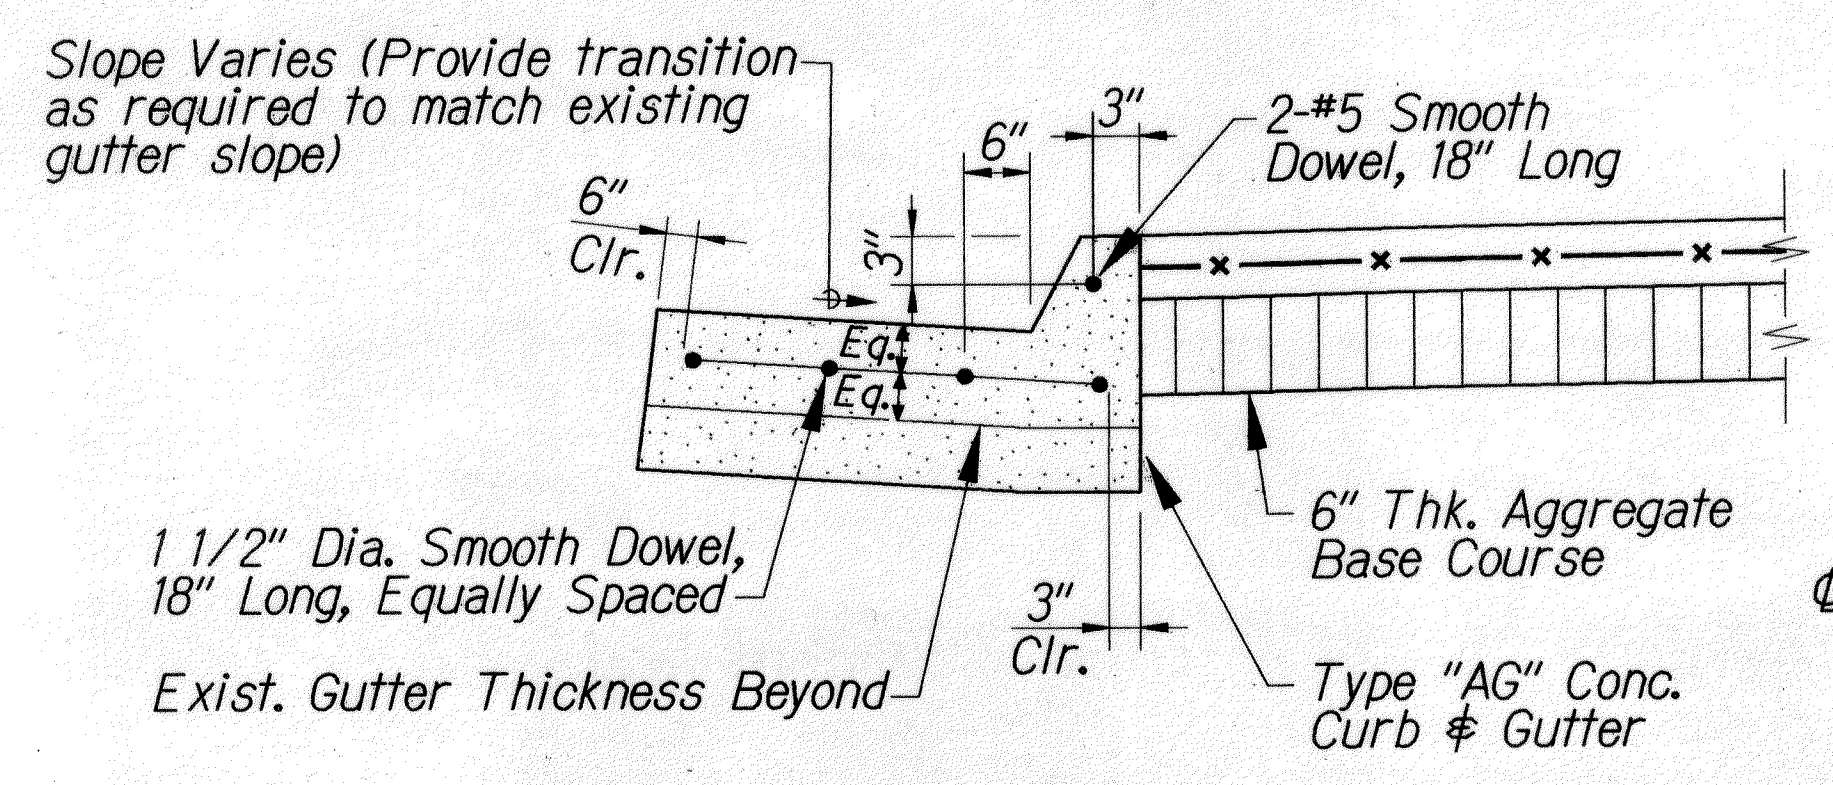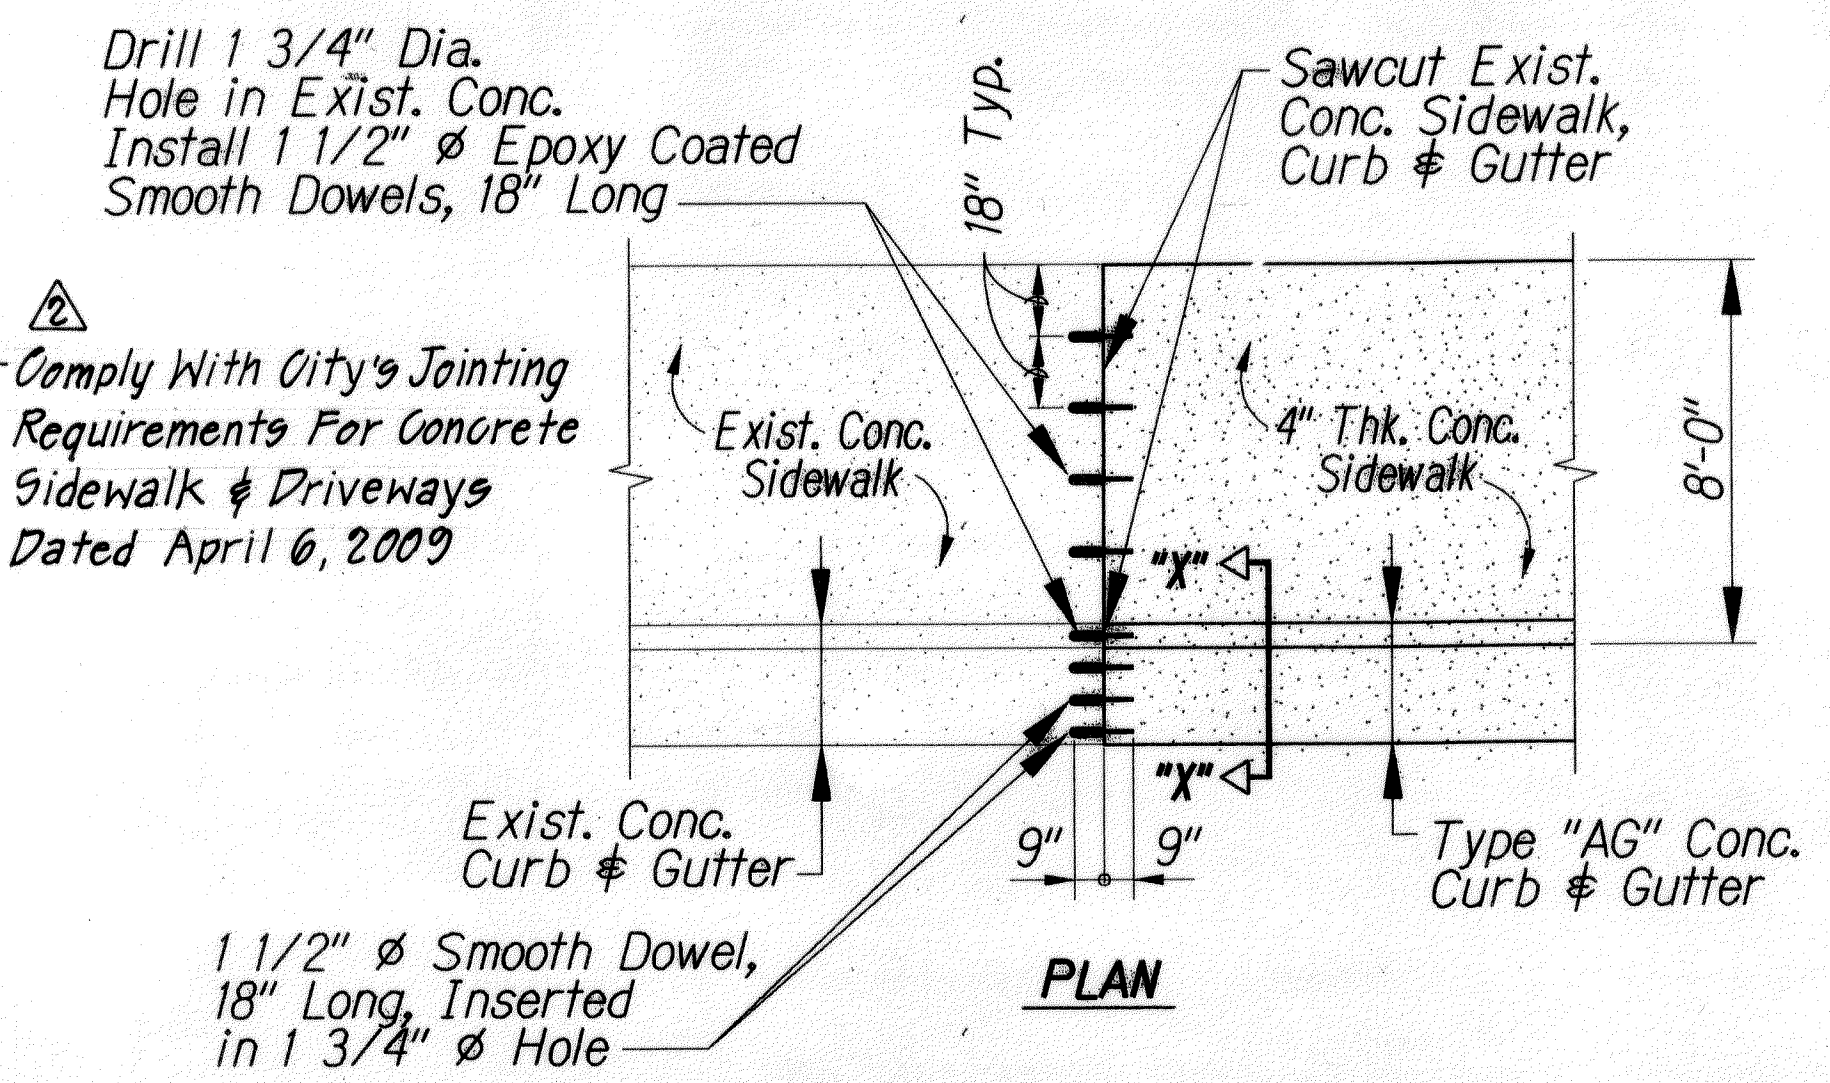


CONNECTION TO EXISTING SIDEWALK, CURB & GUTTER (W/IN STATE ROW)

No Scale

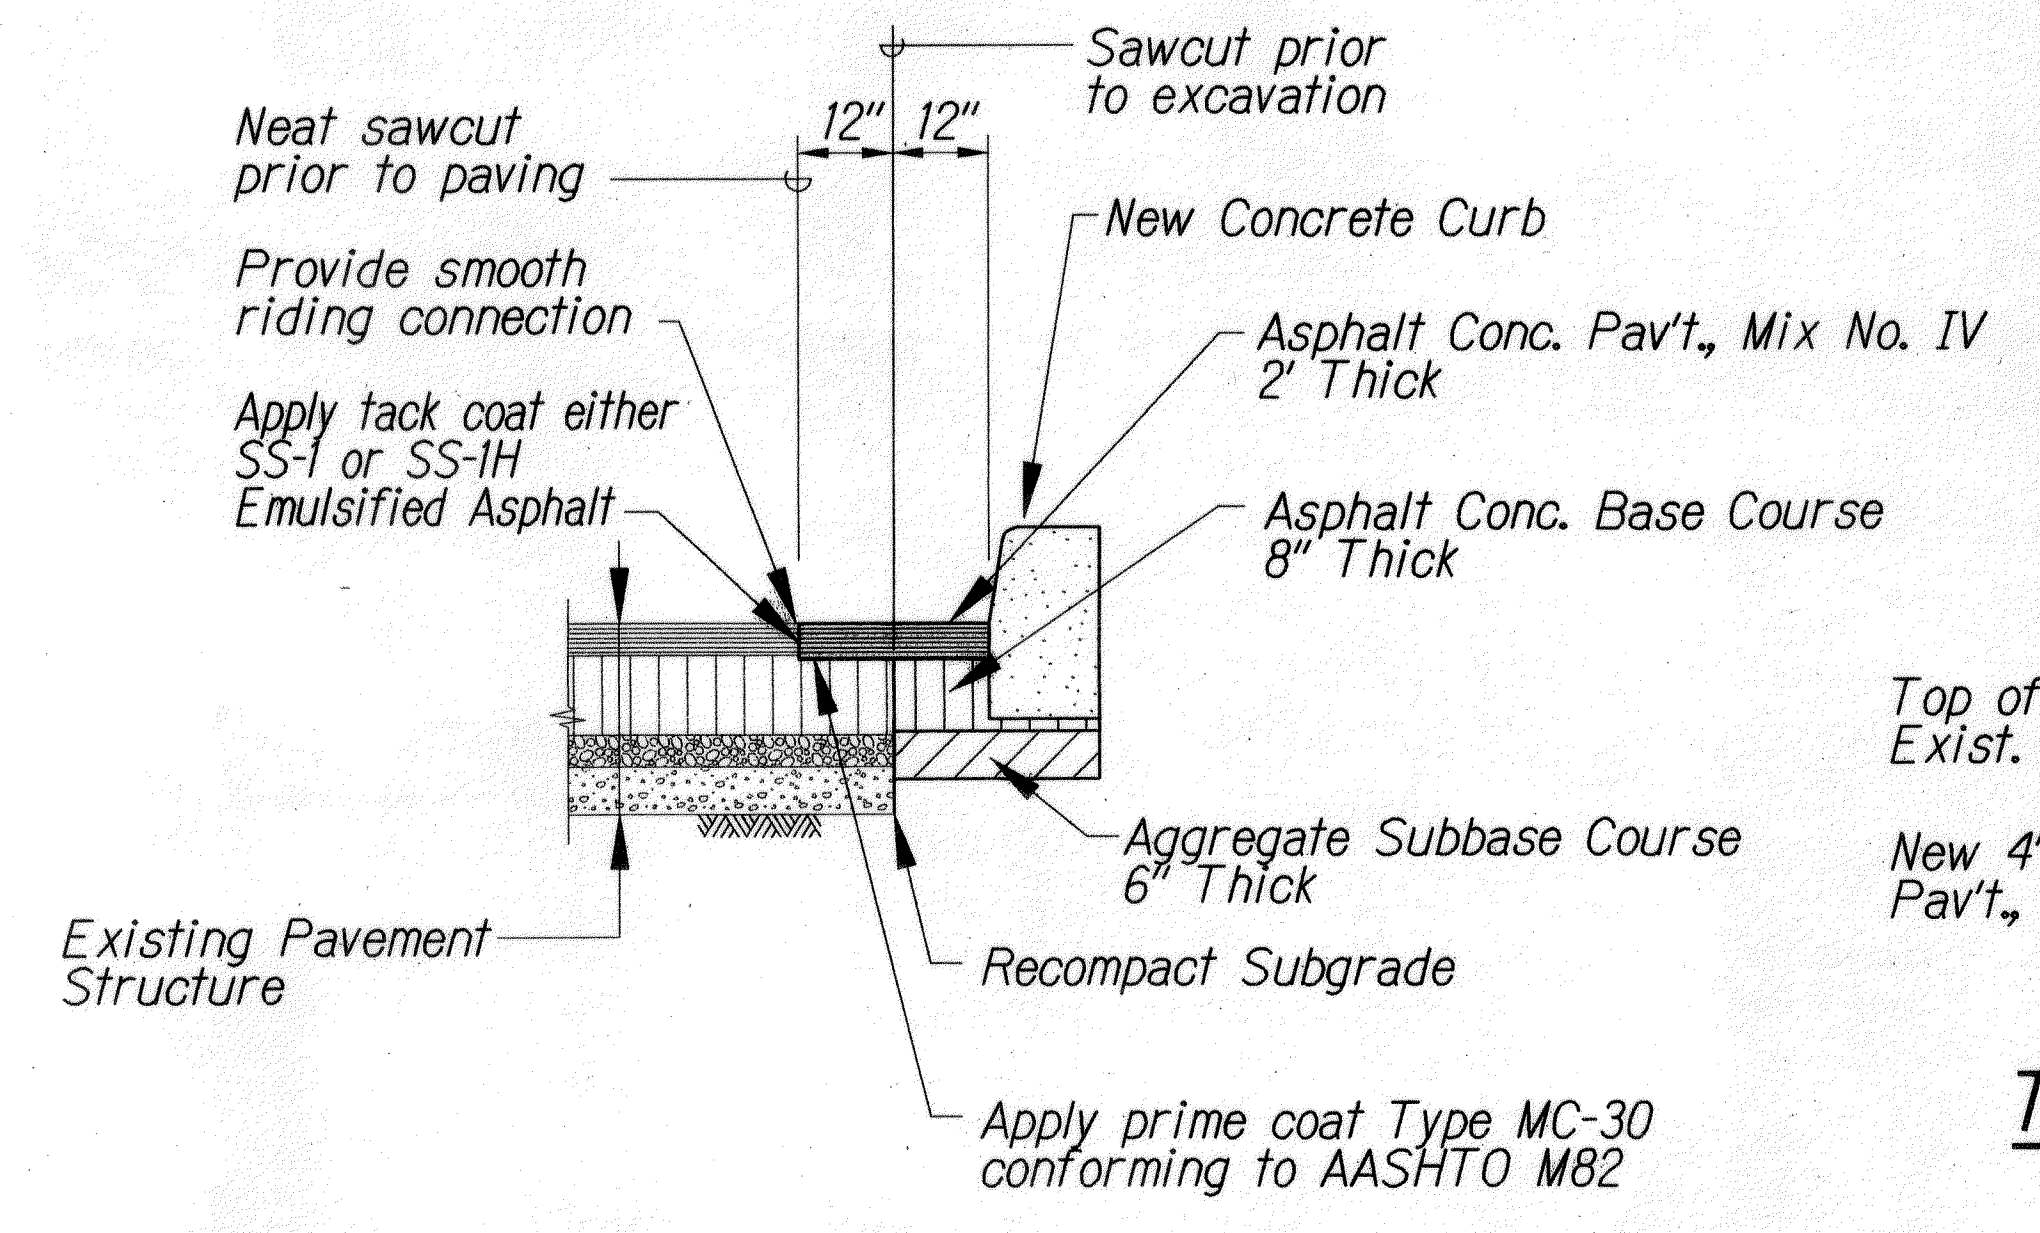

CONNECTION TO EXIST. ASPHALT CONCRETE

No Scale

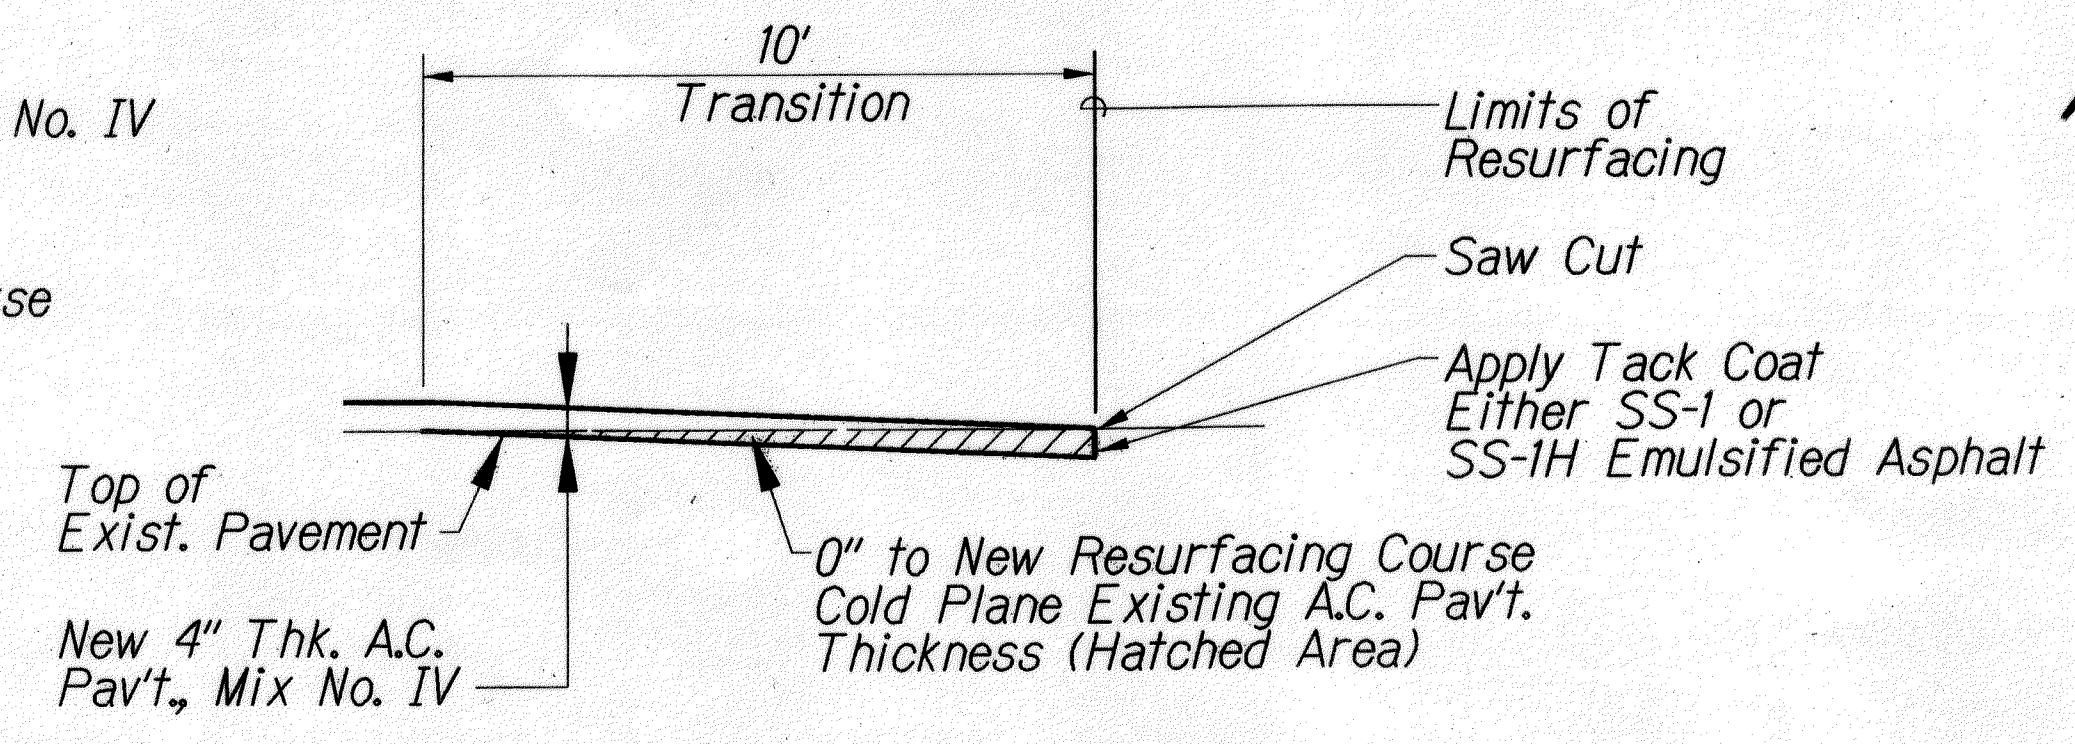

COLD PLANED TRANSITION TO EXISTING A.C. PAVEMENT

No Scale

RE-APPROVAL


M. J. P. 5/14/10

CHIEF, CIVIL ENGINEERING BRANCH, DPP W/ DATE

Approved By:

M. J. P. 6/8/07

Chief, Civil Engineering Branch, DPP W/ DATE

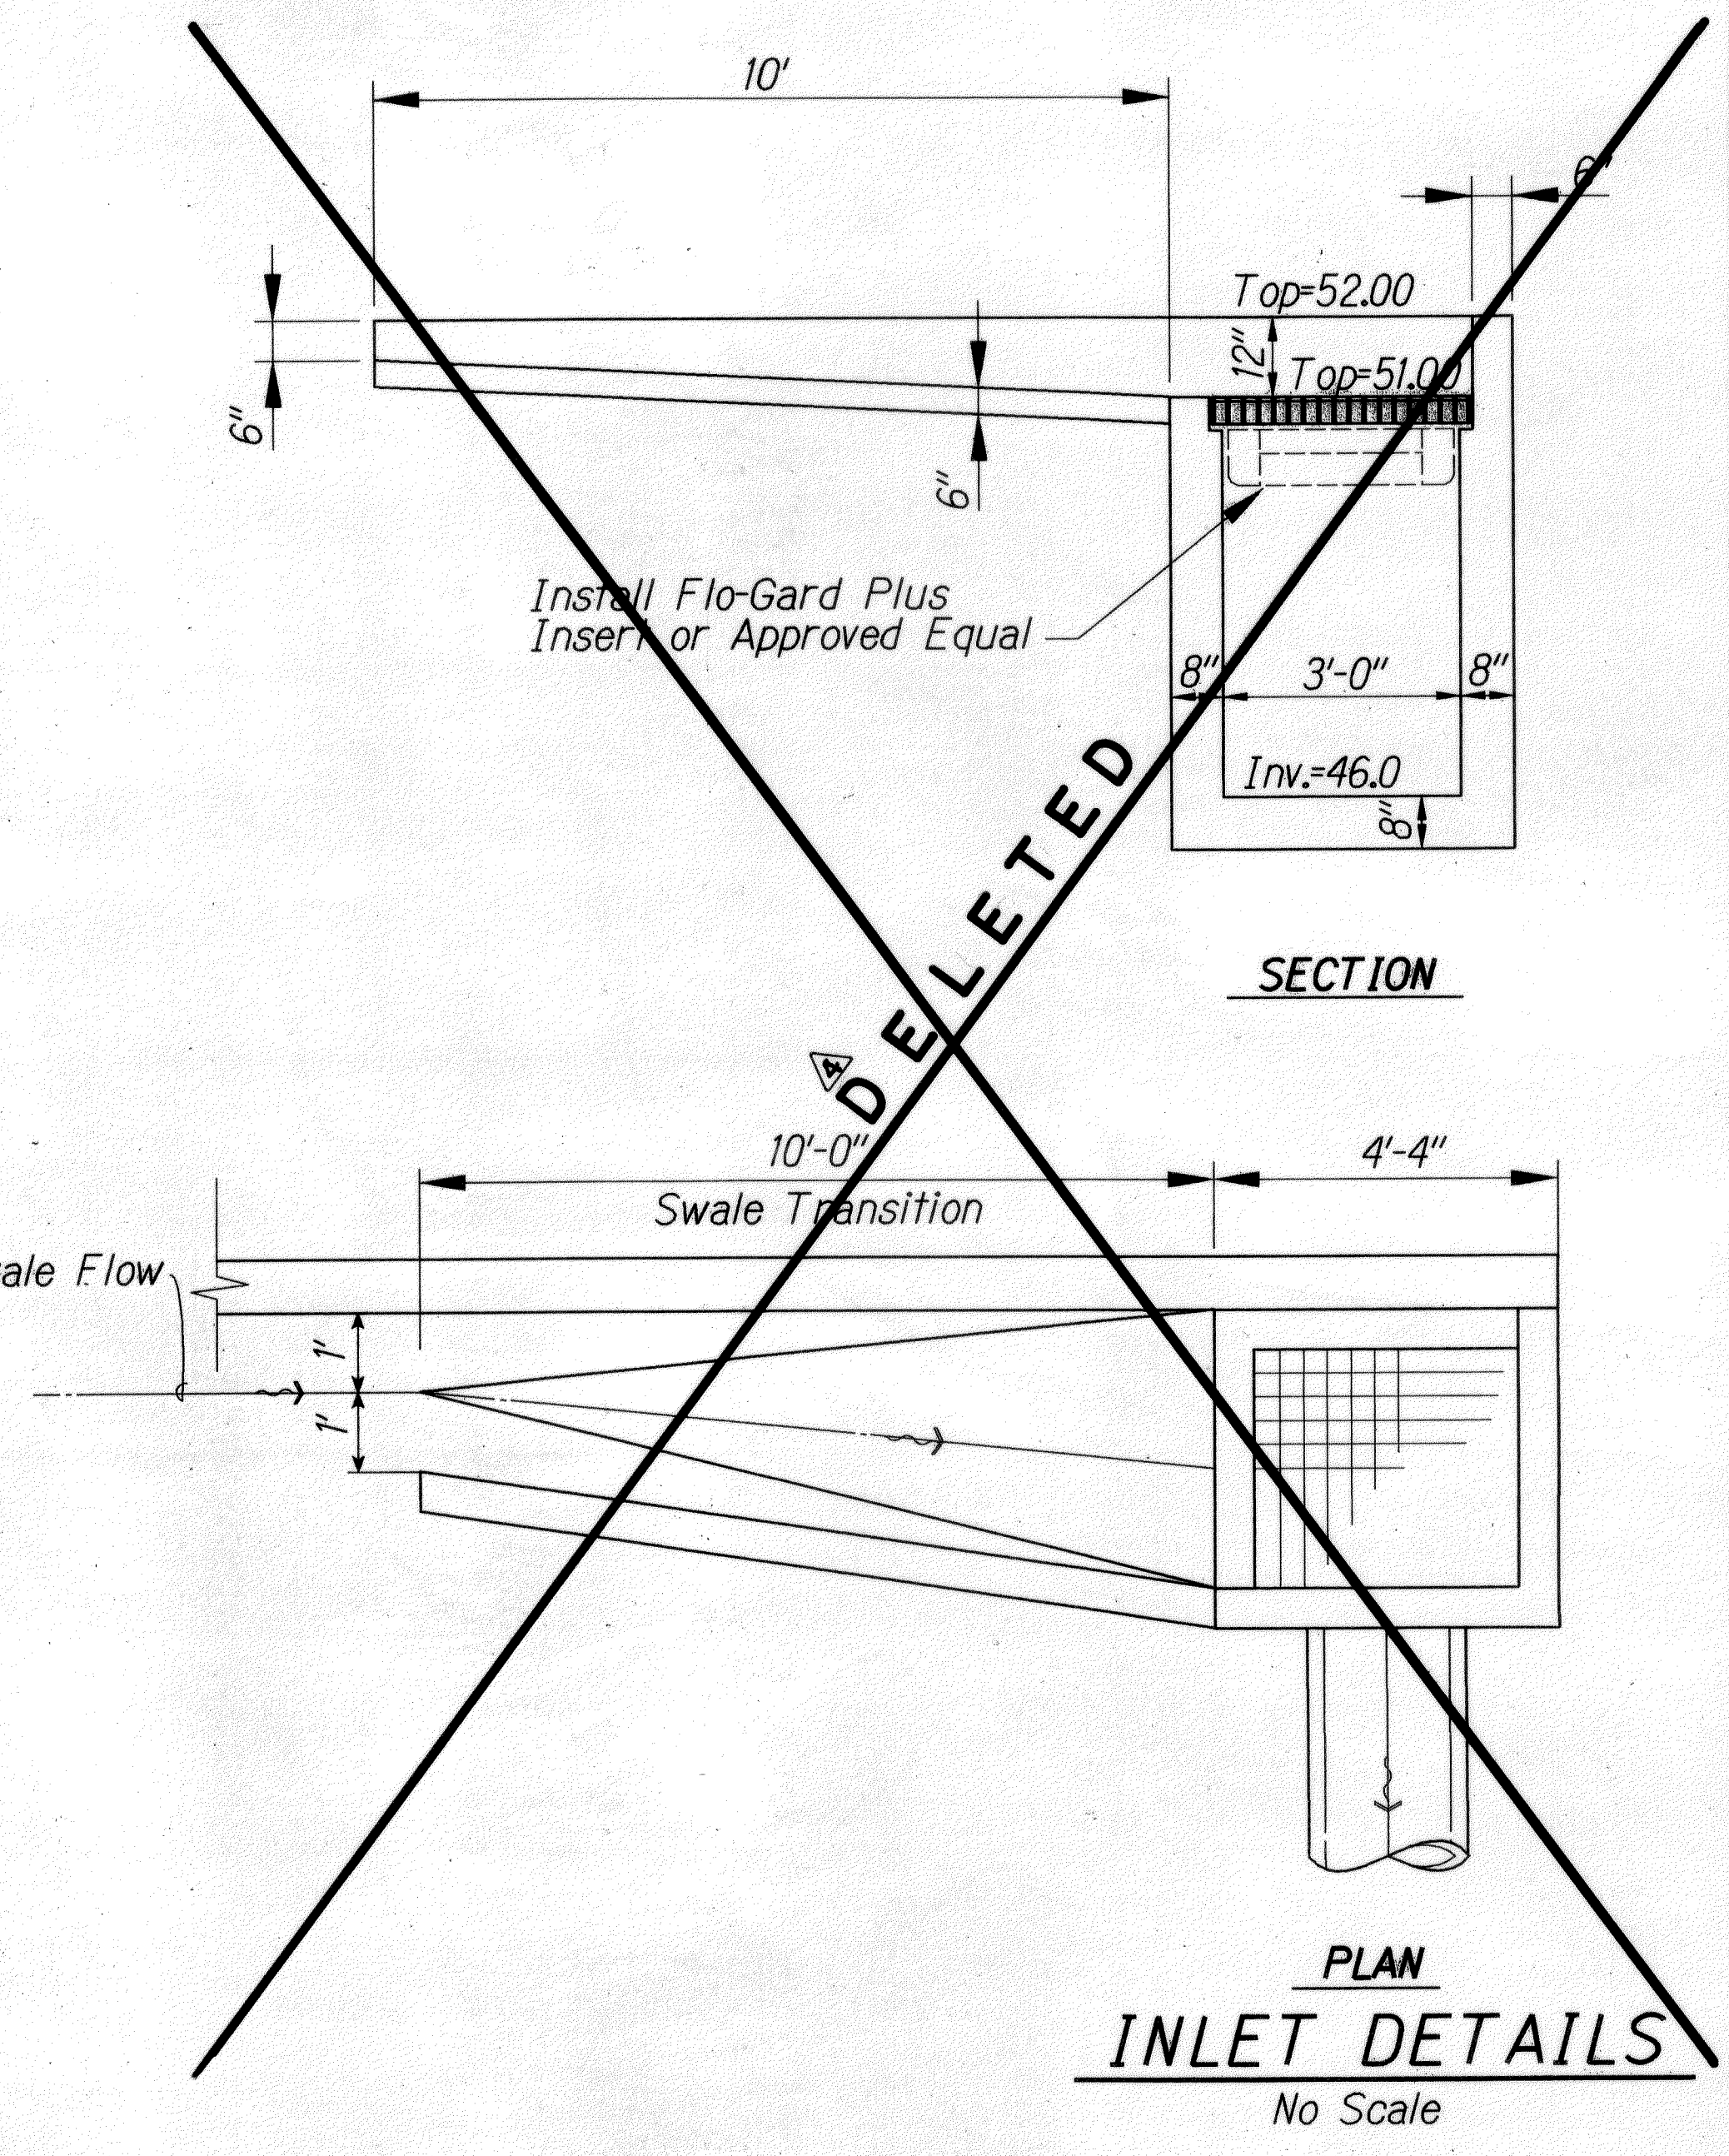

DESIGNED BY	DATE
DRAWN BY	
CHECKED BY	
IN CHARGE	
NOTED BY	
QUANTITIES BY	
CHECKED BY	

CRAIG S. ARAKAKI

LICENSED PROFESSIONAL ENGINEER

No. 5510-C

HAWAII, U.S.A.


LICENSE EXP. DATE 04-30-12

THIS WORK WAS PREPARED BY ME OR UNDER MY SUPERVISION AND CONSTRUCTION OF THIS PROJECT WILL BE UNDER MY OBSERVATION AS DEFINED IN HAWAII TITLE 16, CHAPTER 115, RULES OF THE BOARD OF PROFESSIONAL ENGINEERS, ARCHITECTS AND SURVEYORS, STATE OF HAWAII.


CRIG S. ARAKAKI

STATE OF HAWAII
DEPARTMENT OF TRANSPORTATION
HIGHWAYS DIVISION
MISCELLANEOUS DETAILS
INTERSTATE ROUTE H-1
Kinu Street Off-Ramp Improvements
Vicinity Of Queen's Medical Center
Federal-Aid Project No.TC-HI-K(258)
Scale: As Shown Date: Dec. 2006
SHEET No. 2 OF 2 SHEETS


FED. ROAD DIST. NO.	STATE	FED. AID PROJ. NO.	FISCAL YEAR	SHEET NO.	TOTAL SHEETS
HAWAII	HAW.	TC-HI-1(258)	2006	C.O.30S-1	89

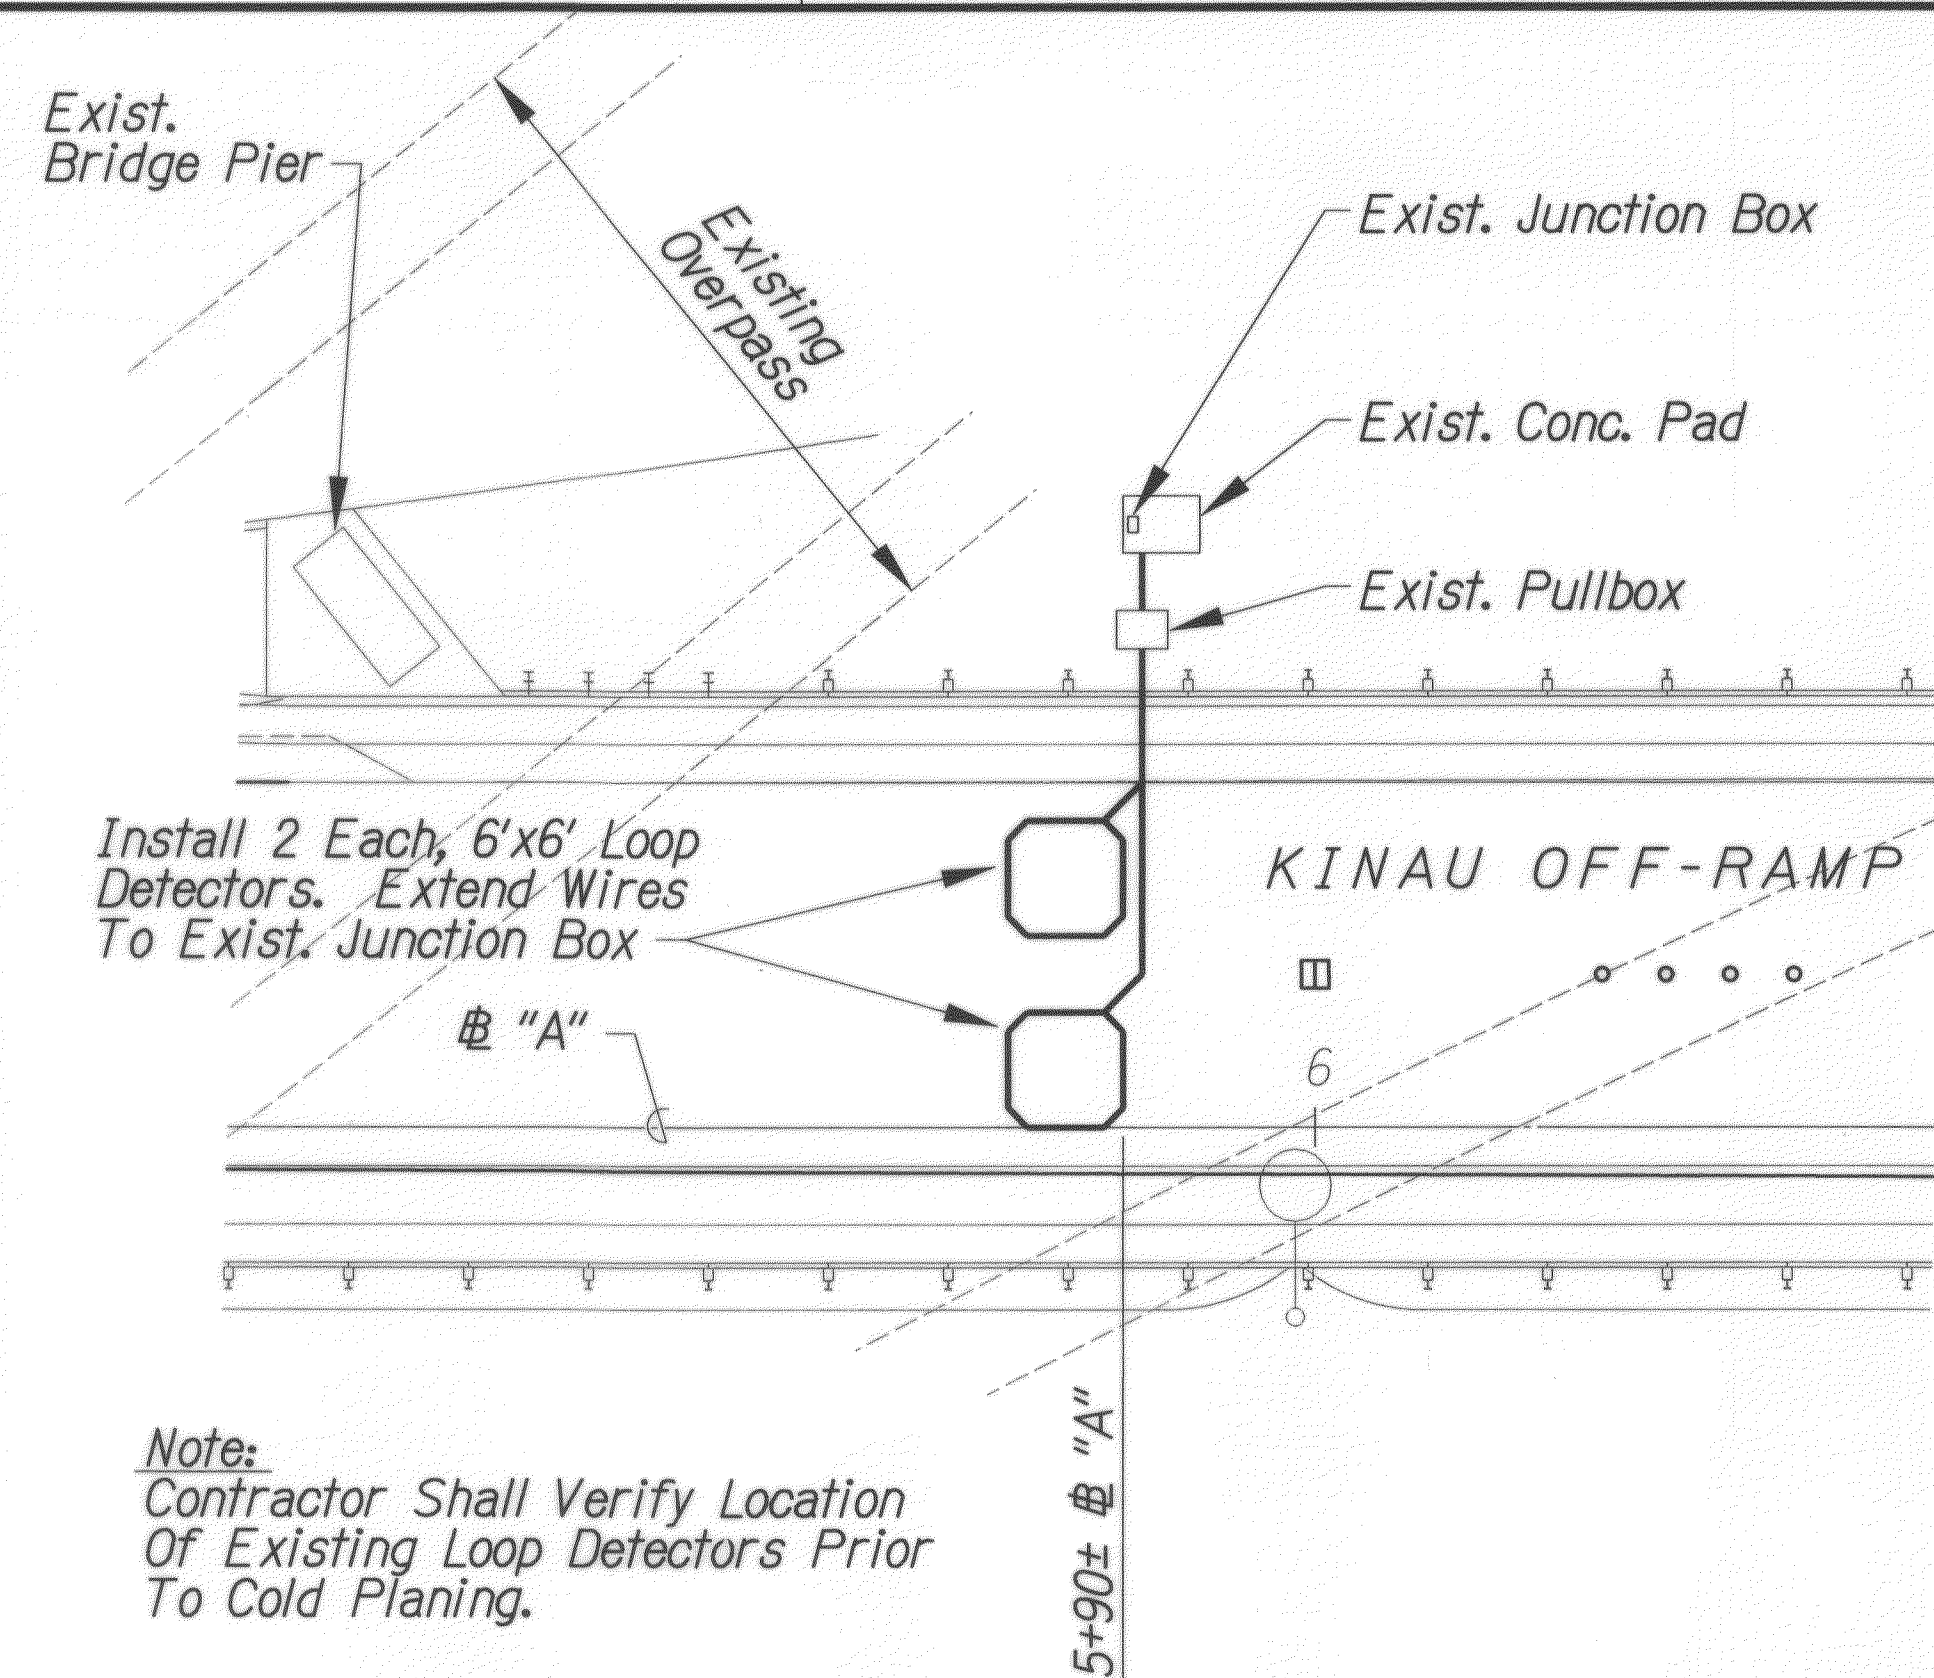


PLAN-LOOP DETECTOR LAYOUT @ 5+90 # "A"
Scale: 1" = 10'

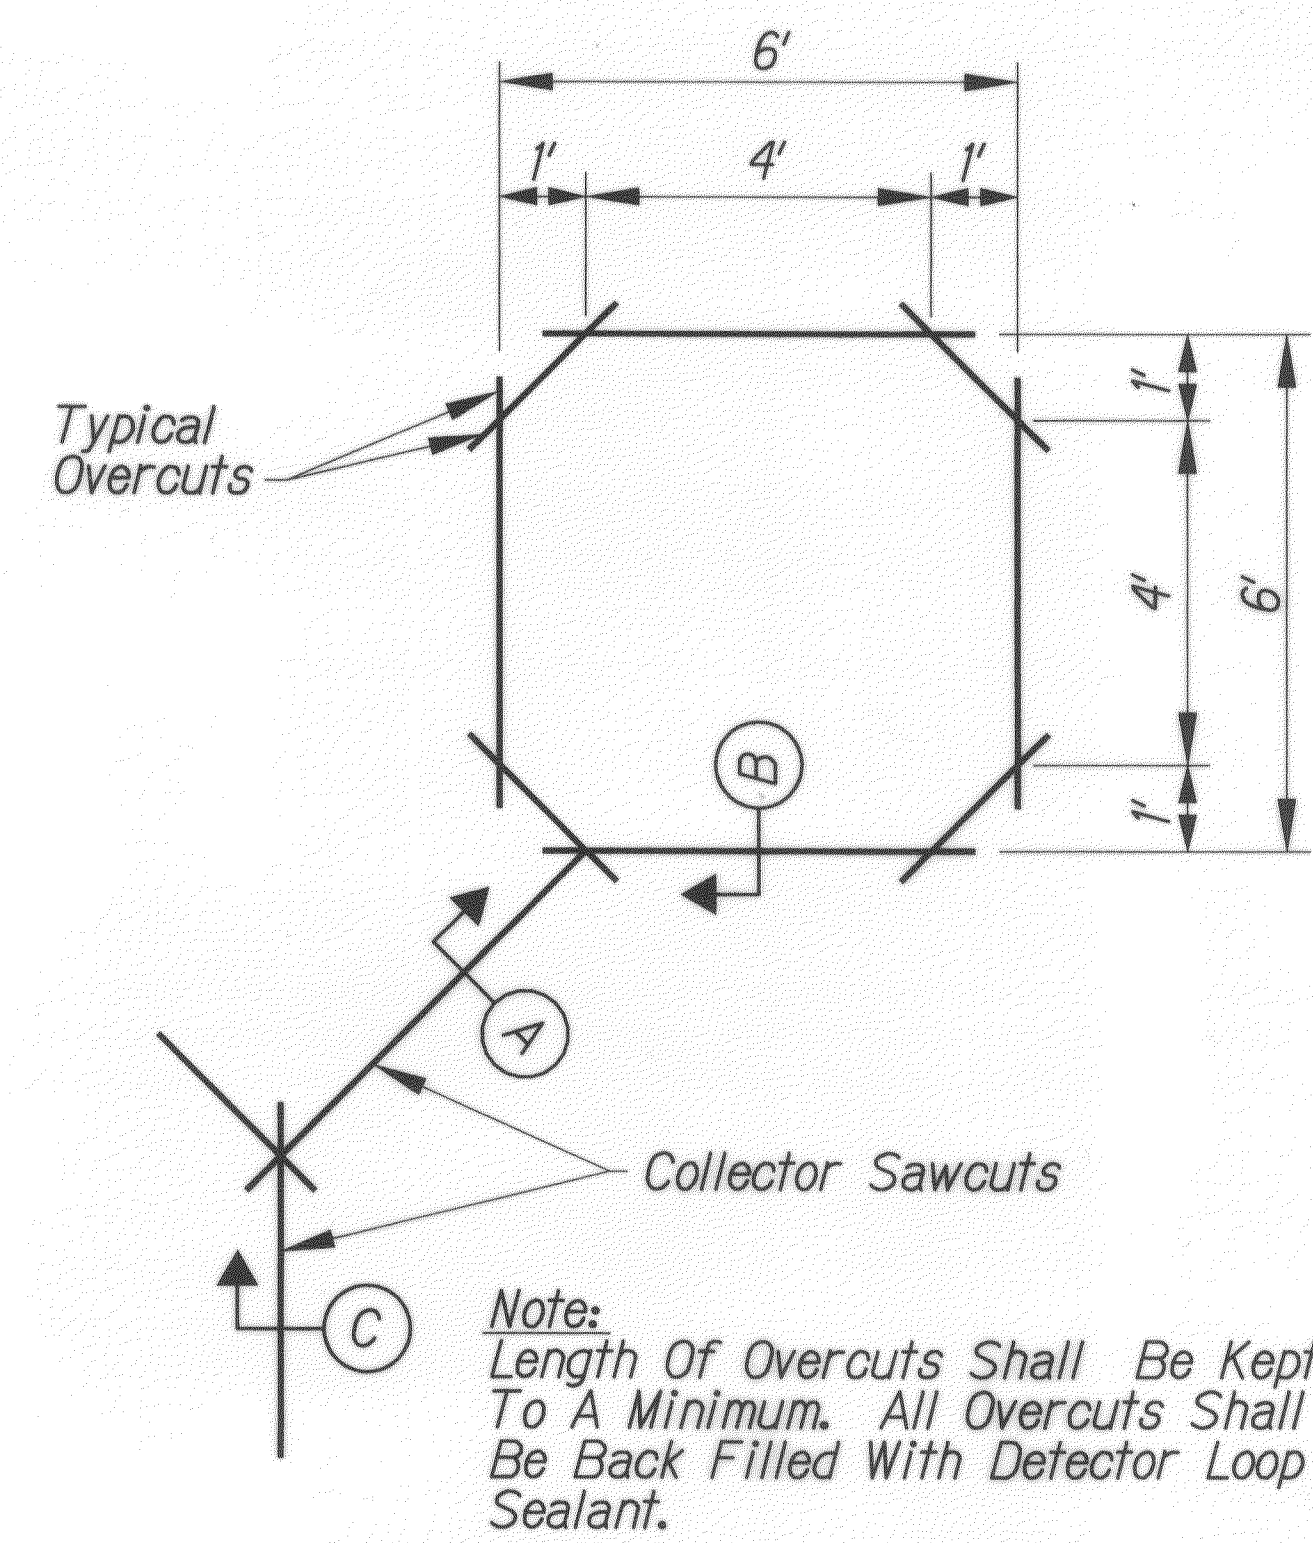


TYPICAL DETECTOR LOOP SAWCUT DETAIL

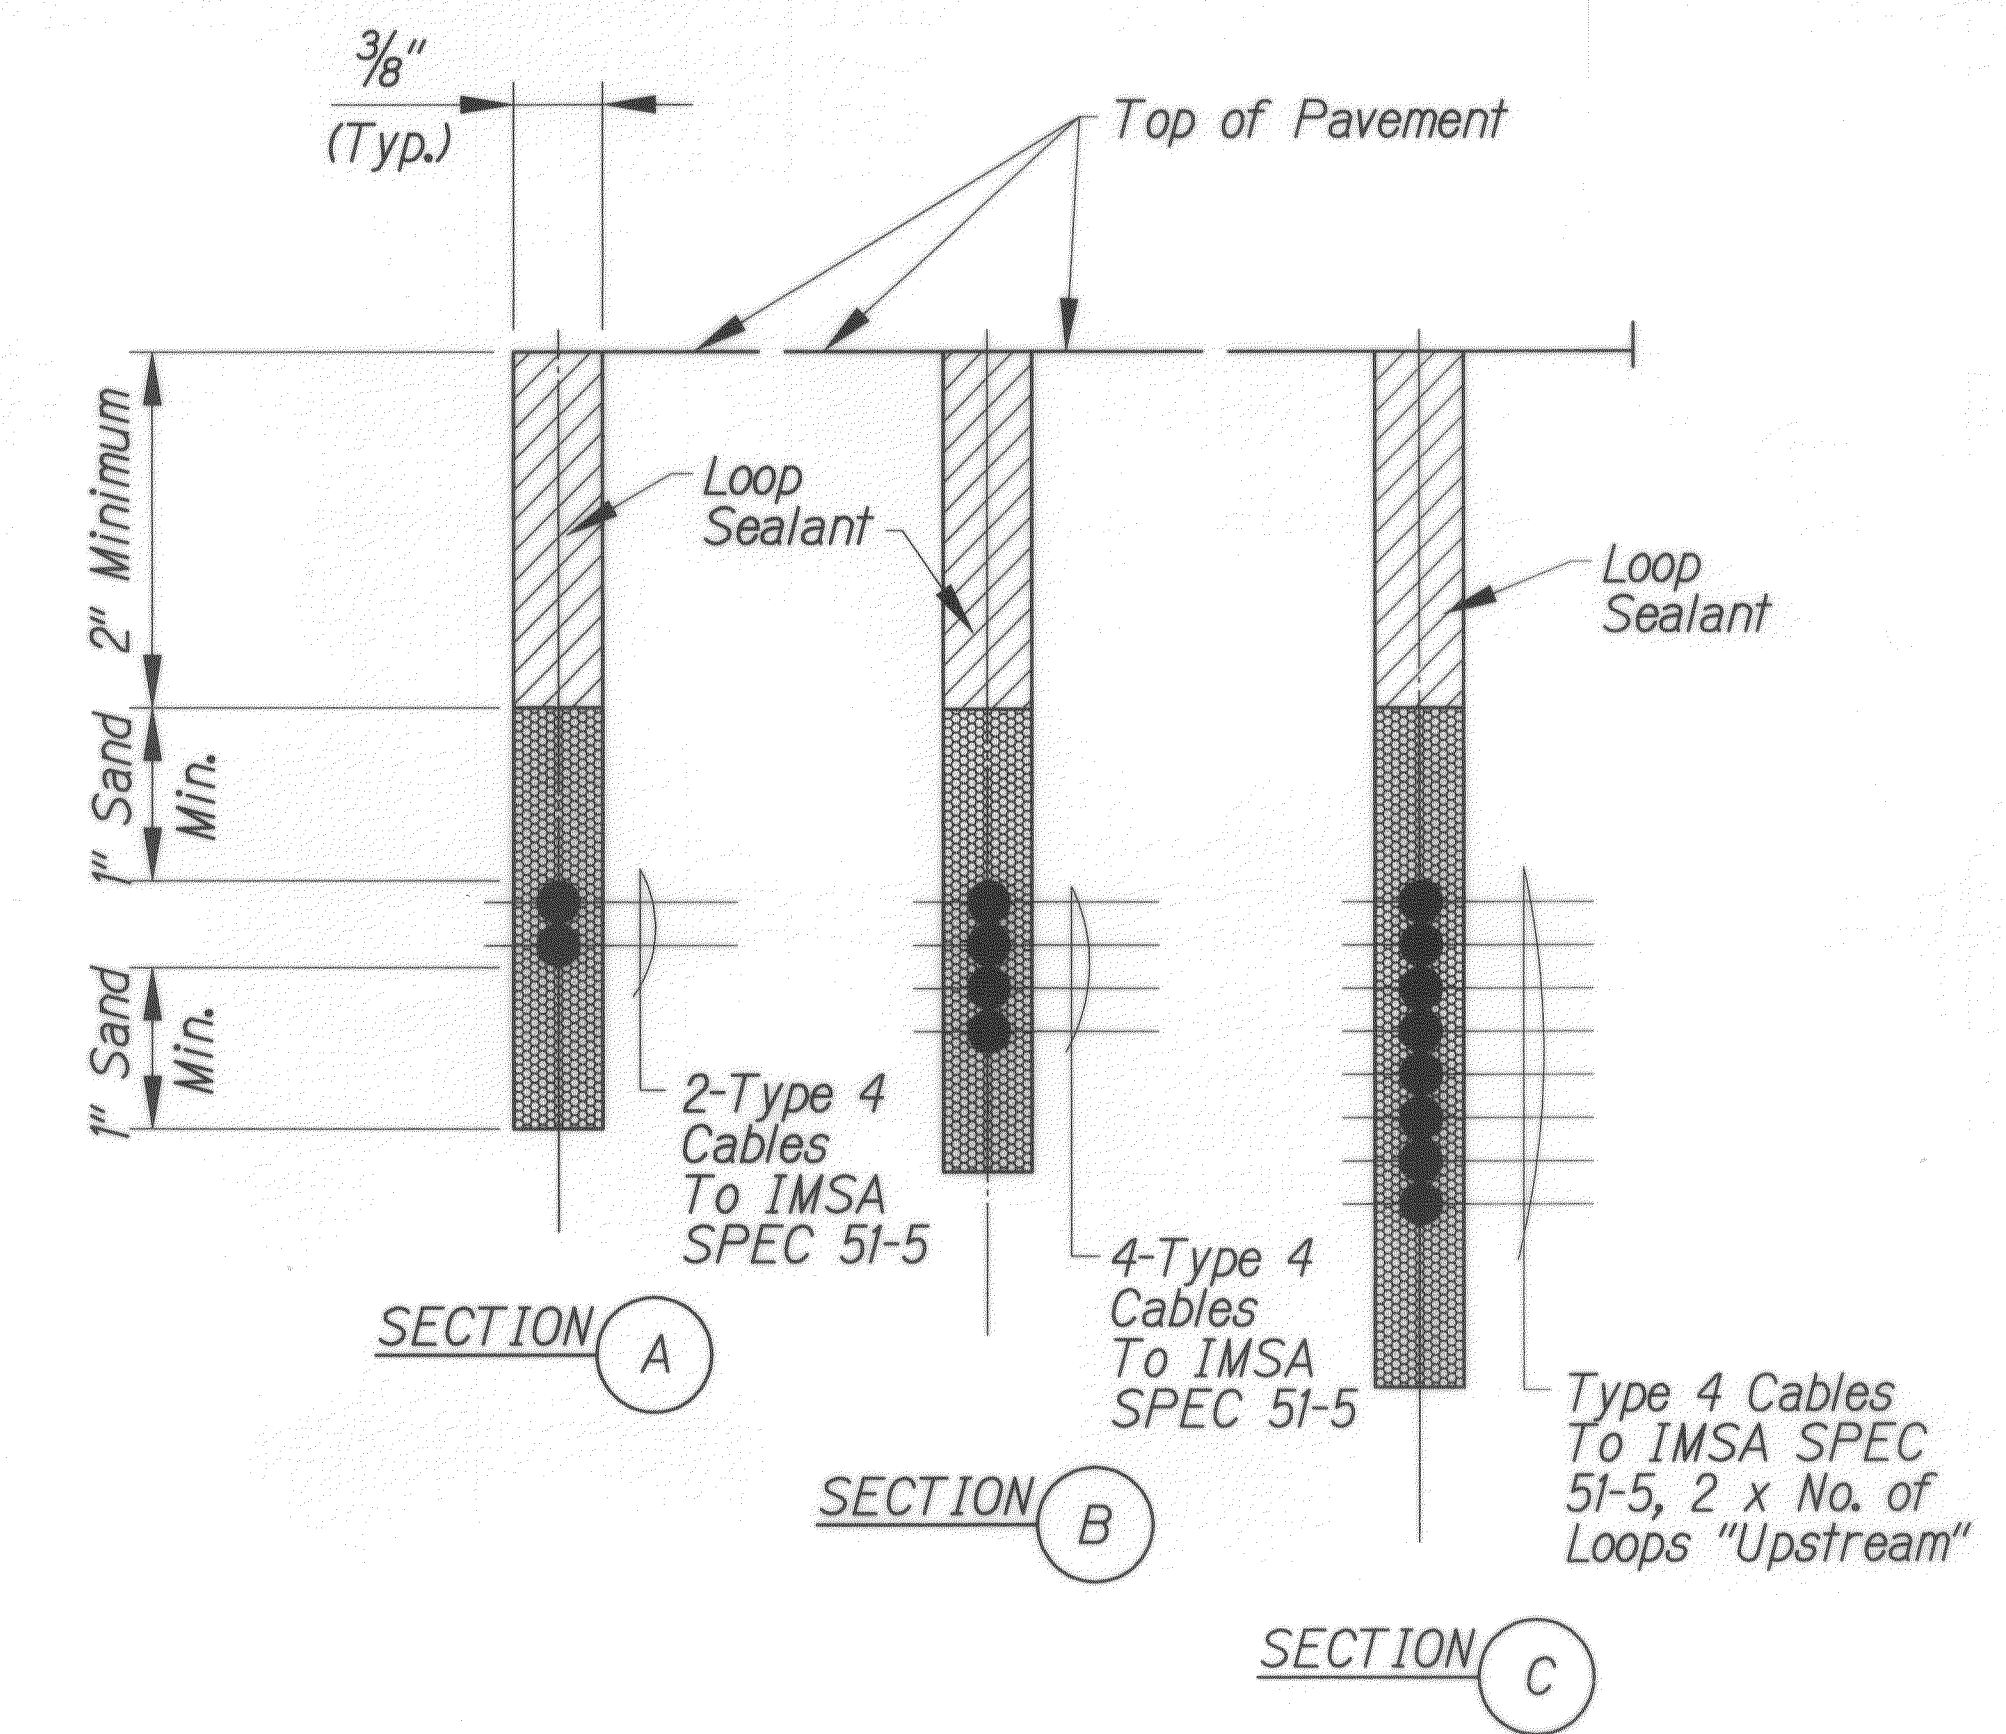

TYPICAL SECTION THROUGH DETECTOR LOOP

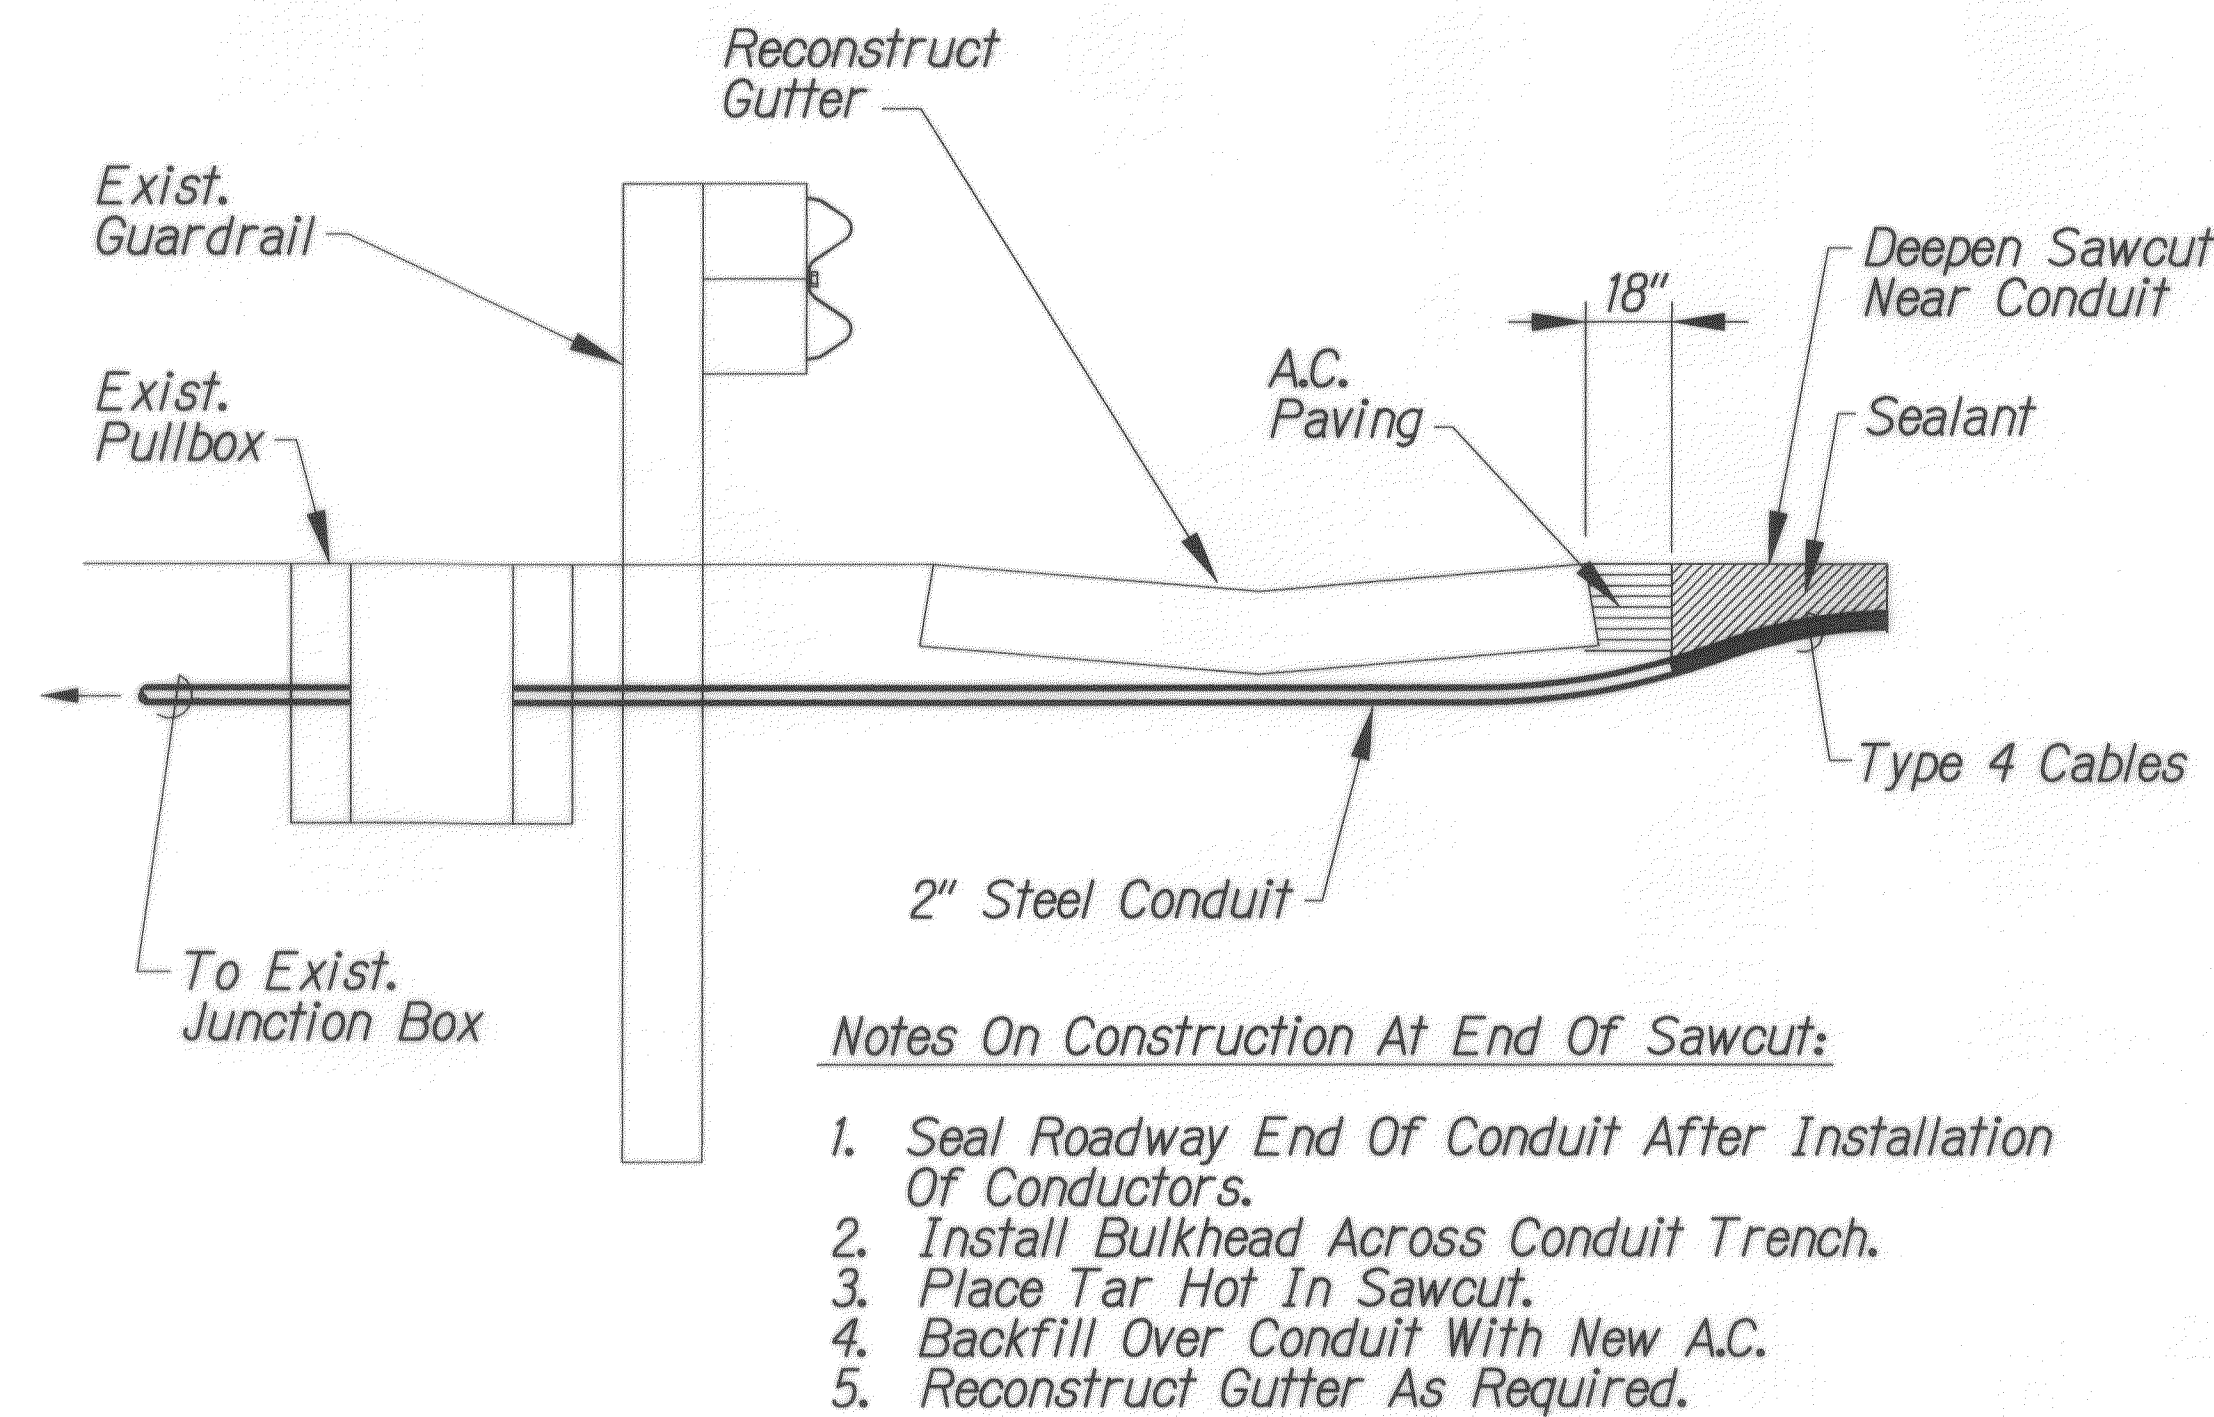

DETAIL OF LOOP DETECTOR INSTALLATION AT EDGE OF ROADWAY

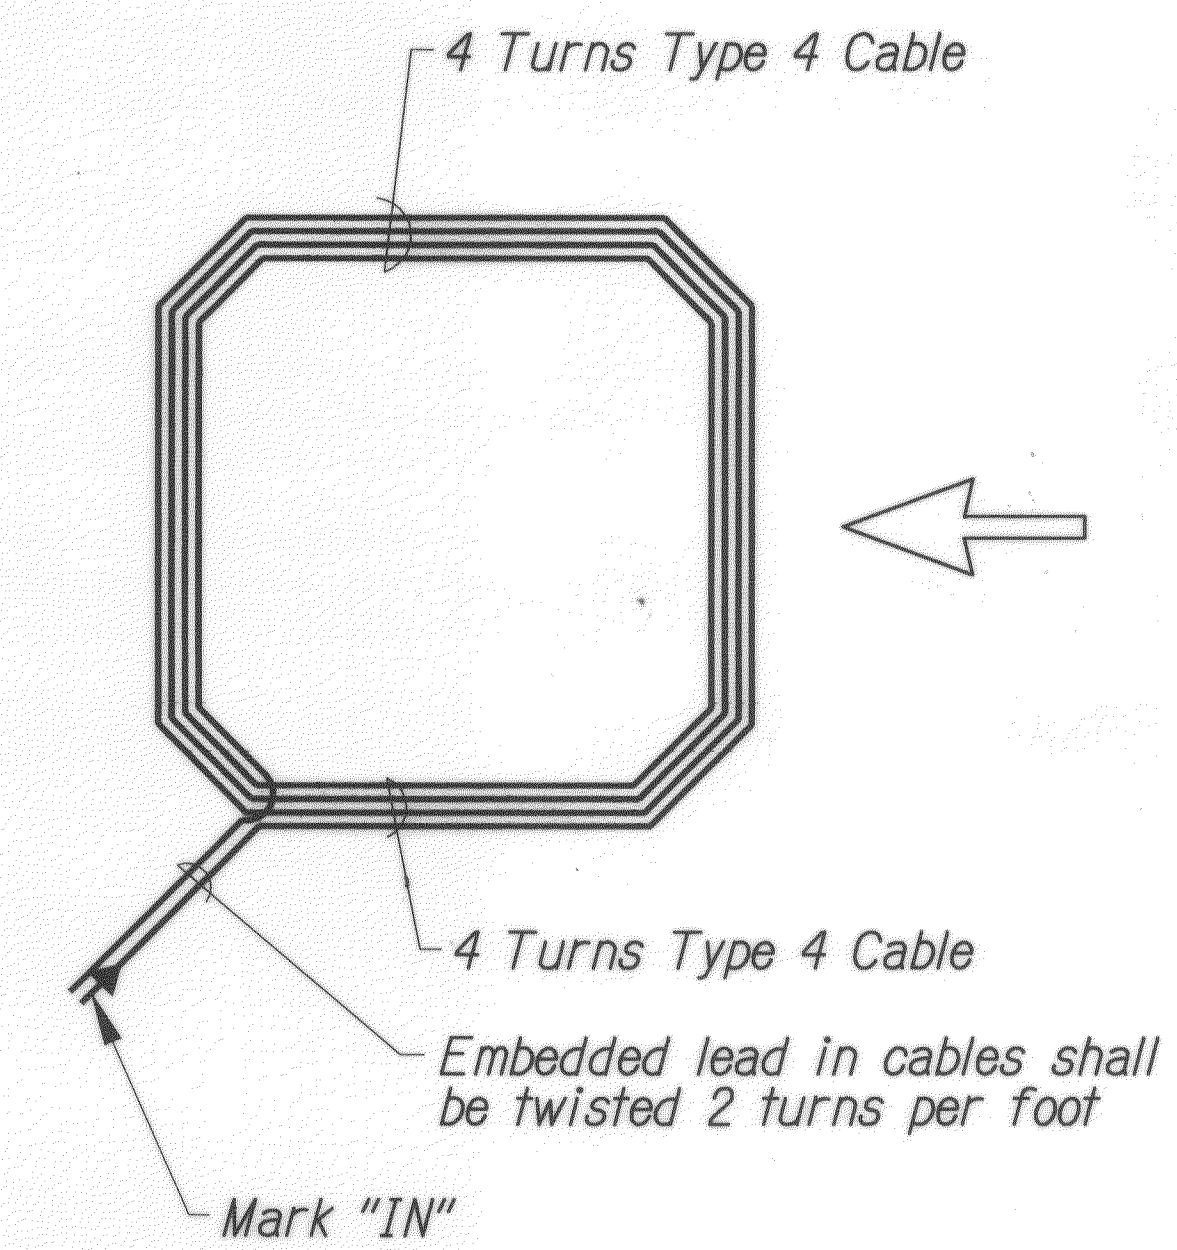


TYPICAL LOOP DETECTOR WIRING DIAGRAM


CRAIG S. ARAKAKI
LICENSED PROFESSIONAL ENGINEER
No. 5510-C
HAWAII, U.S.A.
LICENSE EXP. DATE 04-30-12
THIS WORK WAS PREPARED BY ME OR UNDER MY SUPERVISION AND CONSTRUCTION OF THIS PROJECT WILL BE UNDER MY OBSERVATION AS DEFINED IN HAWAII TITLE 16, CHAPTER 115, RULES OF THE BOARD OF PROFESSIONAL ENGINEERS, ARCHITECTS AND SURVEYORS, STATE OF HAWAII.
Craig S. Arakaki

1/21/11	5	Added Sheet, Loop Detector Detail
DATE	REVISION	
STATE OF HAWAII DEPARTMENT OF TRANSPORTATION HIGHWAYS DIVISION		
MISCELLANEOUS DETAILS		
INTERSTATE ROUTE H-1 Kinau Street Off-Ramp Improvements Vicinity Of Queen's Medical Center Federal-Aid Project No. TC-HI-1(258)		
Scale: Not to Scale Date: Dec. 2006		
SHEET No. 2 OF 2 SHEETS		



FED. ROAD DIST. NO.	STATE	FED. AID PROJ. NO.	FISCAL YEAR	SHEET NO.	TOTAL SHEETS
HAWAII	HAW.	TC-HI-1(258)	2006	C.O.30S-2	89

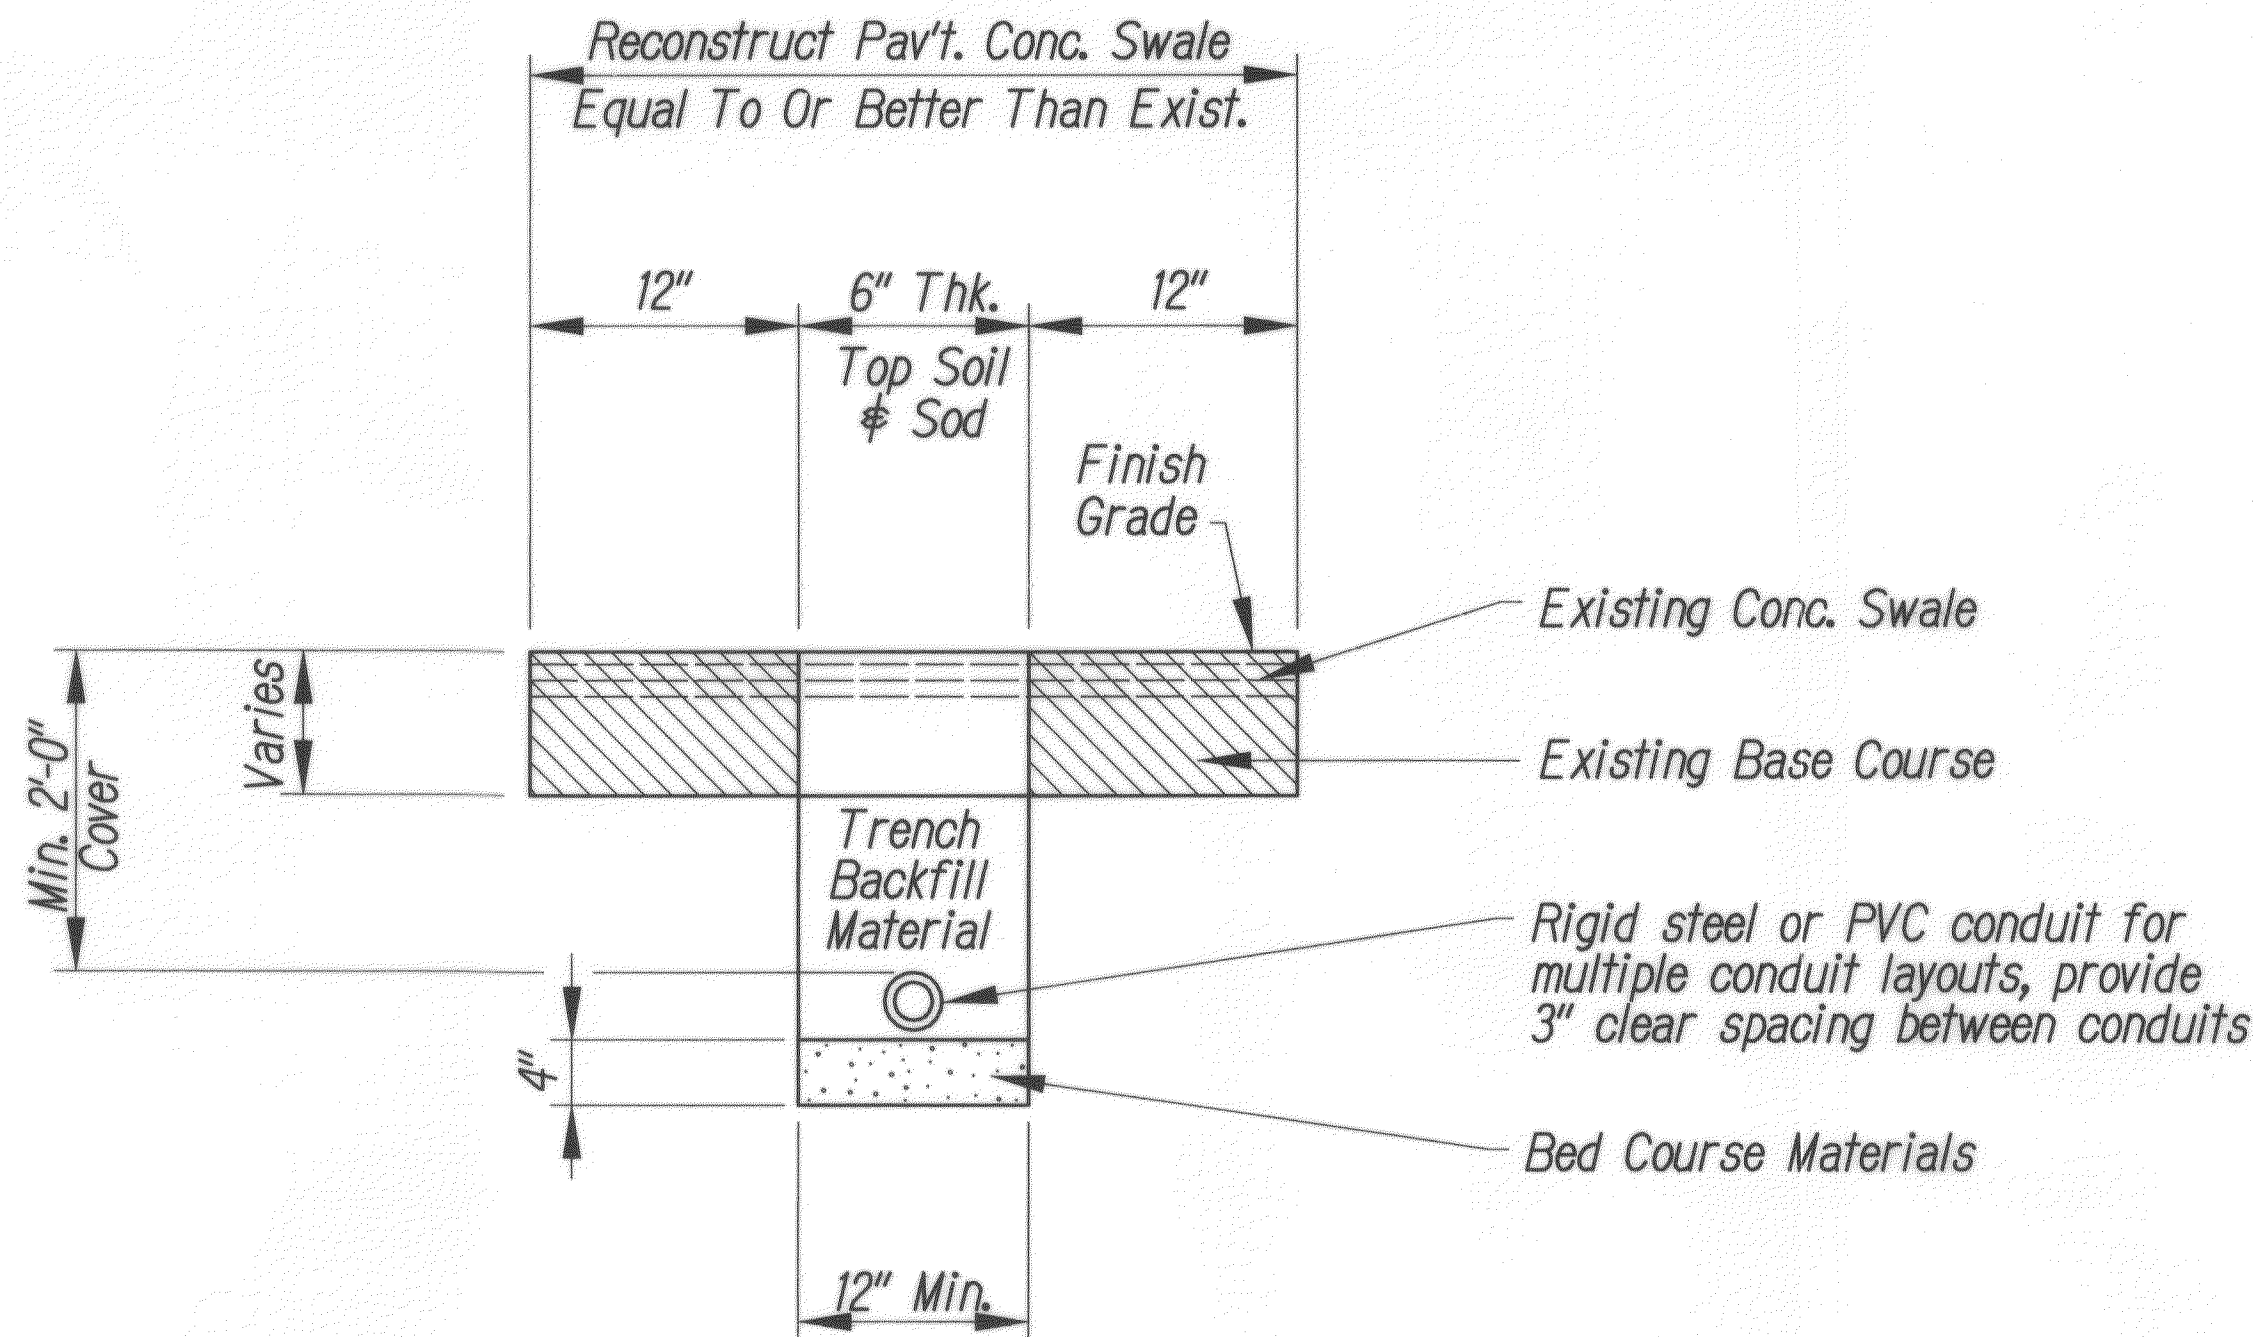


TYPICAL TRENCH SECTION FOR CONDUIT
Not to Scale

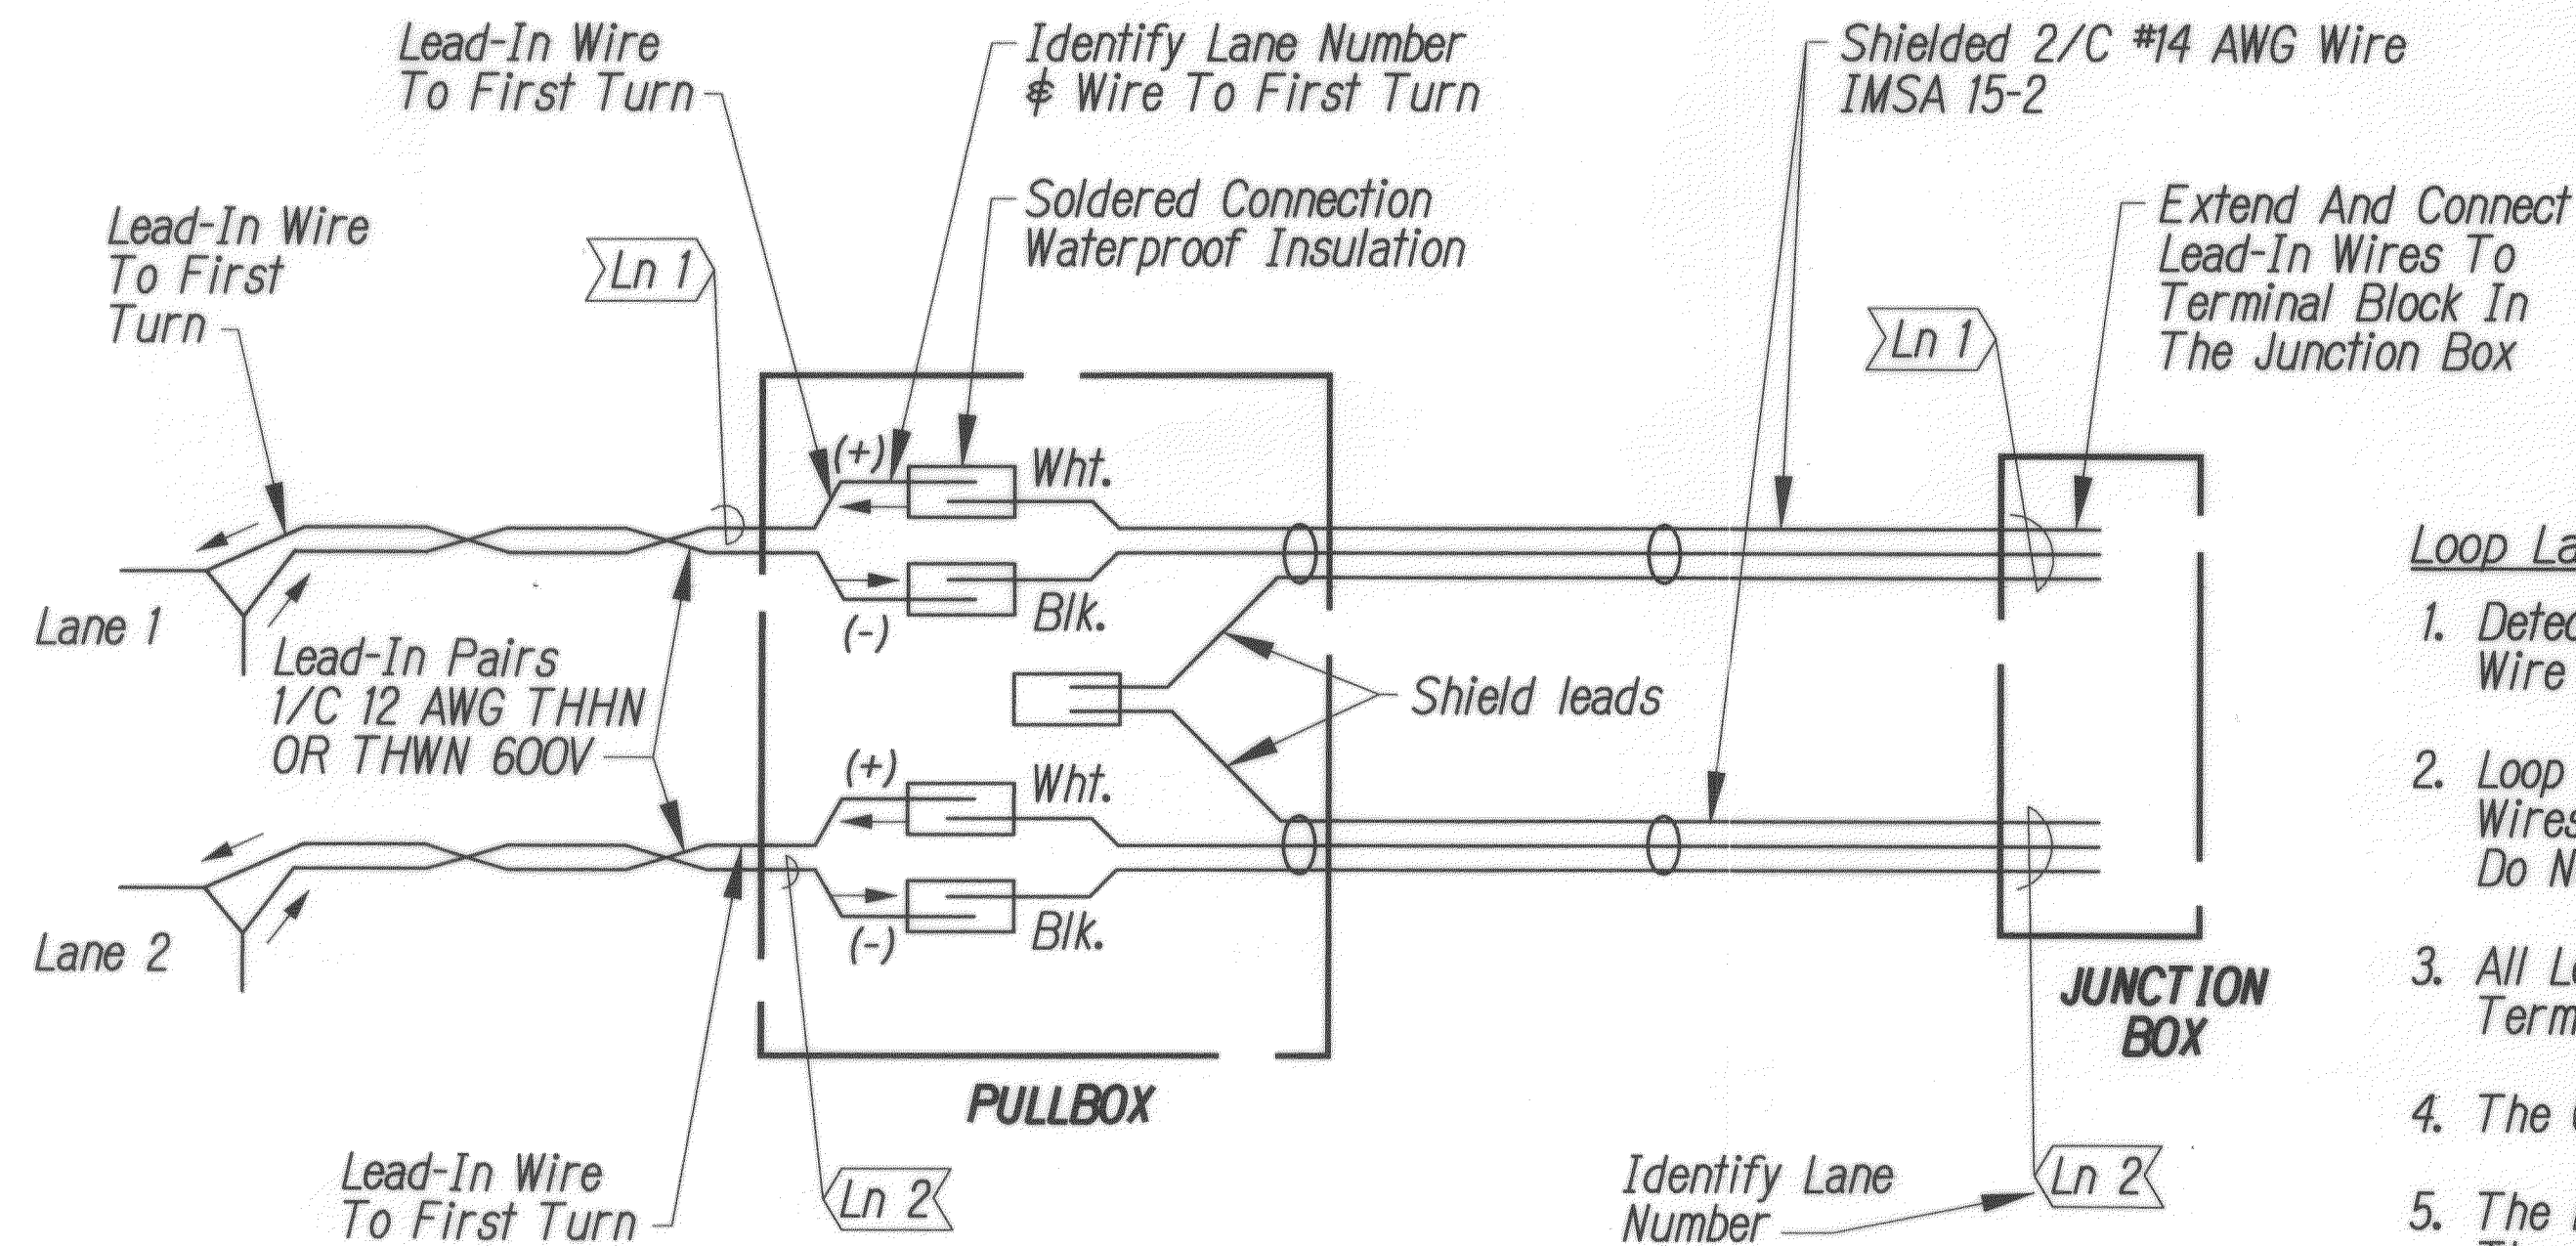

DETECTOR LOOP LEAD-IN WIRING & IDENTIFICATION IN PULLBOX & JUNCTION BOX
Not to Scale

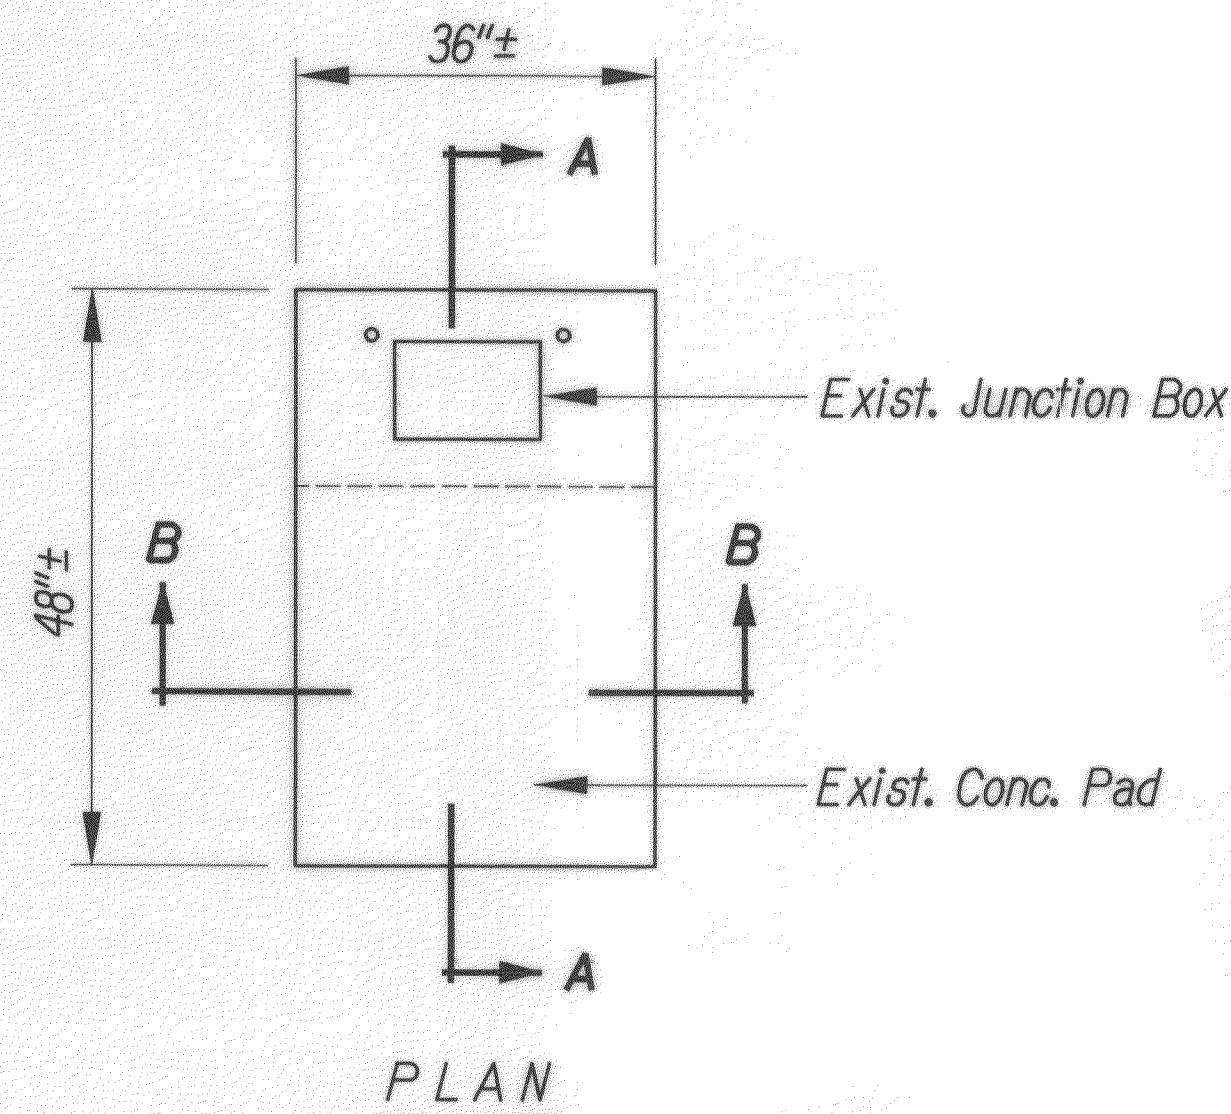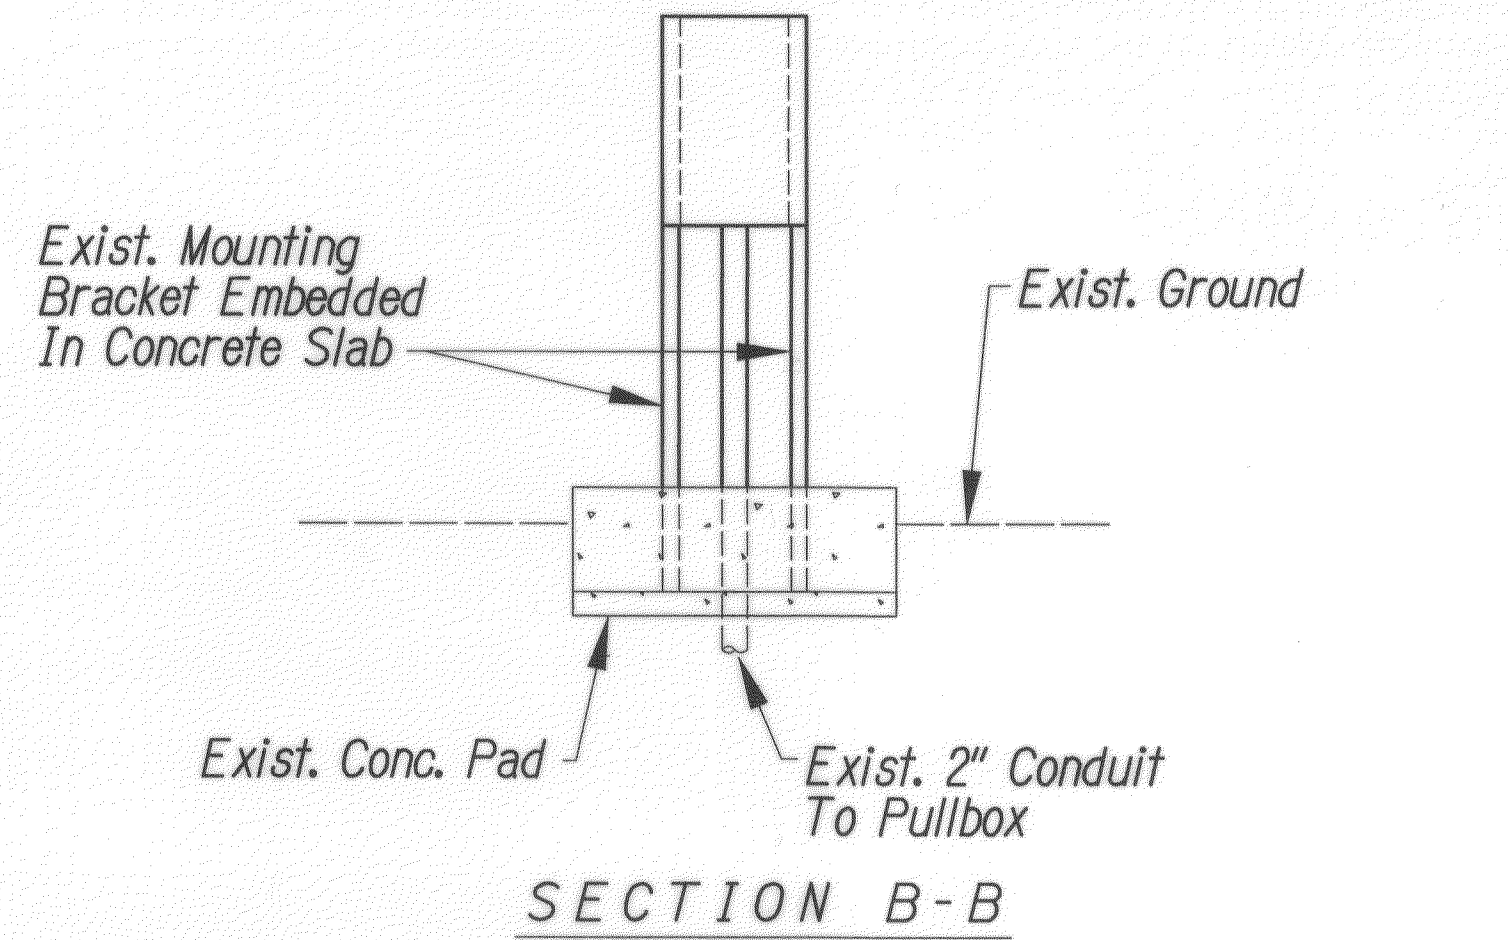

CONCRETE PAD AND JUNCTION BOX
Not to Scale

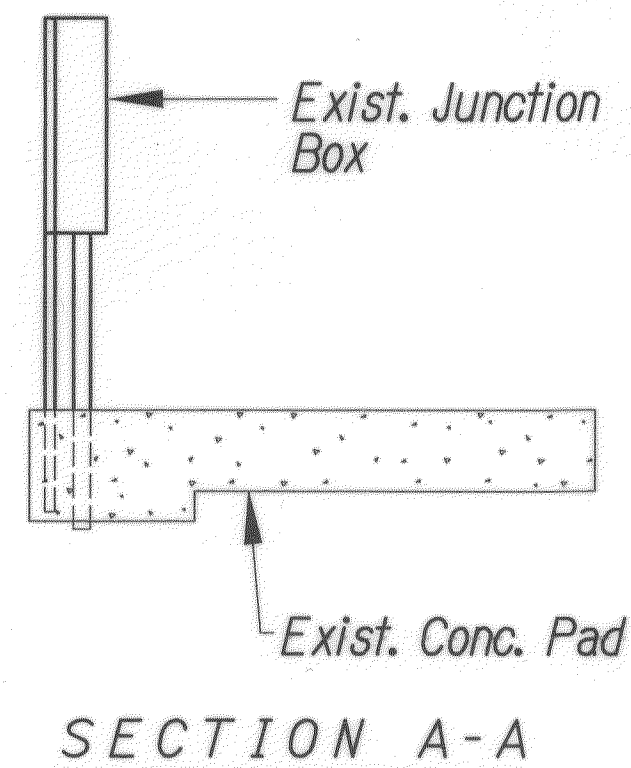


Loop Layout Notes:

1. Detector Loop Shall Consist Of Four (4) Turns Of 1/C 12 AWG THHN Or THWN 600V Wire Or Equivalent Embedded In A 3/8" Minimum Sawcut, Except As Noted.
2. Loop And Lead-In To The First Pullbox Shall Be One Continuous Wire. Lead-In Wires From The Same Loop Shall Be Twisted In Pairs, Two (2) Turns Per Foot. Do Not Twist One Loop-Pairs With Another Loop-Pairs.
3. All Lead-In Wires Shall Be Crimped With Open End Lugs That Will Fit Into The Terminal Board Slots Snugly.
4. The Contractor Shall Connect The Inductance Wires On Each Terminal Slot.
5. The left Lane In The Direction Of Traffic Flow Is Designated As Lane 1, And The Lane Next To Its Right As Lane 2 And So On As Indicated On Plans.
6. Clean Sawcut Thoroughly Before Filling With Appropriate Sealant.
7. All Loop Lead-in Wires In All Enclosures Including Pullboxes Shall Be Identified And Labeled By Direction Of Traffic Flow And Lane Numbers As Shown On Plans.
8. All Cables And Wires Terminated Within An Enclosure Shall Have A Minimum 12" Additional Slack.

General Notes

1. The Locations Of New Inductance Loops, Shall Be Staked Out In The Field By The Contractor And Approved By The Engineer Prior To Installation.
2. The Contractor Shall Inform The Engineer At Least One (1) Day Prior To Saw-Cutting Pavement And Installing Inductance Loops.
3. Continuity Of Inductance Loops And Lead-In Wires Shall Be Tested And Warranted For One (1) Year From Date Of Acceptance By The Contractor.

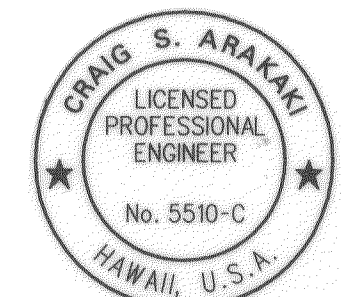

LICENSE EXP. DATE 04-30-12
THIS WORK WAS PREPARED BY ME OR UNDER MY SUPERVISION AND CONSTRUCTION OF THIS PROJECT WILL BE UNDER MY OBSERVATION AS DEFINED IN HAWAIIAN TITLE 16, CHAPTER 115, RULES OF THE BOARD OF PROFESSIONAL ENGINEERS, ARCHITECTS AND SURVEYORS, STATE OF HAWAII.
Craig S. Arakaki

1/21/11	Added Sheet, Loop Detector Detail
DATE	REVISION

STATE OF HAWAII
DEPARTMENT OF TRANSPORTATION
HIGHWAYS DIVISION



MISCELLANEOUS DETAILS

INTERSTATE ROUTE H-1
Kinahu Street Off-Ramp Improvements
Vicinity Of Queen's Medical Center
Federal-Aid Project No. TC-HI-1(258)


Scale: Not to Scale Date: Dec. 2006

SHEET No. 2 OF 2 SHEETS

FED. ROAD DIST. NO.	STATE	FED. AID PROJ. NO.	FISCAL YEAR	SHEET NO.	TOTAL SHEETS
HAWAII	HAW.	TC-HI-K(258)	2006	C.O. 30 S-3	89

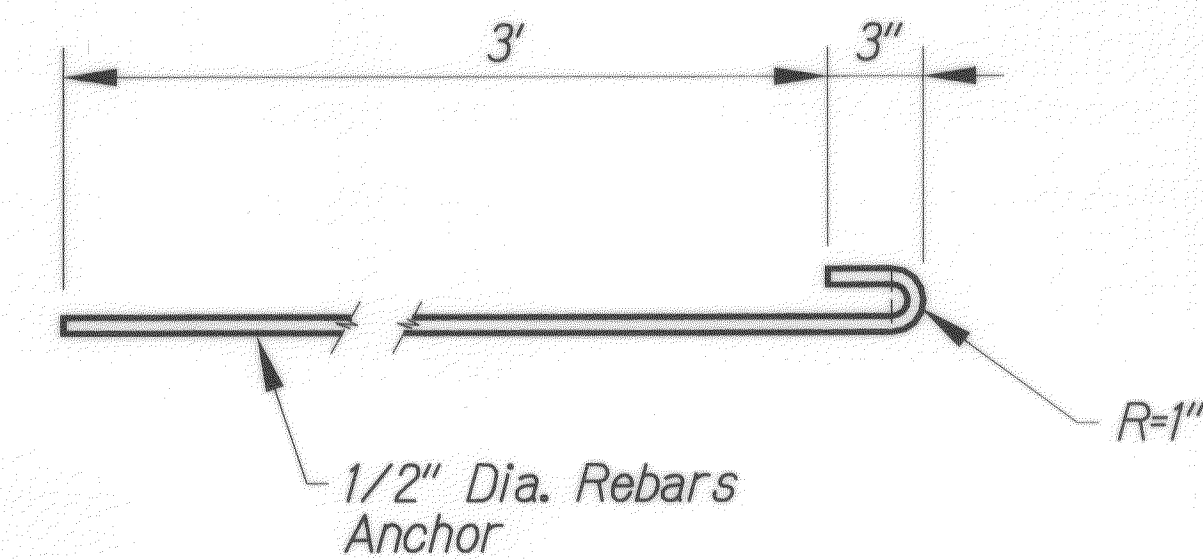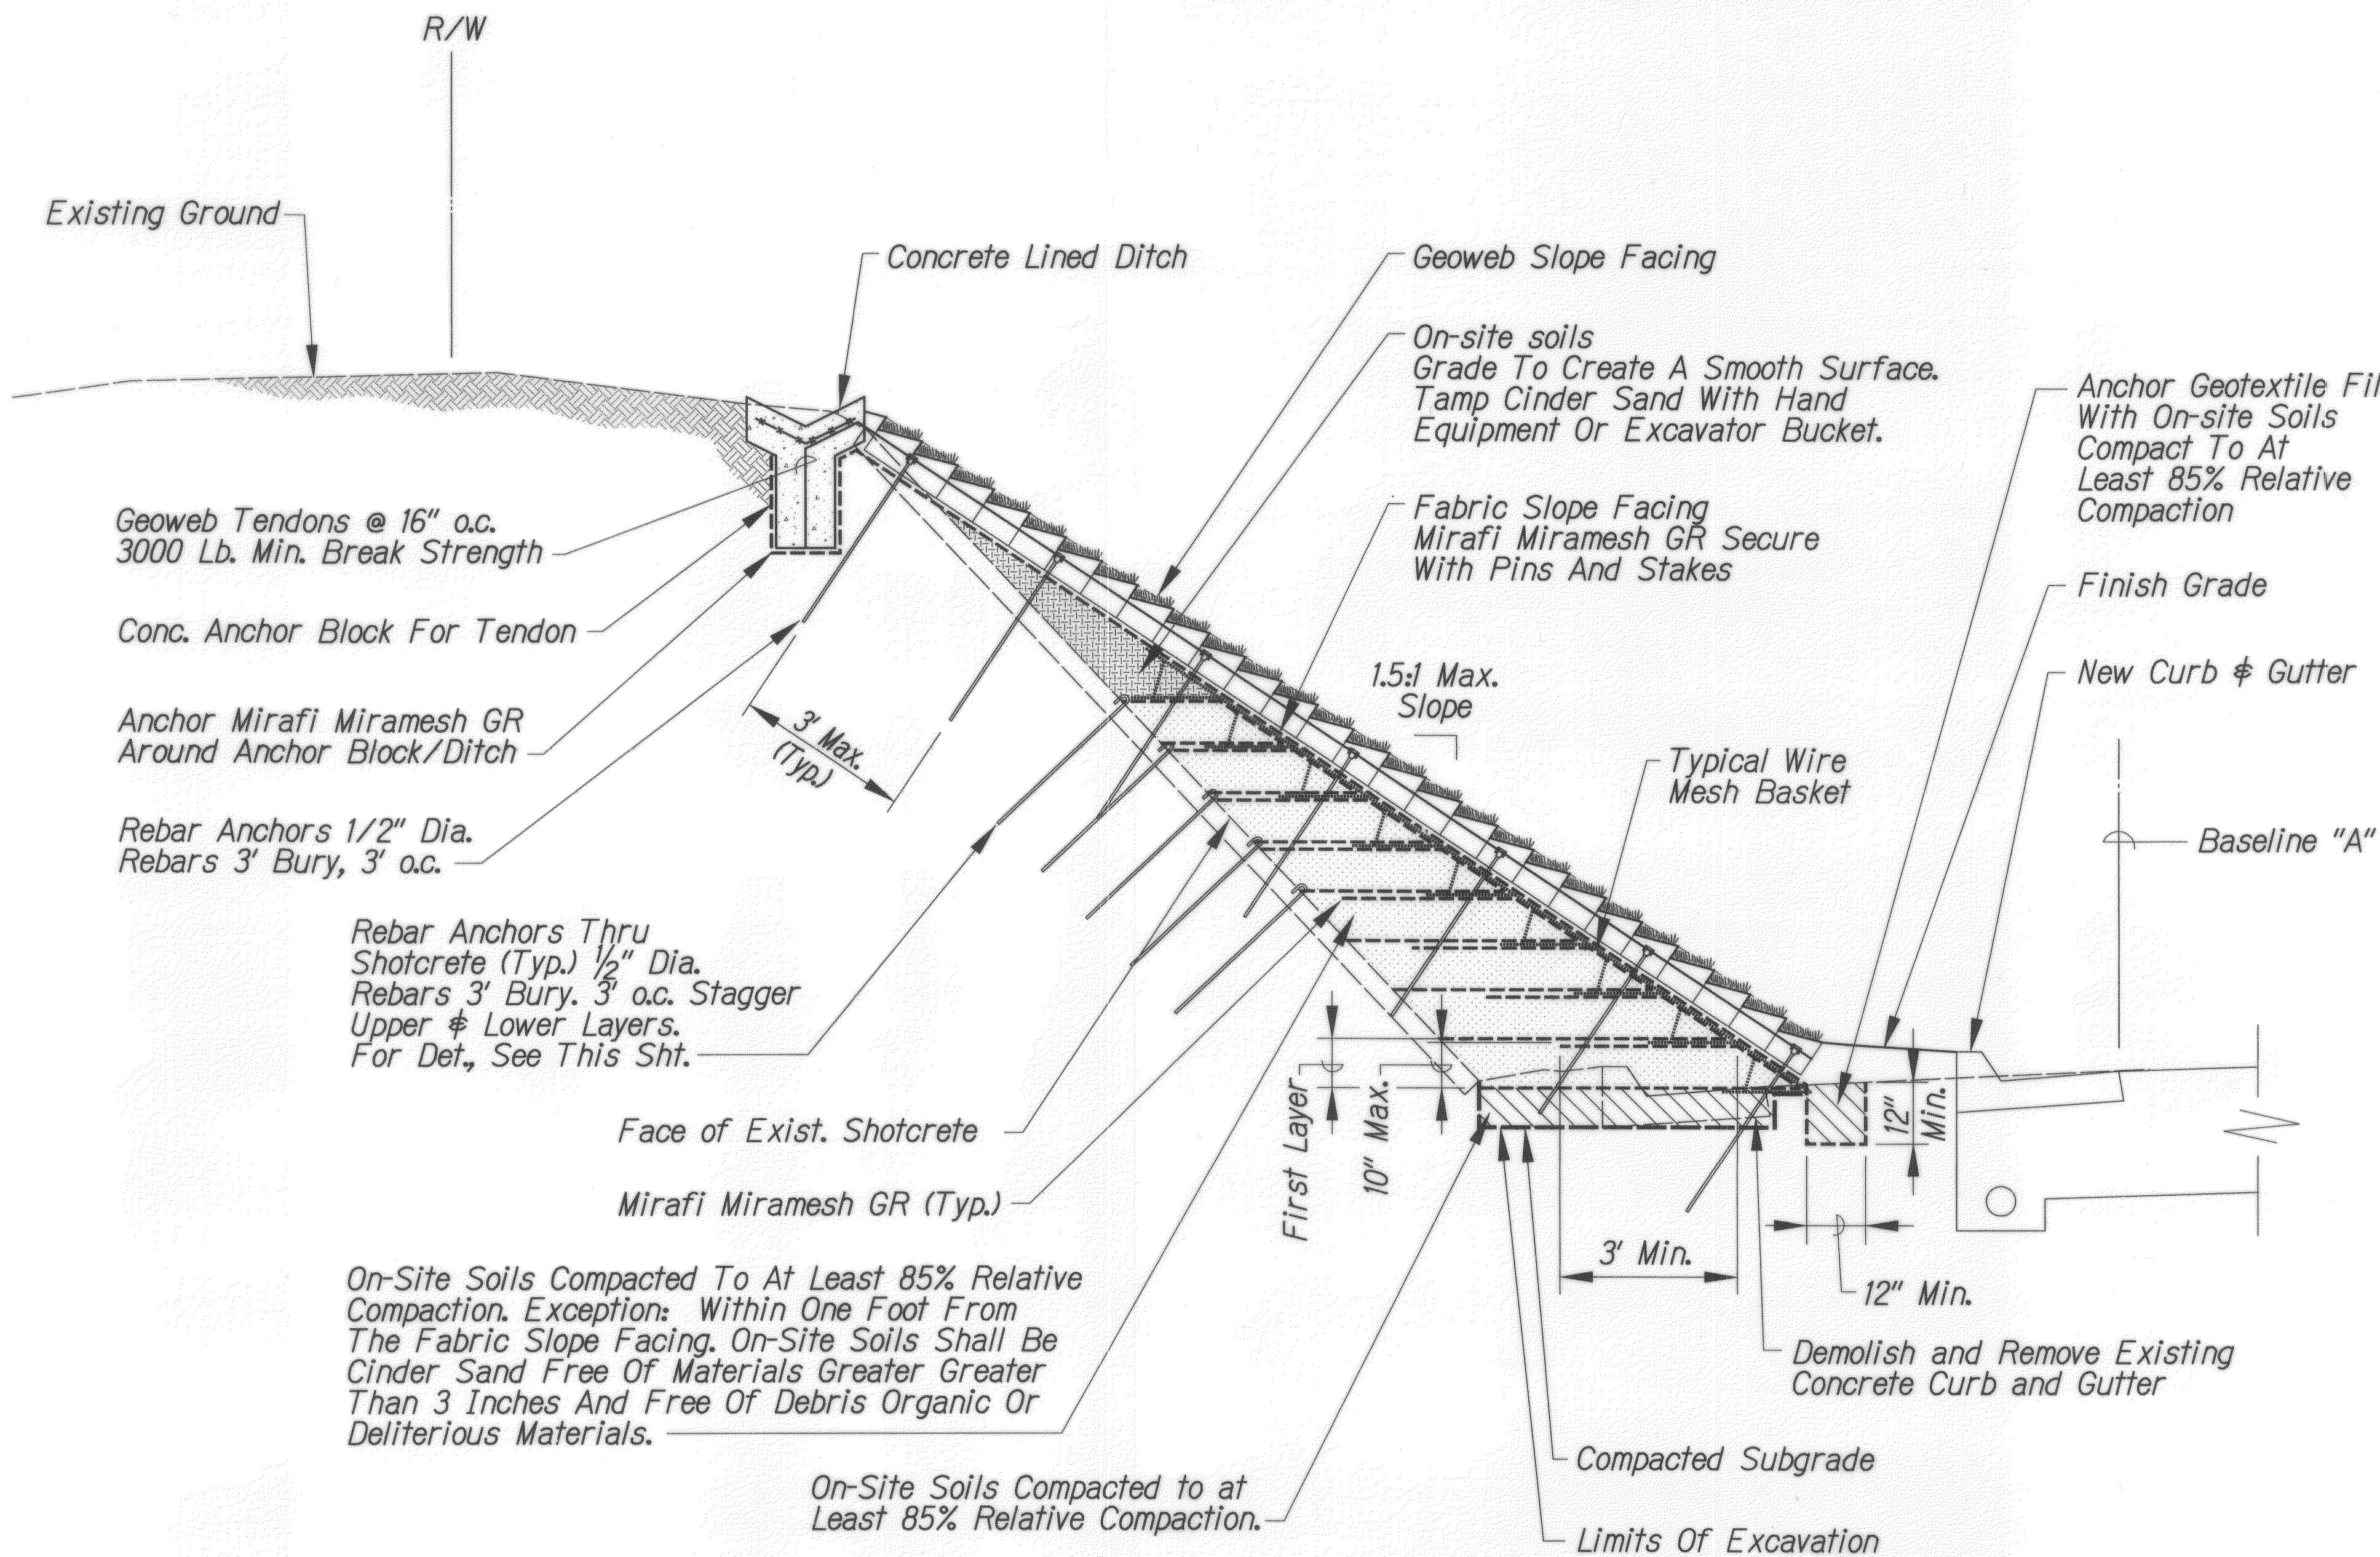

REBAR ANCHOR DETAIL
No Scale


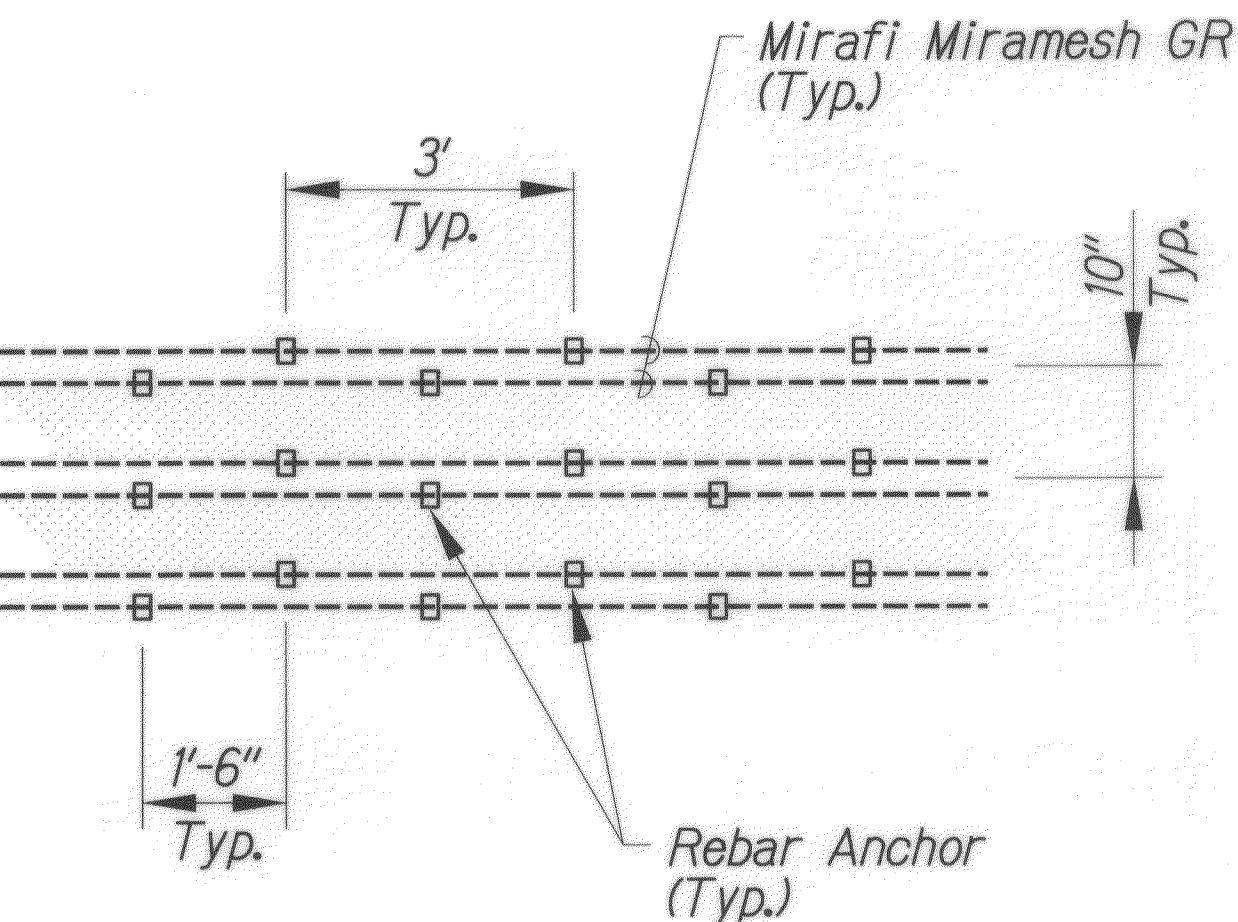


TYPICAL ANCHOR PLACEMENT THRU SHOTCRETE
No Scale

Notes:

1. Use temporary formwork to create 1.5h:1v slope.
2. If shotcrete is encountered during placement of the atra pins for the geoweb slope facing, drill through shotcrete.
3. A compaction test shall be taken for the first layer to determine the compaction effort necessary for 85% relative compaction of on-site soils. Compaction effort shall be measured in water compaction or number of passes with compaction equipment or other acceptable measures.
4. Visual inspection of the compaction effort shall be used for additional layers.


Sta. 9+56± To 10+50
TYPICAL SECTION SLOPE STABILIZATION OVER SHOTCRETE
Scale: 1" = 2'

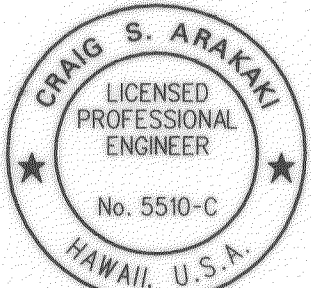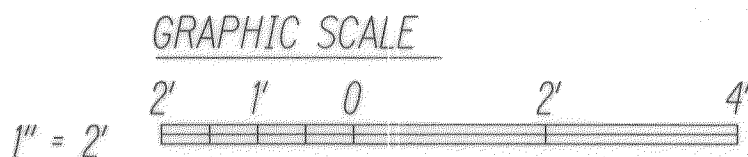

LICENSE EXP. DATE 04-30-12
THIS WORK WAS PREPARED BY ME OR UNDER MY SUPERVISION AND CONSTRUCTION OF THIS PROJECT WILL BE UNDER MY OBSERVATION AS DEFINED IN HAWAII TITLE 16, CHAPTER 115, RULES OF THE BOARD OF PROFESSIONAL ENGINEERS, ARCHITECTS AND SURVEYORS, STATE OF HAWAII.
Craig S. Arakawa


1/21/11	Added Sheet
DATE	REVISION
STATE OF HAWAII DEPARTMENT OF TRANSPORTATION HIGHWAYS DIVISION	
MISCELLANEOUS DETAILS	
INTERSTATE ROUTE H-1 Kinau Street Off-Ramp Improvements Vicinity Of Queen's Medical Center Federal-Aid Project No. TC-HI-K(258)	
Scale: As Shown	Date: Dec. 2006
SHEET No. 2 OF 2 SHEETS	

FED. ROAD DIST. NO.	STATE	FED. AID PROJ. NO.	FISCAL YEAR	SHEET NO.	TOTAL SHEETS
HAWAII	HAW.	TC-HI-1(258)	2006	C.O. 30 S-4	89

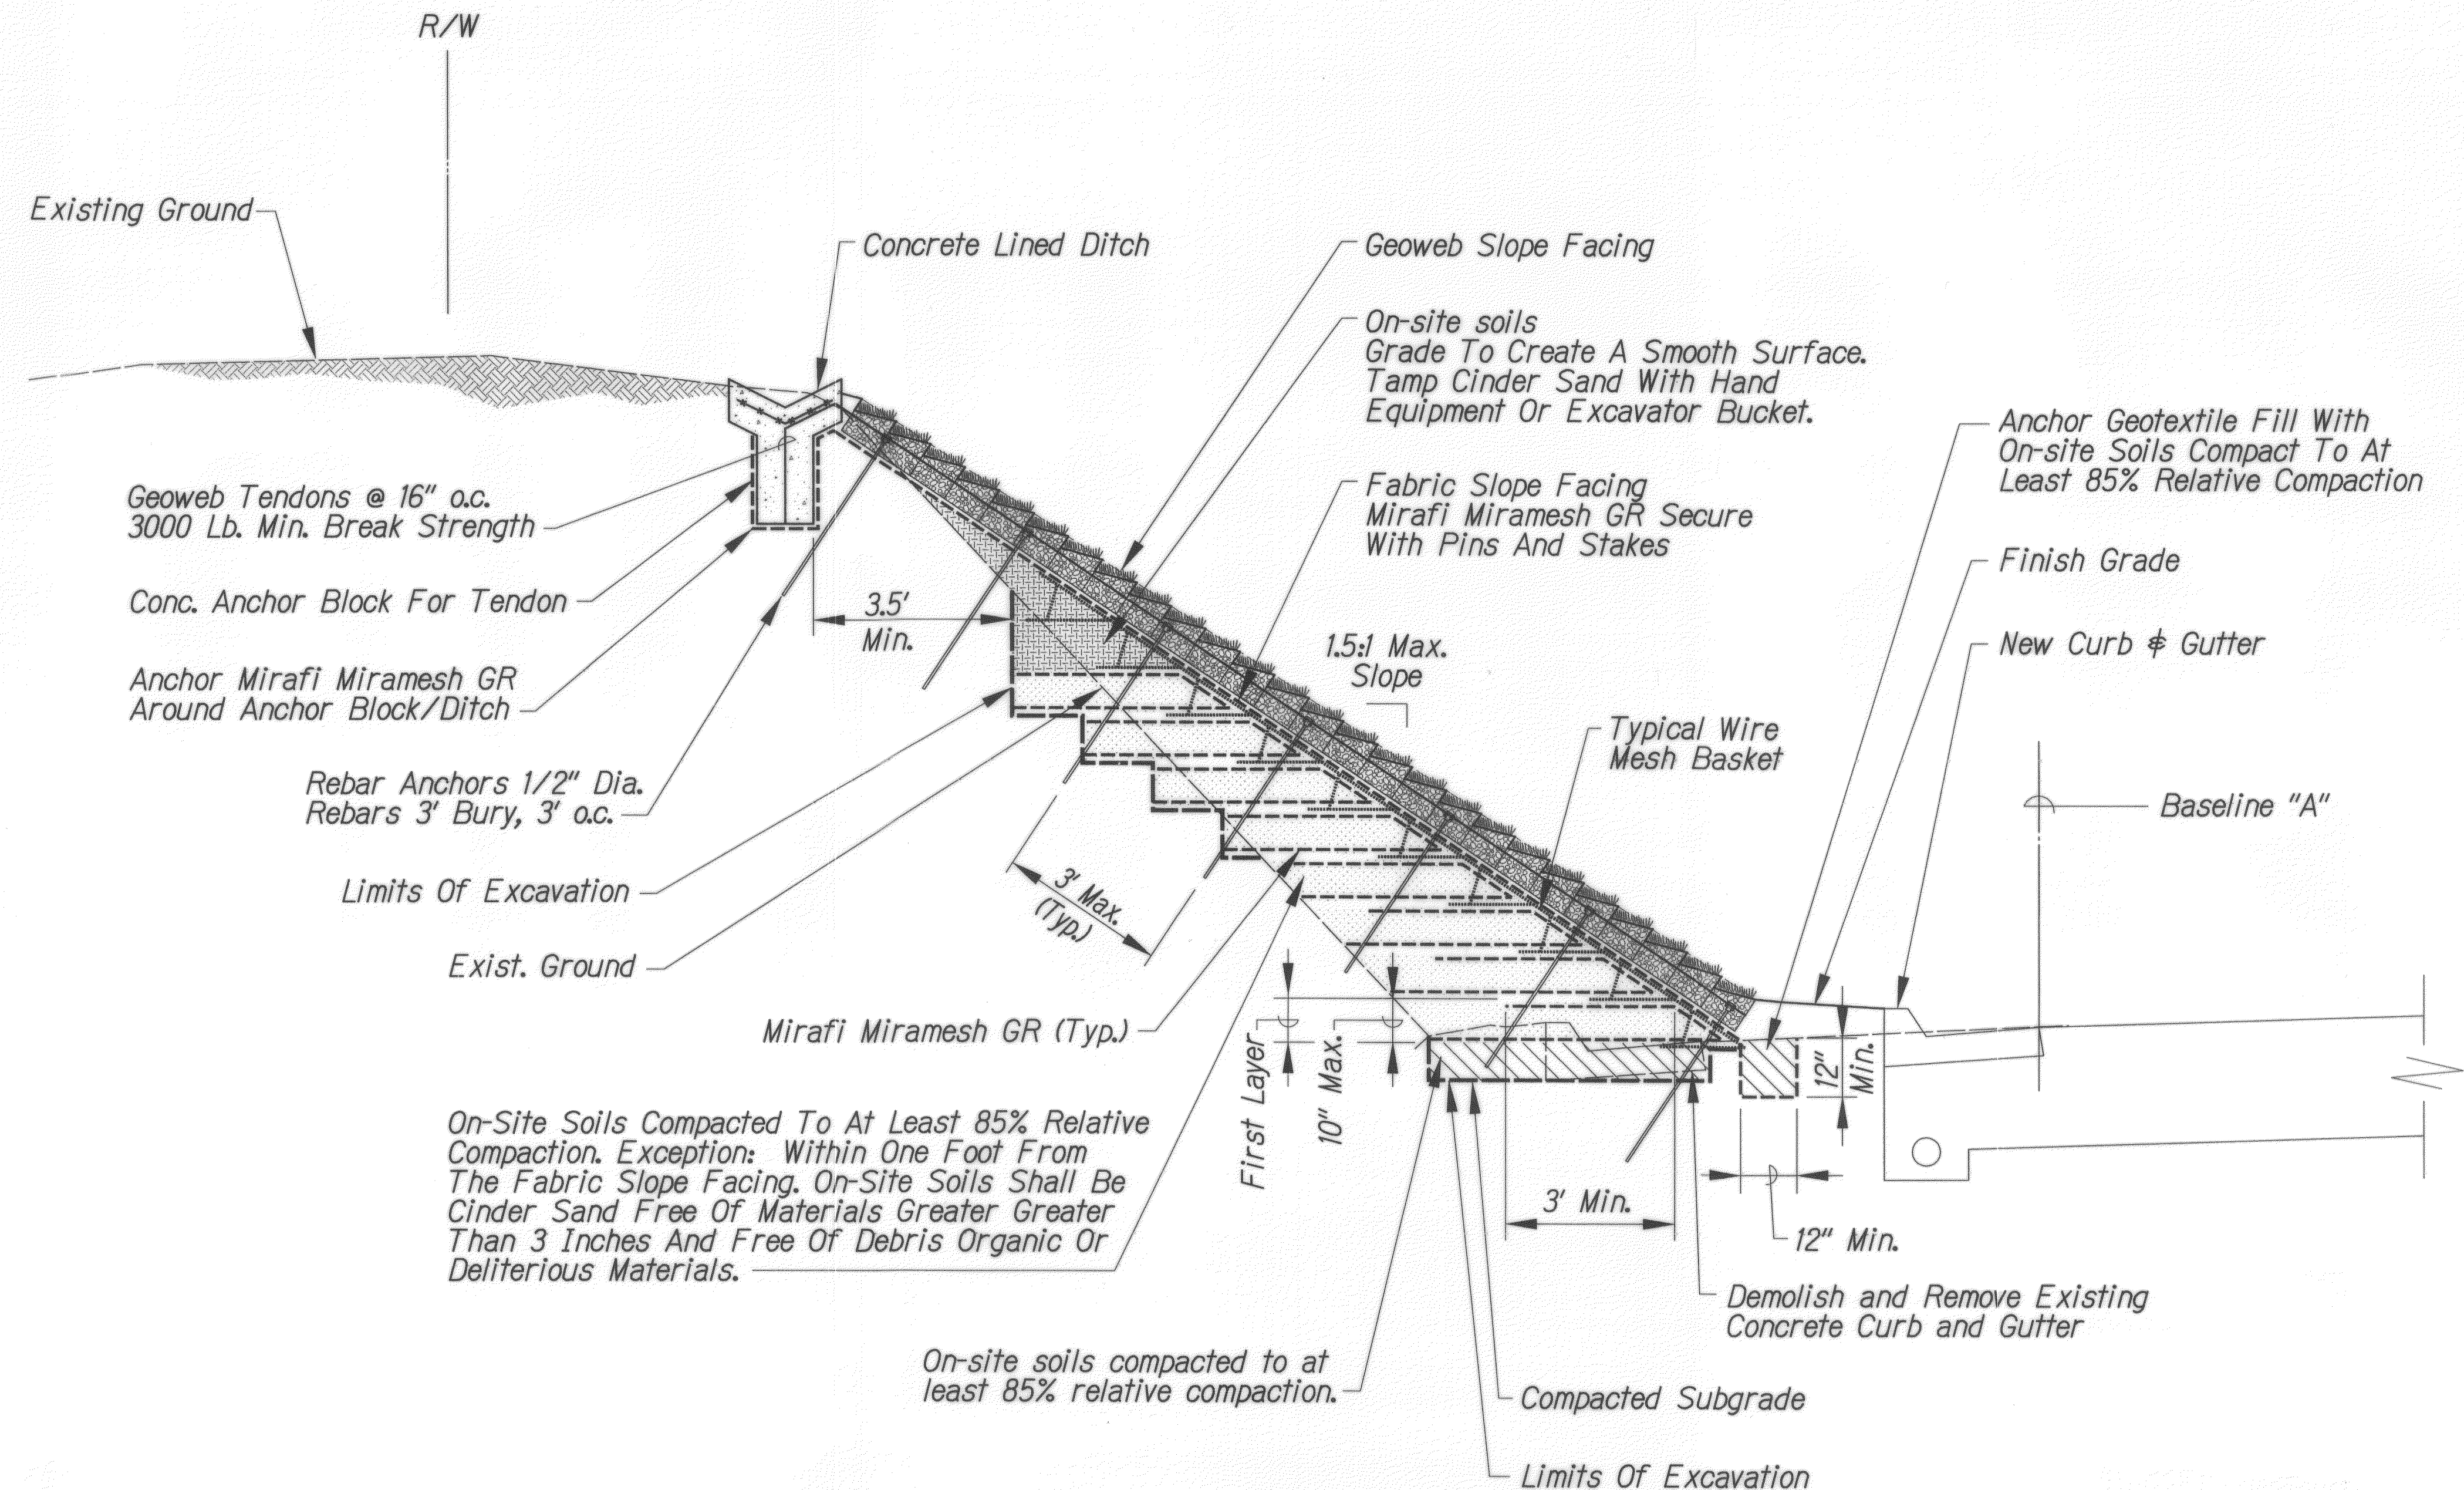

4x4 W4.0xW4.0
Welded Wire Baskets
10 feet Long

No. 4 Wire
Support Strut
@ 2' o.c.


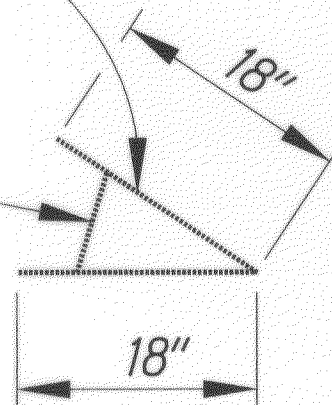


Typical Wire Mesh Basket

Notes:

1. Use temporary formwork to create 1.5h:1v slope.
2. If shotcrete is encountered during placement of the atra pins for the geoweb slope facing, drill through shotcrete.
3. A compaction test shall be taken for the first layer to determine the compaction effort necessary for 85% relative compaction of on-site soils. Compaction effort shall be measured in water compaction or number of passes with compaction equipment or other acceptable measures.
4. Visual inspection of the compaction effort shall be used for additional layers.


Sta. 10+50± To 11+80±
TYPICAL SECTION SLOPE STABILIZATION
Scale: 1" = 2'

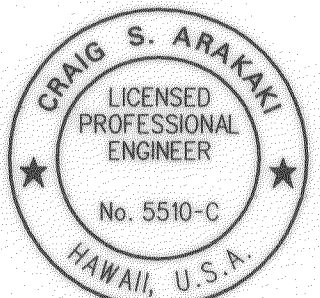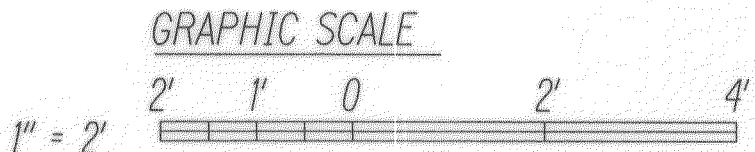

LICENSE EXP. DATE 04-30-12
THIS WORK WAS PREPARED BY ME OR UNDER MY SUPERVISION AND CONSTRUCTION OF THIS PROJECT WILL BE UNDER MY OBSERVATION AS DEFINED IN HAWAIIAN TITLE 16, CHAPTER 115, RULES OF THE BOARD OF PROFESSIONAL ENGINEERS, ARCHITECTS AND SURVEYORS, STATE OF HAWAII.
Craig S. Arakaki


1/21/11	Added Sheet
DATE	REVISION
STATE OF HAWAII DEPARTMENT OF TRANSPORTATION HIGHWAYS DIVISION	
MISCELLANEOUS DETAILS	
INTERSTATE ROUTE H-1 Kinau Street Off-Ramp Improvements Vicinity Of Queen's Medical Center Federal-Aid Project No. TC-HI-1(258) Scale: As Shown Date: Dec. 2006	
SHEET NO. 2 OF 2 SHEETS	

FED. ROAD DIST. NO.	STATE	FED. AID PROJ. NO.	FISCAL YEAR	SHEET NO.	TOTAL SHEETS
HAWAII	HAW.	TC-HI-1(258)	2006	C.O. 30 S-5	89

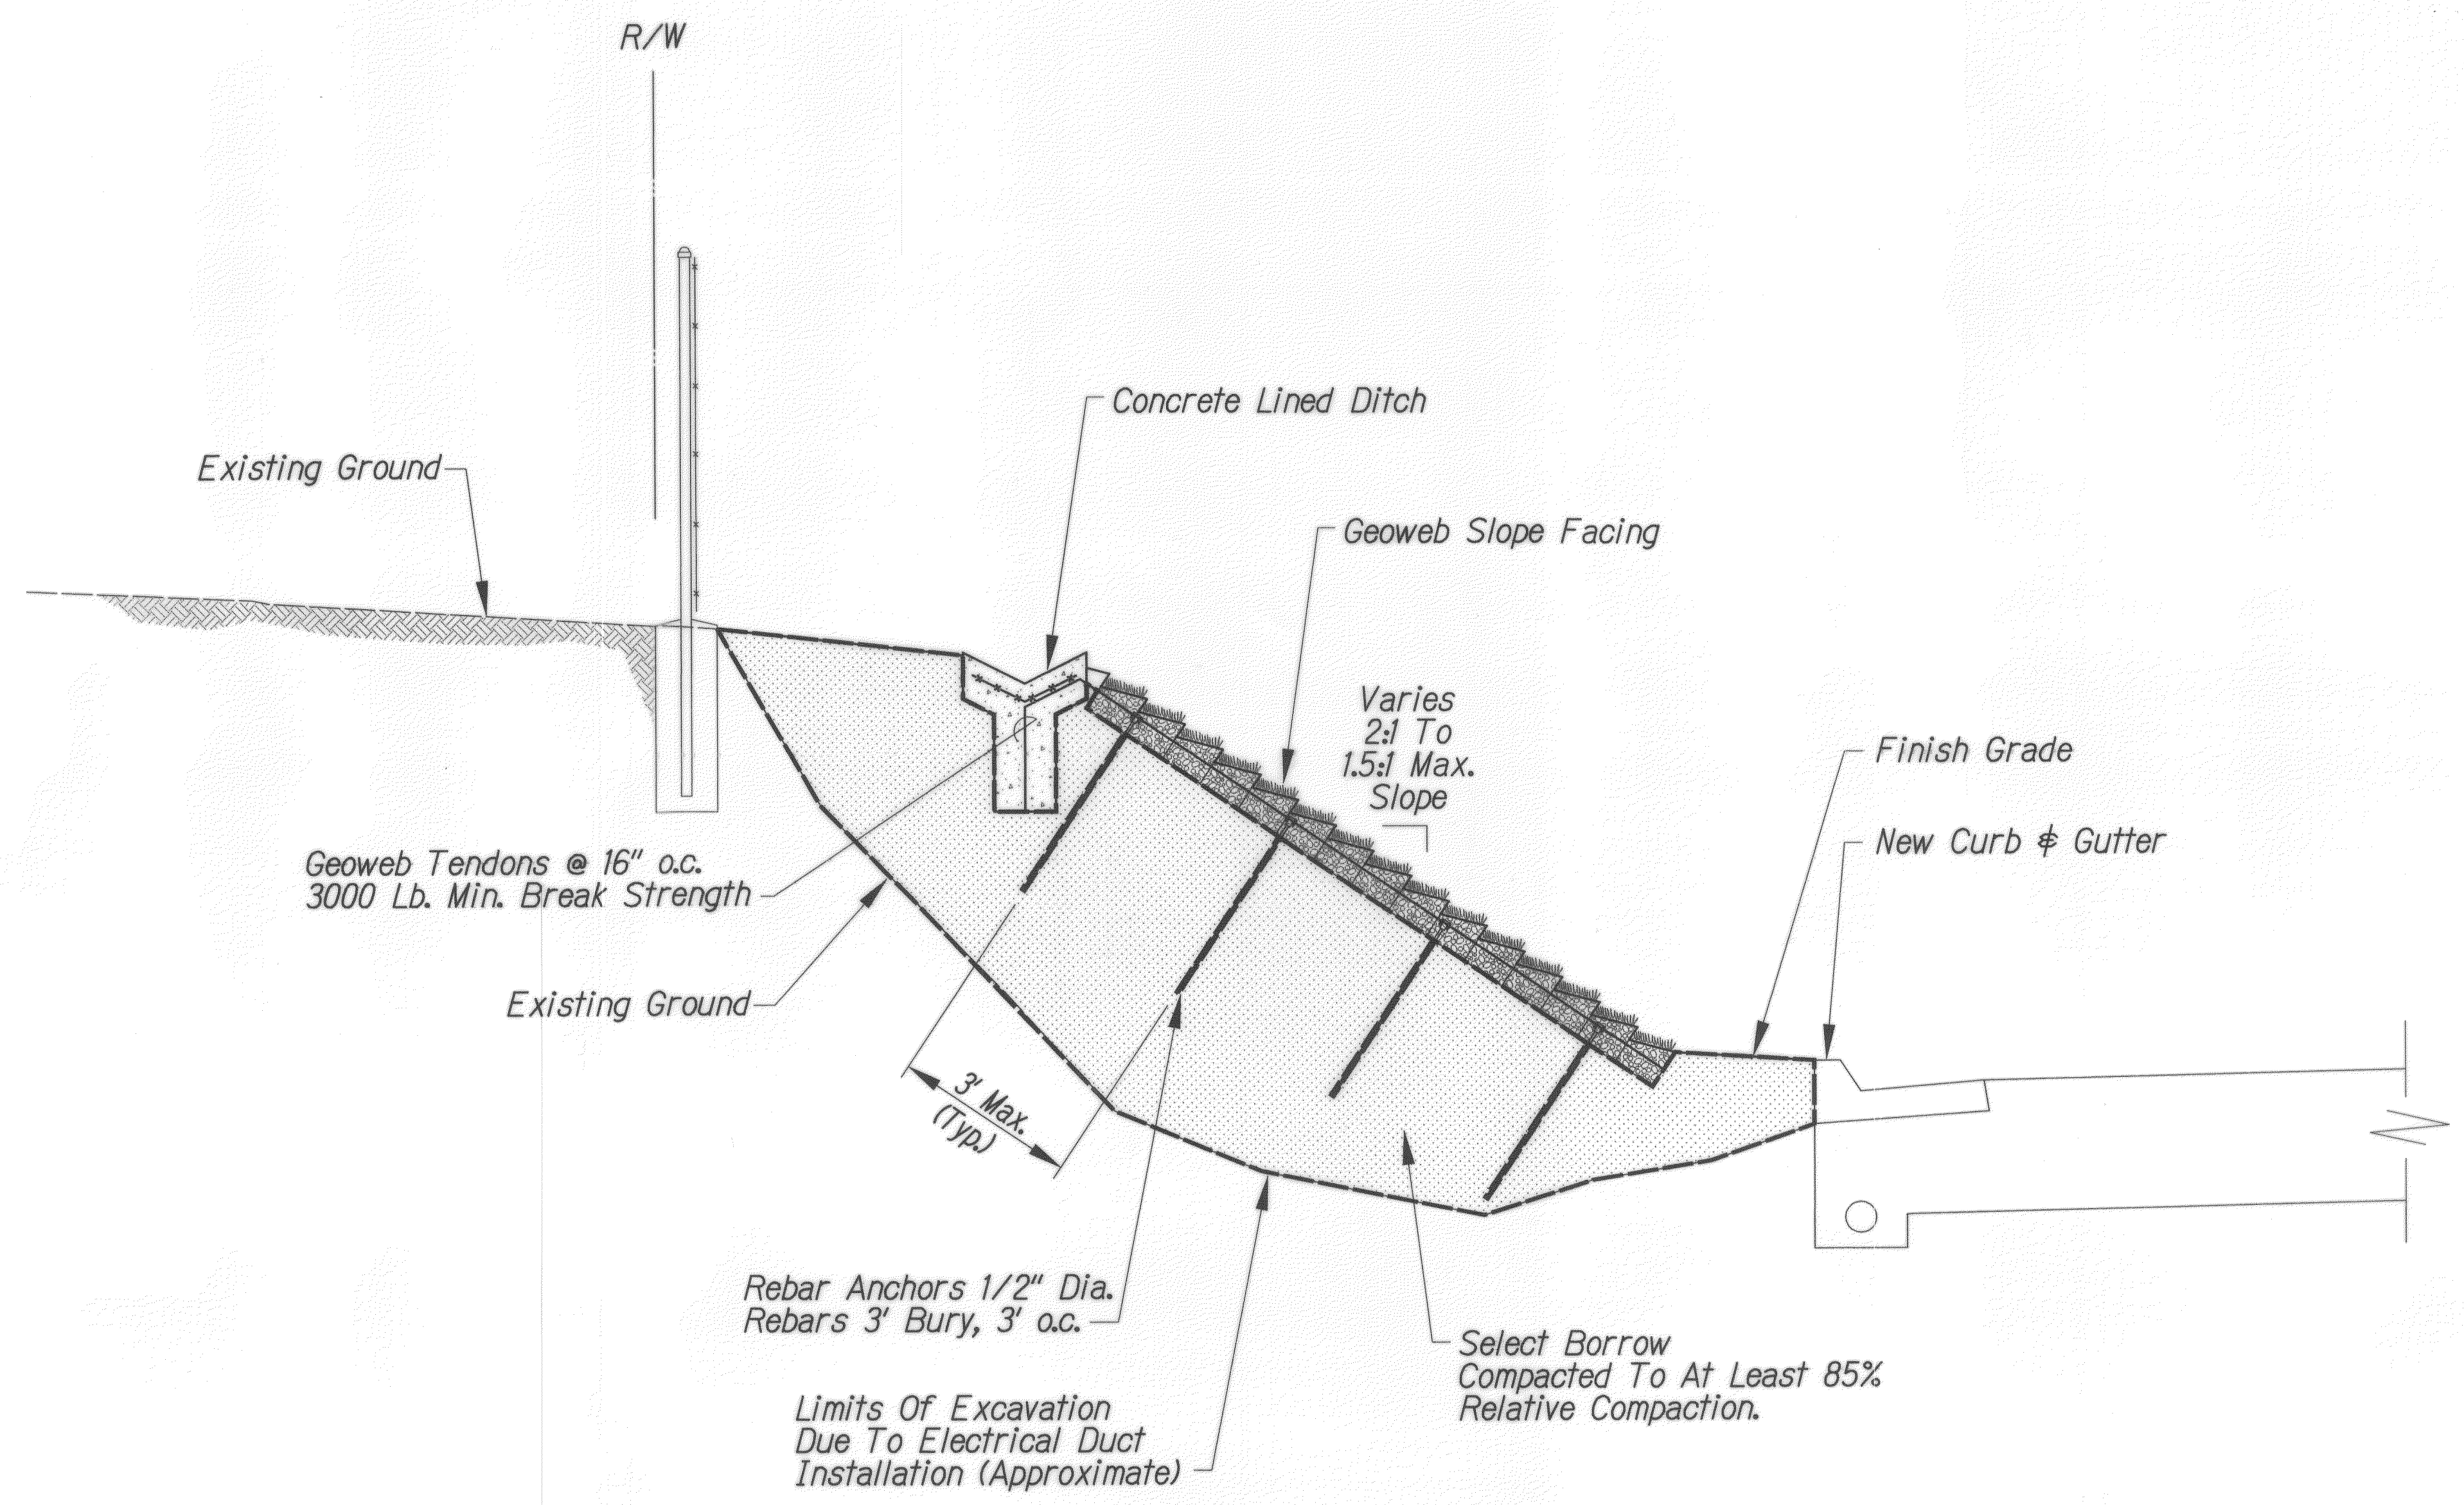

Sta. 11+80± To 12+30
TYPICAL SECTION OVER-EXCAVATED SLOPE
 Scale: 1" = 2'

SURVEY PLOTTED BY	DATE
DRAWN BY	
TRACED BY	
DESIGNED BY	
QUANTITIES BY	
CHECKED BY	

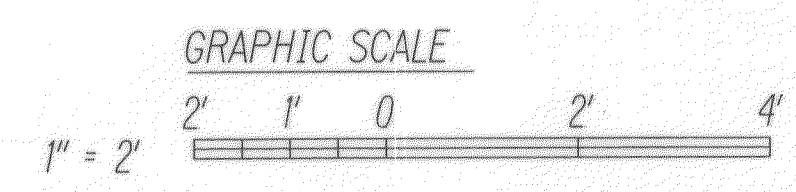

CRAIG S. ARAKAKI
 LICENSED PROFESSIONAL ENGINEER
 No. 5510-C
 HAWAII, U.S.A.
 LICENSE EXP. DATE 04-30-12
 THIS WORK WAS PREPARED BY ME OR UNDER MY SUPERVISION AND CONSTRUCTION OF THIS PROJECT WILL BE UNDER MY OBSERVATION AS DEFINED IN HAWAII TITLE 16, CHAPTER 115, RULES OF THE BOARD OF PROFESSIONAL ENGINEERS, ARCHITECTS AND SURVEYORS, STATE OF HAWAII.
Craig S. Arakaki

1/21/11	Added Sheet
DATE	REVISION

STATE OF HAWAII
 DEPARTMENT OF TRANSPORTATION
 HIGHWAYS DIVISION

MISCELLANEOUS DETAILS

INTERSTATE ROUTE H-1
Kinohiwa Street Off-Ramp Improvements
Vicinity Of Queen's Medical Center
Federal-Aid Project No. TC-HI-1(258)
 Scale: As Shown Date: Dec. 2006

SHEET No. 2 OF 2 SHEETS

FED. ROAD DIST. NO.	STATE	FED. AID PROJ. NO.	FISCAL YEAR	SHEET NO.	TOTAL SHEETS
HAWAII	HAW.	TC-HI-1(258)	2006	60,305-6	89


CURVE DATA		
Curve	1	2
Δ	165° 16' 00"	311° 15' 00"
$\Delta/2$	82° 38' 00"	155° 37' 30"
R	4.00'	8.00'
T	30.94'	3.62'
Ch	7.93'	6.60'
Lc	11.54'	43.46'
Curve	3	4
Δ	90° 45' 00"	15° 25' 34"
$\Delta/2$	45° 23' 30"	7° 42' 47"
R	8.00'	300.00'
T	8.11'	40.63'
Ch	11.39'	80.53'
Lc	12.67'	80.77'
Curve	5	6
Δ	60° 00' 00"	5° 13' 00"
$\Delta/2$	30° 00' 00"	2° 36' 30"
R	10.00'	214.00'
T	5.77'	9.75'
Ch	10.00'	19.48'
Lc	10.47'	19.48'
Curve	7	
Δ	79° 23' 00"	
$\Delta/2$	39° 41' 30"	
R	10.00'	
T	8.30'	
Ch	12.77'	
Lc	13.86'	

Approved By:


M. J. [Signature] 6/7/11
Chief, Civil Engineering Branch, DPP Date

[Signature] 6/12/11
Chief, Traffic Review Branch, DPP Date

DATE	REVISION
5/8/12	Added detectable warnings to replace previously removed warnings
3/28/12	Revised A.C. curb callout. Removed detectable warnings
1/21/11	Added Sheet, Added island for Alapai Improvements
DATE	REVISION
	CITY AND COUNTY DEPARTMENT OF TRANSPORTATION SERVICES HONOLULU, HAWAII
ISLAND "1" & "2" DETAILS	
INTERSTATE ROUTE H-1	
Kinohi Street Off-Ramp Improvements	
Vicinity of Queen's Medical Center	
Federal-Aid Project No. TC-HI-1(258)	
Scale: As Shown	Date: Dec. 2006
SHEET No. 2 OF 2 SHEETS	

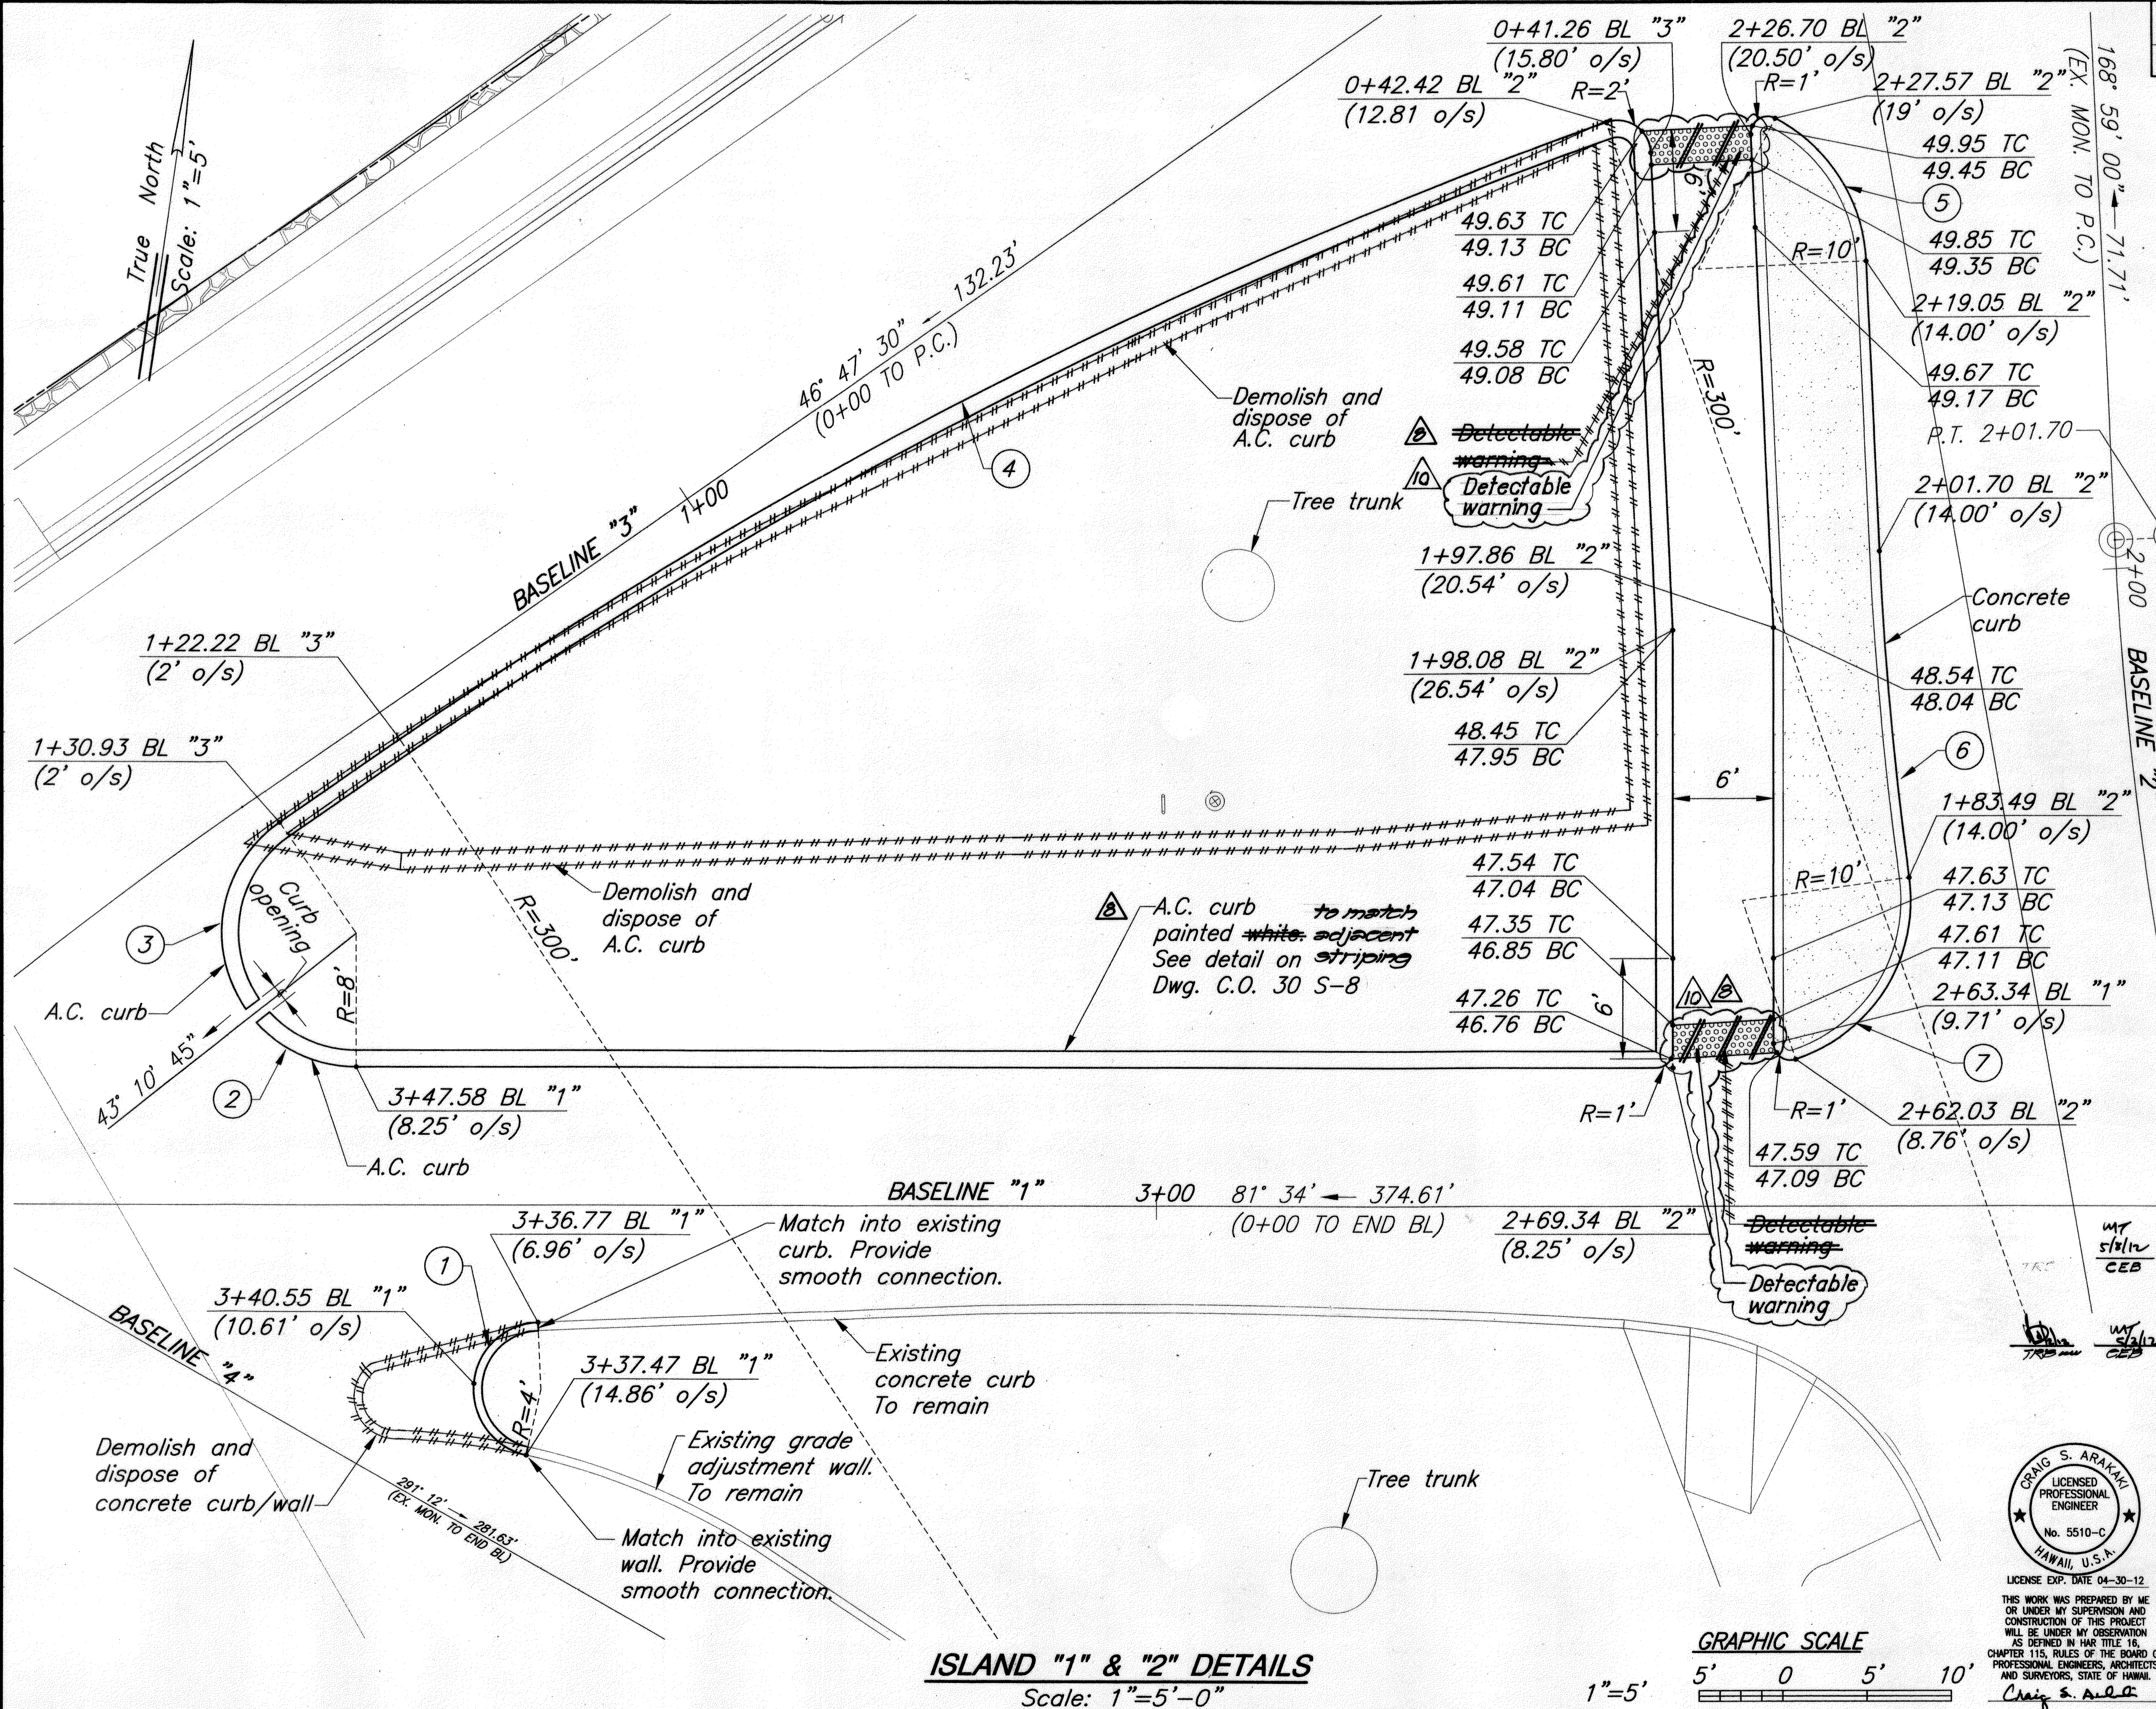

ISLAND "1" & "2" DETAILS
Scale: 1"=5'-0"

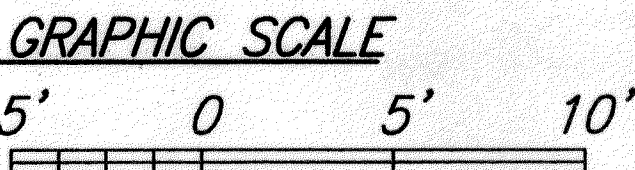

CRAIG S. ARAKAKI
LICENSED PROFESSIONAL ENGINEER
No. 5510-C
HAWAII, U.S.A.
LICENSE EXP. DATE 04-30-12
THIS WORK WAS PREPARED BY ME OR UNDER MY SUPERVISION AND CONSTRUCTION OF THIS PROJECT WILL BE UNDER MY OBSERVATION AS DEFINED IN HAW. TITLE 16, CHAPTER 115, RULES OF THE BOARD OF PROFESSIONAL ENGINEERS, ARCHITECTS AND SURVEYORS, STATE OF HAWAII.
Craig S. Arakaki

May 10, 2011 1:26pm
N:\CAD\DWG\2010\1025-ALAPAI\DOT\CO 30 S-5 ISLAND 1 & 2 DET.DWG


SURVEY PLOTTED BY	DATE
DRAWN BY	
DESIGNED BY	
QUANTITIES BY	
CHECKED BY	
NOTE BOOK	
No.	

FED. ROAD DIST. NO.	STATE	FED. AID PROJ. NO.	FISCAL YEAR	SHEET NO.	TOTAL SHEETS
HAWAII	HAW.	TC-H1-1(258)	2006	C.O.30S-7	89

CURVE DATA		
Curve	(8)	(9)
Δ	130° 32' 30"	36° 43' 30"
$\Delta/2$	65° 16' 15"	18° 21' 45"
R	8.00'	8.00'
T	17.37'	3.32'
Ch	14.53'	6.30'
Lc	18.23'	6.41'
Curve	(10)	(11)
Δ	105° 19' 00"	82° 20' 17"
$\Delta/2$	52° 39' 30"	41° 10' 08.5"
R	8.00'	18.00'
T	10.49'	15.74'
Ch	12.72'	23.70'
Lc	14.71'	25.87'
Curve	(12)	(13)
Δ	127° 57' 30"	148° 09' 30"
$\Delta/2$	63° 58' 45"	74° 04' 45"
R	2.00'	2.00'
T	4.10'	7.01'
Ch	3.59'	3.85'
Lc	4.47'	5.17'
Curve	(14)	
Δ	83° 53' 00"	
$\Delta/2$	41° 56' 30"	
R	4.00'	
T	3.59'	
Ch	5.35'	
Lc	5.86'	


Approved By:		6/7/11
Chief, Civil Engineering Branch, DPP	mt	Date
Chief, Traffic Review Branch, DPP	mt	Date

5/8/12	Added detectable warnings to replace previously removed warnings
3/22/12	Revised A.C. curb callout. Removed detectable warnings
1/21/11	Added Sheet, Added Islands for Alapai Improvements.
DATE	REVISION
CITY AND COUNTY DEPARTMENT OF TRANSPORTATION SERVICES HONOLULU, HAWAII	
ISLAND "3" & "4" DETAILS	
INTERSTATE ROUTE H-1 Kinu Street Off-Ramp Improvements Vicinity of Queen's Medical Center Federal-Aid Project No. TC-H1-1(258)	
Scale: As Shown	Date: Dec. 2006
SHEET No. 2 OF 2 SHEETS	

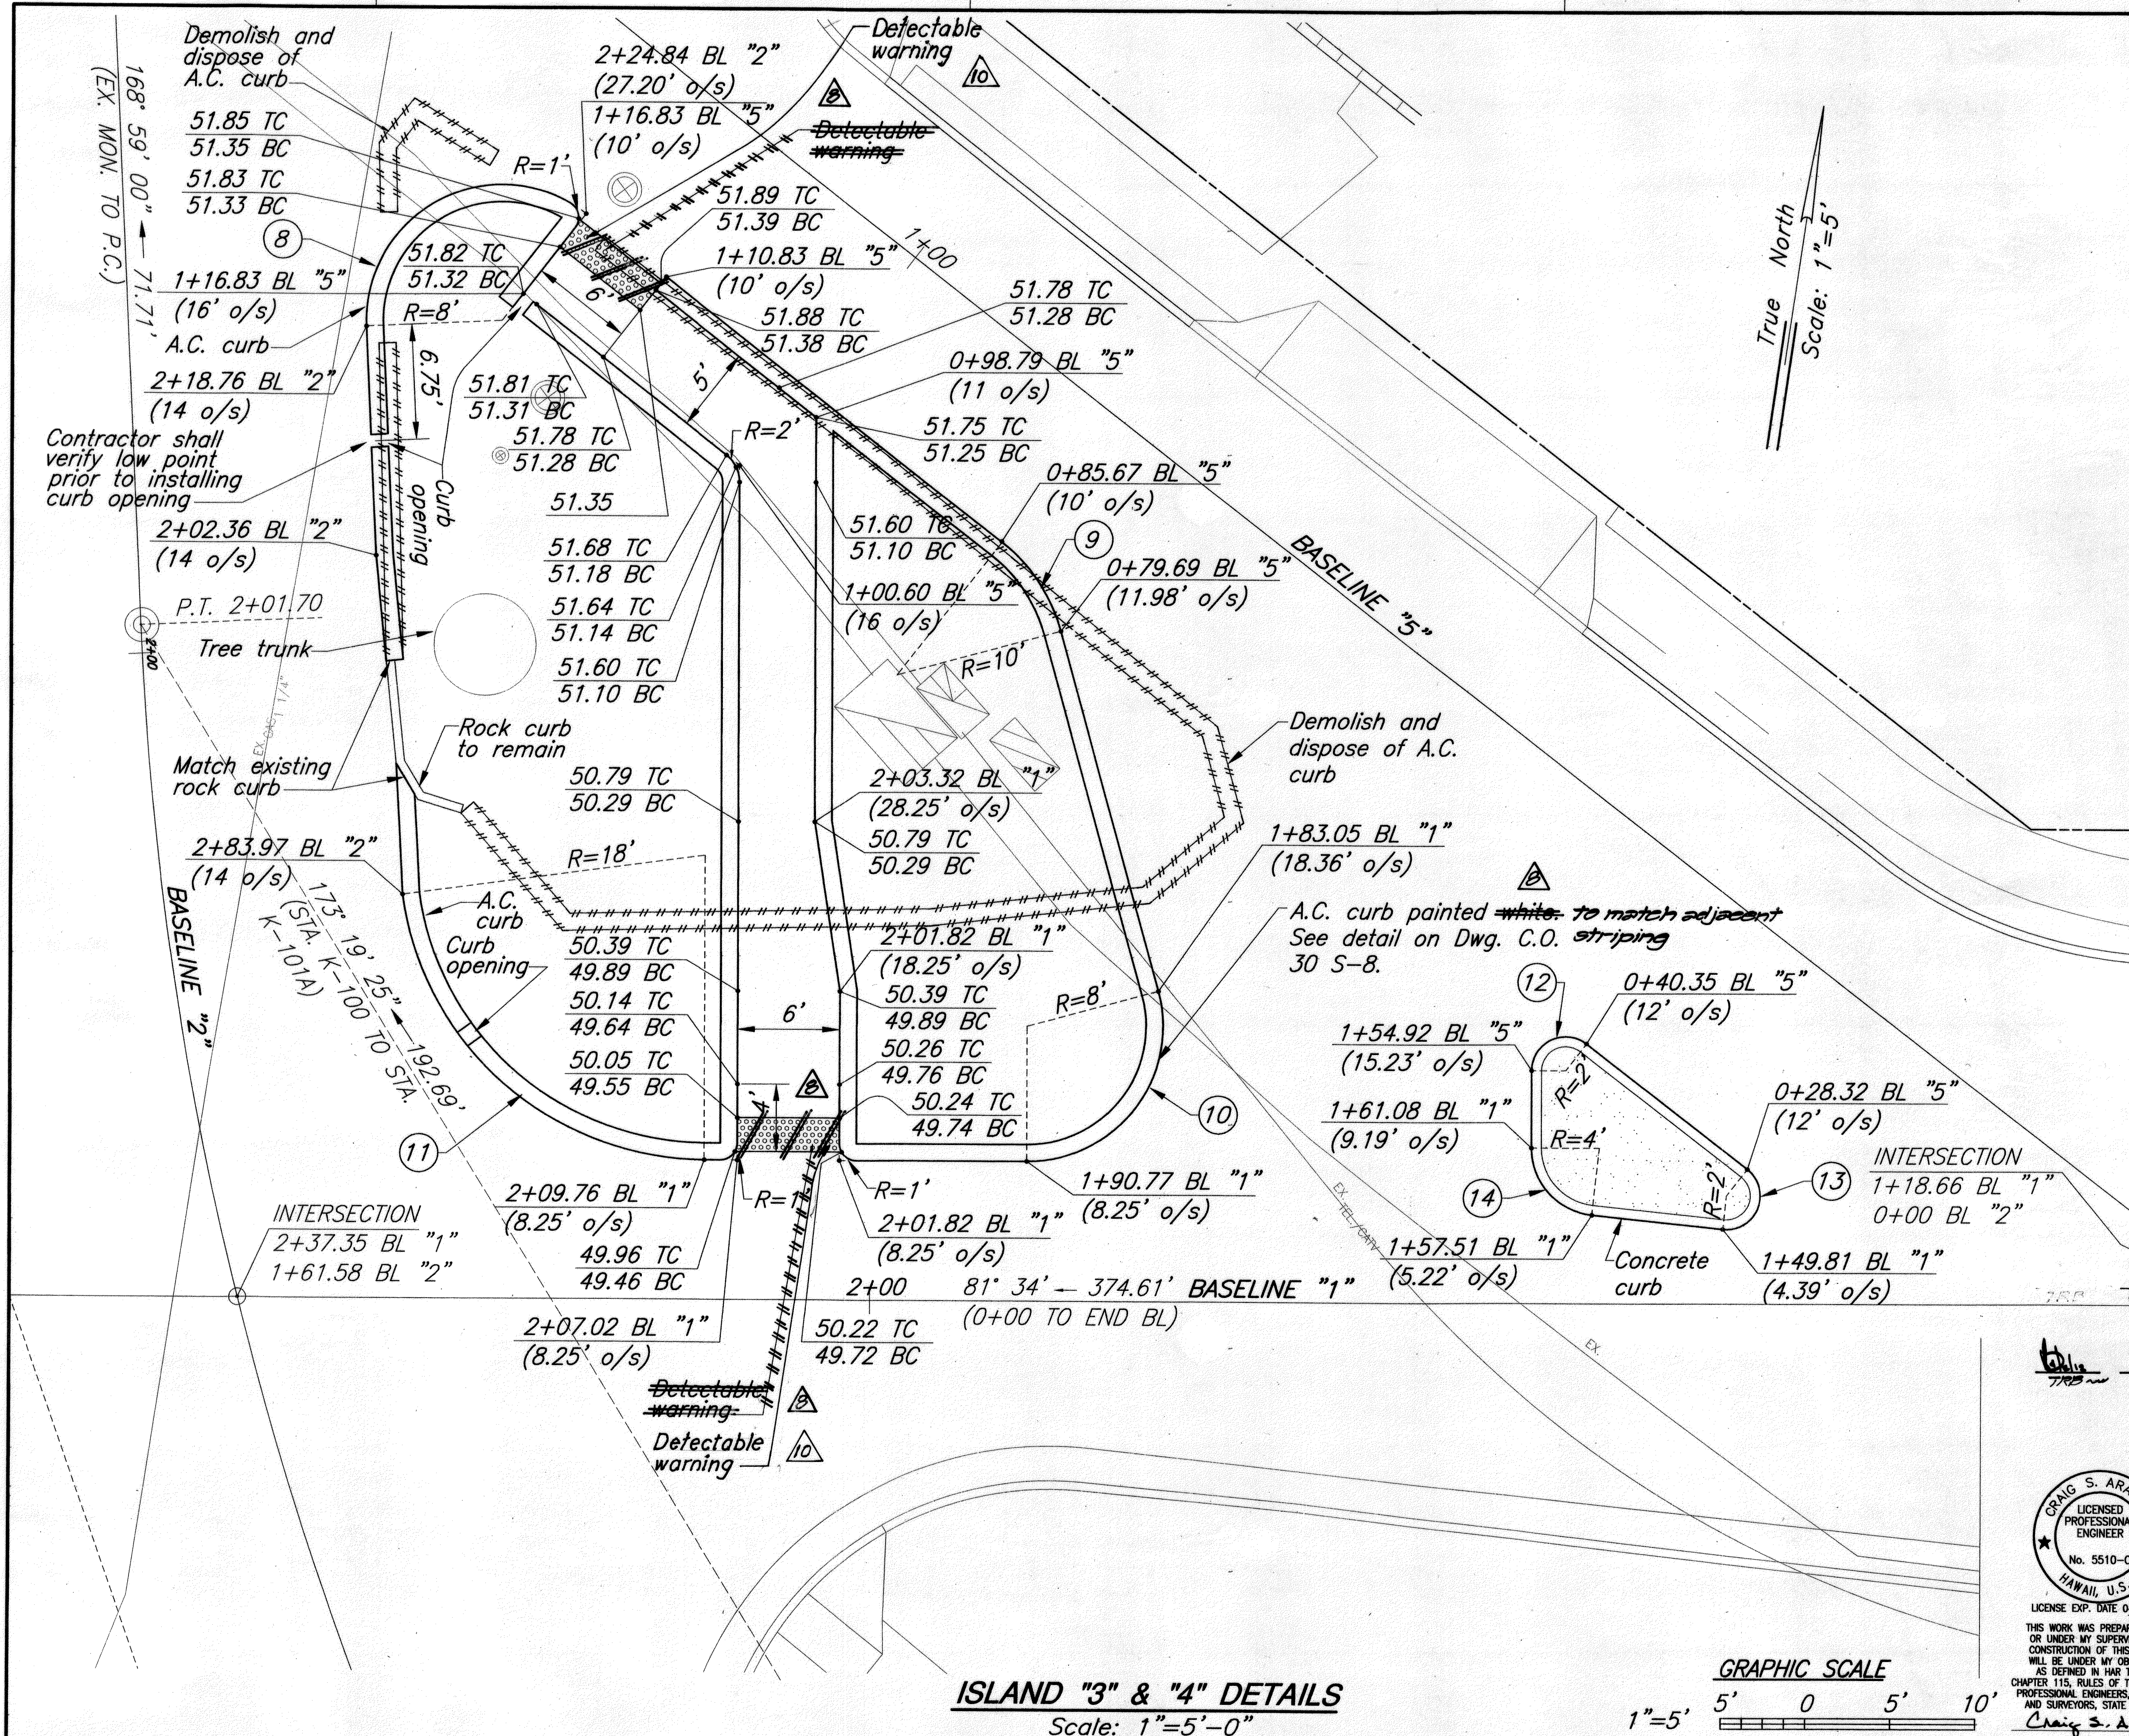

ISLAND "3" & "4" DETAILS
Scale: 1"=5'-0"

GRAPHIC SCALE

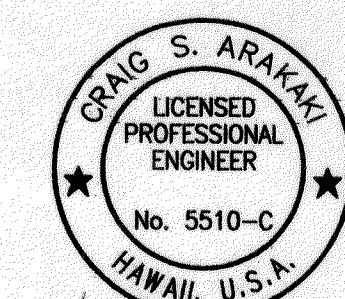


THIS WORK WAS PREPARED BY ME OR UNDER MY SUPERVISION AND CONSTRUCTION OF THIS PROJECT WILL BE UNDER MY OBSERVATION AS DEFINED IN HAWAIIAN TITLE 16, CHAPTER 115, RULES OF THE BOARD OF PROFESSIONAL ENGINEERS, ARCHITECTS AND SURVEYORS, STATE OF HAWAII.


Craig S. Arakawa

May 10, 2011-1:29pm	DATE
N:\CAO\DWG\2010\028-ALAPAI\DOT\CO 30 S-7 ISLAND 3 & 4 DET.dwg	DESIGNED BY
	CHECKED BY
	NOTED BY
	ORIGINAL PLAN
	DESIGNED BY
	CHECKED BY
	NOTED BY
	ORIGINAL PLAN


FED. ROAD DIST. NO.	STATE	FED. AID PROJ. NO.	FISCAL YEAR	SHEET NO.	TOTAL SHEETS
HAWAII	HAW.	TC-H1-1(258)	2006	C.O. 30 S-8	89

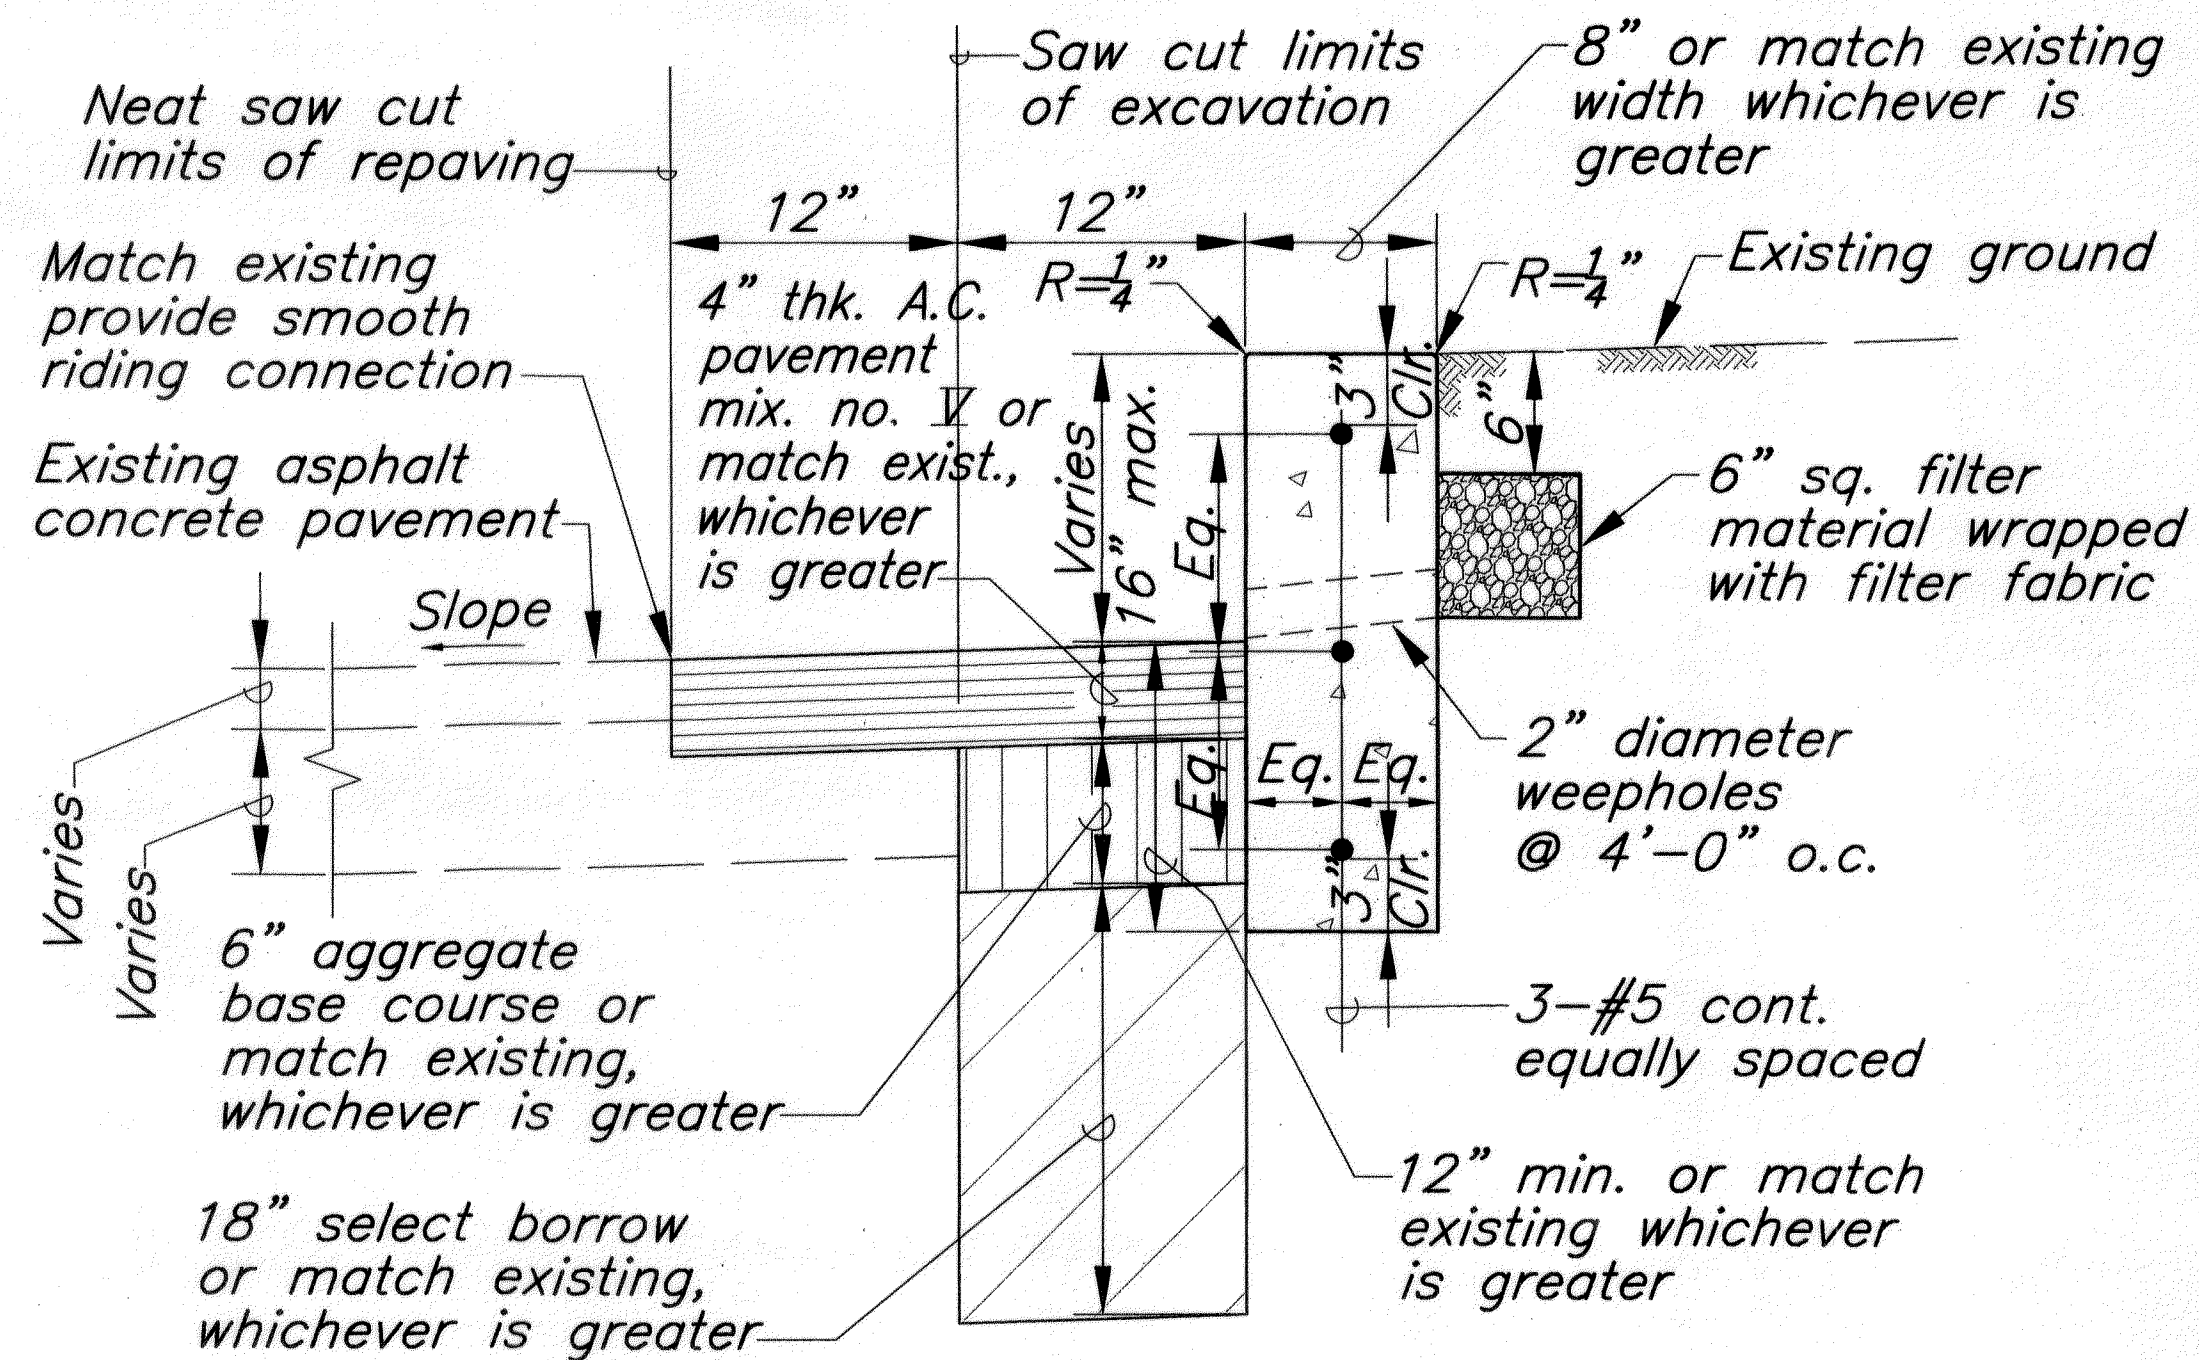

SECTION-GRADE AJUSTMENT WALL
SCALE "1 1/2" = 1'-0"

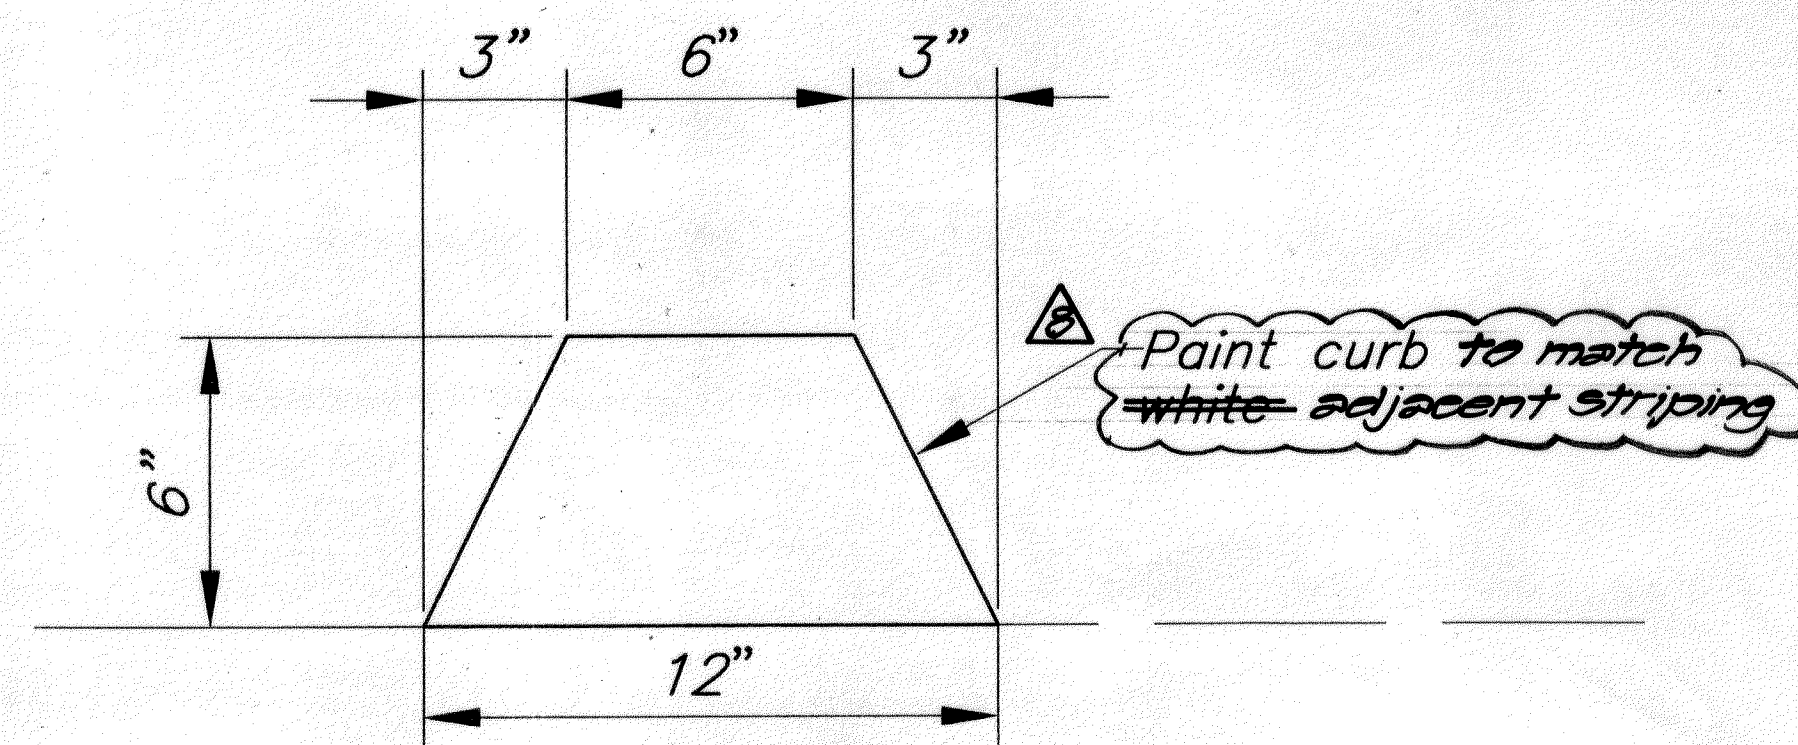

ASPHALT CONCRETE CURB DETAILS
Scale "3" = 1'-0"

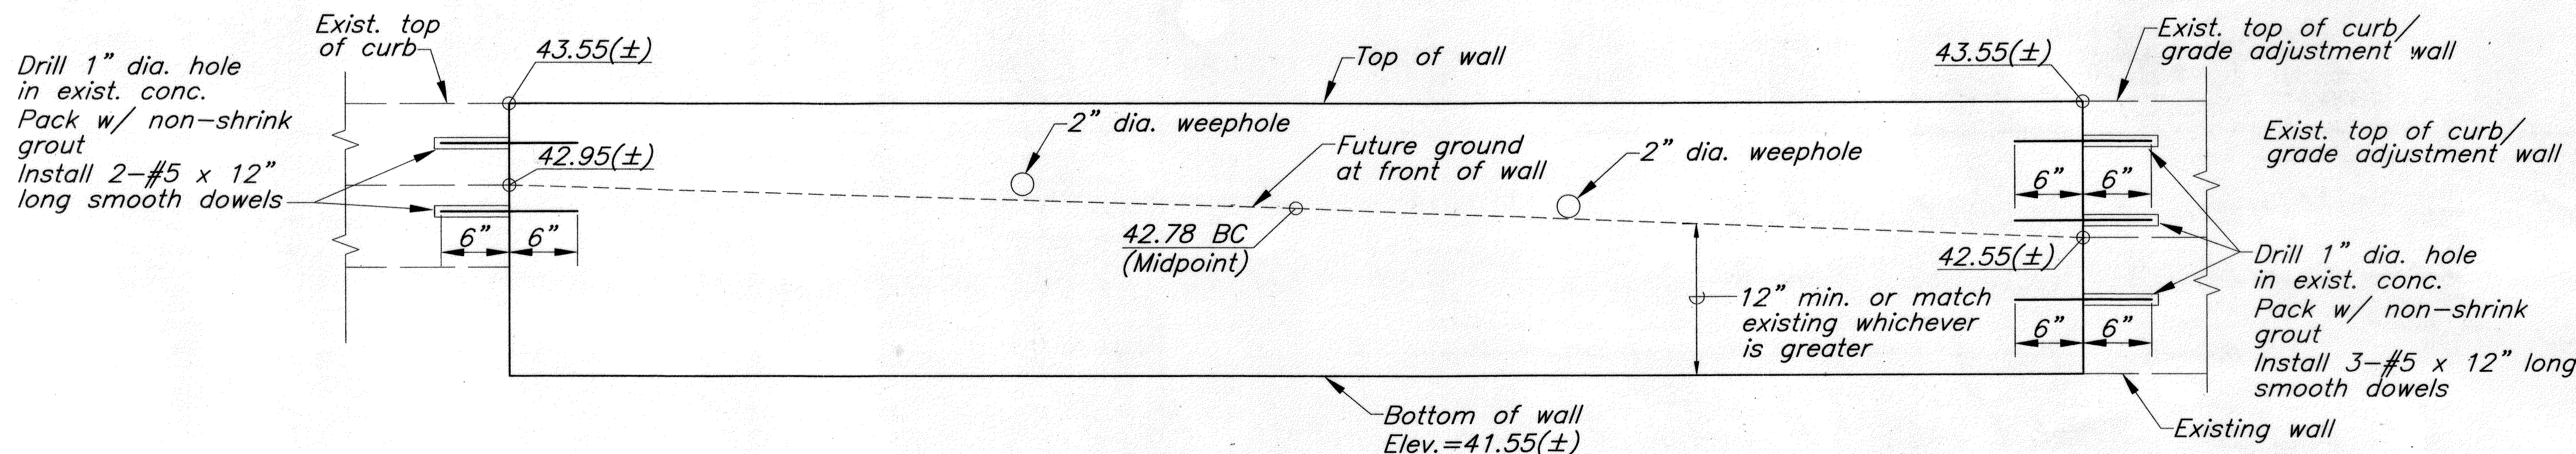

PROFILE-GRADE AJUSTMENT WALL
Scale "1 1/2" = 1'-0"

May 10, 2011-11:31pm N:\CAD\DWG\2010\1026-ALAPAI\DOT\GO 30 S-8-MISCELLANEOUS DET.DWG	SURVEY PLOTTED BY	DATE
ORIGINAL PLAN	DRAWN BY	DATE
NOTE BOOK	TRACED BY	DATE
	CHECKED BY	DATE
	CHECKED BY	DATE
Approved By:
M. J. [Signature] 6/7/11
Chief, Civil Engineering Branch, DPP
[Signature] 6/21/11
Chief, Traffic Review Branch, DPP




LICENSE EXP. DATE 04-30-12
THIS WORK WAS PREPARED BY ME OR UNDER MY SUPERVISION AND CONSTRUCTION OF THIS PROJECT WILL BE UNDER MY OBSERVATION AS DEFINED IN H.A.R. TITLE 16, CHAPTER 115, RULES OF THE BOARD OF PROFESSIONAL ENGINEERS, ARCHITECTS AND SURVEYORS, STATE OF HAWAII.
Craig S. Arakaki


GRAPHIC SCALE




9/28/12	Revised asphalt concrete curb detail.
1/21/11	Added Sheet, Added detail for Alapai repaving
DATE	REVISION
CITY AND COUNTY OF TRANSPORTATION SERVICES HONOLULU, HAWAII	
MISCELLANEOUS DETAILS	
INTERSTATE ROUTE H-1 Kinohi Street Off-Ramp Improvements Vicinity of Queen's Medical Center Federal-Aid Project No. TC-H1-1(258)	
Scale: As Shown	Date: Dec. 2006
SHEET No. 2 OF 2 SHEETS	

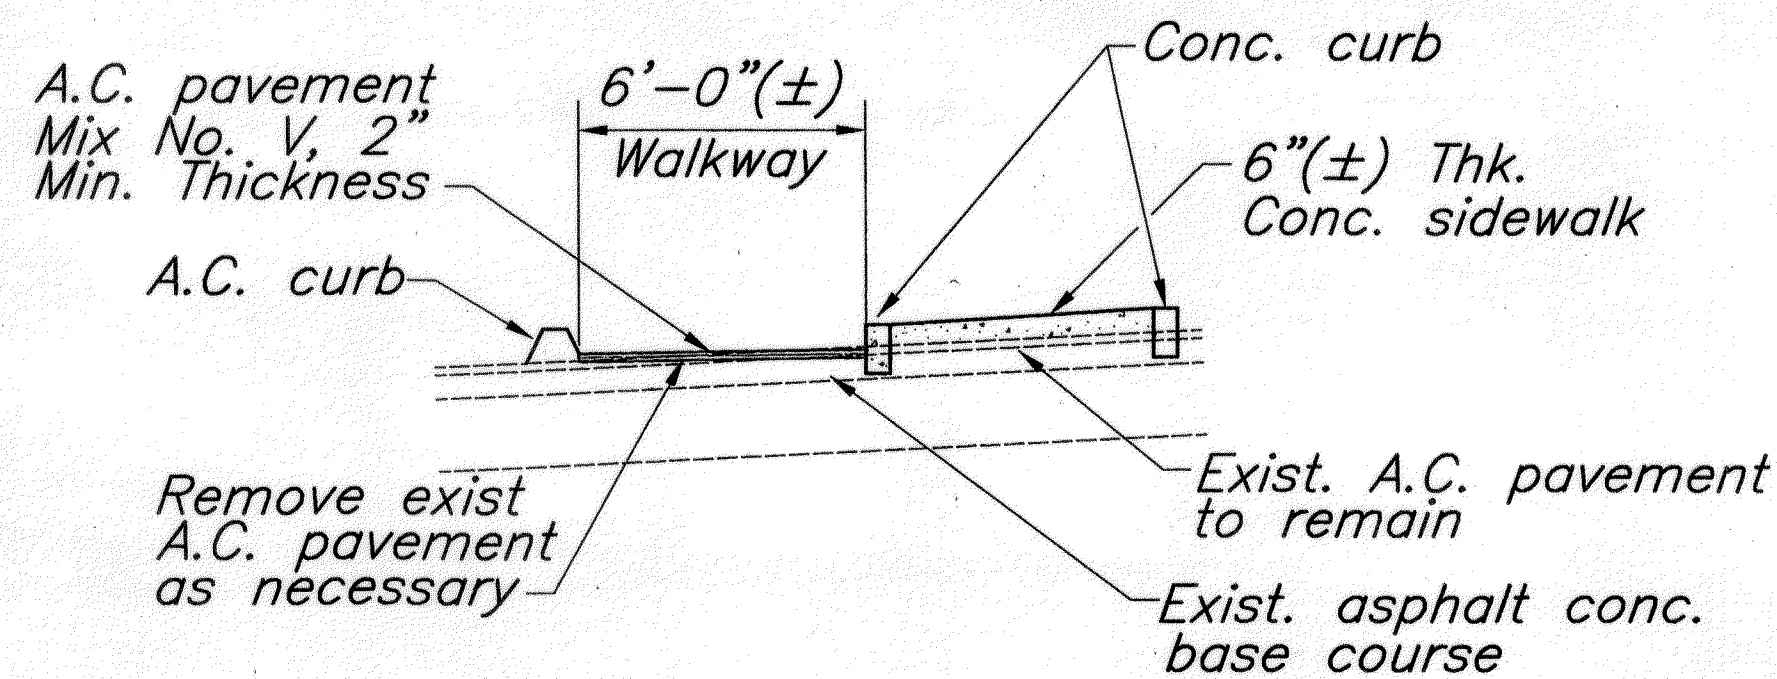


ISLANDS "1" & "2"
TYPICAL WALKWAY SECTION
Scale: 1/4"=1'-0"

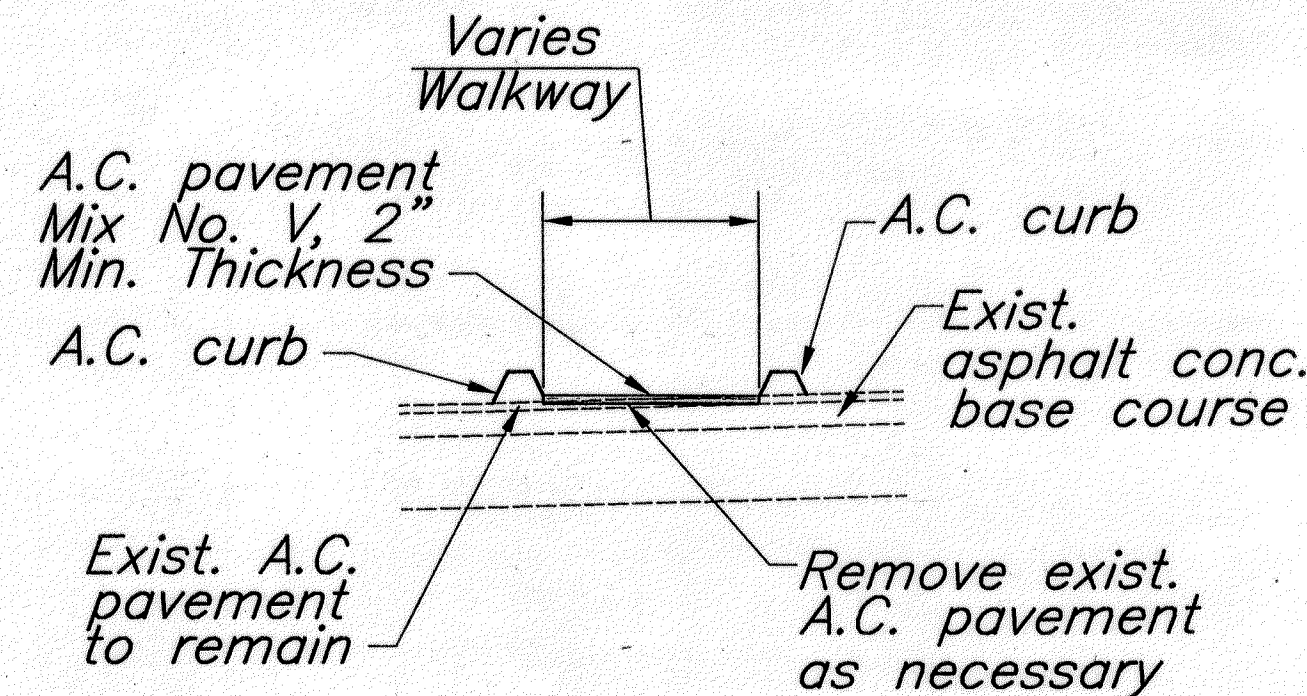

ISLAND "3"
TYPICAL WALKWAY SECTION
Scale: 1/4"=1'-0"

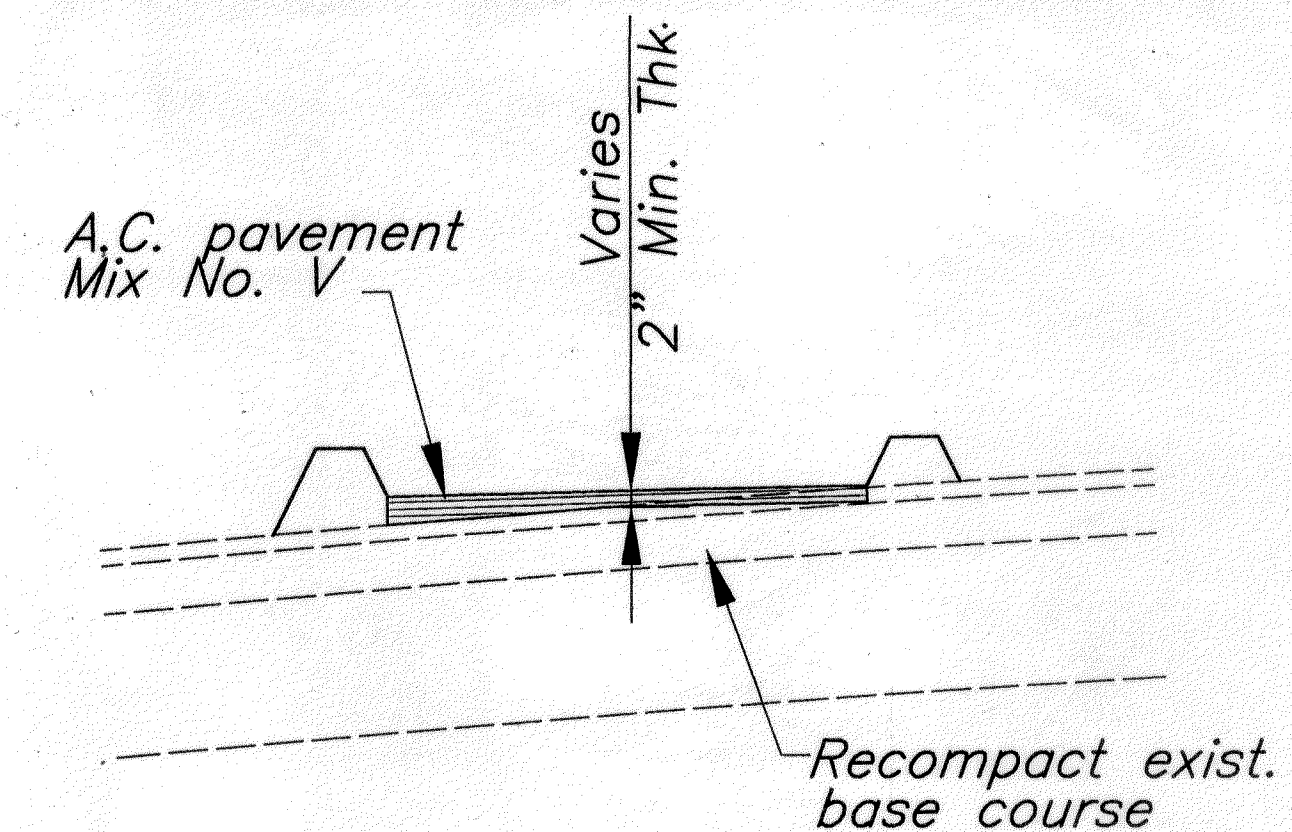

TYPICAL WALKWAY DETAIL
Scale: 1/2"=1'-0"

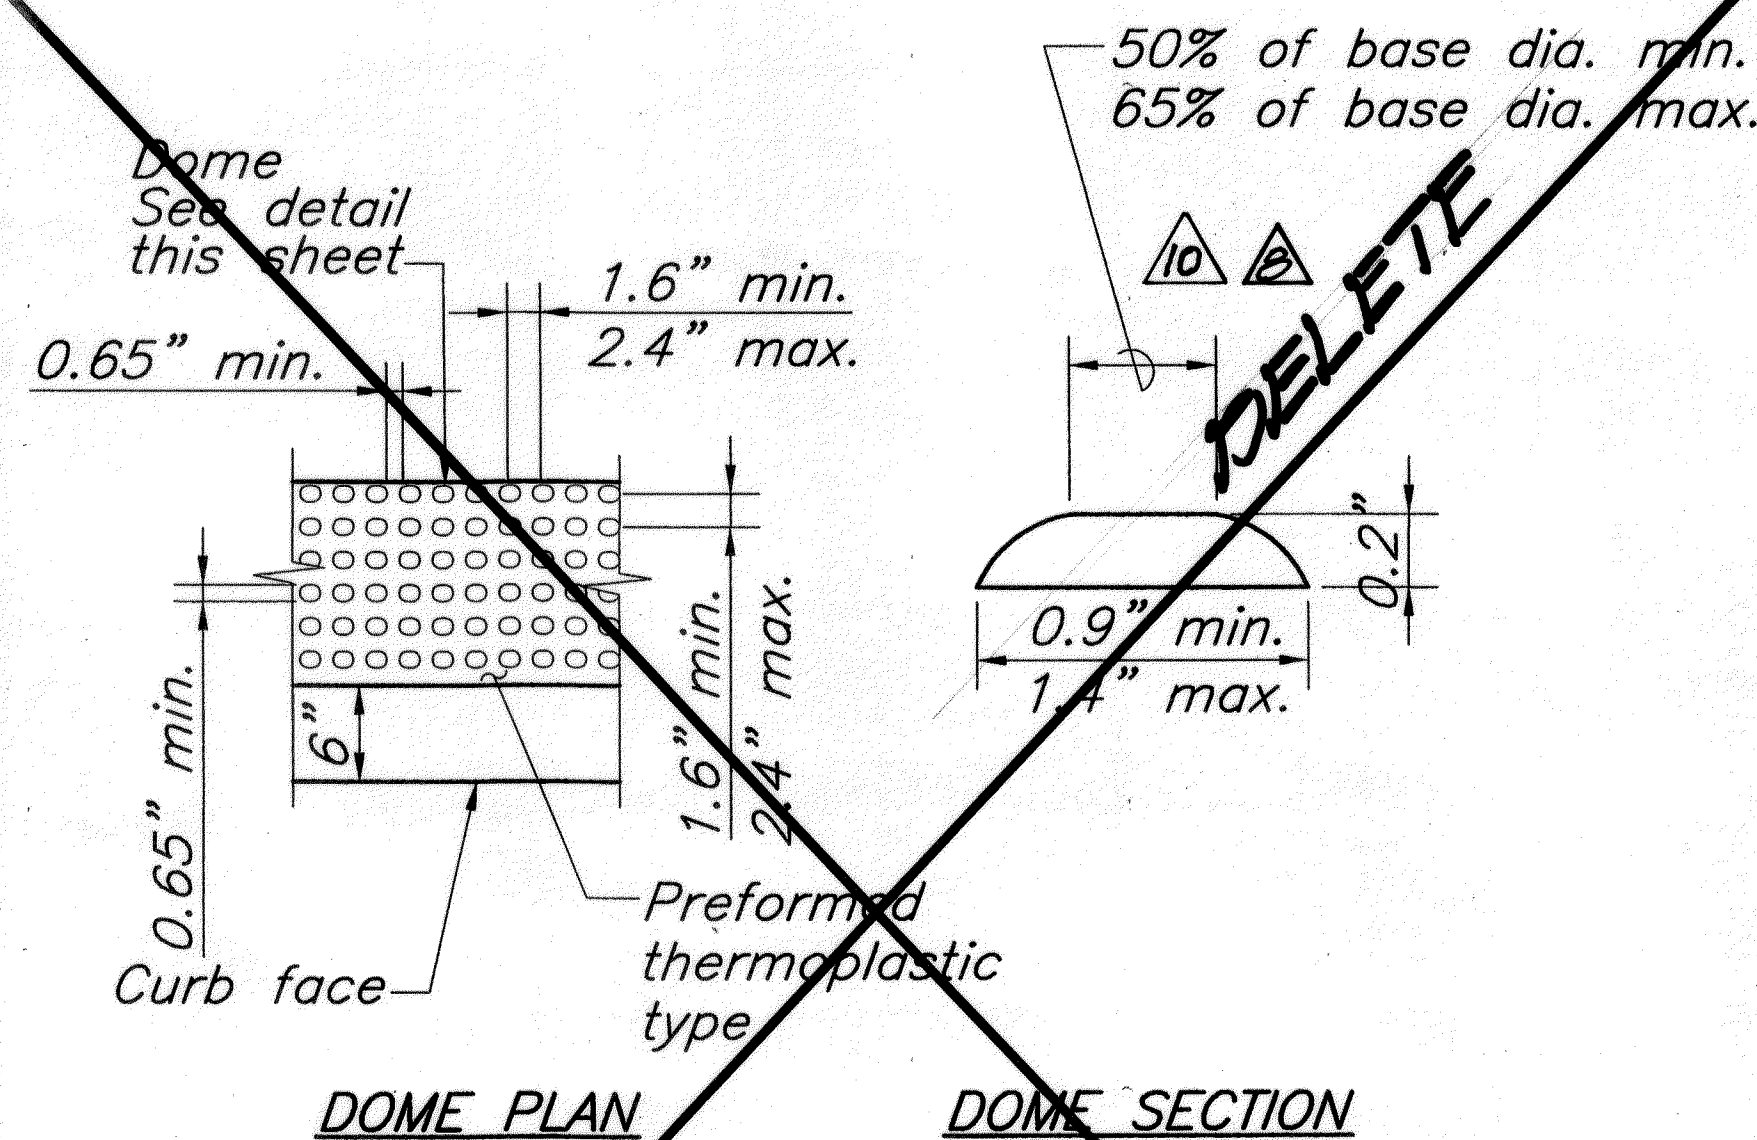

DOME PLAN **DOME SECTION**

NOTE:


Detectable warnings shall be "Safety Yellow". The material used shall be an integral part of the detectable warning surface.

**PREFORMED THERMOPLASTIC TYPE
DETECTABLE WARNING**

No scale

NOTES FOR TRUNCATED DOME DETECTABLE WARNING

- Detectable warnings shall consist of a surface of truncated domes.
- Detectable warnings shall be 24 inches in the direction of travel and extend the full width of the curb ramp or flush surfaces (Does not include flares).
- Truncated domes shall have a base diameter of 0.9 inch minimum and 1.4 inches maximum, a top diameter of 50 percent of the base diameter minimum to 65 percent of the base diameter maximum, and height of 0.2 inch.
- Truncated domes in a detectable warning surface shall have a center-to-center spacing of 1.6 inches minimum and 2.4 inches maximum, and a base-to-base spacing of 0.65 inch minimum, measured between the most adjacent domes on a square arrangement.
- Domes shall be aligned on a square grid in the predominant direction of travel to permit wheels to roll between the domes.
- There shall be a minimum of 70 percent contrast in light reflectance between the detectable warning and an adjoining surface, or the detectable warning shall be "safety yellow".
- The material used to provide visual contrast shall be an integral part of the detectable warning surface.
- The detectable warning shall be located so that the edge nearest the curb line or other potential hazard is 6 to 8 inches from the curb line.

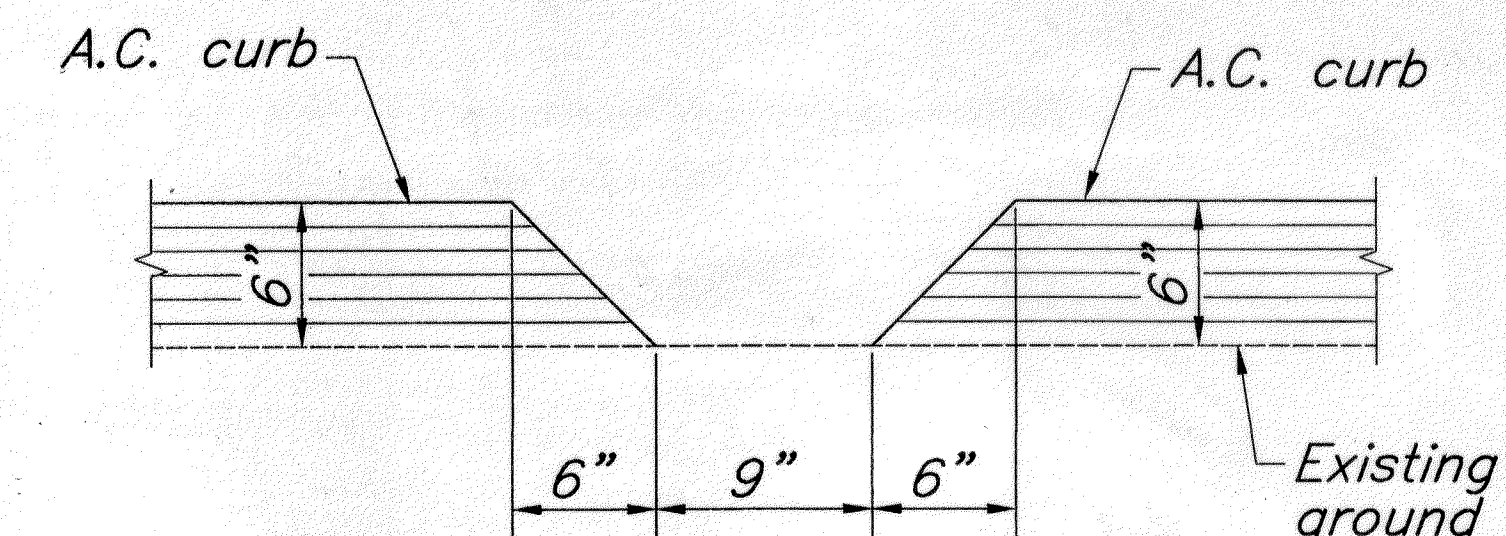


CURB OPENING DETAIL
Scale: 1 1/2"=1'-0"

Approved By:
M. J. [Signature] 6/7/11 Date
Chief, Civil Engineering Branch, DPP
[Signature] 6/12/11 Date
Chief, Traffic Review Branch, DPP

GRAPHIC SCALE

1/4"=1'-0" 4' 2' 0 4' 8'

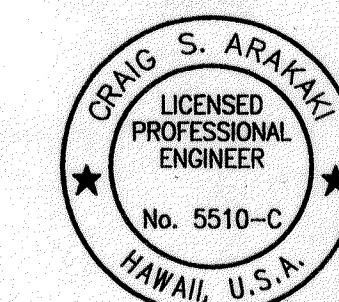

LICENSE EXP. DATE 04-30-12
THIS WORK WAS PREPARED BY ME OR UNDER MY SUPERVISION AND CONSTRUCTION OF THIS PROJECT WILL BE UNDER MY OBSERVATION AS DEFINED IN HAWAII TITLE 16, CHAPTER 115, RULES OF THE BOARD OF PROFESSIONAL ENGINEERS, ARCHITECTS AND SURVEYORS, STATE OF HAWAII.
Craig S. Arakaki

5/8/12	10	Replace previously removed detectable warning details
3/28/12	11	Removed detectable warning details
1/21/11	15	Added Sheet, Added walkway sections & details
DATE	REVISION	
CITY AND COUNTY DEPARTMENT OF TRANSPORTATION SERVICES HONOLULU, HAWAII		
<u>MISCELLANEOUS DETAILS</u>		
<u>INTERSTATE ROUTE H-1</u> <u>Kinohi Street Off-Ramp Improvements</u> <u>Vicinity of Queen's Medical Center</u> <u>Federal-Aid Project No. TC-H1-1(258)</u>		
Scale: As Shown		Date: Dec. 2006
SHEET No. 2 OF 2 SHEETS		