

[illegible]

1. General Requirements:

(A) *Hawaii Department of Transportation, Standard Specifications for Road and Bridge Construction, 2005, together with Special Provisions prepared for this contract.*

2. Design Specifications:

(A) *AASHTO 2004 LRFD Bridge Design Specifications (Third Edition) and its subsequent interim specifications with interim supplements.*

3. Loads:

(A) *Live Load: 85 psf*

4. Materials:

(A) *All concrete strengths shall be as noted below:*

<u>Item No.</u>	<u>Structural Parts</u>	<u>Classes of Concrete</u>	<u>Specified Compressive Strength, f'c (28 Day)</u>
(1)	<i>Box Girder</i>	-	<i>5000 PSI</i>
(2)	<i>Topping</i>	-	<i>5000 PSI</i>
(3)	<i>Curb</i>	-	<i>5000 PSI</i>
(4)	<i>Pier</i>	-	<i>4000 PSI</i>
(5)	<i>Except as noted otherwise, all others</i>	<i>A</i>	<i>3000 PSI</i>

All concrete with the exception of Class A concrete shall have a maximum W/C Ratio of 0.45. The W/C Ratio for Class A concrete shall follow the Standard Specifications.

(B) *Tetraguard AS20 shrinkage reducing admixture (SRA) shall be included in the concrete mix for the precast girder, curb and topping. The required dosage shall be 128 ounces per cubic yard of concrete and follow all manufacturer's recommendations. CORTEC MCI-2005 NS Corrosion Inhibitor shall be added to the curbing and topping at the rate of 1.5 pints per cubic yard of concrete.*

(C) *All reinforcing steel shall be ASTM A615 Grade 60 unless otherwise noted.*

(D) *Reinforcing steel shall be ASTM A706 where welded connections are required.*

(E) *All structural steel shall be ASTM A36 hot dip galvanized after fabrication, unless otherwise noted.*

(F) *All anchor bolts, washers and nuts shall be ASTM A325 hot dip galvanized after fabrication, unless otherwise specified.*

(G) *Steel tube shall be ASTM A 500, Grade B hot dip galvanized after fabrication.*

FED. ROAD DIST. NO.	STATE	PROJ. NO.	FISCAL YEAR	SHEET NO.	TOTAL SHEETS
HAWAII	HAW.	H1 E-01-07M	2007	5	20

- (A) The minimum covering measured from the surface of the concrete to the face of any reinforcing bars shall be 1 1/2" unless otherwise noted.
- (B) Minimum clear spacing between parallel bars shall be 1 1/2 times the diameter of bars (for non bundled bars). In no case shall the clear distance between the bars be less than 1 1/2 times the maximum size of the coarse aggregate or 1 1/2".
- (C) All dimensions relating to reinforcing bars are to centers of bars unless otherwise noted.
- (D) Reinforcing bars shall be securely tied at all intersections and lap splices except where the spacing of intersections is less than one foot in each direction, in which case alternate intersections shall be tied.

(A) Unless otherwise noted, all exposed concrete edges shall be chamfered $\frac{3}{4}" \times \frac{3}{4}"$.

(B) Pier texture shall match existing.

<u>Item No.</u>	<u>Structural Parts</u>	<u>Classes of Concrete</u>	<u>Specified Compressive Strength, f'c (28 Days)</u>
(1)	Box Girder	-	5000 PSI
(2)	Topping	-	5000 PSI
(3)	Curb	-	5000 PSI
(4)	Pier	-	4000 PSI
(5)	Except as noted otherwise, all others	A	3000 PSI

All concrete with the exception of Class A concrete shall have a maximum W/C Ratio of 0.45. The W/C Ratio for Class A concrete shall follow the Standard Specifications.

(B) Tetraguard AS20 shrinkage reducing admixture (SRA) shall be included in the concrete mix for the precast girder, curb and topping. The required dosage shall be 128 ounces per cubic yard of concrete and follow all manufacturer's recommendations. CORTEC MCI-2005 NS Corrosion Inhibitor shall be added to the curbing and topping at the rate of 1.5 pints per cubic yard of concrete.

(C) All reinforcing steel shall be ASTM A615 Grade 60 unless otherwise noted.


(D) Reinforcing steel shall be ASTM A706 where welded connections are required.

(E) All structural steel shall be ASTM A36 hot dip galvanized after fabrication, unless otherwise noted.

(F) All anchor bolts, washers and nuts shall be ASTM A325 hot dip galvanized after fabrication, unless otherwise specified.

(G) Steel tube shall be ASTM A 500, Grade B hot dip galvanized after fabrication.

ORIGINAL PLAN	SURVEY PLOTTED BY _____	DATE _____
NOTE BOOK	DRAWN BY _____	_____
	TRACED BY _____	_____
	DESIGNED BY _____	_____
	QUANTITIES BY _____	_____
No. _____	CHECKED BY _____	_____

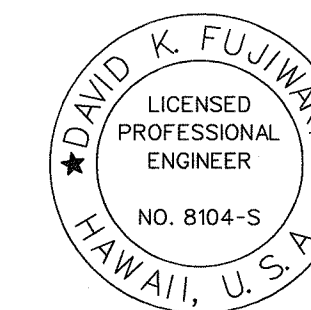

THIS WORK WAS PREPARED BY
ME OR UNDER MY SUPERVISION.

David K. Fugimori 4-30-08
SIGNATURE EXPIRATION DATE OF THE LICENSE


STATE OF HAWAII
DEPARTMENT OF TRANSPORTATION
HIGHWAYS DIVISION

INDEX TO OVERPASS DRAWINGS AND OVERPASS STRUCTURAL NOTES


Repair of Mauka Span of
Mahiko Street Pedestrian Overpass
Project No. H1 E-01-07M

Scale: None Date: Nov. 2006

FED. ROAD DIST. NO.	STATE	PROJ. NO.	FISCAL YEAR	SHEET NO.	TOTAL SHEETS
HAWAII	HAW.	HI E-01-07M	2007	6	20

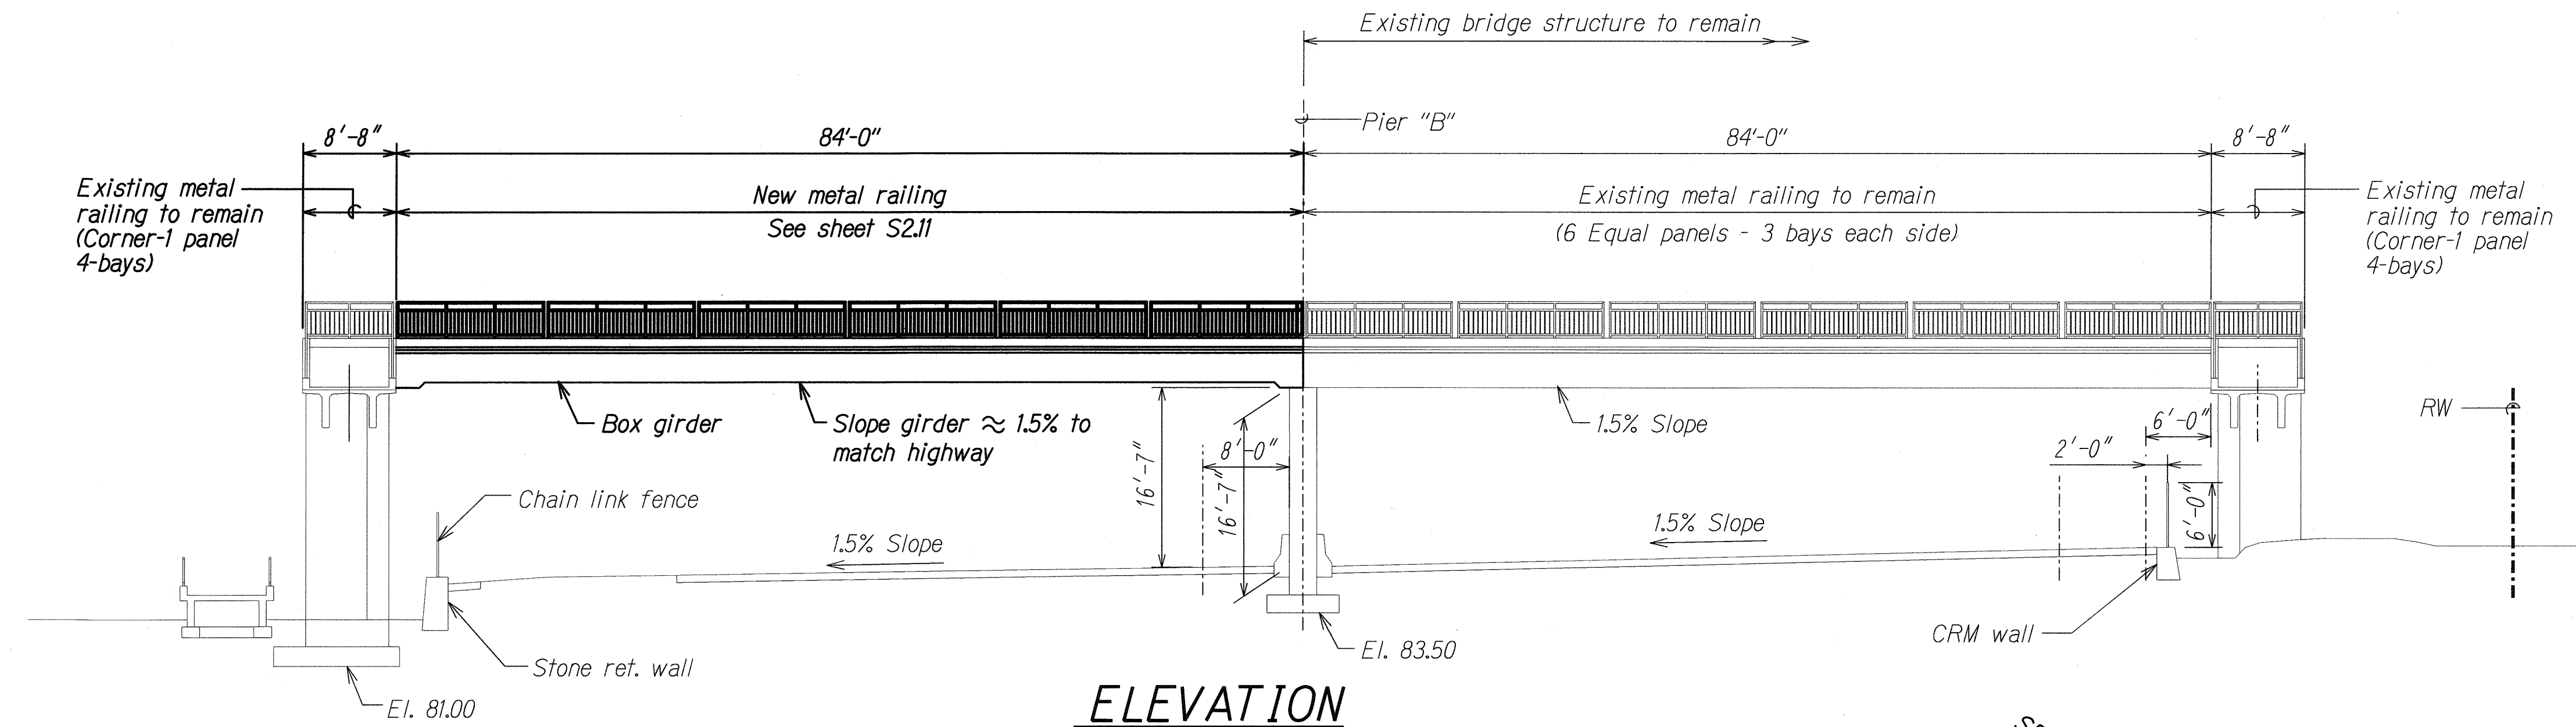


ELEVATION
SCALE: 1" = 10'-0"

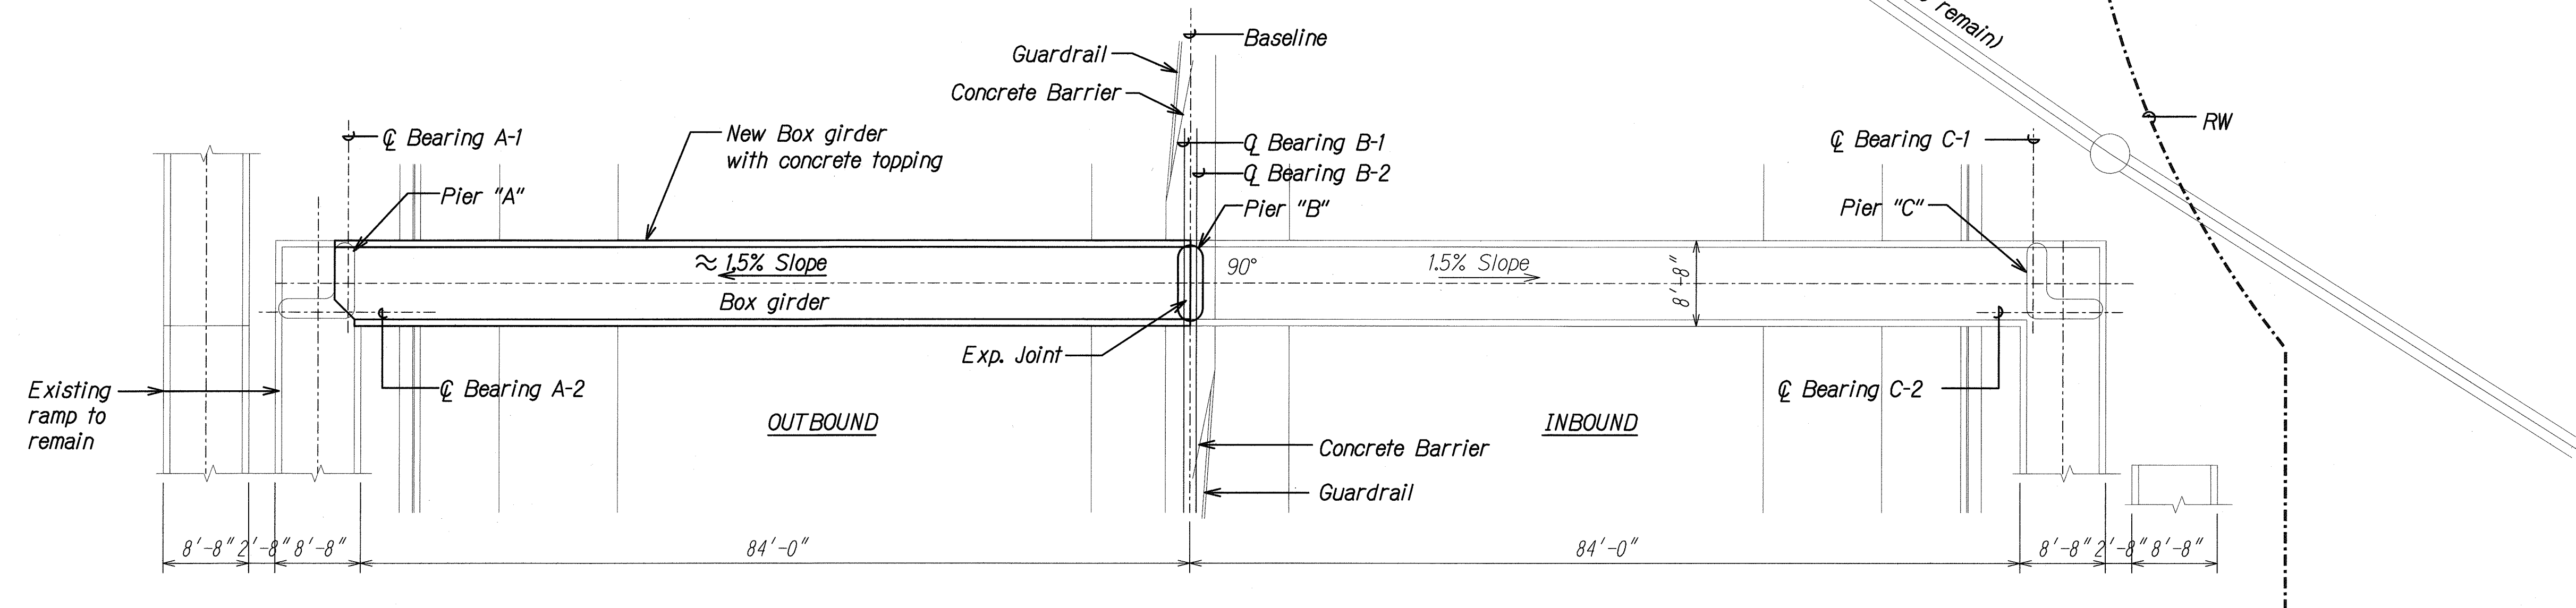

LAYOUT PLAN
SCALE: 1" = 10'-0"

ORIGINAL PLAN	DATE
DESIGNED BY	
TRACED BY	
CHECKED BY	
APPROVED BY	

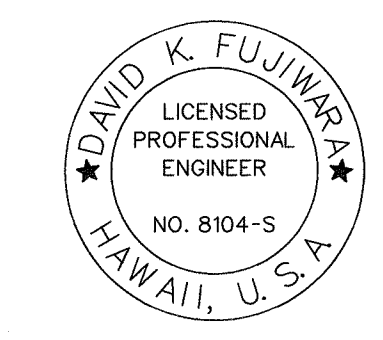

THIS WORK WAS PREPARED BY ME OR UNDER MY SUPERVISION.
 Signature: *David K. Fujiwara*
 EXPIRATION DATE OF THE LICENSE: 4-30-08

STATE OF HAWAII
DEPARTMENT OF TRANSPORTATION
HIGHWAYS DIVISION


LAYOUT PLAN AND ELEVATION

Repair of Mauka Span of Mahiko Street Pedestrian Overpass
Project No. HI E-01-07M


Scale: As Noted Date: Nov. 2006

SHEET No. S2J OF 16 SHEETS


FED. ROAD DIST. NO.	STATE	PROJ. NO.	FISCAL YEAR	SHEET NO.	TOTAL SHEETS
HAWAII	HAW.	HI E-01-07M	2007	7	20

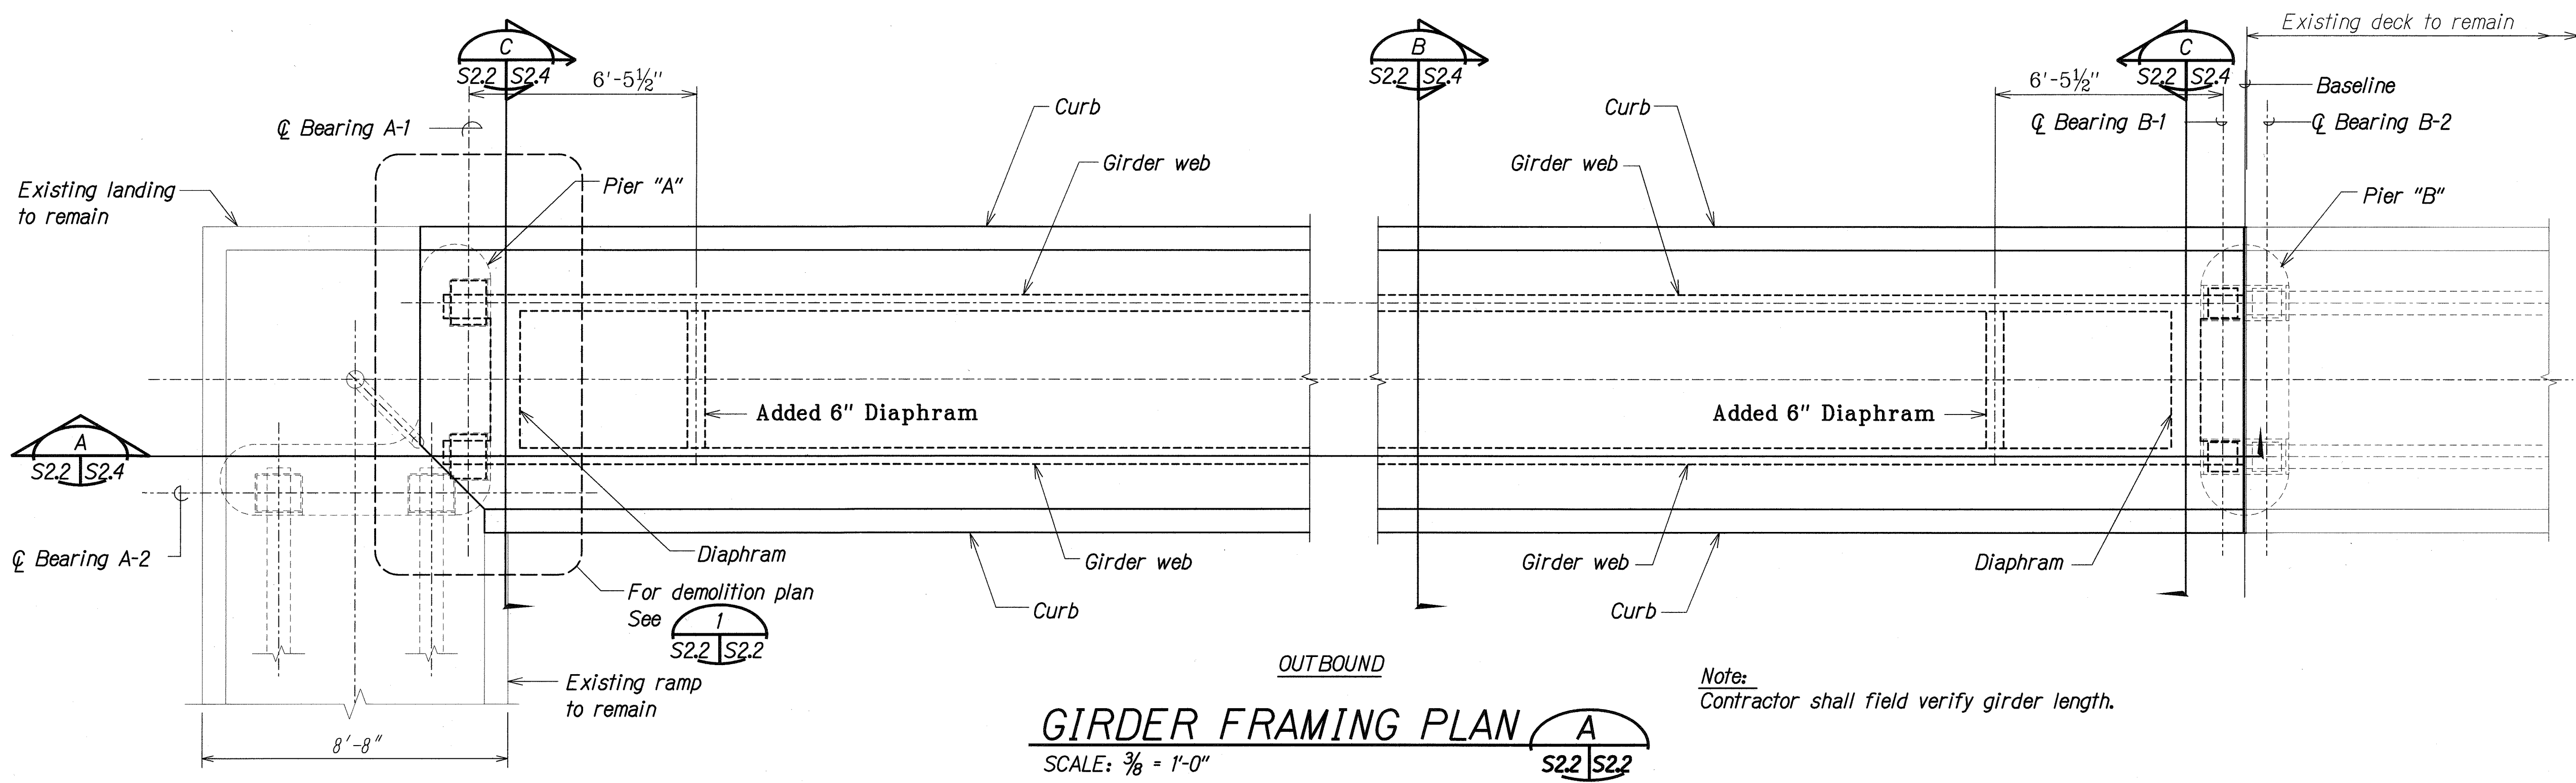

GIRDER FRAMING PLAN A
SCALE: 3/8" = 1'-0"

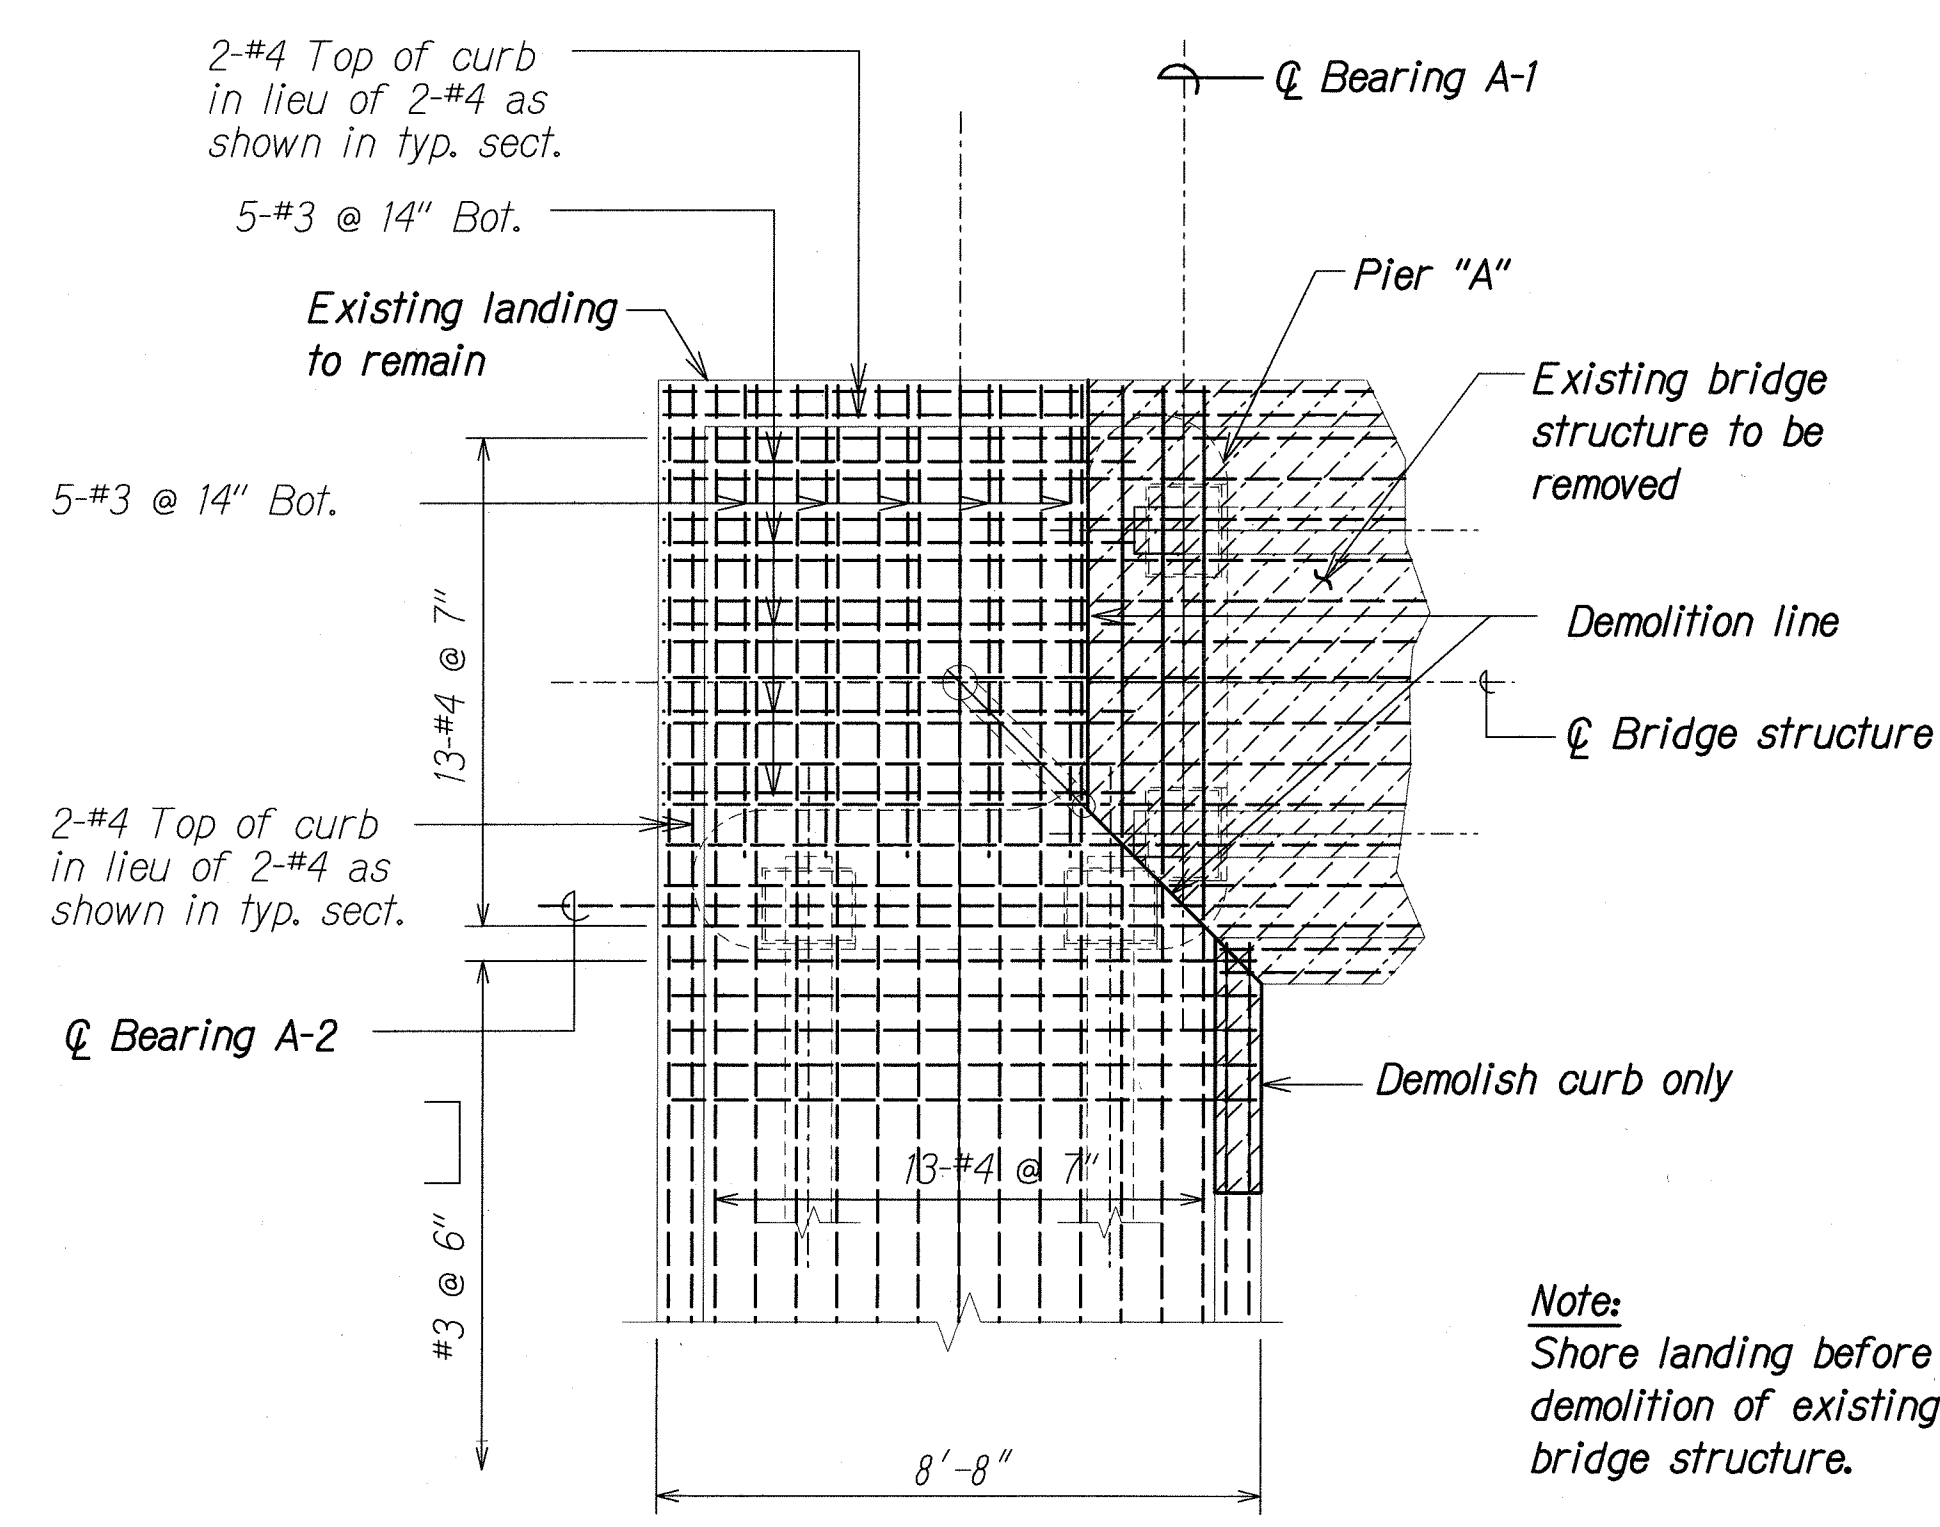


DEMOLITION PLAN 1
SCALE: 3/8" = 1'-0"

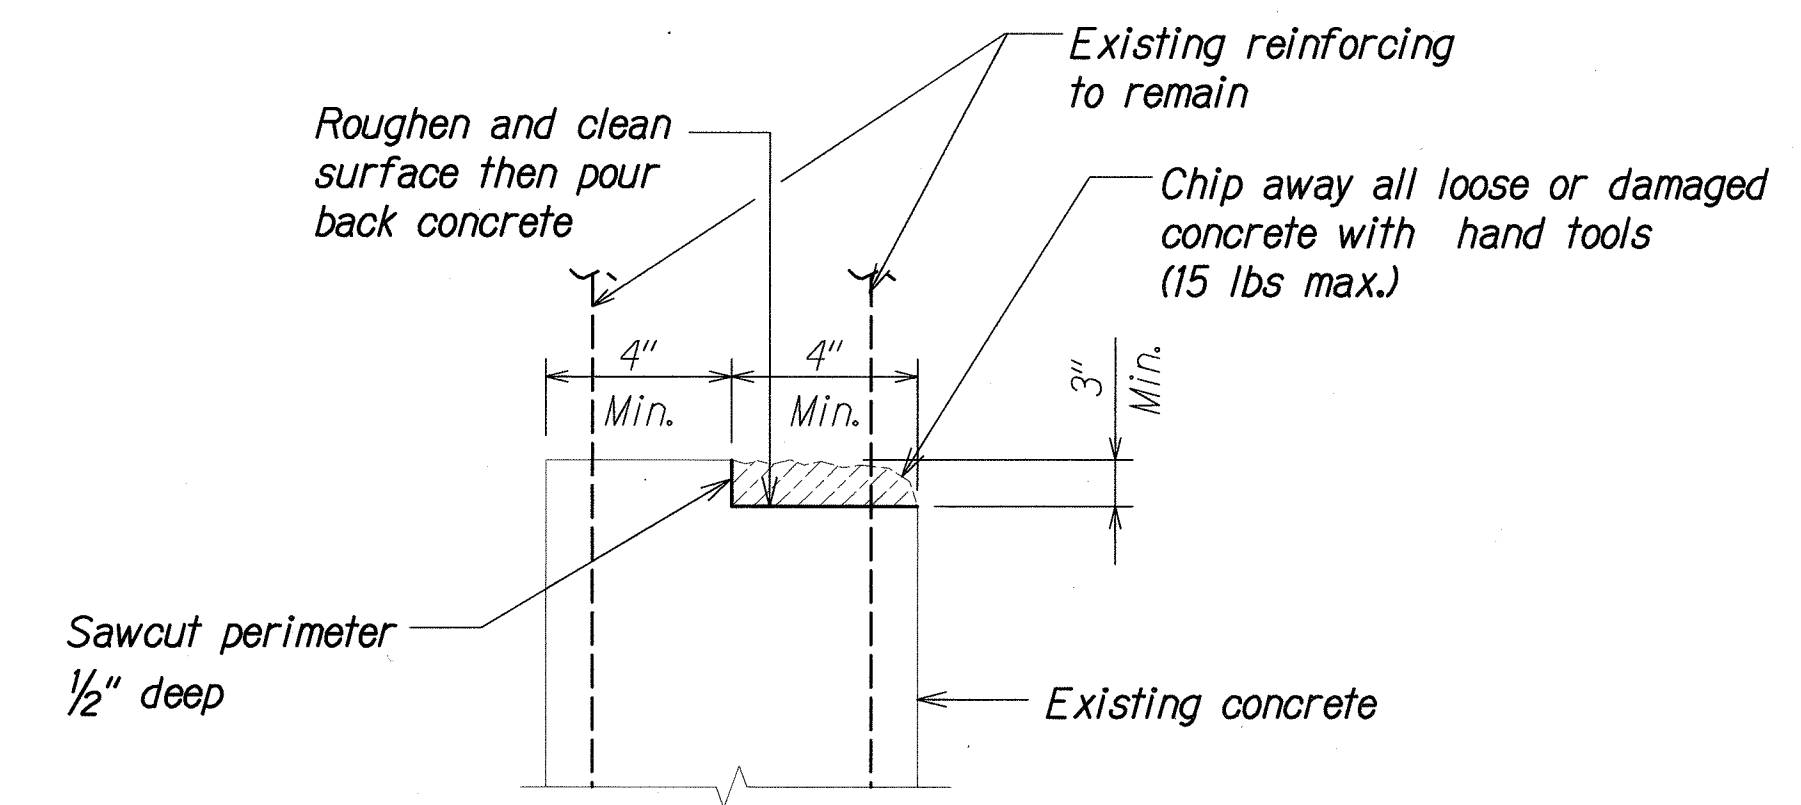

TYPICAL REPAIR CONCRETE DETAIL 2
SCALE: 1" = 1'-0"

LEGEND FOR AS-BUILT POSTINGS	
	Squiggly line for as-built deletion
	Double line for as-built deletion
	Text for as-built posting

DATE	_____
DESIGNED BY	_____
CHECKED BY	_____
NOTES	_____
ORIGINAL PLAN	_____

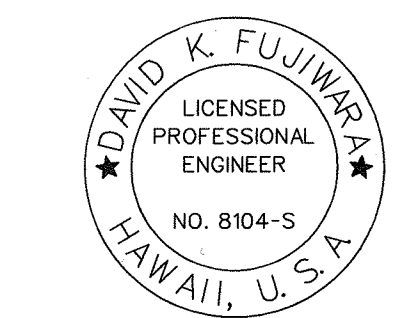


THIS WORK WAS PREPARED BY ME OR UNDER MY SUPERVISION.
Signature: David K. Fujiwara
EXPIRATION DATE OF THE LICENSE: 4-30-08




01/12/07	As Built
DATE	REVISION
STATE OF HAWAII DEPARTMENT OF TRANSPORTATION HIGHWAYS DIVISION	
DEMOLITION PLAN AND GIRDER FRAMING PLAN	
Repair of Mauka Span of Mahiko Street Pedestrian Overpass Project No. HI E-01-07M	
Scale: As Shown	Date: Nov. 2006
SHEET No. S22 OF 16 SHEETS	

"AS-BUILT"

FED. ROAD DIST. NO.	STATE	PROJ. NO.	FISCAL YEAR	SHEET NO.	TOTAL SHEETS
HAWAII	HAW.	HI E-01-07M	2007	9	20

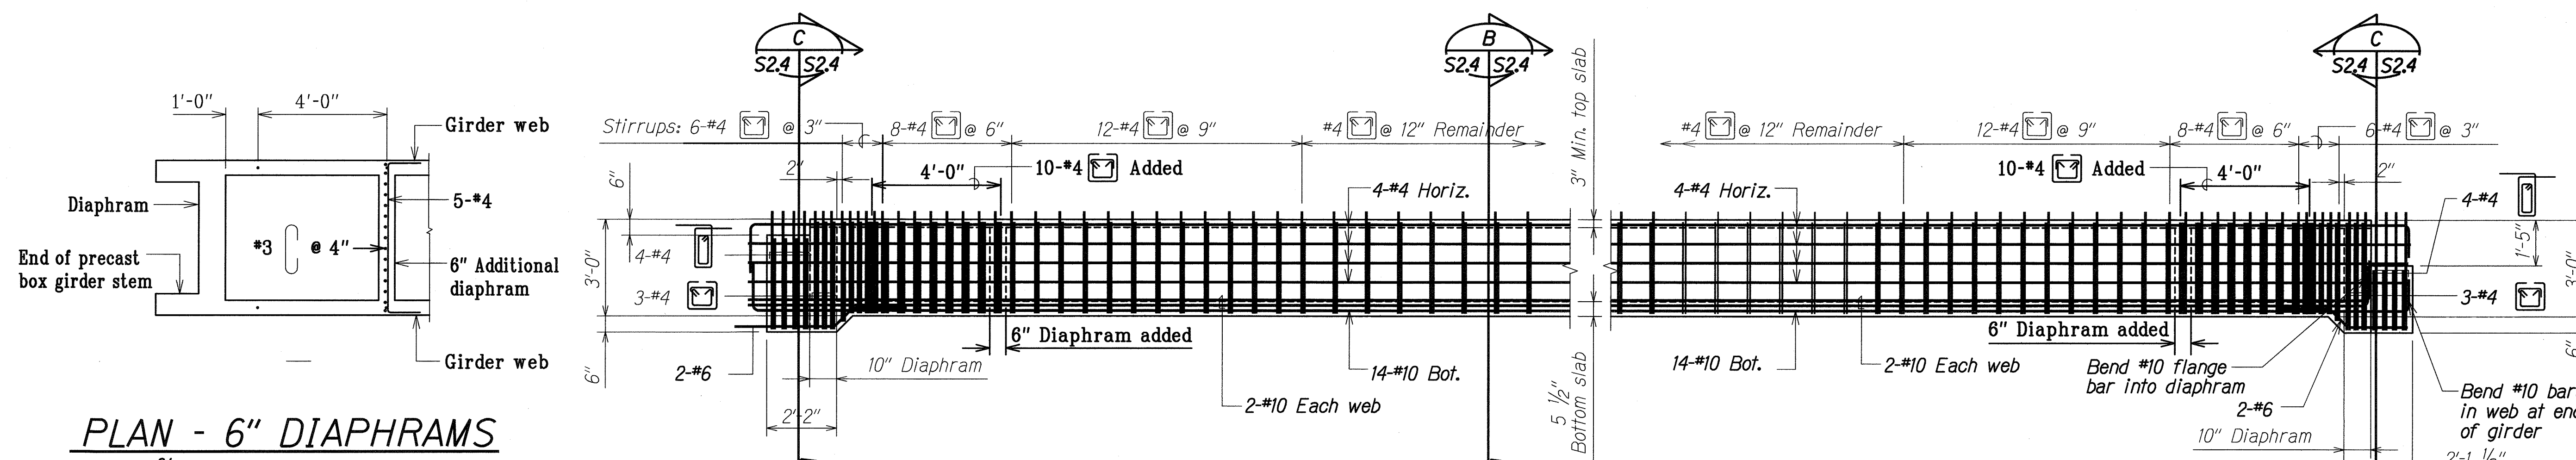

LEGEND FOR AS-BUILT POSTINGS	
	Squiggly line for as-built deletion
	Double line for as-built deletion
Roadway	Text for as-built posting

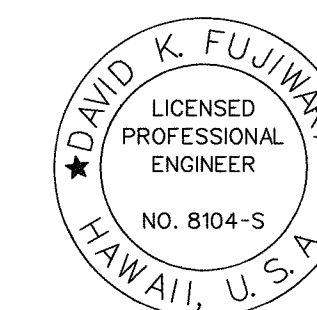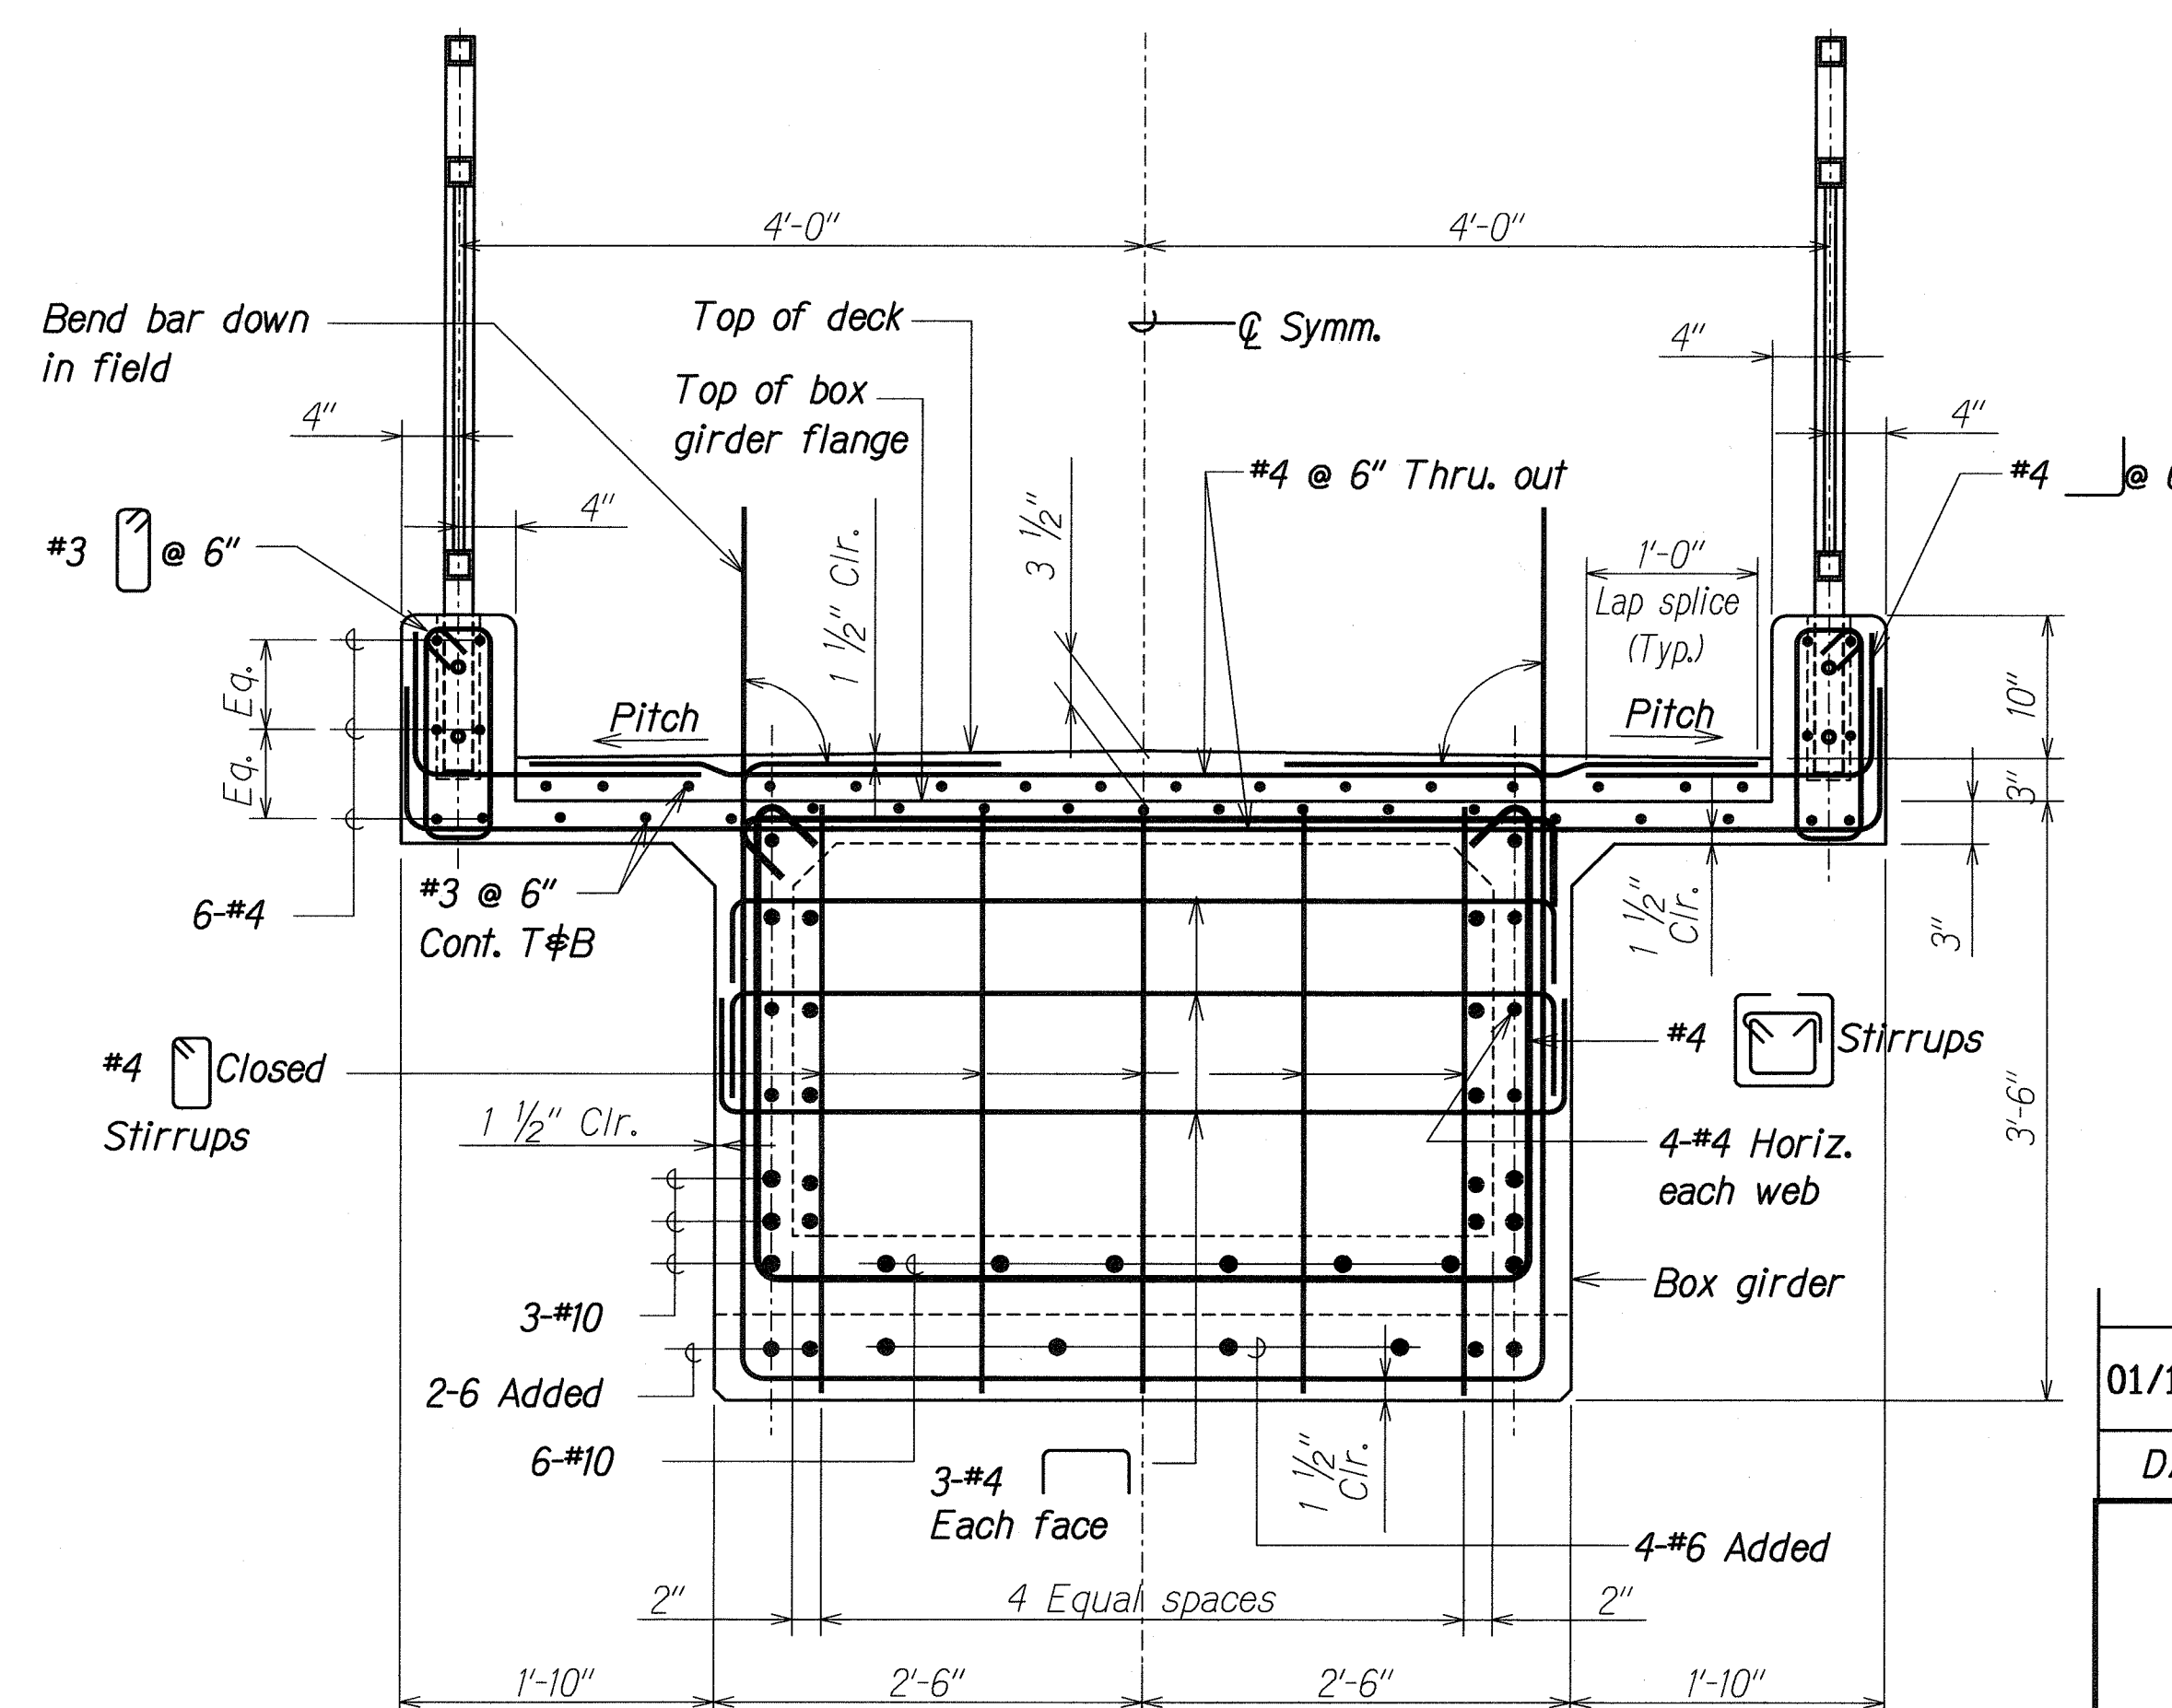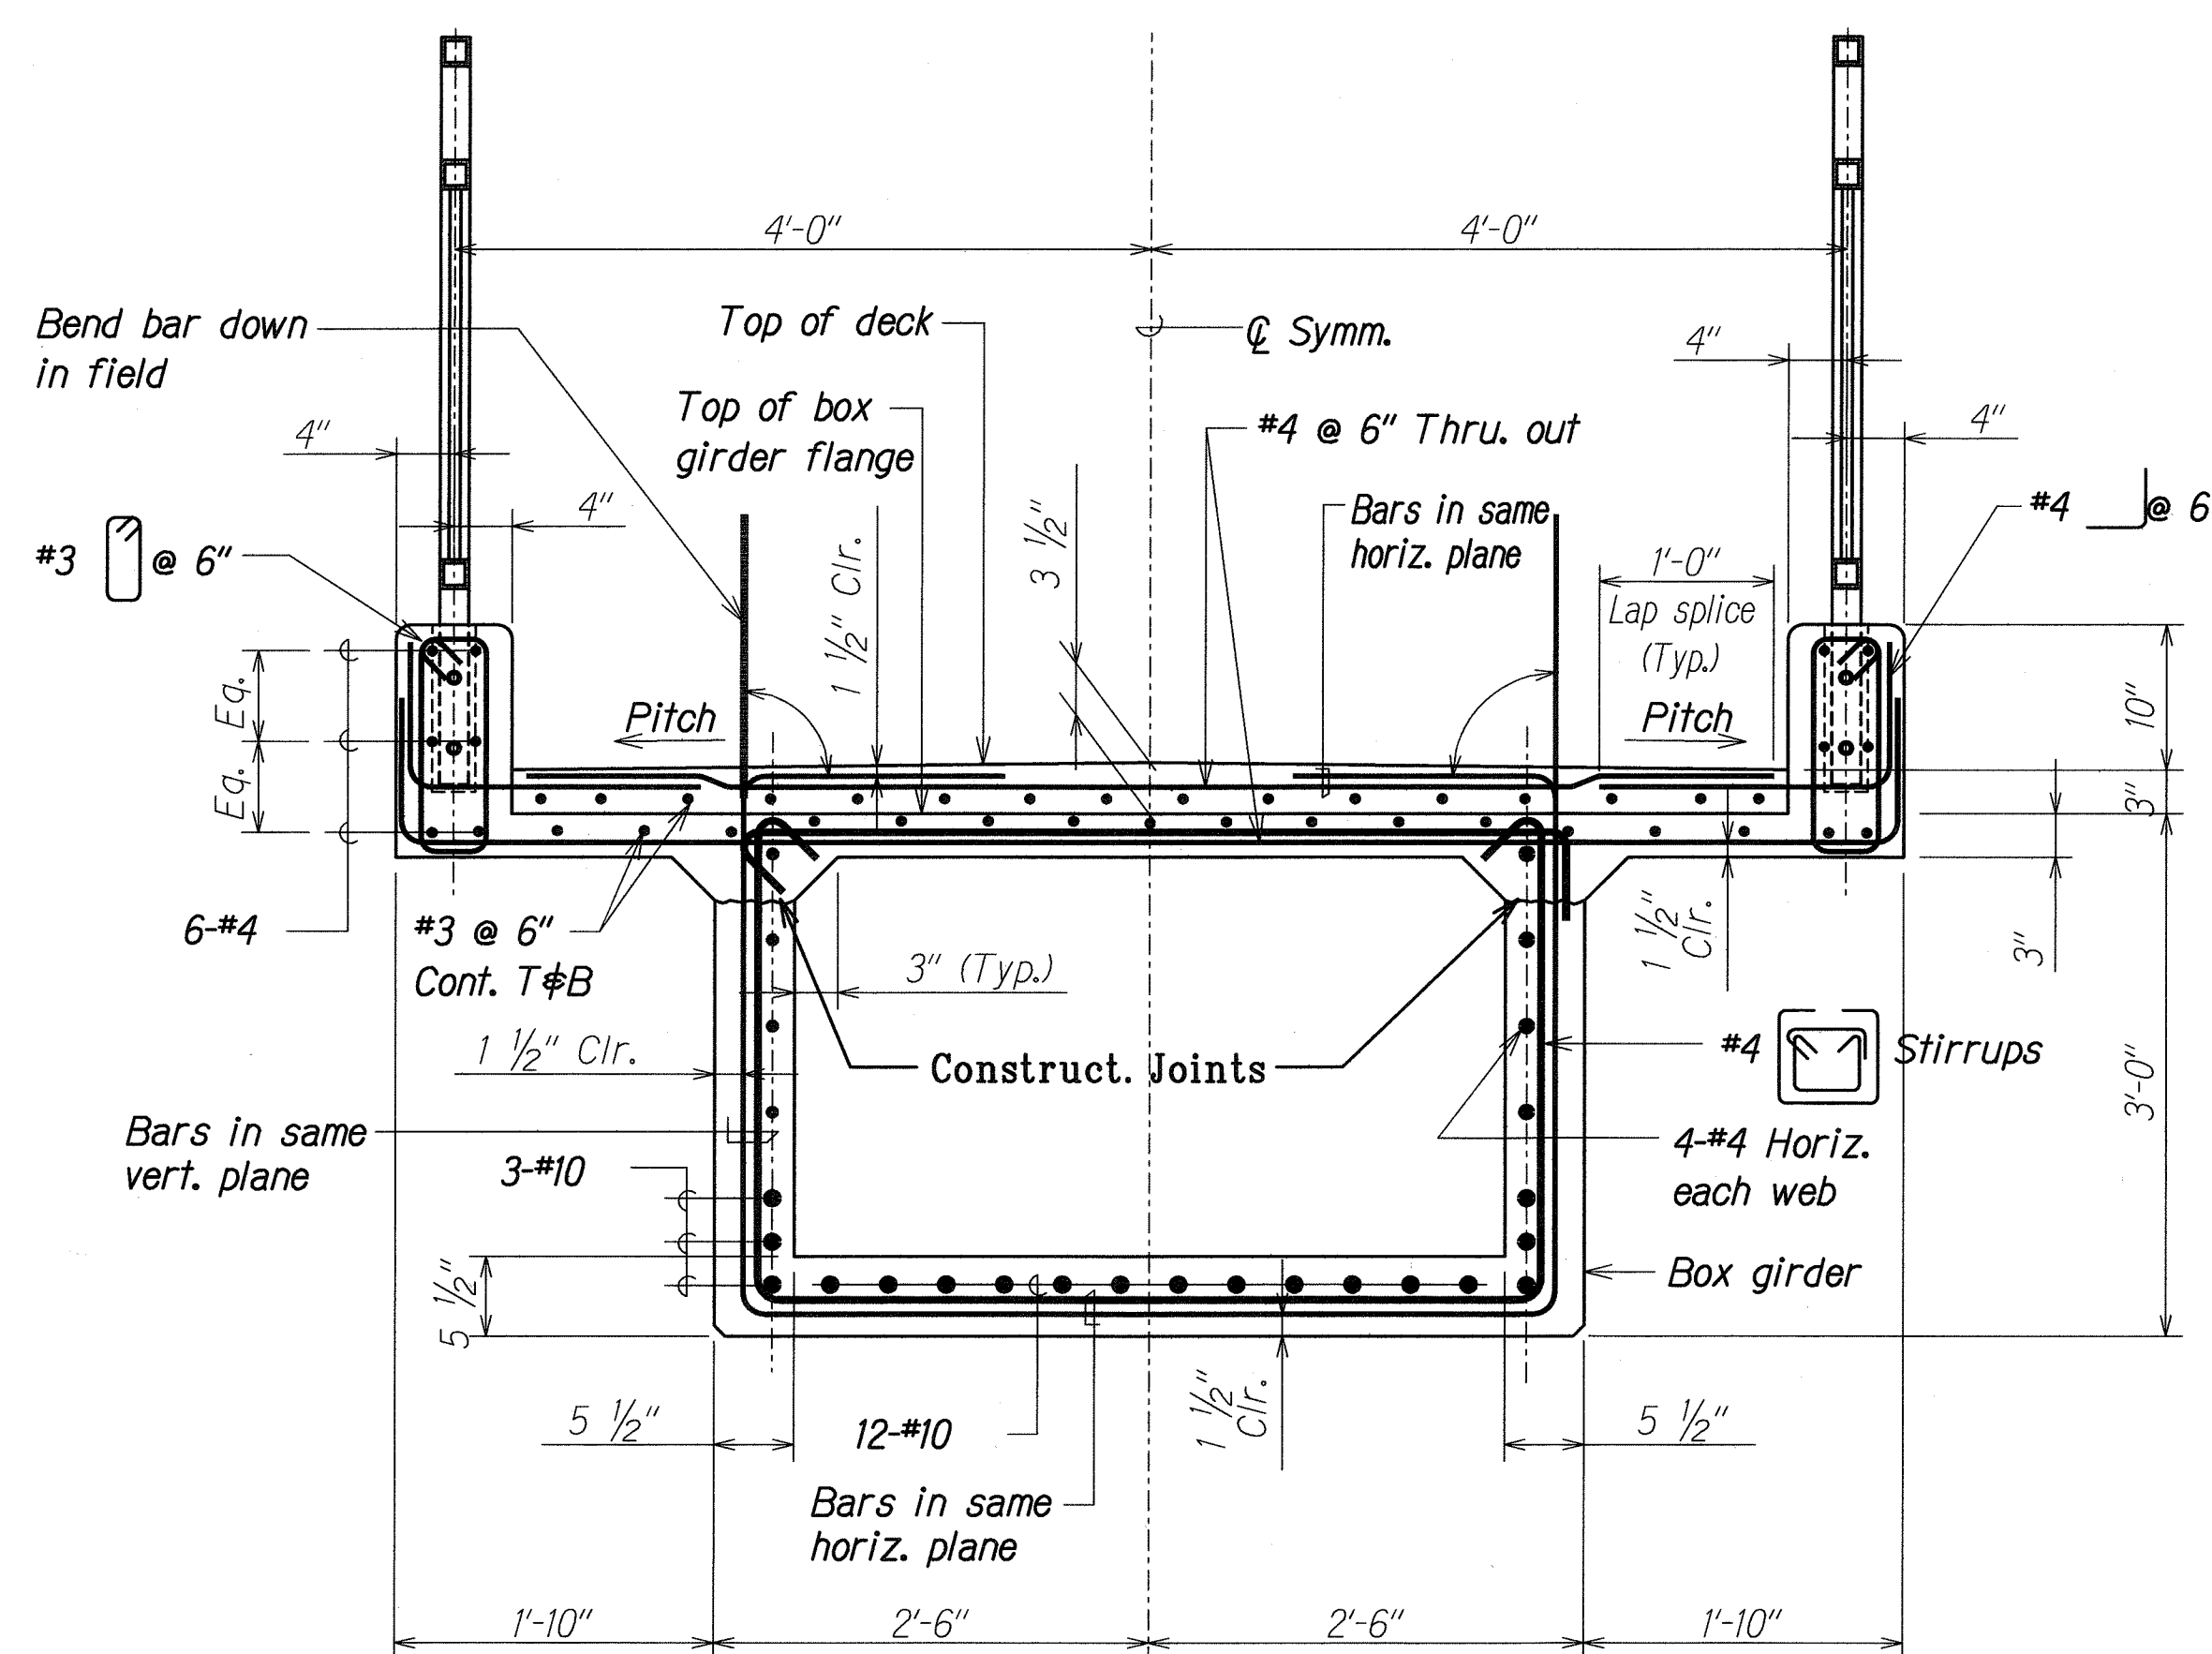


THIS WORK WAS PREPARED BY ME OR UNDER MY SUPERVISION.
 Signature: *David K. Fujiwara*
 EXPIRATION DATE OF THE LICENSE: 4-30-08


01/12/07	As Built
DATE	REVISION
STATE OF HAWAII DEPARTMENT OF TRANSPORTATION HIGHWAYS DIVISION BOX GIRDER ELEVATION AND SECTIONS Repair of Mauka Span of Mahiko Street Pedestrian Overpass Project No. HI E-01-07M Scale: As Noted Date: Nov. 2006 SHEET No. S24 OF 16 SHEETS	

"AS-BUILT"


FED. ROAD DIST. NO.	STATE	PROJ. NO.	FISCAL YEAR	SHEET NO.	TOTAL SHEETS
HAWAII	HAW.	HI E-01-07M	2007	10	20

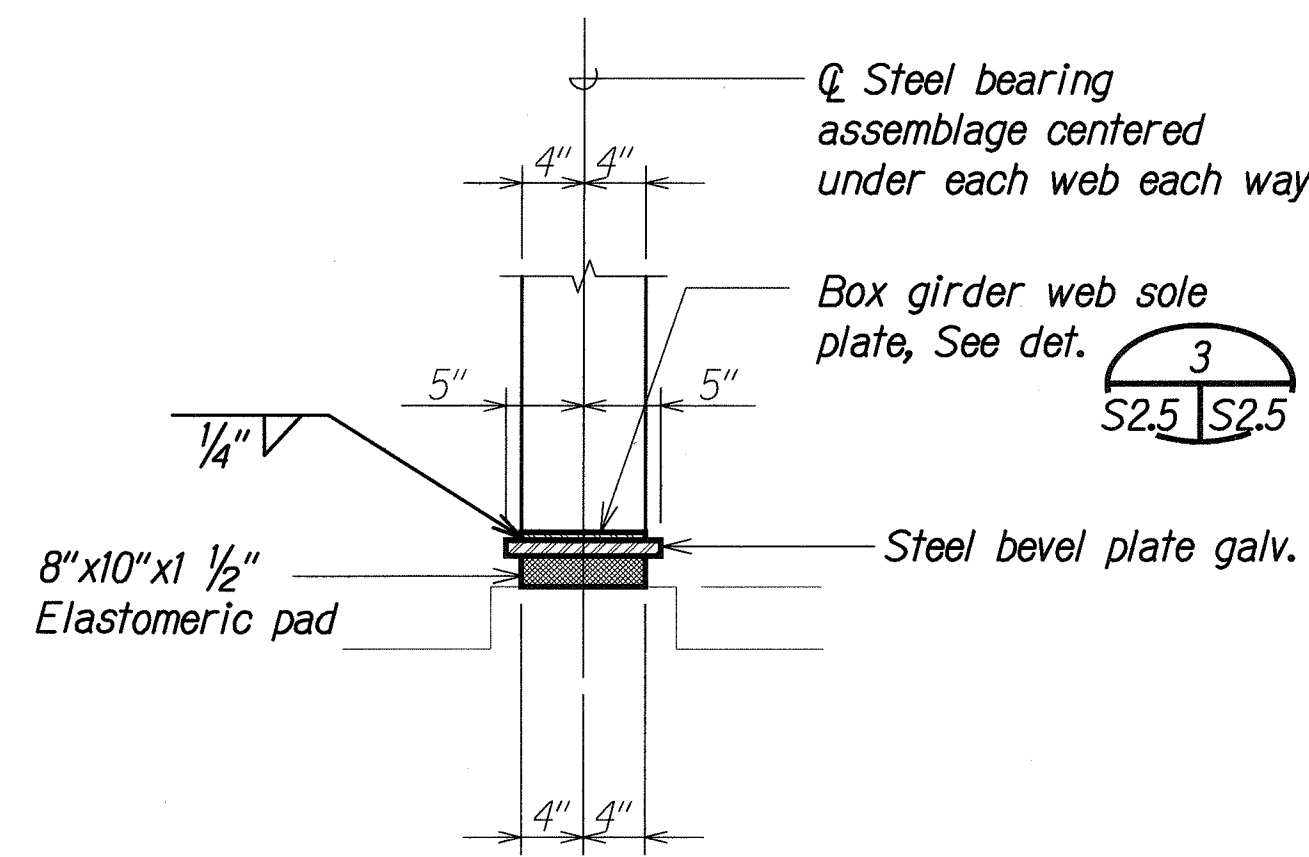


BEARING DETAIL 1
SCALE: 1" = 1'-0"
S2.9 S2.5

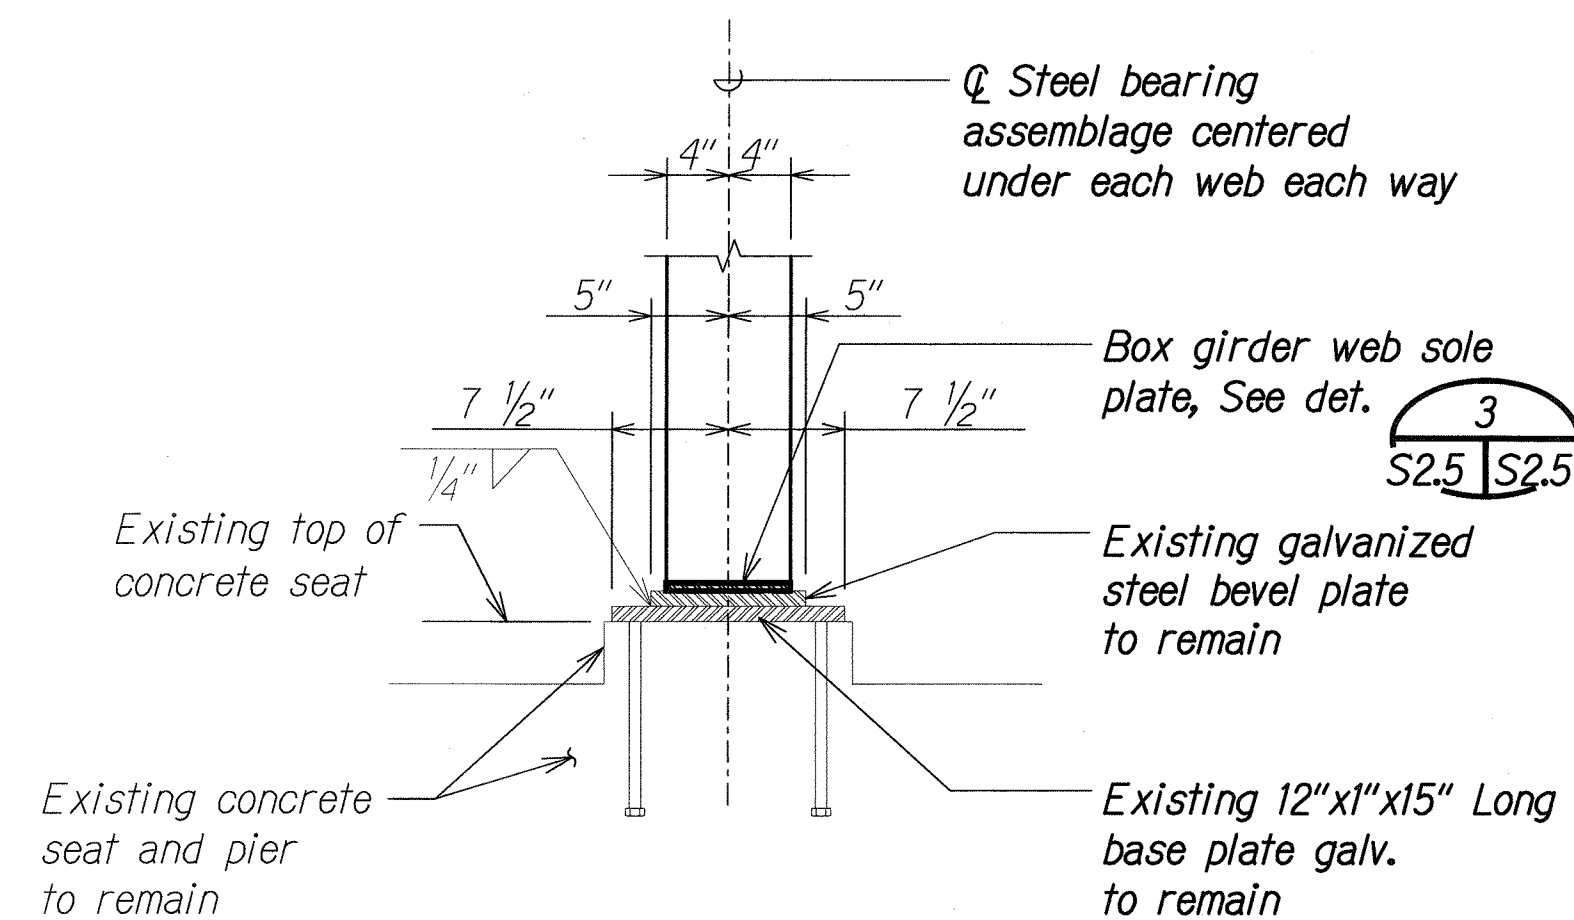

BEARING DETAIL 2
SCALE: 1" = 1'-0"
S2.9 S2.5

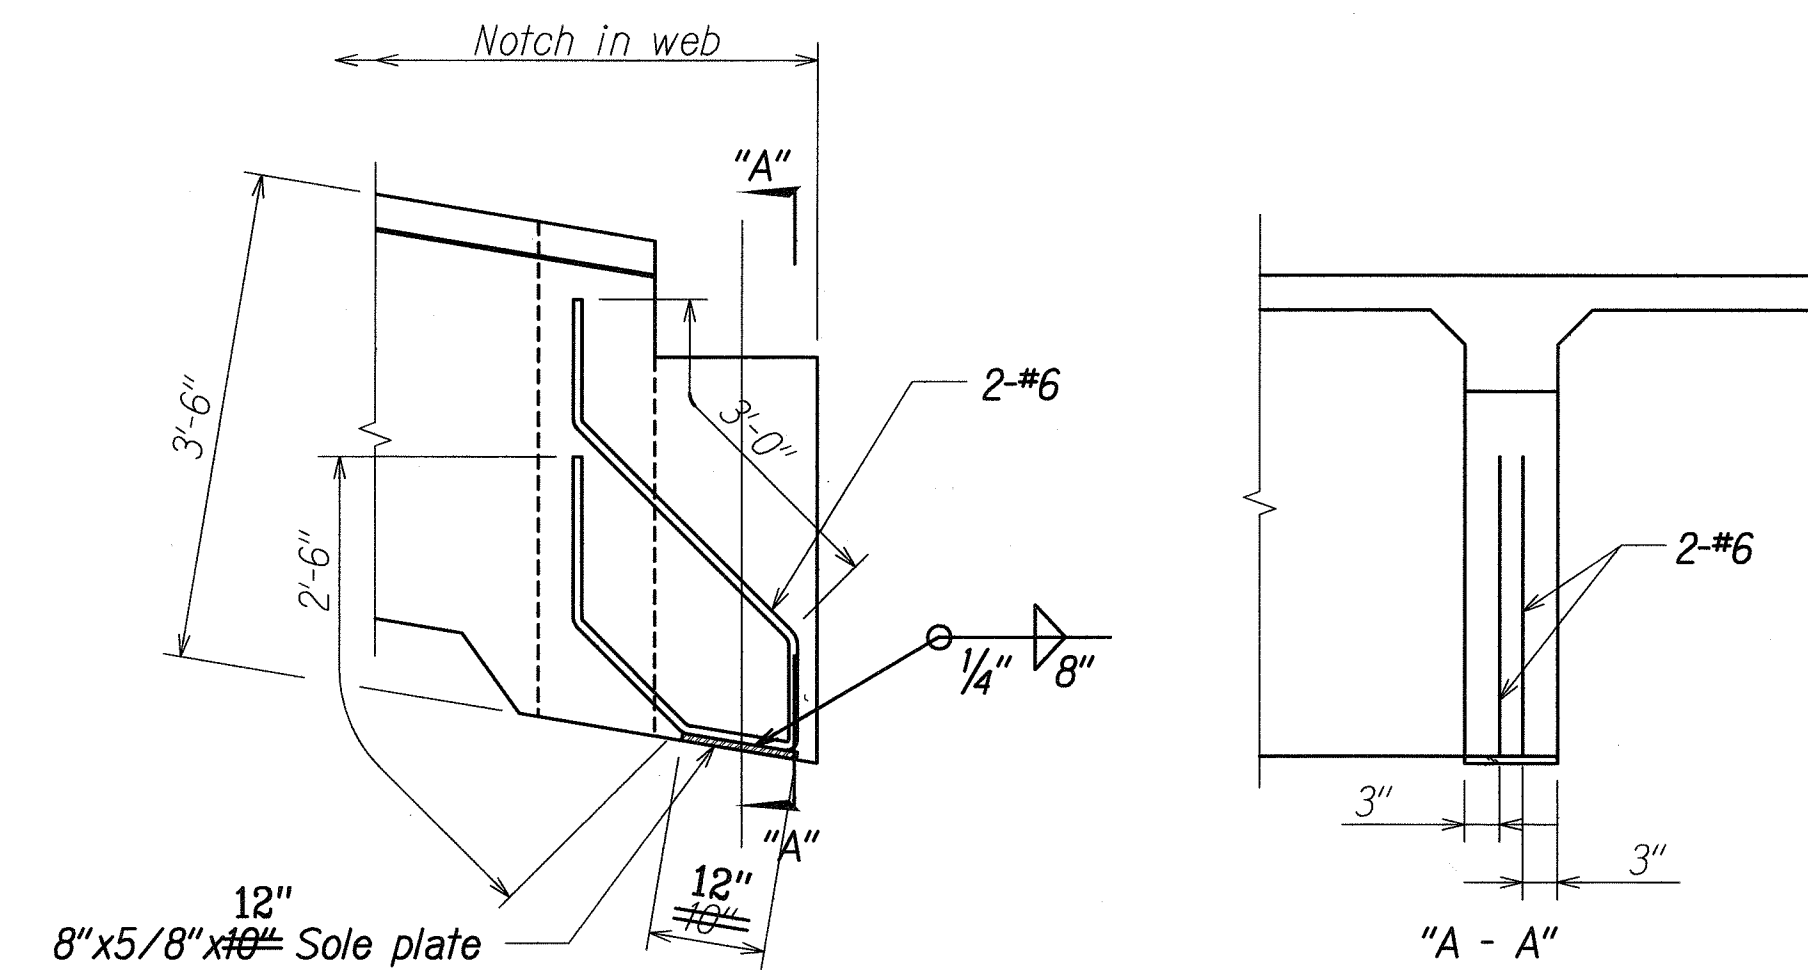


TYP. SOLE PLATE ANCHOR DETAIL 3
SCALE: 3/4" = 1'-0"
S2.5, S2.6, S2.7 S2.5

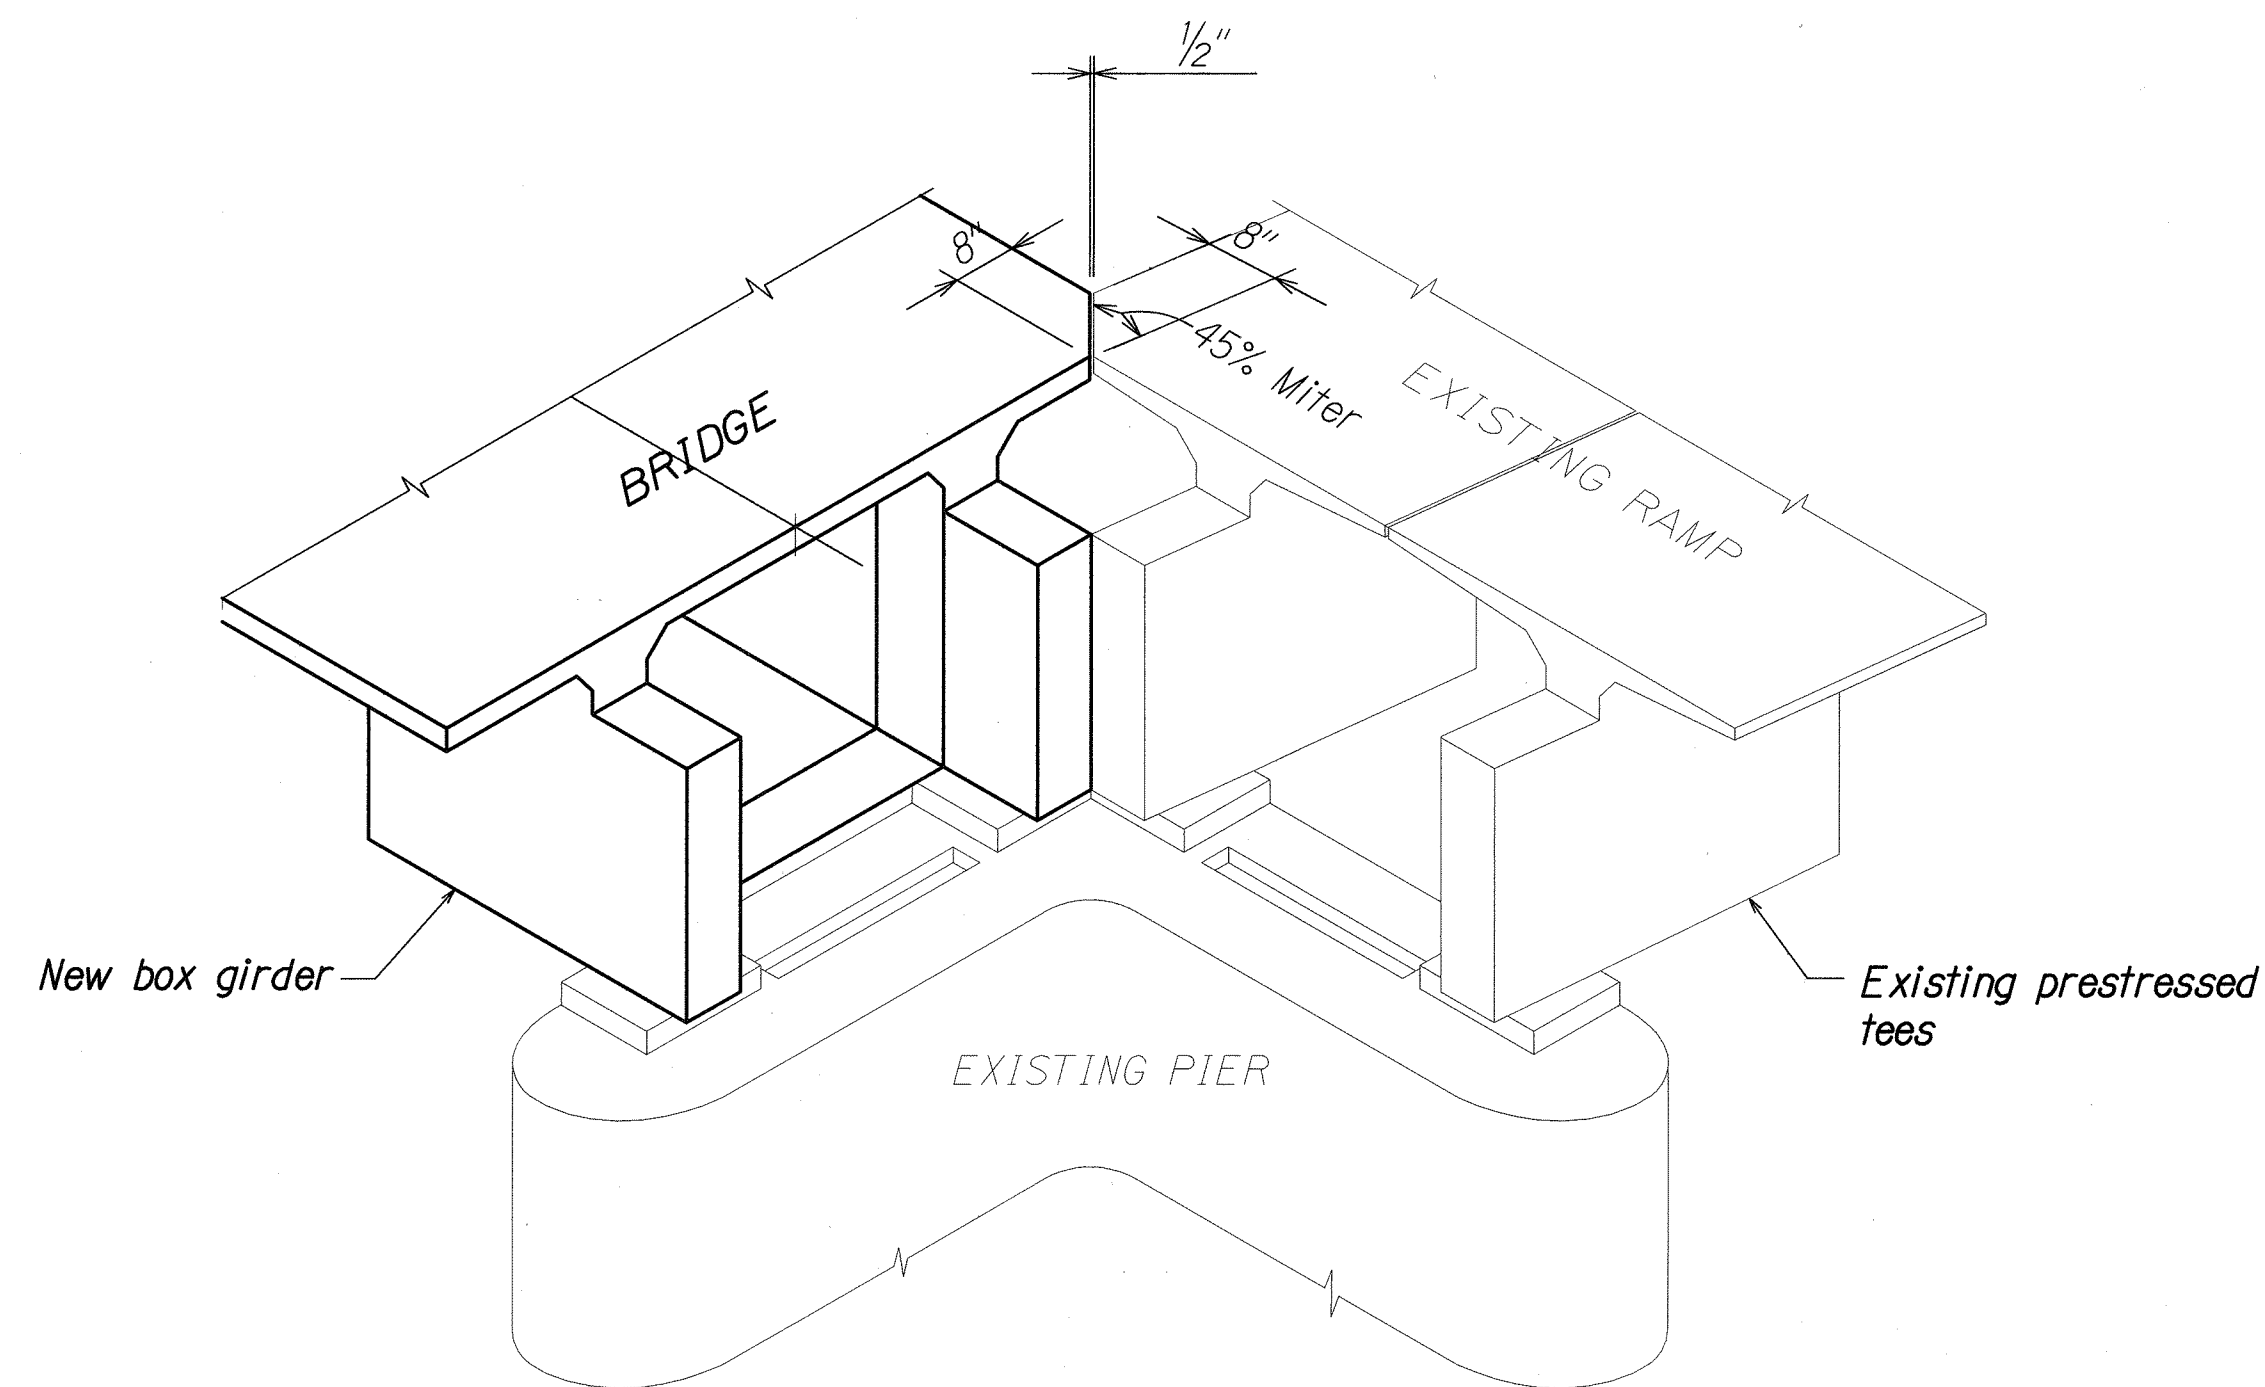

ISOMETRIC
SCALE: Not to scale

LEGEND FOR AS-BUILT POSTINGS	
	Squiggly line for as-built deletion
	Double line for as-built deletion
Roadway	Text for as-built posting

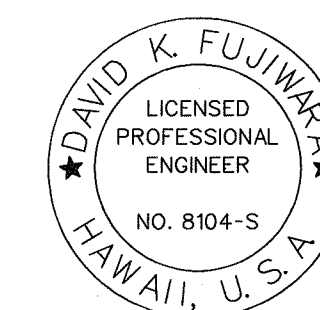


THIS WORK WAS PREPARED BY
ME OR UNDER MY SUPERVISION.
Signature: David K. Fujiwara
4-30-08
SIGNATURE EXPIRATION DATE OF THE LICENSE

01/12/07	As Built
DATE	REVISION
STATE OF HAWAII DEPARTMENT OF TRANSPORTATION HIGHWAYS DIVISION BEARING DETAILS AND ISOMETRIC Repair of Mauka Span of Mahiko Street Pedestrian Overpass Project No. HI E-01-07M Scale: As Noted Date: Nov. 2006 SHEET No. S2.5 OF 16 SHEETS	


DATE	_____
DESIGNED BY	_____
CHECKED BY	_____
NOTED BY	_____
ORIGINAL PLAN	_____
NOTE BOOK	_____
DATE	_____

FED. ROAD DIST. NO.	STATE	PROJ. NO.	FISCAL YEAR	SHEET NO.	TOTAL SHEETS
HAWAII	HAW.	HI E-01-07M	2007	11	20

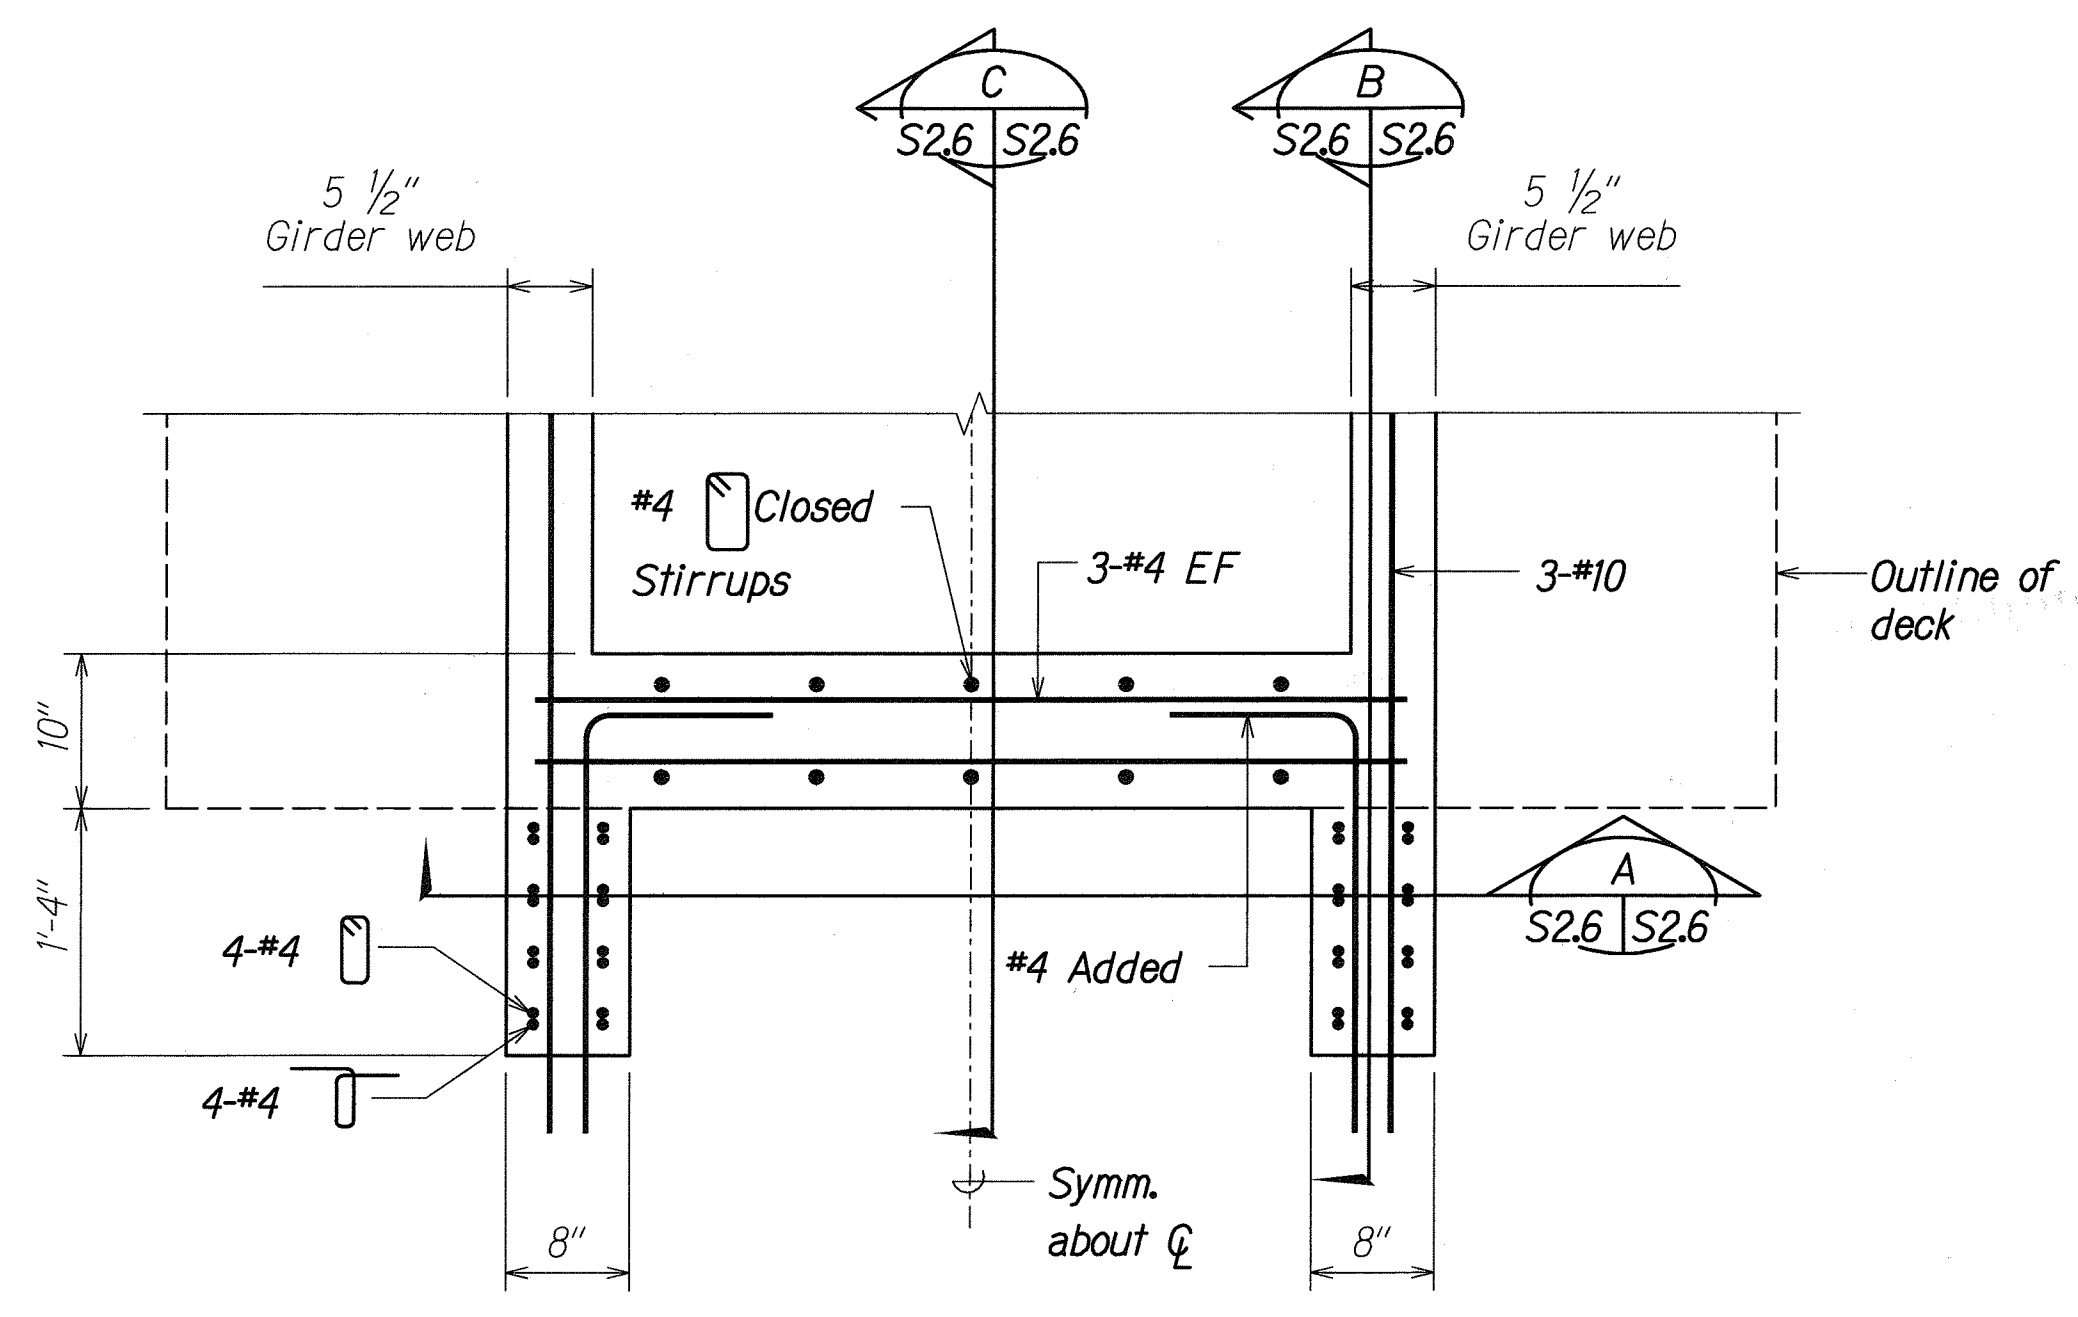

PLAN - FIXED END BOX GIRDER


SCALE: 1" = 1'-0"

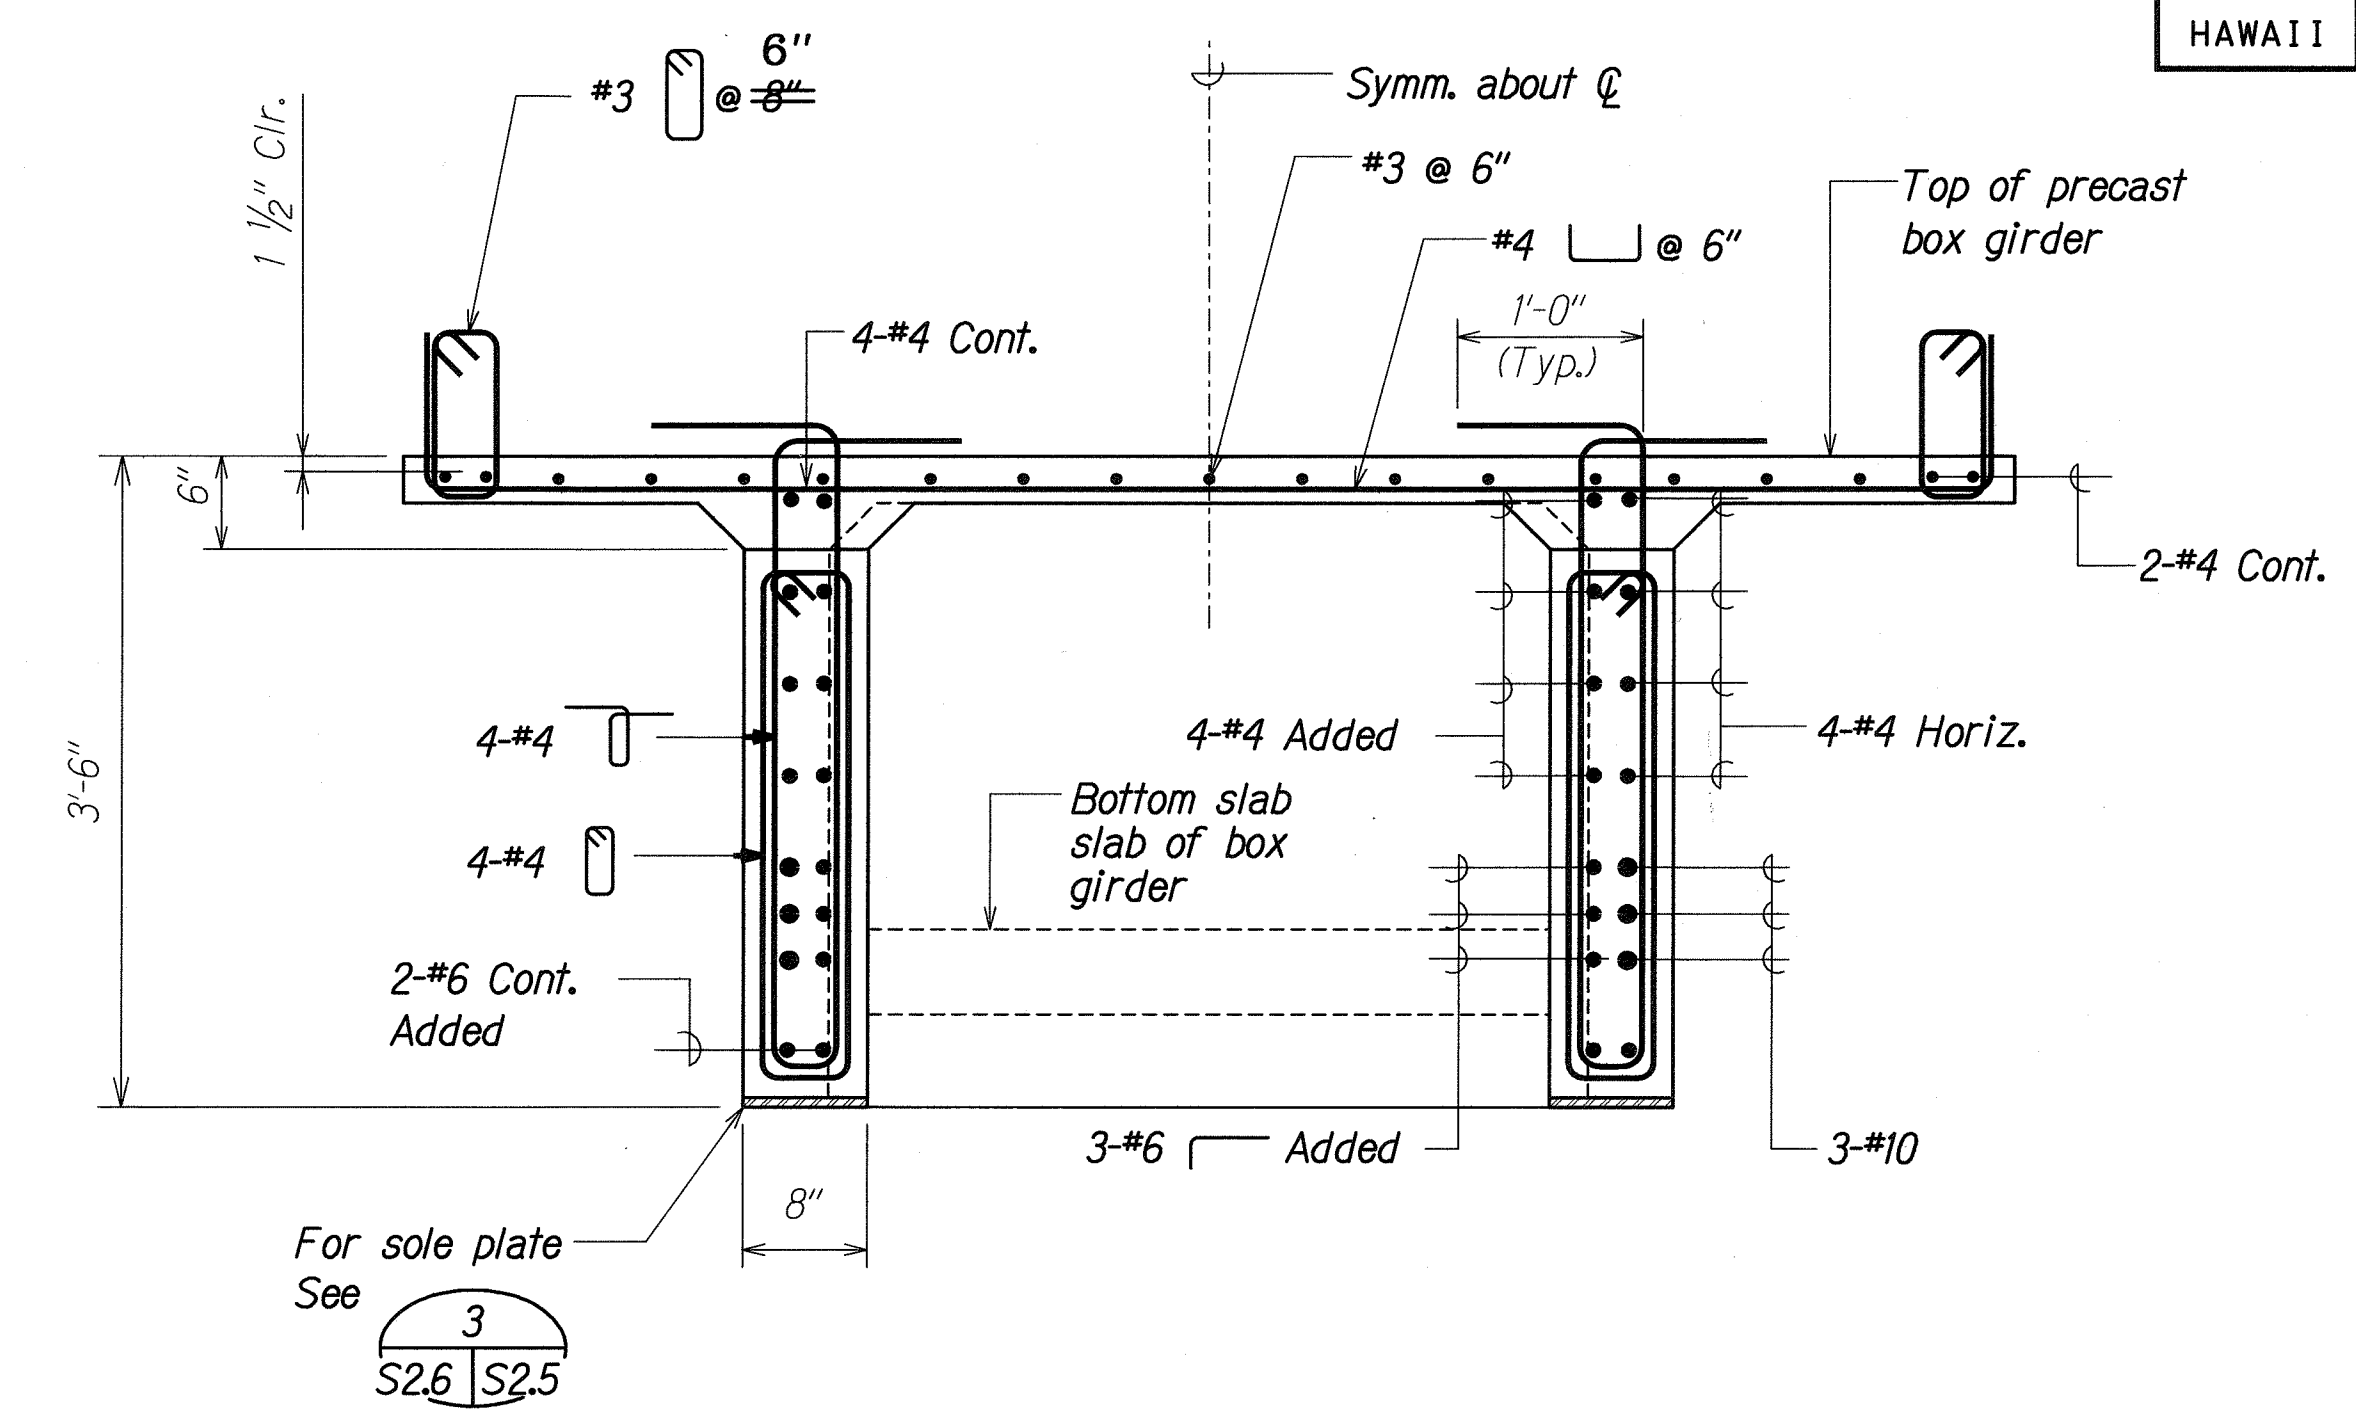

FIXED END ELEVATION A

SCALE: 1" = 1'-0"


S2.6 S2.6

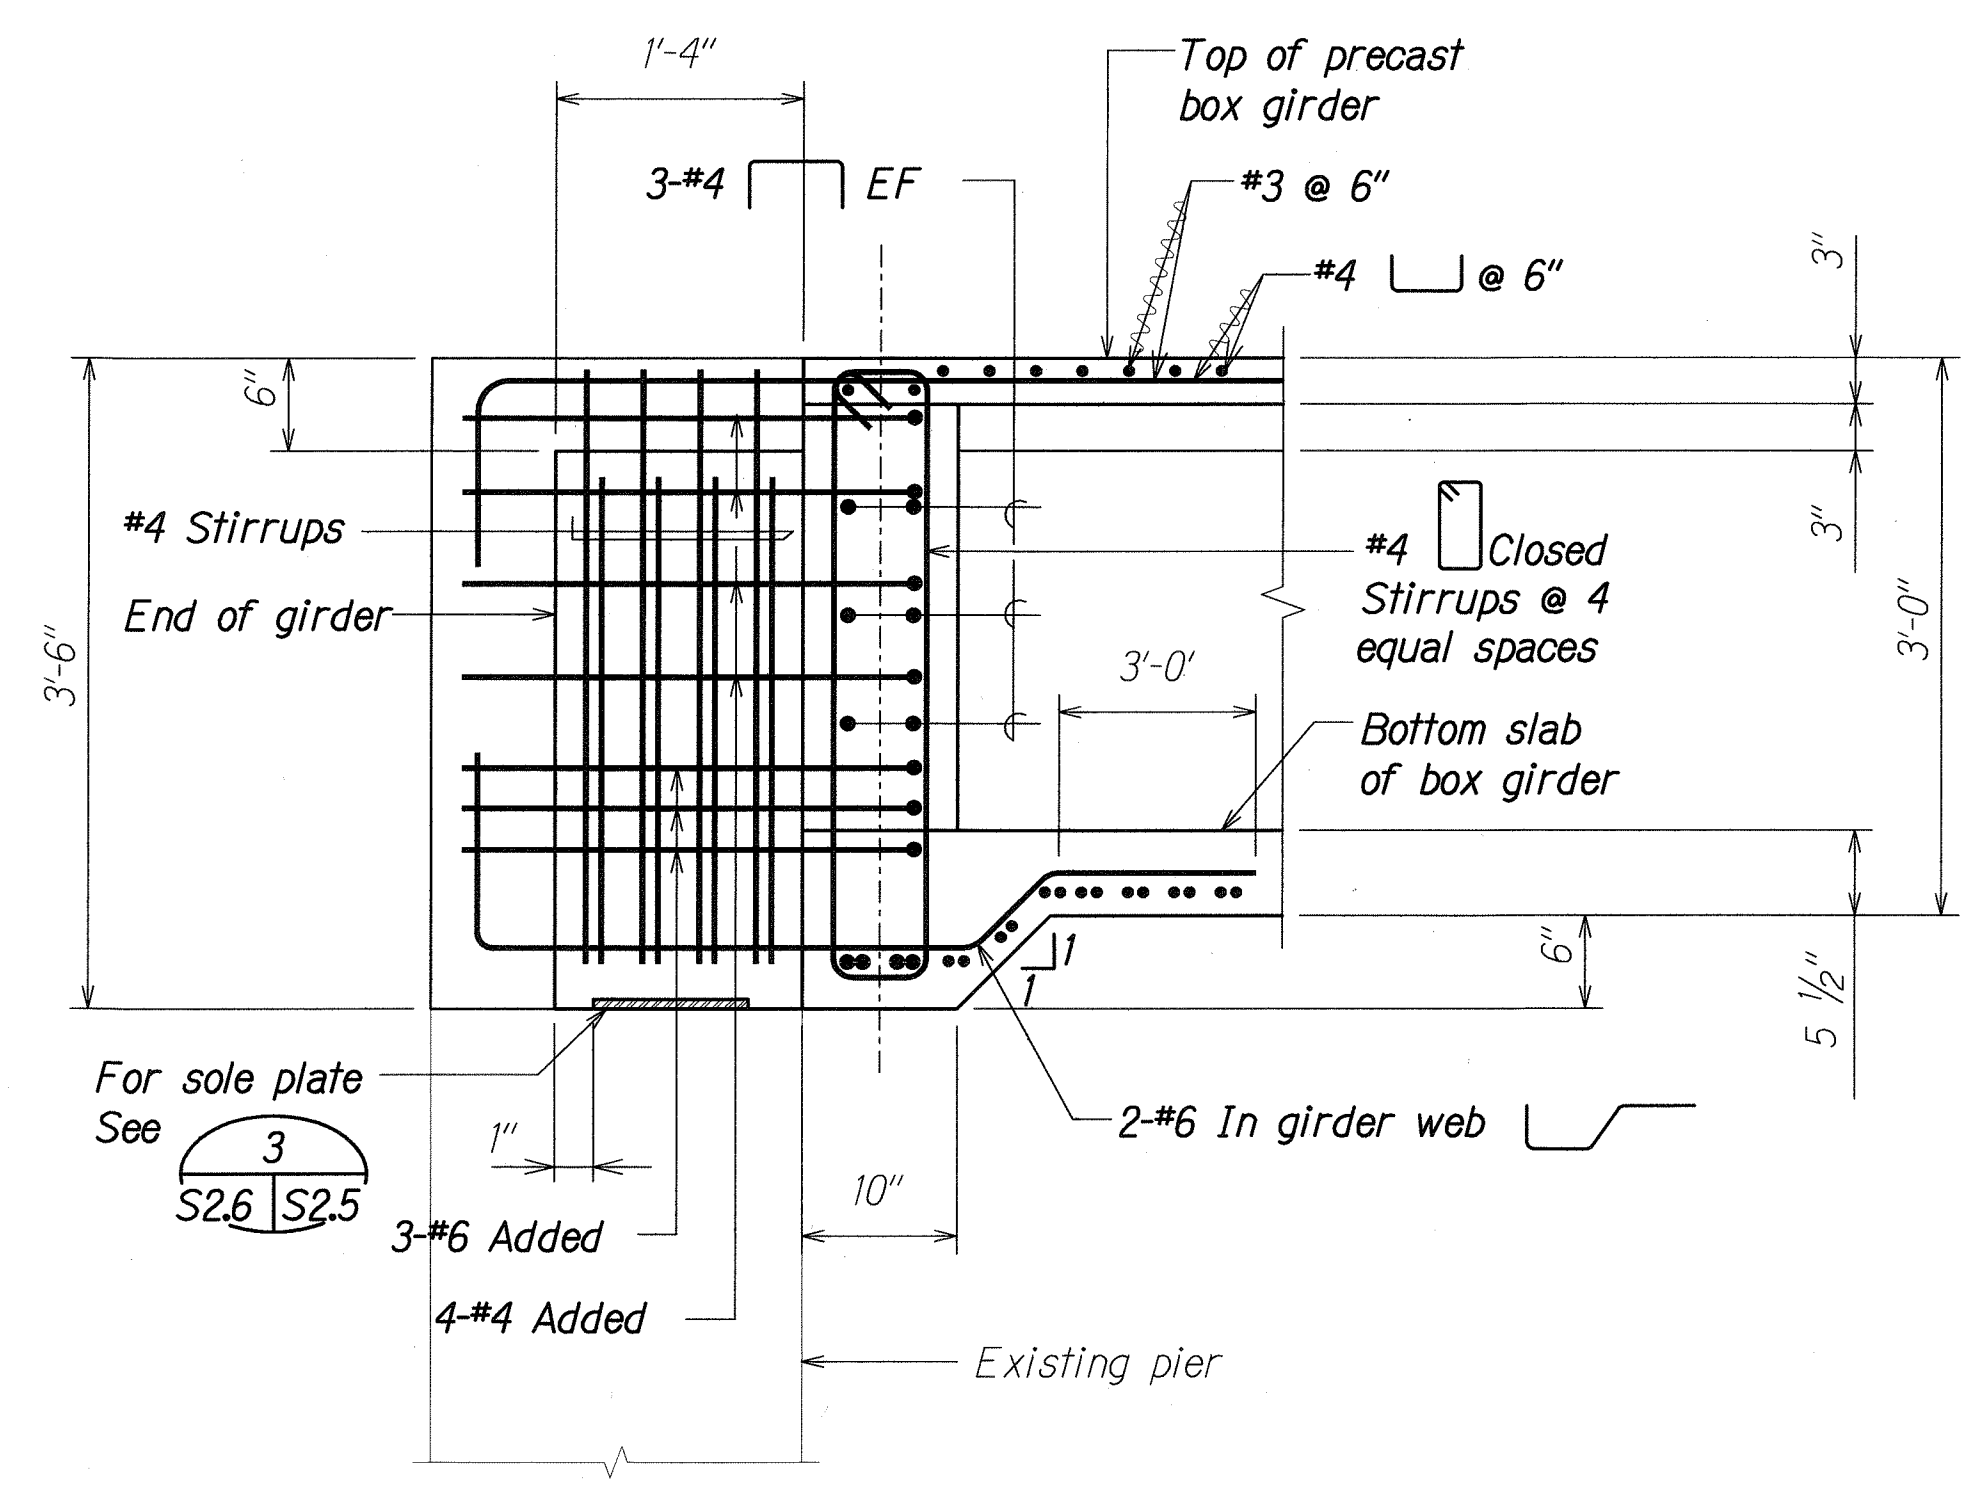

SECTION B

SCALE: 1" = 1'-0"

S2.6 S2.6

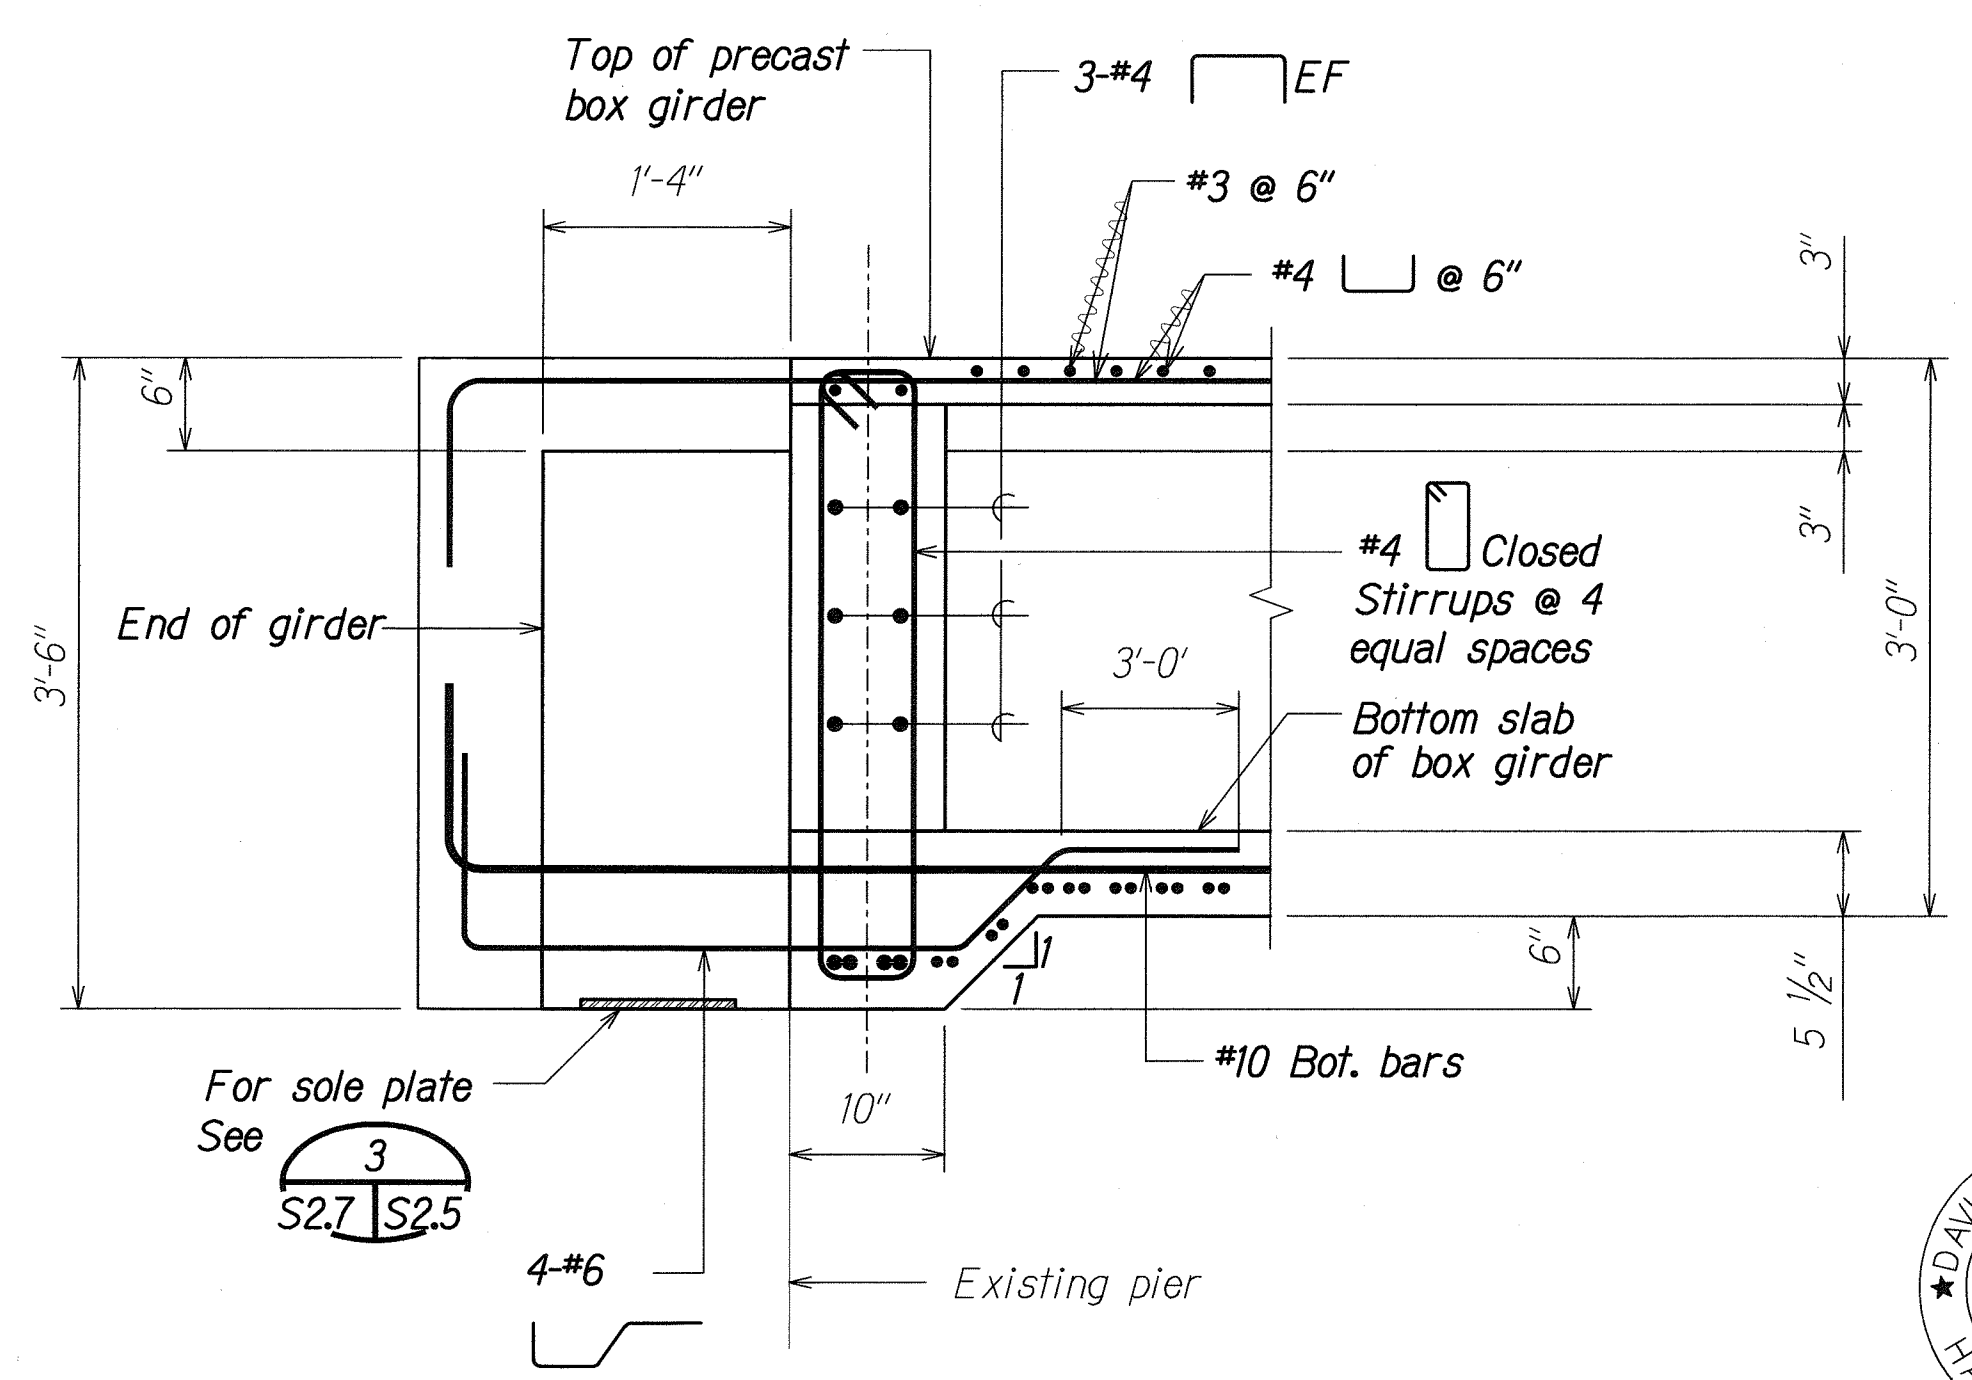


SECTION C

SCALE: 1" = 1'-0"

S2.6 S2.6

LEGEND FOR AS-BUILT POSTINGS	
	Squiggly line for as-built deletion
	Double line for as-built deletion
Roadway	Text for as-built posting

01/12/07	As Built
DATE	REVISION
STATE OF HAWAII DEPARTMENT OF TRANSPORTATION HIGHWAYS DIVISION FIXED END BOX GIRDER PLAN AND SECTIONS Repair of Mauka Span of Mahiko Street Pedestrian Overpass Project No. HI E-01-07M Scale: As Shown Date: Nov. 2006 SHEET No. S2.6 OF 16 SHEETS	

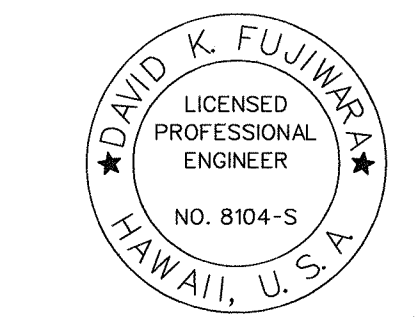


THIS WORK WAS PREPARED BY ME OR UNDER MY SUPERVISION.

David K. Fujiwara


SIGNATURE EXPIRATION DATE OF THE LICENSE 4-30-08

"AS-BUILT"


FED. ROAD DIST. NO.	STATE	PROJ. NO.	FISCAL YEAR	SHEET NO.	TOTAL SHEETS
HAWAII	HAW.	HI E-01-07M	2007	12	20

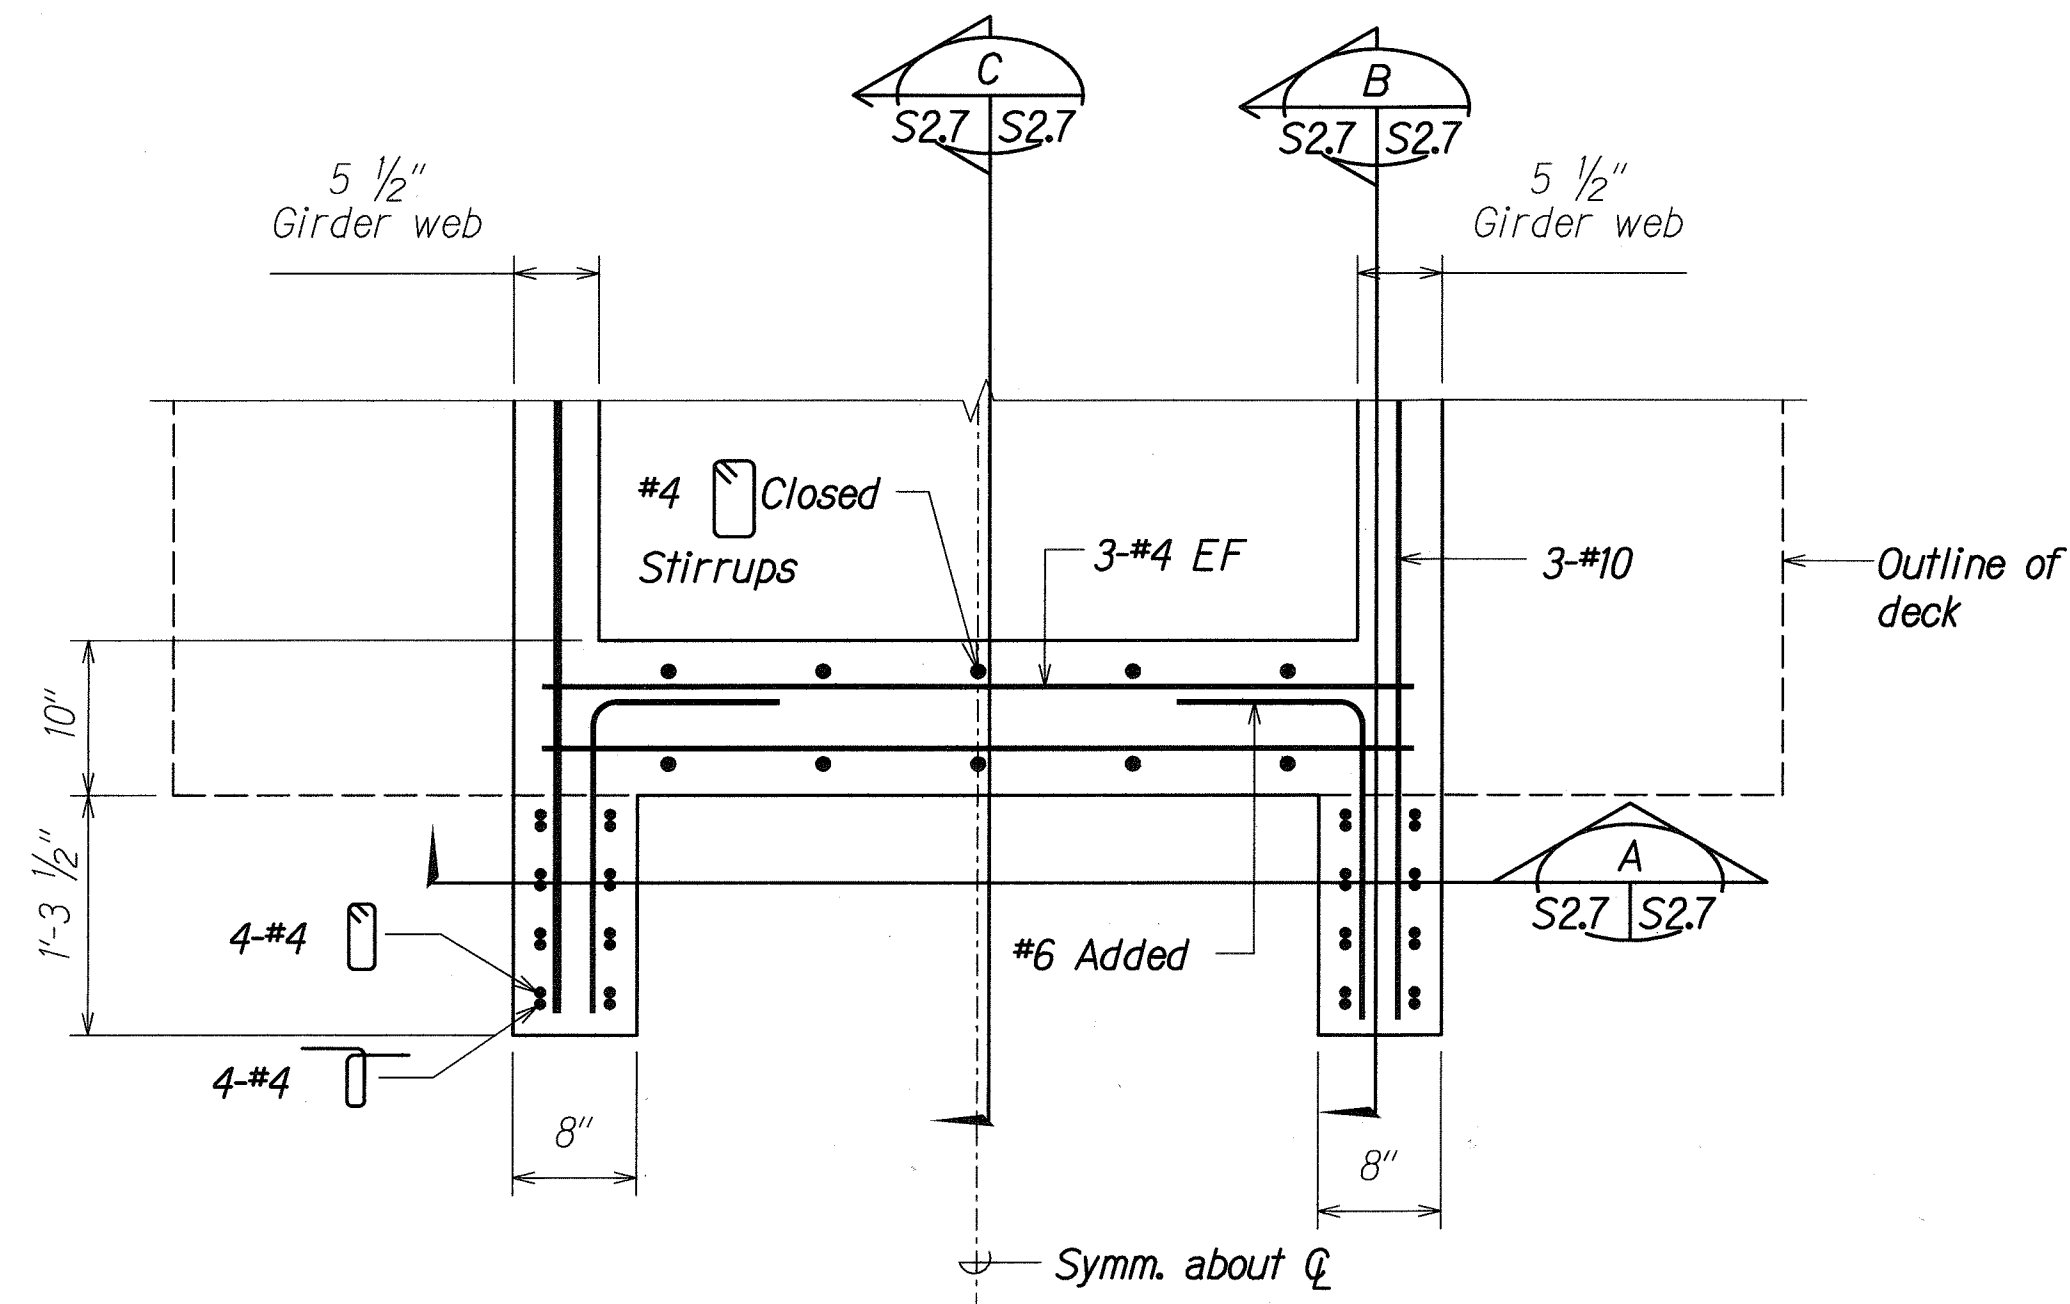


PLAN - EXPANSION END BOX GIRDER
SCALE: 1" = 1'-0"

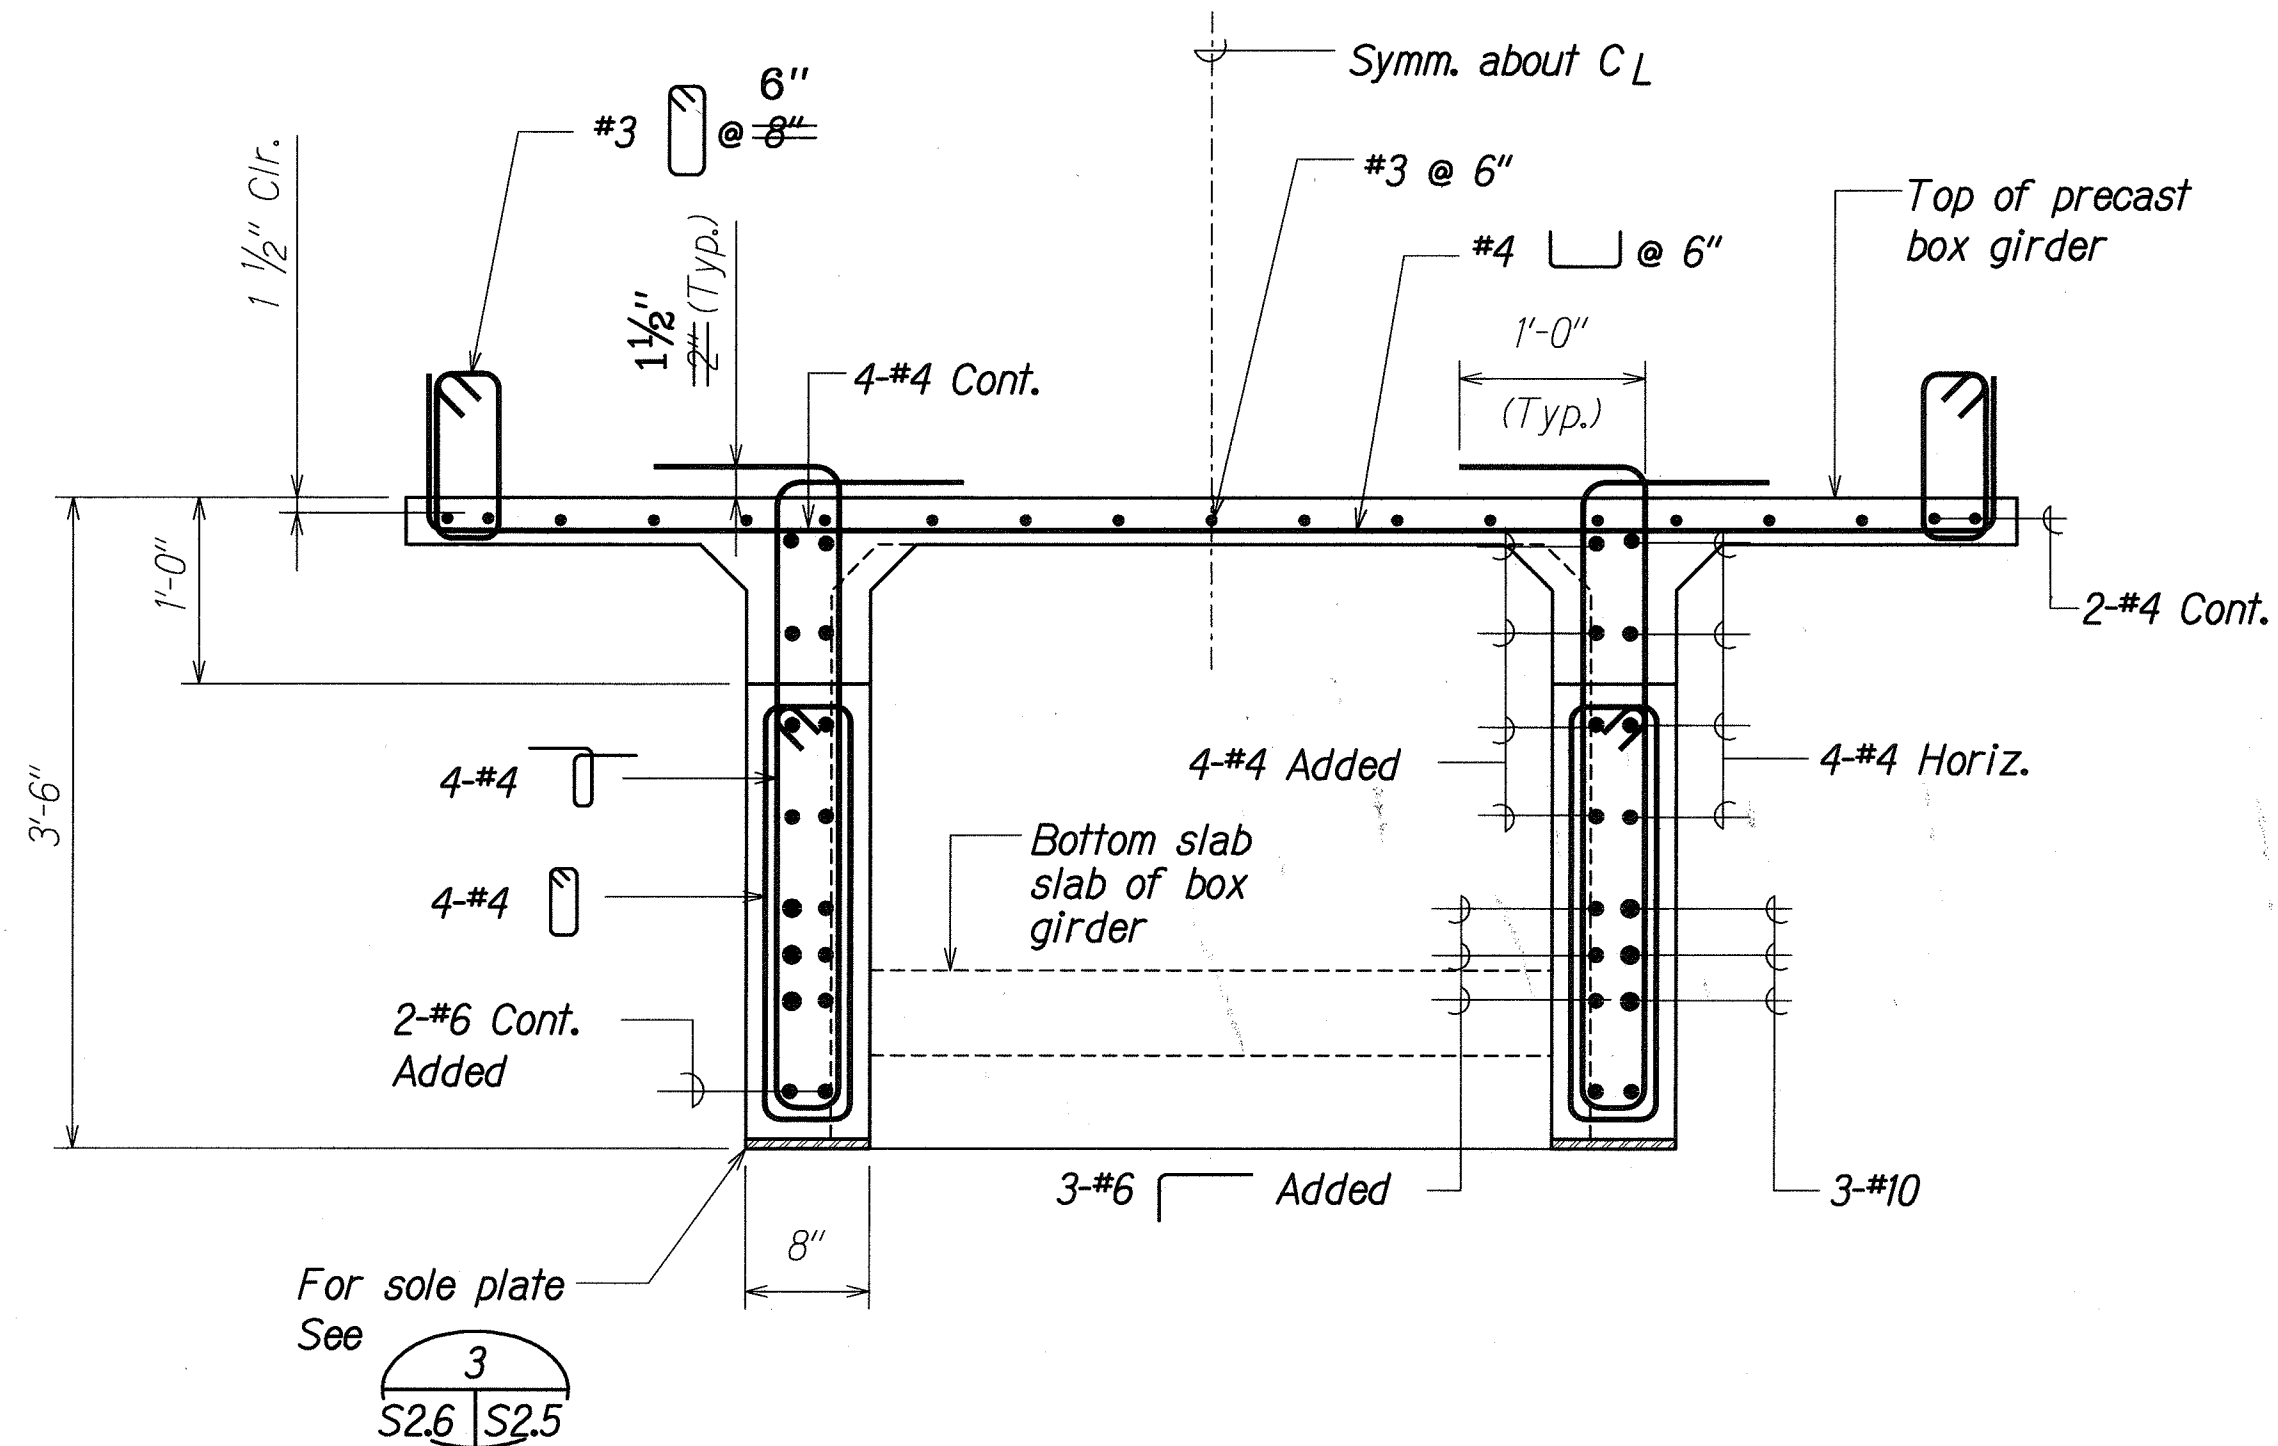

EXPANSION END ELEVATION A
SCALE: 1" = 1'-0"

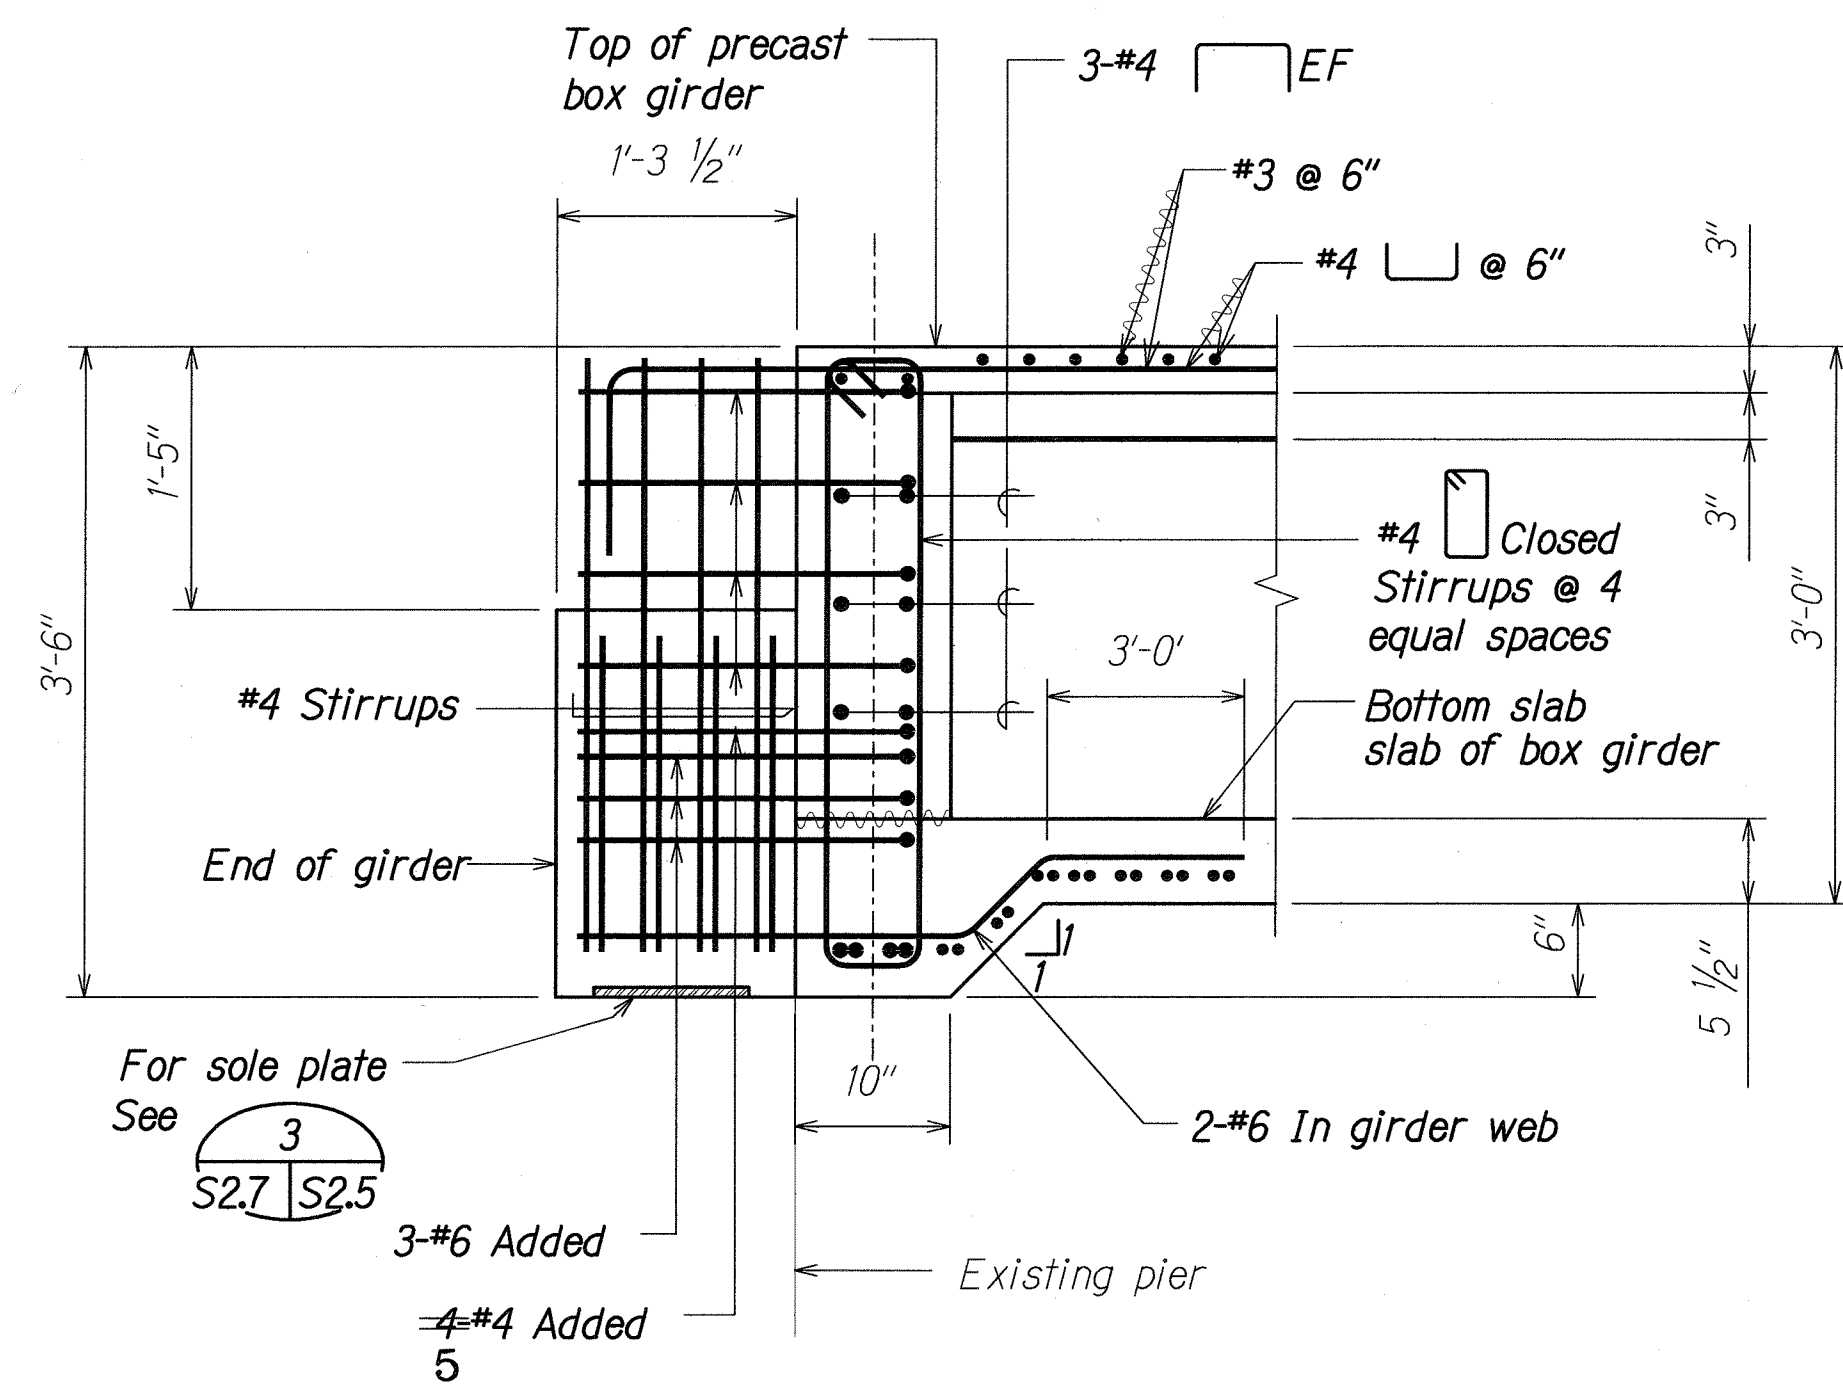

SECTION B
SCALE: 1" = 1'-0"

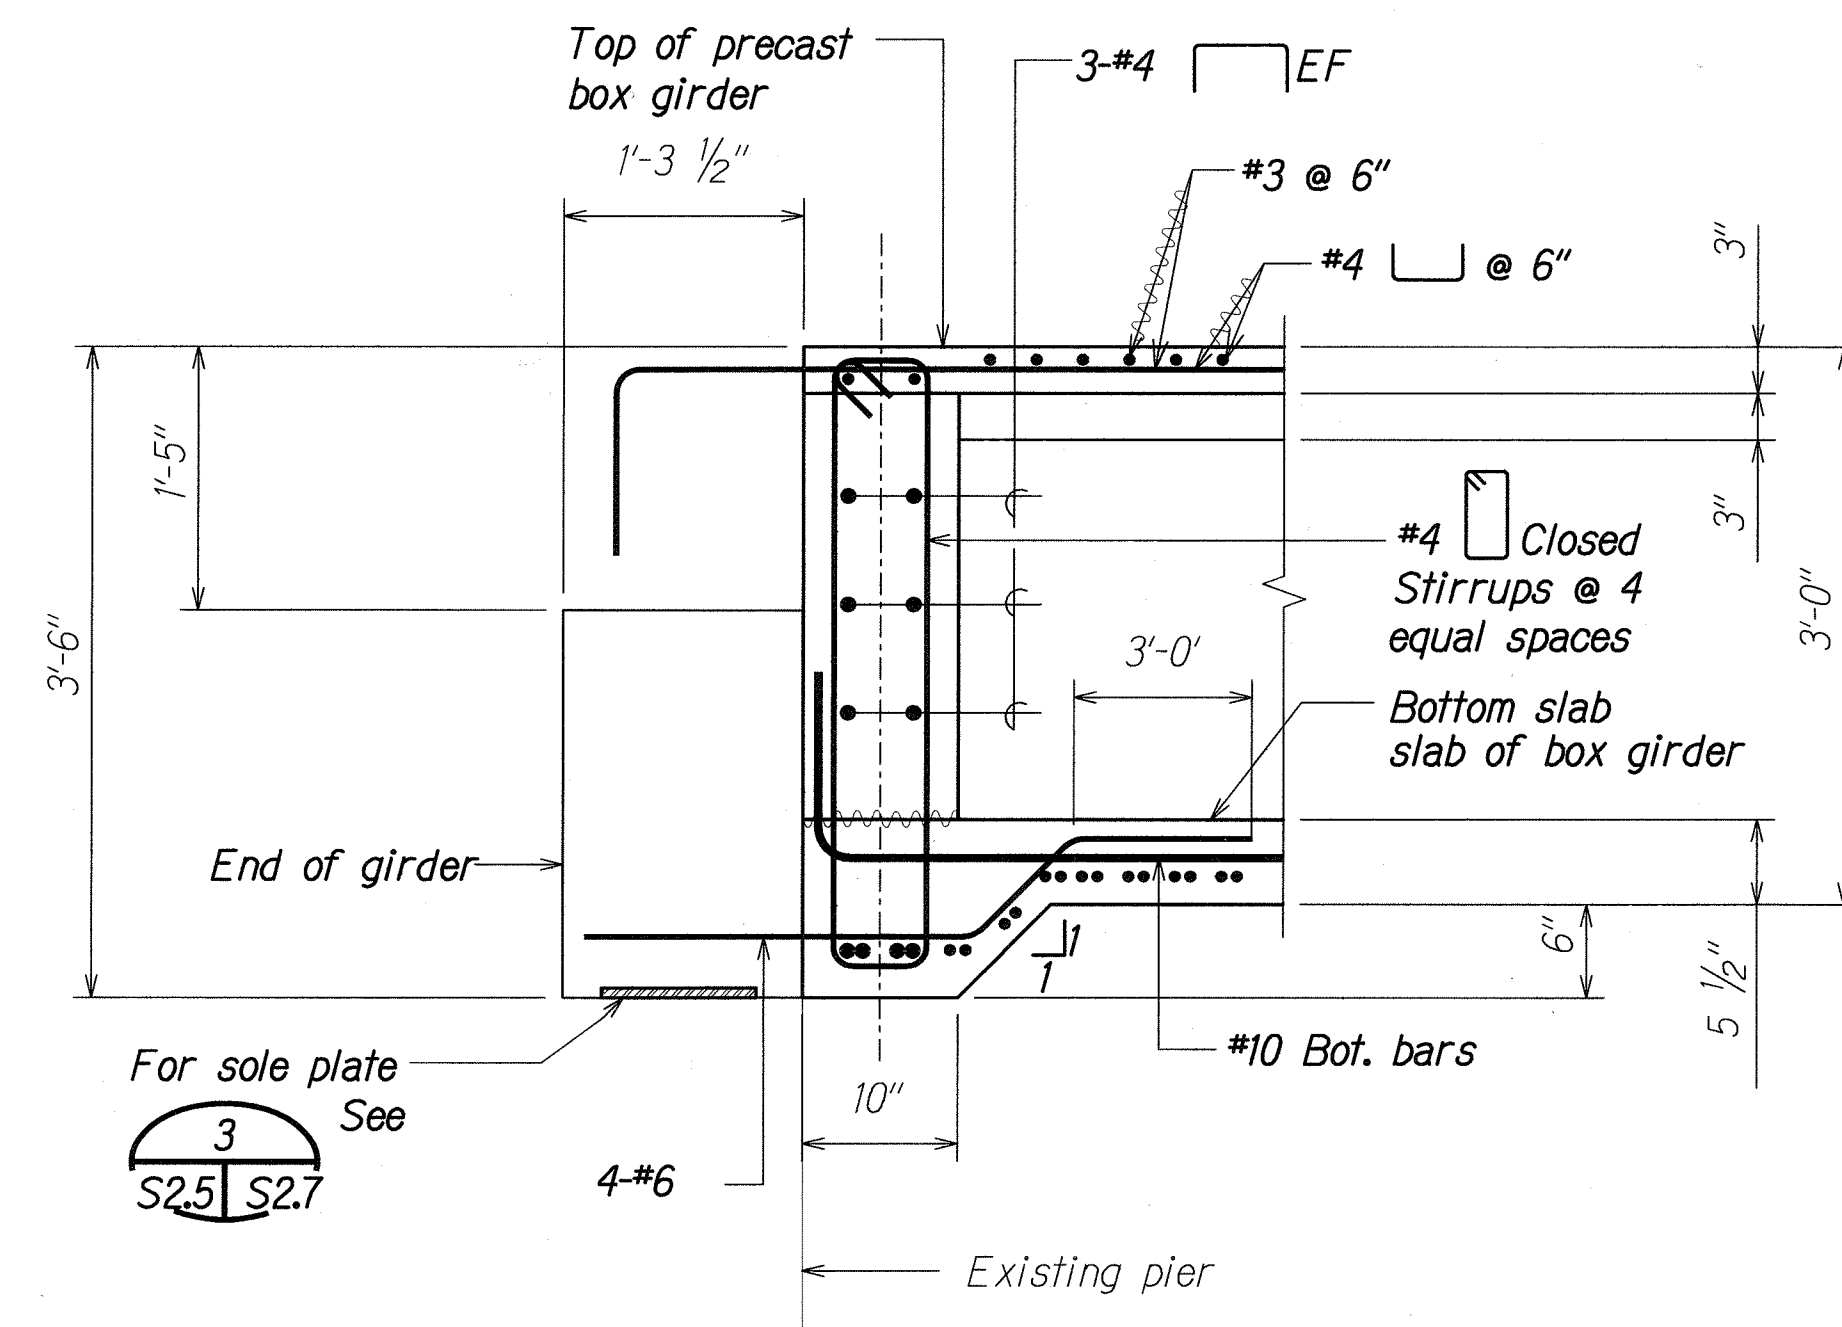


SECTION C
SCALE: 1" = 1'-0"

LEGEND FOR AS-BUILT POSTINGS	
	Squiggly line for as-built deletion
	Double line for as-built deletion
	Text for as-built posting


01/12/07	As Built
DATE	REVISION
STATE OF HAWAII DEPARTMENT OF TRANSPORTATION HIGHWAYS DIVISION EXPANSION END BOX GIRDER PLAN AND SECTIONS Repair of Mauka Span of Mahiko Street Pedestrian Overpass Project No. HI E-01-07M Scale: As Shown Date: Nov. 2006 SHEET No. S27 OF 16 SHEETS	

DESIGNED BY	DATE
TRACED BY	
NOTED BY	
QUANTITIES BY	
CHECKED BY	

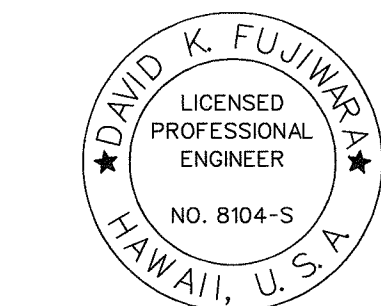


THIS WORK WAS PREPARED BY ME OR UNDER MY SUPERVISION.
 Signature: David K. Fujiwara
 EXPIRATION DATE OF THE LICENSE: 4-30-08

FED. ROAD DIST. NO.	STATE	PROJ. NO.	FISCAL YEAR	SHEET NO.	TOTAL SHEETS
HAWAII	HAW.	HI E-01-07M	2007	13	20

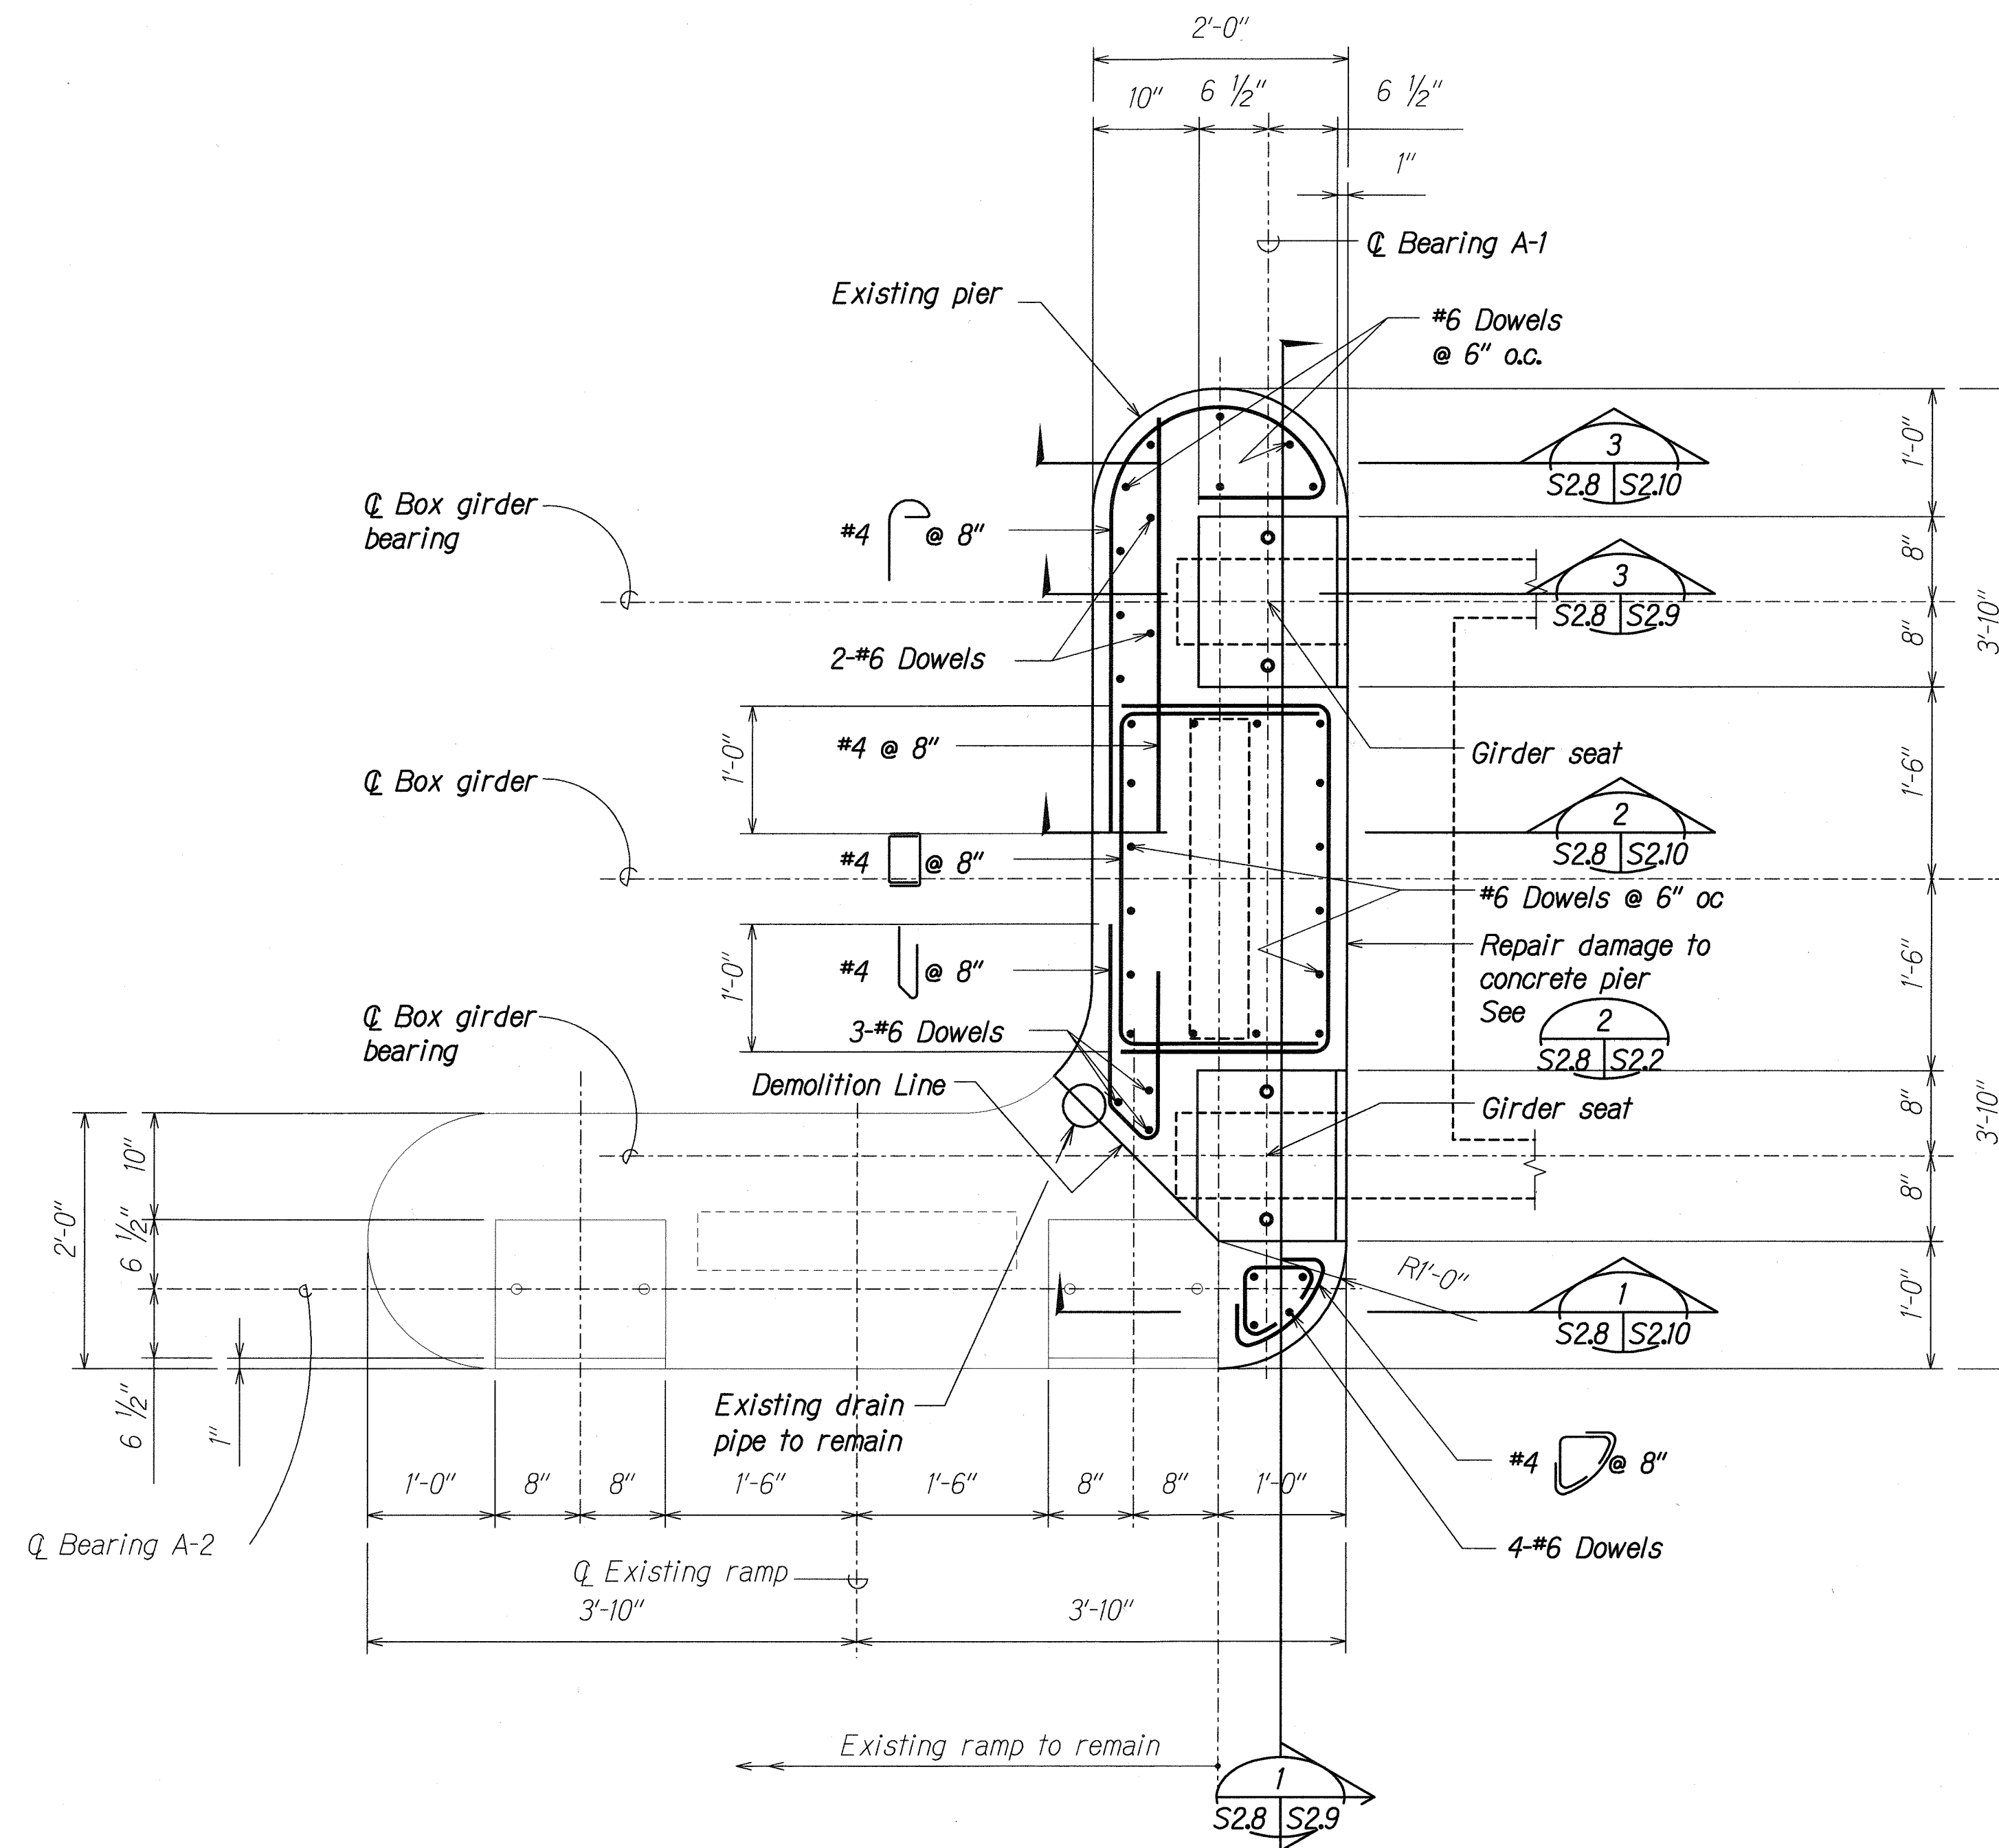


PLAN - PIER "A" A
SCALE: 1" = 1'-0" S2.8 S2.8

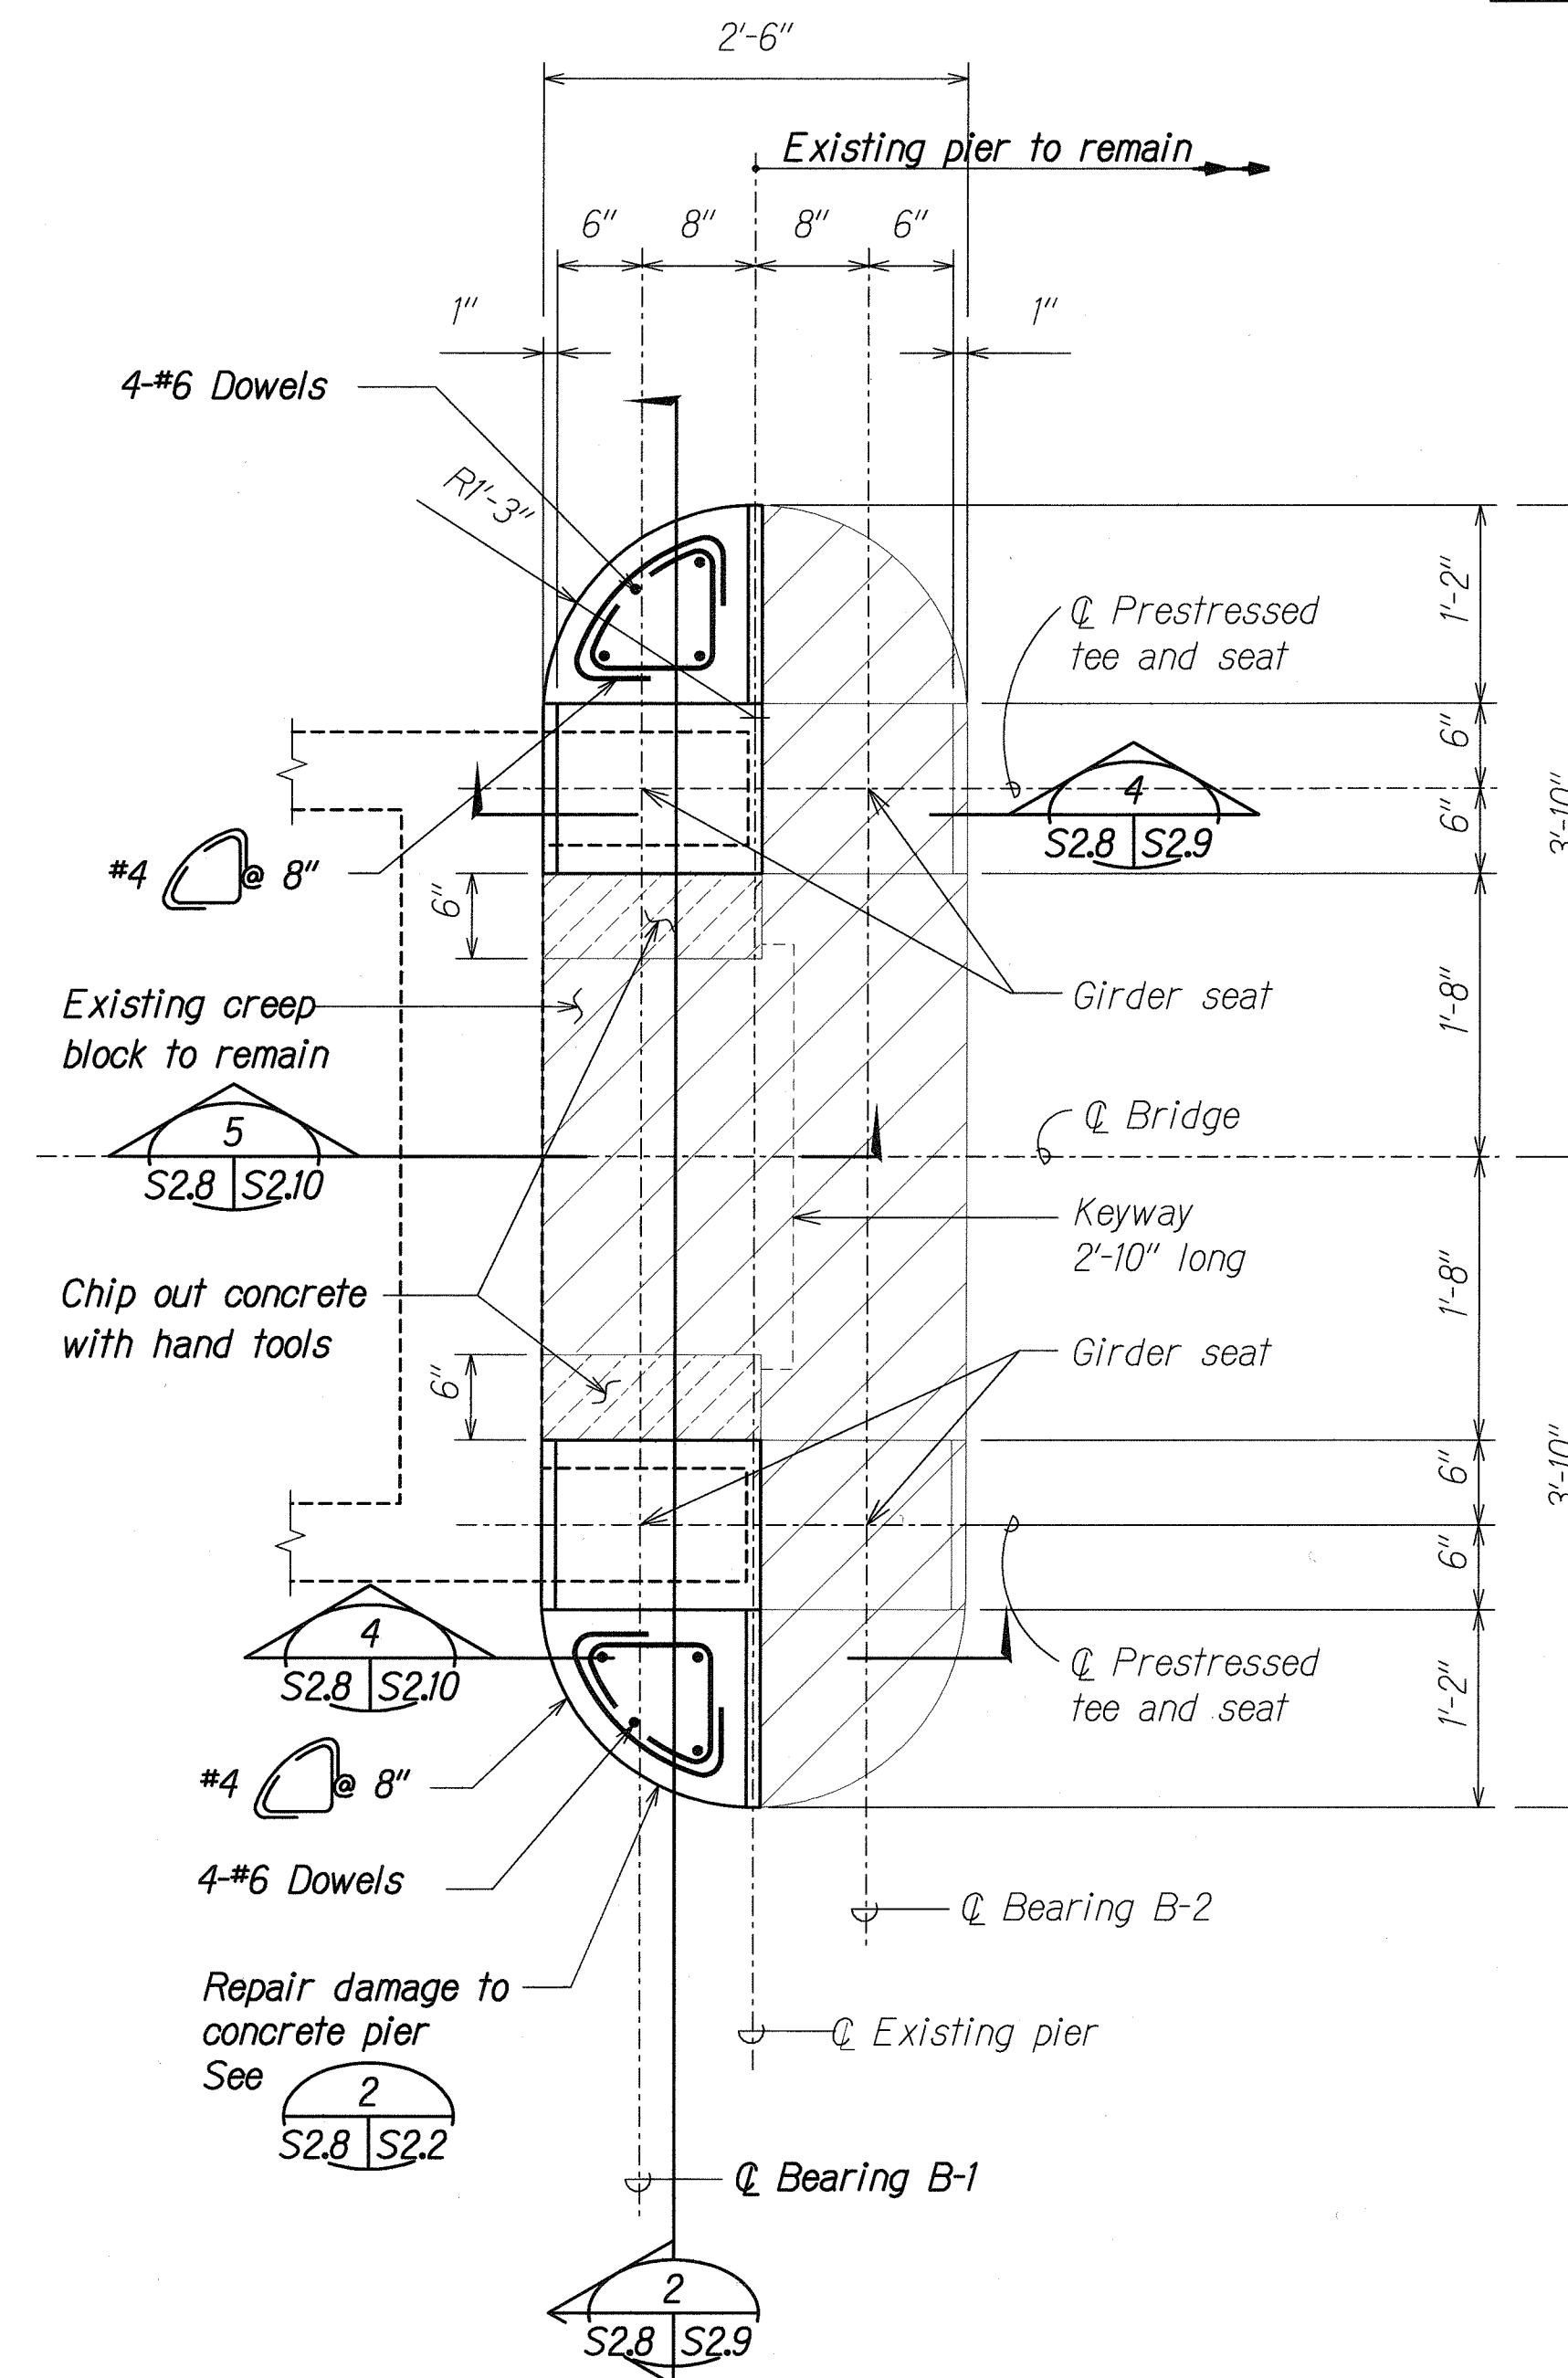

PLAN - PIER "B" B
SCALE: 1" = 1'-0" S2.8 S2.8

ORIGINAL PLAN	SURVEY PLOTTED BY	DATE
NOTE BOOK	DRAWN BY	
	DESIGNED BY	
	CHECKED BY	

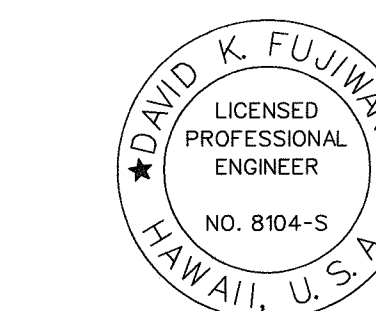

THIS WORK WAS PREPARED BY
ME OR UNDER MY SUPERVISION.

David K. Fujiwara 4-30-08
SIGNATURE EXPIRATION DATE OF THE LICENSE

STATE OF HAWAII
DEPARTMENT OF TRANSPORTATION
HIGHWAYS DIVISION


PIER PLANS

Repair of Mauka Span of
Mahiko Street Pedestrian Overpass
Project No. HI E-01-07M


Scale: As Noted Date: Nov. 2006

SHEET No. S2.8 OF 16 SHEETS

FED. ROAD DIST. NO.	STATE	PROJ. NO.	FISCAL YEAR	SHEET NO.	TOTAL SHEETS
HAWAII	HAW.	HI E-01-07M	2007	15	20

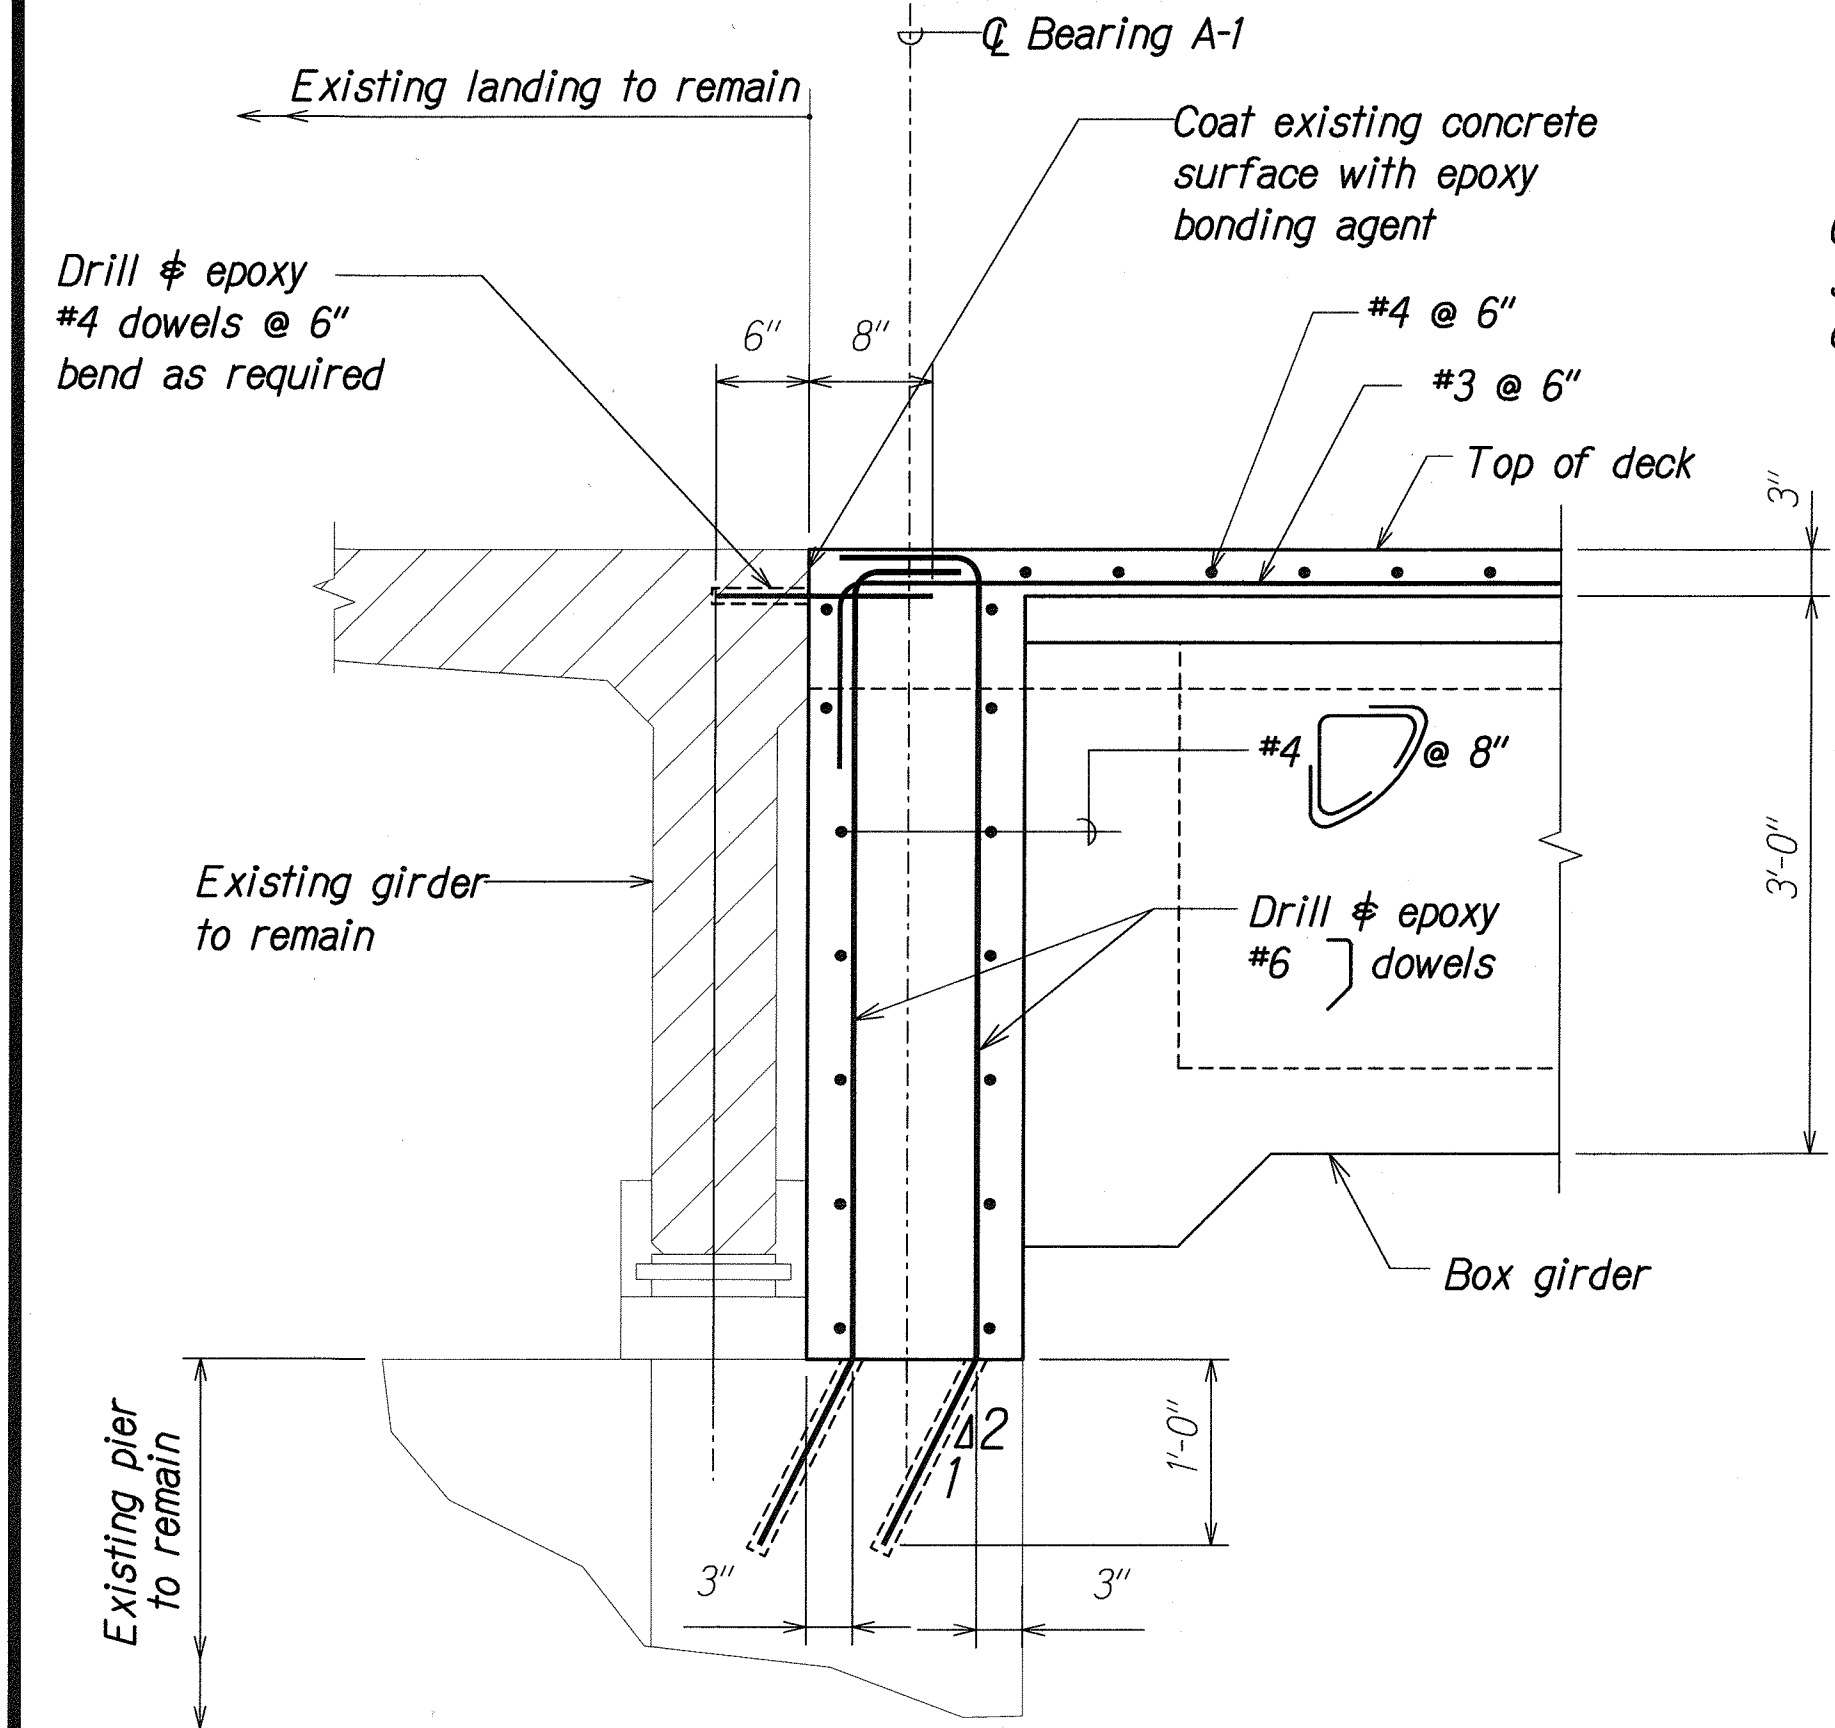


SECTION AT PIER "A" 1
SCALE: 1" = 1'-0"
S2.8 S2.10

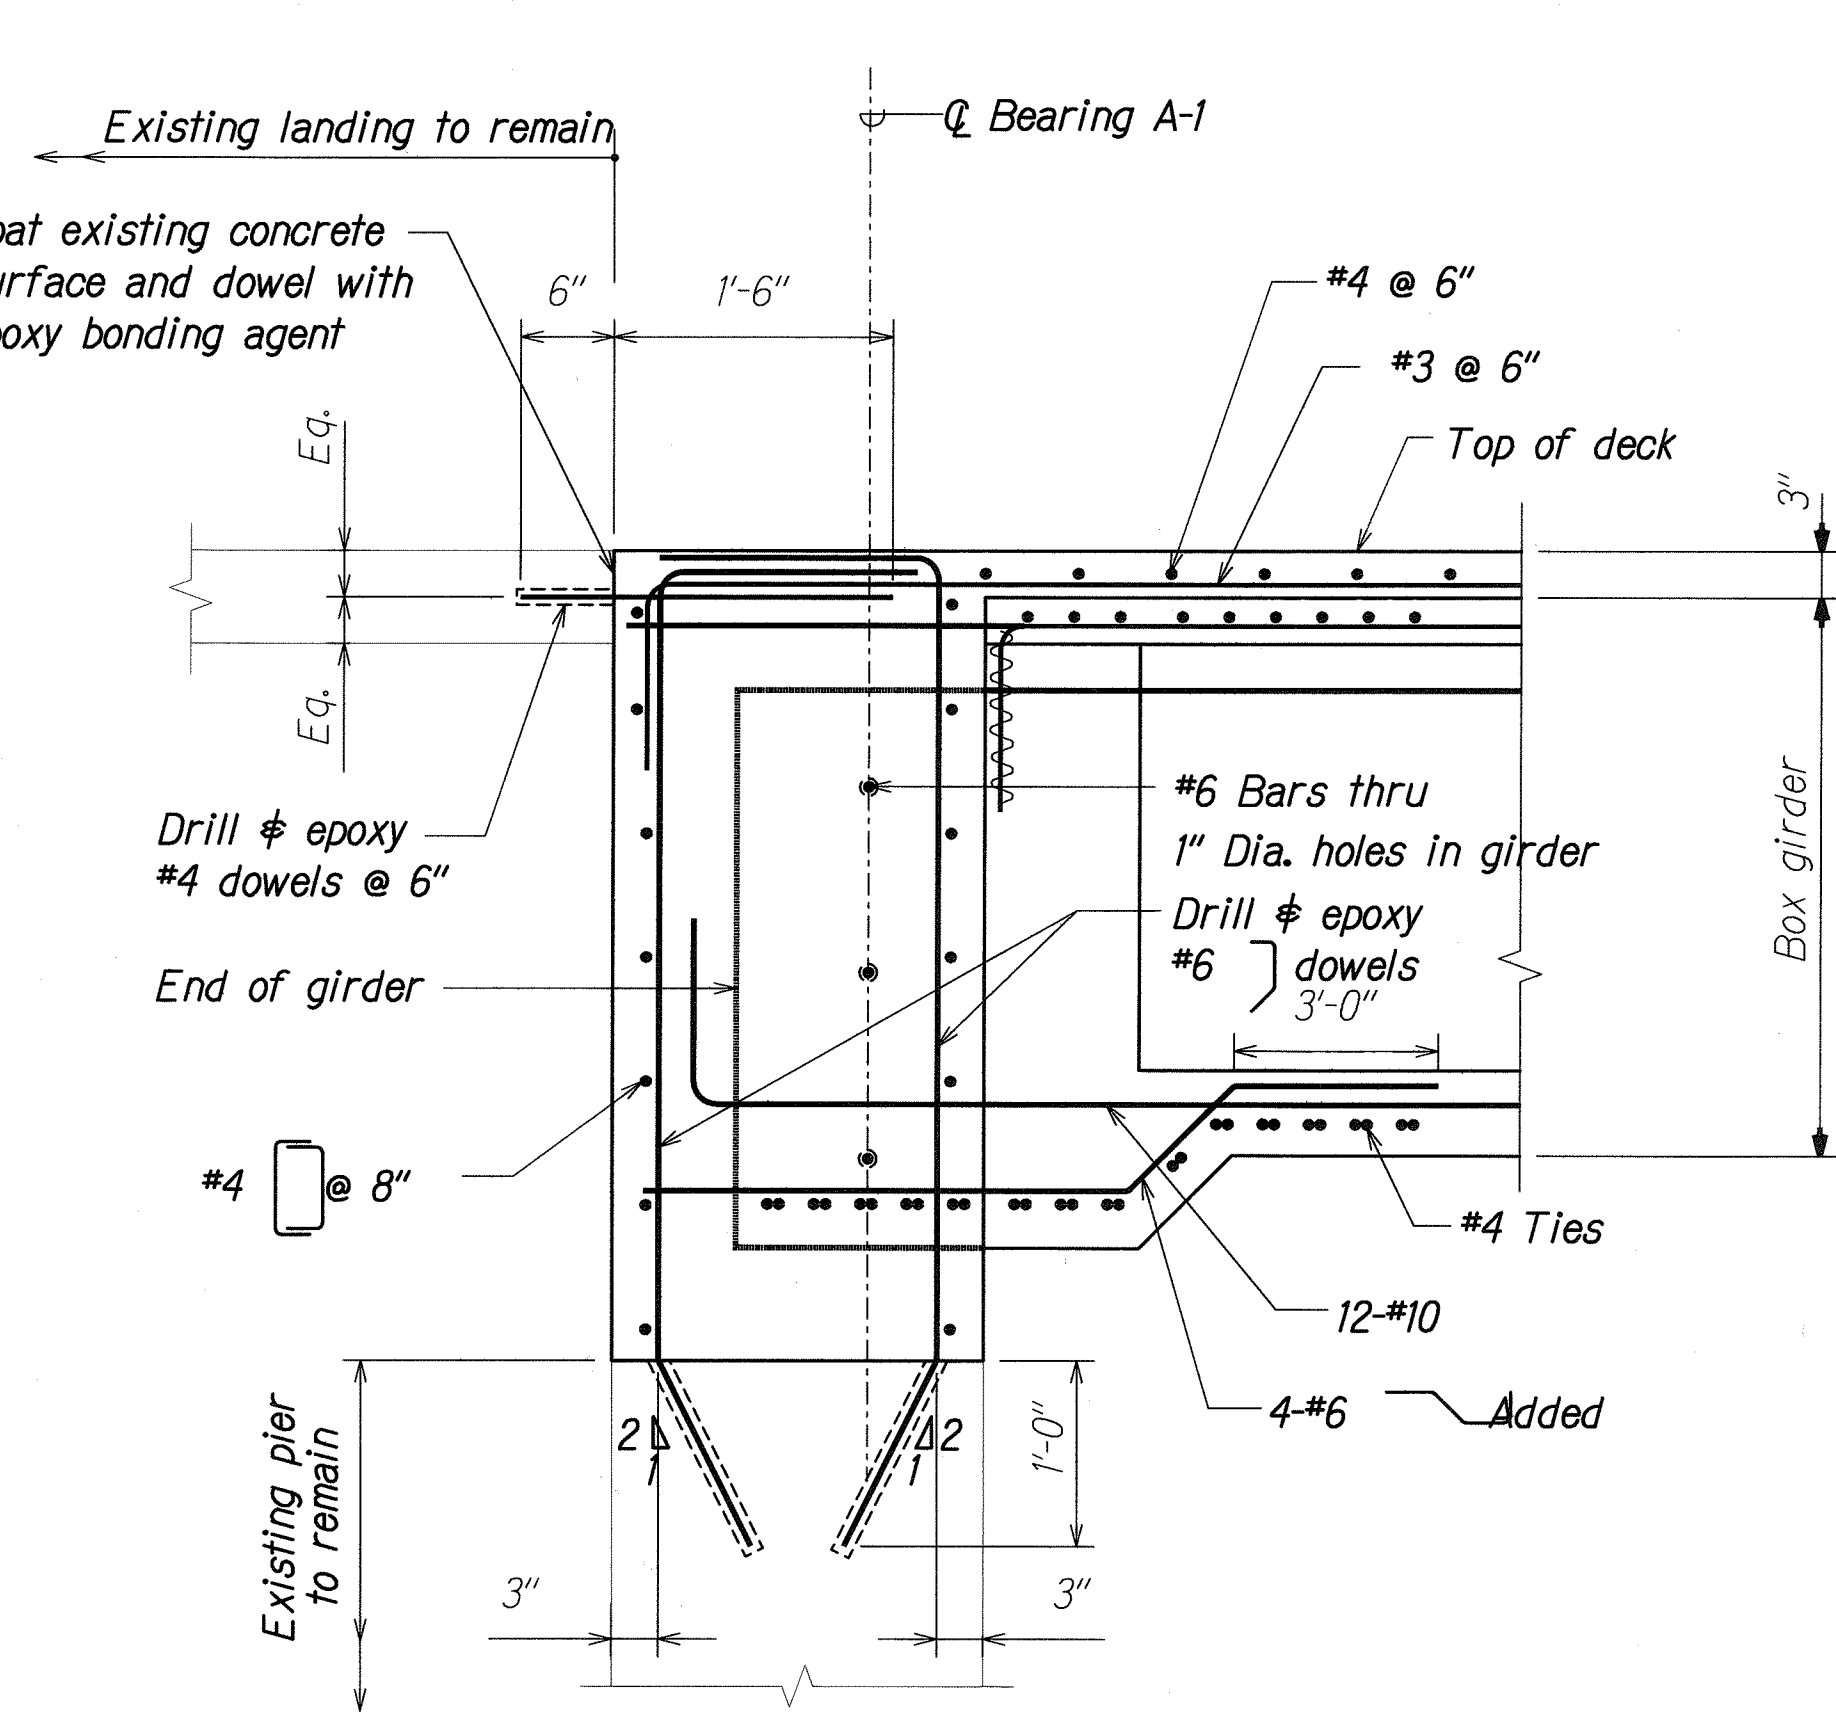


SECTION AT PIER "A" 2
SCALE: 1" = 1'-0"
S2.8 S2.10


LEGEND FOR AS-BUILT POSTINGS	
	Squiggly line for as-built deletion
	Double line for as-built deletion
Roadway	Text for as-built posting

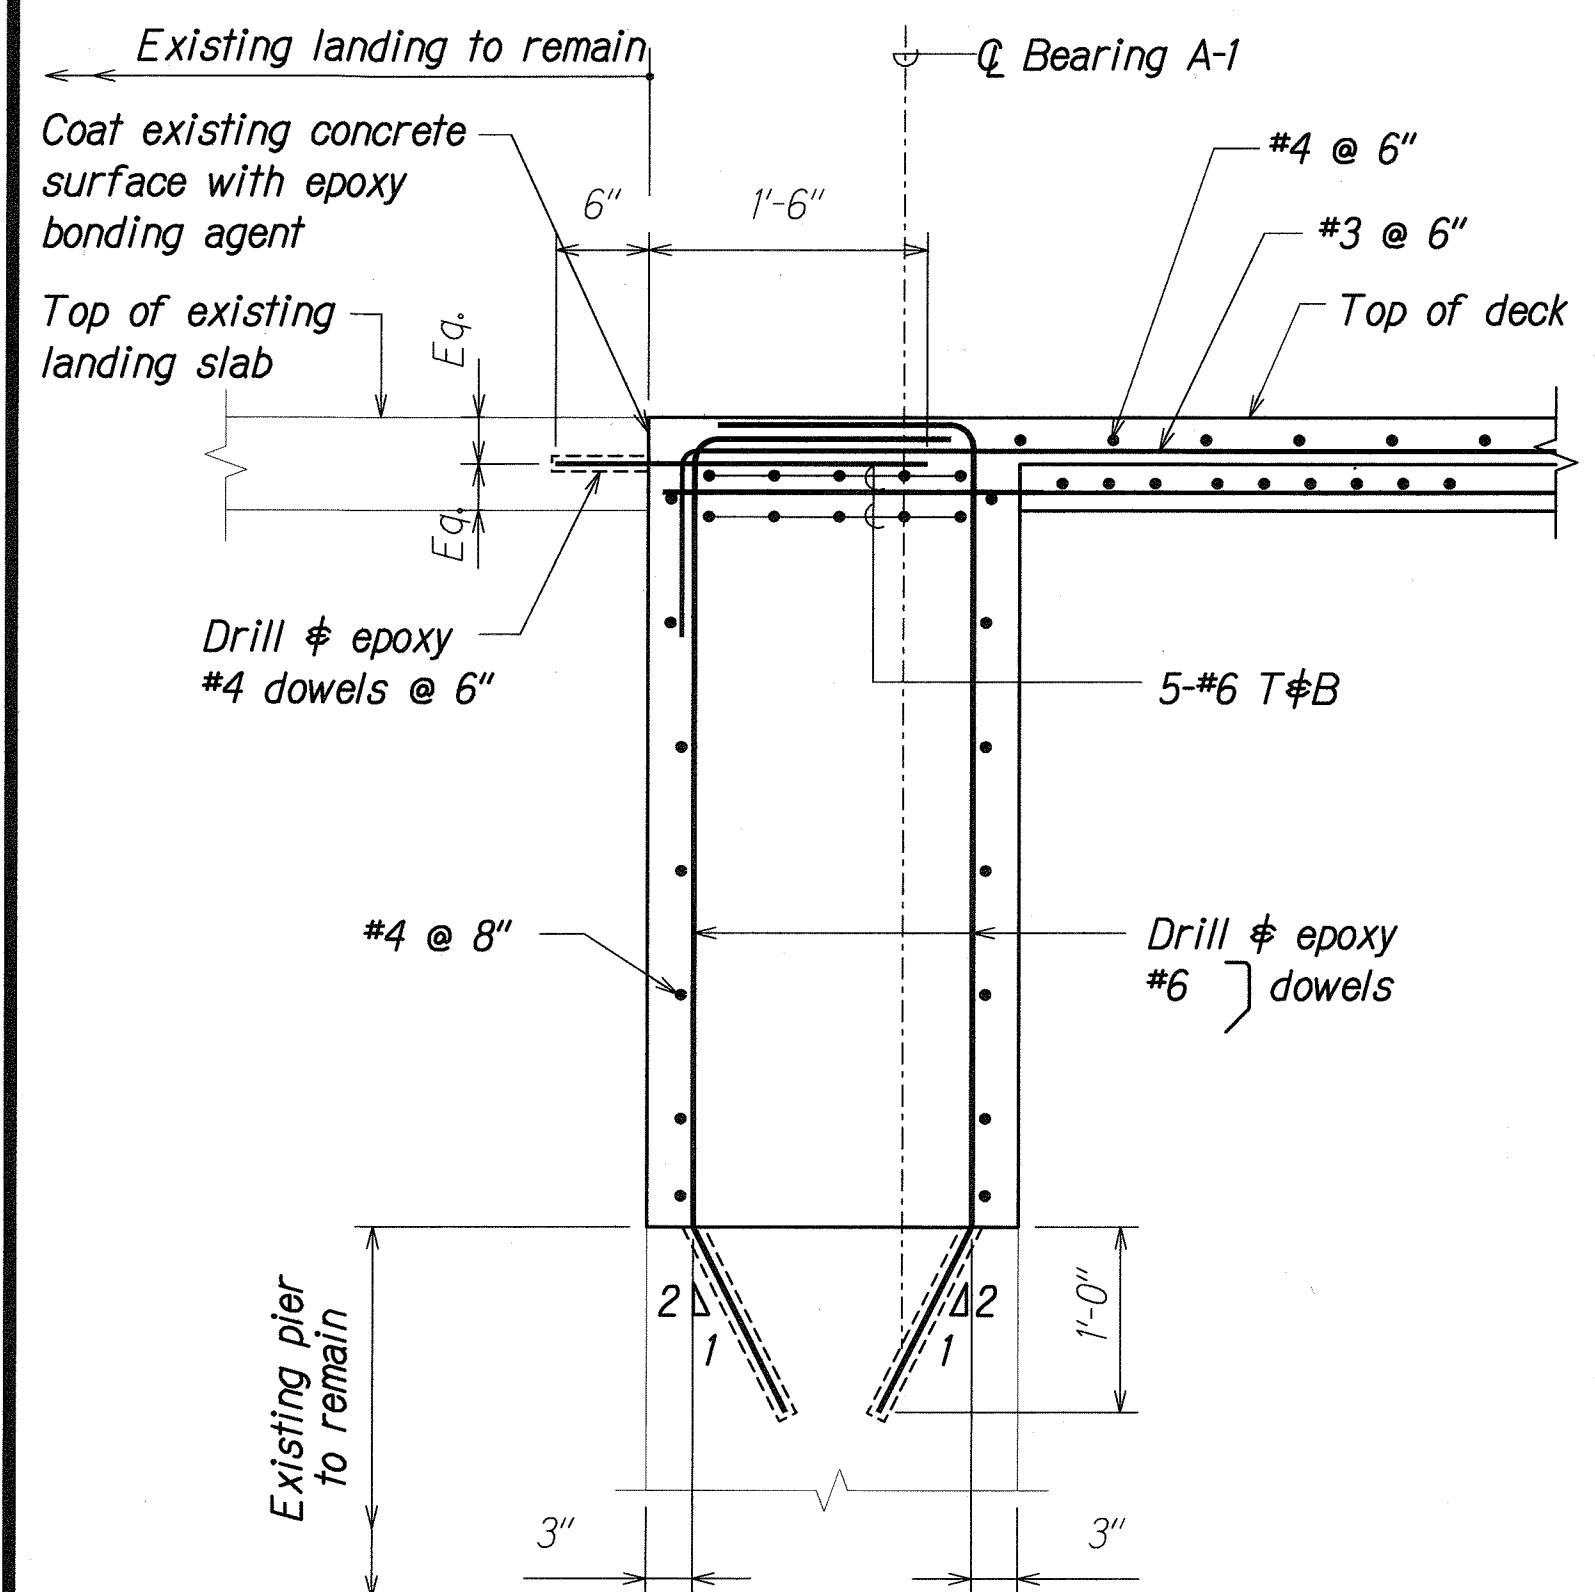


SECTION AT PIER "A" 3
SCALE: 1" = 1'-0"
S2.8 S2.10

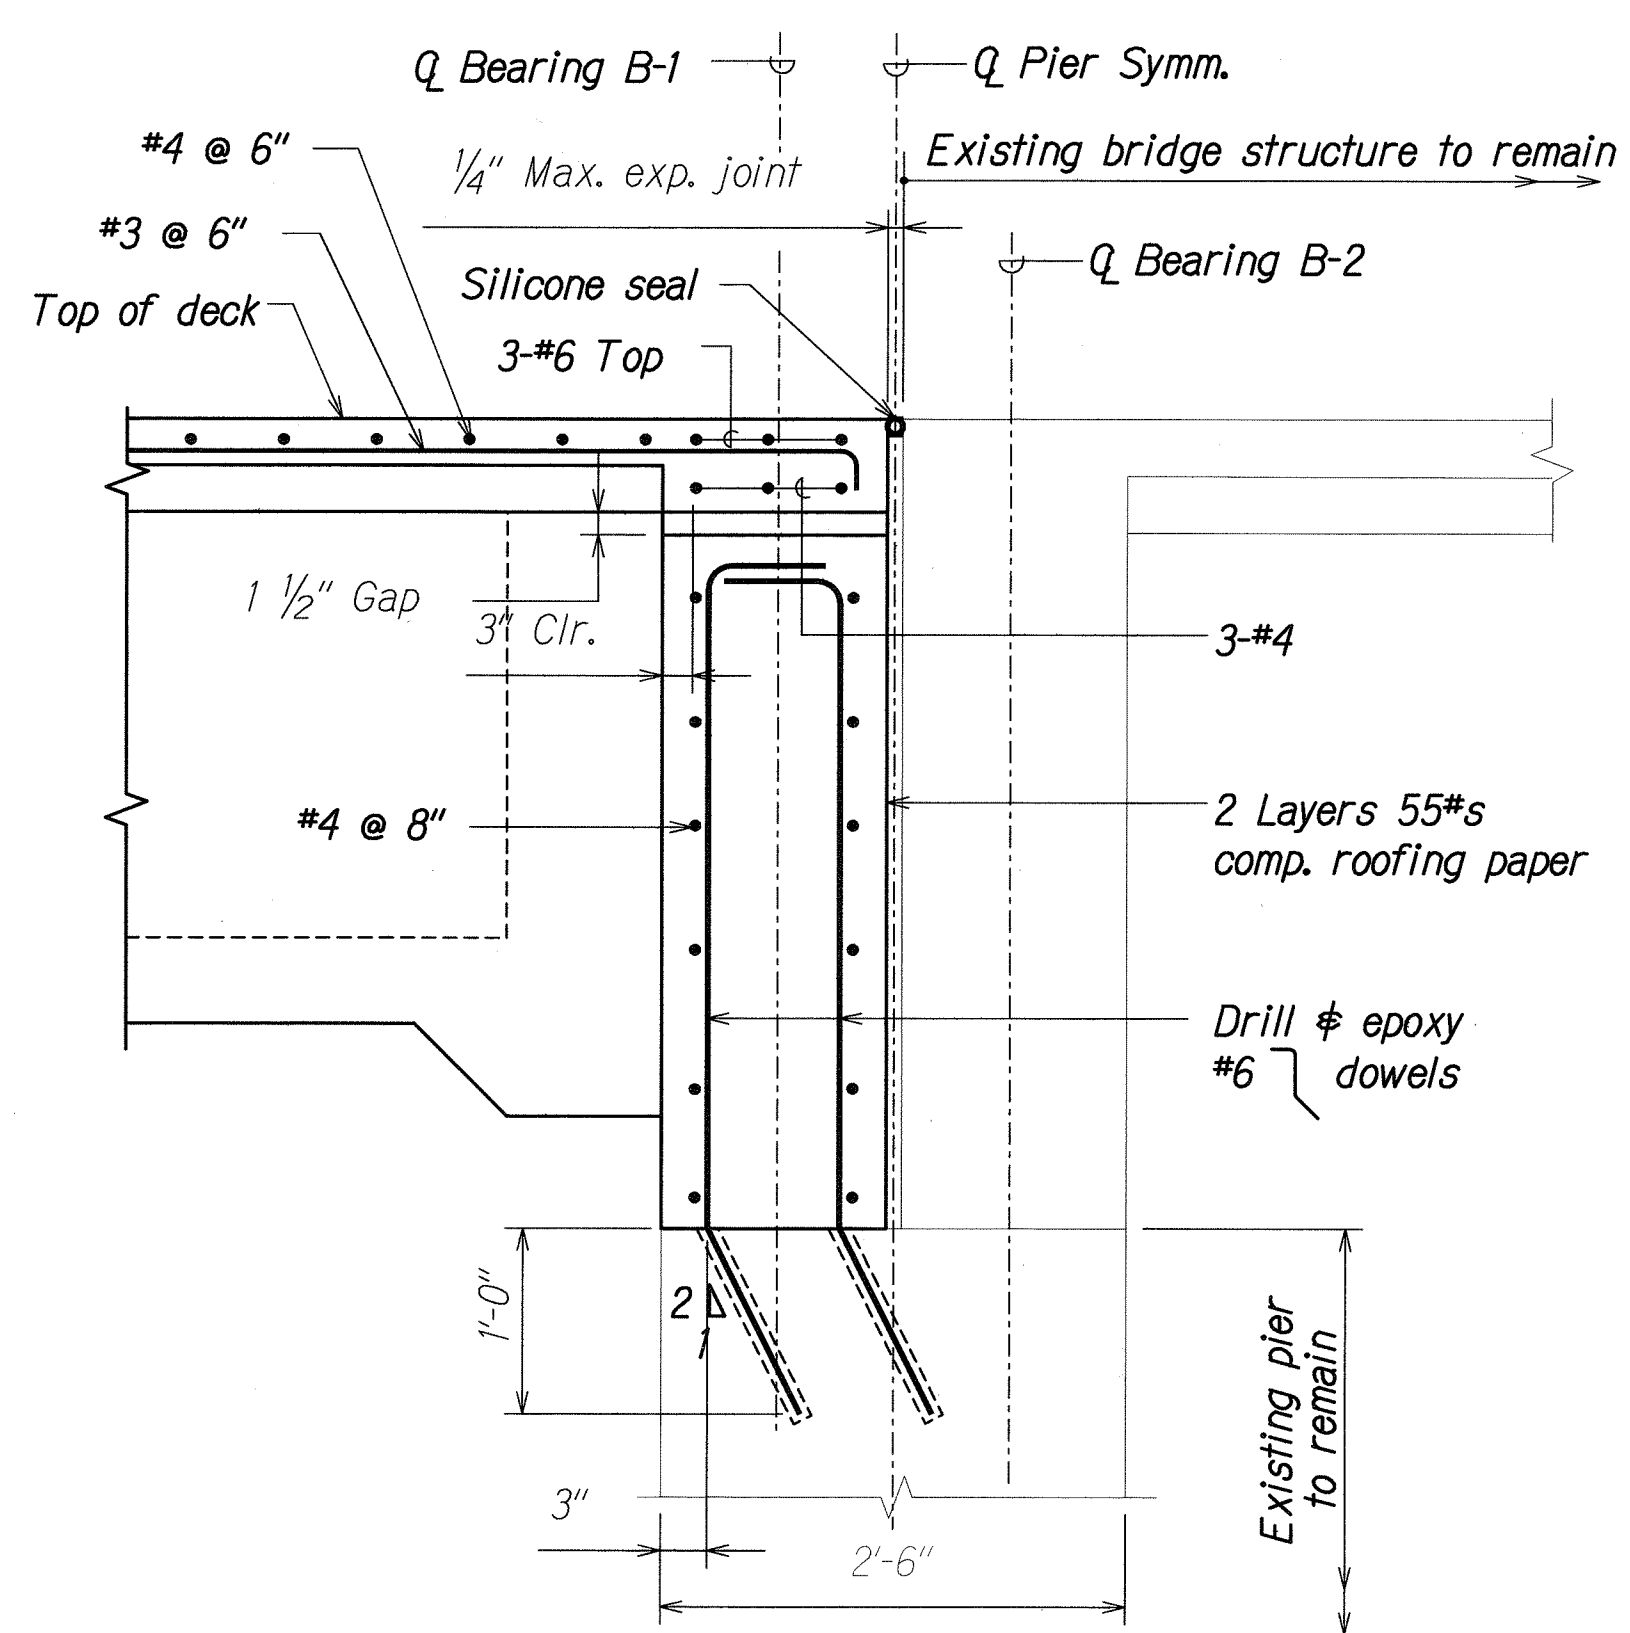

SECTION AT PIER "B" 4
SCALE: 1" = 1'-0"
S2.8 S2.10

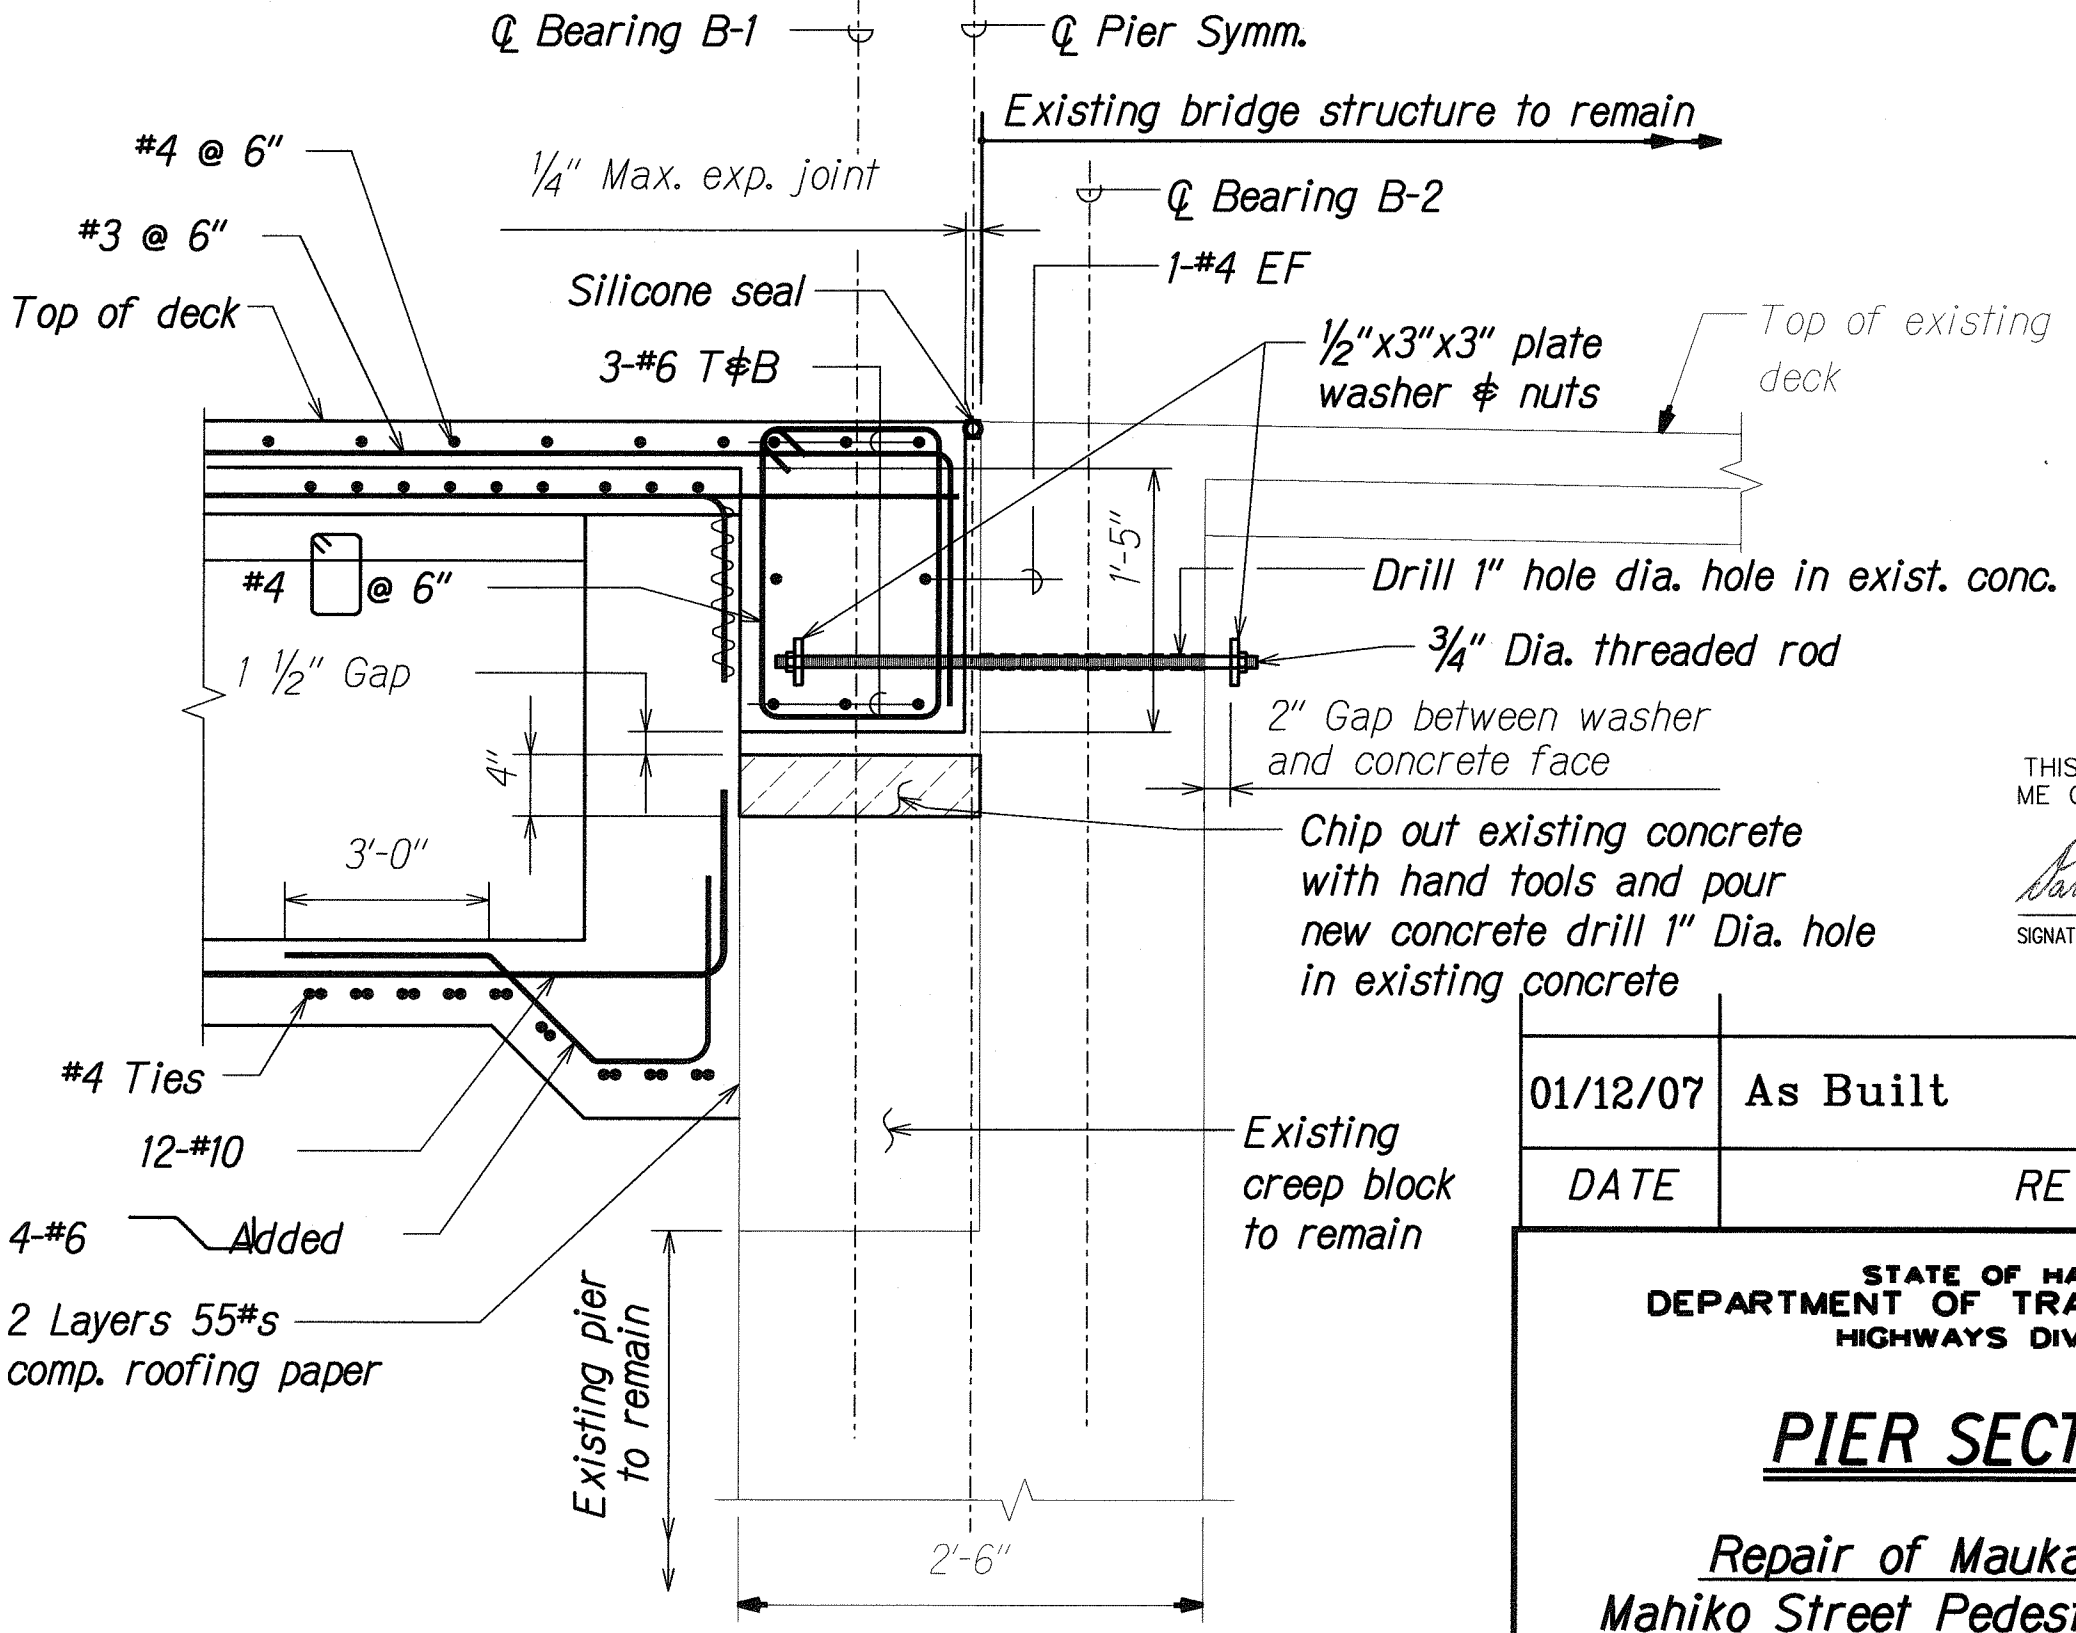

SECTION AT PIER "B" 5
SCALE: 1" = 1'-0"
S2.8 S2.10

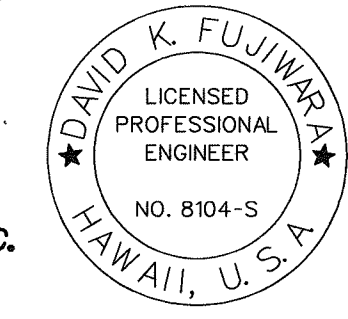


THIS WORK WAS PREPARED BY ME OR UNDER MY SUPERVISION.
David K. Fujiwara
SIGNATURE EXPIRATION DATE OF THE LICENSE 4-30-08

01/12/07	As Built
DATE	REVISION
STATE OF HAWAII DEPARTMENT OF TRANSPORTATION HIGHWAYS DIVISION	
PIER SECTIONS	
Repair of Mauka Span of Mahiko Street Pedestrian Overpass Project No. HI E-01-07M	
Scale: As Noted	Date: Nov. 2006
SHEET No. S2.10 OF 16 SHEETS	

DATE	_____
DESIGNED BY	_____
TRACED BY	_____
NOTED BY	_____
CHECKED BY	_____
ORIGINAL PLAN	_____
NOTE BOOK	_____
QUANTITIES BY	_____
CHECKED BY	_____


"AS-BUILT"

FED. ROAD DIST. NO.	STATE	PROJ. NO.	FISCAL YEAR	SHEET NO.	TOTAL SHEETS
HAWAII	HAW.	HI E-01-07M	2007	16	20

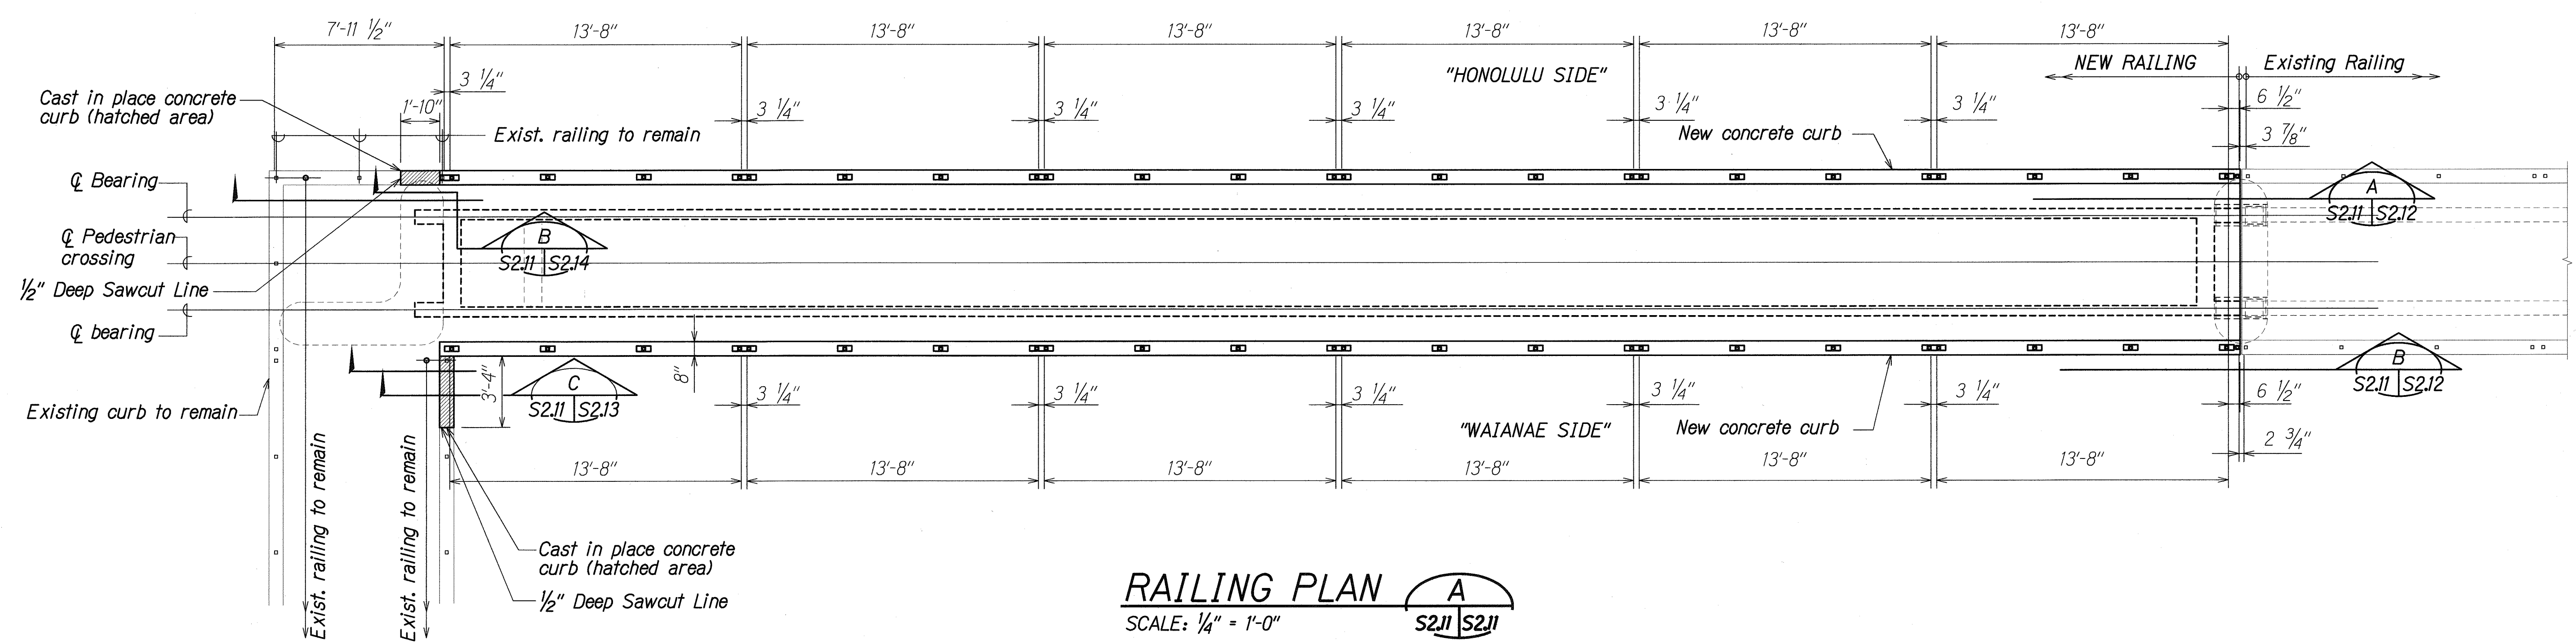

RAILING PLAN A
SCALE: 1/4" = 1'-0"

ORIGINAL PLAN	DATE
DESIGNED BY	
TRACED BY	
NOTED BY	
CHECKED BY	

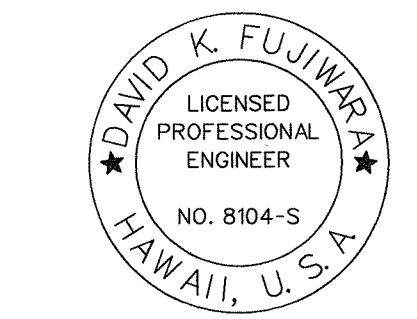

THIS WORK WAS PREPARED BY ME OR UNDER MY SUPERVISION.
David K. Fujiwara
 SIGNATURE EXPIRATION DATE OF THE LICENSE 4-30-08



STATE OF HAWAII
 DEPARTMENT OF TRANSPORTATION
 HIGHWAYS DIVISION

RAILING PLAN


 Repair of Mauka Span of
 Mahiko Street Pedestrian Overpass
 Project No. HI E-01-07M

 Scale: As Shown Date: Nov. 2006
 SHEET No. S2.11 OF 16 SHEETS

FED. ROAD DIST. NO.	STATE	PROJ. NO.	FISCAL YEAR	SHEET NO.	TOTAL SHEETS
HAWAII	HAW.	HI E-01-07M	2007	17	20

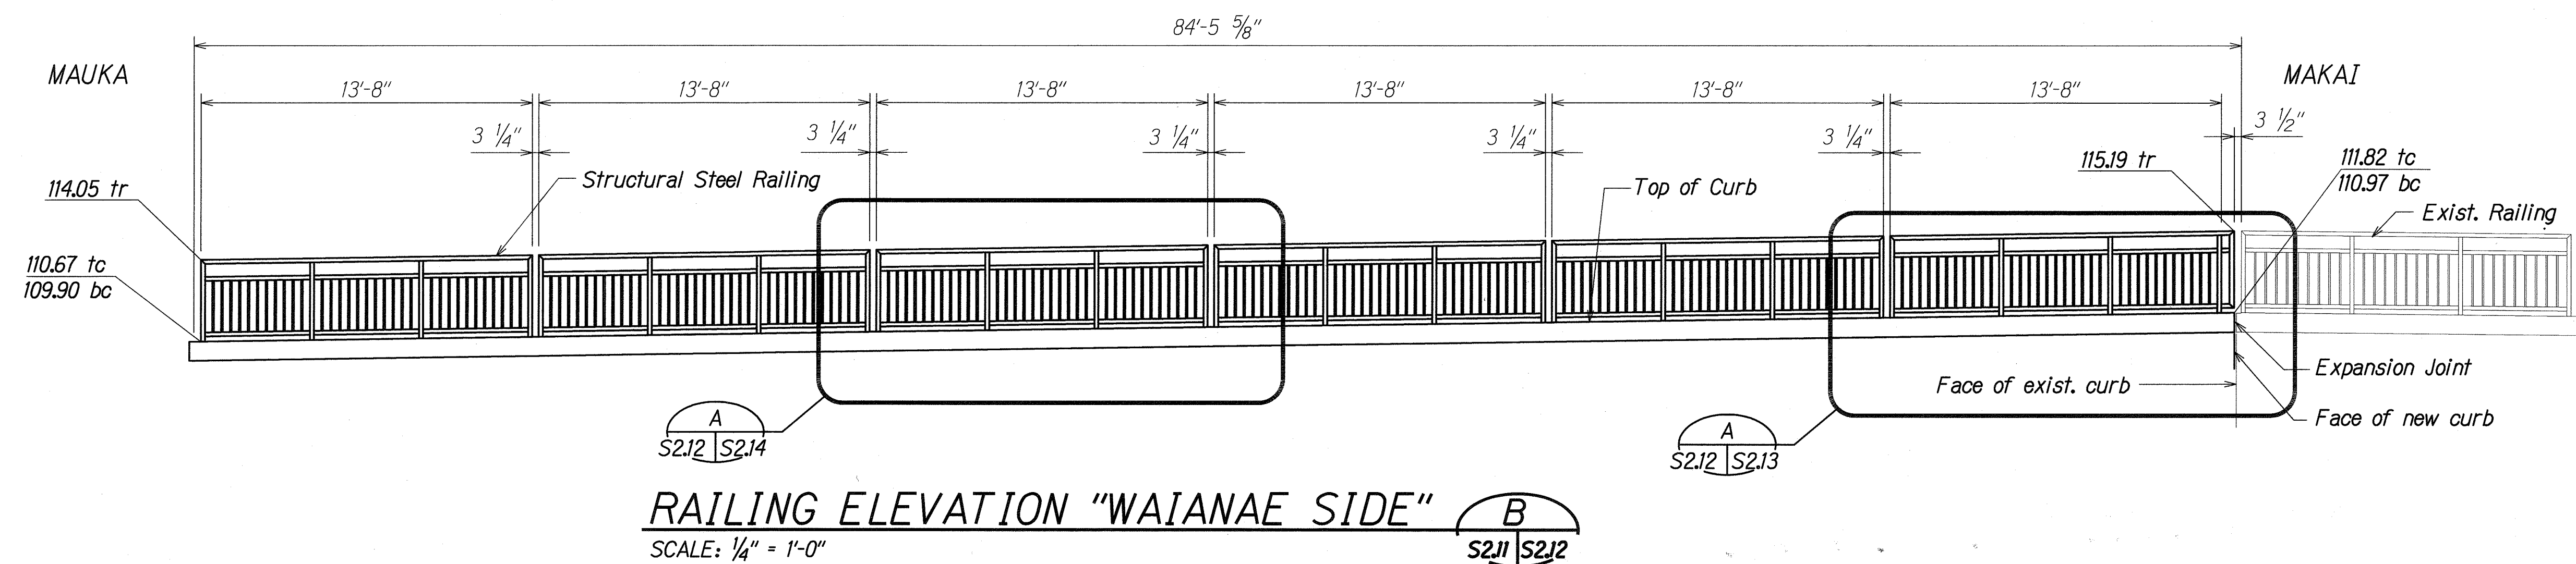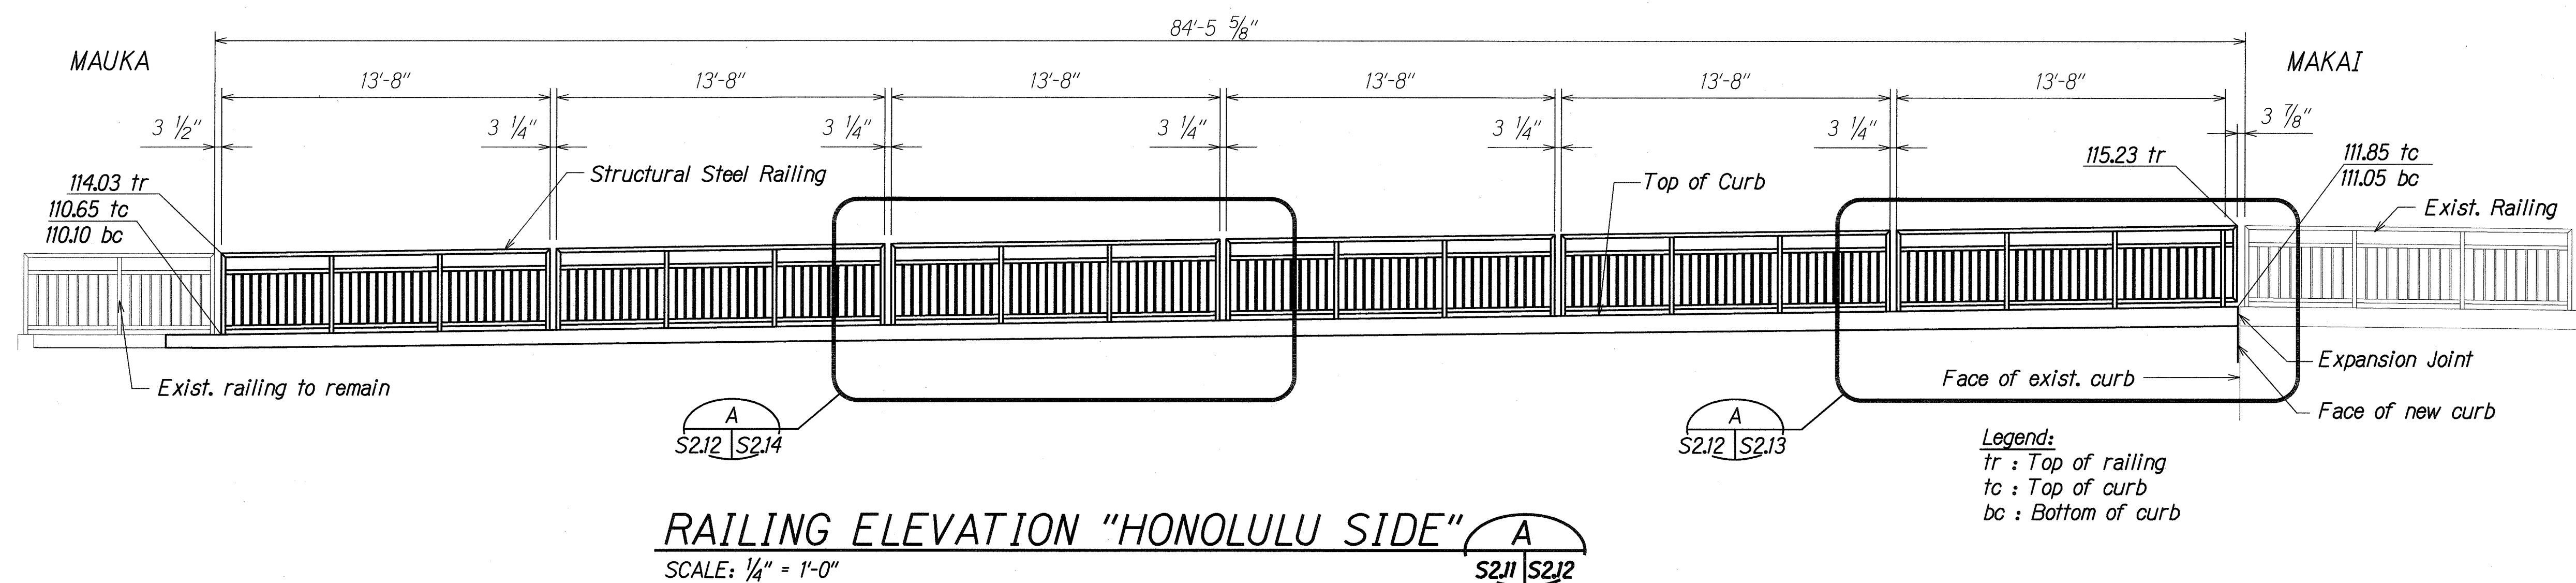

ORIGINAL PLAN	DATE
SURVEY PLOTTED BY	
DRAWN BY	
DESIGNED BY	
CHECKED BY	
NOTE BOOK	
NO.	

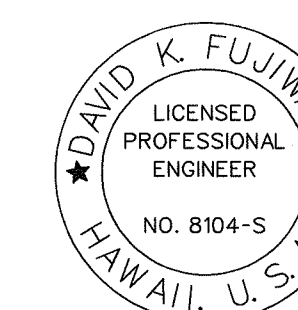

THIS WORK WAS PREPARED BY
ME OR UNDER MY SUPERVISION.
David K. Fujiwara
SIGNATURE EXPIRATION DATE OF THE LICENSE 4-30-08

STATE OF HAWAII
DEPARTMENT OF TRANSPORTATION
HIGHWAYS DIVISION


RAILING ELEVATIONS

Repair of Mauka Span of
Mahiko Street Pedestrian Overpass
Project No. HI E-01-07M

Scale: As Shown Date: Nov. 2006

SHEET No. S2J2 OF 16 SHEETS


FED. ROAD DIST. NO.	STATE	PROJ. NO.	FISCAL YEAR	SHEET NO.	TOTAL SHEETS
HAWAII	HAW.	HI E-01-07M	2007	19	20

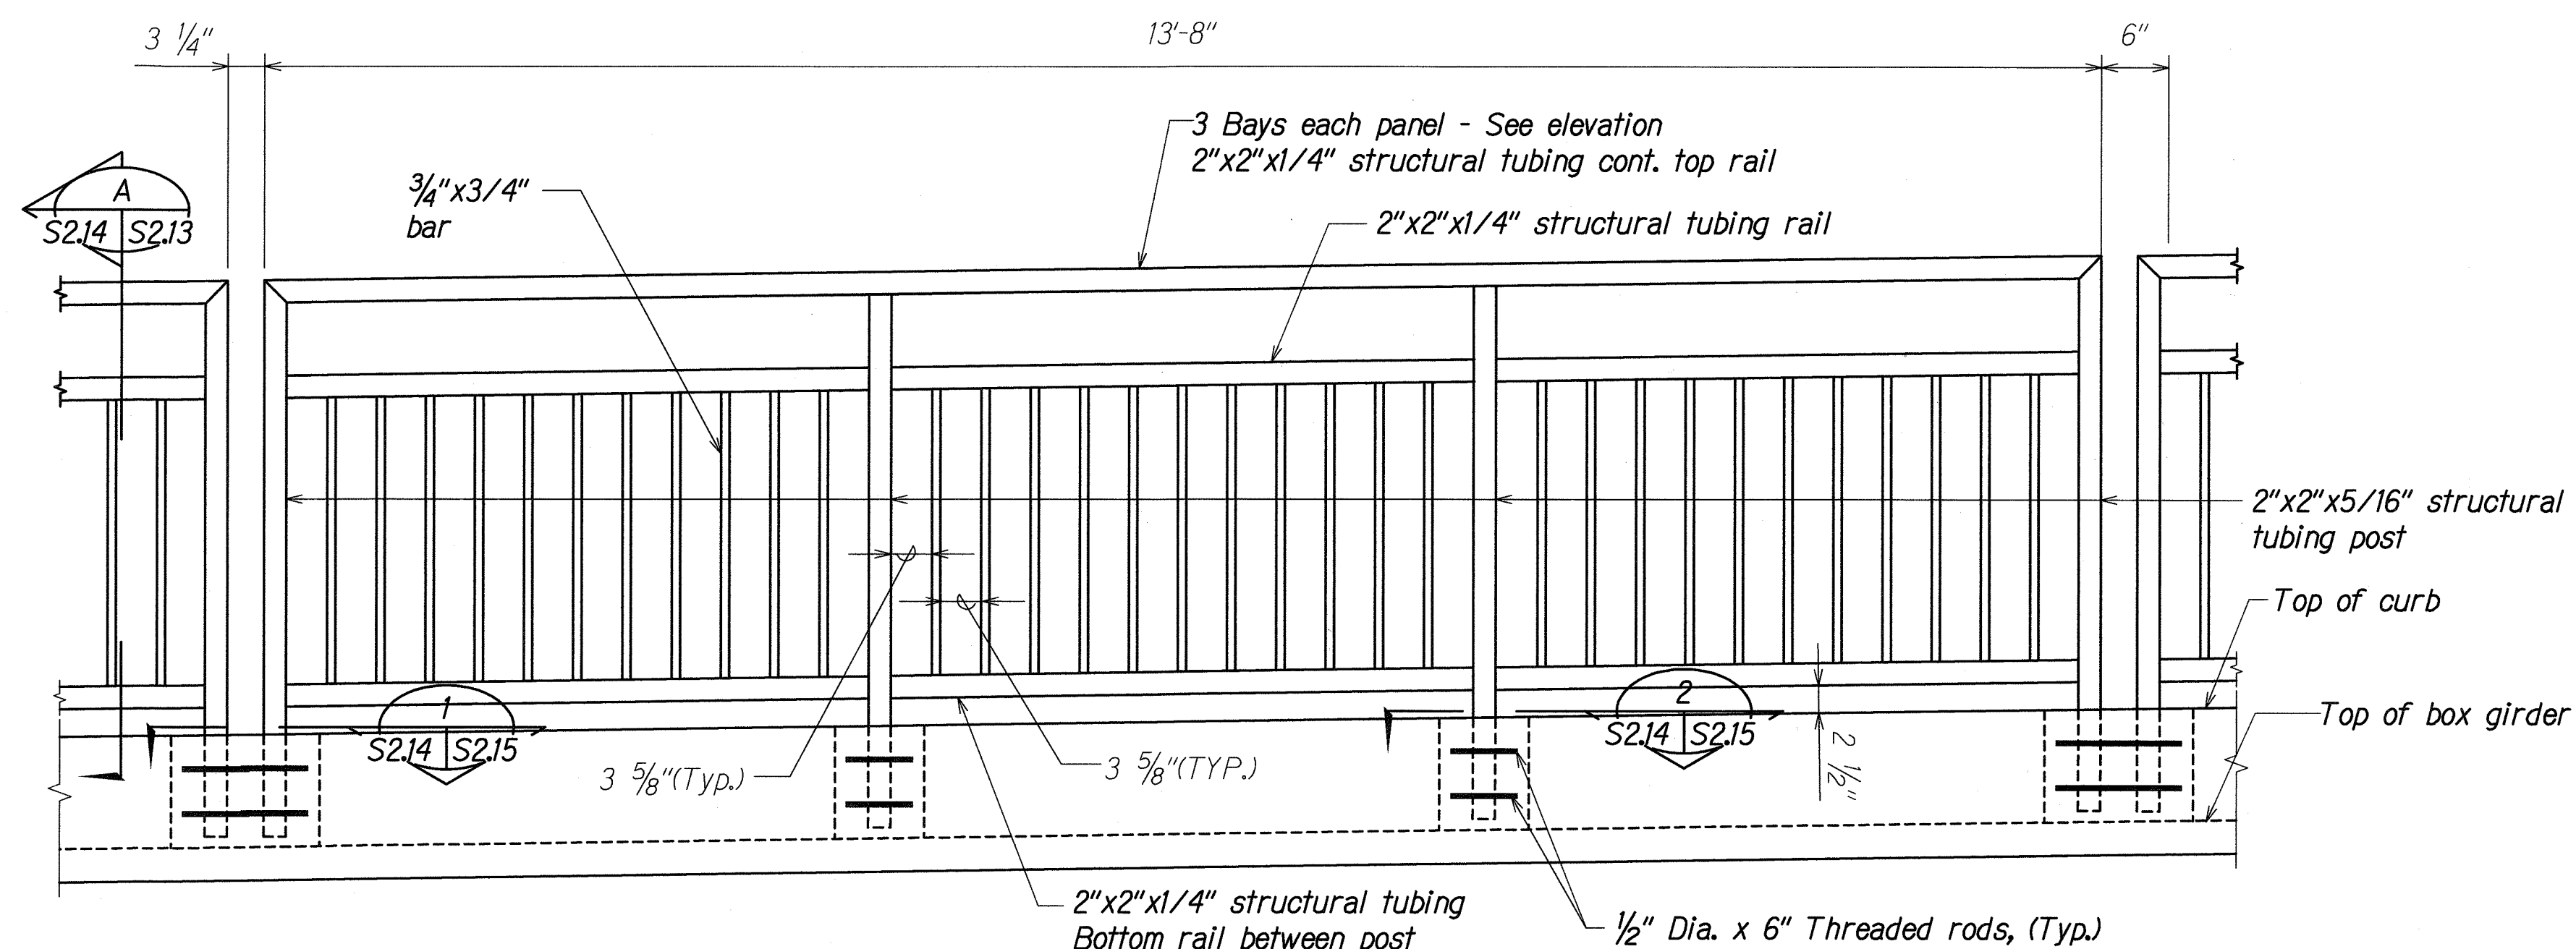

ELEVATION- METAL HANDRAIL

SCALE: 1" = 1'-0"

A
S2J12 S2J14

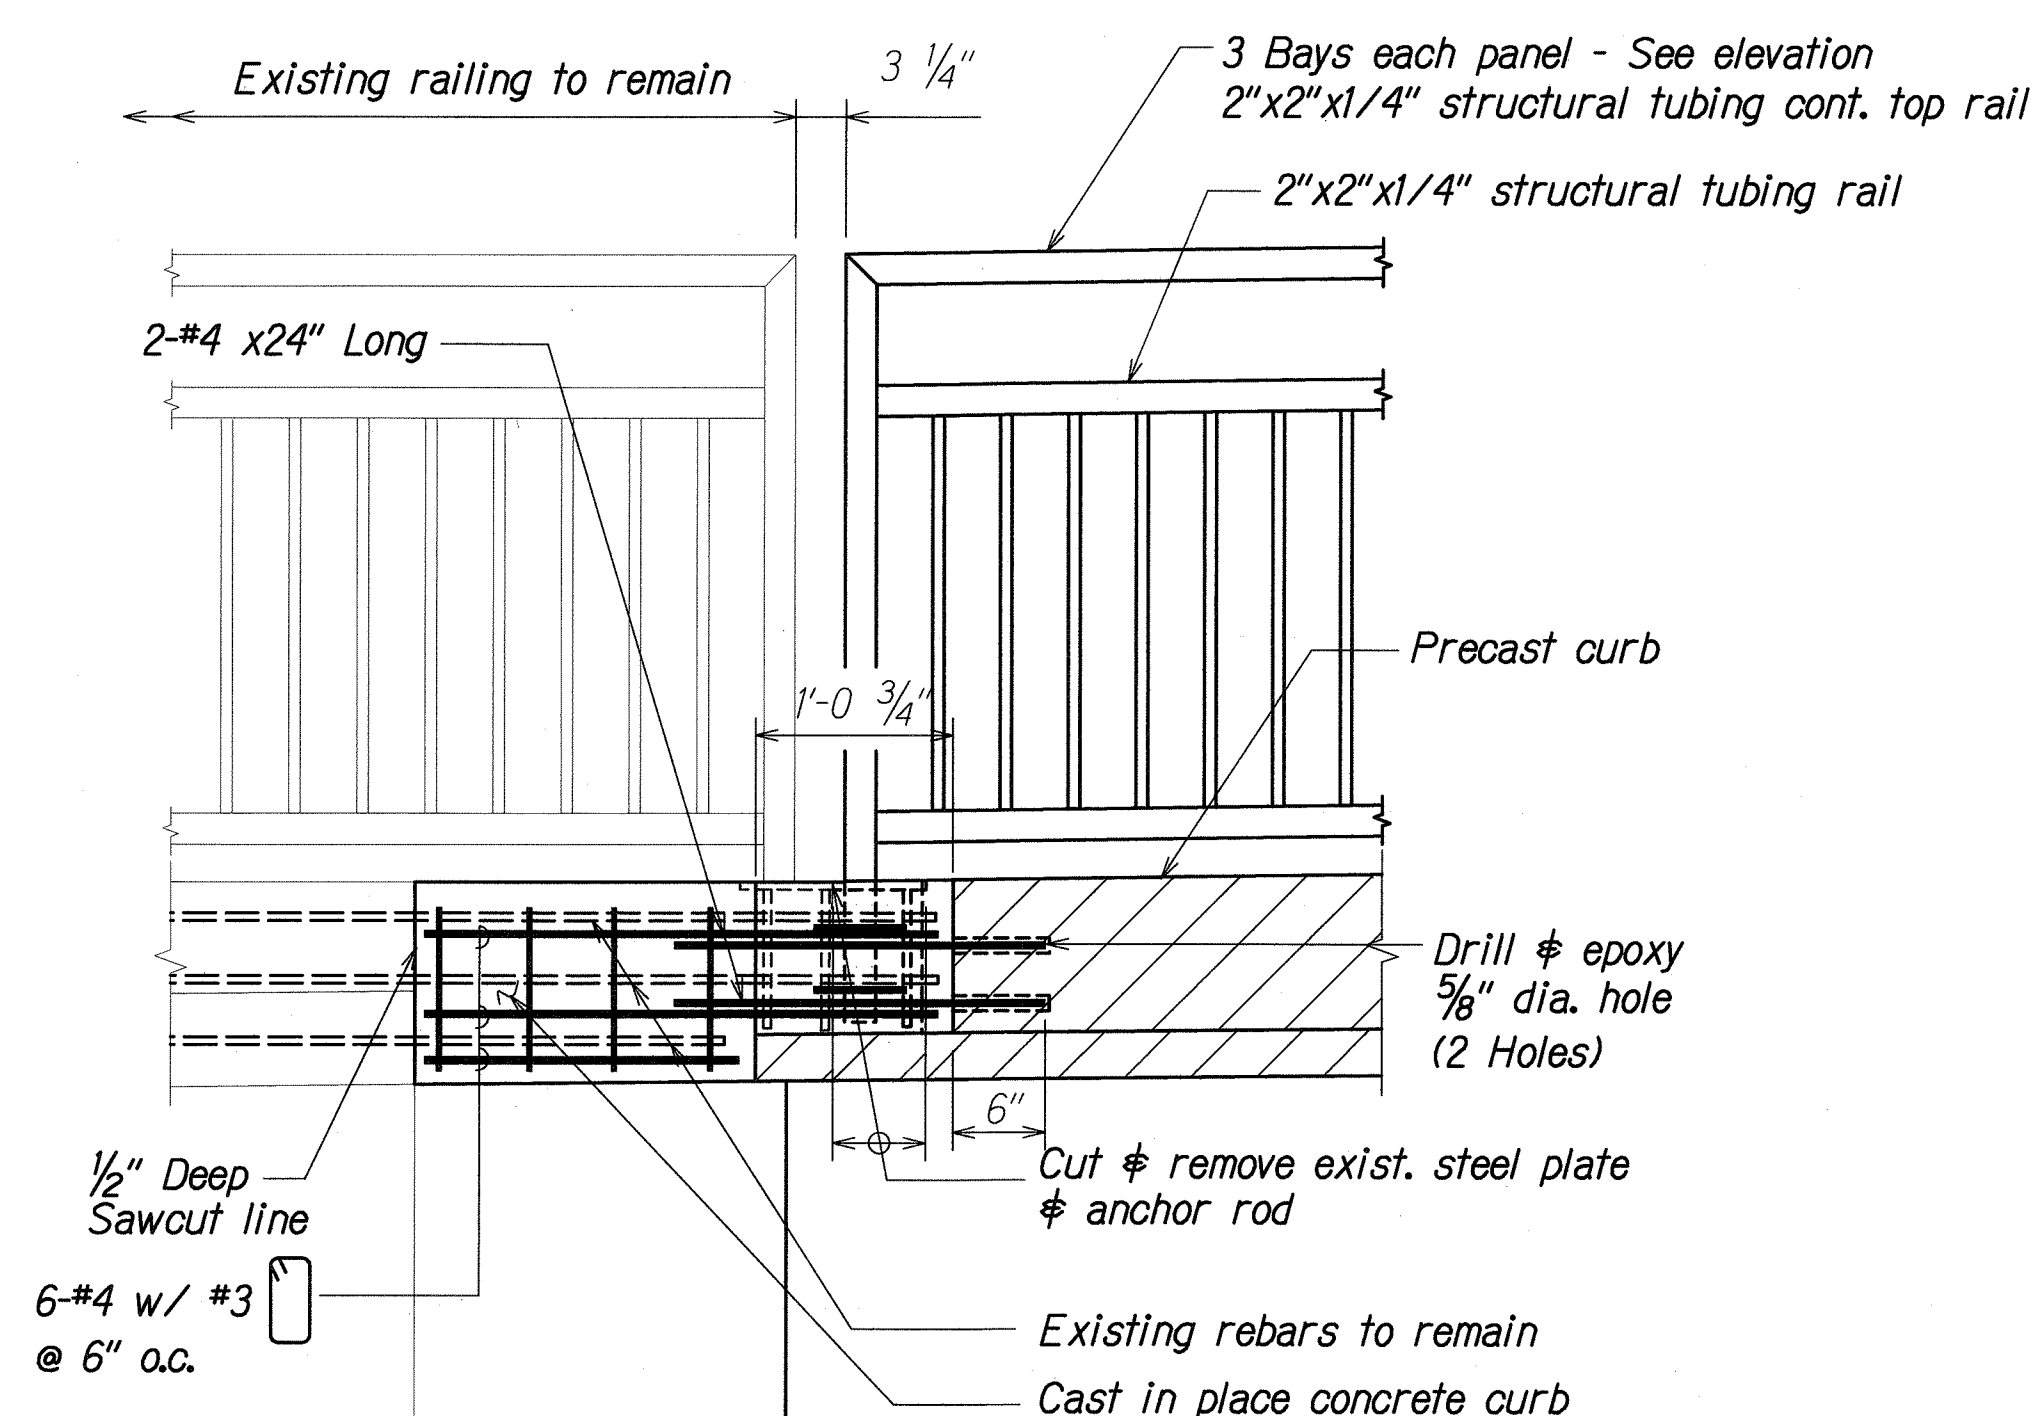


ELEVATION- METAL HANDRAIL

SCALE: 1" = 1'-0"

B
S2J11 S2J14

DESIGNED BY	DATE
TRACED BY	
NOTED BY	
CHECKED BY	
ORIGINAL PLAN	
NOTE BOOK	
N2	

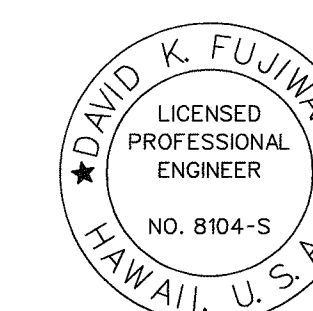

THIS WORK WAS PREPARED BY ME OR UNDER MY SUPERVISION.

SIGNATURE EXPIRATION DATE OF THE LICENSE

STATE OF HAWAII
DEPARTMENT OF TRANSPORTATION
HIGHWAYS DIVISION

RAILING ELEVATION AND SECTION

Repair of Mauka Span of
Mahiko Street Pedestrian Overpass
Project No. HI E-01-07M

Scale: As Shown Date: Nov. 2006

SHEET No. S2J14 OF 16 SHEETS

