



FED. ROAD DIST. NO.	STATE	FED. AID PROJ. NO.	FISCAL YEAR	SHEET NO.	TOTAL SHEETS
HAWAII	HAW.	I-H1-1(136):17	1976	108S-1	124

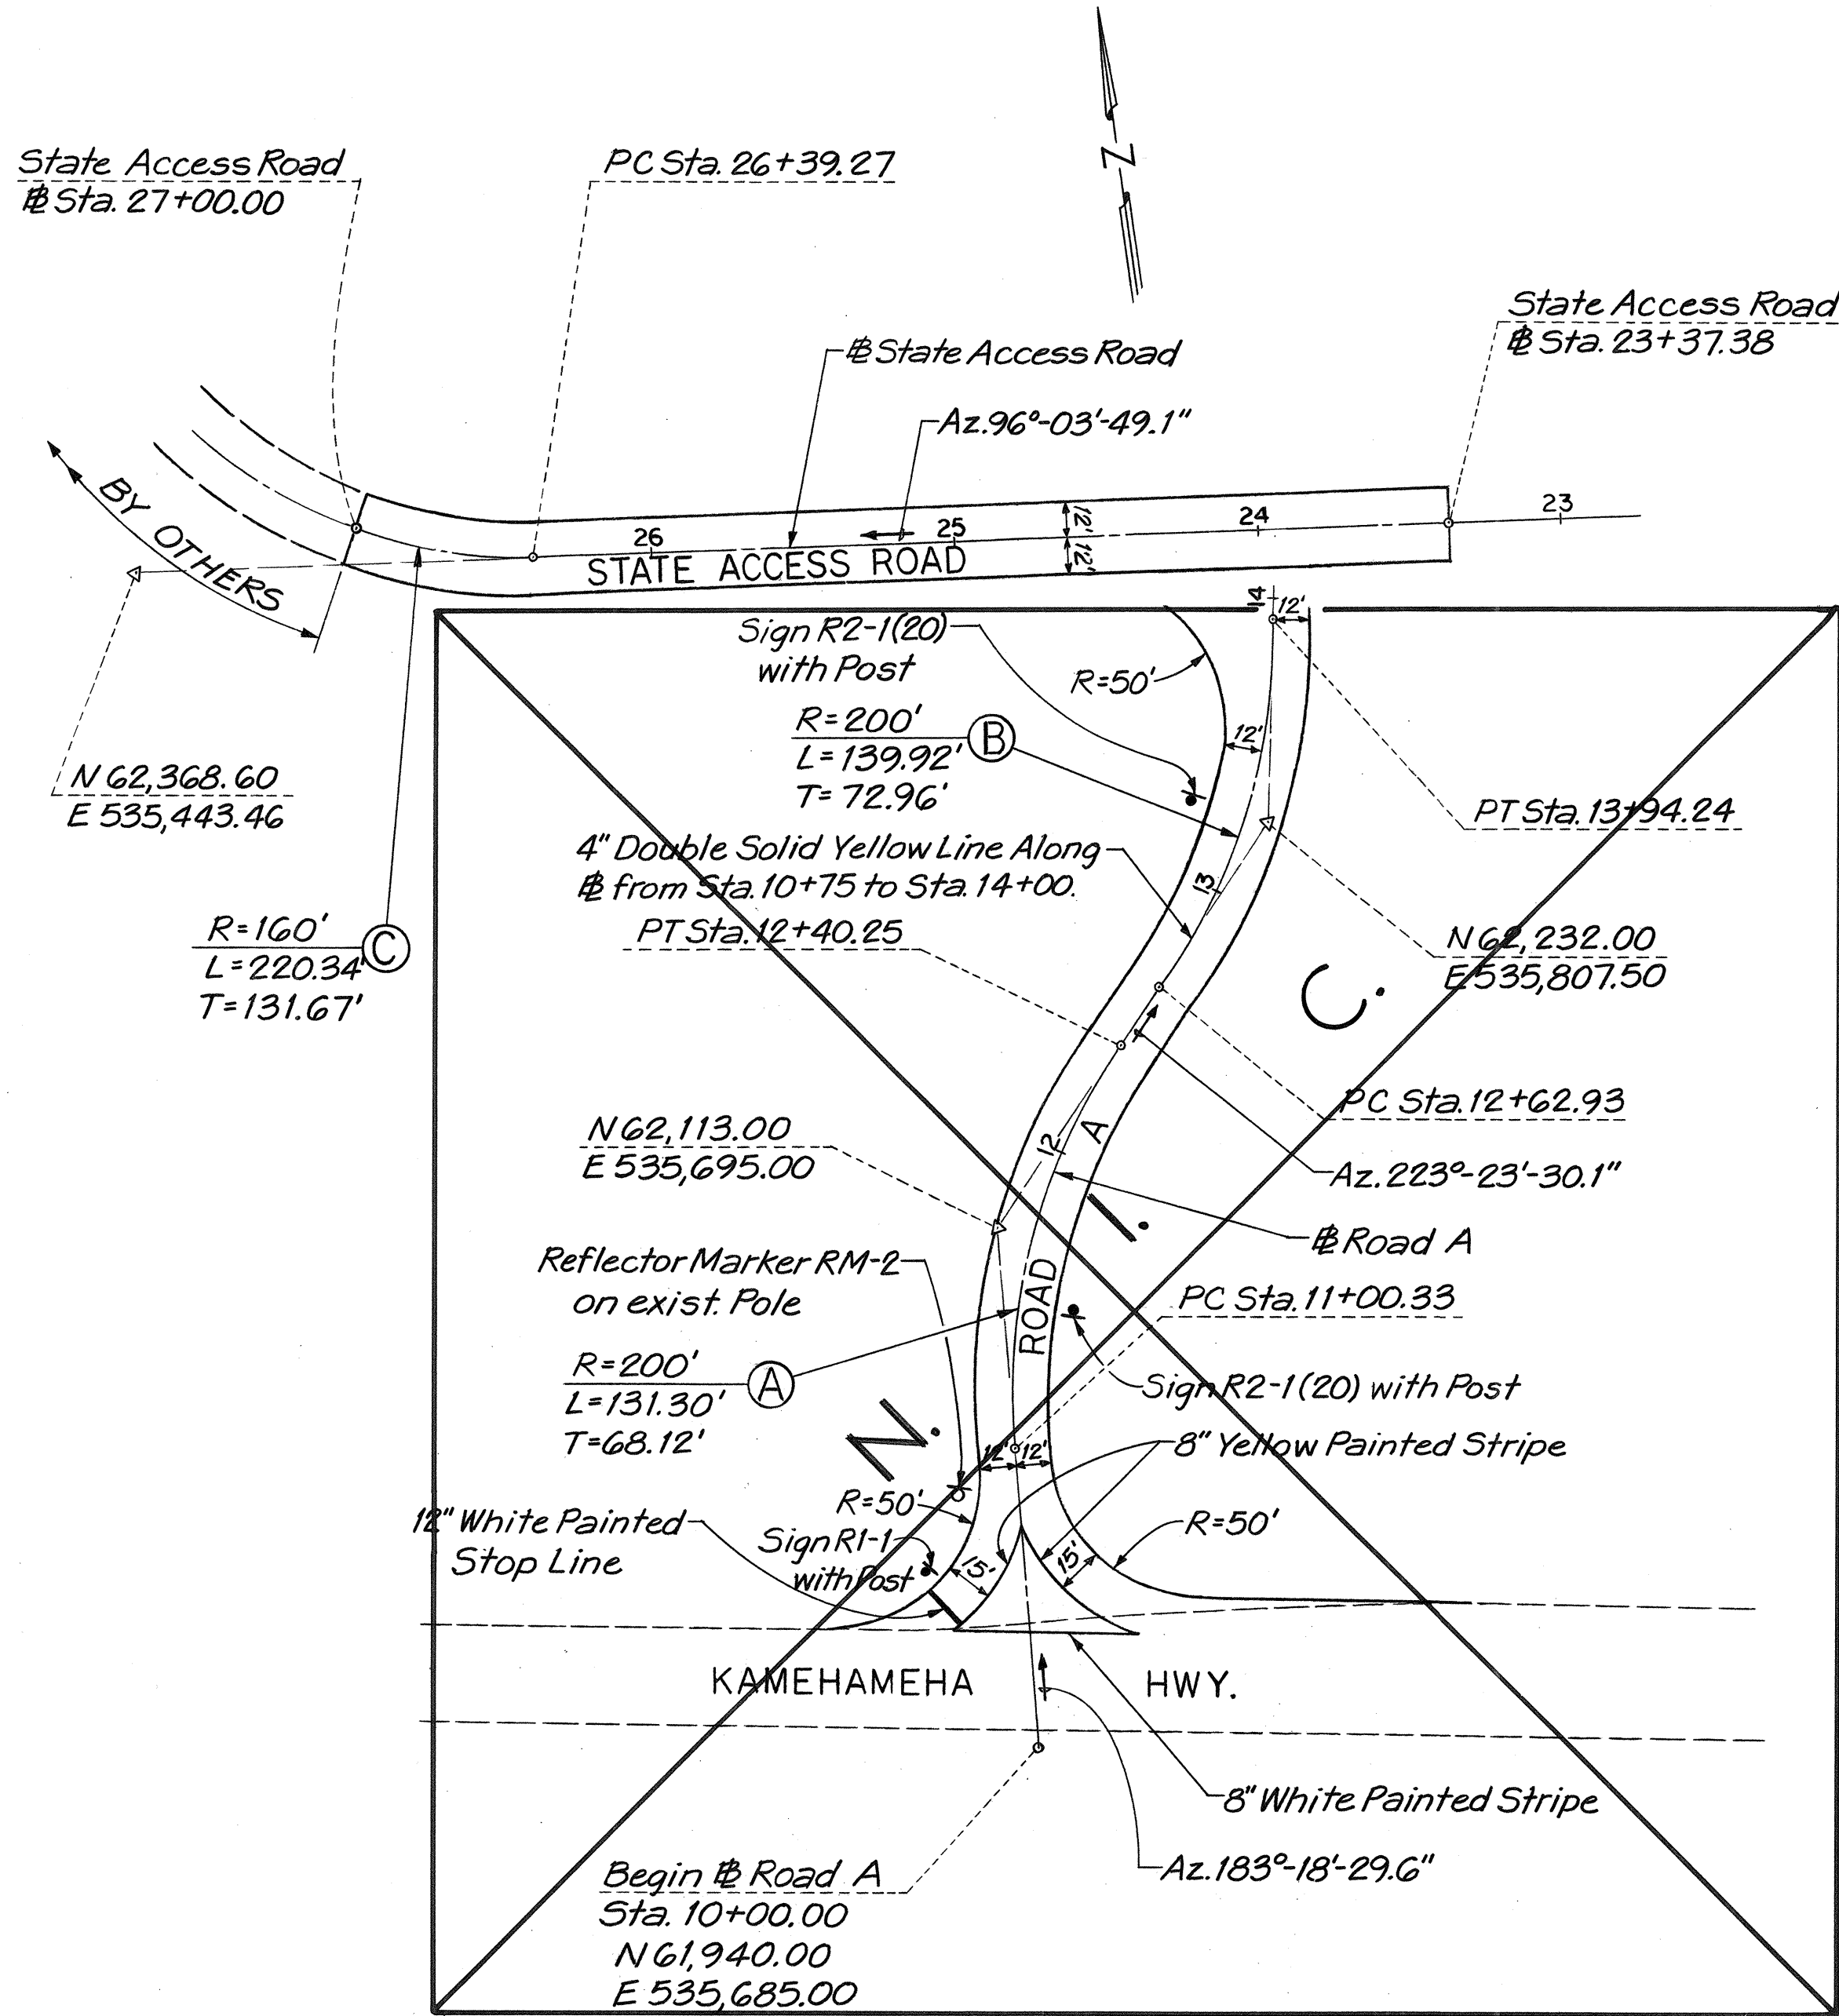


ALIGNMENT - STATE ACCESS ROAD
SCALE: 1"=50'


STA.	ELEV. (D)	ELEV. (E)	ELEV. (F)	ELEV. (G)
23+37.38	10.67	10.34	10.52	10.34
+50	10.61	10.28	10.46	10.28
+75	10.48	10.15	10.33	10.15
24+00	10.36	10.03	10.21	10.03
+25	10.23	9.90	10.08	9.90
+50	10.11	9.78	9.96	9.78
+75	9.98	9.65	9.83	9.65
25+00	9.86	9.53	9.71	9.53
+25	9.73	9.40	9.58	9.40
+50	9.61	9.28	9.46	9.28
+75	9.48	9.15	9.33	9.15
26+00	—	9.03	9.21	9.03
+25	—	8.90	9.08	8.90
+50	—	8.81	8.97	8.81
+75	—	8.82	8.94	8.82
27+00	—	8.91	9.03	8.91

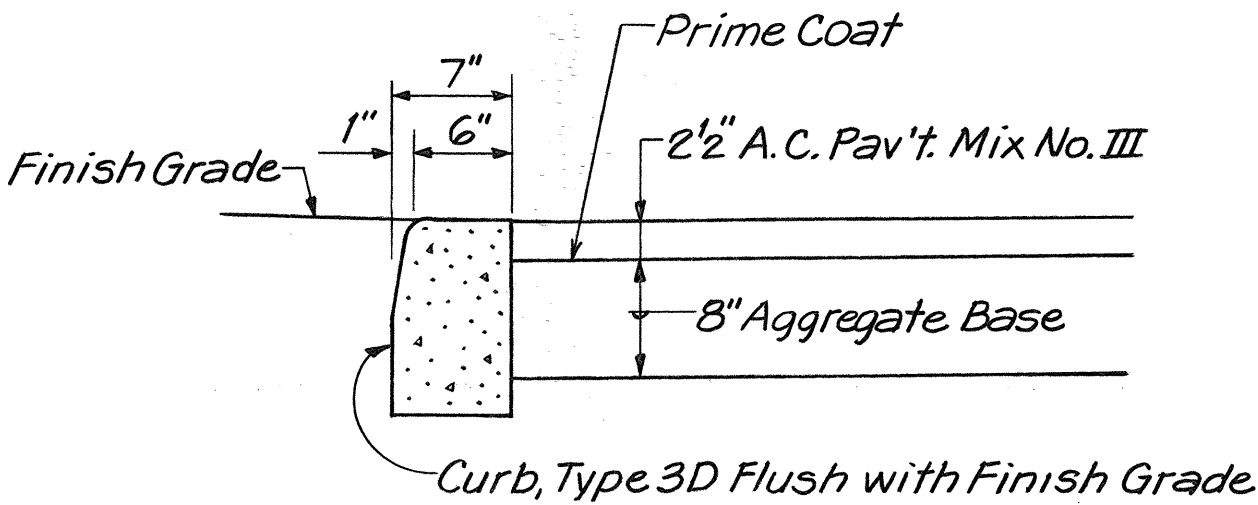


TYPICAL PAVEMENT SECTION-STATE ACCESS ROAD
NOT TO SCALE

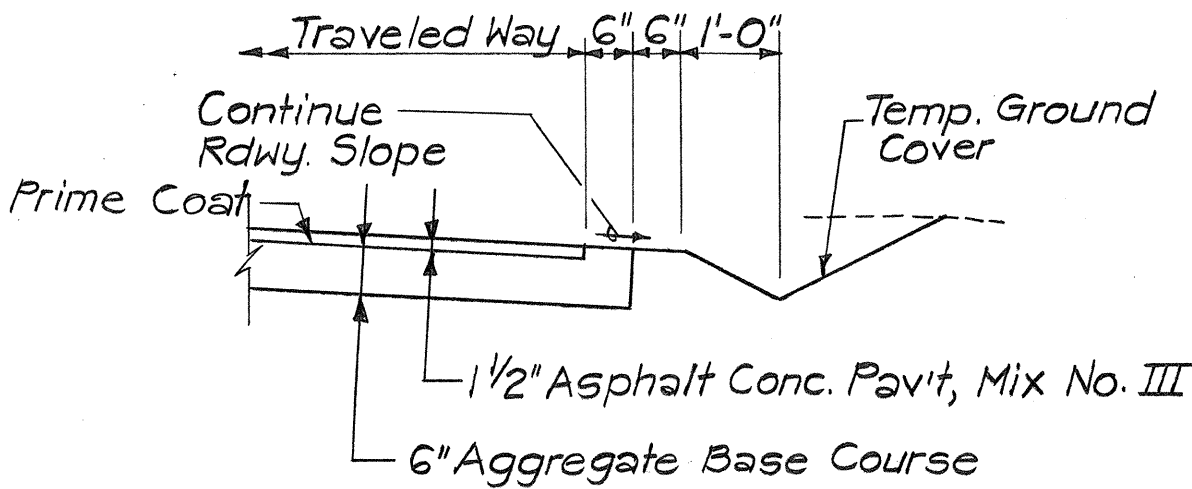


GRASSED SWALE - ROAD 'B'
SCALE: 1/2"=1'-0"

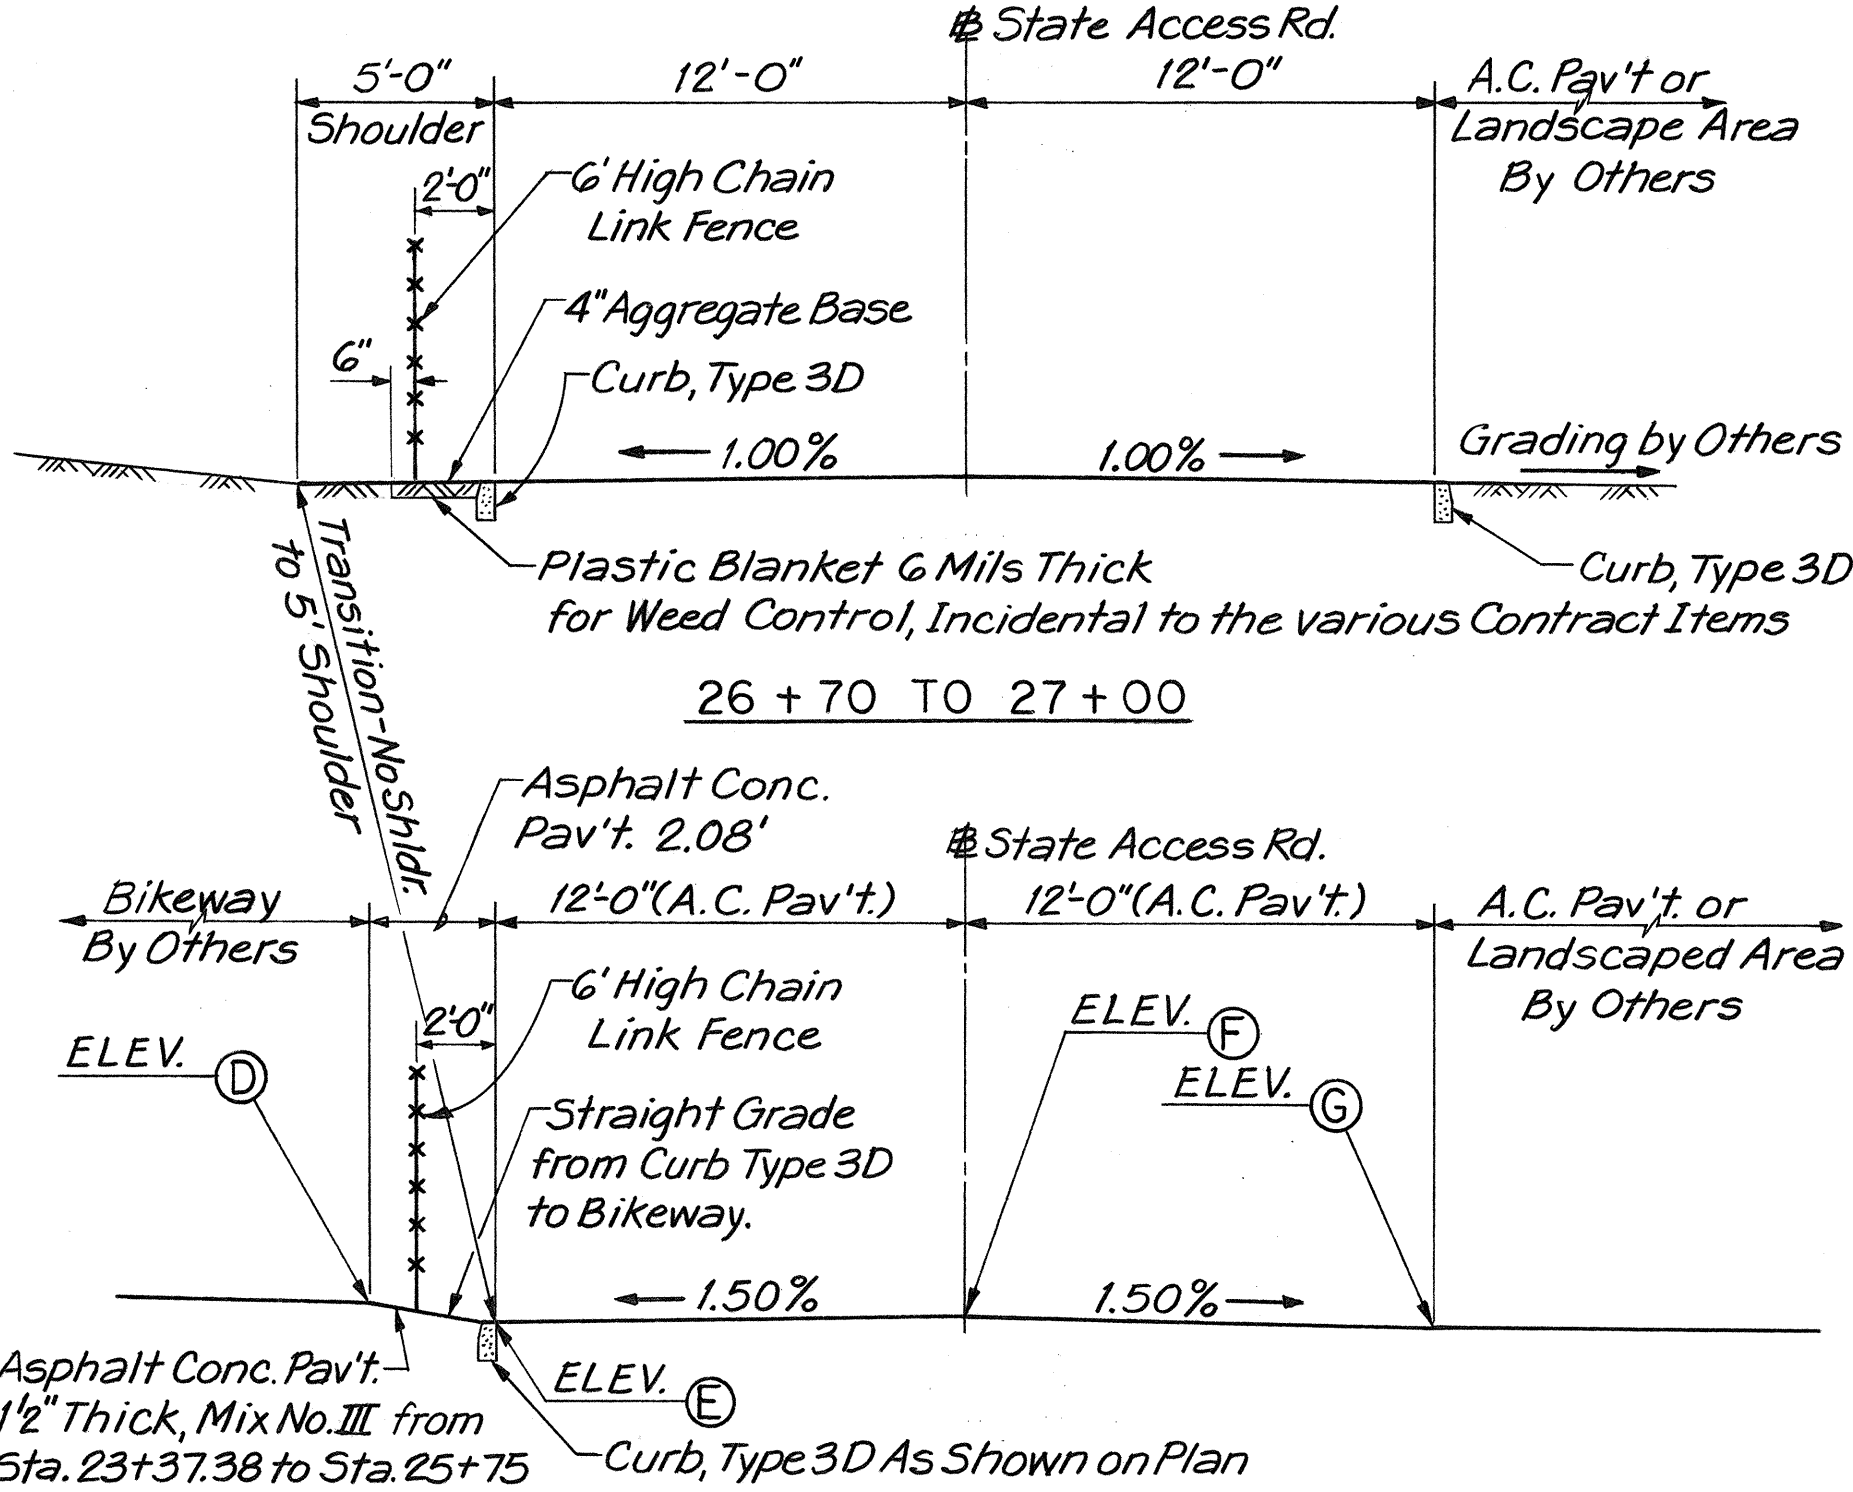

TYPICAL SECTIONS-STATE ACCESS ROAD
SCALE: 1"=5'

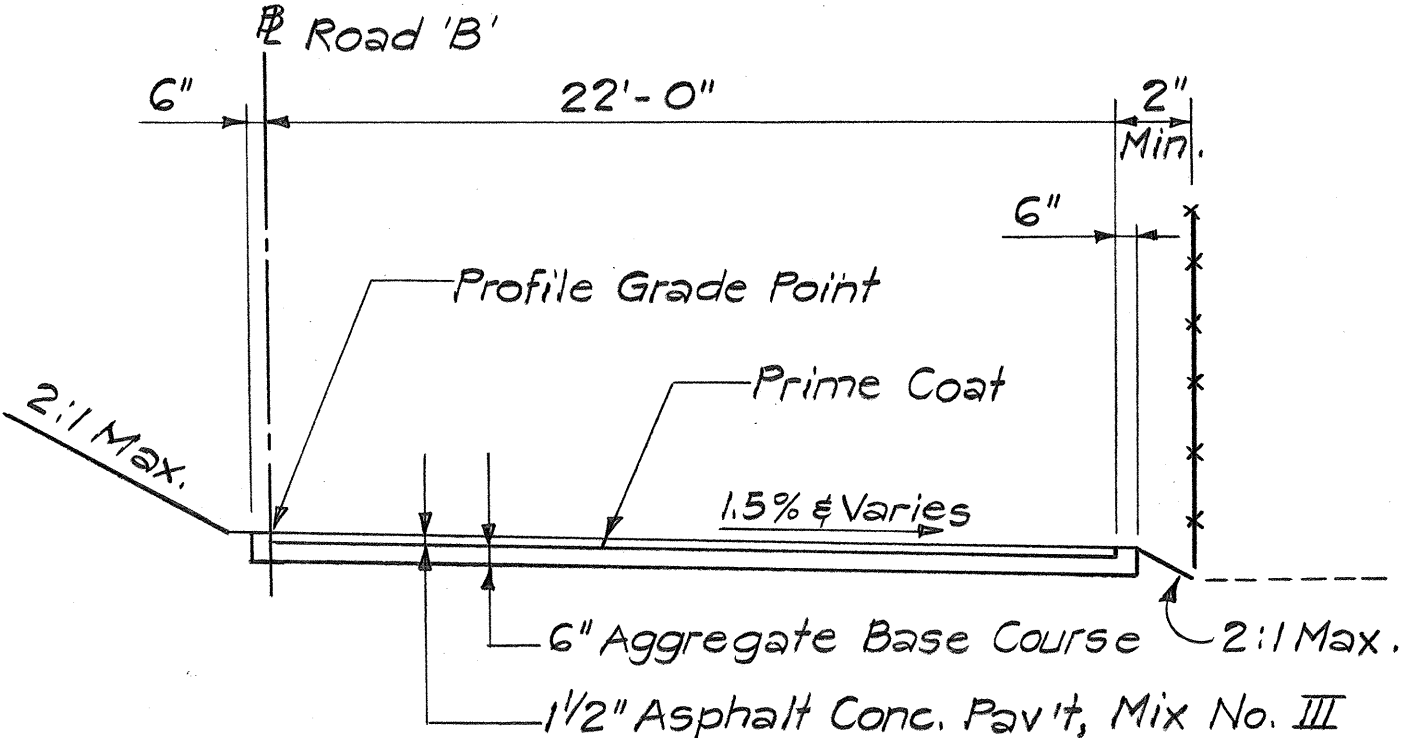

TYPICAL SECTION - ROAD 'B'
SCALE: 1"=5'

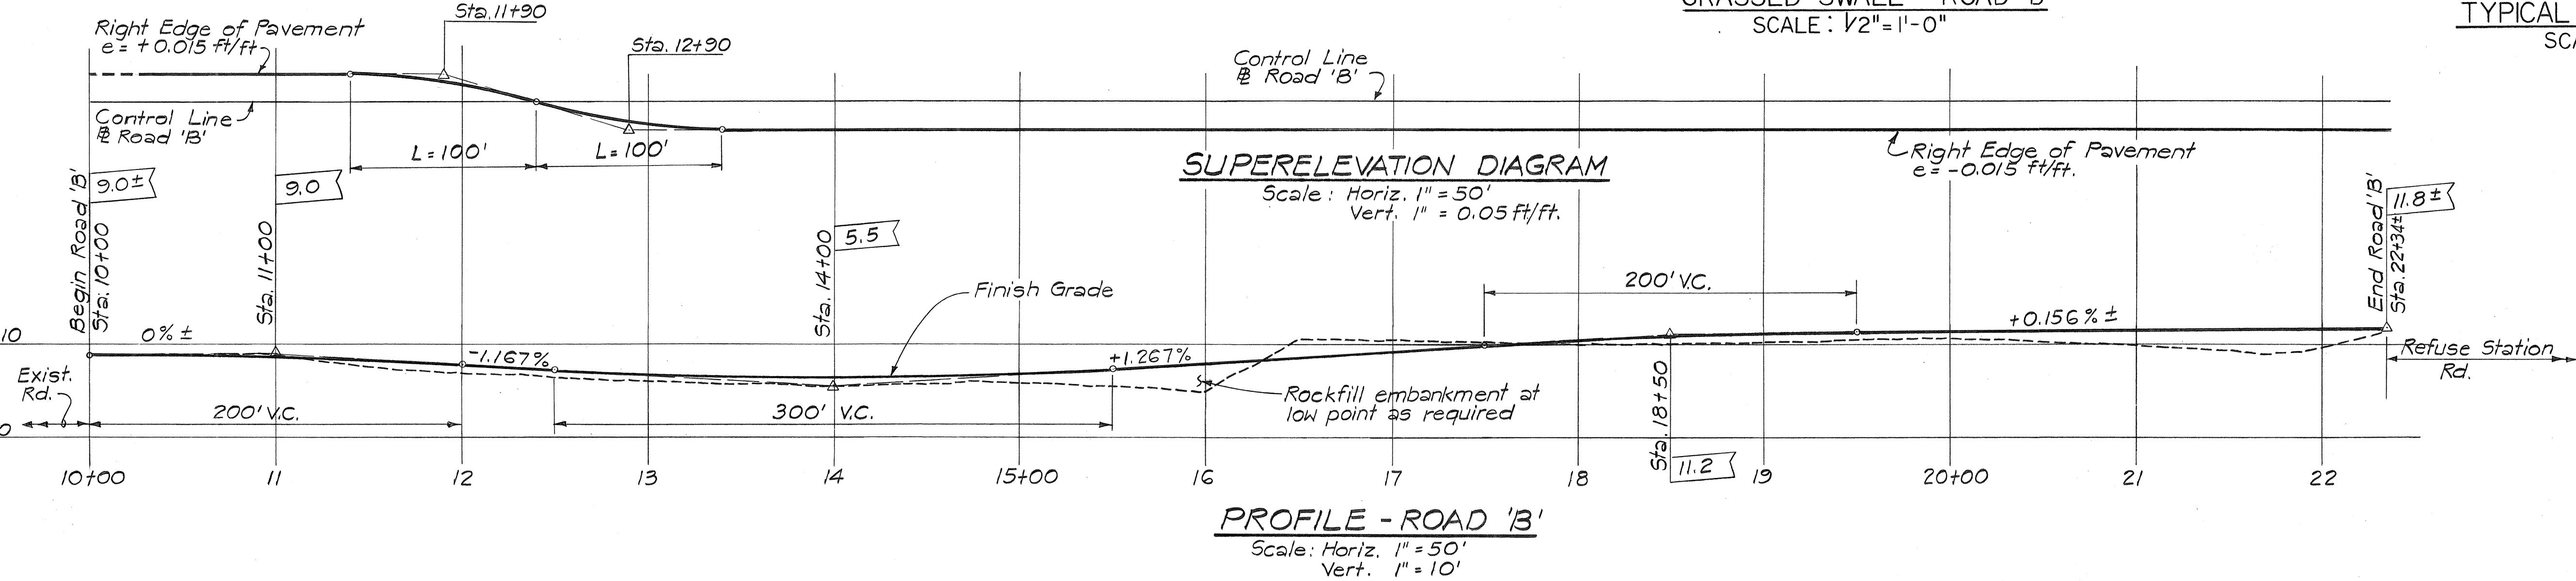

SUPERELEVATION DIAGRAM

Scale: Horiz. 1"=50'
Vert. 1"=10'

PROFILE - ROAD 'B'

Scale: Horiz. 1"=50'
Vert. 1"=10'

7/22/77	Added Road 'B' Typical Section, Profile, Superelevation Diagram and Grassed Swale. Omitted Road 'A'.
6/14/77	Sheet added to Contract Plan Set for additional details required on Sheet No. C.O. 108.

DATE REVISION

STATE OF HAWAII
DEPARTMENT OF TRANSPORTATION
HIGHWAYS DIVISION

ALIGNMENT & DETAILS FOR
ROAD B & STATE ACCESS ROAD

INTERSTATE ROUTE H-1
PROJECT NO. I-H1-1 (136):17

SCALE: AS SHOWN DATE: 6/14/77
SHEET No. 1A OF 1 SHEETS