




ORIGINAL PLAN	SURVEY PLOTTED BY _____ DATE _____	
	DRAWN BY _____	
	TRACED BY _____	
	DESIGNED BY _____	
	QUANTITIES BY _____	
NOTE BOOK	CHECKED BY _____	
	No. _____	

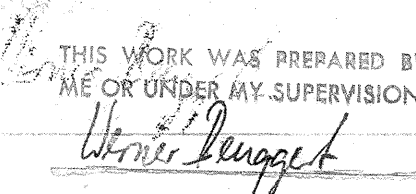

FED. ROAD DIST. NO.	STATE	FED. AID PROJ. NO.	FISCAL YEAR	SHEET NO.	TOTAL SHEETS
HAWAII	HAW.	HH(136)17	1976	38	124

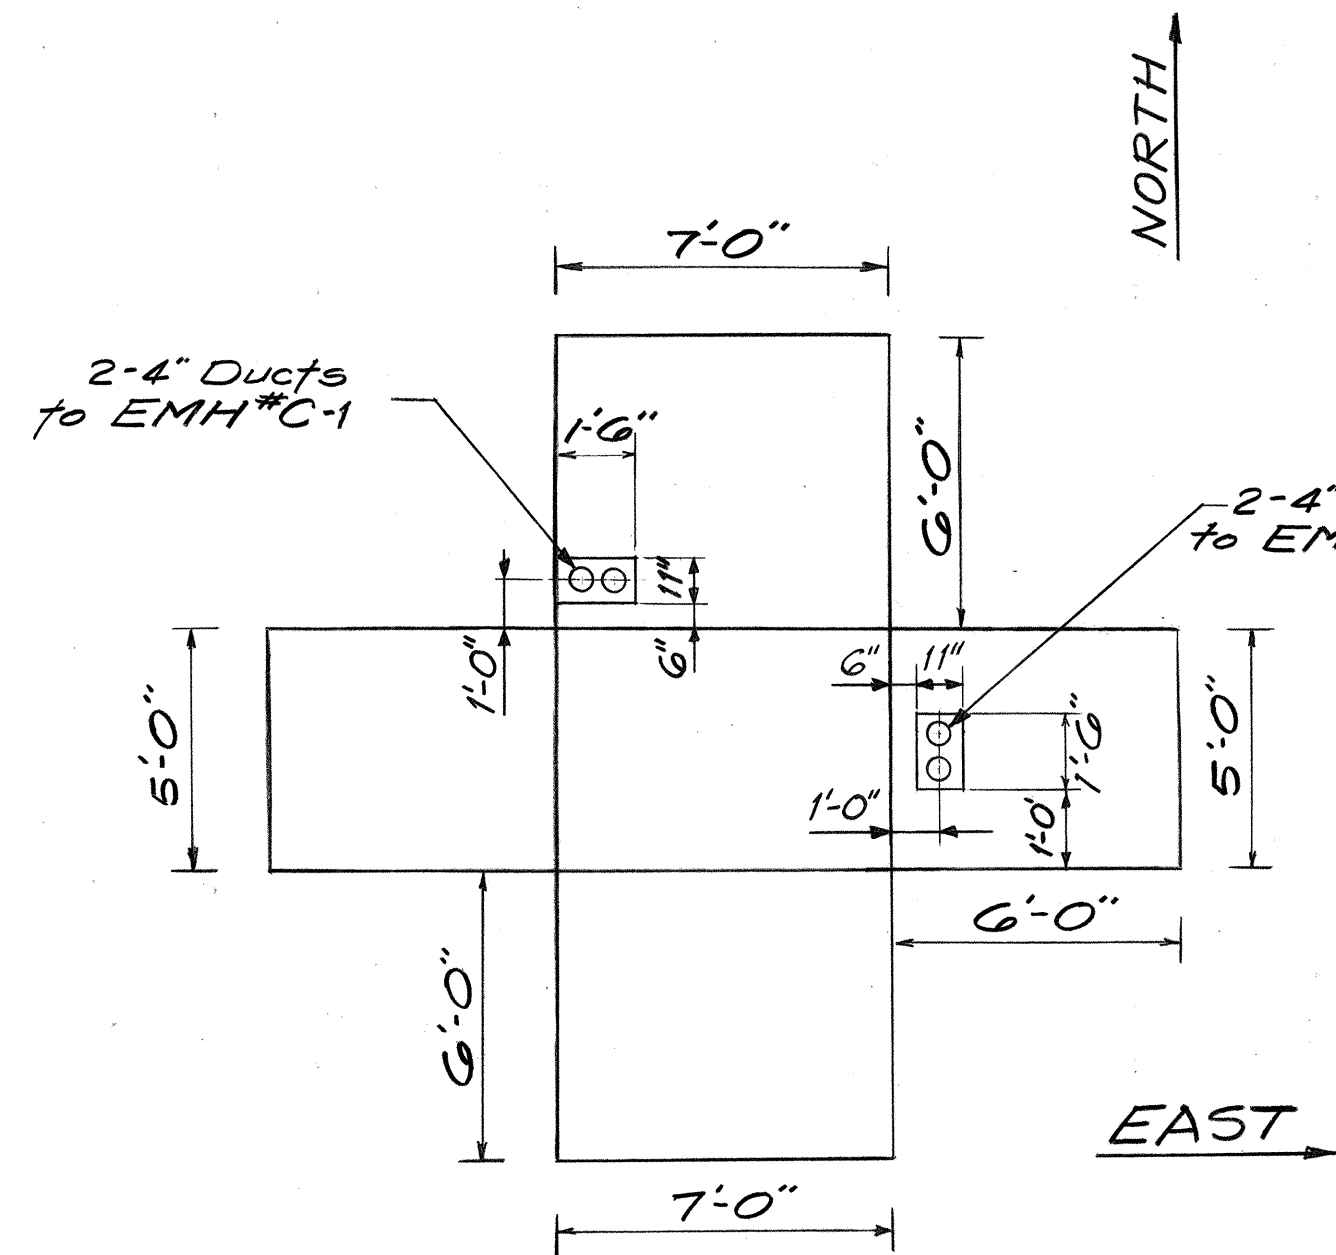


EMH#C-2, TYPE 57M
(#995-A)

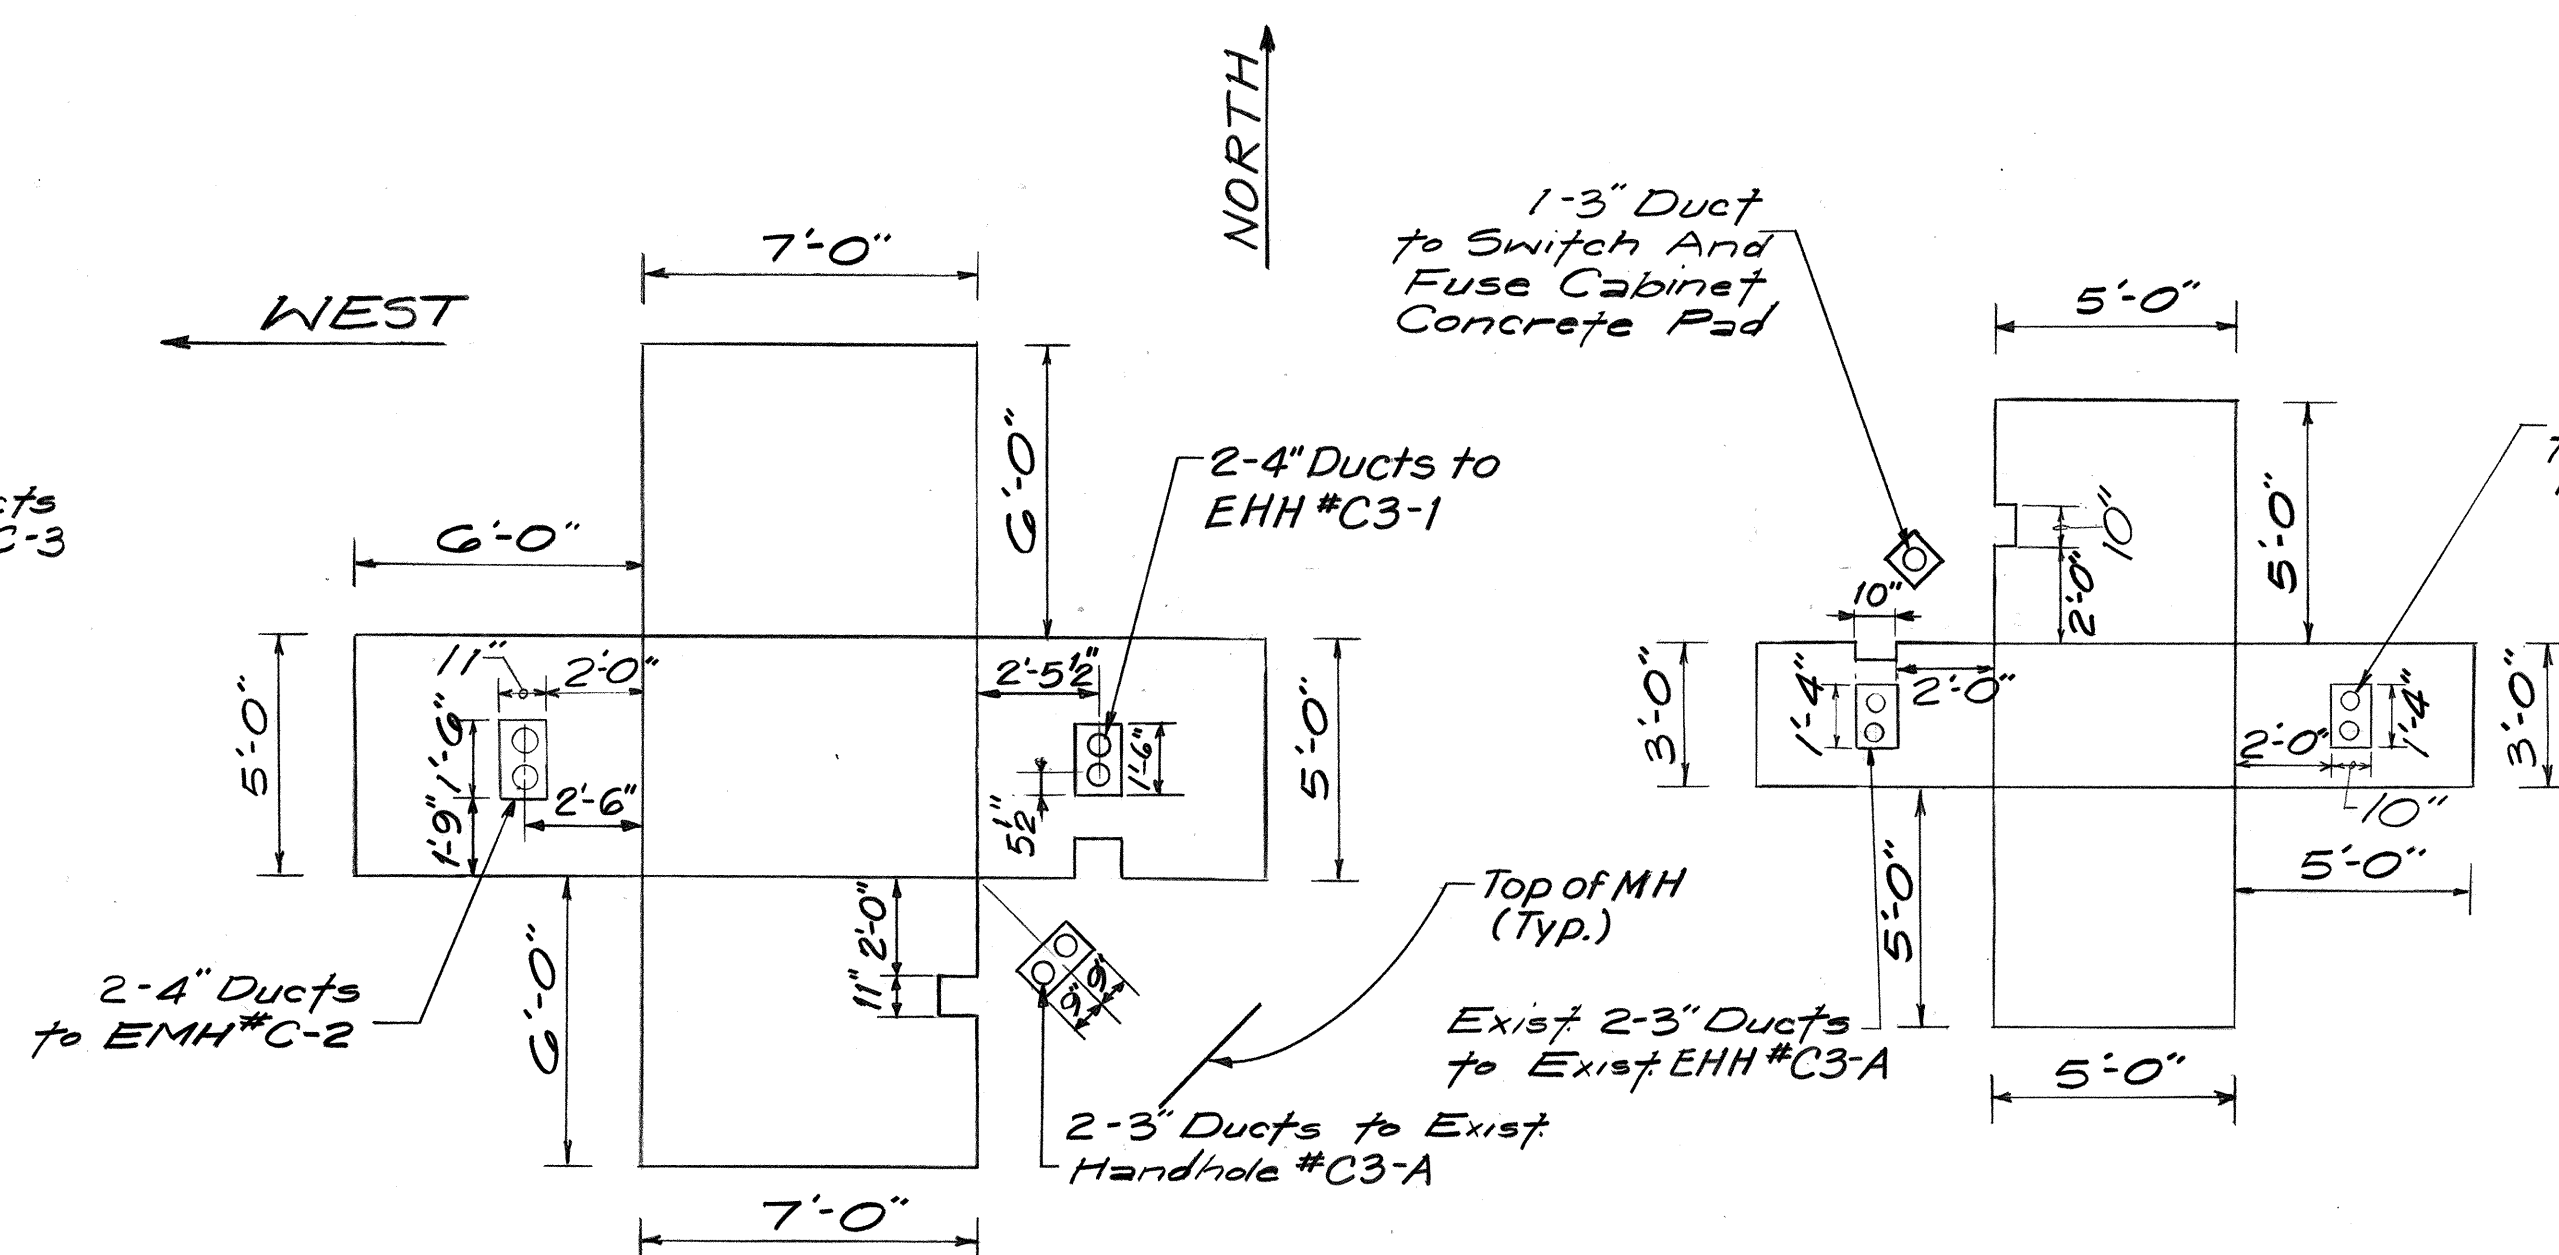


EMH#C-3, TYPE 57M
(#995-B)


EHH#C3-B TYPE 35

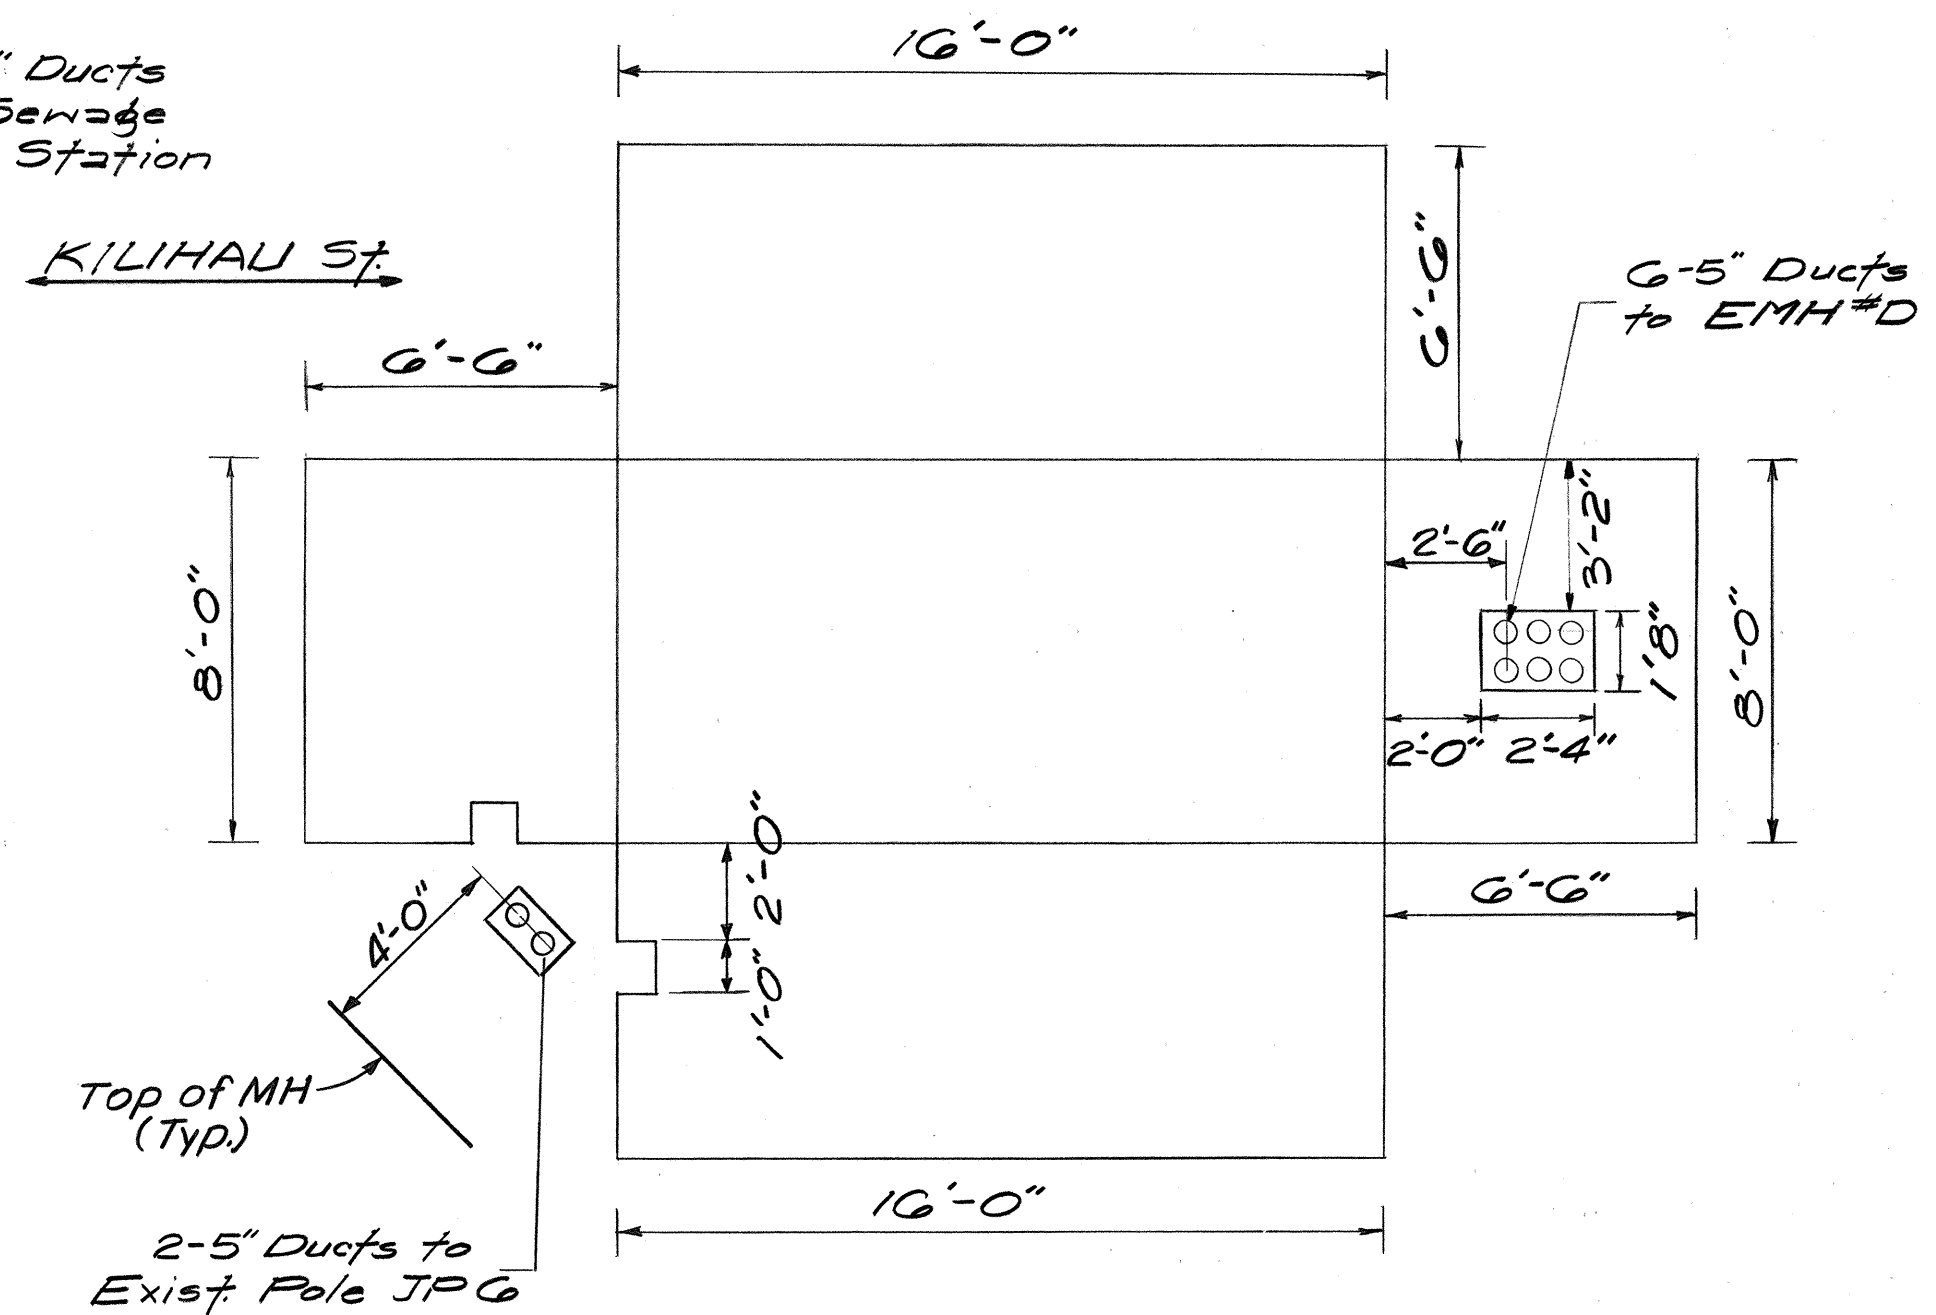


EMH#C, TYPE G
(#996)

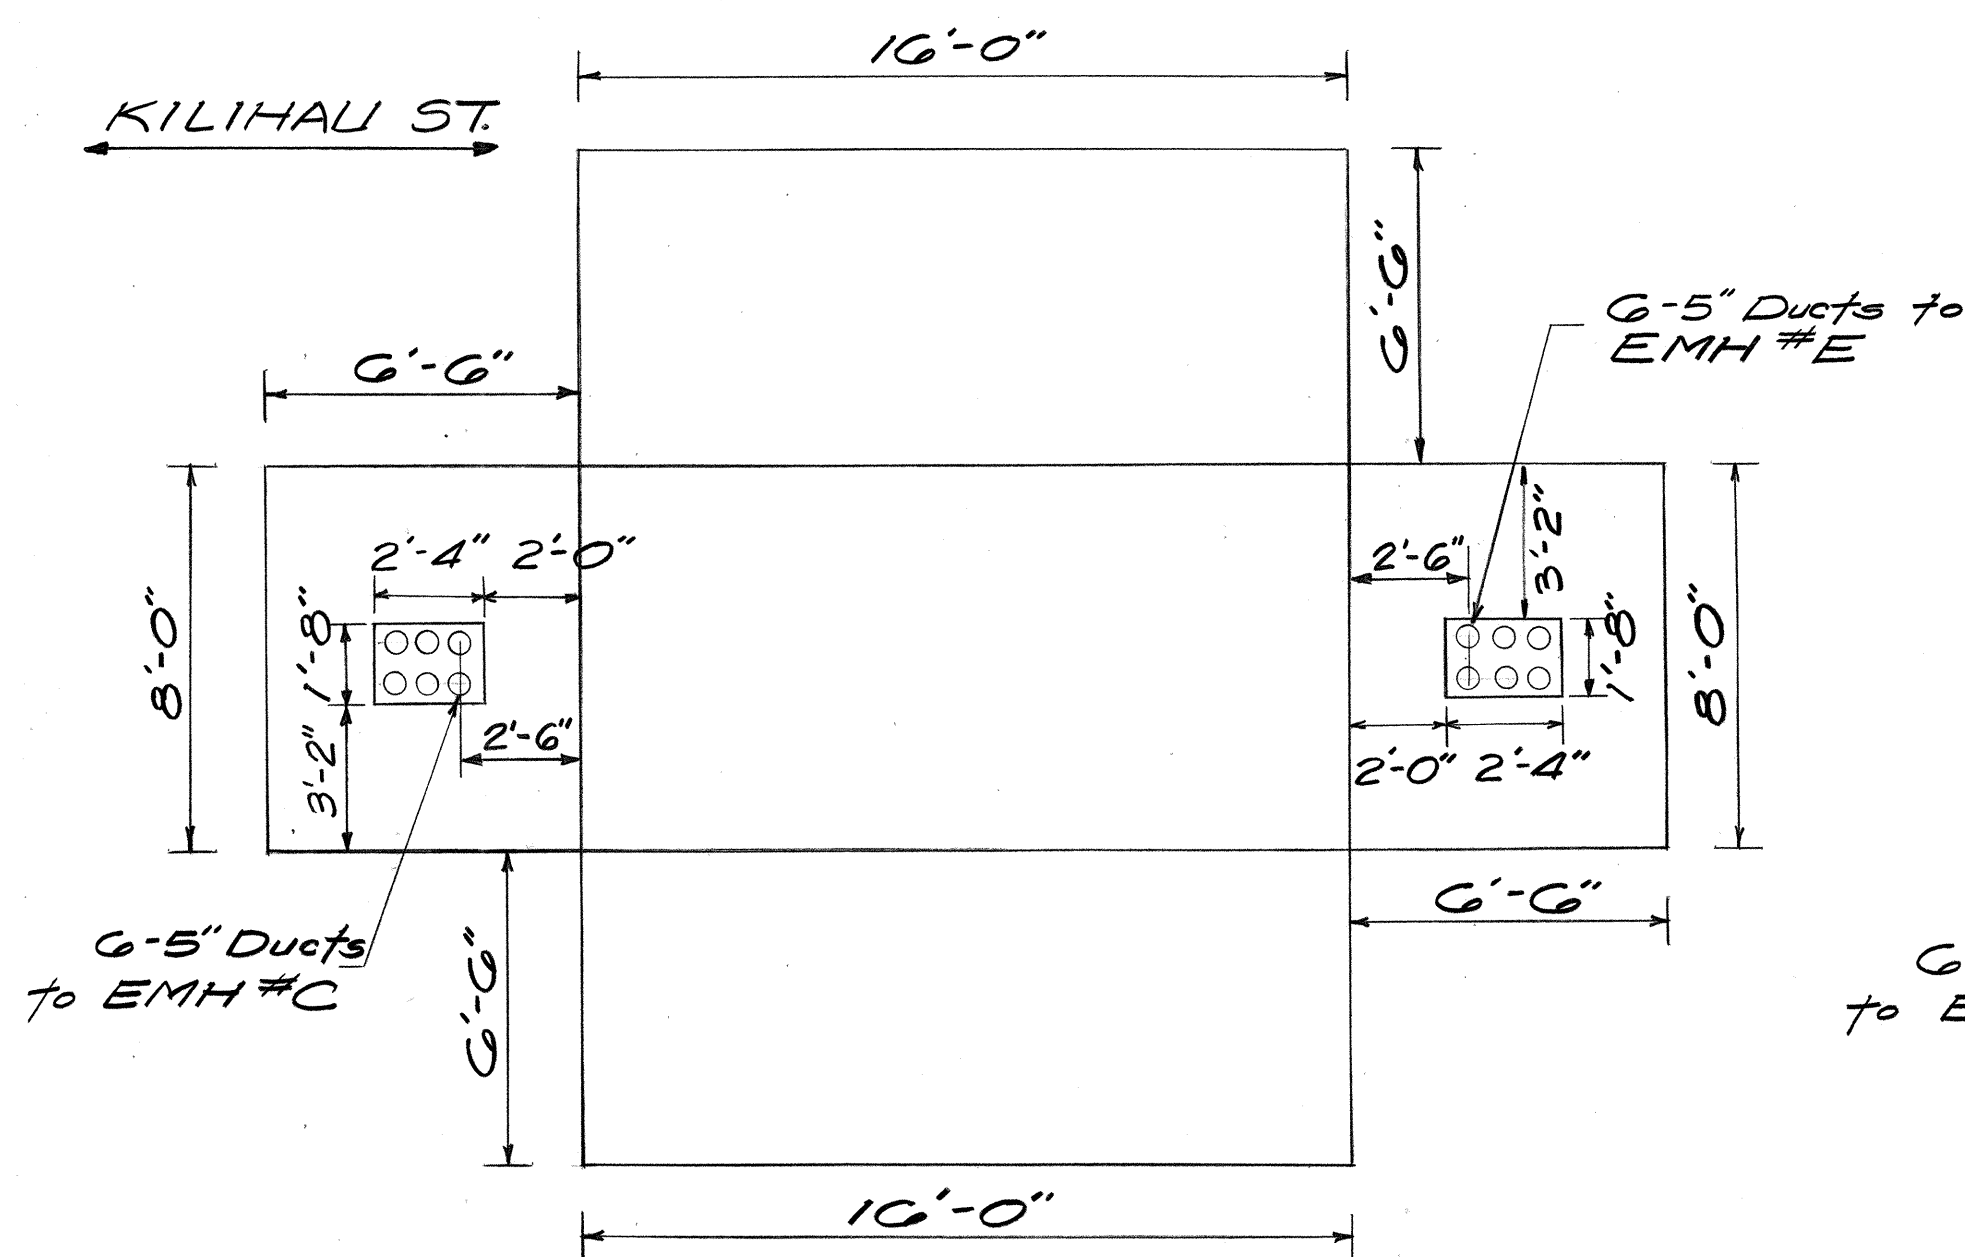


EMH#D, TYPE G
(#996-A)

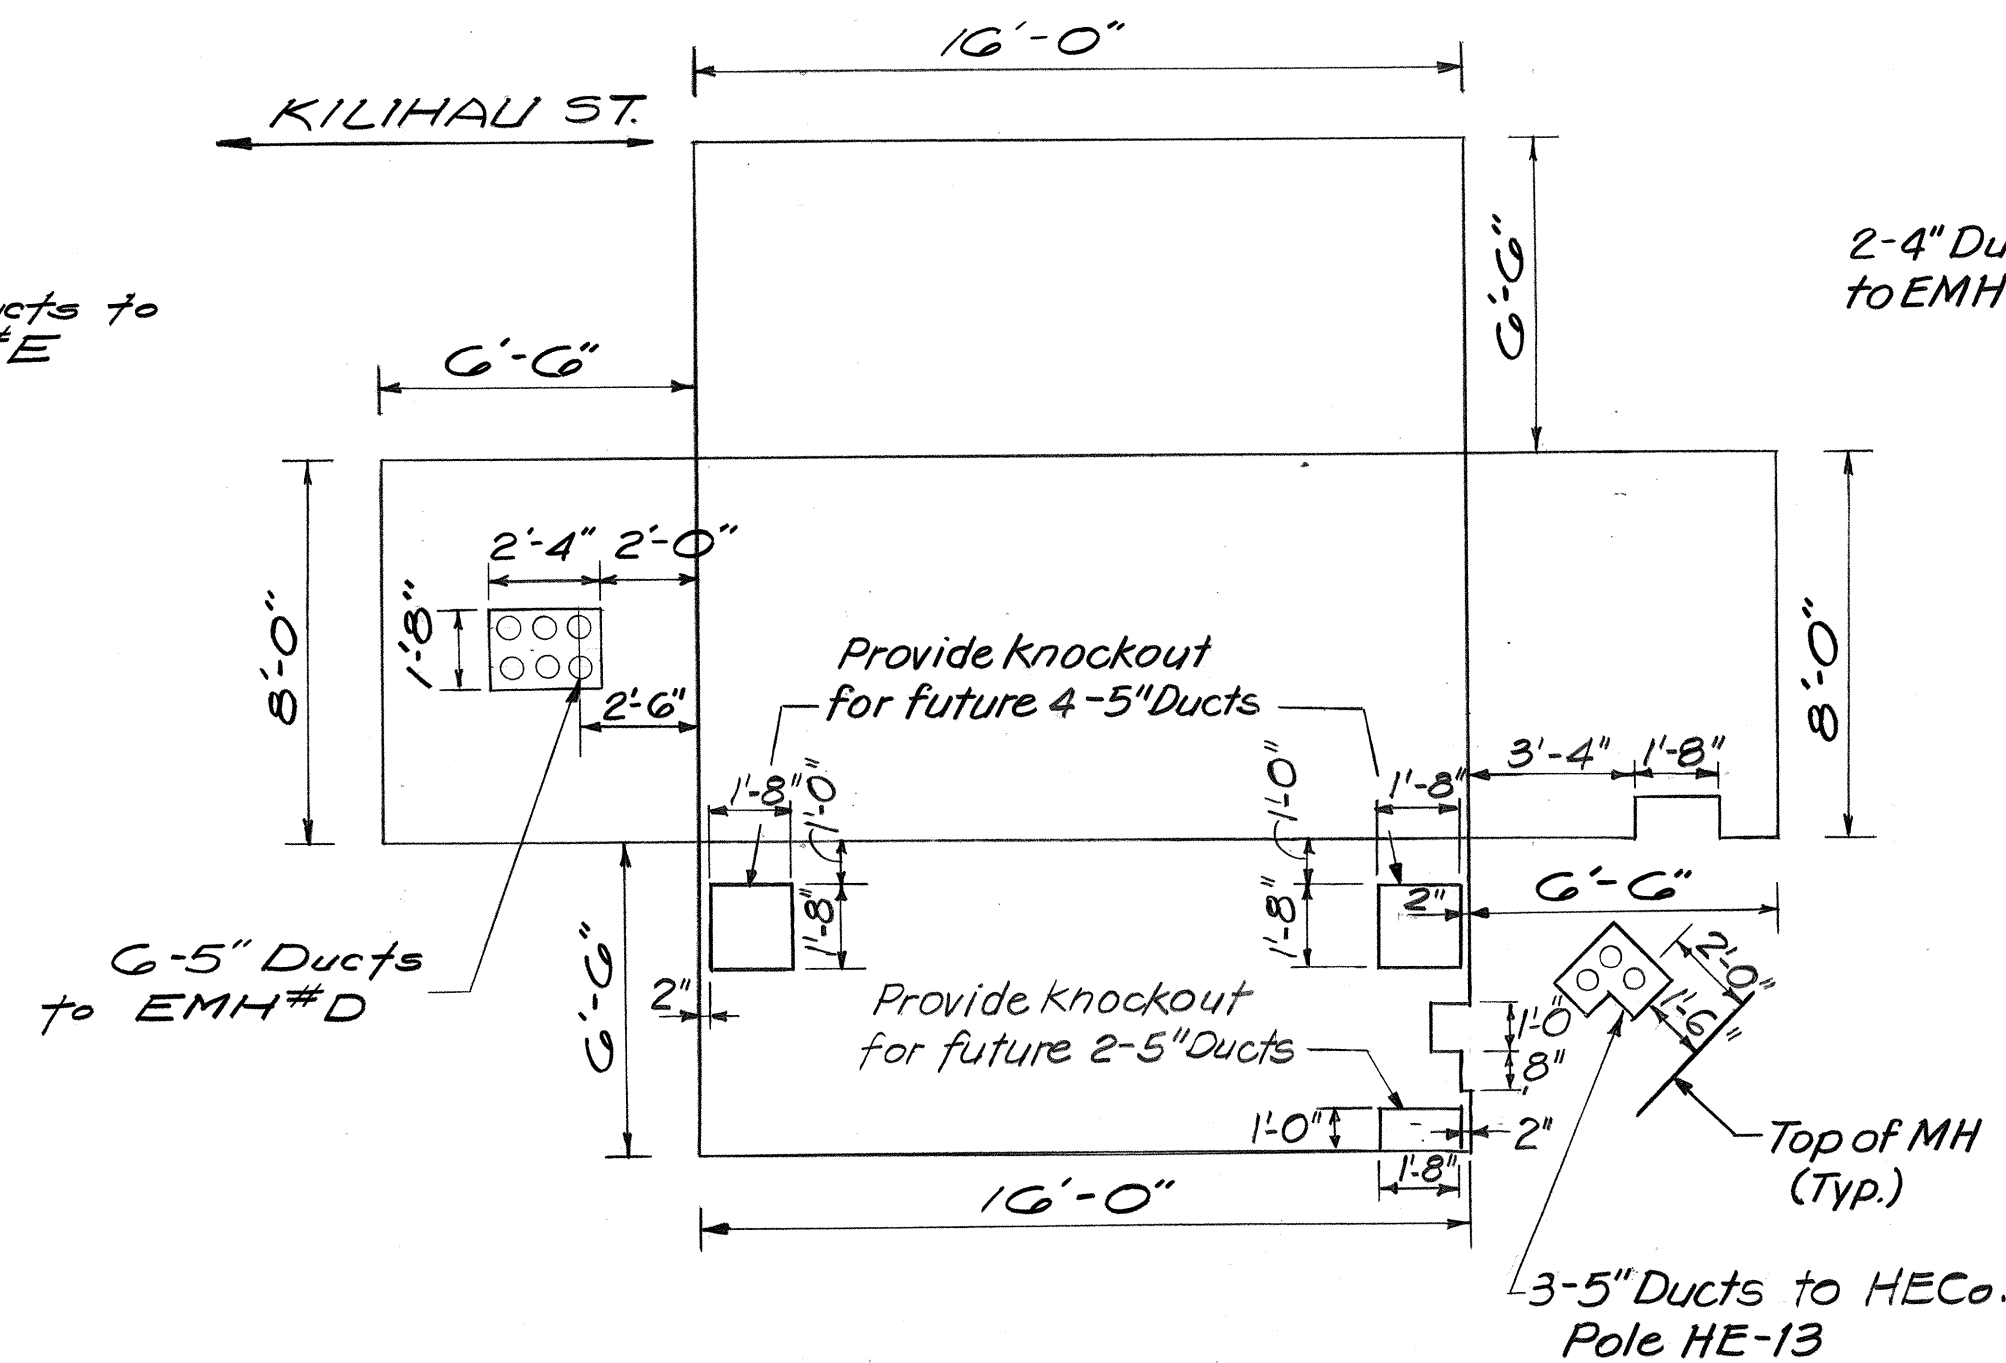


EMH#E, TYPE G
(#996-B)

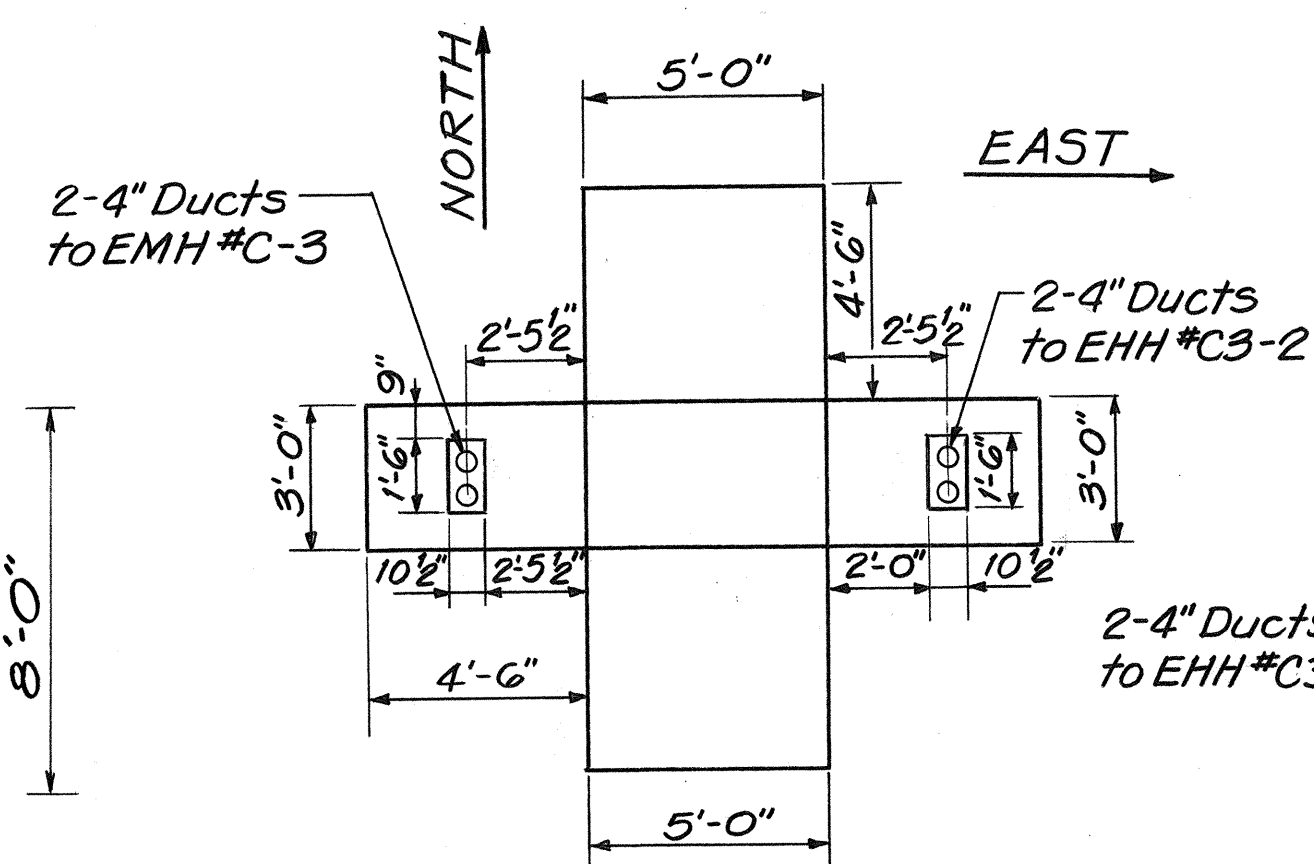

EHH#C3-1, TYPE 35

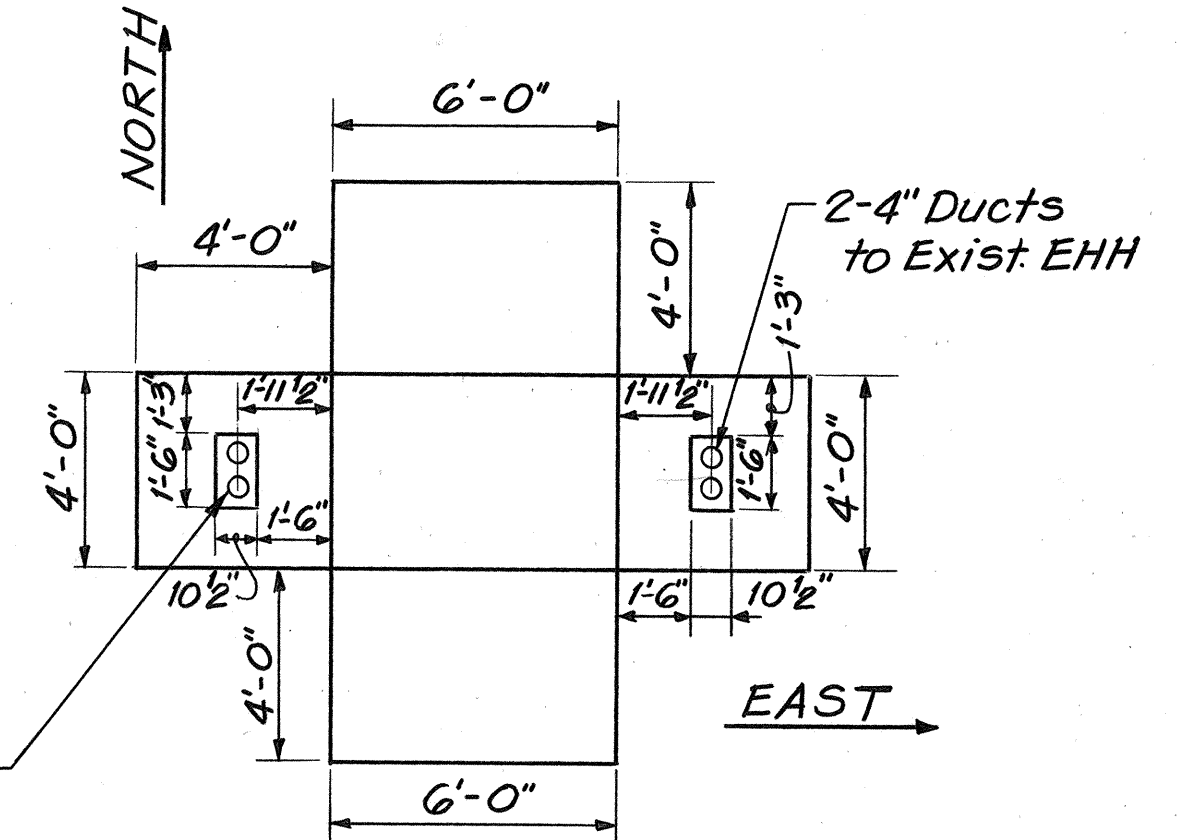

EHH#C3-2, TYPE 46

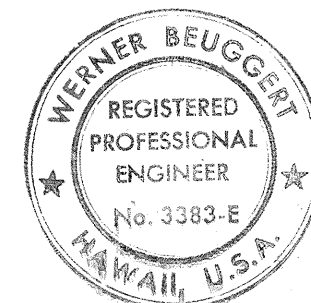




APPROVED:

I. Karamots
Hawaiian Electric Co., Inc.

THIS WORK WAS PREPARED BY ME OR UNDER MY SUPERVISION.
Werner Beugnot
Date 7/27/76

2/17/77	Revised EMH#E Ducts Entrances
DATE	REVISION
STATE OF HAWAII DEPARTMENT OF TRANSPORTATION HIGHWAYS DIVISION	
MANHOLE WALL ELEVATIONS-ELECTRIC	
INTERSTATE ROUTE H-1 PROJECT NO. I-H1-1(136)17	
SCALE: 1/4" = 1'-0"	DATE: July 15, 1976
SHEET NO. 2 OF 3 SHEETS	

FED. ROAD DIST. NO.	STATE	FED. AID PROJ. NO.	FISCAL YEAR	SHEET NO.	TOTAL SHEETS
HAWAII	HAW.	HI-1(13Q):17	1976	39	124

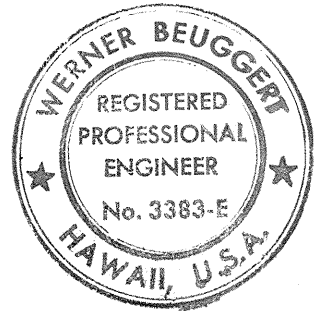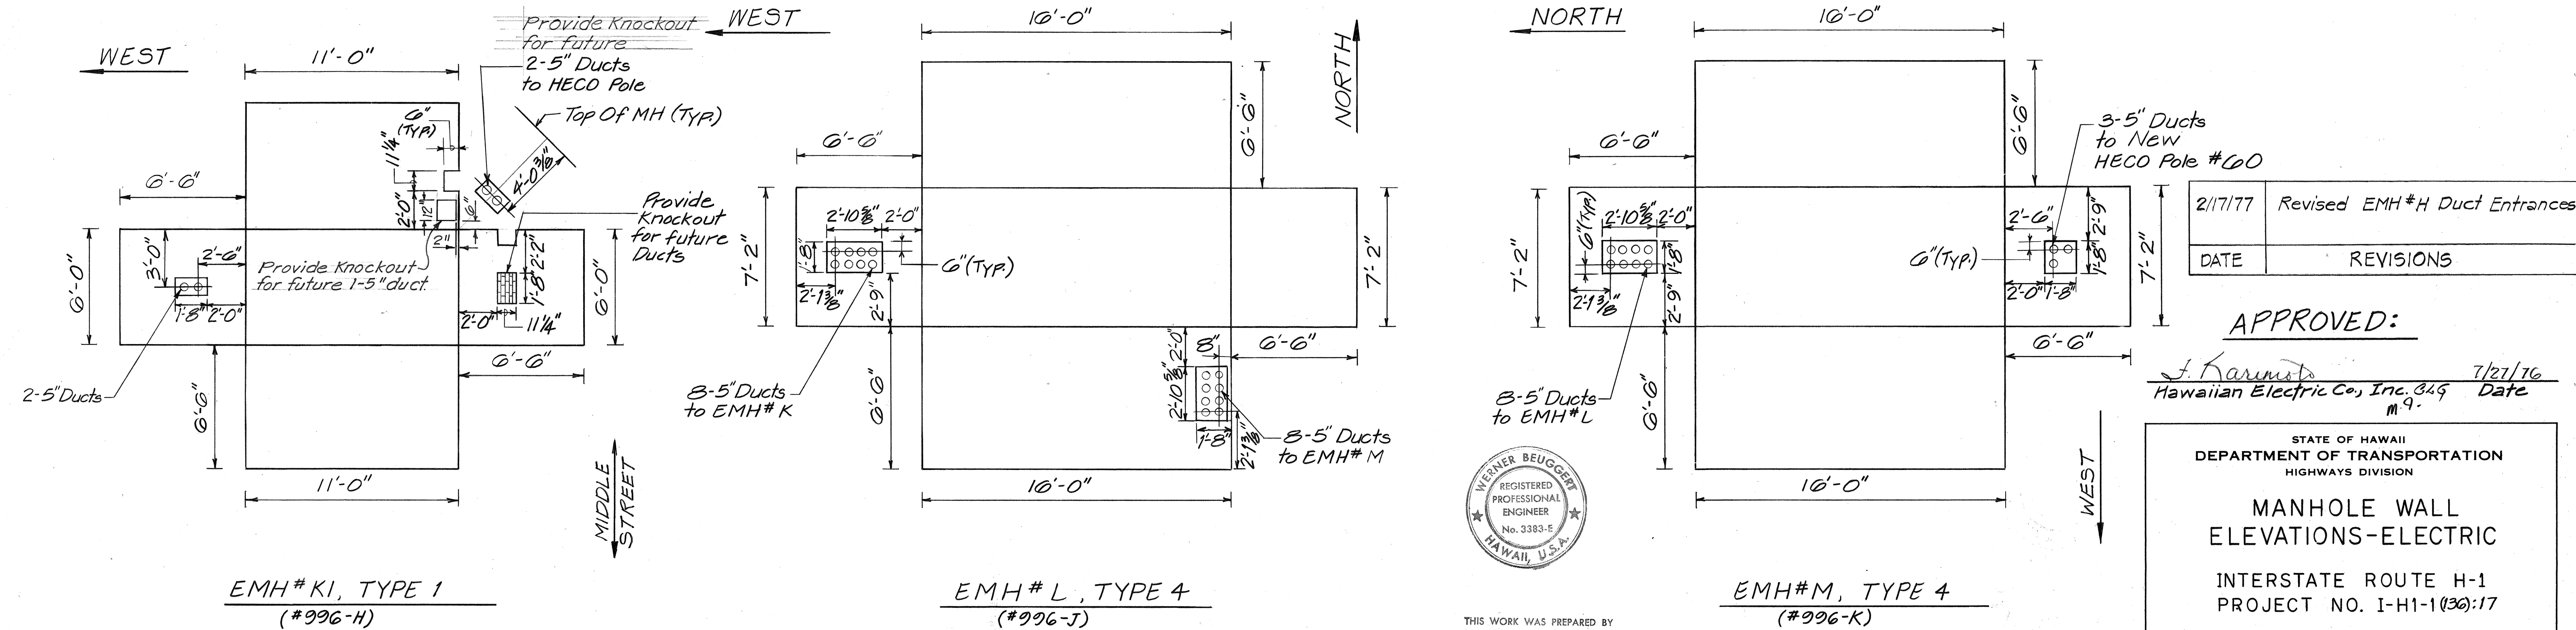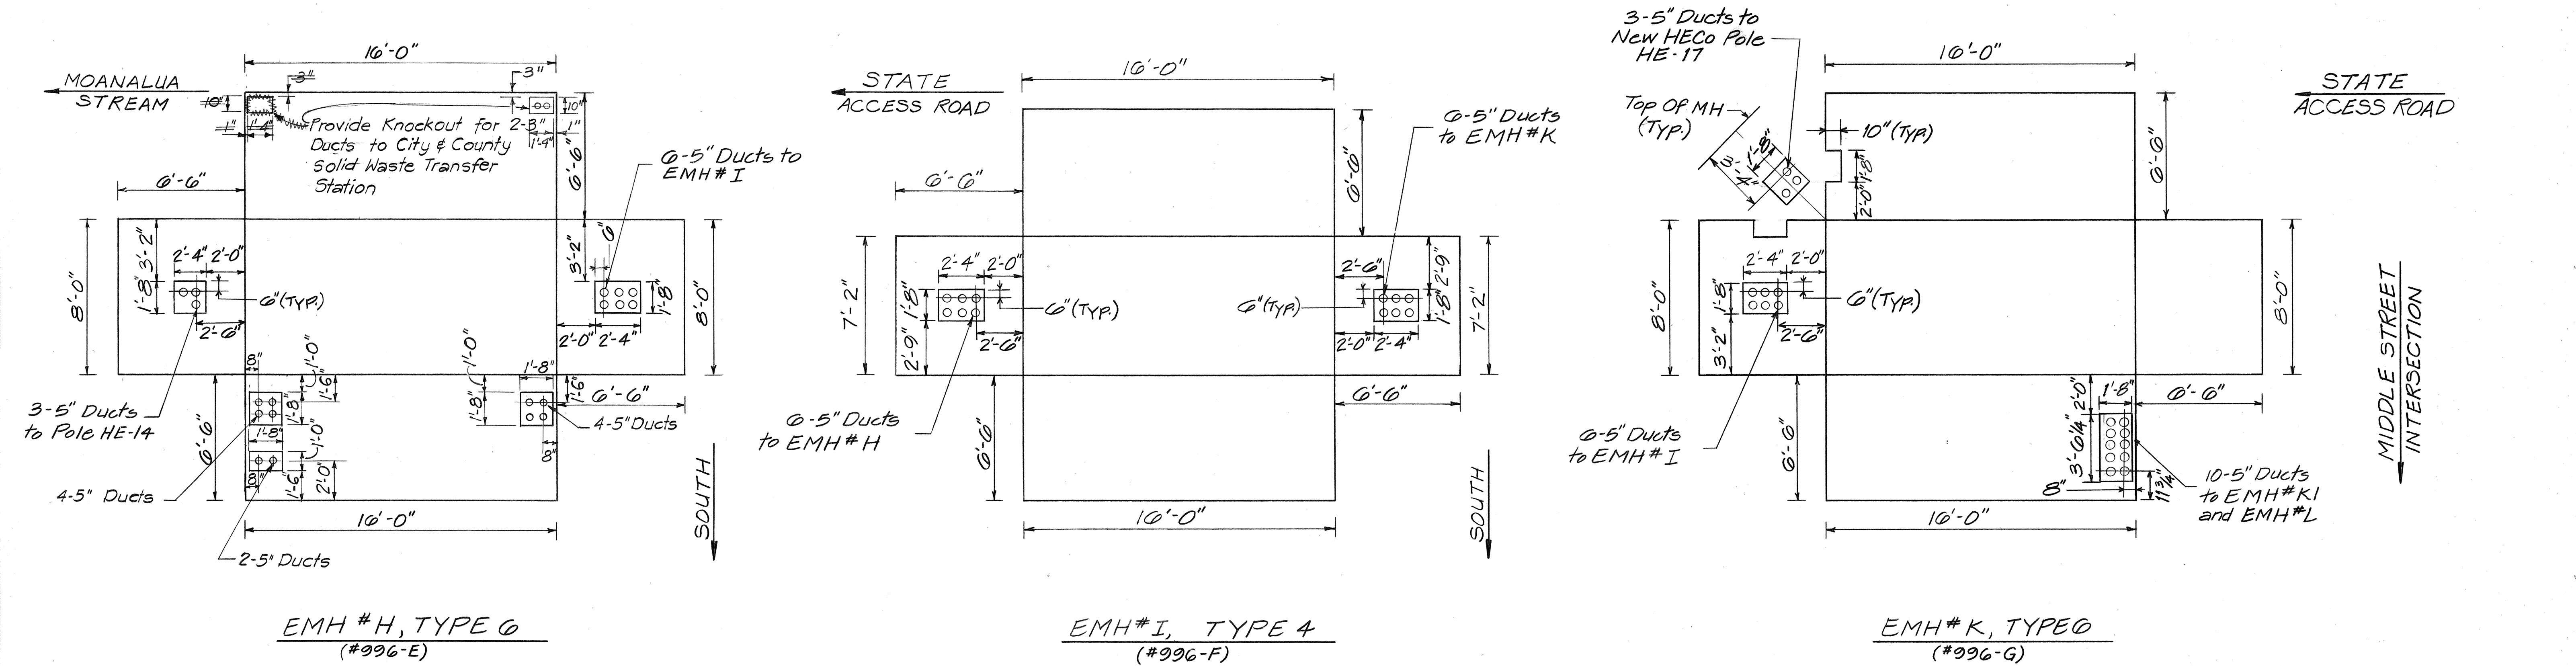

THIS WORK WAS PREPARED BY ME OR UNDER MY SUPERVISION.
Werner Beugger

2/17/77	Revised EMH #H Duct Entrances
DATE	REVISIONS

APPROVED:

J. Karim
Hawaiian Electric Co., Inc. 3/4/9
Date

STATE OF HAWAII
DEPARTMENT OF TRANSPORTATION
HIGHWAYS DIVISION

MANHOLE WALL
ELEVATIONS-ELECTRIC

INTERSTATE ROUTE H-1
PROJECT NO. I-H1-1(13Q):17

SCALE: 1/4" = 1'-0" DATE: July 15, 1976
SHEET NO. 3 OF 3 SHEETS