

FED. ROAD DIST. NO.	STATE	PROJ. NO.	FISCAL YEAR	SHEET NO.	TOTAL SHEETS
HAWAII	HAW.	HIGH-01-10M	2010	ADD.2	13

- | | | |
|--|----------------------------|------------|
| ORIGINAL
PLAN | SURVEY PLOTTED BY _____ | DATE _____ |
| NOTE BOOK
<i>ddxx</i>
<i>Y.ggn</i> | DRAWN BY <i>X</i> | <i>X</i> |
| | TRACED BY _____ | _____ |
| | DESIGNED BY <i>X</i> | _____ |
| | QUANTITIES BY <i>X.ggn</i> | _____ |
| N _o _____ | CHECKED BY _____ | _____ |

 Existing Joint Pole
 Existing Power Pole
 Existing Telephone Line
 Existing Telephone Pole
 Existing Telephone Manhole
 Existing Signal Corps Line
 Existing TV Cable
 Existing Sandwich Isles Communication Line
 Existing 12" Water Line
 Existing Water Manhole
 Existing Water Air Valve
 Existing Water Valve Box
 New Water Valve Box
 Existing Water Meter
 Existing Fire Hydrant
 Existing 12" Sewer Line
 Existing Sewer Manhole
 Existing 6" Gas Line
 Existing Gas Valve Box
 Existing Gas Manhole
 Existing Monument
 Existing 24" Drain Line
 Existing Storm Drain Manhole
 Existing Grated Drop Inlet
 Existing Catch Basin
 Existing Traffic Sign
 Existing Highway Lighting Standard
 Existing Traffic Signal Pole
 Existing Highway Lighting Pullbox
 Existing Metal Guardrail

04/06/10	△ Revised General Notes
DATE	REVISION

STATE OF HAWAII
DEPARTMENT OF TRANSPORTATION
HIGHWAYS DIVISION


GENERAL NOTES AND LEGEND

INTERSTATE ROUTE H-1 LANDSCAPING
Valkenburgh Street To Dillingham Ramp
Project No. HIGH-01-10M

Date: Oct, 2009

SHEET No. 2 OF 13 SHEETS

FED. ROAD DIST. NO.	STATE	FED. AID PROJ. NO.	FISCAL YEAR	SHEET NO.	TOTAL SHEETS
HAWAII	HAW.	HIGH-01-10M	2010	ADD.12	13

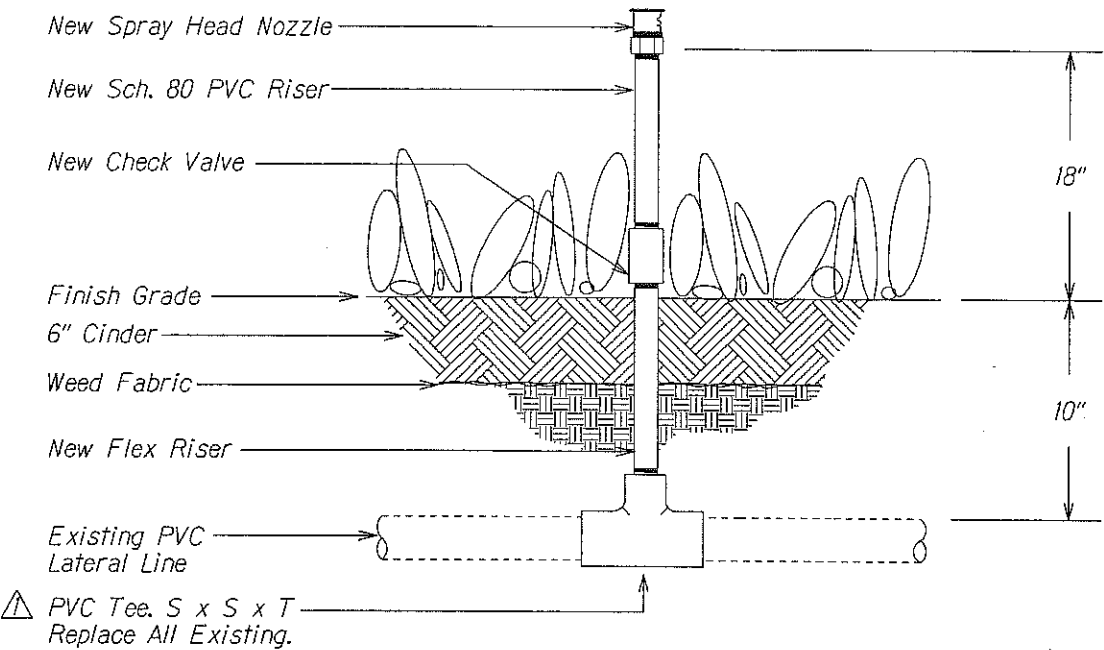

SPRAY HEAD
ON RISER DETAIL
SCALE: N.T.S.

Symbol	Quantity	Catalog Number	Description	G.P.M.	Radius	P.S.I.
☉	268	Rainbird PA-8S-PRS-U8Q	8' Nozzle Qtr: Pressure Regulating Shrub Adapter	0.26	8	30
☉	536	Rainbird PA-8S-PRS-U8H	8' Nozzle Half: Pressure Regulating Shrub Adapter	0.52	8	30
	804	King Brother's Check Valve-CV-0500-FxF	1/2" Check Valve			
	804	King Brother's Flex Riser FR-0500-6F	1/2" x 6" Long MxF			

04/06/10 Revised Spray Head Detail
Irrigation Schedule

DATE REVISION

STATE OF HAWAII
DEPARTMENT OF TRANSPORTATION
HIGHWAYS DIVISION

IRRIGATION DETAIL

INTERSTATE ROUTE H-1 LANDSCAPING
Valkenburgh Street to Dillingham Ramp
Project No. HIGH-01-10M

Scale: Not to Scale Date: Oct, 2009

SHEET No. 1 OF 1 SHEETS

ORIGINAL PLAN	SURVEY PLOTTED BY	DATE
NOTE BOOK	DRAWN BY	
NO. 500000000	DESIGNED BY	
	QUANTITIES BY	
	CHECKED BY	