


FED. ROAD DIST. NO.	STATE	FED. AID PROJ. NO.	FISCAL YEAR	SHEET NO.	TOTAL SHEETS
HAWAII	HAW.	HIGH-01-10M	2010	12	13

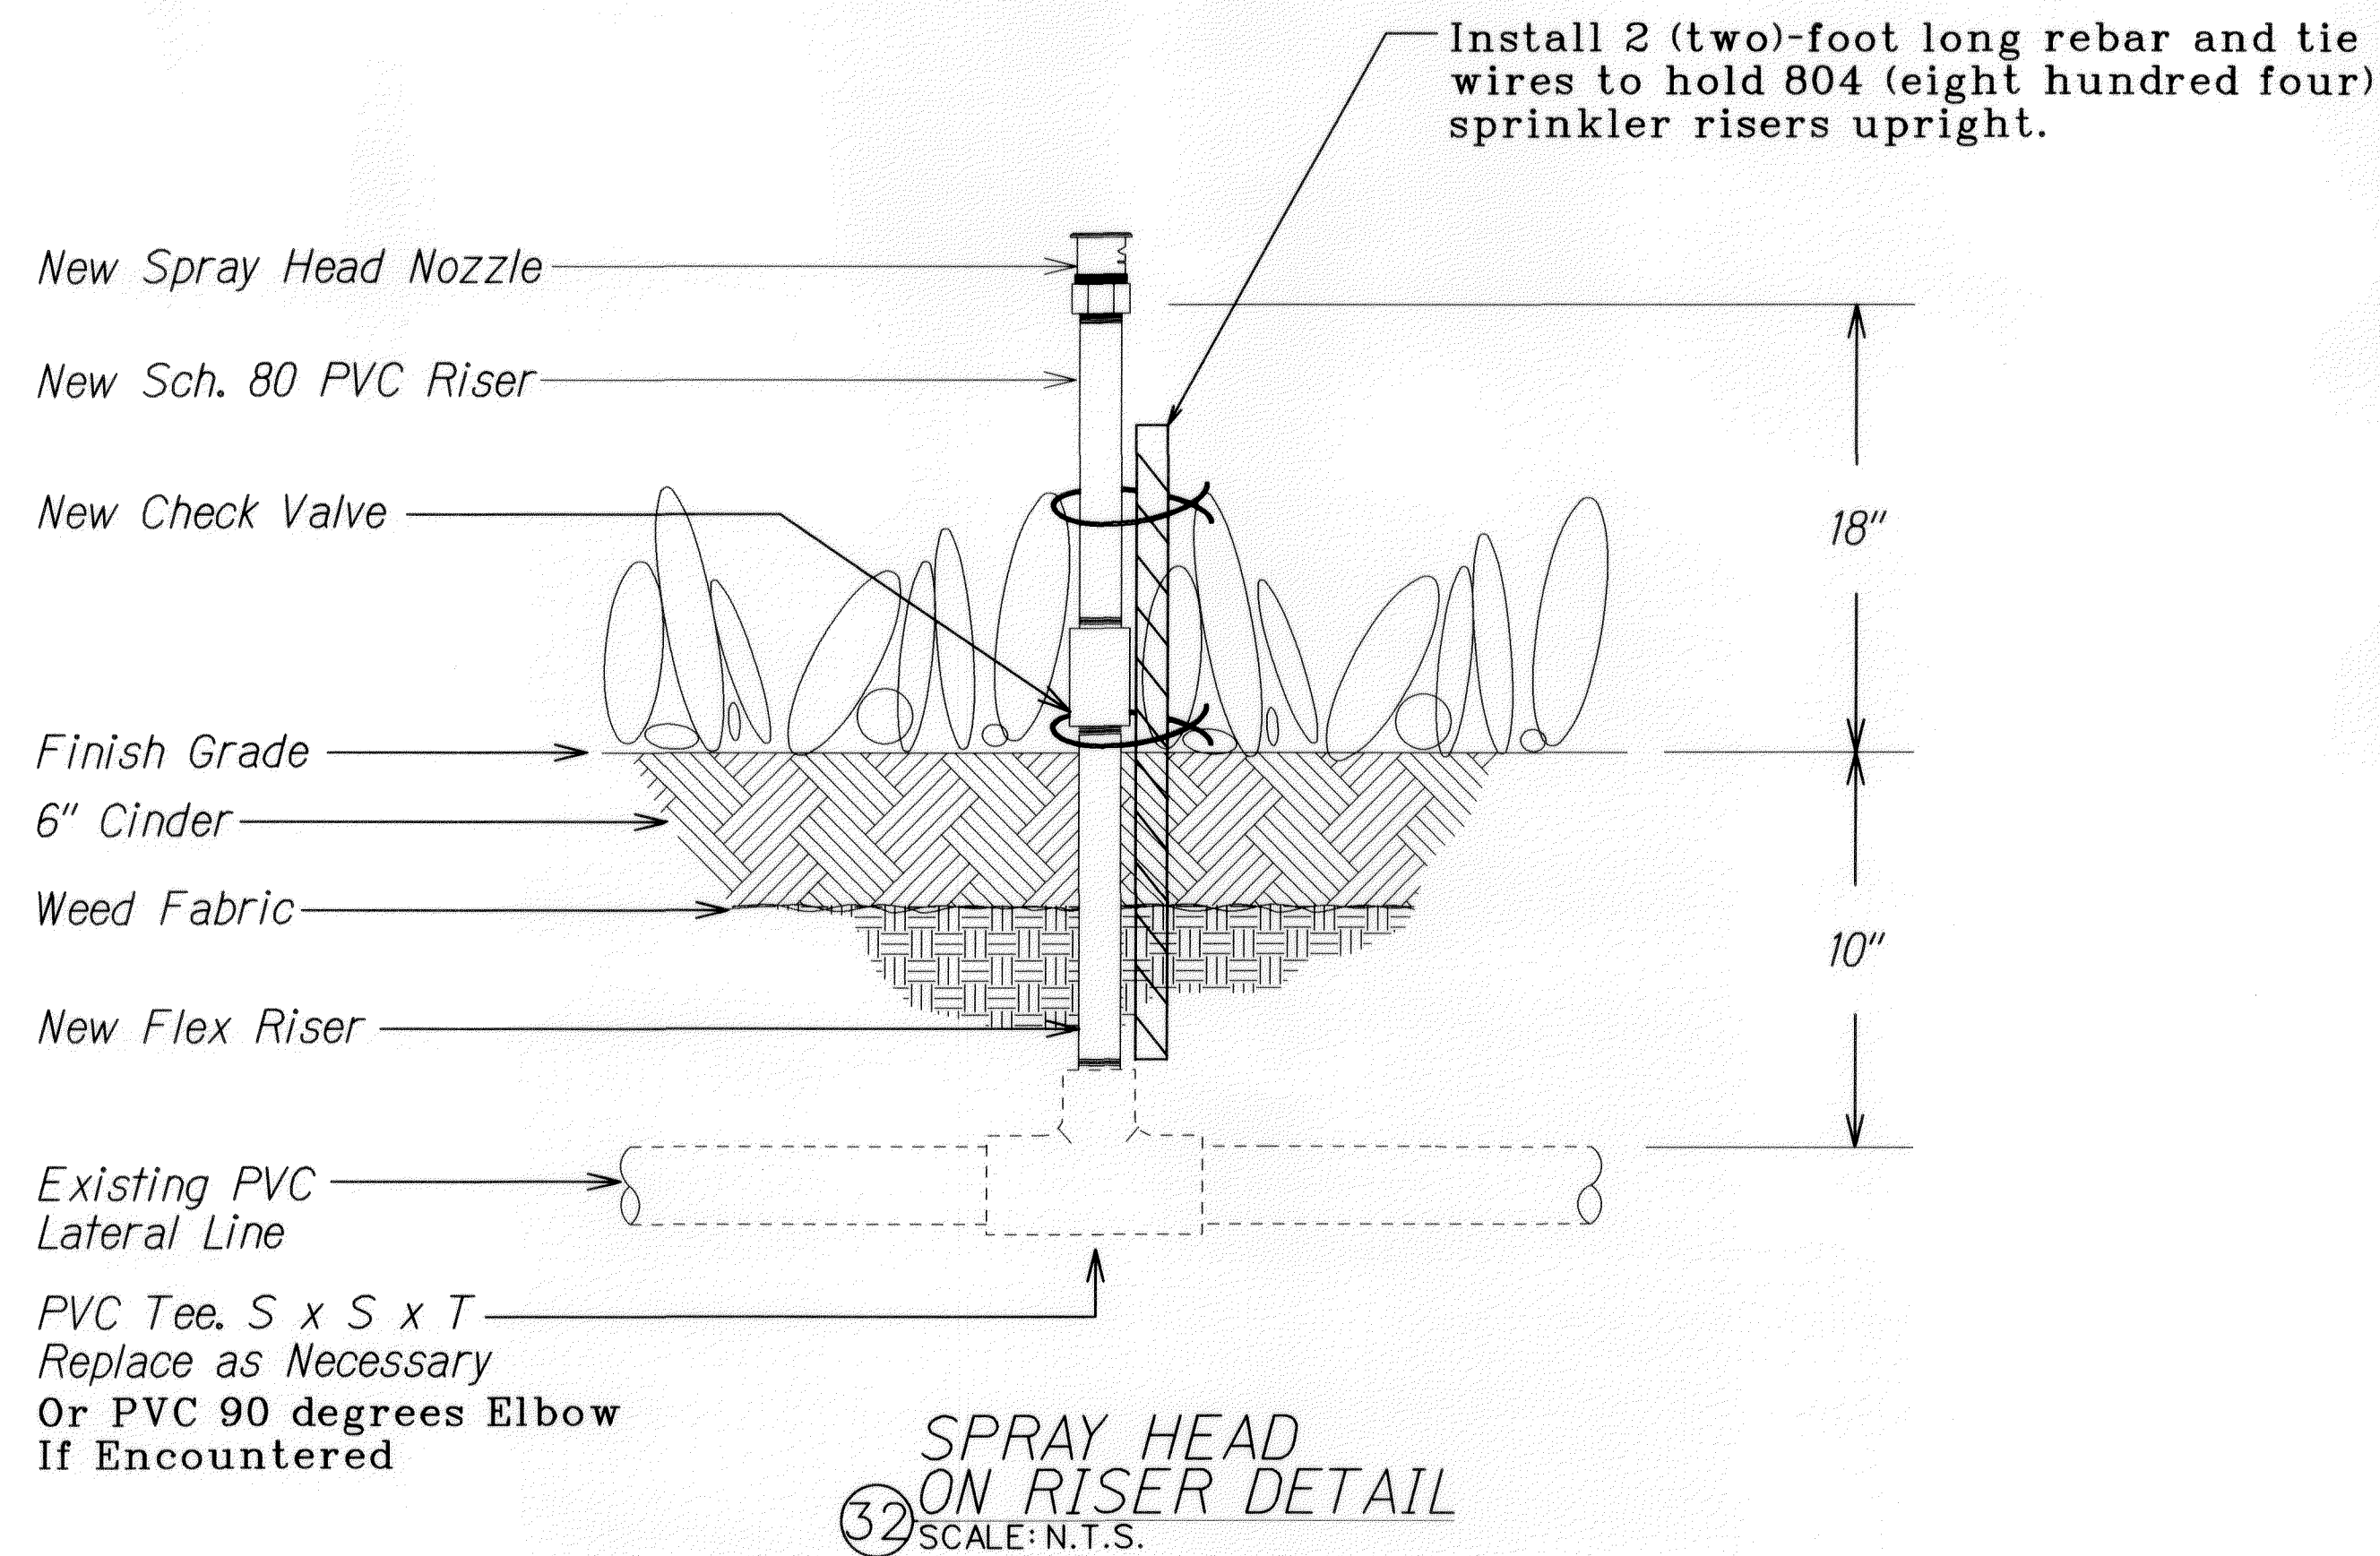

Symbol	Quantity	Catalog Number	Description	G.P.M.	Radius	P.S.I.
☉	536	Rainbird 1804 -SAM-PRS-U8Q	18" Nozzle Half Circle -Brush adapt Assby.	0.18	8	15
◐	268	Rainbird 1804 -SAM-PRS-U8H	18" Nozzle Quarter Circle -Brush adapt Assby.	0.37	8	15
	804	King Brother's Check Valve-CV-0500-FxF	1/2" Check Valve			
	804	King Brother's Flex Riser FR-0500-6F	1/2" x 6" Long MxF			

ORIGINAL PLAN	SURVEY NOTED BY	DATE
NOTE BOOK	DRAWN BY	
DESIGNED BY	CHECKED BY	
NO. 2010/09/09		

LEGEND FOR AS-BUILT POSTINGS	
	Squiggly line for as-built deletion
	Double line for as-built deletion
Roadway	Text for as-built posting

STATE OF HAWAII DEPARTMENT OF TRANSPORTATION HIGHWAYS DIVISION
IRRIGATION DETAIL
INTERSTATE ROUTE H-1 LANDSCAPING Valkenburgh street to Dillingham ramp Project No. HIGH-01-10M
Scale: Not to Scale Date: Oct, 2009
SHEET No. 1 OF 1 SHEETS

"AS-BUILT"