



FED. ROAD DIST. NO.	STATE	FED. AID PROJ. NO.	FISCAL YEAR	SHEET NO.	TOTAL SHEETS
HAWAII	HAW.	HIGH-01-10M	2010	5	13

BEGIN PROJECT
Project No. HIGH-01-10M
Sta. 112+47

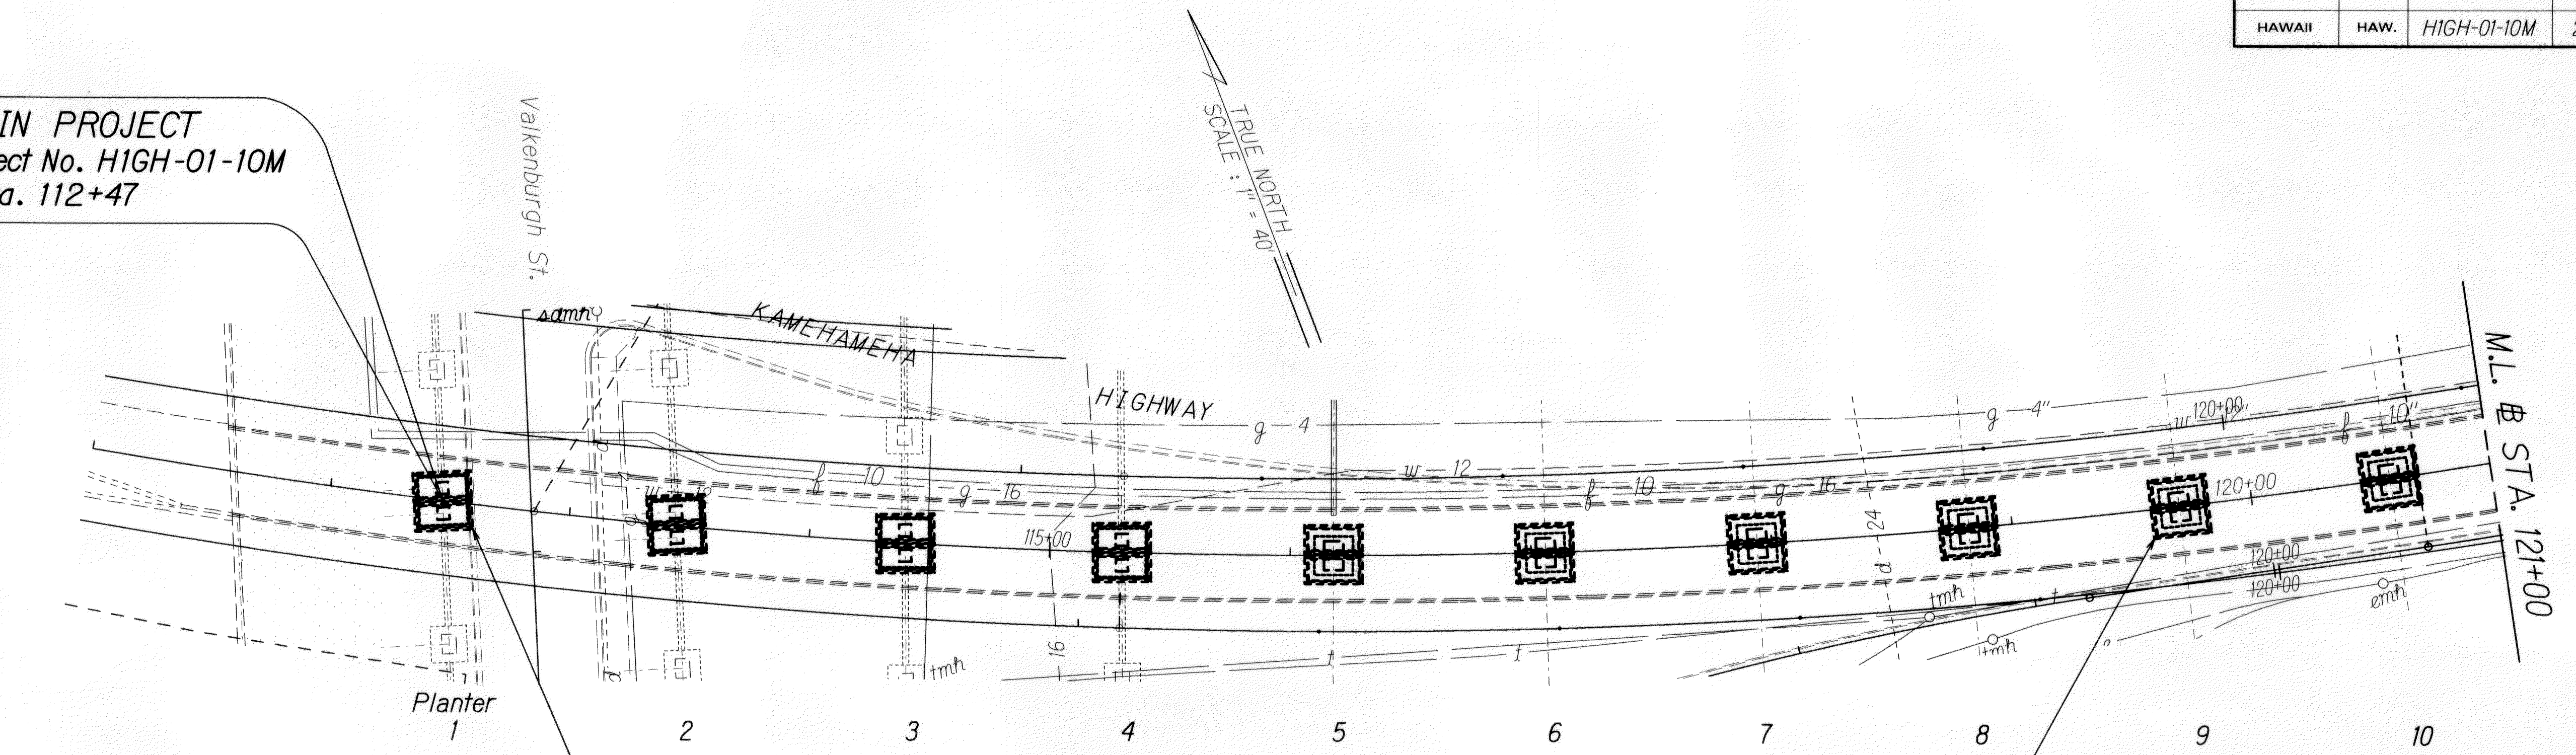

Planter Box #1 has no water supply. Grubbing still was completed for Planter Box #1.

- Excavate trench for new irrigation line from existing control valve on Nimitz Highway Median.
- New 1¼" Schedule 40 PVC pipe in trench for new irrigationline from existing control valve (at STA. 120+10) to Planter Box #9. Pier (at STA. 120+00).
- New 1-inch Schedule 40 PVC pipe for new irrigation line on side of Pier for Planter Box #9 (at STA. 120+00).

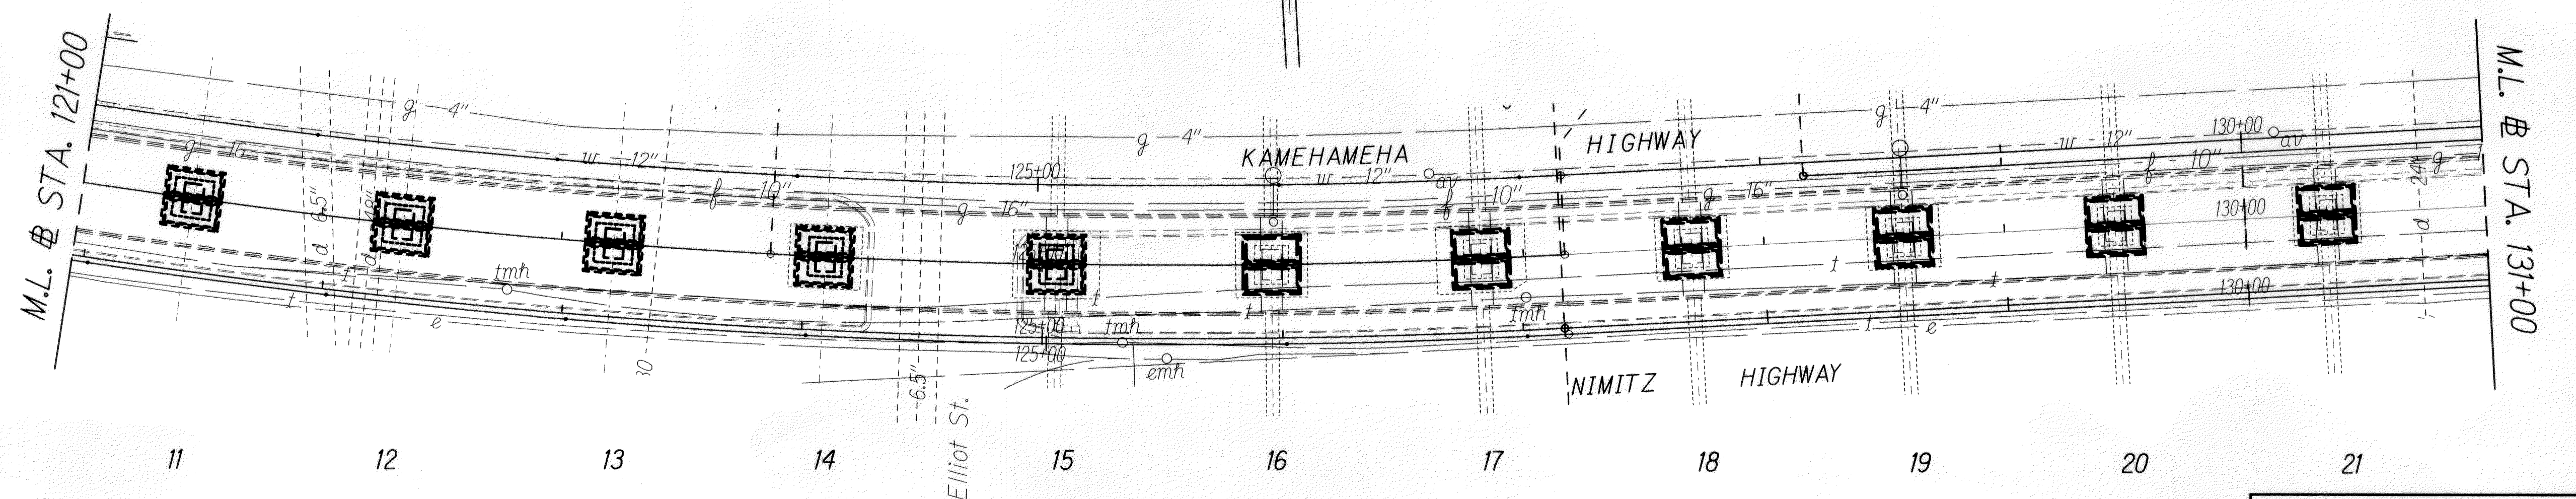

LEGEND FOR AS-BUILT POSTINGS

	Squiggly line for as-built deletion
	Double line for as-built deletion
	Text for as-built posting

For second level planters 1-21, see sheets 11 & 13 for landscape & irrigation.


DATE	
DESIGNED BY	
CHECKED BY	
NOTED BY	
ORIGINAL PLAN	

STATE OF HAWAII
DEPARTMENT OF TRANSPORTATION
HIGHWAYS DIVISION

LANDSCAPE PLANS
INTERSTATE ROUTE H-1 LANDSCAPING
Valkenburgh Street to Dillingham Ramp
Project No. HIGH-01-10M
Scale: 1" = 40' Date: Oct, 2009
SHEET No. 1 OF 6 SHEETS

"AS-BUILT"

FED. ROAD DIST. NO.	STATE	FED. AID PROJ. NO.	FISCAL YEAR	SHEET NO.	TOTAL SHEETS
HAWAII	HAW.	HIGH-01-10M	2010	6	13

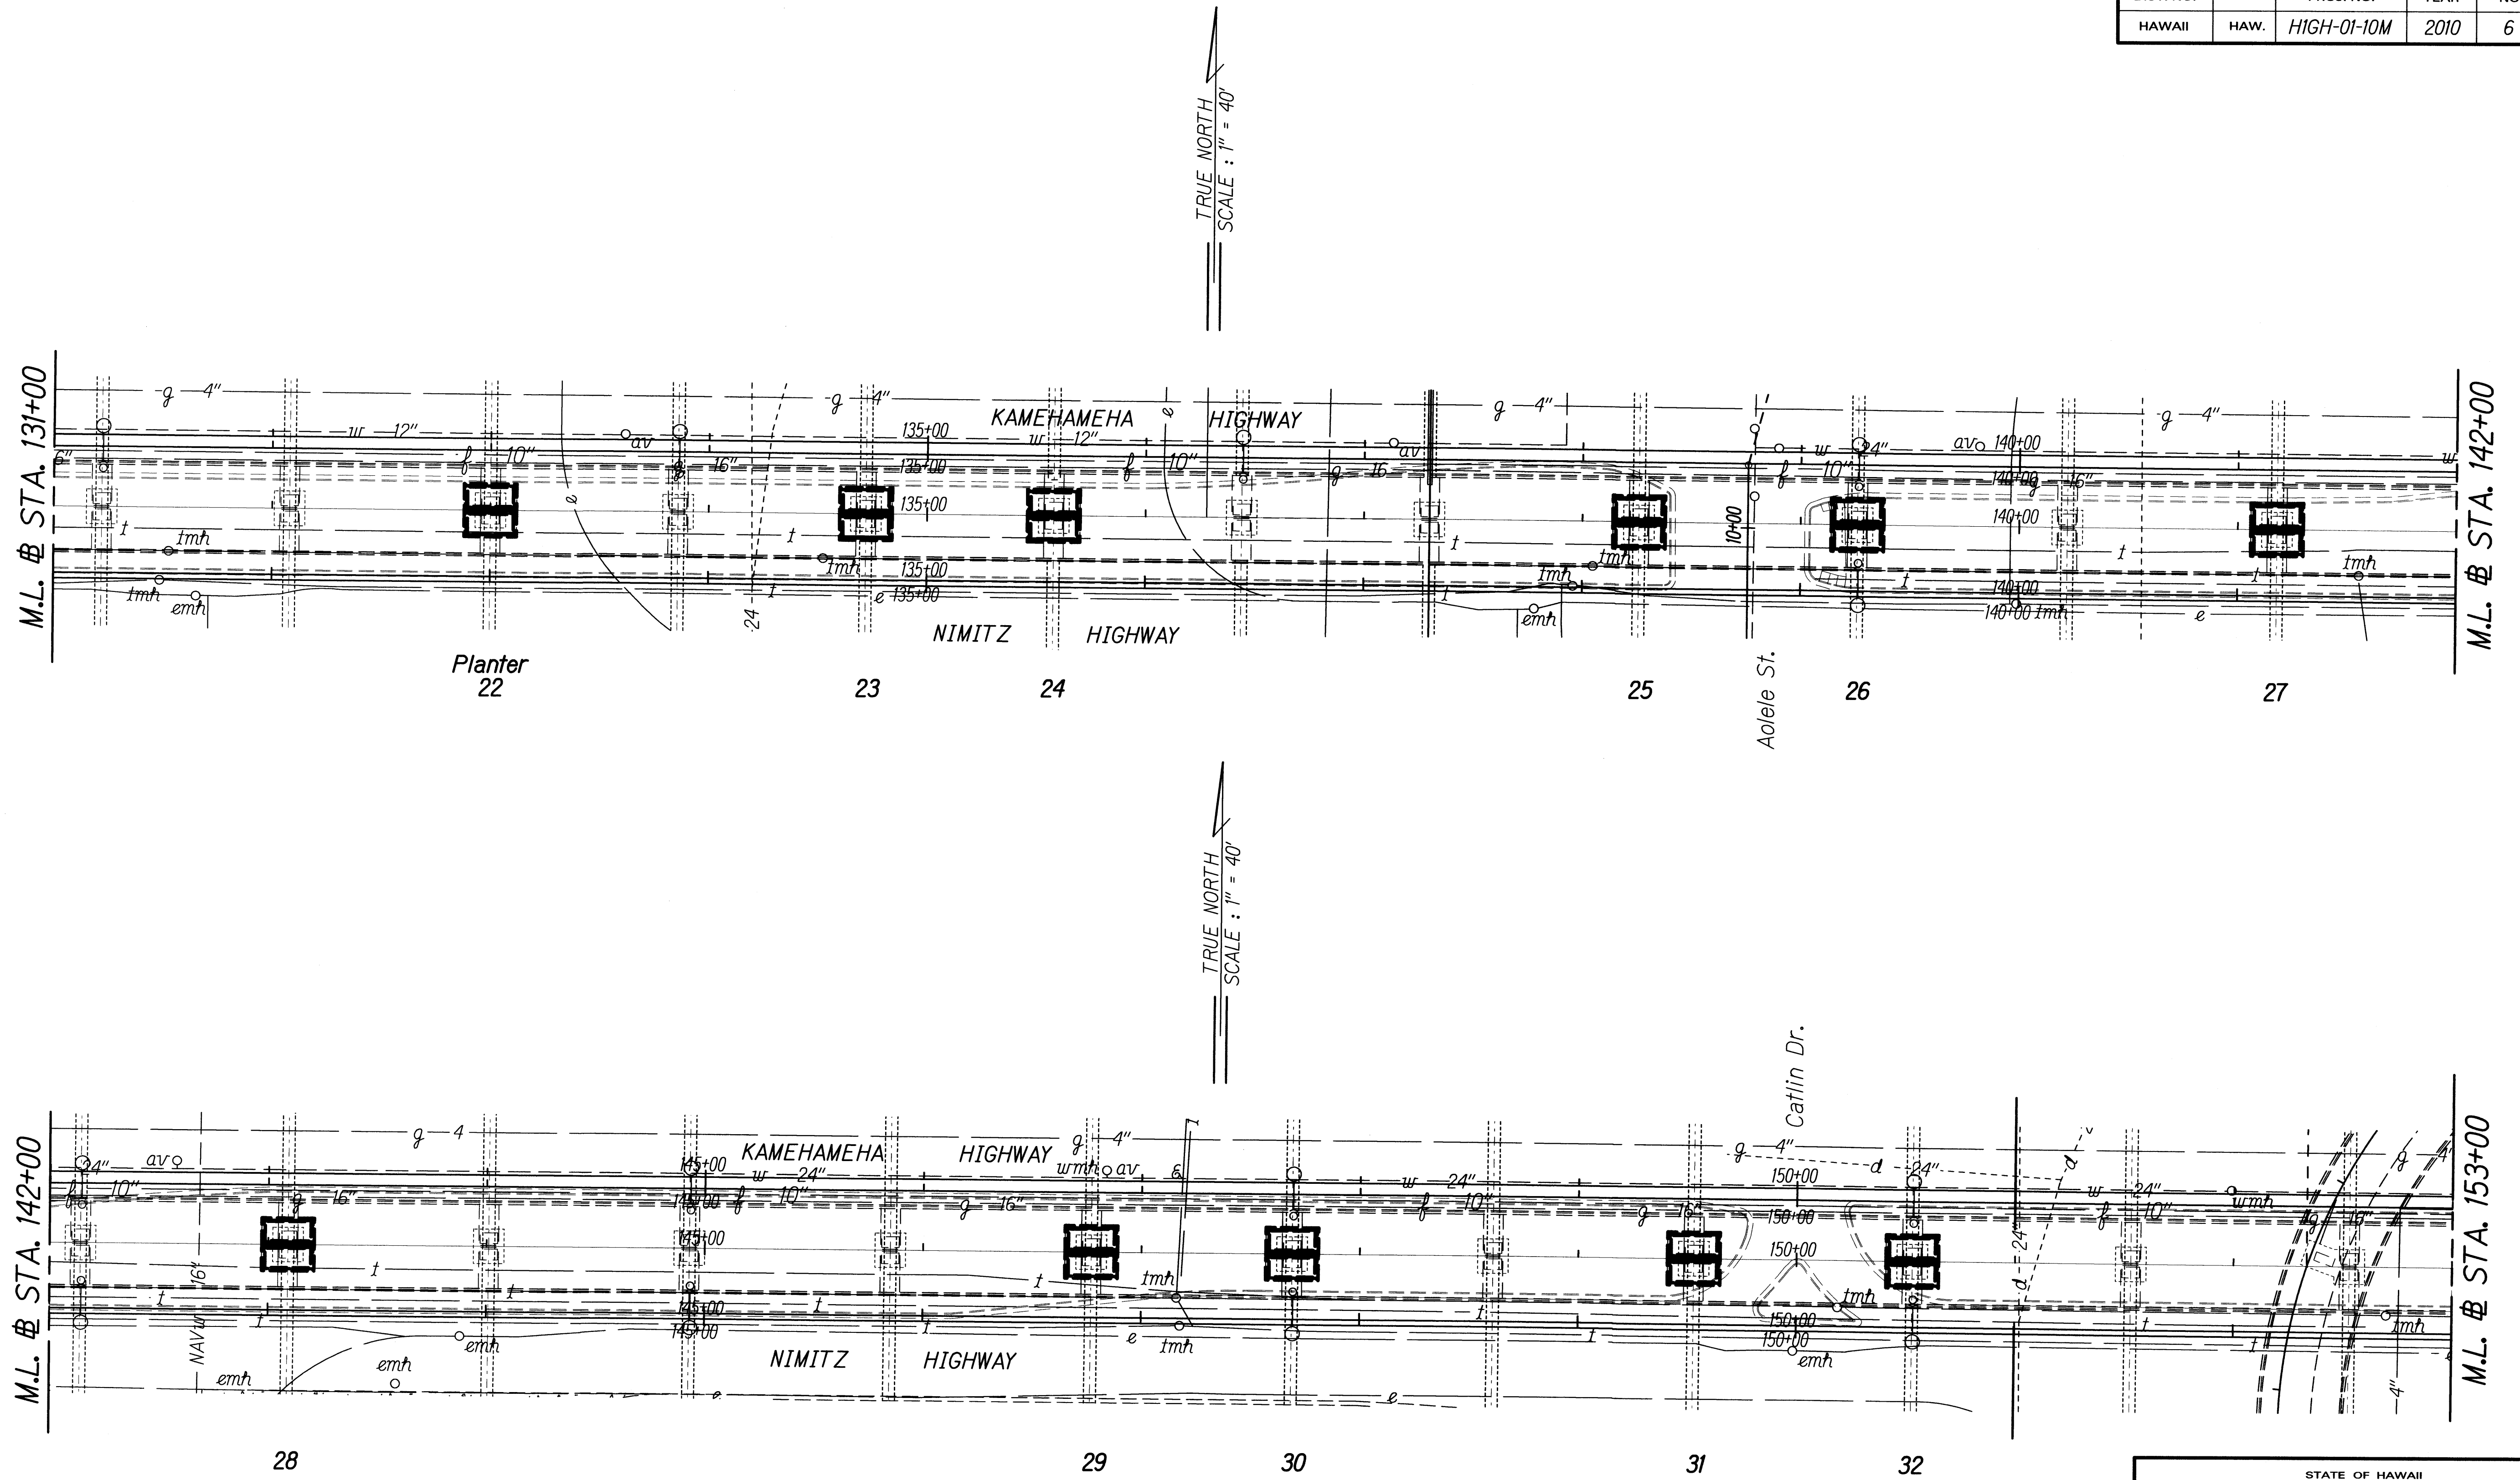

ORIGINAL PLAN	SURVEY PLOTTED BY	DATE
NOTE BOOK	DRAWN BY	
	DESIGNED BY	
	QUANTITIES BY	
	CHECKED BY	

For second level planters 22-32, see sheet 11 # 13 for landscape & irrigation.

STATE OF HAWAII
DEPARTMENT OF TRANSPORTATION
HIGHWAYS DIVISION


LANDSCAPING PLANS

INTERSTATE ROUTE H-1 LANDSCAPING
Valkenburgh Street to Dillingham Ramp
Project No. HIGH-01-10M

Scale: 1" = 40' Date: Oct, 2009

SHEET No. 2 OF 6 SHEETS

FED. ROAD DIST. NO.	STATE	FED. AID PROJ. NO.	FISCAL YEAR	SHEET NO.	TOTAL SHEETS
HAWAII	HAW.	HIGH-01-10M	2010	7	13

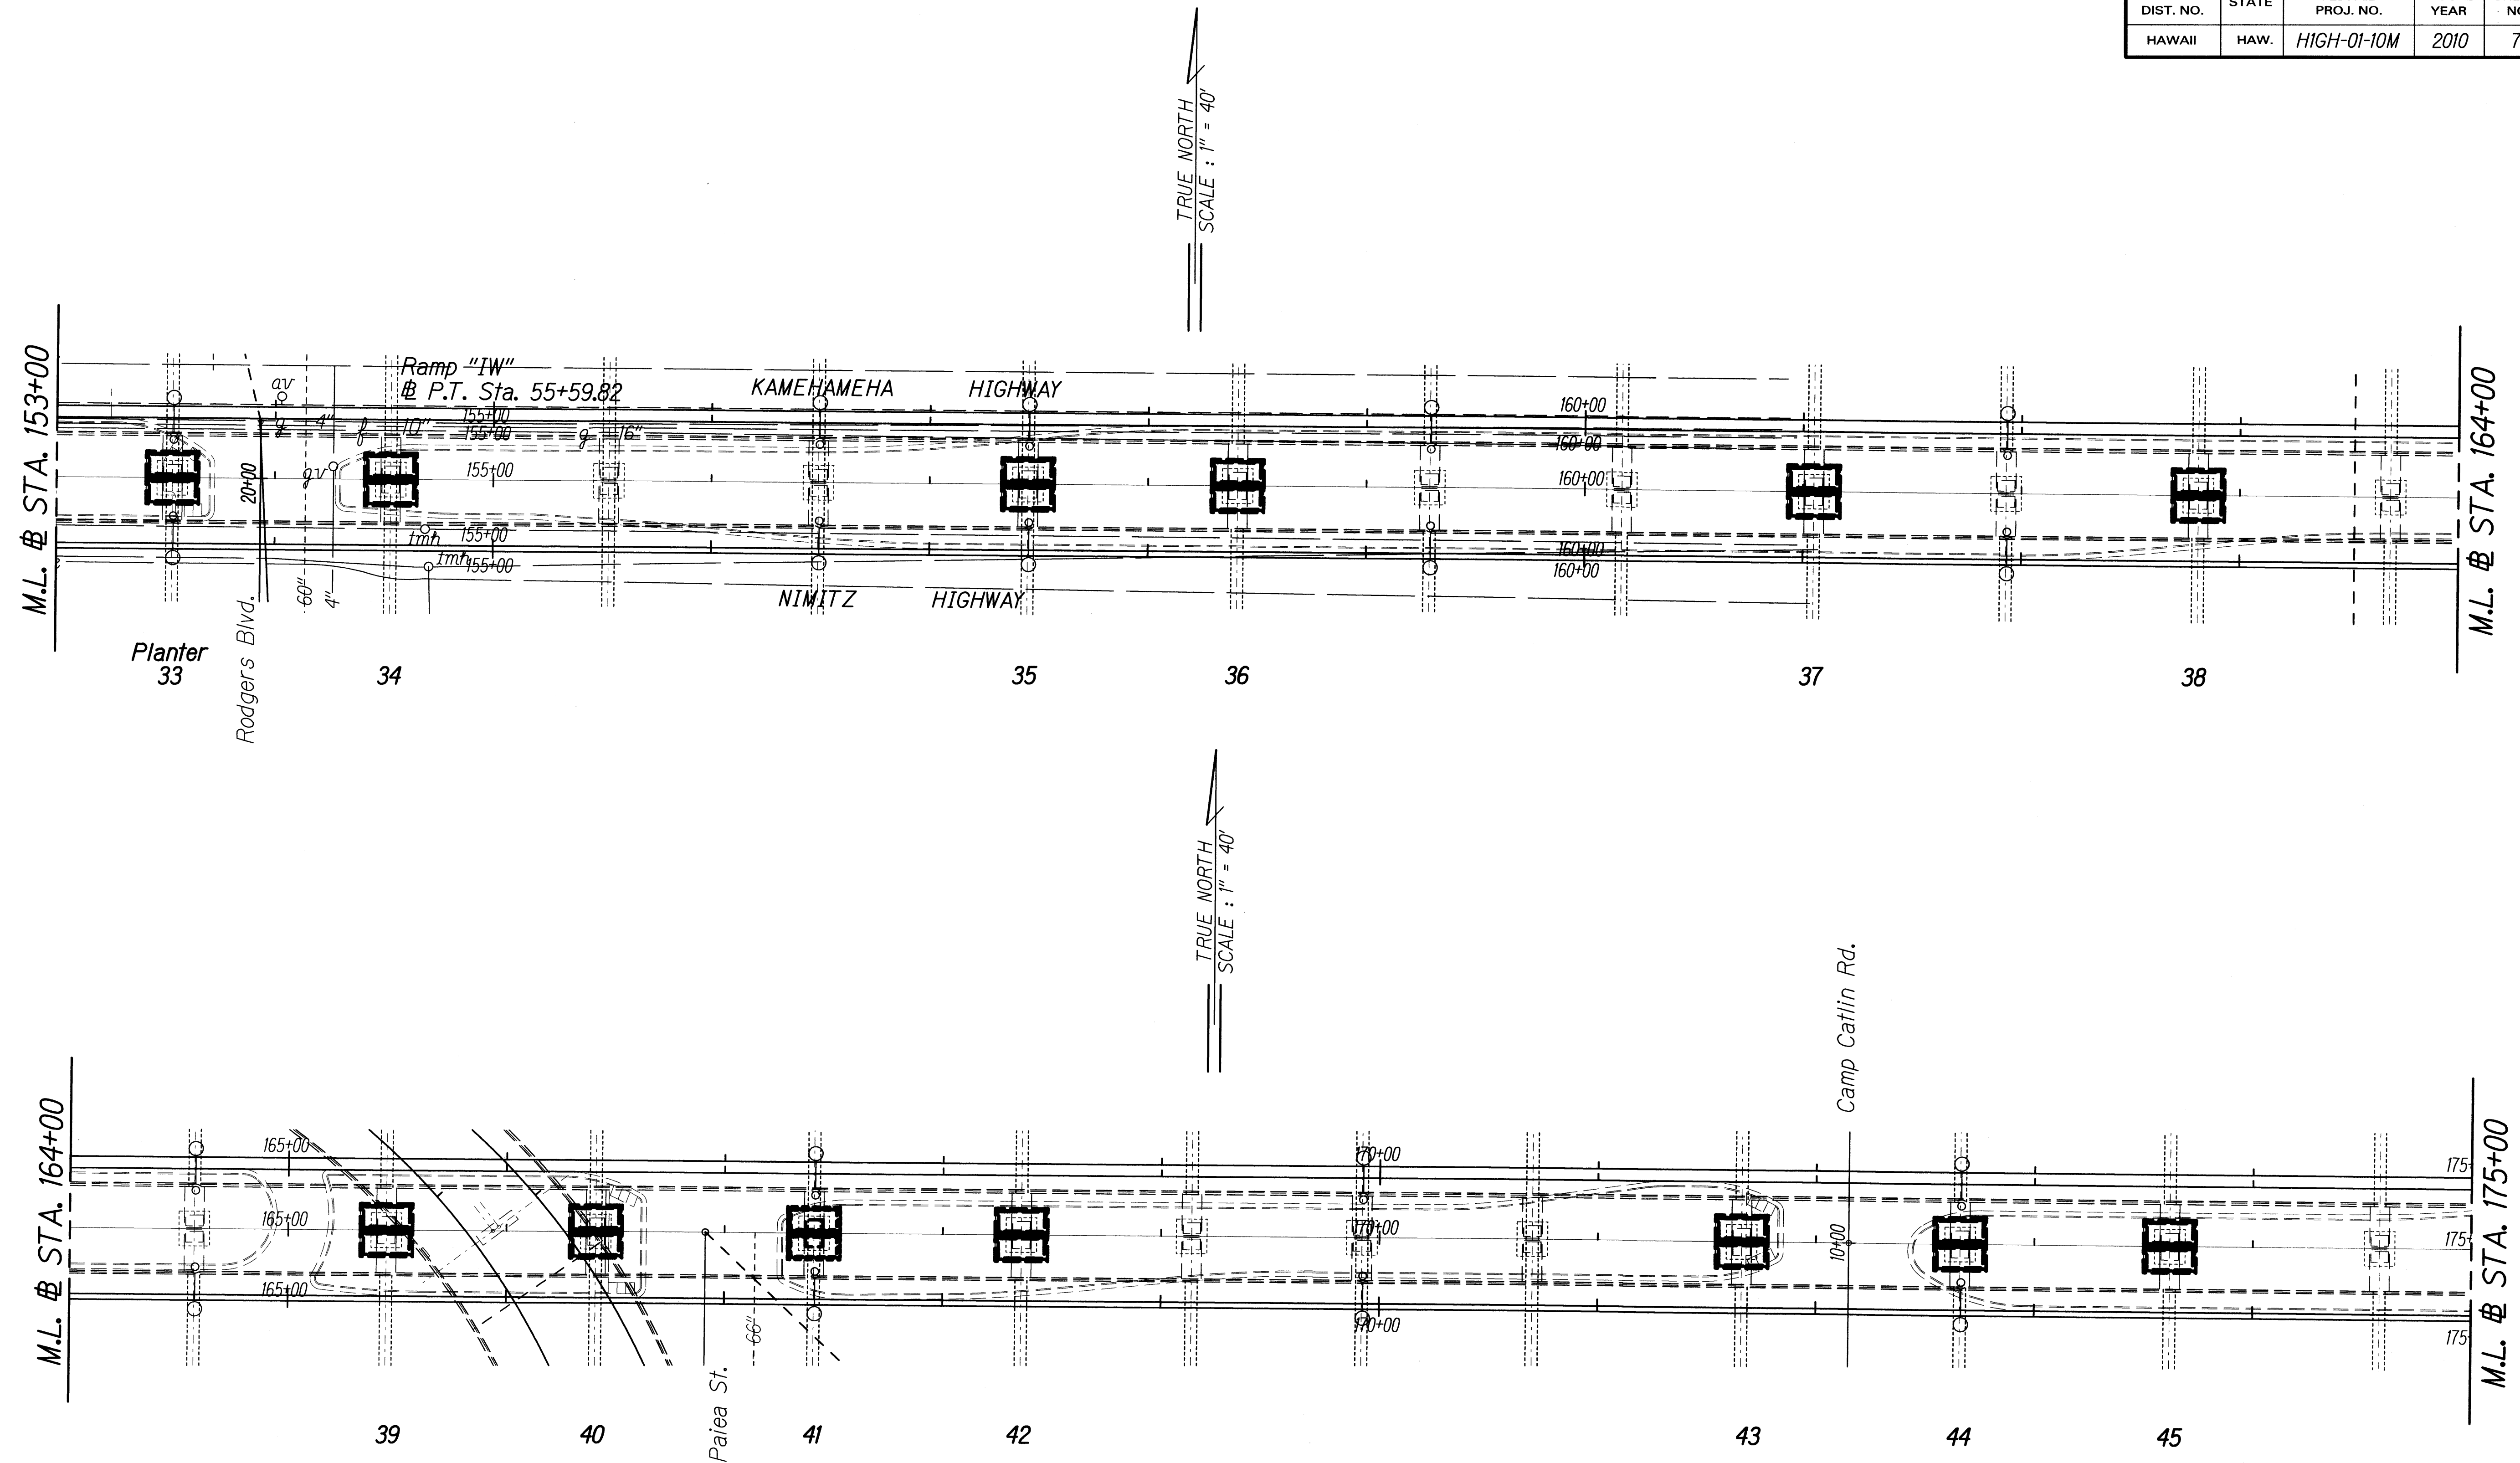

For second level planters 33 through 45, see sheets 11 & 13 for landscape & irrigation.

STATE OF HAWAII
DEPARTMENT OF TRANSPORTATION
HIGHWAYS DIVISION

LANDSCAPE PLANS


INTERSTATE ROUTE H-1 LANDSCAPING
Valkenburgh Street to Dillingham Ramp
Project No. HIGH-01-10M

Scale: 1" = 40' Date: Oct, 2009

SHEET No. 3 OF 6 SHEETS

ORIGINAL PLAN	SURVEY PLOTTED BY	DATE
NOTE BOOK	DRAWN BY	
	CHECKED BY	
	QUANTITIES BY	
	DESIGNED BY	

FED. ROAD DIST. NO.	STATE	FED. AID PROJ. NO.	FISCAL YEAR	SHEET NO.	TOTAL SHEETS
HAWAII	HAW.	HIGH-01-10M	2010	8	13

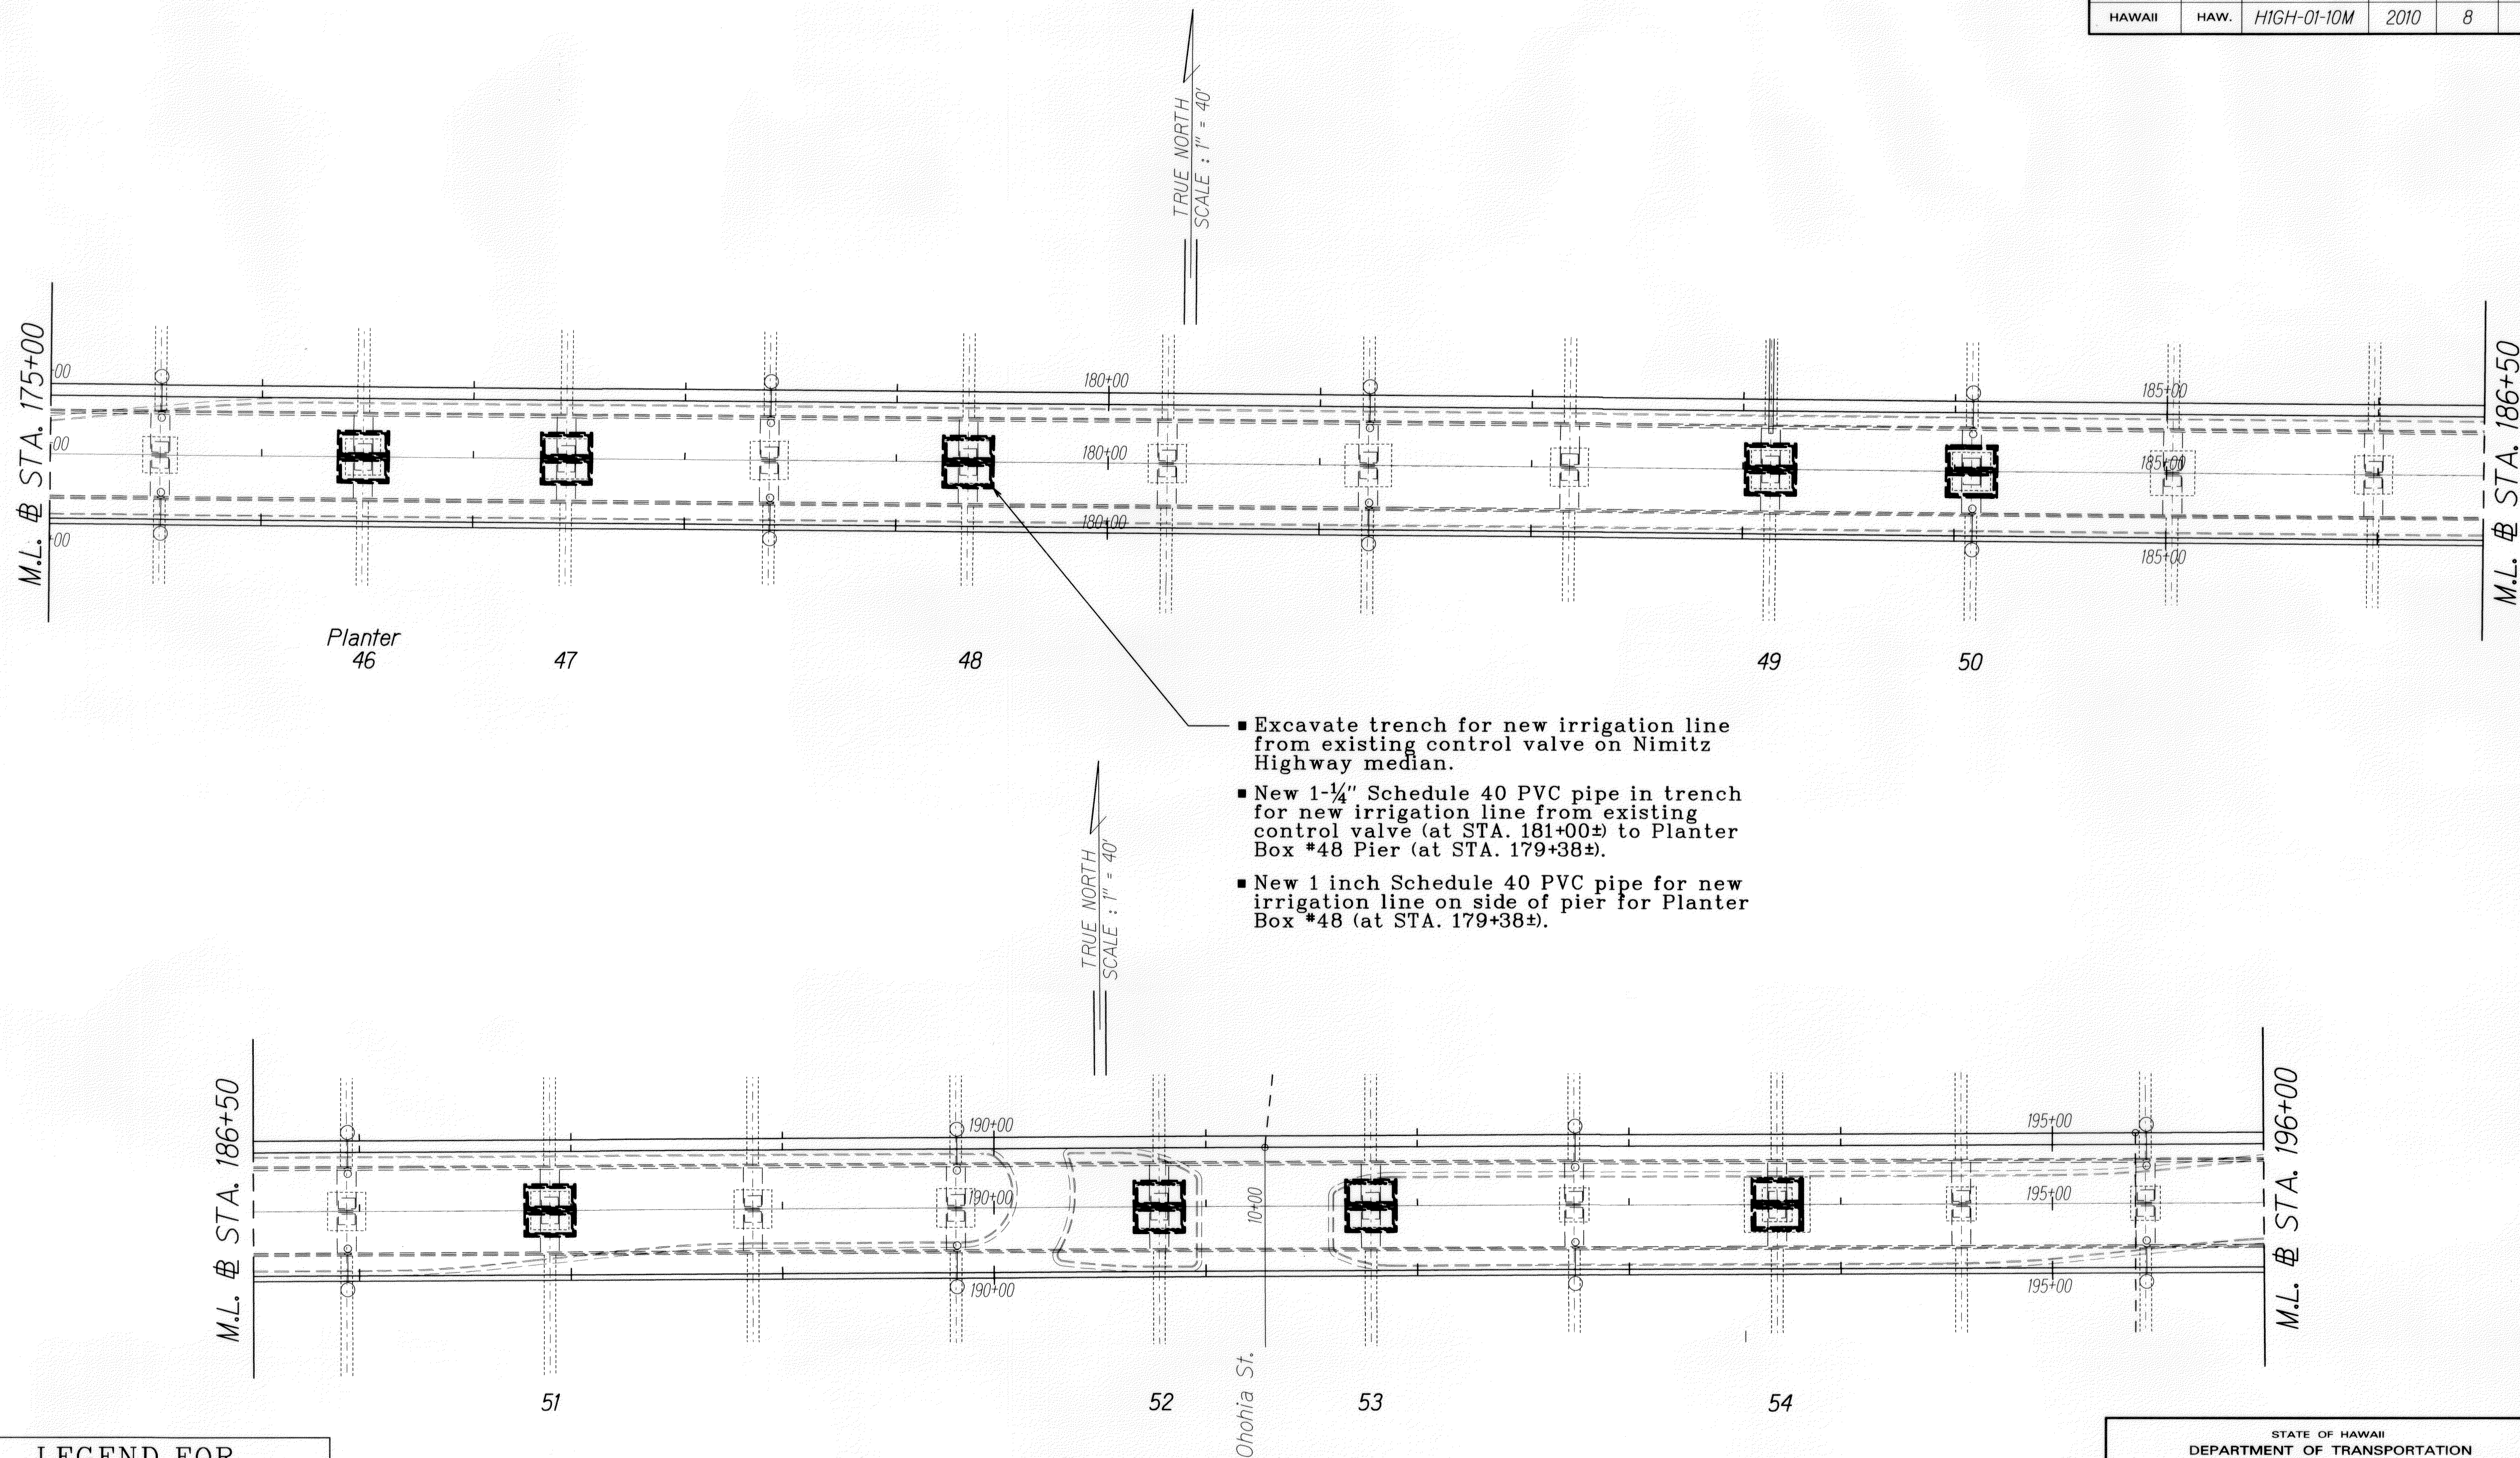


LEGEND FOR AS-BUILT POSTINGS	
	Squiggly line for as-built deletion
	Double line for as-built deletion
Roadway	Text for as-built posting

For second level planters 46 through 54, see sheets 11 & 13 for landscape & irrigation.

STATE OF HAWAII DEPARTMENT OF TRANSPORTATION HIGHWAYS DIVISION	
LANDSCAPE PLANS	
INTERSTATE ROUTE H-1 LANDSCAPING Valkenburgh Street to Dillingham Ramp Project No. HIGH-01-10M	
Scale: 1" = 40'	Date: Oct, 2009
SHEET No. 4 OF 6 SHEETS	

"AS-BUILT"

FED. ROAD DIST. NO.	STATE	FED. AID PROJ. NO.	FISCAL YEAR	SHEET NO.	TOTAL SHEETS
HAWAII	HAW.	HIGH-01-10M	2010	9	13

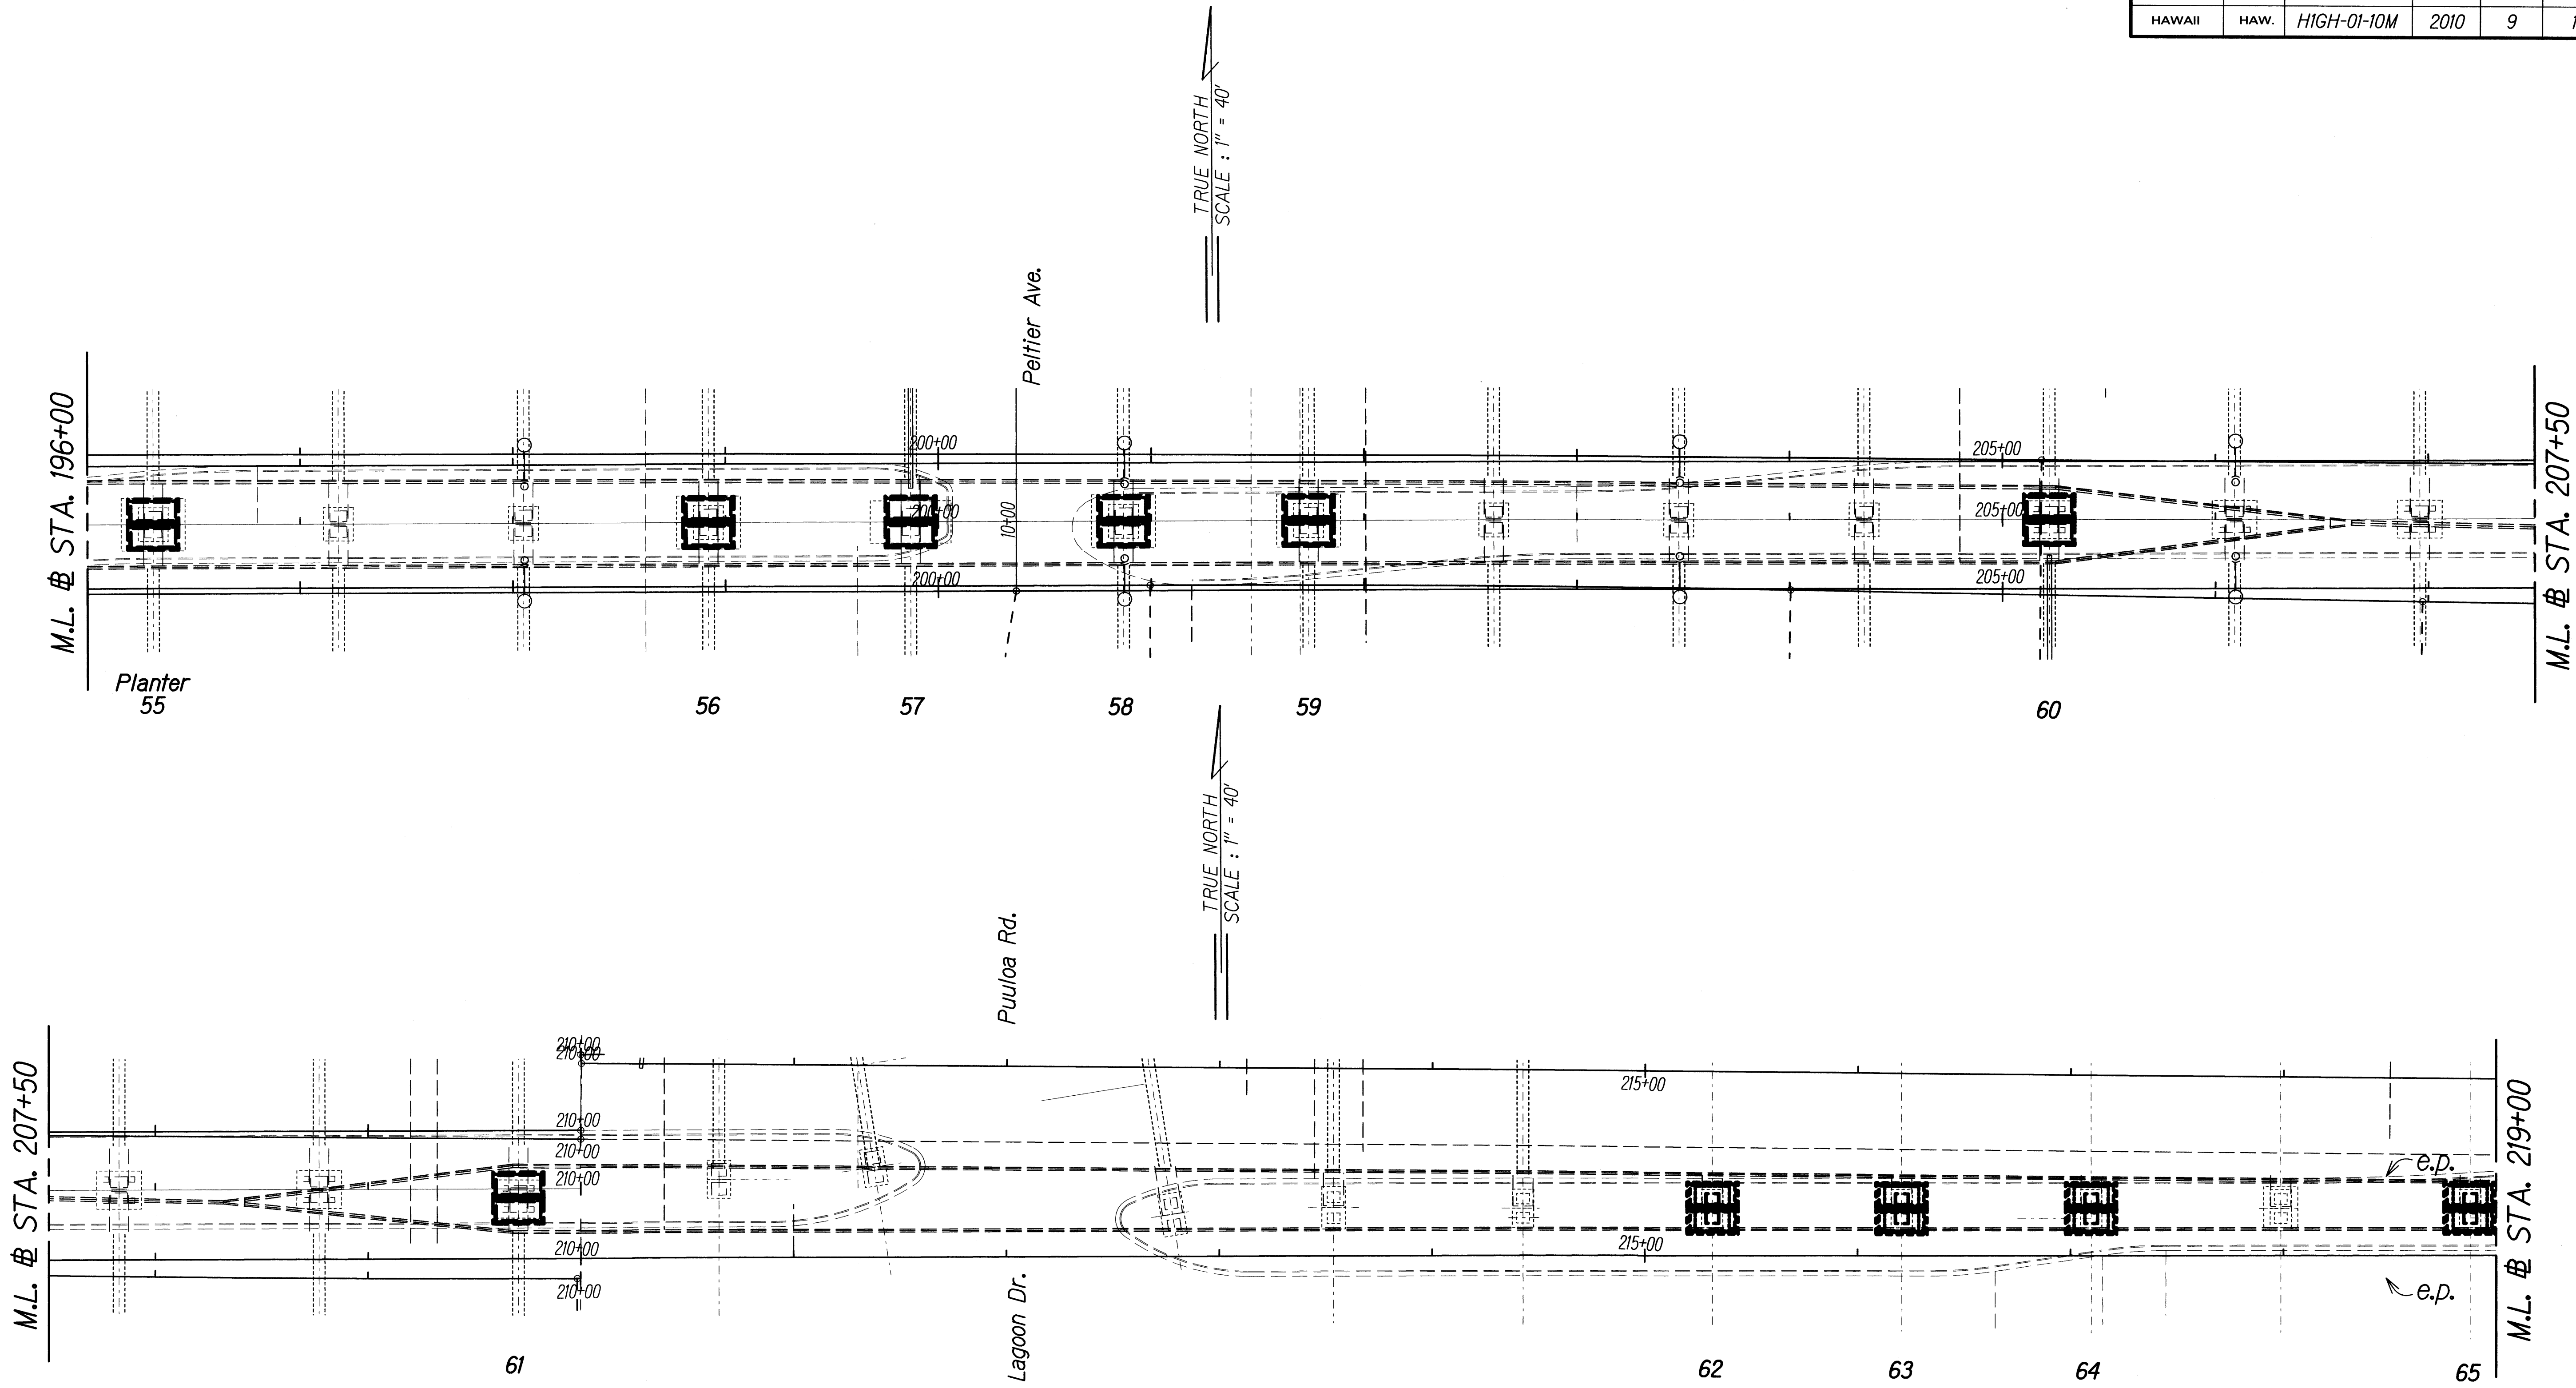

For second level planters 55 through 65, see sheets 11 & 13
for landscape & irrigation.

STATE OF HAWAII
DEPARTMENT OF TRANSPORTATION
HIGHWAYS DIVISION

LANDSCAPE PLANS


INTERSTATE ROUTE H-1 LANDSCAPING
Valkenburgh Street to Dillingham Ramp
Project No. HIGH-01-10M

Scale: 1" = 40' Date: Oct, 2009

SHEET No. 5 OF 6 SHEETS

ORIGINAL PLAN	SURVEY PLOTTED BY	DATE
	DRAWN BY	
	DESIGNED BY	
	CHECKED BY	
NOTE BOOK No.		

FED. ROAD DIST. NO.	STATE	FED. AID PROJ. NO.	FISCAL YEAR	SHEET NO.	TOTAL SHEETS
HAWAII	HAW.	HIGH-01-10M	2010	10	13

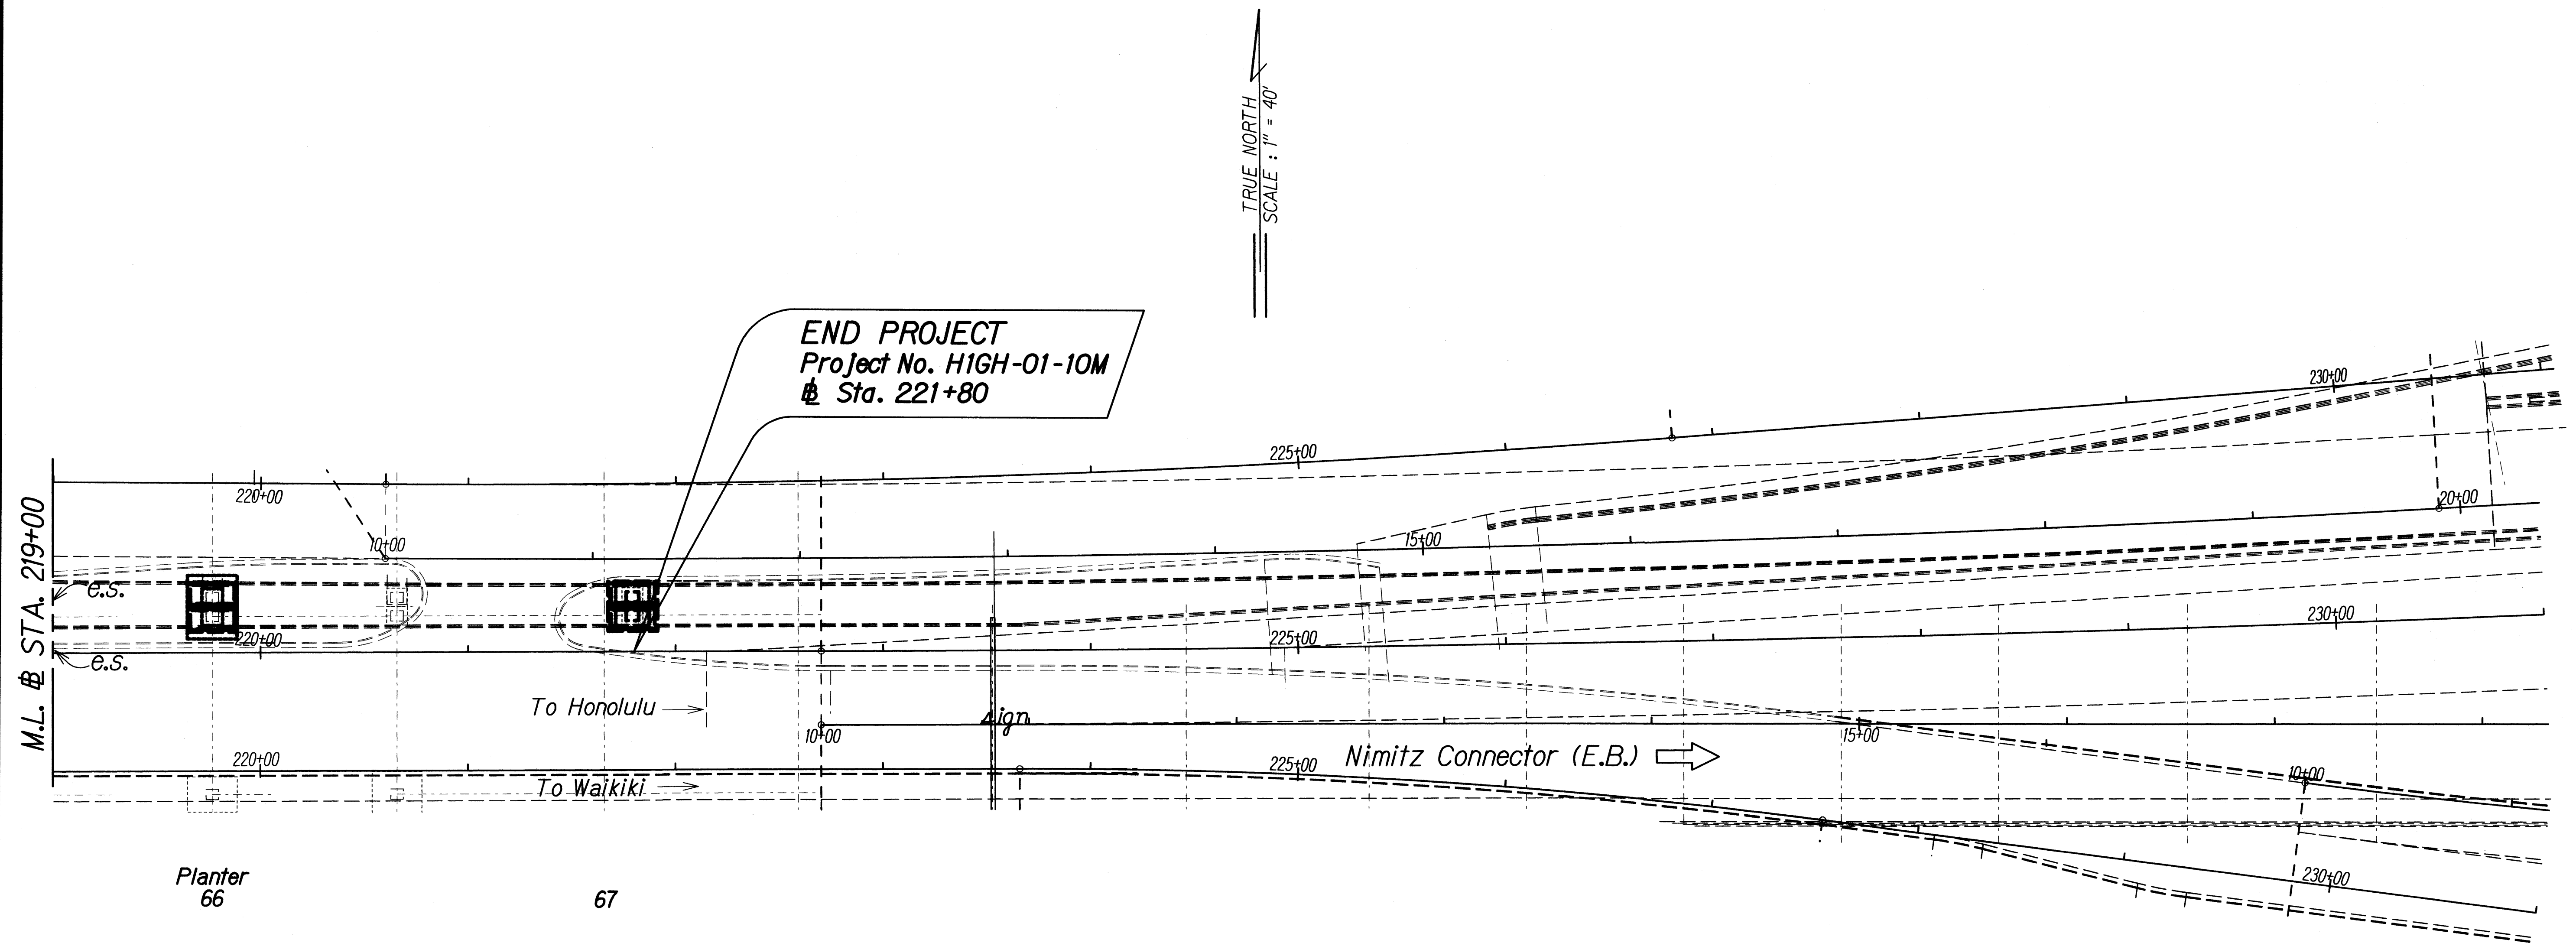

For planters 66 through 67, see sheets 11 & 13 for landscape & irrigation.

ORIGINAL PLAN	SURVEY PLOTTED BY	DATE
NOTE BOOK	DRAWN BY	
	DESIGNED BY	
	QUANTITIES BY	
	CHECKED BY	

STATE OF HAWAII
DEPARTMENT OF TRANSPORTATION
HIGHWAYS DIVISION

LANDSCAPE PLANS

INTERSTATE ROUTE H-1 LANDSCAPING
Valkenburgh Street to Dillingham Ramp
Project No. HIGH-01-10M

Scale: 1" = 40' Date: Oct, 2009

SHEET No. 6 OF 6 SHEETS