

INDEX TO DRAWINGS	
SHEET NO.	DESCRIPTION
1	TITLE SHEET
2	GENERAL NOTES & LEGEND
3 - 4	WATER POLLUTION & EROSION CONTROL NOTES
5 - 10	LANDSCAPE PLANS
11	PLANTING NOTES & TYPICAL DETAILS
12	IRRIGATION DETAIL
13	IRRIGATION NOTES & TYPICAL DETAIL

STATE OF HAWAII

DEPARTMENT OF TRANSPORTATION

HIGHWAYS DIVISION

HONOLULU, HAWAII

"AS-BUILT"

PLANS FOR



INTERSTATE ROUTE H-1 LANDSCAPING

VALKENBURGH STREET TO DILLINGHAM RAMP

PROJECT NO. H1GH-01-10M

DISTRICT OF HONOLULU

ISLAND OF OAHU

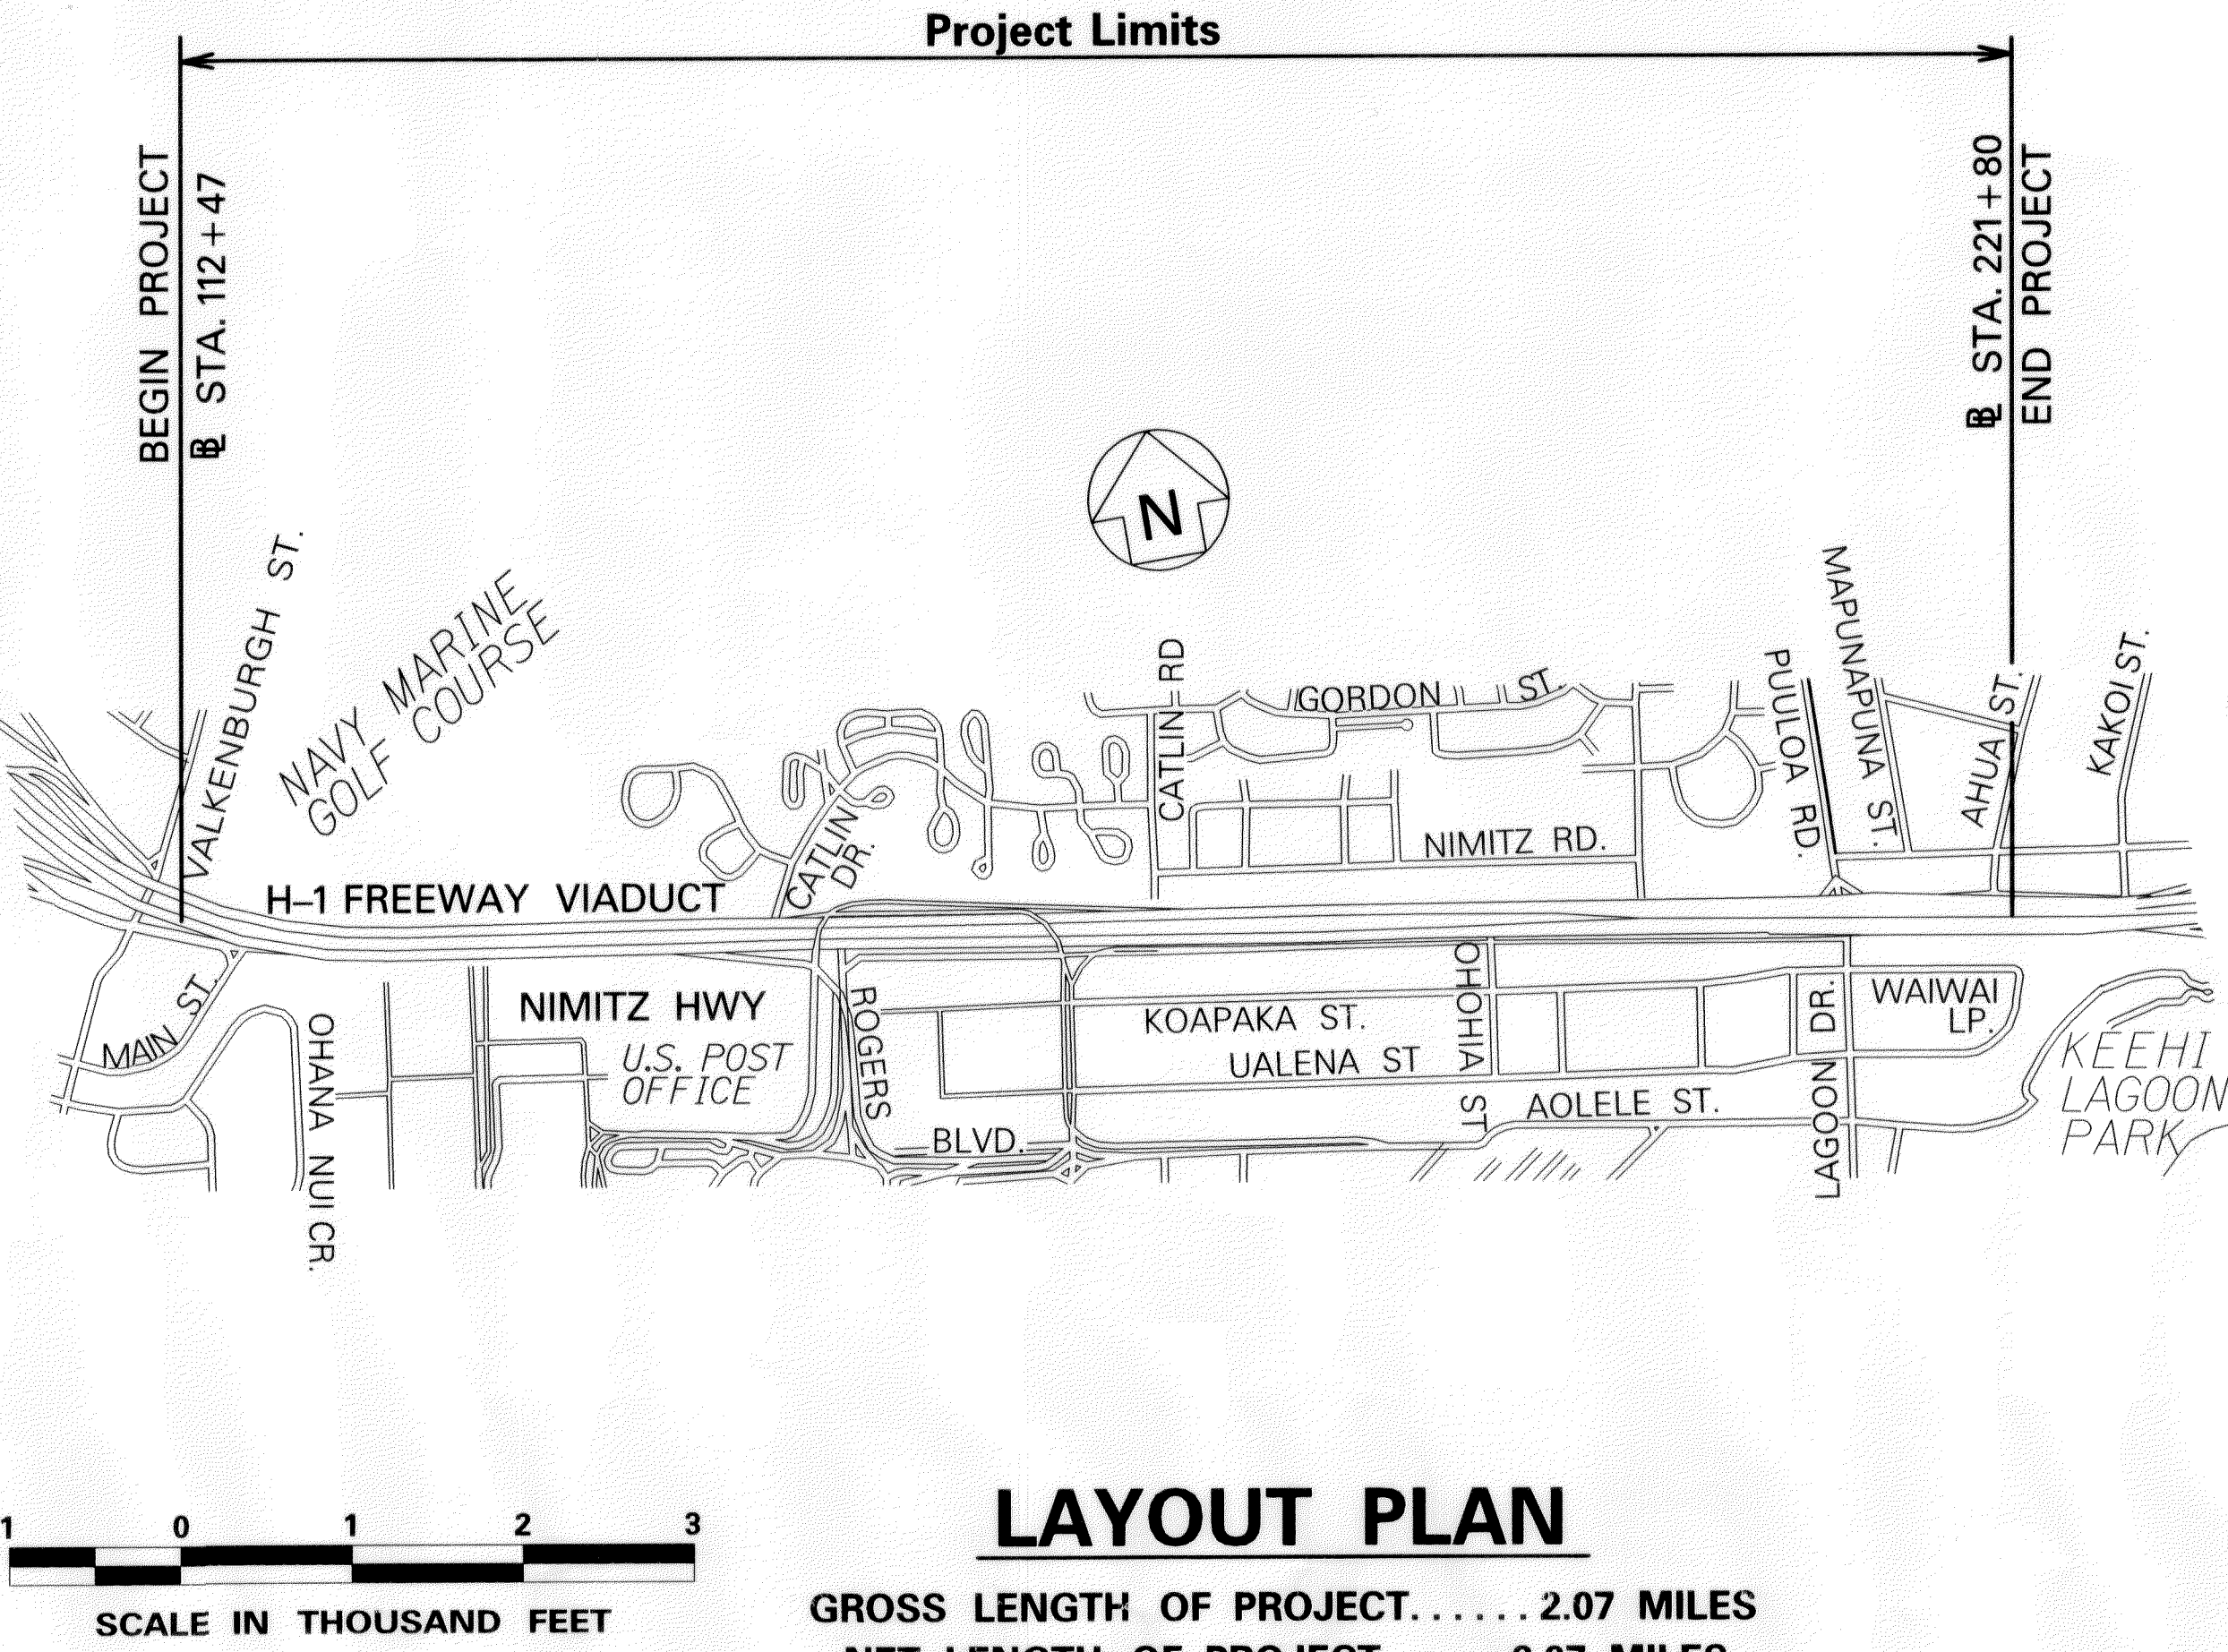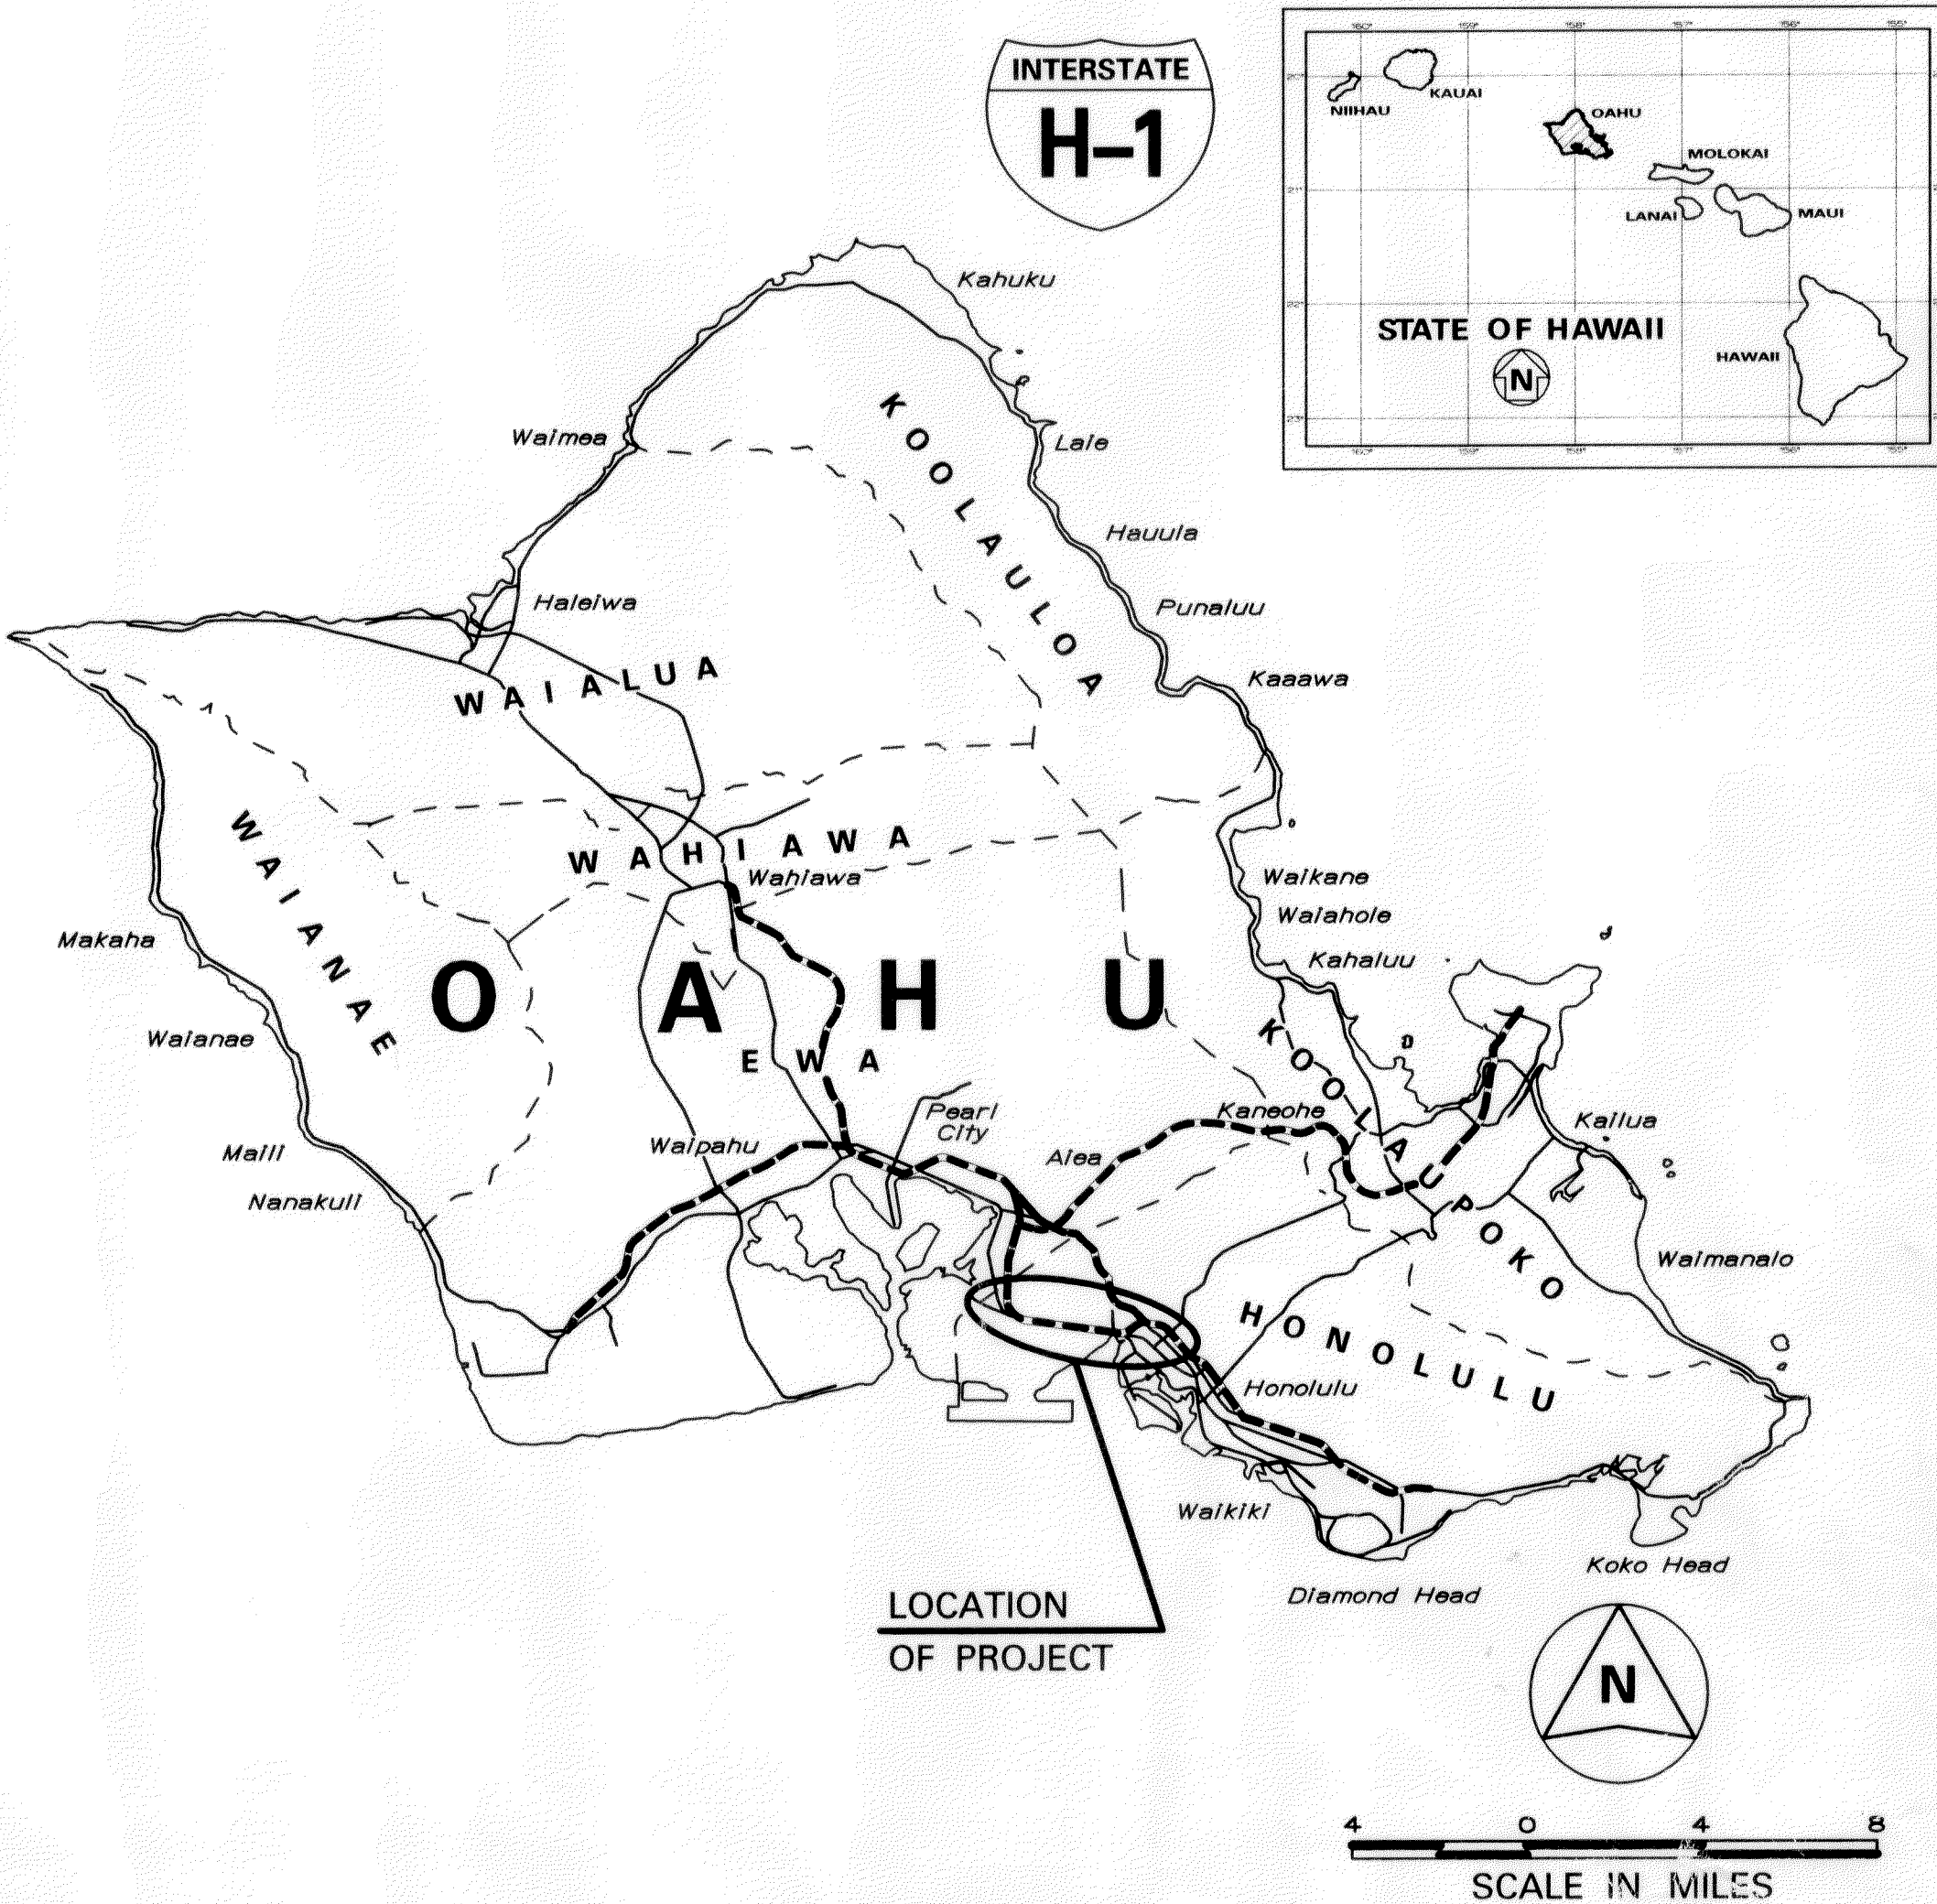

----- FEDERAL AID INTERSTATE PROJECTS PREVIOUSLY
CONSTRUCTED OR UNDER CONSTRUCTION

MILE POST 15.72 TO MILE POST 17.79

CHANGES MADE DURING CONSTRUCTION HAVE BEEN
INCORPORATED ON THESE PLANS EXCEPT CHANGES
IN THE ORIGINAL THEORETICAL QUANTITIES. FOR
ACTUAL QUANTITIES, REFER TO PROJECT LEDGER
AND/OR COMPUTATION BOOK.

Mauro J. Lopez 7-19-2013
RESIDENT ENGINEER DATE

DEPARTMENT OF TRANSPORTATION
STATE OF HAWAII

APPROVED:
Scott M. M. M. JAN 12 2010
DIR. OF TRANSPORTATION DATE

DESIGNED BY
MANAGED BY
HWY-DL
PHONE 692-8363
DATE OCT 2009

LAYOUT PLAN

GROSS LENGTH OF PROJECT.....2.07 MILES

NET LENGTH OF PROJECT.....2.07 MILES