

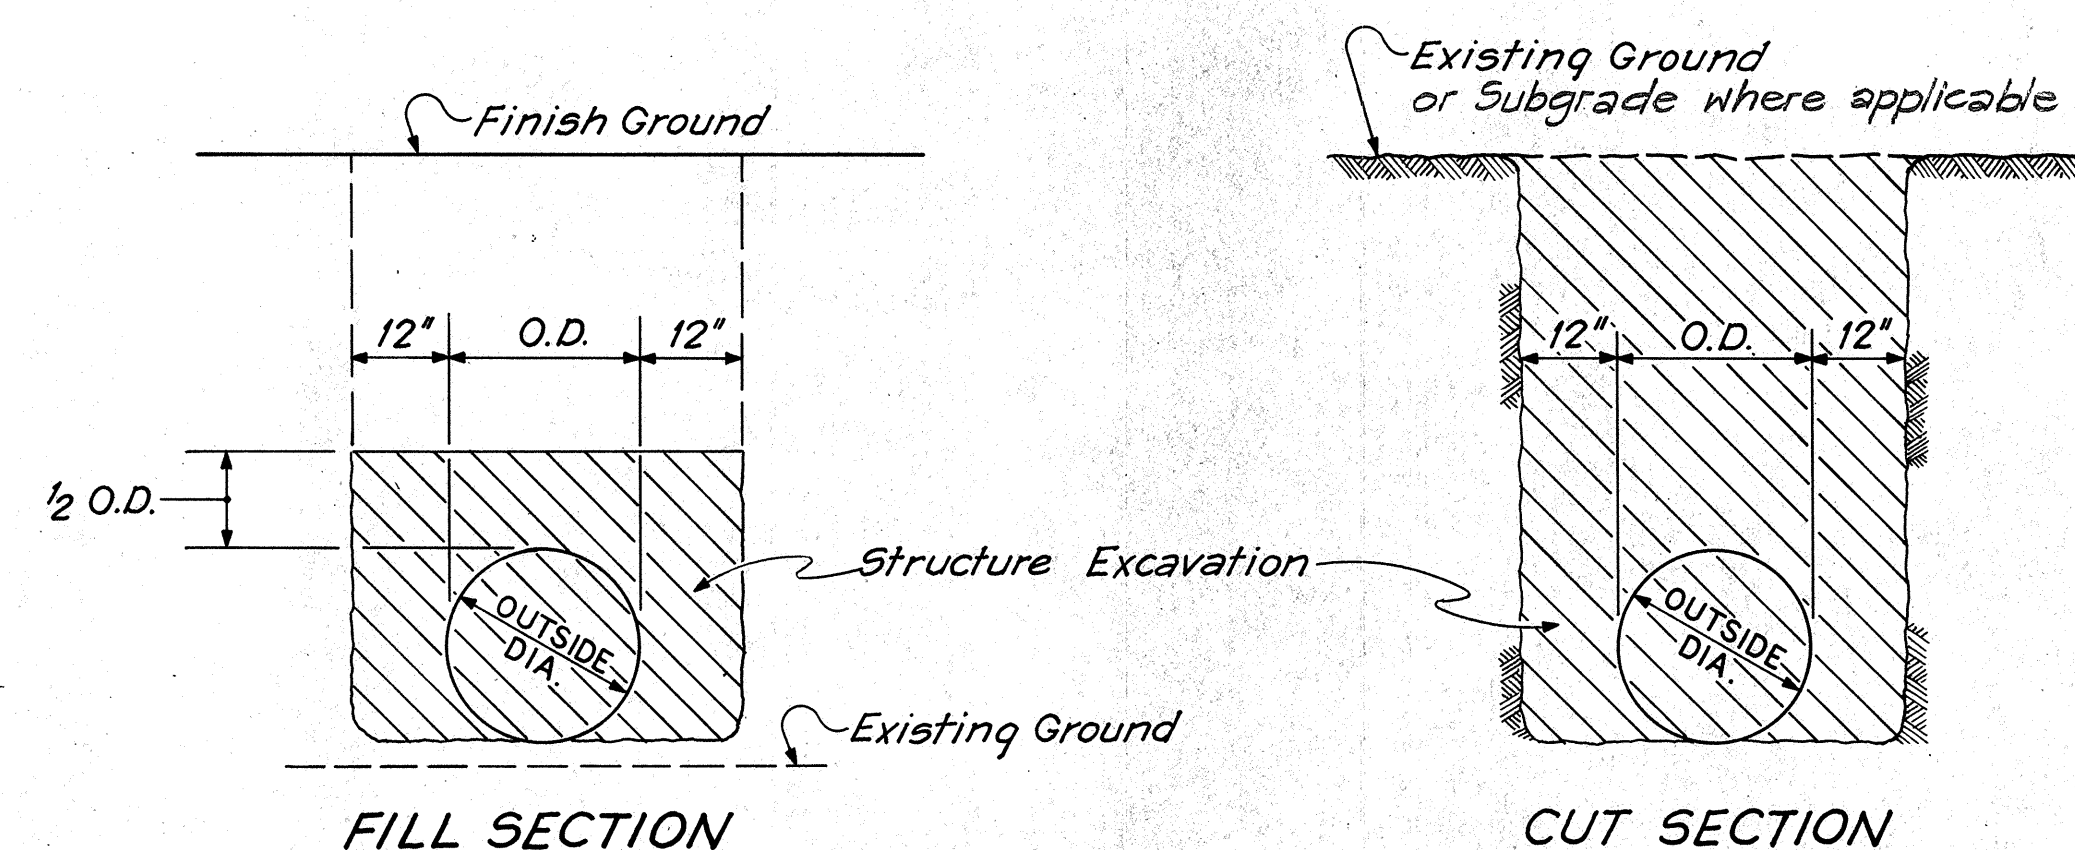
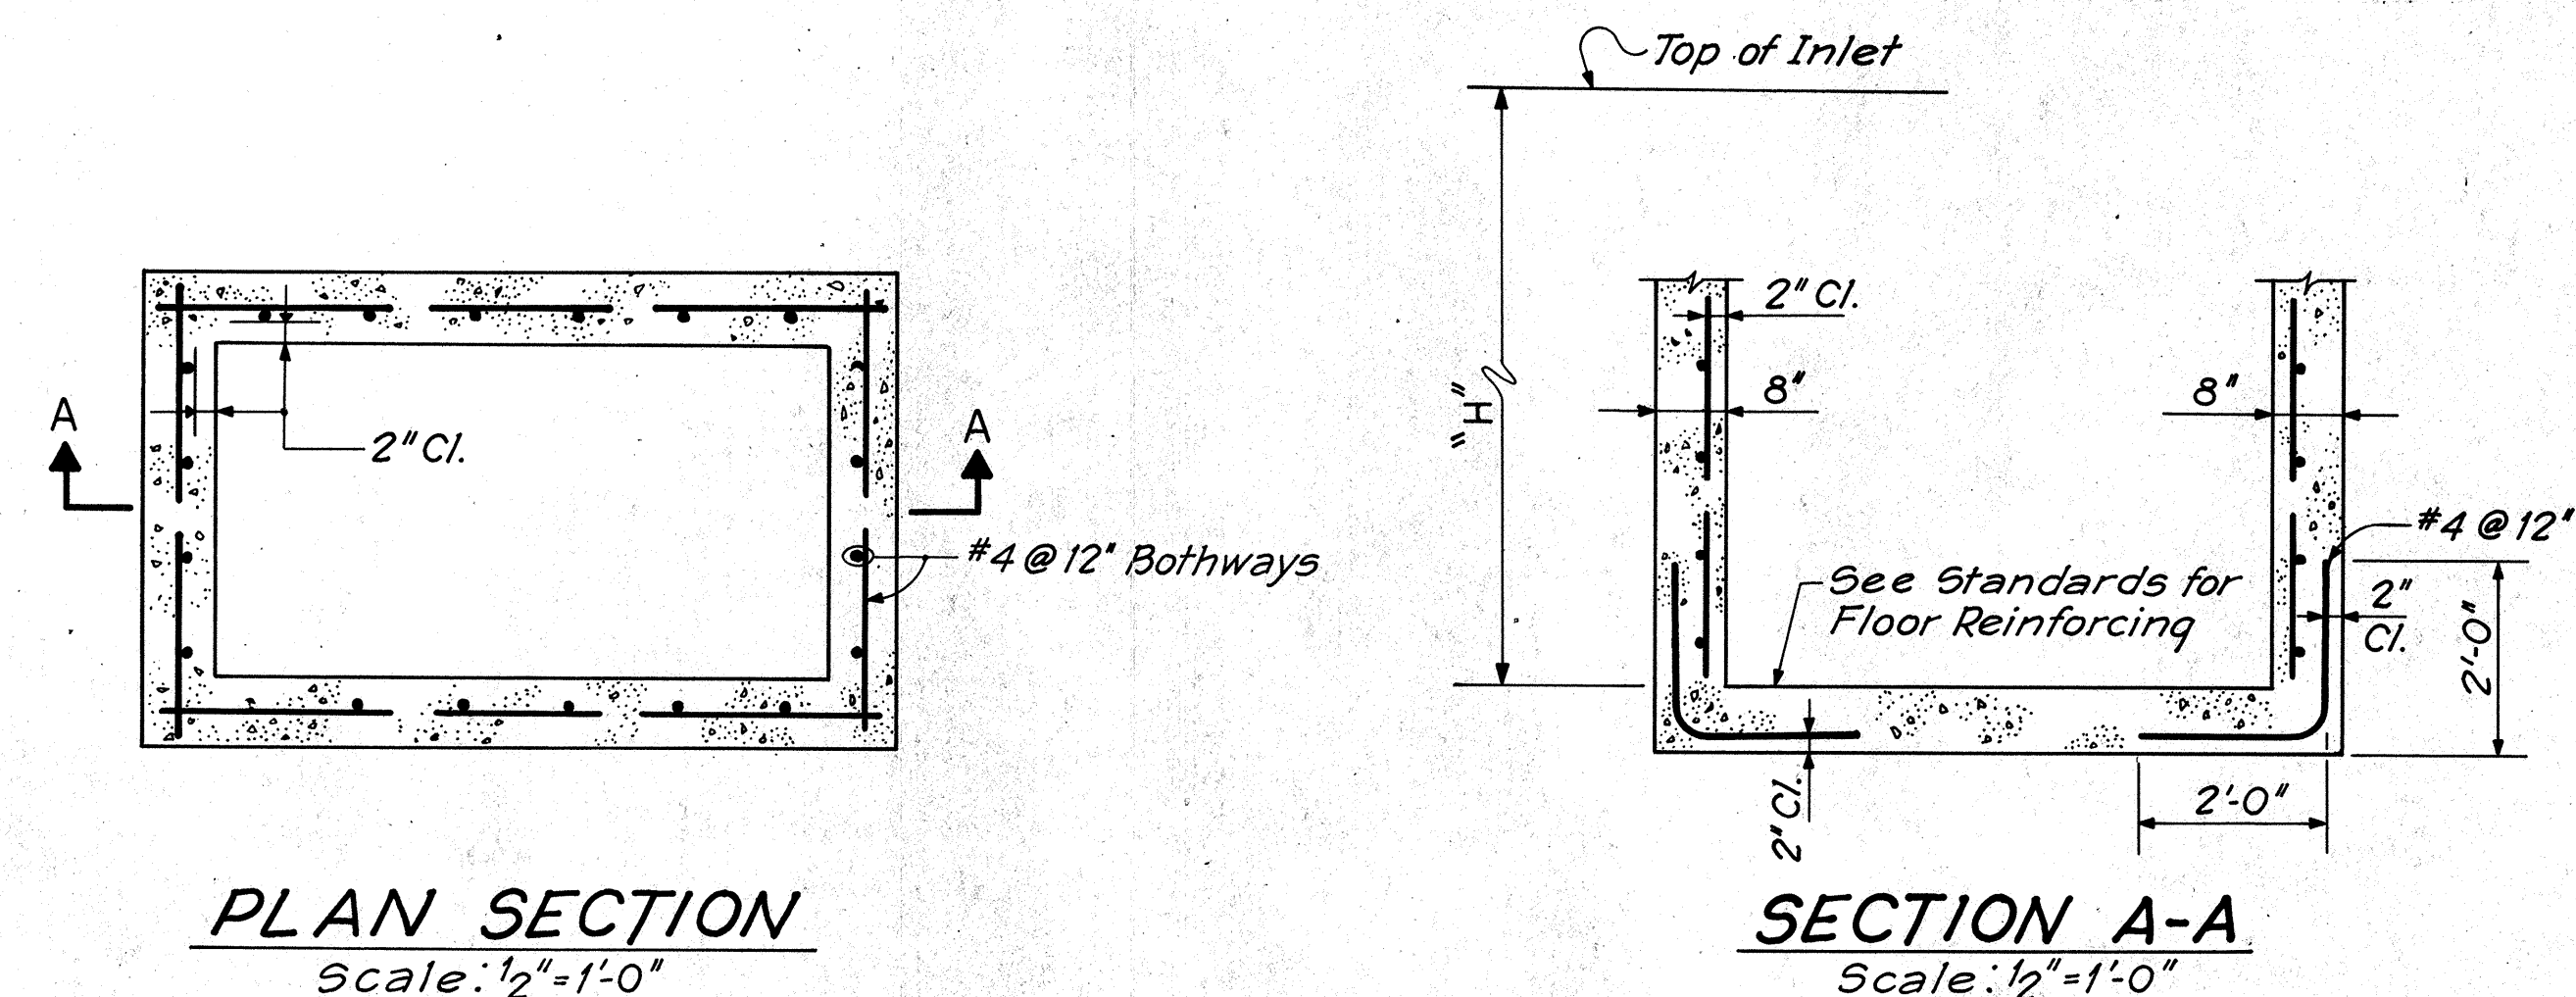
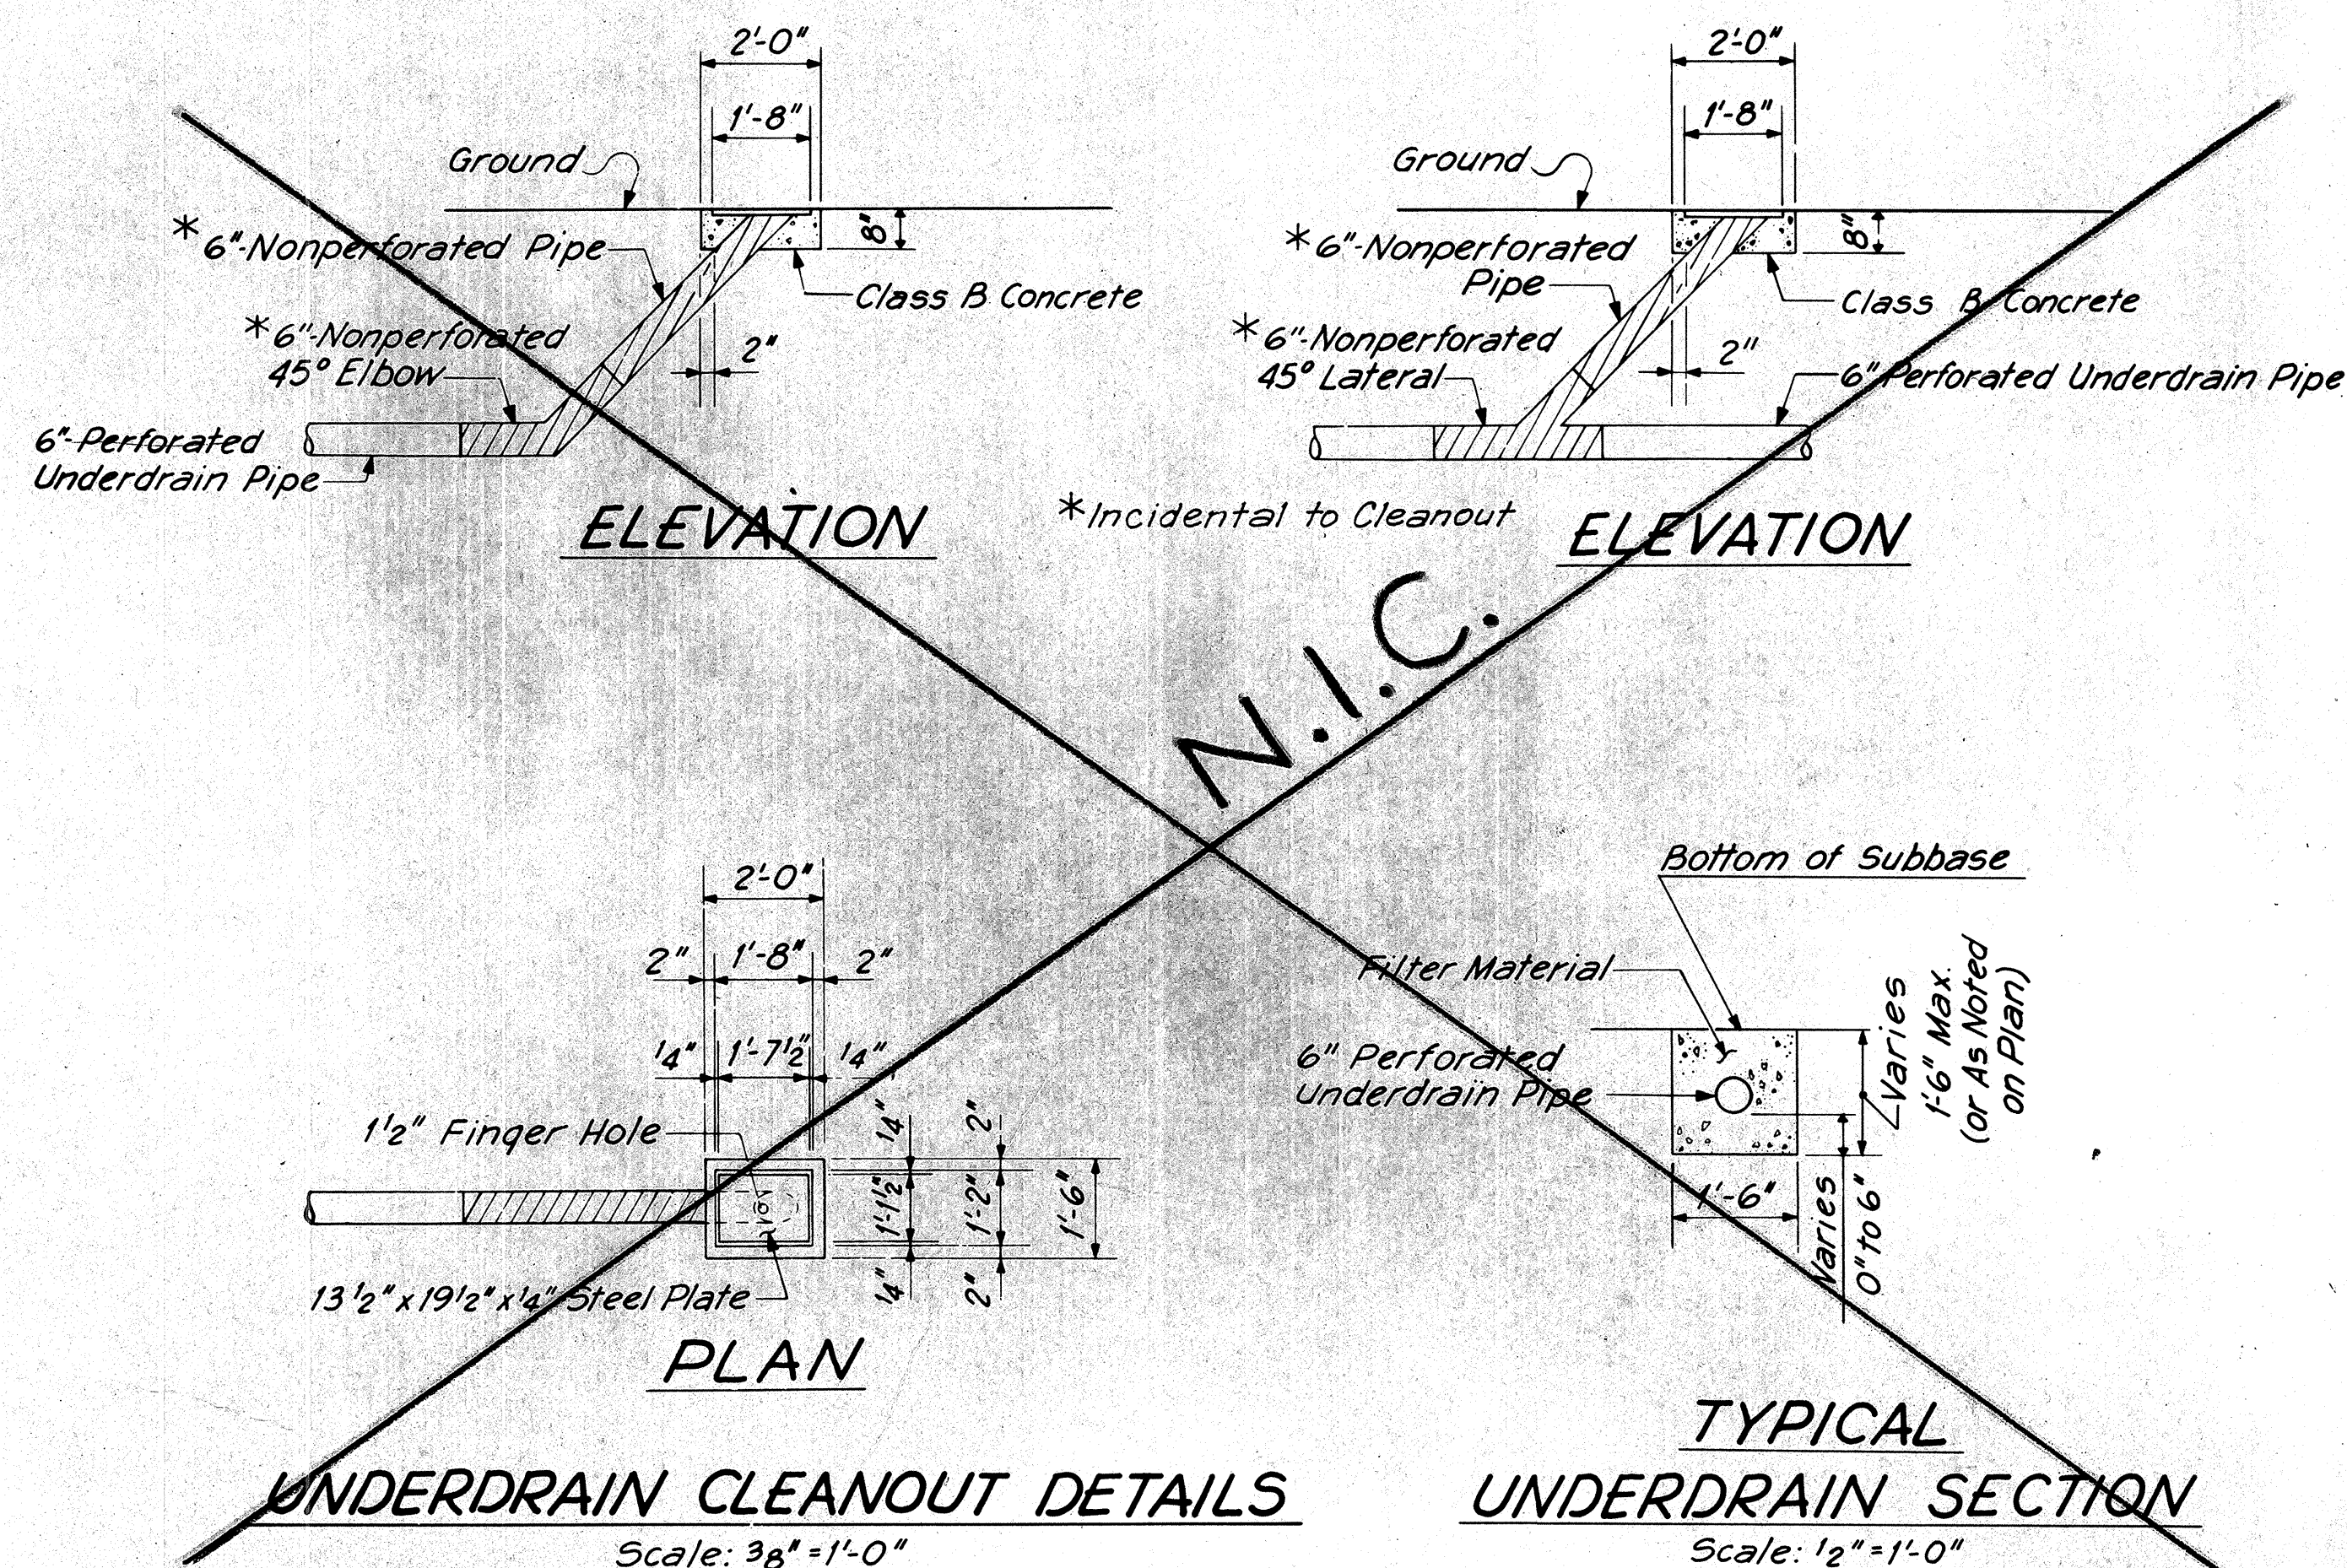
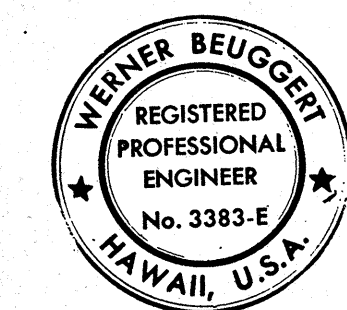


FED. ROAD DIST. NO.	STATE	FED. AID PROJ. NO.	FISCAL YEAR	SHEET NO.	TOTAL SHEETS
HAWAII	HAW.	I-H11(130):17	1976	10	174

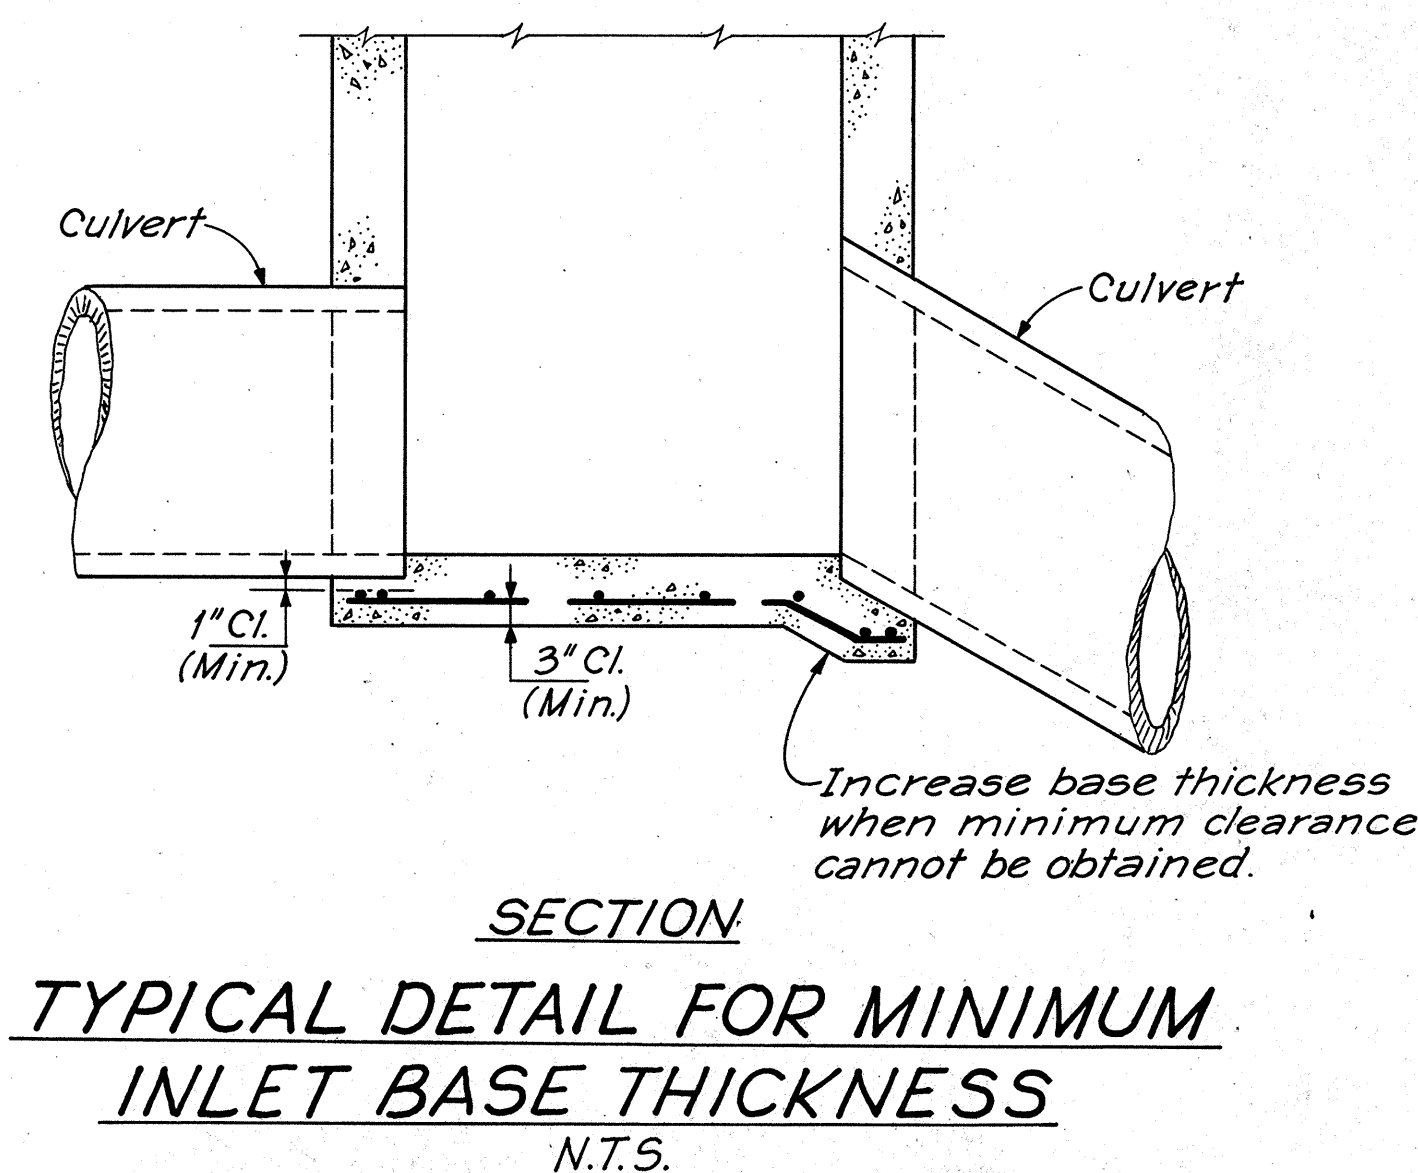

TRENCH EXCAVATION PAY LIMIT
N.T.S.

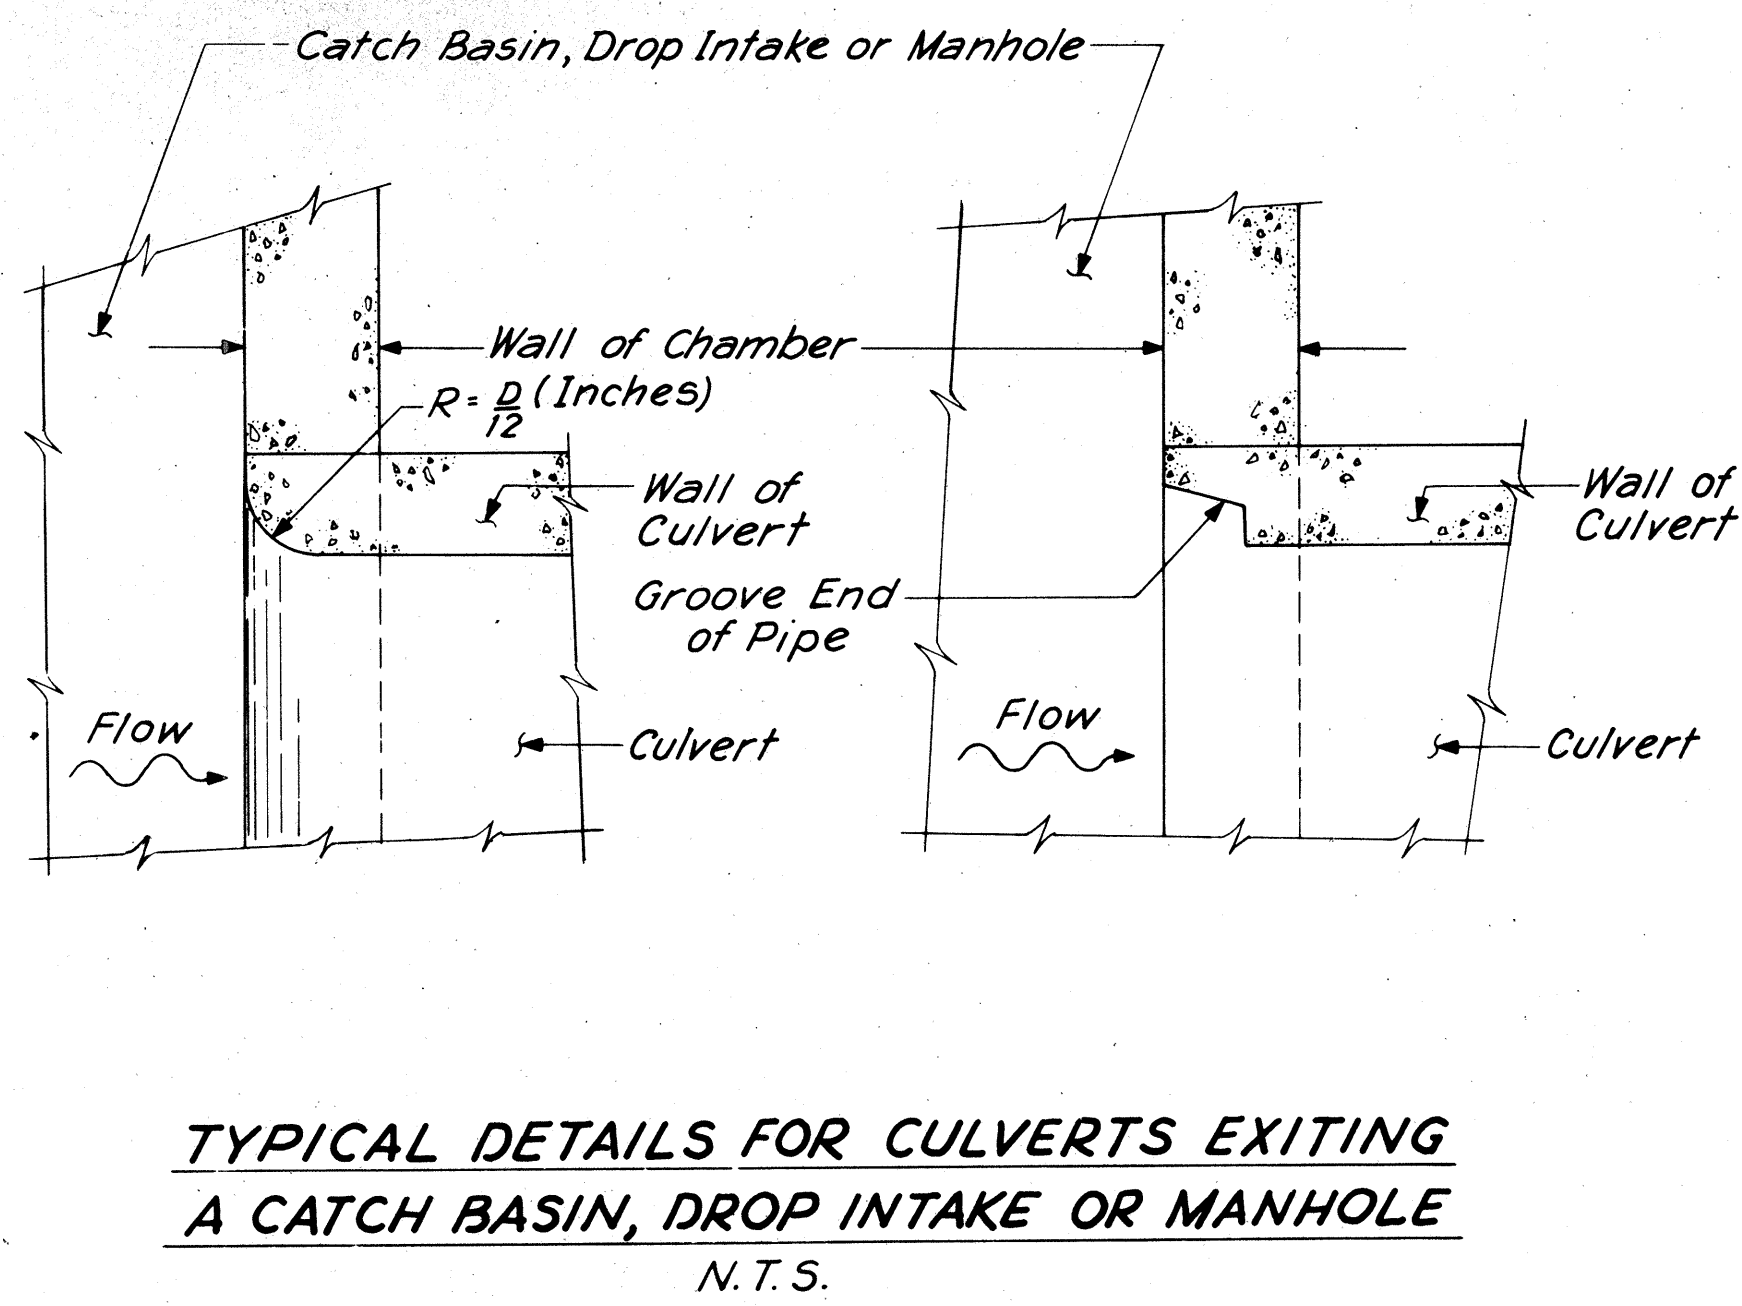

THIS WORK WAS PREPARED BY ME
OR UNDER MY SUPERVISION.
Werner Beuggert

STATE OF HAWAII
DEPARTMENT OF TRANSPORTATION
HIGHWAYS DIVISION

DRAINAGE DETAILS

INTERSTATE ROUTE H-1
PROJECT NO. I-H1-1(130):17
SCALE: AS SHOWN DATE: AUG. 16, 1976
SHEET NO. 2 OF 4 SHEETS

