

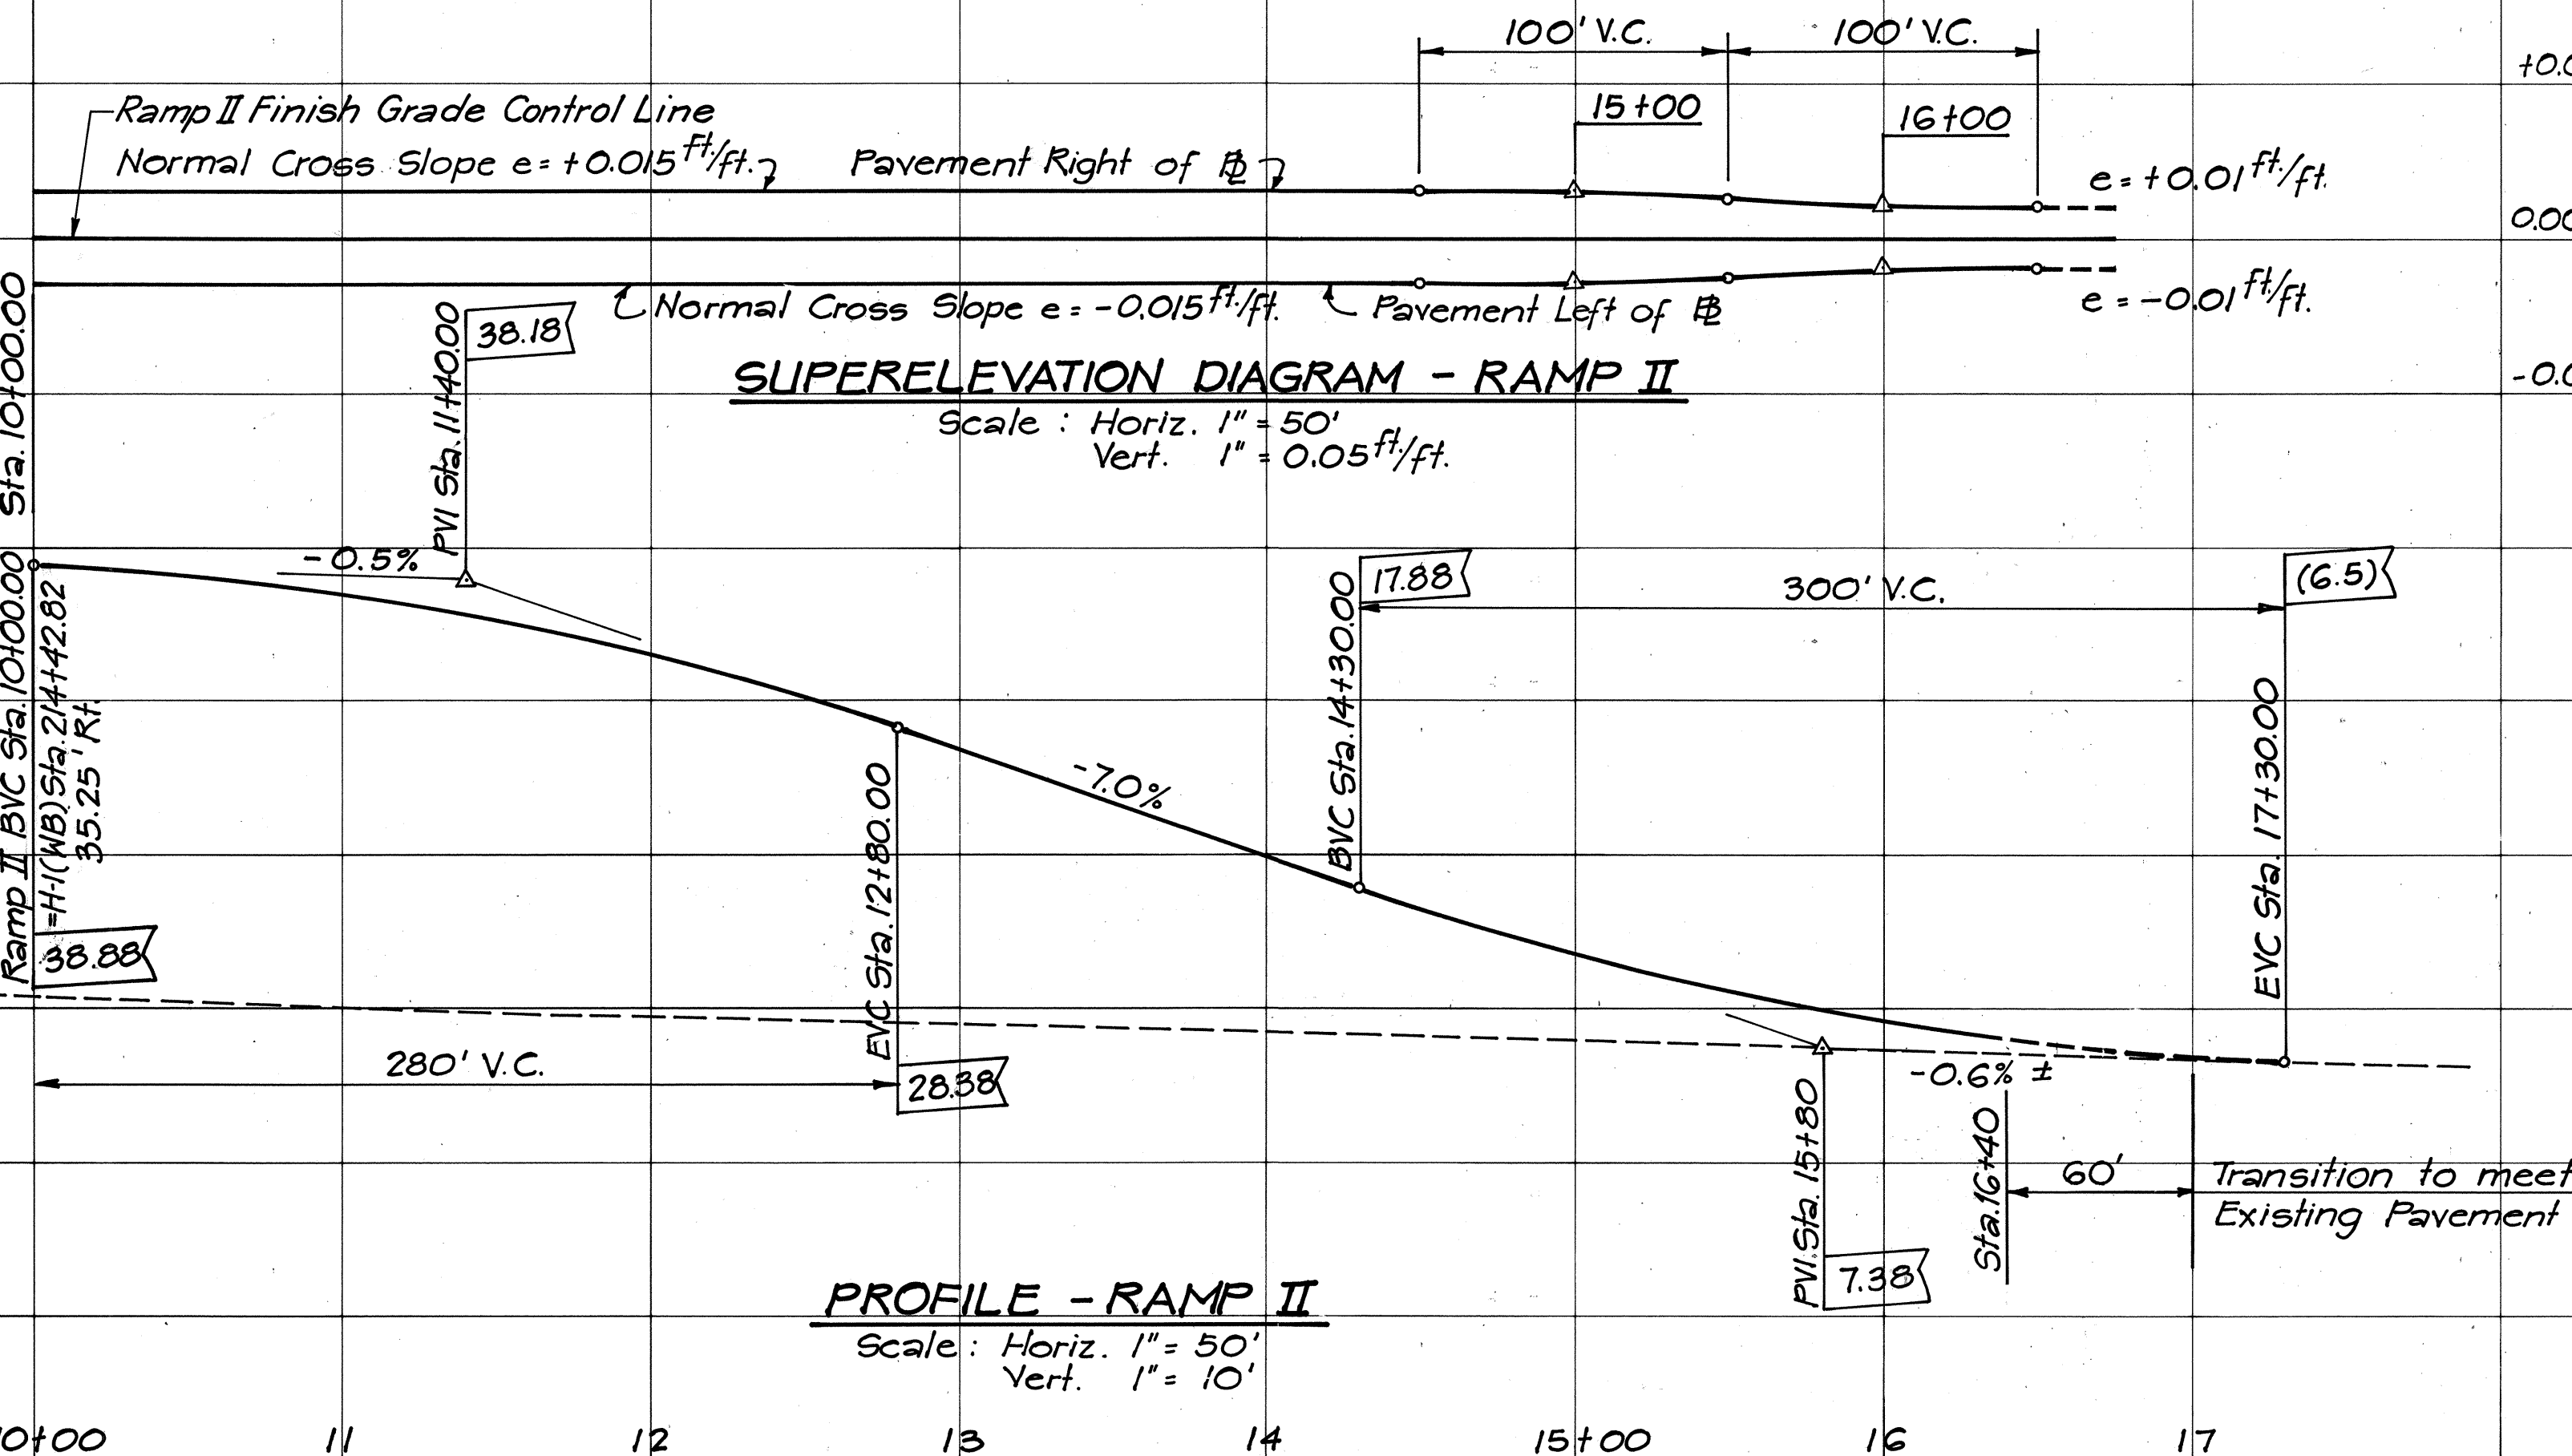
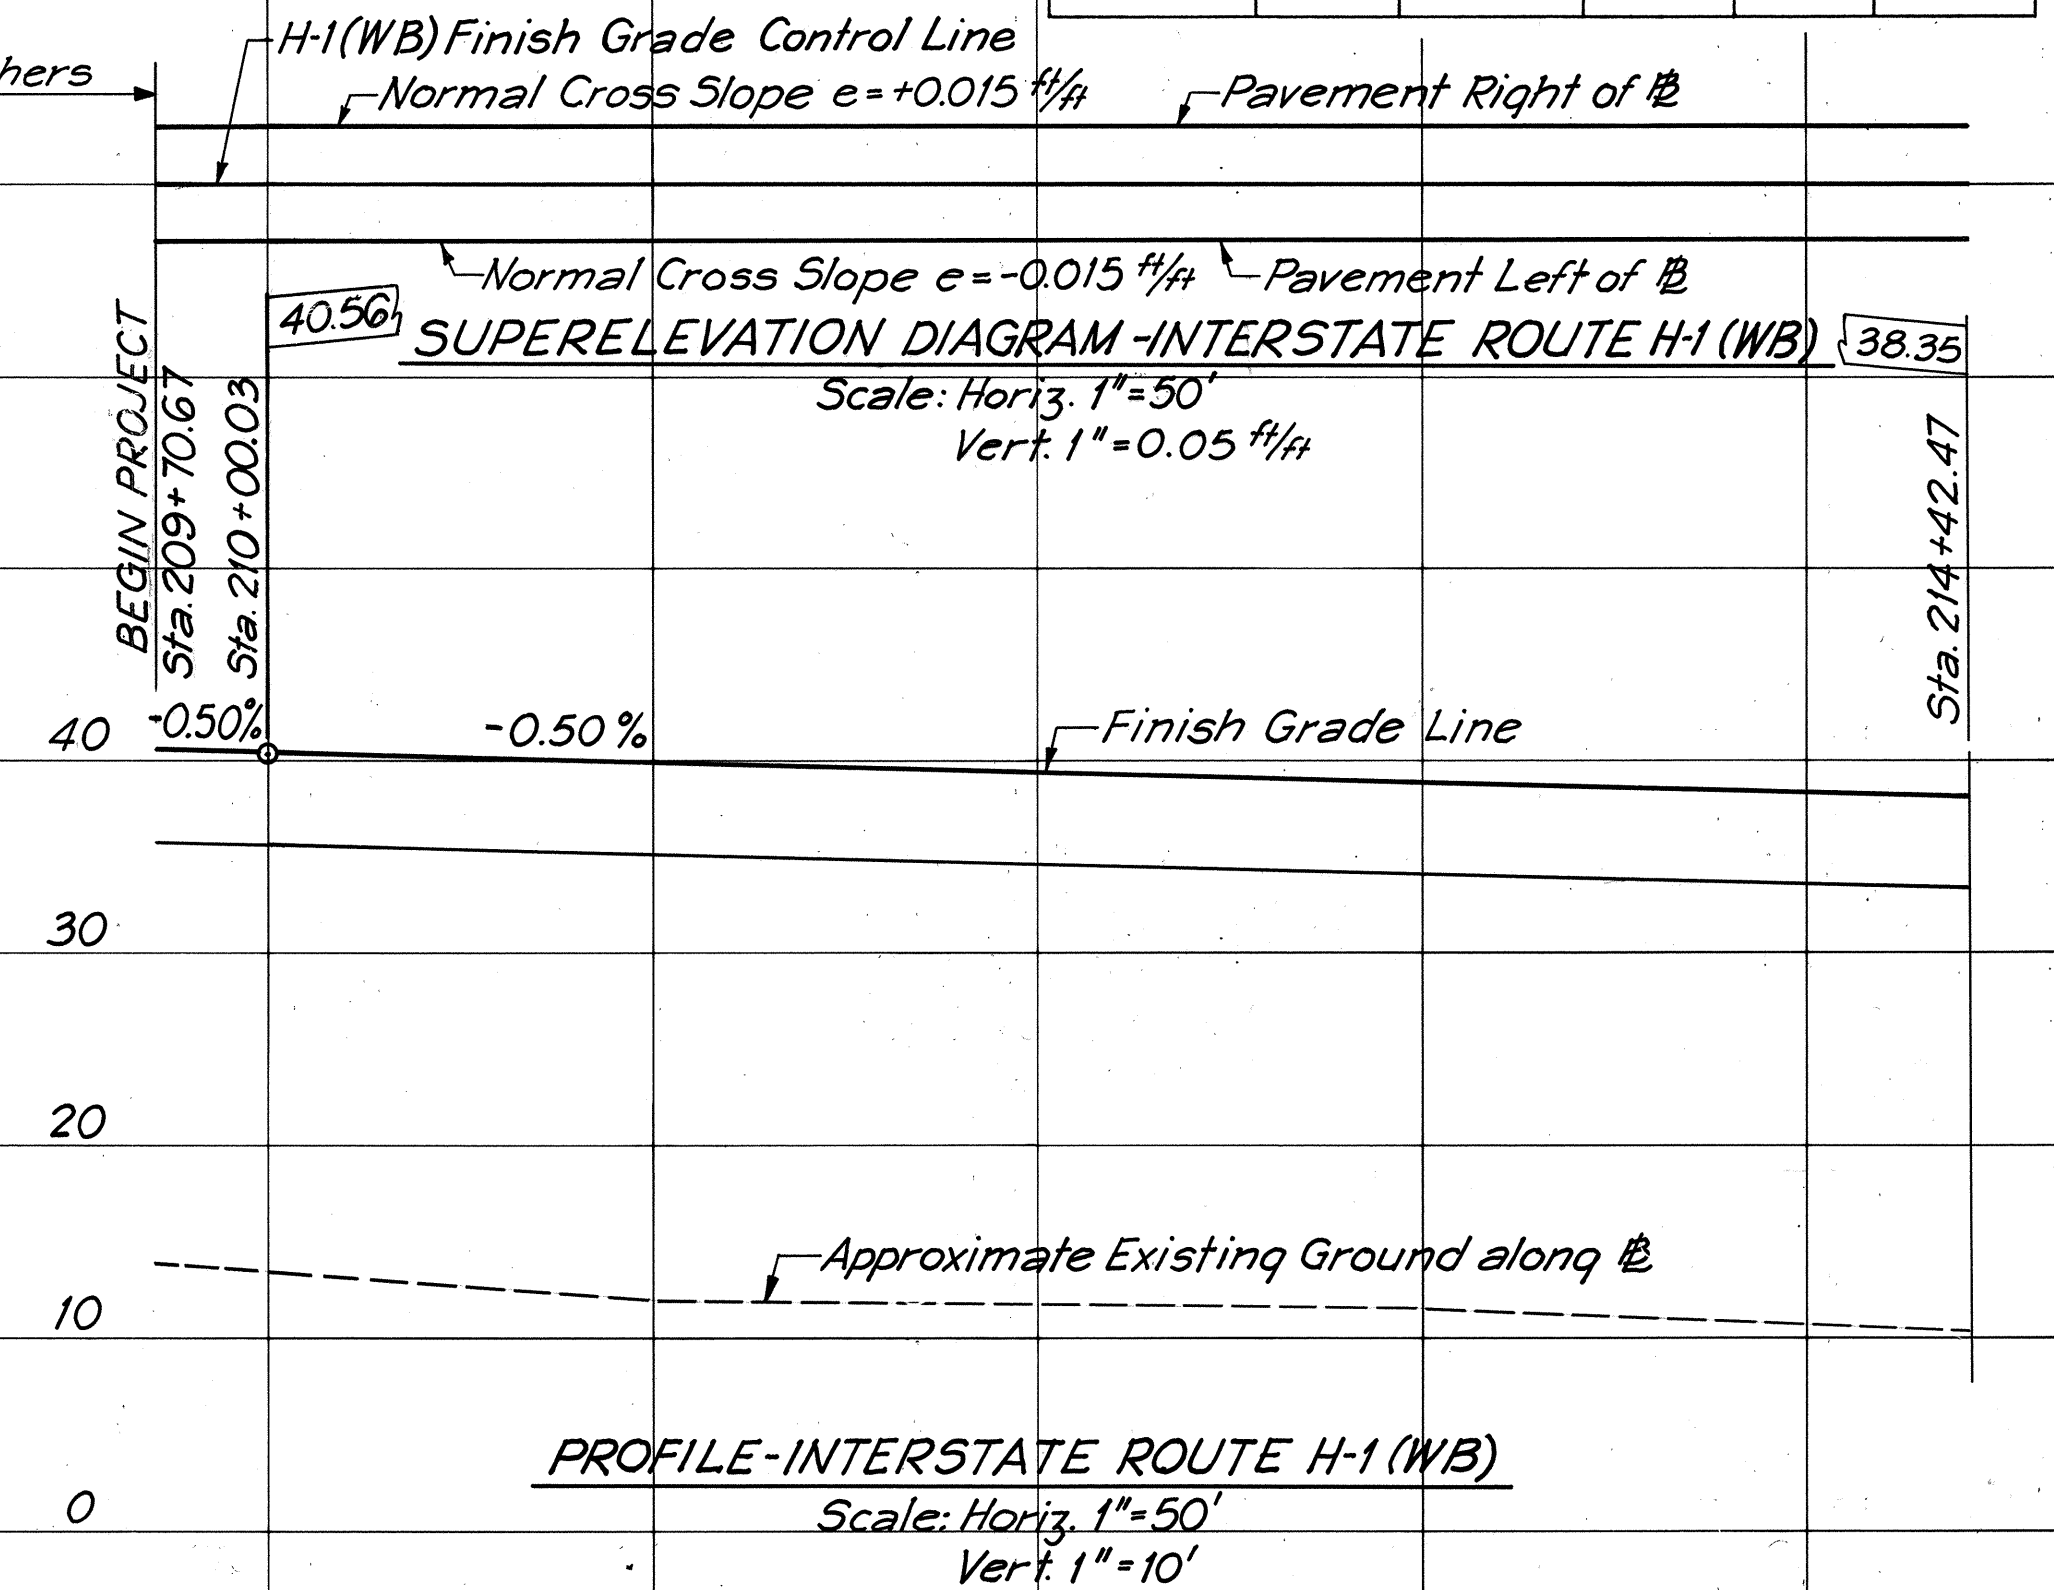


FED. ROAD DIST. NO.	STATE	FED. AID PROJ. NO.	FISCAL YEAR	SHEET NO.	TOTAL SHEETS
HAWAII	HAW.	I-HI-1(130):17	1976	8	174

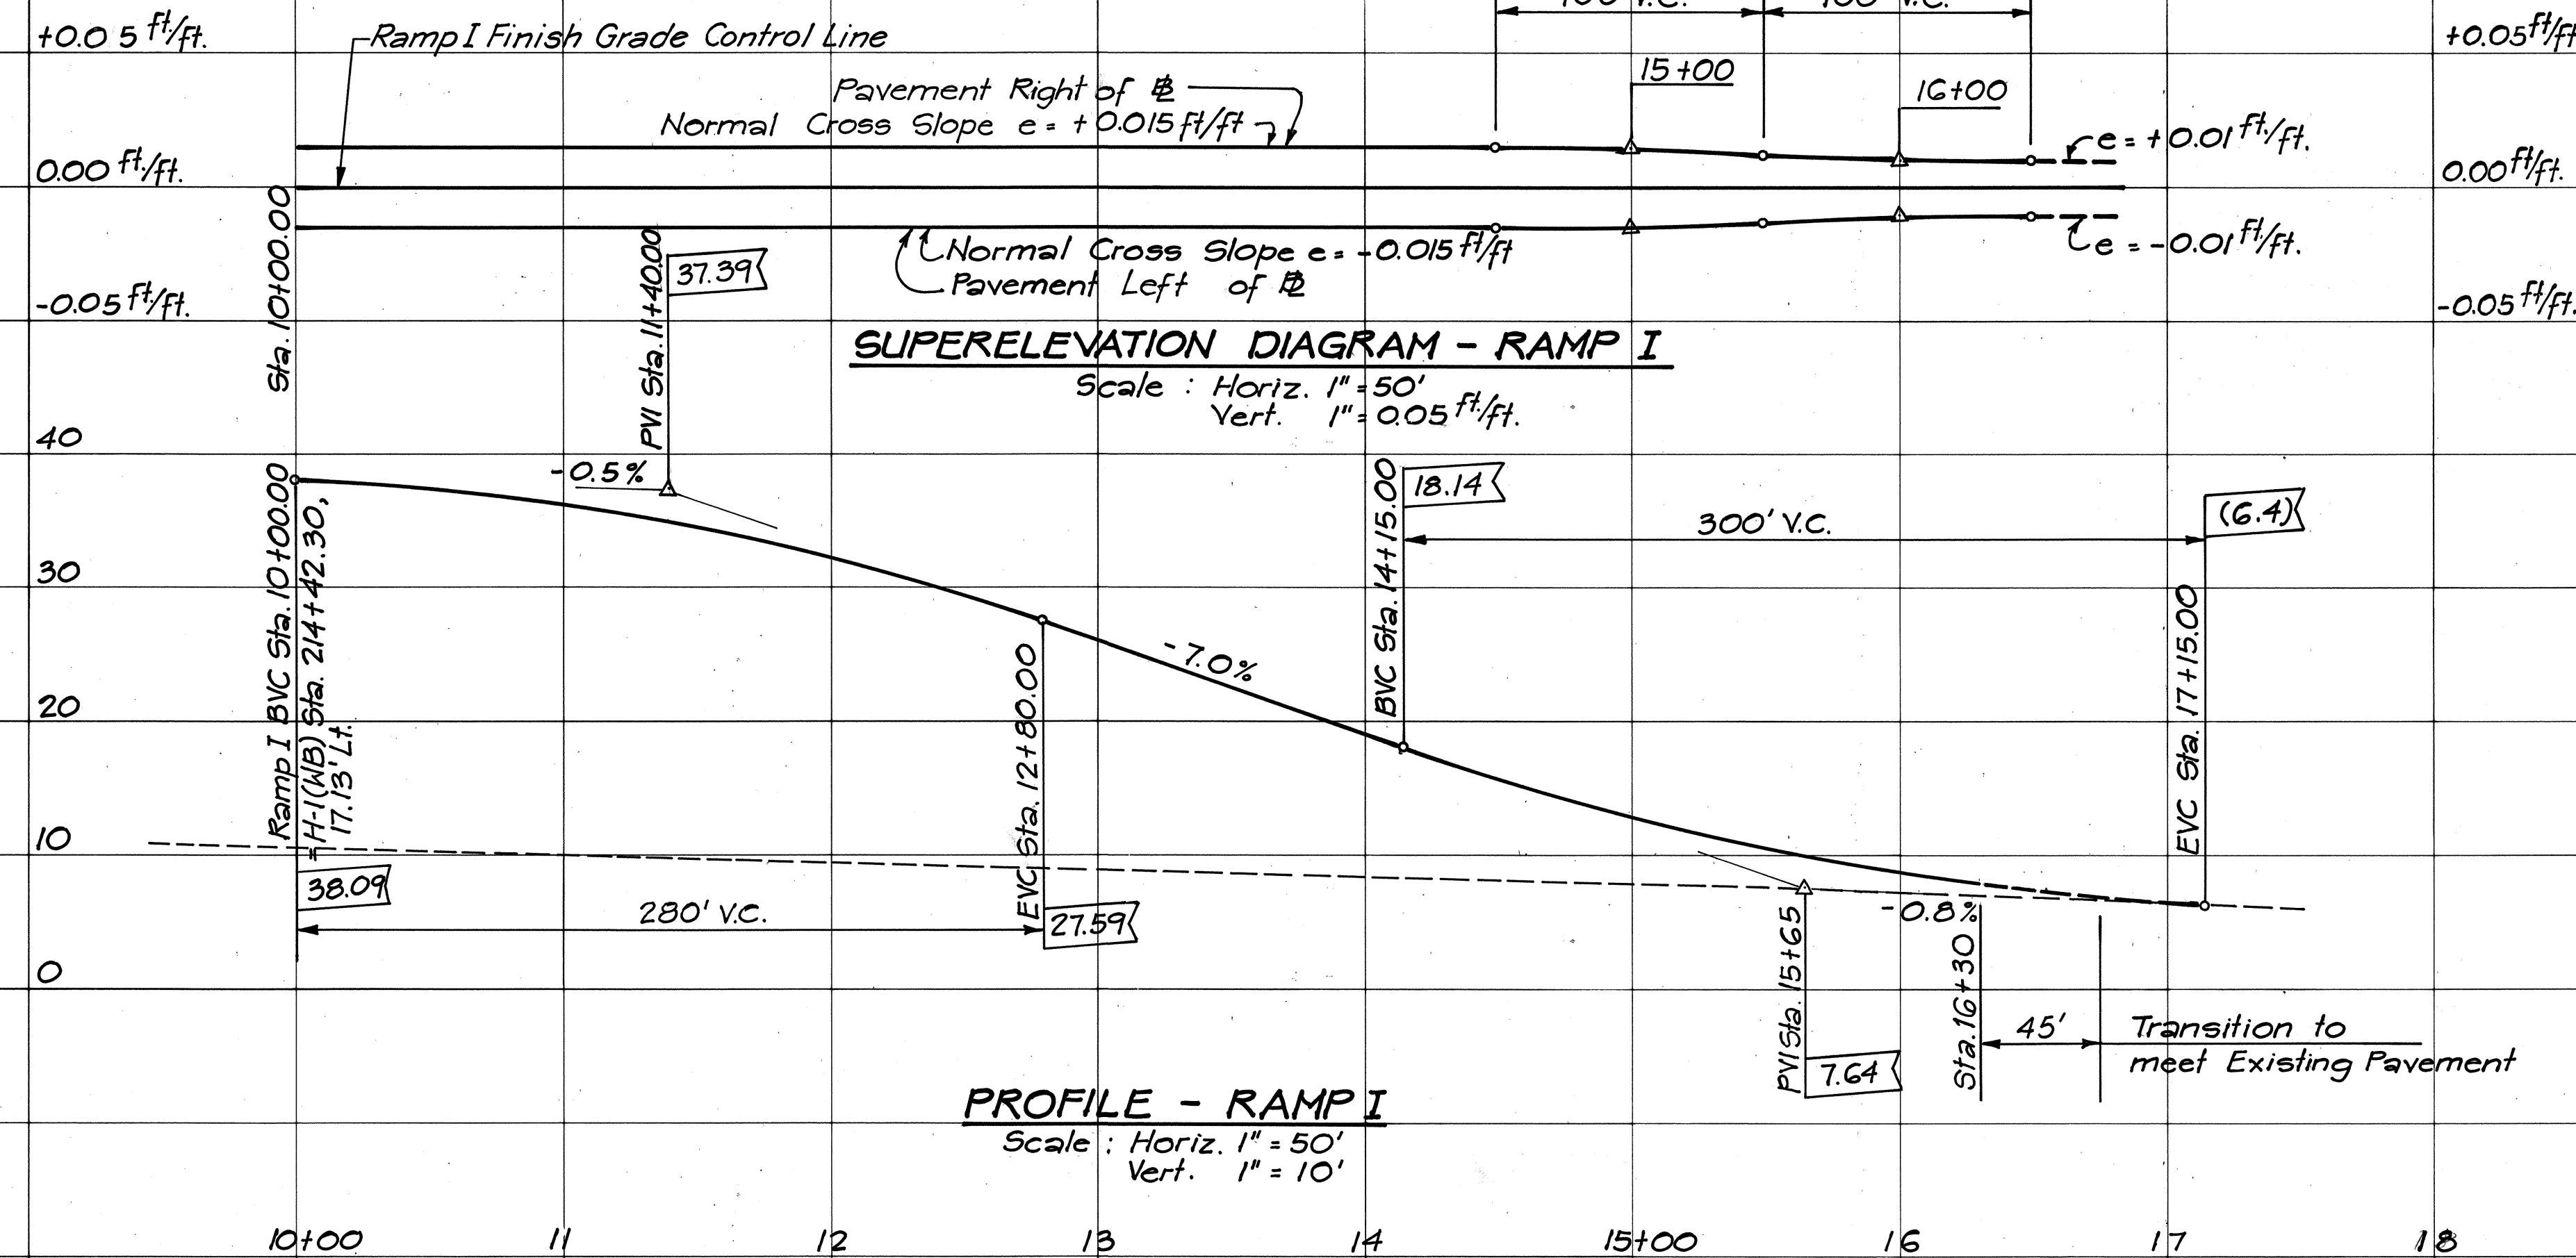

DATE	_____
DESIGNED BY	_____
TRACED BY	_____
NOTED BY	_____
CHECKED BY	_____

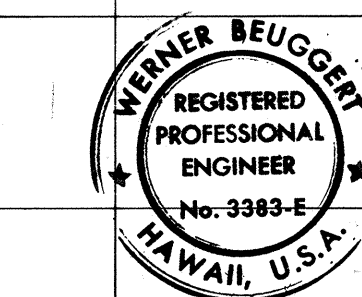

THIS WORK WAS PREPARED BY ME
OR UNDER MY SUPERVISION.

Werner Beuggert

STATE OF HAWAII
DEPARTMENT OF TRANSPORTATION
HIGHWAYS DIVISION

ROADWAY PROFILES

INTERSTATE ROUTE H-1
PROJECT NO. I-HI-1(130):17

SCALE: AS SHOWN DATE: AUG. 16, 1976

SHEET No. 1 OF 1 SHEETS