		· · · · · · · · · · · · · · · · · · ·
>	11	NDEX TO DRAWINGS
	SHEET NO.	DESCRIPTION
	1	TITLE
	2	CONSTRUCTION PHASING
	3	TYPICAL SECTIONS
	4-7	CONSTRUCTION PLANS
	8	ROADWAY PROFILE
	9-12	DETAILS & DRAINAGE PROFILES
	13-34	STANDARD DETAILS
2	35-40	SIGNING & PAVEMENT MARKING PLANS
3	41-42	SIGNING & PAVEMENT
	43-48	OVERHEAD SIGNS T-15, T-30 & T-31
*	49-50	LAYOUT OF OVERHEAD SIGNS E-1 & E-2
4	51-56	SUPPORT OF OVERHEAD SIGNS E-1 & E-2
5	57-68	SIGNING STANDARD DETAILS
***	69-80	HIGHWAY LIGHTING & TRAFFIC SIGNALS
	81-83	UTILITIES LOCATION MAPS
	84-97	BORING LOCATION PLANS & LOGS
	98-119	VIADUCT STRUCTURE
	120-139	RAMP STRUCTURES
	140-159	TYPICAL DETAILS FOR STRUCTURES
	160-162	STRUCTURAL STANDARD DETAILS
8	163-174	CROSS SECTIONS
).29S-I (2) C.O.36S-I, C.O.39

3 C.O.4IS-I 4 C.O.53S-I 5 C.O.64S-I 6 C.O.II3S-I 7 132S-I

8 C.O. ADD 1745-1 to C.O. ADD 1745-18 THESE ARE SUPPLEMENT SHEETS

TO THE CONTRACT PLANS. NEW TOTAL = 201 SHEETS





DEPARTMENT OF TRANSPORTATION HIGHWAYS DIVISION

> HONOLULU, HAWAII "AS BUILT"


PLANS FOR CONSTRUCTION OF A PORTION OF


INTERSTATE ROUTE H-1

INTERCHANGE KEEHI

FEDERAL AID INTERSTATE PROJECT NO. I-H1-1 (130):17

DISTRICT OF HONOLULU ISLAND OF OAHU

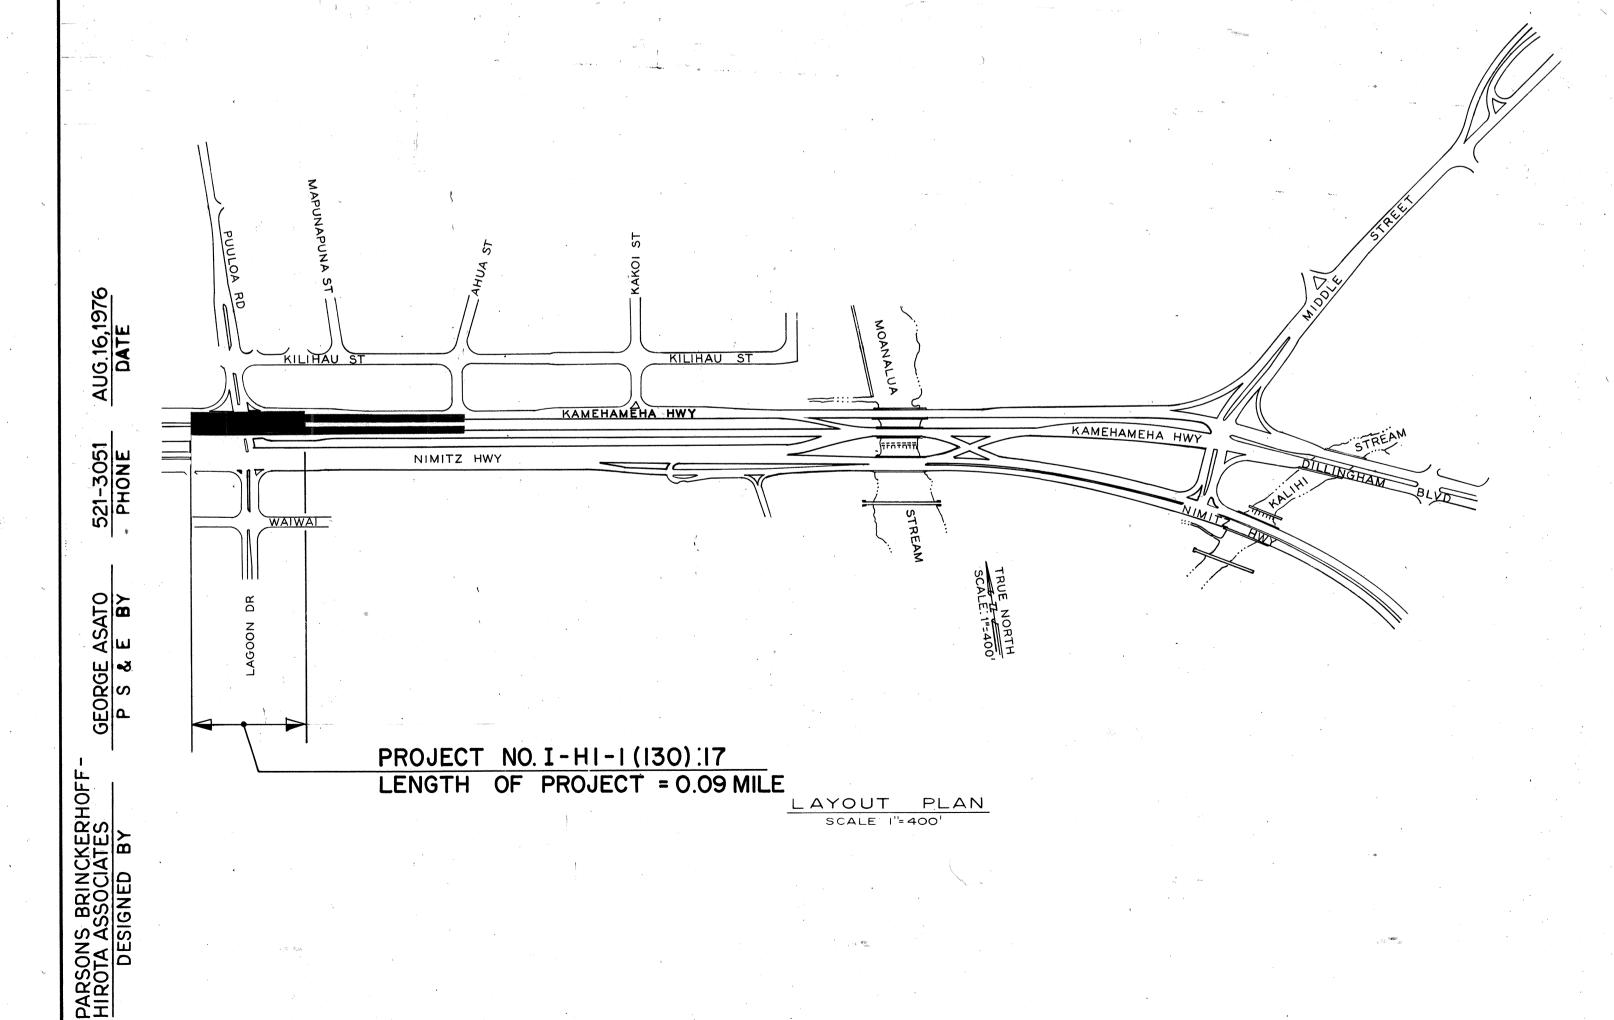

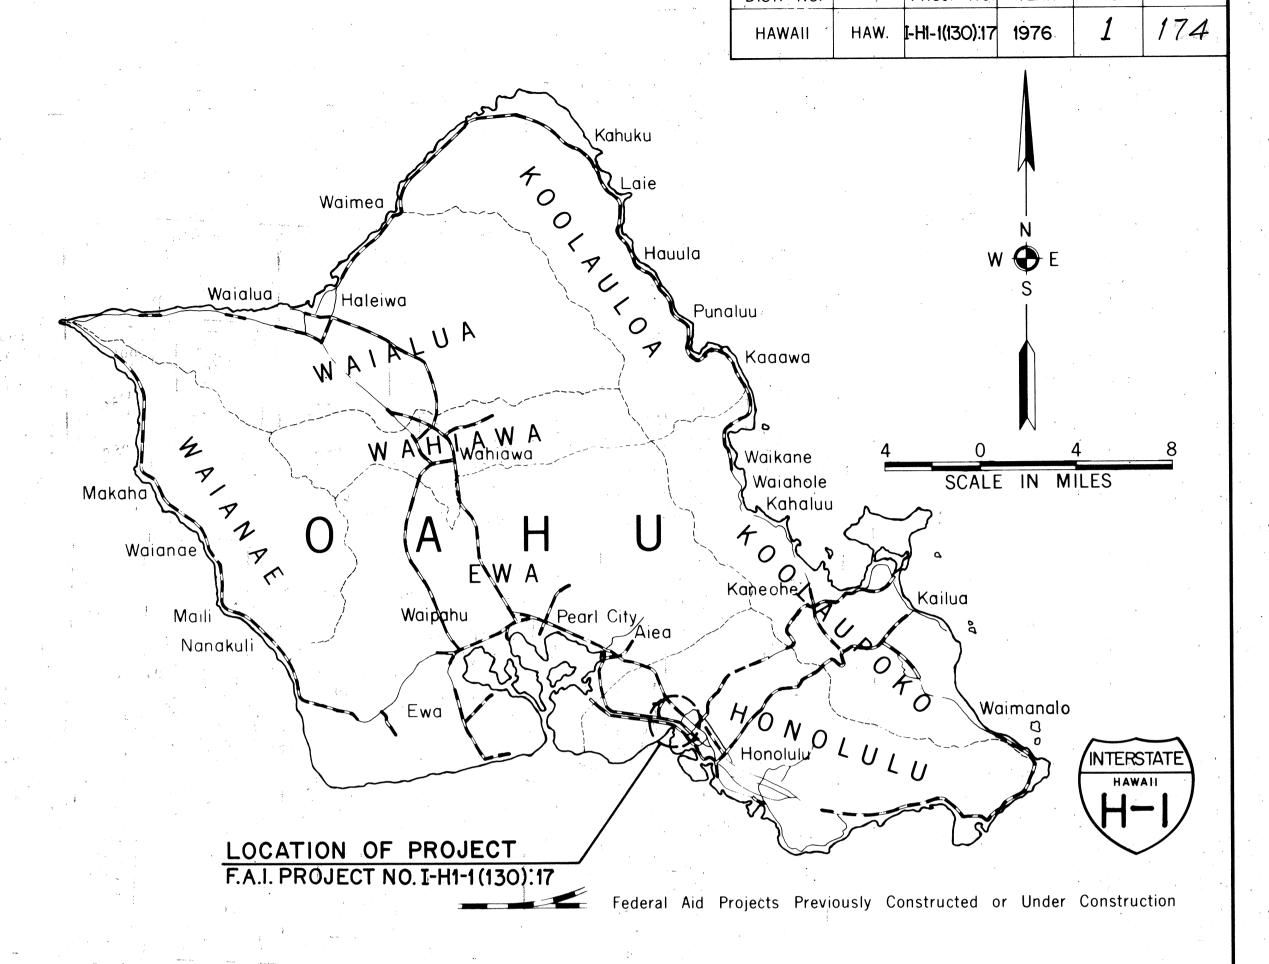

DESIGN CLASSIFICATION

DESIGN ADT (1994)_____98,000 DHV_____10,800

> CHANGES MADE DURING CONSTRUCTION HAVE BEEN INCORPORATED ON THESE PLANS EXCEPT CHANGES IN THE ORIGINAL THEORETICAL QUANTITIES, FOR ACTUAL QUANTITIES, REFER TO PROJECT LEDGER AND/OR COMPUTATION BOOK



DEPARTMENT OF TRANSPORTATION FEDERAL HIGHWAY ADMINISTRATION 9.24.76 DIVISION ADMINISTRATOR DATE

DEPARTMENT OF TRANSPORTATION			
STATE OF HAWAII			
APPROVED:			
<u>coswanson</u>	9/24/16		
acting OF TRANSPORTATION	DATE		