
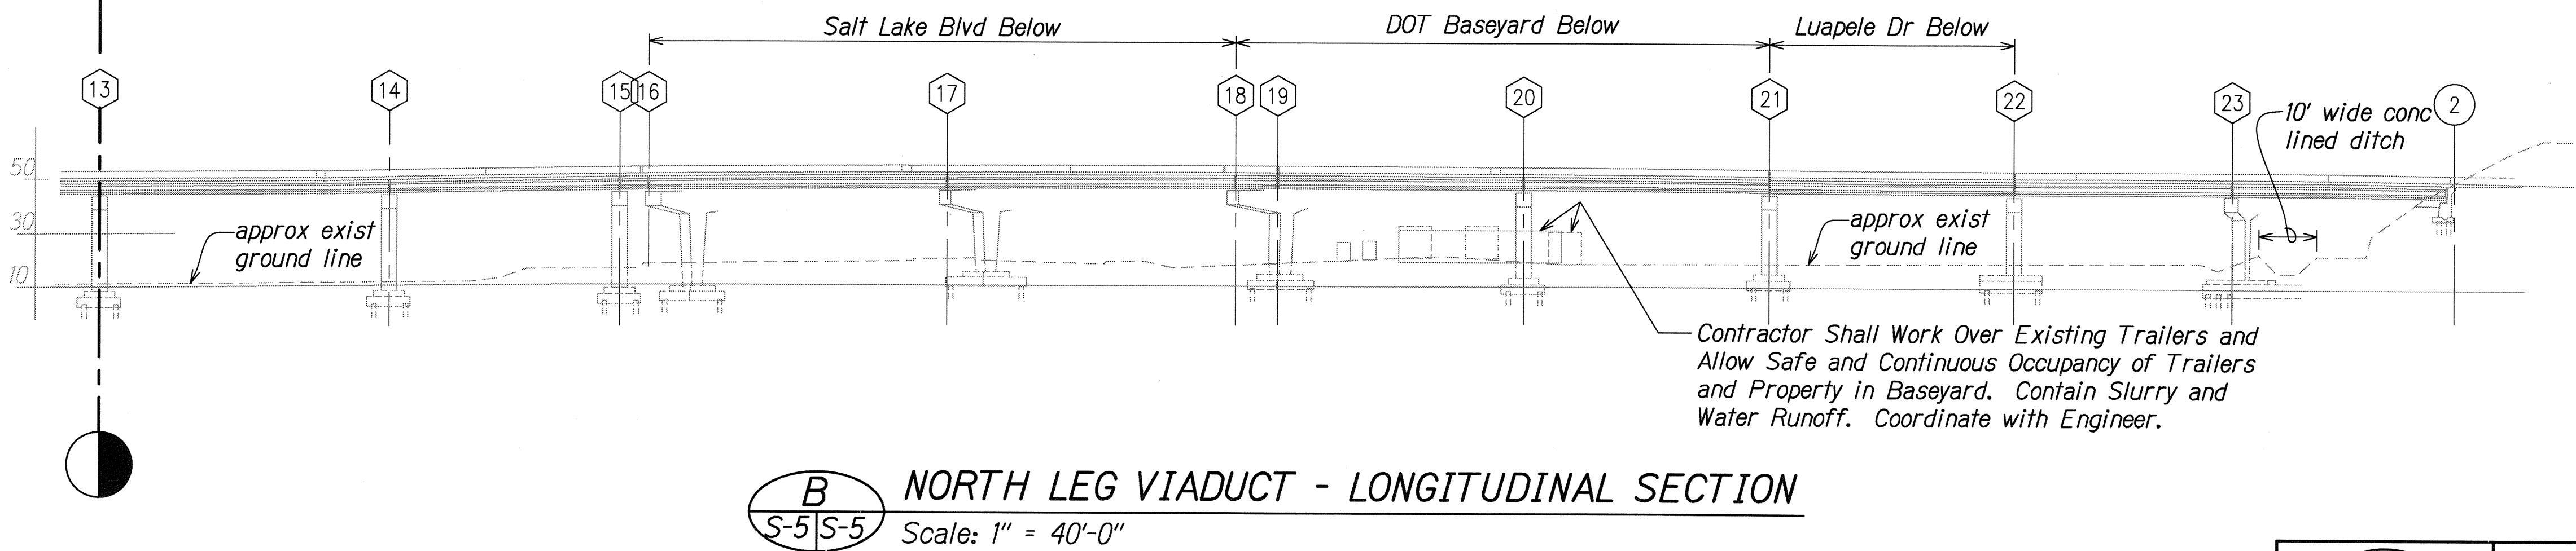


[illegible]

5

FED. ROAD DIST. NO.	STATE	FED. AID PROJ. NO.	FISCAL YEAR	SHEET NO.	TOTAL SHEETS
HAWAII	HAW.	IM-HI-1(265)	2011	6	23

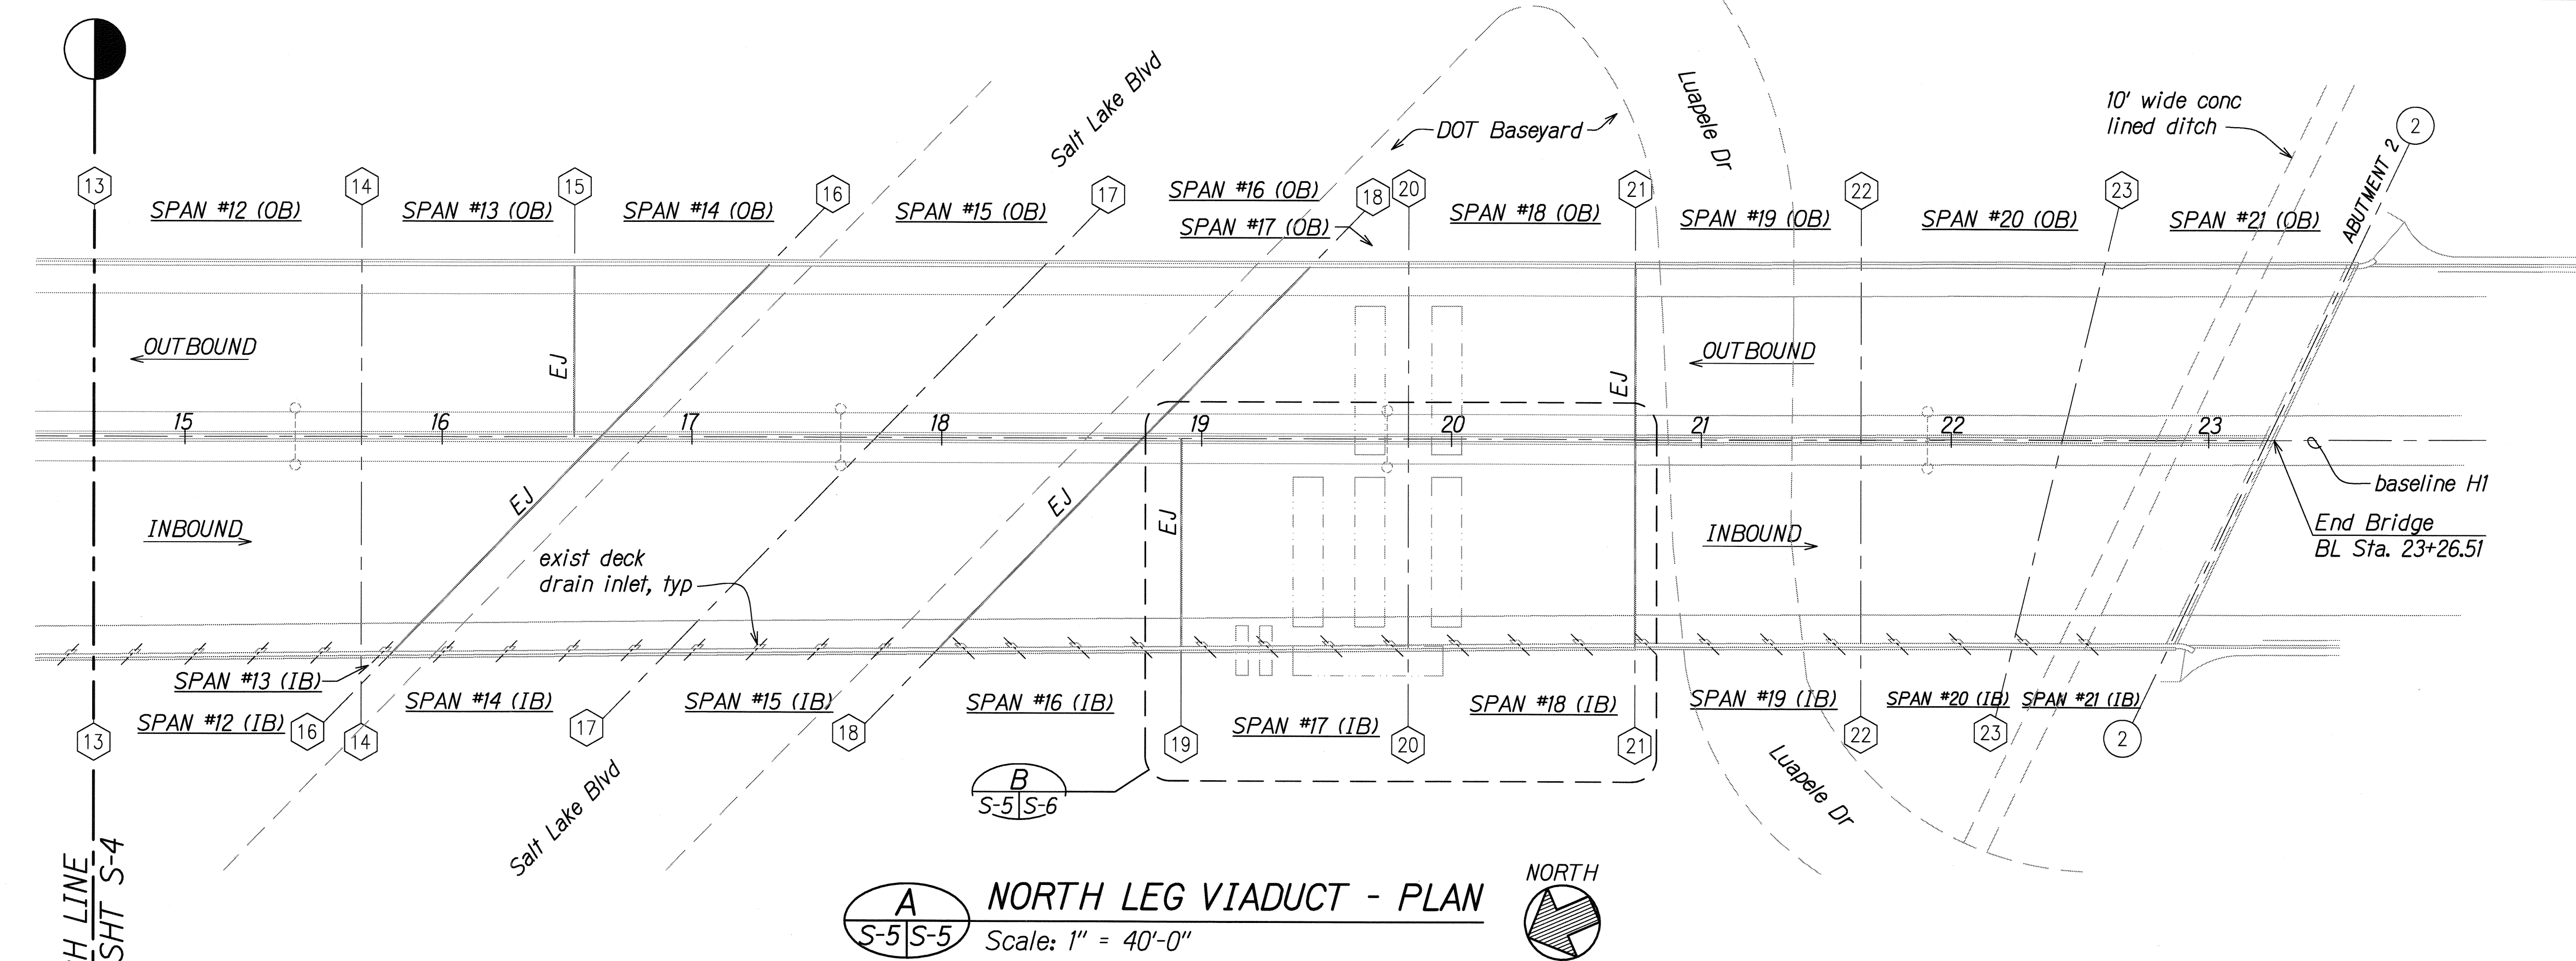

SURVEY PLOTTED BY	DATE
DRAWN BY	
DESIGNED BY	
CHECKED BY	
ORIGINAL PLAN	
NOTEBOOK	
No.	

GRAPHIC SCALE



STATE OF HAWAII
DEPARTMENT OF TRANSPORTATION
HIGHWAYS DIVISION

PLAN & LONGITUDINAL SECTION
INTERSTATE ROUTE H-1
Salt Lake Viaduct Deck Repair, Eastbound
Federal Aid Project No. IM-HI-1(265)

Scale: 1" = 40'-0" Date: May 2011

SHEET No. S-5 OF 23 SHEETS