

INDEX TO DRAWINGS	
SHEET NO.	DESCRIPTION
1	TITLE SHEET
2	GENERAL NOTES
3 - 4	NOTES AND ABBREVIATIONS
5 - 6	PLAN & LONGITUDINAL SECTION
7	ENLARGED PLANS
8 - 9	DETAILS
10 - 17	TRAFFIC CONTROL DRAWINGS
18 - 23	REFERENCE DRAWINGS

STATE OF HAWAII

DEPARTMENT OF TRANSPORTATION

HIGHWAYS DIVISION

HONOLULU, HAWAII

"AS-BUILT"

PLANS FOR


INTERSTATE ROUTE H-1

SALT LAKE VIADUCT DECK REPAIR, EASTBOUND

FEDERAL AID PROJECT NO. IM-H1-1(265)

DISTRICT OF EWA



ISLAND OF OAHU

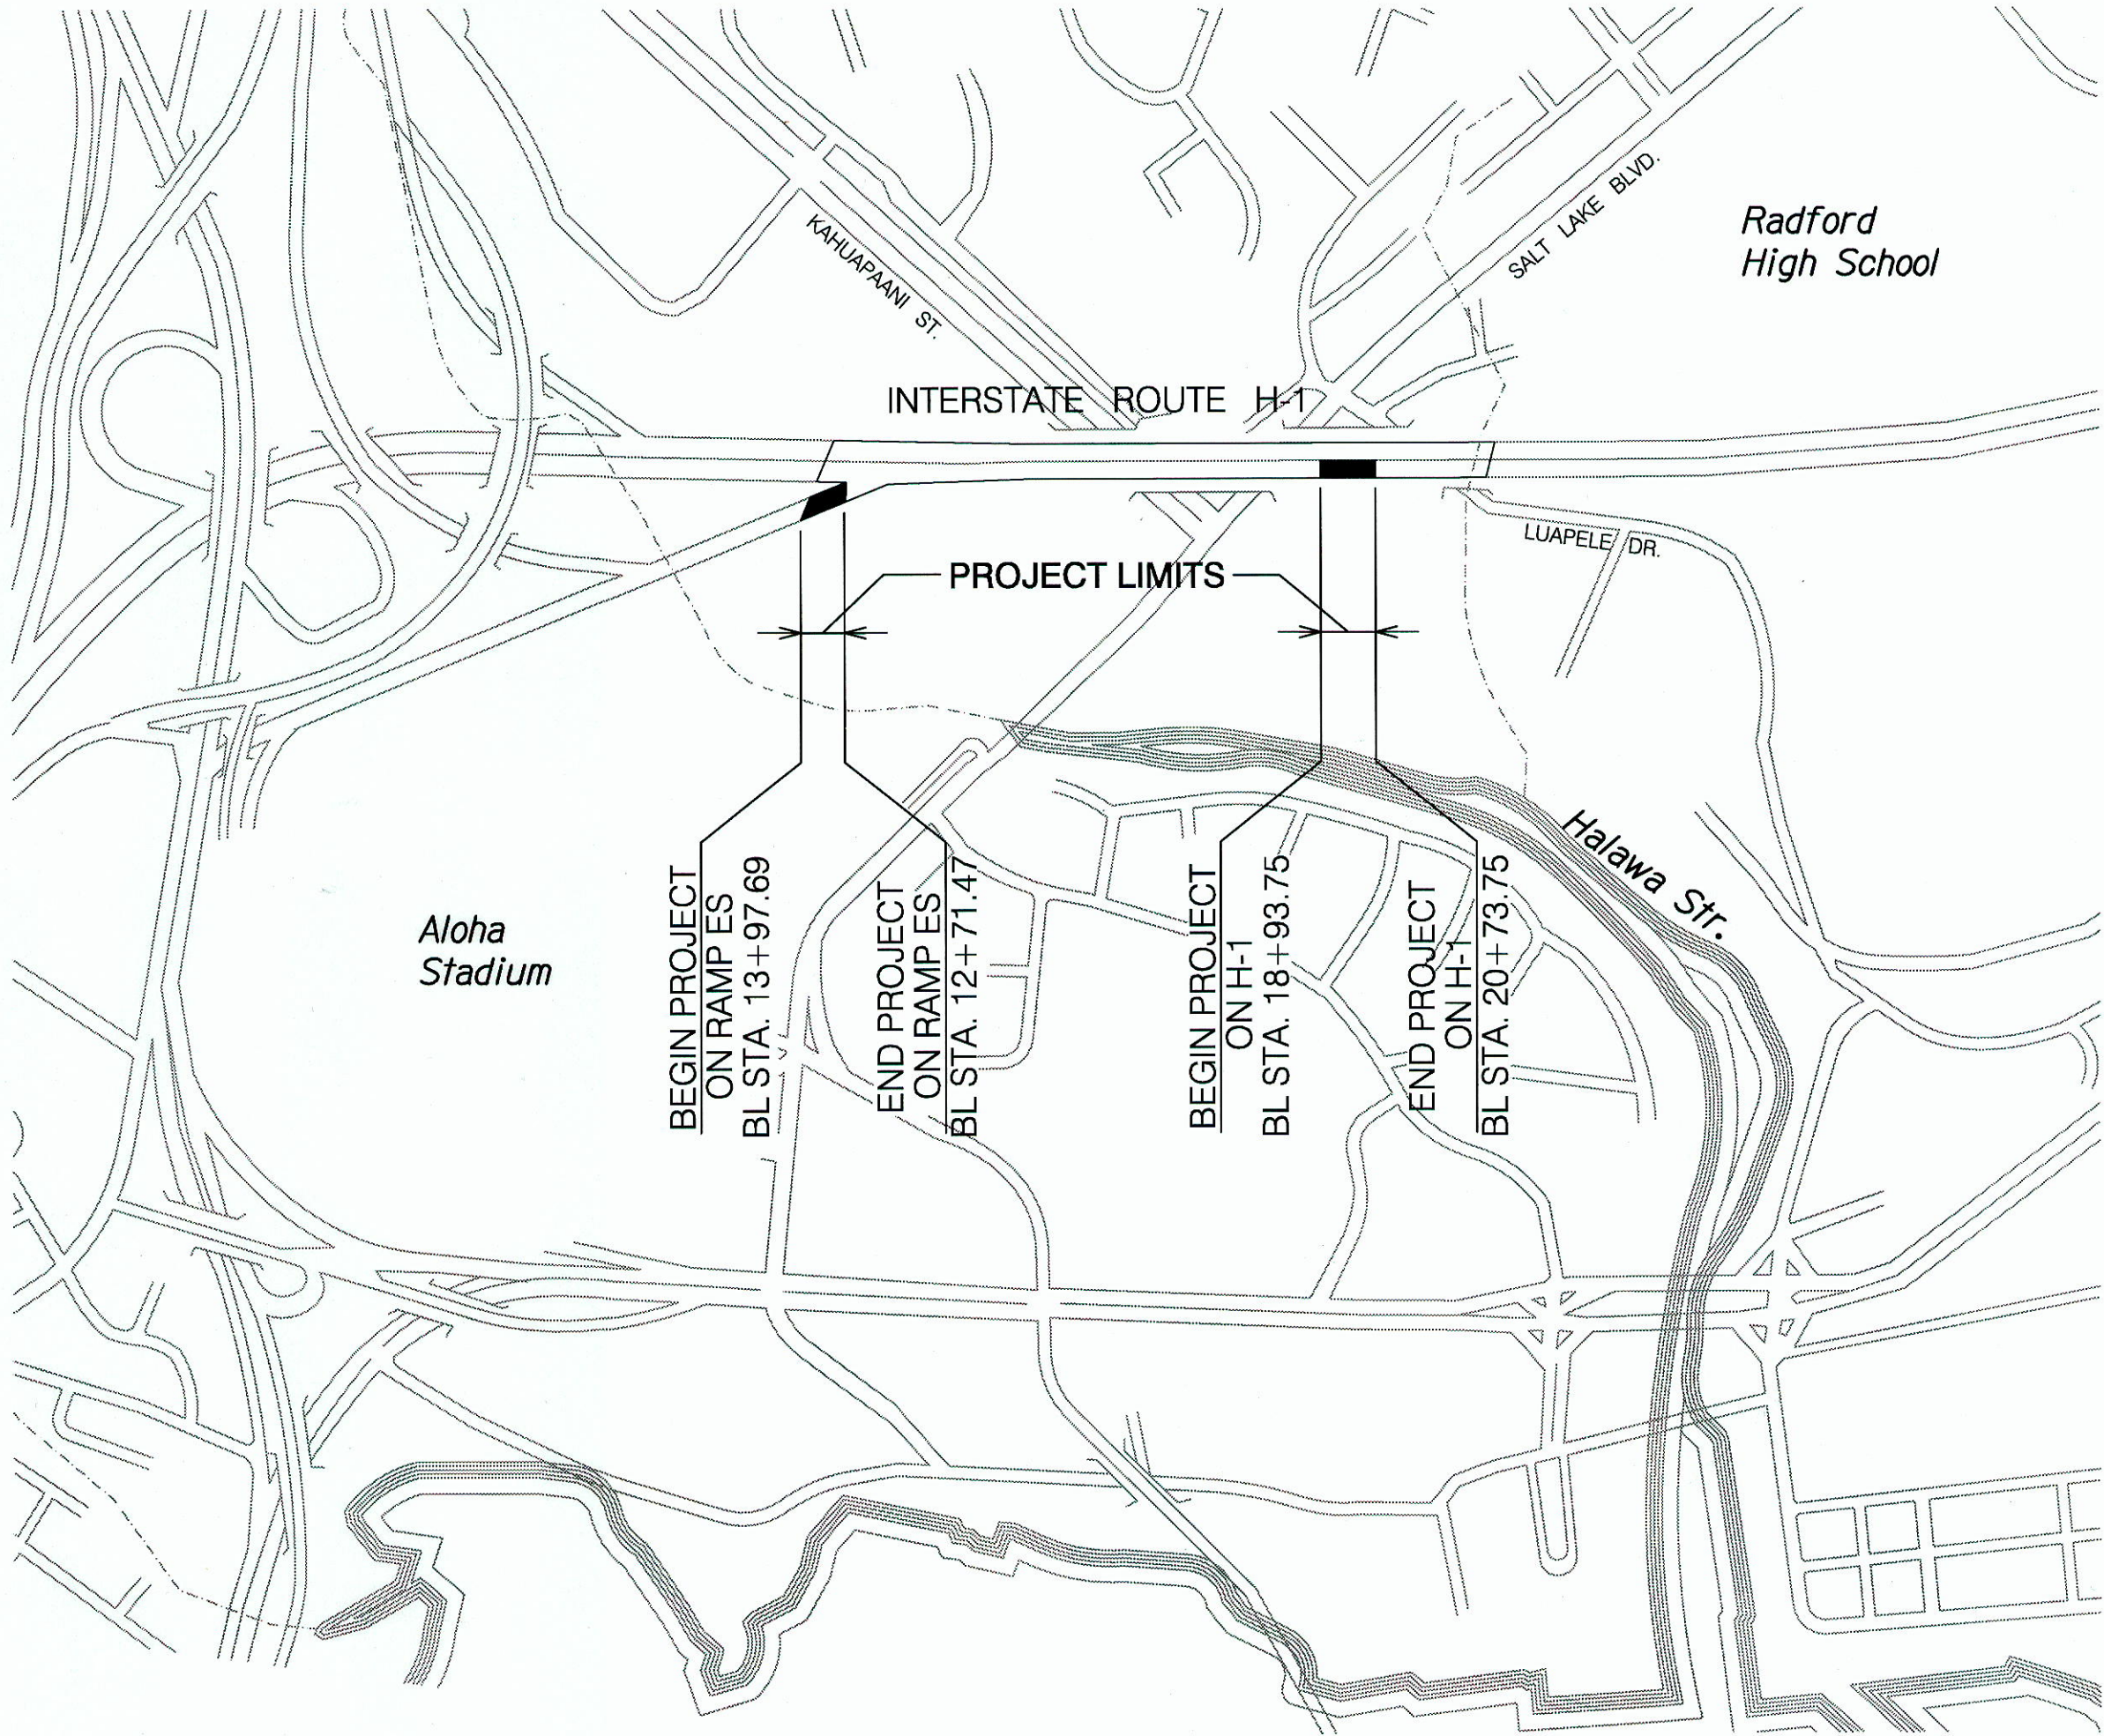

LAYOUT PLAN

NOT TO SCALE

FED. ROAD DIST. NO.	STATE	FED. AID PROJ. NO.	FISCAL YEAR	SHEET NO.	TOTAL SHEETS
HAWAII	HAW.	IM-H1-1(265)	2011	1	23

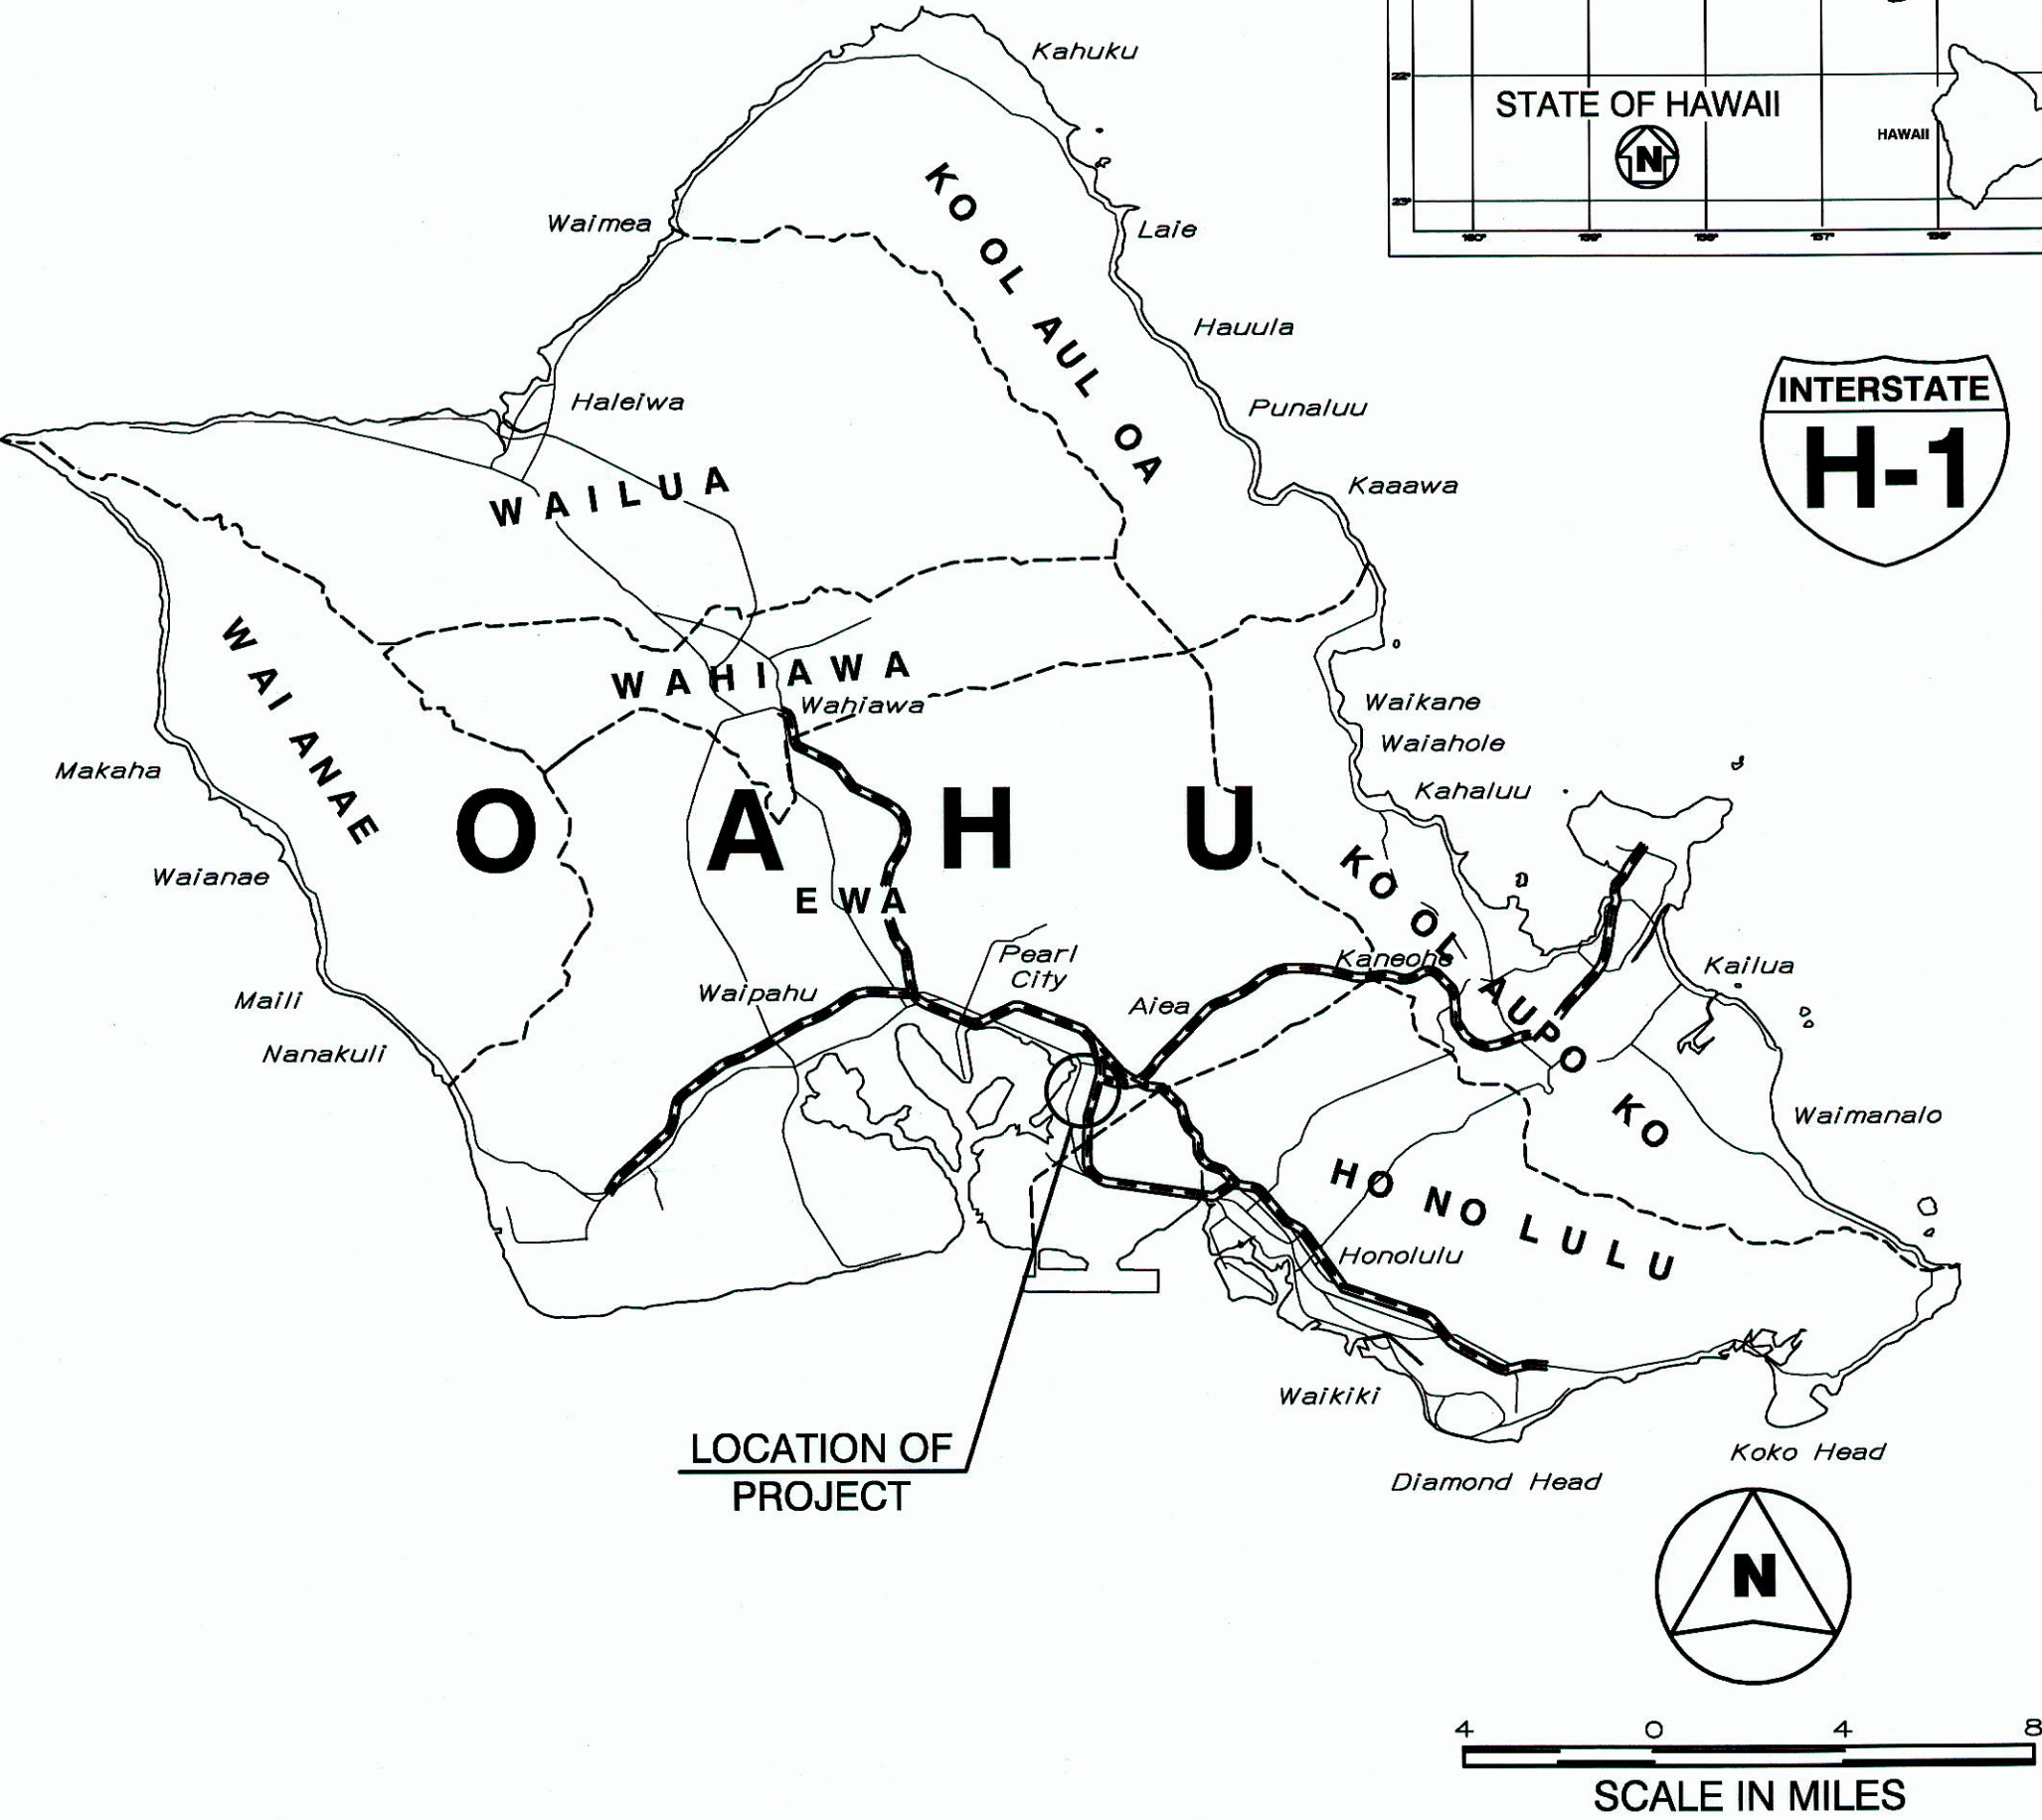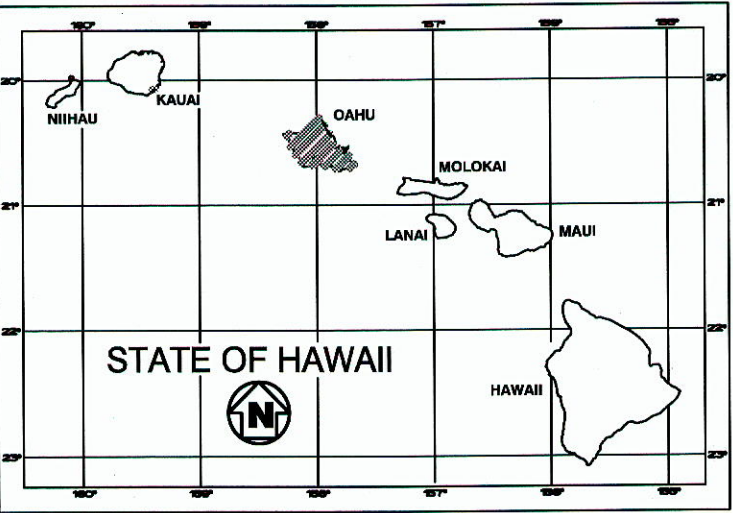

FEDERAL AID INTERSTATE PROJECTS PREVIOUSLY CONSTRUCTED OR UNDER CONSTRUCTION

MILE POST 13.70 TO MILE POST 14.05

DESIGN DESIGNATION

ADT (2011)	76,400
ADT (2031)	96,100
DHV	12,970
K	13.5
D	100/0
T	1.5 %
T ₂₄	3.5 %
V	60 M.P.H.

CHANGES MADE DURING CONSTRUCTION HAVE BEEN INCORPORATED ON THESE PLANS EXCEPT CHANGES IN THE ORIGINAL THEORETICAL QUANTITIES. FOR ACTUAL QUANTITIES, REFER TO PROJECT LEDGER AND/OR COMPUTATION BOOK.

RESIDENT ENGINEER

DATE

DEPARTMENT OF TRANSPORTATION

STATE OF HAWAII

APPROVED:

DIR. OF TRANSPORTATION

DATE

NAGAMINE OKAWA ENGINEERS INC.

DESIGNED BY

MANAGED BY

PHONE

DATE