

FED. ROAD DIST. NO.	STATE	PROJ. NO.	FISCAL YEAR	SHEET NO.	TOTAL SHEETS
HAWAII	HAW.	H1E-01-11MR	2013	25	49

SITE RESTORATION:

- The Contractor's attention is directed to Attachment H of the Interstate Route H-1, Aiea Stream Erosion Control Water Quality Certification (WQC) application which further details site restoration steps that shall be taken as part of the WQC.
- As specified in the Site Restoration Plan, the Contractor shall:
 - Install Silt Fence A (See Sheet EC-2).
 - Remove the following BMP's:
 - 2-36" HDPE Pipes
 - 12" HDPE Spillway Pipe
 - Silt Fence and Sandbag Barrier
 - Sandbag Dam
 - Riprap Outlet Protection
 - Fiber Roll above Shotcrete Wall
 - Stabilized Construction Entrance/Exit
 - Remove 10' wide construction access and restore existing grade.
 - Place Geocells and backfill with Trench Backfill Material A to Restore Slope.
 - Plant Grass.
 - Remove remaining fiber rolls and 12" HDPE Bypass Pipe.
 - Remove Silt Fence A.
 - Relocate portions of Fiber Roll No. 3 after Construction Access Road is restored.
 - Remove Dust Screen and Fiber Rolls Nos. 2 & 3 after plant establishment.
 - Remove impervious sandbags after grass has been established.

LEGEND:

- Grass and 6" Thick Imported Planting Soil
- Restore Existing Grade
- Geocell
- Impervious Sandbags (12"x18"x4.5")

THIS WORK WAS PREPARED BY ME OR UNDER MY SUPERVISION.

SIGNATURE: _____ EXPIRATION DATE OF THE LICENSE: 04/30/14

STATE OF HAWAII
DEPARTMENT OF TRANSPORTATION
HIGHWAYS DIVISION


SITE RESTORATION PLAN

**INTERSTATE ROUTE H-1
AIEA STREAM EROSION CONTROL**

Project No. H1E-01-11MR

Scale: 1"=10' Date: September 2012

SHEET No. SR-1 OF 1 SHEETS

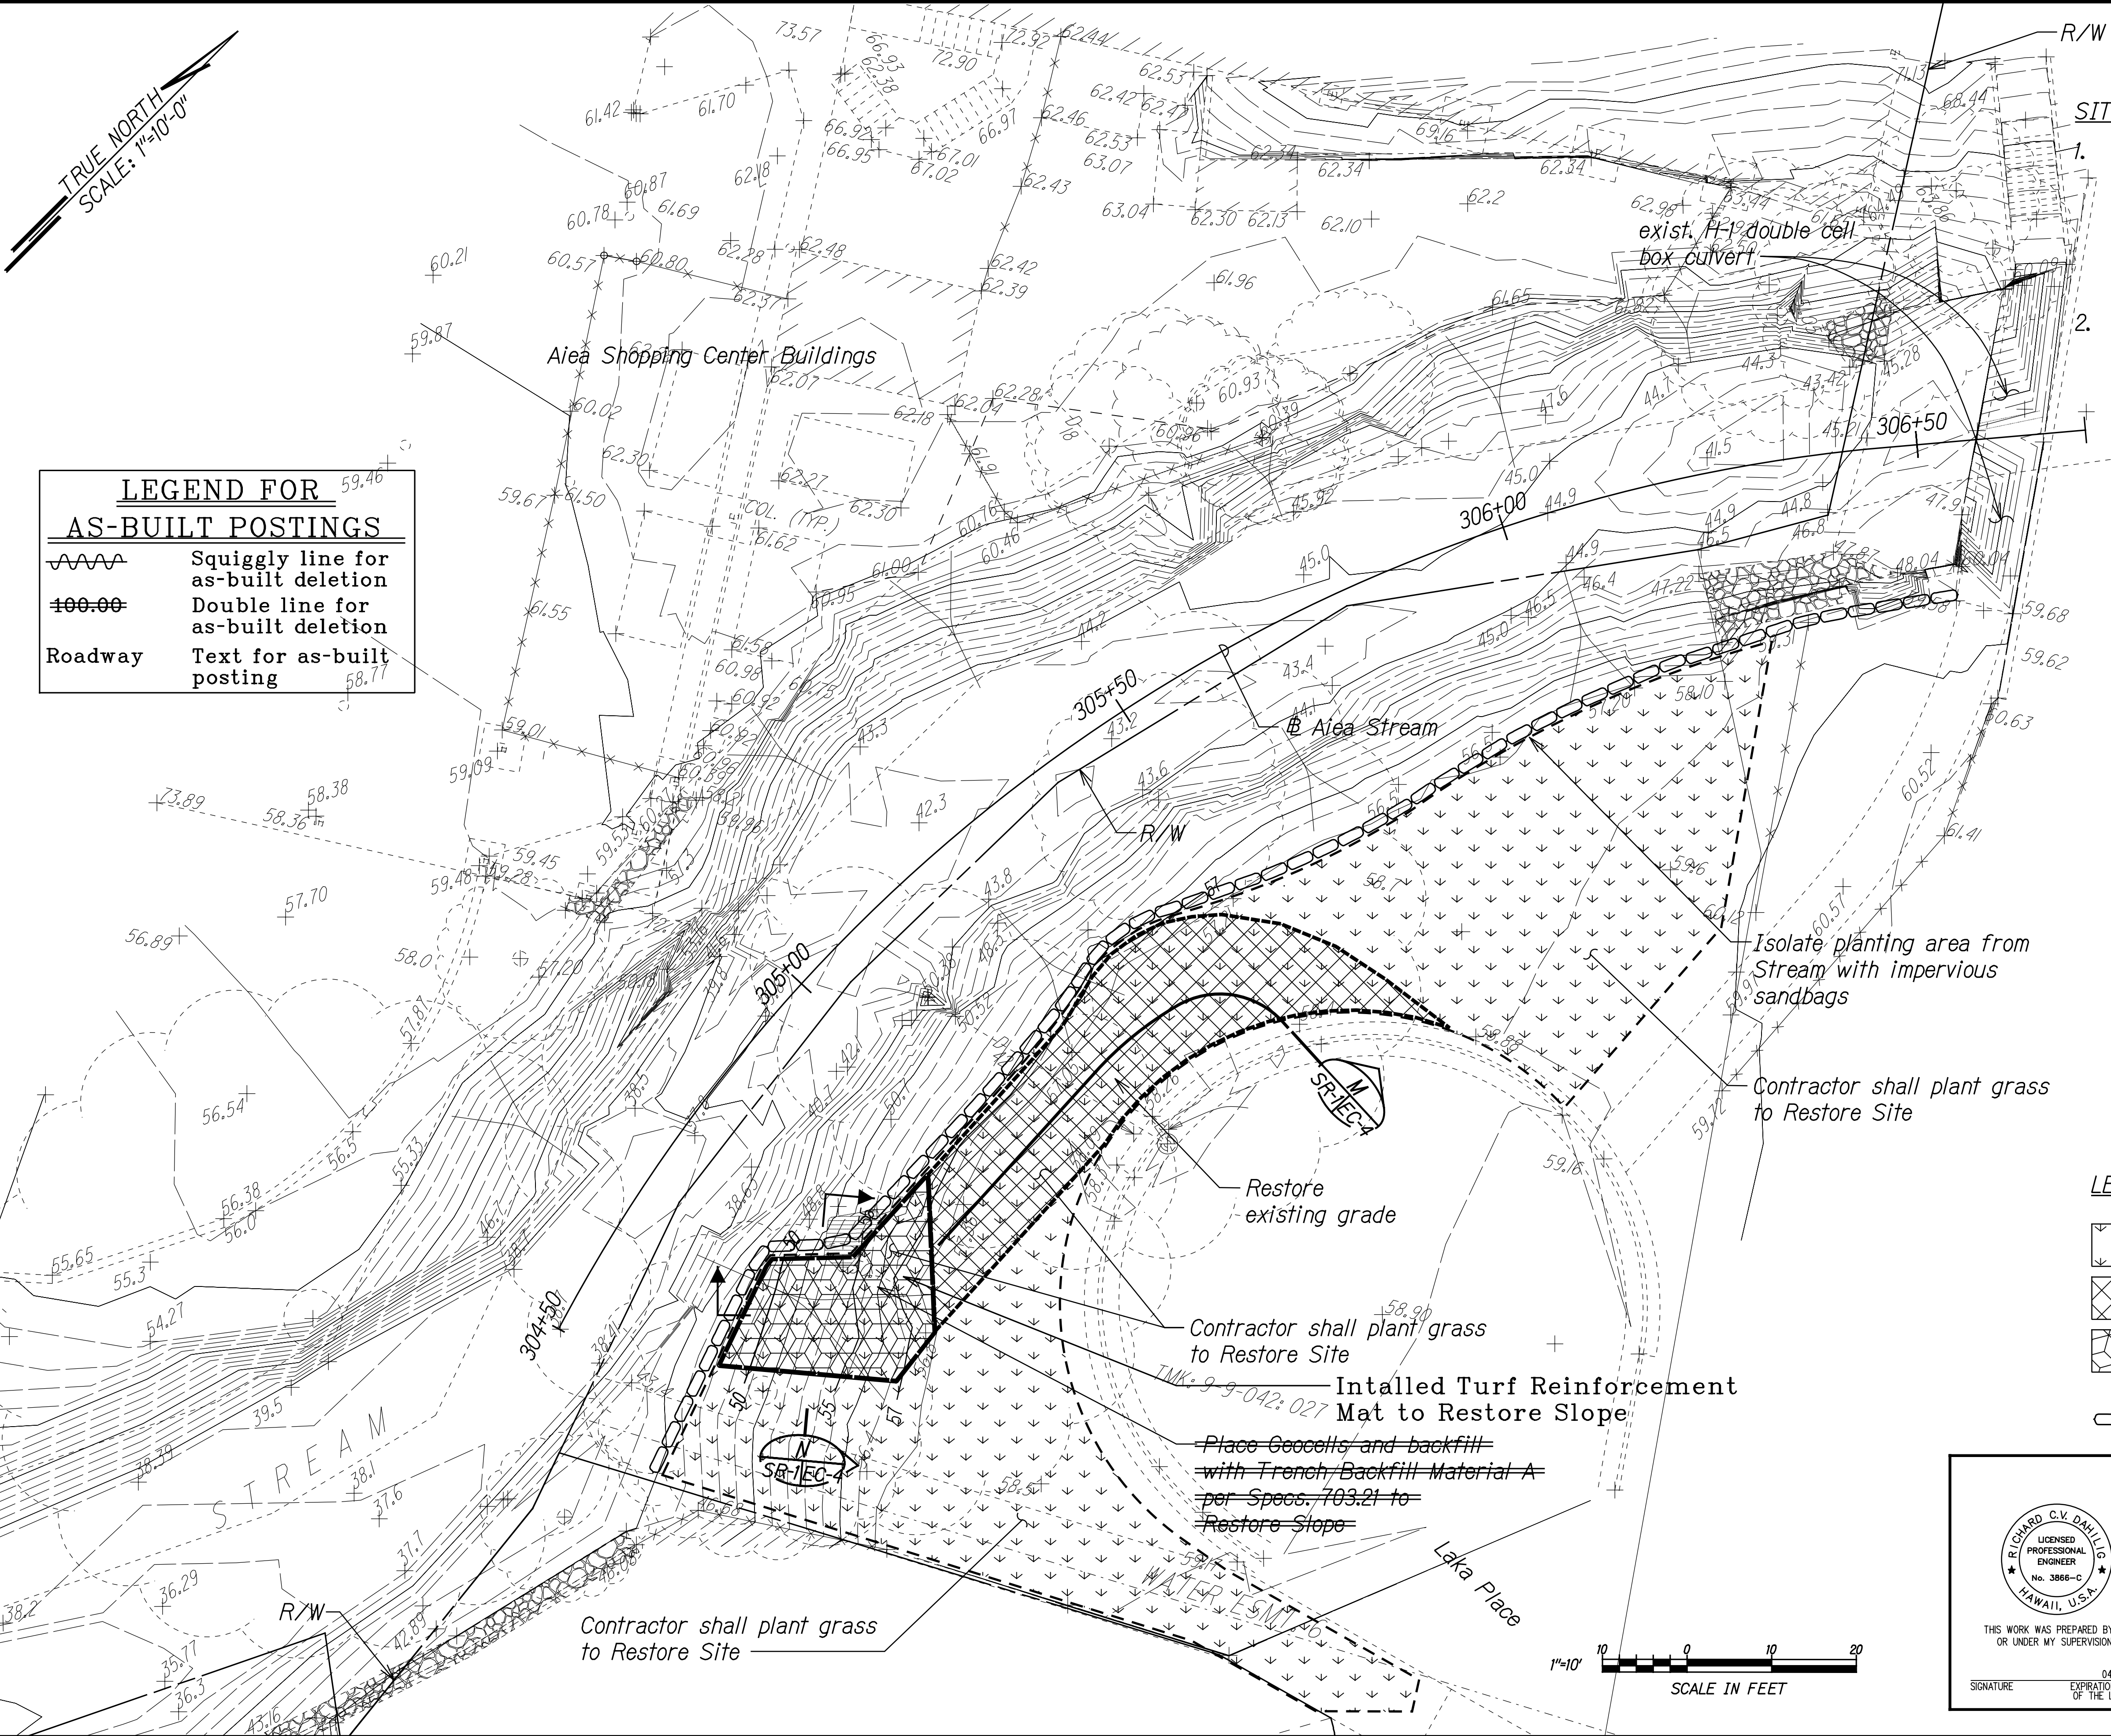

LEGEND FOR AS-BUILT POSTINGS

Squiggly line for as-built deletion

Double line for as-built deletion

Roadway Text for as-built posting

ORIGINAL PLAN	SURVEY PLOTTED BY	DATE
NOTE BOOK	DRAWN BY	
	DESIGNED BY	
	CHECKED BY	

T:\SSWMP\Aiea Stream Erosion Control\Cadd\Sheets\SR-1.dgn

"AS-BUILT"