
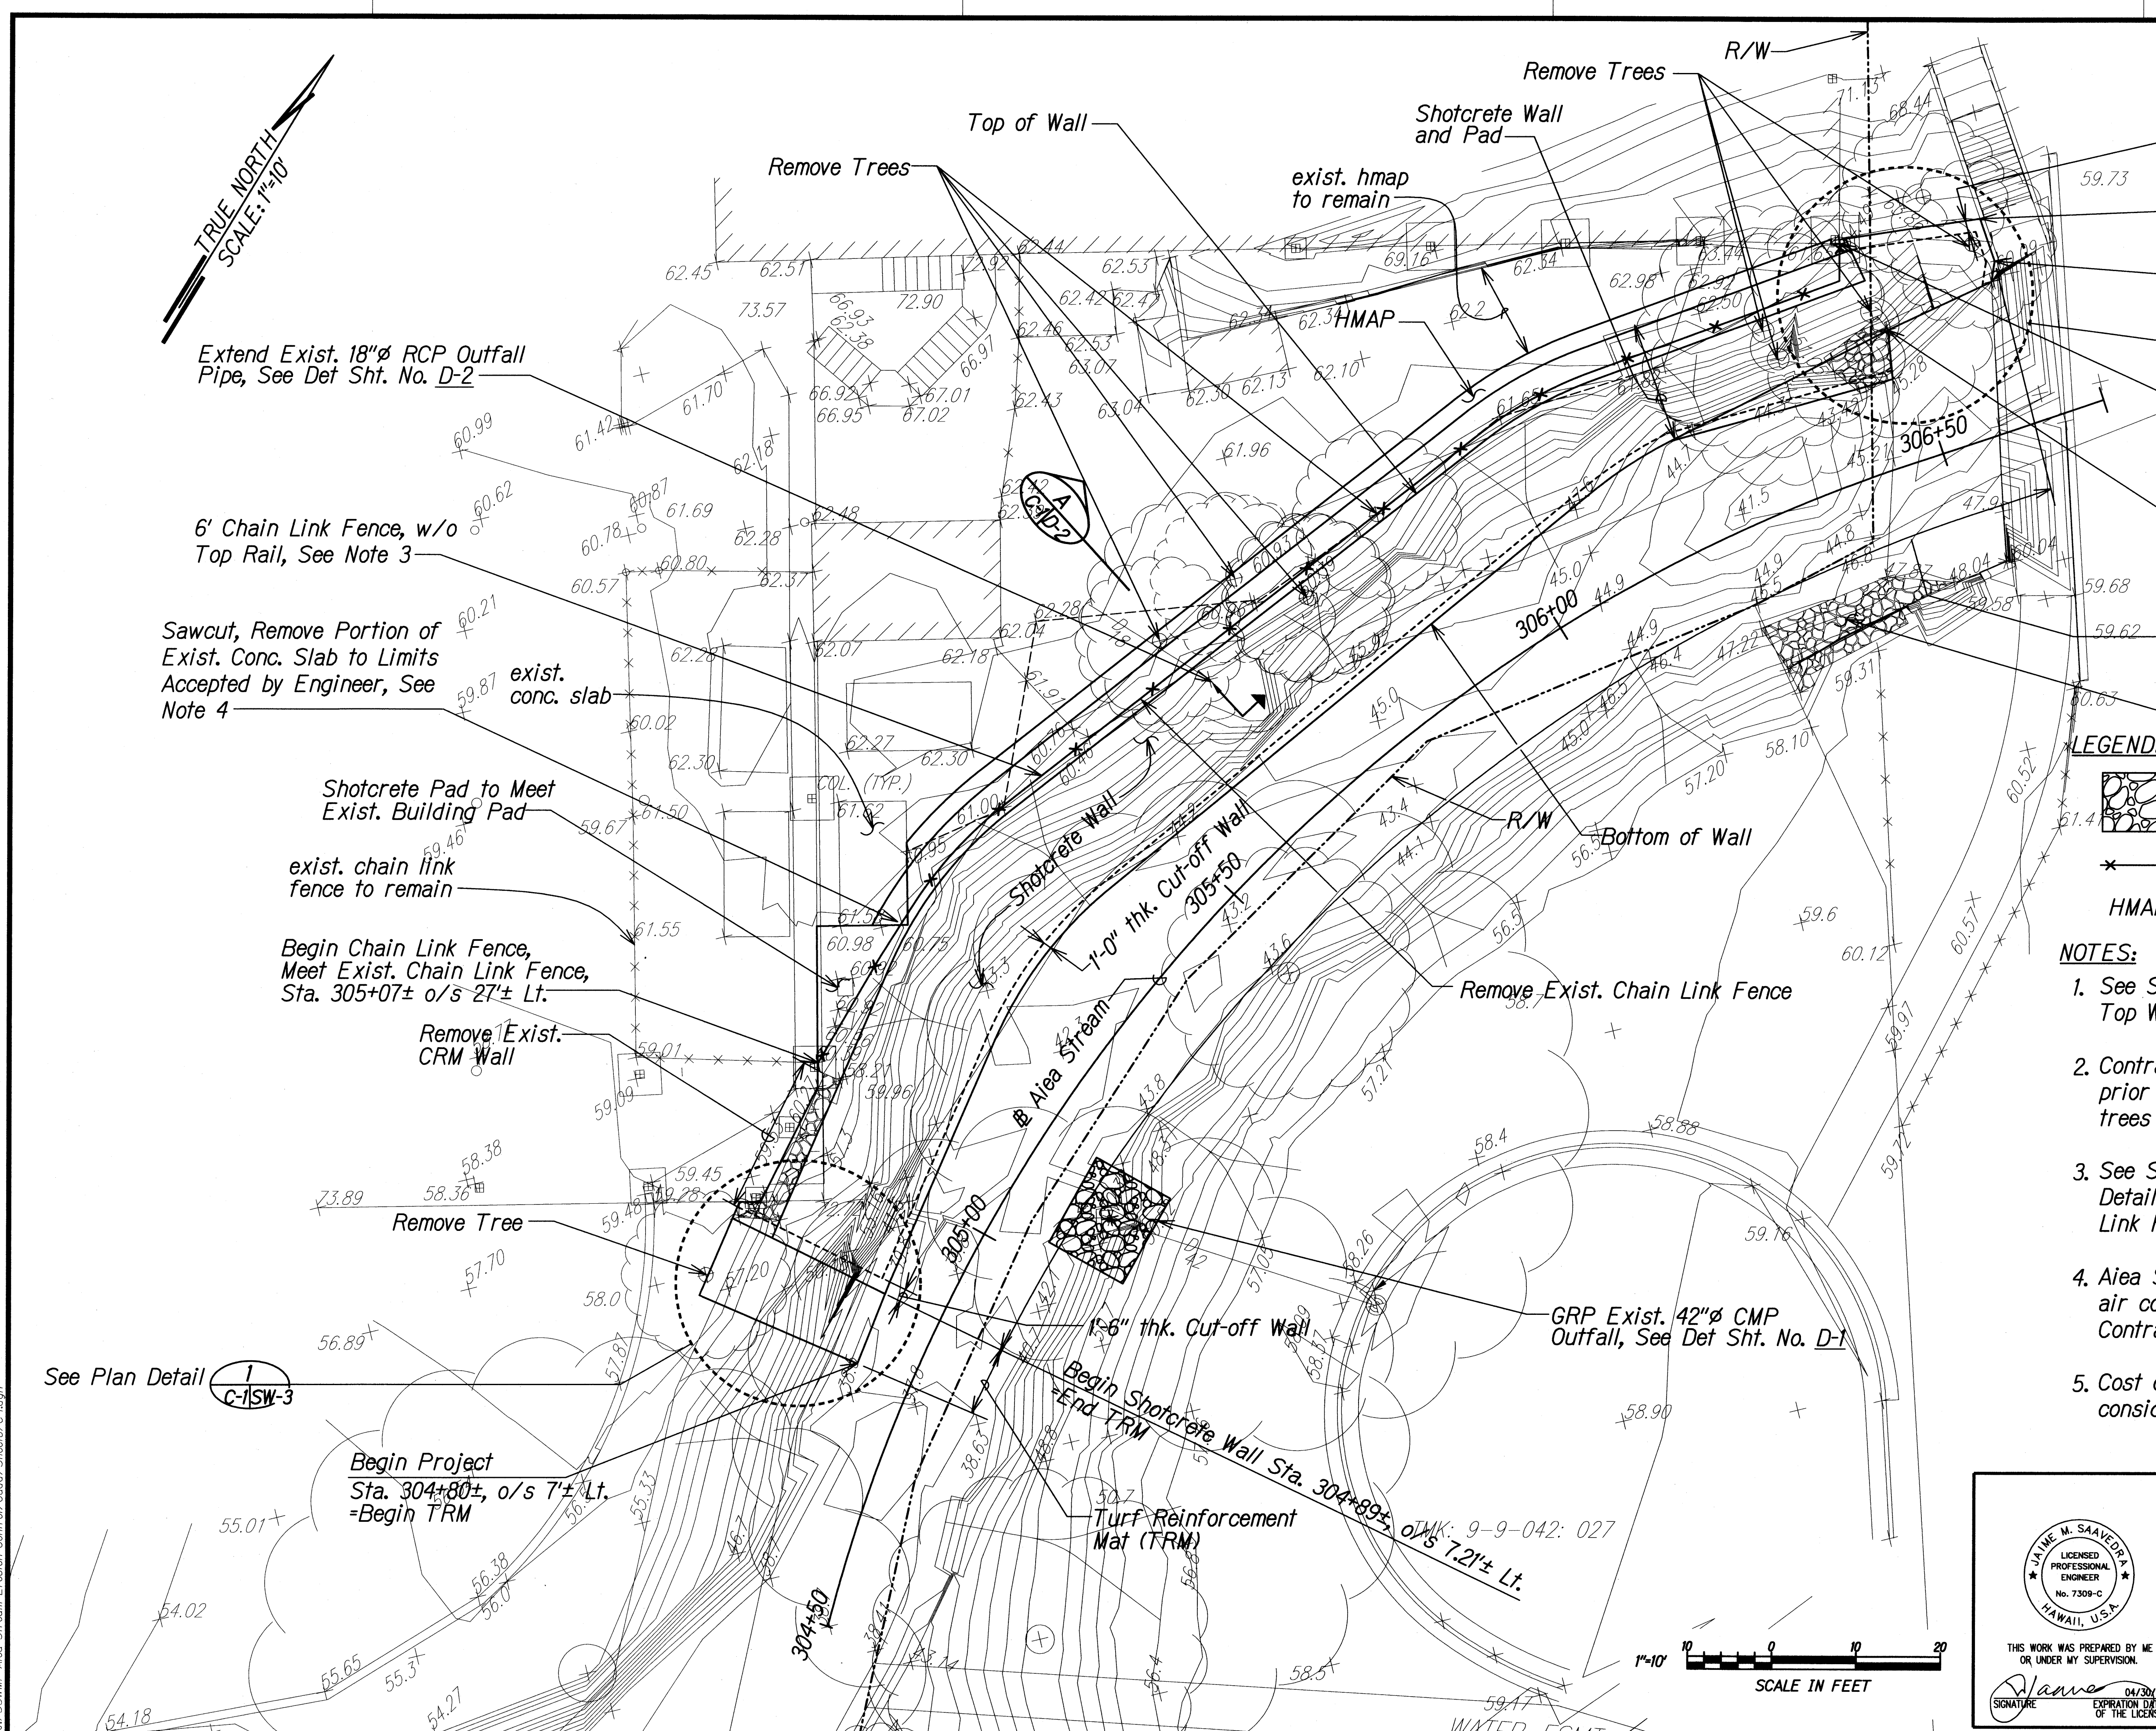


FED. ROAD DIST. NO.	STATE	PROJ. NO.	FISCAL YEAR	SHEET NO.	TOTAL SHEETS
HAWAII	HAW.	HIE-01-11M	2012	12	49

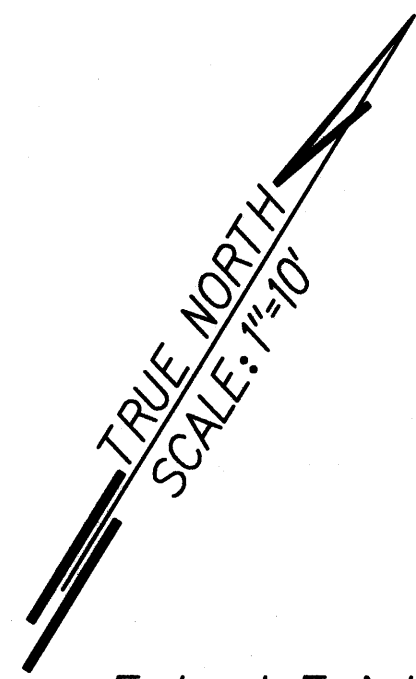

- Cut-off wall, varies
- Sta. 306+63±, o/s 25'± Lt.
Meet Exist. Concrete Wall
- End Project Sta. 306+63±, o/s 20'± Lt.
=End Shotcrete Wall
- See Plan Detail **(2)**
C-1SW-4
- End Chain Link Fence,
Sta. 306+46±, o/s 27'± Lt.
Meet Exist. Building
- Shotcrete Wall Sta. 306+48±, o/s 16'± Lt.
Meet Exist. Culvert Wingwall
- Corner Chain Link Fence,
Sta. 306+45±, o/s 23'± Lt.
- Exist. CRM Wall to remain

LEGEND:

- GRP
- 6' Chain Link Fence
- HMAP Hot Mix Asphalt Pavement

NOTES:

- See Sht. No. SN-3 for locations and elevations of Top Wall and Bottom Wall.
- Contractor shall tag trees to be removed prior to removal. Engineer will verify tagged trees prior to removal.
- See STD Plan No. D-03 for Chain Link Fence Details. See Detail Sht. No. SW-2 for Chain Link Fence Foundation.
- Aiea Shopping Center will temporarily support their air conditioning pipes and appurtenances prior to Contractor's work.
- Cost of removing Exist. Chain Link Fence will be considered incidental to various contract items.

ORIGINAL PLAN	DATE
DRAWN BY	...
DESIGNED BY	...
CHECKED BY	...
NOTE BOOK	...
...	...

Jr/SSWMP-Aiea Stream Erosion Control/Cadd/Sheets/C-1.dgn

STATE OF HAWAII
DEPARTMENT OF TRANSPORTATION
HIGHWAYS DIVISION

**SHOTCRETE WALL
CONSTRUCTION PLAN**

INTERSTATE ROUTE H-1
AIEA STREAM EROSION CONTROL
Project No. HIE-01-11M

Scale: 1"=10'
Date: September 2011

SHEET No. C-1 OF 1 SHEETS