
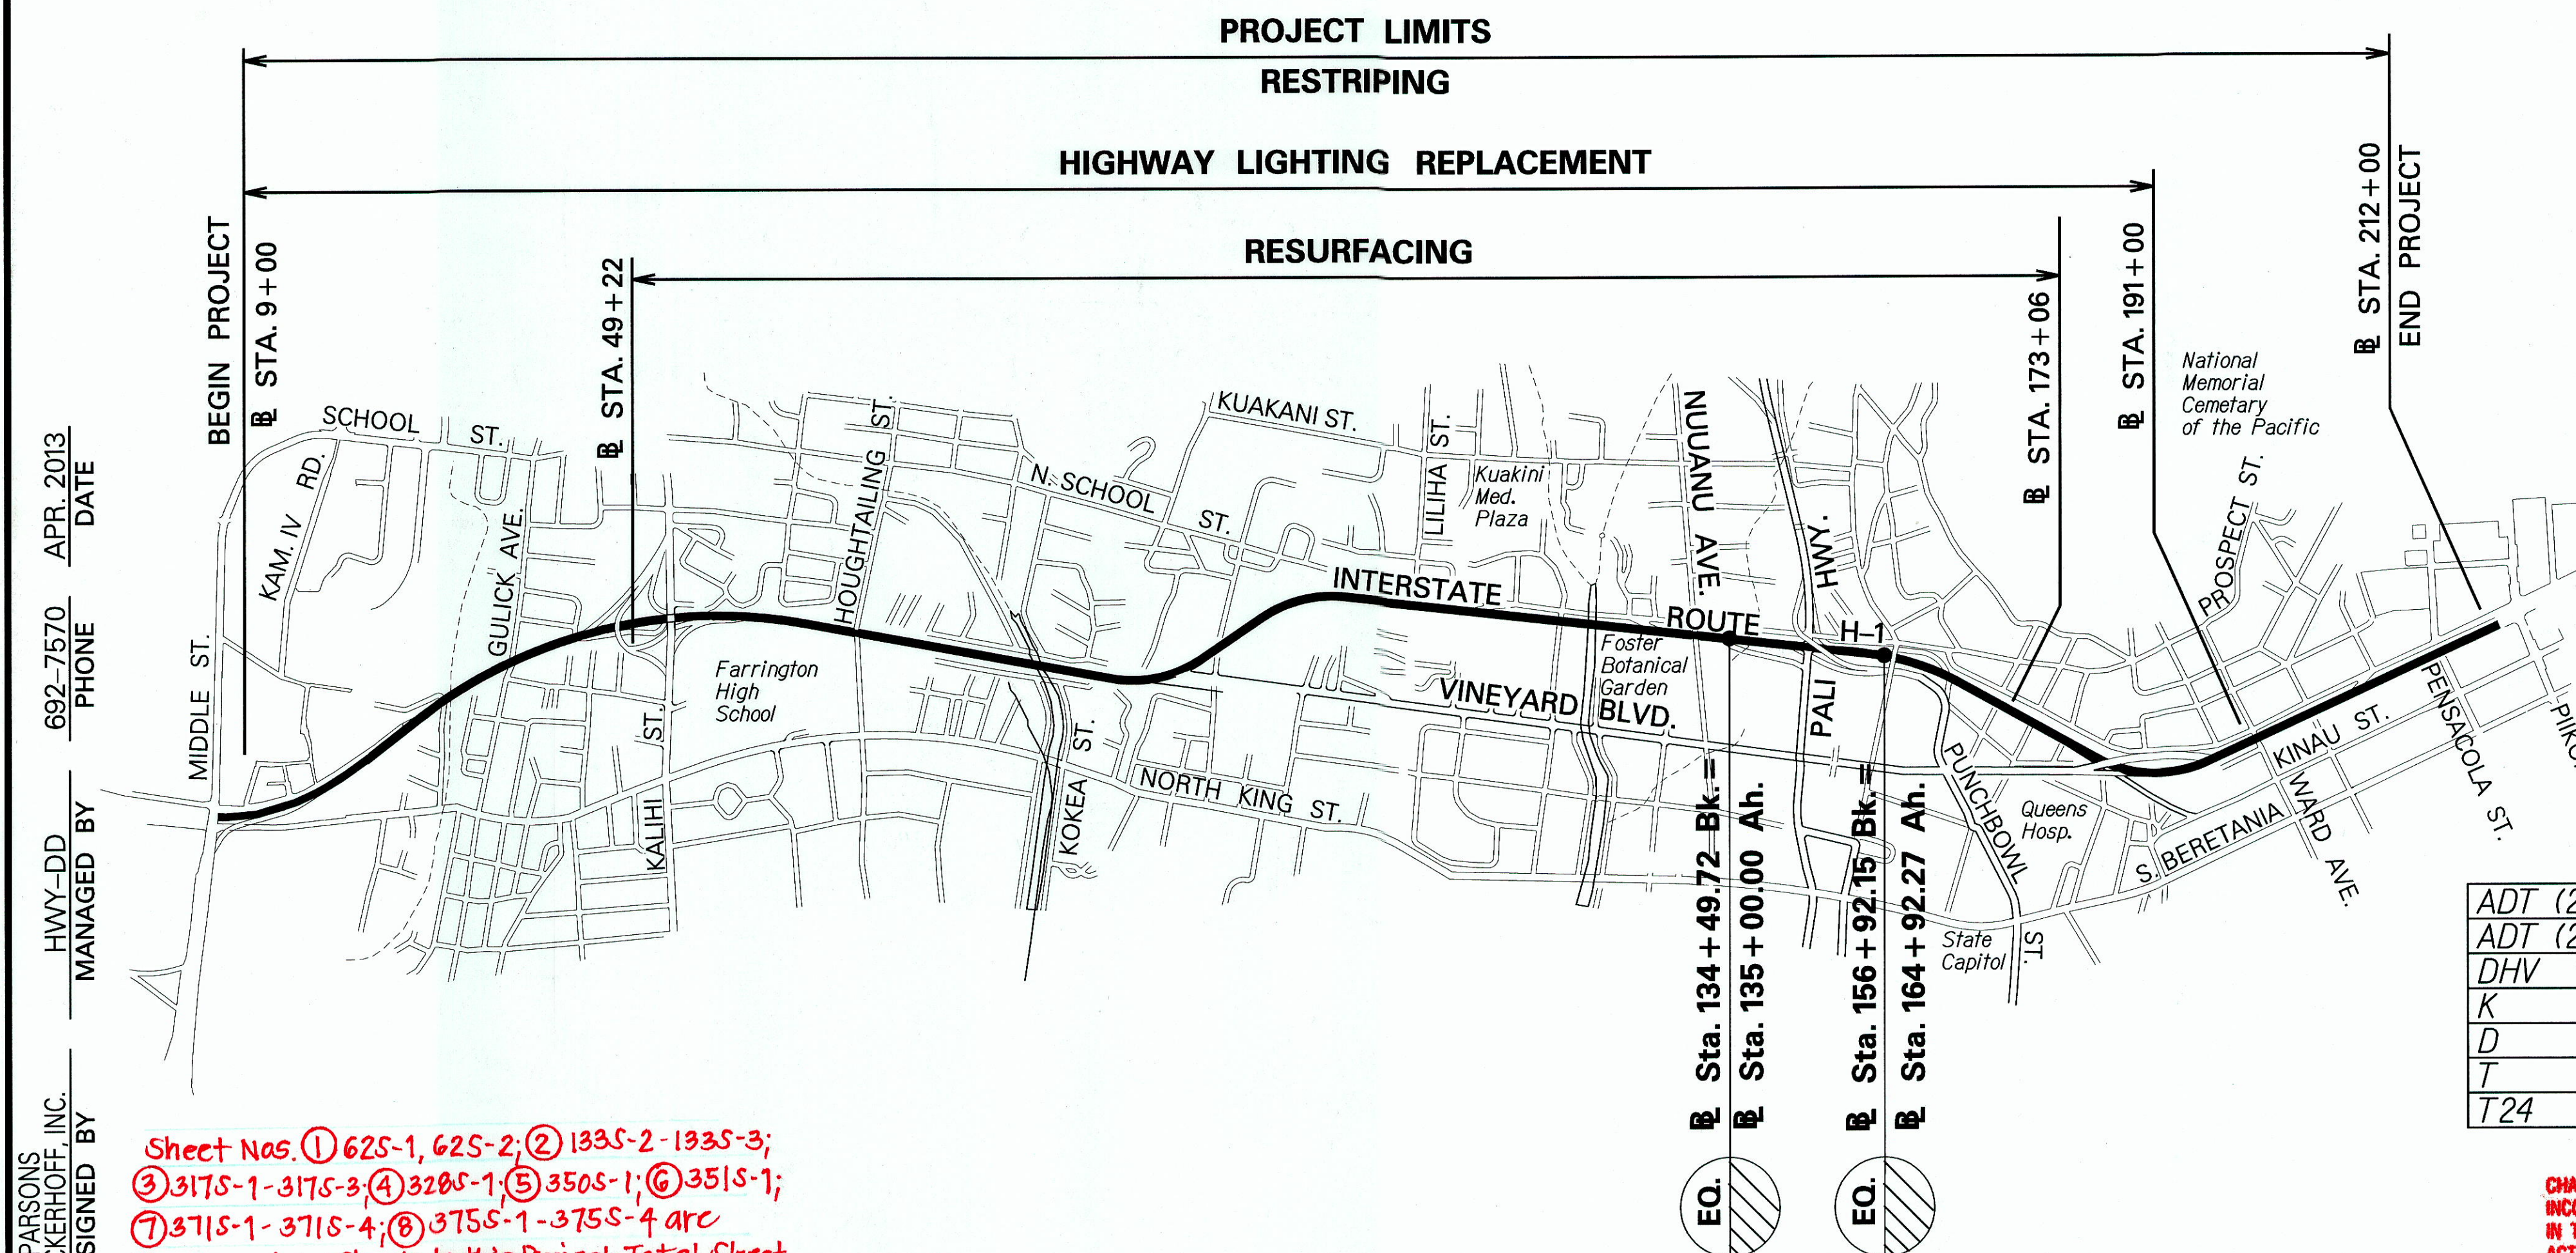
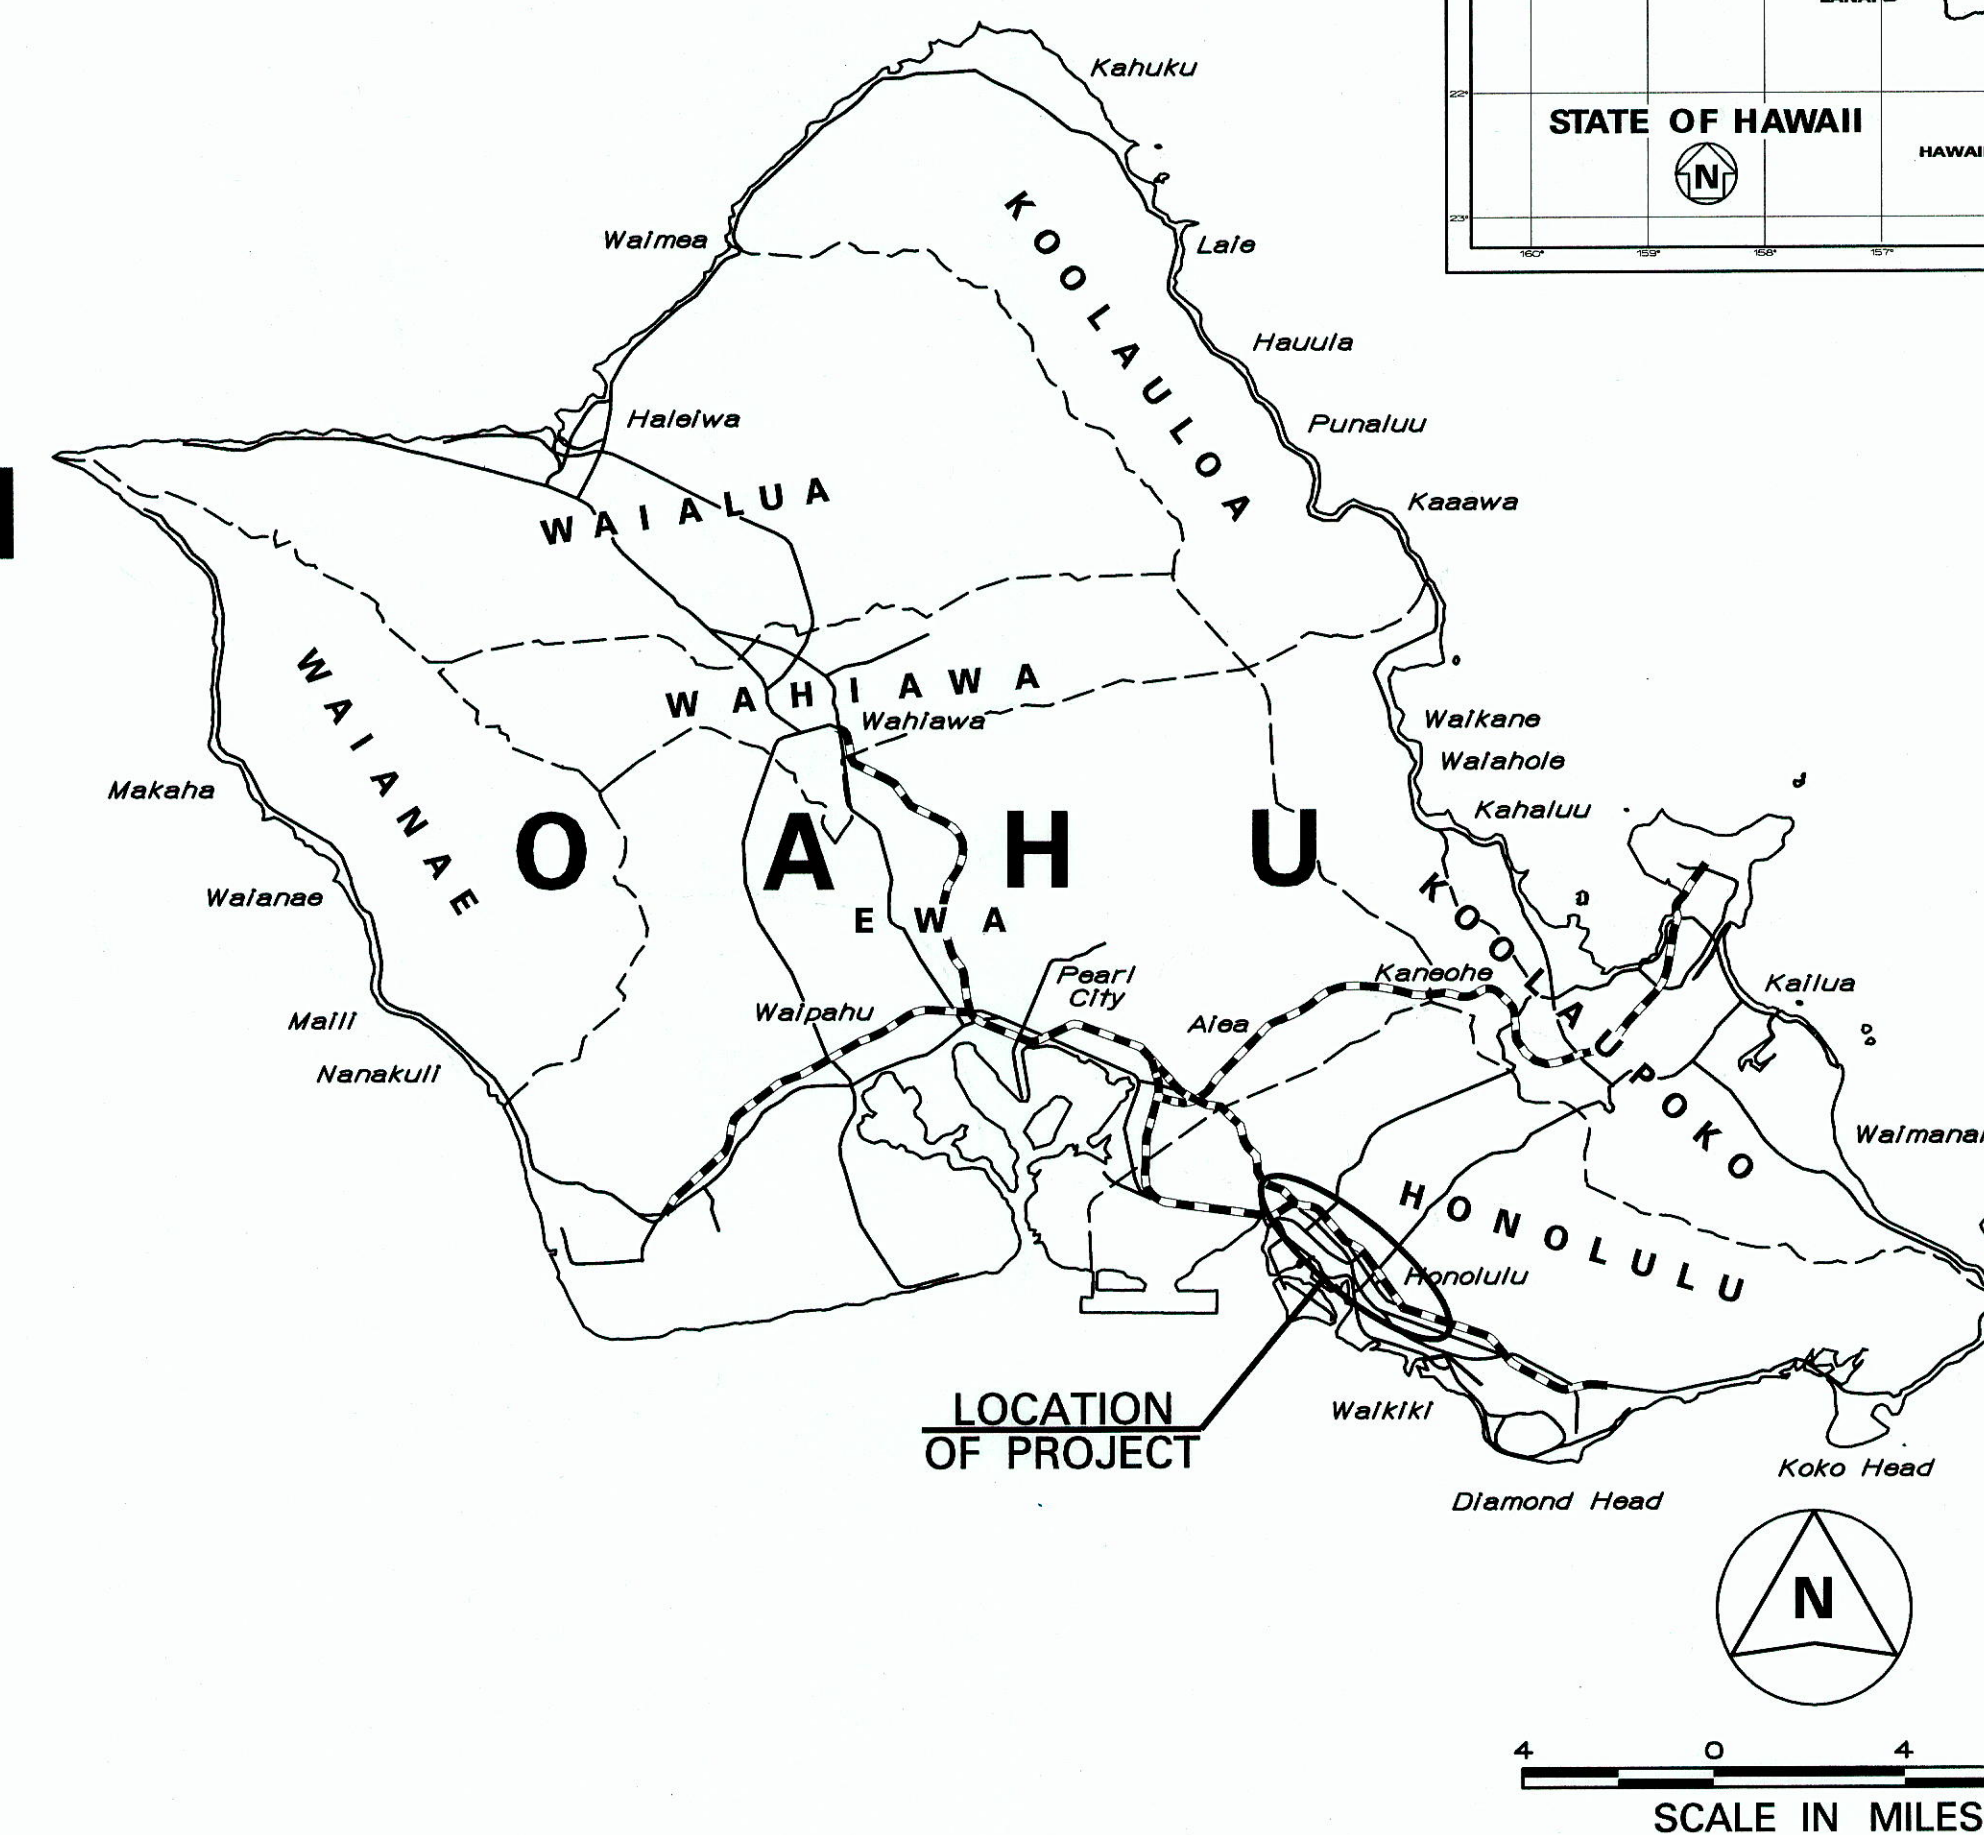


INDEX TO DRAWINGS	
SHEET NO.	DESCRIPTION
1	TITLE SHEET
2	STANDARD PLAN SUMMARY
3 - 10	GENERAL & UTILITY NOTES
11 - 12	WATER POLLUTION AND EROSION CONTROL NOTES
13 - 19	TYPICAL SECTIONS
20	ROADWAY CONSTRUCTION NOTES
21	GENERAL LAYOUT PLAN
22 - 43	ROADWAY PLANS
44 - 62	ROADWAY DETAILS ①
63 - 69	TRAFFIC COUNTING STATION PLAN & DETAILS
70	DRAINAGE PLANS & PROFILE
71 - 86	UTILITY PLANS
87 - 109	EROSION CONTROL PLANS & DETAILS
110 - 133	SIGNING & PAVEMENT MARKINGS PLAN & DETAILS ②
134 - 261	TRAFFIC CONTROL NOTES & PLANS
262 - 291	ELECTRICAL PLANS & DETAILS
292 - 377	STRUCTURAL PLANS & DETAILS ③④⑤⑥⑦⑧
378 - 382	BORING LOGS

STATE OF HAWAII
DEPARTMENT OF TRANSPORTATION
HIGHWAYS DIVISION
HONOLULU, HAWAII
"AS-BUILT"
PLANS FOR
INTERSTATE ROUTE H-1 REHABILITATION
MIDDLE STREET TO VICINITY OF WARD AVENUE
FEDERAL AID PROJECT NO. IM-H1-1(269)

DISTRICT OF HONOLULU
ISLAND OF OAHU

FED. ROAD DIST. NO.	STATE	FED. AID PROJ. NO.	FISCAL YEAR	SHEET NO.	TOTAL SHEETS
HAWAII	HAW.	IM-H1-1(269)	2013	1	382

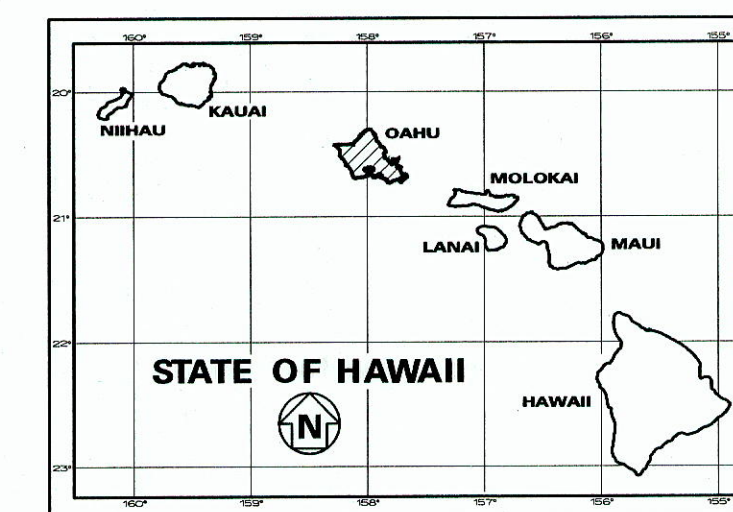


MILE POST 18.95 TO MILE POST 22.13

	Middle Street (MP 18.91) to Kahauiki IC (MP 19.22)	Kahauiki IC (MP 19.22) to Kalihi IC (MP 19.74)	Kalihi IC (MP 19.74) to EB Off-Ramp to Vineyard Blvd. (MP 20.21)	EB Off-Ramp to Vineyard Blvd. (MP 20.21) to Vicinity of Ward Ave (MP 22.12)
ADT (2012)	167,200	187,600	195,000	185,100
ADT (2022)	176,300	197,900	205,700	192,900
DHV	11,460	12,860	13,370	12,540
K	6.5	6.5	6.5	6.5
D	55/45	55/45	55/45	55/45
T	3.0	2.5	2.5	2.5
T24	2.5	2.5	2.0	2.0

PARSONS
BRINCKERHOFF, INC.
DESIGNED BY
HWY-DD
MANAGED BY
692-7570
PHONE
APR. 2013
DATE

Sheet Nos. ① 62S-1, 62S-2; ② 133S-2-133S-3;
③ 317S-1-317S-3; ④ 328S-1; ⑤ 350S-1; ⑥ 351S-1;
⑦ 371S-1-371S-4; ⑧ 375S-1-375S-4 are
Supplementary sheets to this Project. Total Sheet
Count After "As-Built" Posting 400 Sheets.

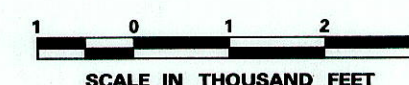

LAYOUT PLAN
GROSS LENGTH OF PROJECT..... 3.18 MILES
NET LENGTH OF PROJECT..... 3.18 MILES

CHANGES MADE DURING CONSTRUCTION HAVE BEEN
INCORPORATED ON THESE PLANS EXCEPT CHANGES
IN THE ORIGINAL THEORETICAL QUANTITIES. FOR
ACTUAL QUANTITIES, REFER TO PROJECT LEDGER
AND/OR COMPUTATION BOOK.
RESIDENT ENGINEER
DATE 12/14/20

DEPARTMENT OF TRANSPORTATION
STATE OF HAWAII
APPROVED:
Dir. of Transportation
DATE 5/09/13