

INDEX TO DRAWINGS	
SHEET NO.	DESCRIPTION
1	TITLE SHEET
2 - 3	SHEET INDEX
4	STANDARD PLANS SUMMARY
5 - 80	CIVIL DRAWINGS
85 - 107	STRUCTURAL DRAWINGS
115 - 136	ELECTRICAL DRAWINGS
145 - 147	LANDSCAPE DRAWINGS

STATE OF HAWAII

DEPARTMENT OF TRANSPORTATION

HIGHWAYS DIVISION

HONOLULU, HAWAII

"AS-BUILT"

PLANS FOR

INTERSTATE ROUTE H-1

SHOULDER WORK AND PORTLAND CEMENT

CONCRETE PAVEMENT REHABILITATION


PHASE 1 - PCCP REHABILITATION AND

SHOULDER WORK

FEDERAL AID PROJECT NO. NH-H1-1(274)

DISTRICT OF EWA AND HONOLULU

ISLAND OF OAHU

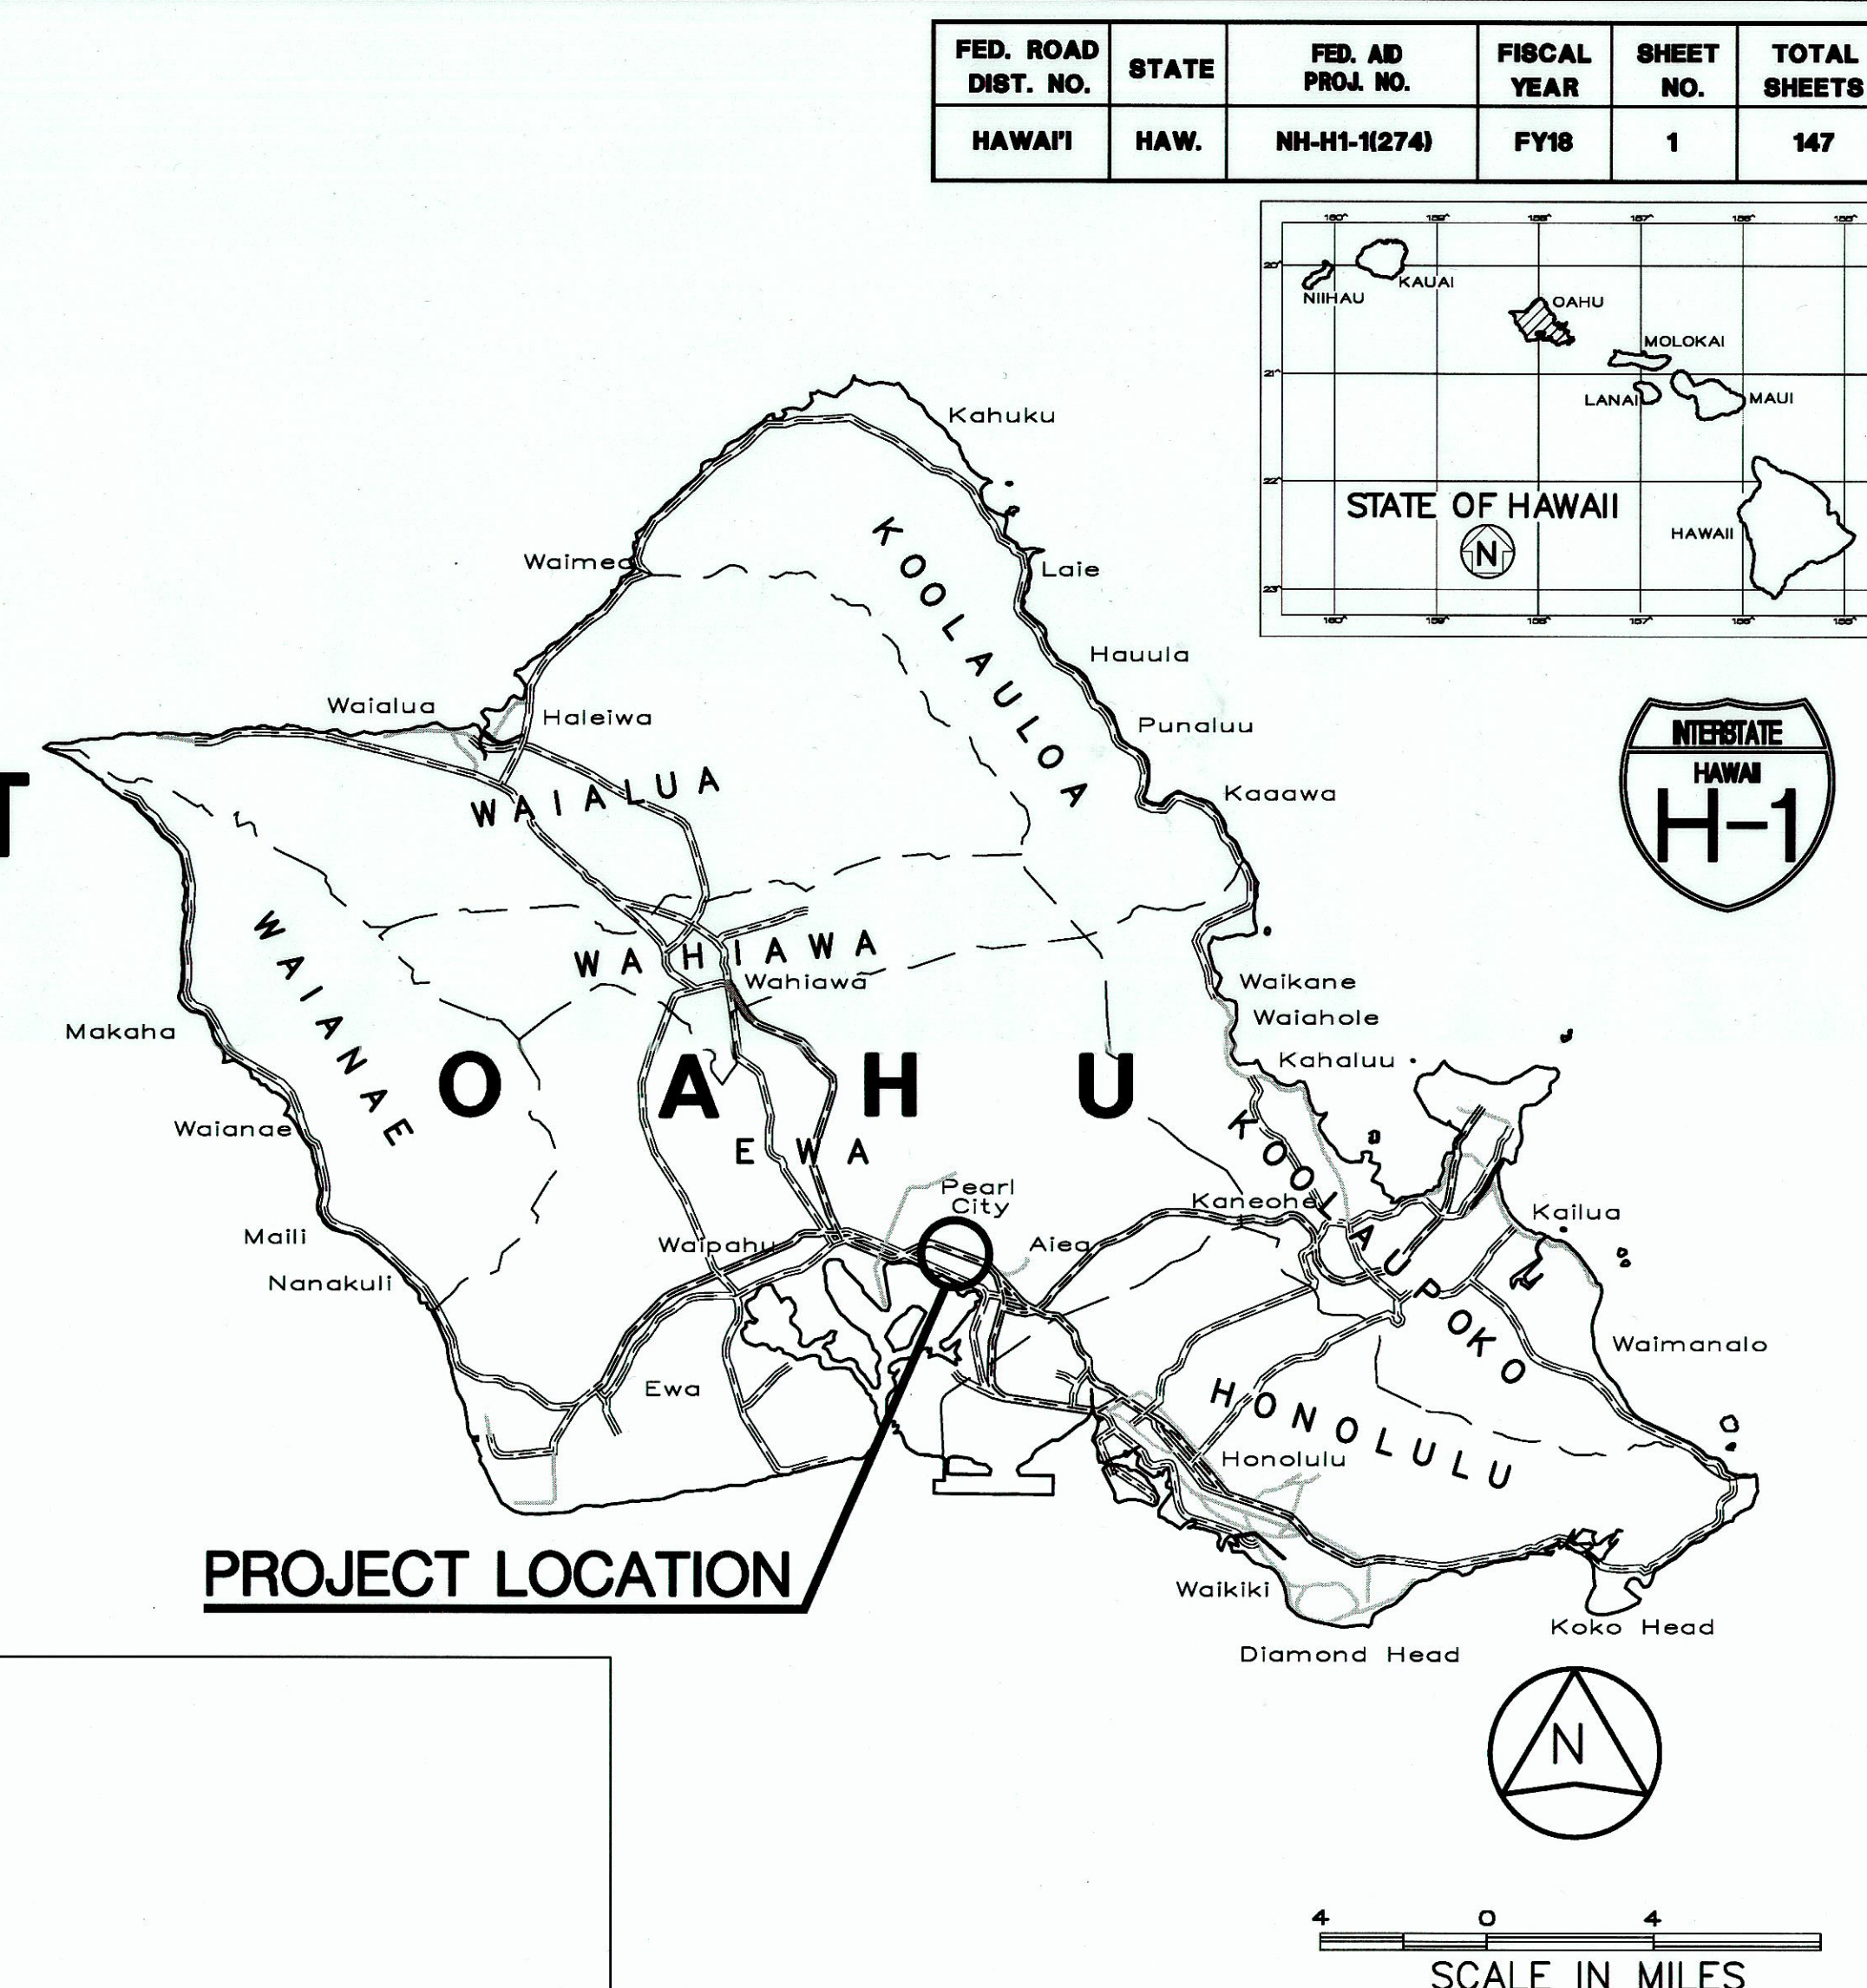

831-6700

4/9/18

PHONE


DATE

HWY-0

MANAGED BY

R.M. TOWILL CORPORATION


DESIGNED BY

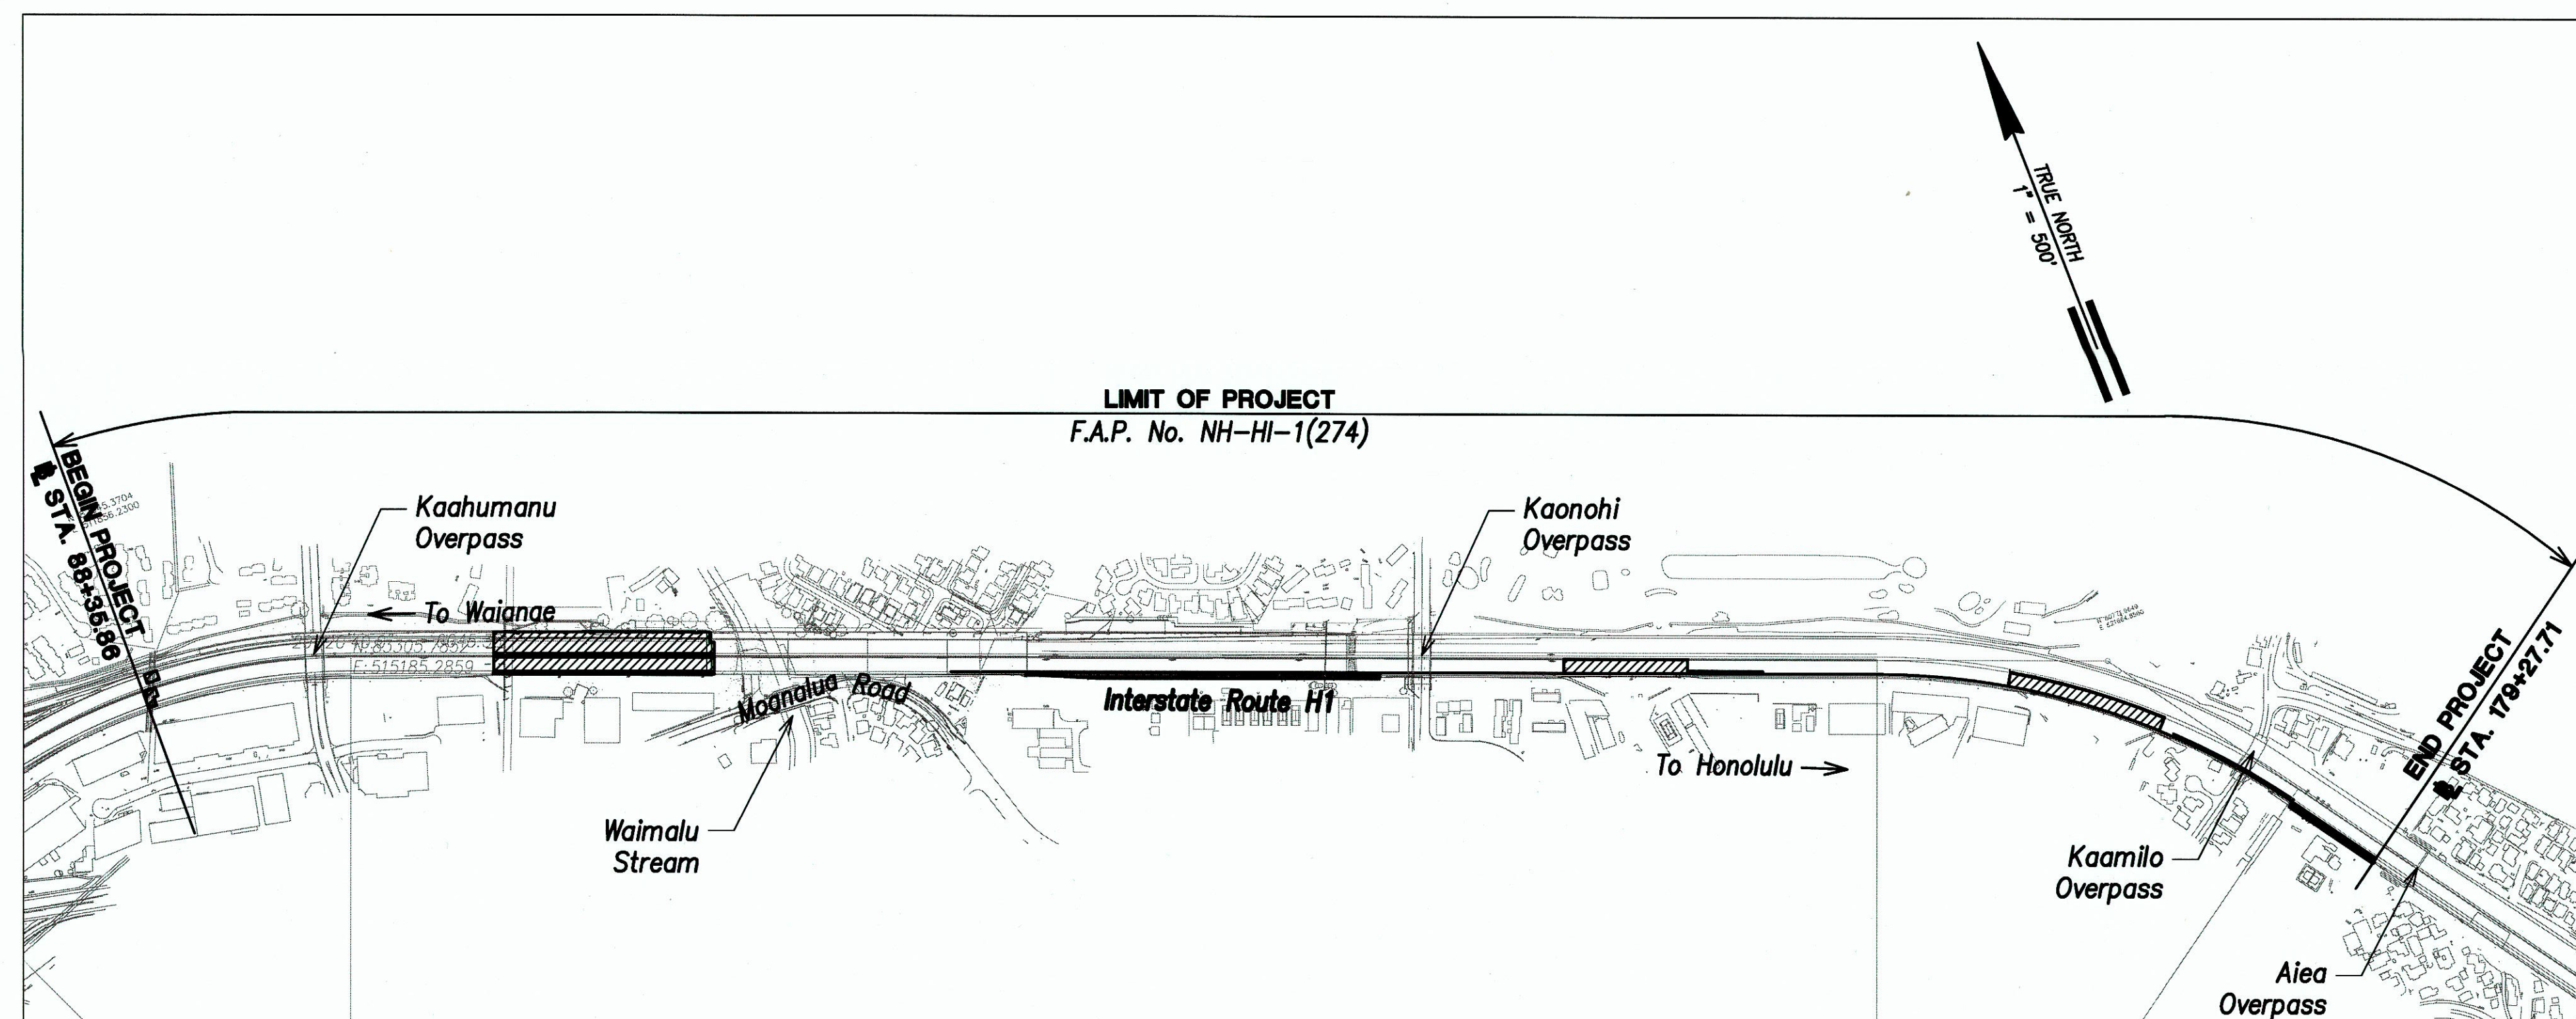

LAYOUT PLAN

NET LENGTH OF PROJECT - 0.80 MILES

GROSS LENGTH OF PROJECT - 1.72 MILES

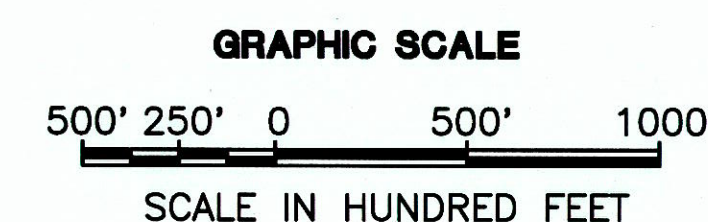

CHANGES MADE DURING CONSTRUCTION HAVE BEEN INCORPORATED ON THESE PLANS EXCEPT CHANGES IN THE ORIGINAL THEORETICAL QUANTITIES. FOR ACTUAL QUANTITIES, REFER TO PROJECT LEDGER AND/OR COMPUTATION BOOK.

Samuel P. Renteria

7/28/20

DATE

RESIDENT ENGINEER

DEPARTMENT OF TRANSPORTATION

STATE OF HAWAII

APPROVED:

Samuel P. Renteria

3/4/20

DATE

DIR. OF TRANSPORTATION