

INDEX TO DRAWINGS	
SHEET NO.	DESCRIPTION
1	TITLE SHEET
2	SHEET INDEX
3	STANDARD PLANS SUMMARY
4 - 25	CIVIL DRAWINGS
36 - 65	STRUCTURAL DRAWINGS

STATE OF HAWAII

DEPARTMENT OF TRANSPORTATION

HIGHWAYS DIVISION

HONOLULU, HAWAII

"AS-BUILT"

PLANS FOR

INTERSTATE ROUTE H-1

SHOULDER WORK AND PORTLAND CEMENT

CONCRETE PAVEMENT REHABILITATION


PHASE 3 - ADDITIONAL PANELS

FEDERAL AID PROJECT NO. NH-H1-1(274)

DISTRICT OF EWA AND HONOLULU

ISLAND OF OAHU

FED. ROAD DIST. NO.	STATE	FED. AID PROJ. NO.	FISCAL YEAR	SHEET NO.	TOTAL SHEETS
HAWAII	HAW.	NH-H1-1(274)	FY18	1	65

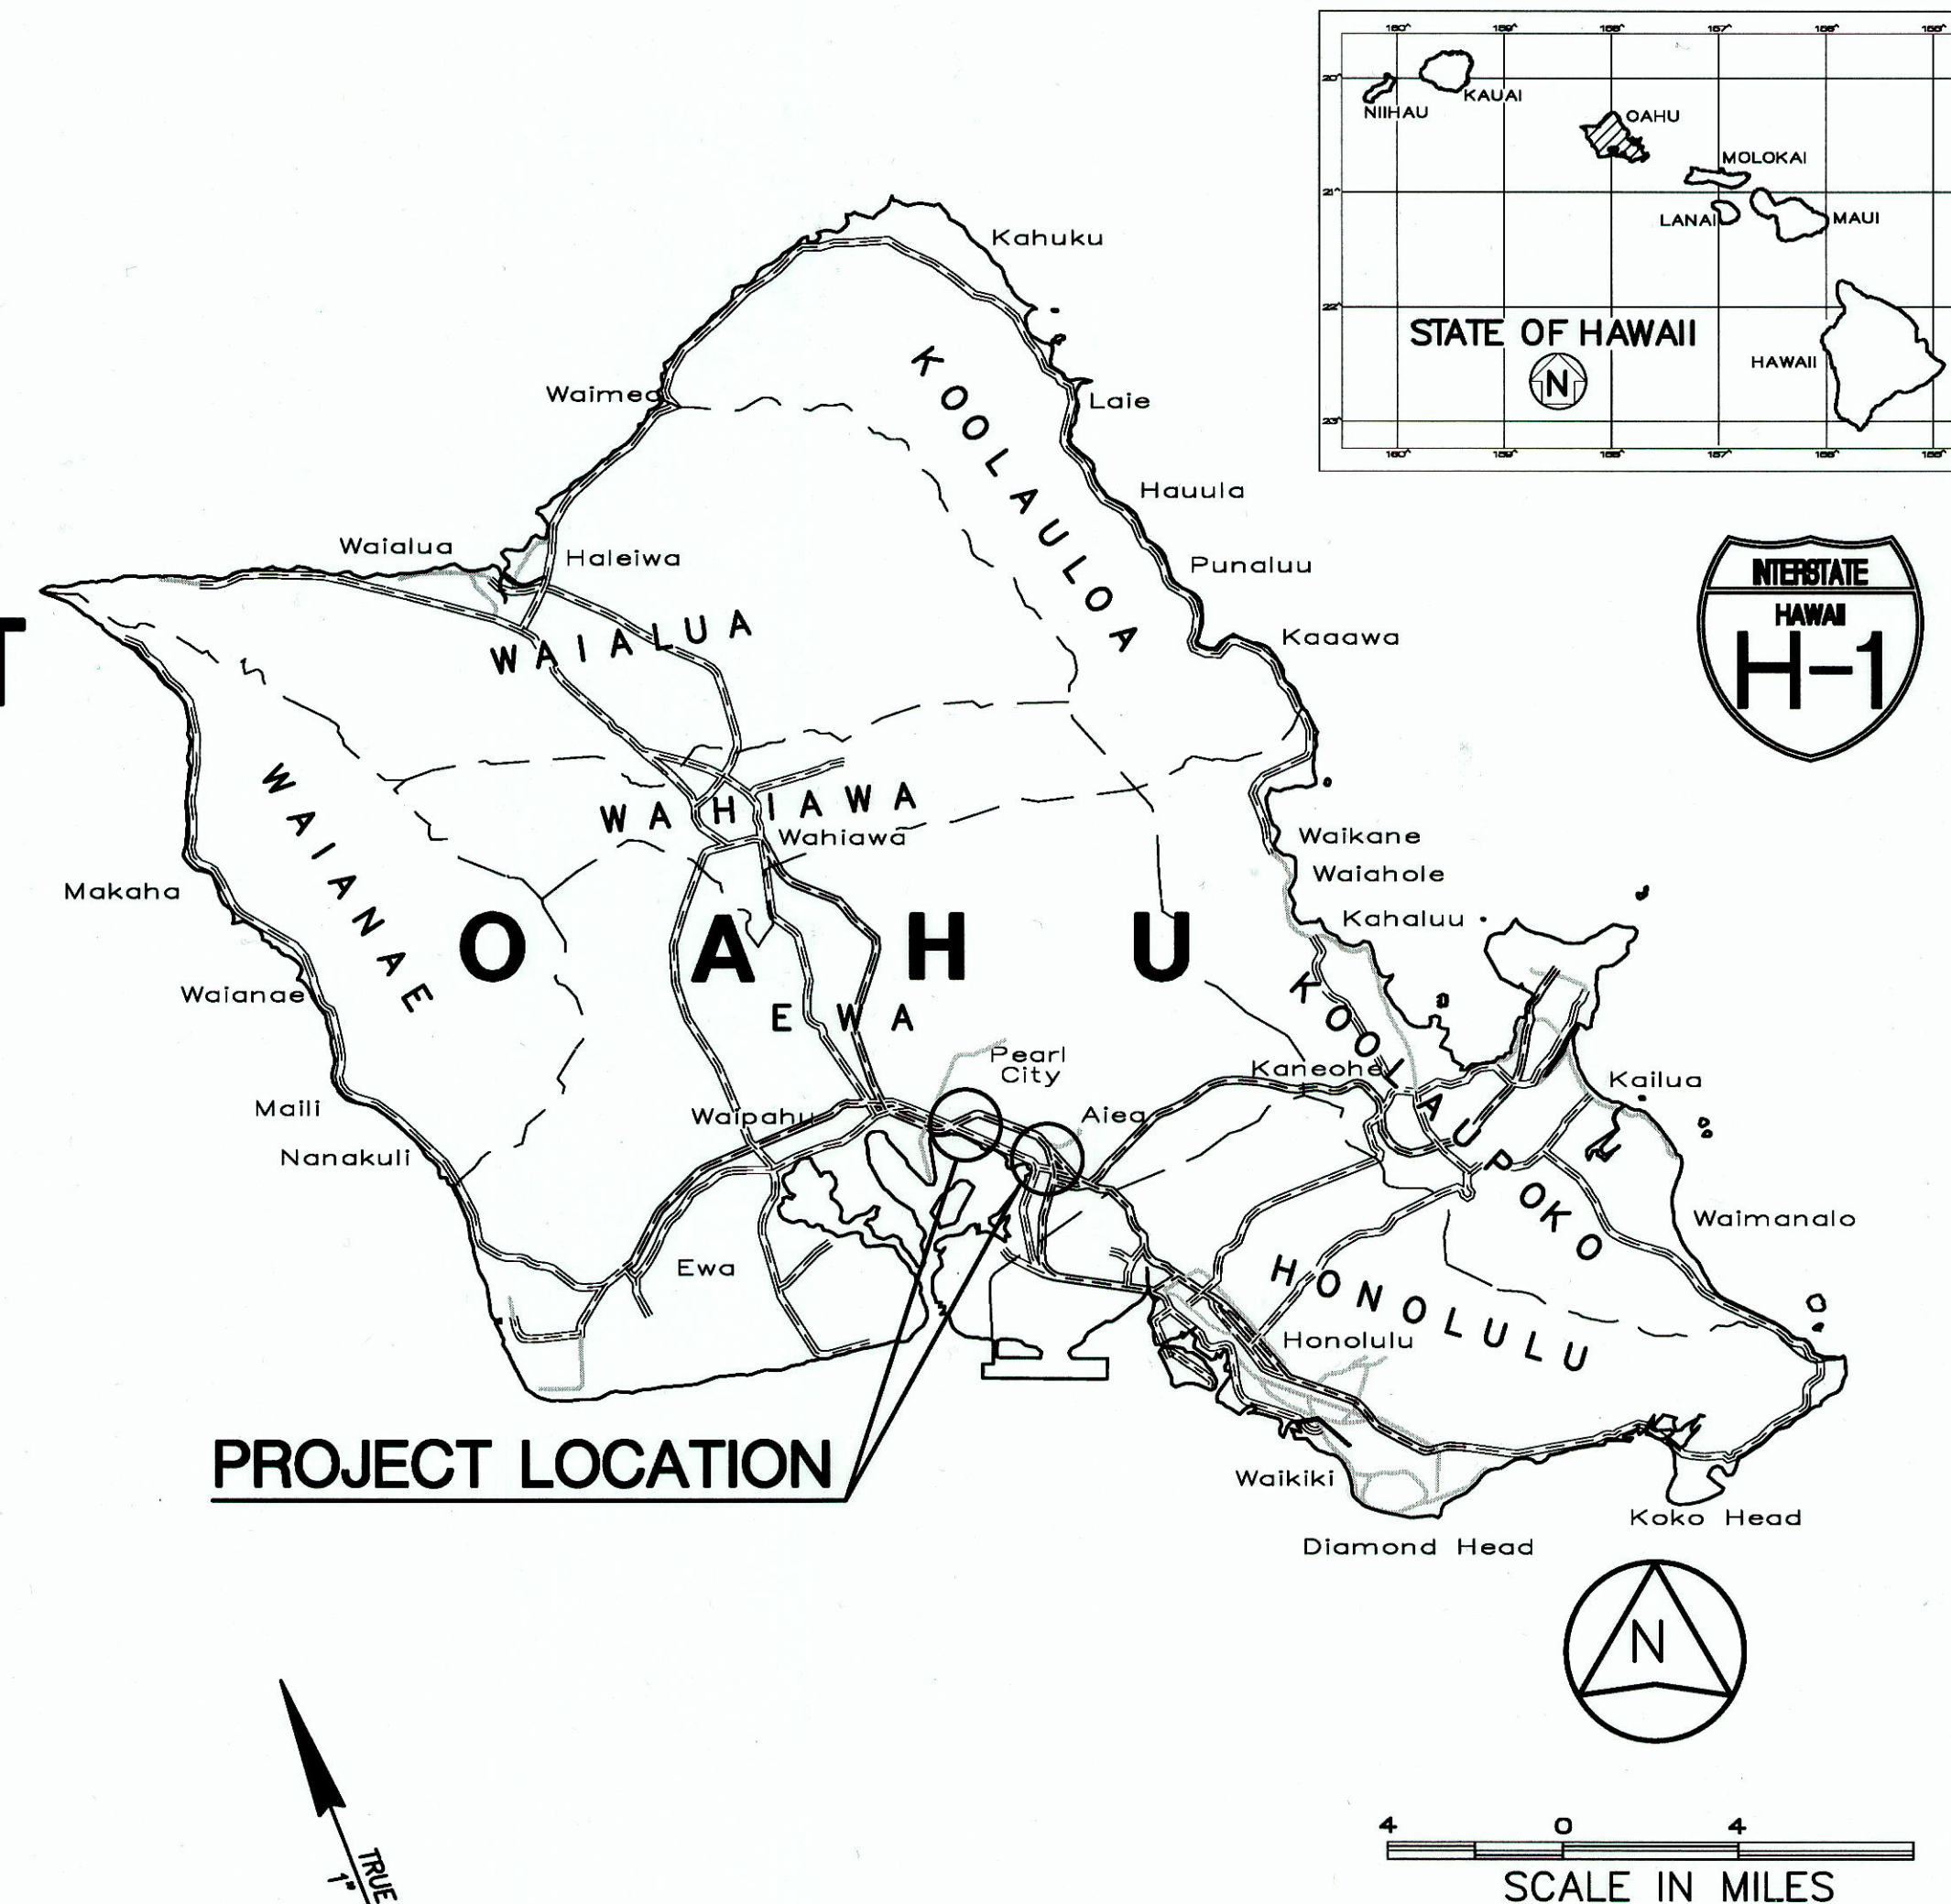

831-6700 10/10/18

DATE


PHONE

HWY-0

MANAGED BY

R.M. TOWILL CORPORATION

DESIGNED BY

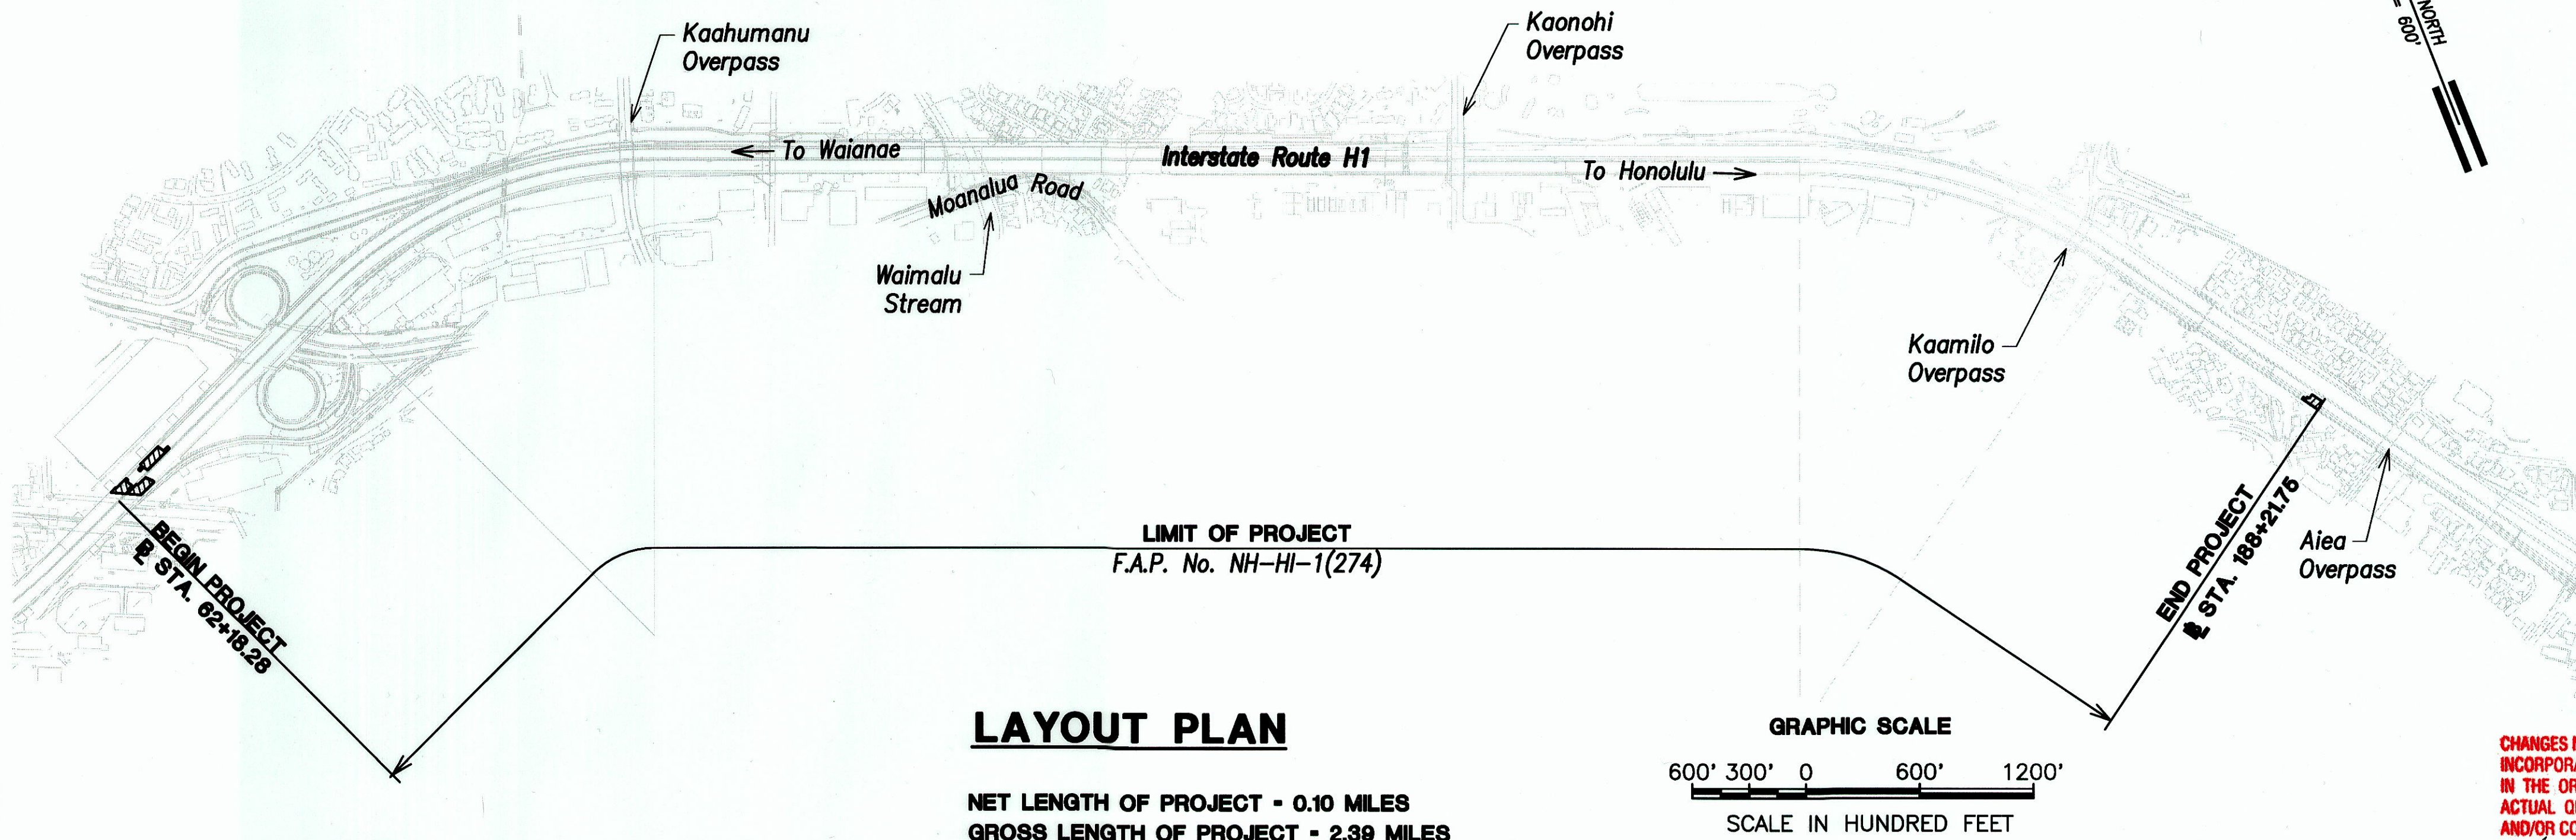

FEDERAL AID PROJECTS PREVIOUSLY CONSTRUCTED OR UNDER CONSTRUCTION

MILE POST 10.10 TO MILE POST 12.55

DESIGN DESIGNATION

ADT (2016)	260,300
DESIGN ADT (2036)	300,200
DHV	21,000
D (DESIGN)	60/40
T (DESIGN)	4.5%
T24	4.0%
V	60 MPH

CHANGES MADE DURING CONSTRUCTION HAVE BEEN INCORPORATED ON THESE PLANS EXCEPT CHANGES IN THE ORIGINAL THEORETICAL QUANTITIES. FOR ACTUAL QUANTITIES, REFER TO PROJECT LEDGER AND/OR COMPUTATION BOOK.

Samuel M. Romberg 7/28/20
RESIDENT ENGINEER DATE

DEPARTMENT OF TRANSPORTATION
STATE OF HAWAII
APPROVED:
Samuel M. Romberg 3/4/20
DIR. OF TRANSPORTATION DATE