

STRUCTURAL GENERAL NOTES:

General:

- A. Workmanship and materials shall conform to the AASHTO LRFD Bridge Design Specification, 7th Edition, Hawaii Standard Specifications for Road and Bridge Construction (2005 Edition), and HDOT Design Criteria for Bridges and Structures, August 8, 2014.
- B. The contractor shall compare all the contract documents with each other and report in writing to the engineer all inconsistencies and omissions.
- C. The contractor shall take field measurements and verify field conditions and shall compare such field measurements and conditions with the drawings before commencing work. Report in writing to the engineer all inconsistencies and omissions.
- D. The contractor shall be responsible for coordinating the work of all trades.
- E. The contractor shall be responsible for means and methods of construction, workmanship and job safety.
- F. The contractor shall provide temporary shoring and bracing as required for stability of structural members and systems.
- G. Construction loading shall not exceed design live load unless special shoring is provided. Permitted construction loads shall be properly reduced in areas where the structure has not attained full design strength.
- H. The contractor shall be responsible for protection of the adjacent properties, structures, streets and utilities during the construction period. Any damaged or deteriorated property shall be restored to the condition prior to the beginning of work or better at no cost to the State.
- I. Details noted as typical on the structural drawings shall apply in all conditions unless specifically shown or noted otherwise.
- J. Elevations and details of the existing bridges and other miscellaneous structures as shown on these plans are based on as-built drawings. The contractor shall be responsible for verifying all existing elevations and existing structure details and shall notify the engineer in writing of any discrepancies for further action.

Design Criteria:

- A. Dead load
- Weight of all components of the structures, appurtenances attached thereto, and earth covers.
 - Unit weight of concrete ----- 160 pcf
 - Compacted earth ----- 120 pcf
 - Future wearing surface ----- 25 psf
- B. Live load ----- AASHTO HL-93
- C. Collision load ----- AASHTO TL-3
- D. Seismic ----- See Table
- E. Basic Wind Speed ----- 105 MPH
- F. Design soil parameters for retaining structures ----- See Table

Foundation:

- A. Foundation design is based upon Geotechnical Exploration and Evaluation Report by Yogi Kwong Engineers, LLC, dated June 2018.
- B. Contractor shall provide for de-watering of excavation from either surface water, ground water or seepage. NPDES permit required for discharging into state waters.
- C. Contractor shall provide for design and installation of all cribbing, sheeting, and shoring necessary for personnel safety and to preserve excavations and earth banks, and adjacent structures and property for damage. Shoring shall conform to OSHA regulations.
- D. Excavation boundaries and grade elevations for footing shall be accepted by a geotechnical engineer licensed in the State of Hawaii prior to placing the concrete and reinforcing.
- E. Footing for Wall 1 shall bear on a 6" layer of aggregate select borrow compacted to a minimum of 95% relative density in accordance with ASTM D1557. Prior to the placement of the select borrow, the exposed soils should be scarified to a depth of 6", moisture conditioned to within 2% of optimum moisture and compacted to no less than 95% relative density in accordance with ASTM D1557. Bottom of footing shall be compacted to provide a relatively firm and smooth bearing surface prior to placement of reinforcing steel and concrete. Footing for Wall 4 shall bear on a clean rock surface. If soft and/or loose materials are encountered at the bottom of excavations, they shall be over-excavated to expose the underlying firm materials. The over-excavated area shall be backfilled with the same select borrow or the footing bottom may be extended down to the underlying competent material. Contractor may substitute flowable concrete for the select borrow upon acceptance from the engineer.
- F. Footing for Wall 1 shall bear on a 6-inch layer of aggregate select borrow (min CBR=25) compacted to no less than 95% relative density in accordance with ASTM D1557. Prior to the placement of the select borrow, the exposed soils should be scarified to a depth of 6-inches, moisture conditioned to within 2% of optimum moisture content and compacted to no less than 90% relative density in accordance with ASTM D1557. Bottom of footing shall be compacted to provide a relatively firm bearing surface prior to placement of reinforcing steel and concrete. Footing for Wall 4 shall bear on a clean, rough cut rock surface free from debris and soil.
- G. If soft and/or loose materials are encountered at the bottom of excavations, they shall be over-excavated a minimum of 24-inches and replaced to proper grade with Structure Backfill Material A (JSS703.20). Contractor may substitute flowable concrete for the select borrow upon acceptance from the engineer.
- H. Engineered fill and backfill shall be in accordance with Section 703.20 of the Hawaii Standard Specifications for Road and Bridge construction, 2005 Edition.
- I. Fill should be moisture conditioned to within two percent of the optimum moisture content and placed in horizontal lifts not to exceed six inches. Fill shall be compacted to minimum 95% relative density as measured by ASTM D1557, method A or D.
- J. Backfill behind Wall 1 and 4 shall consist of either select granular fills or CLSM. Granular backfill shall be placed in uniform lifts of no more than 8 inches in loose thickness and uniformly compacted to at least 95 percent relative compaction.

Concrete:

- A. Concrete shall be regular weight hard rock concrete and shall have the following minimum 28-day compressive strengths and water to cement ratios:
- | Structural Item | Minimum Compressive Strength f'c (28 days) | Maximum (W/C) |
|---|--|---------------|
| 1. Retaining Walls and Foundations ---- | 4,000 psi | 0.45 |
| 2. Light Standard Foundations ----- | 4,500 psi | 0.45 |
| 3. All other concrete ----- | 4,000 psi | 0.45 |
- B. The use of any calcium chloride in any concrete is prohibited.
- C. Concrete delivery tickets shall record all free water in the mix at batching plant, added for consistency by driver, and any additional request by contractor up to the maximum amount allowed by the mix design.
- D. Conduits, pipes, and sleeves passing through a wall not conforming to typical details shall be located and submitted to the structural engineer for approval.
- E. Construction joints may be relocated by the contractor and submitted to the structural engineer for approval. Construction joints shall be made and relocated as not to impair the strength of the structure and to minimize shrinkage stresses. All construction joints shall be cleaned, laitance removed and wetted. See typical details for specific requirements.
- F. Unless otherwise noted, chamfer all exposed concrete edges 3/4".
- G. Reinforcing bars, anchor bolts, inserts and other items to be cast in the concrete shall be secured in position prior to placement of concrete.
- H. All inserts, anchor bolts, plates, and other structural items to be cast in the concrete shall be hot-dipped galvanized according to ASTM A153 unless otherwise noted.
- I. Non-shrink grout shall be a premixed non-metallic formula, capable of developing a minimum compressive strength of 4,000 psi in 1 day and 7,000 psi in 28 days.
- J. Stay-in-place forms shall not be allowed.

Reinforcing Steel:

- A. Reinforcing steel shall be deformed bars conforming to ASTM A615, Grade 60 unless otherwise noted. Epoxy-coated dowels shall conform to ASTM A775, Grade 60 unless otherwise noted.
- B. The contractor shall not damage the epoxy coating on the dowels and deformed bars in any way during shipment, handling, or placement. Damaged epoxy coated dowels and deformed bars shall be replaced at no cost to the State. Repair of epoxy coating as approved by the Engineer shall meet ASTM A775.
- C. Clear concrete coverage for reinforcing bars shall be as follows, unless otherwise noted:
- 1. Footings, etc. cast against earth ----- 3"
 - 2. Footings, walls, etc. formed and exposed to earth or weather ----- 2"
 - 3. Pavement slab top bars ----- 2 1/2"
- C. Thru bolts for guardrail connection shall conform to AASHTO M164 (ASTM A325), unless otherwise noted.
- D. Reinforcing steel shall be spliced only where indicated on plans. Provide lap splice length per typical details and schedule, Sheet S0.2, unless otherwise noted.
- E. Mechanical splice connectors shall develop, in tension, 125 percent of the specified minimum yield strength of reinforcing bars.
- F. Bar bends and hook shall be "standard hooks" in accordance with typical details Sheet S0.2.
- G. Corrosion inhibitors for reinforcing steel threaded connections shall be a thread-sealing compound such as Loctite 5113, or an approved equal.


FED. ROAD DIST. NO.	STATE	FED. AID PROJ. NO.	FISCAL YEAR	SHEET NO.	TOTAL SHEETS
HAWAII	HAW.	NH-H1-112741	2018	83	126

RETAINING WALL DESIGN PARAMETERS			
Item		Wall 1	Wall 4
0.2-second spectral response coefficient, s_s		0.39	0.39
1.0-second spectral response coefficient, s_1		0.11	0.11
Horizontal peak ground coefficient, PGA		0.17	0.17
Site Class		B	B
Seismic Design Zone		1	1
Bearing Capacity (psf)	Extreme Event	7,200	13,500
	Strength	3,240	6,075
Passive Earth Pressure (pcf)	Extreme Event	450	600
	Strength	250	300
Lateral Earth Pressure (pcf)	Active (1.5:1 Slope)	46	46
	At-Rest (1.5:1 Slope)	75	75
Dynamic Lateral Earth Pressure (pcf)	Unrestrained	11.1	11.1
	Restrained	49.3	49.3
Coefficient of Friction	Extreme Event	0.31	0.70
	Strength	0.25	0.56

ORIGINAL PLAN	SURVEY PLOTTED BY	DATE
NOTE BOOK	DRAWN BY	
No. _____	TRACED BY	
	QUANTITIES BY	
	CHECKED BY	

P:\451-4500\4458 H007 - Kiewit Design build of HI Widening\004 Drawings\Structural\AutoCAD format\Phase 2\2020-02-06 - As-Built\4458_S0-1-S0-2.dwg 2/6/2020 11:21 AM BRYAN LUM

THESE PLANS HAVE BEEN PREPARED UTILIZING INFORMATION PROVIDED BY THE PROJECT CONTRACTOR. THE UPDATED CONSTRUCTION INFORMATION DEPICTED HEREIN HAS NOT BEEN VERIFIED FOR ACCURACY AND COMPLETENESS. NO REPRESENTATION IS BEING MADE TO ITS VALIDITY.

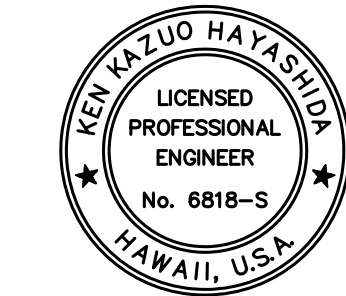

THIS WORK WAS PREPARED BY ME OR UNDER MY SUPERVISION.

SIGNATURE: *[Signature]* April 30, 2020
EXPIRATION DATE OF THE LICENSE

STATE OF HAWAII
DEPARTMENT OF TRANSPORTATION
HIGHWAYS DIVISION

STRUCTURAL GENERAL NOTES

INTERSTATE ROUTE H-1
SHOULDER WORK AND PORTLAND CEMENT
CONCRETE PAVEMENT REHABILITATION
VICINITY OF WAIMALU TO VICINITY OF HALAWA
PHASE 2 - SHOULDER WORK


Scale: As Shown
Date: November 30, 2018

SHEET No. S0.1 OF 2 SHEETS


MINIMUM SPLICE & EMBEDMENT LENGTHS					
Bar Size	Lap Splice		Embedment		
	Top Bars	Other Bars	Straight		with Standard 90° Hook
			Top Bars	Other Bars	
#3, #4	29"	21"	17"	12"	8"
#5	36"	26"	21"	15"	10"
#6	43"	31"	26"	18"	12"
#7	54"	39"	32"	23"	14"
#8	71"	51"	42"	30"	16"
#9	90"	64"	53"	38"	18"

- Notes:**
- "Top Bars" are horizontal bars with 12" or more of concrete cast below.
 - Splice lengths may be reduced by multiplying the tabulated values by 0.765 if the centerline of splice of adjacent bars are staggered 6'-0" o.c. for #9 bars and smaller.
 - Embedment lengths for straight bars may be reduced by multiplying the tabulated values by 0.80 if the bars are spaced laterally not less than 6" center-to-center, with not less than 3" clear cover measured in the direction of the spacing.
 - Embedment lengths for bars with 90° hook are bars with side cover, normal to plane of hook, of not less than 2½" and cover on bar extension beyond hook not less than 2". Increase embedment length by 43% for bars not meeting these requirements.



TYPICAL REBAR SPLICE AND EMBEDMENT LENGTH SCHEDULE
Not to Scale

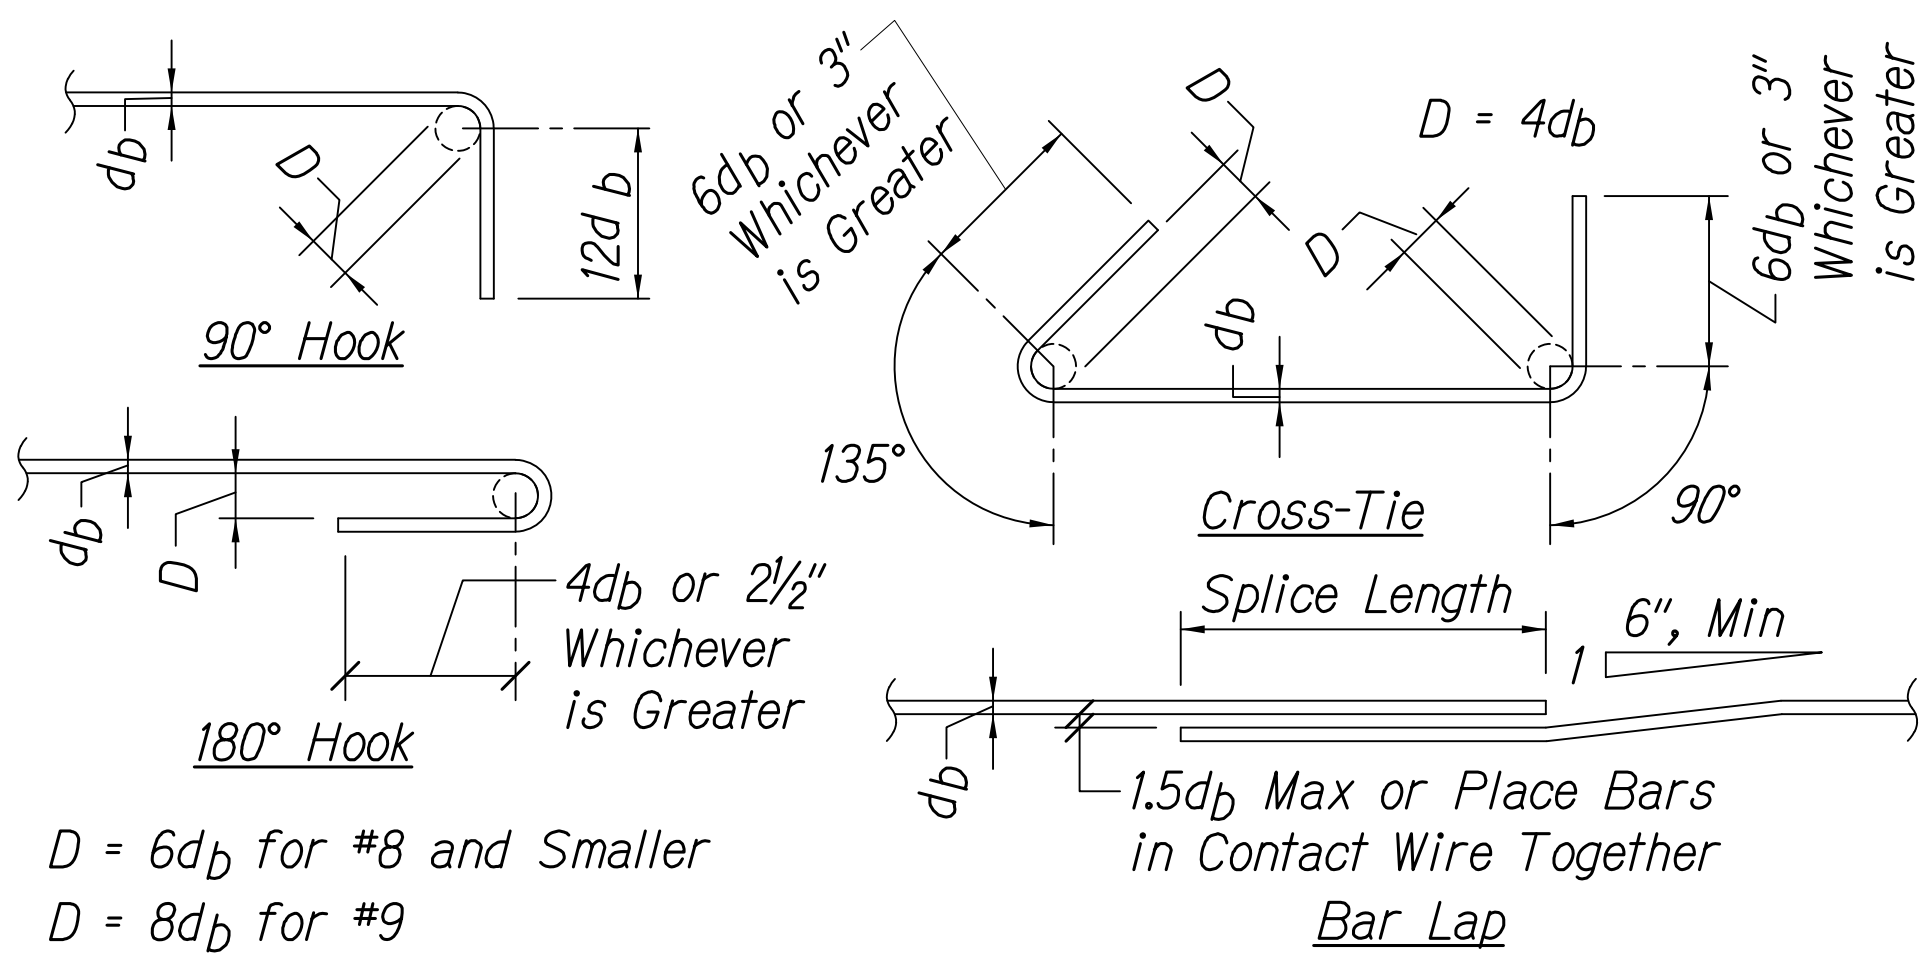


STANDARD HOOKS AND CROSS-TIE DETAIL
Not to Scale

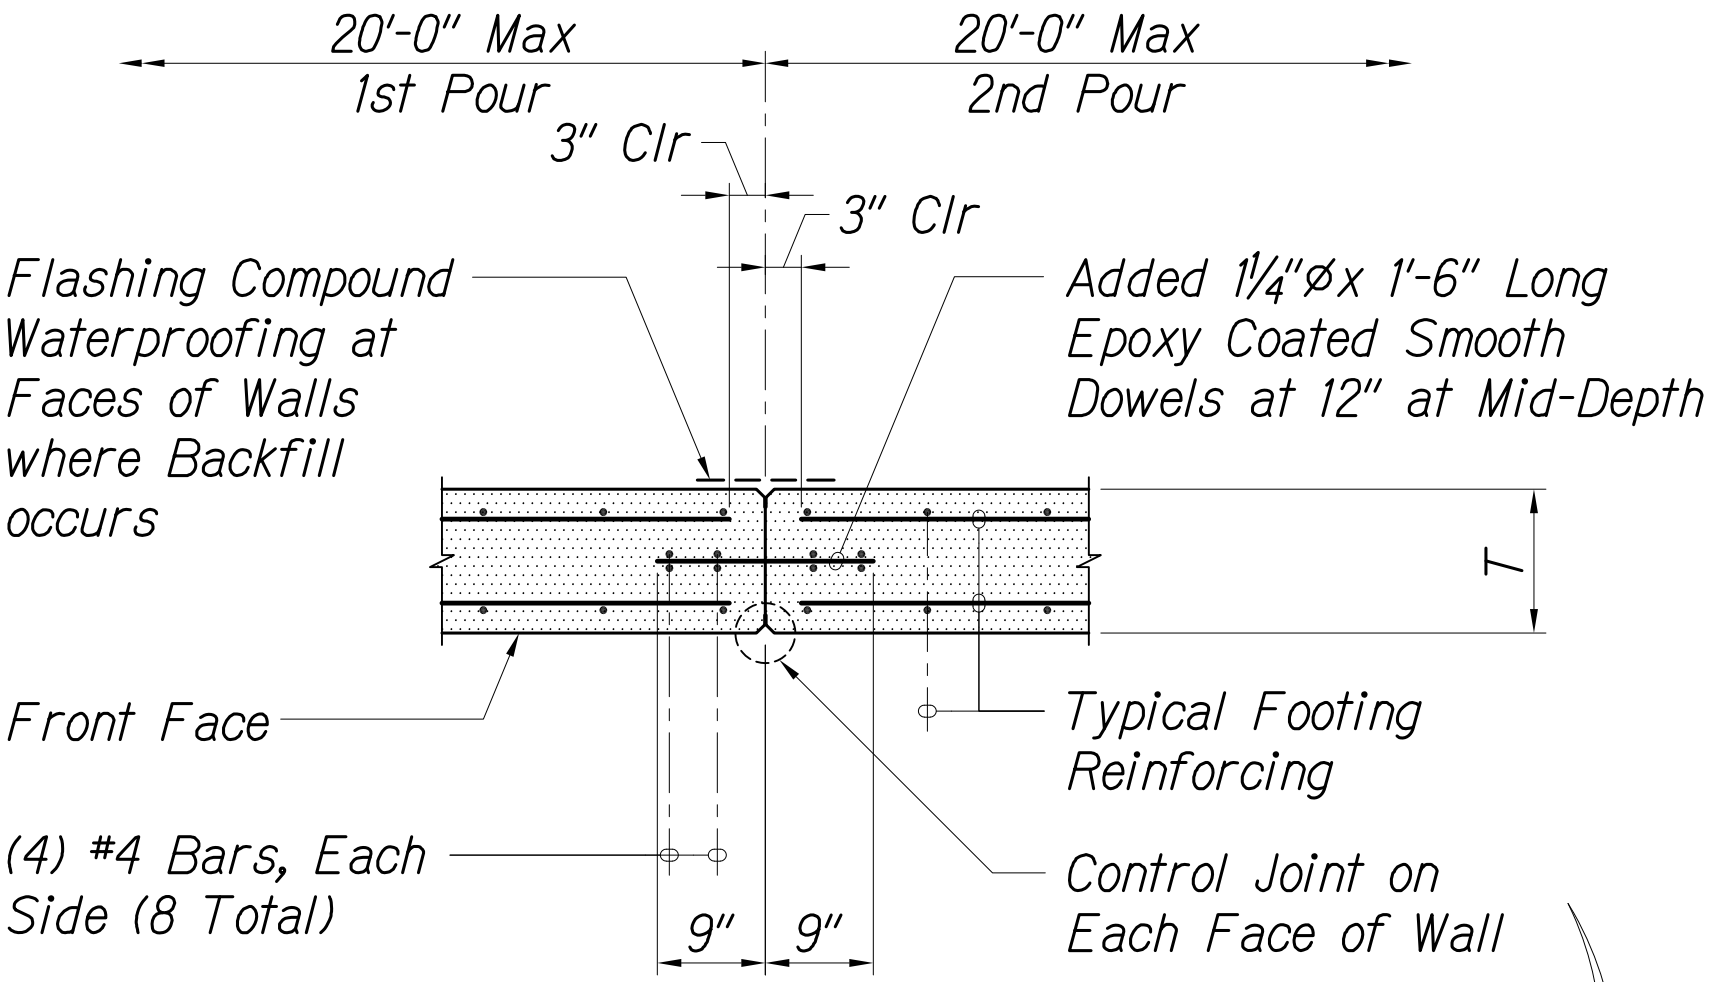

At Control/Construction Joint in Wall

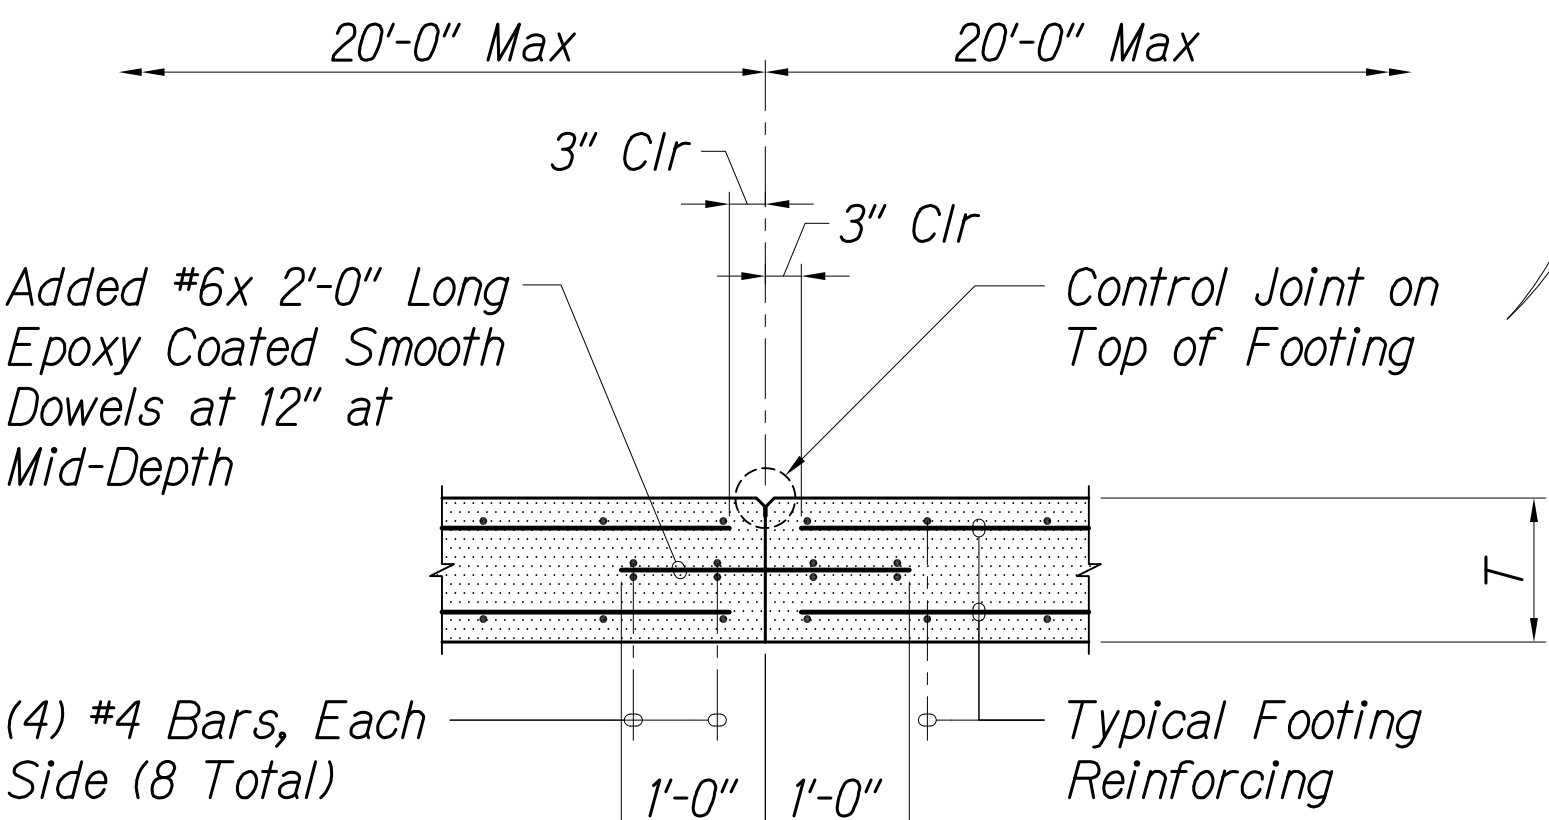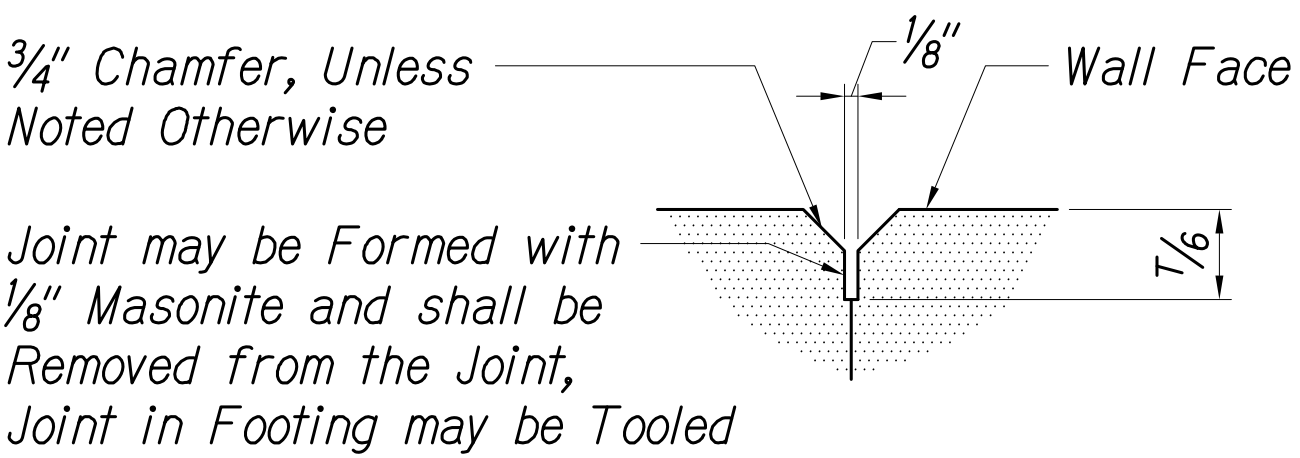


At Control Joint or Construction Joint at Control Joint in Footing

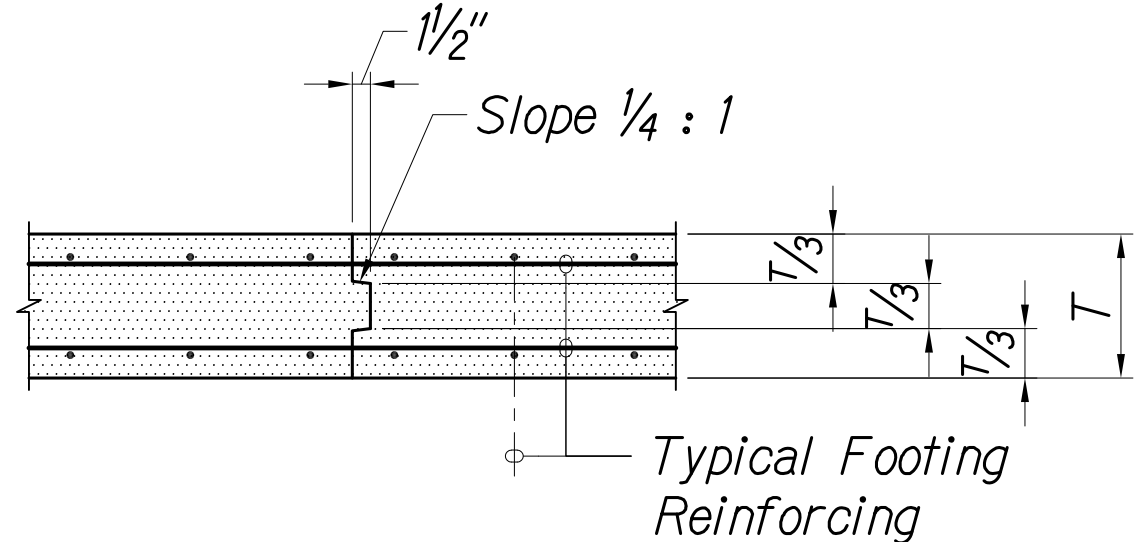


At Construction Joint in Footing

TYPICAL JOINT DETAILS
Not to Scale


FED. ROAD DIST. NO.	STATE	FED. AID PROJ. NO.	FISCAL YEAR	SHEET NO.	TOTAL SHEETS
HAWAII	HAW.	NH-H1-1(274)	2018	84	126

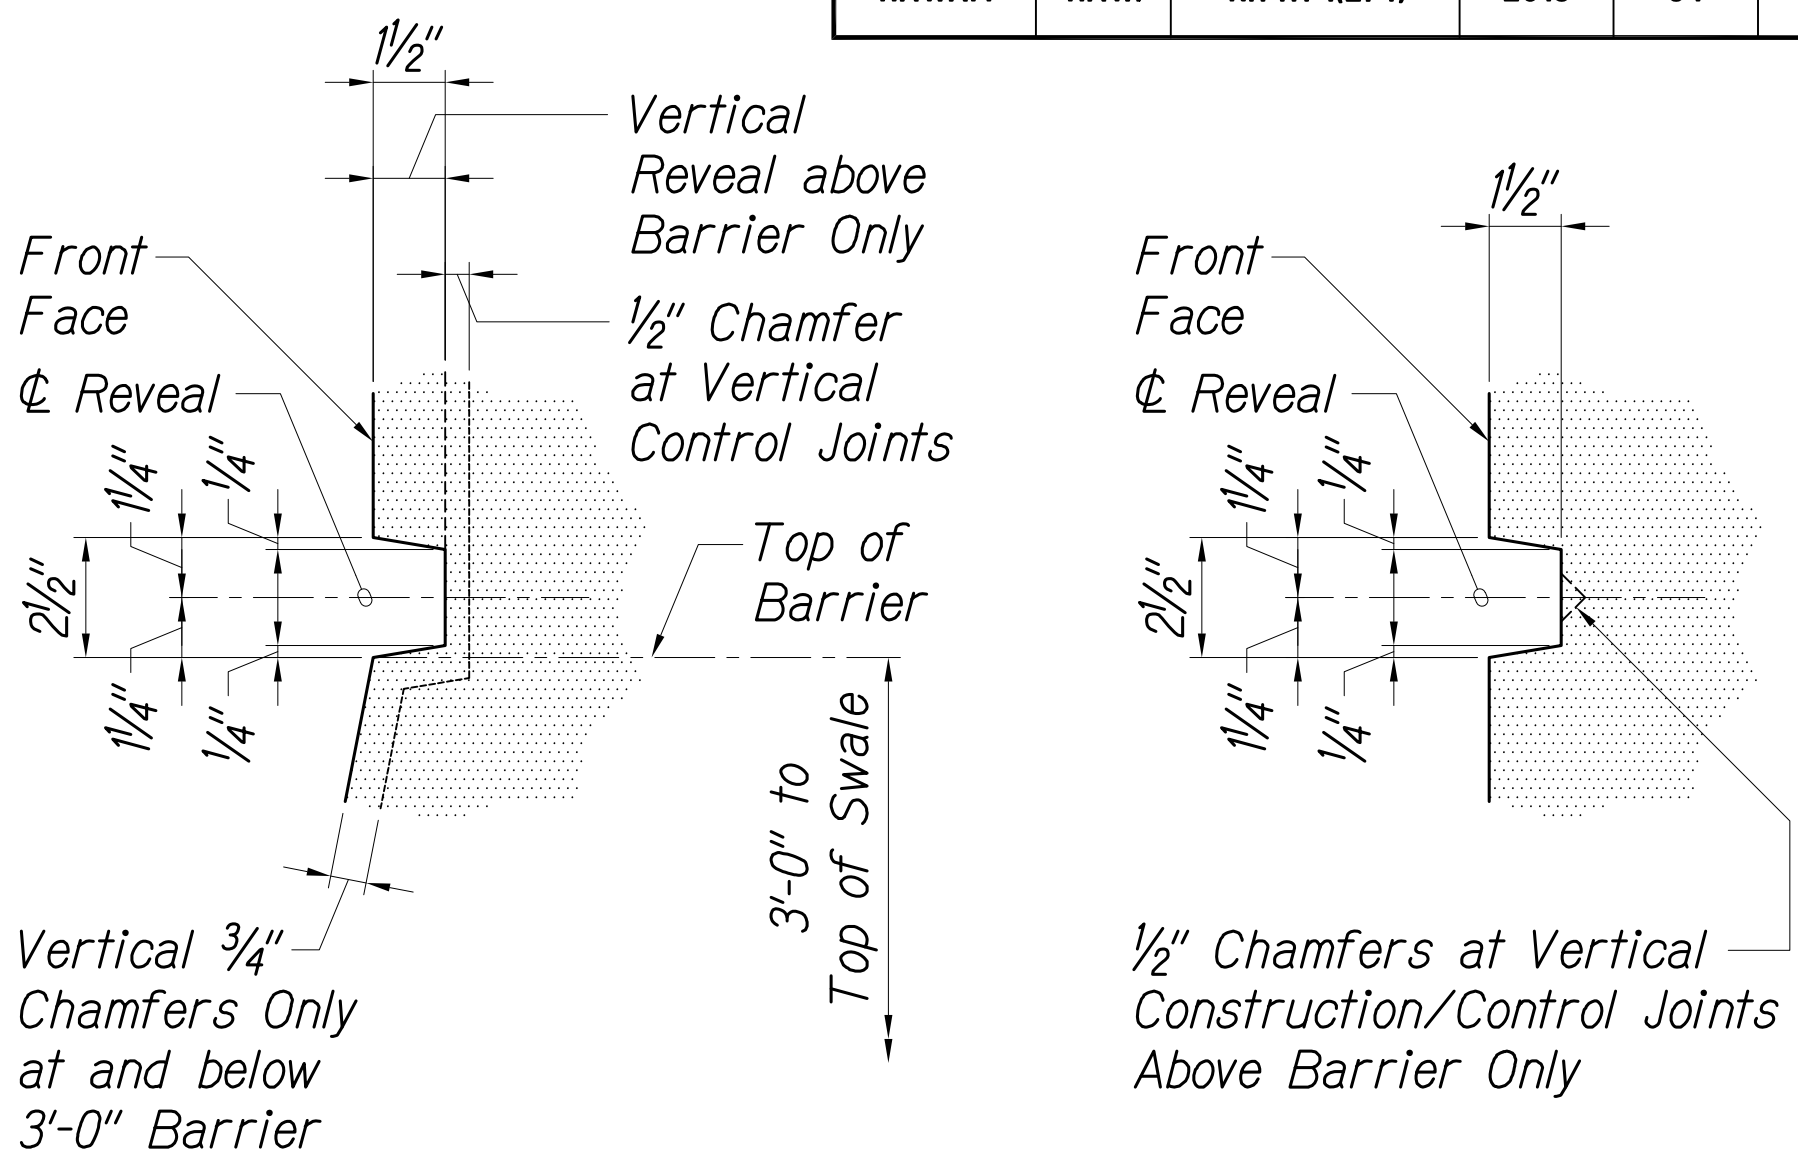

TYPICAL REVEAL DETAILS
Not to Scale

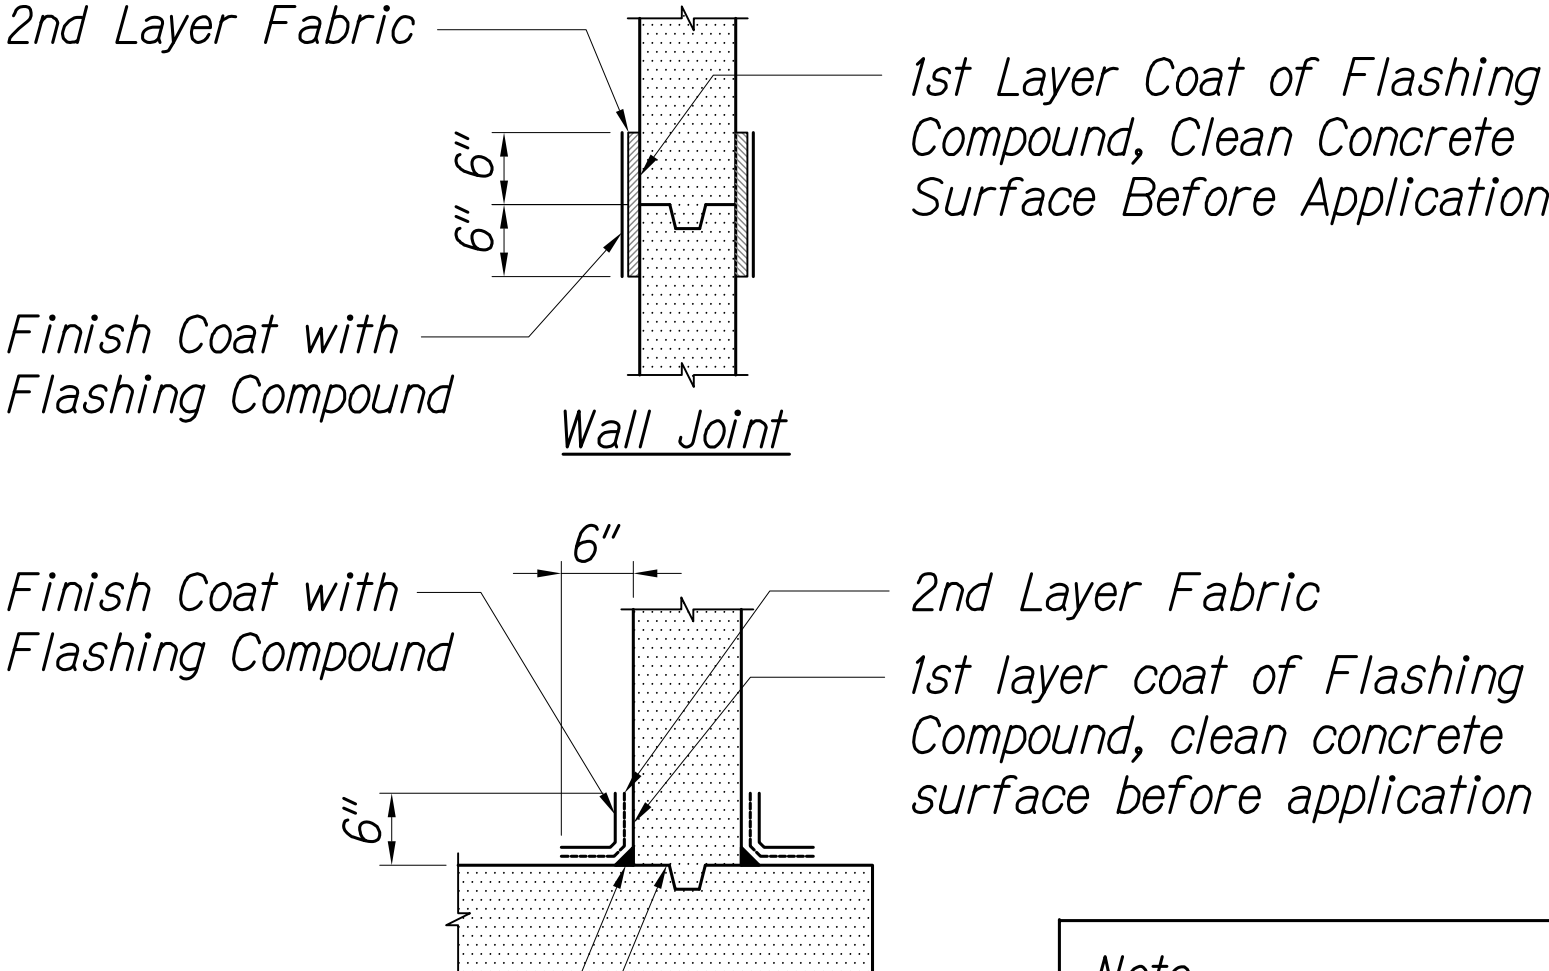

TYPICAL WATERPROOFING DETAIL
Not to Scale

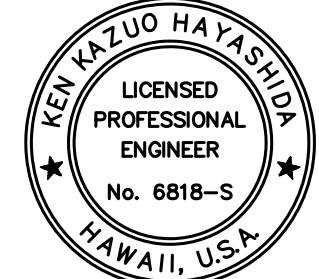

THESE PLANS HAVE BEEN PREPARED UTILIZING INFORMATION PROVIDED BY THE PROJECT CONTRACTOR. THE UPDATED CONSTRUCTION INFORMATION DEPICTED HEREIN HAS NOT BEEN VERIFIED FOR ACCURACY AND COMPLETENESS. NO REPRESENTATION IS BEING MADE TO ITS VALIDITY.

THIS WORK WAS PREPARED BY ME OR UNDER MY SUPERVISION.
Signature: [Signature] April 30, 2020
EXPIRATION DATE OF THE LICENSE


STATE OF HAWAII
DEPARTMENT OF TRANSPORTATION
HIGHWAYS DIVISION
TYPICAL DETAILS

INTERSTATE ROUTE H-1
SHOULDER WORK AND PORTLAND CEMENT
CONCRETE PAVEMENT REHABILITATION
VICINITY OF WAIMALU TO VICINITY OF HALAWA
PHASE 2 - SHOULDER WORK

Scale: As Shown Date: November 30, 2018

SHEET No. S0.2 OF 2 SHEETS


FED. ROAD DIST. NO.	STATE	FED. AID PROJ. NO.	FISCAL YEAR	SHEET NO.	TOTAL SHEETS
HAWAII	HAW.	NH-H1-1(274)	2018	85	126


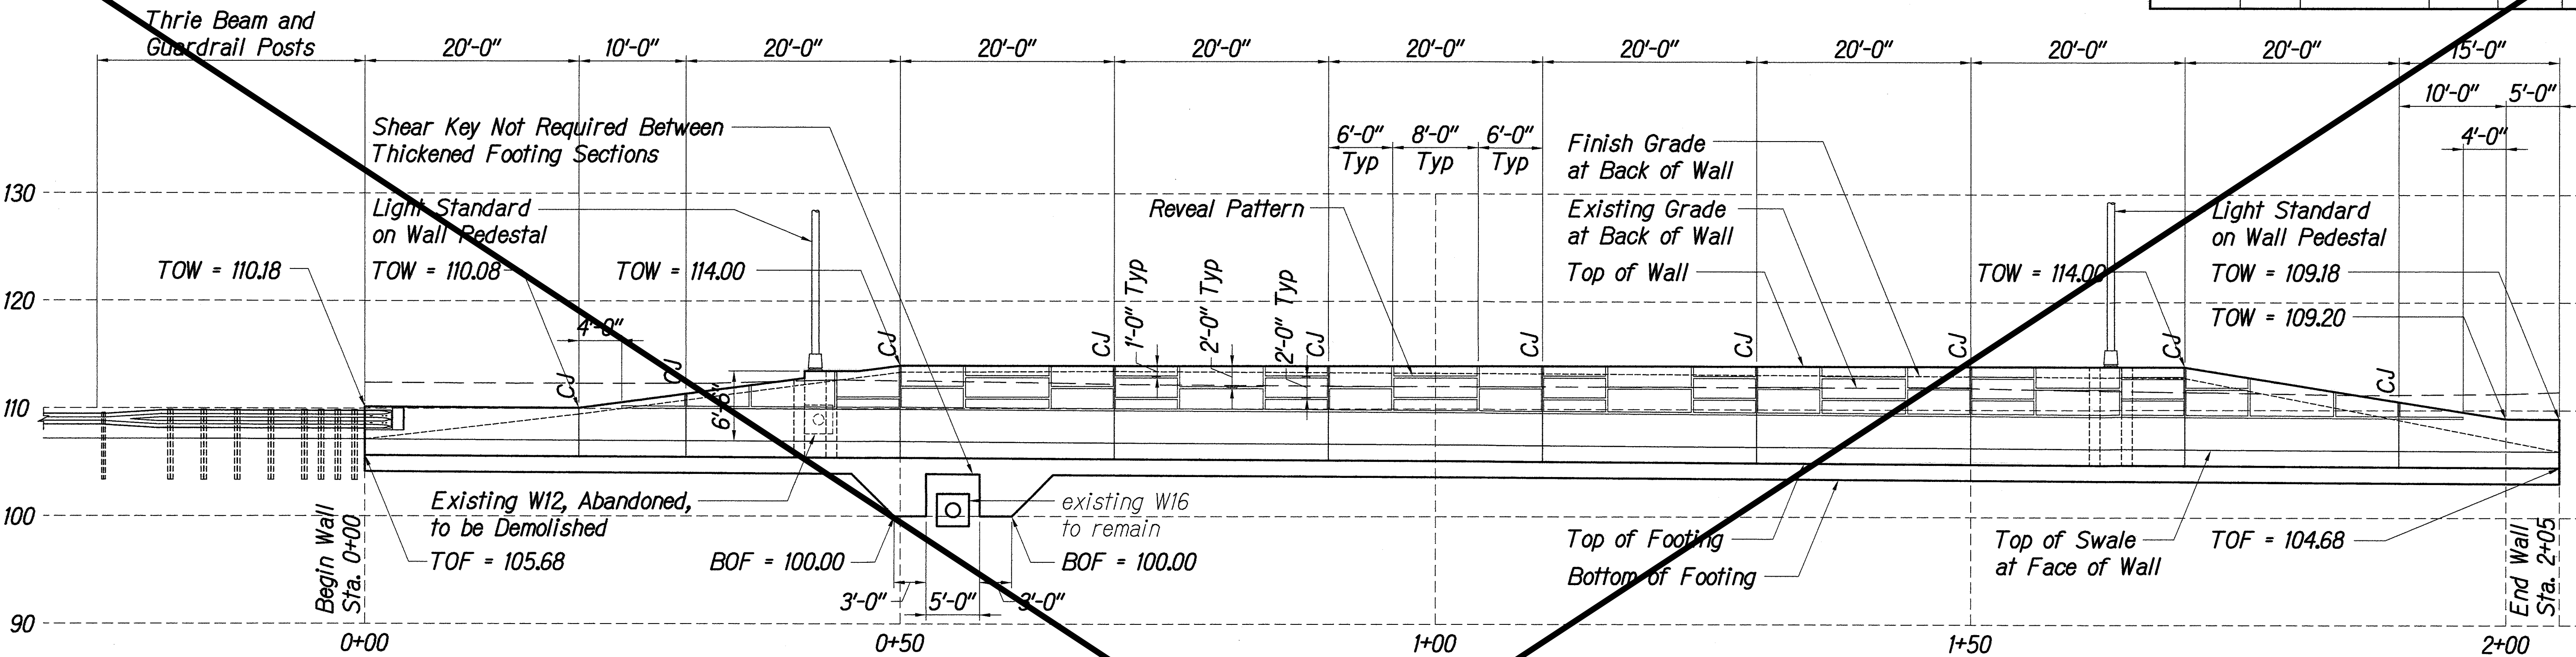


RETAINING WALL NO. 1 REFLECTED ELEVATION
Scale: 1/8" = 1'-0"

ORIGINAL PLAN	SURVEY PLOTTED BY	DATE
NOTE BOOK	DRAWN BY	
No.	TRACED BY	
	CHECKED BY	


PI:4451-4500-4458 H001 - Kierit Design build of H1 Widening U04 Drawings\Structural\AutoCAD\Format\Phase 2\2019-01-25 - BWS\4458_S1-1-2.dwg 3/8/2019 5:04 PM BRYAN LUM

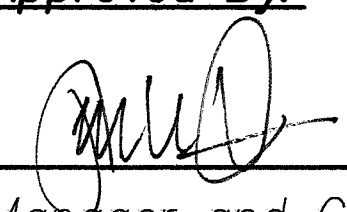Approved By: 
Manager and Chief Engineer, BWS
(For Work Affecting BWS Facilities in City/State R/W and BWS Easements Only)
Date: MAR 18 2019

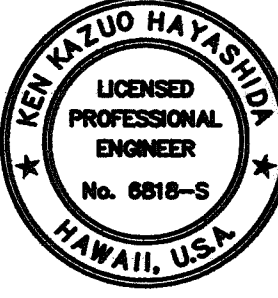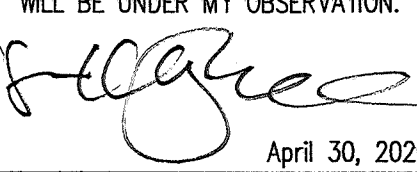
THIS WORK WAS PREPARED BY ME OR UNDER MY SUPERVISION AND CONSTRUCTION OF THIS PROJECT WILL BE UNDER MY OBSERVATION.

Signature: _____
April 30, 2020
Expiration Date of the License

STATE OF HAWAII
DEPARTMENT OF TRANSPORTATION
HIGHWAYS DIVISION
**RETAINING WALL NO. 1
REFLECTED ELEVATION**
INTERSTATE ROUTE H-1
SHOULDER WORK AND PORTLAND CEMENT
CONCRETE PAVEMENT REHABILITATION
VICINITY OF WAIMALU TO VICINITY OF HALAWA
PHASE 2 - SHOULDER WORK
Scale: As Shown Date: January 28, 2019
SHEET No. S1.1 OF 2 SHEETS

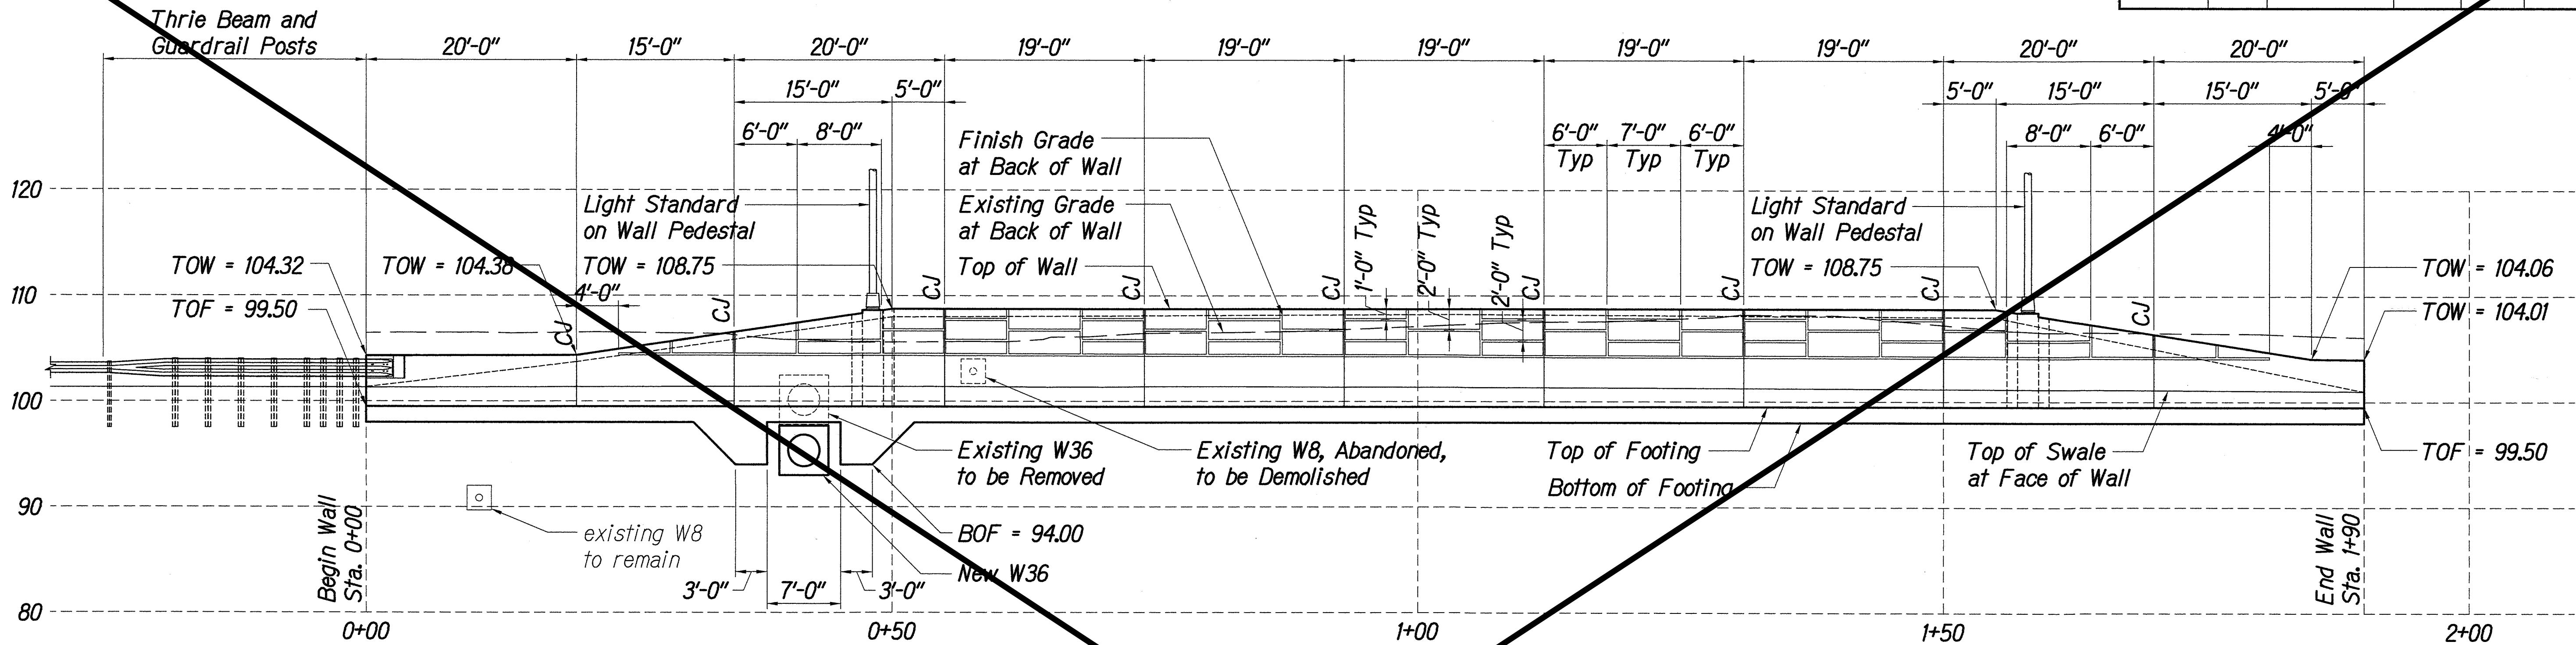
FED. ROAD DIST. NO.	STATE	FED. AID PROJ. NO.	FISCAL YEAR	SHEET NO.	TOTAL SHEETS
HAWAII	HAW.	NH-H1-1(274)	2018	86	126





RETAINING WALL NO. 4 REFLECTED ELEVATION
Scale: 1/8" = 1'-0"

DESIGNED BY	DATE
DRAWN BY	
CHECKED BY	
NOTED BY	
QUANTITIES BY	
NO.	


PA:4451-4500-4458 1001 - Kiewit Design build of HI Widening\004 Drawings\Structure\AutoCAD\Format\Phase 2\2018-01-25 - BWS\4458_S1-1-2_86.dwg 3/8/2018 5:04 PM BRYAN LUM

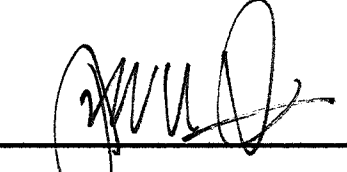Approved By: 
Manager and Chief Engineer, BWS
(For Work Affecting BWS Facilities in City/State R/W and BWS Easements Only)
Date: MAR 18 2019

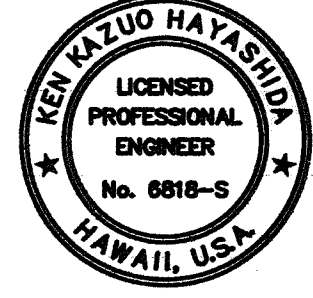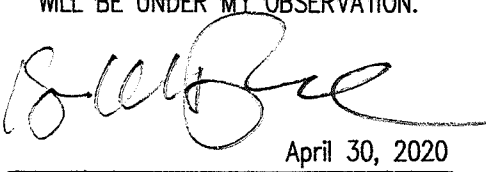
THIS WORK WAS PREPARED BY ME OR UNDER MY SUPERVISION AND CONSTRUCTION OF THIS PROJECT WILL BE UNDER MY OBSERVATION.

SIGNATURE
EXPIRATION DATE OF THE LICENSE: April 30, 2020

STATE OF HAWAII
DEPARTMENT OF TRANSPORTATION
HIGHWAYS DIVISION
**RETAINING WALL NO. 4
REFLECTED ELEVATION**
INTERSTATE ROUTE H-1
SHOULDER WORK AND PORTLAND CEMENT
CONCRETE PAVEMENT REHABILITATION
VICINITY OF WAIMALU TO VICINITY OF HALAWA
PHASE 2 - SHOULDER WORK
Scale: As Shown Date: January 28, 2019
SHEET No. S1.2 OF 2 SHEETS

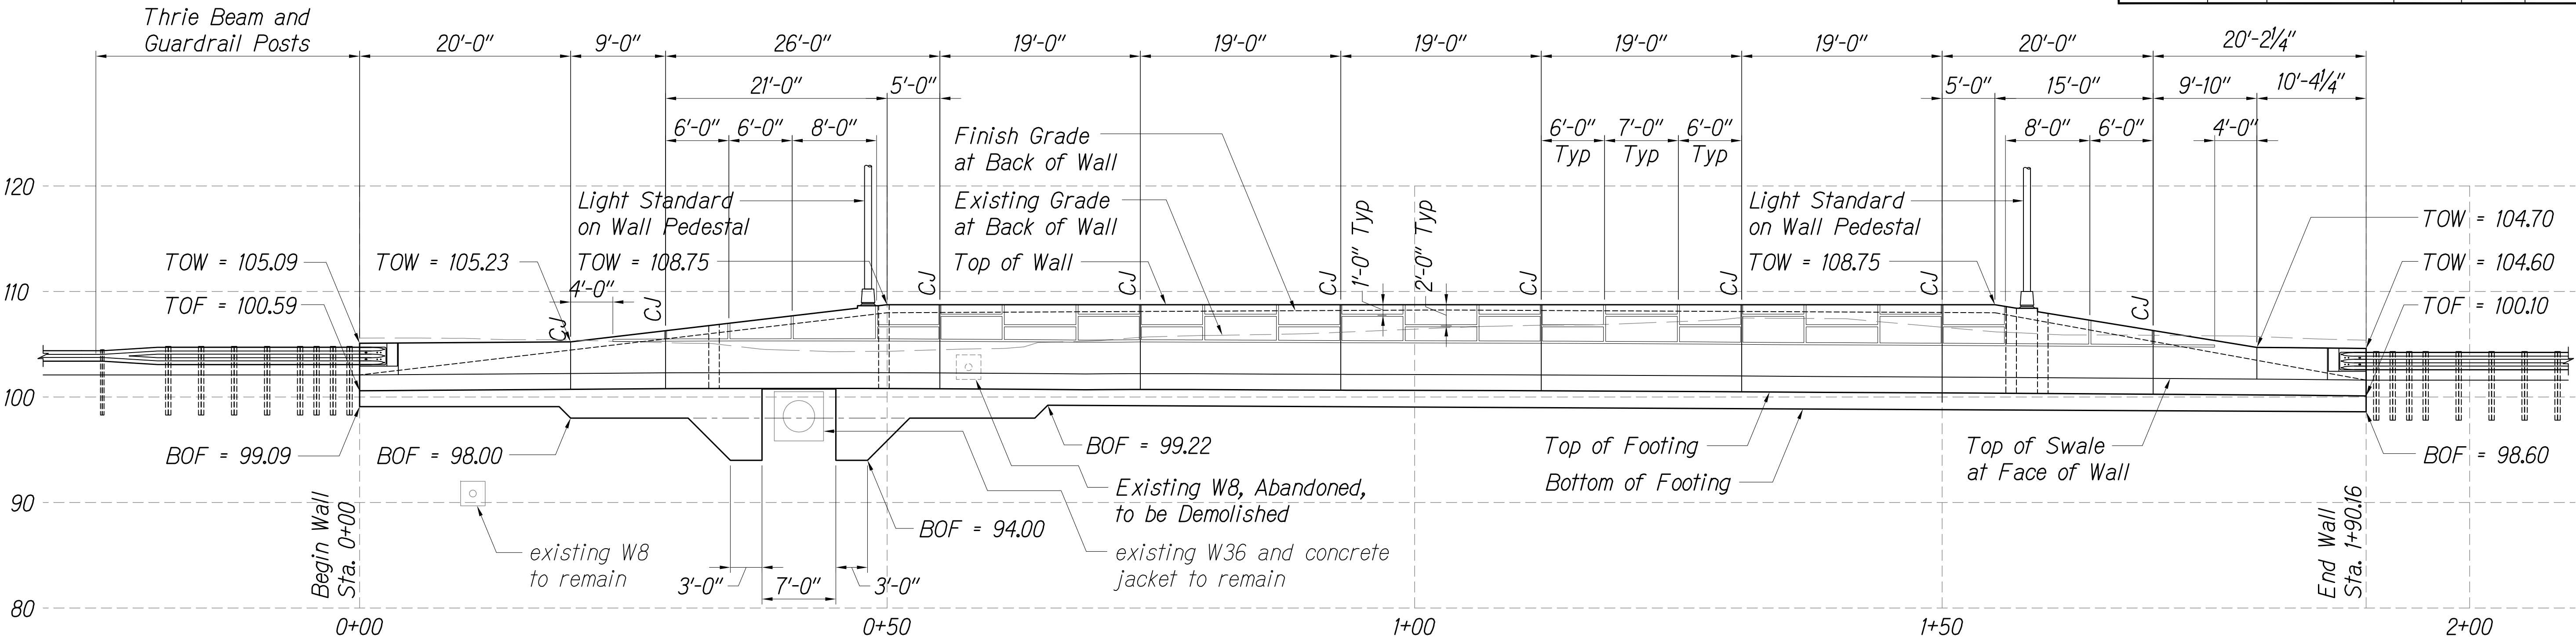FED. ROAD DIST. NO.	STATE	FED. AID PROJ. NO.	FISCAL YEAR	SHEET NO.	TOTAL SHEETS
HAWAII	HAW.	NH-H1-1(274)	2018	86	126




RETAINING WALL NO. 4 REFLECTED ELEVATION
Scale: 1/8" = 1'-0"

- Notes:
- Concrete footing shall be placed directly on weathered basalt between Sta. 0+20 to Sta. 0+64.
 - Replace over-excavated material with Structure Backfill Material A and compacted to a minimum of 95% of its maximum dry density per the latest procedure of ASTM D1557.

ORIGINAL PLAN	SURVEY PLOTTED BY	DATE
NOTE BOOK	DRAWN BY	
No.	TRACED BY	
	QUANTITIES BY	
	CHECKED BY	

P:\451-4500\4458-1007 - Kent Design build of HI Widening\04 Drawings\Structural\AutoCAD\Format\Phase 2\2020-02-06 - As-Built\4458-S1-1-1-S1-2.dwg - 2/6/2020 11:21 AM BRYAN LUM

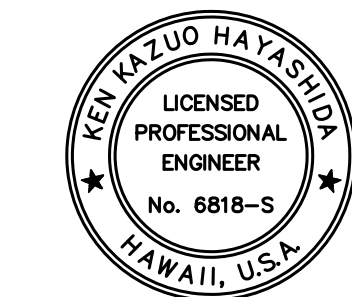

THIS WORK WAS PREPARED BY ME
OR UNDER MY SUPERVISION.

SIGNATURE: *[Signature]* April 30, 2020
EXPIRATION DATE OF THE LICENSE

THESE PLANS HAVE BEEN PREPARED UTILIZING INFORMATION PROVIDED BY THE PROJECT CONTRACTOR. THE UPDATED CONSTRUCTION INFORMATION DEPICTED HEREIN HAS NOT BEEN VERIFIED FOR ACCURACY AND COMPLETENESS. NO REPRESENTATION IS BEING MADE TO ITS VALIDITY.


STATE OF HAWAII
DEPARTMENT OF TRANSPORTATION
HIGHWAYS DIVISION
**RETAINING WALL NO. 4
REFLECTED ELEVATION**
INTERSTATE ROUTE H-1
SHOULDER WORK AND PORTLAND CEMENT
CONCRETE PAVEMENT REHABILITATION
VICINITY OF WAIMALU TO VICINITY OF HALAWA
PHASE 2 - SHOULDER WORK
Scale: As Shown Date: November 30, 2018
SHEET No. S1.2 OF 2 SHEETS

"AS-BUILT"

FED. ROAD DIST. NO.	STATE	FED. AID PROJ. NO.	FISCAL YEAR	SHEET NO.	TOTAL SHEETS
HAWAII	HAW.	NH-H1-1(274)	2018	87	126

Notes:


- Contractor may use full length vertical bars or lap splice bars at construction joints. If couplers are used, contractor shall use galvanized or epoxy coated Dayton Superior D310 Taper-Lock Standard Coupler, or an approved equal, and shall apply Loctite 5113 Thread Sealant, or an approved equal, to the threaded connections such that the surfaces of the assembled coupler are covered with an unbroken seal of corrosion inhibitor. If couplers are used, they shall only be used between Sta. 0+30 and Sta. 1+90.
- Horizontal construction joints shall not be allowed at wall sections Sta. 0+20 to Sta. 0+30 and Sta. 1+90 to Sta. 2+00. These wall sections shall be poured monolithically.
- For the vertical bars at the top of wall between Sta. 0+36 and Sta. 1+86, the contractor may elect to field bend 8" long hooked ends similar to locations where "H1" < 2'-2" in lieu of providing additional #4 U-bars. The #4 U-bars around the light standard shall remain.
- In foundation, provide additional #5x 20'-0" long longitudinal bars at 12", evenly spaced, at top and bottom, between Sta. 0+45 and Sta. 0+65.
- Expansion Joints are not Required.

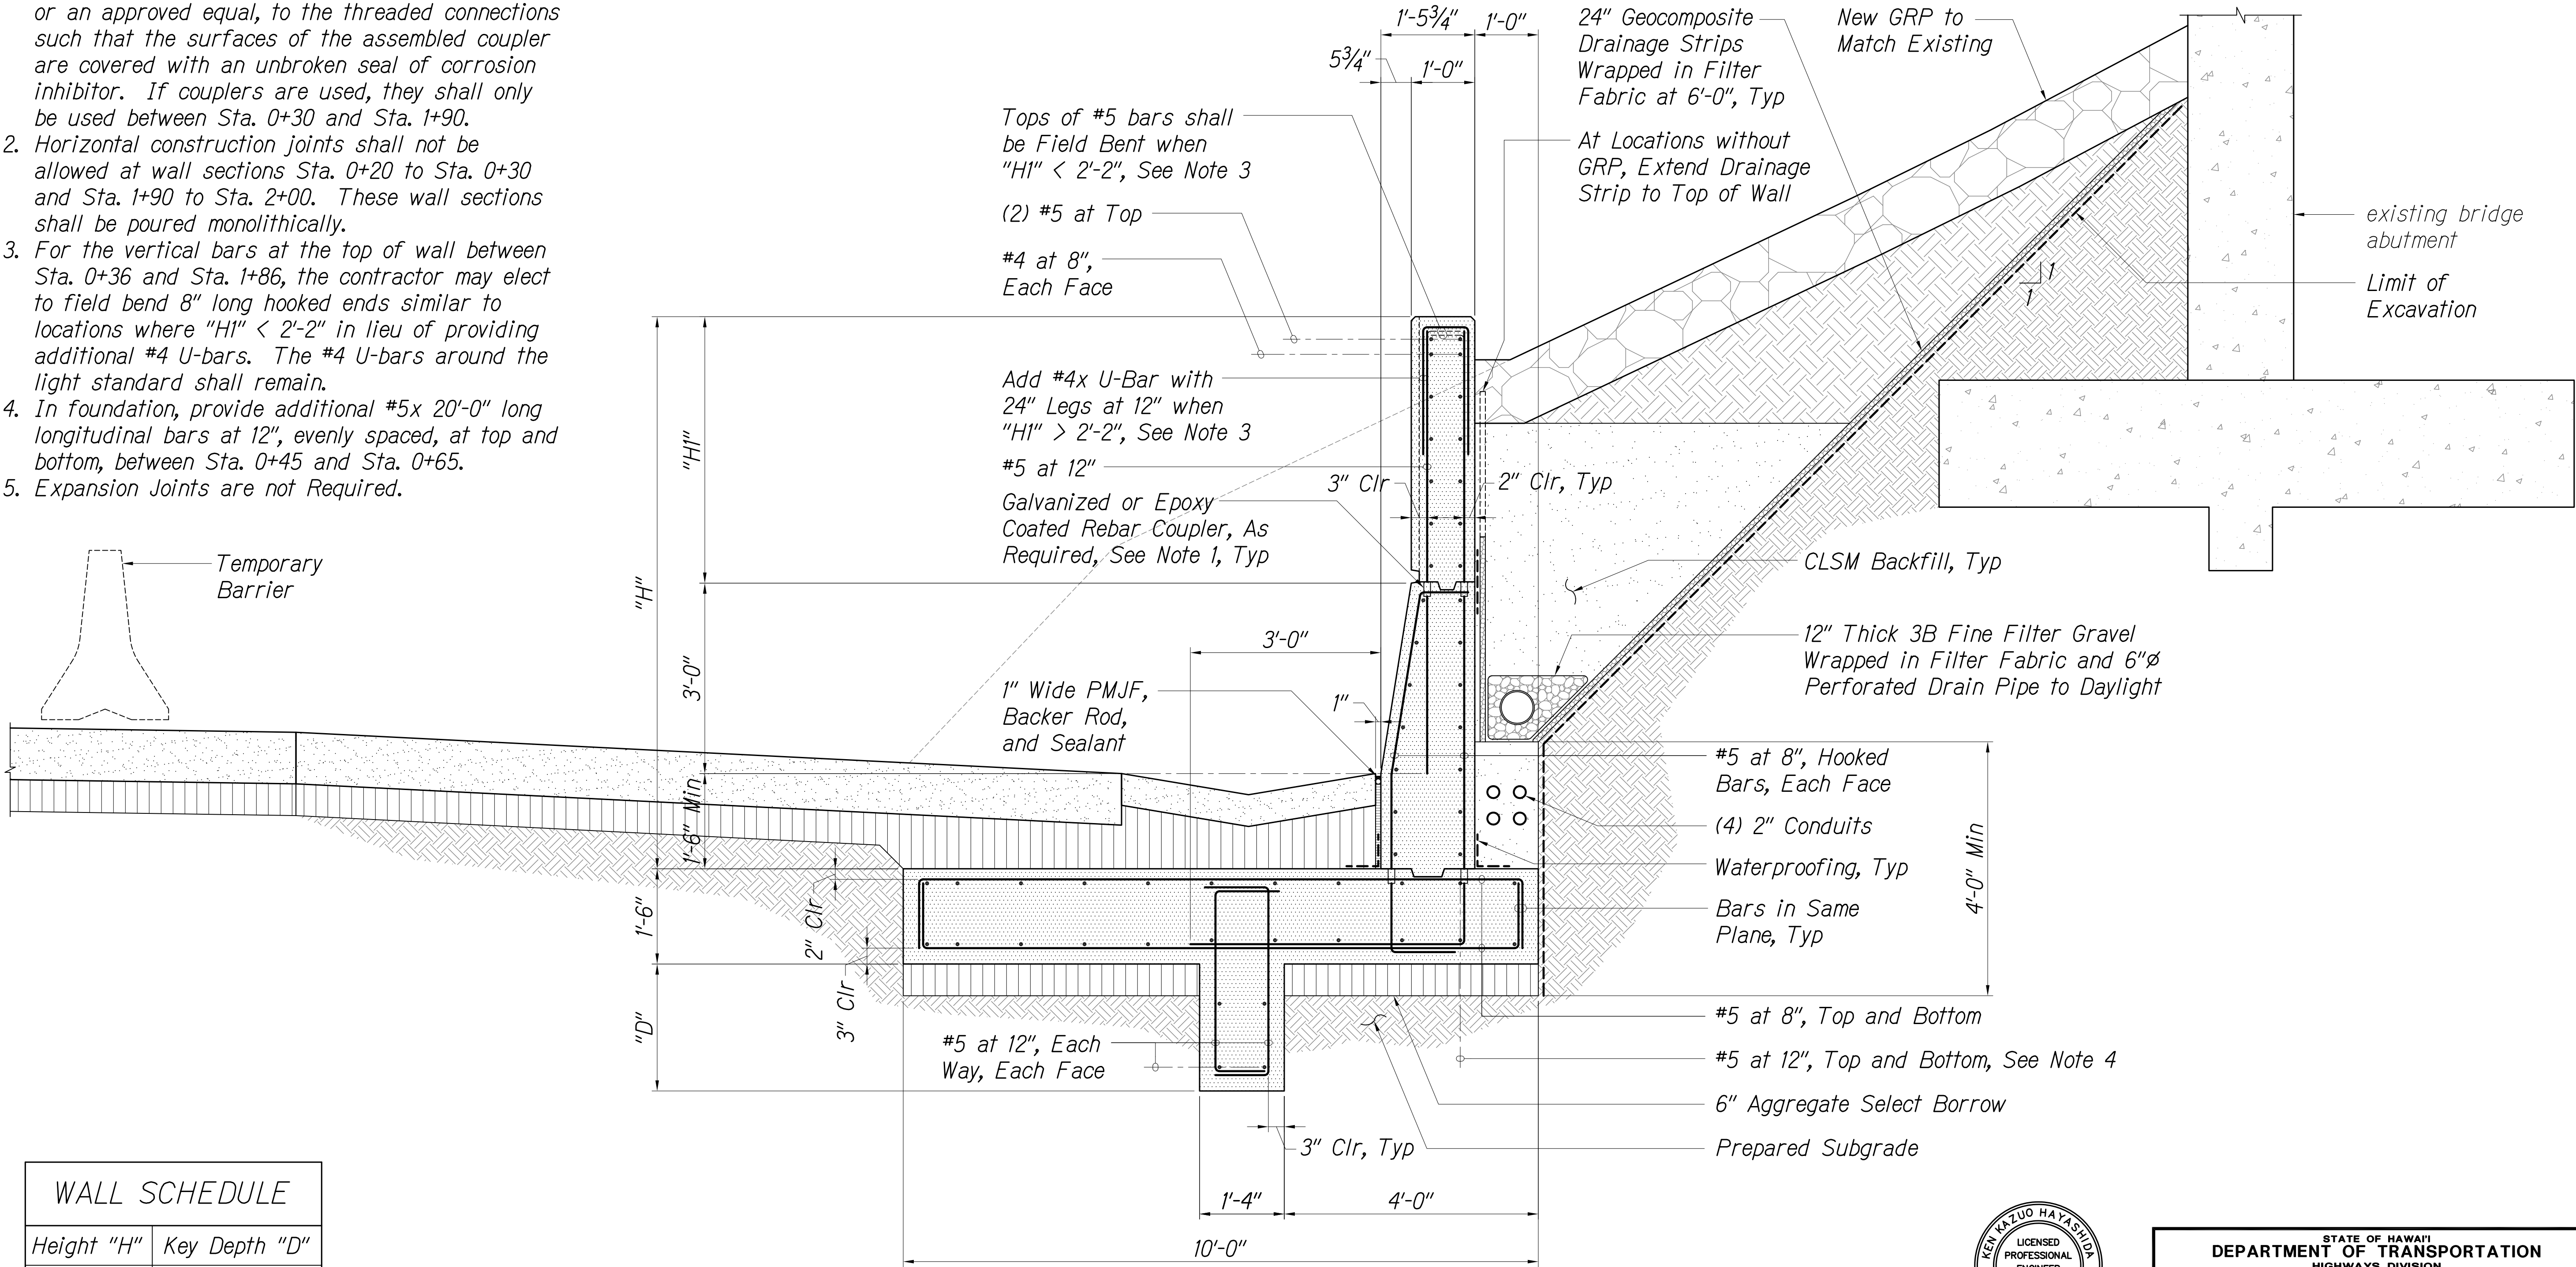


WALL SCHEDULE	
Height "H"	Key Depth "D"
≤ 9'-0"	2'-0"
≤ 7'-0"	1'-6"
≤ 5'-0"	1'-0"

RETAINING WALL NO. 1 SCHEDULE (KAONOHI OVERPASS)

Scale: 3/4" = 1'-0"

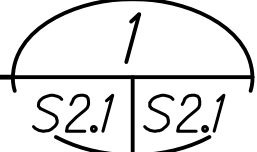

THESE PLANS HAVE BEEN PREPARED UTILIZING INFORMATION PROVIDED BY THE PROJECT CONTRACTOR. THE UPDATED CONSTRUCTION INFORMATION DEPICTED HEREIN HAS NOT BEEN VERIFIED FOR ACCURACY AND COMPLETENESS. NO REPRESENTATION IS BEING MADE TO ITS VALIDITY.

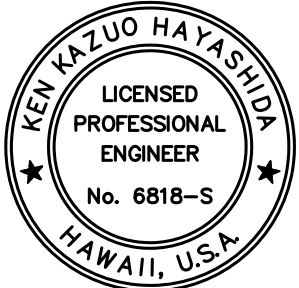

THIS WORK WAS PREPARED BY ME OR UNDER MY SUPERVISION.

SIGNATURE: [Signature] EXPIRATION DATE OF THE LICENSE: April 30, 2020



STATE OF HAWAII
DEPARTMENT OF TRANSPORTATION
HIGHWAYS DIVISION
RETAINING WALL NO. 1
SCHEDULE
INTERSTATE ROUTE H-1
SHOULDER WORK AND PORTLAND CEMENT
CONCRETE PAVEMENT REHABILITATION
VICINITY OF WAIMALU TO VICINITY OF HALAWA
PHASE 2 - SHOULDER WORK
Scale: As Shown Date: November 30, 2018
SHEET No. S2.1 OF 10 SHEETS

"AS-BUILT"

FED. ROAD DIST. NO.	STATE	FED. AID PROJ. NO.	FISCAL YEAR	SHEET NO.	TOTAL SHEETS
HAWAII	HAW.	NH-H1-1(274)	2018	88	126

Notes:

- For balance of information, see Sheet S2.1.
- Control joint in wall shall not be located within 7'-0" of the centerline of the light standard.

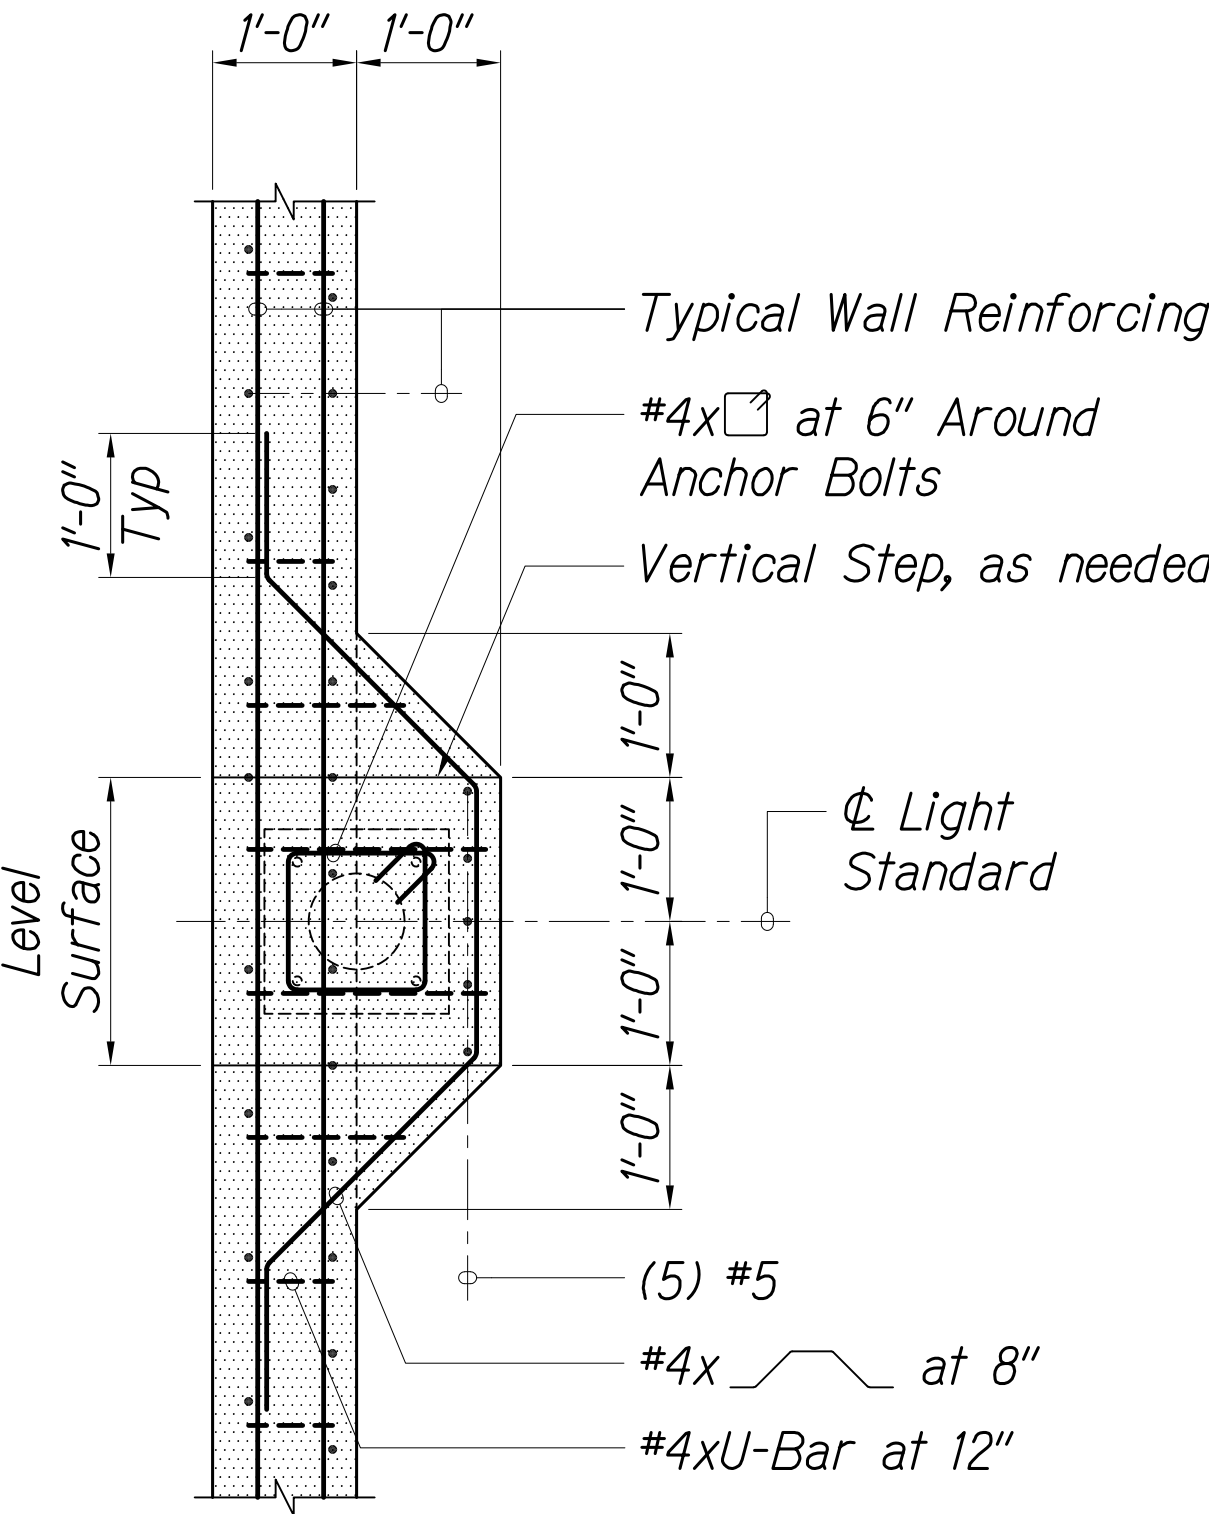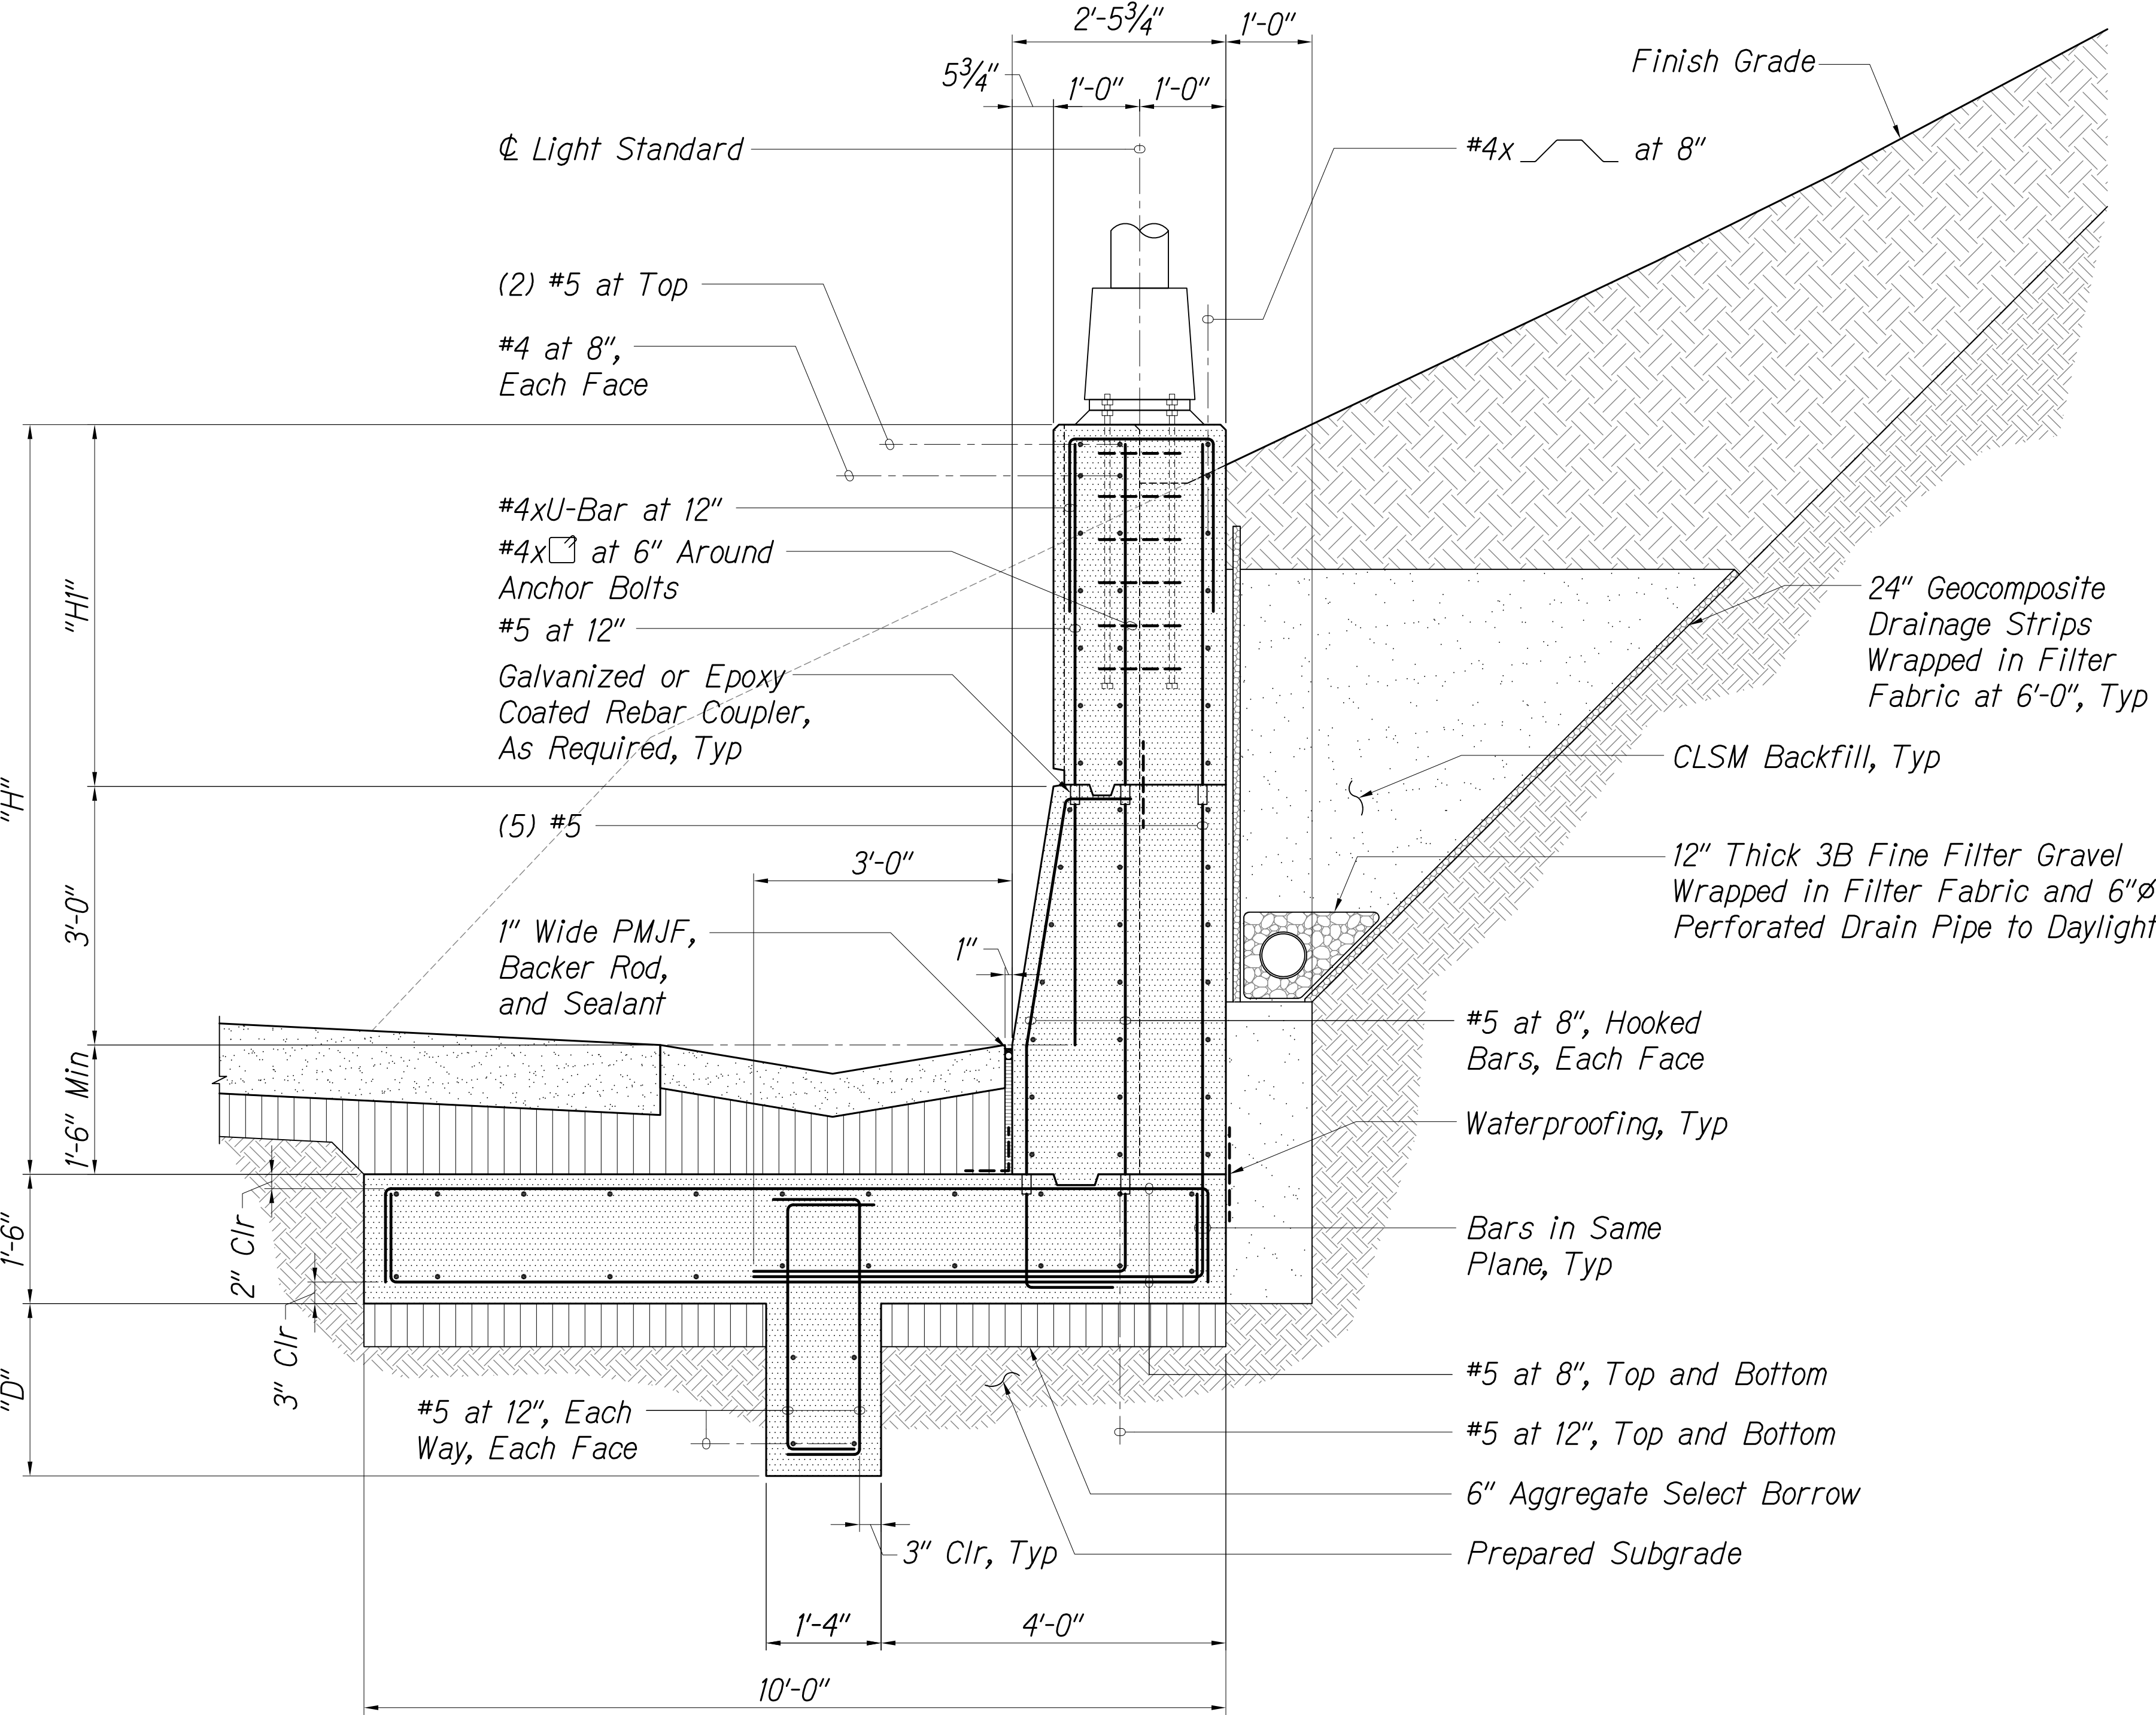


Section - Plan View

RETAINING WALL NO. 1 THICKENED SECTION AT LIGHT STANDARD

Scale: 3/4" = 1'-0"

1
S2.2 S2.2

THESE PLANS HAVE BEEN PREPARED UTILIZING INFORMATION PROVIDED BY THE PROJECT CONTRACTOR. THE UPDATED CONSTRUCTION INFORMATION DEPICTED HEREIN HAS NOT BEEN VERIFIED FOR ACCURACY AND COMPLETENESS. NO REPRESENTATION IS BEING MADE TO ITS VALIDITY.

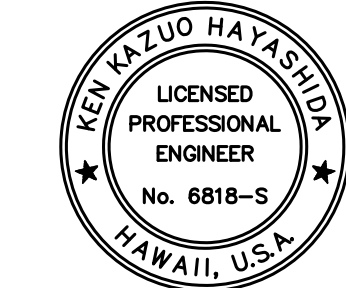

THIS WORK WAS PREPARED BY ME OR UNDER MY SUPERVISION.

SIGNATURE: [Signature] EXPIRATION DATE OF THE LICENSE: April 30, 2020

STATE OF HAWAII
DEPARTMENT OF TRANSPORTATION
HIGHWAYS DIVISION

RETAINING WALL NO. 1
SECTIONS AT LIGHT STD

INTERSTATE ROUTE H-1
SHOULDER WORK AND PORTLAND CEMENT
CONCRETE PAVEMENT REHABILITATION
VICINITY OF WAIMALU TO VICINITY OF HALAWA
PHASE 2 - SHOULDER WORK


Scale: As Shown Date: November 30, 2018

SHEET No. S2.2 OF 10 SHEETS


"AS-BUILT"

FED. ROAD DIST. NO.	STATE	FED. AID PROJ. NO.	FISCAL YEAR	SHEET NO.	TOTAL SHEETS
HAWAII	HAW.	NH-H1-1(274)	2018	89	126


Note:
For balance of information, see Sheet S2.1.

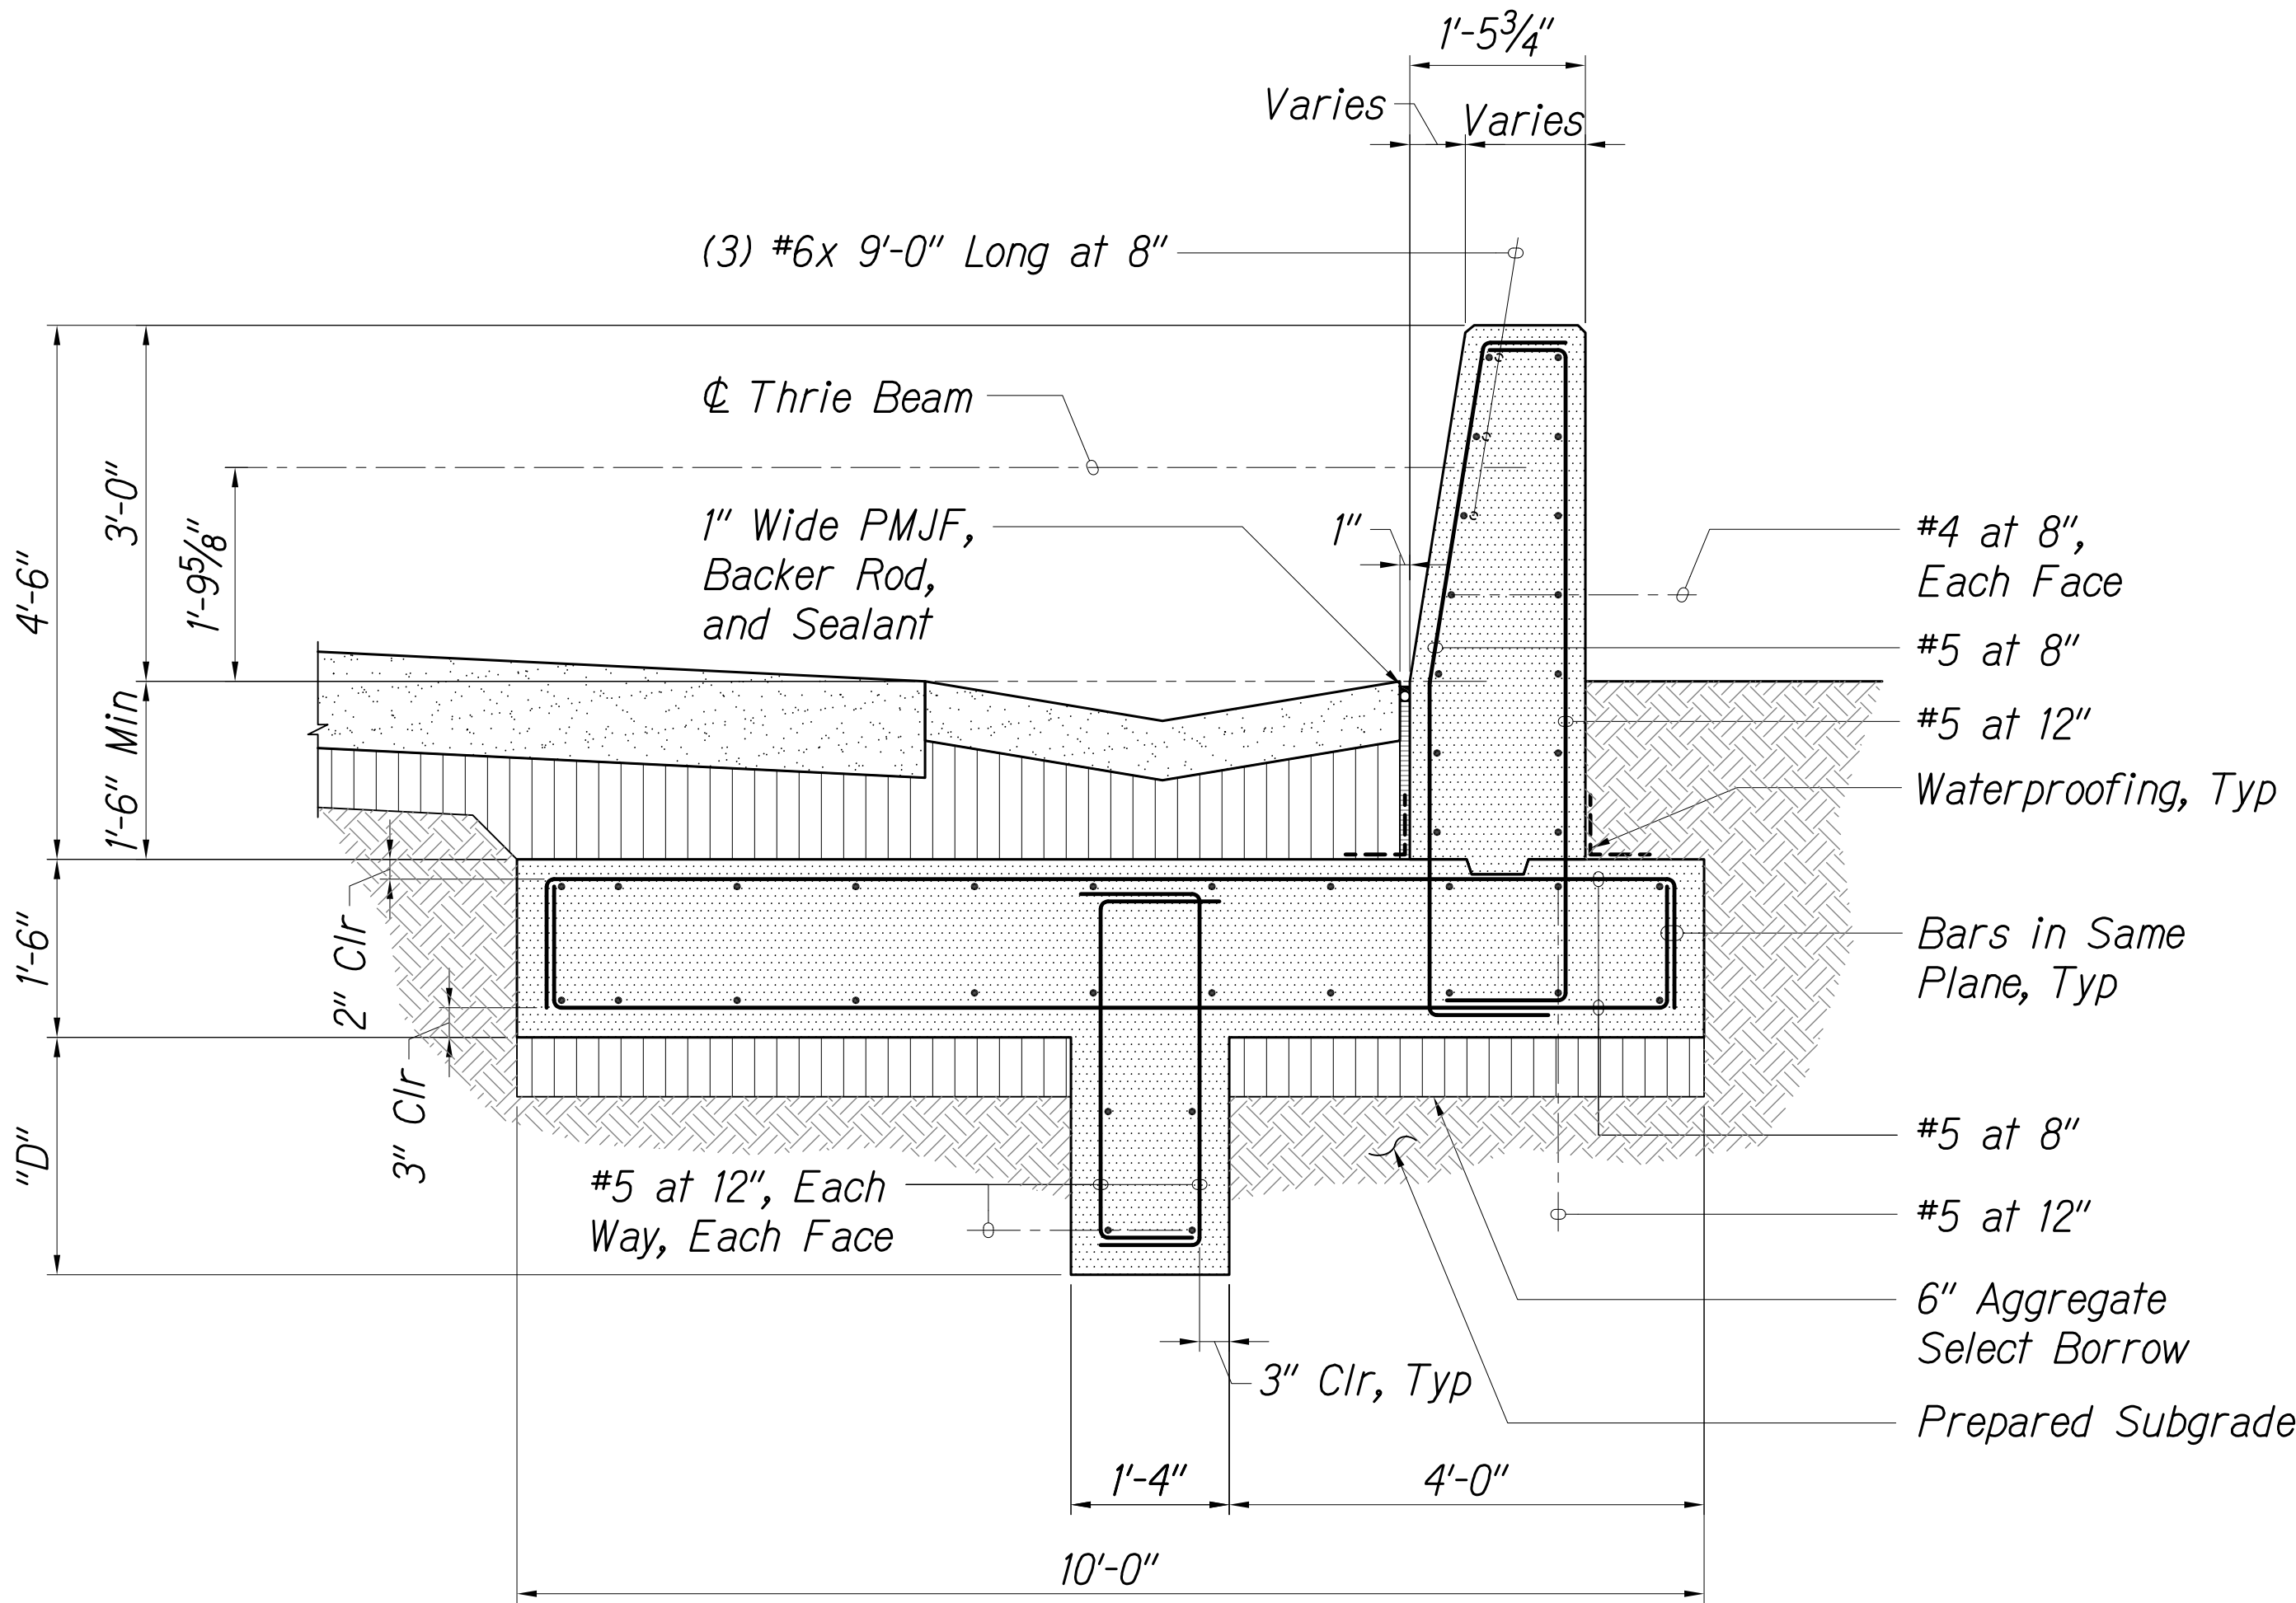

Section at Transition

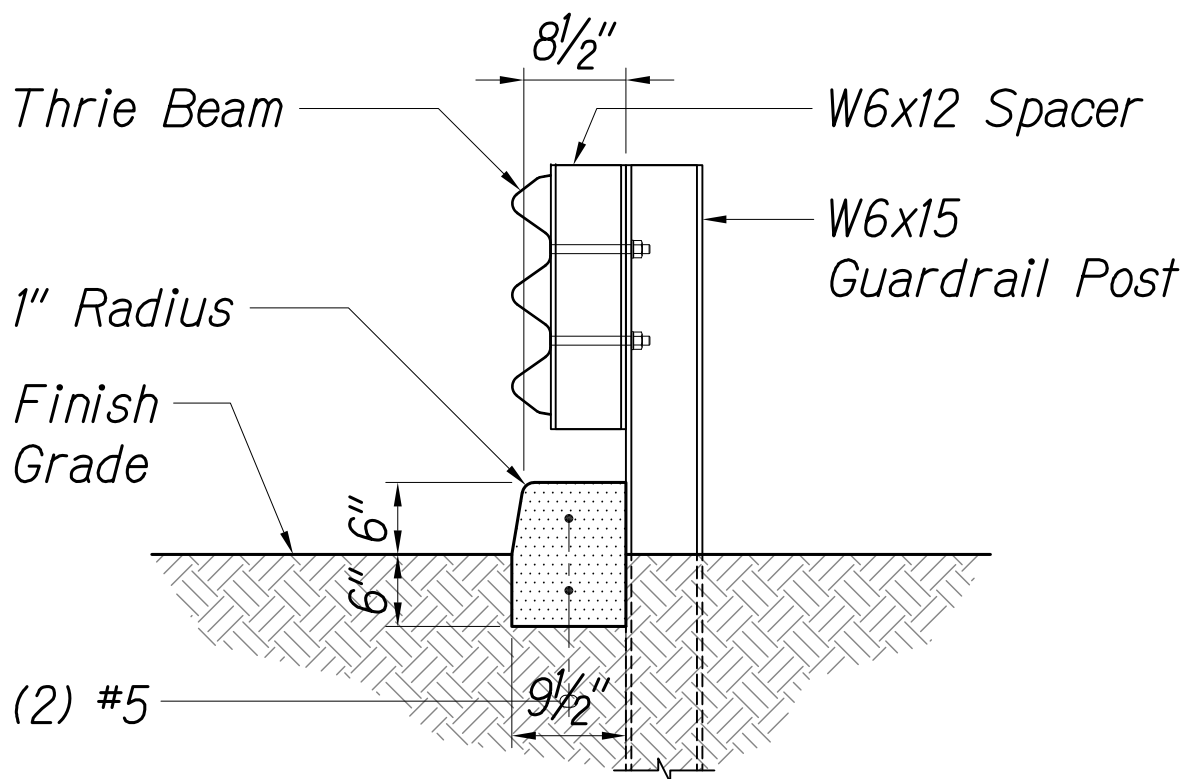

Section at Guardrail Post

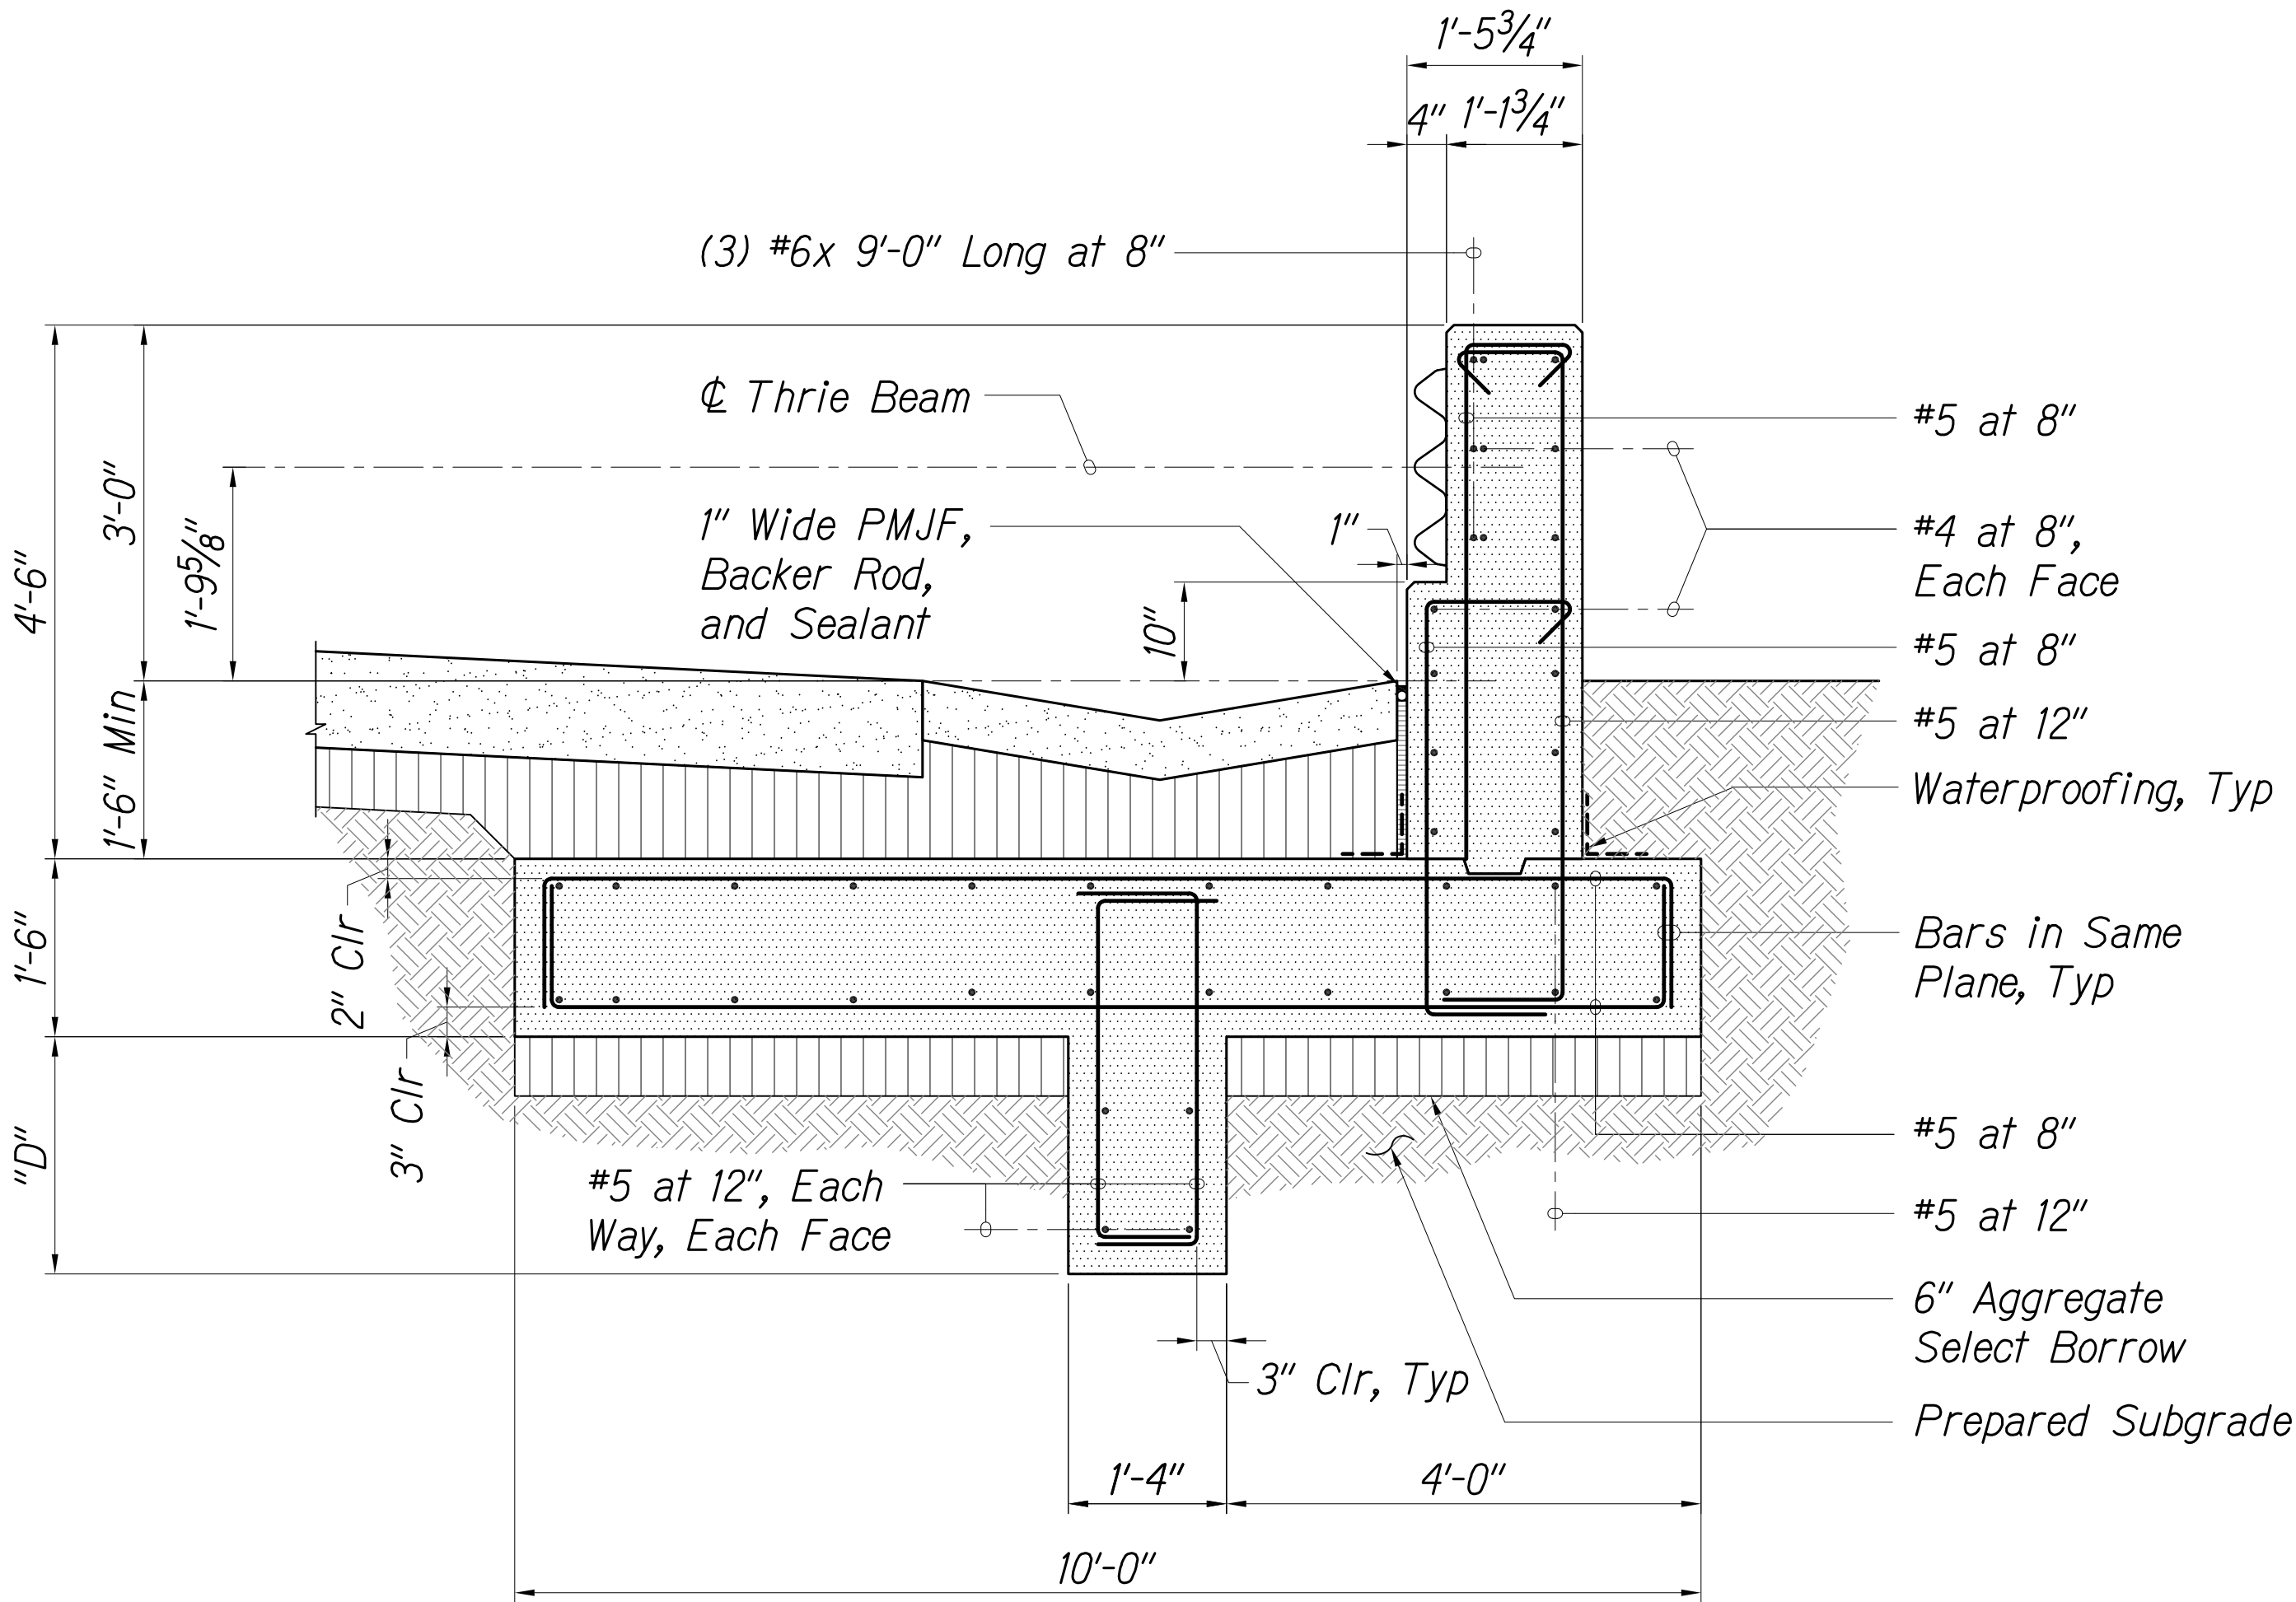


Section at Terminal Connection


ORIGINAL PLAN	SURVEY PLOTTED BY	DATE
NOTE BOOK	DRAWN BY	
No.	TRACED BY	
	QUANTITIES BY	
	CHECKED BY	

RETAINING WALL NO. 1 SECTIONS AT END POST

Scale: 3/4" = 1'-0"

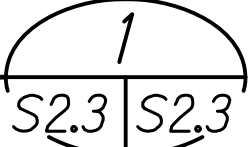

THESE PLANS HAVE BEEN PREPARED UTILIZING INFORMATION PROVIDED BY THE PROJECT CONTRACTOR. THE UPDATED CONSTRUCTION INFORMATION DEPICTED HEREIN HAS NOT BEEN VERIFIED FOR ACCURACY AND COMPLETENESS. NO REPRESENTATION IS BEING MADE TO ITS VALIDITY.

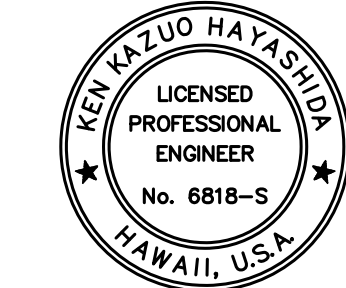

THIS WORK WAS PREPARED BY ME OR UNDER MY SUPERVISION.

SIGNATURE: [Signature] EXPIRATION DATE OF THE LICENSE: April 30, 2020

STATE OF HAWAII
DEPARTMENT OF TRANSPORTATION
HIGHWAYS DIVISION
RETAINING WALL NO. 1
SECTIONS AT END POST
INTERSTATE ROUTE H-1
SHOULDER WORK AND PORTLAND CEMENT
CONCRETE PAVEMENT REHABILITATION
VICINITY OF WAIMALU TO VICINITY OF HALAWA
PHASE 2 - SHOULDER WORK
Scale: As Shown Date: November 30, 2018
SHEET No. S2.3 OF 10 SHEETS


"AS-BUILT"

FED. ROAD DIST. NO.	STATE	FED. AID PROJ. NO.	FISCAL YEAR	SHEET NO.	TOTAL SHEETS
HAWAII	HAW.	NH-H1-1(274)	2018	90	126

Notes:

- Contractor may use full length vertical bars or lap splice bars at construction joints. If couplers are used, contractor shall use galvanized or epoxy coated Dayton Superior D310 Taper-Lock Standard Coupler, or an approved equal, and shall apply Loctite 5113 Thread Sealant, or an approved equal, to the threaded connections such that the surfaces of the assembled coupler are covered with an unbroken seal of corrosion inhibitor. If couplers are used, they shall only be used between Sta. 0+35 and Sta. 1+70.
- Horizontal construction joints shall not be allowed at wall sections Sta. 0+20 to Sta. 0+35 and Sta. 1+70 to Sta. 1+85. These wall sections shall be poured monolithically.
- For the vertical bars at the top of wall between Sta. 0+35 and Sta. 1+71, the contractor may elect to field bend 8" long hooked ends similar to locations where "H" < 2'-2" in lieu of providing additional #4 U-bars. The #4 U-bars around the light standard shall remain.
- In foundation, provide additional #5x 20'-0" long longitudinal bars at 12", evenly spaced, at top and bottom, between Sta. 0+31.50 and Sta. 0+51.50.
- Expansion Joints are not Required.



- Concrete footing shall be placed directly on weathered basalt between Sta. 0+20 to Sta. 0+64.
- Replace over-excavated material with Structure Backfill Material A and compacted to a minimum of 95% of its maximum dry density per the latest procedure of ASTM D1557.

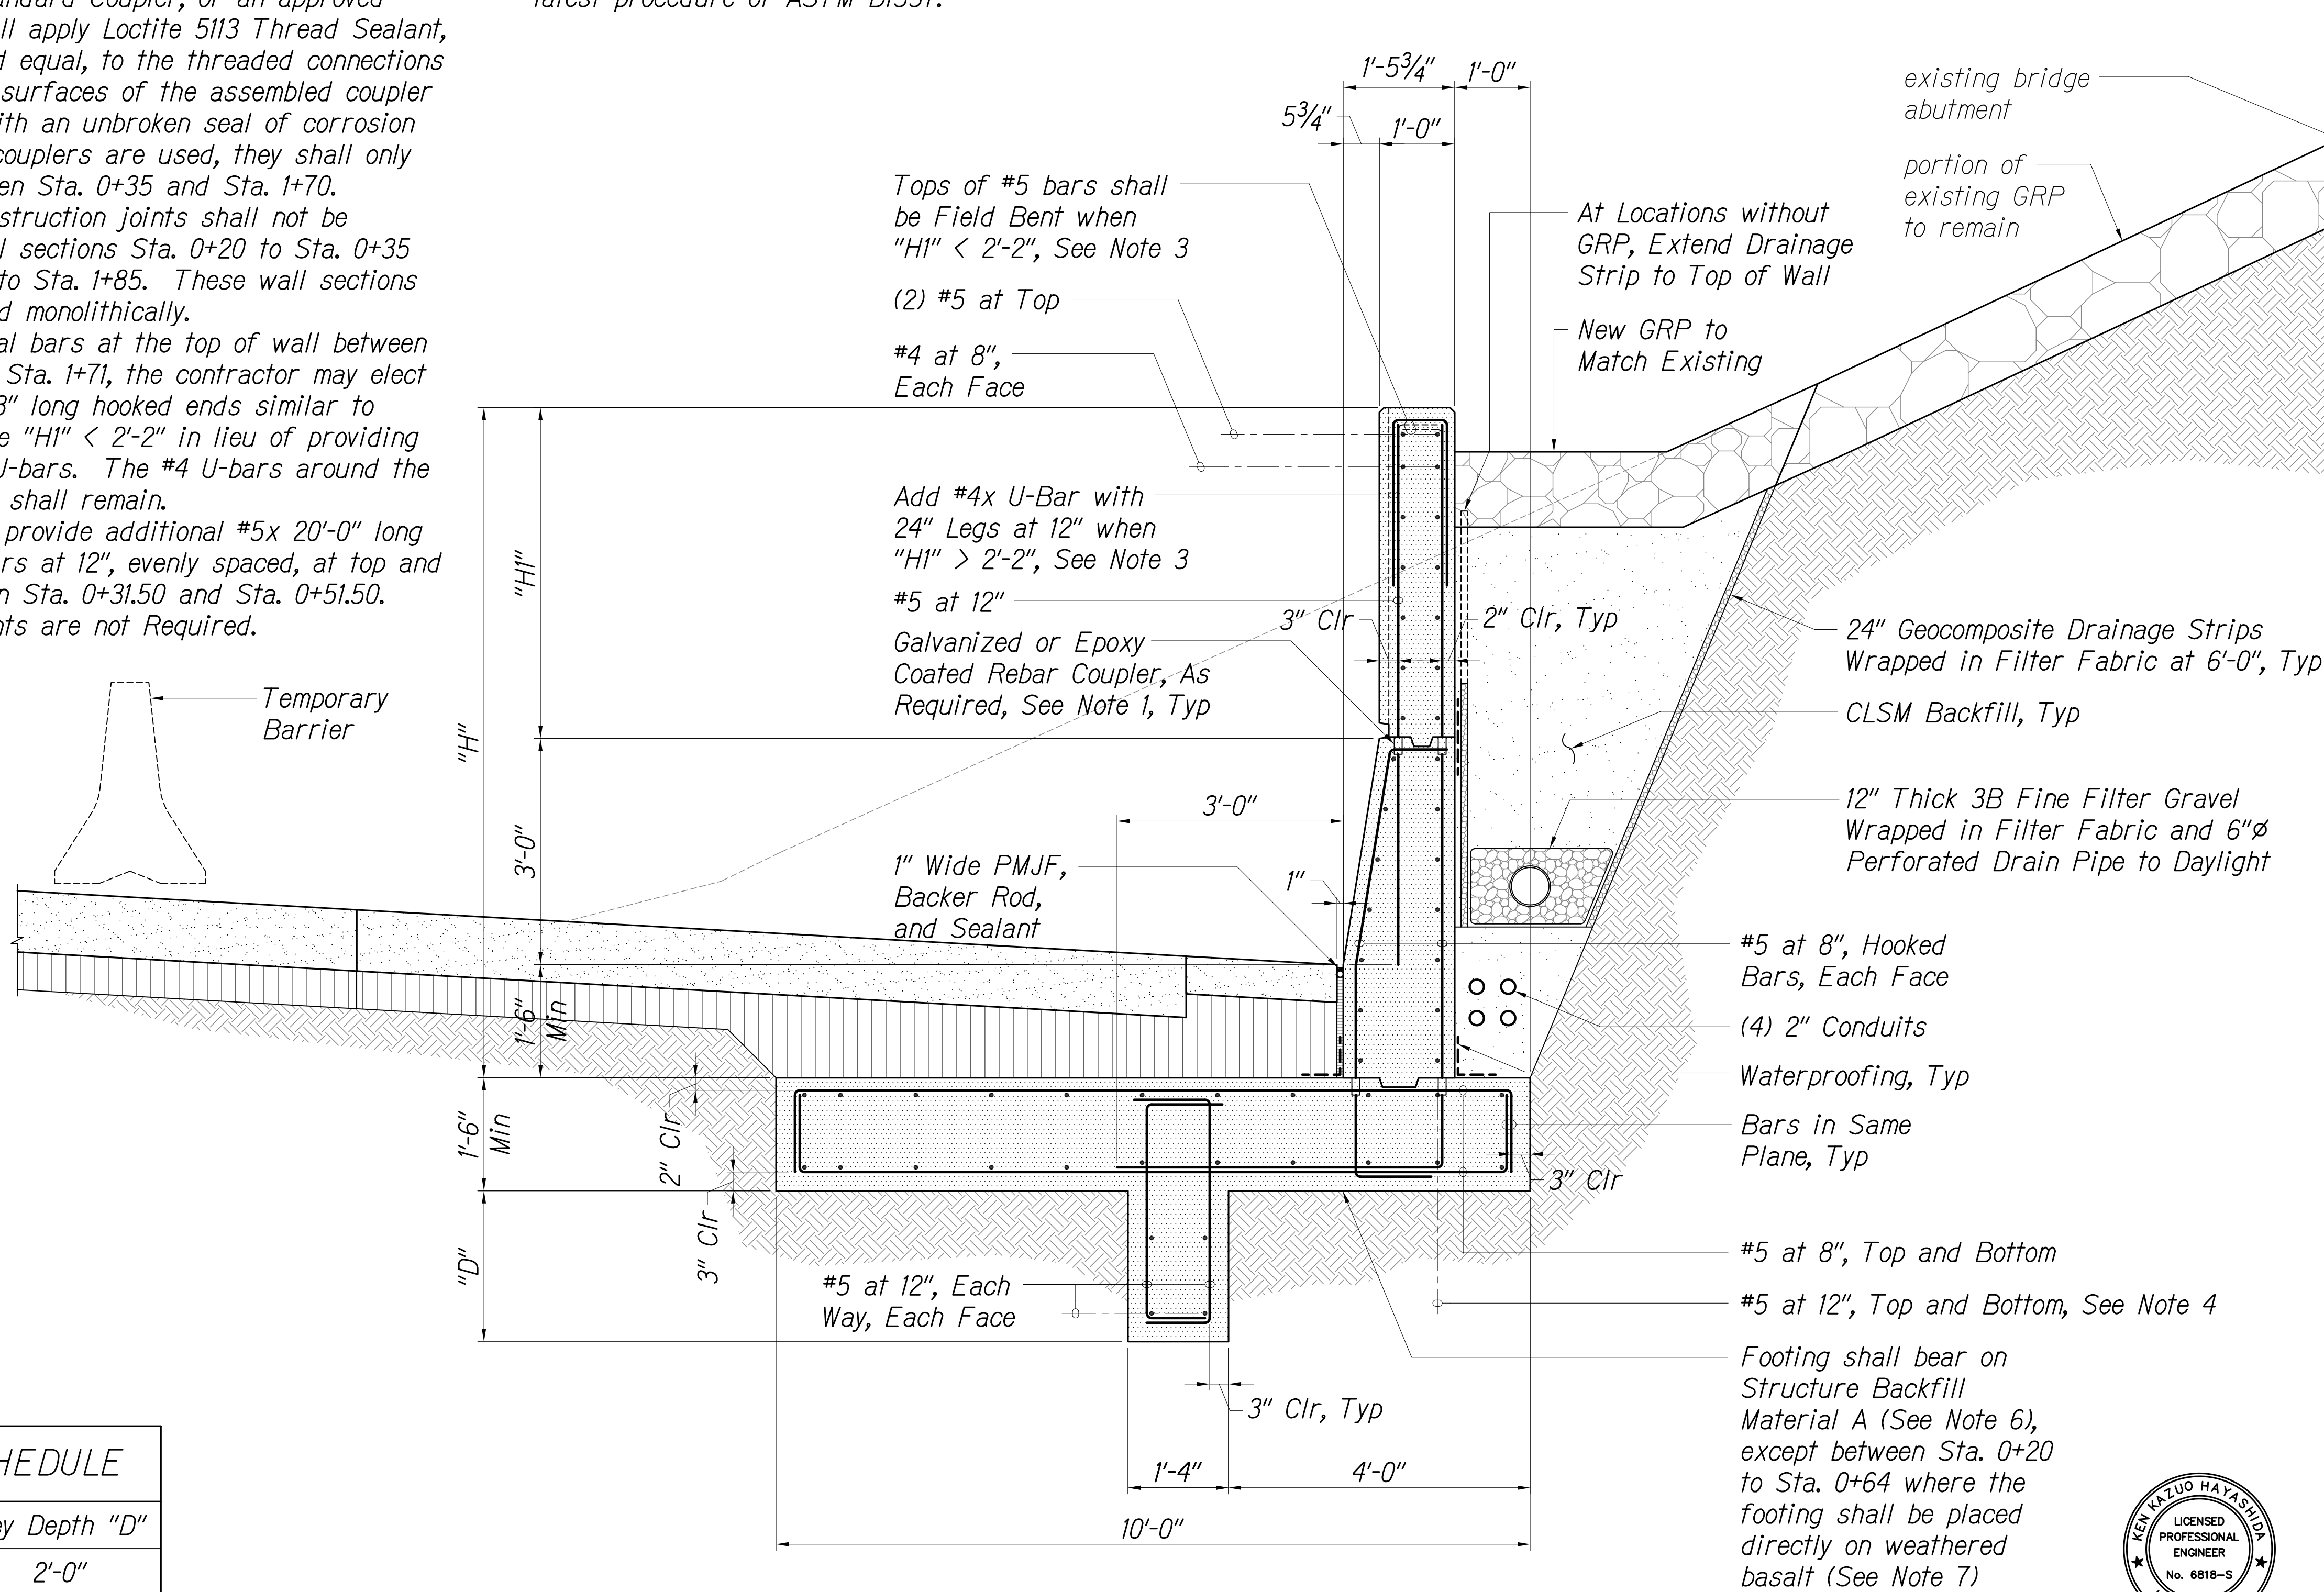

WALL SCHEDULE	
Height "H"	Key Depth "D"
≤ 9'-0"	2'-0"
≤ 7'-0"	1'-6"
≤ 5'-0"	1'-0"

RETAINING WALL NO. 4 SCHEDULE (KAAMILO OVERPASS)

Scale: 3/4" = 1'-0"

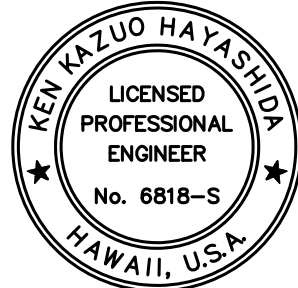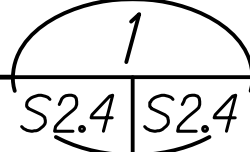

THIS WORK WAS PREPARED BY ME OR UNDER MY SUPERVISION.

SIGNATURE: [Signature] EXPIRATION DATE OF THE LICENSE: April 30, 2020

THESE PLANS HAVE BEEN PREPARED UTILIZING INFORMATION PROVIDED BY THE PROJECT CONTRACTOR. THE UPDATED CONSTRUCTION INFORMATION DEPICTED HEREIN HAS NOT BEEN VERIFIED FOR ACCURACY AND COMPLETENESS. NO REPRESENTATION IS BEING MADE TO ITS VALIDITY.

STATE OF HAWAII
DEPARTMENT OF TRANSPORTATION
HIGHWAYS DIVISION
RETAINING WALL NO. 4
SCHEDULE
INTERSTATE ROUTE H-1
SHOULDER WORK AND PORTLAND CEMENT
CONCRETE PAVEMENT REHABILITATION
VICINITY OF WAIMALU TO VICINITY OF HALAWA
PHASE 2 - SHOULDER WORK
Scale: As Shown Date: November 30, 2018
SHEET No. S2.4 OF 10 SHEETS


"AS-BUILT"

9.


FED. ROAD DIST. NO.	STATE	FED. AID PROJ. NO.	FISCAL YEAR	SHEET NO.	TOTAL SHEETS
HAWAII	HAW.	NH-H1-1(274)	2018	92	126

Notes:


- For balance of information, see Sheet S2.4.
- Concrete footing shall be placed directly on weathered basalt between Sta. 0+20 to Sta. 0+64.
- Replace over-excavated material with Structure Backfill Material A and compacted to a minimum of 95% of its maximum dry density per the latest procedure of ASTM D1557.

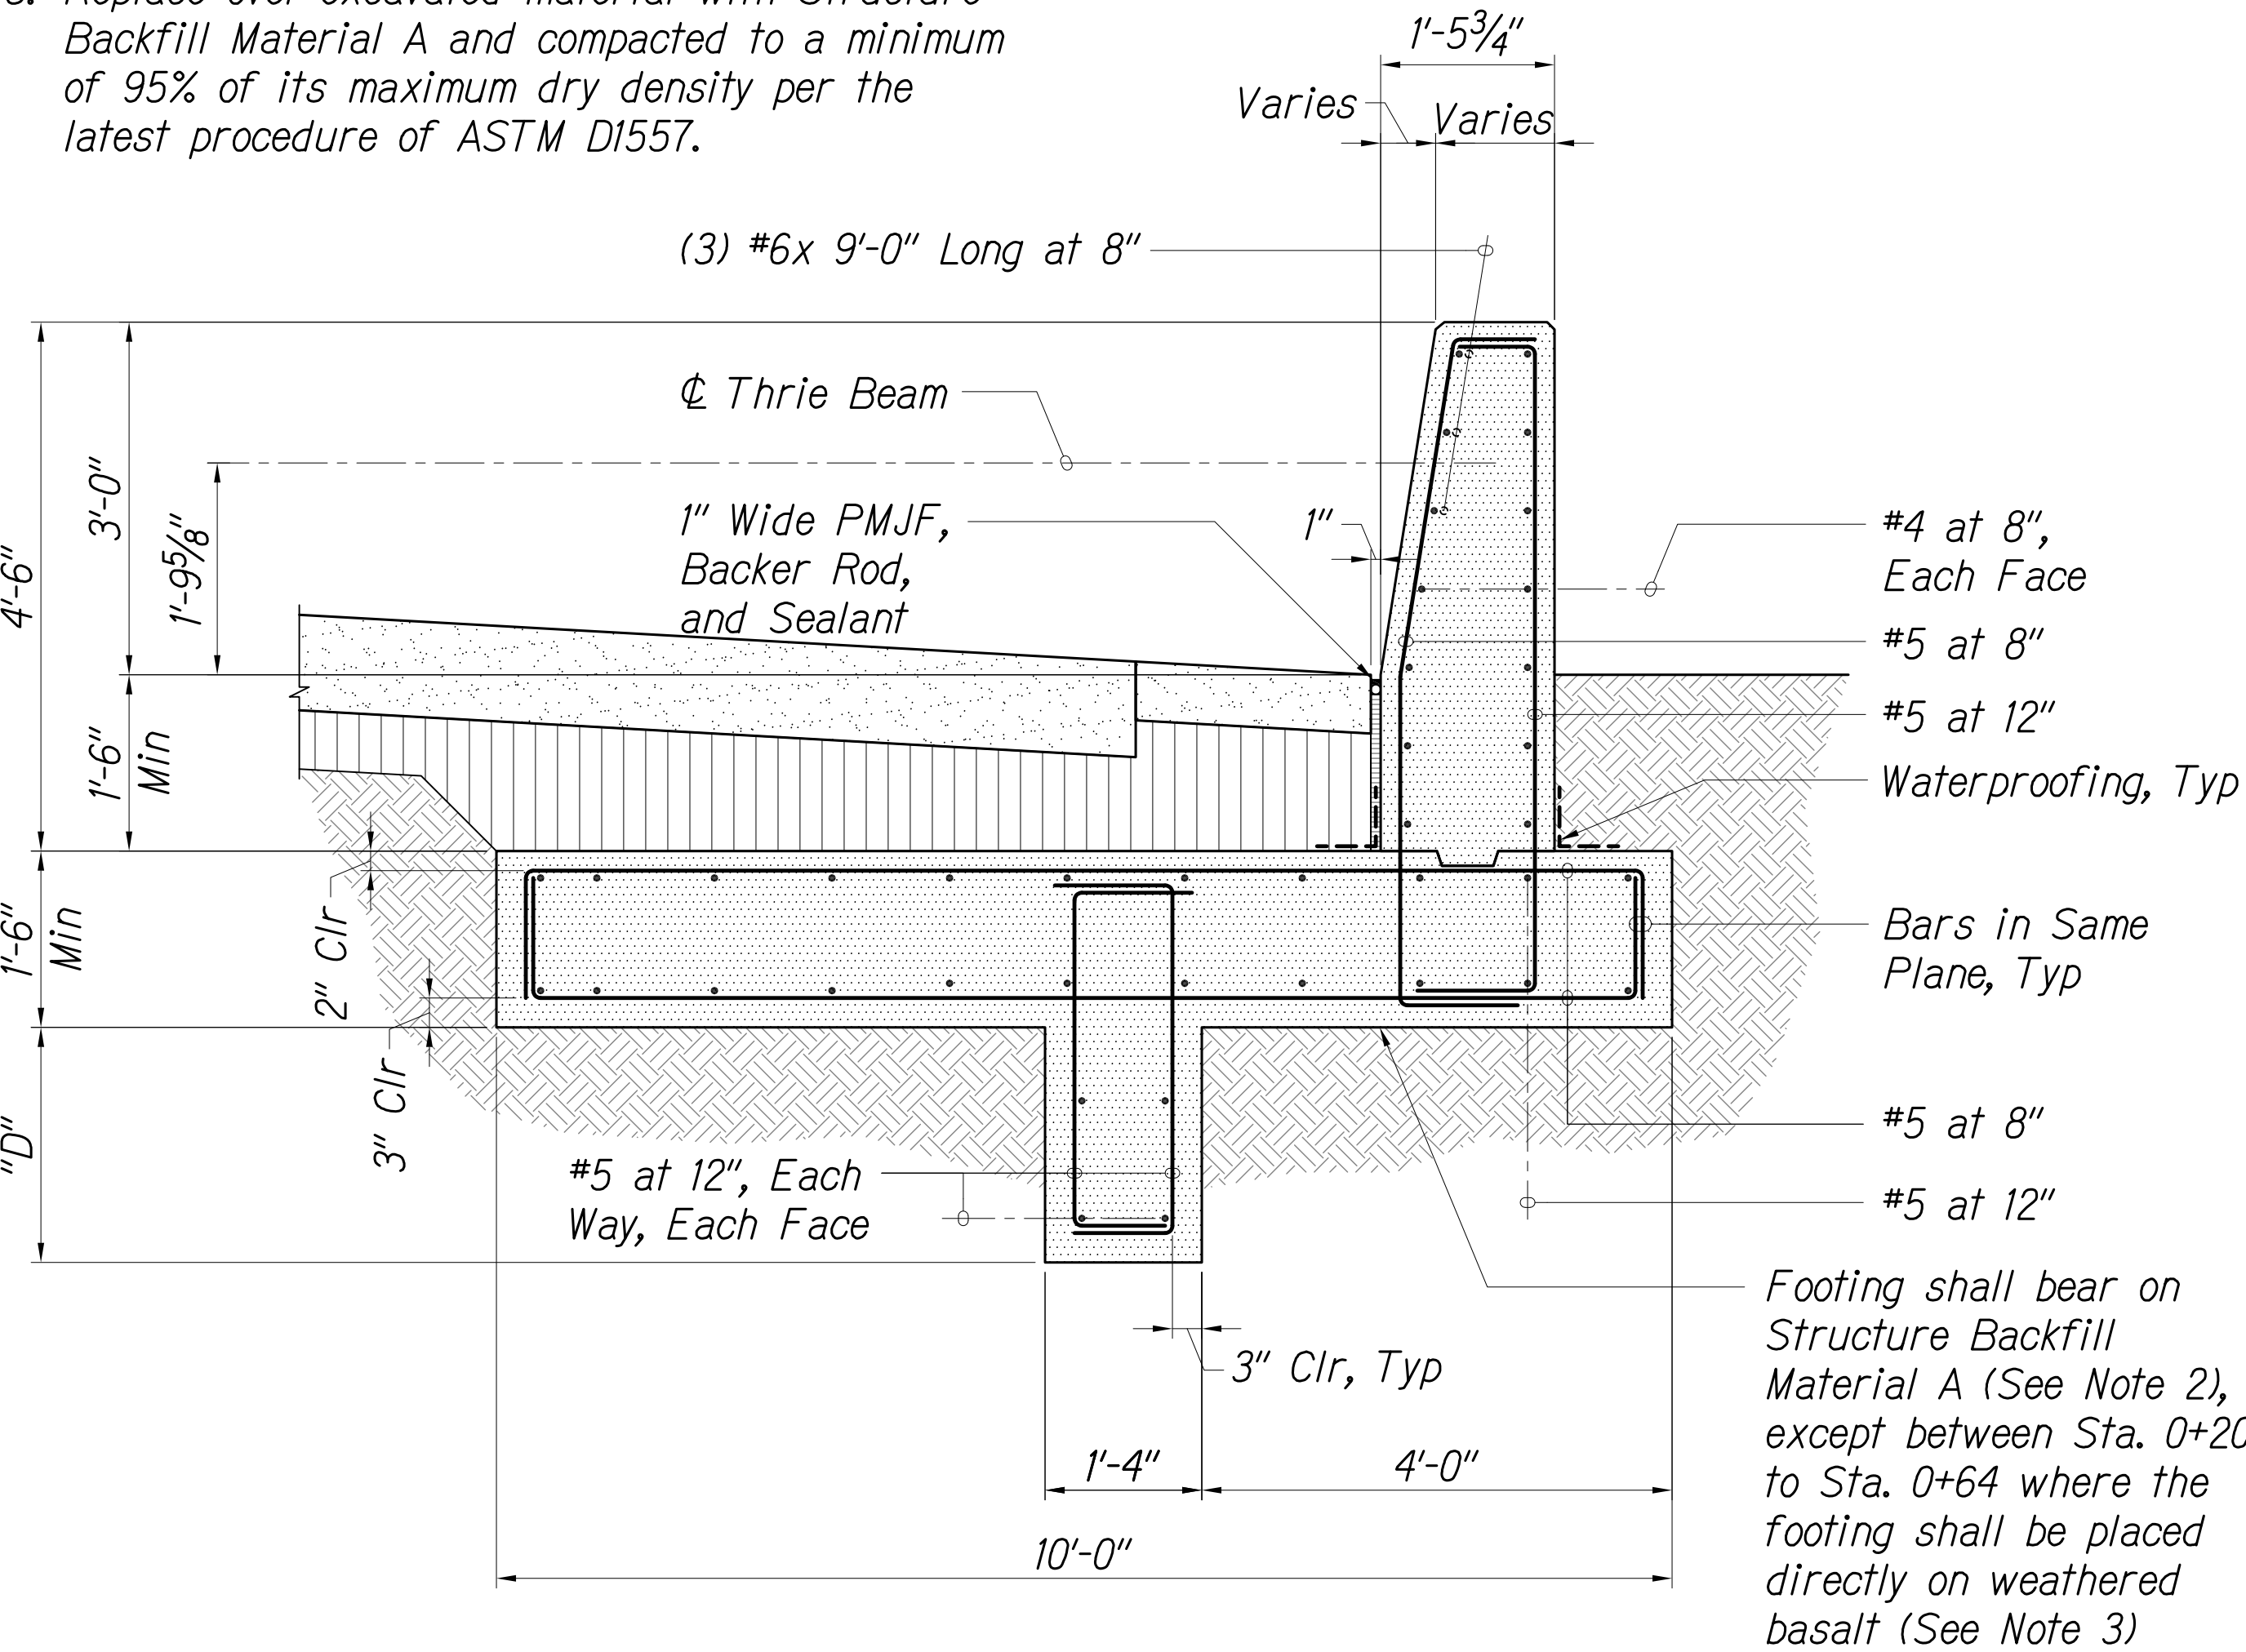

Section at Transition

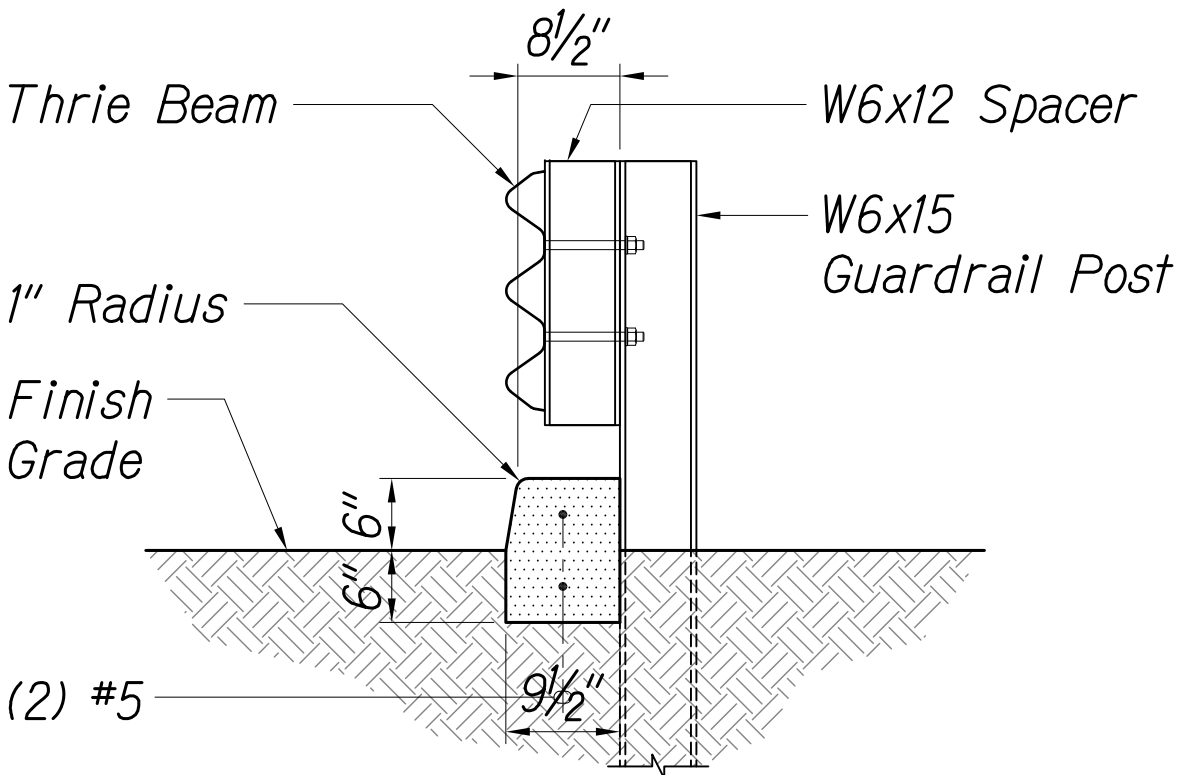


Section at Guardrail Post

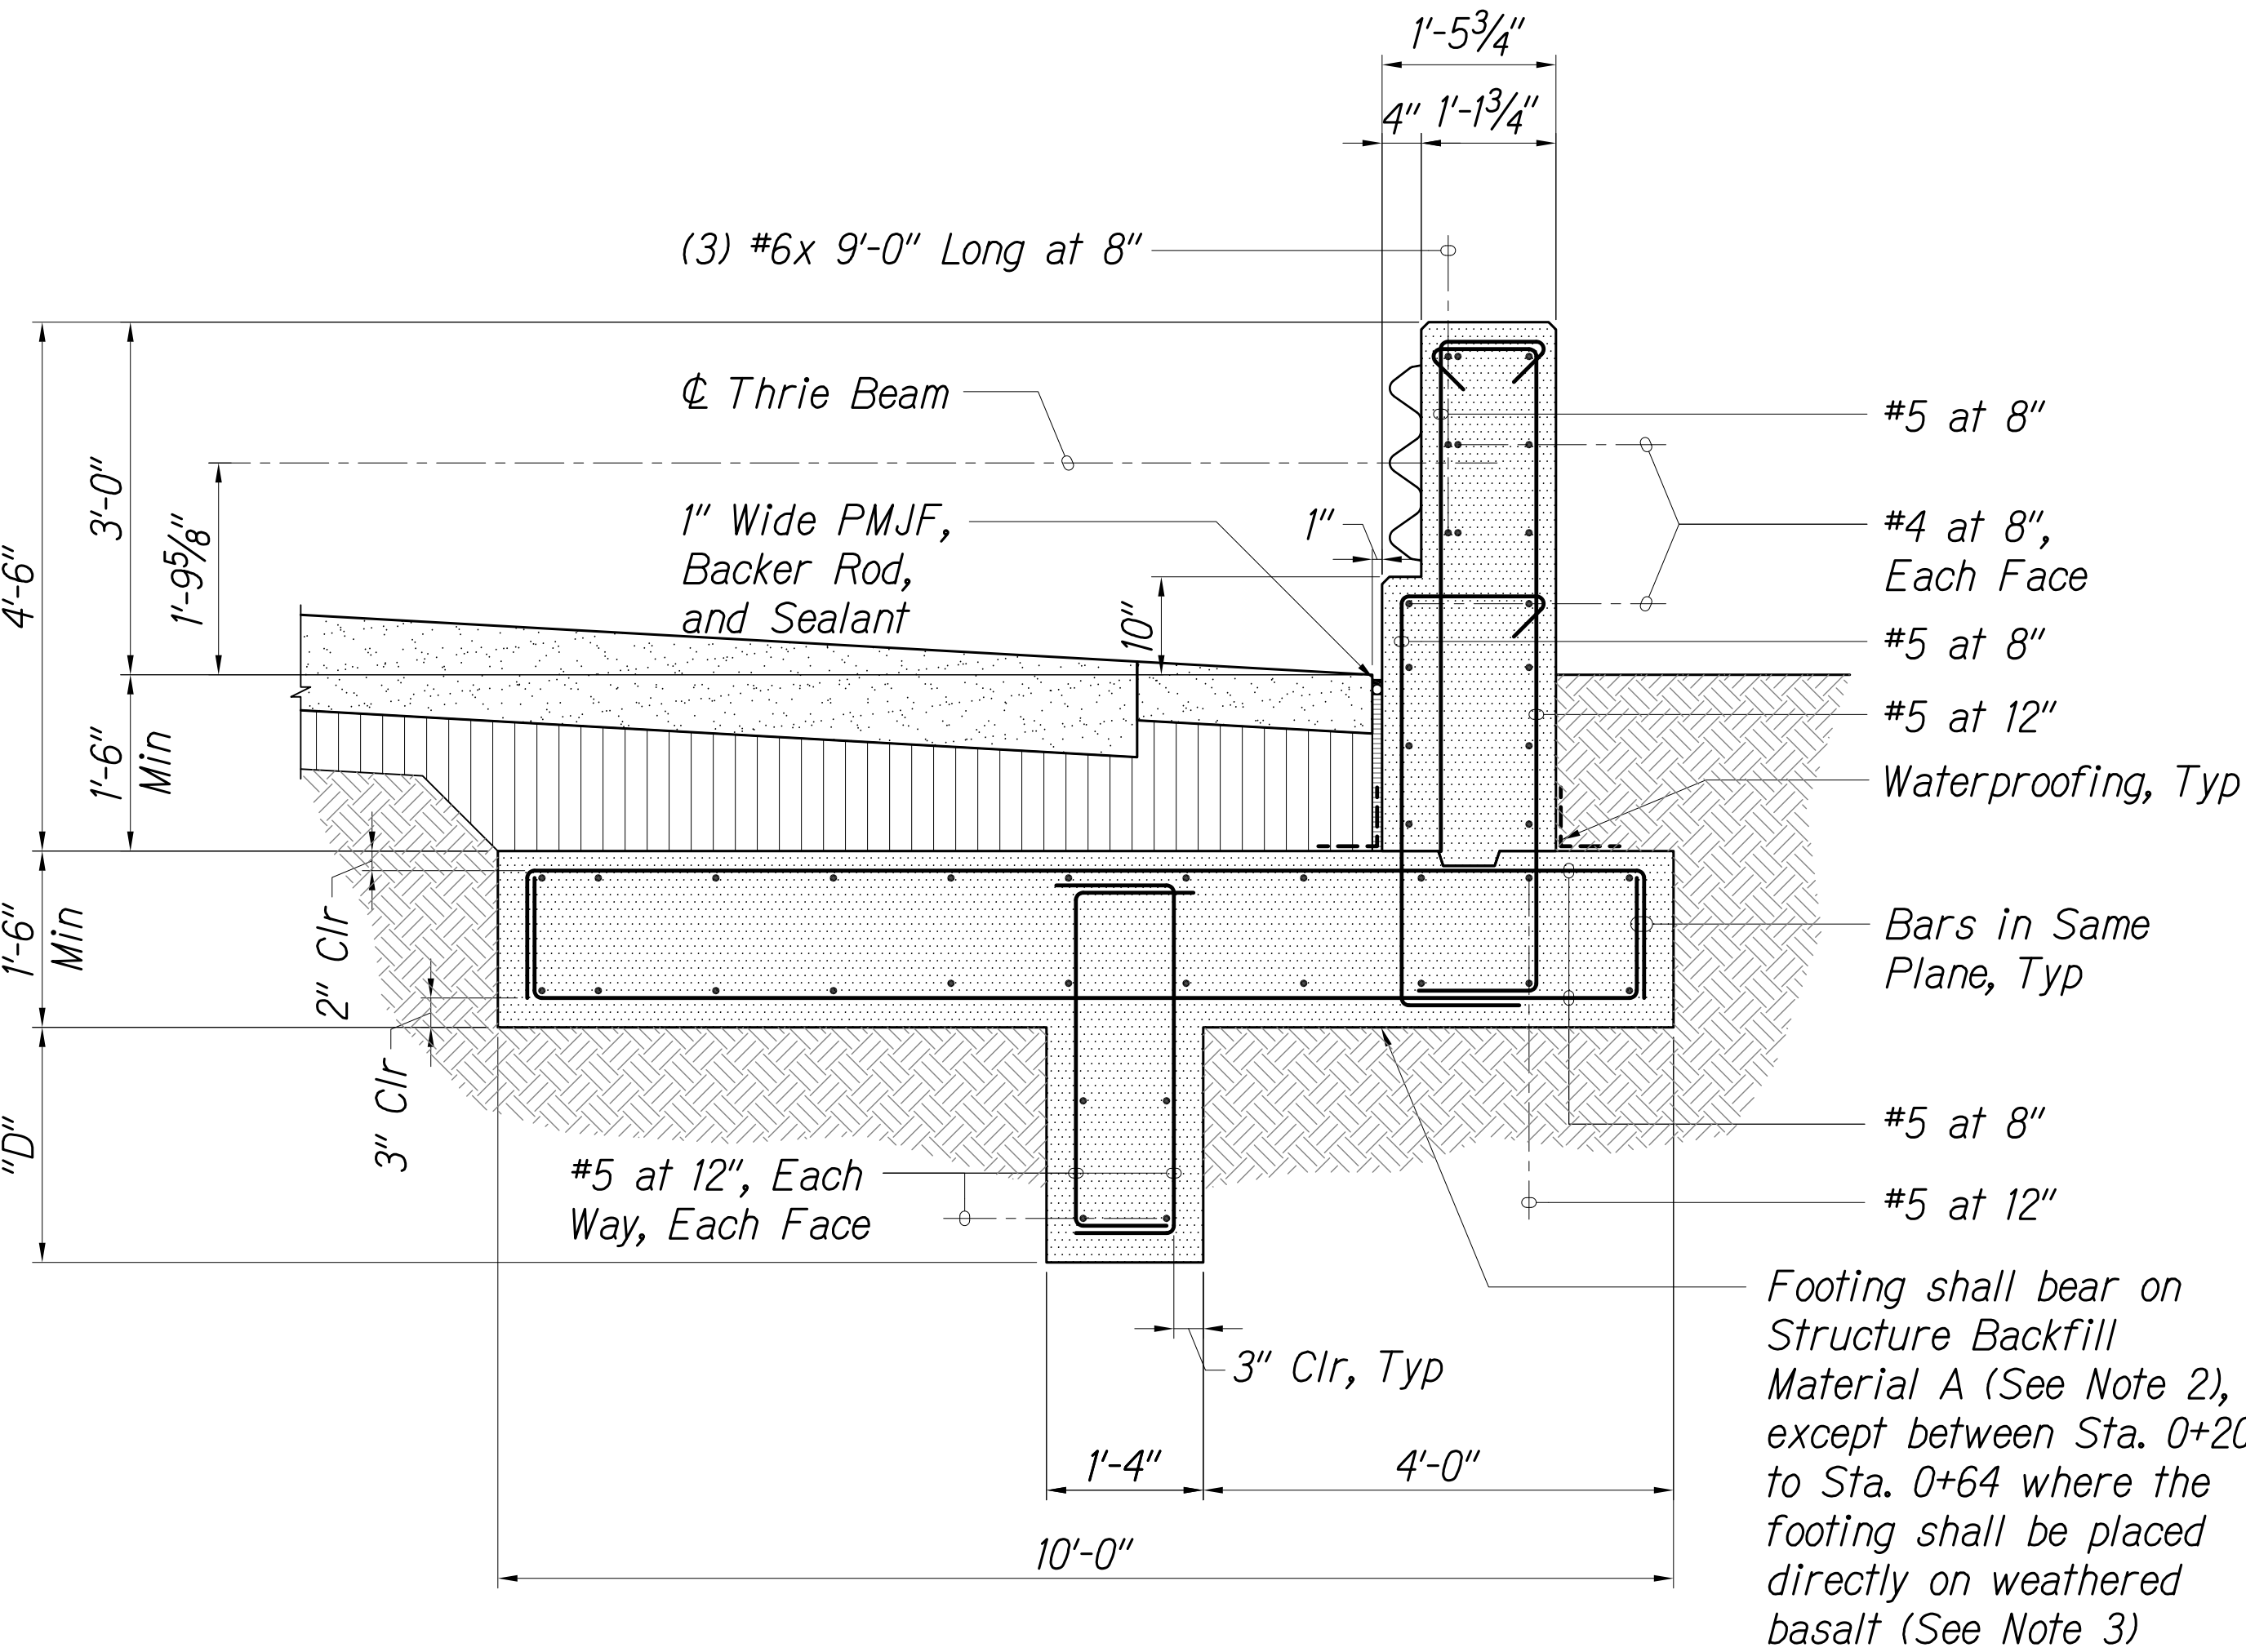


Section at Terminal Connection

RETAINING WALL NO. 4 SECTIONS AT END POST

Scale: 3/4" = 1'-0"

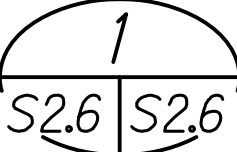

THESE PLANS HAVE BEEN PREPARED UTILIZING INFORMATION PROVIDED BY THE PROJECT CONTRACTOR. THE UPDATED CONSTRUCTION INFORMATION DEPICTED HEREIN HAS NOT BEEN VERIFIED FOR ACCURACY AND COMPLETENESS. NO REPRESENTATION IS BEING MADE TO ITS VALIDITY.

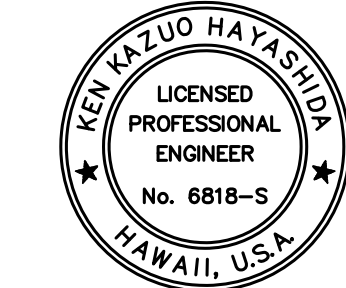

THIS WORK WAS PREPARED BY ME OR UNDER MY SUPERVISION.

Signature: [Signature] April 30, 2020
EXPIRATION DATE OF THE LICENSE

DEPARTMENT OF TRANSPORTATION
HIGHWAYS DIVISION
RETAINING WALL NO. 4
SECTIONS AT END POST


INTERSTATE ROUTE H-1
SHOULDER WORK AND PORTLAND CEMENT
CONCRETE PAVEMENT REHABILITATION
VICINITY OF WAIMALU TO VICINITY OF HALAWA
PHASE 2 - SHOULDER WORK

Scale: As Shown Date: November 30, 2018



SHEET No. S2.6 OF 10 SHEETS

"AS-BUILT"


FED. ROAD DIST. NO.	STATE	FED. AID PROJ. NO.	FISCAL YEAR	SHEET NO.	TOTAL SHEETS
HAWAII	HAW.	NH-H1-1(274)	2018	93	126

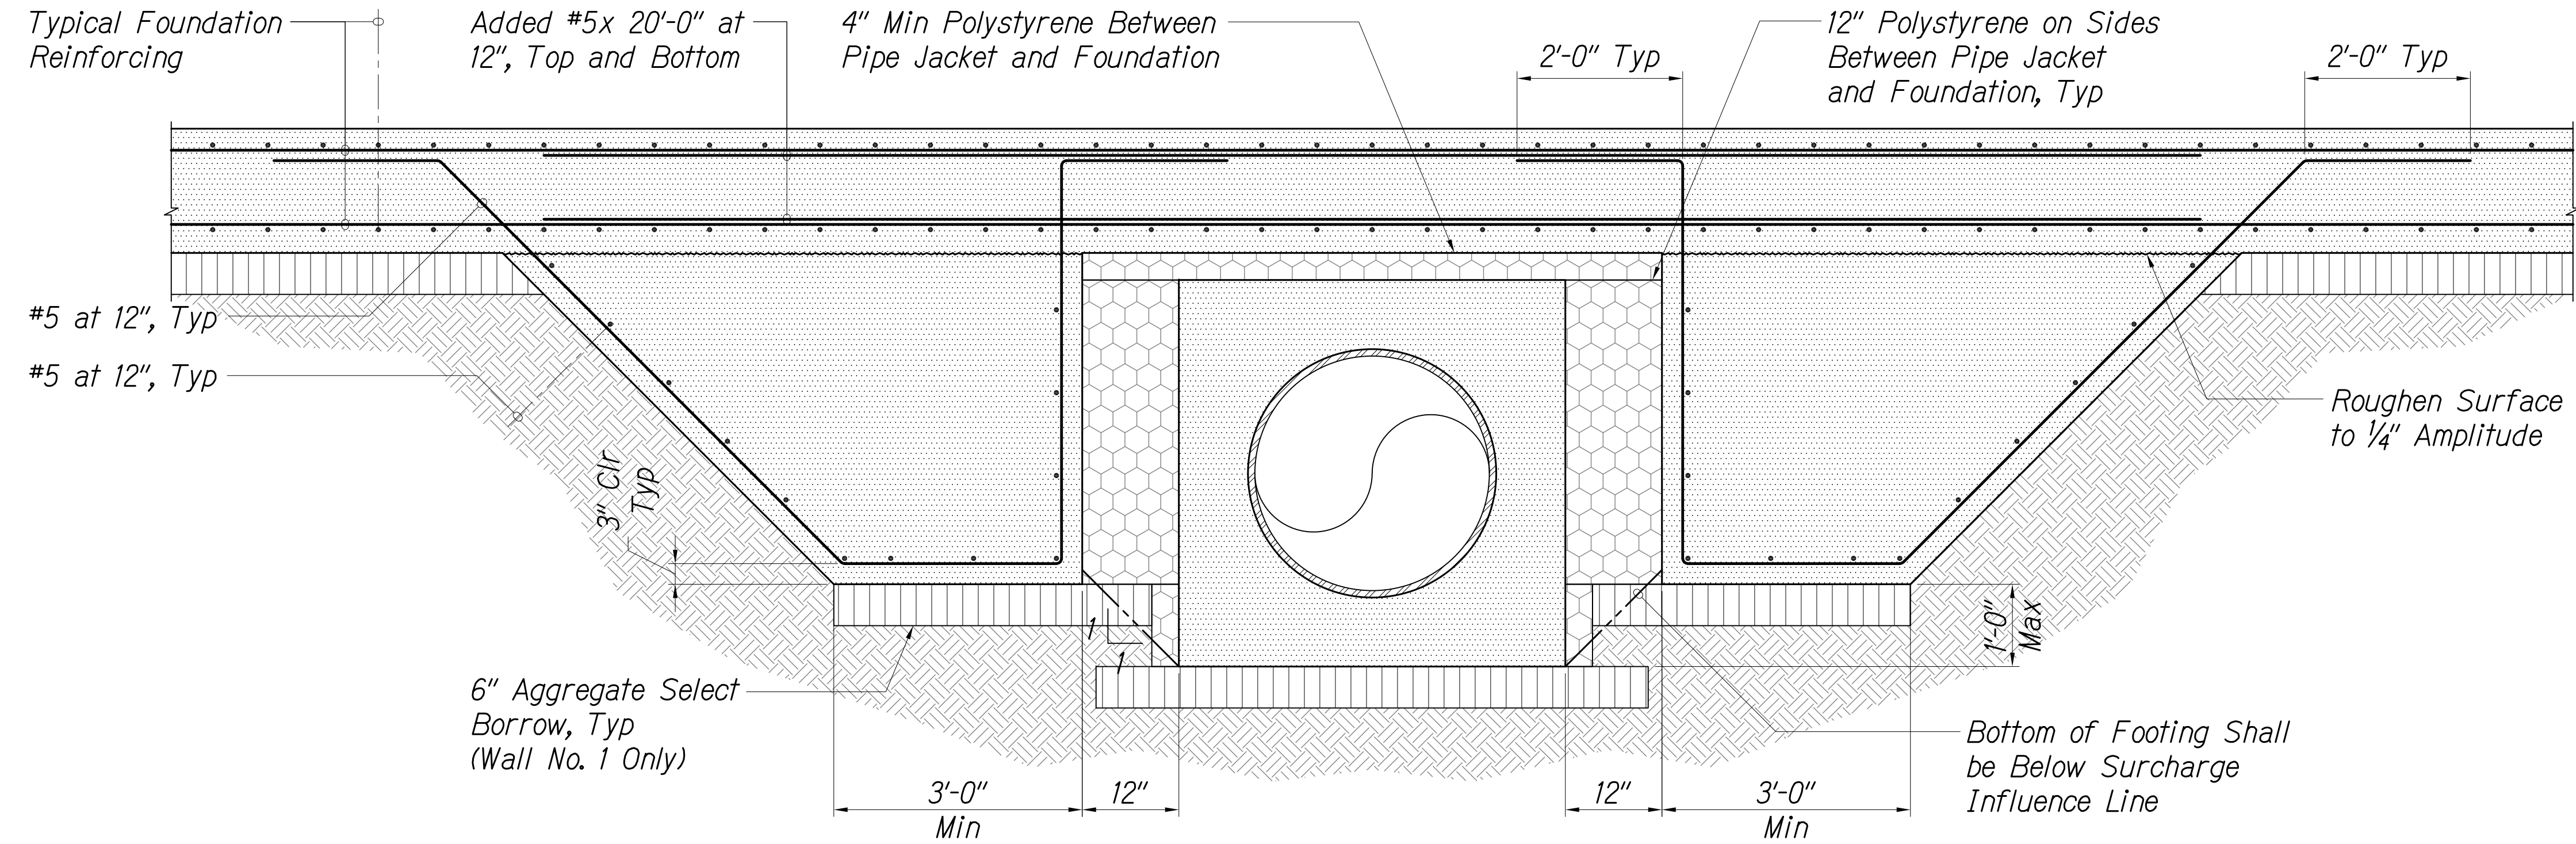

TYPICAL THICKENED FOUNDATION AT WATERLINE
Scale: 3/4" = 1'-0"

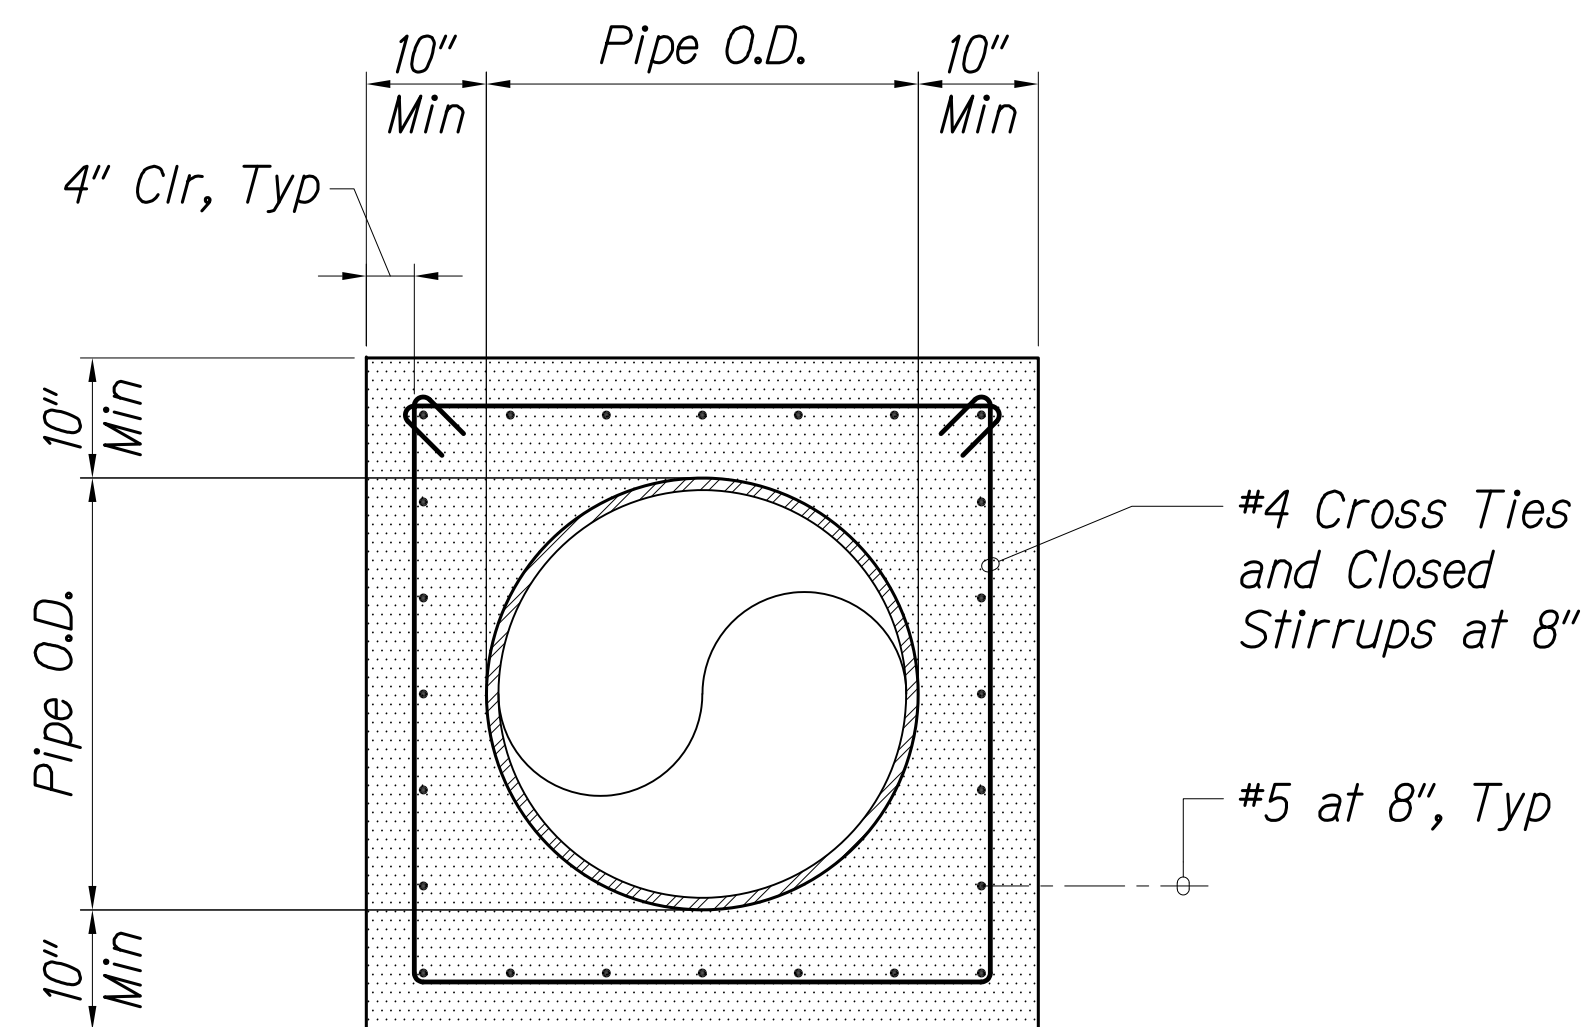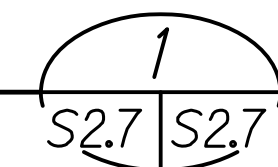


TYPICAL WATERLINE JACKET DETAIL
Scale: 3/4" = 1'-0"

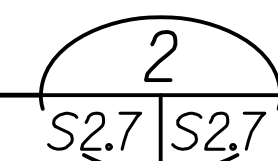

ORIGINAL PLAN	SURVEY PLOTTED BY	DATE
NOTE BOOK	DRAWN BY	
No.	TRACED BY	
	QUANTITIES BY	
	CHECKED BY	

P:\451-4500\4508-1001 - Kent Design build of HI Watering\04 Drawings\Structural\AutoCAD\Format\Phase 2\2020-02-06 - As-Built\4508-S2-1-S2-10.dwg 2/6/2020 11:21 AM BRYAN LUM

THESE PLANS HAVE BEEN PREPARED UTILIZING INFORMATION PROVIDED BY THE PROJECT CONTRACTOR. THE UPDATED CONSTRUCTION INFORMATION DEPICTED HEREIN HAS NOT BEEN VERIFIED FOR ACCURACY AND COMPLETENESS. NO REPRESENTATION IS BEING MADE TO ITS VALIDITY.

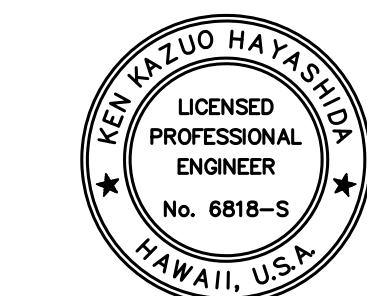

THIS WORK WAS PREPARED BY ME OR UNDER MY SUPERVISION.

SIGNATURE: *[Signature]* EXPIRATION DATE OF THE LICENSE: April 30, 2020


STATE OF HAWAII
DEPARTMENT OF TRANSPORTATION
HIGHWAYS DIVISION
RETAINING WALL NOS. 1 & 4
TYPICAL DETAILS
INTERSTATE ROUTE H-1
SHOULDER WORK AND PORTLAND CEMENT
CONCRETE PAVEMENT REHABILITATION
VICINITY OF WAIMALU TO VICINITY OF HALAWA
PHASE 2 - SHOULDER WORK
Scale: As Shown Date: November 30, 2018
SHEET No. S2.7 OF 10 SHEETS

"AS-BUILT"

FED. ROAD DIST. NO.	STATE	FED. AID PROJ. NO.	FISCAL YEAR	SHEET NO.	TOTAL SHEETS
HAWAII	HAW.	NH-H1-11274	2018	93A	126



Notes:

- For the vertical bars at the top of wall between Sta. 0+35 and Sta. 1+71, the contractor may elect to field bend 8" long hooked ends similar to locations where "H1" < 2'-2" in lieu of providing additional #4 U-bars. The #4 U-bars around the light standard shall remain.
- Contractor to field verify elevation of bottom of jacket.

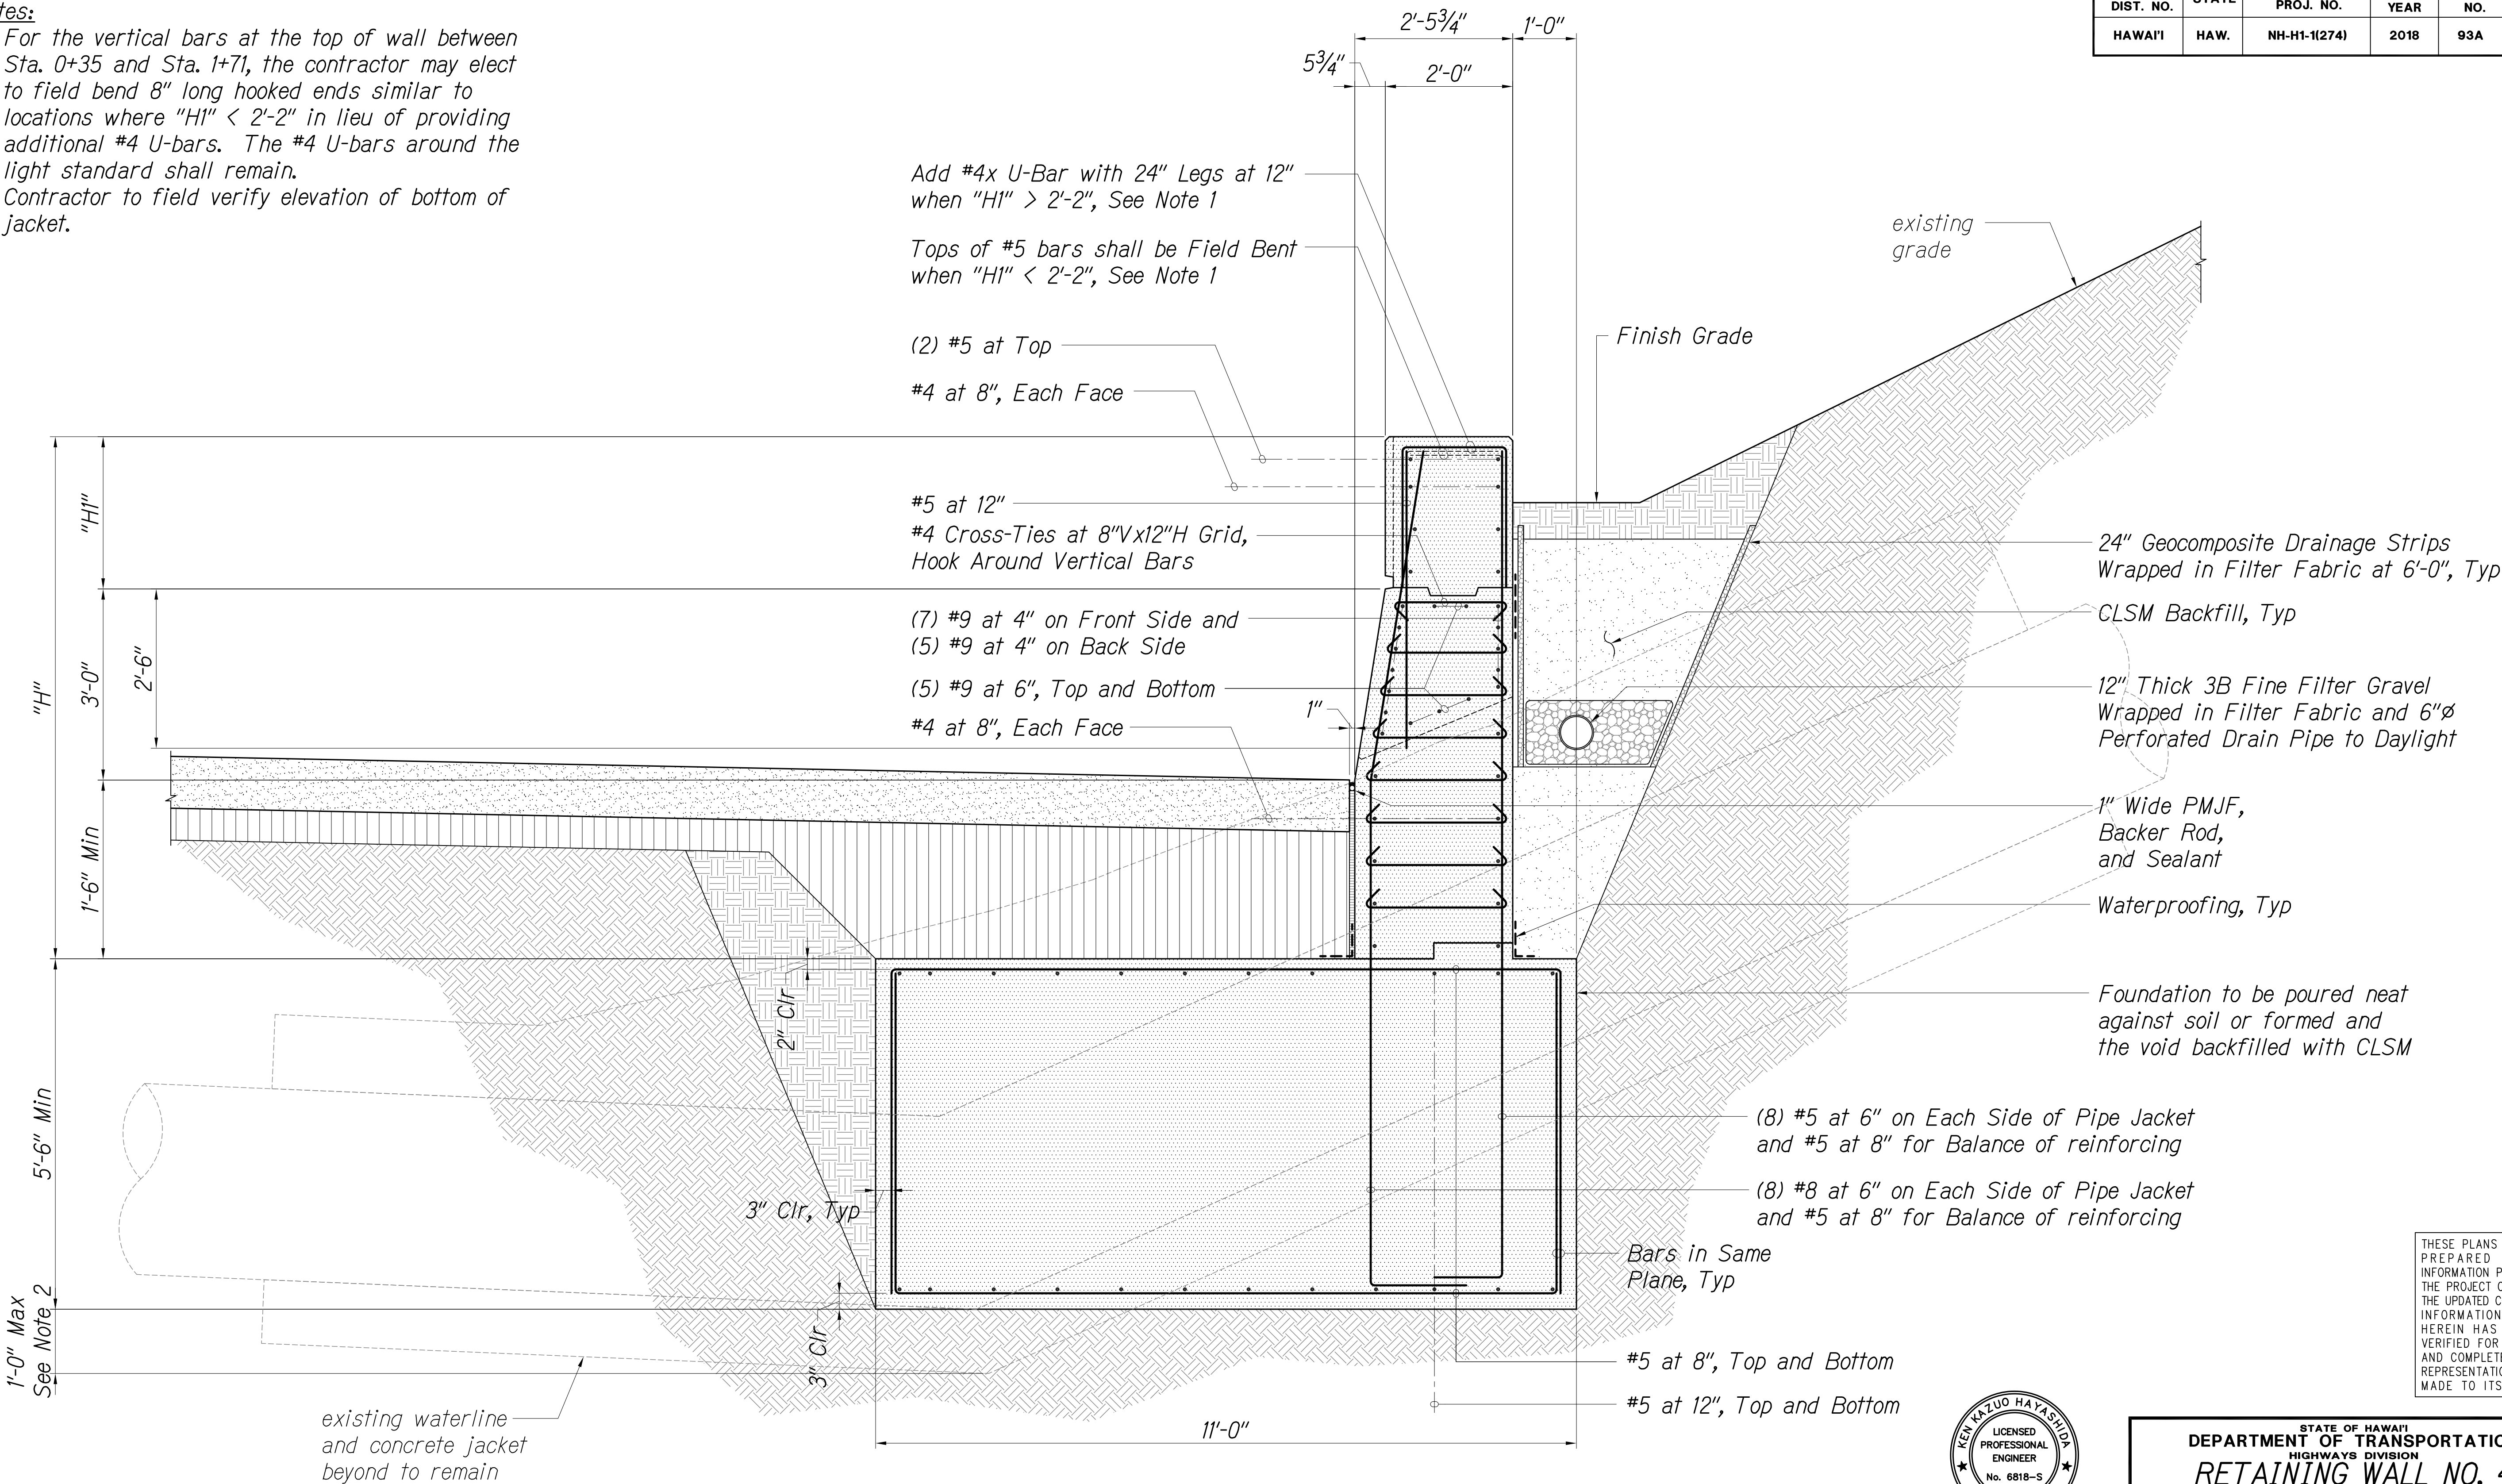

RETAINING WALL NO. 4 SECTION AT EACH SIDE OF WATERLINE

Scale: 3/4" = 1'-0"

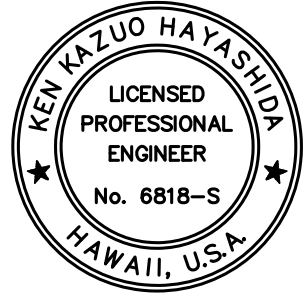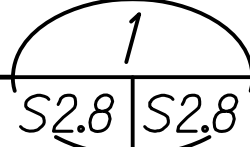

THIS WORK WAS PREPARED BY ME
OR UNDER MY SUPERVISION.

SIGNATURE: *[Signature]* April 30, 2020
EXPIRATION DATE
OF THE LICENSE

THESE PLANS HAVE BEEN
PREPARED UTILIZING
INFORMATION PROVIDED BY
THE PROJECT CONTRACTOR.
THE UPDATED CONSTRUCTION
INFORMATION DEPICTED
HEREIN HAS NOT BEEN
VERIFIED FOR ACCURACY
AND COMPLETENESS. NO
REPRESENTATION IS BEING
MADE TO ITS VALIDITY.

STATE OF HAWAII
DEPARTMENT OF TRANSPORTATION
HIGHWAYS DIVISION

RETAINING WALL NO. 4

SECTION AT WATERLINE - 1

INTERSTATE ROUTE H-1
SHOULDER WORK AND PORTLAND CEMENT
CONCRETE PAVEMENT REHABILITATION

VICINITY OF WAIMALU TO VICINITY OF HALAWA
PHASE 2 - SHOULDER WORK

Scale: As Shown Date: November 30, 2018

SHEET No. S2.8 OF 10 SHEETS


"AS-BUILT"

93A

FED. ROAD DIST. NO.	STATE	FED. AID PROJ. NO.	FISCAL YEAR	SHEET NO.	TOTAL SHEETS
HAWAII	HAW.	NH-H1-1(274)	2018	93B	126



Notes:

- For the vertical bars at the top of wall between Sta. 0+35 and Sta. 1+71, the contractor may elect to field bend 8" long hooked ends similar to locations where "H1" < 2'-2" in lieu of providing additional #4 U-bars. The #4 U-bars around the light standard shall remain.
- Contractor to field verify elevation of bottom of jacket.

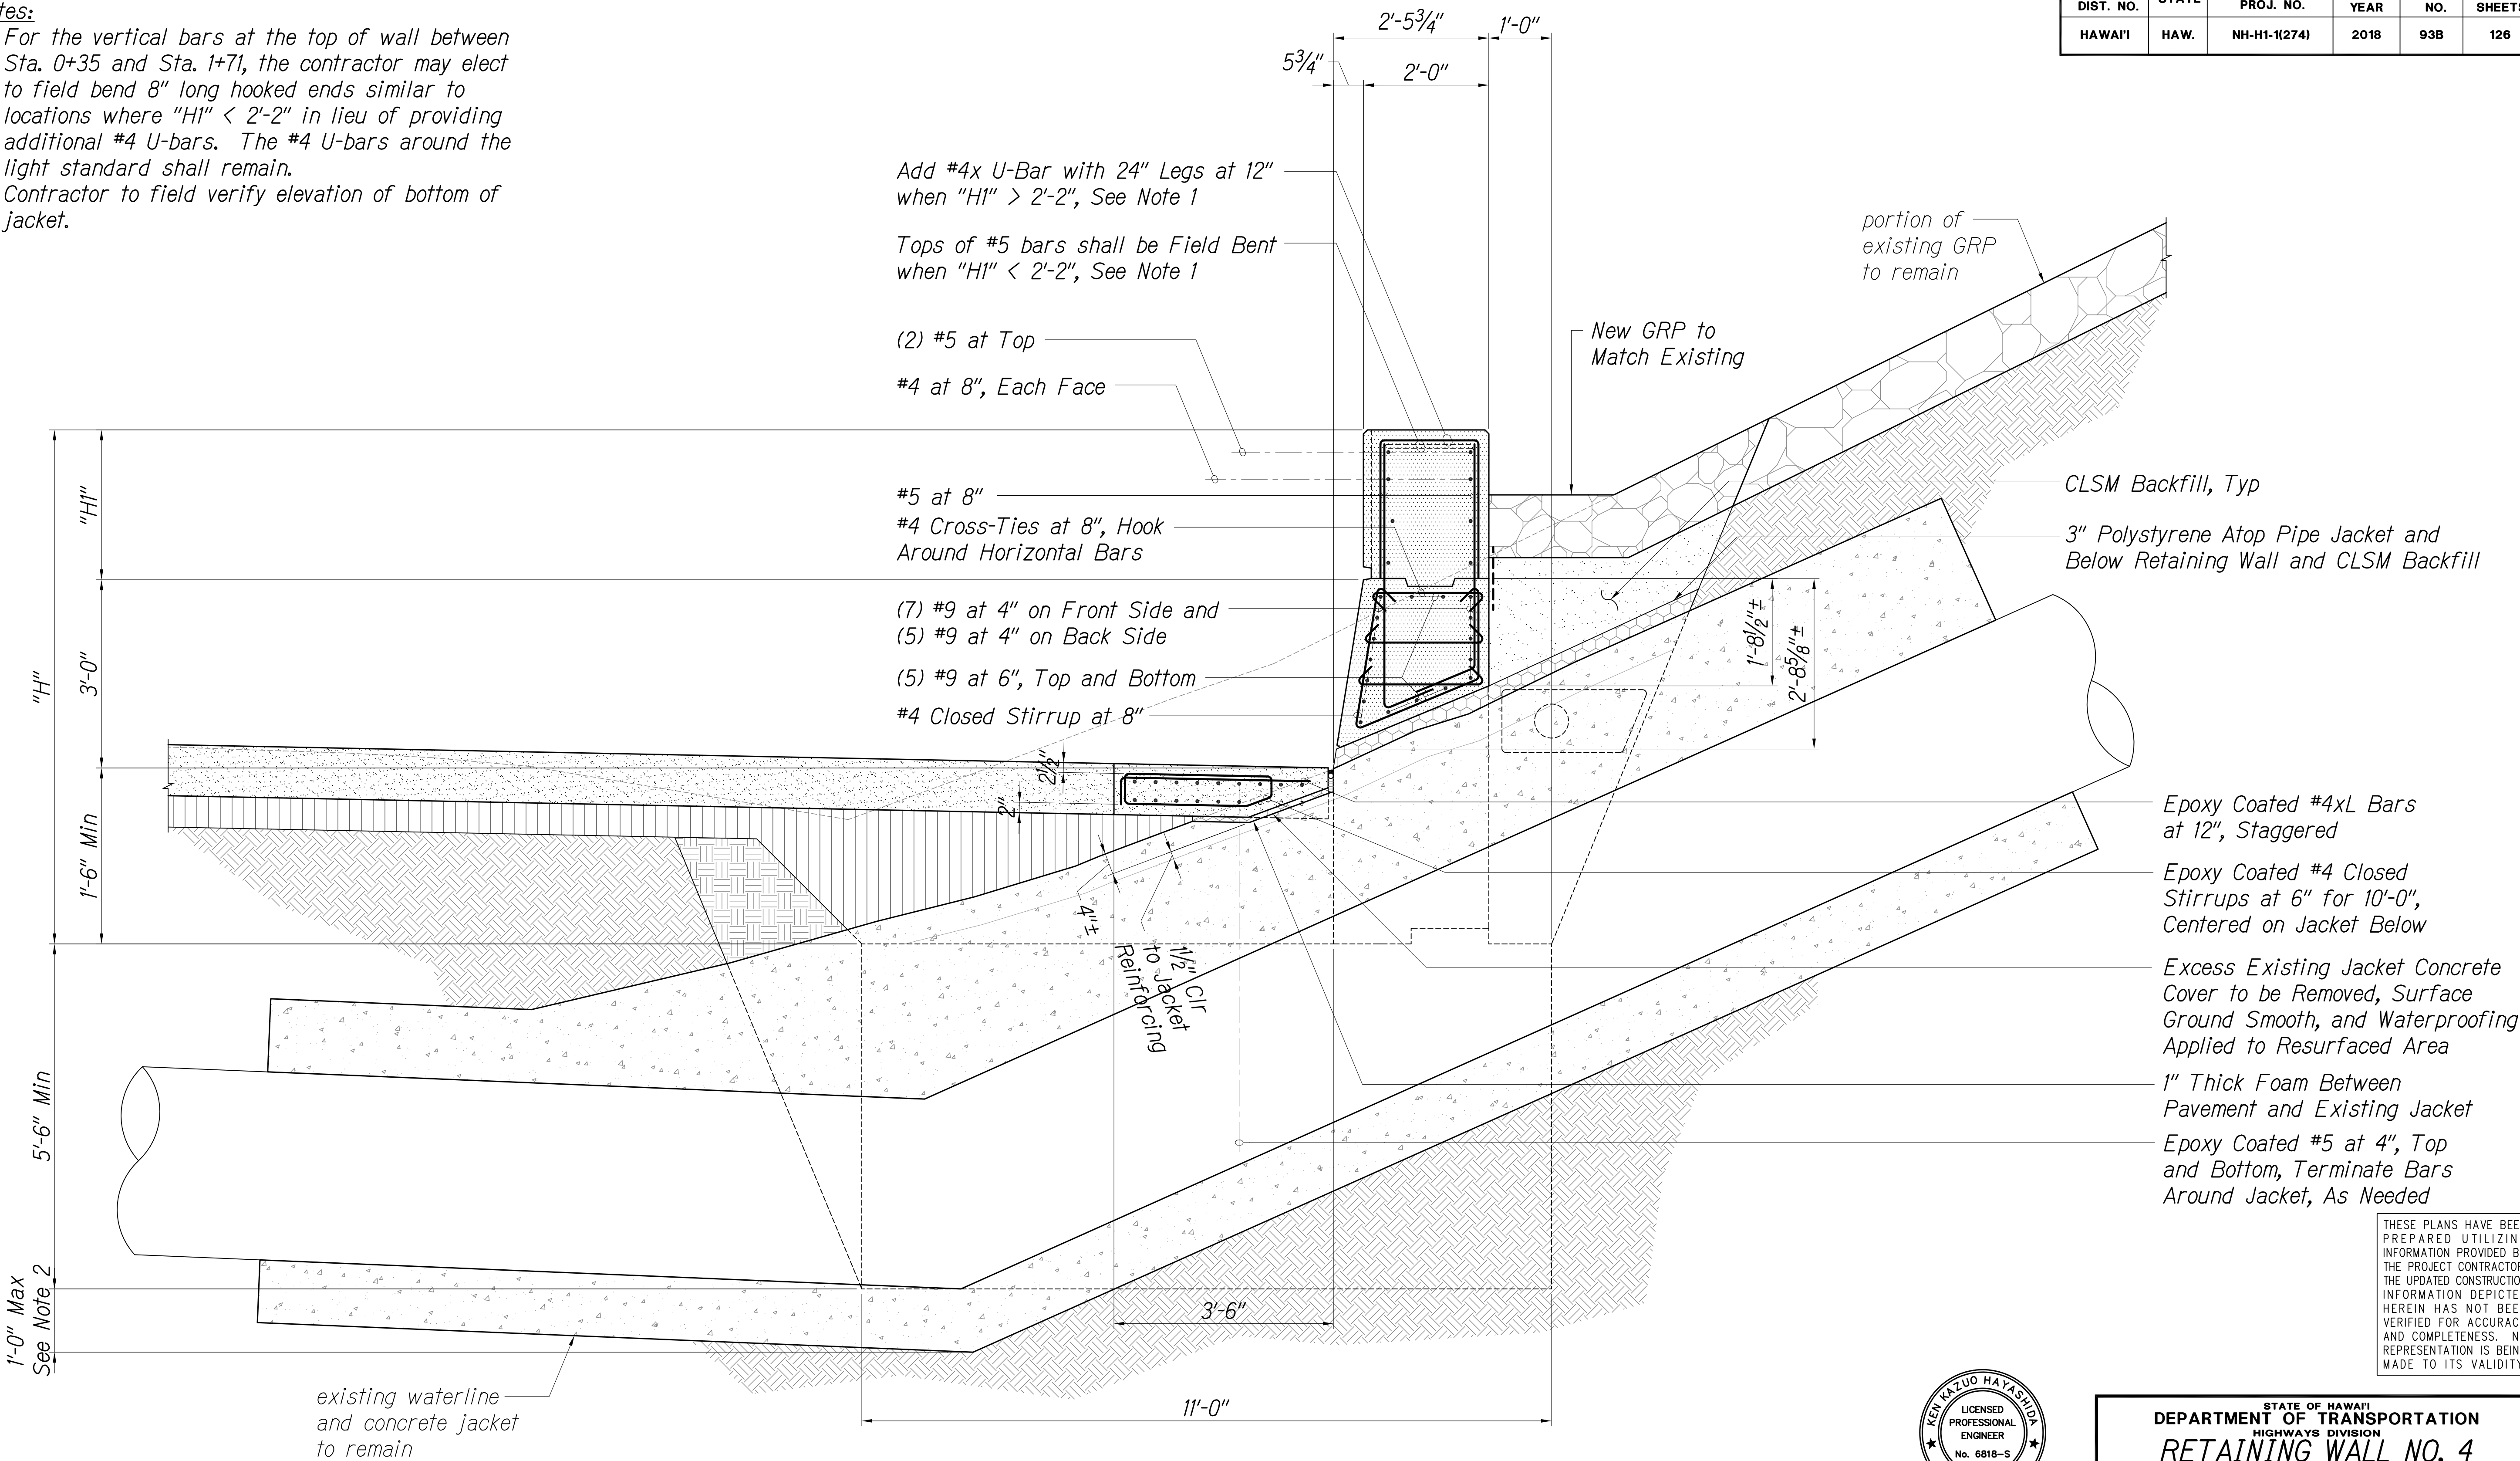

RETAINING WALL NO. 4 SECTION AT WATERLINE

Scale: 3/4" = 1'-0"

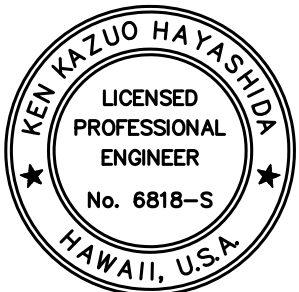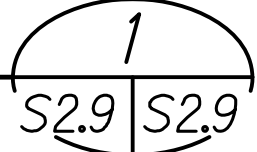

THIS WORK WAS PREPARED BY ME
OR UNDER MY SUPERVISION.

SIGNATURE: *[Signature]* April 30, 2020
EXPIRATION DATE OF THE LICENSE

THESE PLANS HAVE BEEN
PREPARED UTILIZING
INFORMATION PROVIDED BY
THE PROJECT CONTRACTOR.
THE UPDATED CONSTRUCTION
INFORMATION DEPICTED
HEREIN HAS NOT BEEN
VERIFIED FOR ACCURACY
AND COMPLETENESS. NO
REPRESENTATION IS BEING
MADE TO ITS VALIDITY.

STATE OF HAWAII
DEPARTMENT OF TRANSPORTATION
HIGHWAYS DIVISION
RETAINING WALL NO. 4
SECTION AT WATERLINE - 2

INTERSTATE ROUTE H-1
SHOULDER WORK AND PORTLAND CEMENT
CONCRETE PAVEMENT REHABILITATION
VICINITY OF WAIMALU TO VICINITY OF HALAWA
PHASE 2 - SHOULDER WORK

Scale: As Shown Date: November 30, 2018

SHEET No. S2.9 OF 10 SHEETS



"AS-BUILT"

93B

P:\451-4500\4500-1007 - Kiewit Design build of HI Waterline\04 Drawings\Structural\AutoCAD\Drawings\Phase 2\2020-02-06 - As-Built\4500-S2-1-S2-10.dwg 2/6/2020 11:21 AM BRYAN LIM


ORIGINAL PLAN	SURVEY PLOTTED BY	DATE
NOTE BOOK	DRAWN BY	
No.	TRACED BY	
	CHECKED BY	

FED. ROAD DIST. NO.	STATE	FED. AID PROJ. NO.	FISCAL YEAR	SHEET NO.	TOTAL SHEETS
HAWAII	HAW.	NH-H1-112741	2018	93C	126

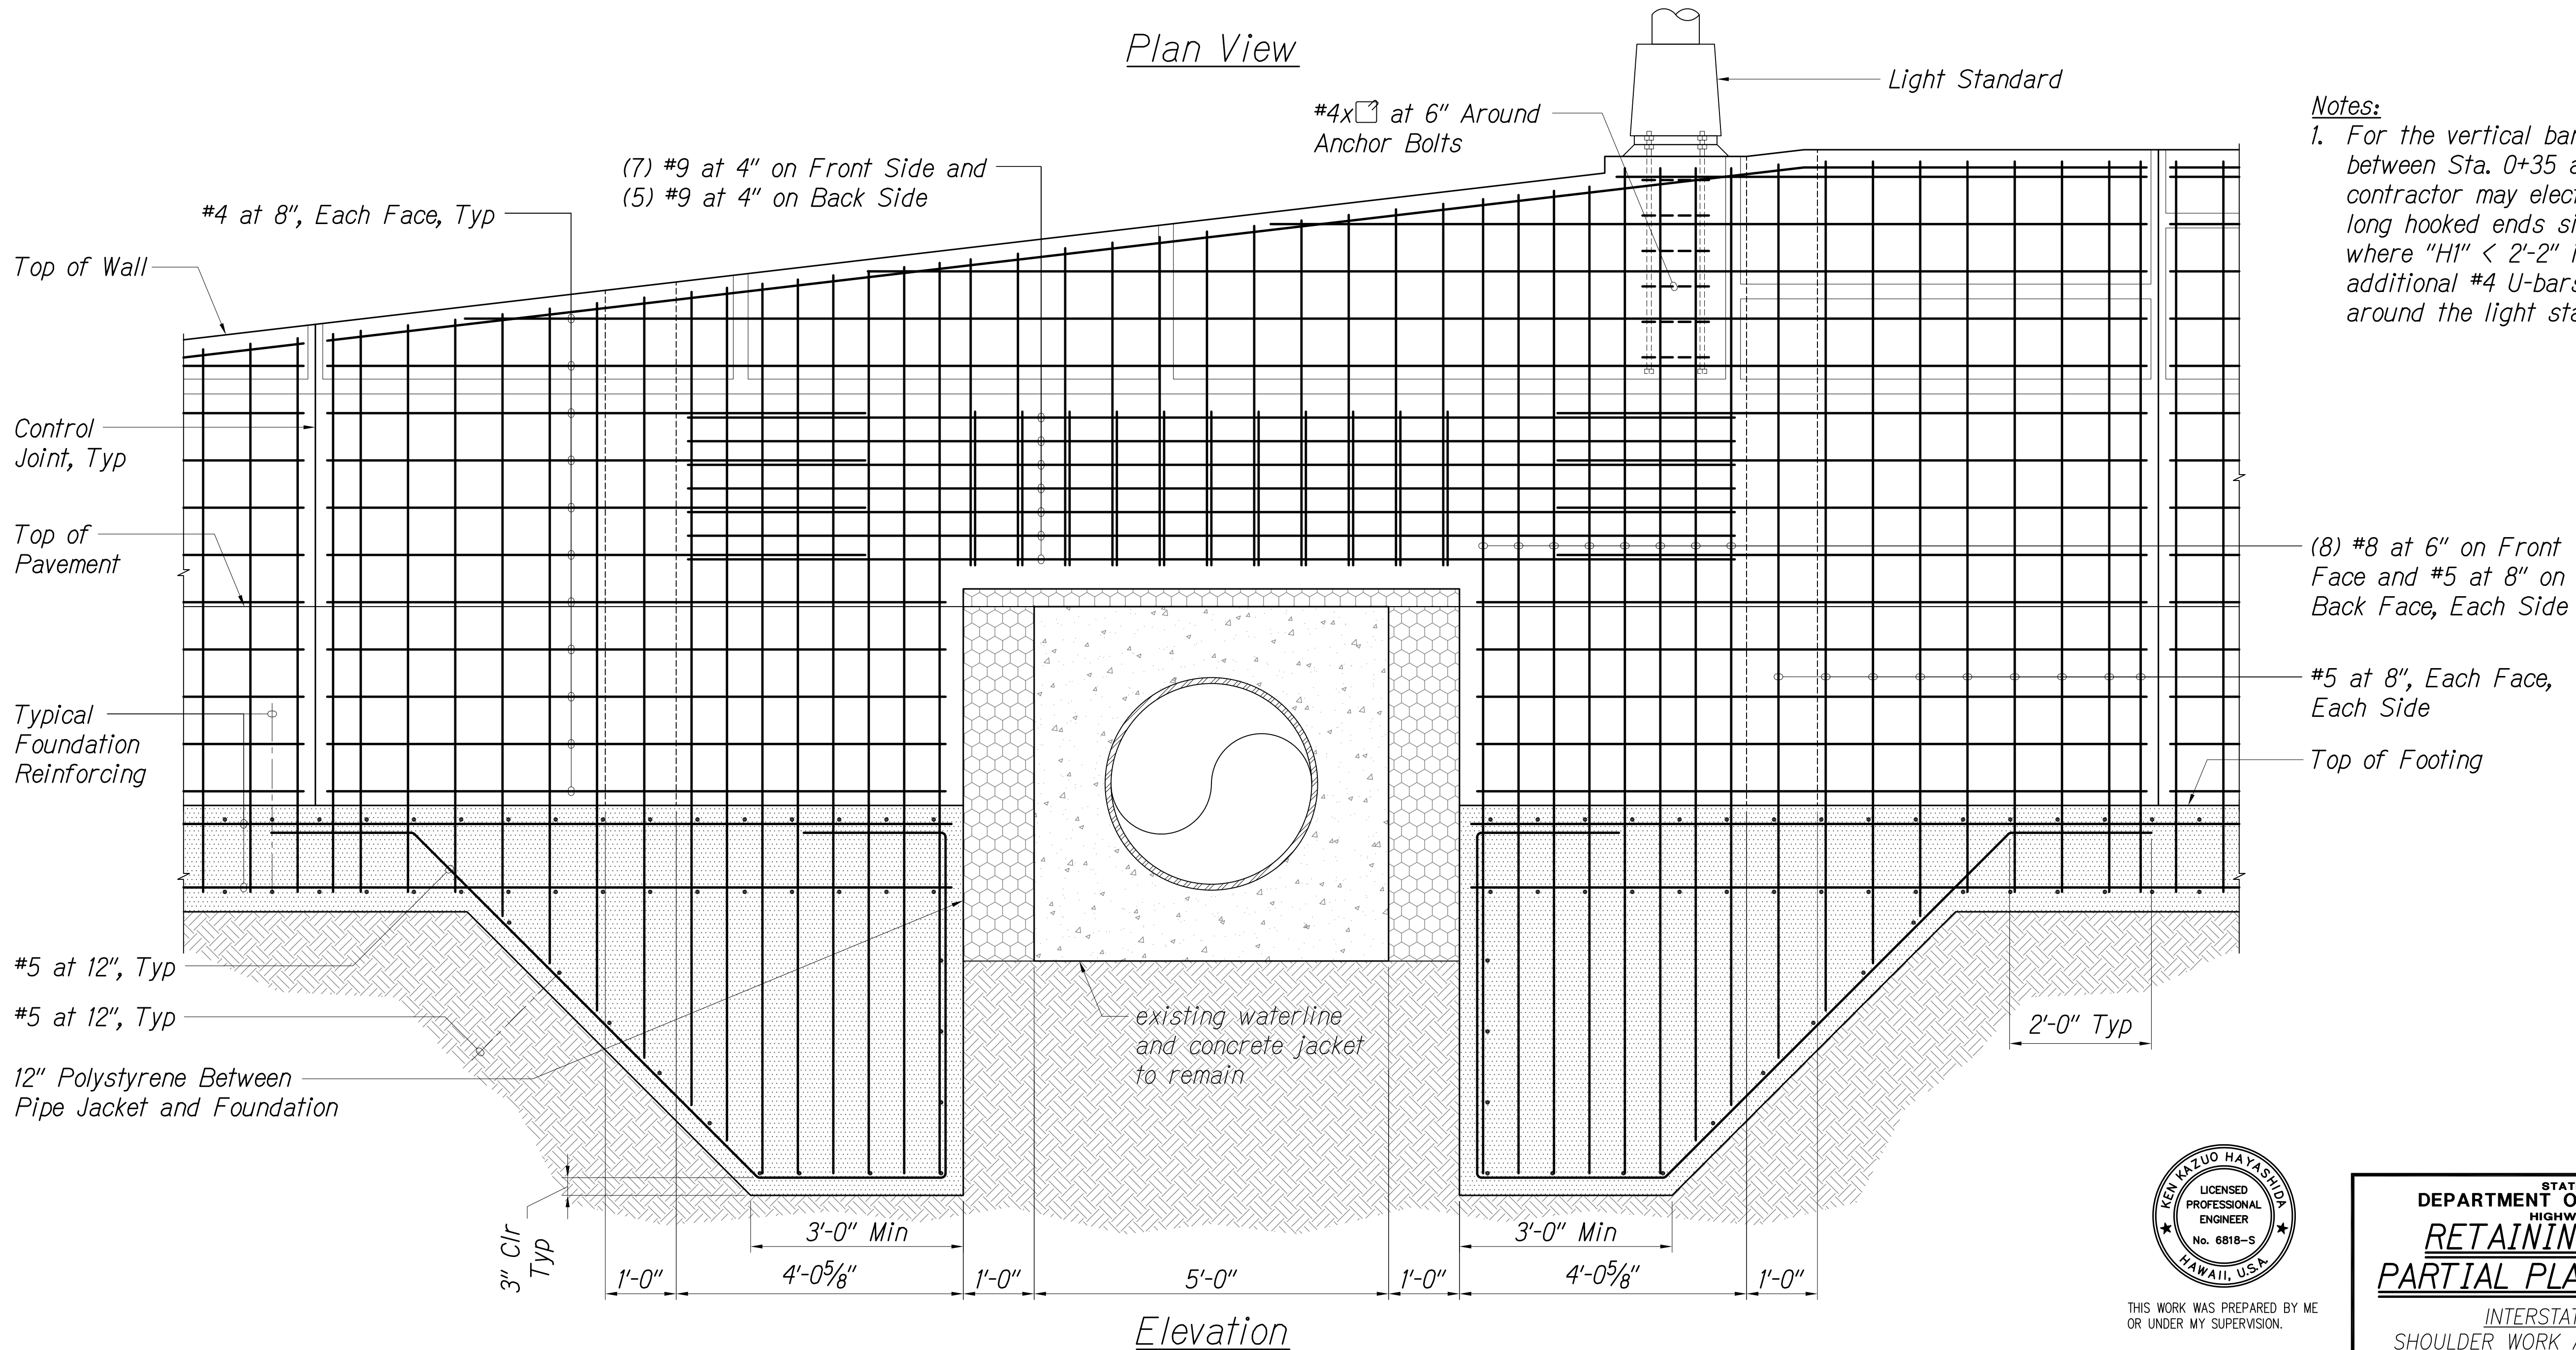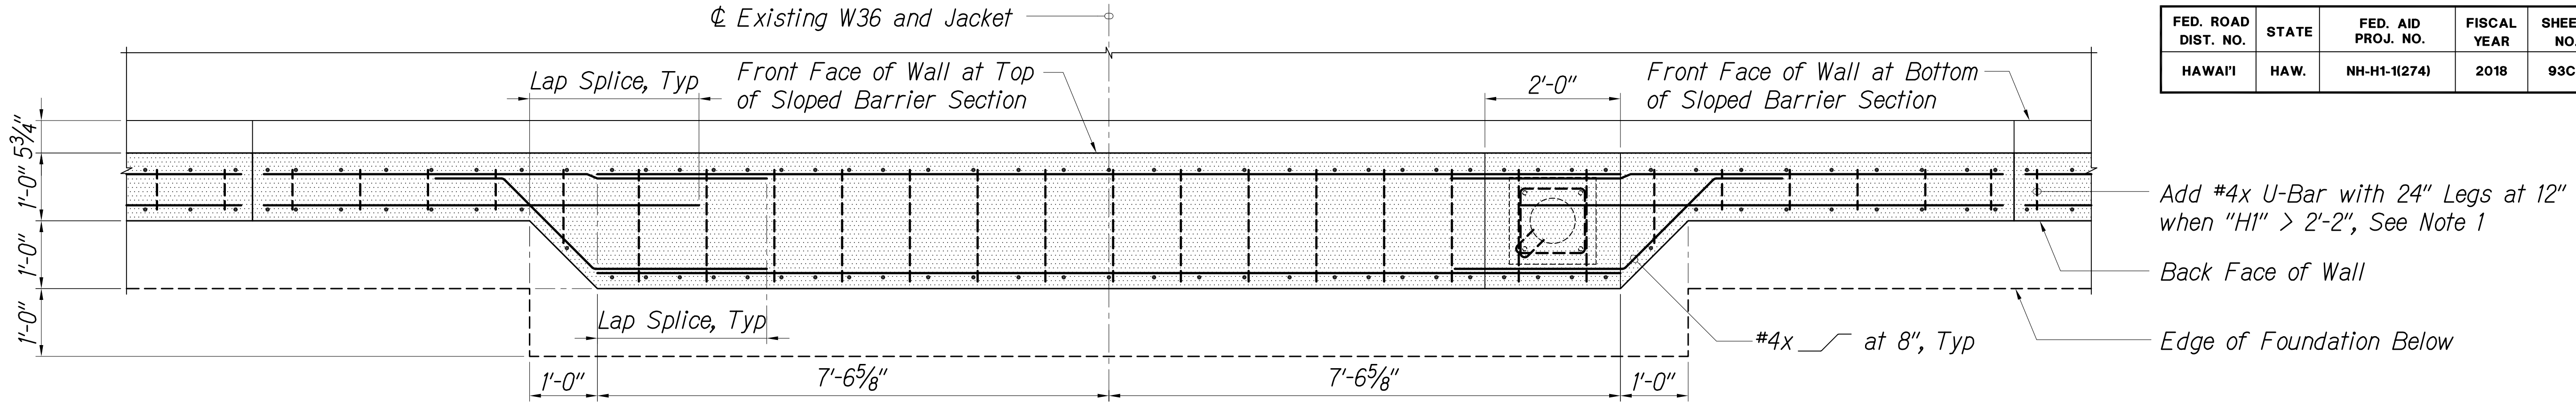

Notes:
1. For the vertical bars at the top of wall between Sta. 0+35 and Sta. 1+71, the contractor may elect to field bend 8" long hooked ends similar to locations where "H1" < 2'-2" in lieu of providing additional #4 U-bars. The #4 U-bars around the light standard shall remain.

THESE PLANS HAVE BEEN PREPARED UTILIZING INFORMATION PROVIDED BY THE PROJECT CONTRACTOR. THE UPDATED CONSTRUCTION INFORMATION DEPICTED HEREIN HAS NOT BEEN VERIFIED FOR ACCURACY AND COMPLETENESS. NO REPRESENTATION IS BEING MADE TO ITS VALIDITY.

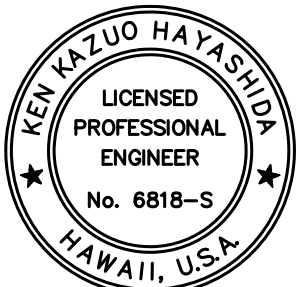

THIS WORK WAS PREPARED BY ME OR UNDER MY SUPERVISION.

SIGNATURE: [Signature] EXPIRATION DATE OF THE LICENSE: April 30, 2020

STATE OF HAWAII
DEPARTMENT OF TRANSPORTATION
HIGHWAYS DIVISION


RETAINING WALL NO. 4
PARTIAL PLAN & WALL ELEV.

INTERSTATE ROUTE H-1
SHOULDER WORK AND PORTLAND CEMENT
CONCRETE PAVEMENT REHABILITATION
VICINITY OF WAIMALU TO VICINITY OF HALAWA
PHASE 2 - SHOULDER WORK

Scale: As Shown Date: November 30, 2018

SHEET No. S2.10 OF 10 SHEETS

RETAINING WALL NO. 4 PARTIAL PLAN AND WALL ELEVATION
Scale: 3/4" = 1'-0"

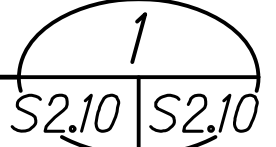


"AS-BUILT"

94


FED. ROAD DIST. NO.	STATE	FED. AID PROJ. NO.	FISCAL YEAR	SHEET NO.	TOTAL SHEETS
HAWAII	HAW.	NH-H1-1(274)	2018	95	126

Note:
For Balance
of Information,
See 1
S3.1 | S3.1

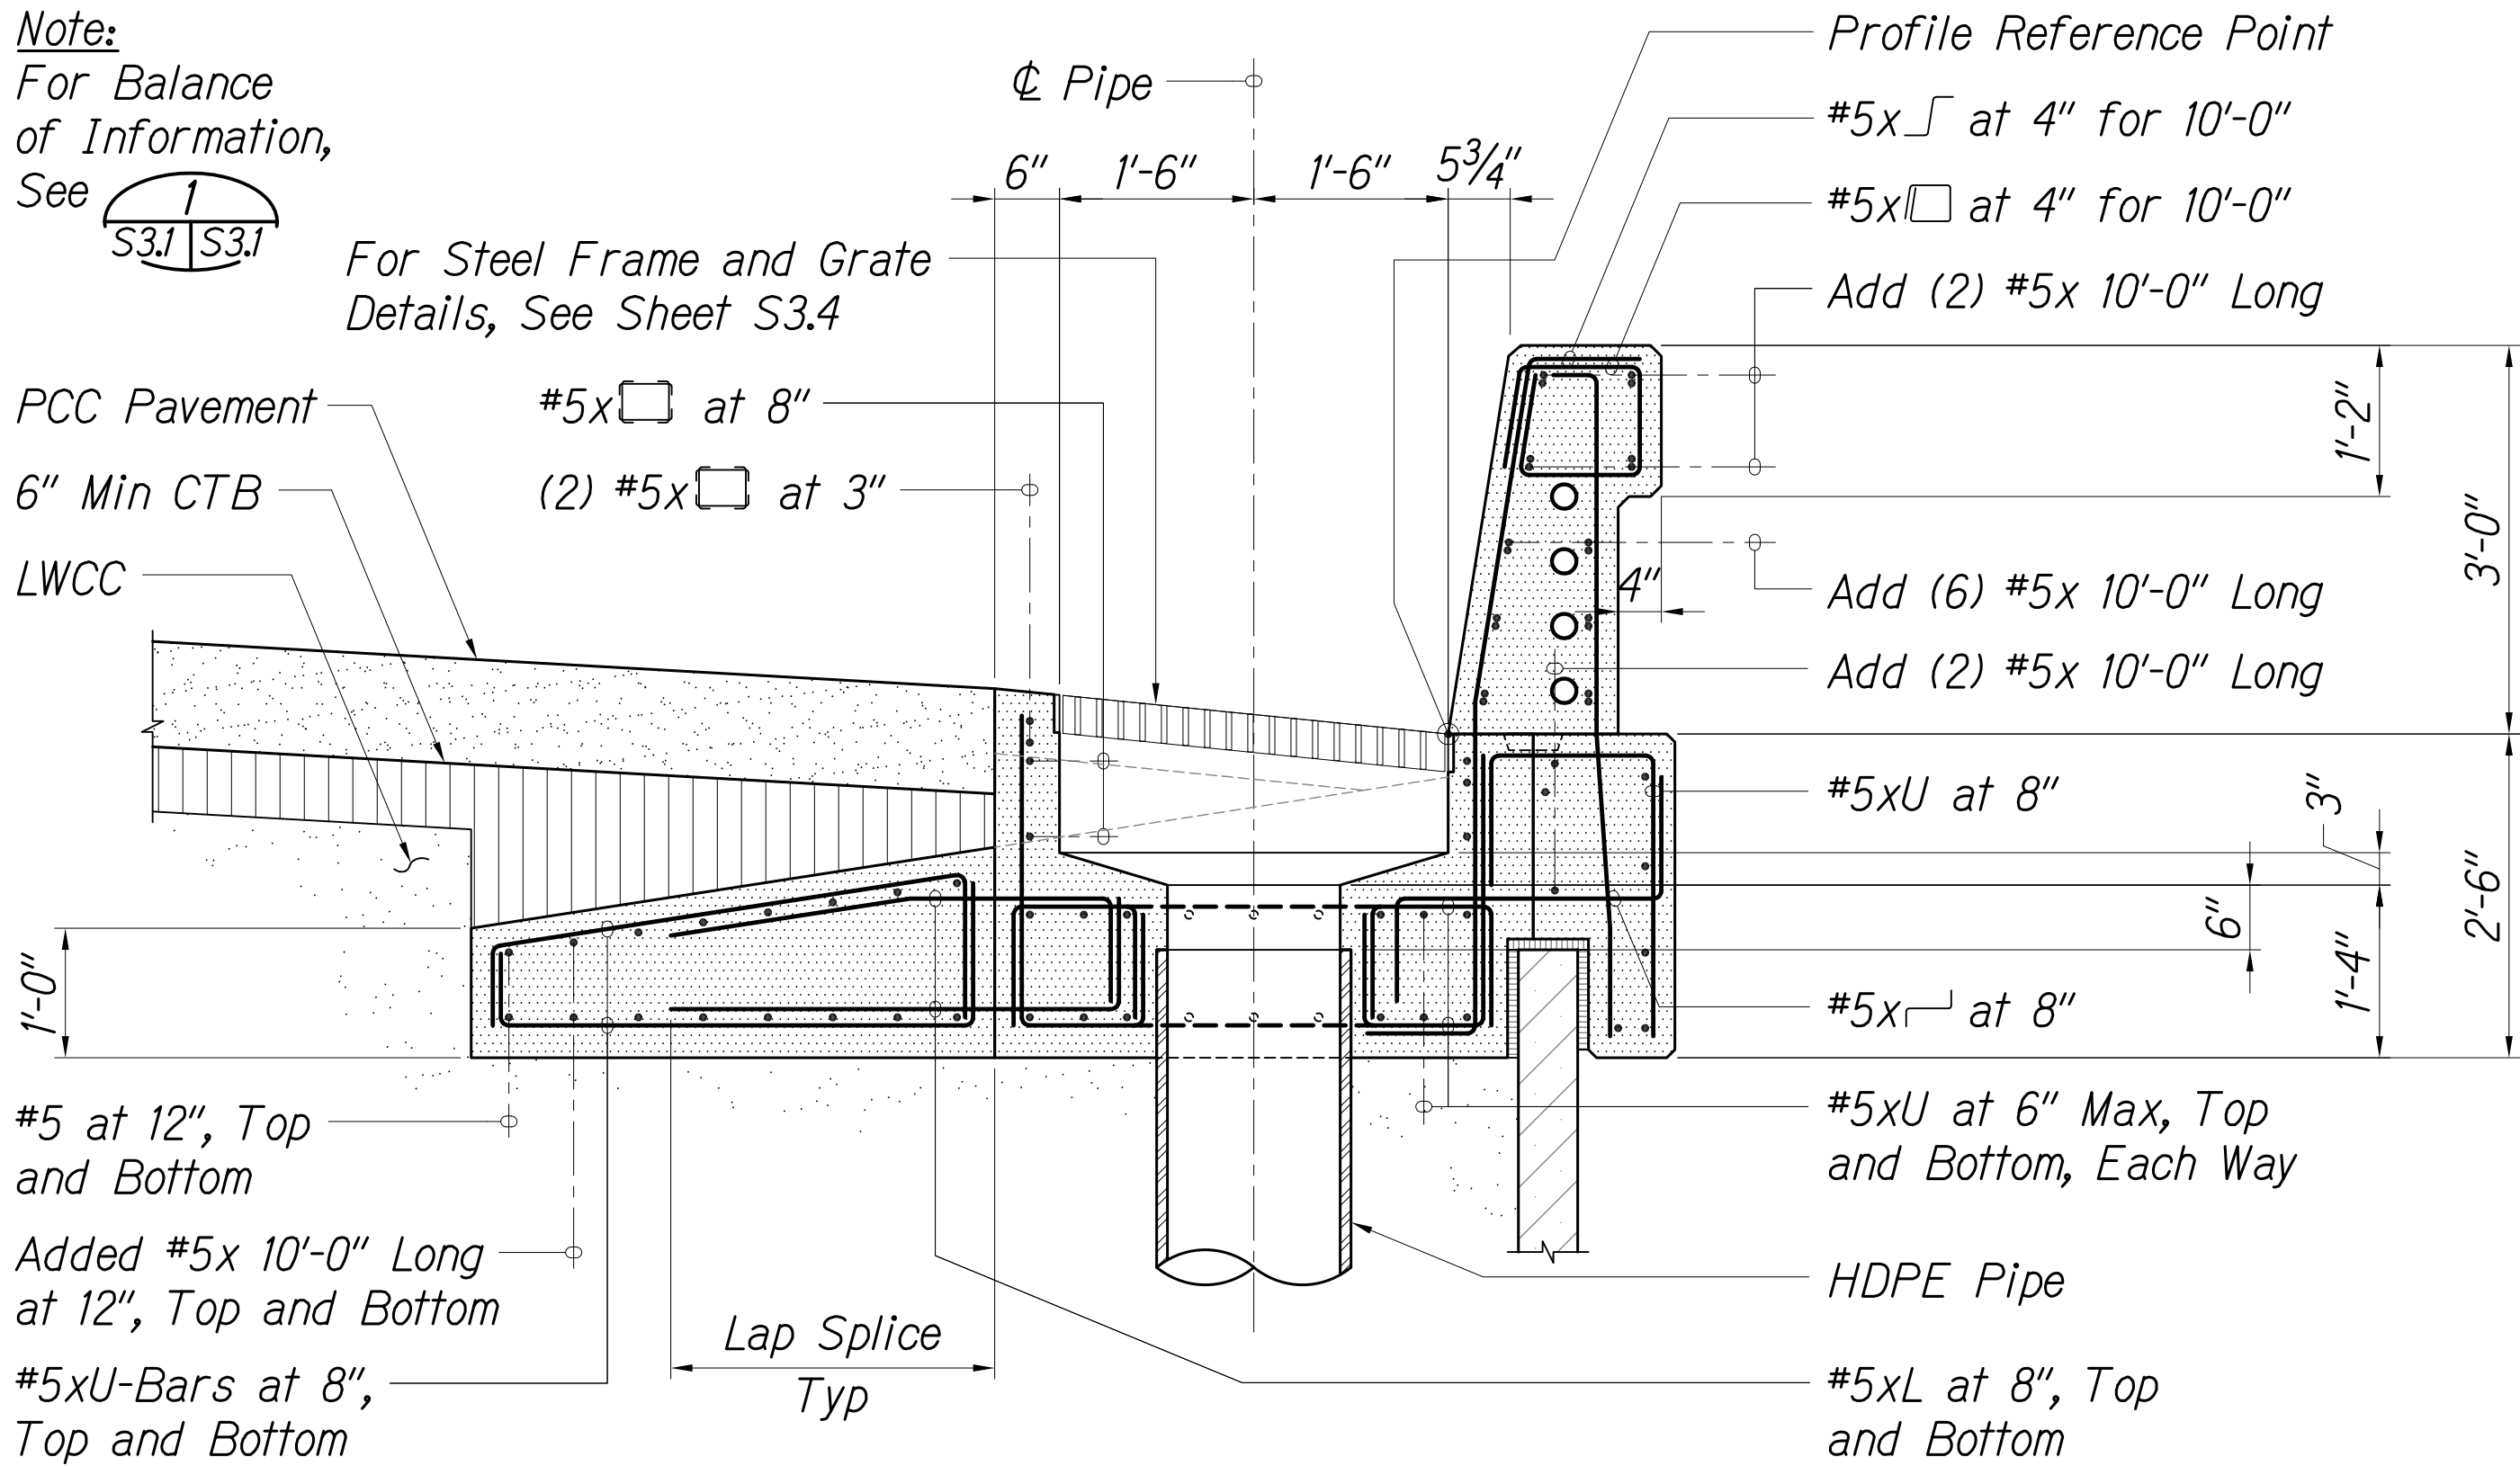

RETAINING WALL NOS. 2 & 3 CROSS SECTION AT GDI
Scale: 3/4" = 1'-0"


1
S3.2 | S3.2

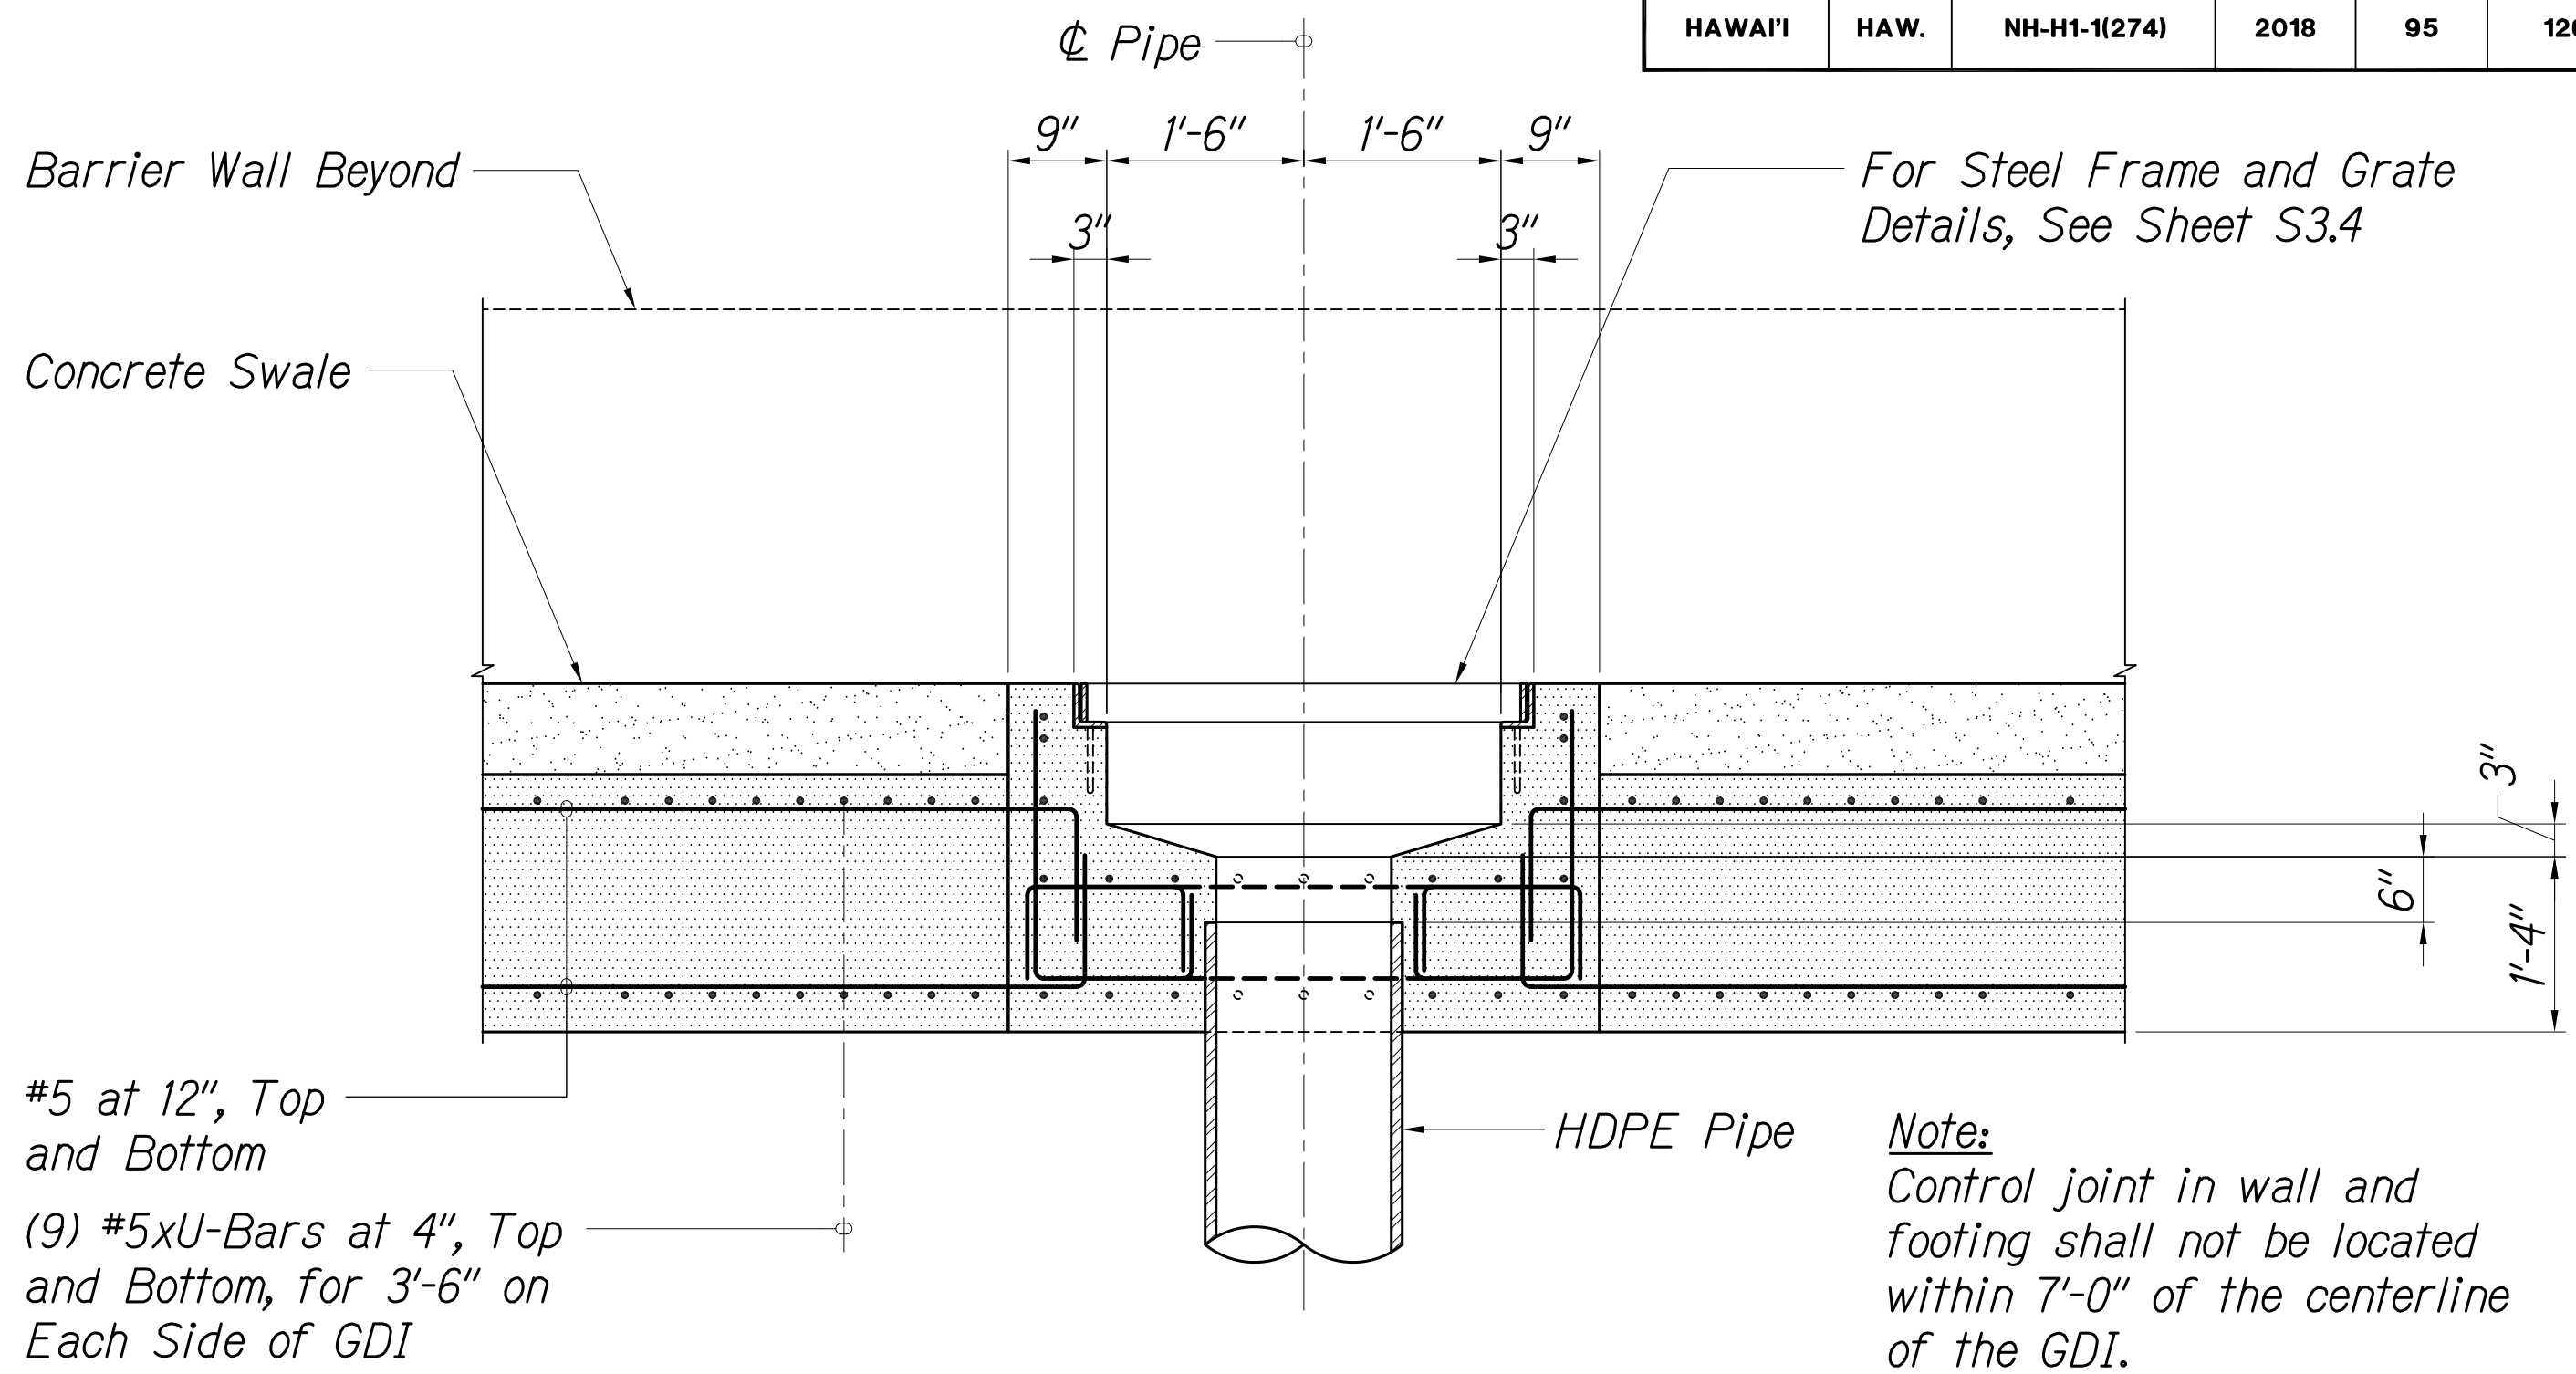

RETAINING WALL NOS. 2 & 3 LONGITUDINAL SECTION AT GDI
Scale: 3/4" = 1'-0"


2
S3.2 | S3.2

Note:
For Balance
of Information,
See 1
S3.1 | S3.1

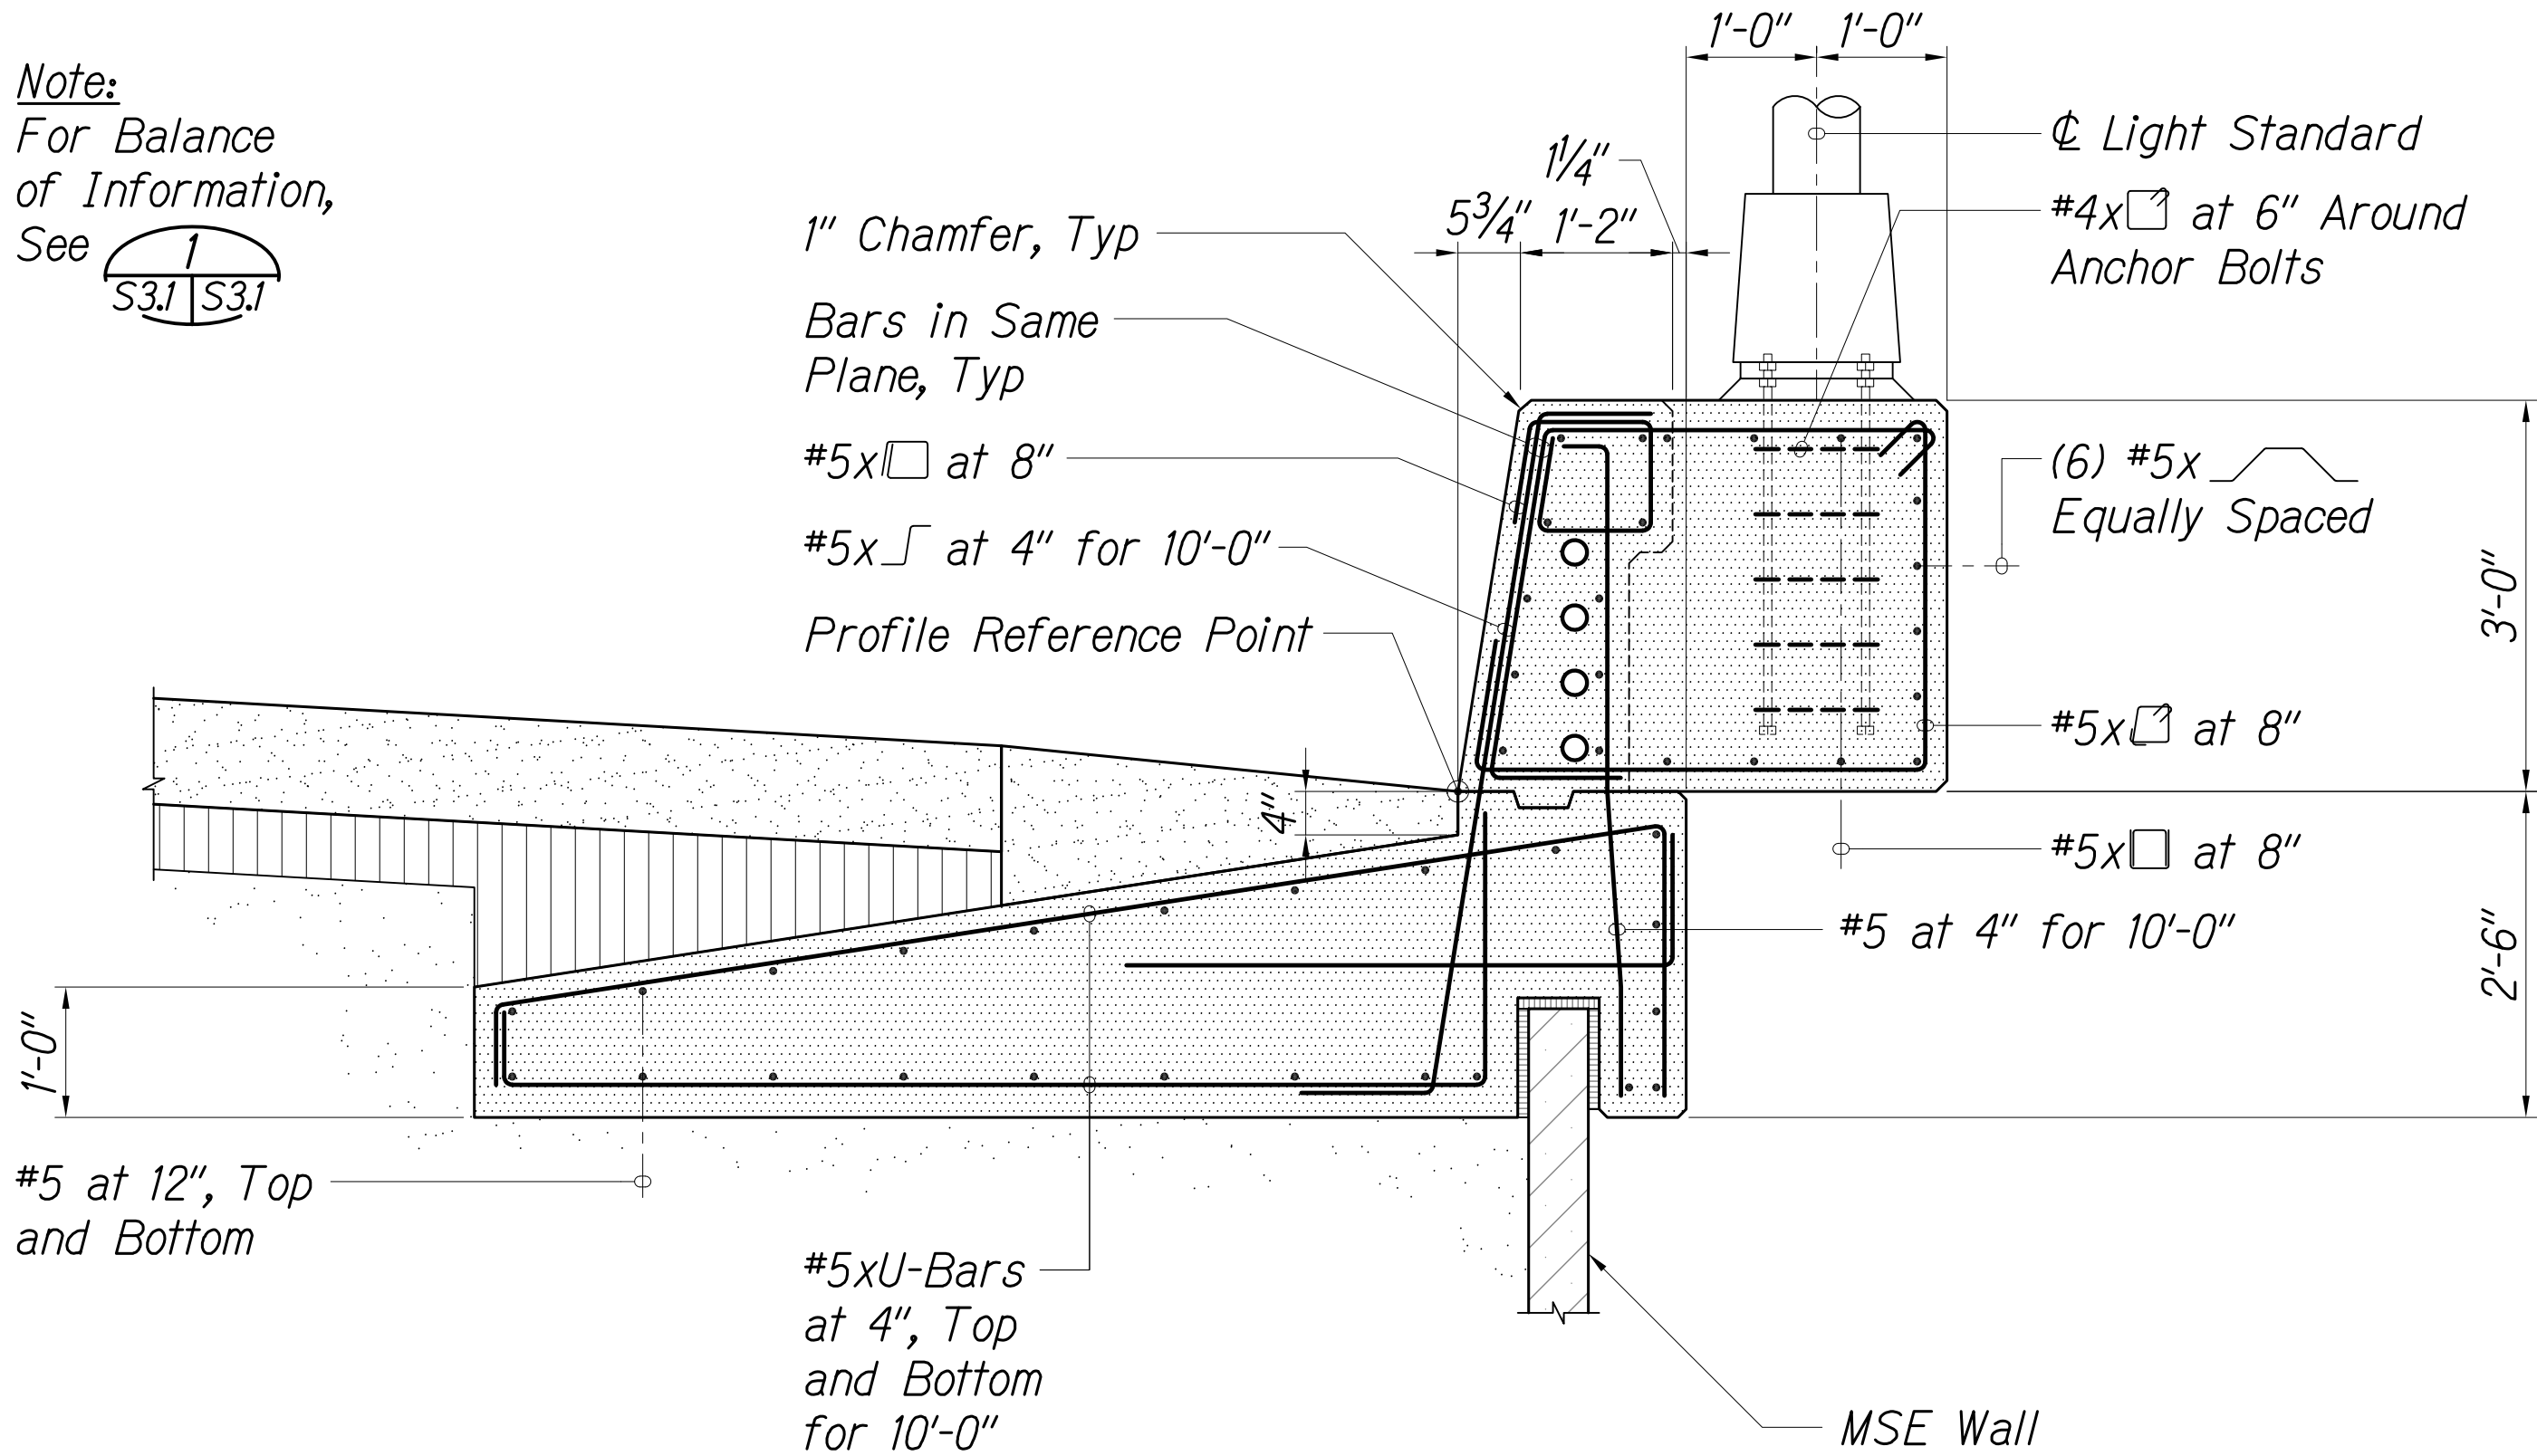


RETAINING WALL NOS. 2 & 3 SECTION AT LIGHT STANDARD
Scale: 3/4" = 1'-0"

3
S3.2 | S3.2

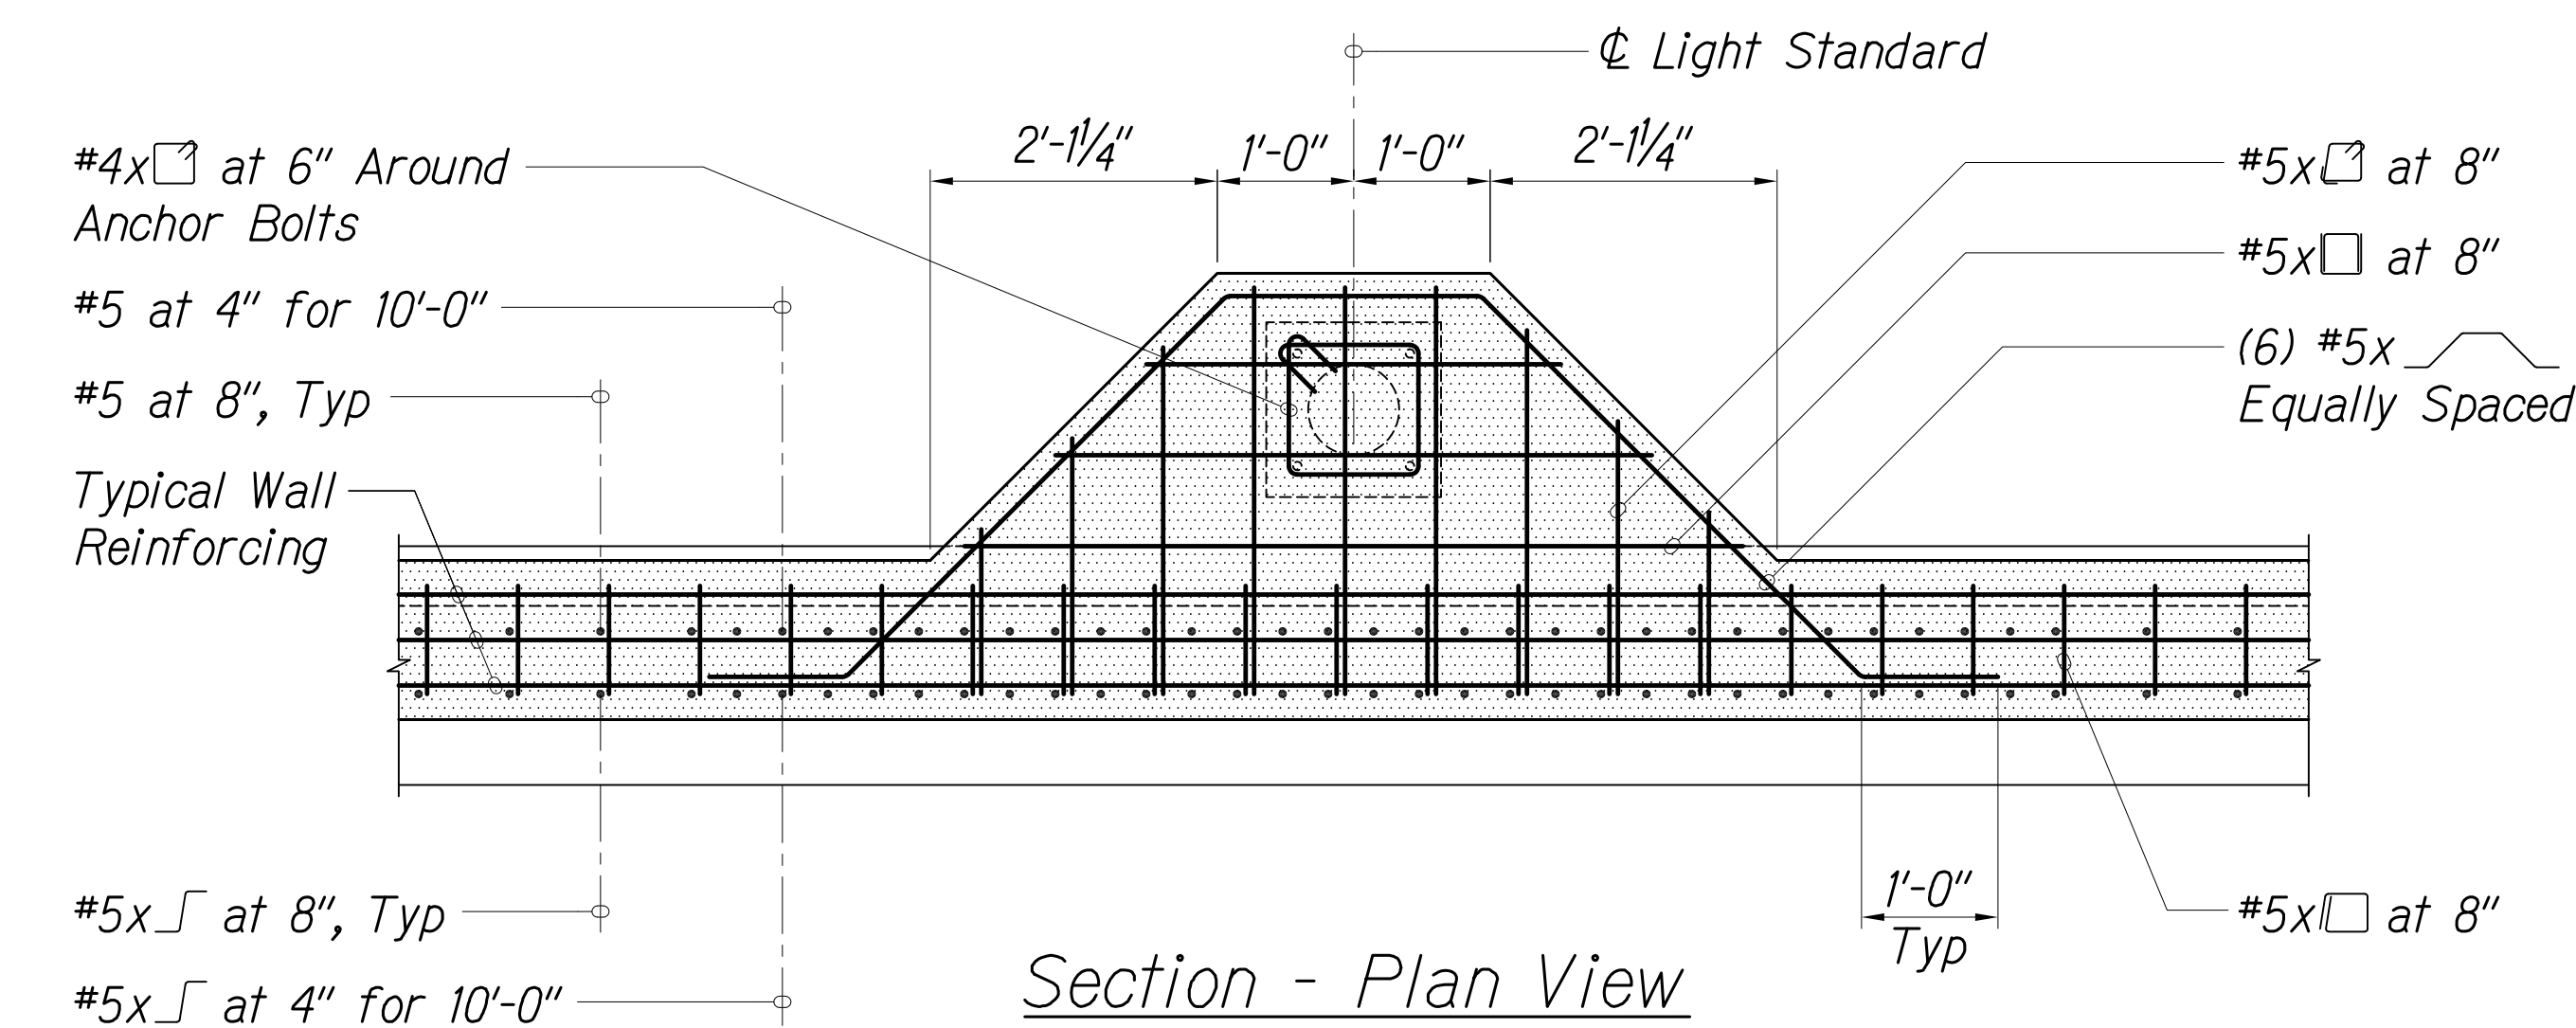

Note:
Control joint in wall and footing
shall not be located within 7'-0" of
the centerline of the light standard.

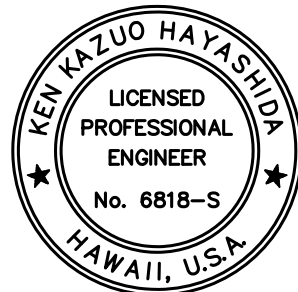

THIS WORK WAS PREPARED BY ME
OR UNDER MY SUPERVISION.

SIGNATURE: *[Signature]* April 30, 2020
EXPIRATION DATE
OF THE LICENSE

THESE PLANS HAVE BEEN
PREPARED UTILIZING
INFORMATION PROVIDED BY
THE PROJECT CONTRACTOR.
THE UPDATED CONSTRUCTION
INFORMATION DEPICTED
HEREIN HAS NOT BEEN
VERIFIED FOR ACCURACY
AND COMPLETENESS. NO
REPRESENTATION IS BEING
MADE TO ITS VALIDITY.

STATE OF HAWAII
DEPARTMENT OF TRANSPORTATION
HIGHWAYS DIVISION
RETAINING WALL NOS. 2 & 3
DETAILS - 2


INTERSTATE ROUTE H-1
SHOULDER WORK AND PORTLAND CEMENT
CONCRETE PAVEMENT REHABILITATION
VICINITY OF WAIMALU TO VICINITY OF HALAWA
PHASE 2 - SHOULDER WORK


Scale: As Shown Date: November 30, 2018

SHEET No. S3.2 OF 4 SHEETS

"AS-BUILT"

FED. ROAD DIST. NO.	STATE	FED. AID PROJ. NO.	FISCAL YEAR	SHEET NO.	TOTAL SHEETS
HAWAII	HAW.	NH-H1-1(274)	2018	96	126



Note:
For Balance
of Information,
See 

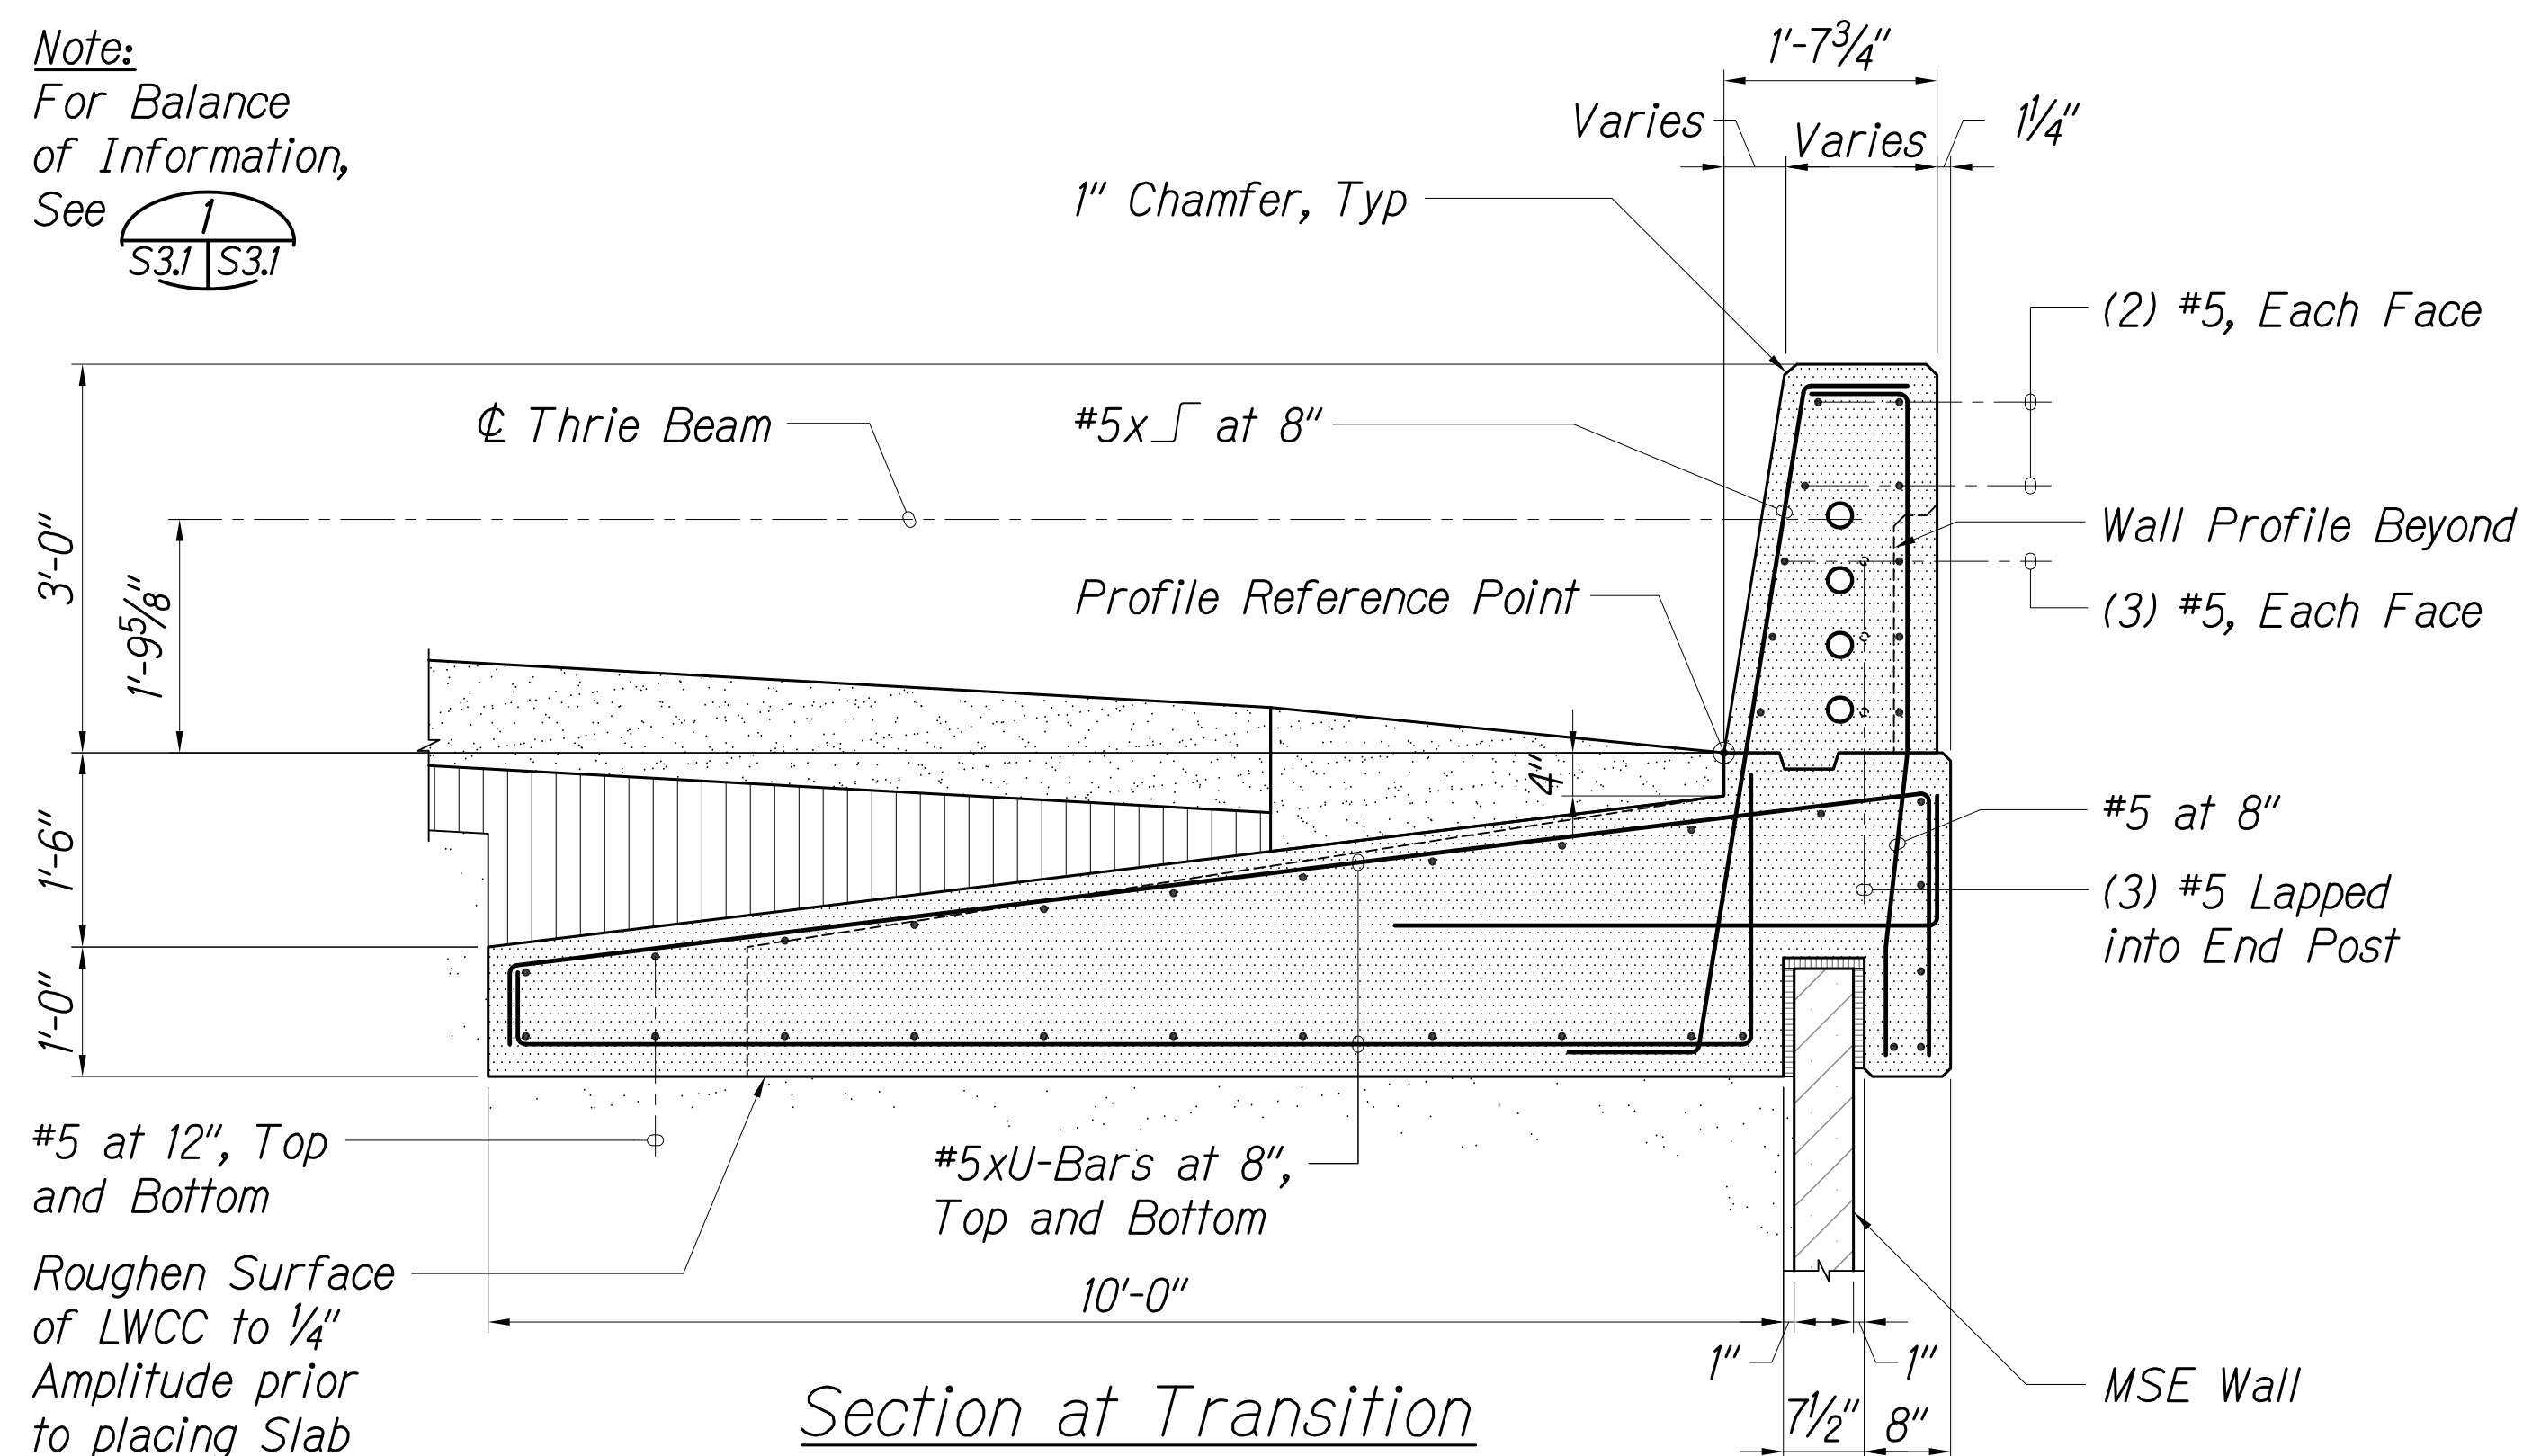


Section at Transition

RETAINING WALL NOS. 2 & 3 SECTIONS AT END POST


Scale: $3/4'' = 1'-0''$

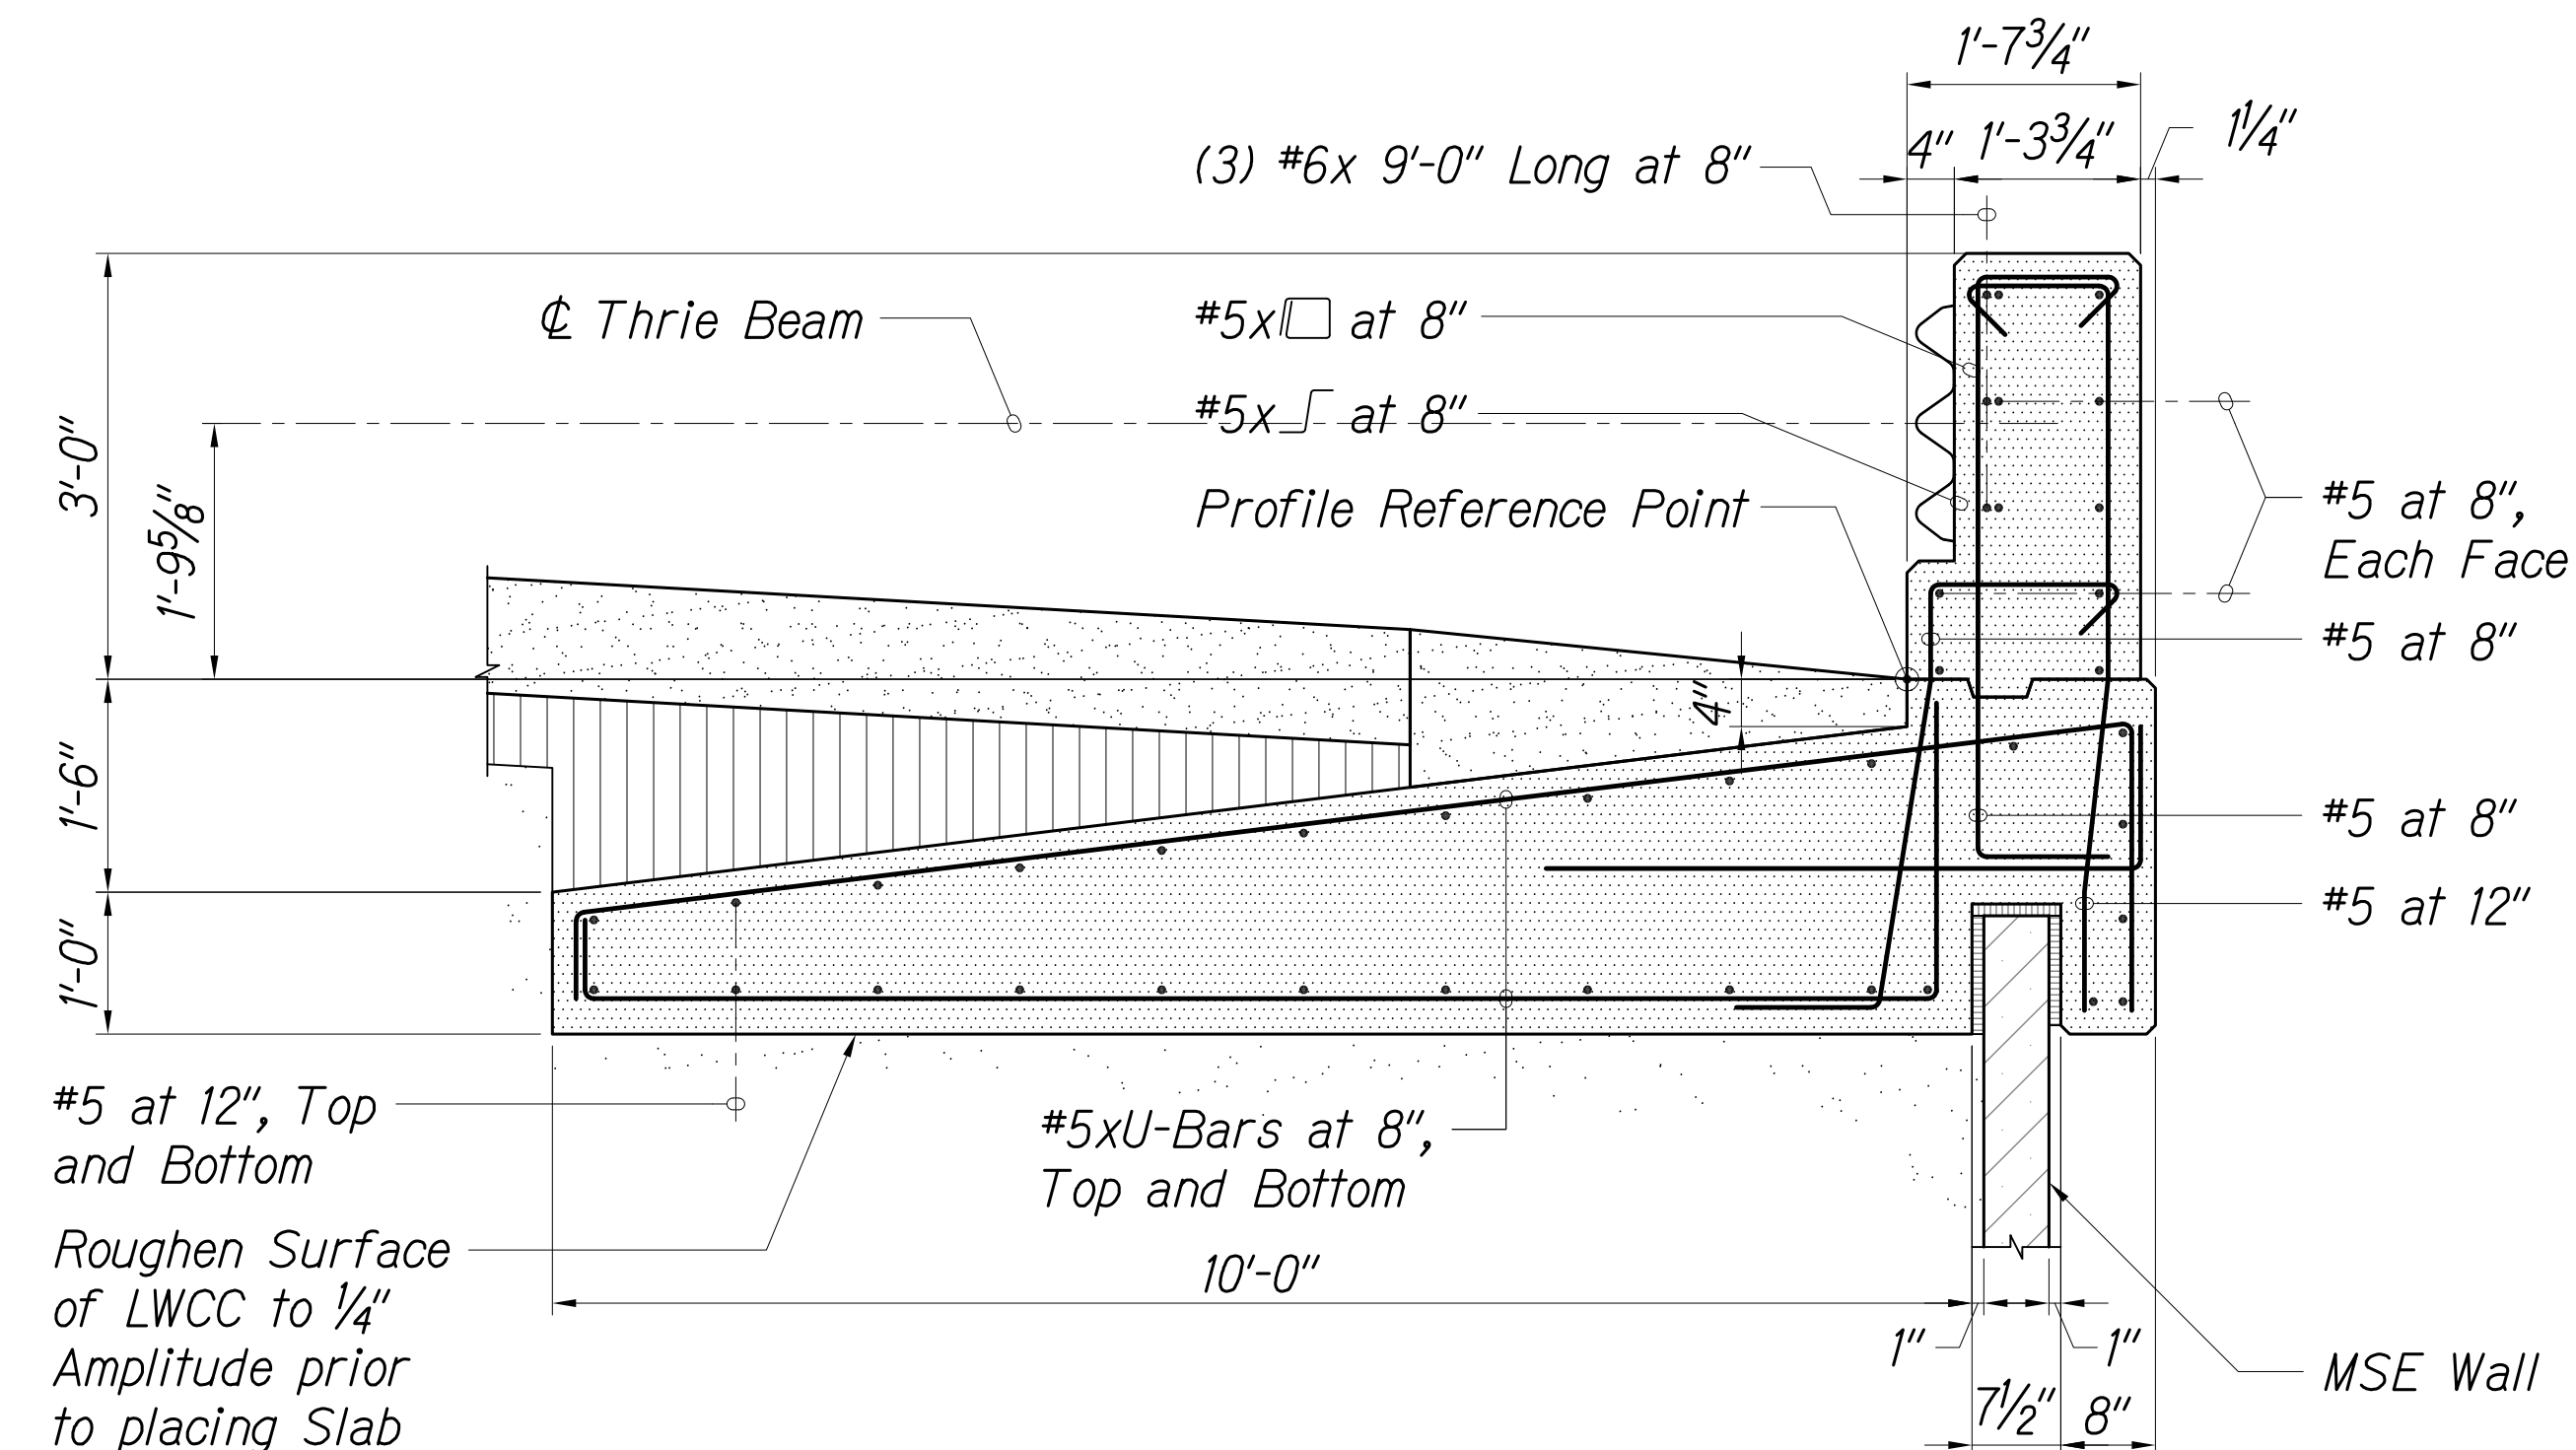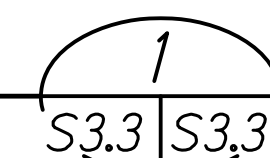


Section at Terminal Connection

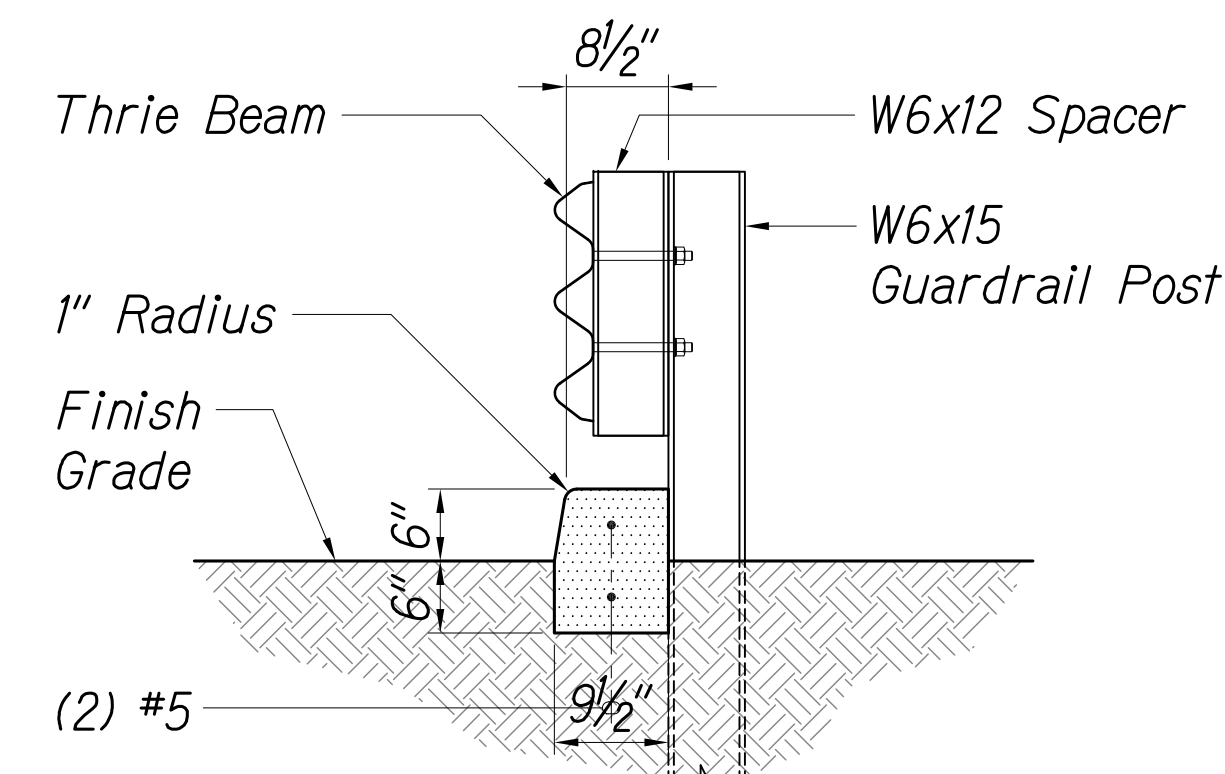


Section at Guardrail Post

Note:
For Balance
of Information,
See 

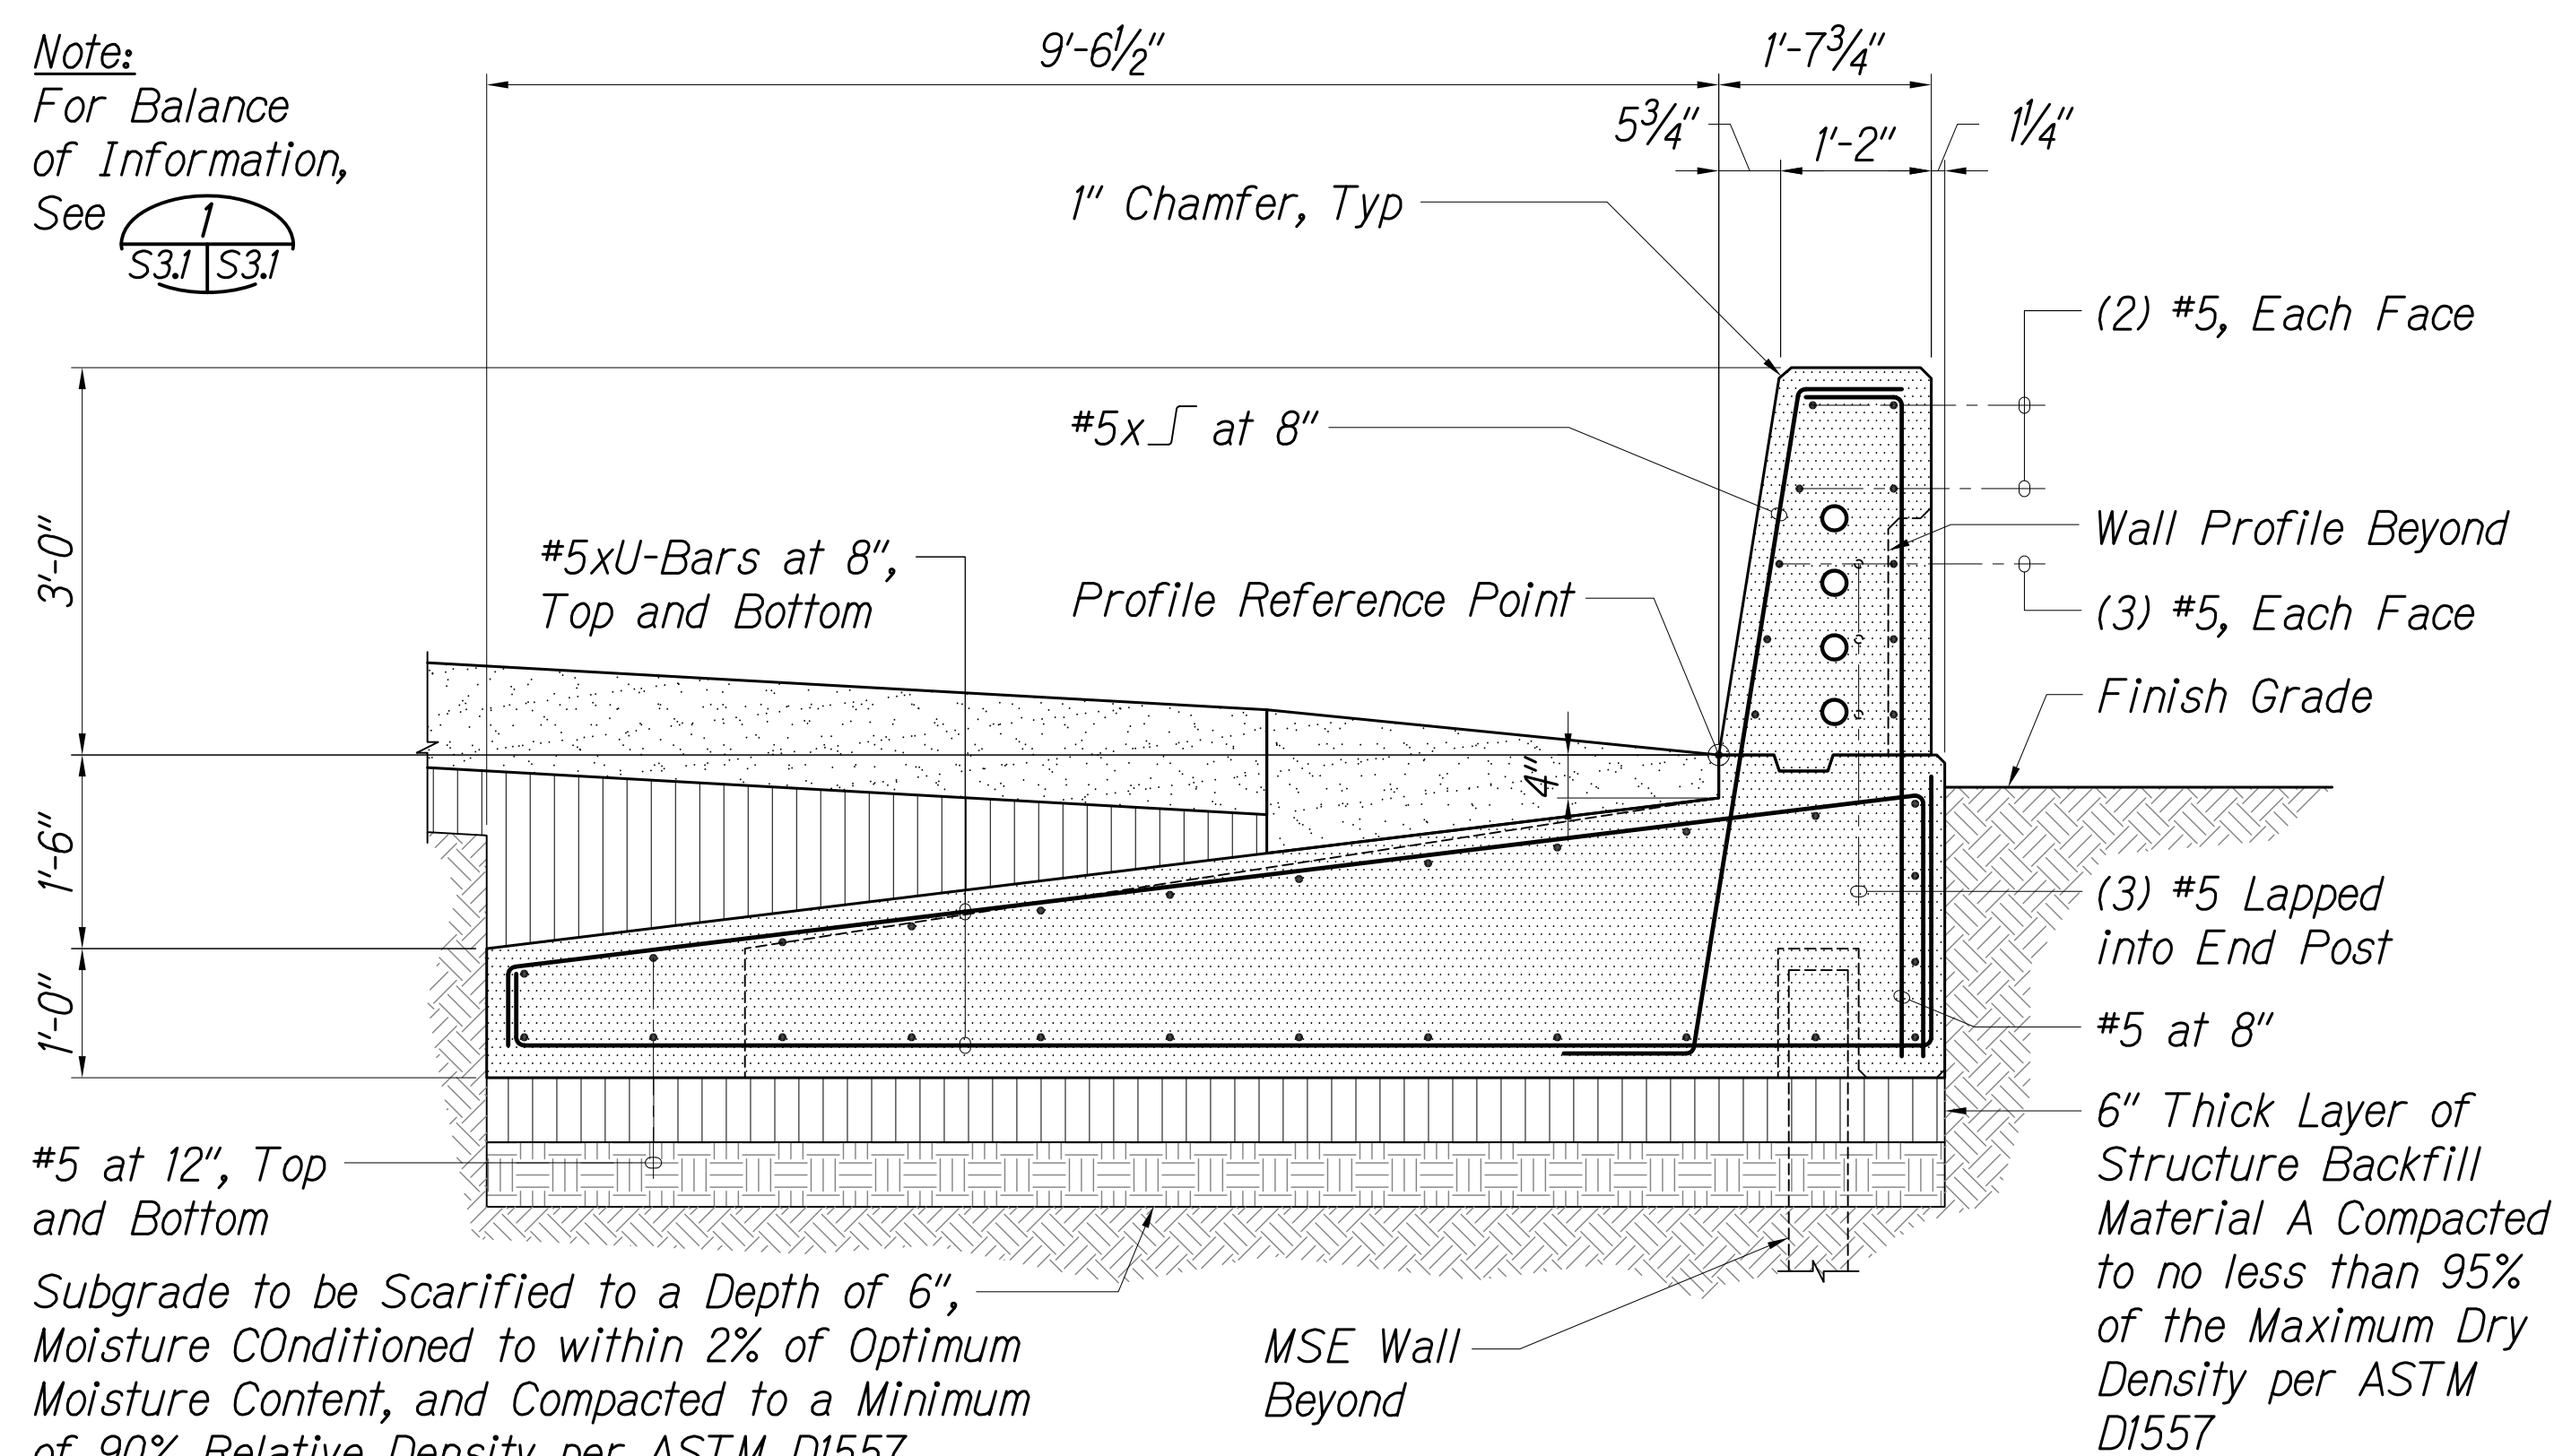


RETAINING WALL NOS. 2 & 3 SECTIONS AT TRAILING END

Scale: $3/4" = 1'-0"$

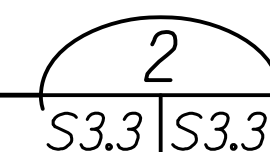

THESE PLANS HAVE BEEN PREPARED UTILIZING INFORMATION PROVIDED BY THE PROJECT CONTRACTOR. THE UPDATED CONSTRUCTION INFORMATION DEPICTED HEREIN HAS NOT BEEN VERIFIED FOR ACCURACY AND COMPLETENESS. NO REPRESENTATION IS BEING MADE TO ITS VALIDITY.

THIS WORK WAS PREPARED BY ME
OR UNDER MY SUPERVISION.



April 30, 2020
SIGNATURE EXPIRATION DATE
OF THE LICENSE

STATE OF HAWAII
DEPARTMENT OF TRANSPORTATION
HIGHWAYS DIVISION
RETAINING WALL NOS. 2 & 3
DETAILS - 3

INTERSTATE ROUTE H-1
SHOULDER WORK AND PORTLAND CEMENT
CONCRETE PAVEMENT REHABILITATION
VICINITY OF WAIMALU TO VICINITY OF HALAWA
PHASE 2 – SHOULDER WORK

Scale: As Shown Date: November 30, 2018

SHEET No. S3.3 OF 4 SHEETS

"AS-BUILT"


96

\\4451-1500\4458 HDOT - Kiewit Design build of H1 Widening\004 Drawings\Structural\AutoCAD_format\Phase 2\2020-02-06 - As-Built\4458_S3-1-S3-4.dwg 2/6/2020 11:21 AM BRYAN LUM

ORIGINAL PLAN	SURVEY PLOTTED BY _____	DATE _____
	DRAWN BY _____	" _____
NOTE BOOK	TRACED BY _____	" _____
	DESIGNED BY _____	" _____
	QUANTITIES BY _____	" _____
	CHECKED BY _____	" _____
No. _____		

44451-4510/4458 HDOOT - View: Design build of HI Widening/004 Drawings/Structural/AuscCAD_format/Phase 2/2020 02-06 - As-Built/4458_S3-1_S3-4.dwg, 2/6/2020 11:21:58 AM, NaJ Adobe PDF.pc3



FED. ROAD DIST. NO.	STATE	FED. AID PROJ. NO.	FISCAL YEAR	SHEET NO.	TOTAL SHEETS
HAWAII	HAW.	NH-H1-1(274)	2018	97	126

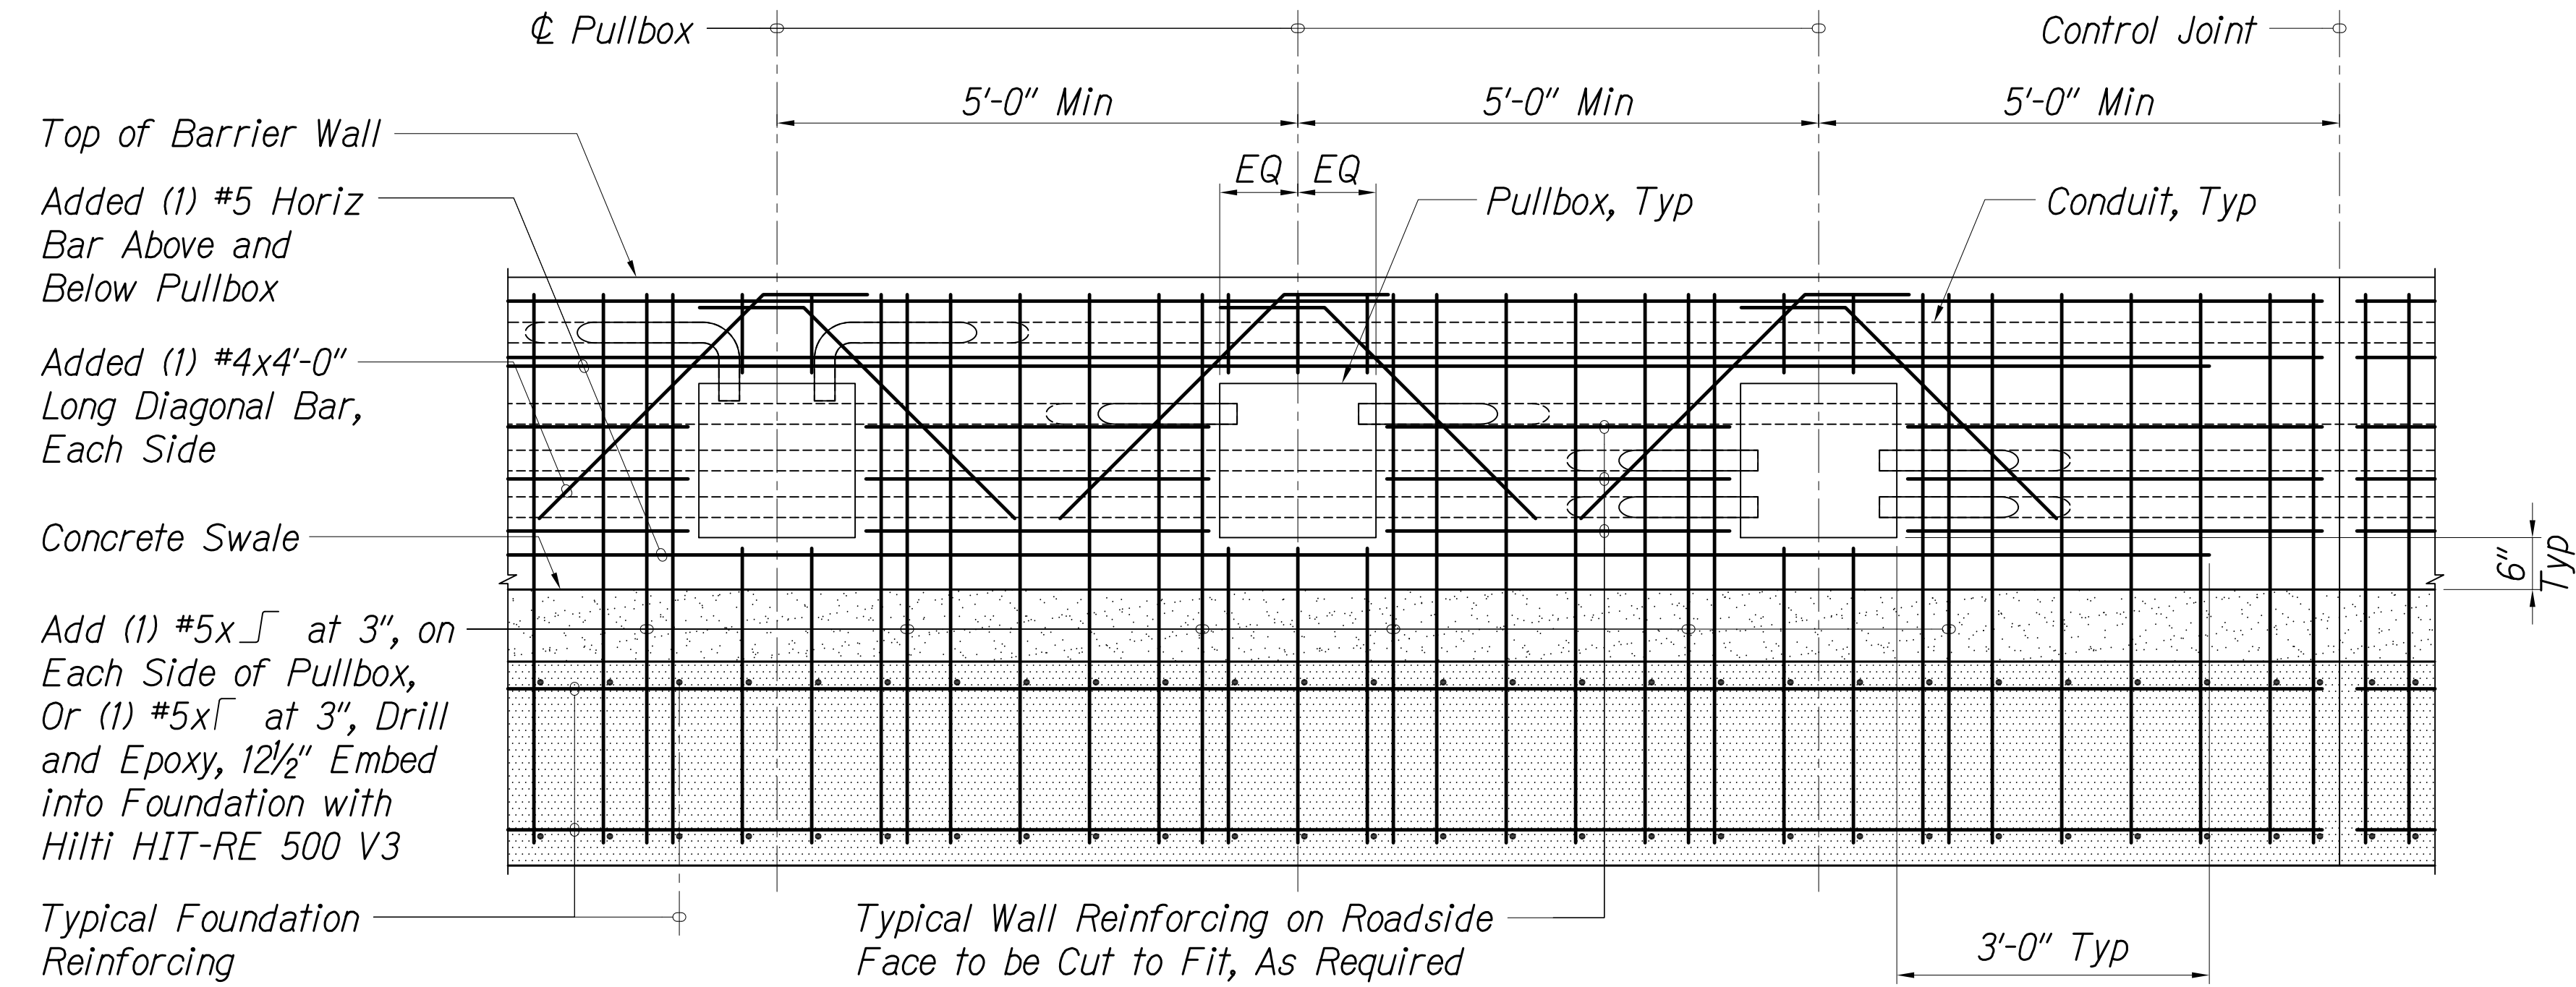

Roadside Elevation



RETAINING WALL NOS. 2 & 3 ELEVATION AT PULLBOXES

Scale: 3/4" = 1'-0"

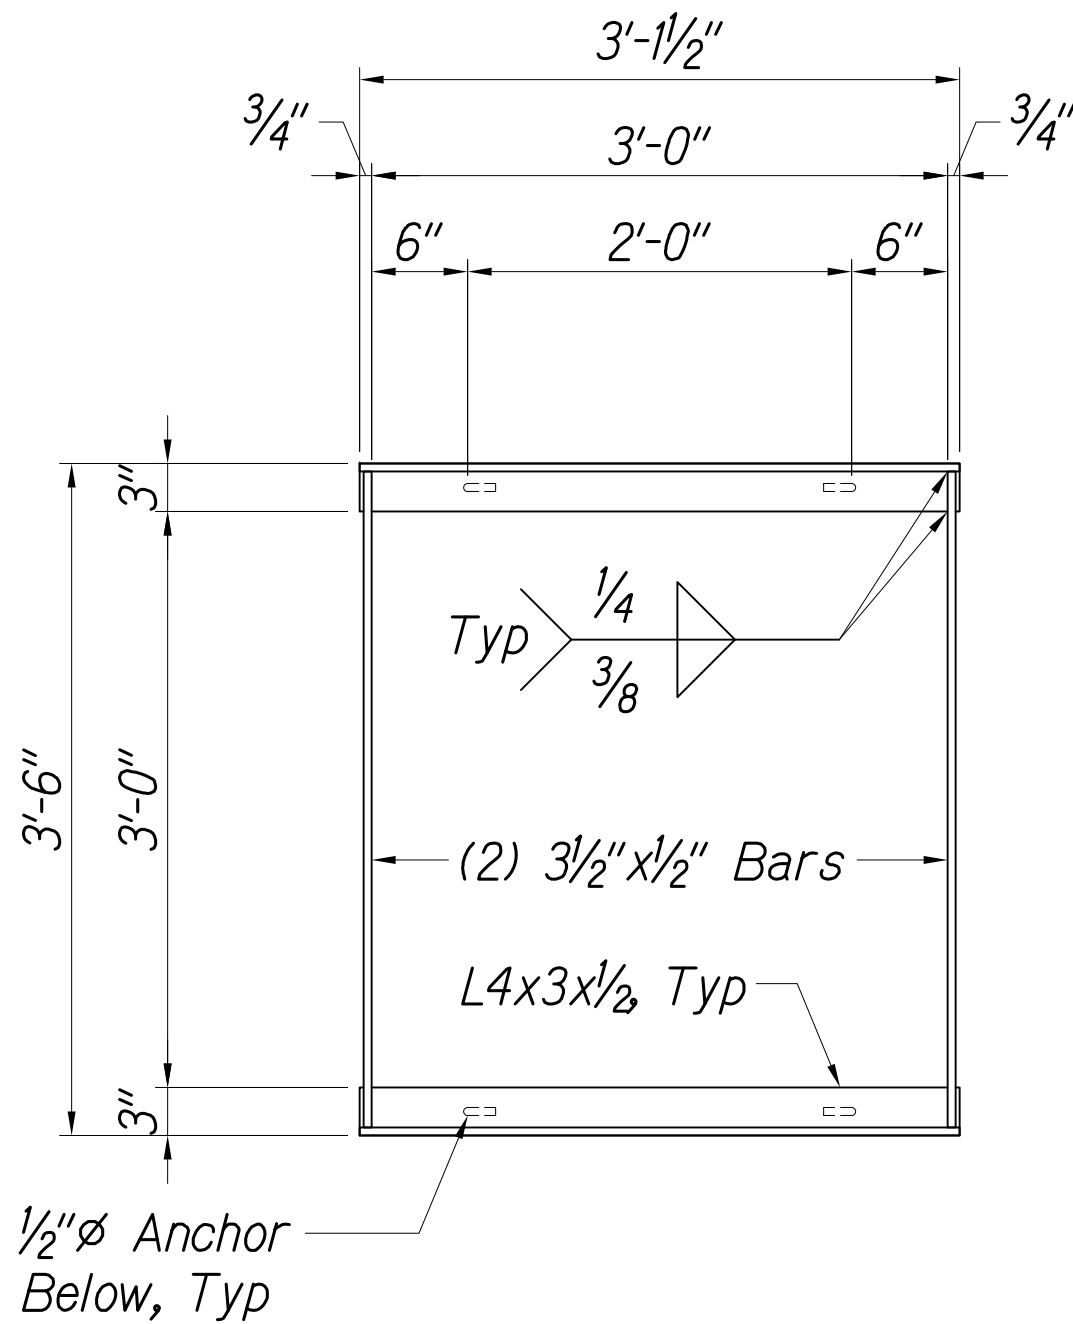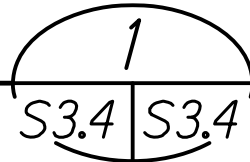


STEEL FRAME DETAIL

Scale: 1" = 1'-0"

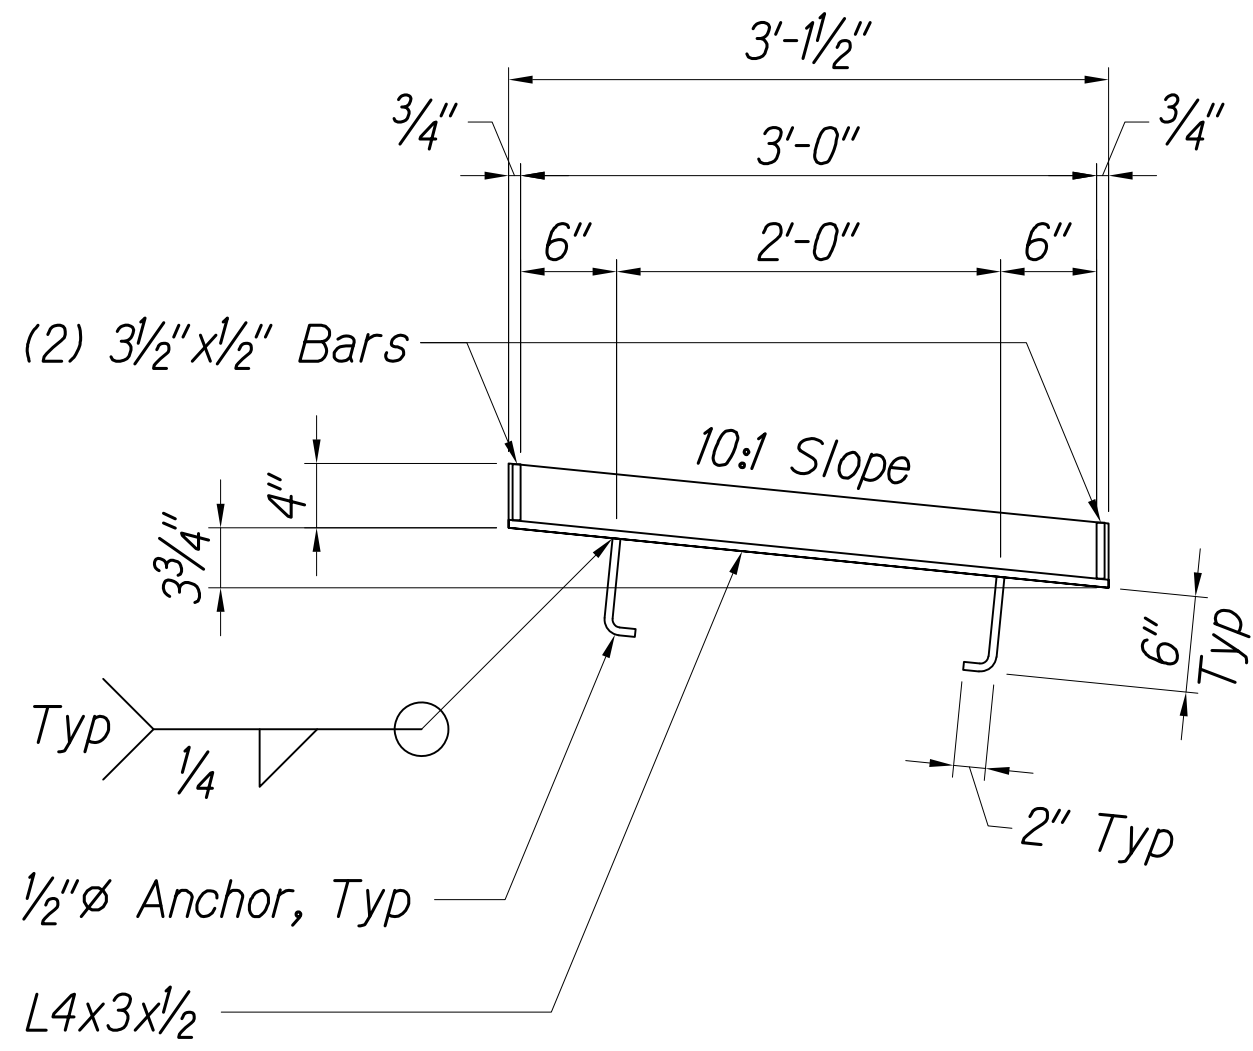
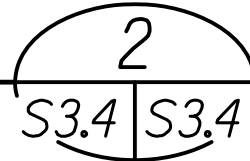


Section

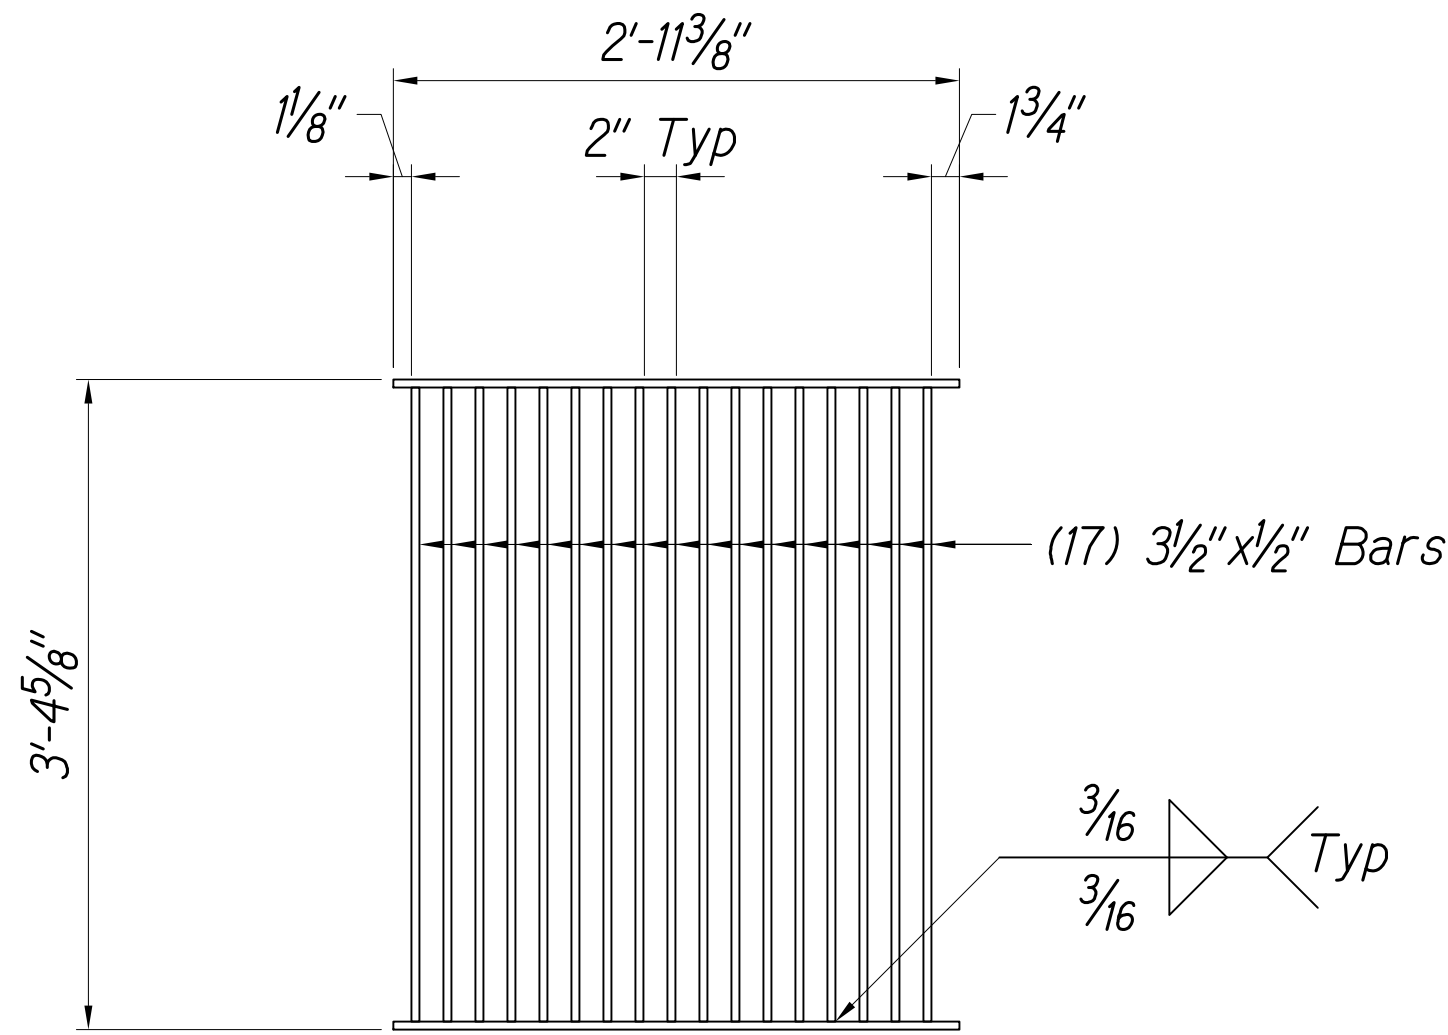


STEEL GRATE DETAIL

Scale: 1" = 1'-0"

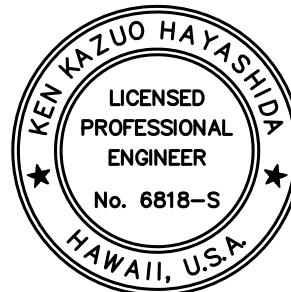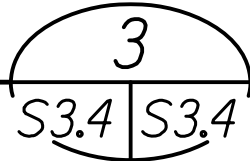

THIS WORK WAS PREPARED BY ME OR UNDER MY SUPERVISION.

SIGNATURE: [Signature] April 30, 2020 EXPIRATION DATE OF THE LICENSE

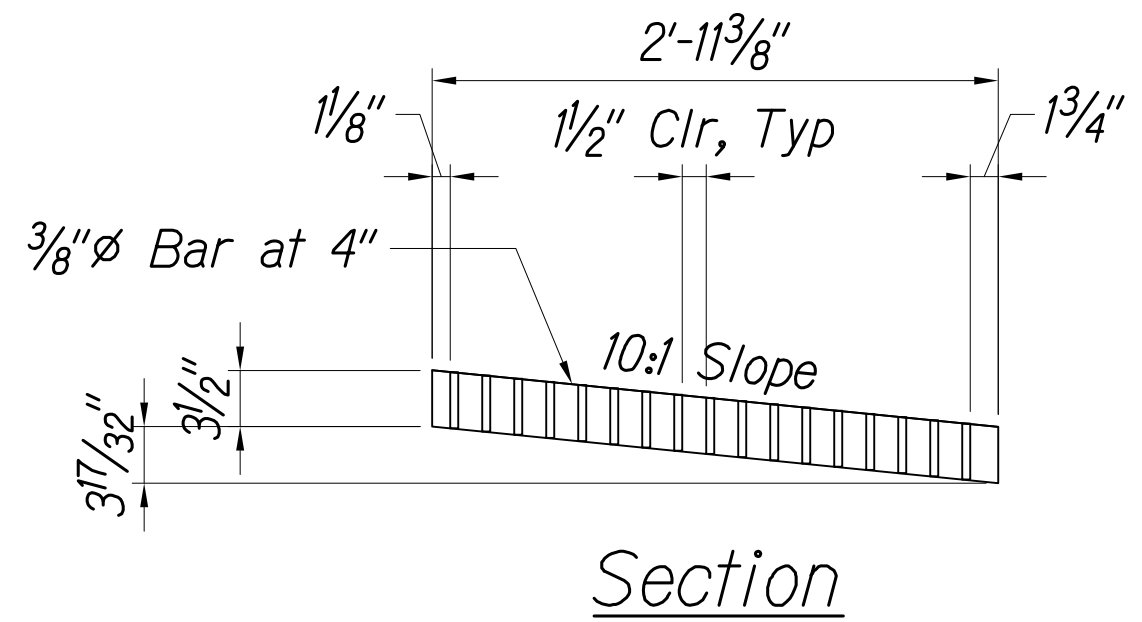

Section

THESE PLANS HAVE BEEN PREPARED UTILIZING INFORMATION PROVIDED BY THE PROJECT CONTRACTOR. THE UPDATED CONSTRUCTION INFORMATION DEPICTED HEREIN HAS NOT BEEN VERIFIED FOR ACCURACY AND COMPLETENESS. NO REPRESENTATION IS BEING MADE TO ITS VALIDITY.

STATE OF HAWAII
DEPARTMENT OF TRANSPORTATION
HIGHWAYS DIVISION
RETAINING WALL NOS. 2 & 3
DETAILS - 4
INTERSTATE ROUTE H-1
SHOULDER WORK AND PORTLAND CEMENT
CONCRETE PAVEMENT REHABILITATION
VICINITY OF WAIMALU TO VICINITY OF HALAWA
PHASE 2 - SHOULDER WORK
Scale: As Shown Date: November 30, 2018
SHEET No. S3.4 OF 4 SHEETS

** Dimension shown is for Retaining Wall Nos. 1 & 4. Add 2" for Retaining Wall Nos. 2 & 3.*

Retaining Wall

End Post Length, "L"

Front Face of Concrete End Post at Top

Front Face of Concrete End Post at Swale

Control Joint

Control Joint with 30# Roofing Felt

Concrete Curb

25'-0" Guardrail Type 3 Thrie Beam

Metal Guardrail

Transition Length, "T"

2'-6" Term. Conn.

1'-0³/₄"

8"

7¹/₄"

1"-1³/₄" *

1"

1'-0"

1'-11"

8"

6"

9¹/₂"

10⁵/₈"

3'-8"

12'-1³/₄"

2'-6¹/₂"


1'-5³/₄" *

1'-0"



5³/₄"

FED. ROAD DIST. NO.	STATE	FED. AID PROJ. NO.	FISC. YEAR
HAWAII	HAW.	NH-H1-1(274)	20

Scale: $1/2'' = 1'-0''$

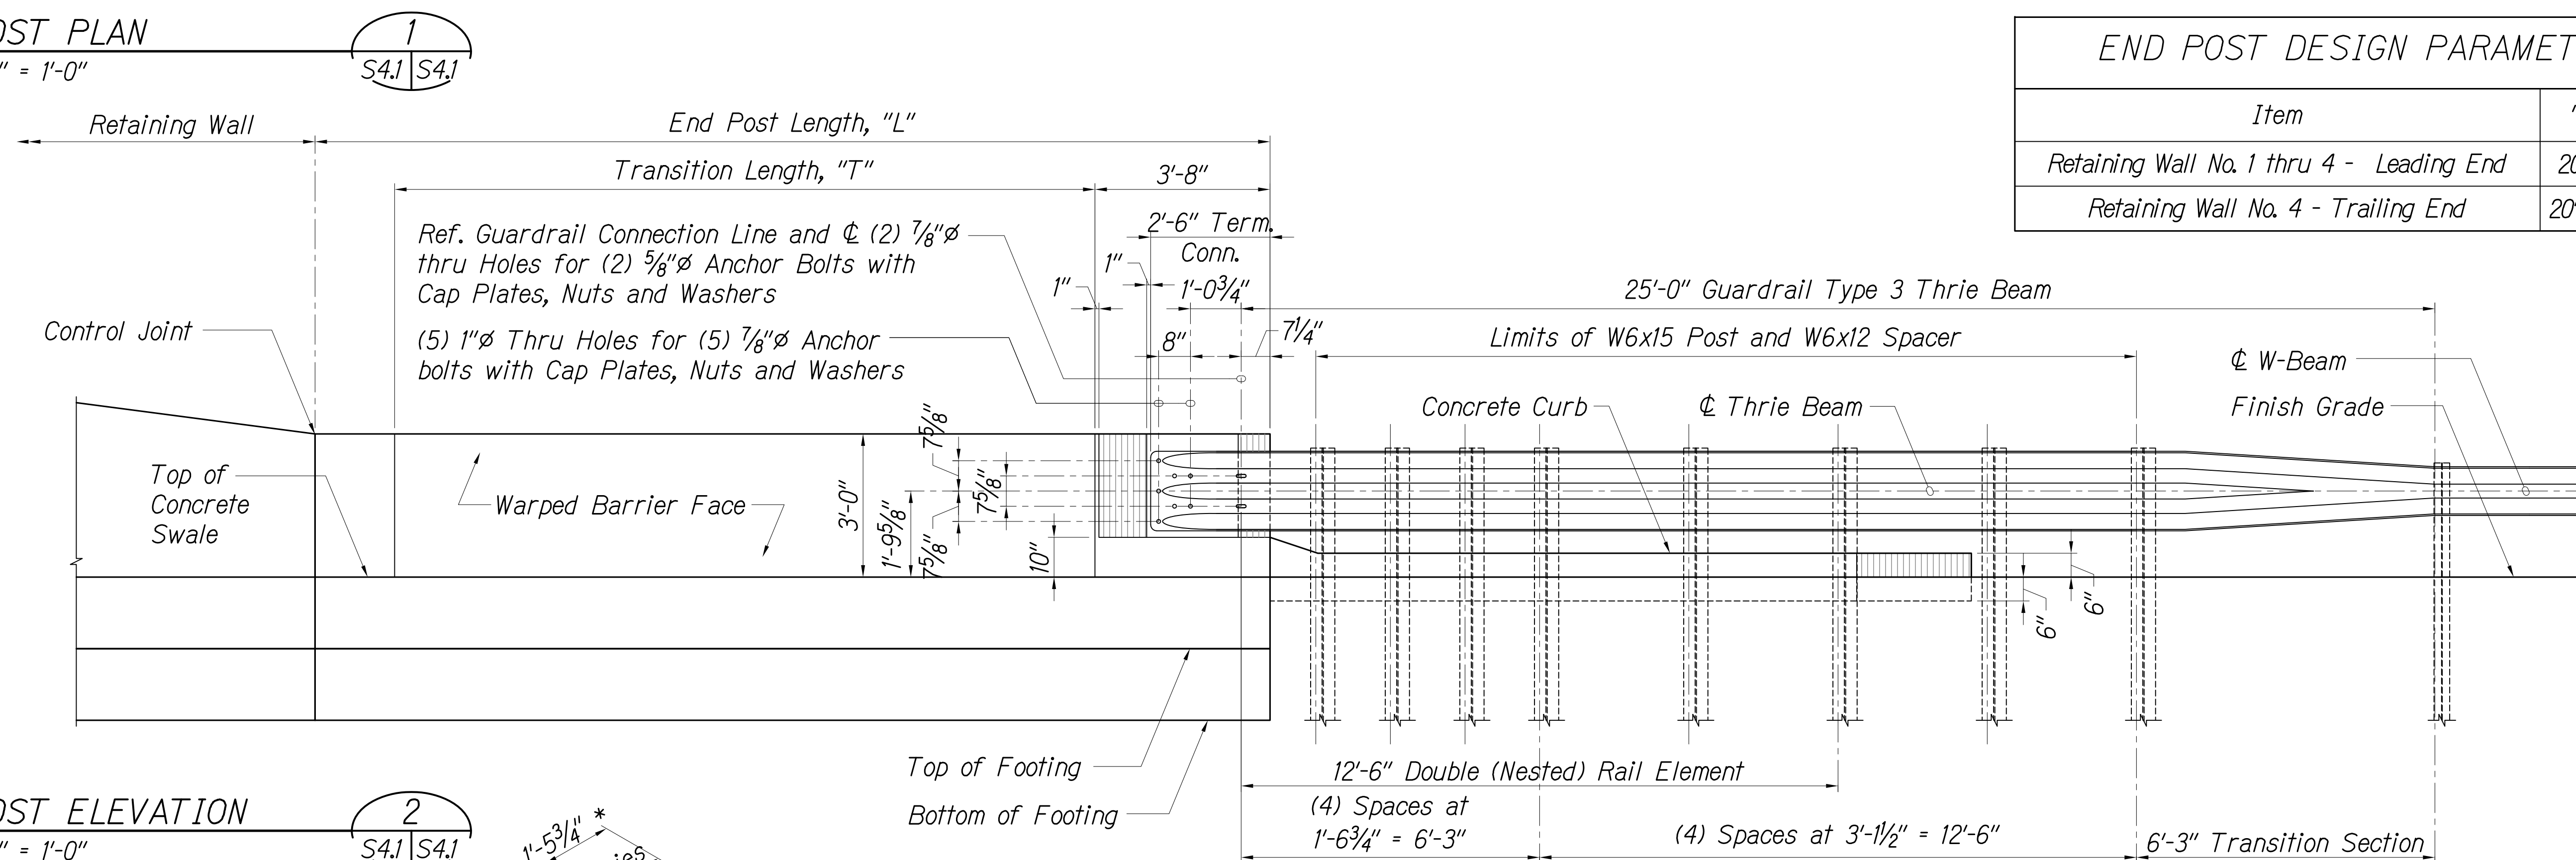


Scale: 1/2" = 1'-0"

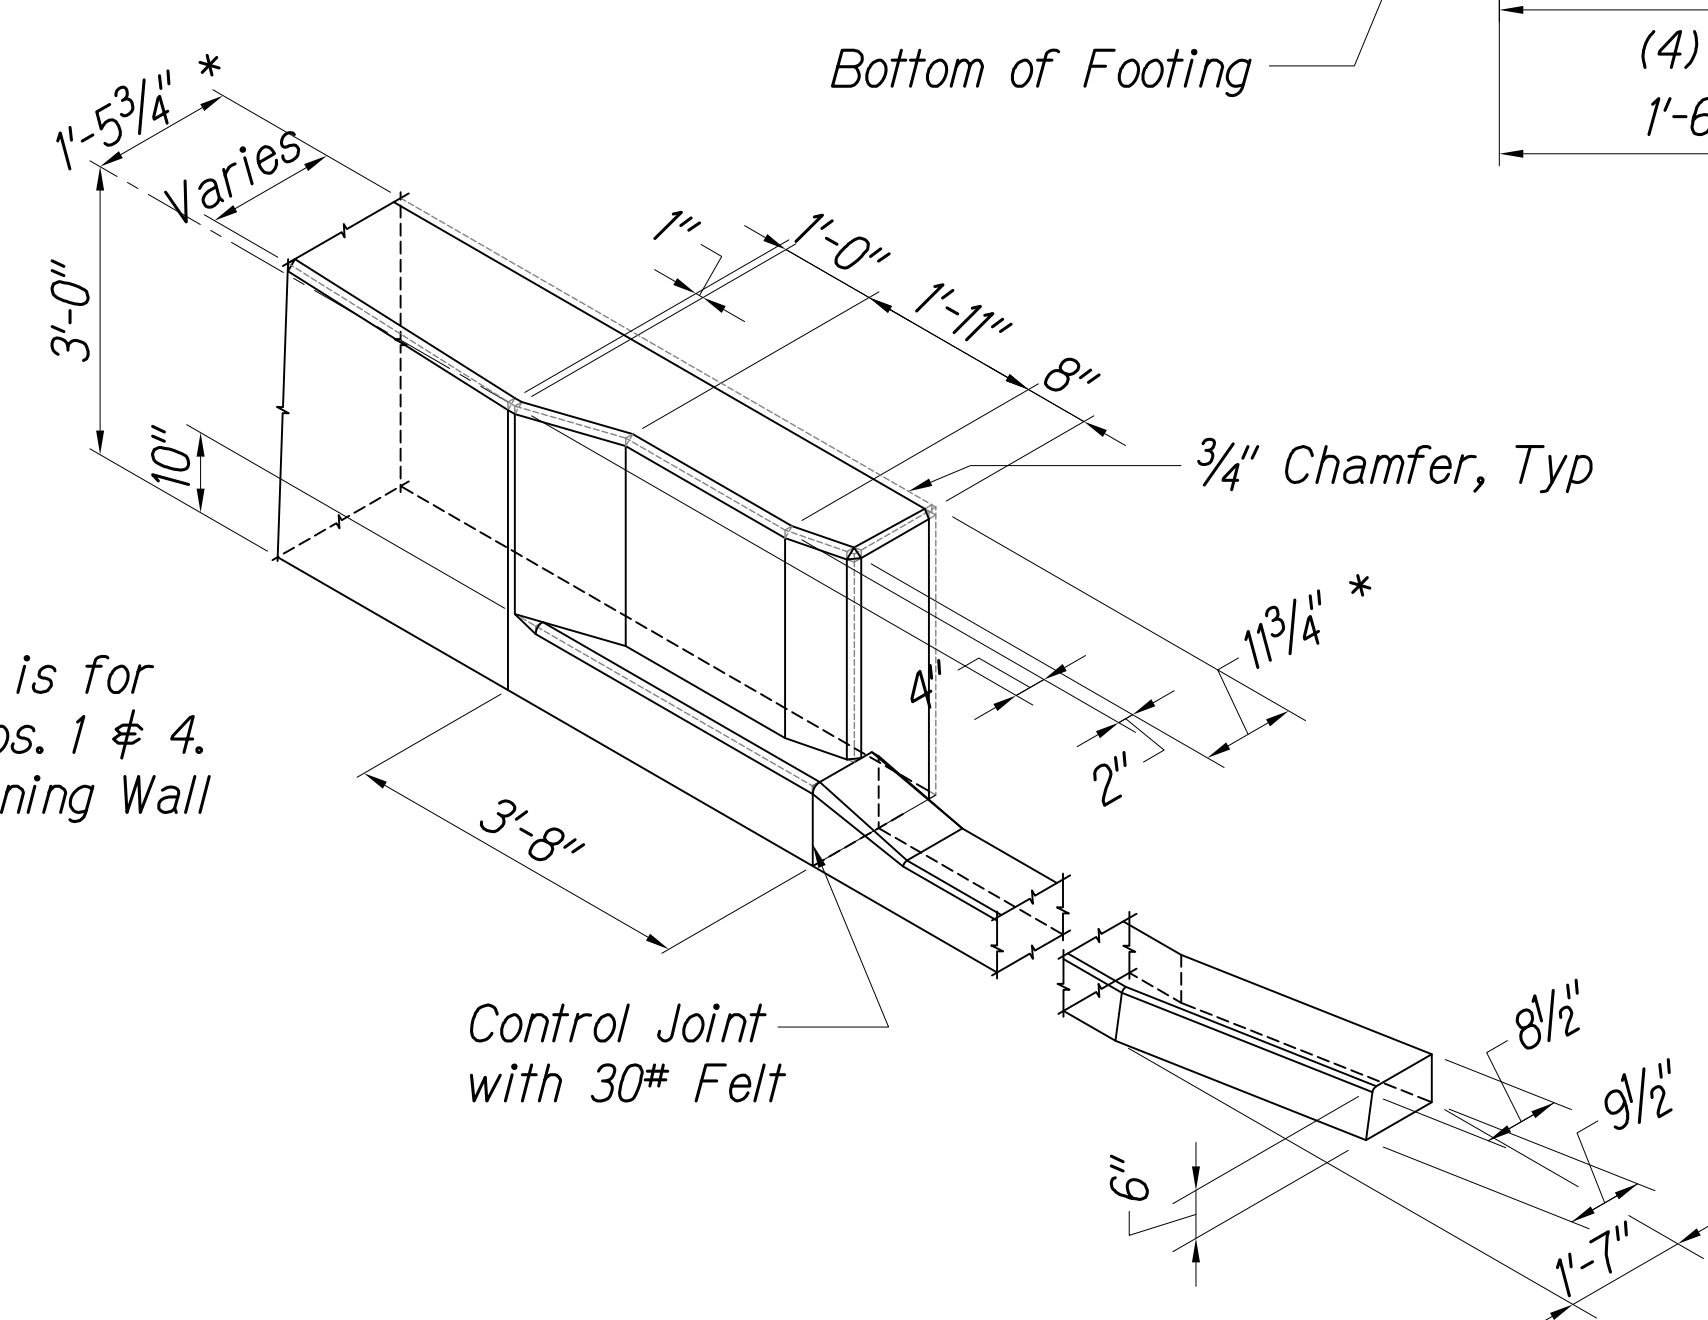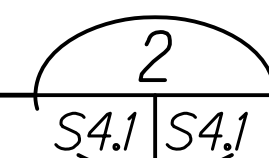

* Dimension shown is for Retaining Wall Nos. 1 & 4. Add 2" for Retaining Wall Nos. 2 & 3.


Scale: $1/2'' = 1'-0''$

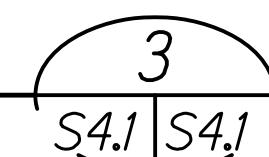

ORIGINAL PLAN	SURVEY PLOTTED BY _____ DATE _____
NOTE BOOK	DRAWN BY _____
	TRACED BY _____
	DESIGNED BY _____
	QUANTITIES BY _____
No. _____	CHECKED BY _____

FILE NAME	CHECKED BY	DATE
\\4451-4500\4458 HDOT - Kiewit Design build of H1 Widening\004 Drawings\Structural\AutoCAD_format\Phase 2\2020-02-06 - As-Builts\4458_S4-1.dwg		2/6/2020 11:22 AM
BRYAN LUM		

THESE PLANS HAVE BEEN PREPARED UTILIZING INFORMATION PROVIDED BY THE PROJECT CONTRACTOR. THE UPDATED CONSTRUCTION INFORMATION DEPICTED HEREIN HAS NOT BEEN VERIFIED FOR ACCURACY AND COMPLETENESS. NO REPRESENTATION IS BEING MADE TO ITS VALIDITY.




THIS WORK WAS PREPARED BY ME
OR UNDER MY SUPERVISION.


April 30, 2020
SIGNATURE _____ EXPIRATION DATE _____
OF THE LICENSE _____

STATE OF HAWAII
DEPARTMENT OF TRANSPORTATION
HIGHWAYS DIVISION
RETAINING WALL
END POST DETAILS
INTERSTATE ROUTE H-1
SHOULDER WORK AND PORTLAND CEMENT
CONCRETE PAVEMENT REHABILITATION
VICINITY OF WAIMALU TO VICINITY OF HALAWA
PHASE 2 - SHOULDER WORK
Scale: As Shown Date: November 30, 2018
SHEET No. S4.1 OF 1 SHEETS


FED. ROAD DIST. NO.	STATE	FED. AID PROJ. NO.	FISCAL YEAR	SHEET NO.	TOTAL SHEETS
HAWAII	HAW.	NH-H1-1(274)	2018	99	126

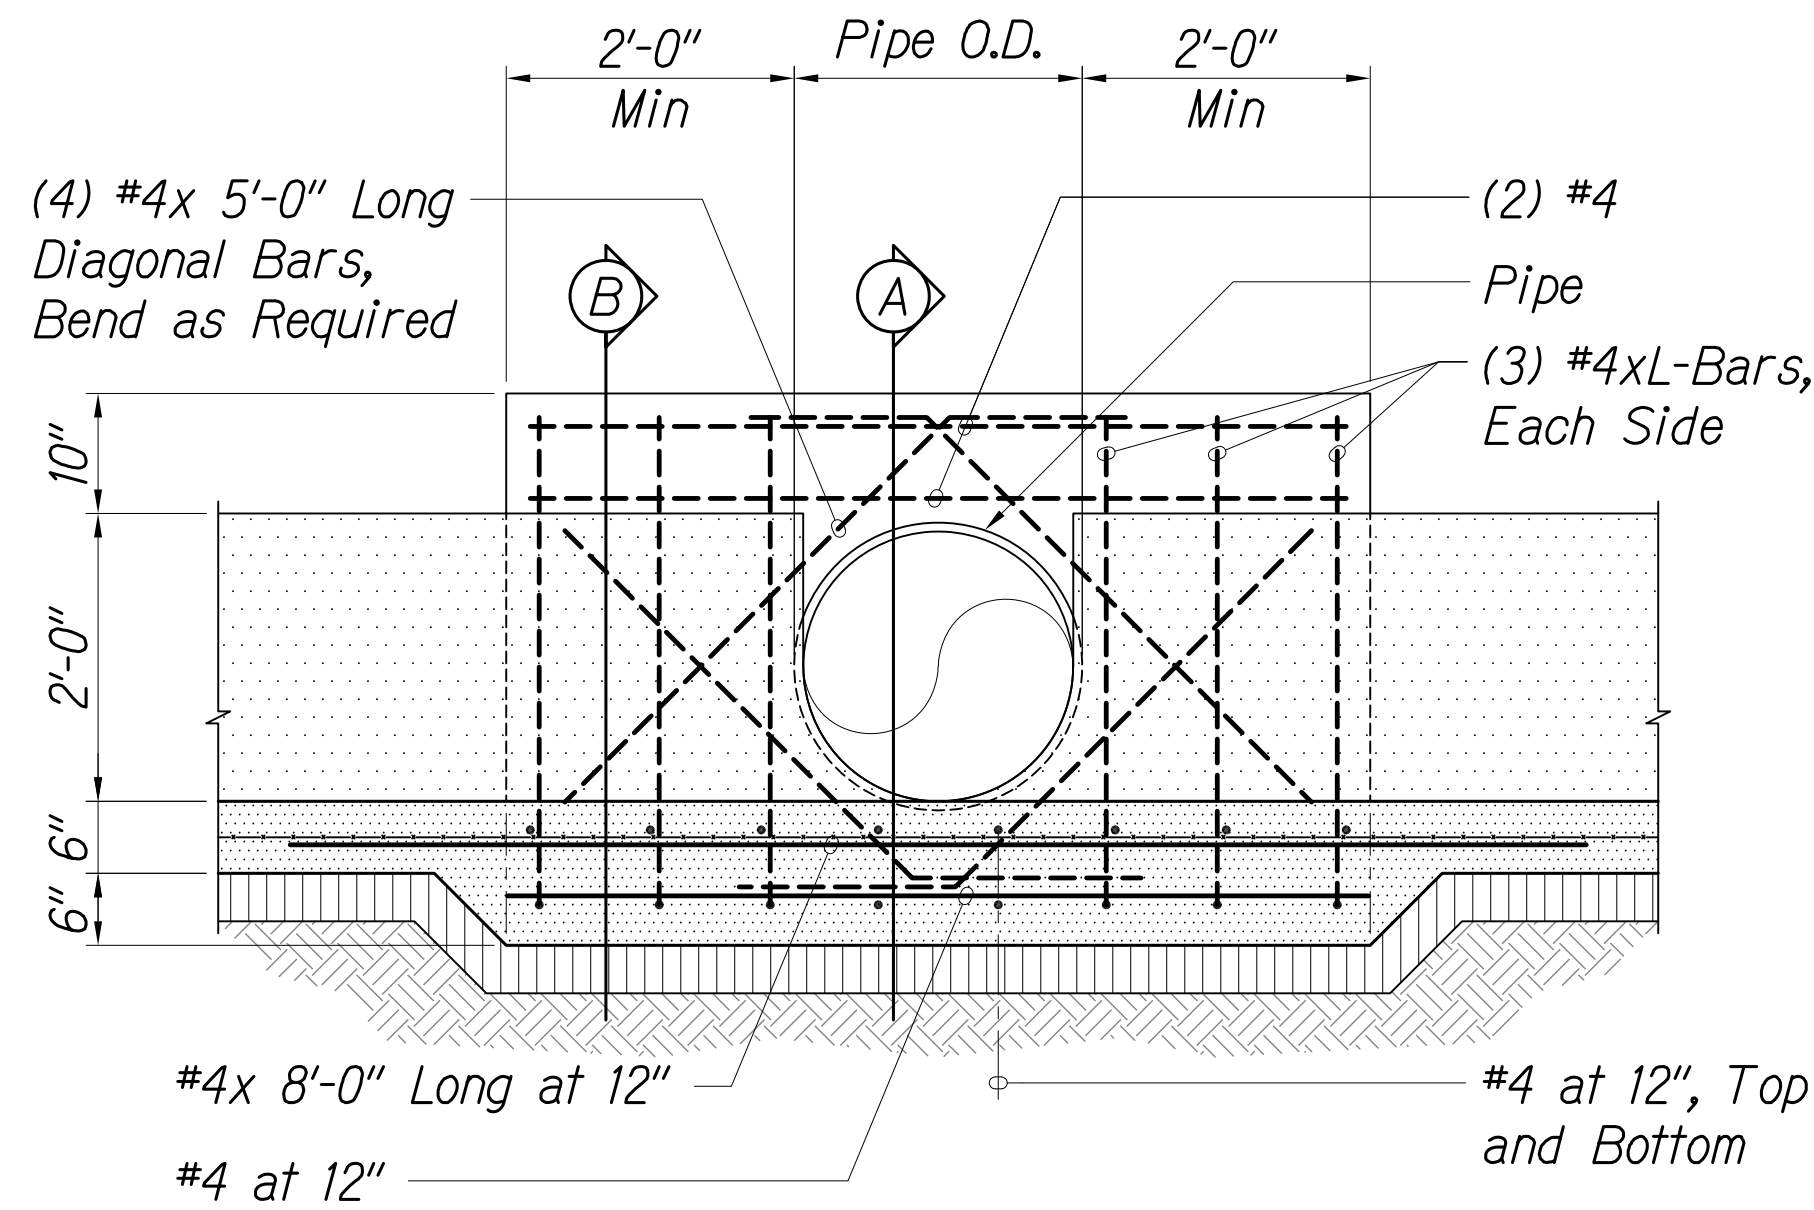

Pipe Headwall Section


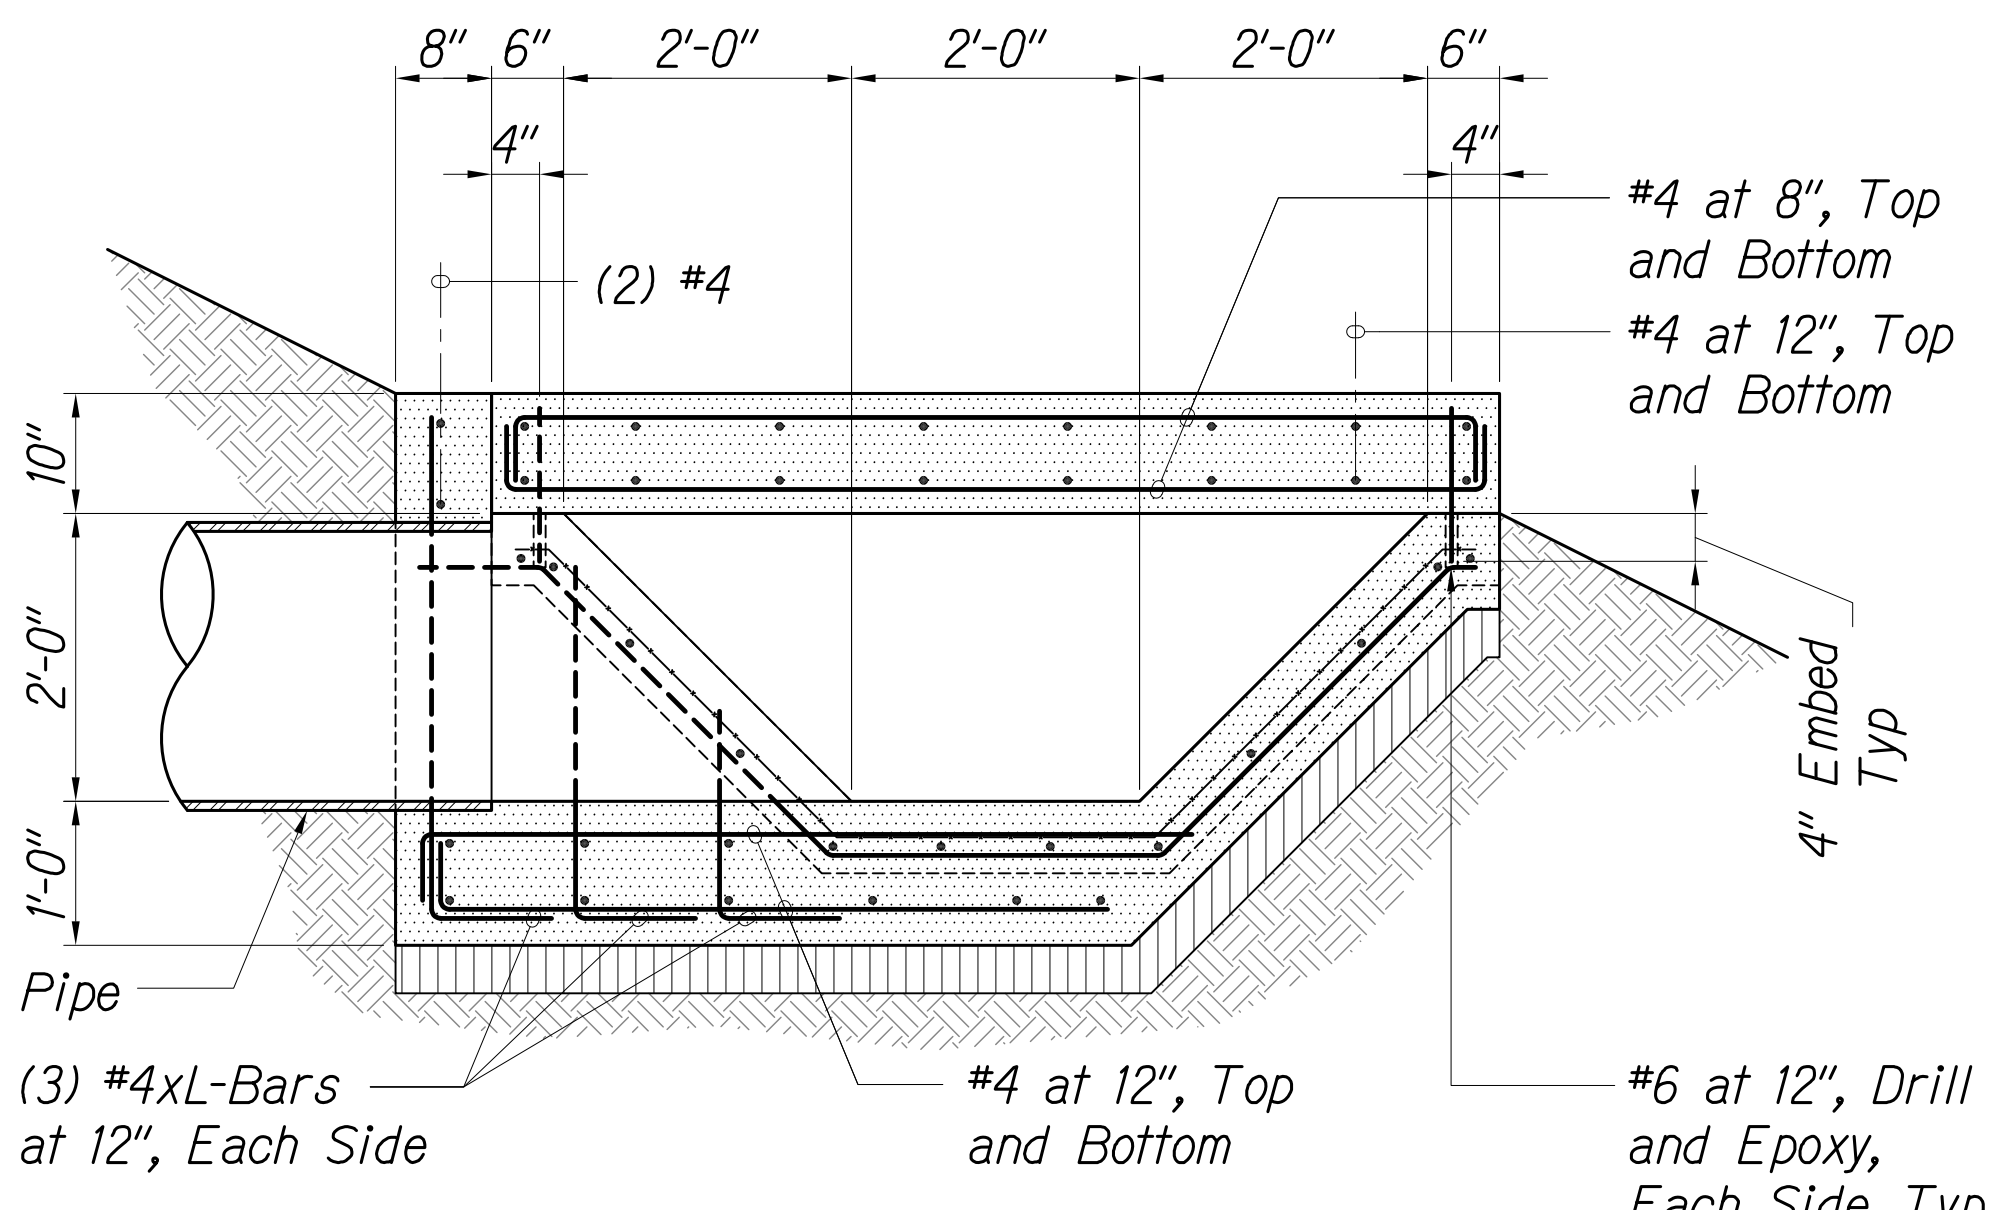


A-Section

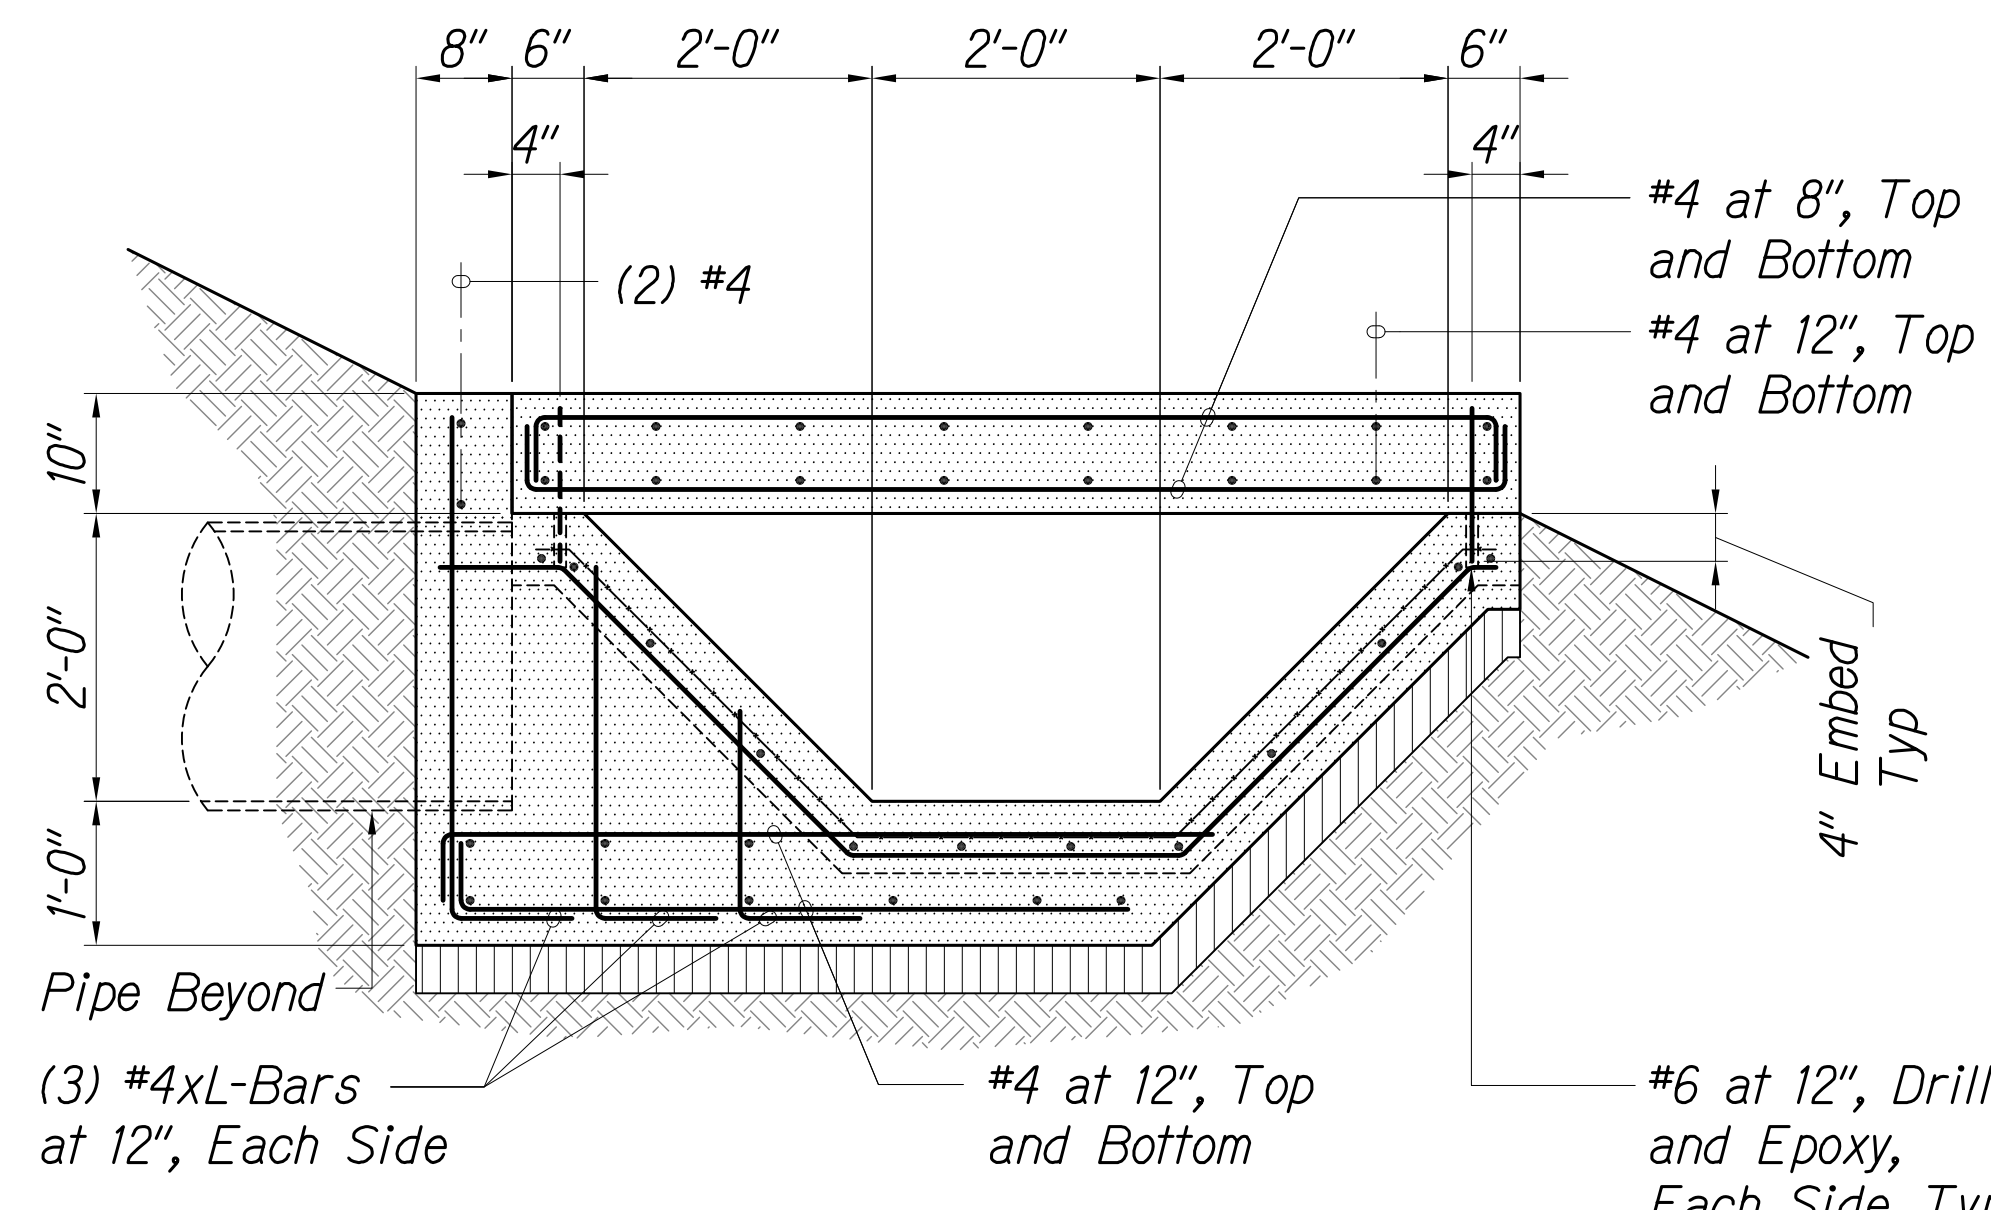


B-Section

CONCRETE DITCH
PIPE HEADWALL AND AND CONCRETE TOP SLAB DETAIL
Scale: 3/4" = 1'-0"

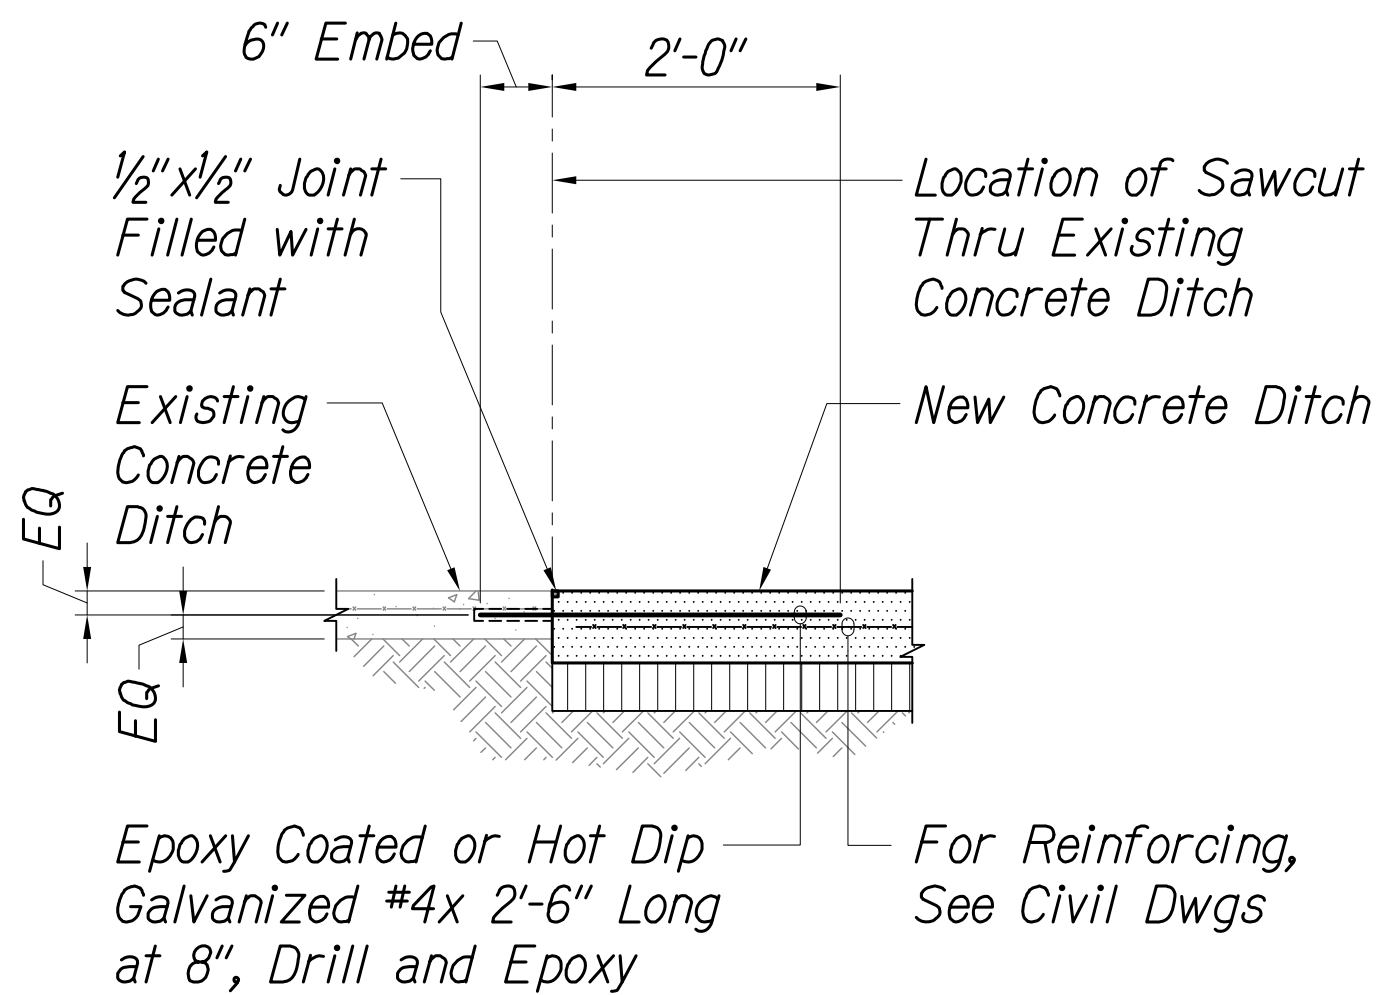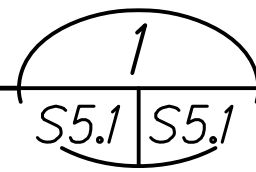


Existing Ditch to New Ditch Section

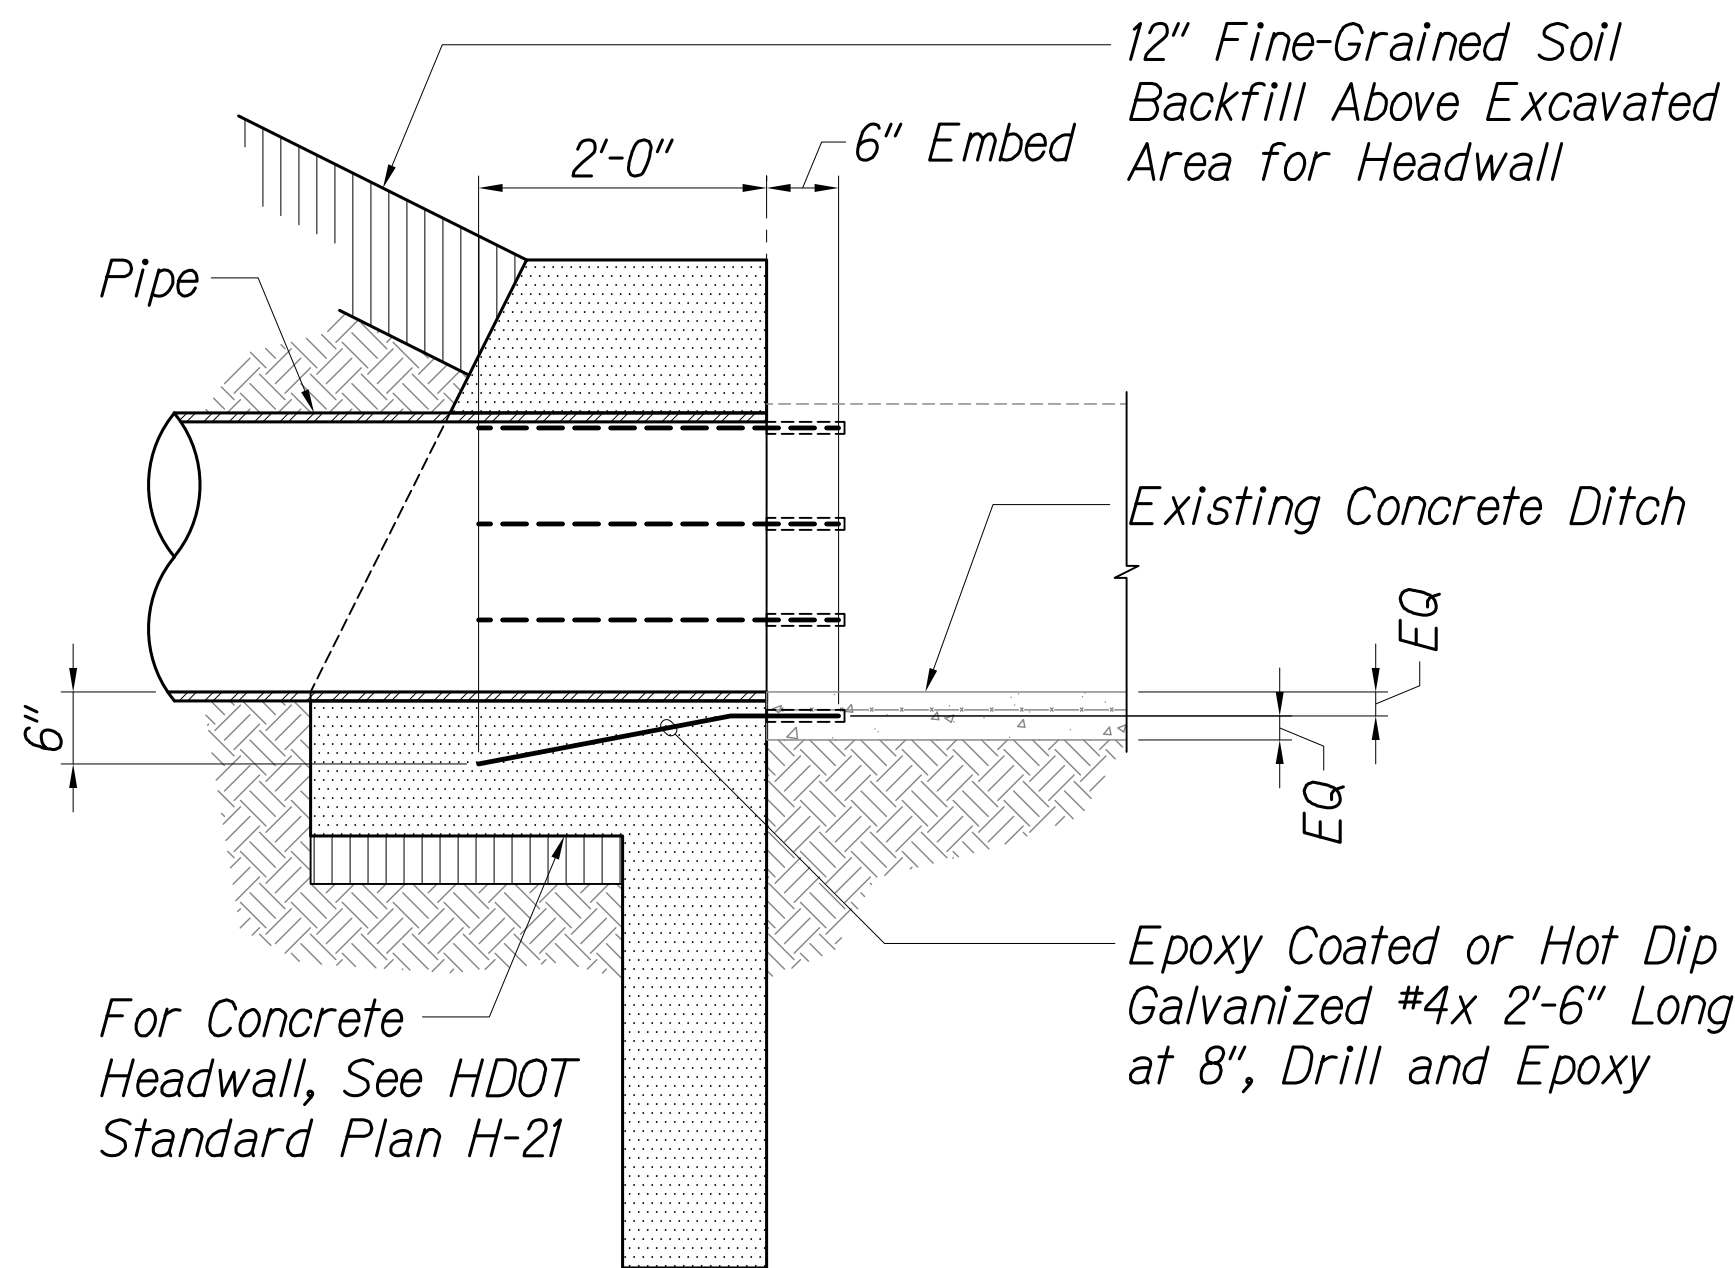

Existing Ditch to New Concrete Headwall

CONCRETE DITCH
CONNECTION DETAILS
Scale: 3/4" = 1'-0"

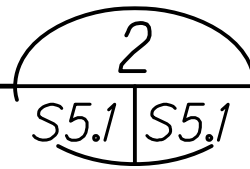


THIS WORK WAS PREPARED BY ME
OR UNDER MY SUPERVISION.

Signature: [Signature] April 30, 2020
EXPIRATION DATE
OF THE LICENSE


THESE PLANS HAVE BEEN
PREPARED UTILIZING
INFORMATION PROVIDED BY
THE PROJECT CONTRACTOR.
THE UPDATED CONSTRUCTION
INFORMATION DEPICTED
HEREIN HAS NOT BEEN
VERIFIED FOR ACCURACY
AND COMPLETENESS. NO
REPRESENTATION IS BEING
MADE TO ITS VALIDITY.

STATE OF HAWAII
DEPARTMENT OF TRANSPORTATION
HIGHWAYS DIVISION
**TYPICAL CONCRETE
DITCH DETAILS**
INTERSTATE ROUTE H-1
SHOULDER WORK AND PORTLAND CEMENT
CONCRETE PAVEMENT REHABILITATION
VICINITY OF WAIMALU TO VICINITY OF HALAWA
PHASE 2 - SHOULDER WORK
Scale: As Shown Date: November 30, 2018
SHEET No. S5.1 OF 2 SHEETS

FED. ROAD DIST. NO.	STATE	FED. AID PROJ. NO.	FISCAL YEAR	SHEET NO.	TOTAL SHEETS
HAWAII	HAW.	NH-H1-1(274)	2018	100	126

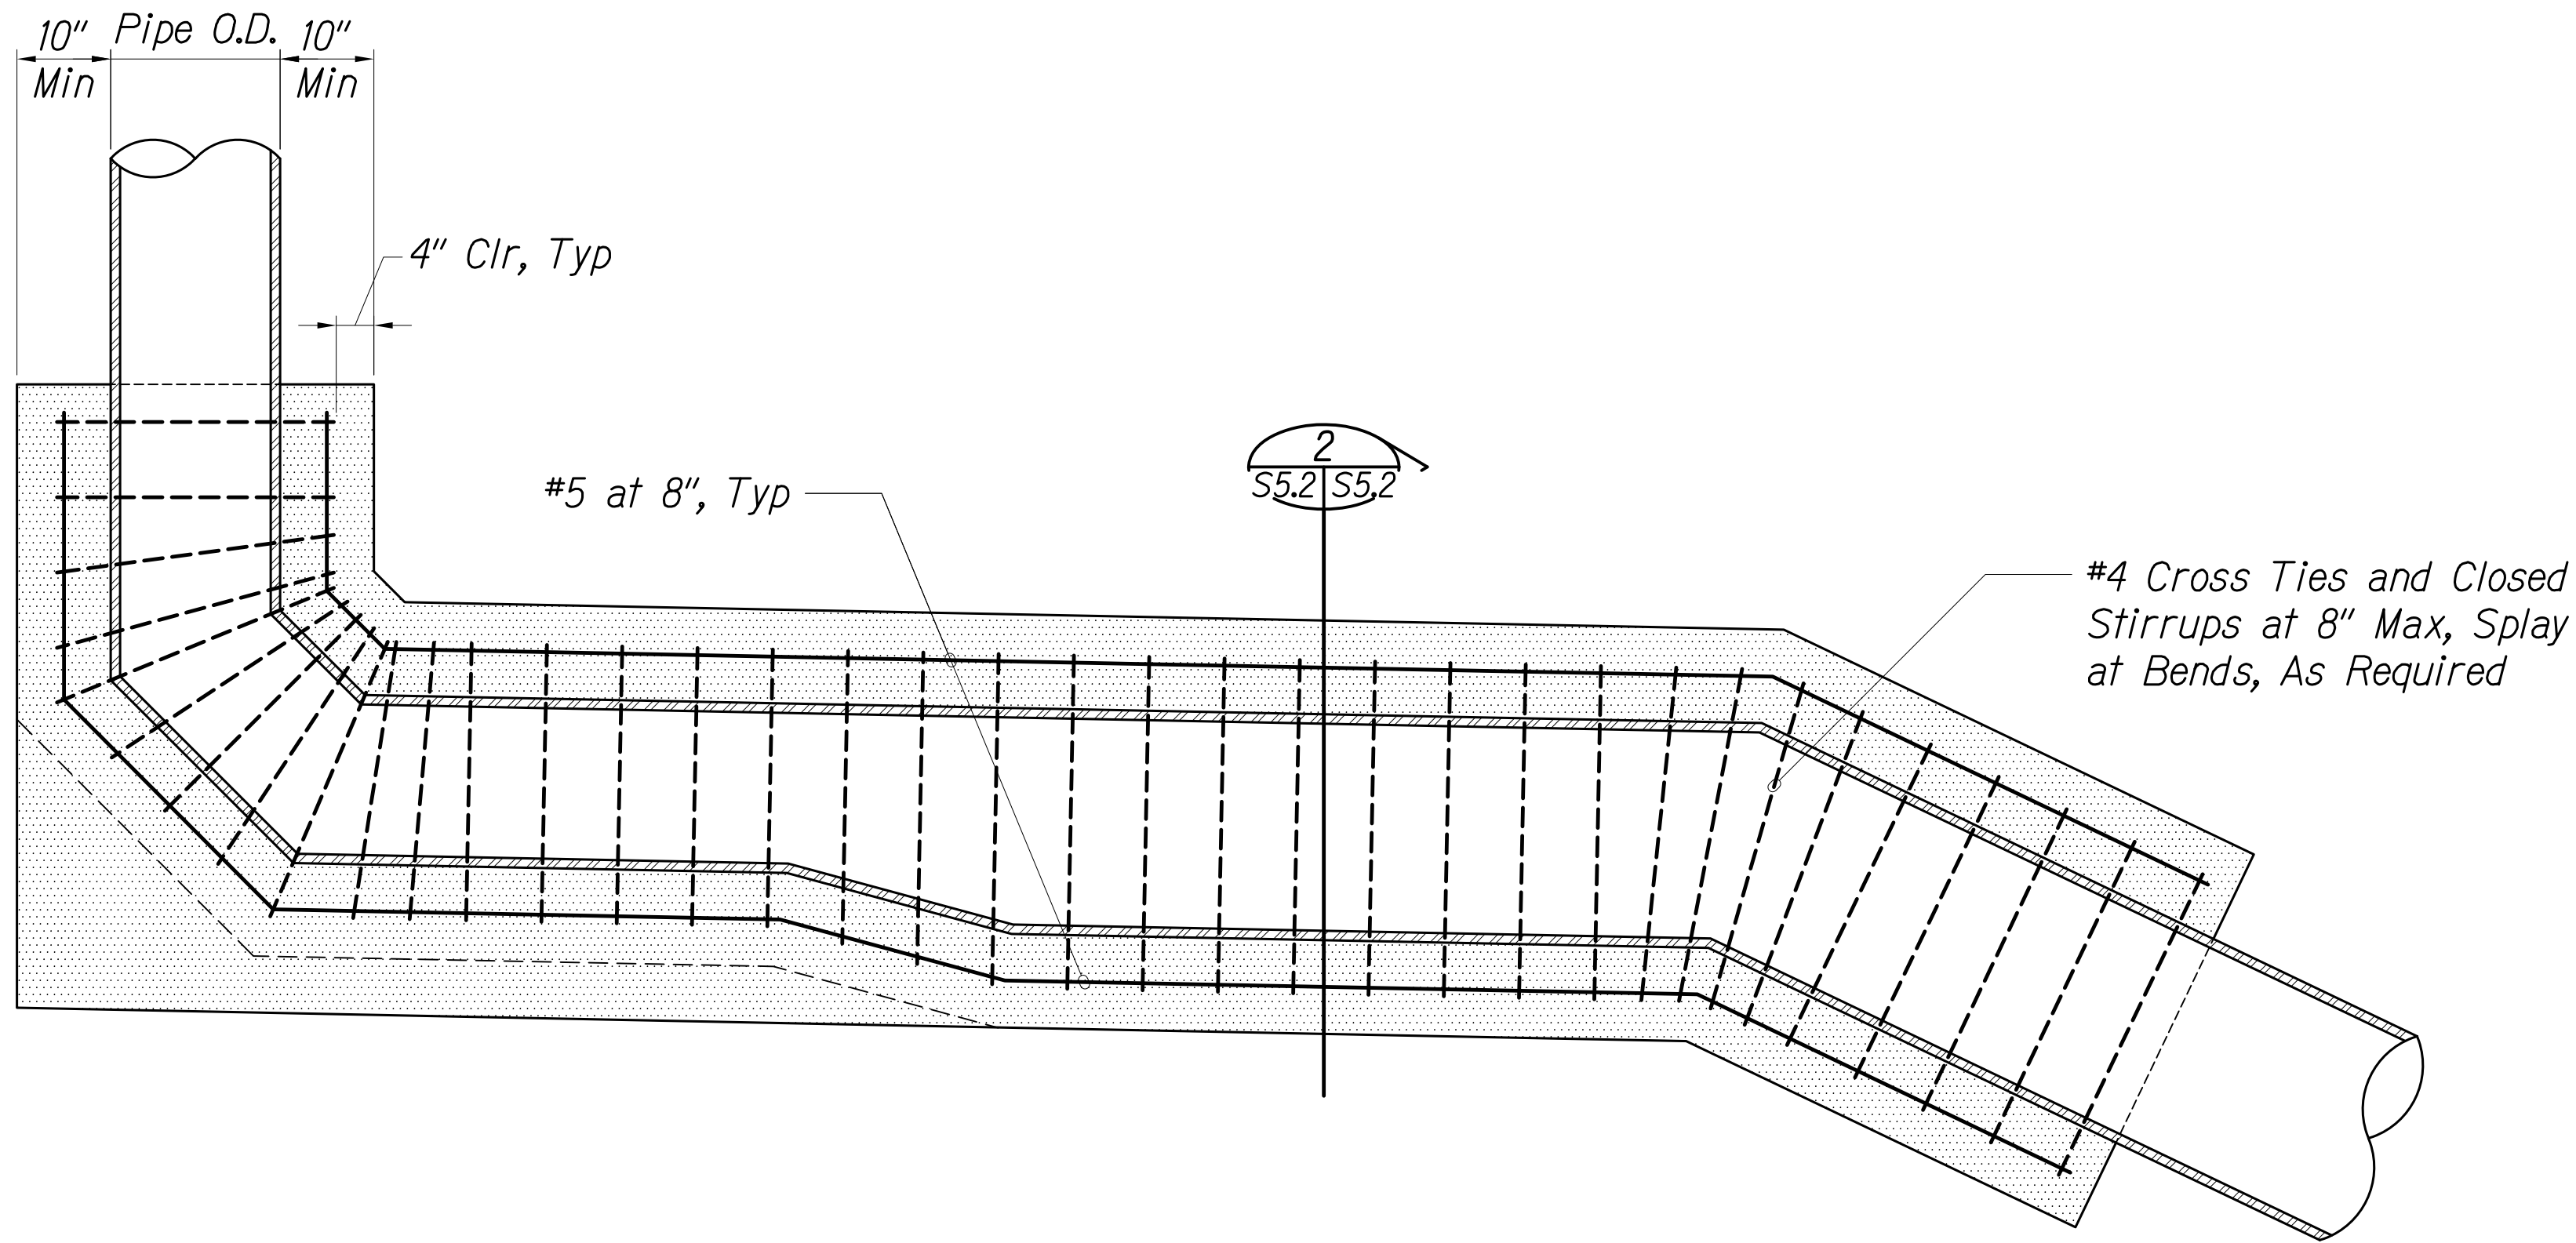

TYPICAL DRAINLINE COLLAR DETAIL
Scale: 3/4" = 1'-0"

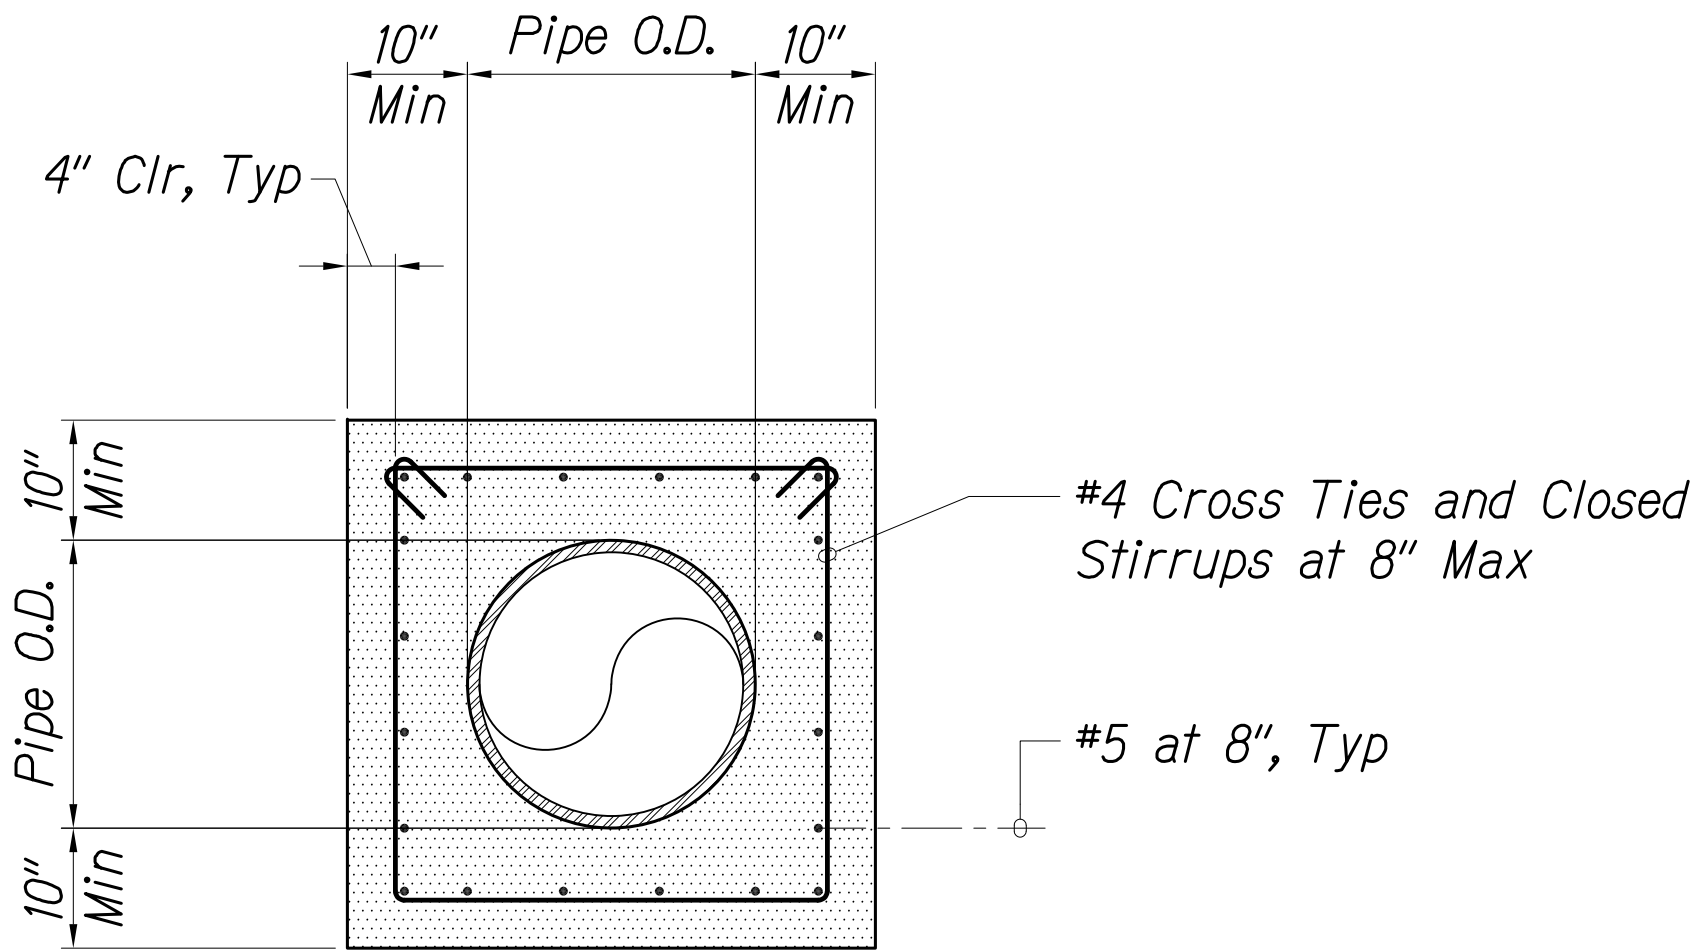


SECTION
Scale: 3/4" = 1'-0"

ORIGINAL PLAN	SURVEY PLOTTED BY	DATE
NOTE BOOK	DRAWN BY	
No.	TRACED BY	
	DESIGNED BY	
	QUANTITIES BY	
	CHECKED BY	

P:\451-4500\4458-1001 - Kenit Design build of HI Widening\04 Drawings\Structural\AutoCAD\Format\Phase 2\2020-02-06 - As-Built\4458-SS-1-SS-2.dwg 2/6/2020 11:22 AM BRYAN LUM

THESE PLANS HAVE BEEN PREPARED UTILIZING INFORMATION PROVIDED BY THE PROJECT CONTRACTOR. THE UPDATED CONSTRUCTION INFORMATION DEPICTED HEREIN HAS NOT BEEN VERIFIED FOR ACCURACY AND COMPLETENESS. NO REPRESENTATION IS BEING MADE TO ITS VALIDITY.


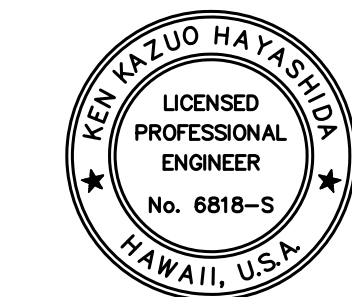


THIS WORK WAS PREPARED BY ME OR UNDER MY SUPERVISION.

Signature: [Signature] April 30, 2020
EXPIRATION DATE OF THE LICENSE

STATE OF HAWAII
DEPARTMENT OF TRANSPORTATION
HIGHWAYS DIVISION
TYPICAL CONCRETE COLLAR DETAILS
INTERSTATE ROUTE H-1
SHOULDER WORK AND PORTLAND CEMENT
CONCRETE PAVEMENT REHABILITATION
VICINITY OF WAIMALU TO VICINITY OF HALAWA
PHASE 2 - SHOULDER WORK
Scale: As Shown Date: November 30, 2018
SHEET No. S5.2 OF 2 SHEETS

* Where basalt rock is encountered above or at the bottom of Pedestal elevation, the Drilled Shaft Length can be reduced to 4'-6".

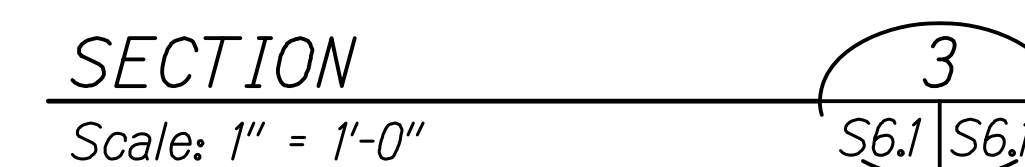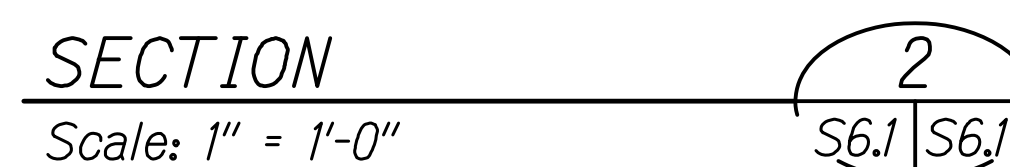


\\4451-4500\4458 HDOT - Kiewit Design build of H1 Widening\004 Drawings\Structural\AutoCAD_format\Phase 2\2020-02-06 - As-Built\4458_S6-1.dwg 2/6/2020 11:22 AM BRYAN LUM

April 30, 2020
SIGNATURE _____ EXPIRATION DATE
OF THE LICENSE


"AS-BUILT"

FED. ROAD DIST. NO.	STATE	FED. AID PROJ. NO.	FISCAL YEAR	SHEET NO.	TOTAL SHEETS
HAWAII	HAW.	NH-H1-1(274)	2018	101A	126

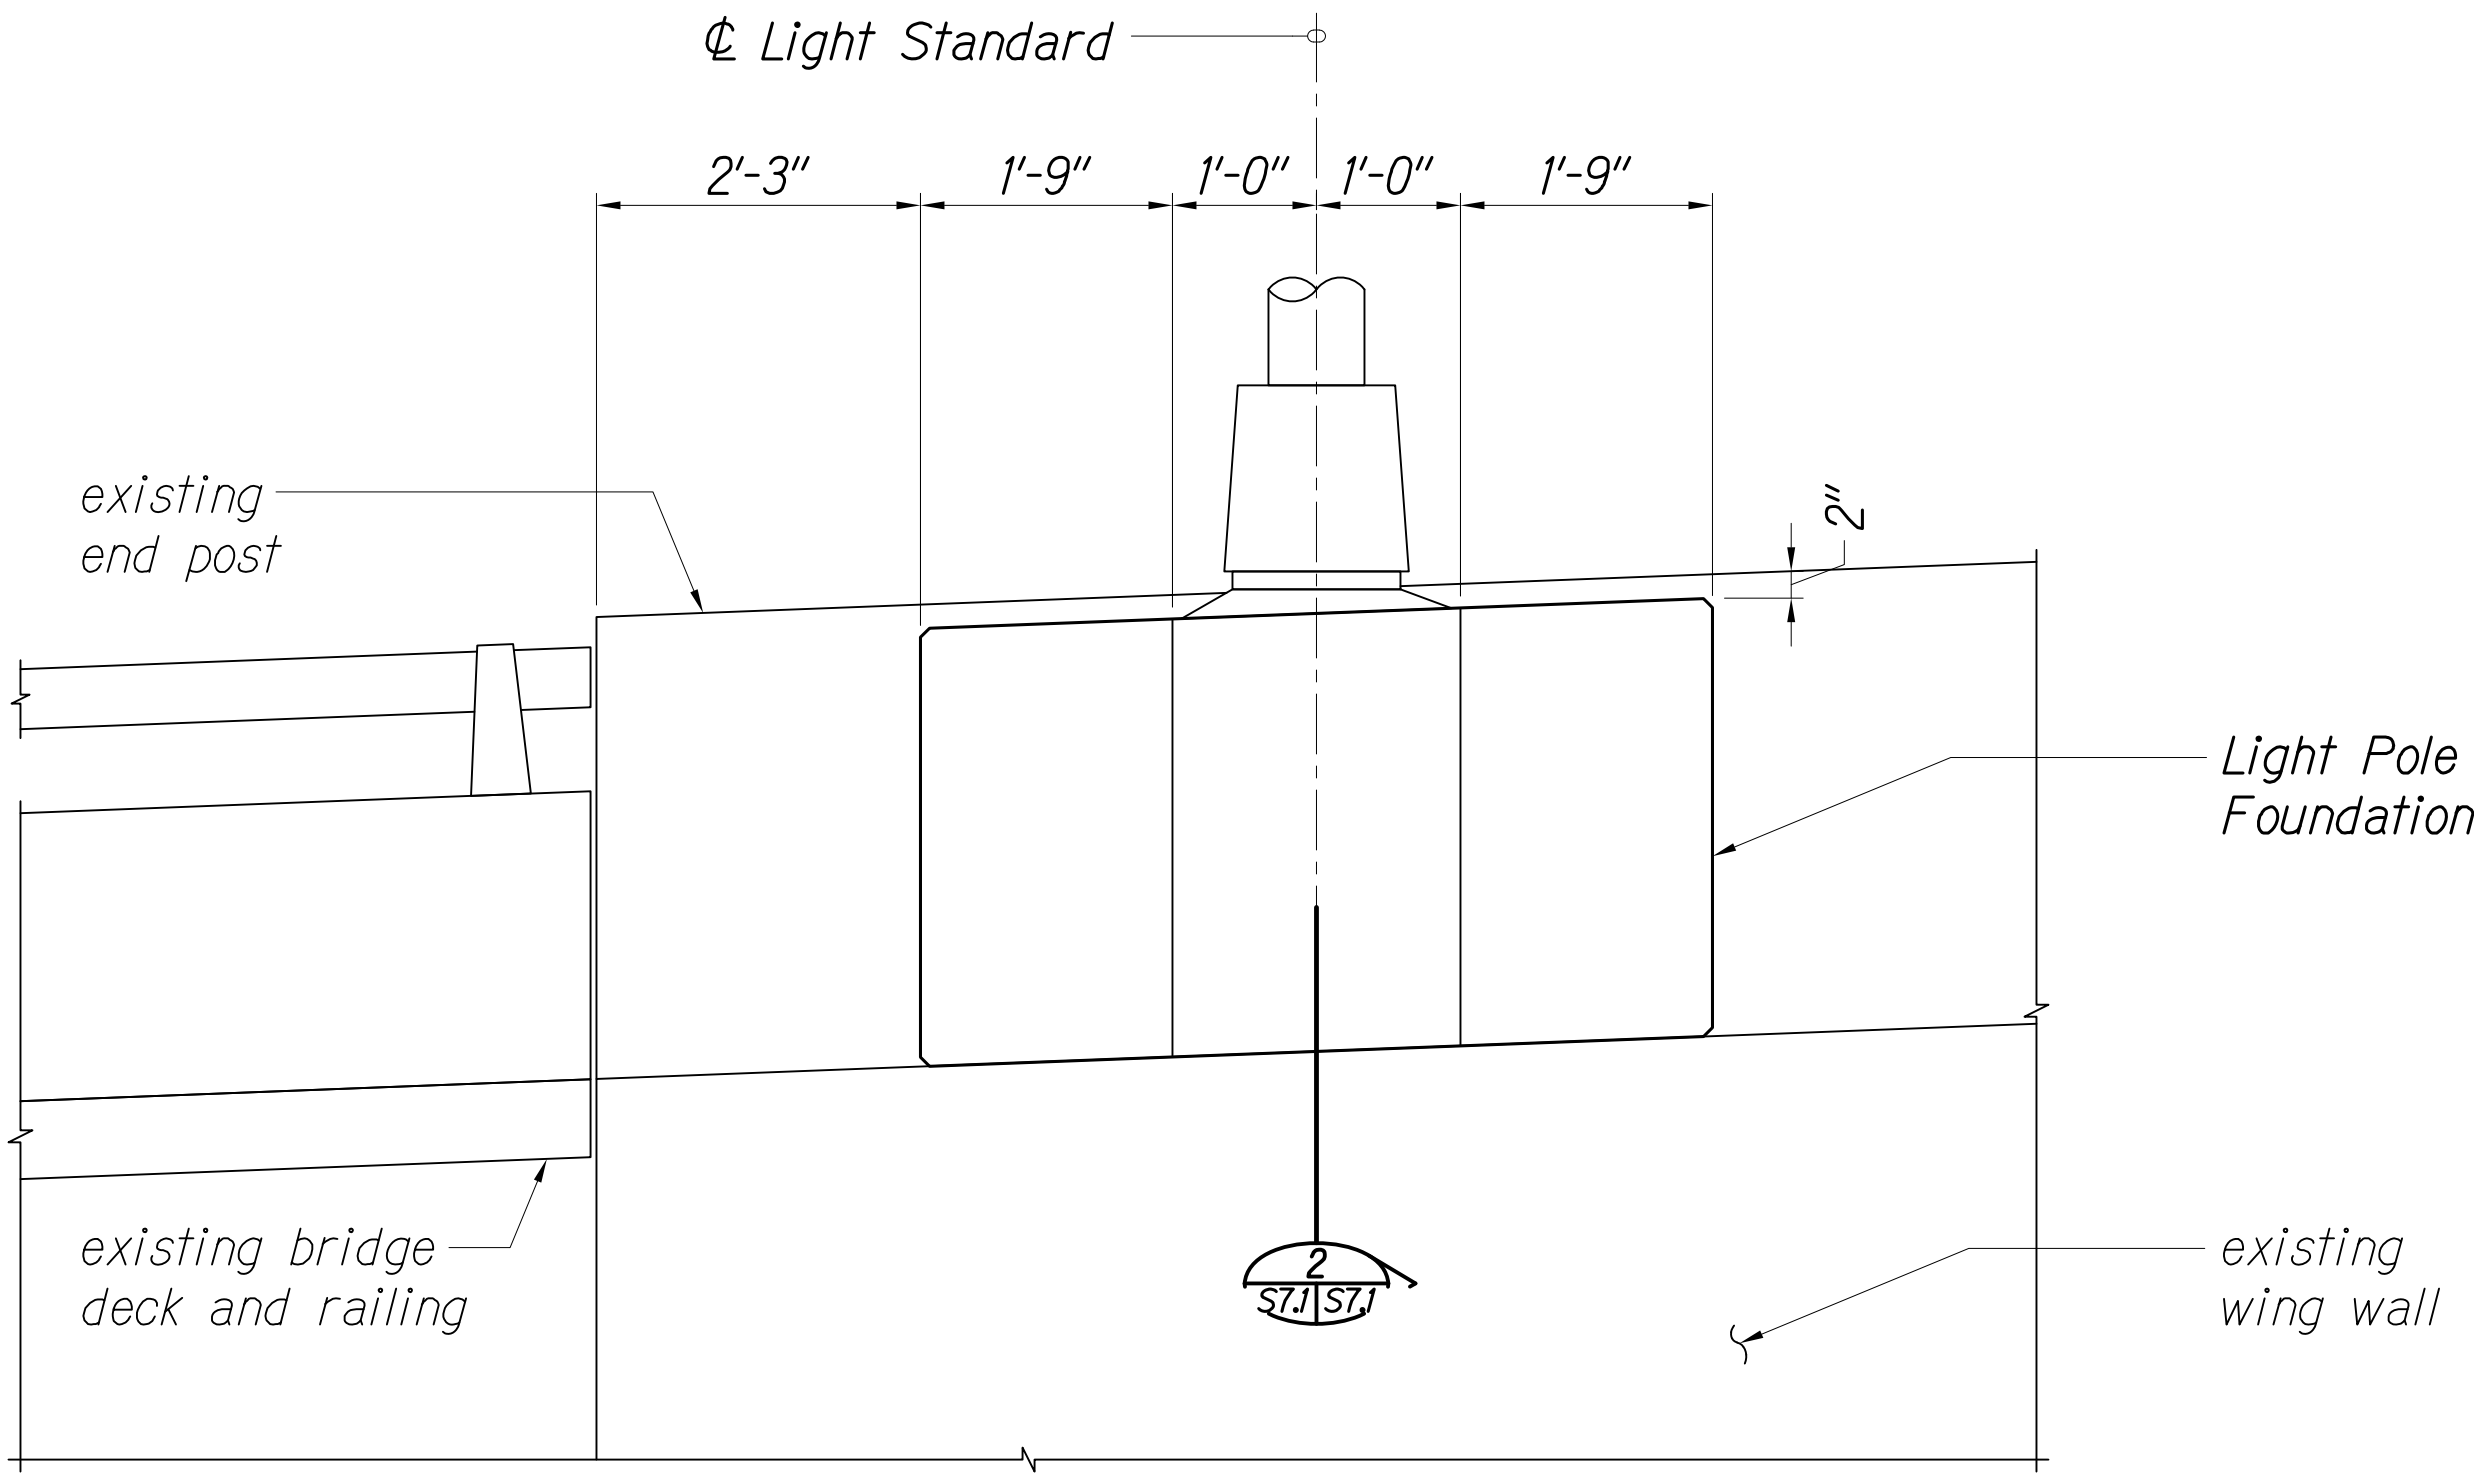


EXISTING BRIDGE END POST ELEVATION
Scale: 3/4" = 1'-0"

1
S7.1 S7.1

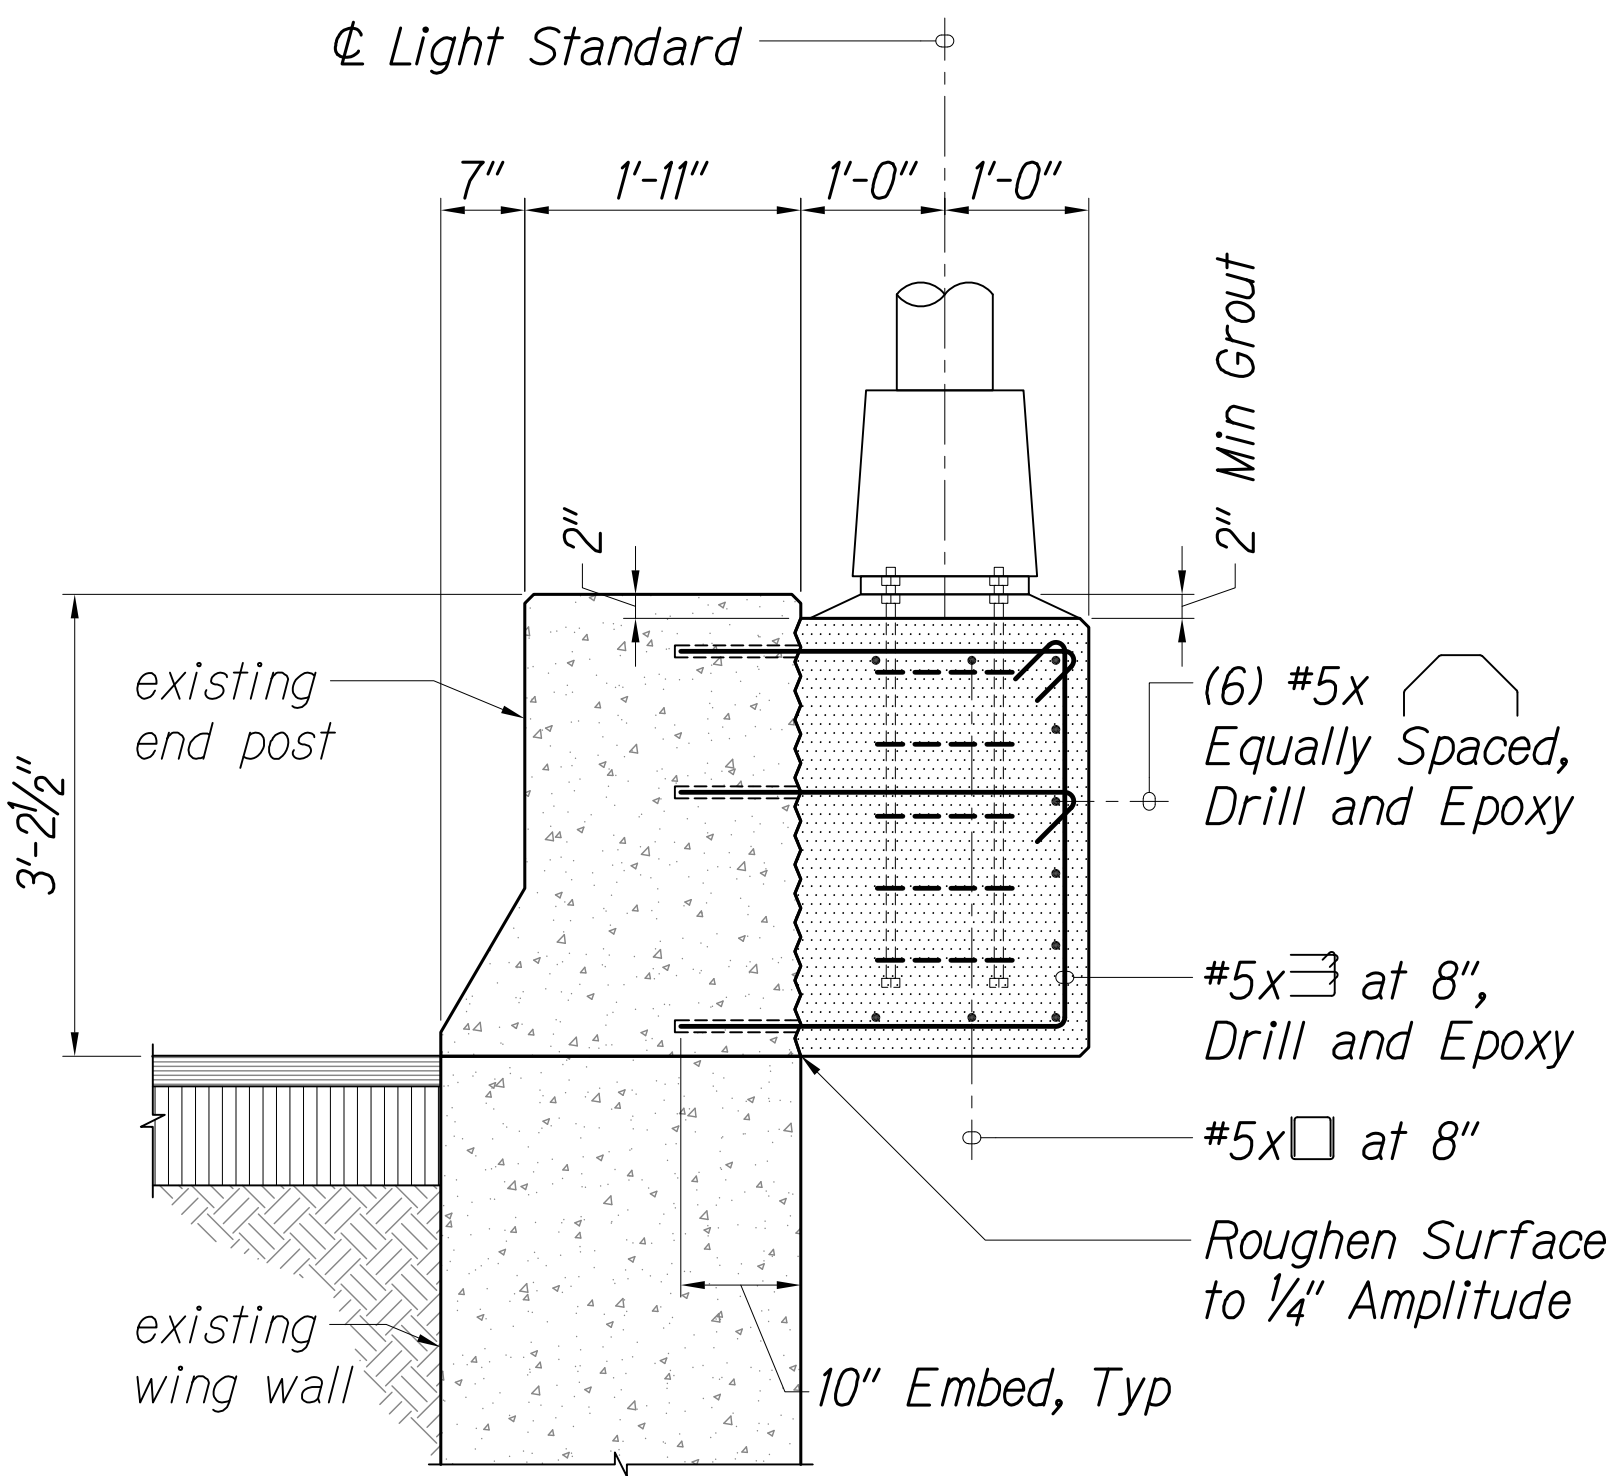


SECTION
Scale: 3/4" = 1'-0"

2
S7.1 S7.1

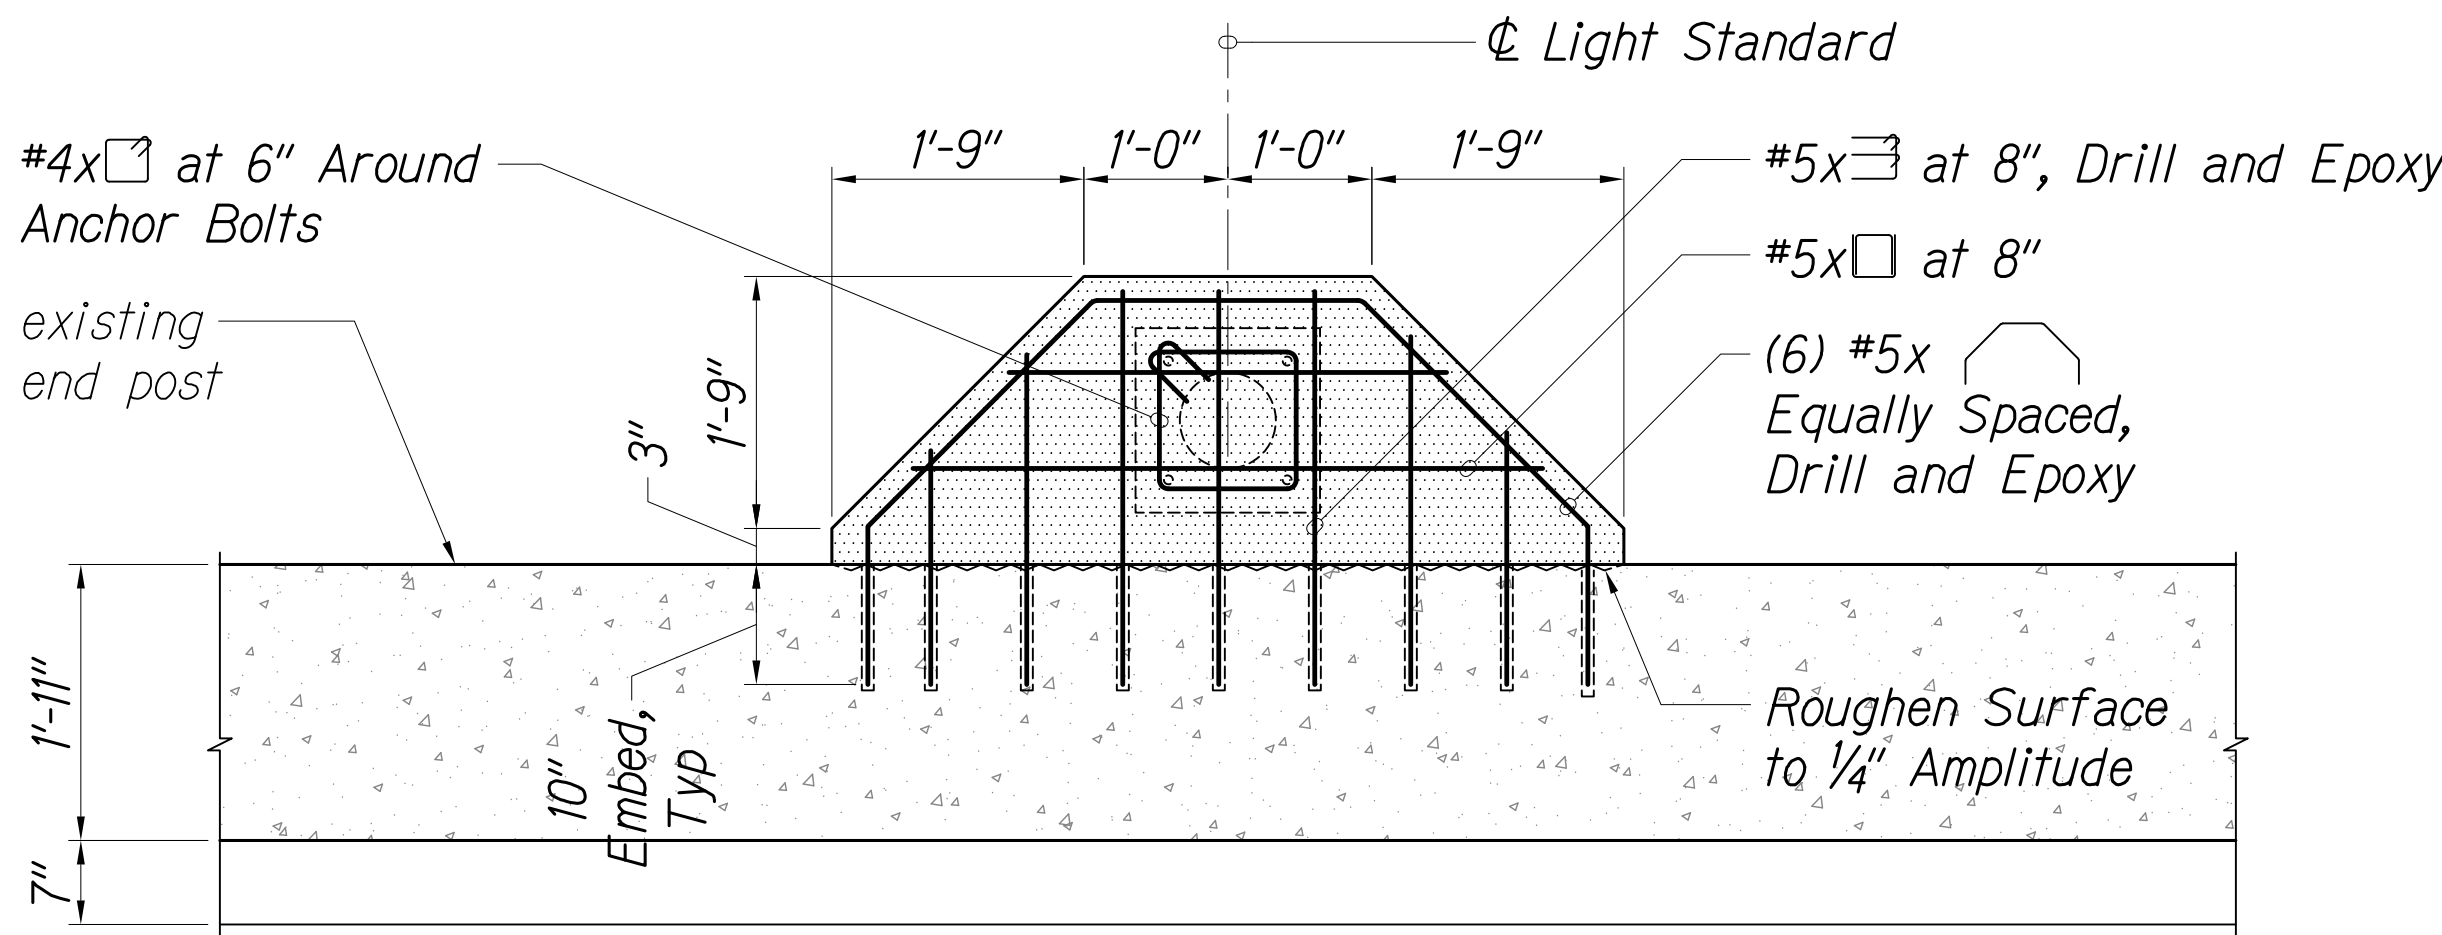

Section - Plan View

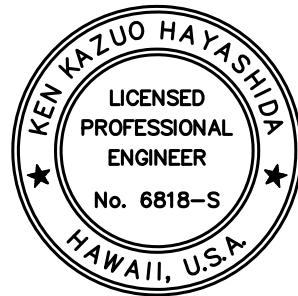

THESE PLANS HAVE BEEN PREPARED UTILIZING INFORMATION PROVIDED BY THE PROJECT CONTRACTOR. THE UPDATED CONSTRUCTION INFORMATION DEPICTED HEREIN HAS NOT BEEN VERIFIED FOR ACCURACY AND COMPLETENESS. NO REPRESENTATION IS BEING MADE TO ITS VALIDITY.

THIS WORK WAS PREPARED BY ME OR UNDER MY SUPERVISION.

SIGNATURE: [Signature] EXPIRATION DATE OF THE LICENSE: April 30, 2020

STATE OF HAWAII
DEPARTMENT OF TRANSPORTATION
HIGHWAYS DIVISION
**END POST MOUNTED
LIGHT POLE FOUNDATION**
INTERSTATE ROUTE H-1
SHOULDER WORK AND PORTLAND CEMENT
CONCRETE PAVEMENT REHABILITATION
VICINITY OF WAIMALU TO VICINITY OF HALAWA
PHASE 2 - SHOULDER WORK
Scale: As Shown Date: November 30, 2018
SHEET No. S7.1 OF 1 SHEETS