


FED. ROAD DIST. NO.	STATE	FED-AID PROJ. NO.	FISCAL YEAR	SHEET NO.	TOTAL SHEETS
HAWAII	HAW.	NH-HI-1(279)	2021	ADD. 53	304

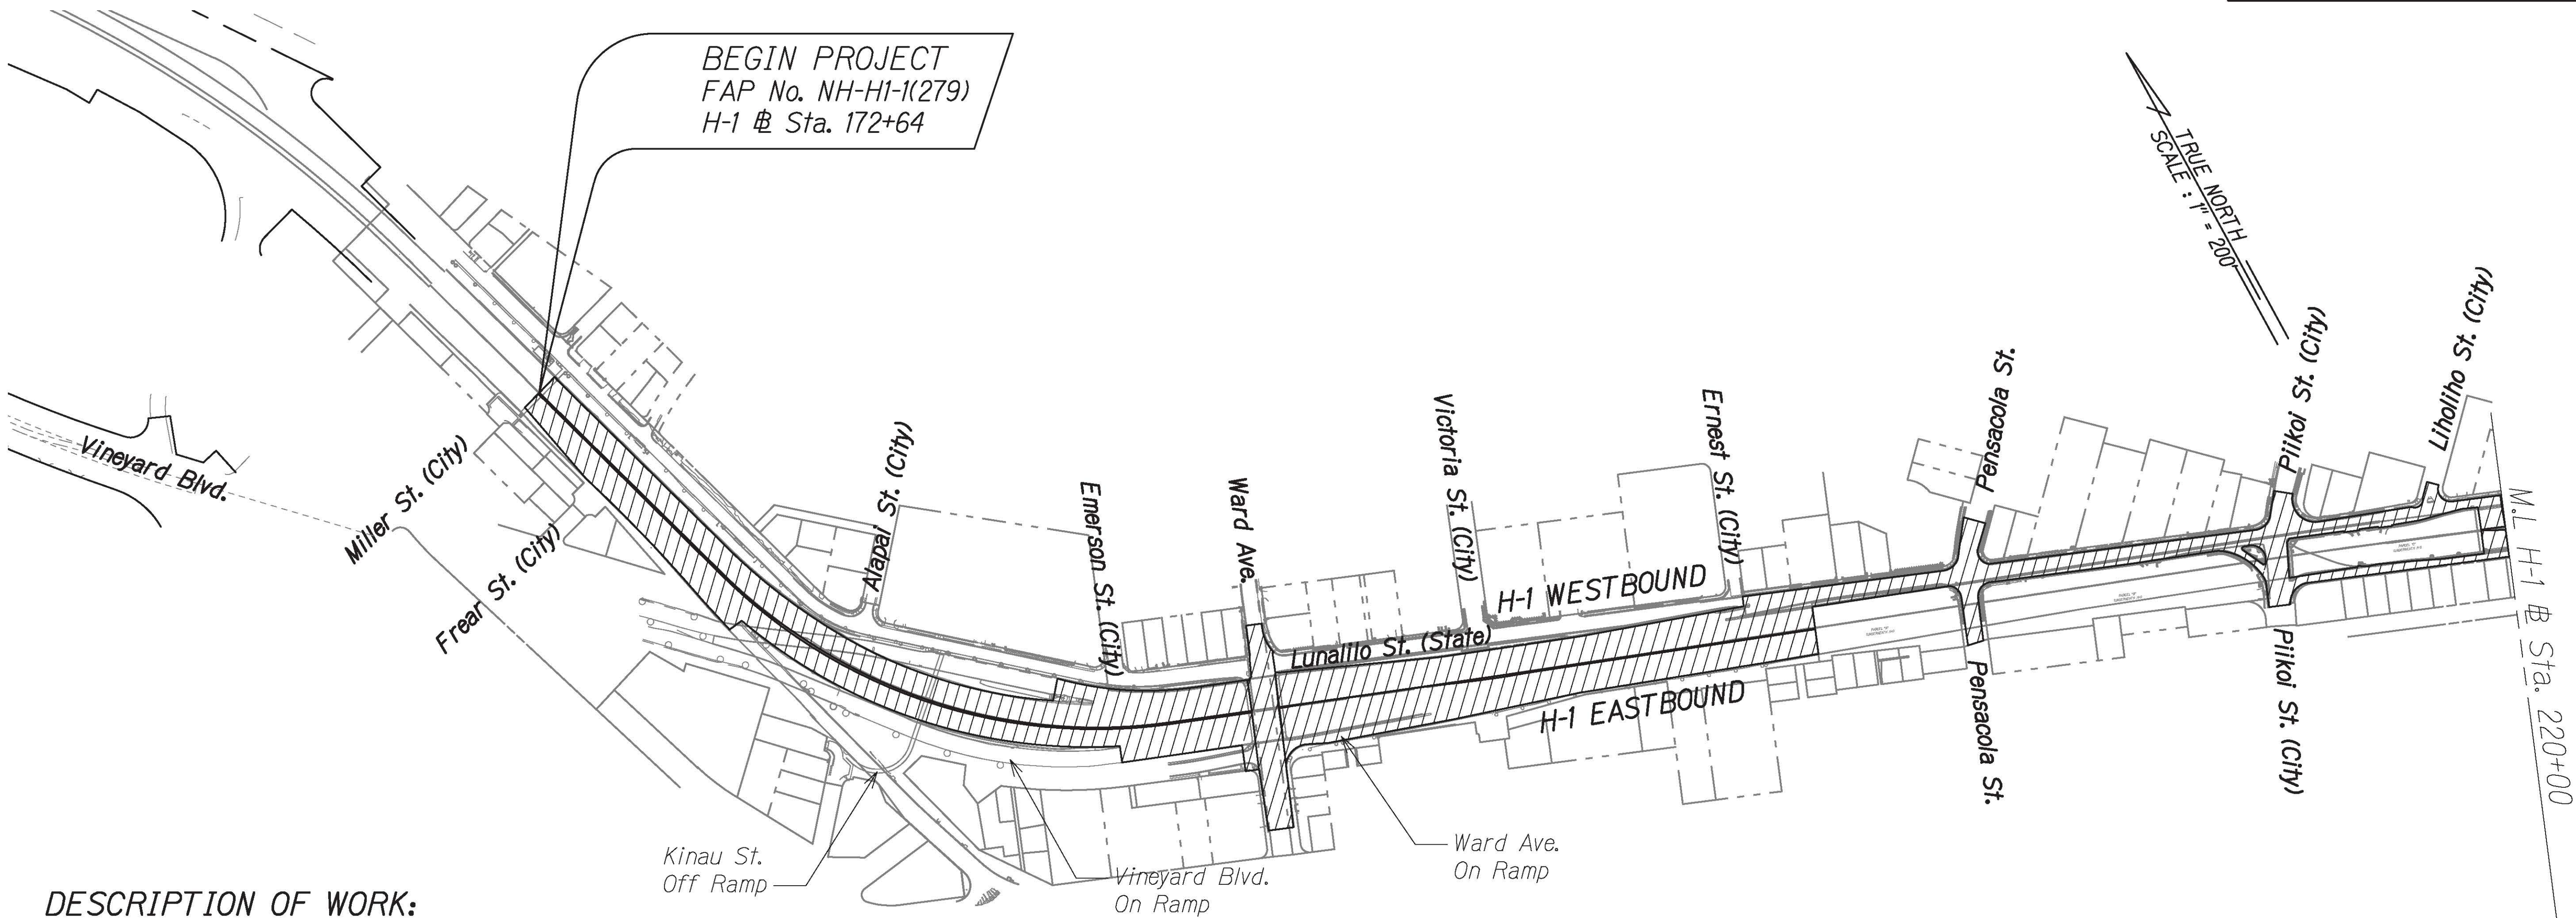

**DESCRIPTION OF WORK:**

1. General. The Interstate Route H-1 Freeway Resurfacing, vicinity of Punchbowl off ramp to Kapiolani Interchange, includes the following roadways to be resurfaced:

A. H-1 Freeway from Station 172+64 (MP 21.80) to the east abutments of the Kapiolani Boulevard Grade Separation Structure, Station 45+82 (MP 24.71).

B. Freeway on and off ramps (eastbound):

- 1) Portion of Kinau St. Off Ramp
- 2) Portion of Vineyard Blvd. On Ramp
- 3) Ward Avenue On Ramp
- 4) Piikoi Street On Ramp
- 5) Punahou St. Off Ramp
- 6) Bingham Street off ramp
- 7) University Avenue On Ramp "U-1"
- 8) University Avenue Off Ramp "U-3"
- 9) Portion of King Street Off Ramp
- 10) Old Waialae Road On Ramp

C. Freeway on and off ramps (westbound):

- 1) Portion of Vineyard Boulevard Off Ramp
- 2) Lunalilo Street on ramp
- 3) Lunalilo Street off ramp

- 4) Punahou Street on ramp
- 5) Wilder Avenue off ramp
- 6) University Avenue On Ramp "U-8"
- 7) University Avenue Off Ramp "U-5"
- 8) University Avenue On Ramp "U-6"
- 9) Old Waialae Road on Ramp "T"

Metcalf Street On Ramp and Old Waialae Road Off Ramp are excluded from resurfacing.

D. Frontage Roads

- 1) Lunalilo Street from Ernest Street to Keeaumoku Street including Pensacola and Piikoi Streets beneath the Piikoi Viaduct within the State DOT right-of-way
- 2) Bingham Street from Punahou Street to 310 feet east of Isenberg Street
- 3) Metcalf Street from Alexander Street to Dole Street
- 4) Wilder Avenue from Wilder Avenue off ramp to University on ramp
- 5) Waiaka Road from Station 0+35 to Station 7+87


E. Cross Streets

- 1) Ward Avenue from Kinau Street to Lunalilo Street

- 2) Keeaumoku Street from Station 6+48 to Station 15+50 (near Kaihee Street)
- 3) McCully Street from Beretania Street to Dole Street

Punahou Street, University Avenue, Kalo Lane, and King Street/Harding Avenue/Kapahulu Avenue and Old Waialae Road beneath the Kapiolani Interchange are excluded from resurfacing work. Also, Kinalau Place and Papaku Place are also excluded. Street lighting upgrade work is limited to H-1 Freeway only.

**LEGEND:**

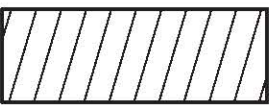

General Resurfacing Limits



THIS WORK WAS PREPARED BY ME OR UNDER MY SUPERVISION


SIGNATURE

04/30/22  
EXPIRATION DATE OF THE LICENSE


7/9/21	3 Revised resurfacing limits
DATE	REVISION
STATE OF HAWAII DEPARTMENT OF TRANSPORTATION HIGHWAYS DIVISION	
<b>GENERAL PLAN</b>	
<b>INTERSTATE ROUTE H-1 RESURFACING</b>	
<b>Miller Pedestrian Overpass to Kapiolani Interchange</b>	
<b>Federal-Aid Project No. NH-HI-1(279)</b>	
Scale: 1" = 200'	Date: August 2021
SHEET No. GPI OF 3 SHEETS	



FED. ROAD DIST. NO.	STATE	FED-AID PROJ. NO.	FISCAL YEAR	SHEET NO.	TOTAL SHEETS
HAWAII	HAW.	NH-HI-1(279)	2021	ADD. 54	304

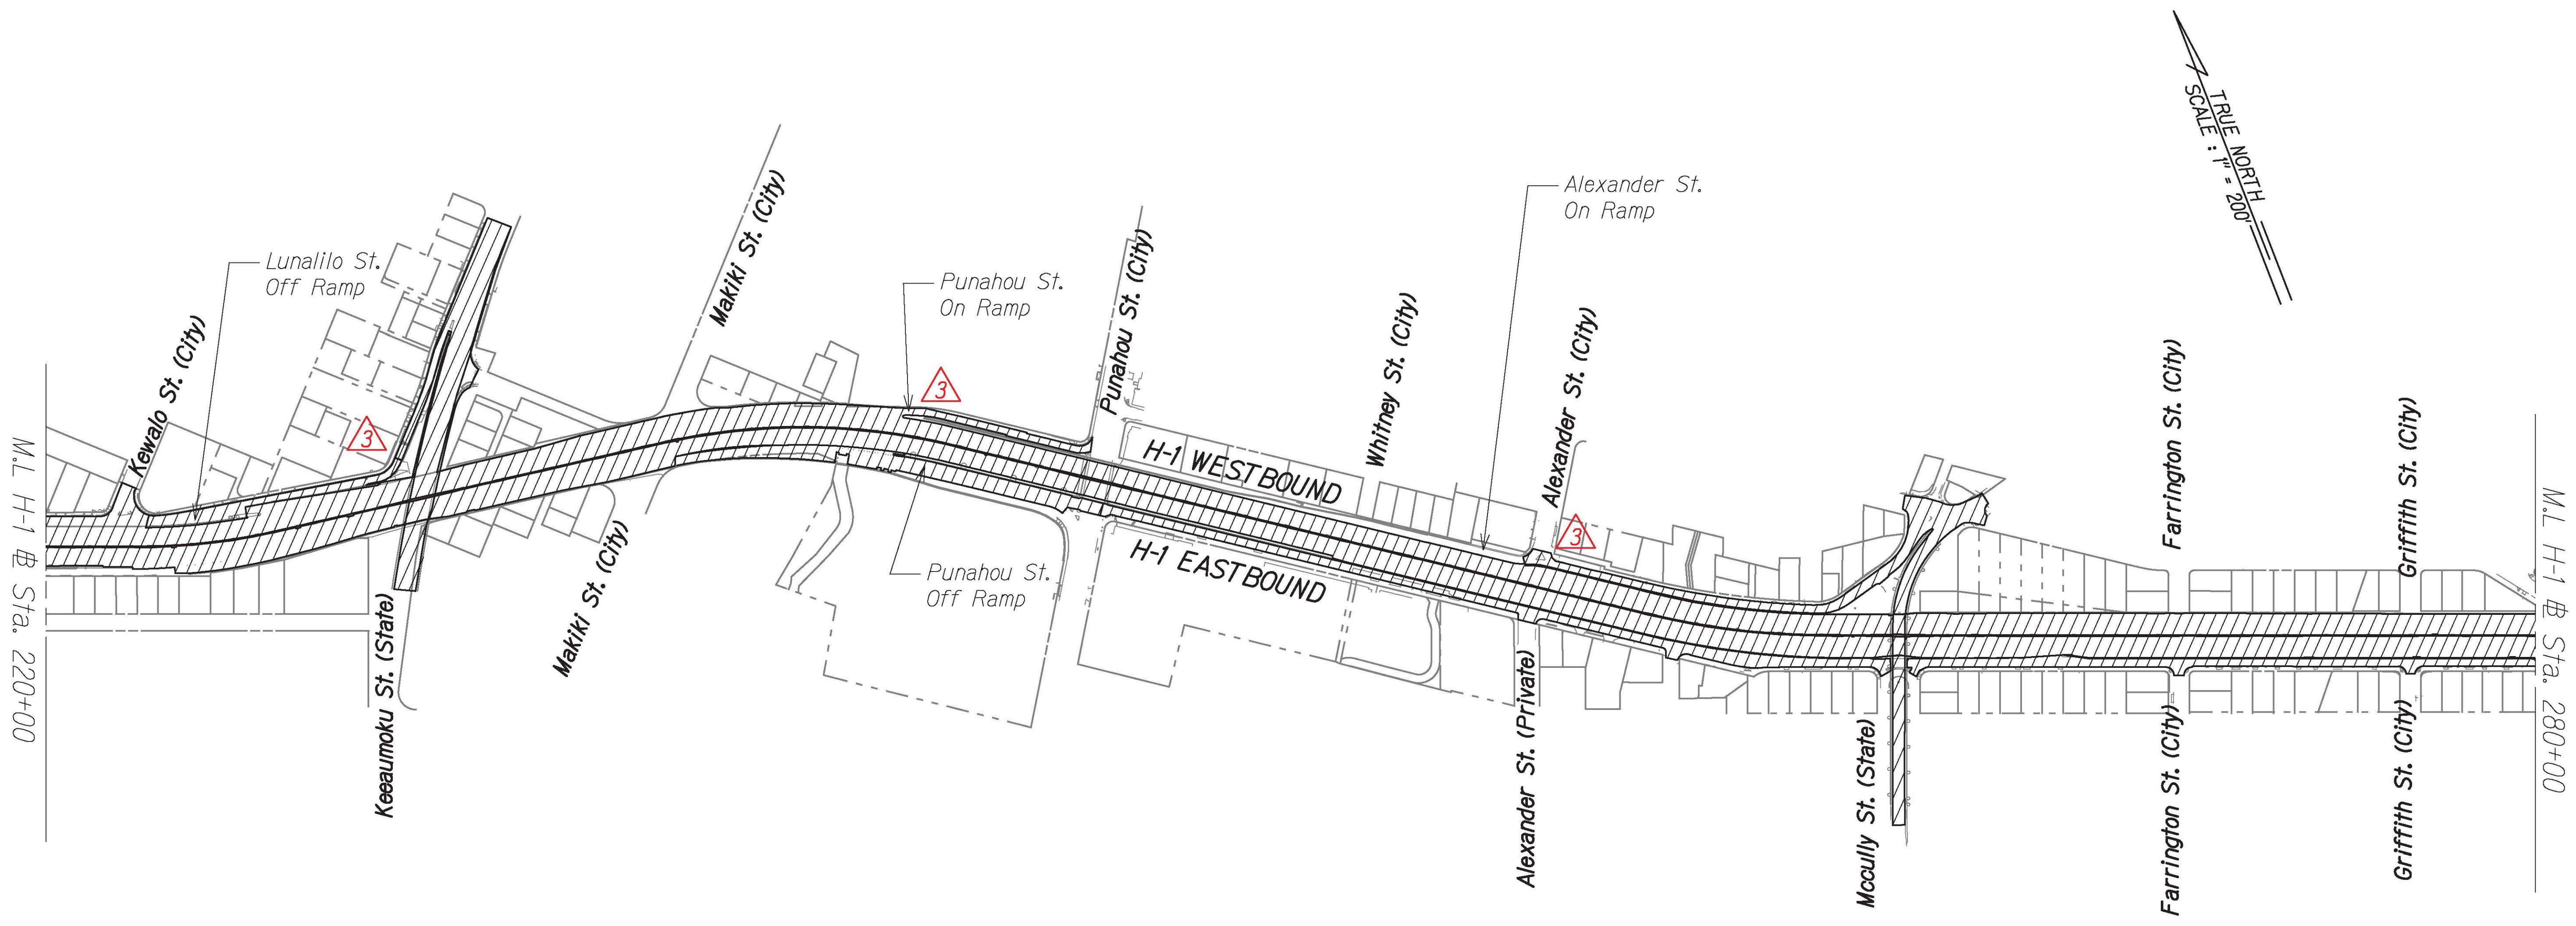


**LEGEND:**

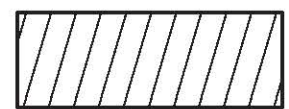
 General Resurfacing Limits



THIS WORK WAS PREPARED BY ME  
OR UNDER MY SUPERVISION

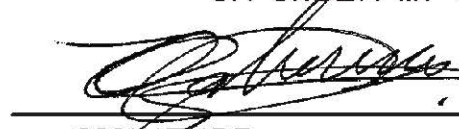 04/30/22


SIGNATURE EXPIRATION DATE  
OF THE LICENSE

7/9/21	 Revised resurfacing limits
DATE	REVISION
STATE OF HAWAII DEPARTMENT OF TRANSPORTATION HIGHWAYS DIVISION	
<b>GENERAL PLAN</b>	
<b>INTERSTATE ROUTE H-1 RESURFACING</b>	
<b>Miller Pedestrian Overpass to Kapiolani Interchange</b>	
<b>Federal-Aid Project No. NH-HI-1(279)</b>	
Scale: 1" = 200'	Date: August 2021
SHEET No. GP2 OF 3 SHEETS	

W:\\_CIVIL\_3D\_PROJECTS\2016\_2022\000 DOT-HWYS H1 RESURFACING - MILLER TO KAPITV\01 CIVIL DRAWINGS\GP2 GENERAL PLANDWG 7/9/2021 6:57 AM




FED. ROAD DIST. NO.	STATE	FED-AID PROJ. NO.	FISCAL YEAR	SHEET NO.	TOTAL SHEETS
HAWAII	HAW.	NH-HI-1(279)	2021	ADD. 55	304

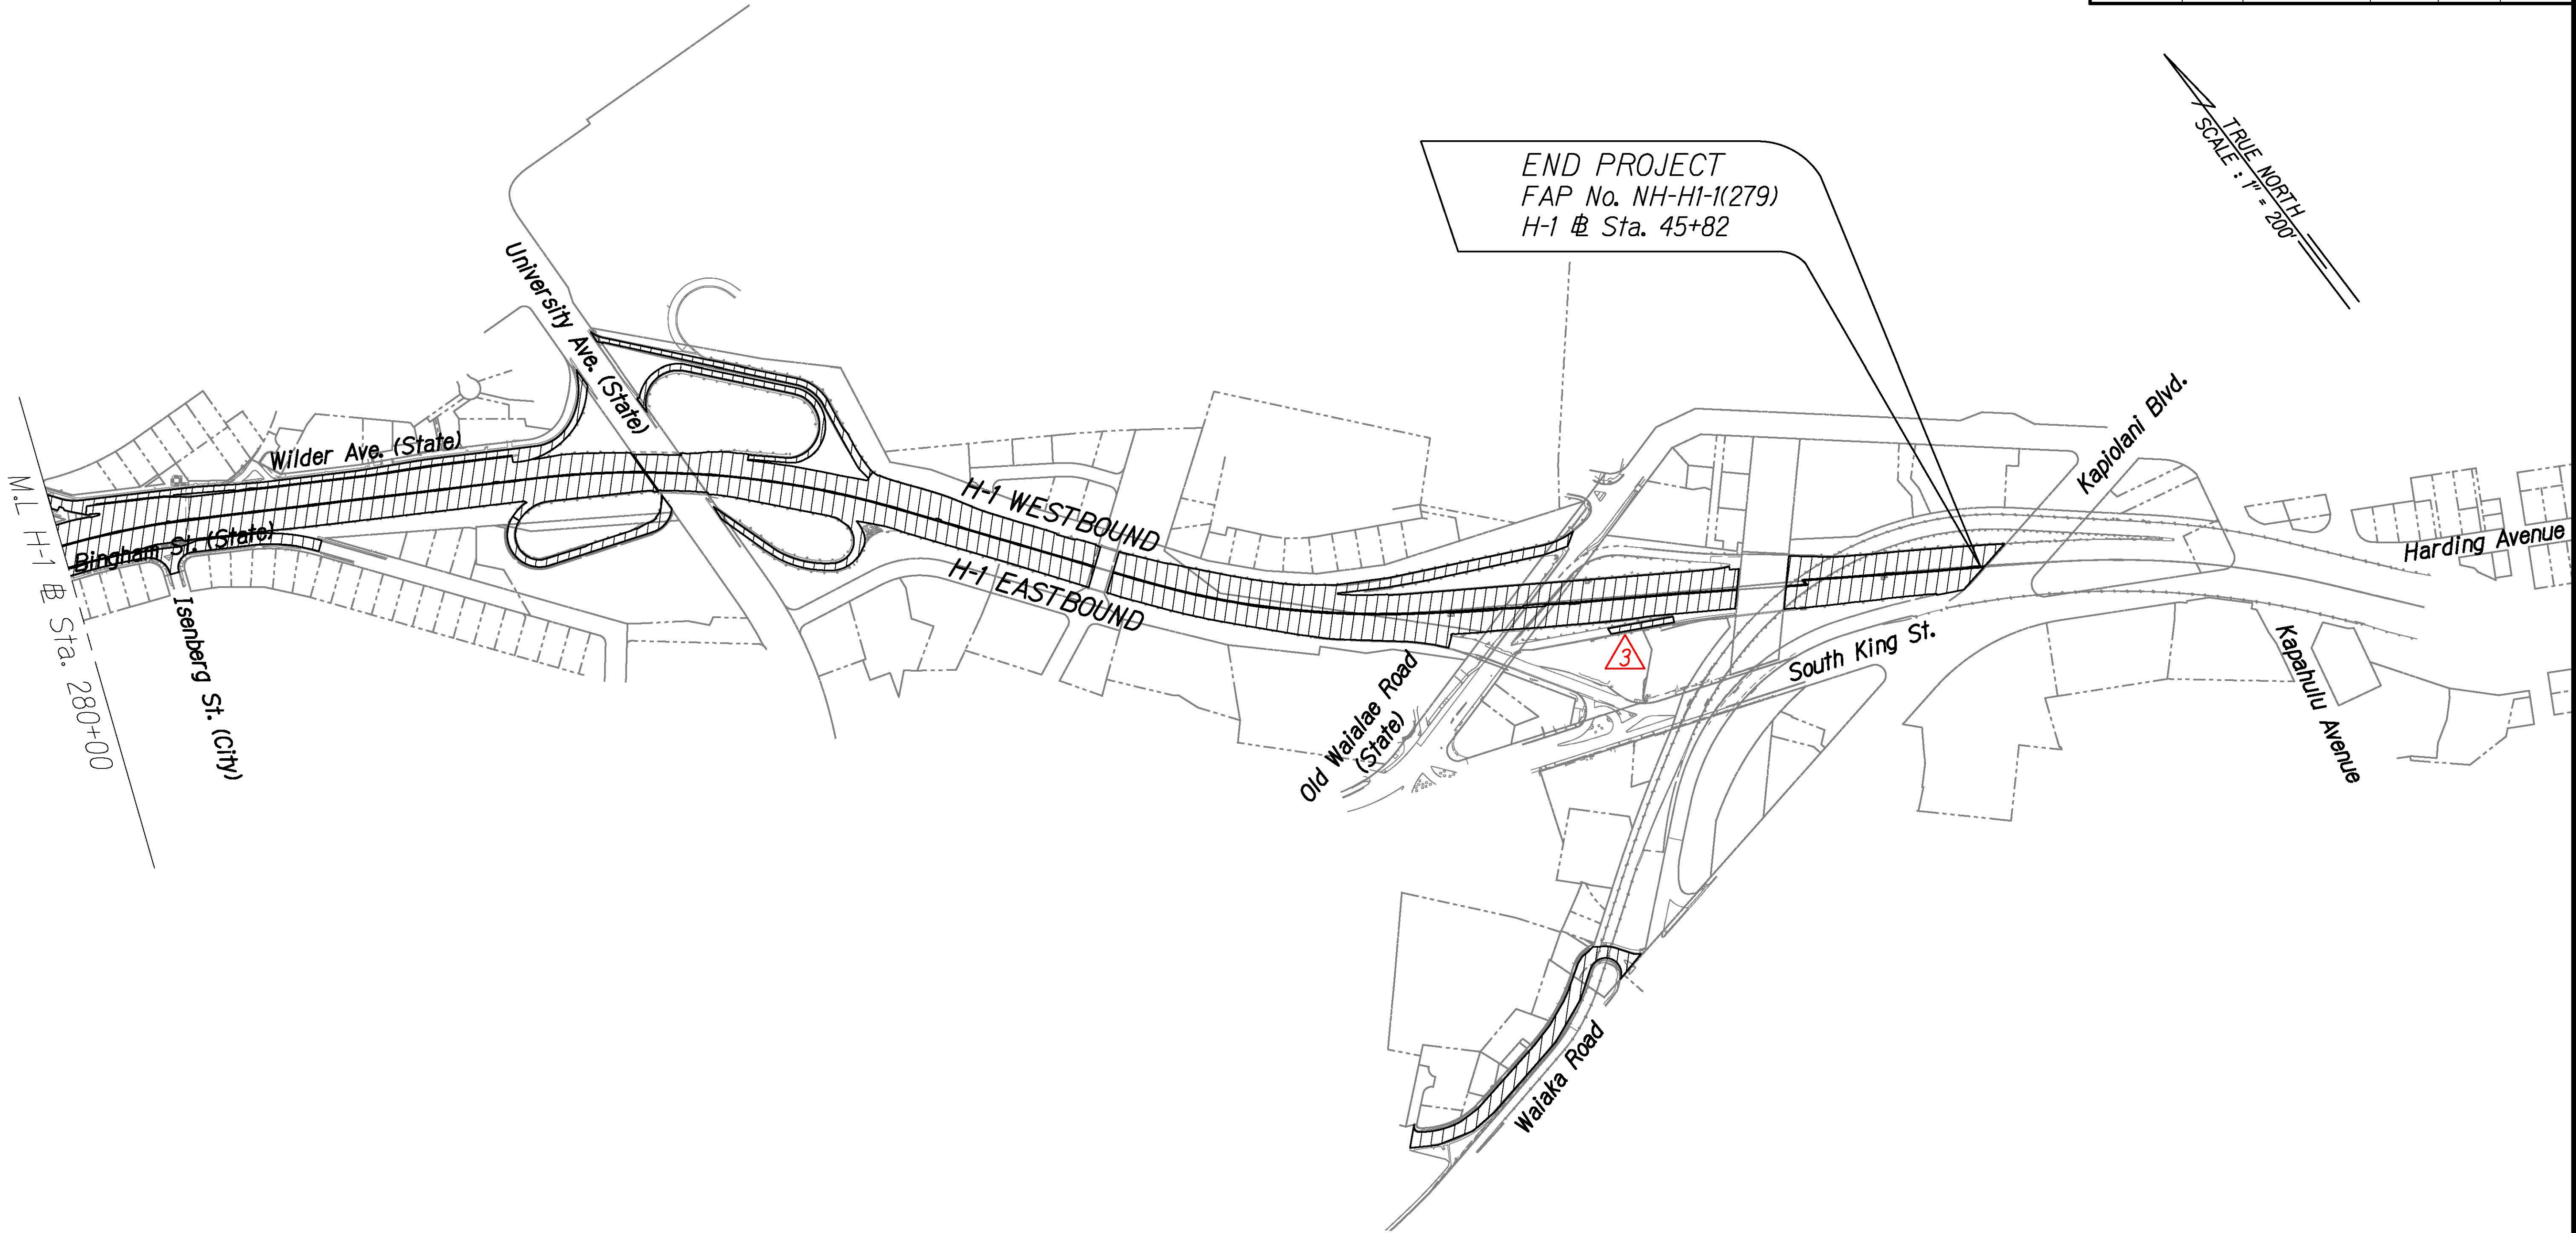


**LEGEND:**


General Resurfacing Limits

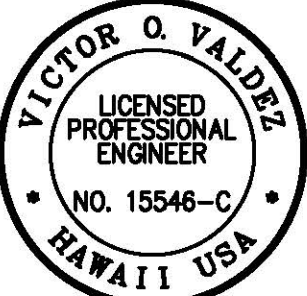

THIS WORK WAS PREPARED BY ME  
OR UNDER MY SUPERVISION

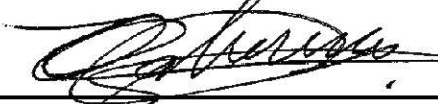  
SIGNATURE

04/30/22  
EXPIRATION DATE  
OF THE LICENSE

7/9/21	 Revised resurfacing limits
DATE	REVISION

STATE OF HAWAII  
DEPARTMENT OF TRANSPORTATION  
HIGHWAYS DIVISION

**GENERAL PLAN**

**INTERSTATE ROUTE H-1 RESURFACING**  
**Miller Pedestrian Overpass to Kapiolani Interchange**  
**Federal-Aid Project No. NH-HI-1(279)**

Scale: 1" = 200'      Date: August 2021

SHEET No. GP3 OF 3      SHEETS

G:\CIVIL\_3D PROJECTS\2016\_2022\000 DOT-HWYS H1 RESURFACING - MILLER TO KAPINITY\01 CIVIL DRAWINGS\GP3 GENERAL PLANDWG 7/9/2021 6:41 PM