


FED. ROAD DIST. NO.	STATE	FED.-AID PROJ. NO.	FISCAL YEAR	SHEET NO.	TOTAL SHEETS
HAWAII	HAW.	NH-HI-1(279)	2021	ADD. 15	304

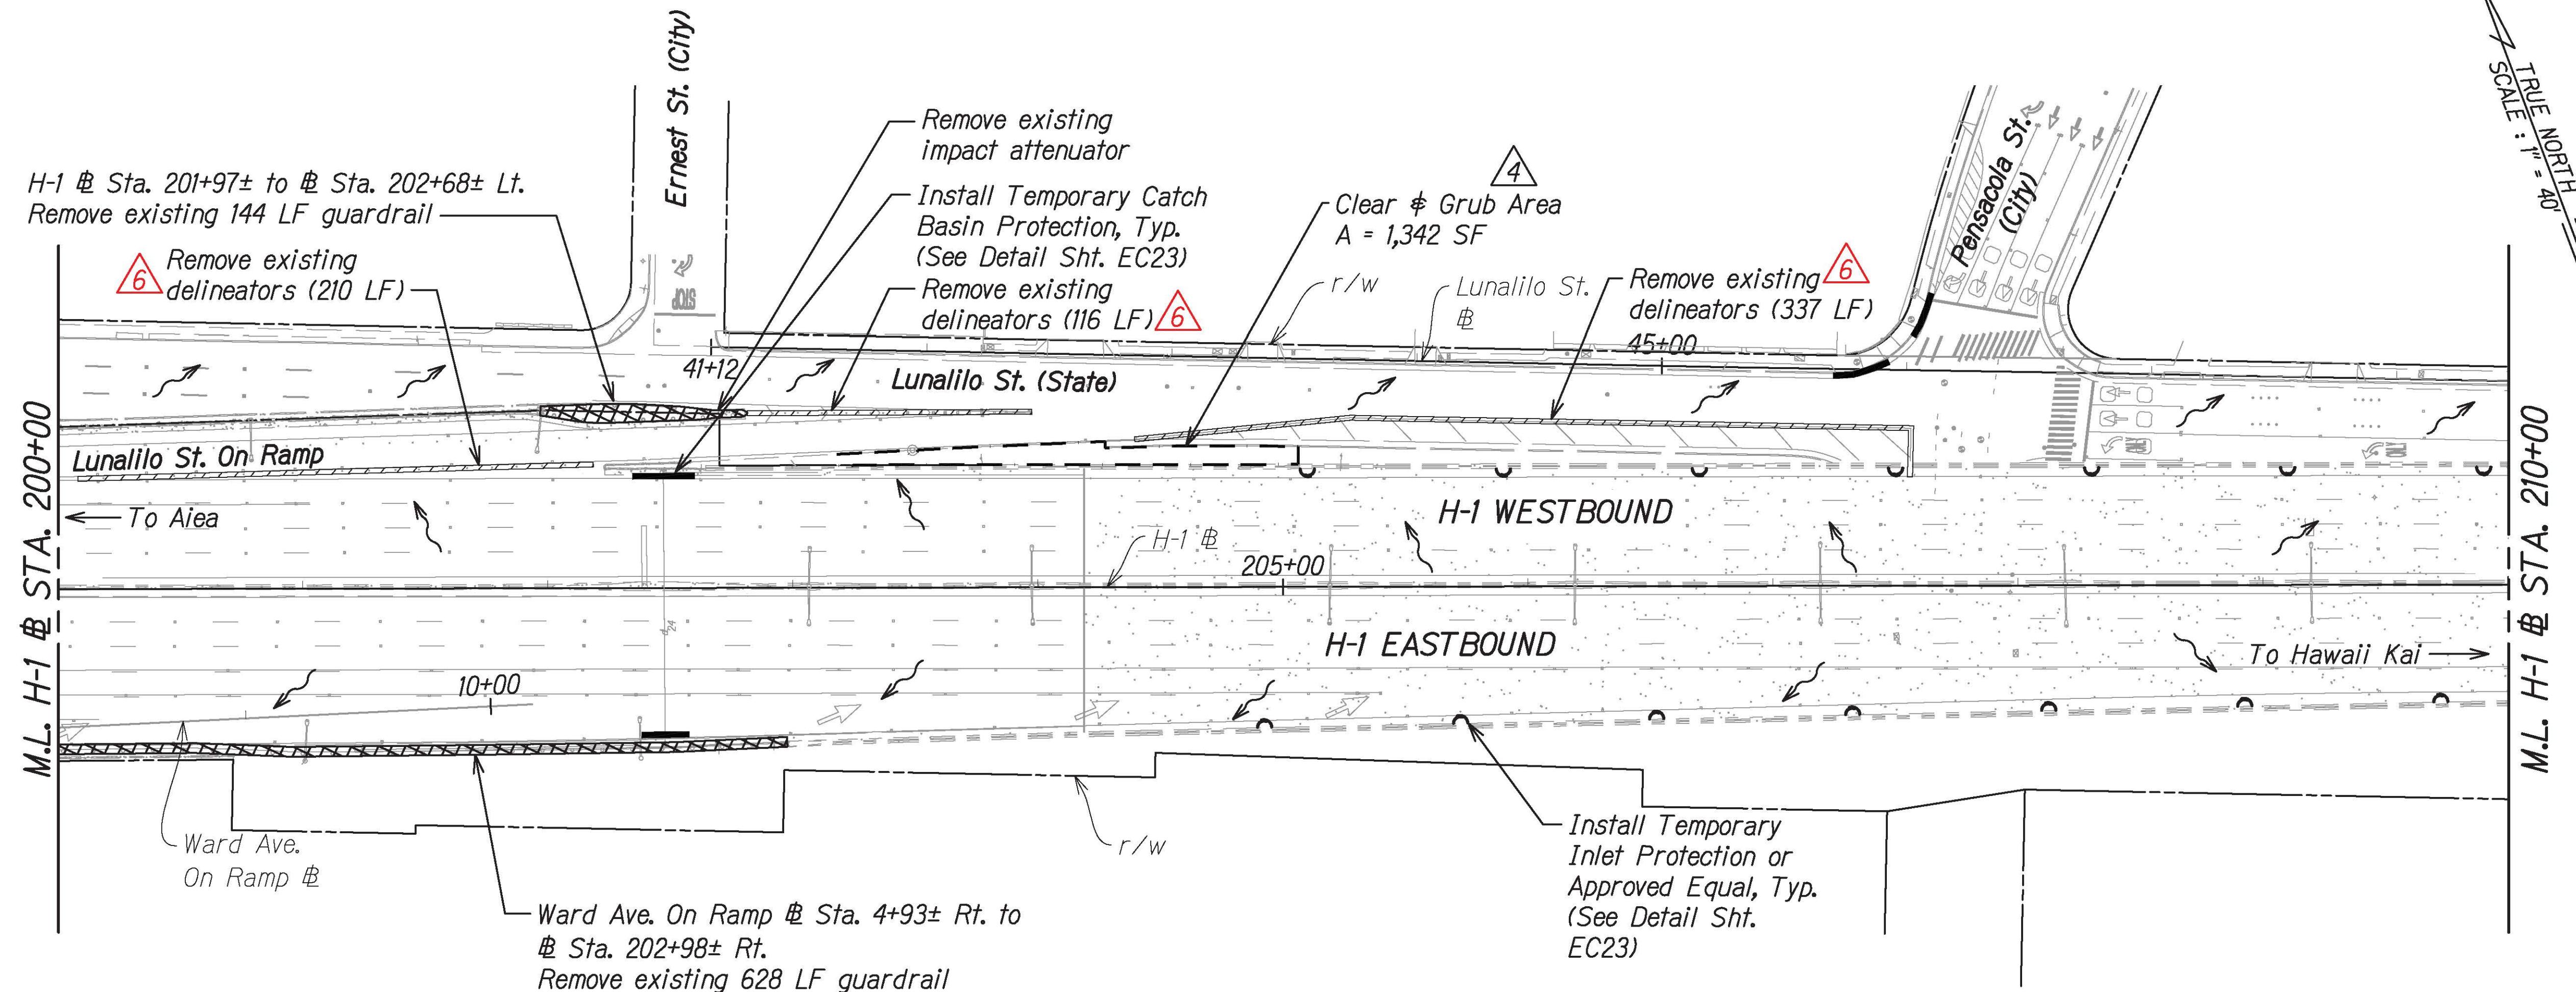

#### LEGEND:

- Catch Basin Protection
- ~~ Flow Arrow
- XXXX Snake Bags or Approved Equal
- Demolish Existing Guardrails or Impact Attenuator
- — — Limits of Clear & Grub 4
- Remove Existing Delineators 6

#### NOTES:

1. Sediment and Erosion Control BMP measures shown in the Contract Documents are minimum BMPs requirements and do not constitute an acceptable and/or complete Sediment and Erosion Control Plan. The Contractor shall incorporate additional BMPs based upon their means and methods considering site conditions and construction sequence in accordance with the Contract Documents including applicable permit document requirements. Cost shall be included in Pay Item 209.0100, Installation, Maintenance, Monitoring, and Removal of BMP.
2. The Contractor shall take proper precautions and make necessary measures to ensure compliance to all applicable but not limited to Federal, State, and HDOT guidelines.
3. Limits of milling and roadway pavement reconstructions, including on and off ramps are shown in the Roadway Plan R1 - R23.
4. Traffic sign relocations and any other sign-related works resulting from the proposed improvements are shown in the Pavement Marking and Signing Plans M2 - M24.
5. The Contractor shall only remove existing bushes and vegetation that may hinder construction work for this project related activities/phases and within the right-of-way. The Contractor shall be responsible to protect all open bare areas during all phases of construction to prevent erosion. Best Management Practices shall not be removed until final stabilization is complete for that phase. Bushes and vegetation shall be restored to pre-construction condition prior to final acceptance.

#### GRAPHIC SCALE:



40' 20' 0 40' 80'  
Scale: 1" = 40'

7/21/21	<span style="color:red">6</span> Added Removal of Existing Delineators
7/14/21	<span style="color:red">4</span> Added Clear & Grub Limits
DATE	REVISION
STATE OF HAWAII DEPARTMENT OF TRANSPORTATION HIGHWAYS DIVISION	
<b>DEMOLITION AND EROSION CONTROL</b>	
<b>INTERSTATE ROUTE H-1 RESURFACING</b>	
Miller Pedestrian Overpass to Kapiolani Interchange	
Federal-Aid Project No. NH-HI-1(279)	
Scale: 1" = 40'	
Date: August 2021	
SHEET No. EC4 OF 23 SHEETS	



THIS WORK WAS PREPARED BY ME  
OR UNDER MY SUPERVISION  
  
04/30/22  
SIGNATURE  
EXPIRATION DATE  
OF THE LICENSE

FED. ROAD DIST. NO.	STATE	FED-AID PROJ. NO.	FISCAL YEAR	SHEET NO.	TOTAL SHEETS
HAWAII	HAW.	NH-HI-1(279)	2021	ADD. 17	304

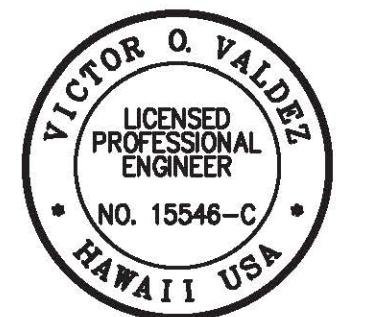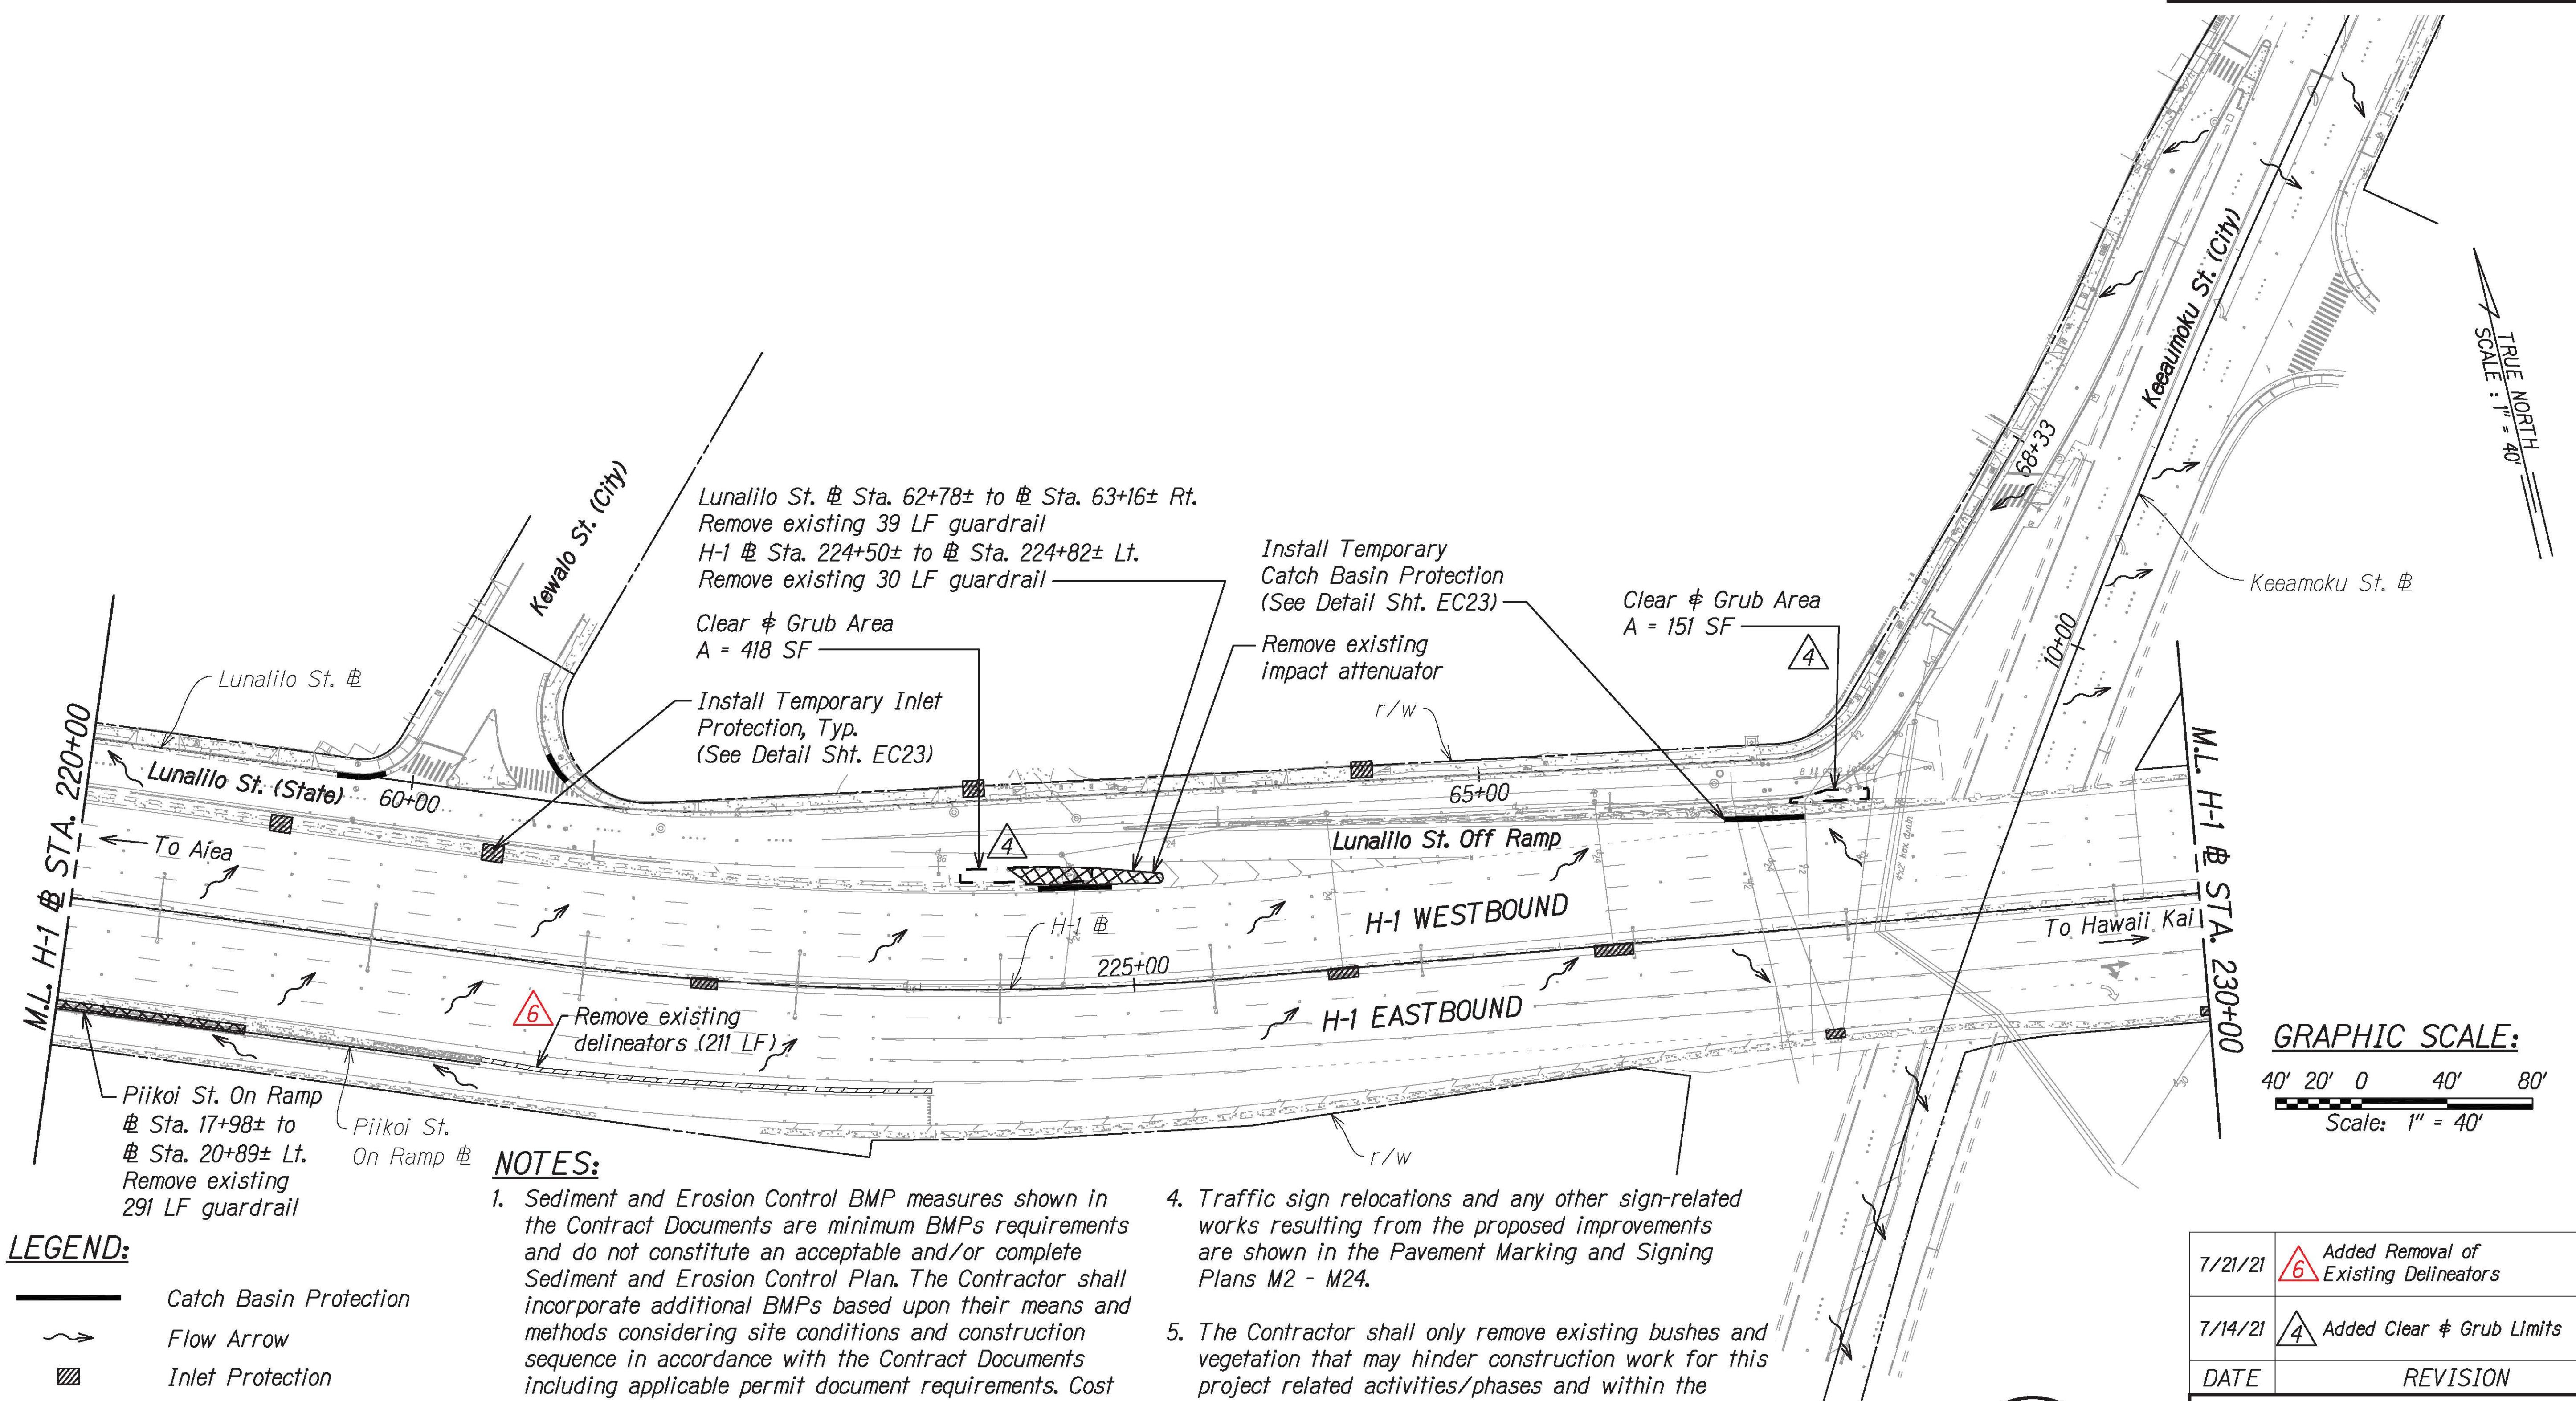


THIS WORK WAS PREPARED BY ME  
OR UNDER MY SUPERVISION


04/30/22  
SIGNATURE  
EXPIRATION DATE  
OF THE LICENSE

7/21/21	Added Removal of Existing Delineators
7/14/21	Added Clear & Grub Limits
DATE	REVISION
STATE OF HAWAII DEPARTMENT OF TRANSPORTATION HIGHWAYS DIVISION	
<b>DEMOLITION AND EROSION CONTROL</b>	
<b>INTERSTATE ROUTE H-1 RESURFACING</b>	
Miller Pedestrian Overpass to Kapiolani Interchange	
Federal-Aid Project No. NH-HI-1(279)	
Scale: 1" = 40'	
Date: August 2021	
SHEET NO. EC6 OF 23 SHEETS	

FED. ROAD DIST. NO.	STATE	FED.-AID PROJ. NO.	FISCAL YEAR	HEET NO.	TOTAL SHEETS
HAWAII	HAW.	NH-HI-1(279)	2021	ADD. 18	304

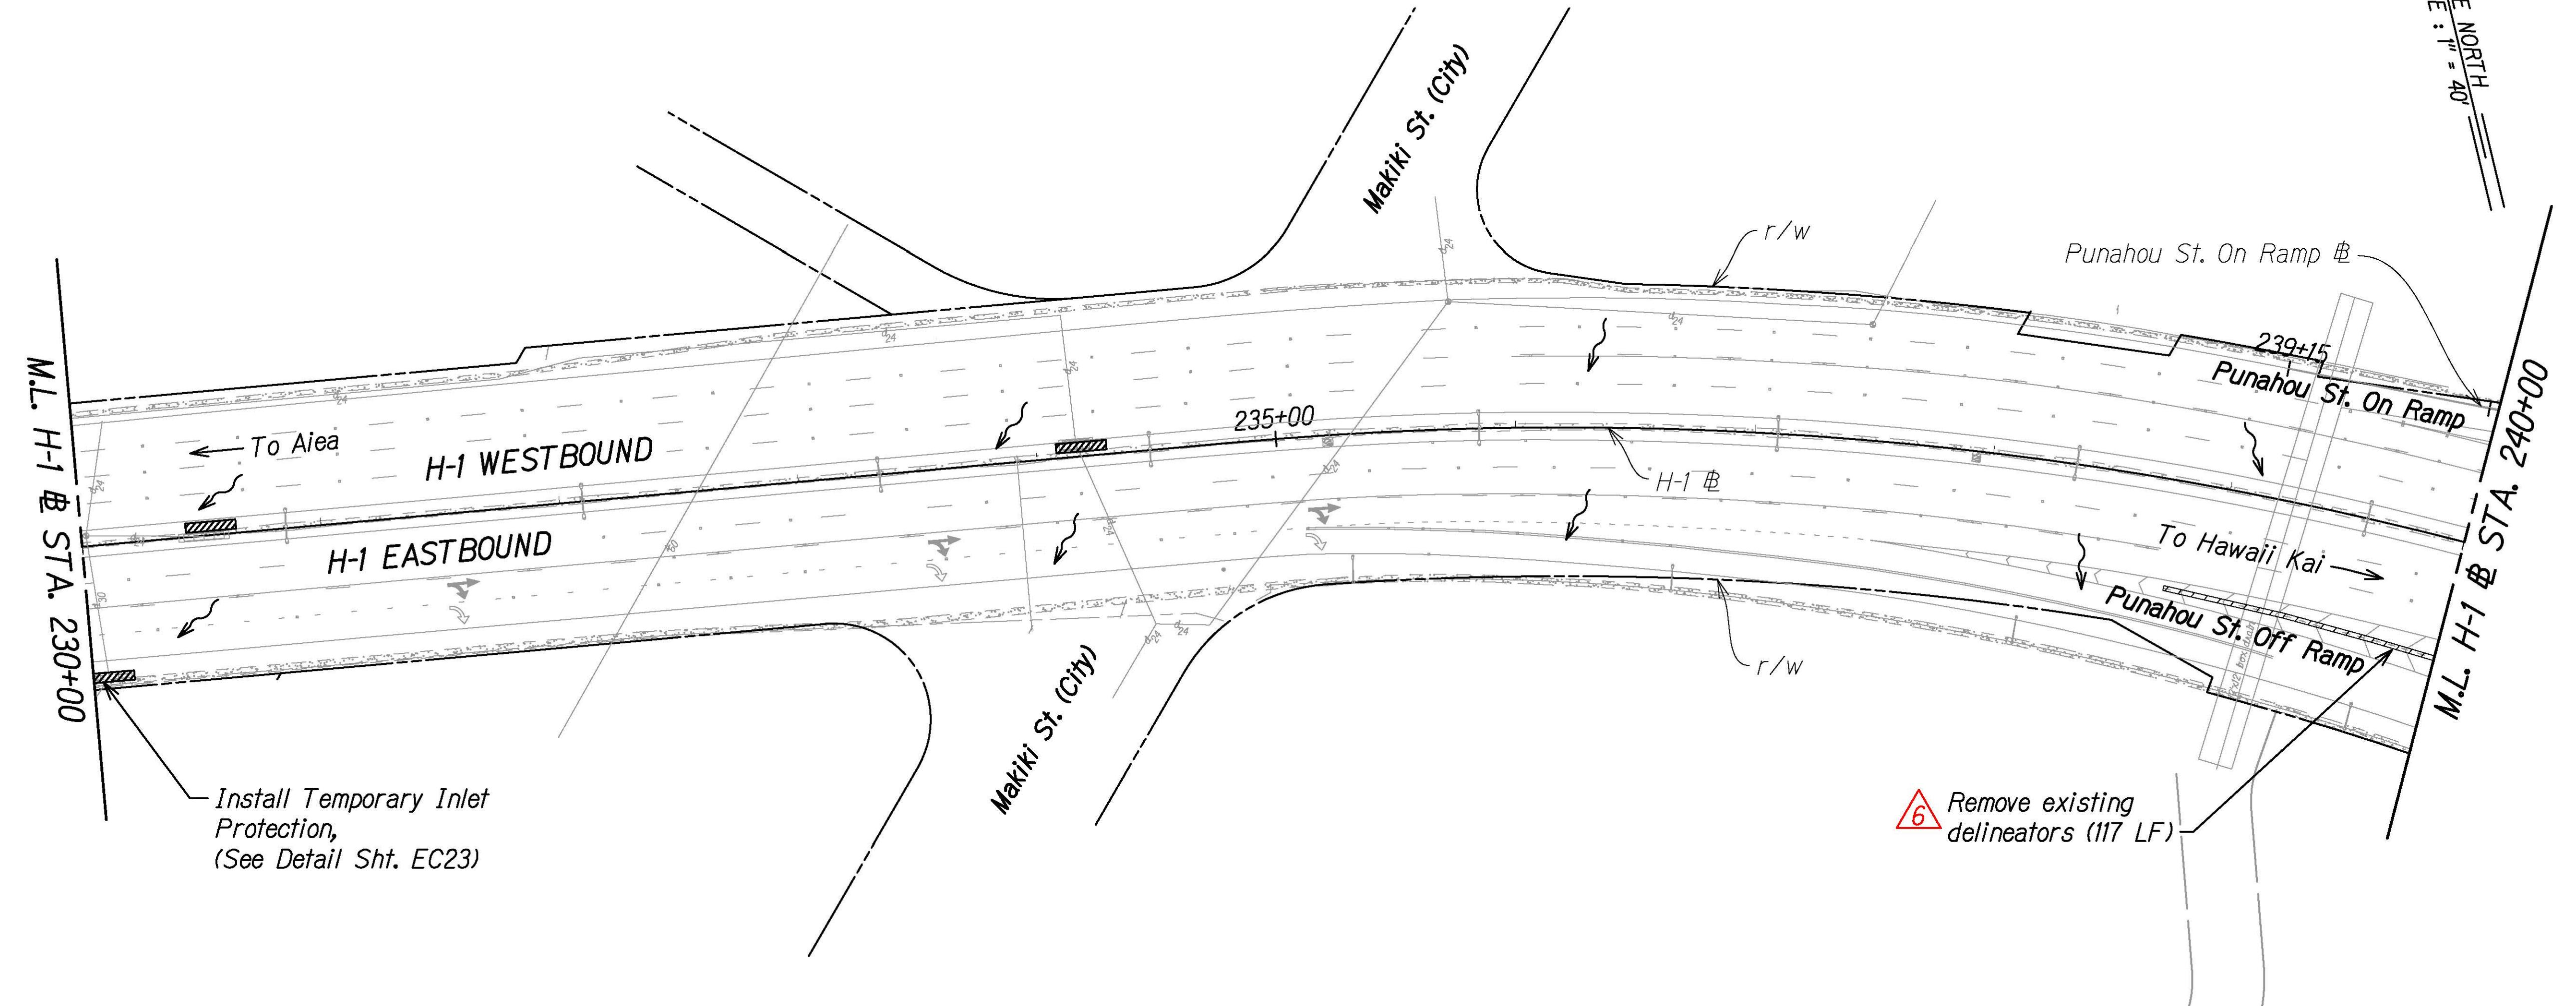


#### LEGEND:

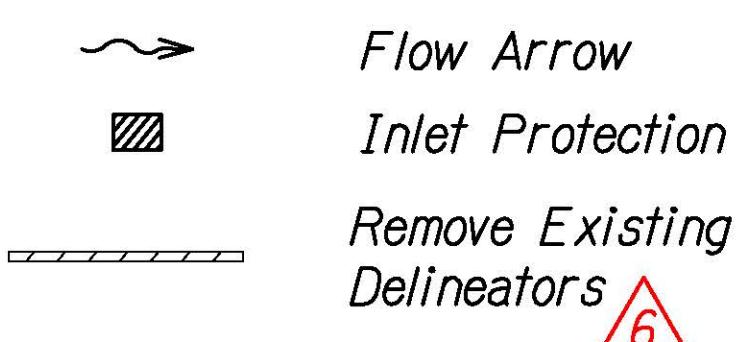

#### NOTES:

1. Sediment and Erosion Control BMP measures shown in the Contract Documents are minimum BMPs requirements and do not constitute an acceptable and/or complete Sediment and Erosion Control Plan. The Contractor shall incorporate additional BMPs based upon their means and methods considering site conditions and construction sequence in accordance with the Contract Documents including applicable permit document requirements. Cost shall be included in Pay Item 209.0100, Installation, Maintenance, Monitoring, and Removal of BMP.
2. The Contractor shall take proper precautions and make necessary measures to ensure compliance to all applicable but not limited to Federal, State, and HDOT guidelines.
3. Limits of milling and roadway pavement reconstructions, including on and off ramps are shown in the Roadway Plan R1 - R23.
4. Traffic sign relocations and any other sign-related works resulting from the proposed improvements are shown in the Pavement Marking and Signing Plans M2 - M24.
5. The Contractor shall only remove existing bushes and vegetation that may hinder construction work for this project related activities/phases and within the right-of-way. The Contractor shall be responsible to protect all open bare areas during all phases of construction to prevent erosion. Best Management Practices shall not be removed until final stabilization is complete for that phase. Bushes and vegetation shall be restored to pre-construction condition prior to final acceptance.

#### GRAPHIC SCALE:

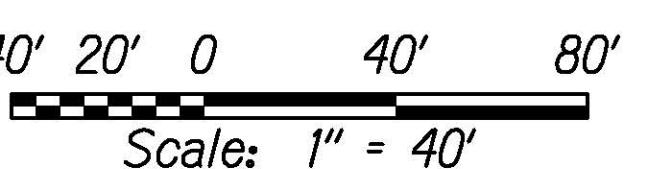

7/21/21	Added Removal of Existing Delineators ⑥
DATE	REVISION

STATE OF HAWAII  
DEPARTMENT OF TRANSPORTATION  
HIGHWAYS DIVISION

<b>DEMOLITION AND EROSION CONTROL</b>	
INTERSTATE ROUTE H-1 RESURFACING	
Miller Pedestrian Overpass to Kapiolani Interchange	
Federal-Aid Project No. NH-HI-1(279)	
Scale: 1" = 40'	
Date: August 2021	
SIGNATURE	04/30/22
EXPIRATION DATE OF THE LICENSE	
SHEET No. EC7 OF 23 SHEETS	




THIS WORK WAS PREPARED BY ME  
OR UNDER MY SUPERVISION

04/30/22  
SIGNATURE  
EXPIRATION DATE OF THE LICENSE  
Scale: 1" = 40'  
Date: August 2021

FED. ROAD DIST. NO.	STATE	FED.-AID PROJ. NO.	FISCAL YEAR	SHEET NO.	TOTAL SHEETS
HAWAII	HAW.	NH-HI-1(279)	2021	ADD. 19	304

TRUE NORTH  
SCALE: 1" = 40'

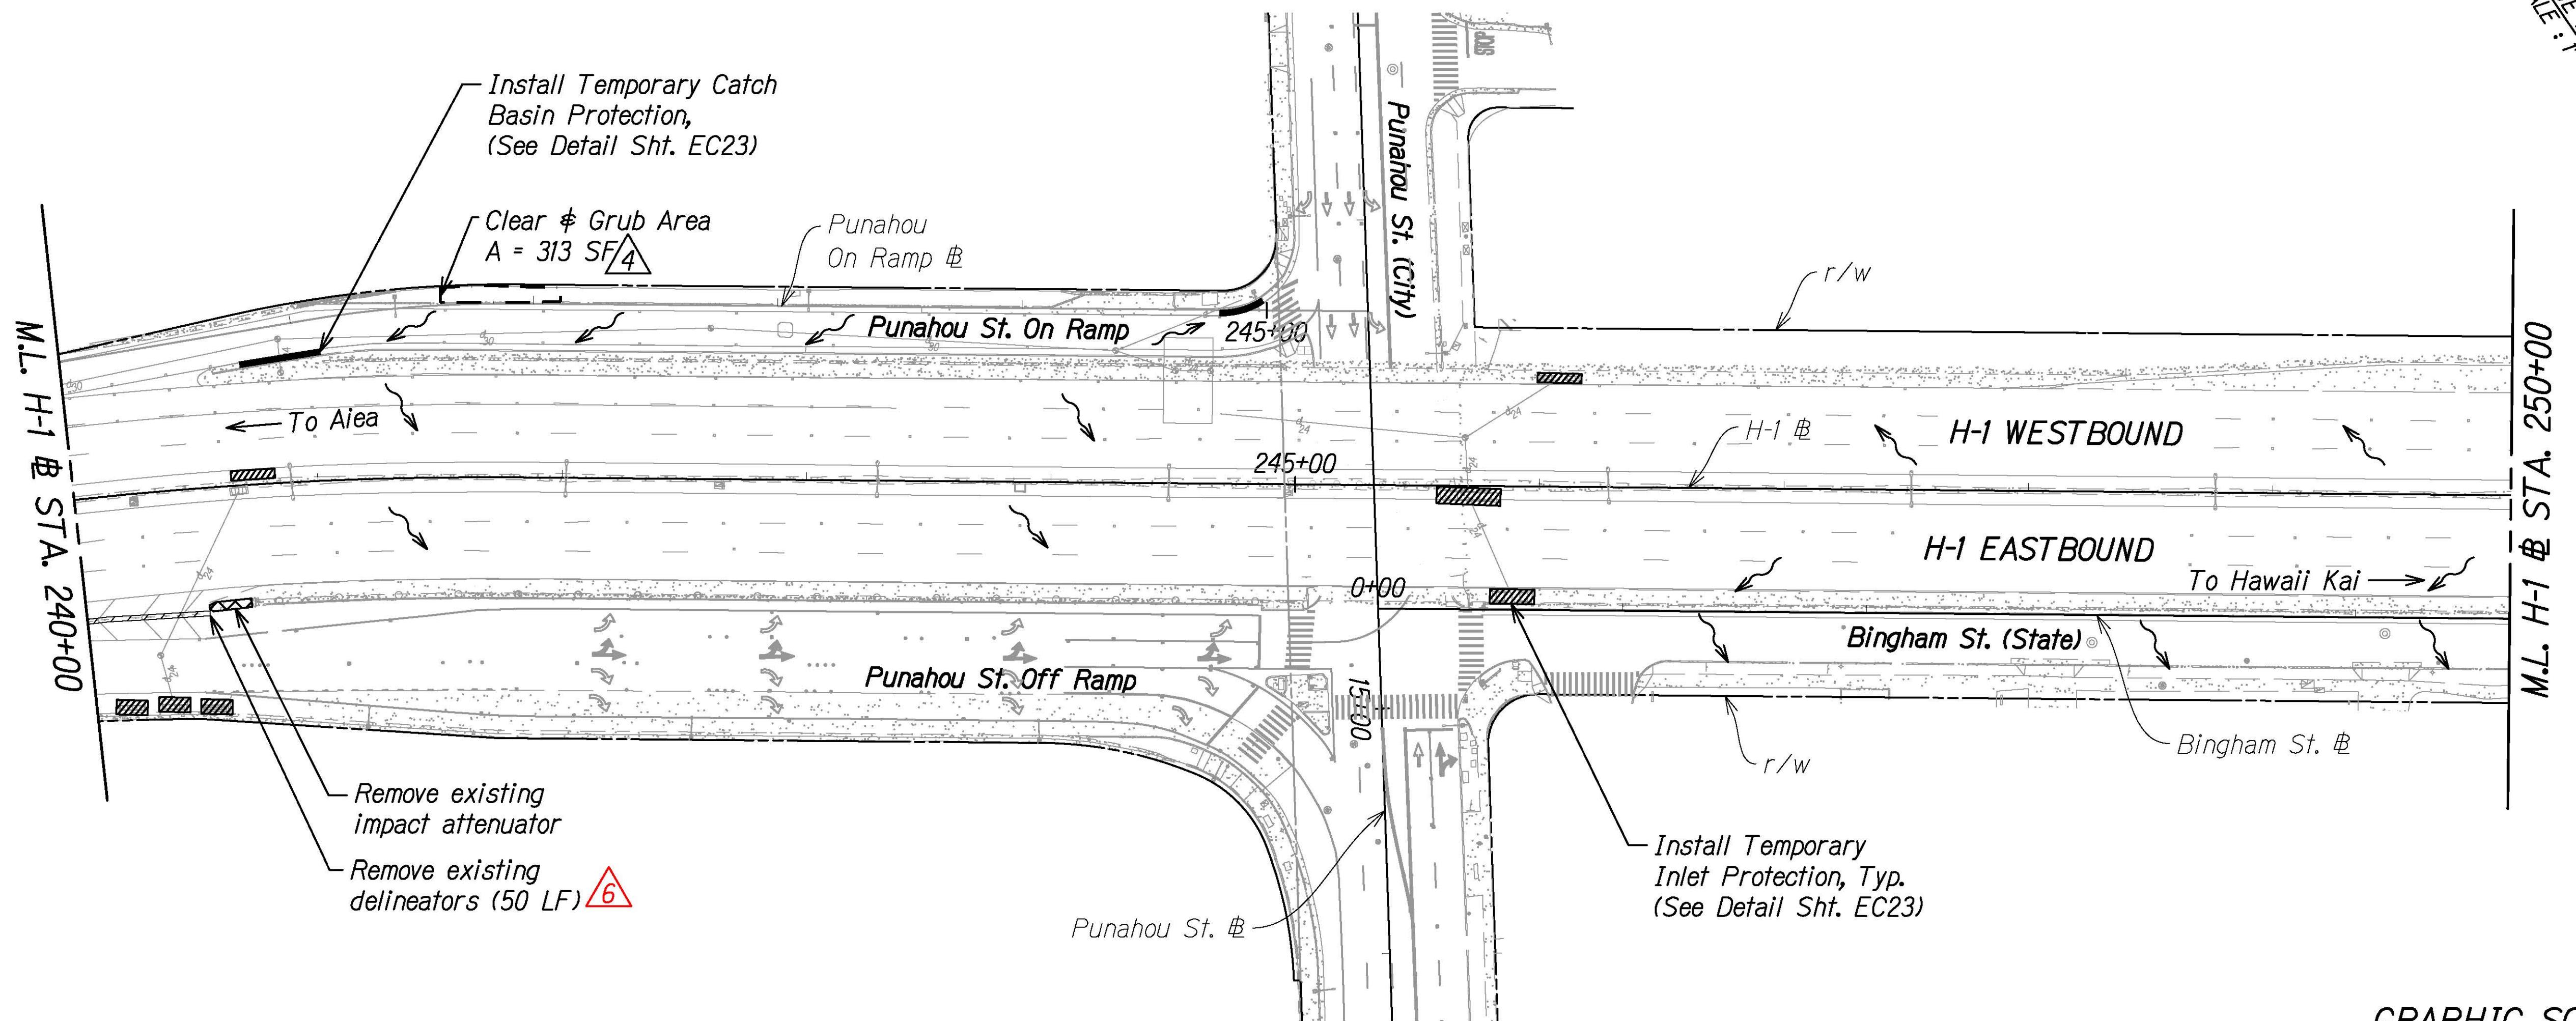

#### GRAPHIC SCALE:


40' 20' 0 40' 80'  
Scale: 1" = 40'

#### LEGEND:

- Catch Basin Protection
- ~~> Flow Arrow
- Inlet Protection
- XXXXX Remove Impact Attenuator
- - - Limits of Clear & Grub ④
- ~~~~ Remove Existing Delineators ⑥

#### NOTES:

1. Sediment and Erosion Control BMP measures shown in the Contract Documents are minimum BMPs requirements and do not constitute an acceptable and/or complete Sediment and Erosion Control Plan. The Contractor shall incorporate additional BMPs based upon their means and methods considering site conditions and construction sequence in accordance with the Contract Documents including applicable permit document requirements. Cost shall be included in Pay Item 209.0100, Installation, Maintenance, Monitoring, and Removal of BMP.
2. The Contractor shall take proper precautions and make necessary measures to ensure compliance to all applicable but not limited to Federal, State, and HDOT guidelines.
3. Limits of milling and roadway pavement reconstructions, including on and off ramps are shown in the Roadway Plan R1 - R23.
4. Traffic sign relocations and any other sign-related works resulting from the proposed improvements are shown in the Pavement Marking and Signing Plans M2 - M24.
5. The Contractor shall only remove existing bushes and vegetation that may hinder construction work for this project related activities/phases and within the right-of-way. The Contractor shall be responsible to protect all open bare areas during all phases of construction to prevent erosion. Best Management Practices shall not be removed until final stabilization is complete for that phase. Bushes and vegetation shall be restored to pre-construction condition prior to final acceptance.

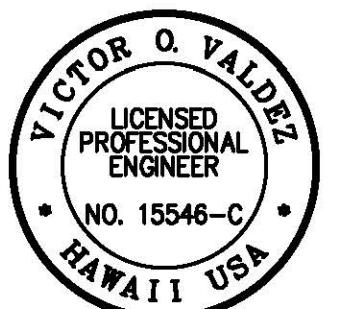

THIS WORK WAS PREPARED BY ME  
OR UNDER MY SUPERVISION

*[Signature]* 04/30/22  
SIGNATURE EXPIRATION DATE  
OF THE LICENSE

7/21/21	⑥ Added Removal of Existing Delineators
7/14/21	④ Added Clear & Grub Limits
DATE	REVISION

STATE OF HAWAII  
DEPARTMENT OF TRANSPORTATION  
HIGHWAYS DIVISION

DEMOLITION AND EROSION CONTROL	
<u>INTERSTATE ROUTE H-1 RESURFACING</u>	
<u>Miller Pedestrian Overpass to Kapiolani Interchange</u>	
Federal-Aid Project No. NH-HI-1(279)	Date: August 2021
Scale: 1" = 40'	
SHEET No. EC8 OF 23 SHEETS	

FED. ROAD DIST. NO.	STATE	FED.-AID PROJ. NO.	FISCAL YEAR	HEET NO.	TOTAL SHEETS
HAWAII	HAW.	NH-HI-1(279)	2021	ADD. 24	304

TRUE NORTH SCALE: 1" = 40'


Clear & Grub Area  
A = 628 SF △6

Install Temporary Inlet Protection, Typ.  
(See Detail Sht. EC23)

Remove existing delineators (227 LF) △6

M.L. H-1 @ STA. 20+00

GRAPHIC SCALE:  
40' 20' 0 40' 80'  
Scale: 1" = 40'

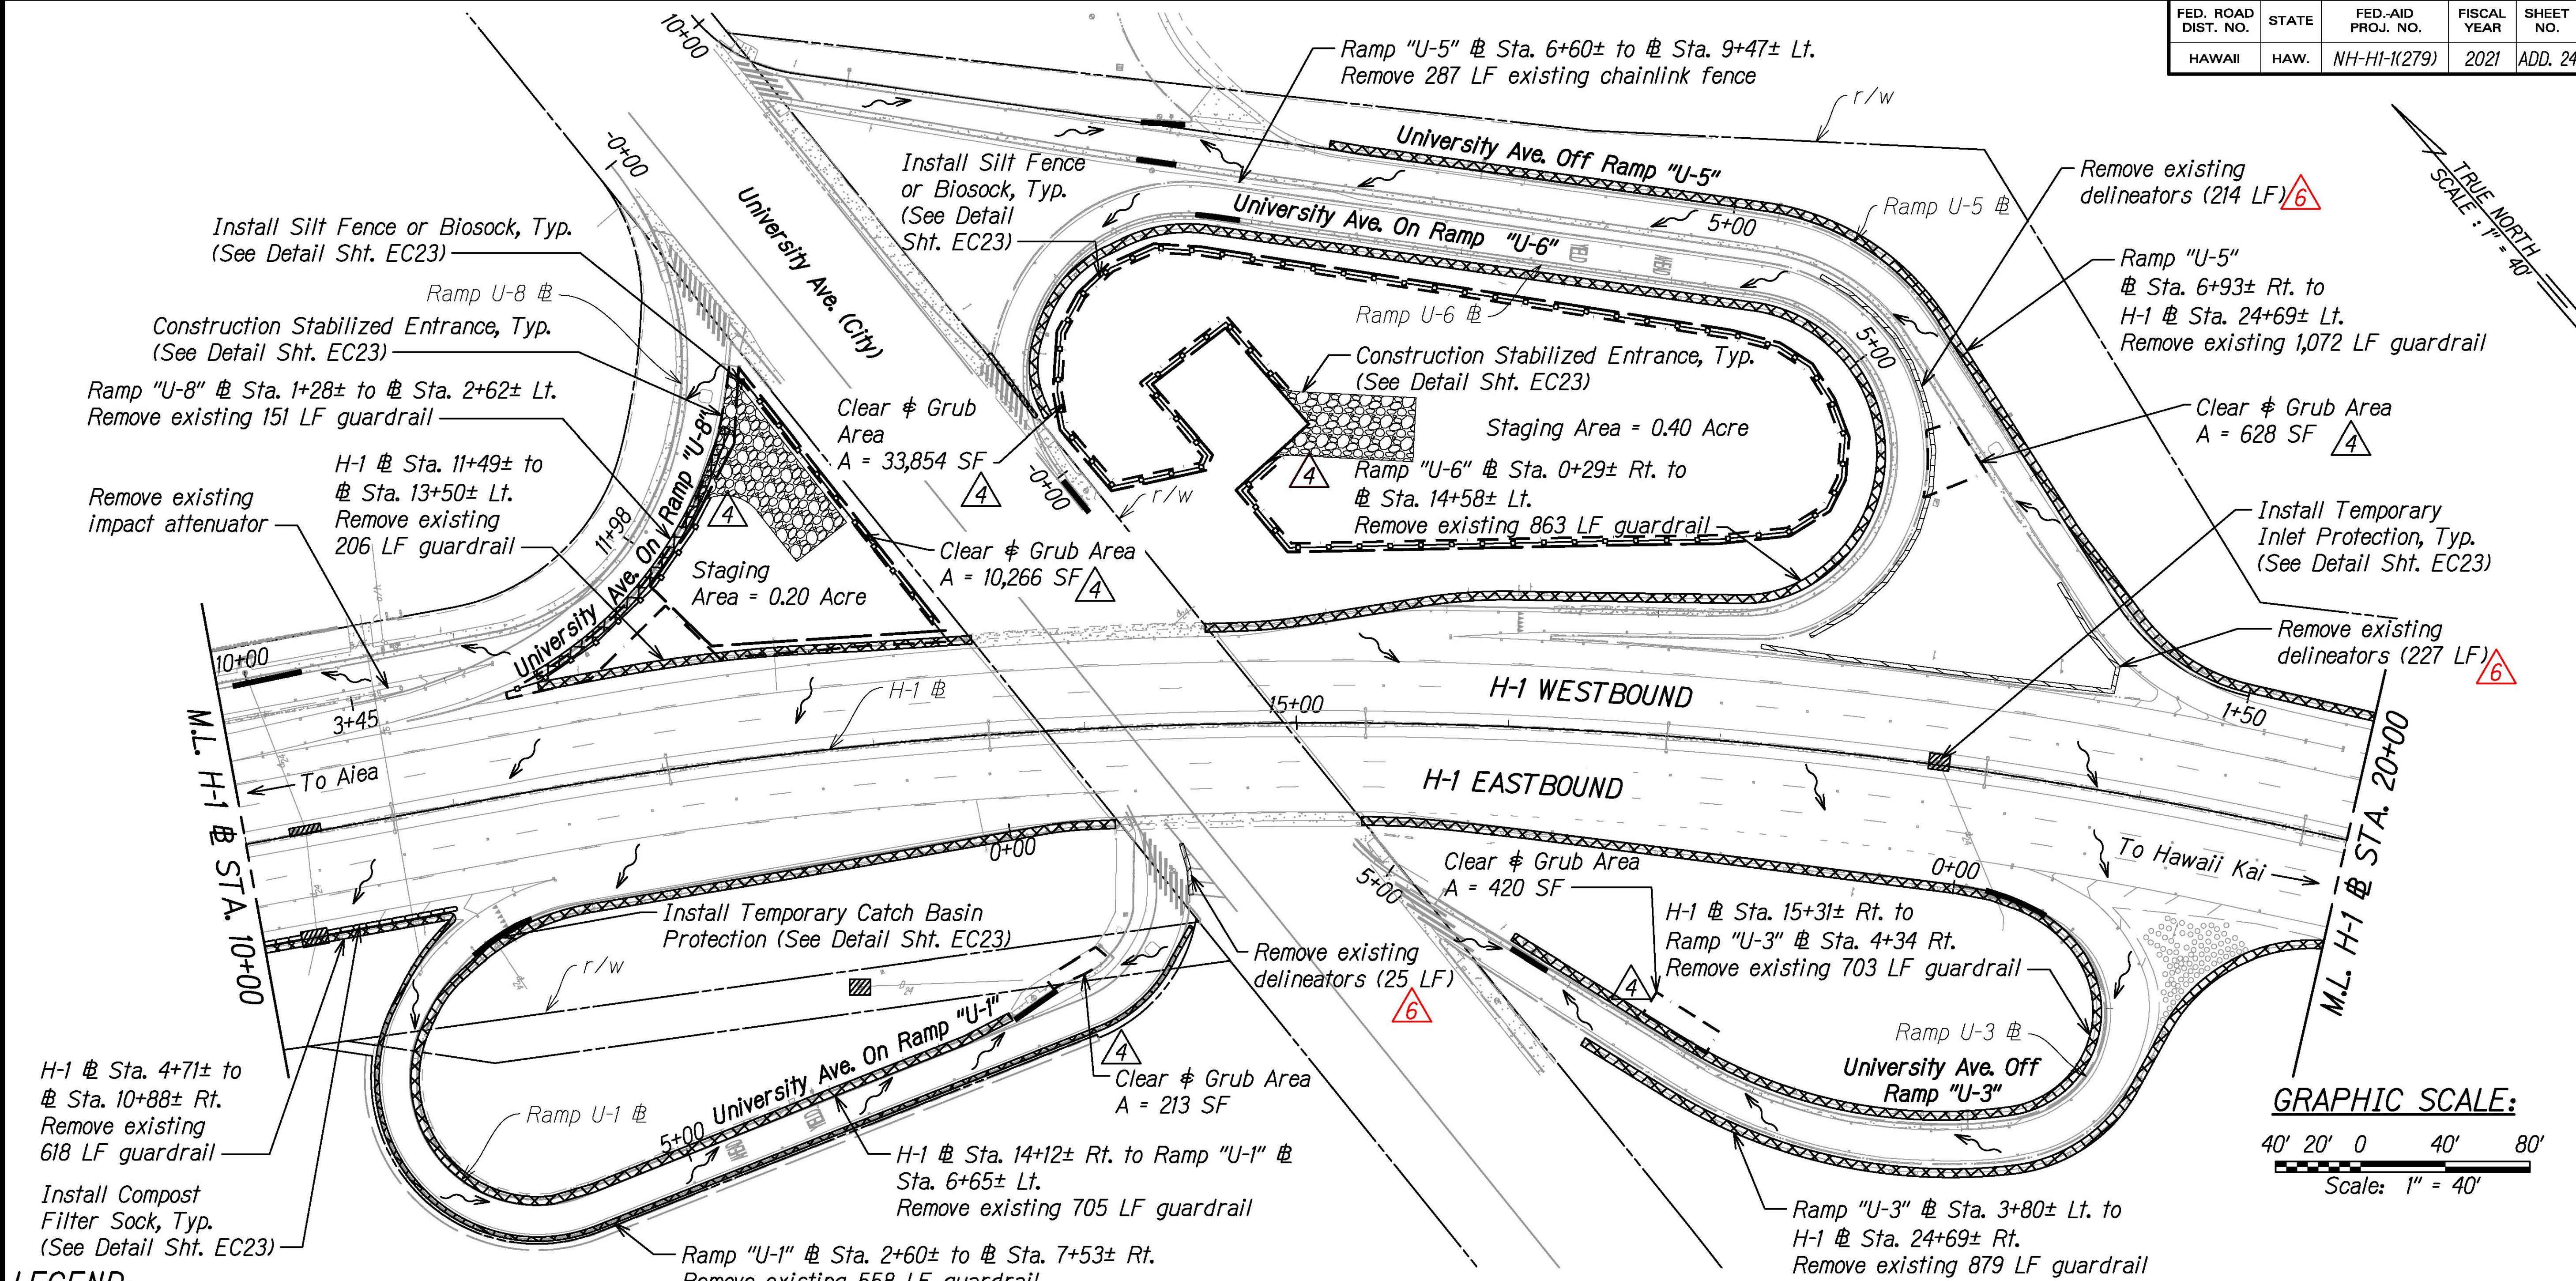

7/21/21	Added Removal of Existing Delineators <span style="color:red;">△6</span>
7/14/21	Added Clear & Grub Limits, Revised Construction Entrances & Silt Fence <span style="color:red;">△4</span>

DATE	REVISION
------	----------



THIS WORK WAS PREPARED BY ME OR UNDER MY SUPERVISION

04/30/22  
SIGNATURE

EXPIRATION DATE OF THE LICENSE

STATE OF HAWAII  
DEPARTMENT OF TRANSPORTATION  
HIGHWAYS DIVISION

### DEMOLITION AND EROSION CONTROL

INTERSTATE ROUTE H-1 RESURFACING


Miller Pedestrian Overpass to Kapiolani Interchange

Federal-Aid Project No. NH-HI-1(279)

Scale: 1" = 40' Date: August 2021

SHEET No. EC13 OF 23 SHEETS

FED. ROAD DIST. NO.	STATE	FED.-AID PROJ. NO.	FISCAL YEAR	SHEET NO.	TOTAL SHEETS
HAWAII	HAW.	NH-HI-1(279)	2021	ADD. 61	304

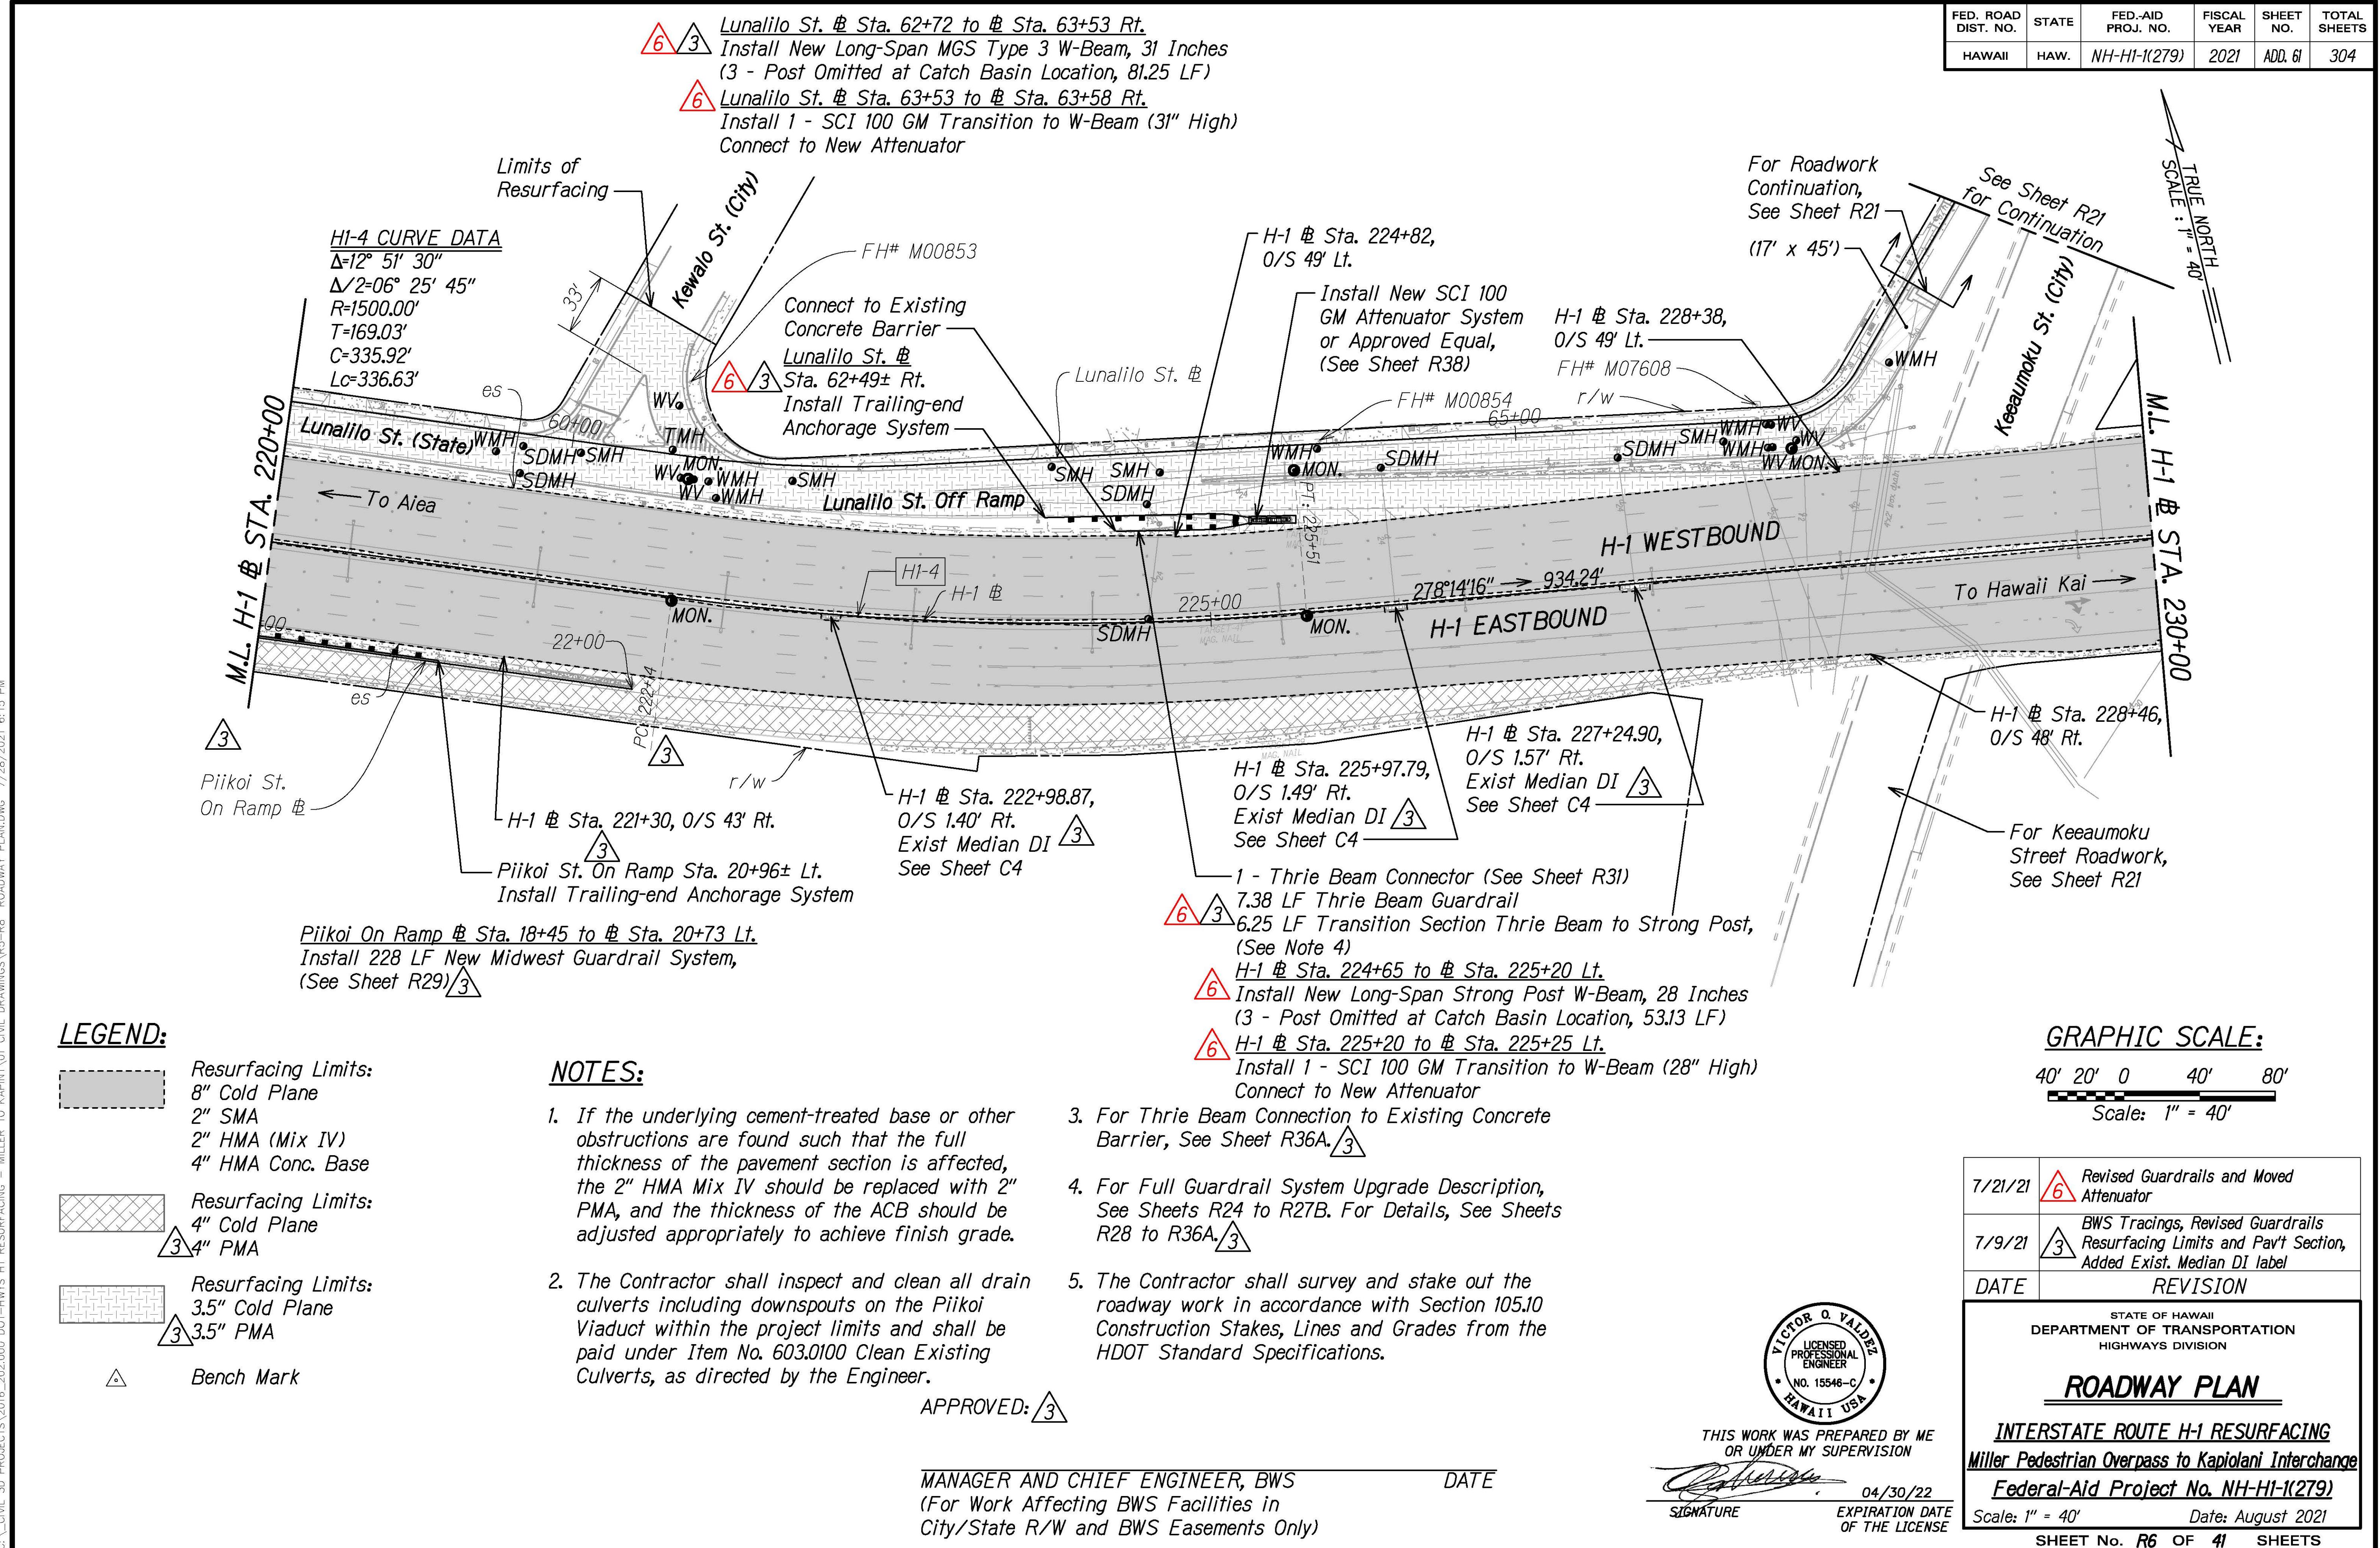

7/21/21	Revised Guardrails and Moved Attenuator
7/9/21	BWS Tracings, Revised Guardrails Resurfacing Limits and Pav't Section, Added Exist. Median DI label
DATE	REVISION

STATE OF HAWAII  
DEPARTMENT OF TRANSPORTATION  
HIGHWAYS DIVISION

**ROADWAY PLAN**

**INTERSTATE ROUTE H-1 RESURFACING**  
Miller Pedestrian Overpass to Kapiolani Interchange

**Federal-Aid Project No. NH-HI-1(279)**

**SIGNATURE:** [Signature]

**EXPIRATION DATE OF THE LICENSE:** 04/30/22

**Scale: 1" = 40'**


**Date: August 2021**

**SHEET NO. R6 OF 41 SHEETS**

FED. ROAD DIST. NO.	STATE	FED.-AID PROJ. NO.	FISCAL YEAR	HEET NO.	TOTAL SHEETS
HAWAII	HAW.	NH-HI-1(279)	2021	ADD. 67	304

TRUE SCALE:  
1" = 40'


M.L. H-1 STA. 10+00

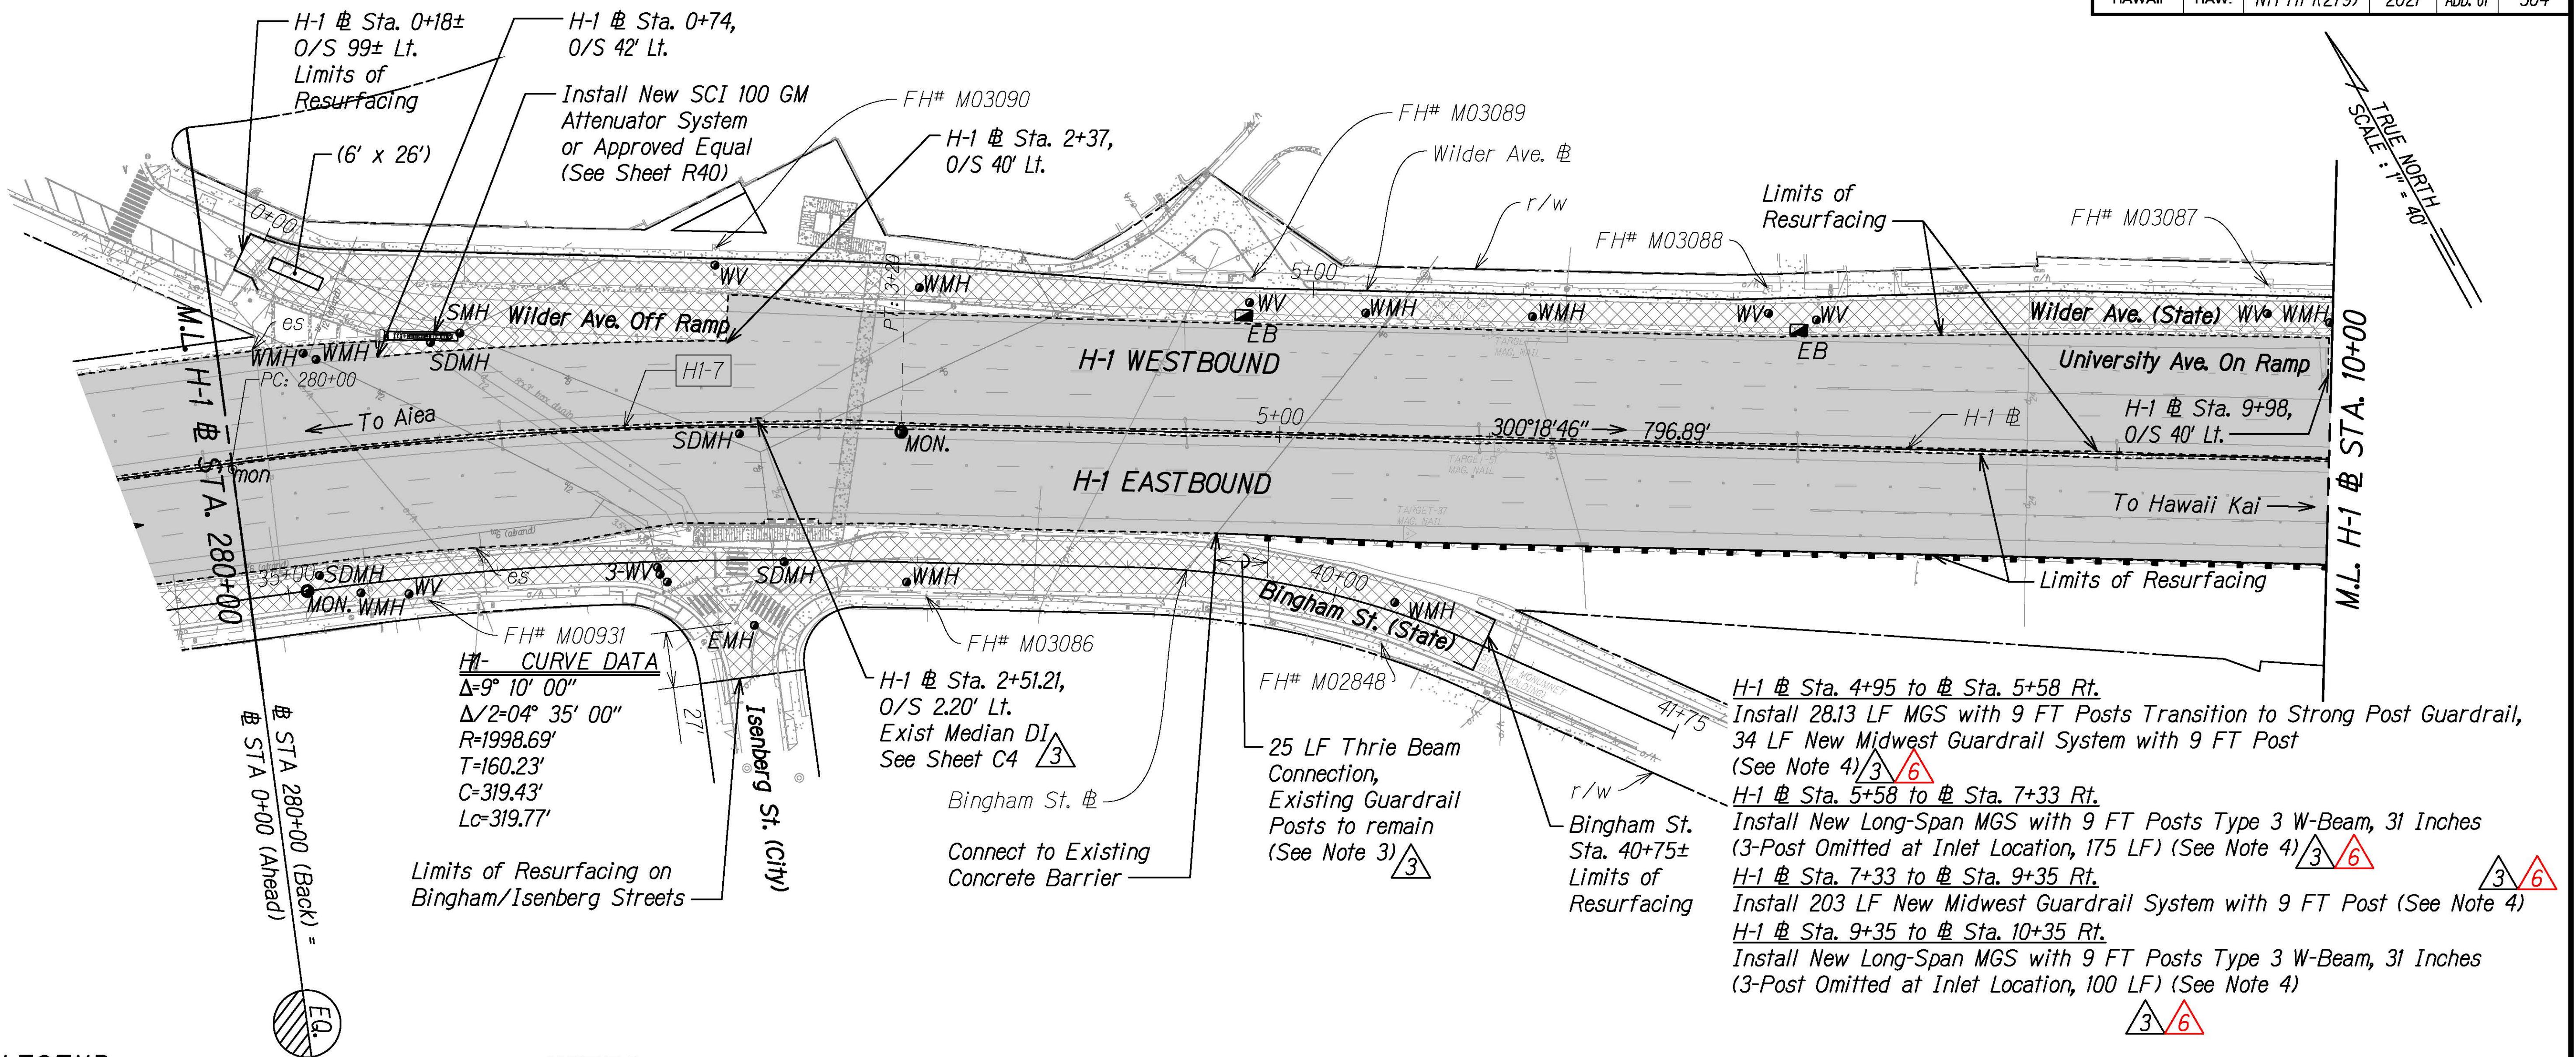

APPROVED: 3

MANAGER AND CHIEF ENGINEER, BWS  
(For Work Affecting BWS Facilities in  
City/State R/W and BWS Easements Only)

DATE

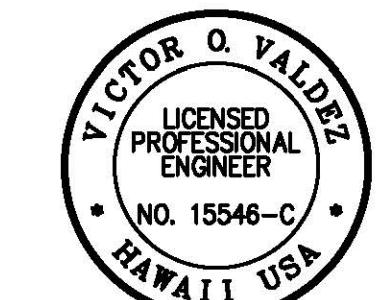


THIS WORK WAS PREPARED BY ME  
OR UNDER MY SUPERVISION  
  
04/30/22  
SIGNATURE  
EXPIRATION DATE  
OF THE LICENSE

7/21/21	<span style="color:red">6</span> Revised Guardrails
7/9/21	<span style="color:red">3</span> BWS Tracings and Revised Guardrails Added Exist. Median DI label
DATE	REVISION

STATE OF HAWAII  
DEPARTMENT OF TRANSPORTATION  
HIGHWAYS DIVISION

### ROADWAY PLAN

INTERSTATE ROUTE H-1 RESURFACING  
Miller Pedestrian Overpass to Kapiolani Interchange  
Federal-Aid Project No. NH-HI-1(279)  
Scale: 1" = 40'  
Date: August 2021  
SHEET No. R12 OF 41 SHEETS

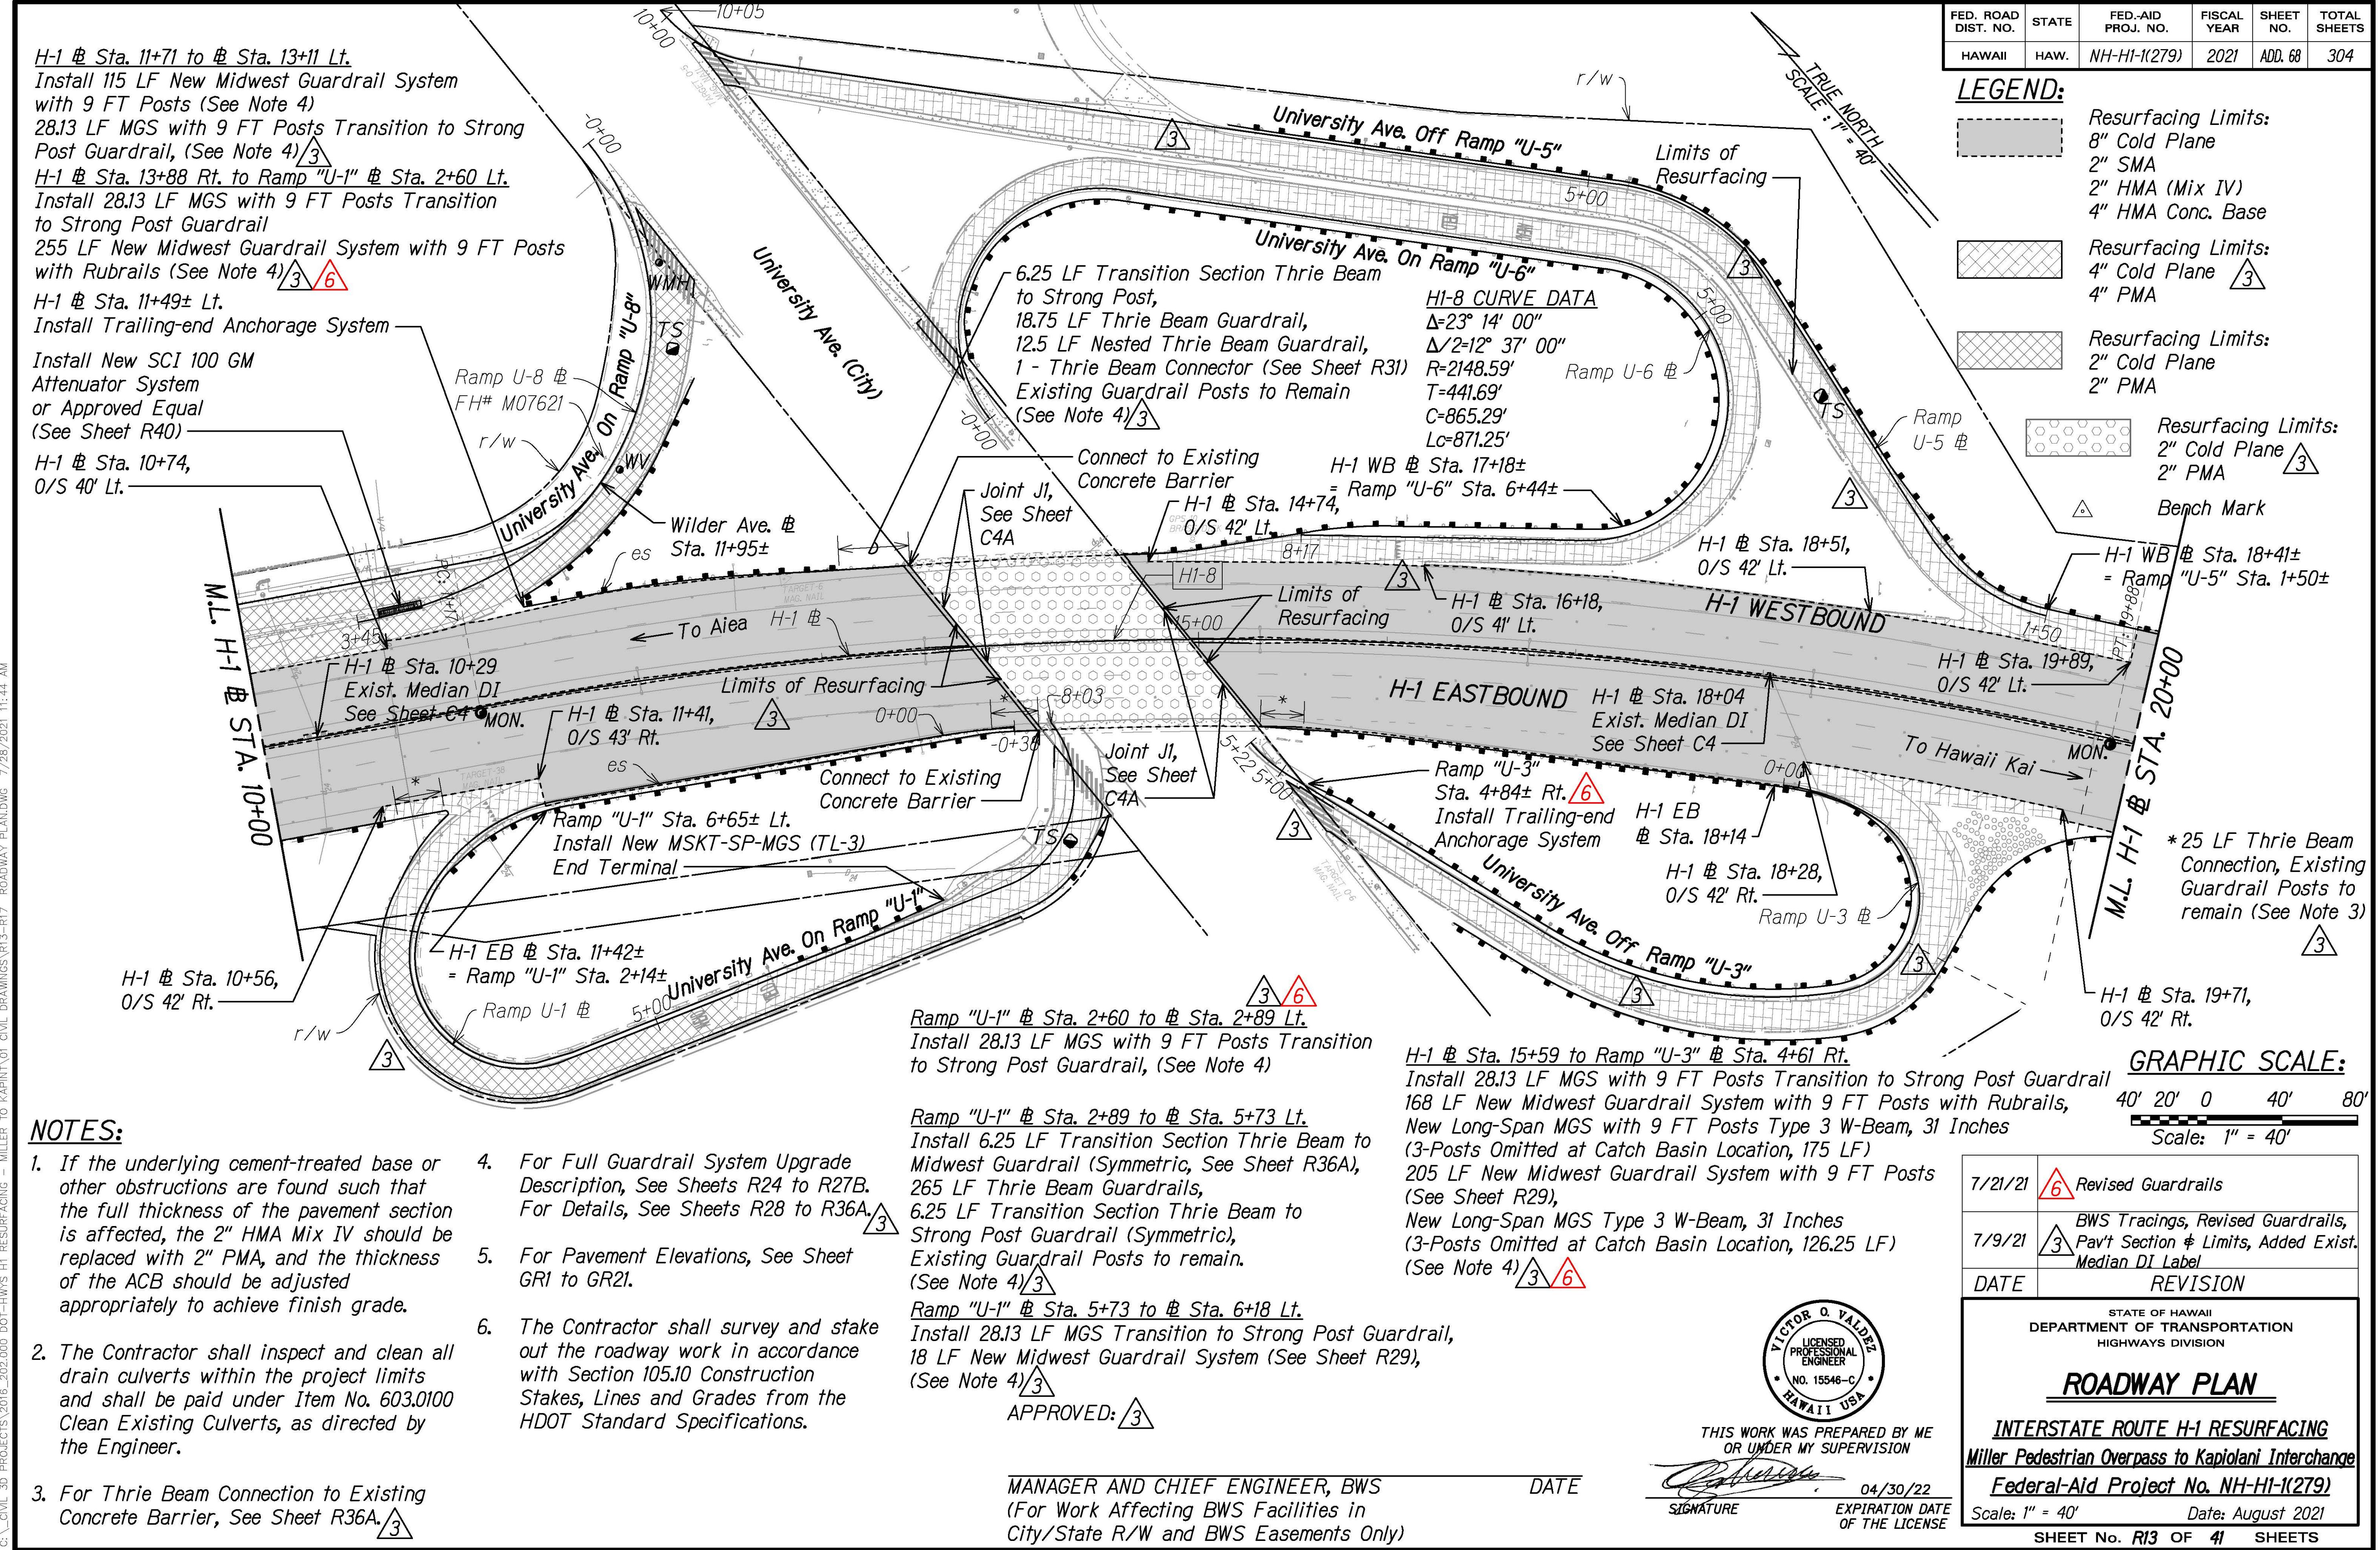
**NOTES:**

- If the underlying cement-treated base or other obstructions are found such that the full thickness of the pavement section is affected, the 2" HMA Mix IV should be replaced with 2" PMA, and the thickness of the ACB should be adjusted appropriately to achieve finish grade.
- The Contractor shall inspect and clean all drain culverts within the project limits and shall be paid under Item No. 603.0100 Clean Existing Culverts, as directed by the Engineer.
- For Thrie Beam Connection to Existing Concrete Barrier, See Sheet R36A.
- For Full Guardrail System Upgrade Description, See Sheets R24 to R27B. For Details, See Sheets R28 to R36A.
- For Pavement Elevations, See Sheet GR1 to GR21.
- The Contractor shall survey and stake out the roadway work in accordance with Section 105.10 Construction Stakes, Lines and Grades from the HDOT Standard Specifications.


MANAGER AND CHIEF ENGINEER, BWS  
(For Work Affecting BWS Facilities in City/State R/W and BWS Easements Only)

DATE  
  
04/30/22

SIGNATURE  
EXPIRATION DATE OF THE LICENSE  
Scale: 1" = 40'  
Date: August 2021

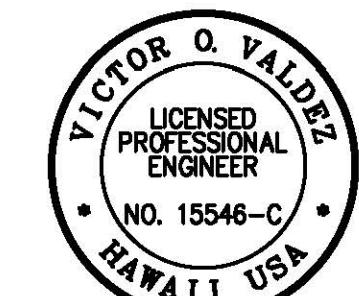

THIS WORK WAS PREPARED BY ME OR UNDER MY SUPERVISION

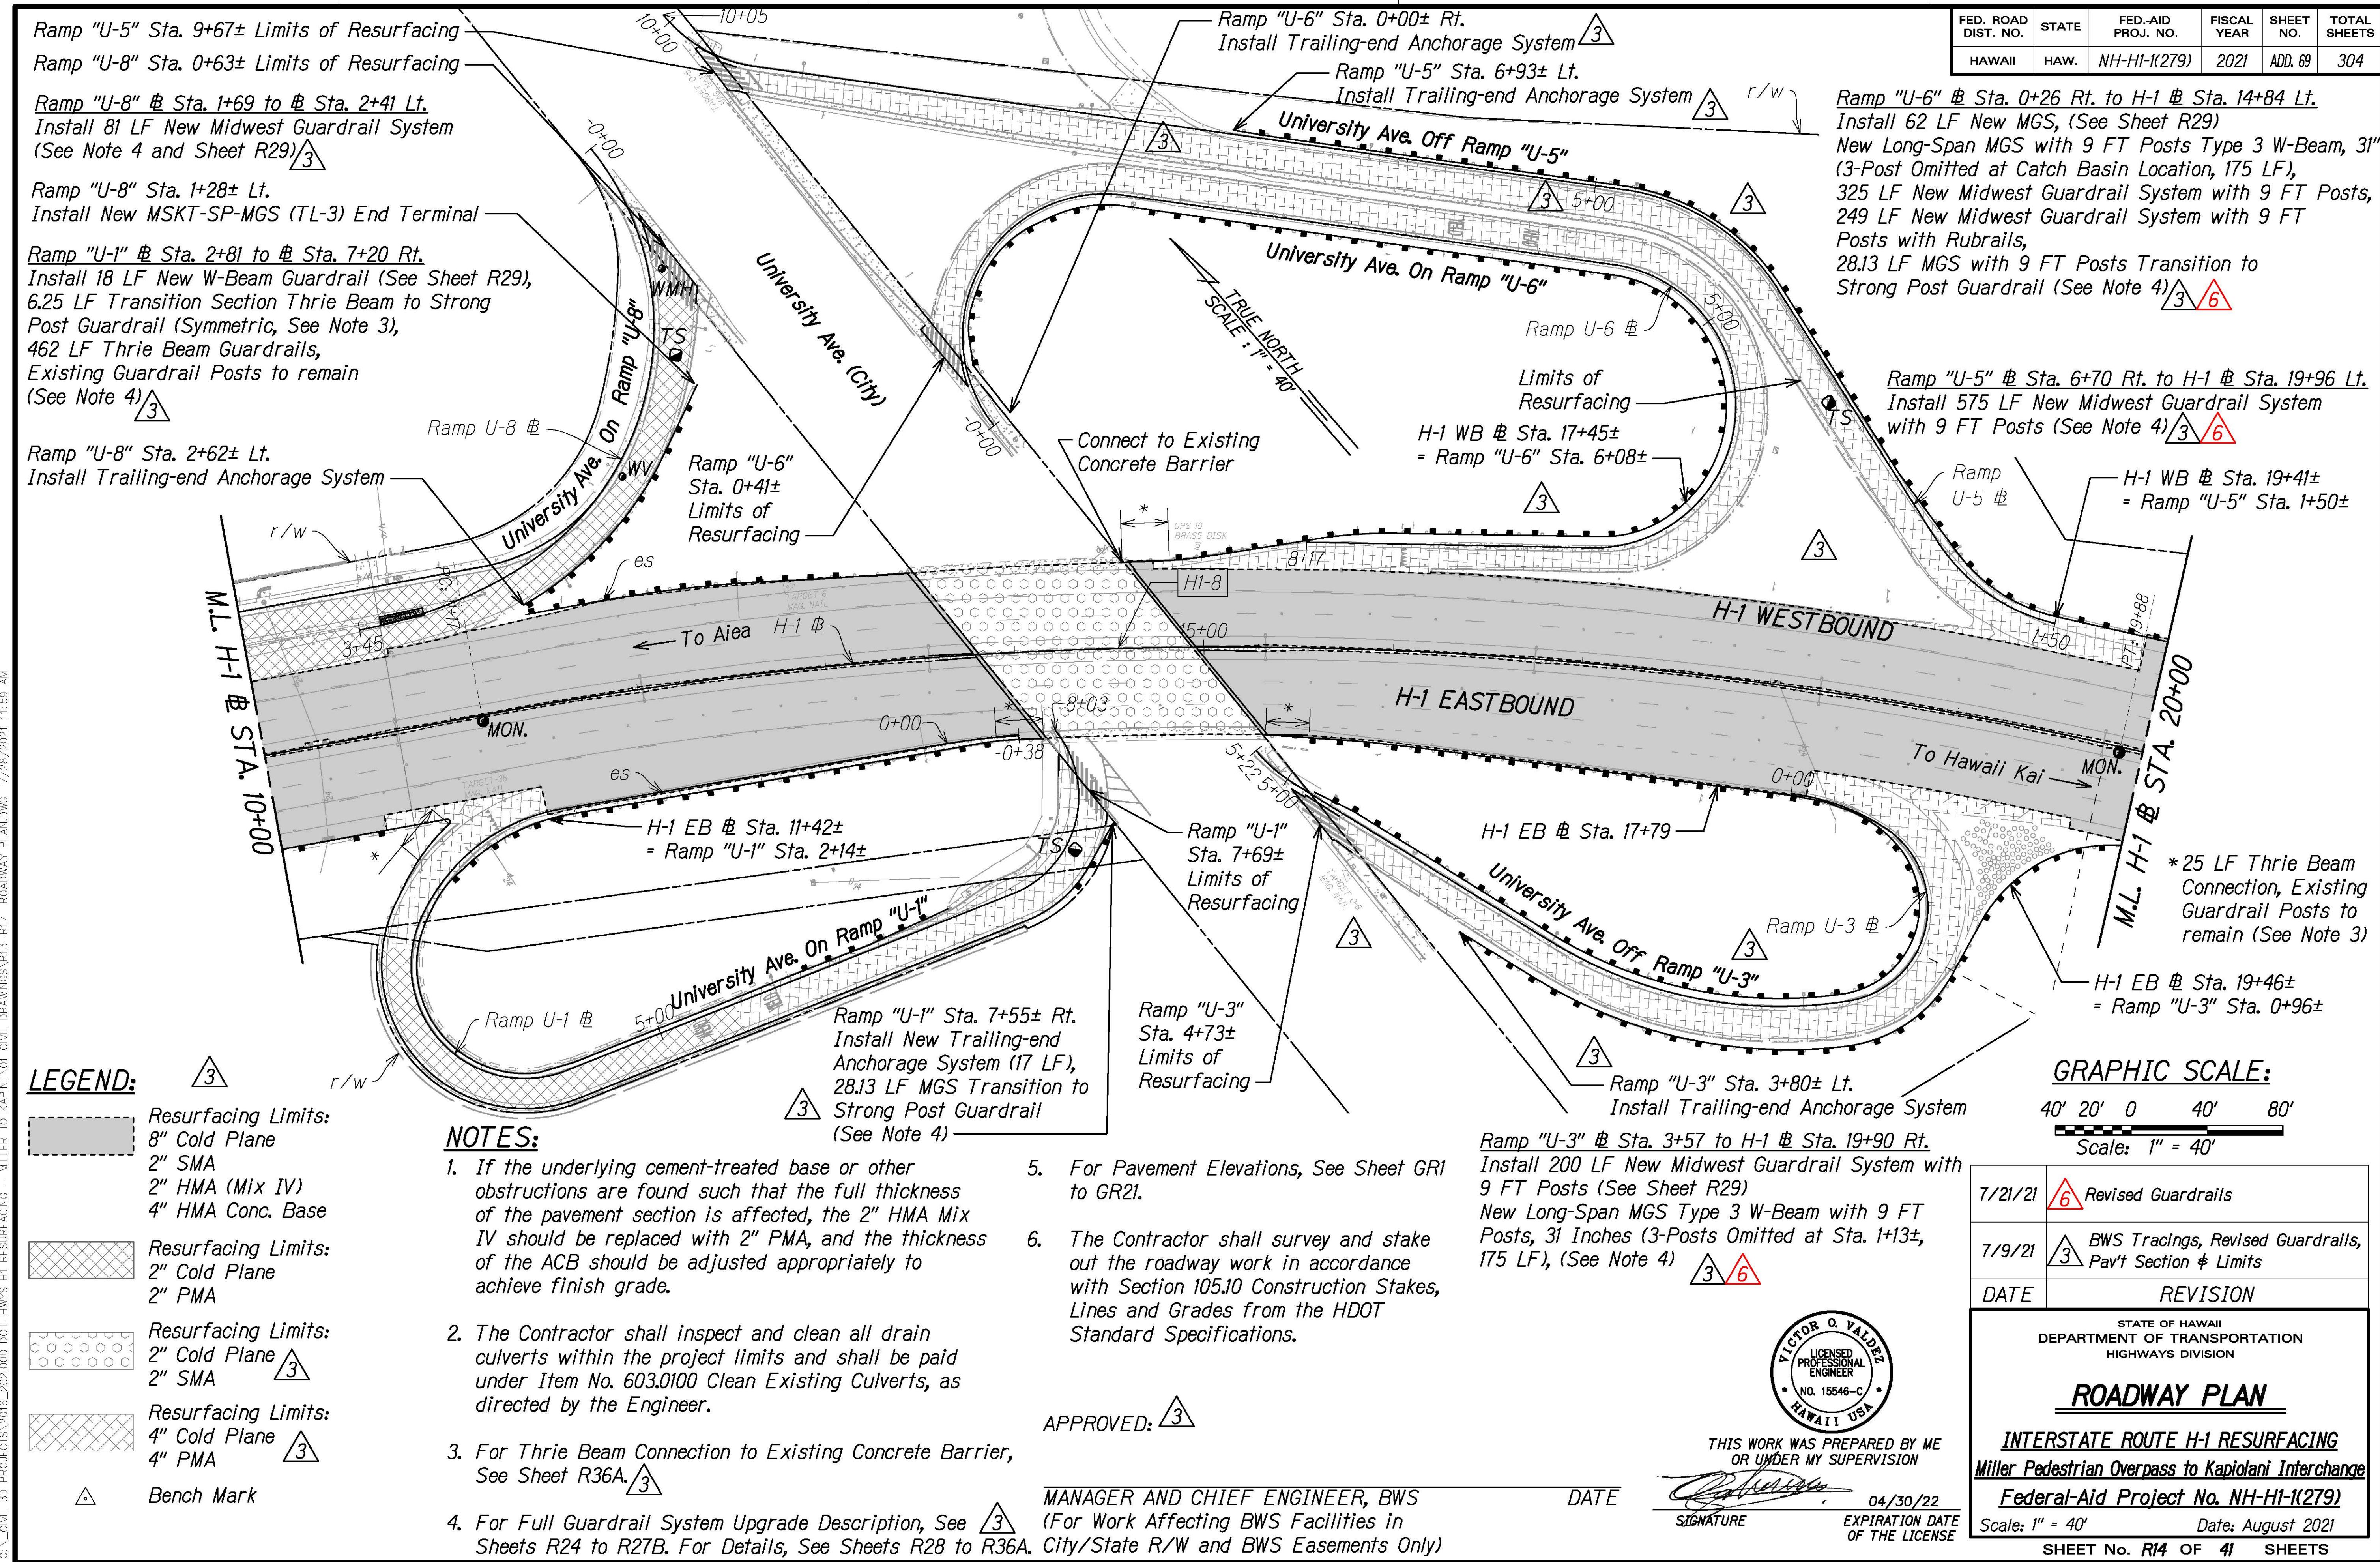

H-1 # Sta. 19+96 to Sta. 21+70 Lt.

Install New Long-Span MGS with 9 FT Posts

Type 3 W-Beam, 31 Inches

(3-Posts Omitted at Inlet Location, 175 LF), **6**

(See Note 3)

H-1 # Sta. 21+70 to Sta. 24+36 Lt.

Install 237 LF New Midwest Guardrail System

with 9 FT Posts,

28.13 LF MGS with 9 FT Posts Transition

to Strong Post Guardrail

(See Note 3) **3** **6**

△ 6.25 LF Transition Section Thrie Beam  
to Strong Post,  
12.5 LF Thrie Beam Guardrail,  
12.5 LF Nested Thrie Beam Guardrail,  
1- Thrie Beam Connector (See Sheet R31)  
Existing Guardrail Posts to Remain  
(See Note 3)

H-1 # Sta. 25+39 to Waialae On Ramp # Ah. Sta. 7+50 Lt.

Install 28.13 LF MGS with 9 FT Posts Transition to Strong Post Guardrail,

45 LF New Midwest Guardrail System with 9 FT Posts,

New Long-Span MGS with 9 FT Posts Type 3 W-Beam, 31 Inches

(3-Post Omitted at Inlet Location, 175 LF),

15 LF New Midwest Guardrail System with 9 FT Posts,

New Long-Span MGS with 9 FT Posts Type 3 W-Beam, 31 Inches

(3-Post Omitted at Inlet Location, 175 LF),


48 LF New Midwest Guardrail System with 9 FT Posts,

28.13 LF MGS with 9 FT Posts Transition to Strong Post Guardrail

(See Note 3) **3** **6**

FED. ROAD DIST. NO.	STATE	FED-AID PROJ. NO.	FISCAL YEAR	SHEET NO.	TOTAL SHEETS
HAWAII	HAW.	NH-HI-1(279)	2021	ADD. 70	304

TRUE NORTH  
SCALE: 1" = 40'

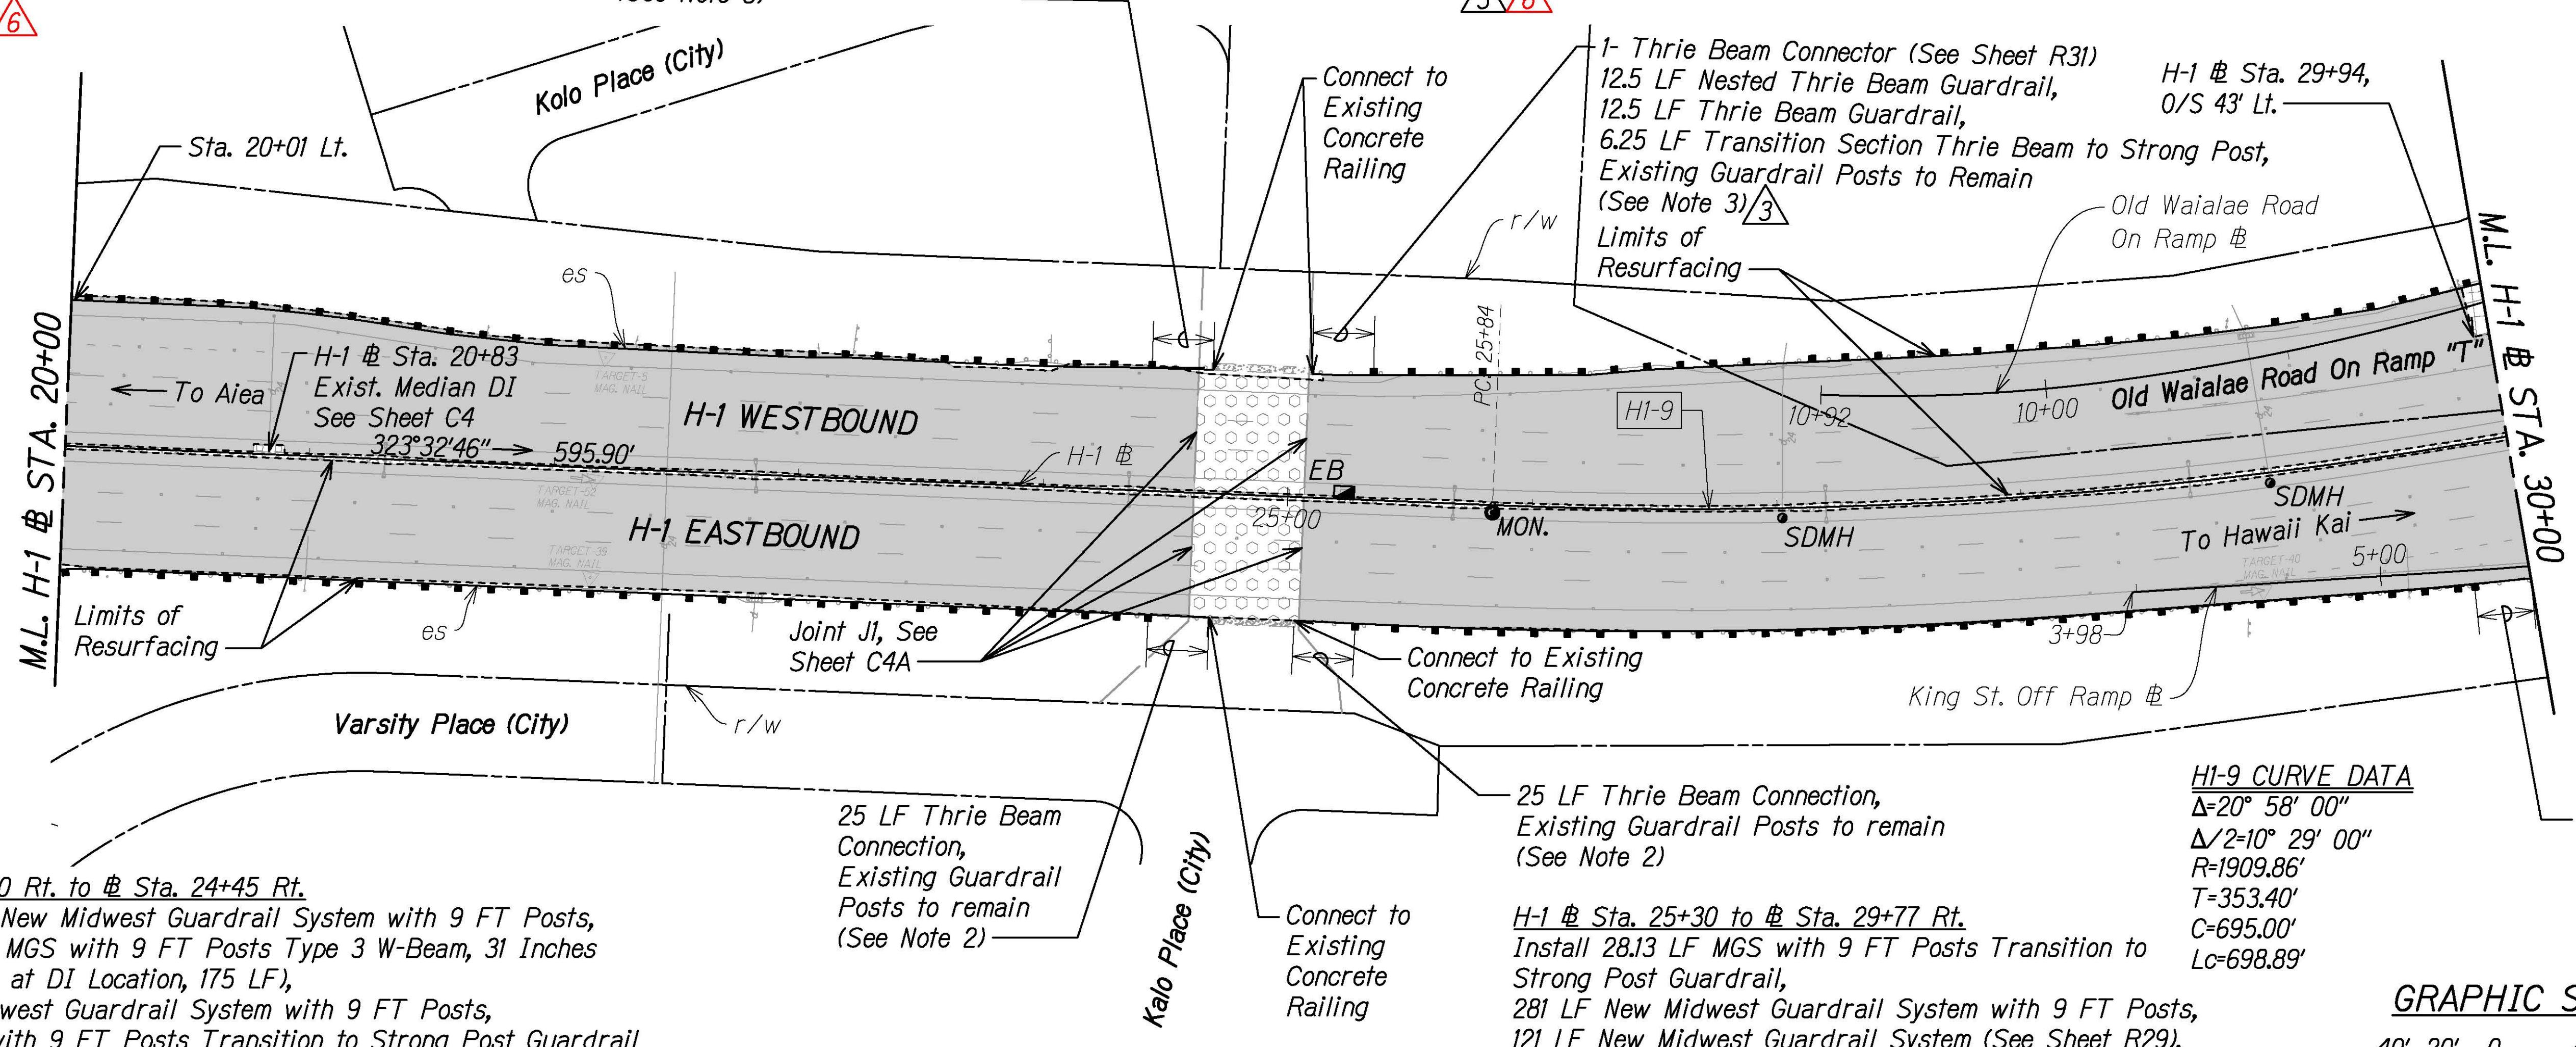


#### NOTES:

- If the underlying cement-treated base or other obstructions are found such that the full thickness of the pavement section is affected, the 2" HMA Mix IV should be replaced with 2" PMA, and the thickness of the ACB should be adjusted appropriately to achieve finish grade.
- For Thrie Beam Connection to Existing Concrete Railing, See Sheet R36A. **3**
- For Full Guardrail System Upgrade Description, See Sheets R24 to R27B. For Details, See Sheets R28 to R36A. **3**
- For Pavement Elevations, See Sheet GR1 to GR21.
- The Contractor shall survey and stake out the roadway work in accordance with Section 105.10 Construction Stakes, Lines and Grades from the HDOT Standard Specifications.

#### LEGEND:


Resurfacing Limits:  
8" Cold Plane  
2" SMA  
2" HMA (Mix IV)  
4" HMA Conc. Base

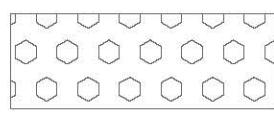


Resurfacing Limits:

2" Cold Plane  
2" SMA

Resurfacing Limits:  
4" Cold Plane **3**  
4" PMA

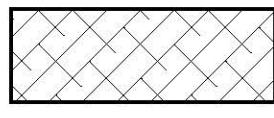

Bench Mark

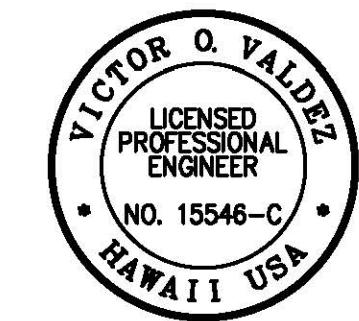

THIS WORK WAS PREPARED BY ME  
OR UNDER MY SUPERVISION

04/30/22

SIGNATURE EXPIRATION DATE  
OF THE LICENSE

7/21/21	<b>6</b> Revised Guardrails
7/9/21	<b>3</b> Revised Guardrails, Pav't Section & Limits, Added Exist. Median DI Label
DATE	REVISION

STATE OF HAWAII  
DEPARTMENT OF TRANSPORTATION  
HIGHWAYS DIVISION

#### ROADWAY PLAN

#### INTERSTATE ROUTE H-1 RESURFACING

Miller Pedestrian Overpass to Kapiolani Interchange

Federal-Aid Project No. NH-HI-1(279)

Scale: 1" = 40' Date: August 2021

SHEET NO. R15 OF 41 SHEETS


ADD. 70

SCHEDULE - EXISTING GUARDRAIL UPGRADE					
DRAWING NO.	DESCRIPTION	FROM	TO	DISTANCE (Feet)	GUARDRAIL UPGRADE (Feet)
R3	Ward Ave. On Ramp (Rt.)	# 7+14	# 7+73	59	- Midwest Guardrail existing guardrail posts to remain
	Ward Ave. On Ramp (Rt.)	# 7+73	# 8+30	--	- 6.25 LF Transition Section Thrie Beam to Strong Posts - 45 LF Thrie Beam Guardrail - 6.25 LF Transition Section Thrie Beam to Strong Posts, existing guardrail posts to remain
R4	Ward Ave. On Ramp (Rt.)	# 8+30	H-1 EB # 200+36	28.13	- MGS with 9 FT Posts Transition to Strong Post Guardrail
	H-1 EB Shoulder	# 200+36	# 201+94	158	- Midwest Guardrail with 9 FT Posts
	H-1 EB Shoulder	# 201+94	# 202+22	28.13	- MGS with 9 FT Posts Transition to Strong Post Guardrail
	H-1 EB Shoulder	# 202+22	# 202+71	50	Midwest Guardrail with Rubrails, existing guardrail posts to remain
	H-1 EB Shoulder	# 202+71	# 202+96±	25	- Thrie Beam Connection to existing concrete barrier, existing guardrail posts to remain
	H-1 WB Shoulder (along Lunalilo Street)	# 201+98±	# 202+58	--	- Thrie Beam Connector - 12.5 LF Nested Thrie Beam Guardrail - 47.5 LF Thrie Beam Guardrail - Thrie Beam End Section (Rounded), existing guardrail posts to remain
	H-1 WB Shoulder (along Lunalilo On Ramp)	# 201+98±	# 202+58	--	- Thrie Beam Connector - 12.5 LF Nested Thrie Beam Guardrail - 47.5 LF Thrie Beam Guardrail - Thrie Beam End Section (Rounded), existing guardrail posts to remain
	Piikoi On Ramp (Lt.)	# 17+98±	# 18+45	--	- MSKT-SP-MGS (TL-3) End Terminal
R5	Piikoi On Ramp (Lt.)	# 18+45	# 20+73	228	- Midwest Guardrail
R6	Piikoi On Ramp (Lt.)	# 20+73	# 20+96	--	- Trailing-End Anchorage System
	H-1 WB Shoulder	# 224+51±	# 224+65	--	- Thrie Beam Connector - 7.38 LF Thrie Beam Guardrail - 6.25 LF Transition Section Thrie Beam to Strong Posts
	H-1 WB Shoulder	# 224+65	# 225+20	53.13	- Long-Span Strong Post, (3 - Post Omitted at Catch Basin Location)
	H-1 WB Shoulder	# 225+14	# 225+18	4.75	- SCI 100 GM Transition to W-Beam (31" High), Connect to New Impact Attenuator
	Lunalilo Street (Rt.)	# 62+49	# 62+72	--	- Trailing-End Anchorage System
	Lunalilo Street (Rt.)	# 62+72	# 63+53	81.25	- Long-Span Midwest Guardrail System, (3 - Post Omitted at Catch Basin Location)
	Lunalilo Street (Rt.)	# 63+47	# 63+52	4.75	- SCI 100 GM Transition to W-Beam (28" High), Connect to New Impact Attenuator
R8	H-1 EB Shoulder (along Punahou Street)	# 239+67	# 240+71	--	- Connect to New Impact Attenuator - 101 LF Thrie Beam Guardrail, - Thrie Beam Connector


FED. ROAD DIST. NO.	STATE	FED.-AID PROJ. NO.	FISCAL YEAR	HEET NO.	TOTAL SHEETS
HAWAII	HAW.	NH-HI-1(279)	2021	ADD. 80	304

SCHEDULE - EXISTING GUARDRAIL UPGRADE					
DRAWING NO.	DESCRIPTION	FROM	TO	DISTANCE (Feet)	GUARDRAIL UPGRADE (Feet)
R8	Punahou St. Off Ramp (Lt.)	Punahou St. Off Ramp # 19+75	Punahou St. Off Ramp # 20+75	--	- Connect to New Impact Attenuator - 102 LF Thrie Beam Guardrail, - Thrie Beam Connector
	H-1 EB Shoulder	# 4+70±	# 4+95	25	- Thrie Beam Connection to existing concrete barrier, existing guardrail posts to remain
	H-1 EB Shoulder	# 4+95±	# 5+24	28.13	- MGS with 9 FT Posts Transition to Strong Post Guardrail
	H-1 EB Shoulder	# 5+24±	# 5+58	34	- Midwest Guardrail with 9 FT Posts
R12	H-1 EB Shoulder	# 5+58	# 7+33	175 <span style="color:red">6</span>	- Long-Span MGS with 9 FT Posts, (3 - Post Omitted at Inlet Location)
	H-1 EB Shoulder	# 7+33	# 9+35	203	- Midwest Guardrail with 9 FT Posts
	H-1 EB Shoulder	# 9+35	# 10+35	100	- Long-Span MGS with 9 FT Posts, (3 - Post Omitted at Inlet Location)
	H-1 EB Shoulder	# 10+63	# 10+88	25	- Thrie Beam Connection to existing concrete post, existing guardrail posts to remain
	H-1 WB Shoulder	# 11+49	# 11+71	--	- Trailing-End Anchorage System
	H-1 WB Shoulder	# 11+71	# 12+84	115	- Midwest Guardrail with 9 FT Posts
R13	H-1 WB Shoulder	# 12+84	# 13+11	28.13	- MGS with 9 FT Posts Transition to Strong Post Guardrail
	H-1 WB Shoulder	# 13+11	# 13+48±	--	- 6.25 LF Transition Section Thrie Beam to Strong Posts - 18.75 LF Thrie Beam Guardrail - 12.5 LF Nested Thrie Beam Guardrail - Thrie Beam Connector, existing guardrail posts to remain

7/21/21	<span style="color:red">6</span> Revised System Description and Quantity
7/14/21	<span style="color:red">4</span> Revised System Description
7/9/21	<span style="color:red">3</span> Revised Guardrails
DATE	REVISION

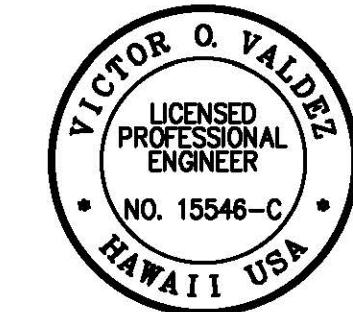


\*Equation Station:  
H-1 @ Sta. 280+00=H-1 @ Sta. 0+00

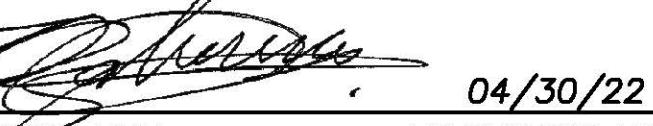
THIS WORK WAS PREPARED BY ME  
OR UNDER MY SUPERVISION  
  
04/30/22  
SIGNATURE  
EXPIRATION DATE  
OF THE LICENSE

GUARDRAIL SCHEDULE	
INTERSTATE ROUTE H-1 RESURFACING	Miller Pedestrian Overpass to Kapiolani Interchange
Federal-Aid Project No. NH-HI-1(279)	Date: August 2021
Scale: N/A	SHEET No. R25 OF 41 SHEETS

SCHEDULE - EXISTING GUARDRAIL UPGRADE					
DRAWING NO.	DESCRIPTION	FROM	TO	DISTANCE (Feet)	GUARDRAIL UPGRADE (Feet)
R13	H-1 EB Shoulder	# 15+33±	# 15+59	25	- Thrie Beam Connection to existing concrete barrier, existing guardrail posts to remain
	H-1 EB Shoulder	# 15+59	# 15+87	28.13	- MGS with 9 FT Posts Transition to Strong Post Guardrail
	H-1 EB Shoulder	# 15+87	# 17+60	168	- MGS with 9 FT Posts with Rubrail
	Ramp "U-3" Shoulder (Rt.)	H-1 EB # 17+60	Ramp "U-3" # 1+23	175	- Long-Span MGS with 9 FT Posts, (3 - Post Omitted at Catch Basin Location)
	Ramp "U-3" Shoulder (Rt.)	# 1+23	# 3+35	205	- Midwest Guardrail with 9 FT Posts
	Ramp "U-3" Shoulder (Rt.)	# 3+35	# 4+61	126.25	- Long-Span Midwest Guardrail System, (3 - Post Omitted at Catch Basin Location)
	Ramp "U-3" Shoulder (Rt.)	# 4+61	# 4+84	--	- Trailing-End Anchorage System
	H-1 EB Shoulder	# 14+13	# 13+88±	25	- Thrie Beam Connection to existing concrete barrier, existing guardrail posts to remain
	Ramp "U-1" Shoulder (Lt.)	# 13+88	# 13+59	28.13	- MGS with 9 FT Posts Transition to Strong Post Guardrail
	H-1 EB Shoulder	# 13+59	Ramp "U-1" # 2+60 / H-1 EB # 11+00	255	- MGS with 9 FT Posts with Rubrail
	Ramp "U-1" Shoulder (Lt.)	# 2+60	# 2+89	28.13	- MGS with 9 FT Posts Transition to Strong Post Guardrail
	Ramp "U-1" Shoulder (Lt.)	# 2+89	# 2+96	6.25	- Transition Section Thrie Beam to Strong Post Guardrail (Symmetric)
	Ramp "U-1" Shoulder (Lt.)	# 2+96	# 5+67	265	- Thrie Beam Guardrail existing guardrail posts to remain
R14	Ramp "U-1" Shoulder (Lt.)	# 5+67	# 5+73	6.25	- Transition Section Thrie Beam to Midwest Guardrail (Symmetric)
	Ramp "U-1" Shoulder (Lt.)	# 5+73	# 6+01	28.13	- Midwest Guardrail System Transition to Strong Post Guardrail
	Ramp "U-1" Shoulder (Lt.)	# 6+01	# 6+18	18	- Midwest Guardrail
	Ramp "U-1" Shoulder (Lt.)	# 6+18	# 6+65	--	- MSKT-SP-MGS (TL-3) End Terminal
	Ramp "U-6" Shoulder (Rt.)	# 0+00	# 0+26	--	- Trailing-End Anchorage System
	Ramp "U-6" Shoulder (Rt.)	# 0+26	# 0+91	62	- Midwest Guardrail
R14	Ramp "U-6" Shoulder (Rt.)	# 0+91	# 2+72	175	- Long-Span MGS with 9 FT Posts, (3 - Post Omitted at Catch Basin Location)


FED. ROAD DIST. NO.	STATE	FED.-AID PROJ. NO.	FISCAL YEAR	HEET NO.	TOTAL SHEETS					
HAWAII	HAW.	NH-HI-1(279)	2021	ADD. 81	304					
SCHEDULE - EXISTING GUARDRAIL UPGRADE										
DRAWING NO.	DESCRIPTION	FROM	TO	DISTANCE (Feet)	GUARDRAIL UPGRADE (Feet)					
# 6/3	Ramp "U-6" Shoulder (Rt.)	# 2+72	# 6+08	325	- Midwest Guardrail with 9 FT Posts					
# 6/3										
# 3	Ramp "U-6" # 6+08 / H-1 EB # 17+45	# 15+12		249	- MGS with 9 FT Posts with Rubrail					
# 3	H-1 WB Shoulder	# 15+12	# 14+84	28.13	- MGS with 9 FT Posts Transition to Strong Post Guardrail					
R14 # 3	H-1 WB Shoulder	# 14+84	# 14+60	25	- Thrie Beam Connection to existing concrete barrier, existing guardrail posts to remain					
# 3	Ramp "U-1" Shoulder (Rt.)	# 2+60±	# 2+81	25	- Thrie Beam Connection to existing concrete post, existing guardrail posts to remain					
# 3	Ramp "U-1" Shoulder (Rt.)	# 2+81	# 2+96	18	- Midwest Guardrail existing guardrail posts to remain					
# 3	Ramp "U-1" Shoulder (Rt.)	# 2+96	# 3+02	6.25	- Transition Section Thrie Beam to Midwest Guardrail (Symmetric)					
# 3	Ramp "U-1" Shoulder (Rt.)	# 3+02	# 7+20	462	- Thrie Beam Guardrail existing guardrail posts to remain					
# 3	Ramp "U-1" Shoulder (Rt.)	# 7+20	# 7+42	28.13	- Midwest Guardrail System Transition to Strong Post Guardrail					
7/21/21 <span style="color:red">6</span> Revised System Description and Quantity										
7/9/21 <span style="color:red">3</span> Revised Guardrails										
DATE	REVISION									
STATE OF HAWAII DEPARTMENT OF TRANSPORTATION HIGHWAYS DIVISION										
<b>GUARDRAIL SCHEDULE</b>										
<u>INTERSTATE ROUTE H-1 RESURFACING</u>										
Miller Pedestrian Overpass to Kapiolani Interchange										
Federal-Aid Project No. NH-HI-1(279)										
Scale: N/A Date: August 2021										
SHEET No. R26 OF 41 SHEETS										

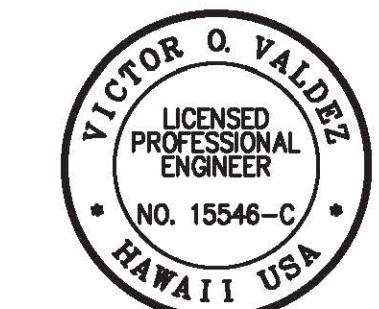

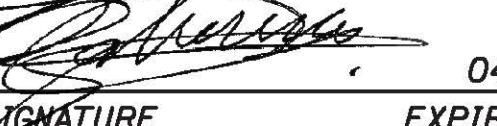THIS WORK WAS PREPARED BY ME  
OR UNDER MY SUPERVISION  
  
04/30/22  
SIGNATURE  
EXPIRATION DATE  
OF THE LICENSE

7/21/21 6 Revised System Description and Quantity  
7/9/21 3 Revised Guardrails  
DATE REVISION  
STATE OF HAWAII  
DEPARTMENT OF TRANSPORTATION  
HIGHWAYS DIVISION  
**GUARDRAIL SCHEDULE**  
INTERSTATE ROUTE H-1 RESURFACING  
Miller Pedestrian Overpass to Kapiolani Interchange  
Federal-Aid Project No. NH-HI-1(279)  
Scale: N/A Date: August 2021  
SHEET No. R26 OF 41 SHEETS

SCHEDULE - EXISTING GUARDRAIL UPGRADE					
DRAWING NO.	DESCRIPTION	FROM	TO	DISTANCE (Feet)	GUARDRAIL UPGRADE (Feet)
R14	Ramp "U-1" Shoulder (Rt.)	# 7+42	# 7+55±	17	- Trailing-End Anchorage System
	Ramp "U-8" Shoulder (Lt.)	# 1+28	# 1+69	--	- MSKT-SP-MGS (TL-3) End Terminal
	Ramp "U-8" Shoulder (Lt.)	# 1+69	# 2+41	81	- Midwest Guardrail
	Ramp "U-8" Shoulder (Lt.)	# 2+41	# 2+62	--	- Trailing-End Anchorage System
	Ramp "U-3" Shoulder (Lt.)	# 3+80	# 3+57	--	- Trailing-End Anchorage System
	Ramp "U-3" Shoulder (Lt.)	# 3+57	# 1+73	300	- Midwest Guardrail with 9 FT Posts
	Ramp "U-3" Shoulder (Lt.)	# 1+73	H-1 EB # 19+90	175	- Long-Span MGS with 9 FT Posts, (3 - Post Omitted at Sta. 1+13±)
	Ramp "U-5" Shoulder (Lt.)	# 6+93±	# 6+70	--	- Trailing-End Anchorage System
	Ramp "U-5" Shoulder (Lt.)	# 6+70	H-1 WB # 19+96	575	- Midwest Guardrail with 9 FT Posts
	H-1 WB Shoulder	# 19+96	# 21+70	175	- Long-Span MGS with 9 FT Posts, (3 - Post Omitted at Inlet Location)
R15	H-1 WB Shoulder	# 21+70	# 24+07	237	- Midwest Guardrail with 9 FT Posts
	H-1 WB Shoulder	# 24+07	# 24+36	28.13	- MGS with 9 FT Posts Transition to Strong Post Guardrail
	H-1 WB Shoulder	# 24+36	# 24+67	--	- 6.25 LF Transition Section Thrie Beam to Strong Posts - 12.5 LF Thrie Beam Guardrail - 12.5 LF Nested Thrie Beam Guardrail - Thrie Beam Connector, existing guardrail posts to remain
	H-1 EB Shoulder	H-1 EB # 19+90	# 21+97	208	- Midwest Guardrail with 9 FT Posts
	H-1 EB Shoulder	# 21+97	# 23+72	175	- Long-Span MGS with 9 FT Posts, (3 - Post Omitted at DI Location)
	H-1 EB Shoulder	# 23+72	# 24+17	45	- Midwest Guardrail with 9 FT Posts
	H-1 EB Shoulder	# 24+17	# 24+45	28.13	- MGS with 9 FT Posts Transition to Strong Post Guardrail
	H-1 EB Shoulder	# 24+45	# 24+70±	25	- Thrie Beam Connection to existing concrete railing, existing guardrail posts to remain
	H-1 EB Shoulder	# 25+05±	# 25+30	25	- Thrie Beam Connection to existing concrete railing, existing guardrail posts to remain
	H-1 EB Shoulder	# 25+30	# 25+58	28.13	- MGS with 9 FT Posts Transition to Strong Post Guardrail
	H-1 EB Shoulder	# 25+58	# 28+32	281	- Midwest Guardrail with 9 FT Posts

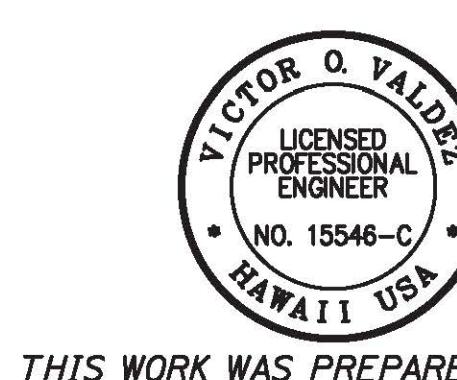FED. ROAD DIST. NO.	STATE	FED.-AID PROJ. NO.	FISCAL YEAR	HEET NO.	TOTAL SHEETS						
HAWAII	HAW.	NH-HI-1(279)	2021	ADD. 82	304						
SCHEDULE - EXISTING GUARDRAIL UPGRADE											
DRAWING NO.	DESCRIPTION	FROM	TO	DISTANCE (Feet)	GUARDRAIL UPGRADE (Feet)						
(3)	H-1 EB Shoulder	# 28+32	# 29+50	121	- Midwest Guardrail						
(3)	H-1 EB Shoulder	# 29+50	# 29+77	28.13	- Midwest Guardrail System Transition to Strong Post Guardrail						
	H-1 EB Shoulder	# 29+77	# 30+02±	25	- Thrie Beam Connection to existing concrete railing, existing guardrail posts to remain						
(3)	H-1 WB Shoulder	# 25+08	# 25+39	--	- Thrie Beam Connector - 6.25 LF Transition Section Thrie Beam to Strong Posts - 12.5 LF Nested Thrie Beam Guardrail - 12.5 LF Thrie Beam Guardrail, existing guardrail posts to remain						
R15	H-1 WB Shoulder	# 25+39	# 25+67	28.13	- MGS with 9 FT Posts Transition to Strong Post Guardrail						
(6)(3)	H-1 WB Shoulder	# 25+67	# 26+14	45	- Midwest Guardrail with 9 FT Posts						
(6)(3)	H-1 WB Shoulder	# 26+14	# 27+94	175	- Long-Span MGS with 9 FT Posts, (3 - Post Omitted at Inlet Location)						
(6)(3)	H-1 WB Shoulder	# 27+94	# 28+09	15	- Midwest Guardrail with 9 FT Posts						
(6)(3)	H-1 WB Shoulder	# 28+09	# 29+90	175	- Long-Span MGS with 9 FT Posts, (3 - Post Omitted at Inlet Location)						
(6)(3)	H-1 WB Shoulder	# 29+90	# 30+40	48	- Midwest Guardrail with 9 FT Posts						
(6)(3)	H-1 WB Shoulder	# 30+40	Ramp "T" # Ah 7+50	28.13	- MGS with 9 FT Posts Transition to Strong Post Guardrail						
<table border="1"> <tr> <td>7/21/21</td> <td>(6) Revised System Description and Quantity</td> </tr> <tr> <td>7/9/21</td> <td>(3) Revised Guardrails</td> </tr> <tr> <td>DATE</td> <td>REVISION</td> </tr> </table>						7/21/21	(6) Revised System Description and Quantity	7/9/21	(3) Revised Guardrails	DATE	REVISION
7/21/21	(6) Revised System Description and Quantity										
7/9/21	(3) Revised Guardrails										
DATE	REVISION										
<p style="text-align: center;">STATE OF HAWAII DEPARTMENT OF TRANSPORTATION HIGHWAYS DIVISION</p> <p style="text-align: center;"><b>GUARDRAIL SCHEDULE</b></p> <p style="text-align: center;"><u>INTERSTATE ROUTE H-1 RESURFACING</u> Miller Pedestrian Overpass to Kapiolani Interchange Federal-Aid Project No. NH-HI-1(279) Scale: N/A Date: August 2021</p> <p style="text-align: center;">SHEET No. R27 OF 41 SHEETS</p>											
<p style="text-align: center;">THIS WORK WAS PREPARED BY ME OR UNDER MY SUPERVISION</p> <p style="text-align: center;">VICTOR O. VALDEZ LICENSED PROFESSIONAL ENGINEER NO. 15546-C • HAWAII USA •</p> <p style="text-align: center;">SIGNATURE  EXPIRATION DATE OF THE LICENSE 04/30/22</p>											

FED. ROAD DIST. NO.	STATE	FED.-AID PROJ. NO.	FISCAL YEAR	HEET NO.	TOTAL SHEETS
HAWAII	HAW.	NH-HI-1(279)	2021	ADD. 82S-2	304

### SCHEDULE - EXISTING GUARDRAIL UPGRADE

DRAWING NO.	DESCRIPTION	FROM	TO	DISTANCE (Feet)	GUARDRAIL UPGRADE (Feet)
R17	③ H-1 WB Shoulder	# 43+15	# 43+83	68	- W-Beam Guardrail, existing guardrail posts to remain
	③ H-1 WB Shoulder	# 43+83	# 43+89	6.25	- Transition Section Thrie Beam to Midwest Guardrail (Symmetric)
	③ H-1 WB Shoulder	# 43+89	# 44+49	60	- Thrie Beam Guardrail, existing guardrail posts to remain
	③ H-1 WB Shoulder	# 44+49	# 44+55	6.25	- Transition Section Thrie Beam to Midwest Guardrail (Symmetric)
	③ H-1 WB Shoulder	# 44+55	# 44+83	28.13	- MGS with 9 FT Posts Transition to Strong Post Guardrail
	④ ③ H-1 WB Shoulder	# 44+83	# 45+76	94	- Midwest Guardrail with 9FT Posts
	③ H-1 WB Shoulder	# 45+76	# 46+04	28.13	- MGS with 9 FT Posts Transition to Strong Post Guardrail
	H-1 WB Shoulder	# 46+04	# 46+29±	25	- Thrie Beam Connection to existing concrete railing, existing guardrail posts to remain

### SUMMARY - EXISTING GUARDRAIL UPGRADE ③

DESCRIPTION	QTY
Midwest Guardrail System, MGS	④ 1,223 LF
Midwest Guardrail System, MGS (with Rubrails)	50 LF
Midwest on 2:1 Fill Slope (9ft Post)	④ 4,115 LF
Midwest on 2:1 Fill Slope (9ft Post) (with Rubrails)	④ 672 LF
MGS Transition to Strong Post Guardrail	④ 19 EA
MGS Transition to Strong Post Guardrail with 9ft Posts	④ 17 EA
25 LF Thrie Beam Connection (Railing Replacement Only)	④ 26 EA
W-Beam Railing (Existing Posts to Remain)	④ 165 LF
W-Beam Railing (with Rubrails) (Existing Posts to Remain)	50 LF
Type 3 Thrie Beam Railing (Existing Posts to Remain)	④ 1,439 LF
Type 3 Thrie Beam Railing (with Posts)	210 LF
Thrie Beam End Terminal Connector	④ 11 EA
Thrie Beam End Rounded End Section	4 EA
W-Beam End Rounded End Section	2 EA
Symmetrical Thrie Beam to Strong Post Transition (6.25 LF)	④ 13 EA
Asymmetrical Thrie Beam to MGS Transition (6.25 LF)	④ 6 EA
SoftStop (TL-2) End Terminal	1 EA
MSKT-SP-MGS (TL-3) End Terminal	6 EA
Trailing-End Anchorage System	④ 11 EA
Long-Span MGS Type 3 W-Beam, 31 Inches (3-Post Omitted)	2 EA
Long-Span MGS Type 3 W-Beam, 31 Inches (3-Post Omitted) with 9 ft Posts	④ 9 EA

### SUMMARY - EXISTING GUARDRAIL UPGRADE

DESCRIPTION	QTY
Long-Span Strong Post W-Beam, 28 Inches (3-Post Omitted)	⑥ 1 EA
SCI 100 GM Transition to W-Beam (28" High)	⑥ 1 EA
SCI 100 GM Transition to W-Beam (31" High)	⑥ 1 EA

7/21/21 ⑥ Revised Quantities & System Description

7/14/21 ④ Revised Quantities, System Description, & Added SoftStop

7/9/21 ③ Revised Guardrails

DATE REVISION

STATE OF HAWAII  
DEPARTMENT OF TRANSPORTATION  
HIGHWAYS DIVISION

### GUARDRAIL SCHEDULE


INTERSTATE ROUTE H-1 RESURFACING  
Miller Pedestrian Overpass to Kapiolani Interchange  
Federal-Aid Project No. NH-HI-1(279)  
Scale: N/A Date: August 2021  
SHEET No. R27B OF 41 SHEETS




THIS WORK WAS PREPARED BY ME  
OR UNDER MY SUPERVISION  
  
04/30/22  
SIGNATURE EXPIRATION DATE  
OF THE LICENSE

ADD. 82S-2

FED. ROAD DIST. NO.	STATE	FED.-AID PROJ. NO.	FISCAL YEAR	HEET NO.	TOTAL SHEETS
HAWAII	HAW.	NH-HI-1(279)	2021	ADD. 84S-3	304

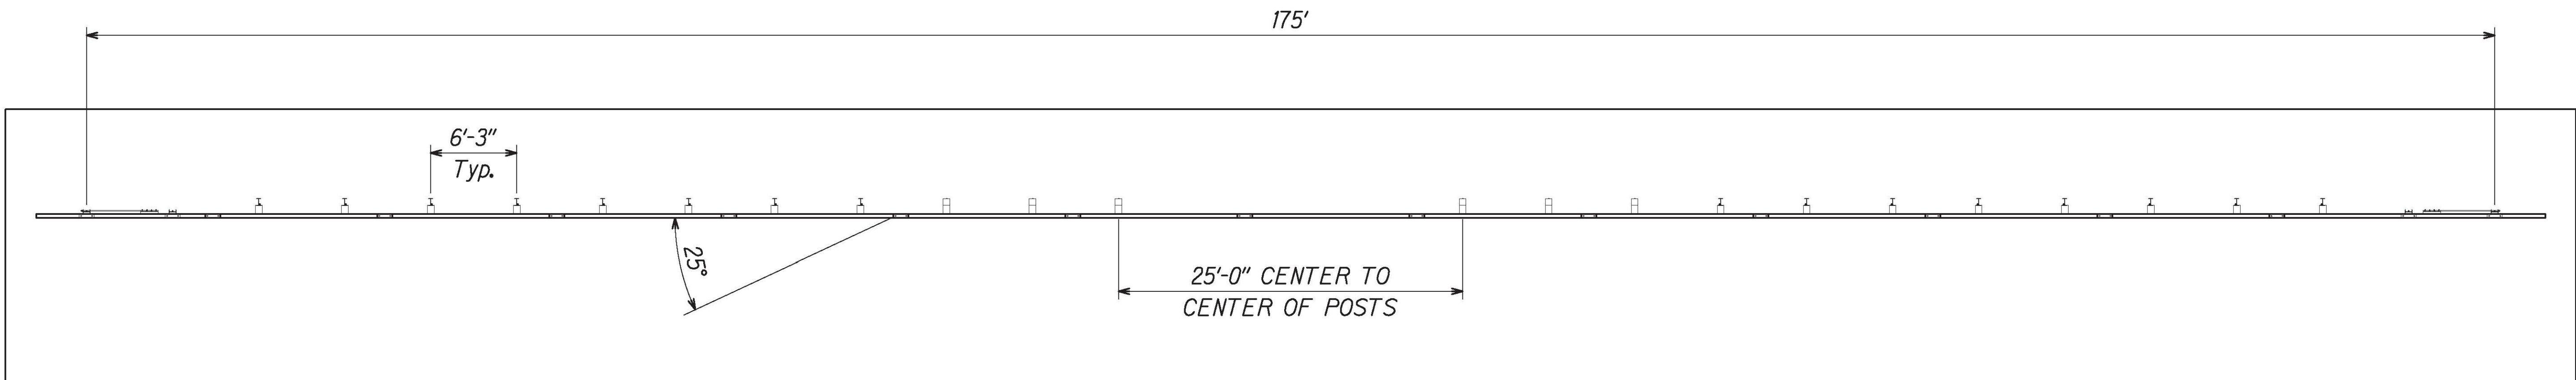


PLAN VIEW

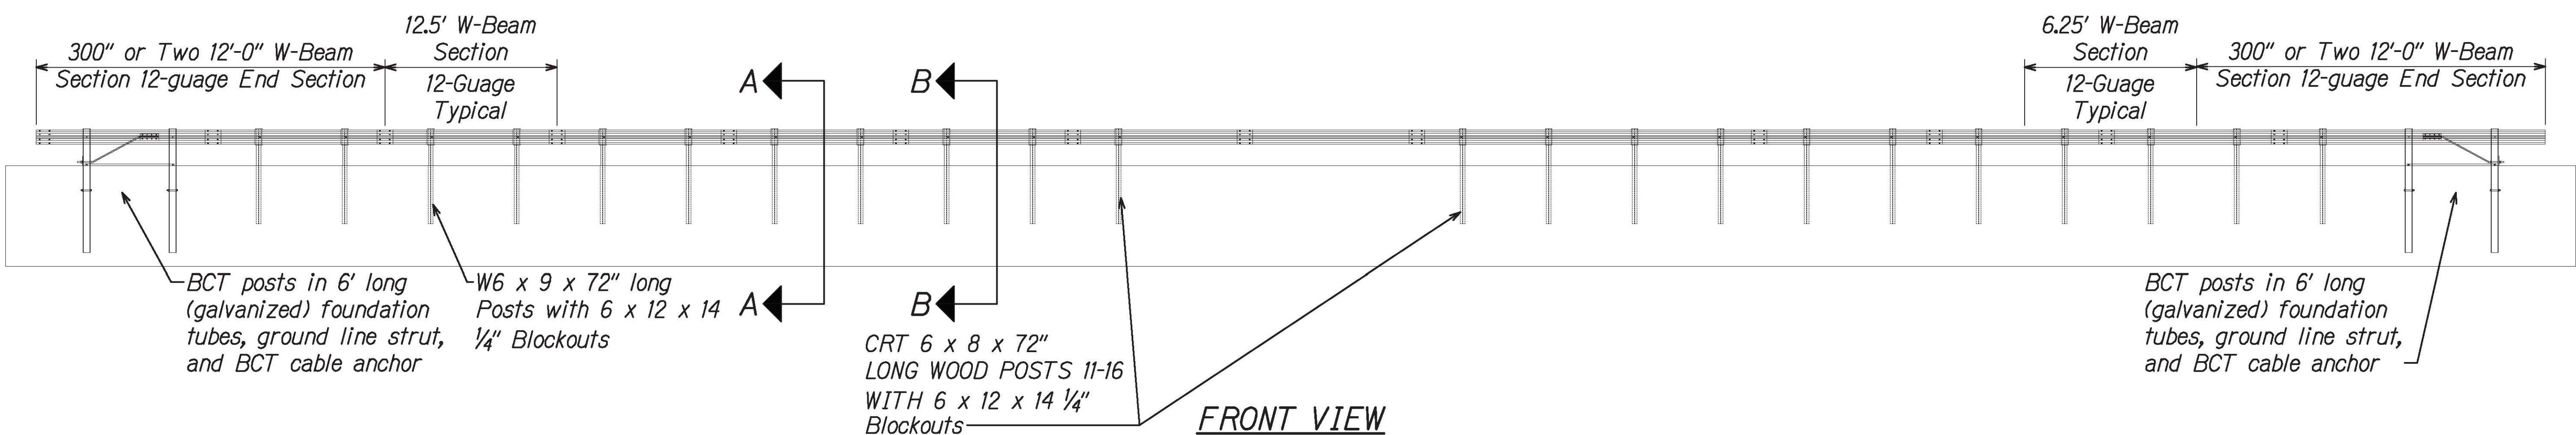


FRONT VIEW

MGS LONG SPAN LSC-2 DETAILS ⑥

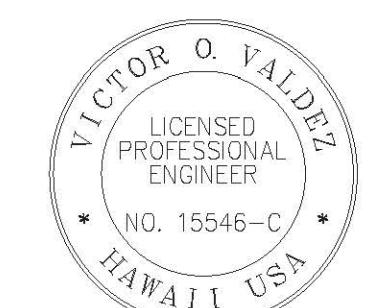

THIS WORK WAS PREPARED BY ME  
OR UNDER MY SUPERVISION

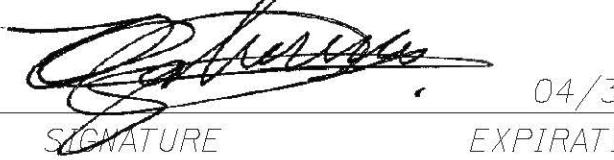  
04/30/22


EXPIRATION DATE  
OF THE LICENSE

7/21/21	<span style="color:red">⑥</span> Added Sheet
DATE	REVISION
STATE OF HAWAII DEPARTMENT OF TRANSPORTATION HIGHWAYS DIVISION	
<u>MGS LONG SPAN LSC-2</u>	
INTERSTATE ROUTE H-1 RESURFACING	
Miller Pedestrian Overpass to Kapiolani Interchange	
Federal-Aid Project No. NH-HI-1(279)	
Scale: NTS Date: August 2021	
SHEET NO. R29C OF 41 SHEETS	

FED. ROAD DIST. NO.	STATE	FED.-AID PROJ. NO.	FISCAL YEAR	SHEET NO.	TOTAL SHEETS
HAWAII	HAW.	NH-HI-1(279)	2021	ADD. 84S-4	304

TS 8x 6x 0.1875

### PLAN VIEW

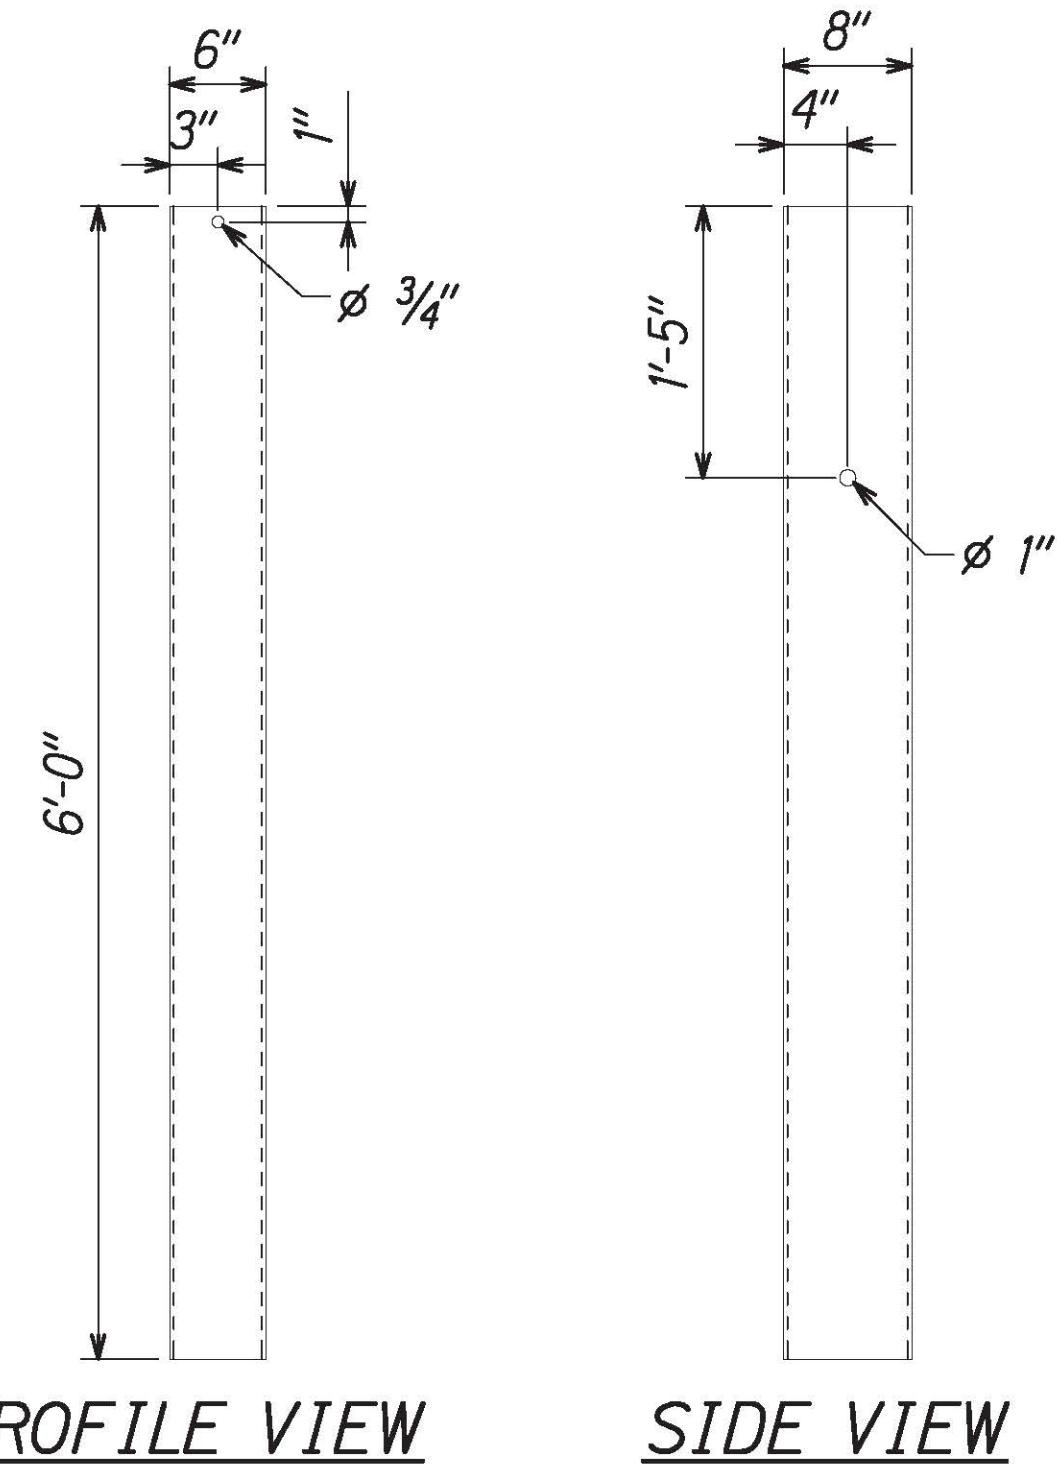


PROFILE VIEW

SIDE VIEW

### FOUNDATION TUBE PART B1

PLAN VIEW

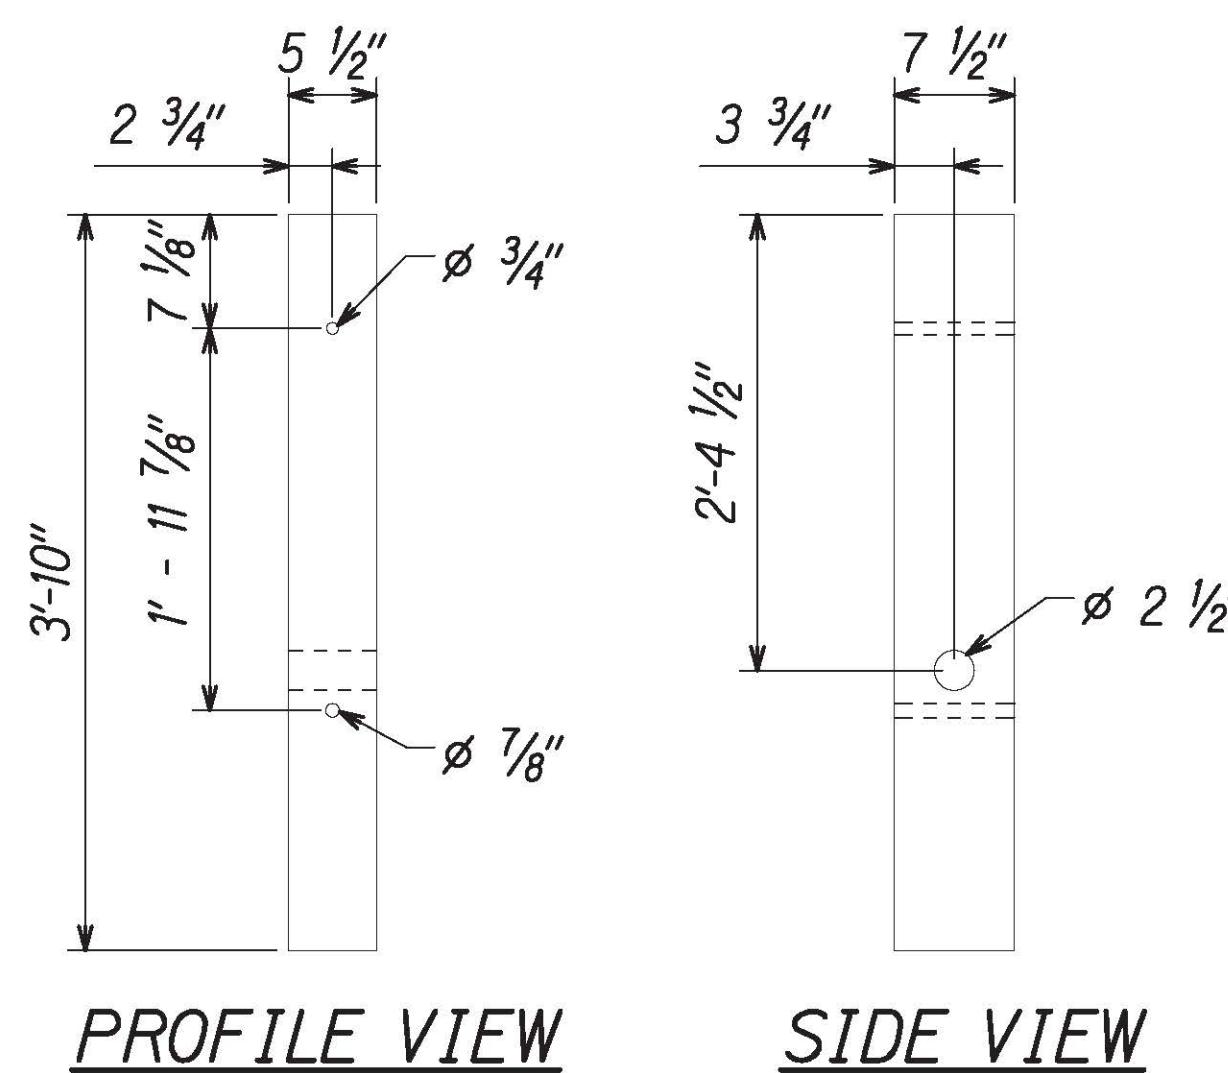


PROFILE VIEW


SIDE VIEW

### PART B2


### BCT (MGS) TIMBER POST

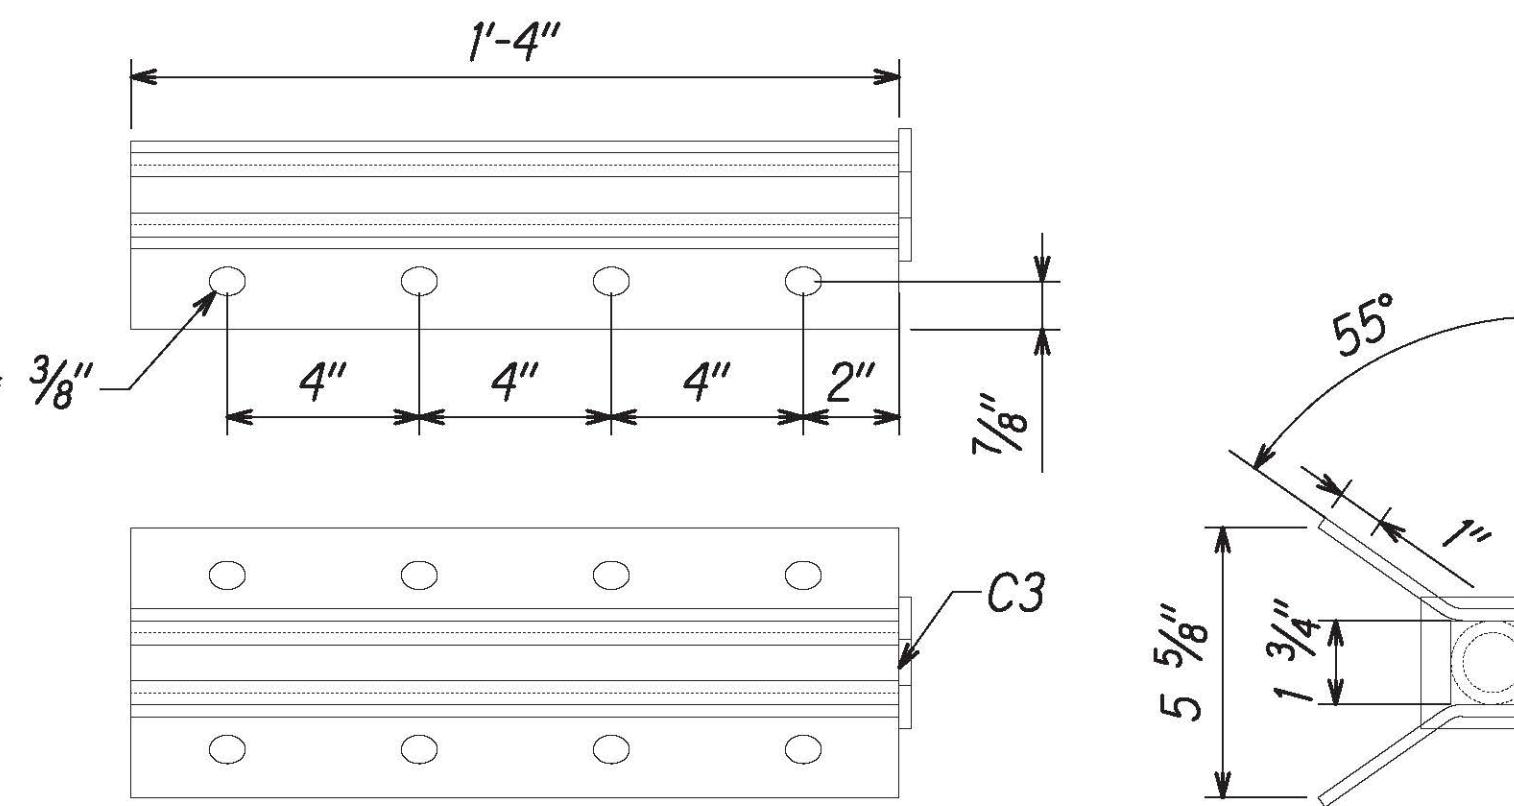


### ANCHOR BRACKET PART C2

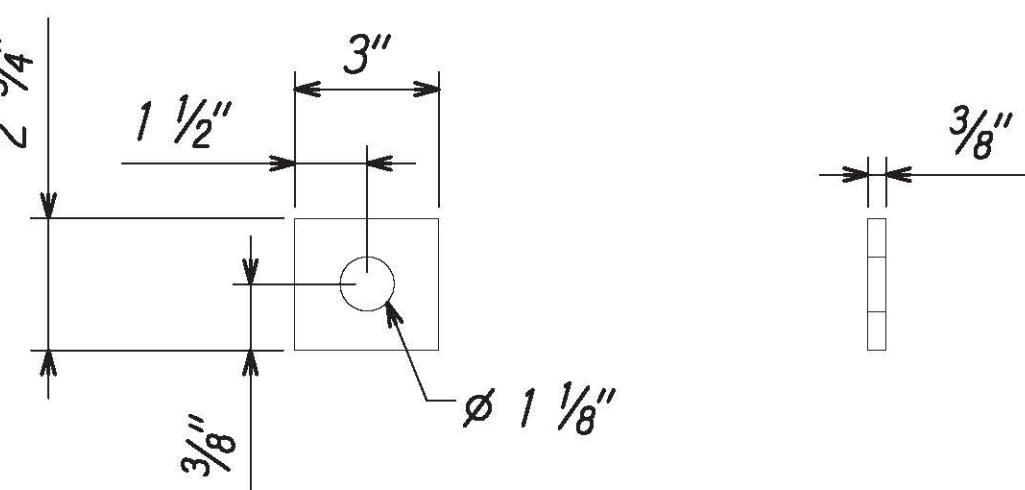

### ANCHOR BRACKET BEARING PLATE PART C3

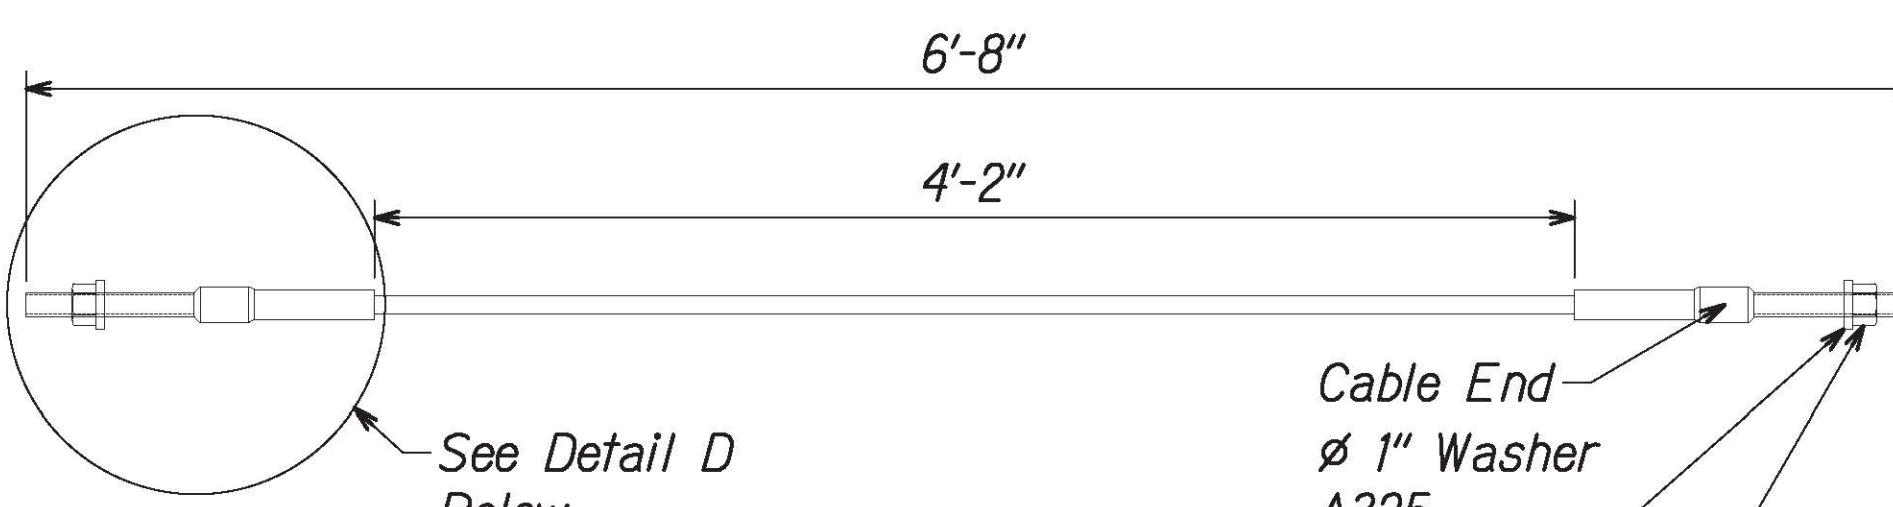

### BCT ANCHOR CABLE PART D1

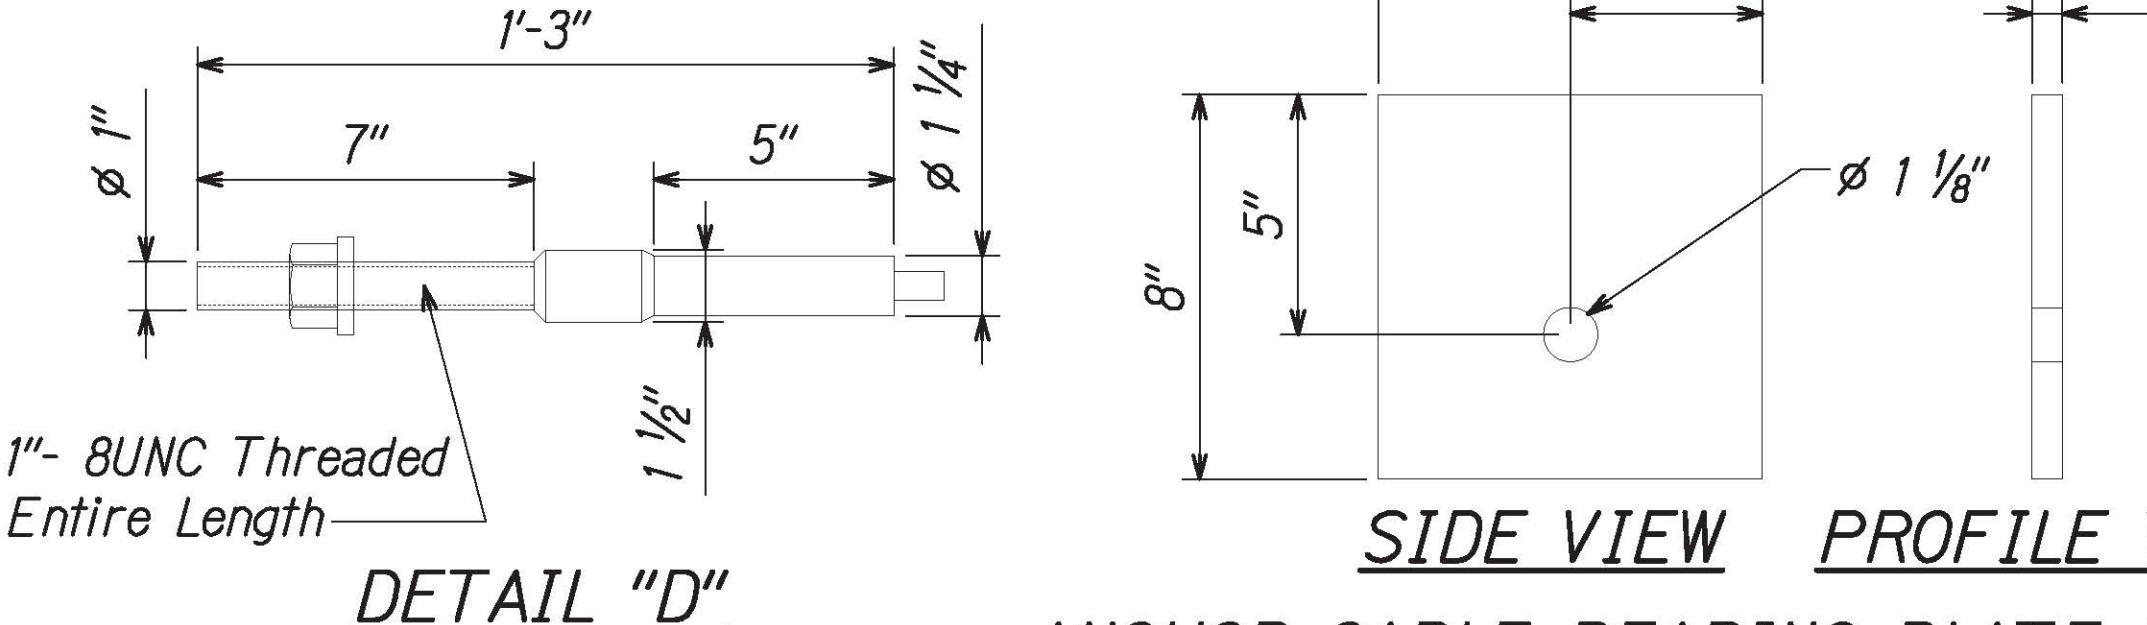


### SIDE VIEW PROFILE VIEW


### ANCHOR CABLE BEARING PLATE PART D2

### BCT ANCHOR CABLE DETAIL


### MGS LONG SPAN LSC-2 DETAILS

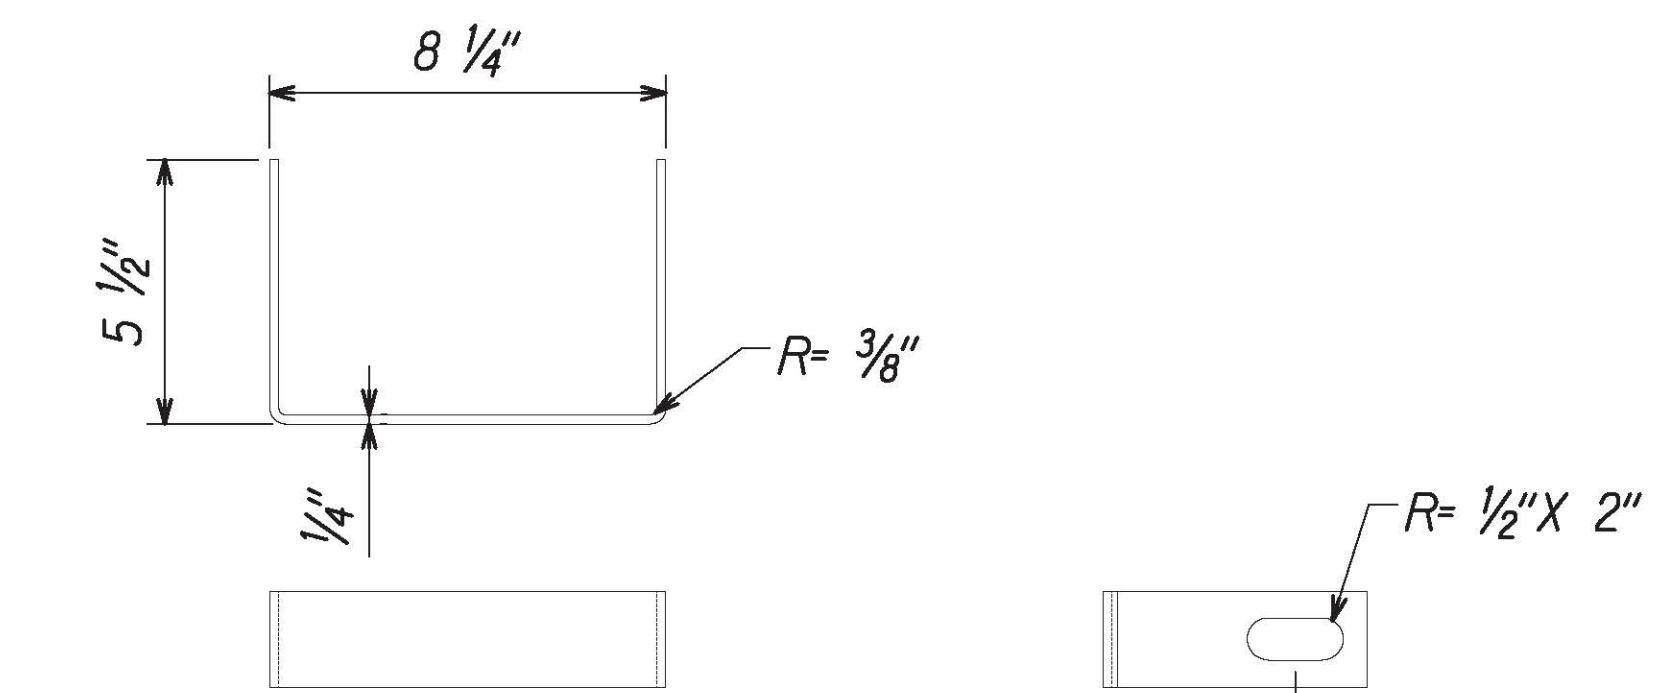

### YOKE DETAIL

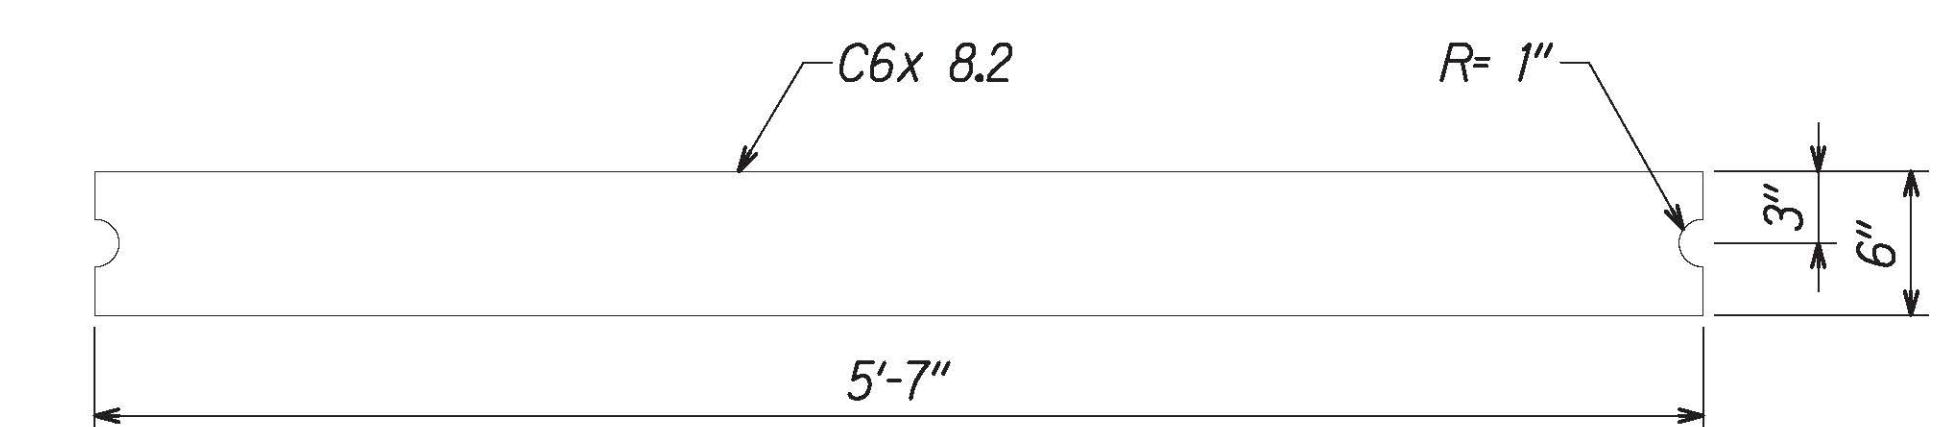

### STRUT DETAIL

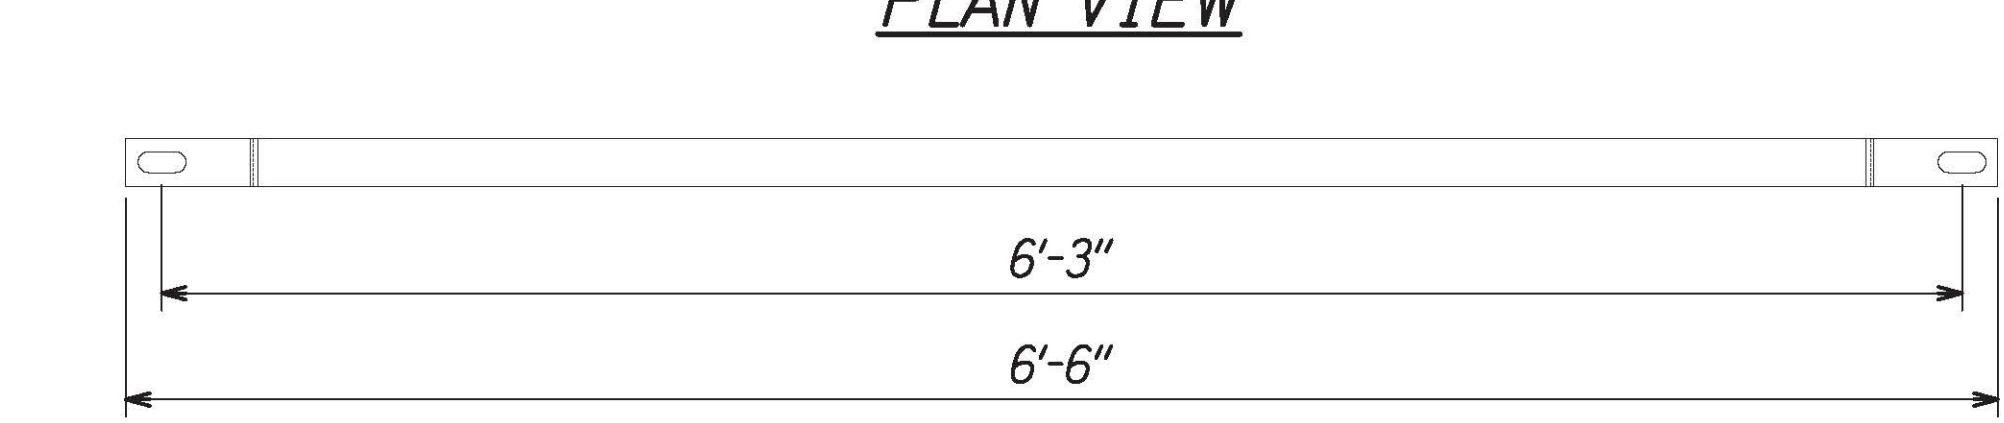

### FRONT VIEW

### GROUND STRUT PART C1

7/21/21	6	Added Sheet
DATE		REVISION

STATE OF HAWAII  
DEPARTMENT OF TRANSPORTATION  
HIGHWAYS DIVISION


### MGS LONG SPAN LSC-2

### INTERSTATE ROUTE H-1 RESURFACING

Miller Pedestrian Overpass to Kapiolani Interchange

Federal-Aid Project No. NH-HI-1(279)

Scale: NTS Date: August 2021

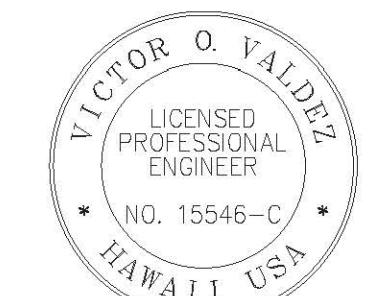





THIS WORK WAS PREPARED BY ME  
OR UNDER MY SUPERVISION

04/30/22  
EXPIRATION DATE  
OF THE LICENSE  
Signature


SHEET NO. R29D OF 41 SHEETS

ADD. 84S-4


FED. ROAD DIST. NO.	STATE	FED.-AID PROJ. NO.	FISCAL YEAR	SHEET NO.	TOTAL SHEETS
HAWAII	HAW.	NH-HI-1(279)	2021	ADD. 84S-5	304

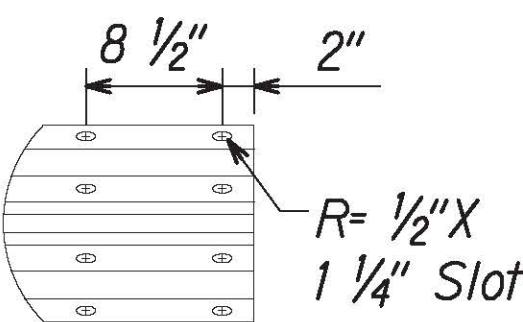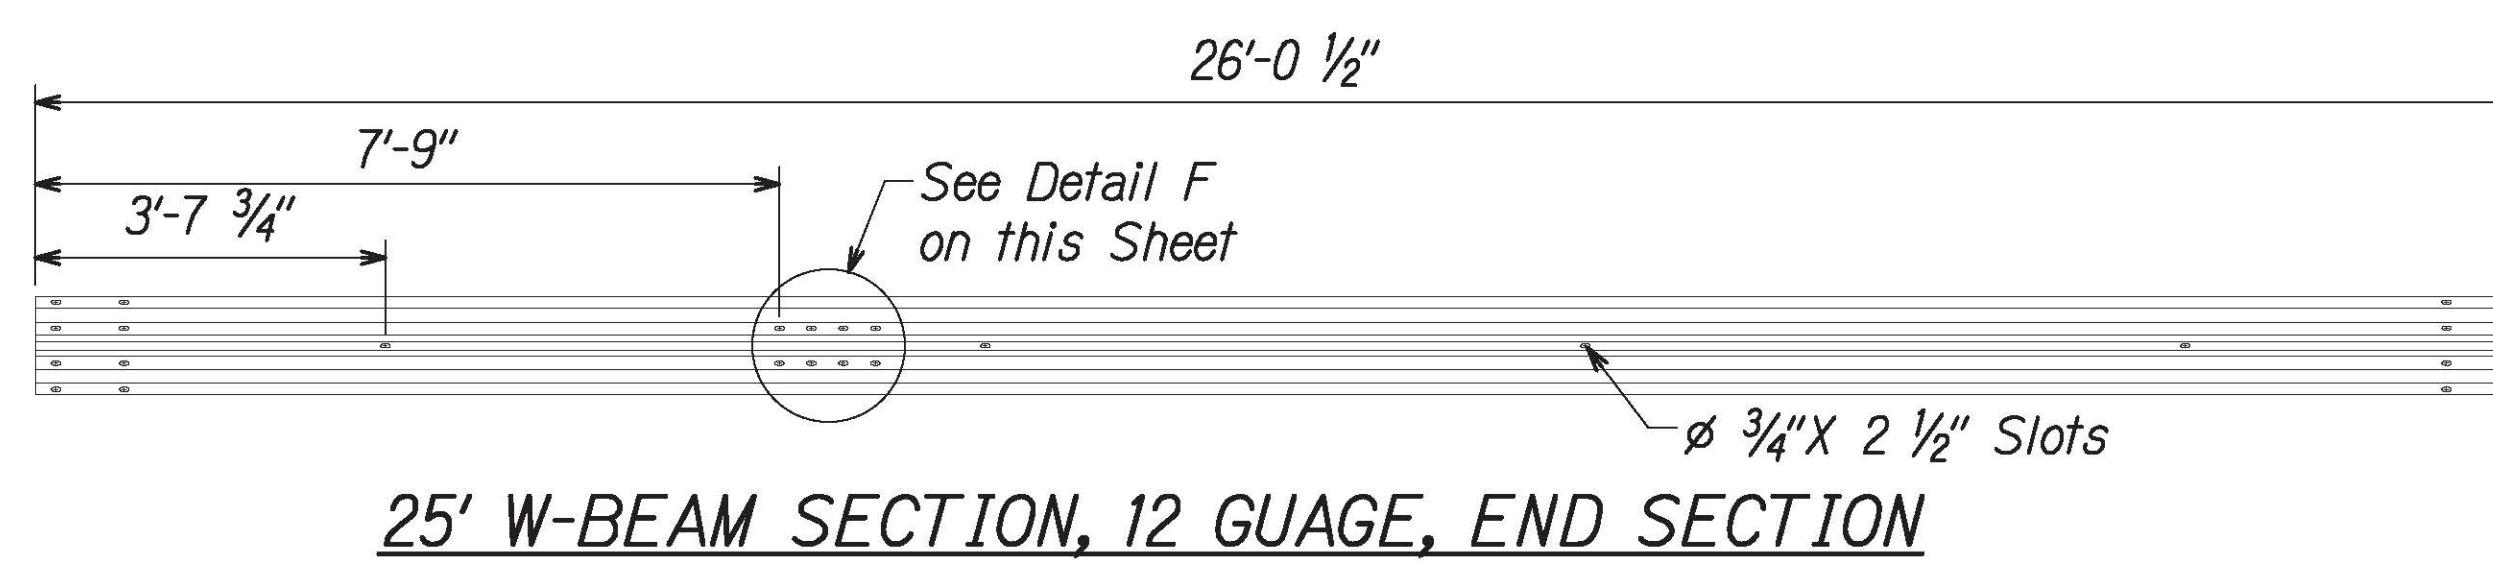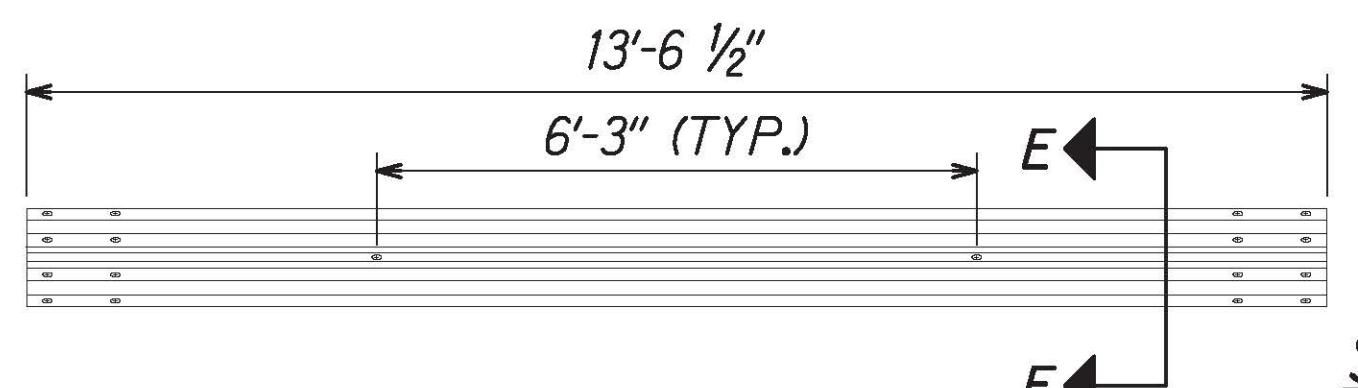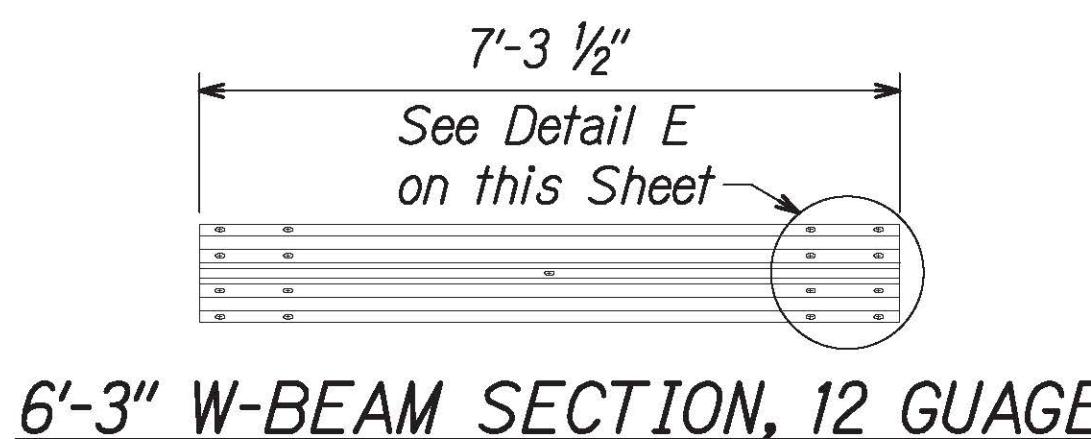


DETAIL E

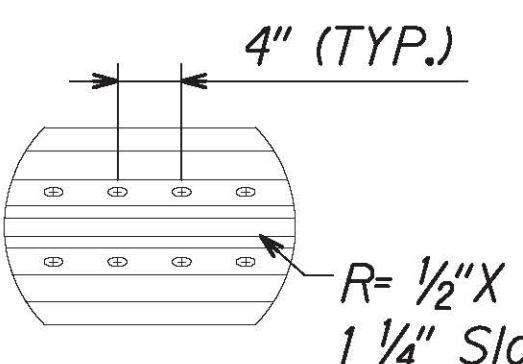


DETAIL F

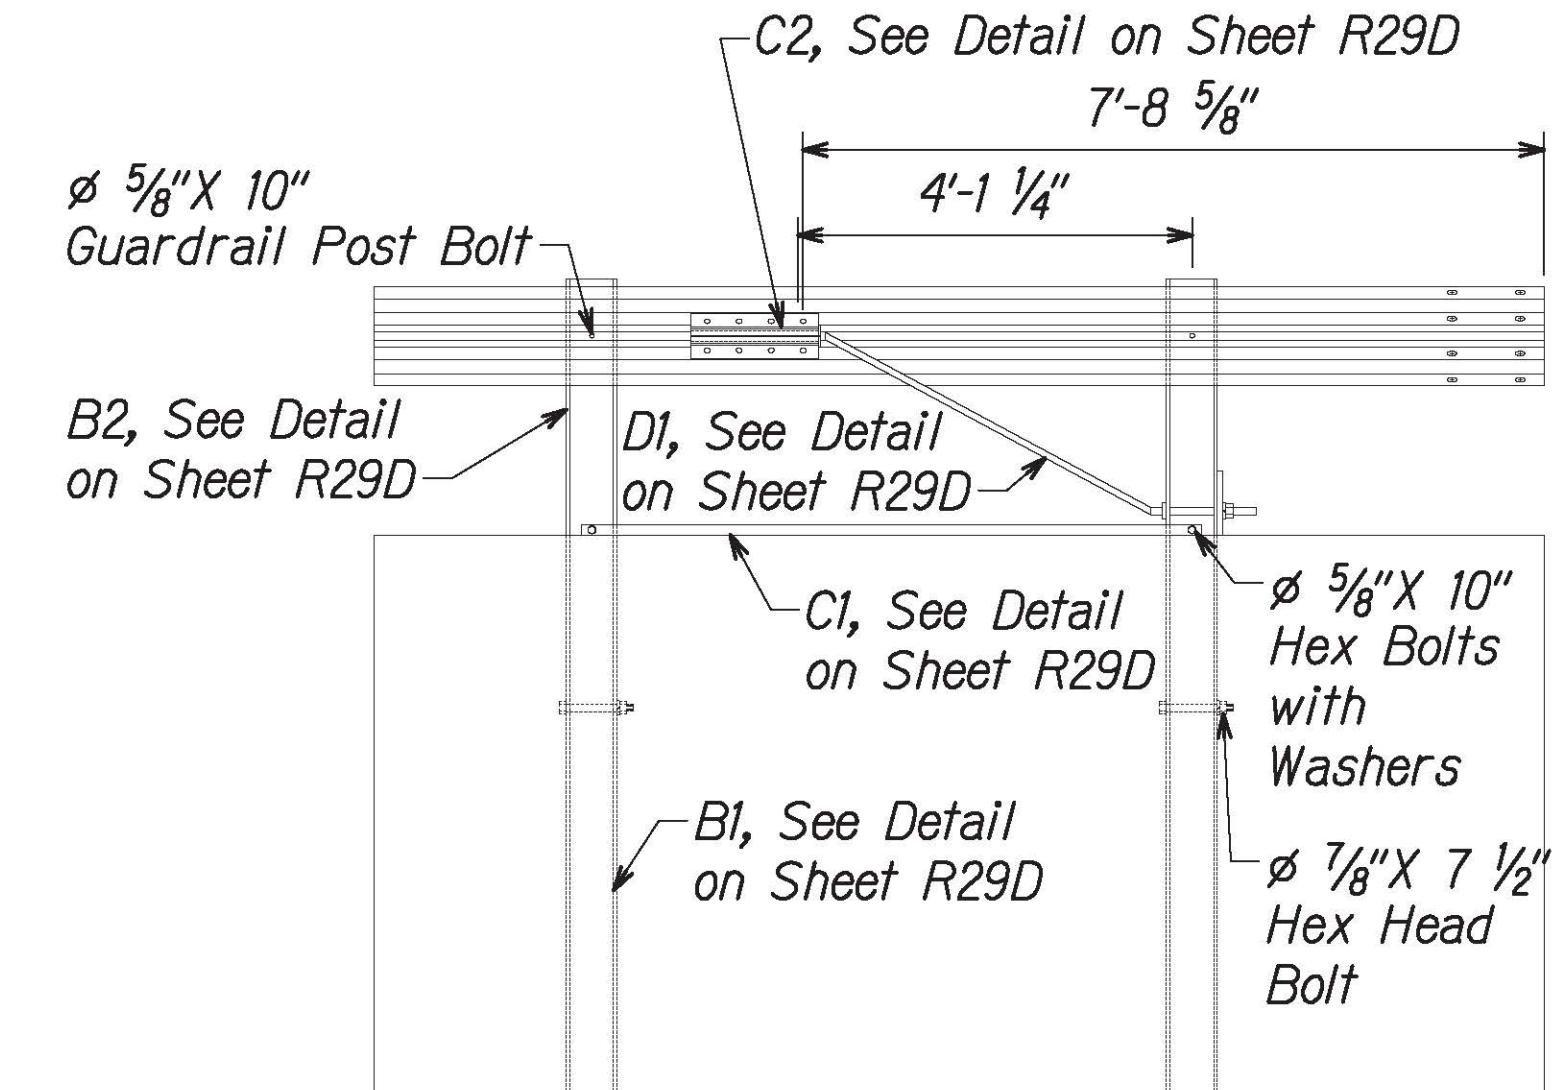


END RAIL DETAIL

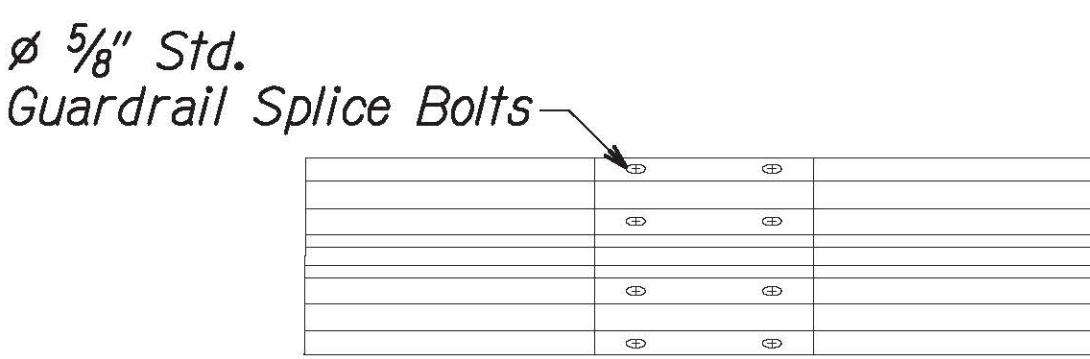

DETAIL "C"

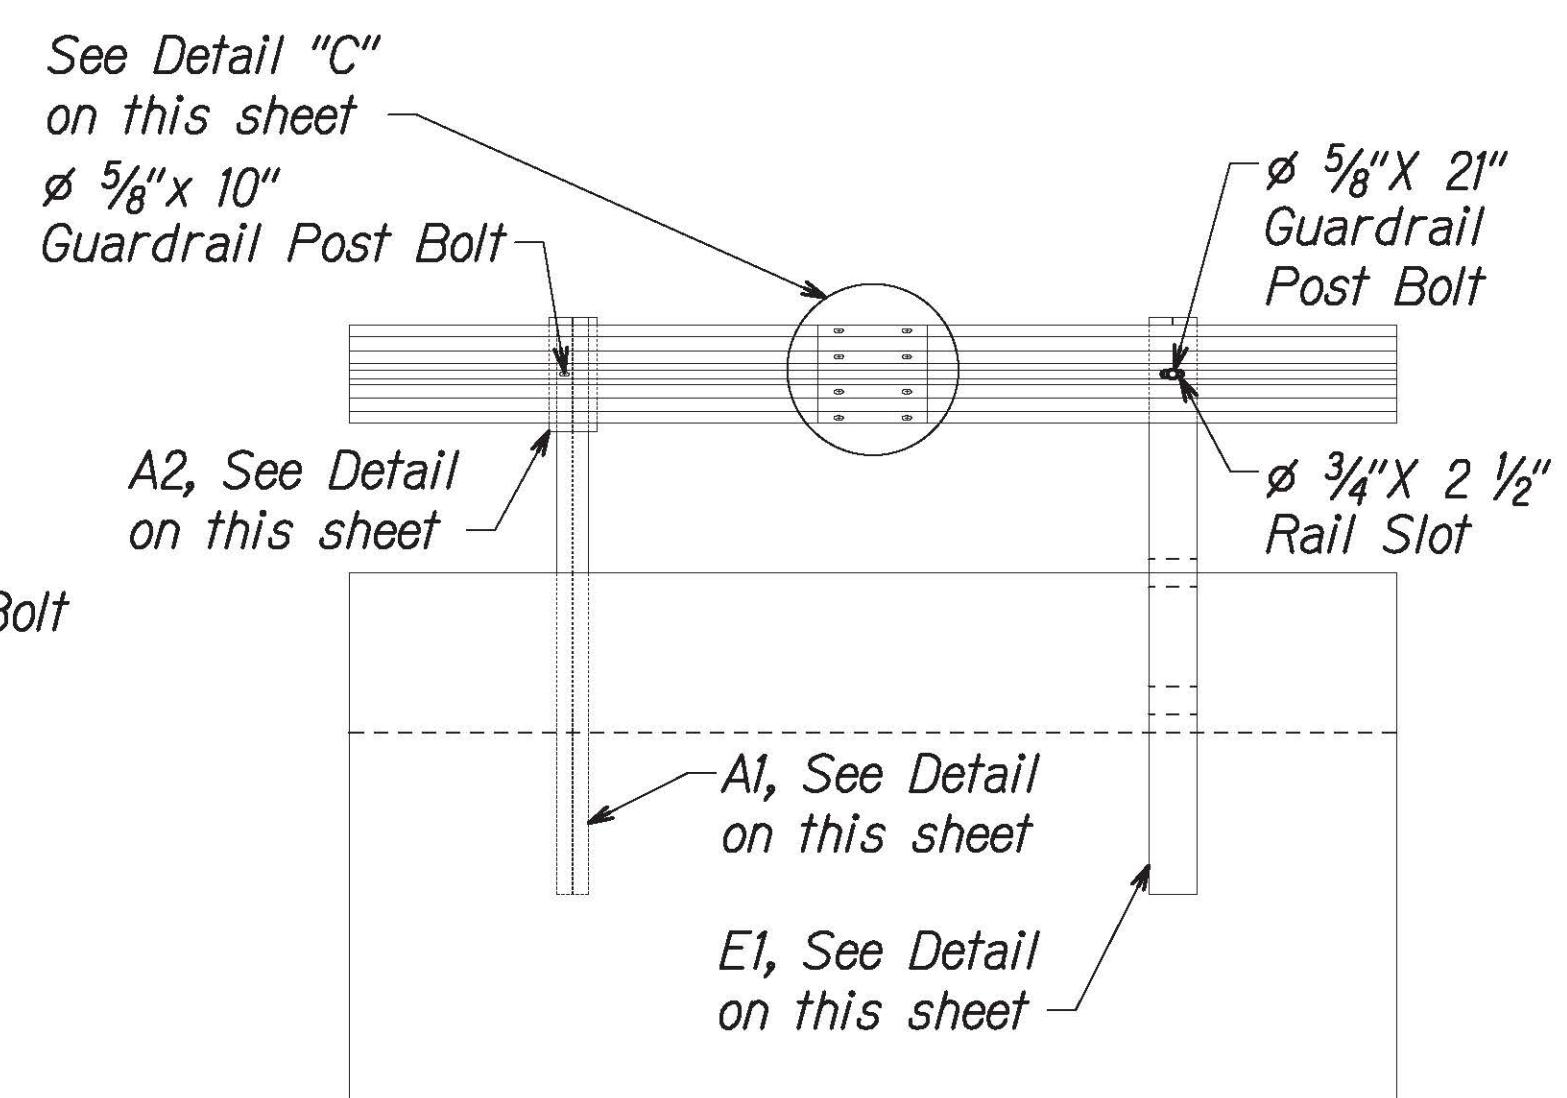


SPLICE DETAIL

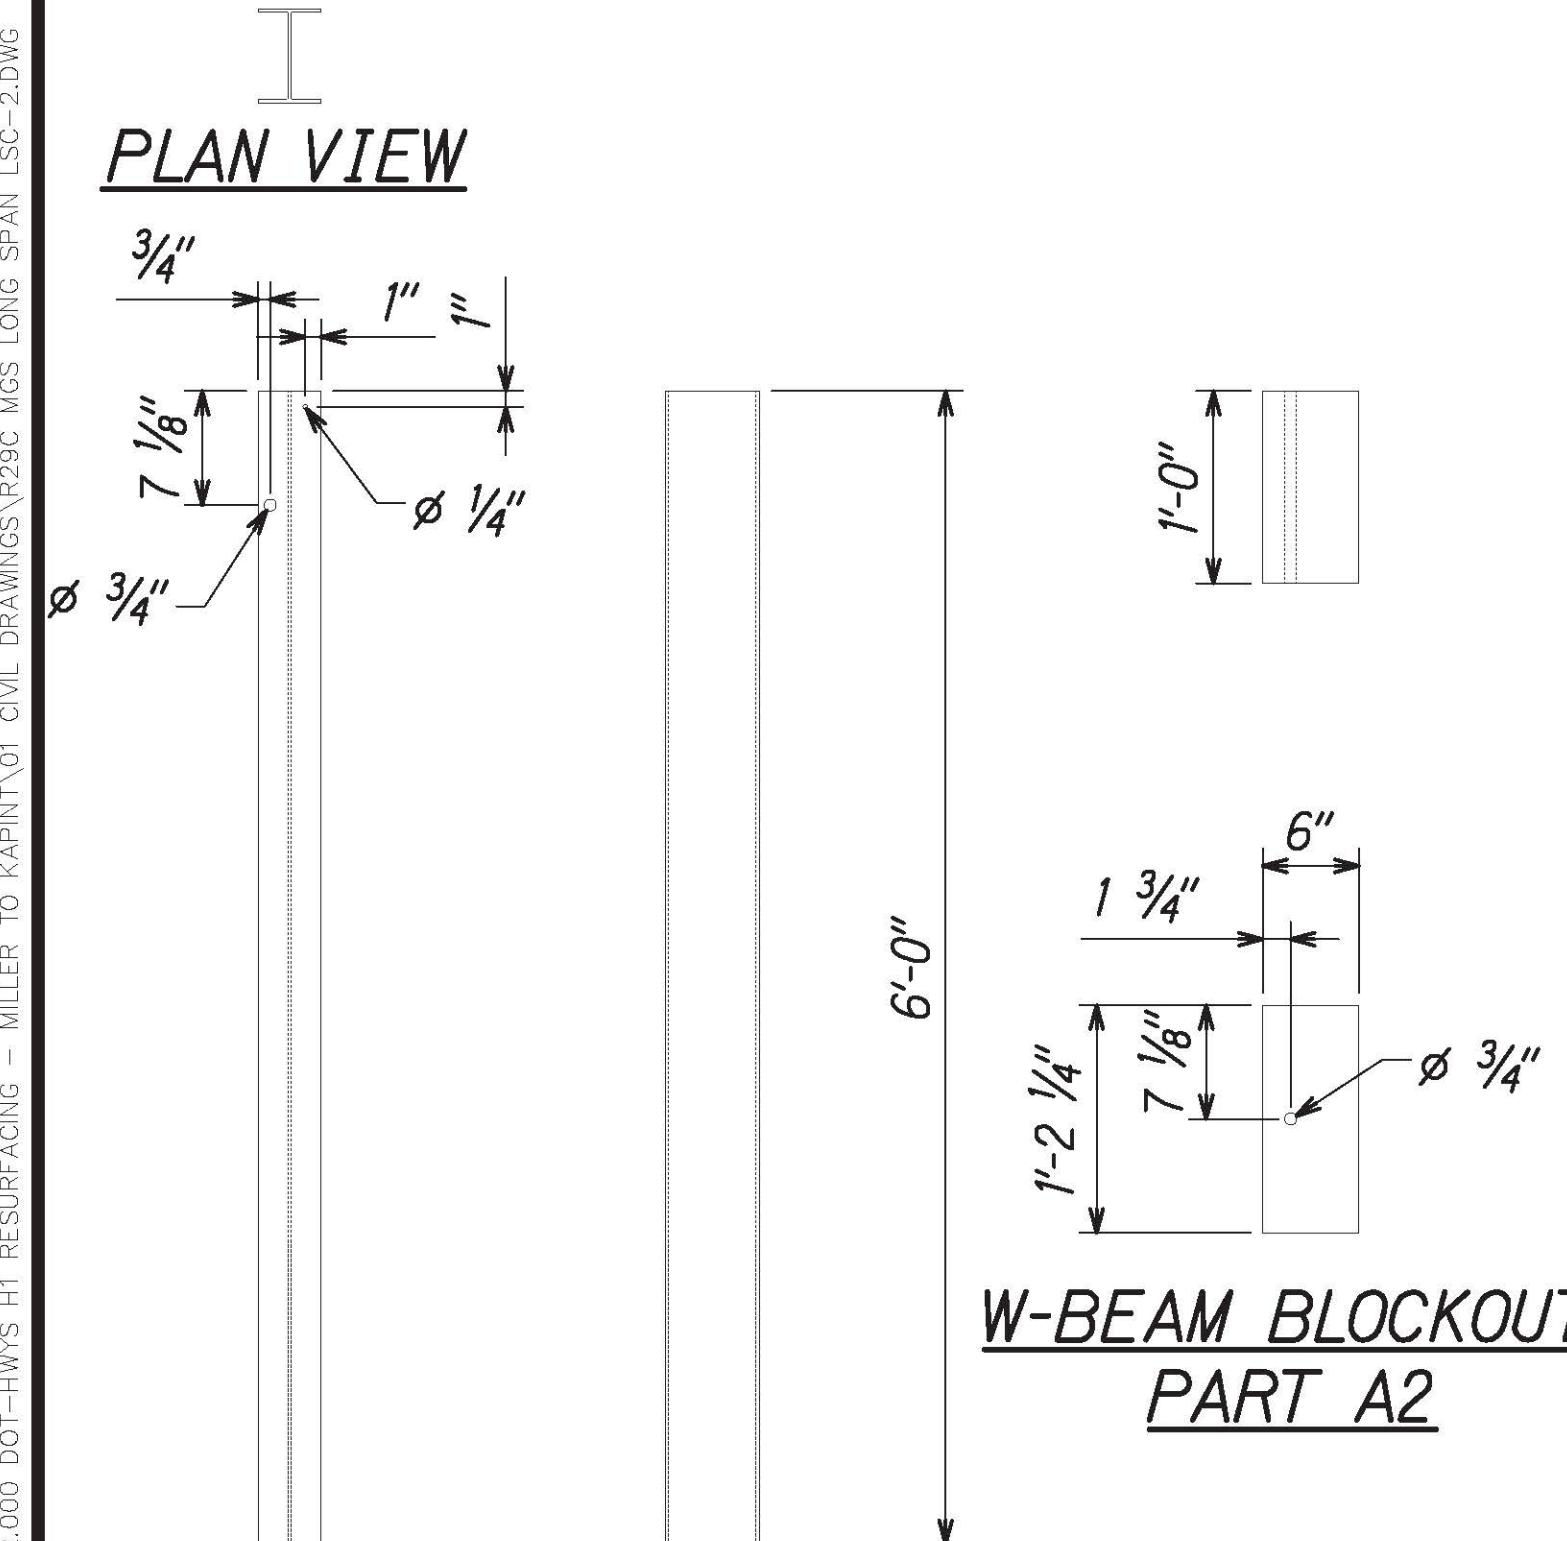


PROFILE VIEW SIDE VIEW

W6x 9-BEAM POST PART A1

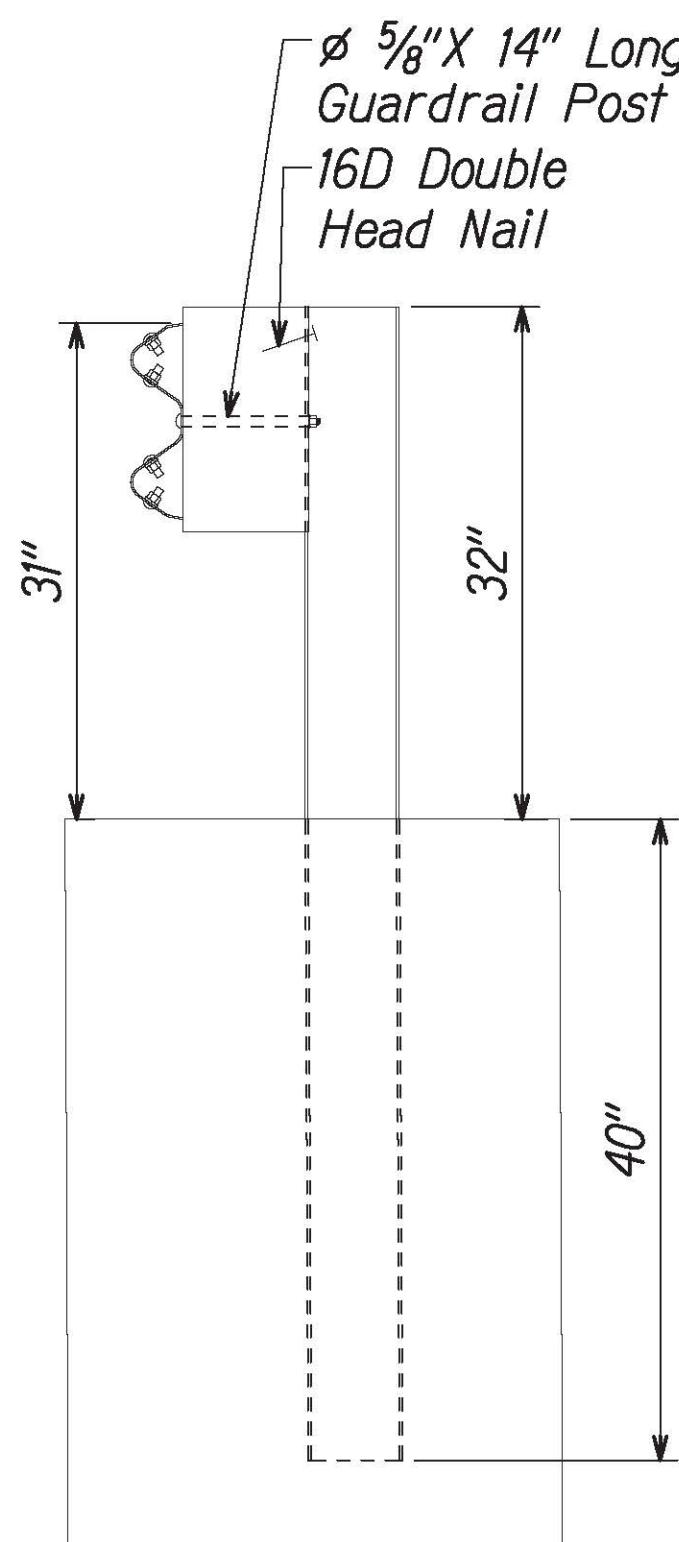


SECTION A-A

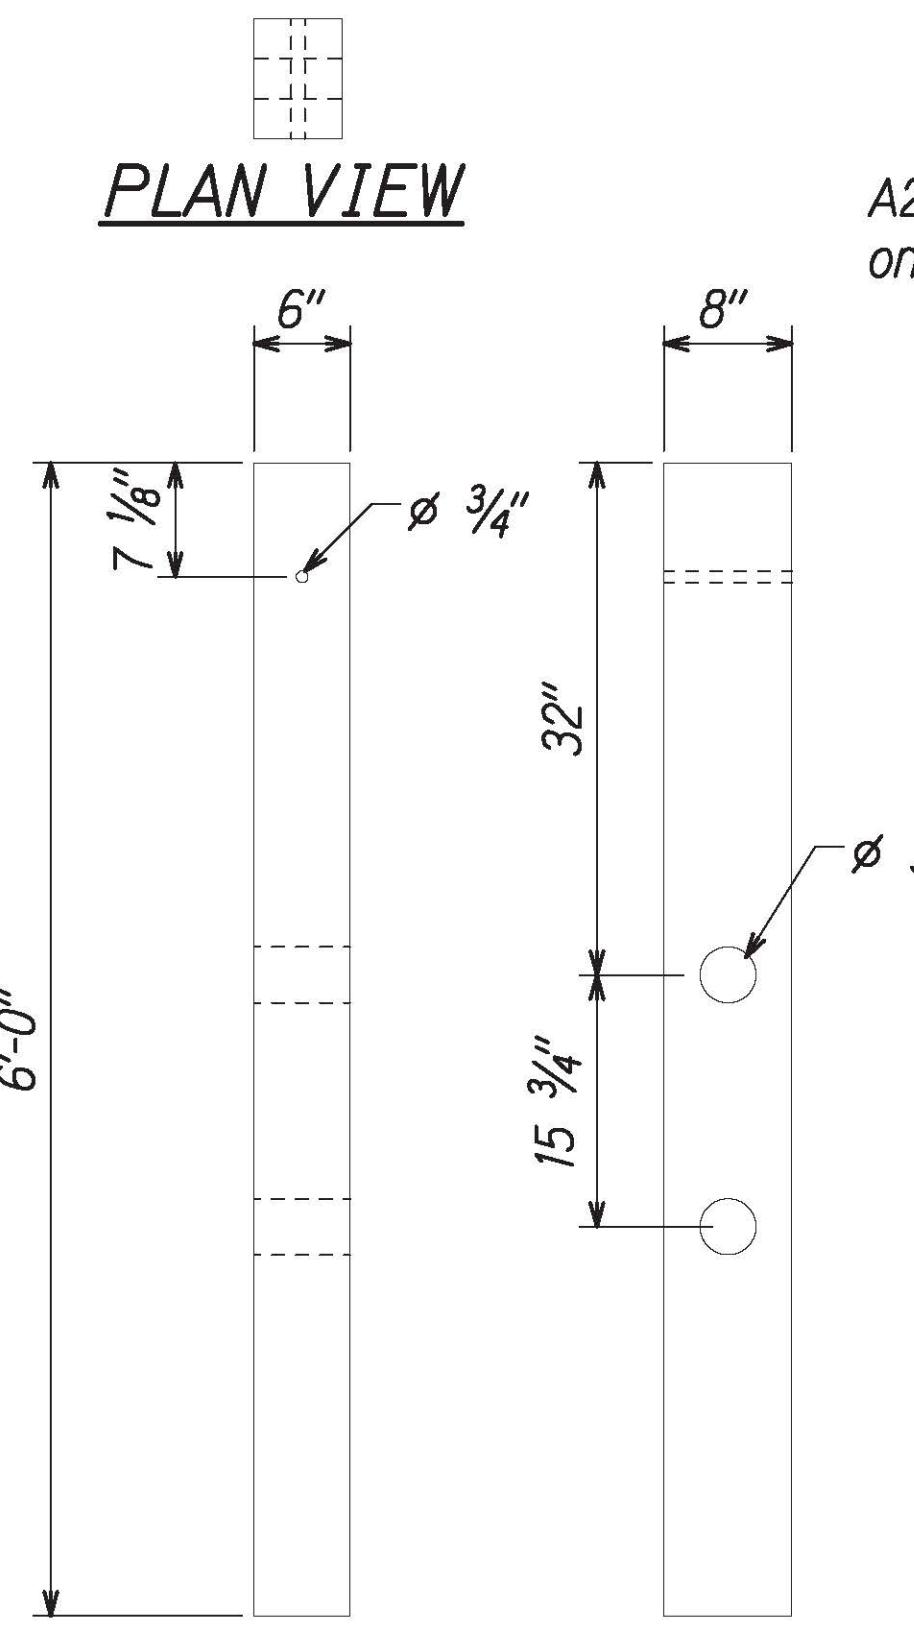

PROFILE VIEW SIDE VIEW

CRT WOOD POST PART E1

MGS LONG SPAN LSC-2 DETAILS △

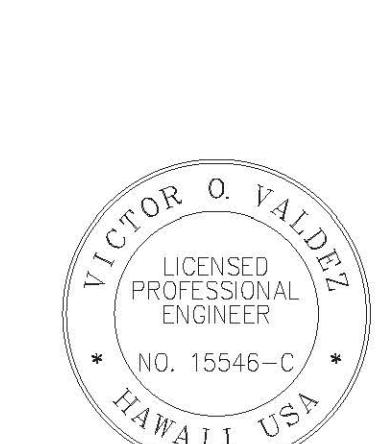


THIS WORK WAS PREPARED BY ME OR UNDER MY SUPERVISION

04/30/22 EXPIRATION DATE OF THE LICENSE


SIGNATURE Scale: NTS

7/21/21	<span style="color:red">△</span> Added Sheet
DATE	REVISION
STATE OF HAWAII DEPARTMENT OF TRANSPORTATION HIGHWAYS DIVISION	
<u>MGS LONG SPAN LSC-2</u>	
INTERSTATE ROUTE H-1 RESURFACING	
Miller Pedestrian Overpass to Kapiolani Interchange	
Federal-Aid Project No. NH-HI-1(279)	
Scale: NTS Date: August 2021	
SHEET No. R29E OF 41 SHEETS	

FED. ROAD DIST. NO.	STATE	FED.-AID PROJ. NO.	FISCAL YEAR	HEET NO.	TOTAL SHEETS
HAWAII	HAW.	NH-HI-1(279)	2021	ADD. 93	304

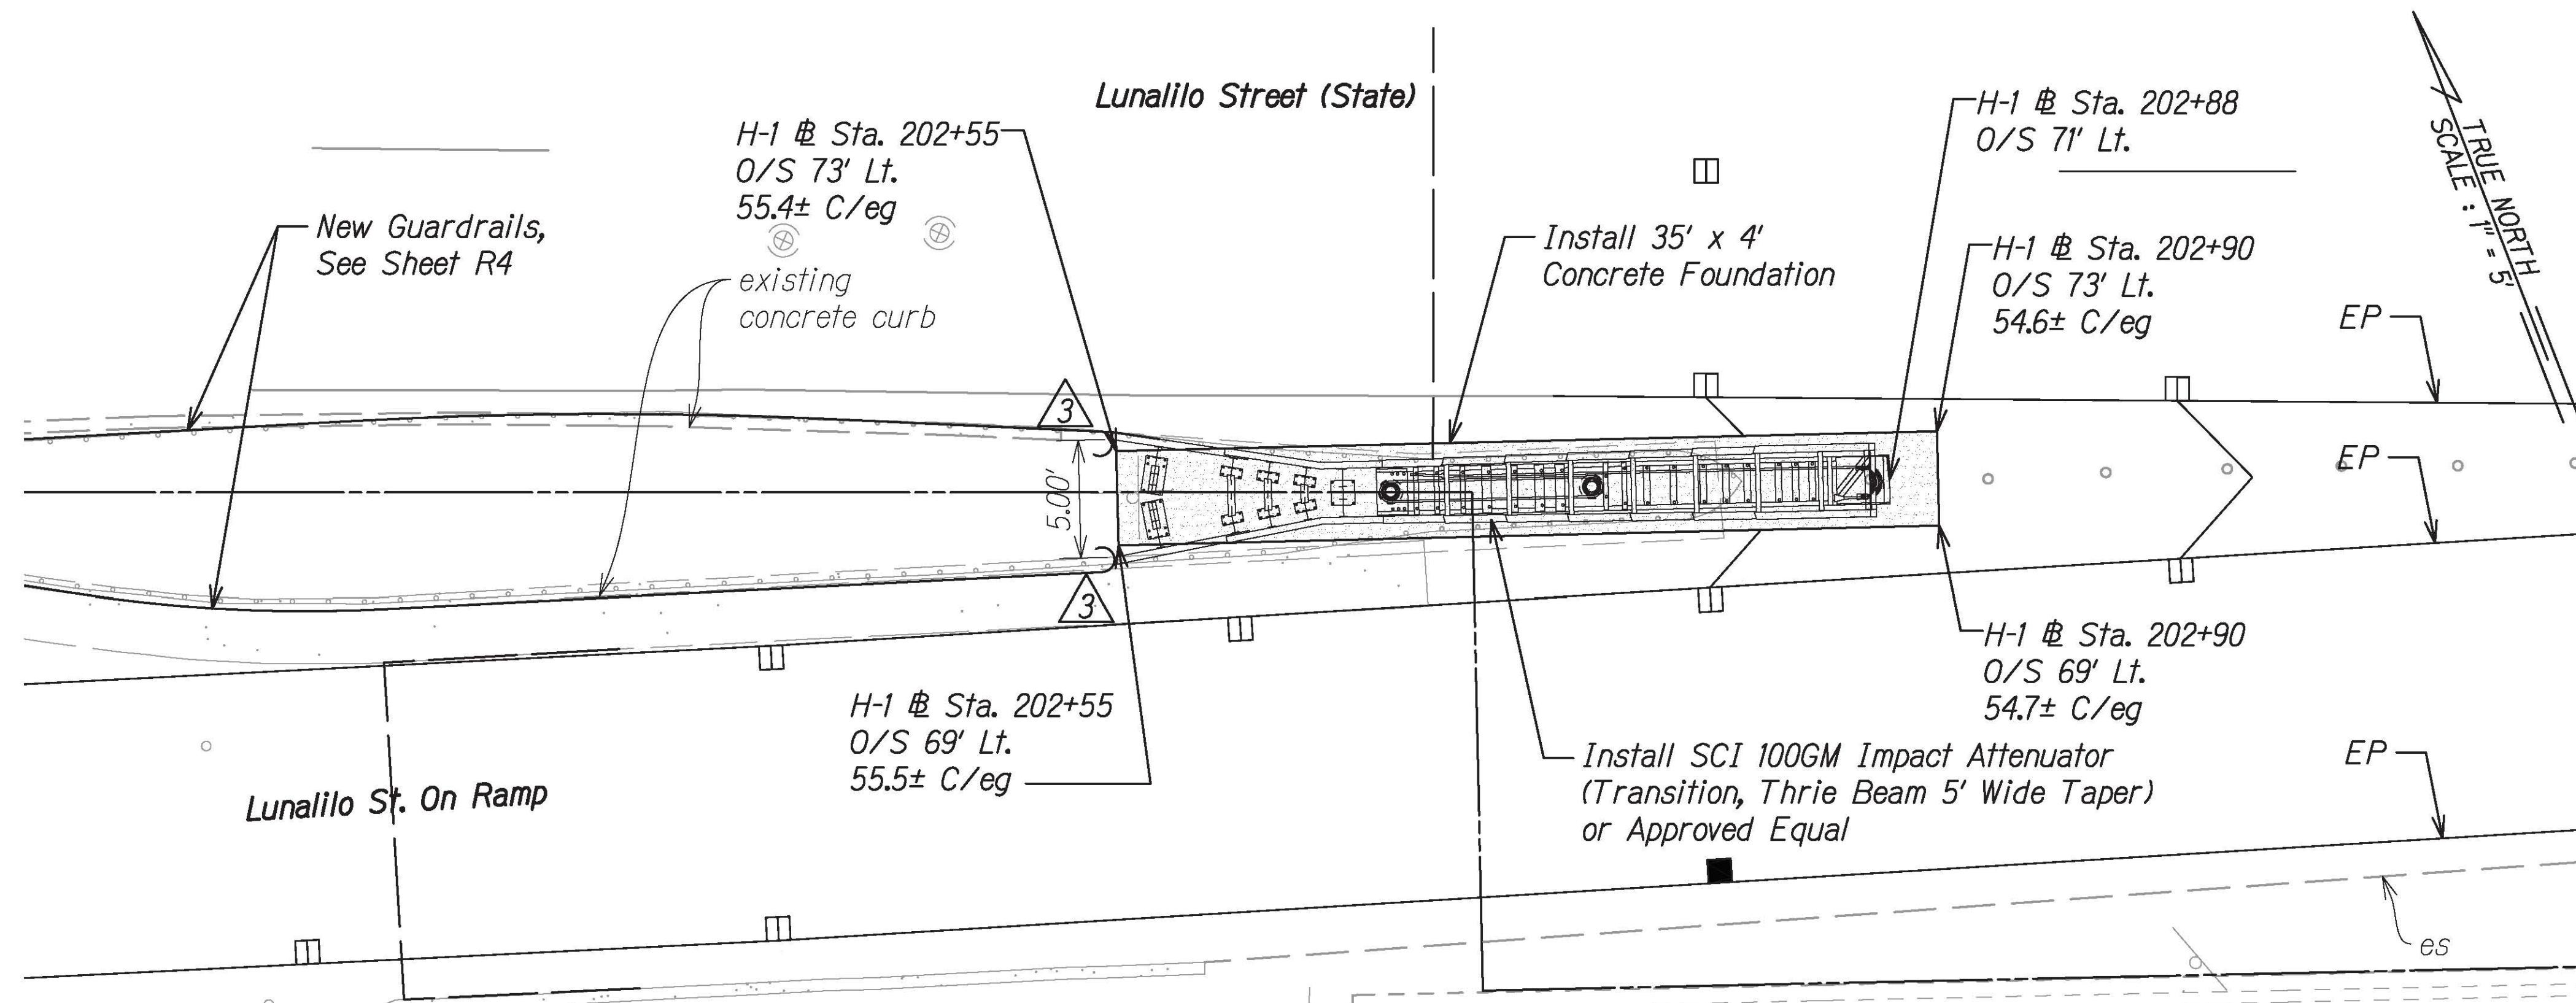


H-1 (WESTBOUND)  
**LUNALILO STREET ON RAMP**  
SCALE: 1" = 5'

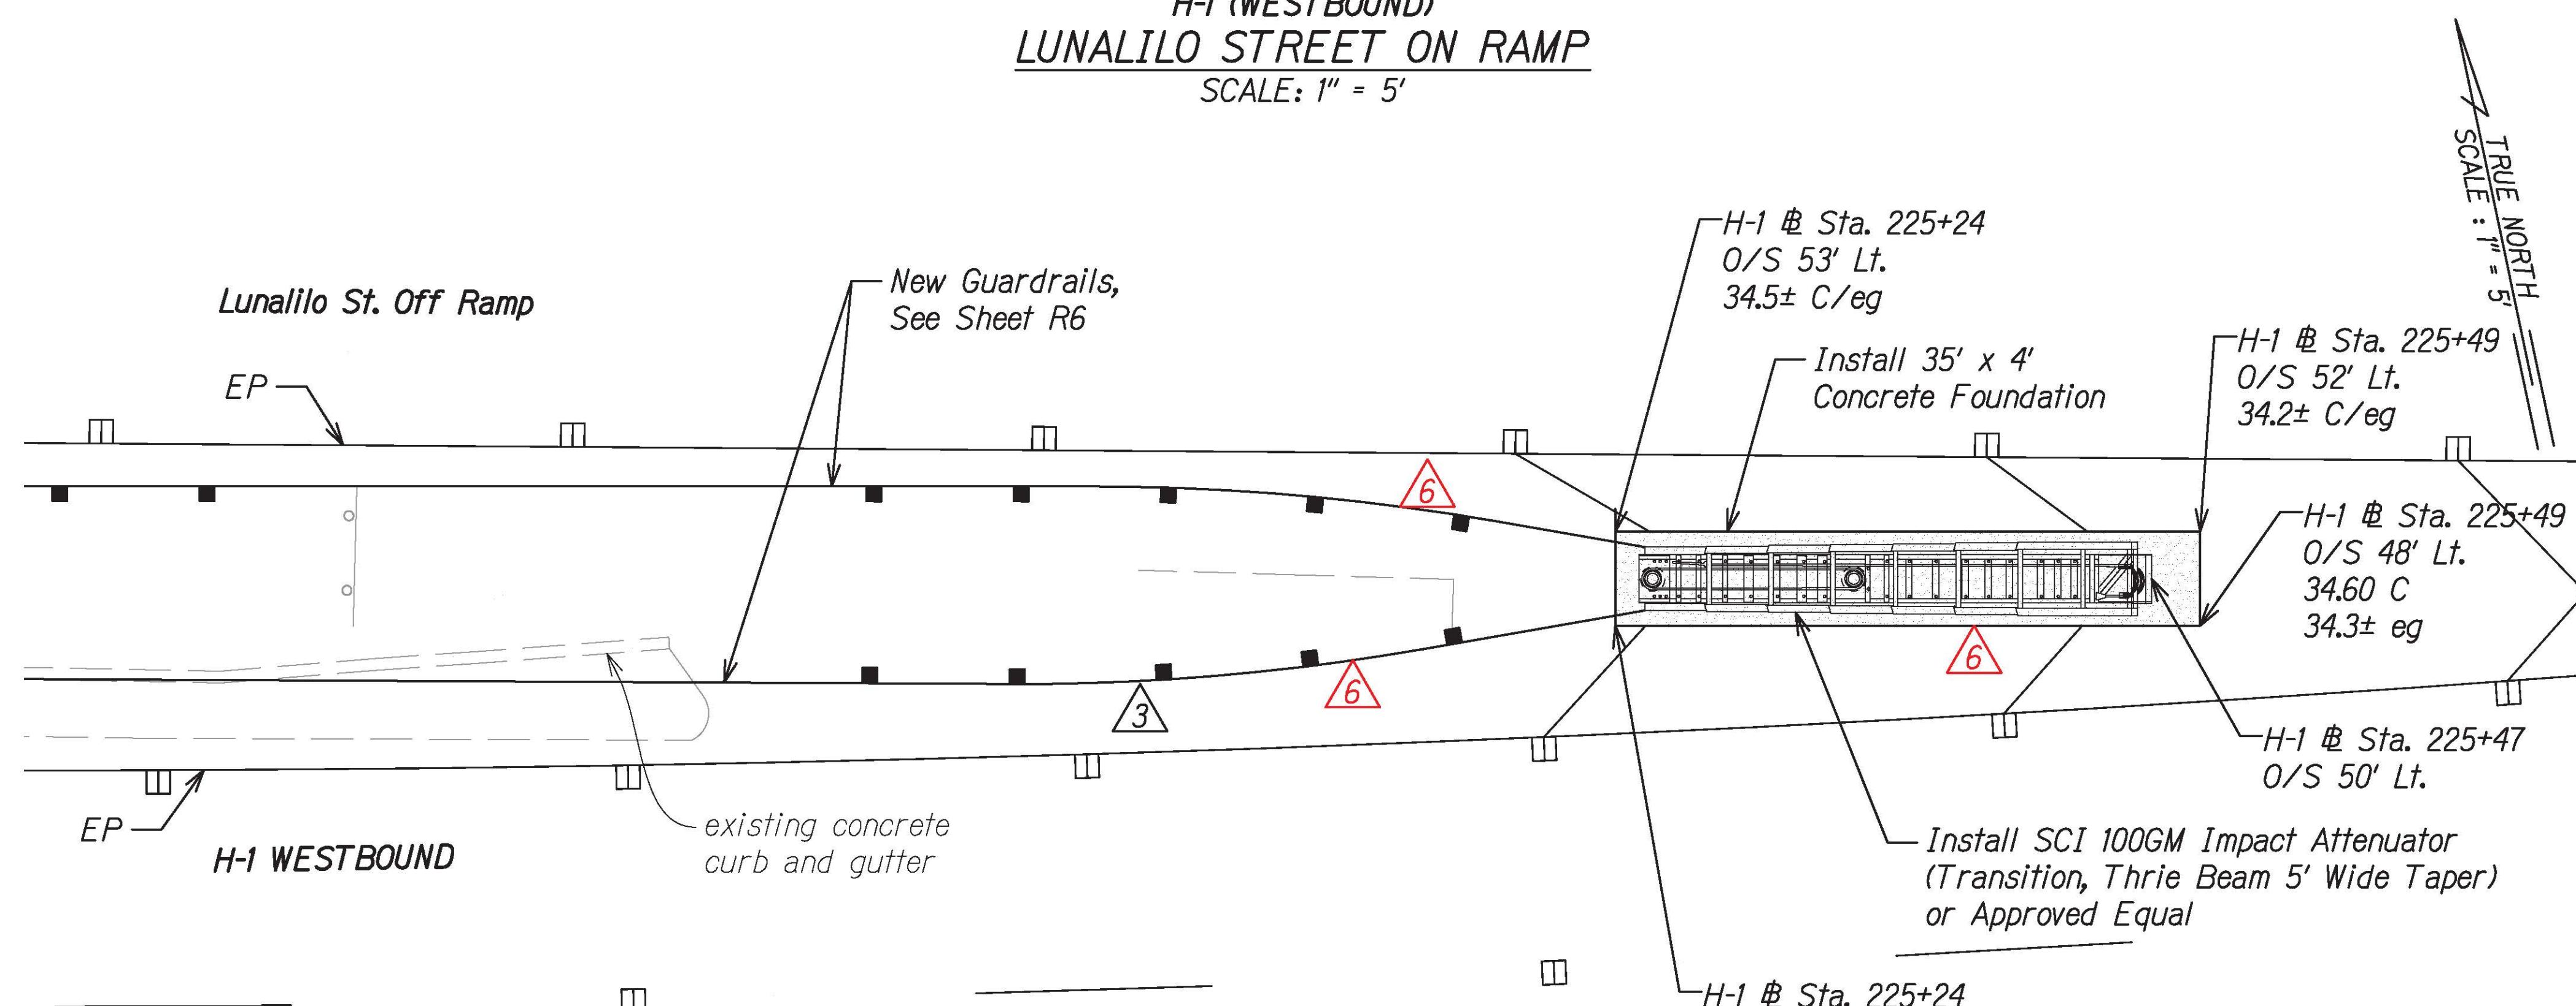

H-1 (WESTBOUND)  
**LUNALILO STREET OFF RAMP**  
SCALE: 1" = 5'

GRAPHICAL SCALE:  
5' 0 5' 10'  
Scale: 1" = 5'

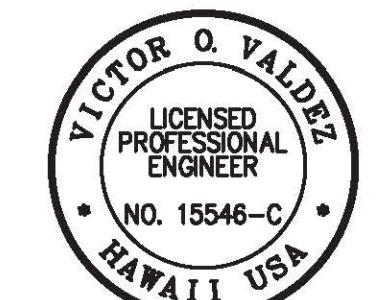


THIS WORK WAS PREPARED BY ME  
OR UNDER MY SUPERVISION  
Signature  
04/30/22  
SIGNATURE  
EXPIRATION DATE  
OF THE LICENSE  
Scale: 1" = 5'

7/21/21	Revised Guardrail and Moved Attenuator
7/9/21	Revised Guardrails
DATE	REVISION
STATE OF HAWAII DEPARTMENT OF TRANSPORTATION HIGHWAYS DIVISION	
<b>IMPACT ATTENUATOR DETAILS</b>	
INTERSTATE ROUTE H-1 RESURFACING Miller Pedestrian Overpass to Kapiolani Interchange Federal-Aid Project No. NH-HI-1(279)	
Scale: 1" = 5' Date: August 2021	
SHEET No. R38 OF 41 SHEETS	


FED. ROAD DIST. NO.	STATE	FED.-AID PROJ. NO.	FISCAL YEAR	SHEET NO.	TOTAL SHEETS
HAWAII	HAW.	NH-HI-1(279)	2021	ADD. 143	304

BEGIN PROJECT  
FAP No. NH-HI-1(279)  
H-1 # Sta. 172+64

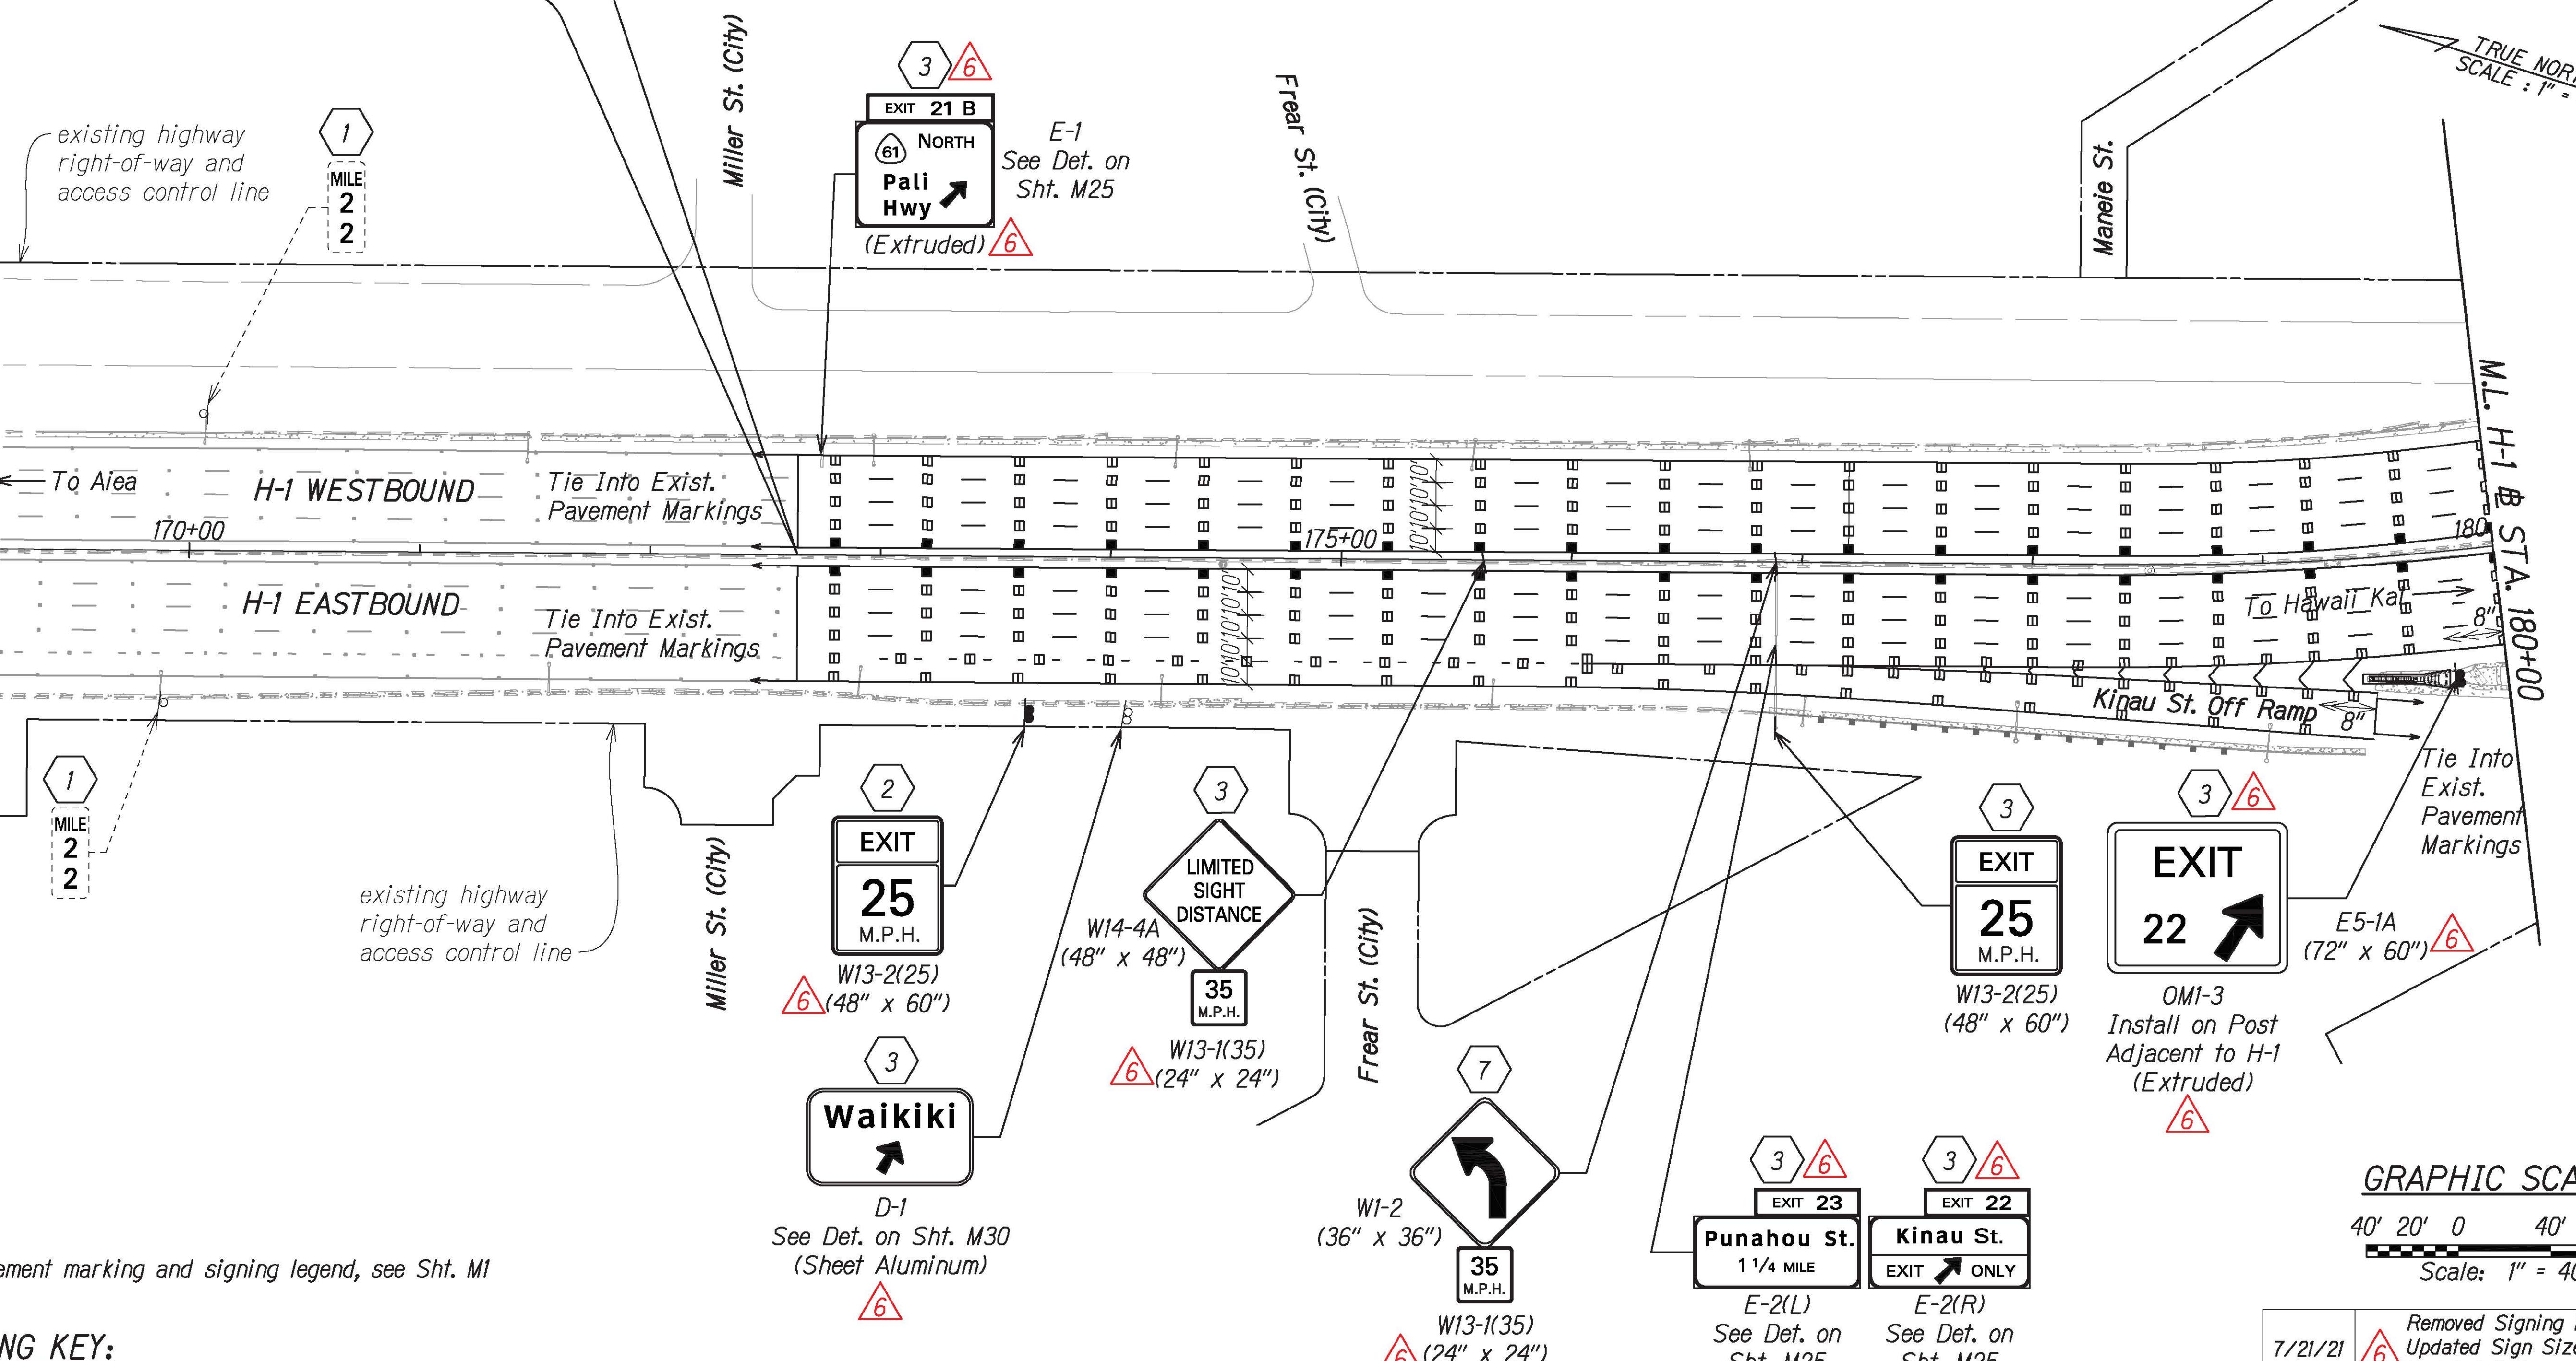

GRAPHIC SCALE:  
40' 20' 0 40' 80'  
Scale: 1" = 40'


7/21/21	Removed Signing Key No. 10, Updated Sign Size and Updated Reference Note ⑥
DATE	REVISION
STATE OF HAWAII DEPARTMENT OF TRANSPORTATION HIGHWAYS DIVISION	
<b>PAVEMENT MARKING &amp; SIGNING PLAN</b>	
INTERSTATE ROUTE H-1 RESURFACING Miller Pedestrian Overpass to Kapiolani Interchange	
Federal-Aid Project No. NH-HI-1(279)	
Scale: 1" = 40'	
Date: August 2021	
SHEET NO. M2 OF 34 SHEETS	

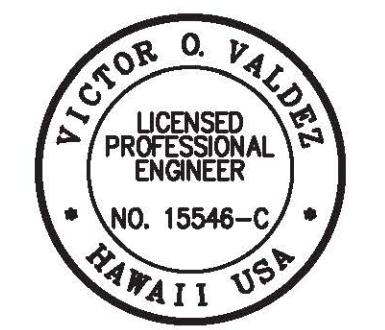

THIS WORK WAS PREPARED BY ME  
OR UNDER MY SUPERVISION  
  
04/30/22  
SIGNATURE  
EXPIRATION DATE  
OF THE LICENSE

ADD. 143

FED. ROAD DIST. NO.	STATE	FED.-AID PROJ. NO.	FISCAL YEAR	HEET NO.	TOTAL SHEETS
HAWAII	HAW.	NH-HI-1(279)	2021	ADD. 144	304

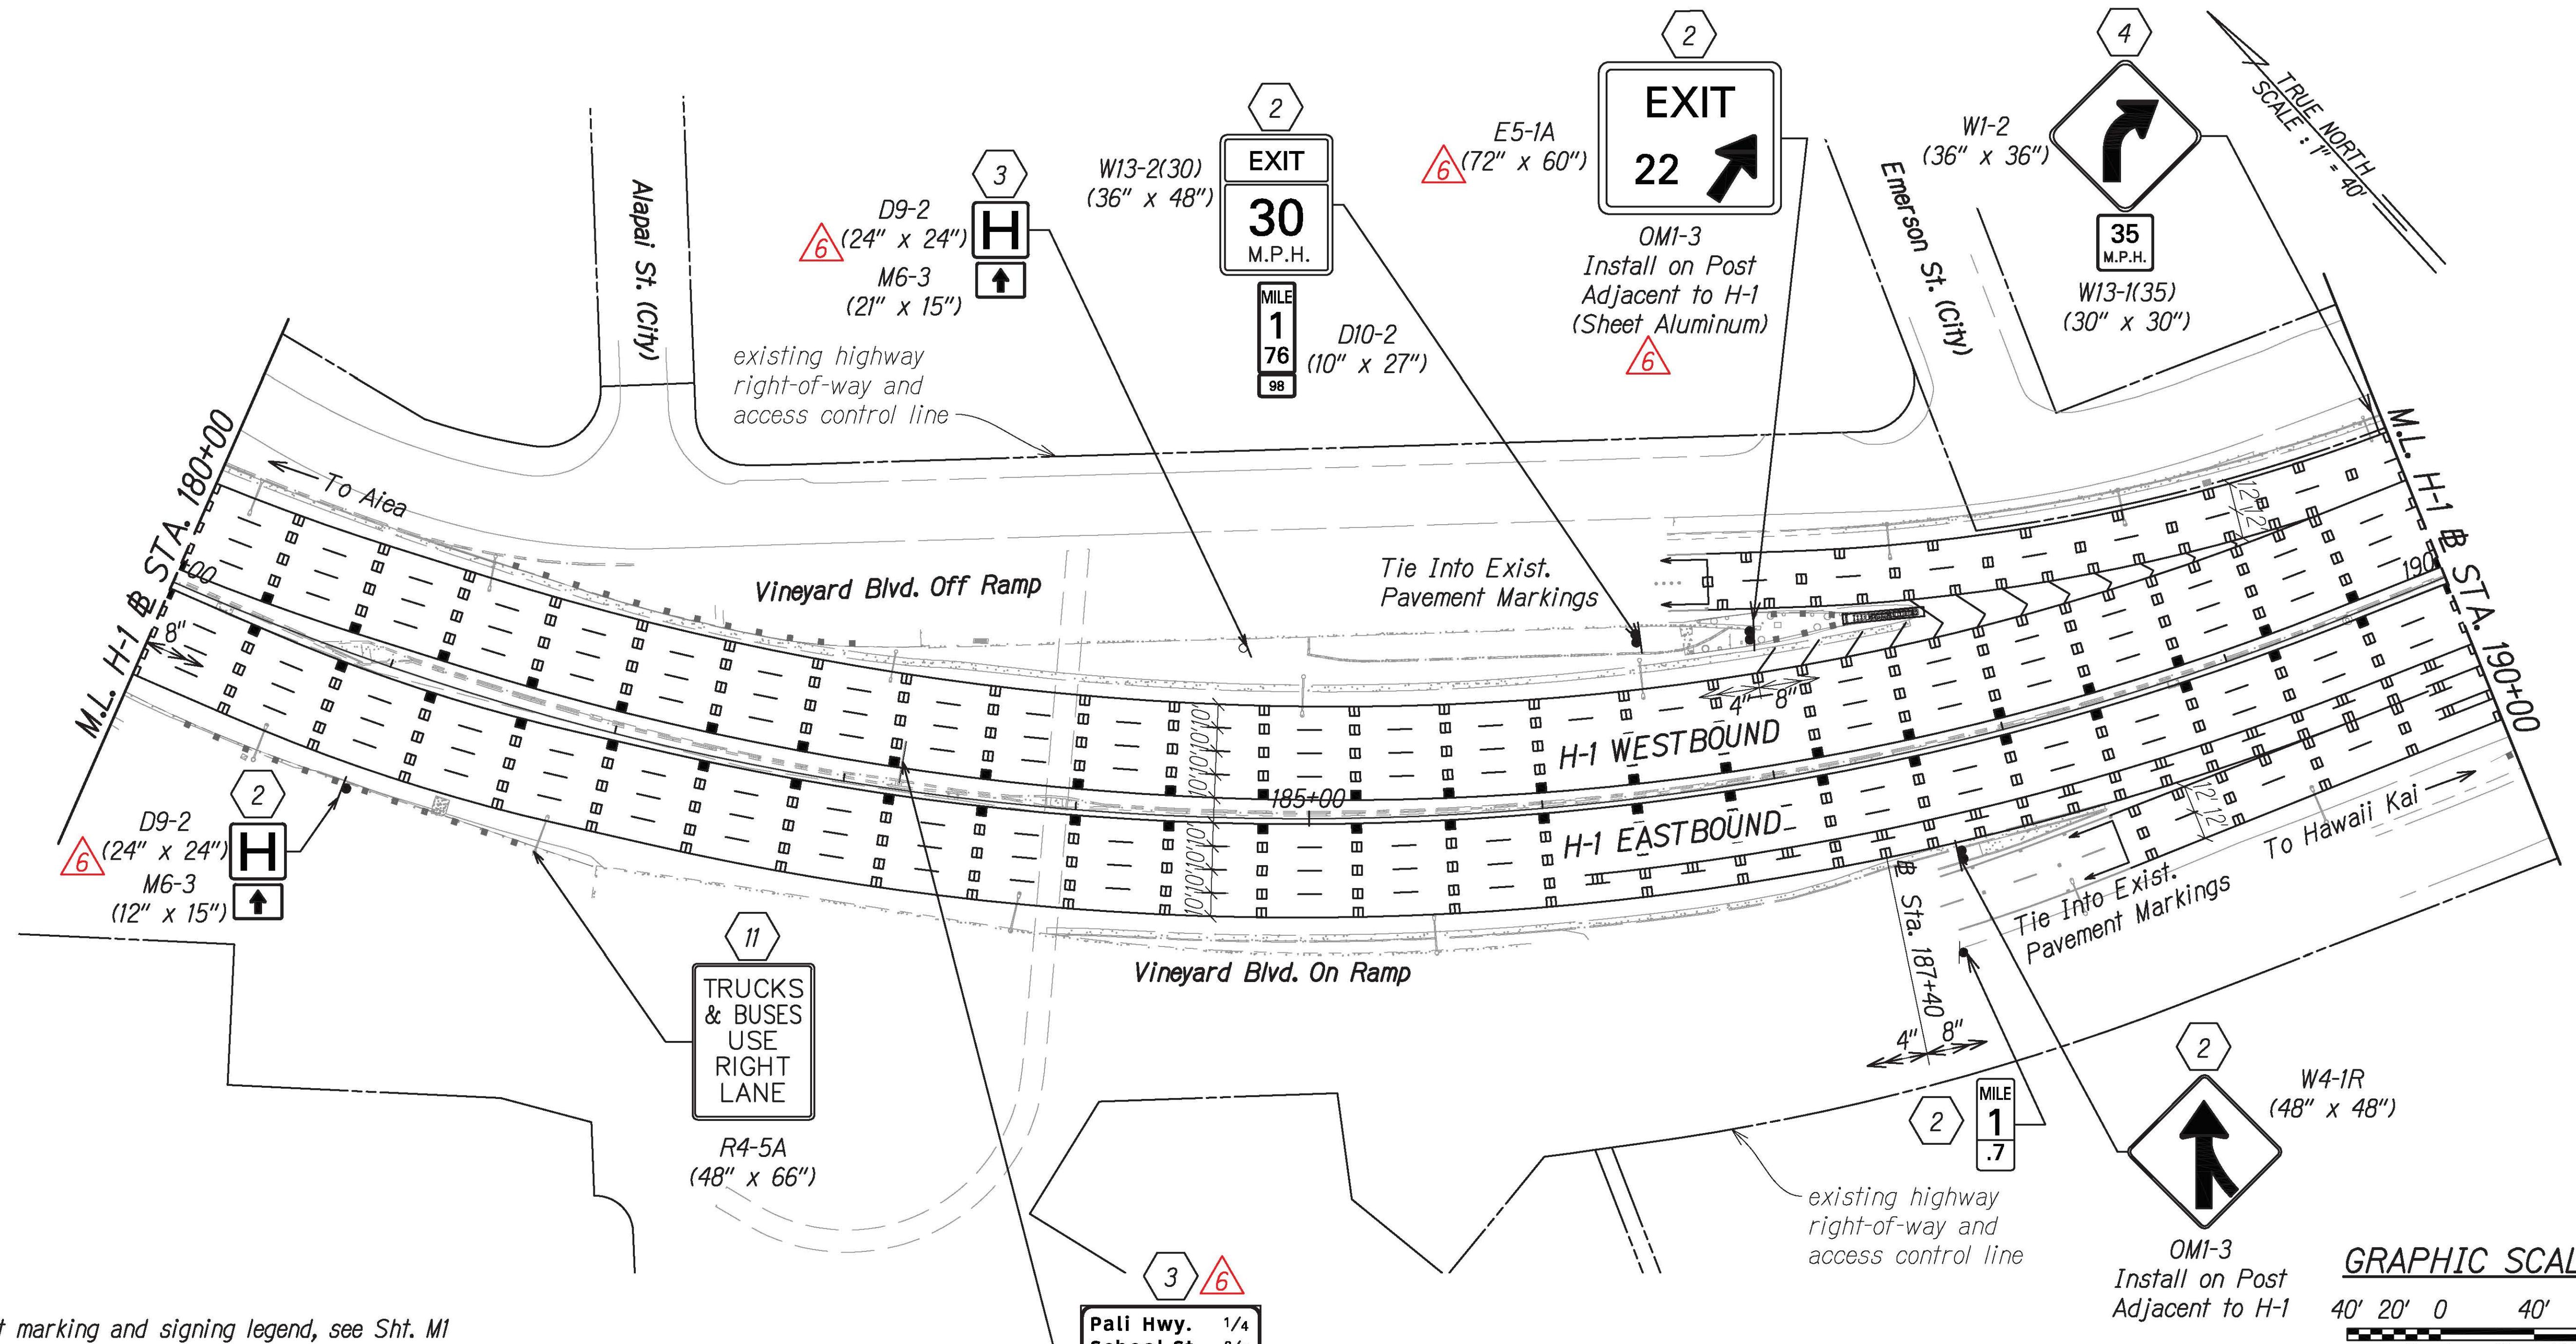

#### GRAPHIC SCALE:


40' 20' 0 40' 80'  
Scale: 1" = 40'

7/21/21	Removed Signing Key No. 10, Updated Sign Size and Updated Reference Note <b>(6)</b>
DATE	REVISION
STATE OF HAWAII DEPARTMENT OF TRANSPORTATION HIGHWAYS DIVISION	
<b>PAVEMENT MARKING &amp; SIGNING PLAN</b>	
INTERSTATE ROUTE H-1 RESURFACING	
Miller Pedestrian Overpass to Kapiolani Interchange	
Federal-Aid Project No. NH-HI-1(279)	
Scale: 1" = 40'	
Date: August 2021	
SHEET No. M3 OF 34 SHEETS	




THIS WORK WAS PREPARED BY ME  
OR UNDER MY SUPERVISION

*[Signature]* 04/30/22  
SIGNATURE EXPIRATION DATE  
OF THE LICENSE

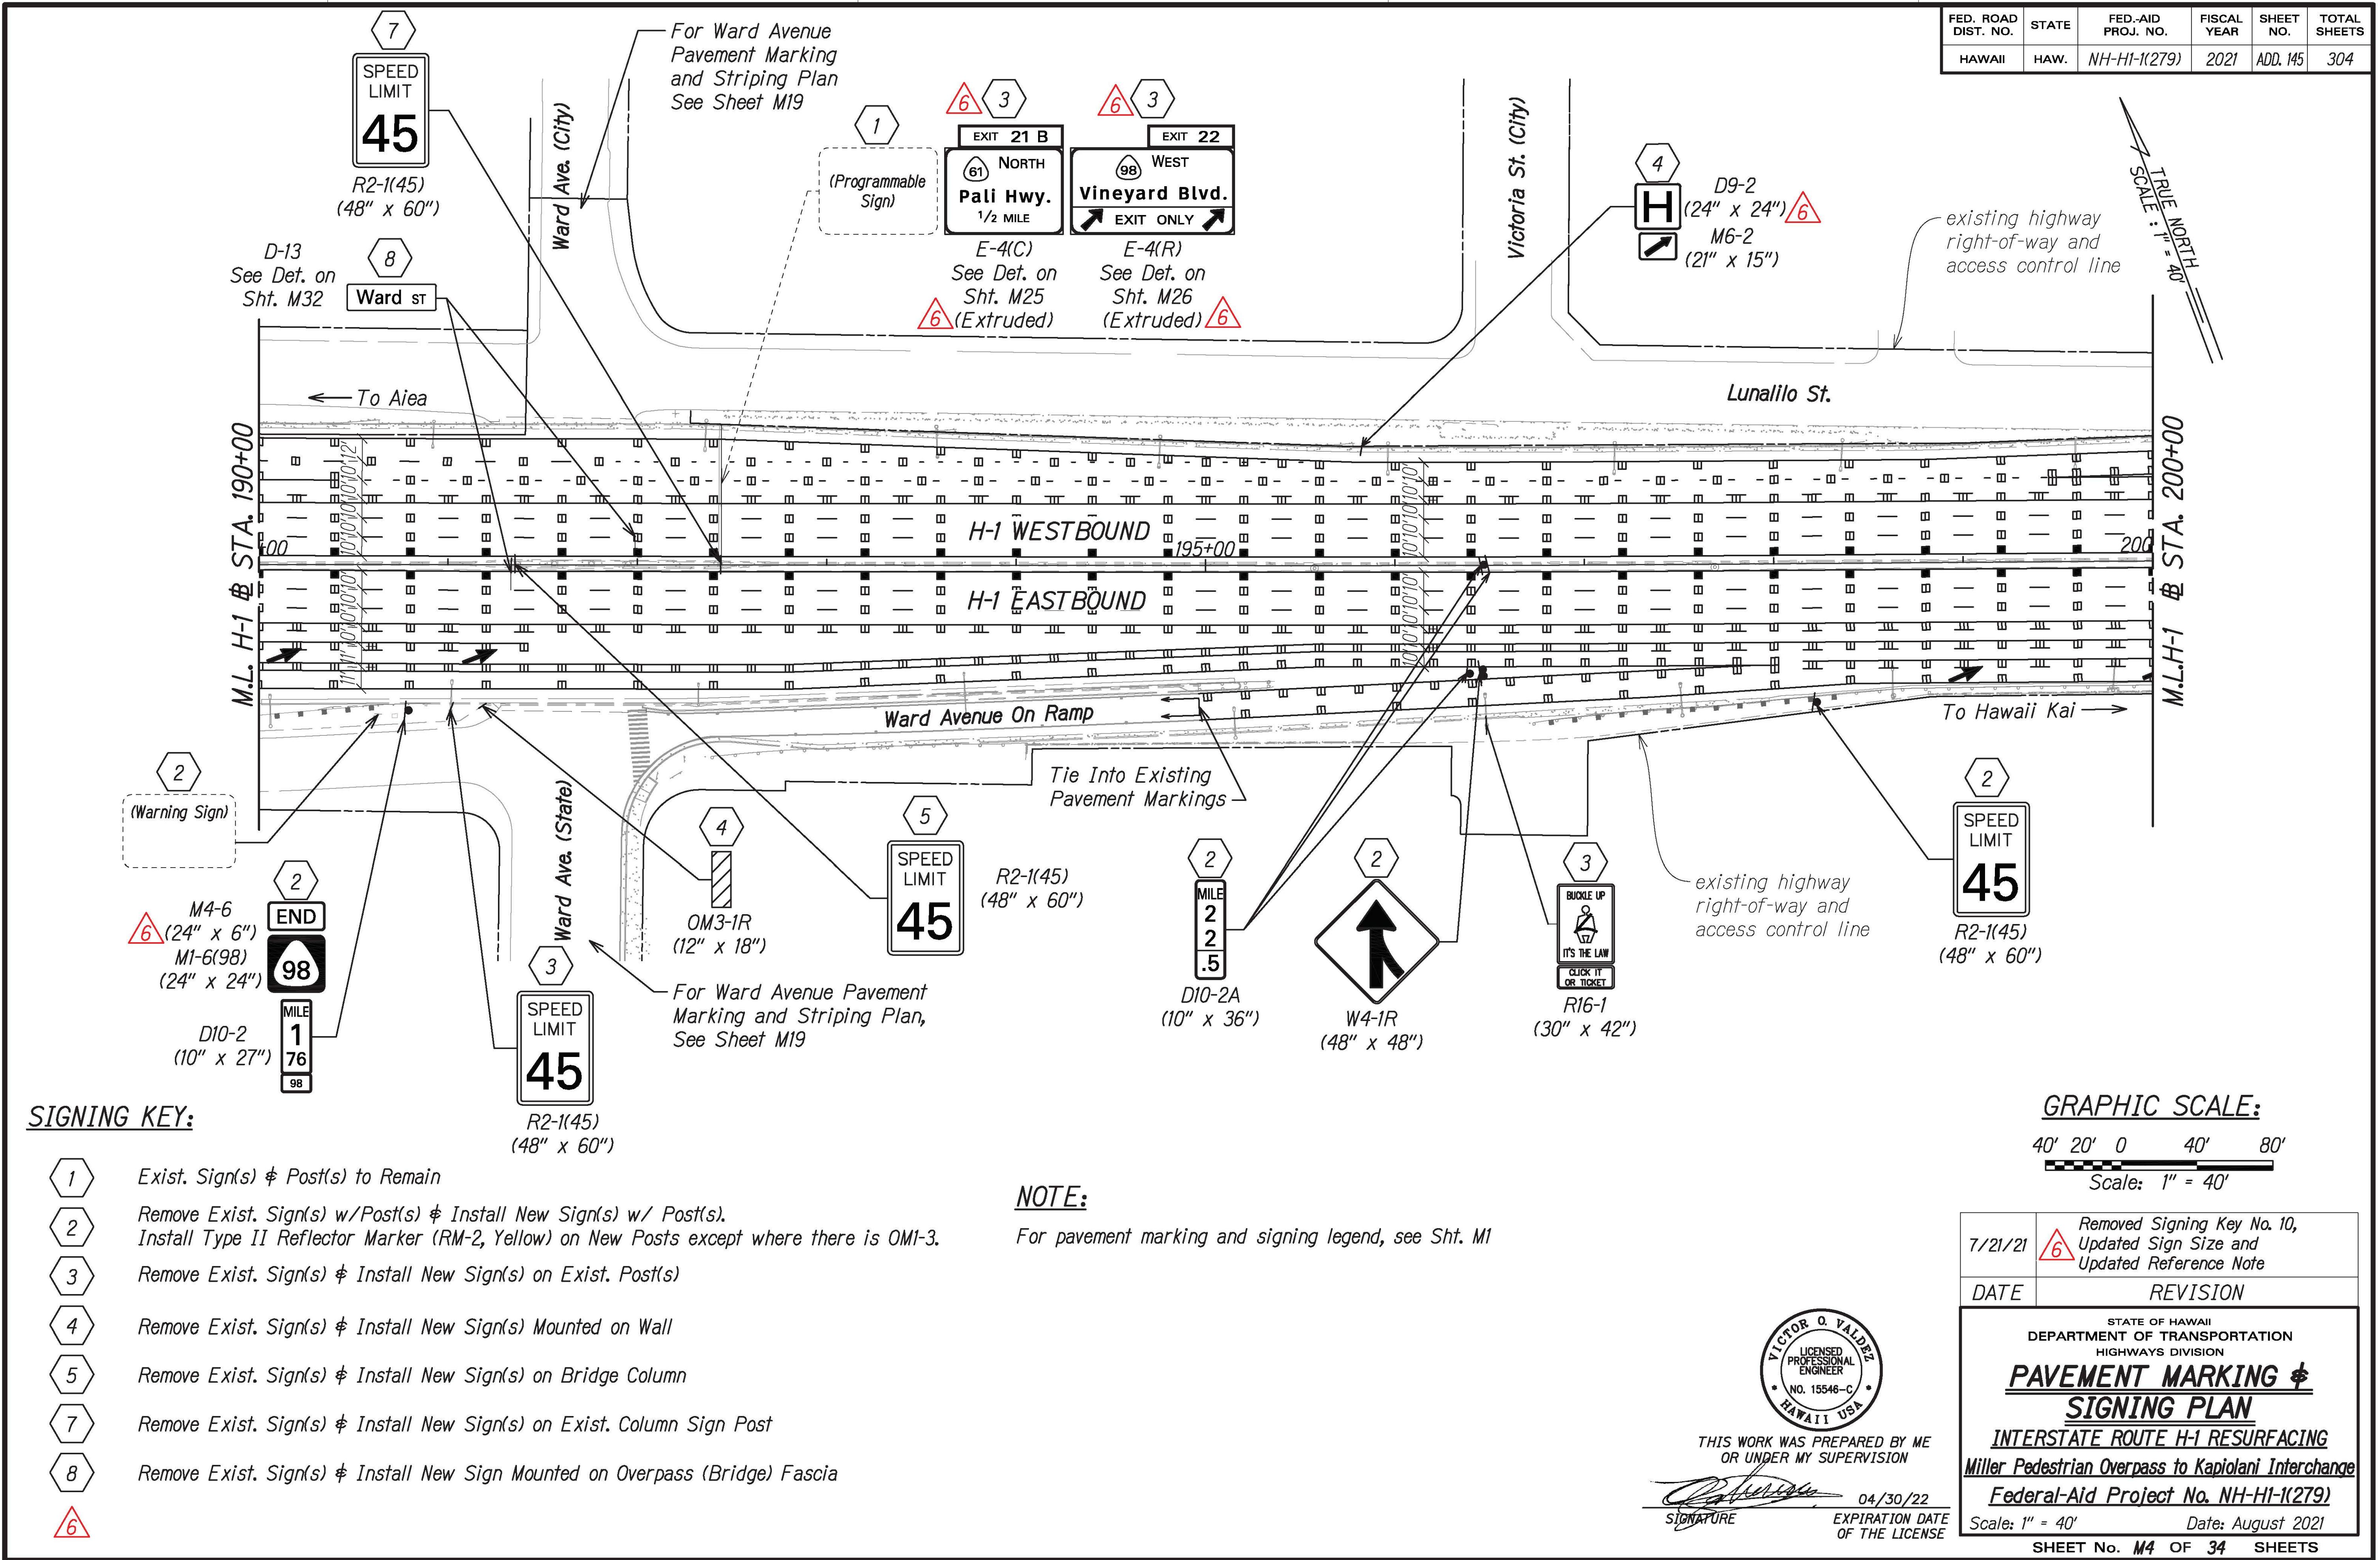


FED. ROAD DIST. NO.	STATE	FED.-AID PROJ. NO.	FISCAL YEAR	SHEET NO.	TOTAL SHEETS
HAWAII	HAW.	NH-HI-1(279)	2021	ADD. 146	304

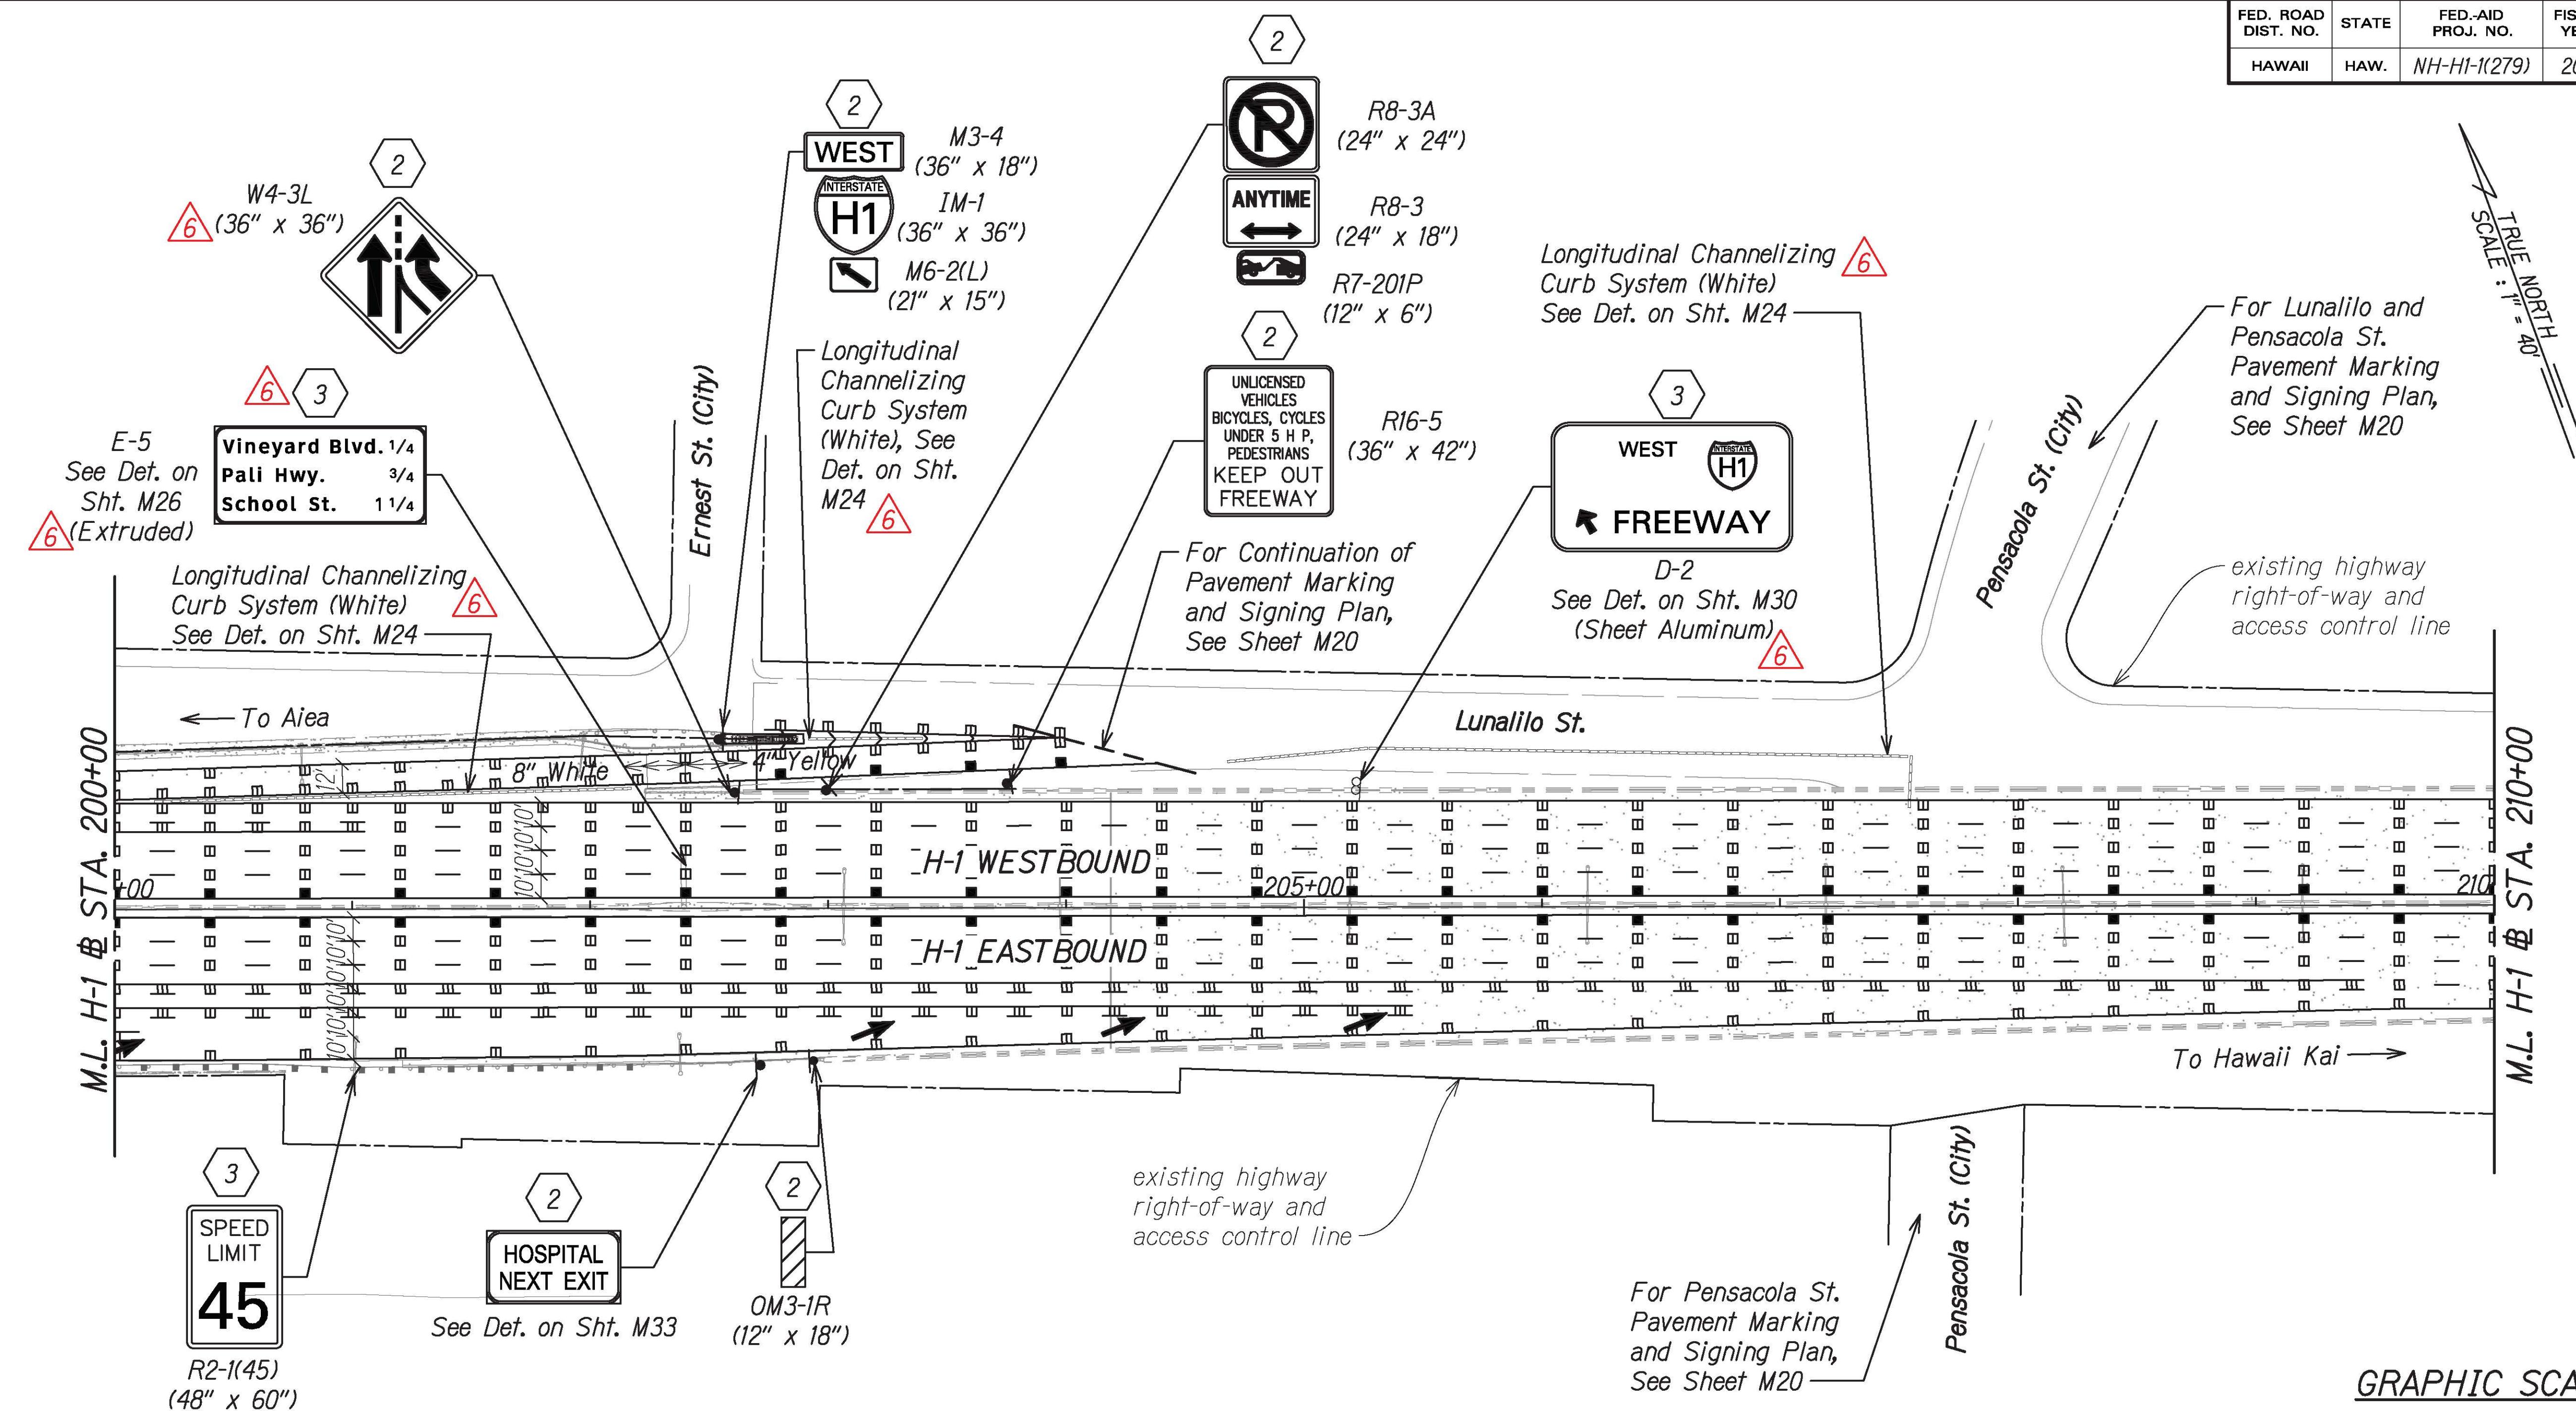

GRAPHIC SCALE:  
40' 20' 0 40' 80'  
Scale: 1" = 40'

7/21/21	Removed Signing Key No. 10, <b>(6)</b> Updated Sign Size and Updated Reference Note and Callout
DATE	REVISION
<b>PAVEMENT MARKING &amp; SIGNING PLAN</b> <b>INTERSTATE ROUTE H-1 RESURFACING</b> Miller Pedestrian Overpass to Kapiolani Interchange Federal-Aid Project No. NH-HI-1(279) Scale: 1" = 40' Date: August 2021 SHEET No. M5 OF 34 SHEETS	

FED. ROAD DIST. NO.	STATE	FED.-AID PROJ. NO.	FISCAL YEAR	SHEET NO.	TOTAL SHEETS
HAWAII	HAW.	NH-HI-1(279)	2021	ADD. 147	304

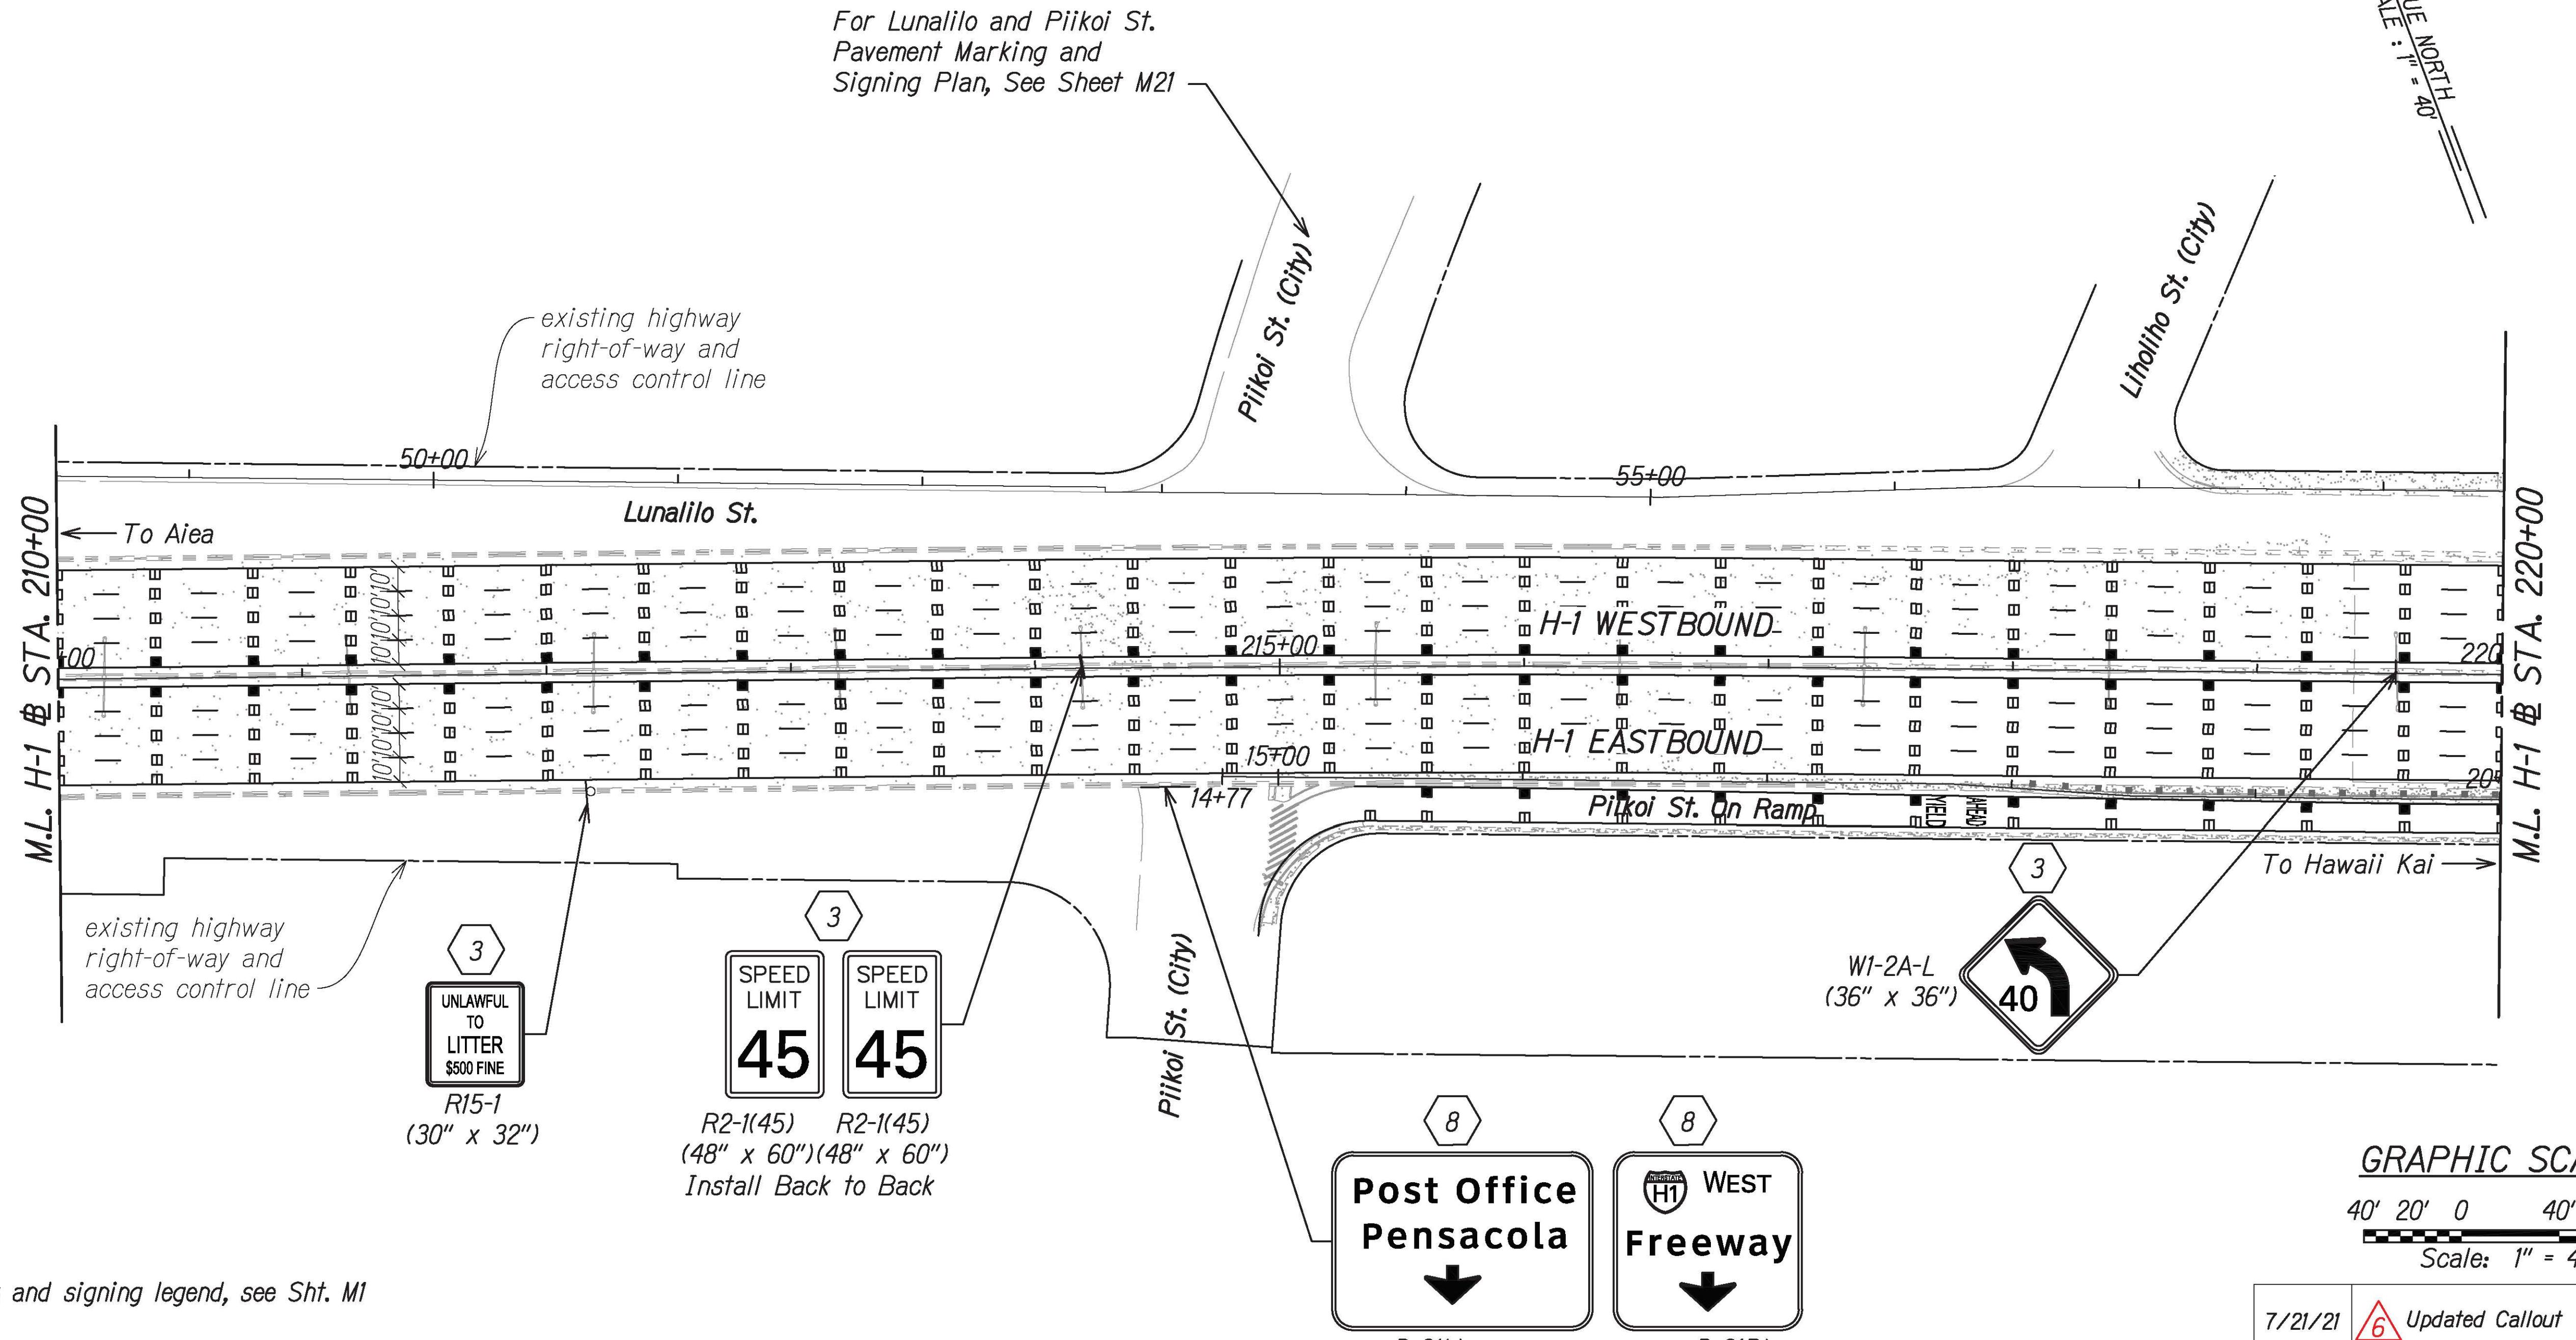

#### NOTE:

For pavement marking and signing legend, see Sht. M1

#### SIGNING KEY:


- (3) Remove Exist. Sign(s) & Install New Sign(s) on Exist. Post(s)
- (8) Remove Exist. Sign(s) & Install New Sign Mounted on Overpass (Bridge) Fascia




THIS WORK WAS PREPARED BY ME  
OR UNDER MY SUPERVISION

*[Signature]* 04/30/22  
SIGNATURE EXPIRATION DATE  
OF THE LICENSE

7/21/21	6 Updated Callout
DATE	REVISION
STATE OF HAWAII DEPARTMENT OF TRANSPORTATION HIGHWAYS DIVISION	
<b>PAVEMENT MARKING &amp; SIGNING PLAN</b>	
INTERSTATE ROUTE H-1 RESURFACING	
Miller Pedestrian Overpass to Kapiolani Interchange	
Federal-Aid Project No. NH-HI-1(279)	
Scale: 1" = 40'	
Date: August 2021	
SHEET NO. M6 OF 34 SHEETS	

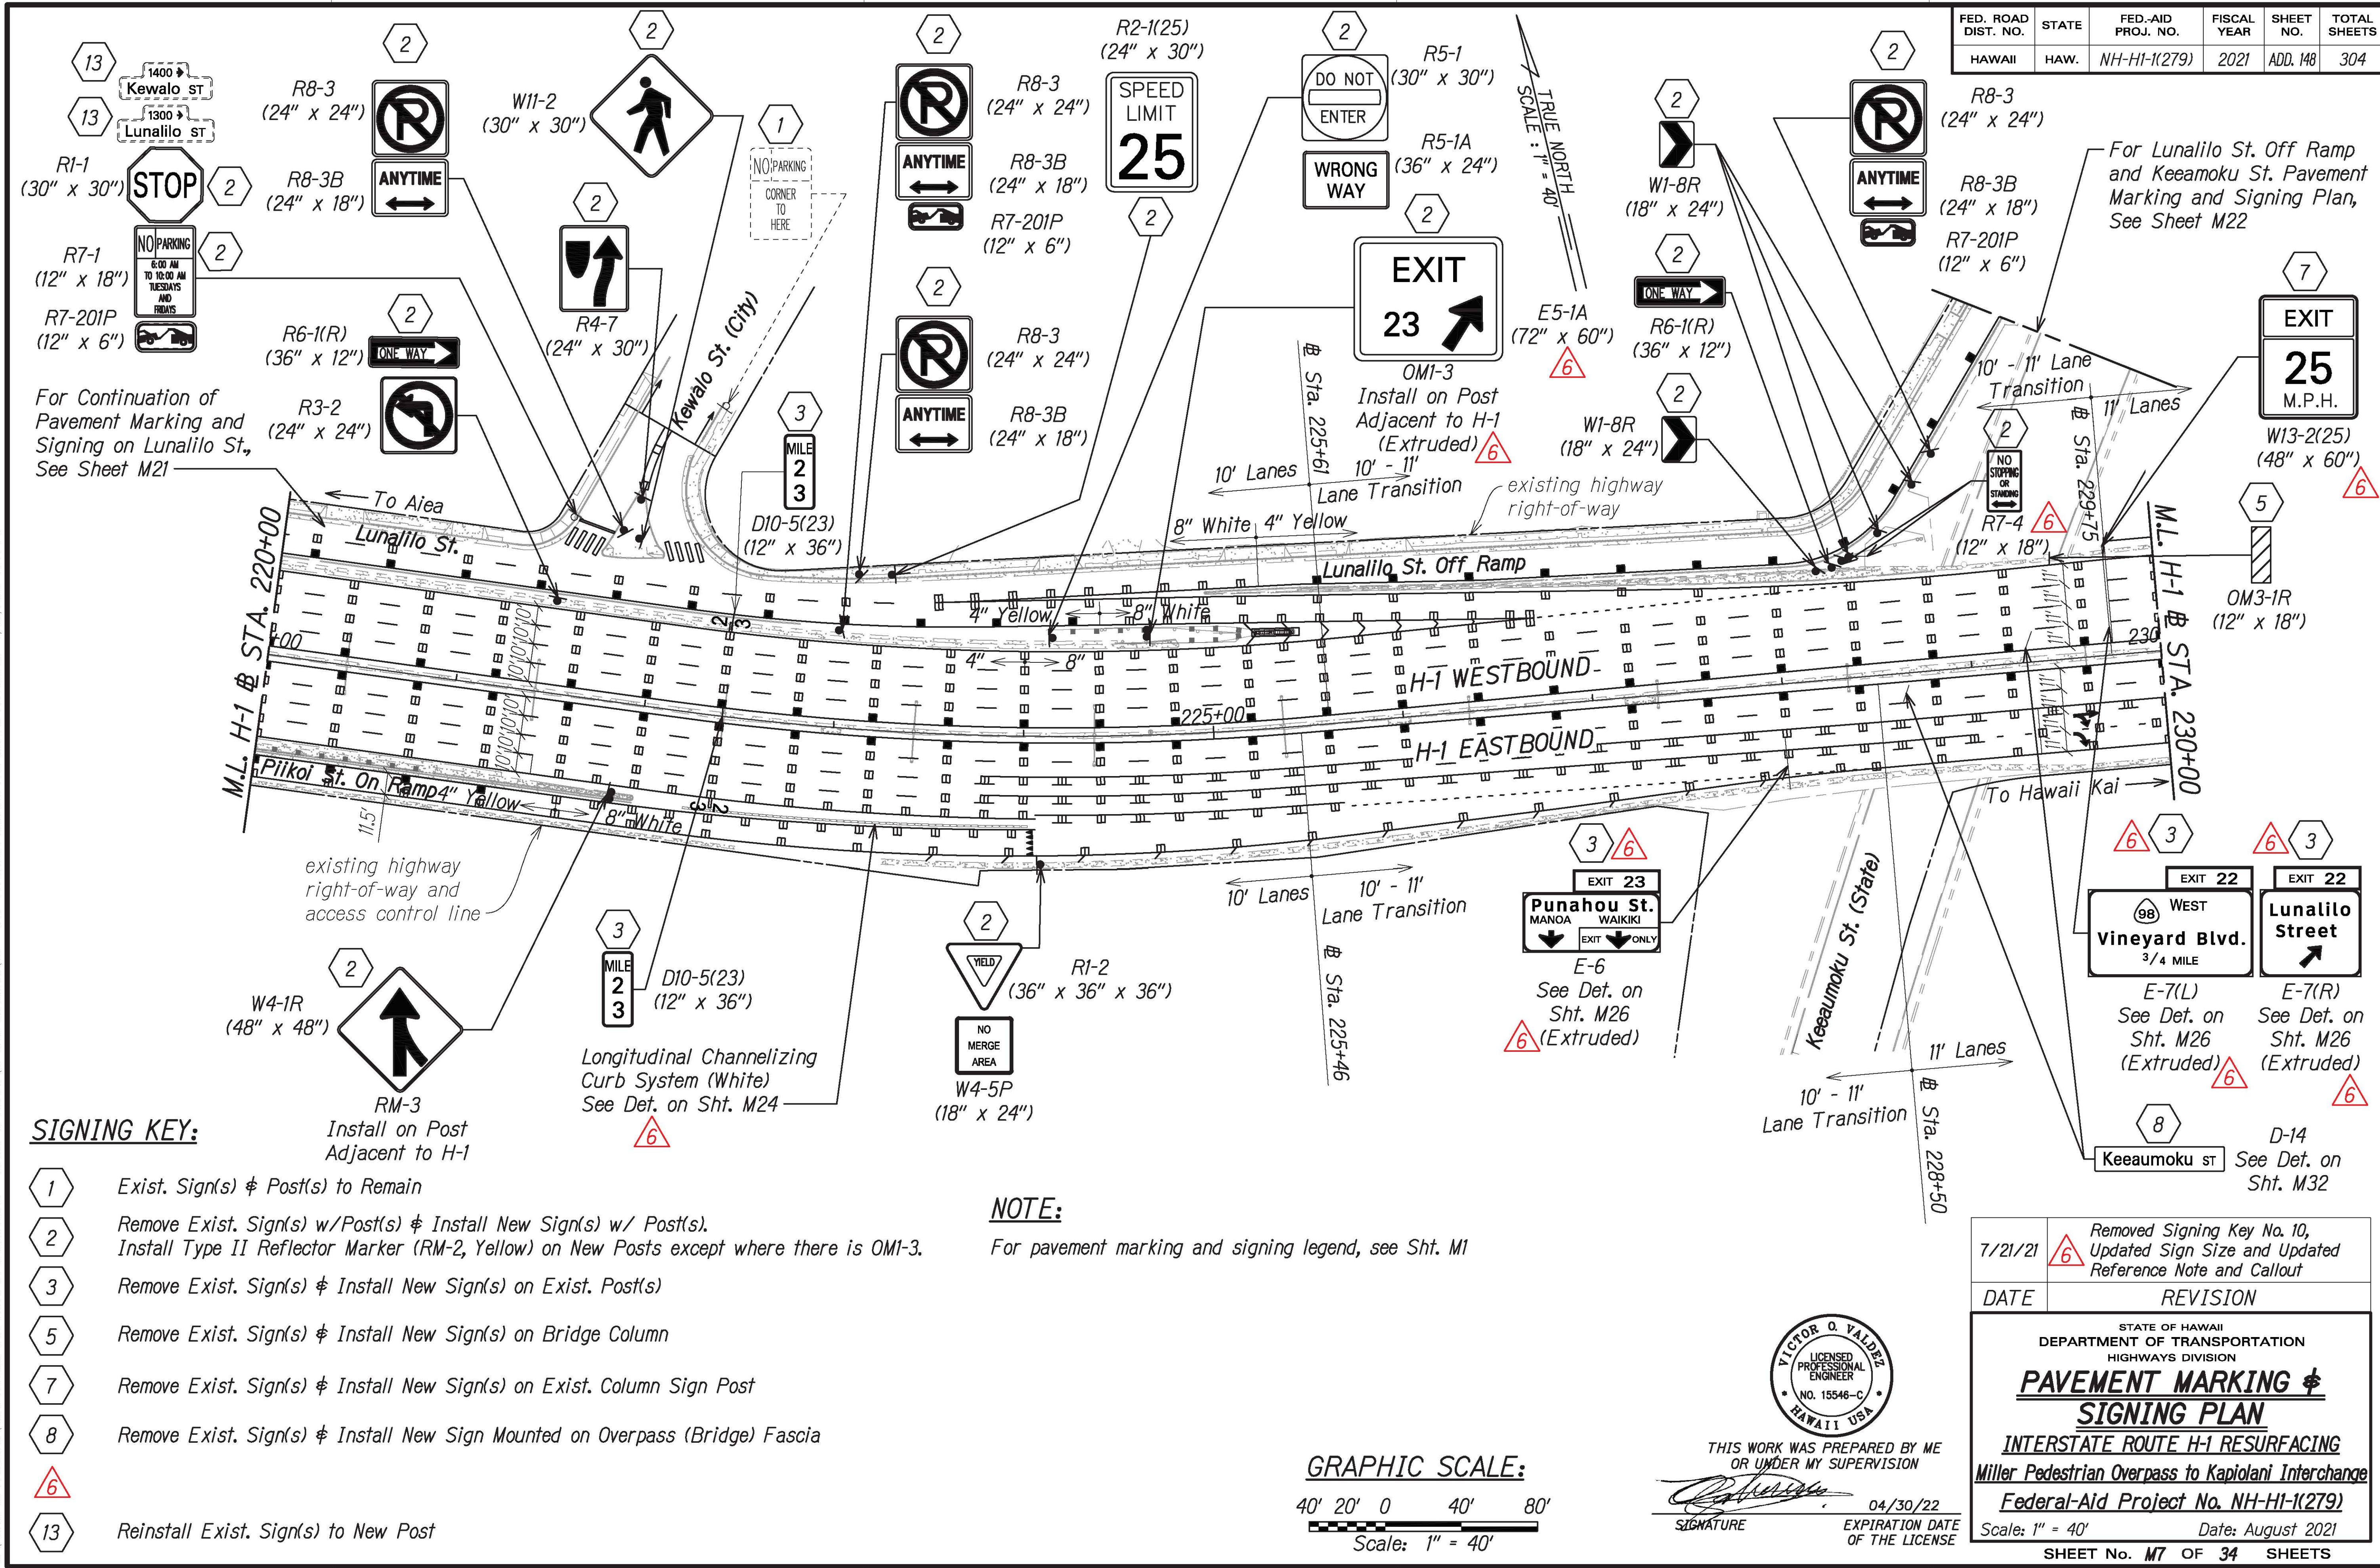

FED. ROAD DIST. NO.	STATE	FED.-AID PROJ. NO.	FISCAL YEAR	SHEET NO.	TOTAL SHEETS
HAWAII	HAW.	NH-HI-1(279)	2021	ADD. 149	304

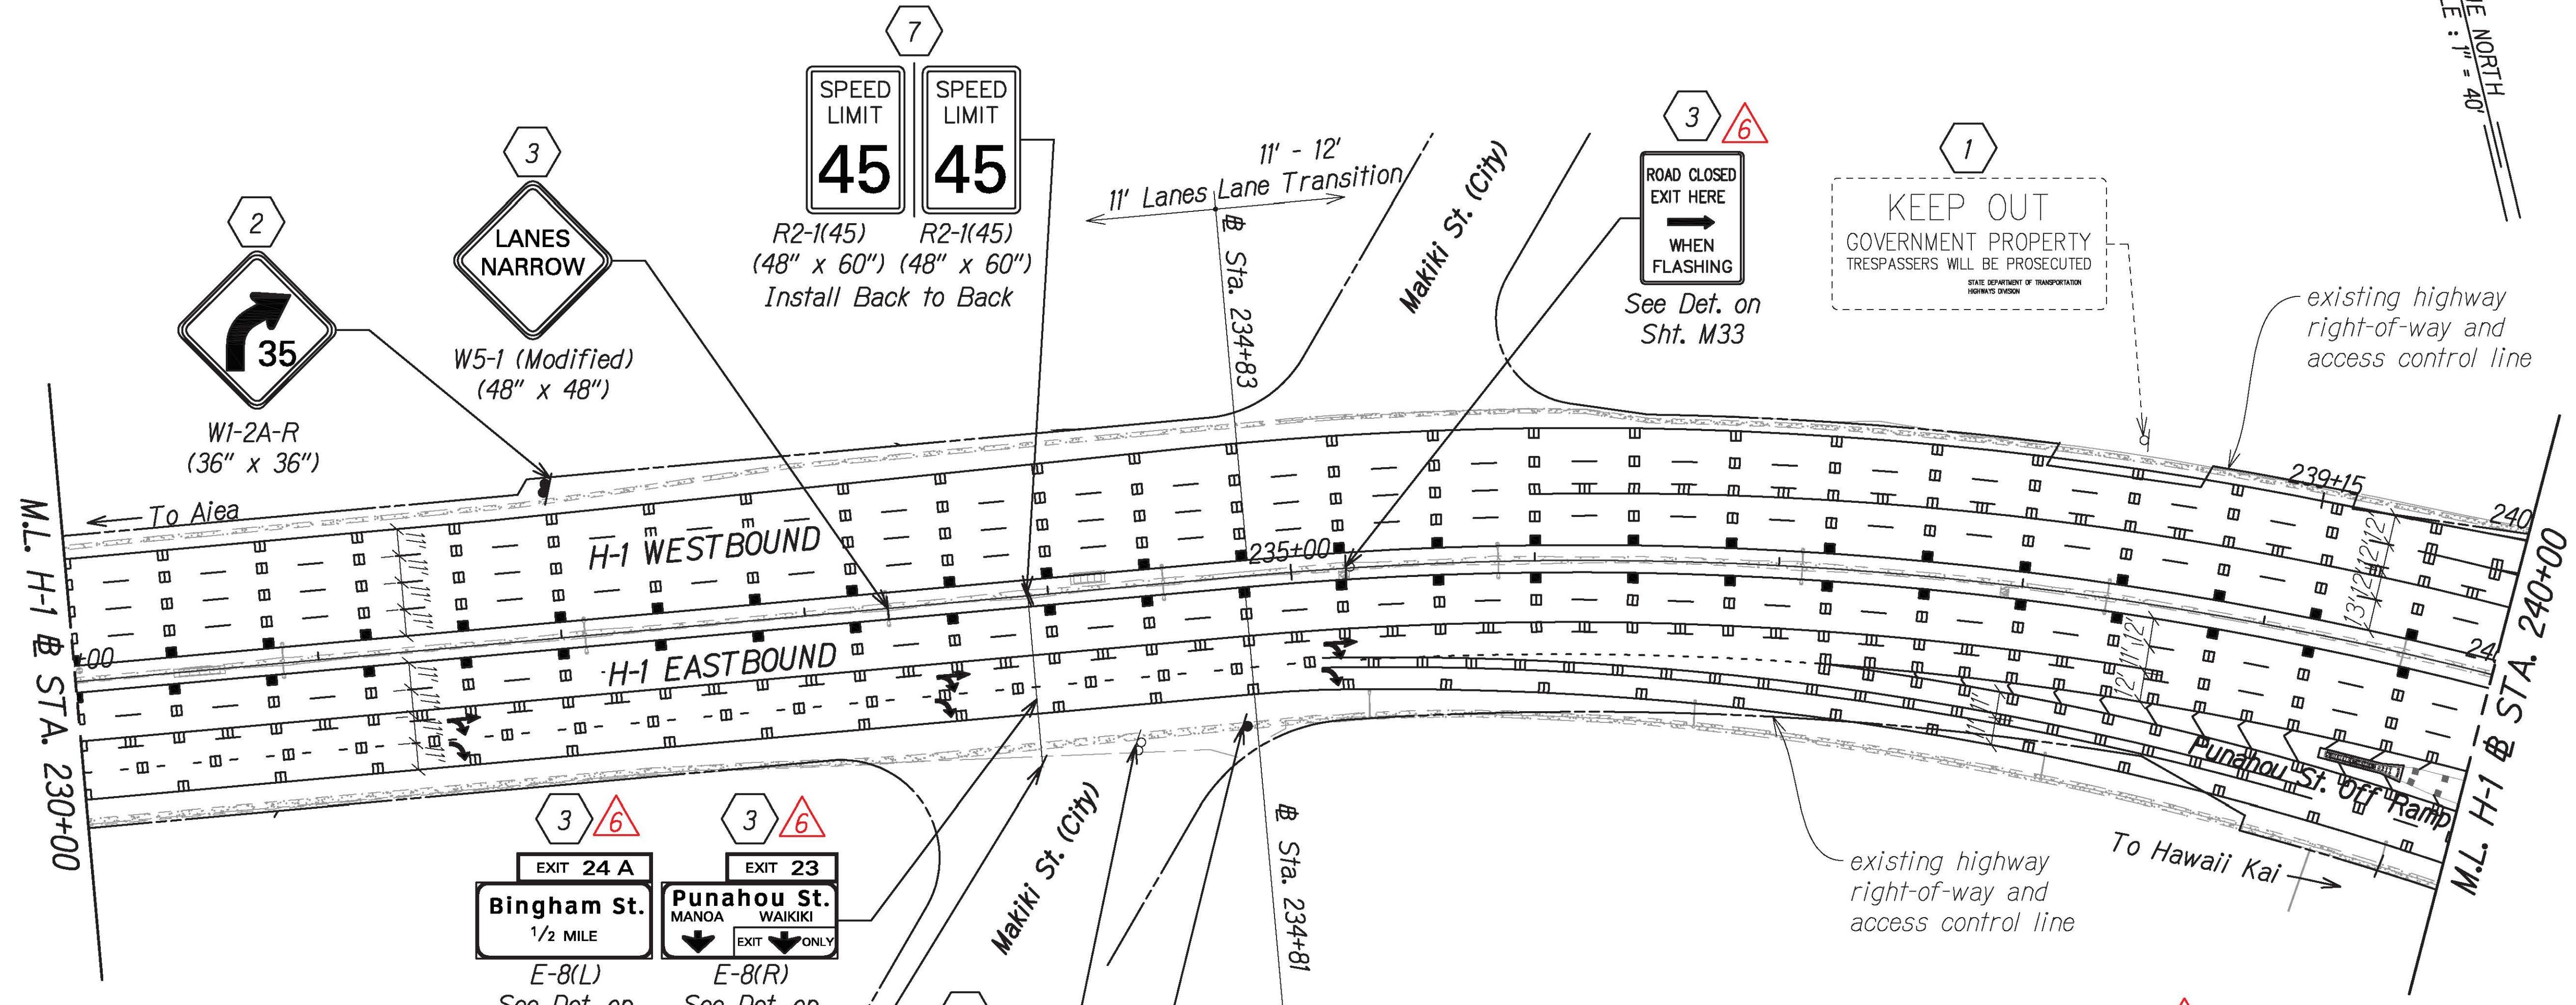

C:\\_CIVIL 3D PROJECTS\2016-2020\000 DOT-HWYS H1 RESURFACING - MILLER TO KAPIOLANI\01 CIVIL DRAWINGS\M2 - M18 PAVEMENT MARKING AND SIGNING PLANS.DWG 7/28/2021 8:59 PM

#### NOTE:

For pavement marking and signing legend, see Sht. M1


#### SIGNING KEY:

- (1) Exist. Sign(s) & Post(s) to Remain
- (2) Remove Exist. Sign(s) w/Post(s) & Install New Sign(s) w/ Post(s).  
Install Type II Reflector Marker (RM-2, Yellow) on New Posts except where there is OM1-3.
- (3) Remove Exist. Sign(s) & Install New Sign(s) on Exist. Post(s)
- (7) Remove Exist. Sign(s) & Install New Sign(s) on Exist. Column Sign Post
- (6) Remove Exist. Sign(s) & Install New Signs on Existing Concrete Barrier Mounted Post(s)
- (12) Remove Exist. Sign(s) & Install New Signs on Existing Concrete Barrier Mounted Post(s)


#### NOTE:

For pavement marking and signing legend, see Sht. M1

#### GRAPHIC SCALE:

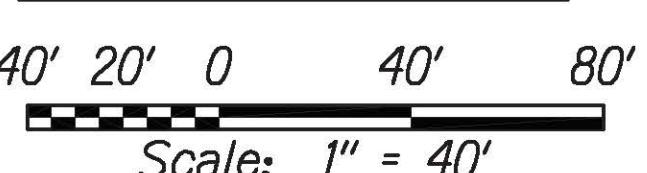

7/21/21	Removed Signing Key No. 10, Updated Sign Size and Updated Reference Note and Callout
DATE	REVISION

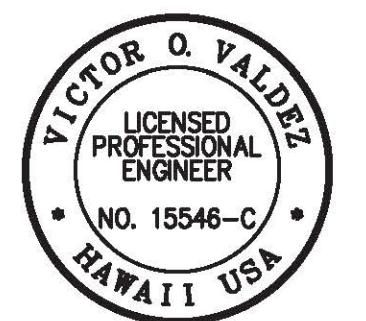

THIS WORK WAS PREPARED BY ME  
OR UNDER MY SUPERVISION

*[Signature]* 04/30/22  
SIGNATURE EXPIRATION DATE  
OF THE LICENSE

INTERSTATE ROUTE H-1 RESURFACING  
Miller Pedestrian Overpass to Kapiolani Interchange


Federal-Aid Project No. NH-HI-1(279)

Scale: 1" = 40'  
Date: August 2021

SHEET No. M8 OF 34 SHEETS

ADD. 149

FED. ROAD DIST. NO.	STATE	FED.-AID PROJ. NO.	FISCAL YEAR	HEET NO.	TOTAL SHEETS
HAWAII	HAW.	NH-HI-1(279)	2021	ADD. 150	304

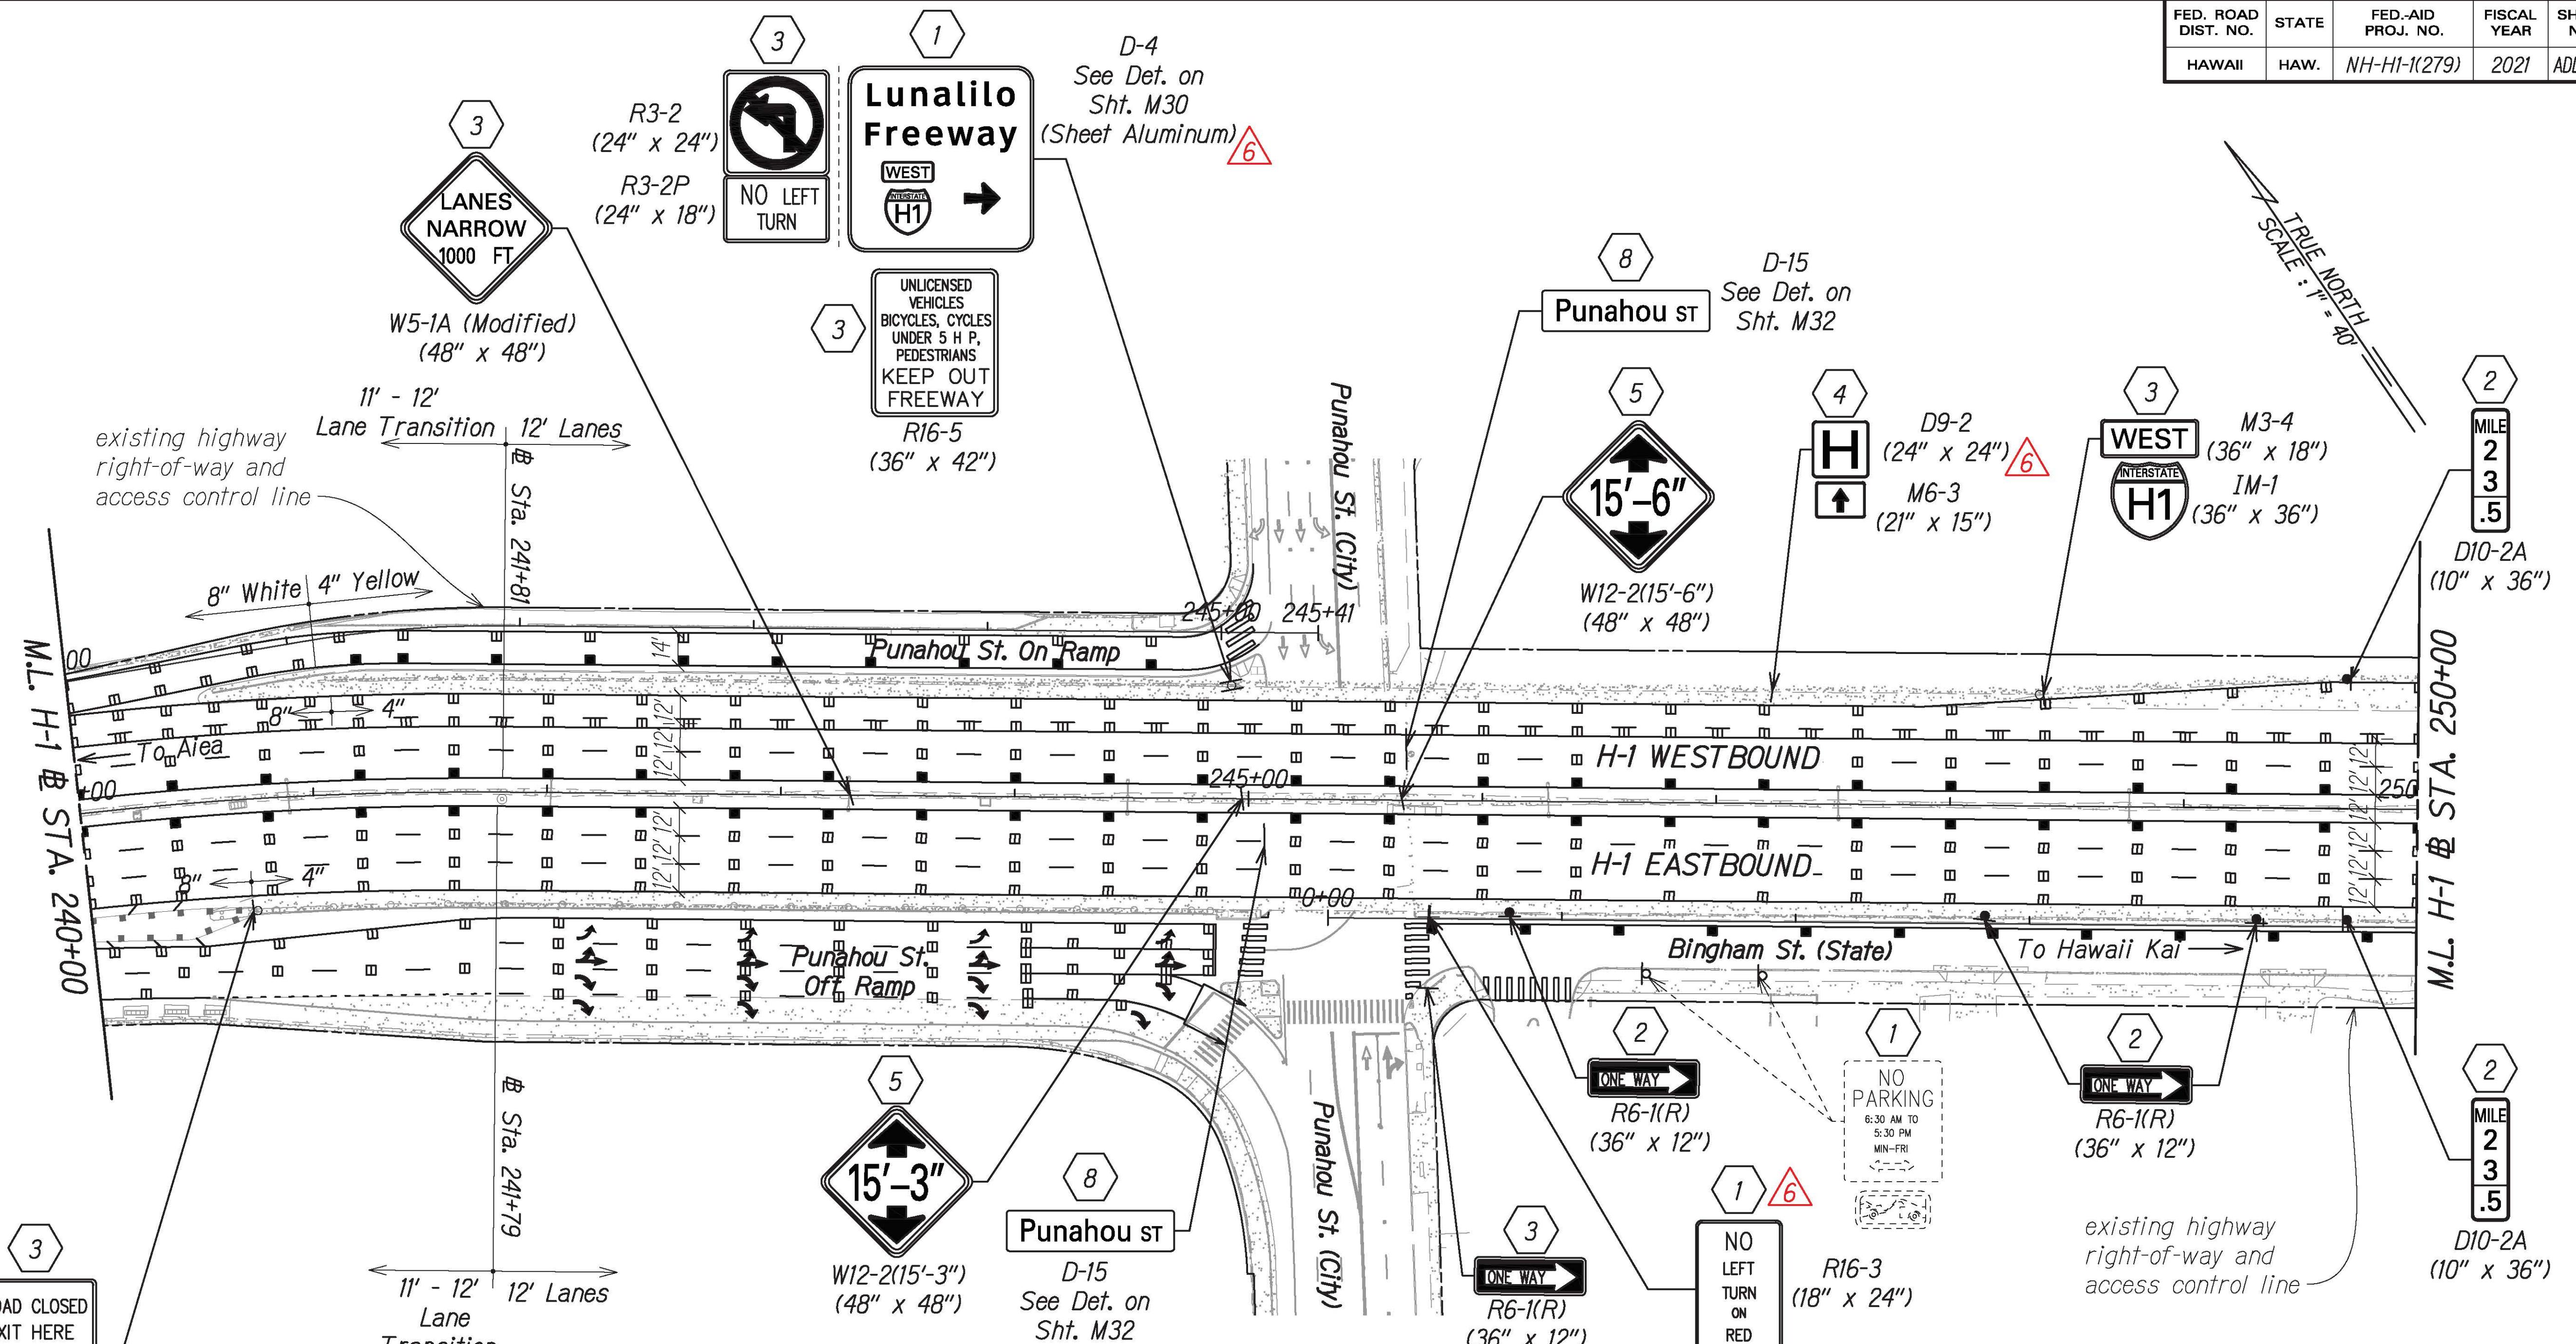

NOTE:

For pavement marking and signing legend, see Sht. M1

SIGNING KEY:

- (1) Exist. Sign(s) & Post(s) to Remain
- (2) Remove Exist. Sign(s) w/ Post(s) & Install New Sign(s) w/ Post(s).  
Install Type II Reflector Marker (RM-2, Yellow) on New Posts except where there is OM1-3.
- (3) Remove Exist. Sign(s) & Install New Sign(s) on Exist. Post(s)
- (4) Remove Exist. Sign(s) & Install New Sign(s) Mounted on Wall
- (5) Remove Exist. Sign(s) & Install New Sign(s) on Bridge Column
- (8) Remove Exist. Sign(s) & Install New Sign Mounted on Overpass (Bridge) Fascia

GRAPHIC SCALE:


40' 20' 0 40' 80'  
Scale: 1" = 40'

7/21/21	Updated Sign Size and Updated Reference Note and Callout
DATE	REVISION
STATE OF HAWAII DEPARTMENT OF TRANSPORTATION HIGHWAYS DIVISION	
<b>PAVEMENT MARKING &amp; SIGNING PLAN</b>	
INTERSTATE ROUTE H-1 RESURFACING	
Miller Pedestrian Overpass to Kapiolani Interchange	
Federal-Aid Project No. NH-HI-1(279)	
Scale: 1" = 40'	
Date: August 2021	
SHEET No. M9 OF 34 SHEETS	




THIS WORK WAS PREPARED BY ME  
OR UNDER MY SUPERVISION

*[Signature]*  
04/30/22  
SIGNATURE  
EXPIRATION DATE  
OF THE LICENSE

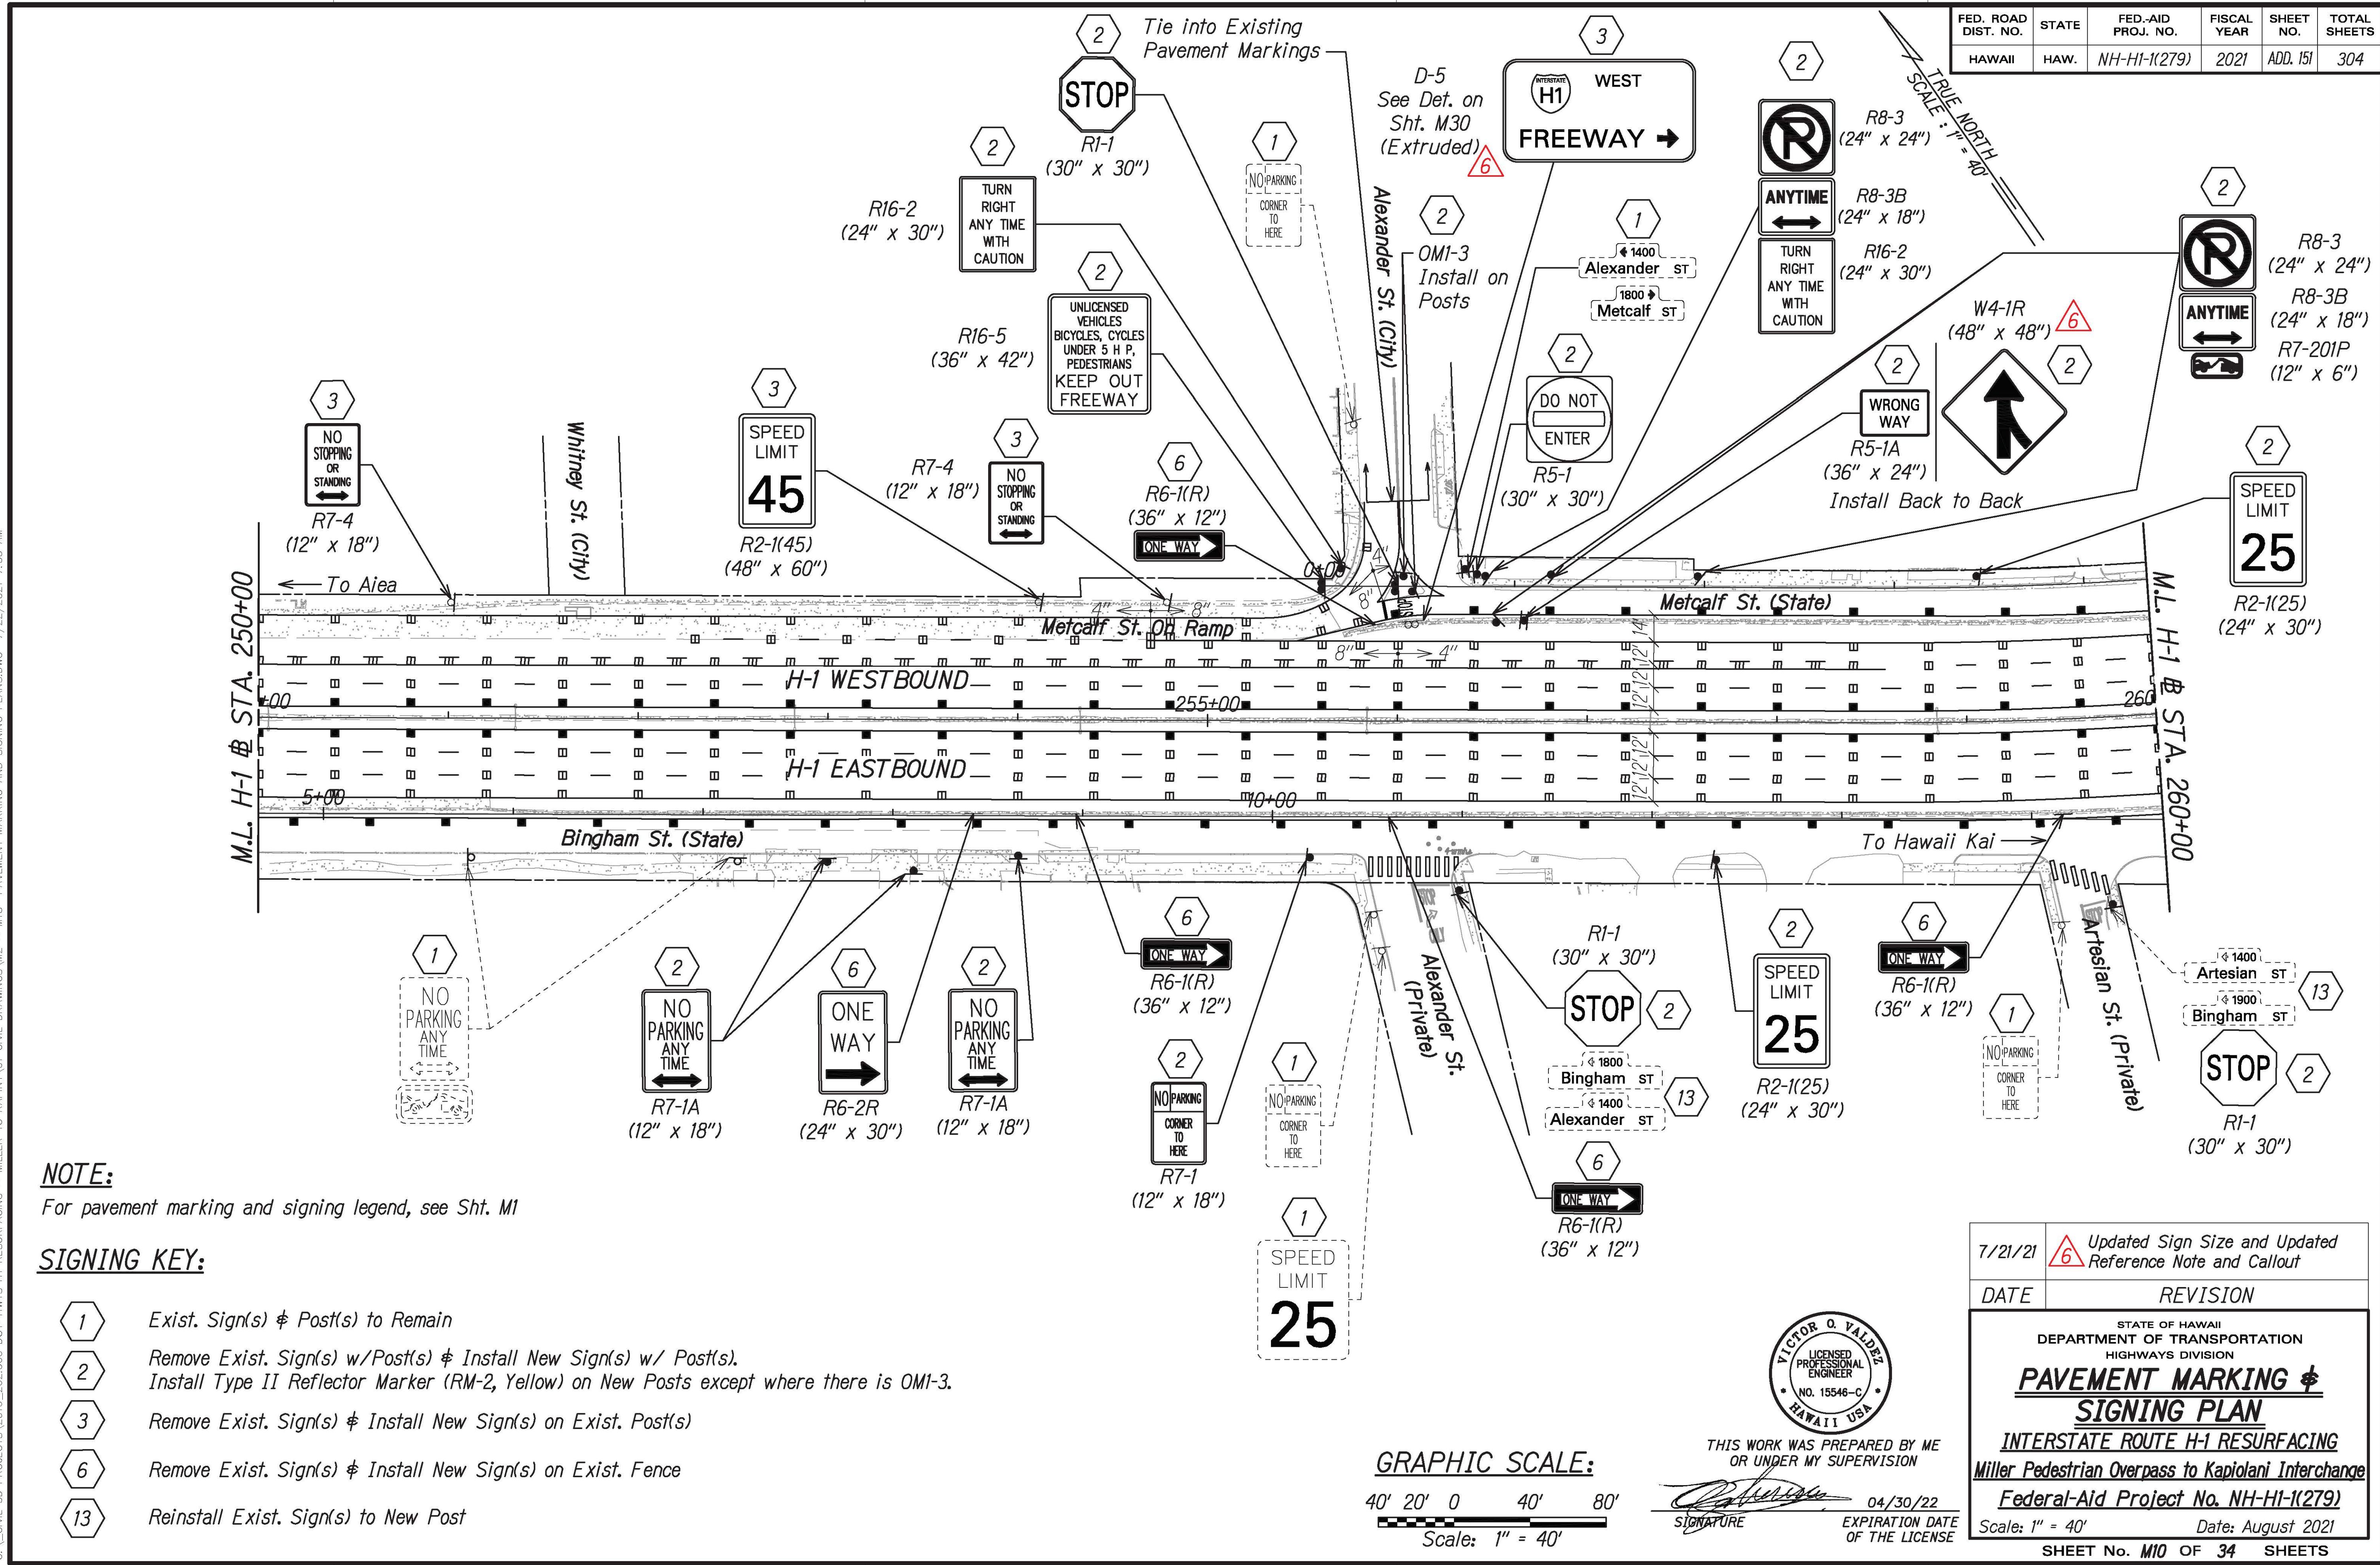


FED. ROAD DIST. NO.	STATE	FED-AID PROJ. NO.	FISCAL YEAR	SHEET NO.	TOTAL SHEETS
HAWAII	HAW.	NH-HI-1(279)	2021	ADD. 152	304

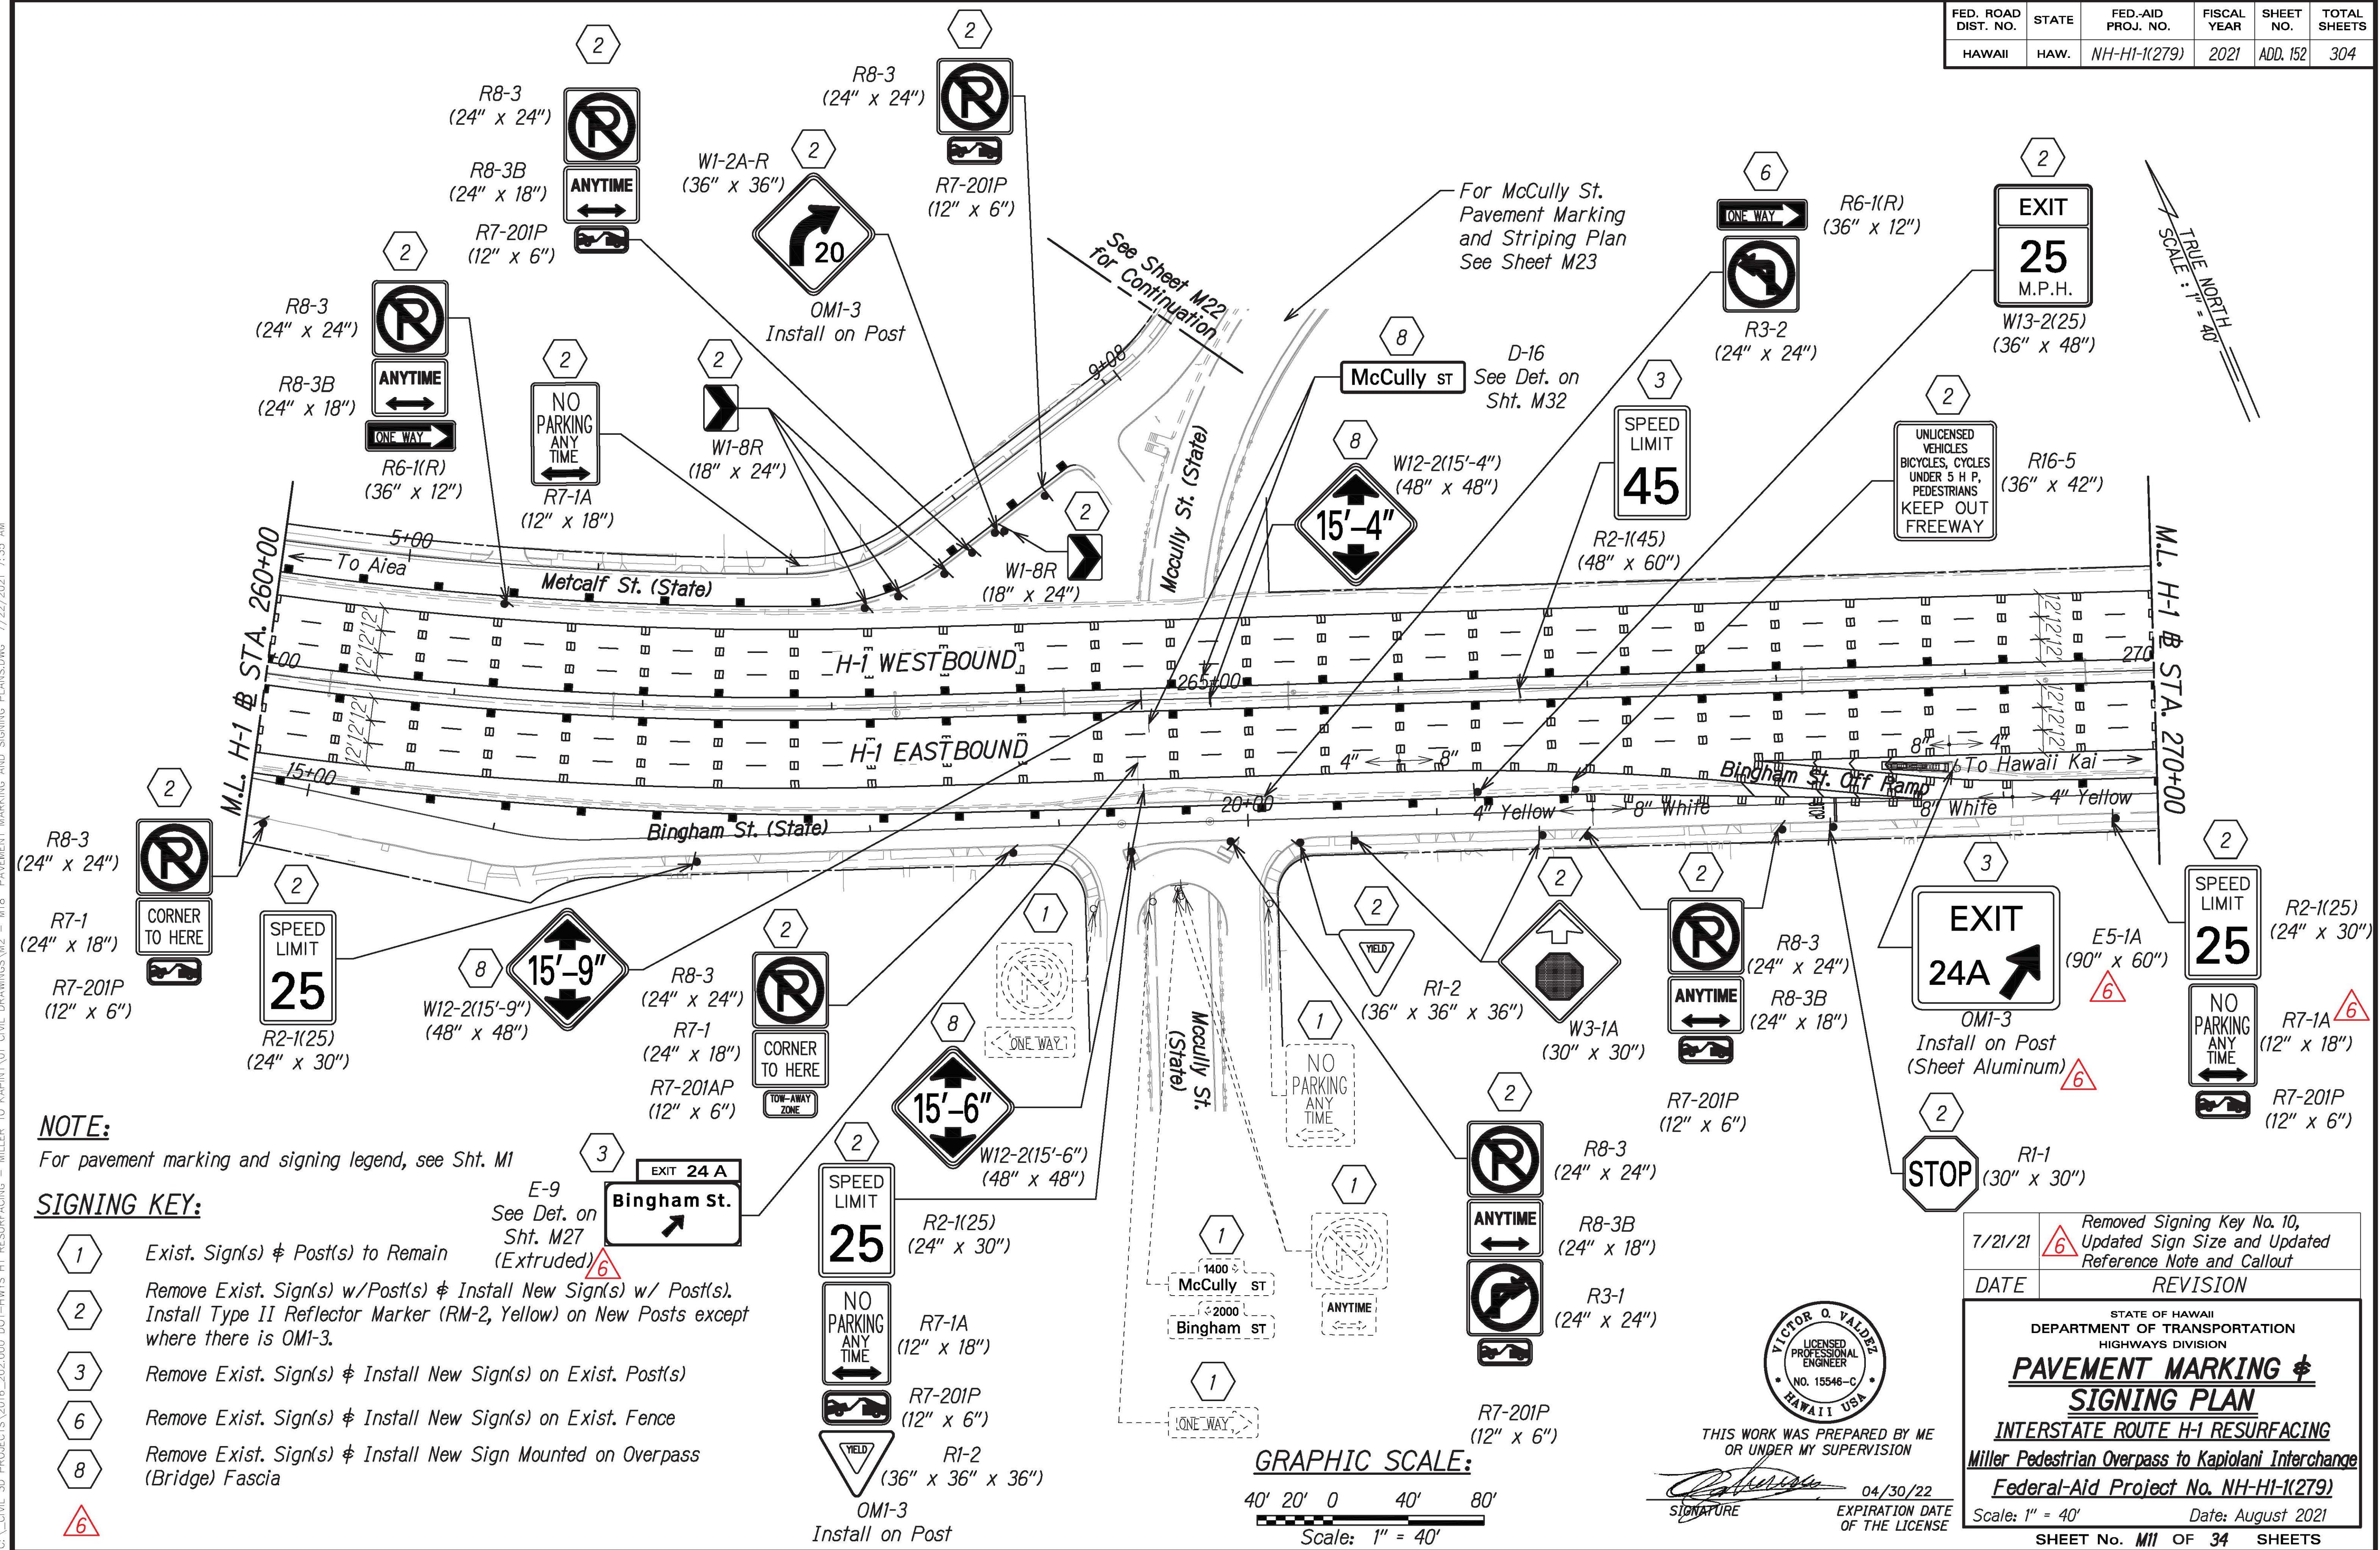

FED. ROAD DIST. NO.	STATE	FED.-AID PROJ. NO.	FISCAL YEAR	SHEET NO.	TOTAL SHEETS
HAWAII	HAW.	NH-HI-1(279)	2021	ADD. 153	304

TRUE  
SCALE:  
0' = 40'

M.L. H-1 STA. 280+00

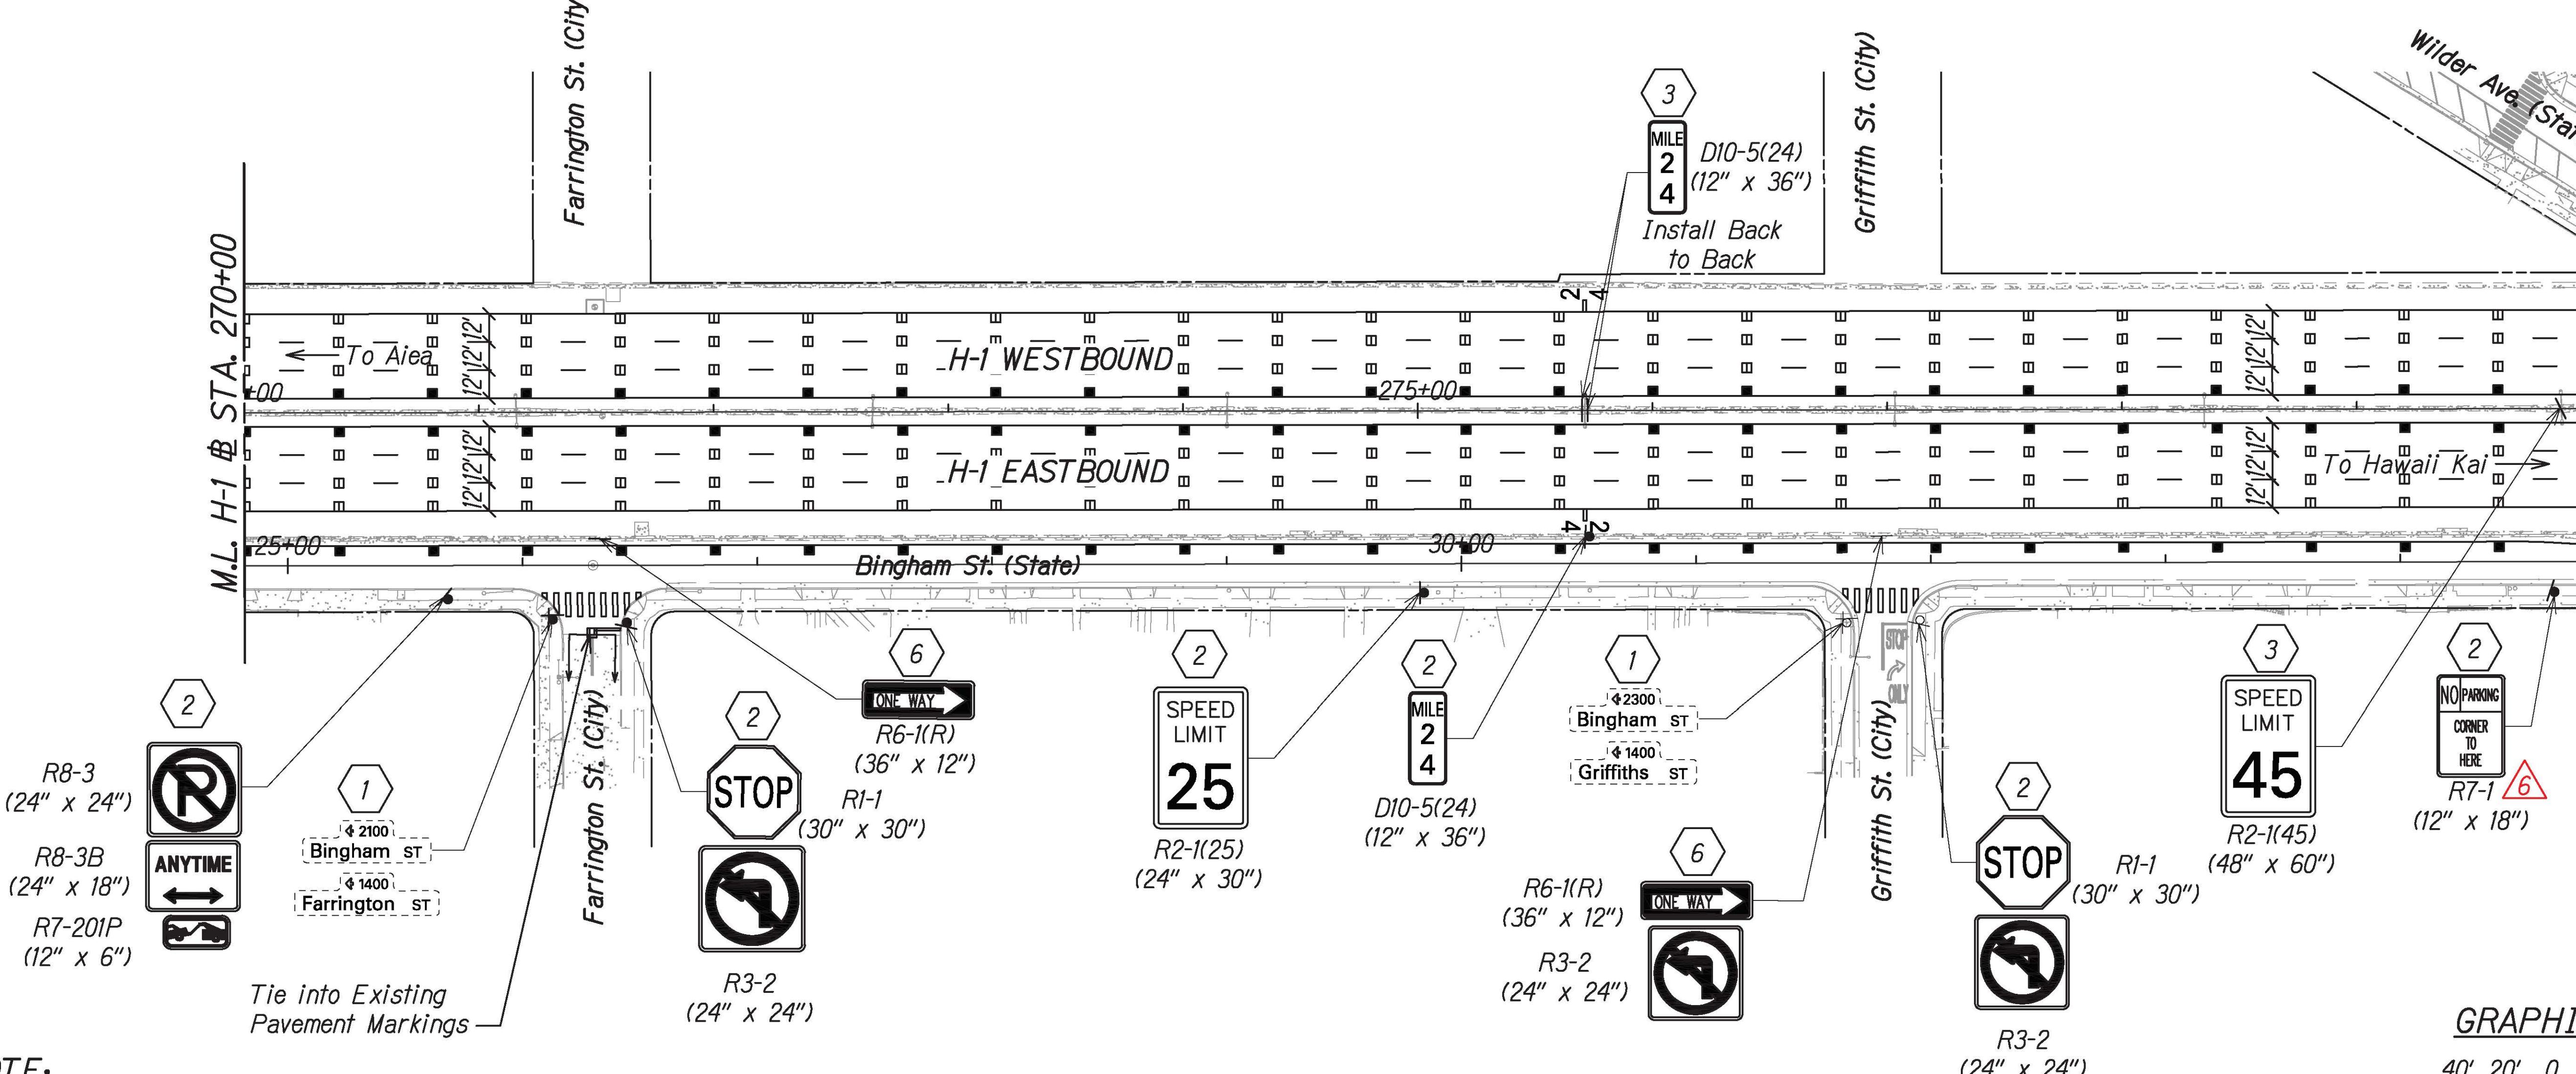

#### NOTE:

For pavement marking and signing legend, see Sht. M1

#### SIGNING KEY:

- 1 Exist. Sign(s) & Post(s) to Remain
- 2 Remove Exist. Sign(s) w/Post(s) & Install New Sign(s) w/ Post(s).  
Install Type II Reflector Marker (RM-2, Yellow) on New Posts except where there is OM1-3.
- 3 Remove Exist. Sign(s) & Install New Sign(s) on Exist. Post(s)
- 6 Remove Exist. Sign(s) & Install New Sign(s) on Exist. Fence


GRAPHIC SCALE:  
40' 20' 0 40' 80'  
Scale: 1" = 40'

7/21/21	<span style="color: red;">6</span>	Updated Sign Description
DATE	REVISION	
STATE OF HAWAII DEPARTMENT OF TRANSPORTATION HIGHWAYS DIVISION		
<b>PAVEMENT MARKING &amp; SIGNING PLAN</b>		
INTERSTATE ROUTE H-1 RESURFACING		
Miller Pedestrian Overpass to Kapiolani Interchange		
Federal-Aid Project No. NH-HI-1(279)		
Scale: 1" = 40'		
Date: August 2021		
SHEET No. M12 OF 34 SHEETS		



THIS WORK WAS PREPARED BY ME  
OR UNDER MY SUPERVISION

  
04/30/22  
SIGNATURE  
EXPIRATION DATE  
OF THE LICENSE

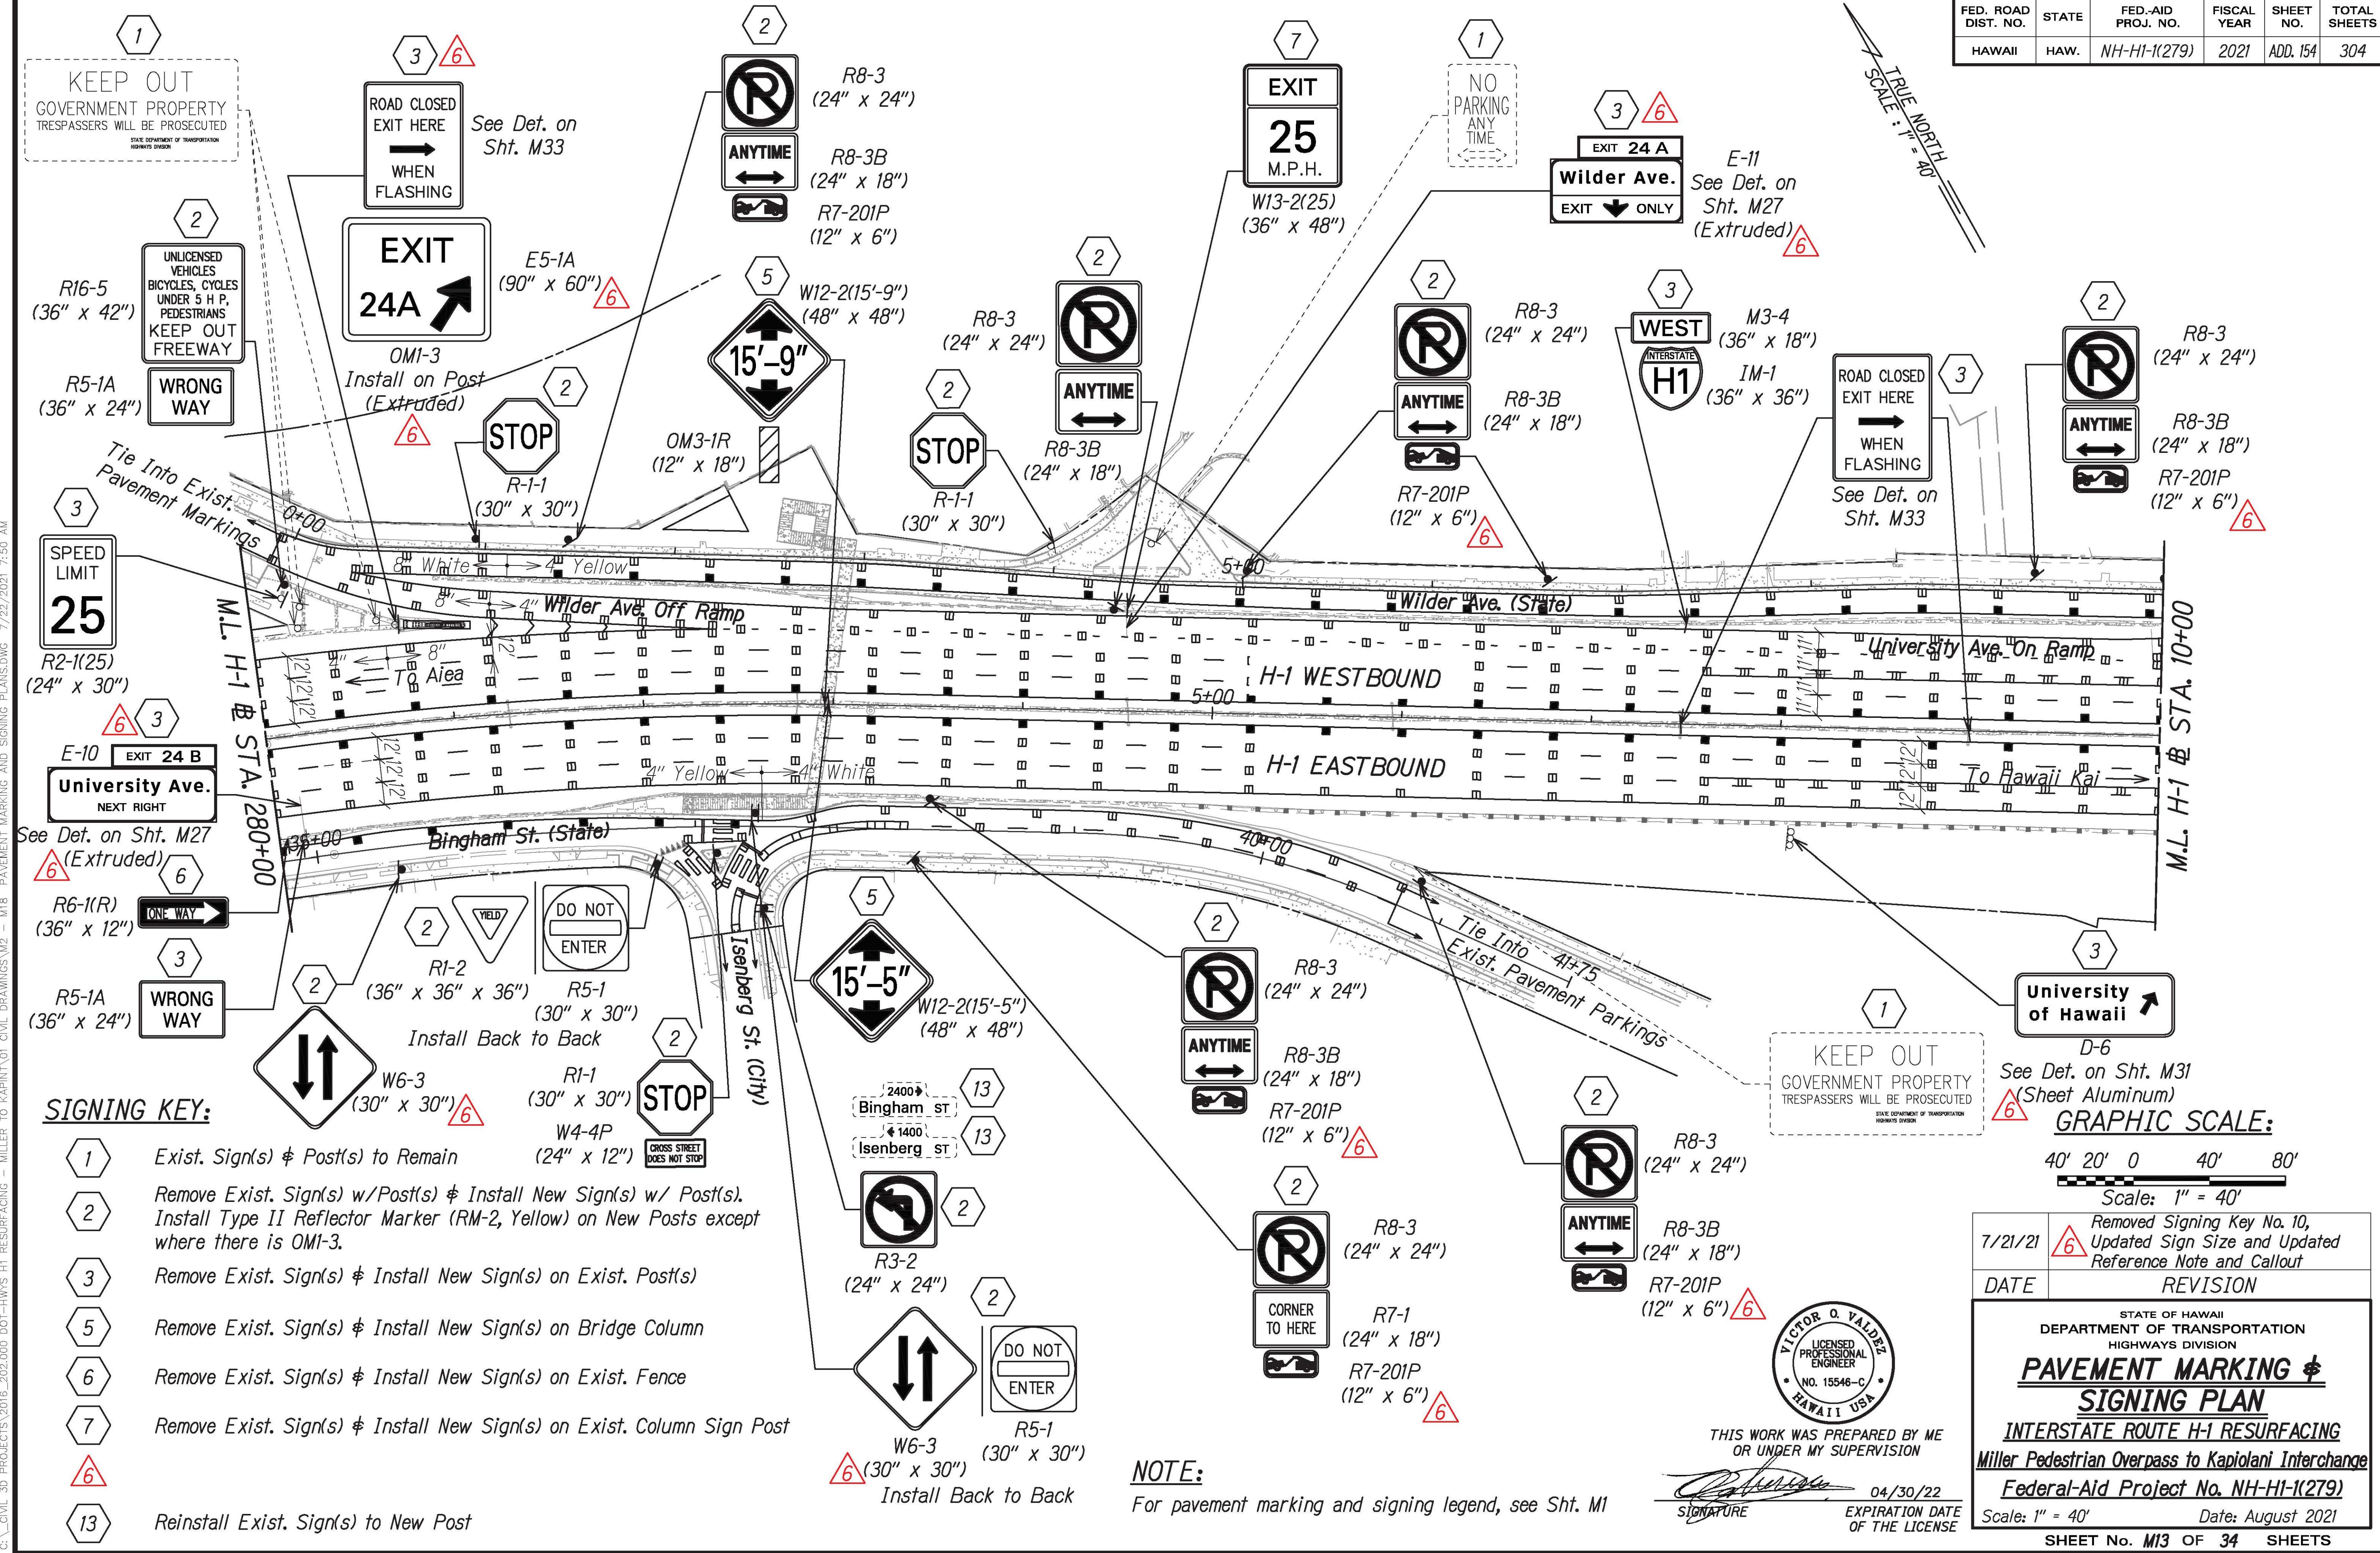


FED. ROAD DIST. NO.	STATE	FED.-AID PROJ. NO.	FISCAL YEAR	SHEET NO.	TOTAL SHEETS
HAWAII	HAW.	NH-HI-1(279)	2021	ADD. 155	304


### SIGNING KEY:

(2) Remove Exist. Sign(s) w/Post(s) & Install New Sign(s) w/ Post(s).  
Install Type II Reflector Marker (RM-2, Yellow) on New Posts except where there is OM1-3.


(3) Remove Exist. Sign(s) & Install New on Exist. Post(s)

(6)

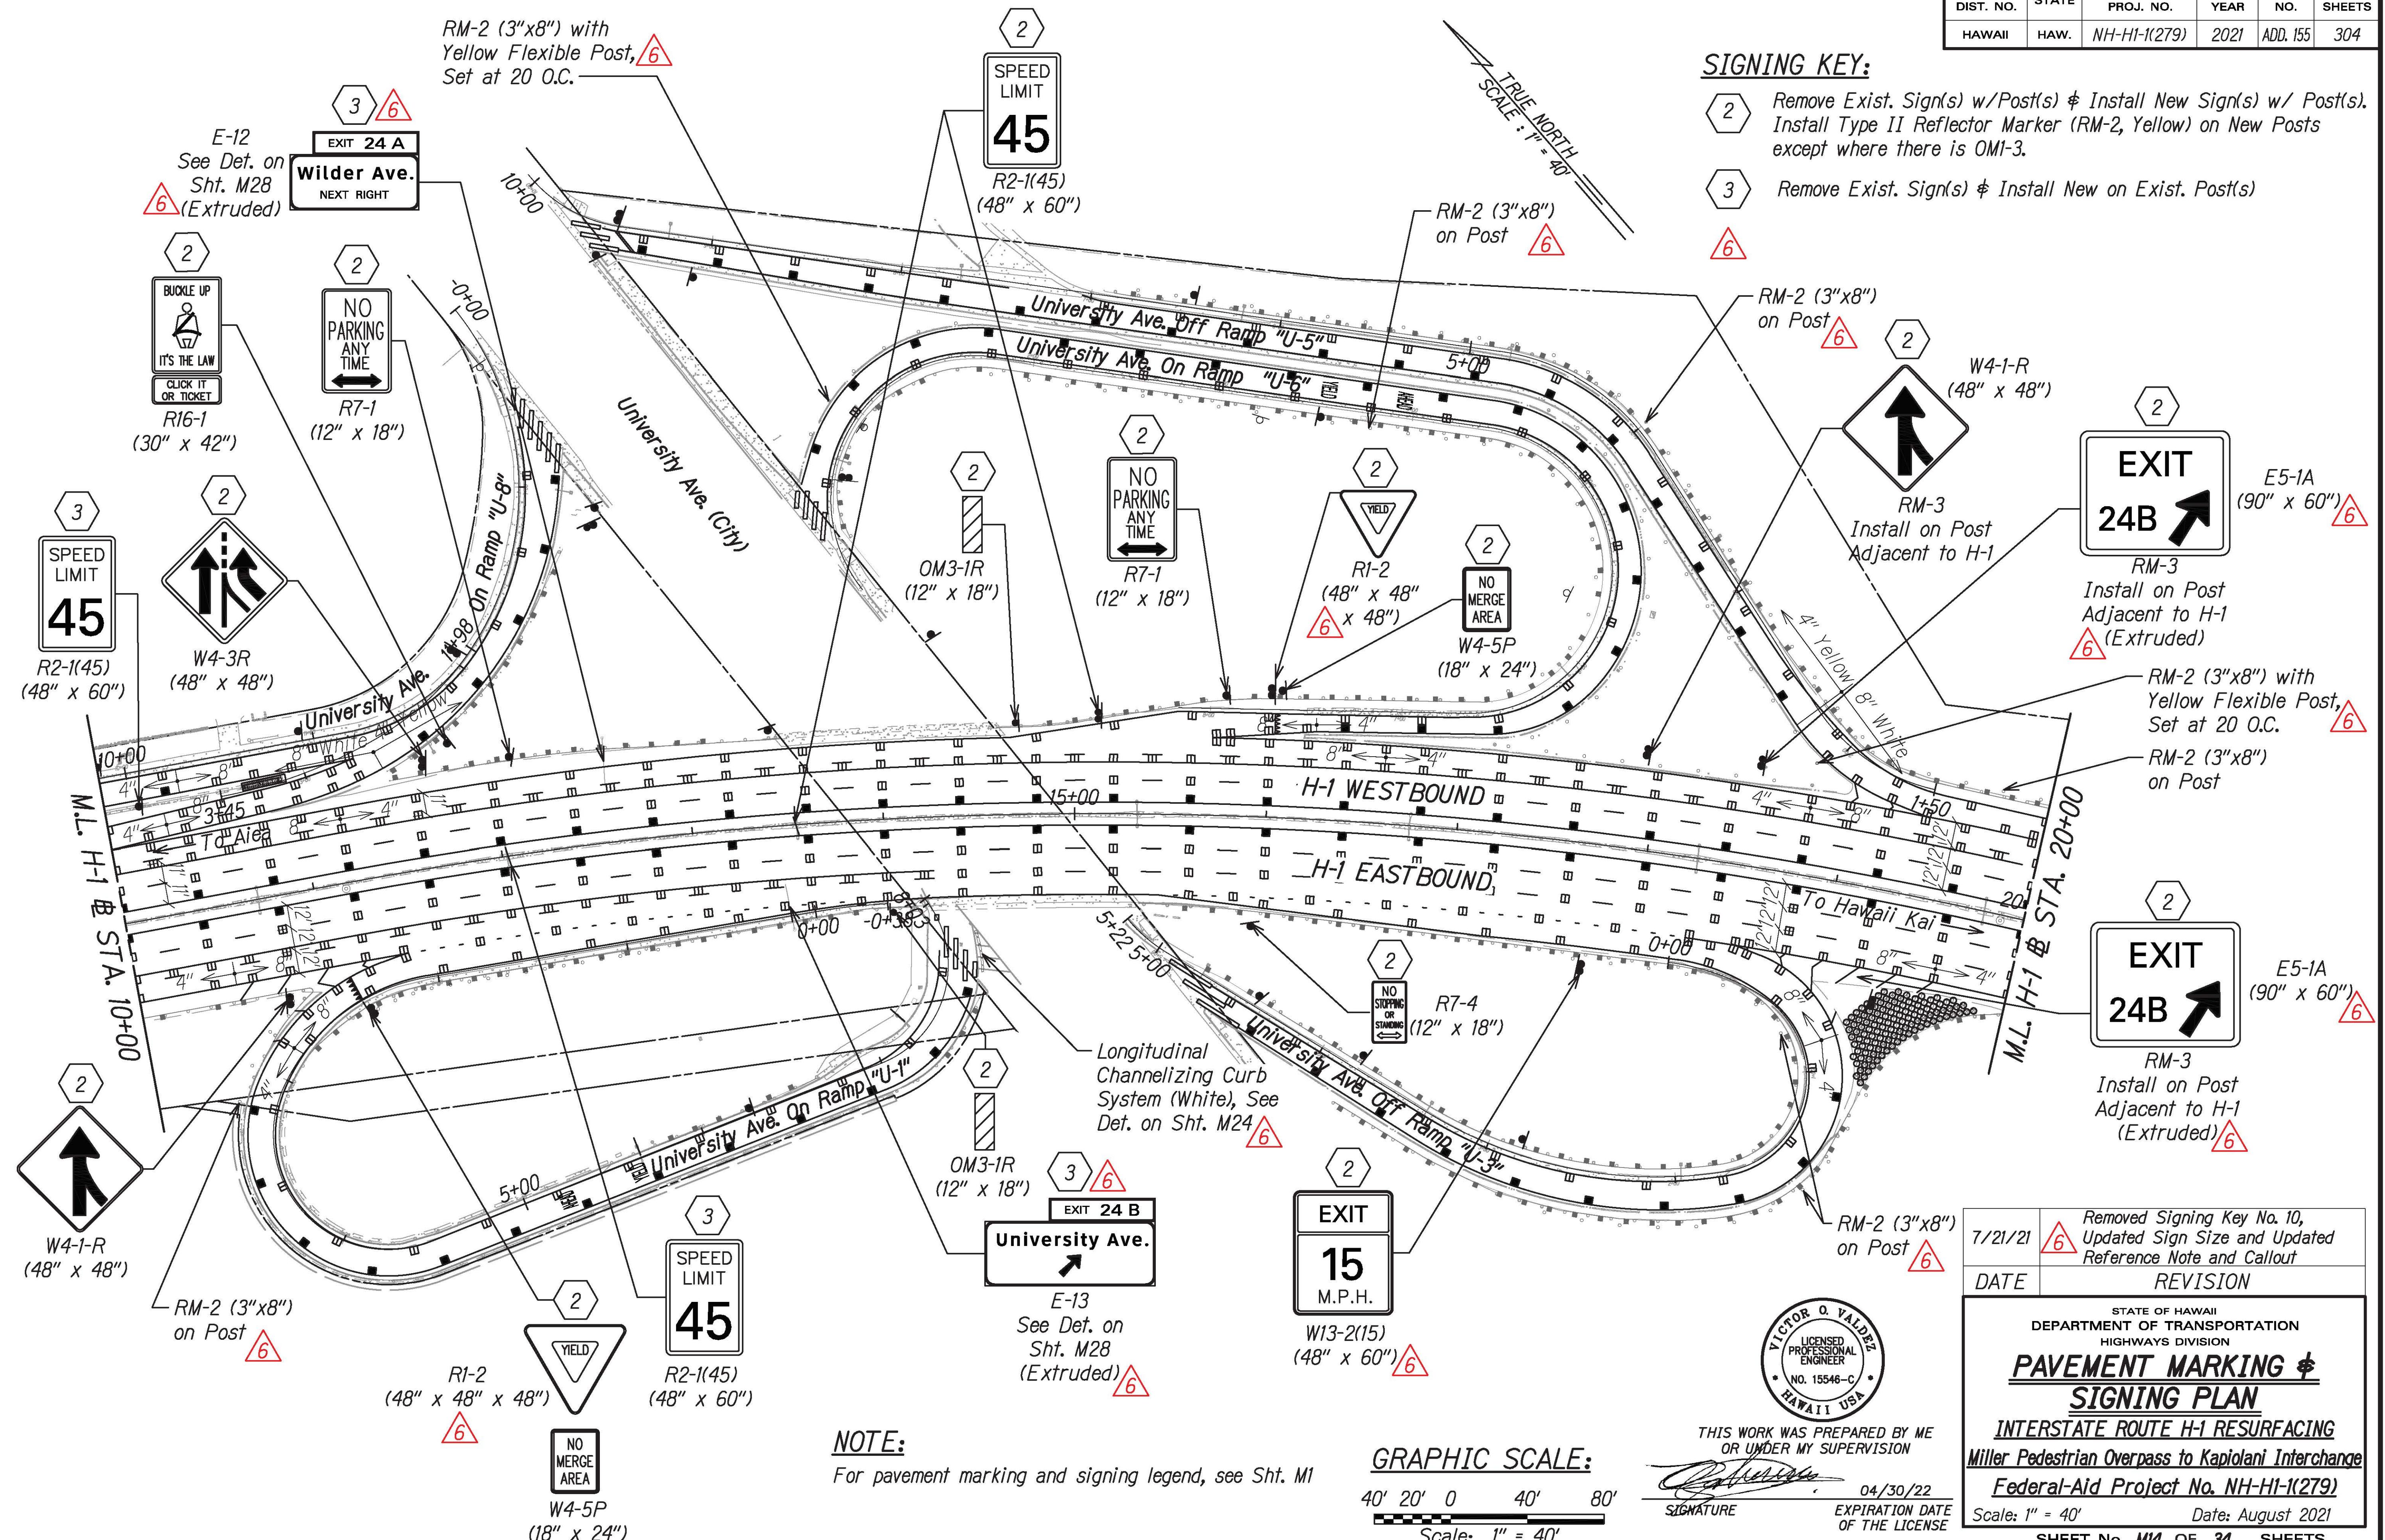

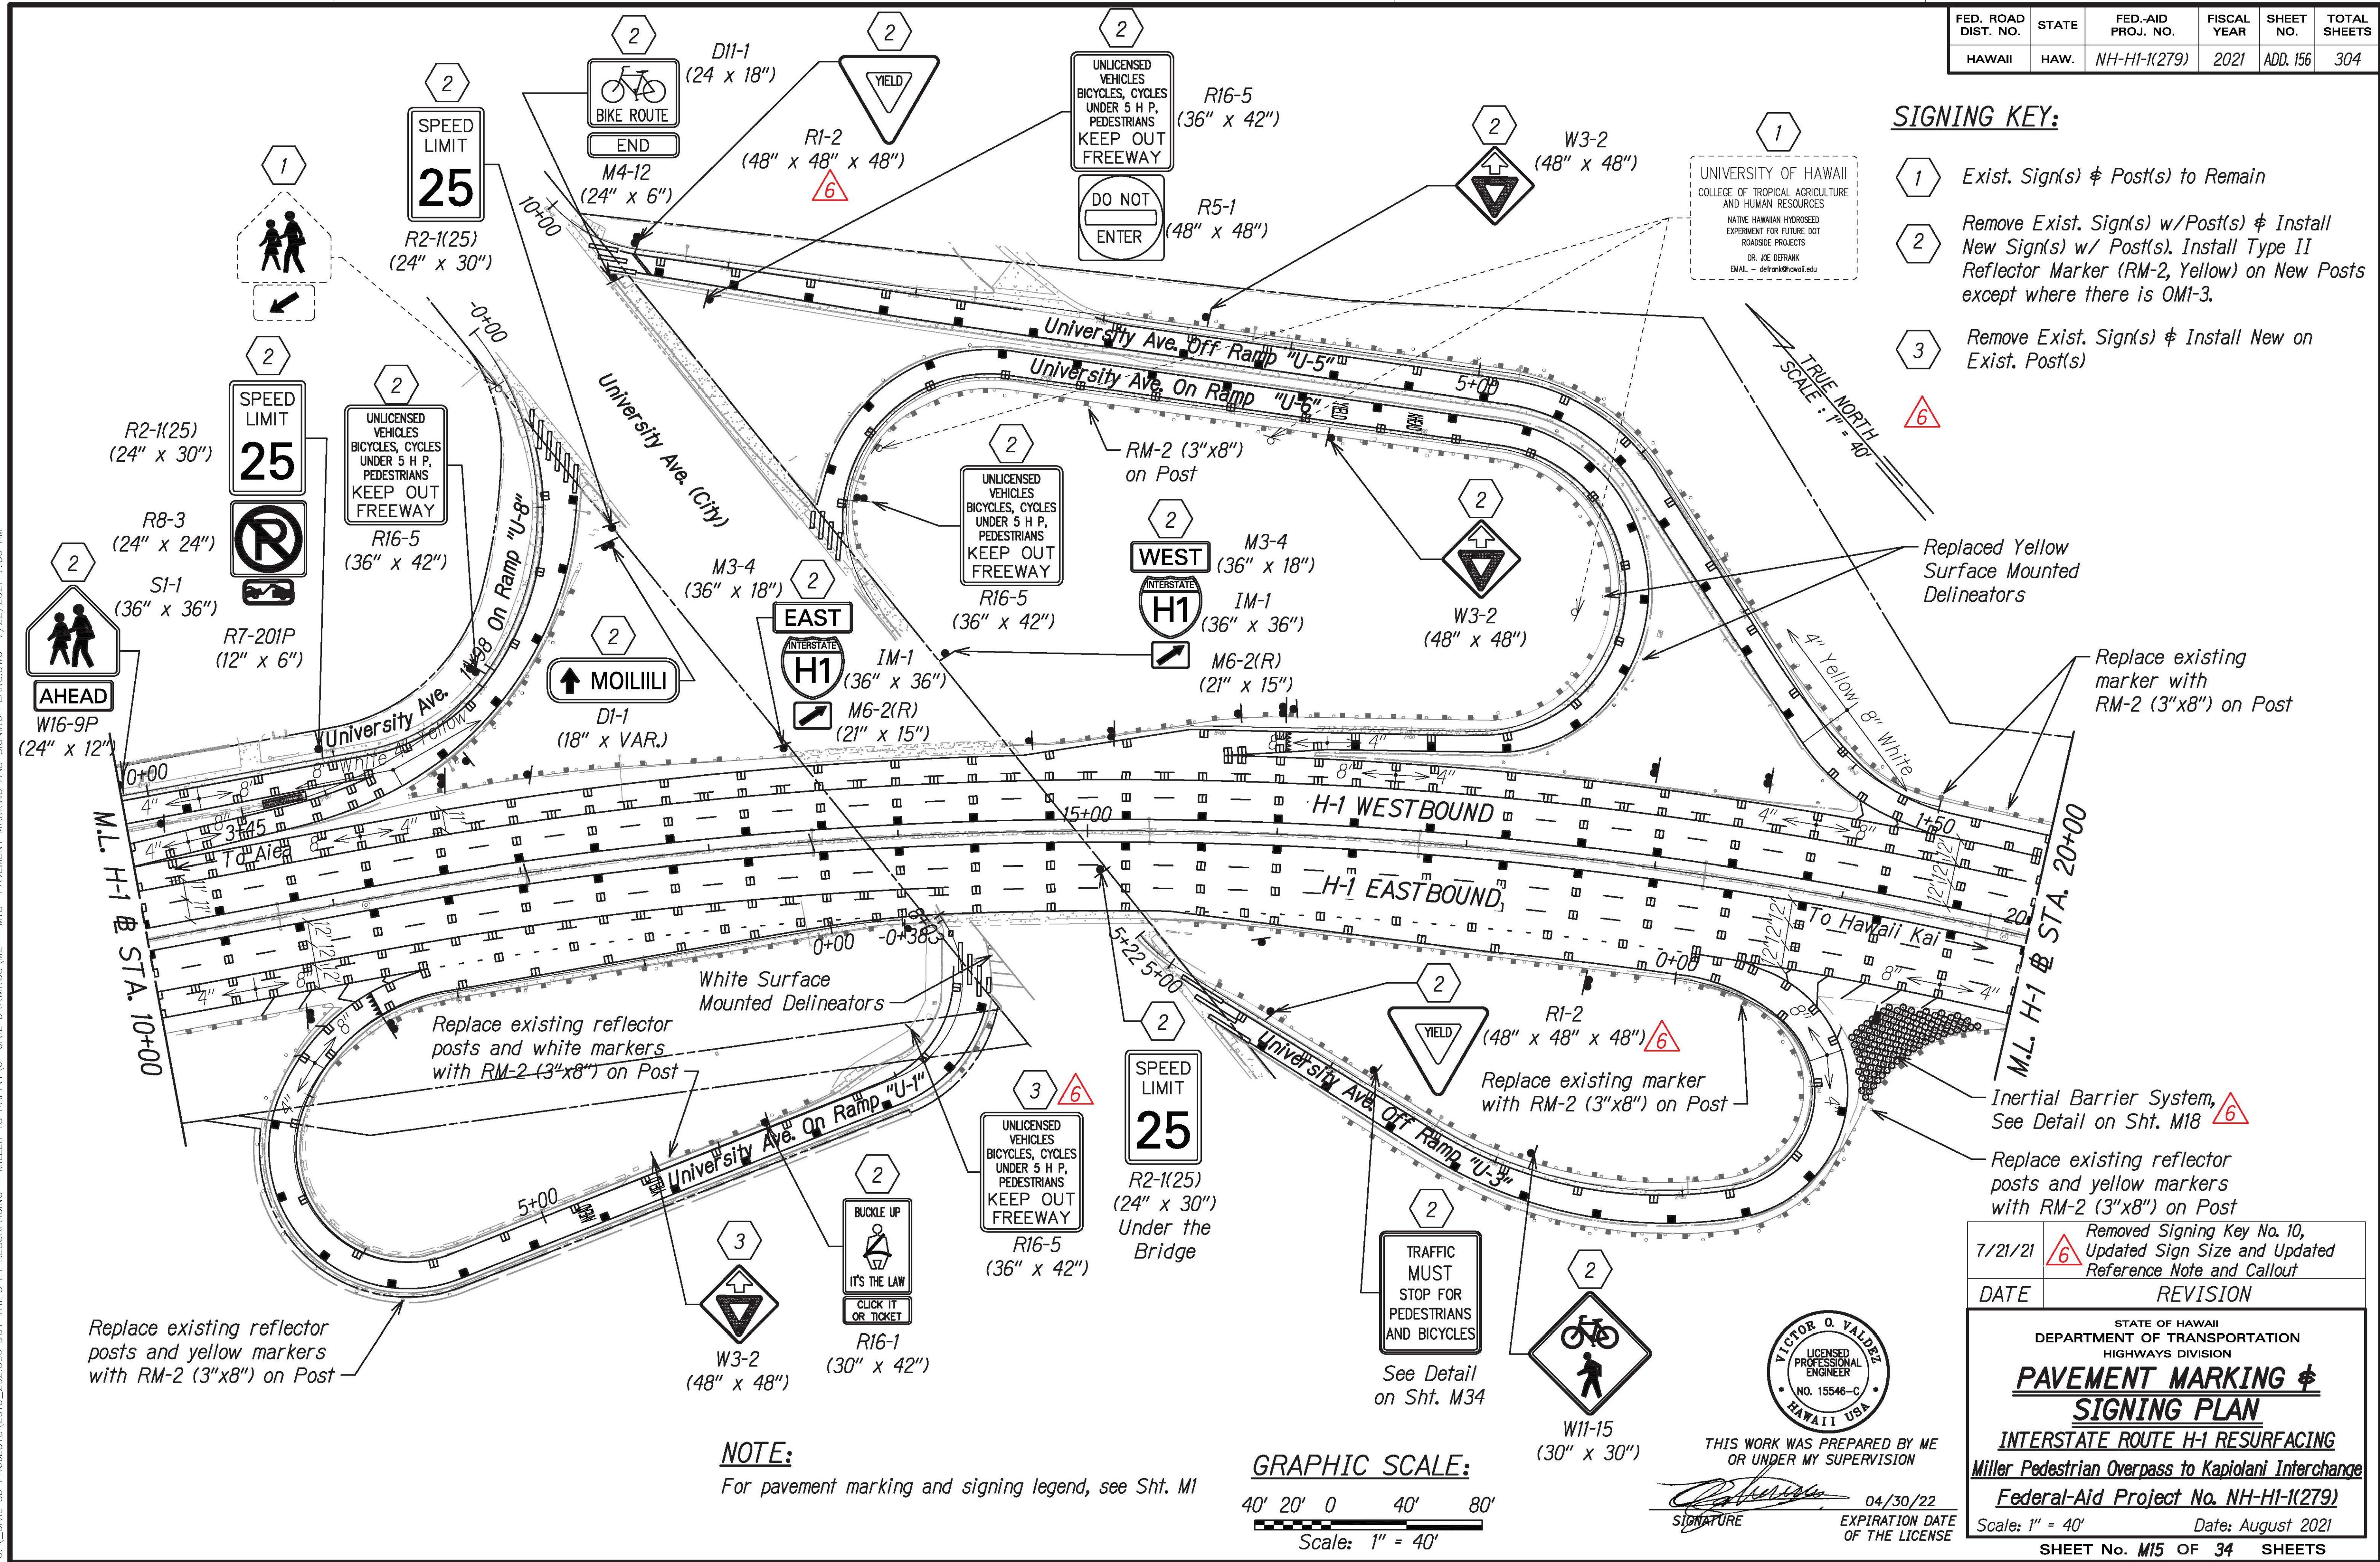

FED. ROAD DIST. NO.	STATE	FED.-AID PROJ. NO.	FISCAL YEAR	SHEET NO.	TOTAL SHEETS
HAWAII	HAW.	NH-HI-1(279)	2021	ADD. 157	304

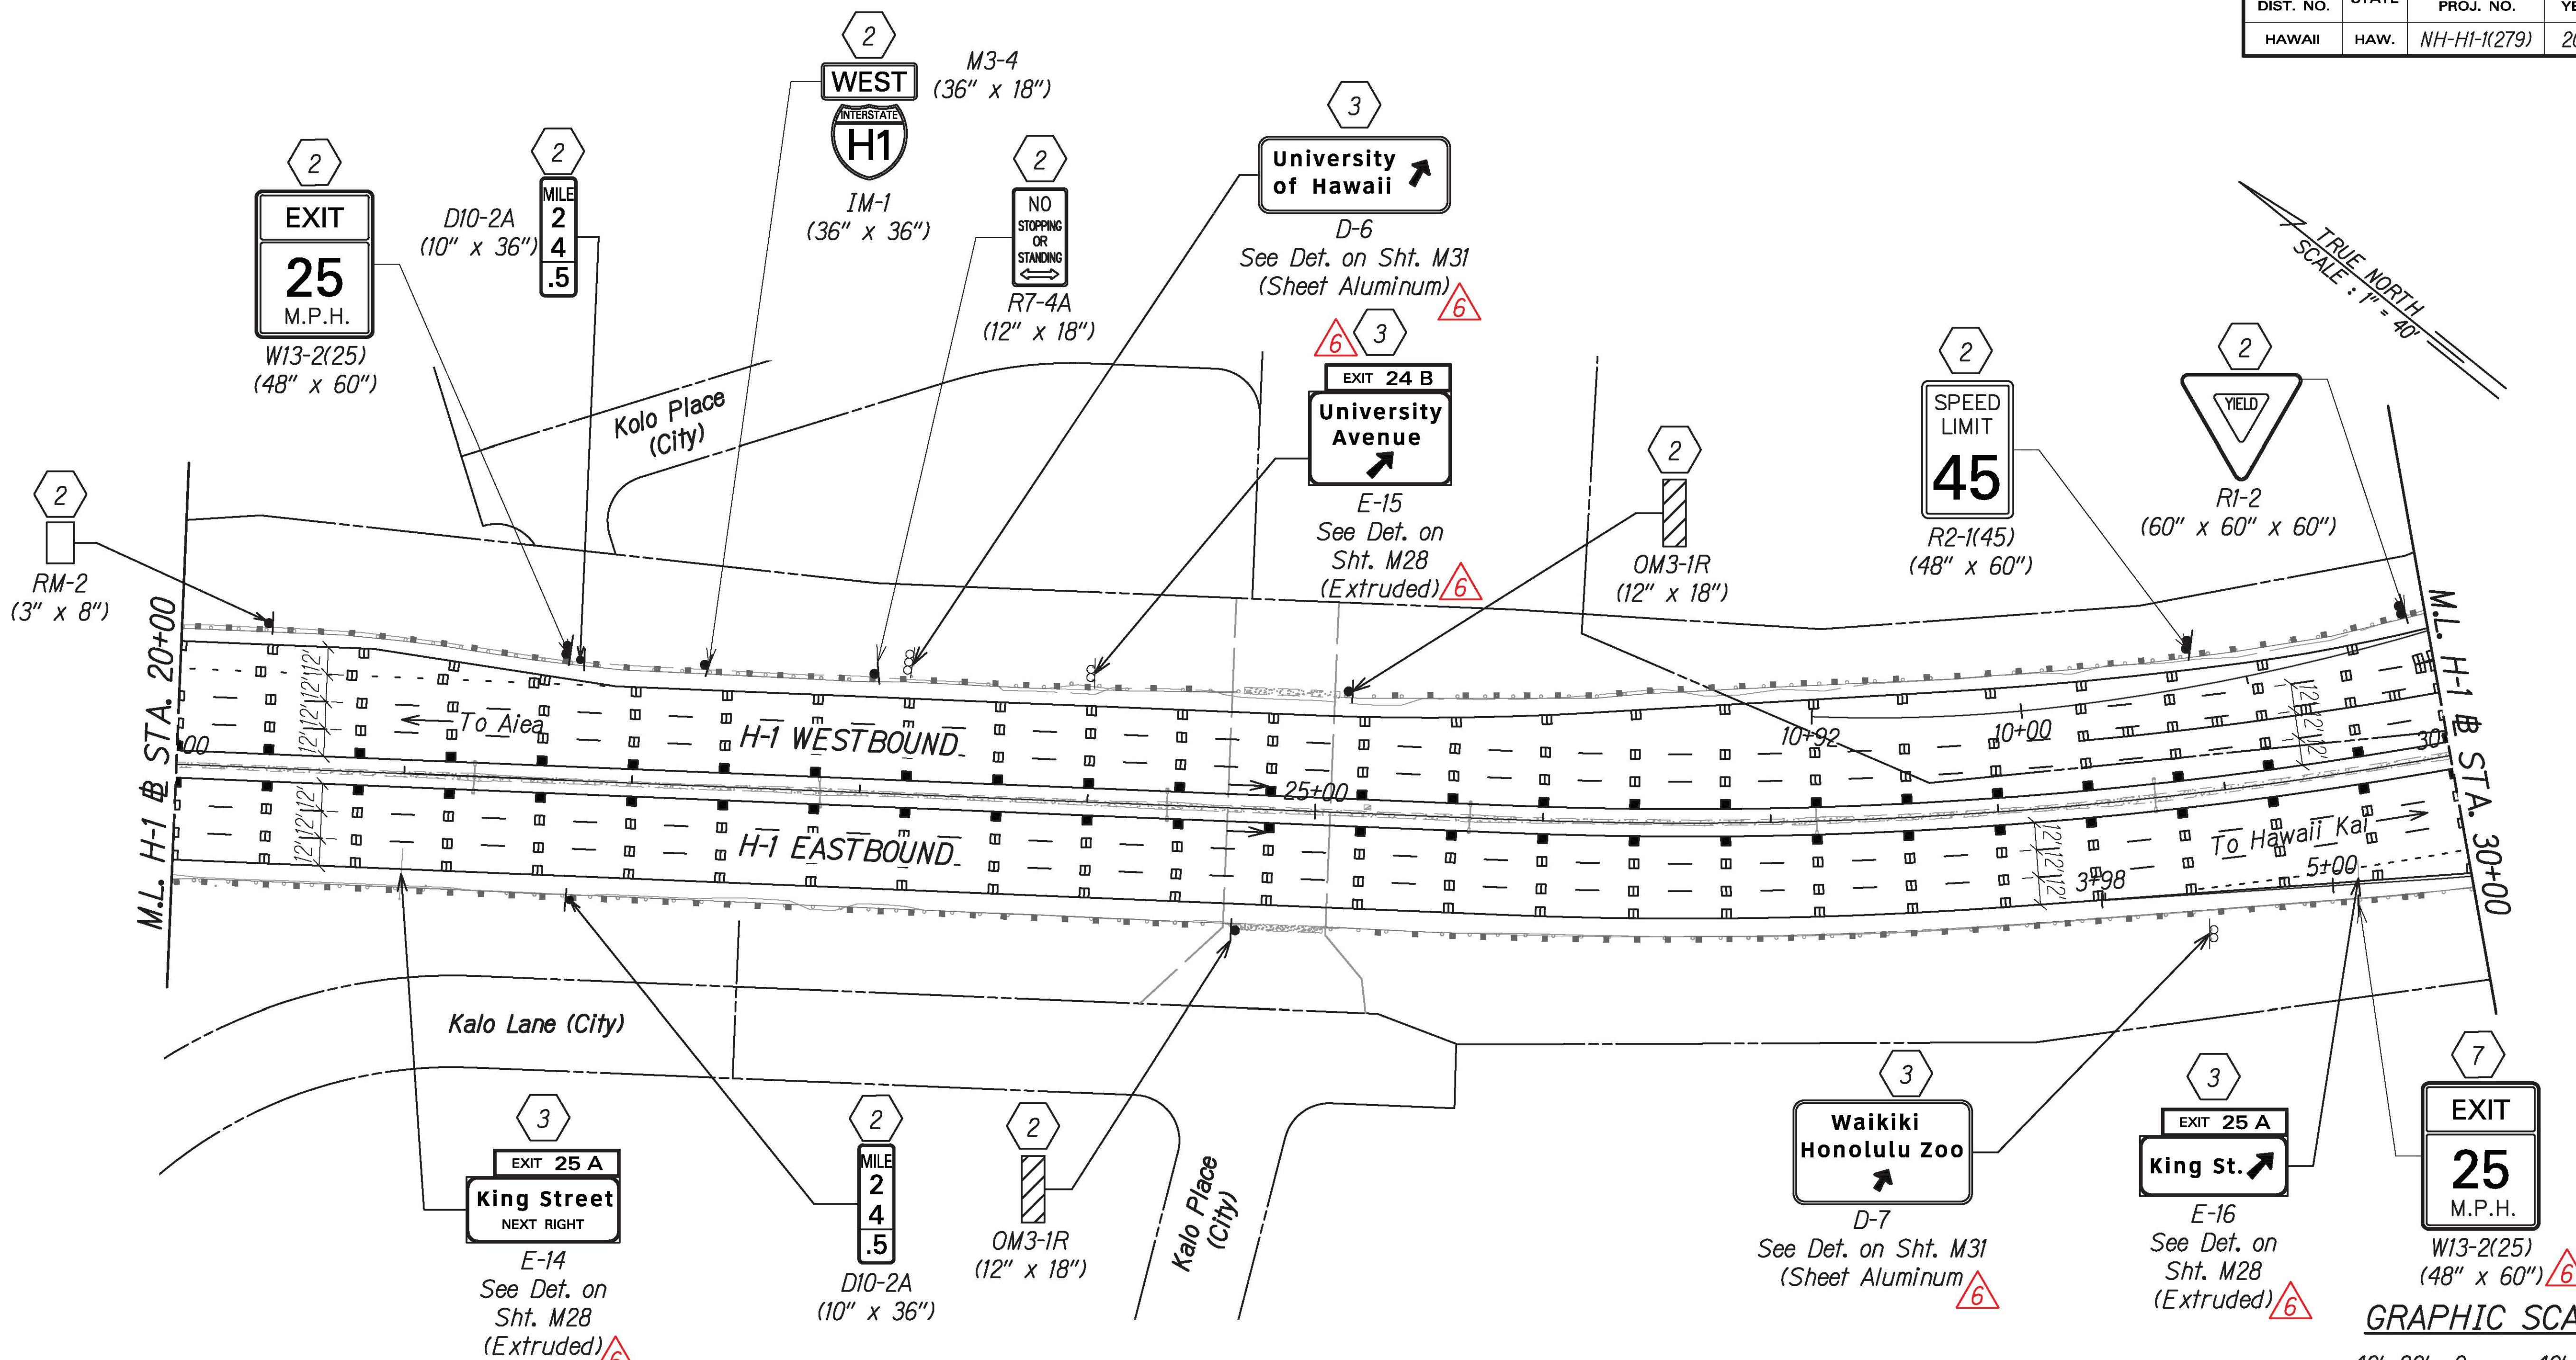

C:\CIVIL 3D PROJECTS\2016-2020\000 DOT-HWYS H1 RESURFACING - MILLER TO KAPIOLANI CIVIL DRAWINGS\01 CIVIL DRAWINGS\M18 - PAVEMENT MARKING AND SIGNING PLANS.DWG 7/22/2021 7:59 AM


#### NOTE:

For pavement marking and signing legend, see Sht. M1

#### SIGNING KEY:

- (2) Remove Exist. Sign(s) w/ Post(s) & Install New Sign(s) w/ Post(s).  
Install Type II Reflector Marker (RM-2, Yellow) on New Posts except where there is OM1-3.
- (3) Remove Exist. Sign(s) & Install New Sign(s) on Exist. Post(s)
- (7) Remove Exist. Sign(s) & Install New Sign(s) on Exist. Column Sign Post

(6)

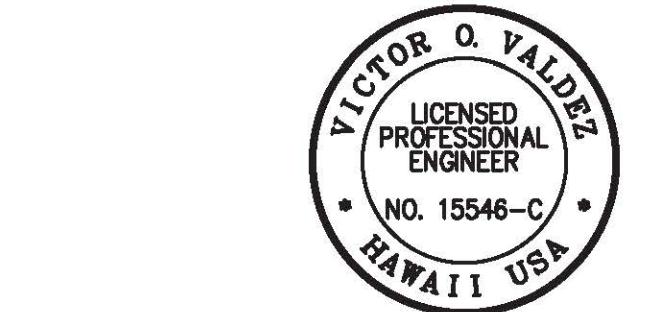

THIS WORK WAS PREPARED BY ME  
OR UNDER MY SUPERVISION


*[Signature]* 04/30/22  
SIGNATURE


EXPIRATION DATE  
OF THE LICENSE

7/21/21	Removed Signing Key No. 10, Updated Sign Size and Updated Reference Note and Callout (6)
DATE	REVISION
STATE OF HAWAII DEPARTMENT OF TRANSPORTATION HIGHWAYS DIVISION <b>PAVEMENT MARKING &amp; SIGNING PLAN</b> INTERSTATE ROUTE H-1 RESURFACING Miller Pedestrian Overpass to Kapiolani Interchange Federal-Aid Project No. NH-HI-1(279)	
Scale: 1" = 40'	
Date: August 2021	


SHEET NO. M16 OF 34 SHEETS

ADD. 157

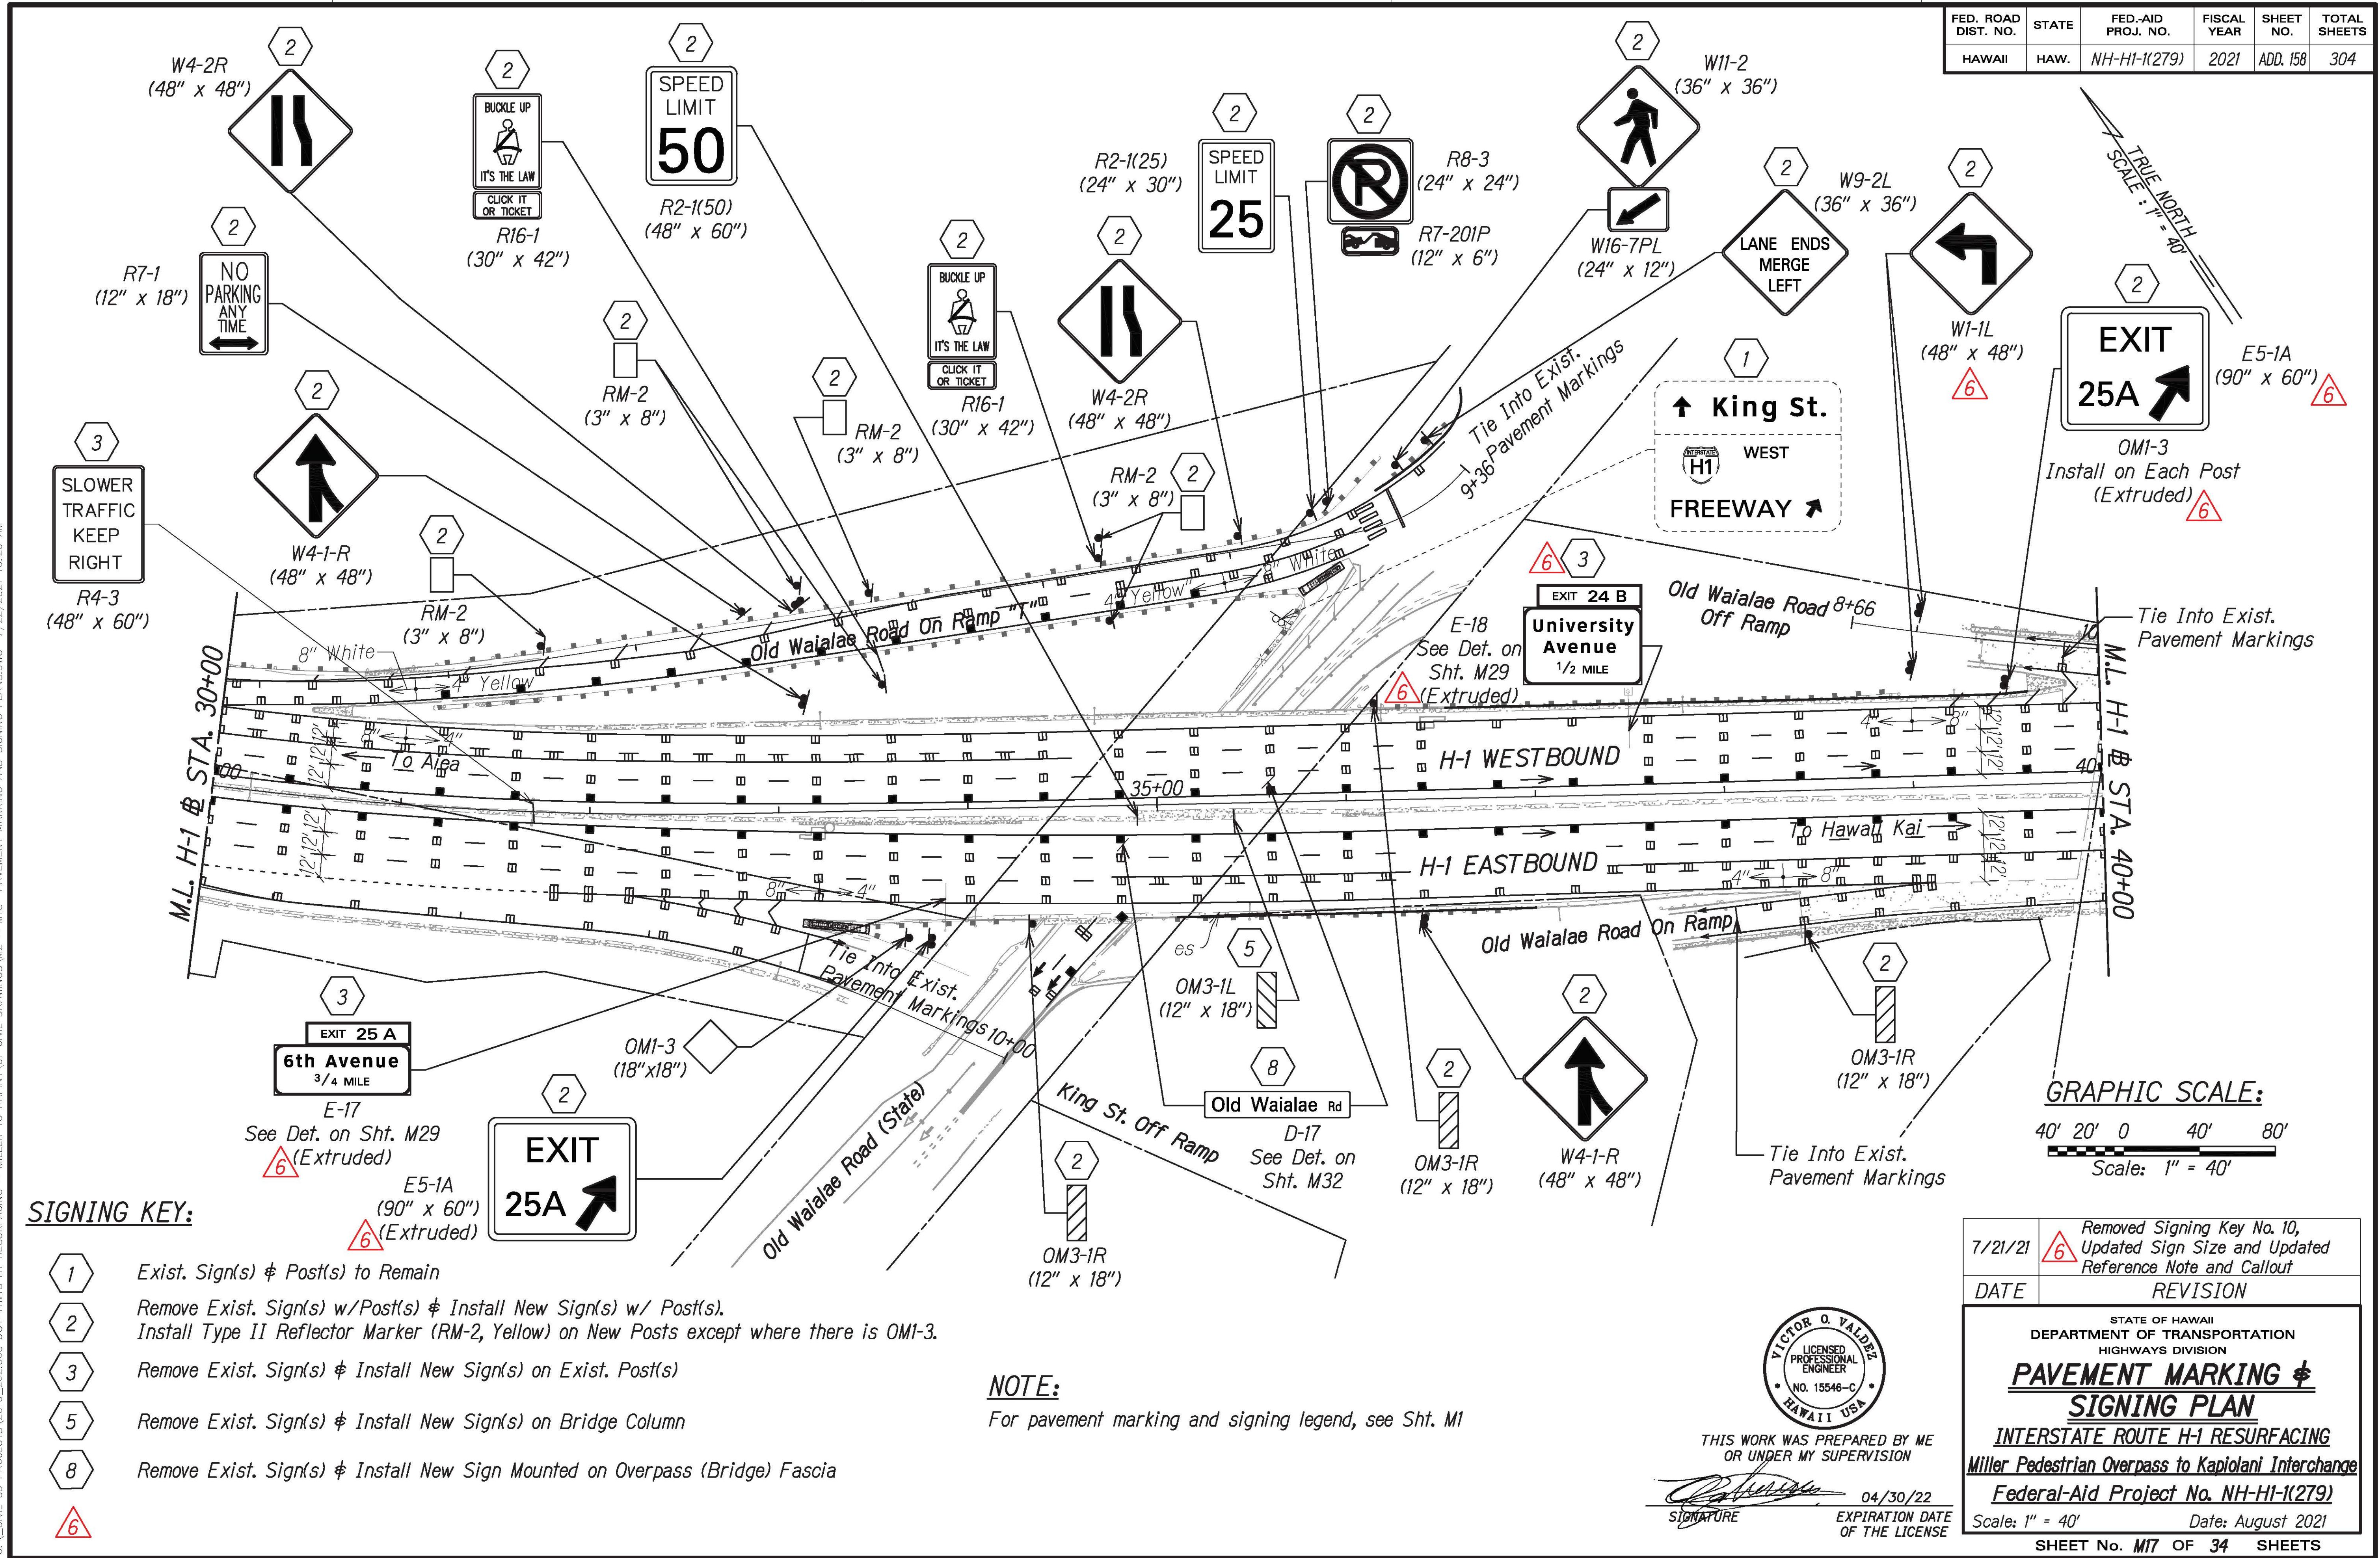


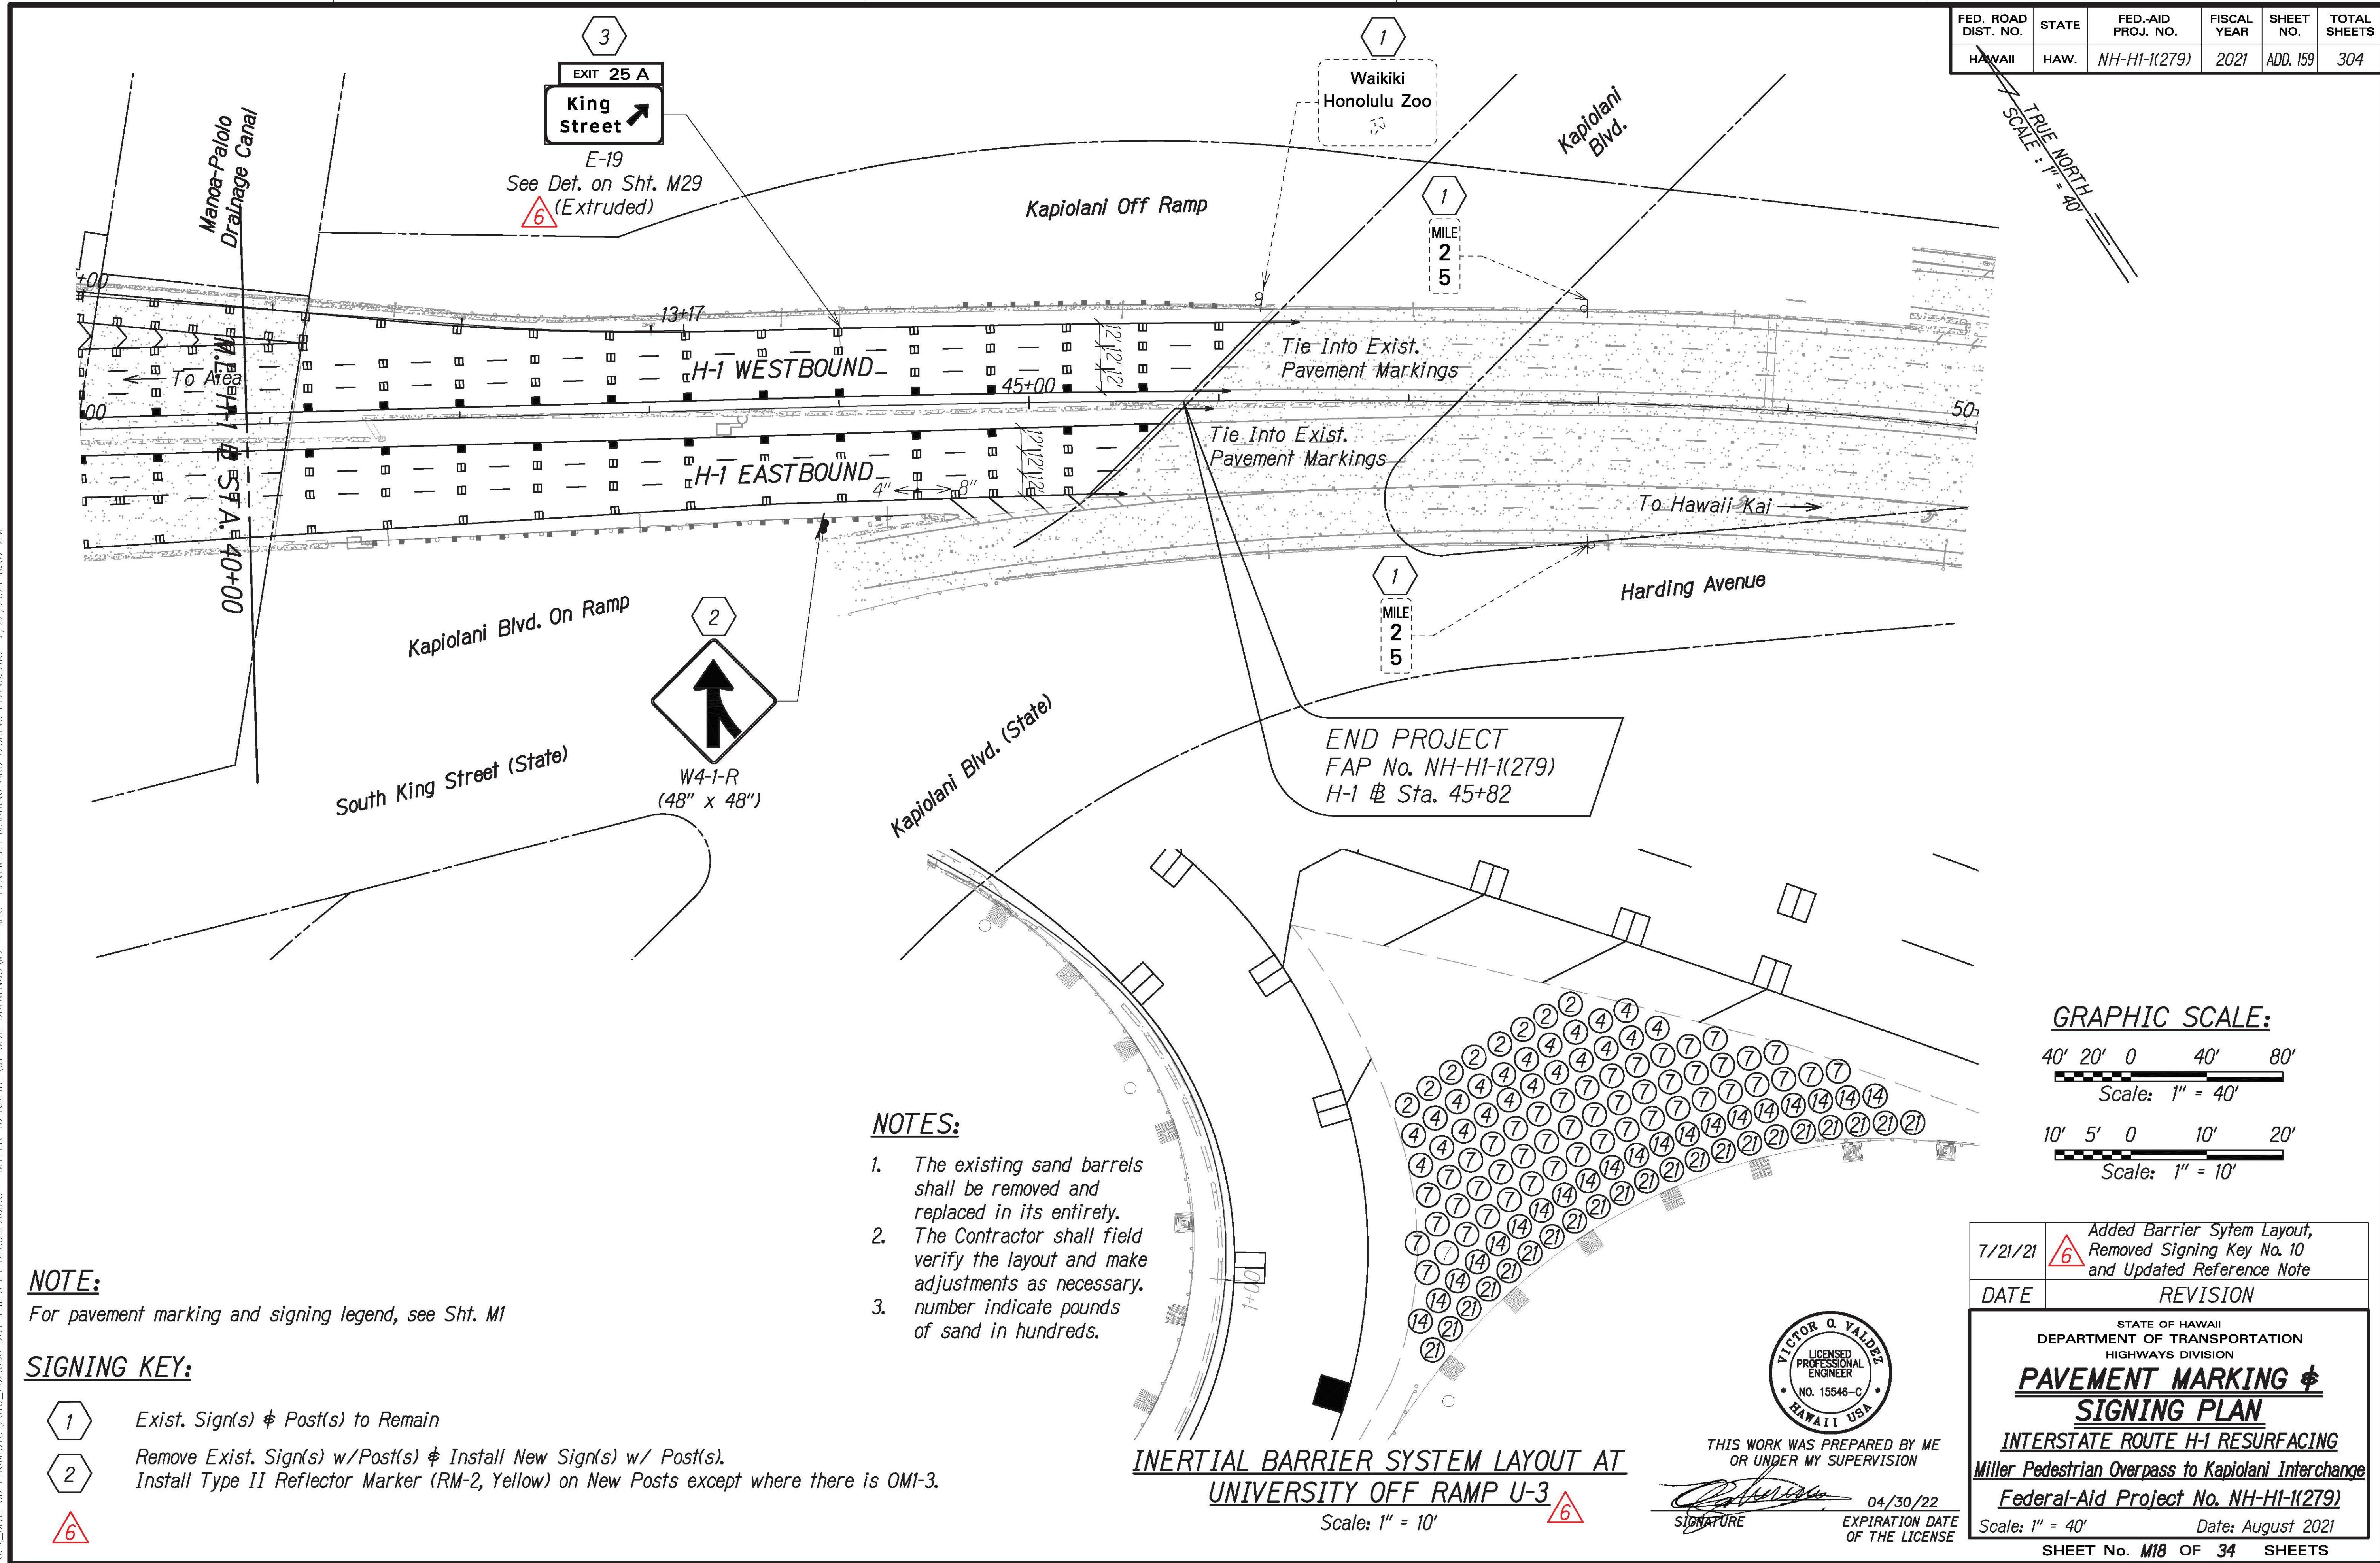


FED. ROAD DIST. NO.	STATE	FED.-AID PROJ. NO.	FISCAL YEAR	SHEET NO.	TOTAL SHEETS
HAWAII	HAW.	NH-HI-1(279)	2021	ADD. 160	304

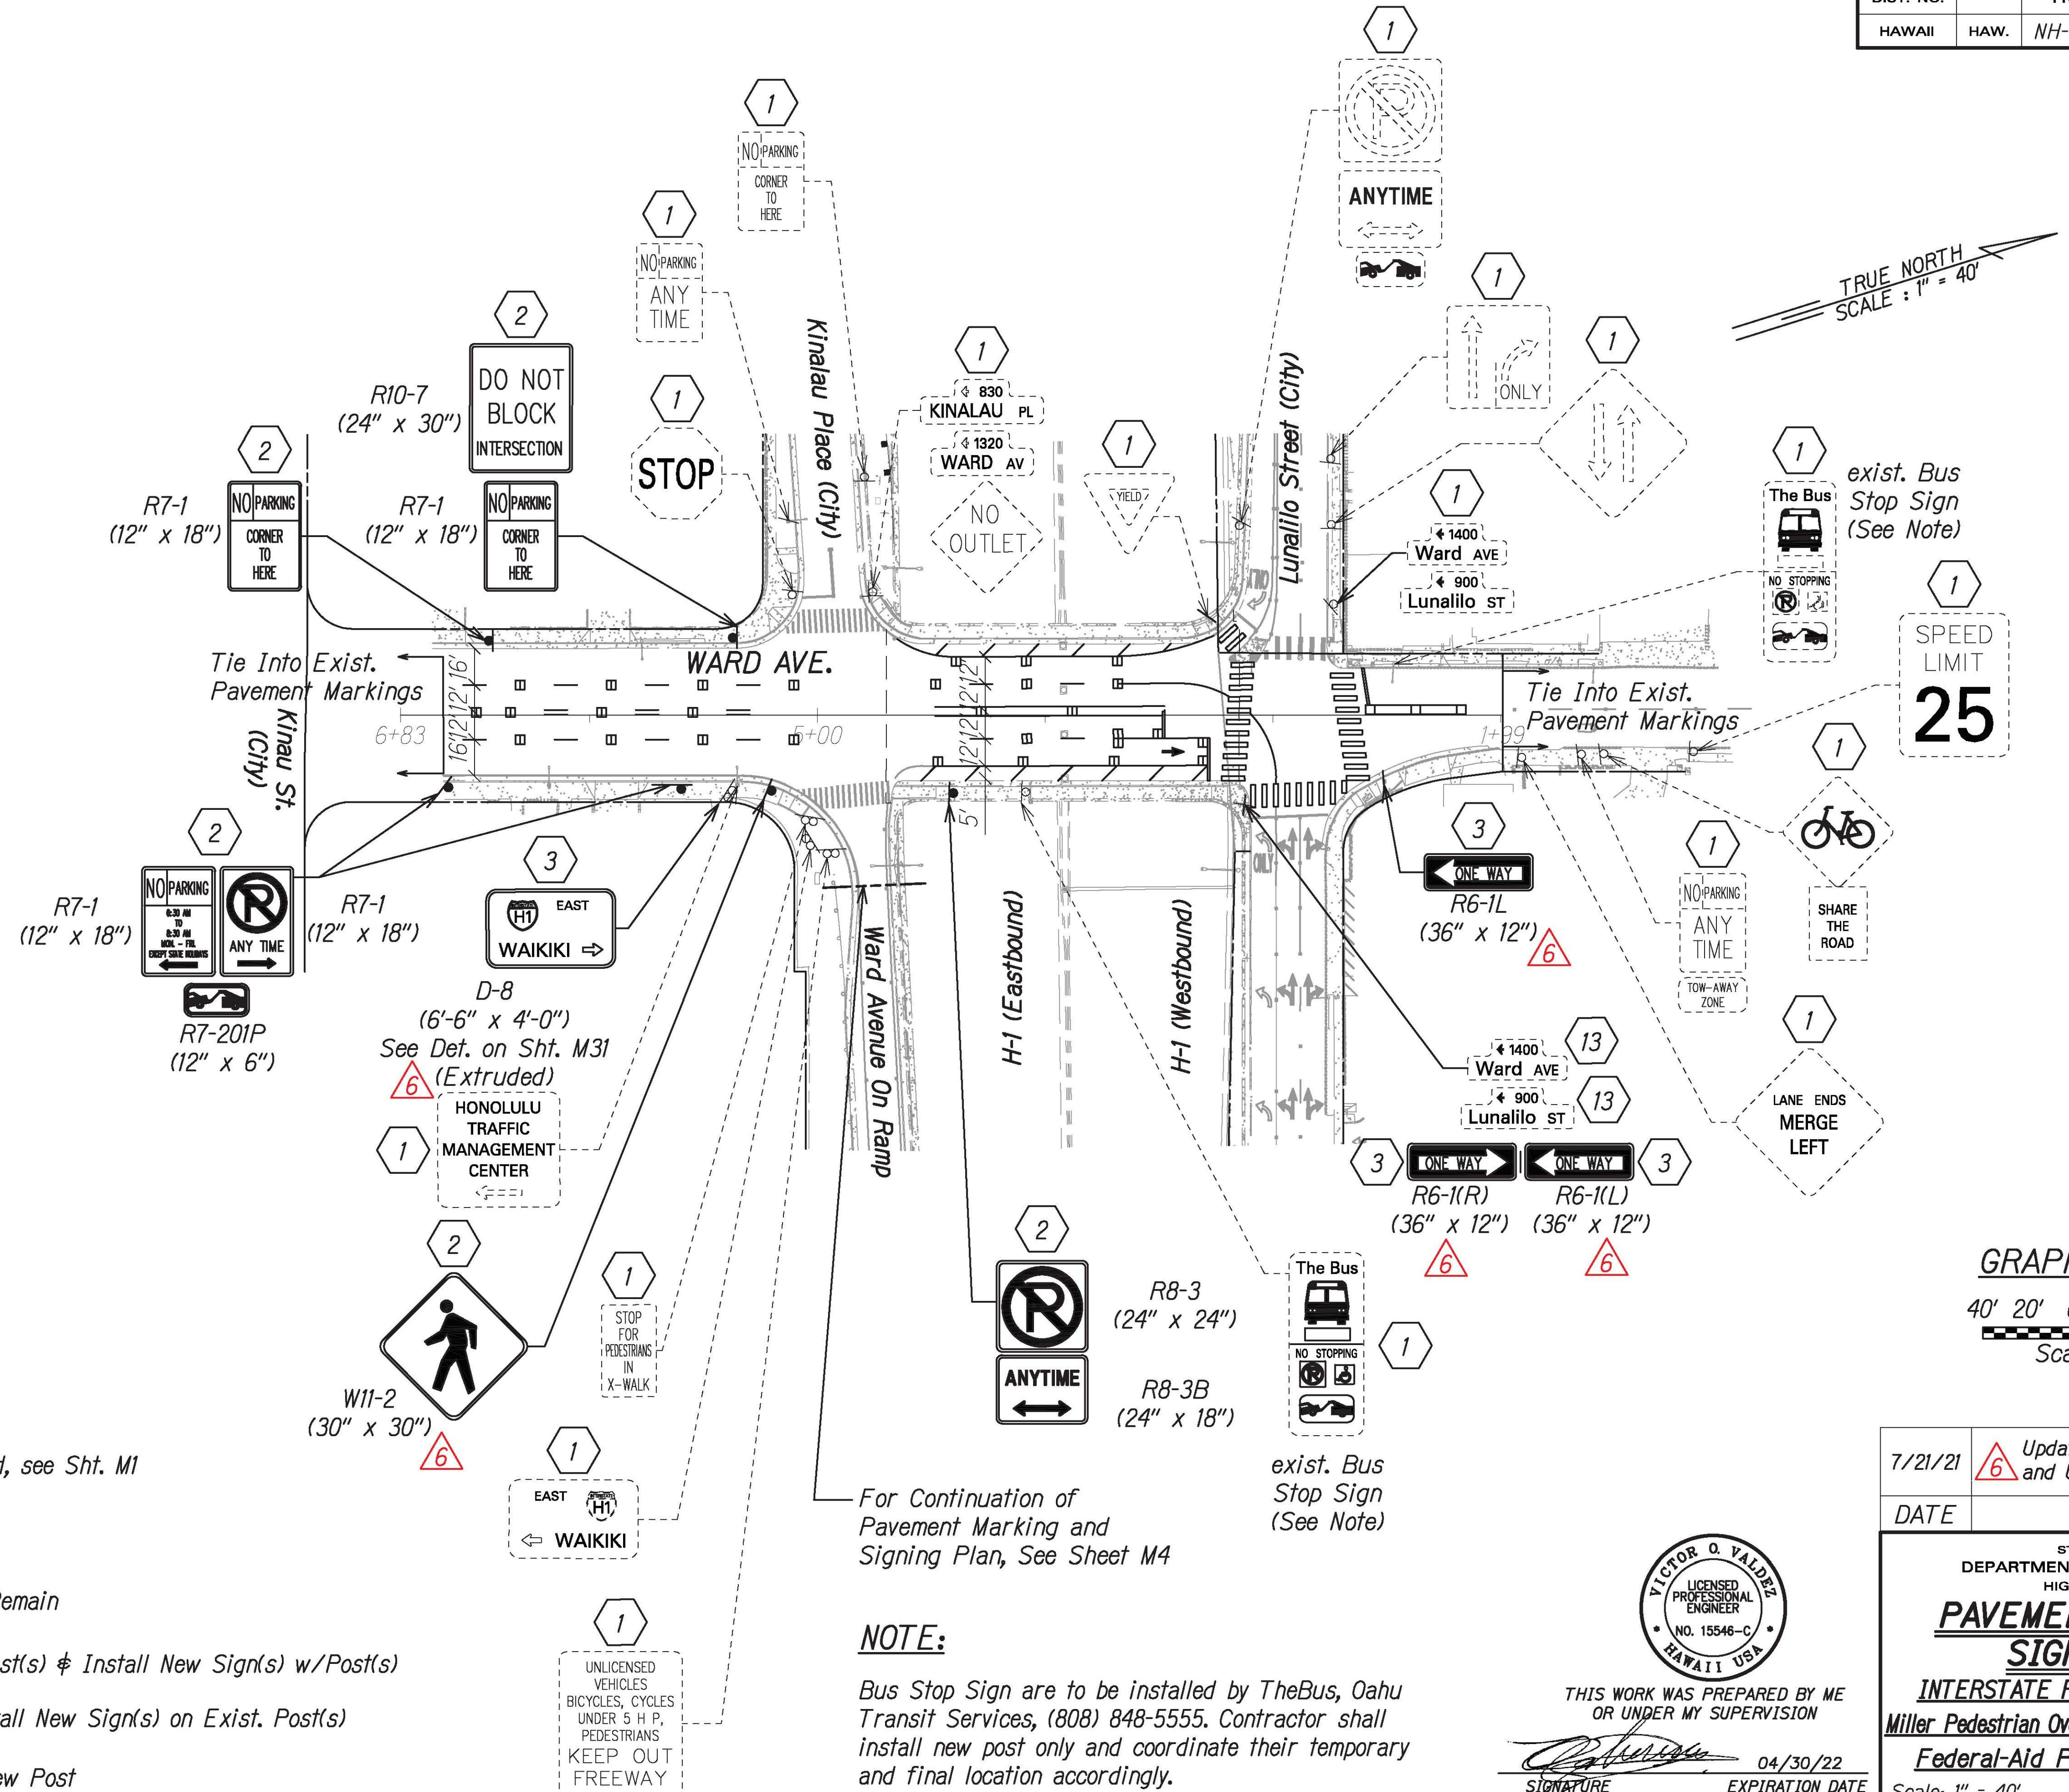


7/21/21	Updated Sign Description <b>6</b> and Updated Sign Size
DATE	REVISION
STATE OF HAWAII DEPARTMENT OF TRANSPORTATION HIGHWAYS DIVISION	
<b>PAVEMENT MARKING &amp; SIGNING PLAN</b>	
INTERSTATE ROUTE H-1 RESURFACING	
Miller Pedestrian Overpass to Kapiolani Interchange	
Federal-Aid Project No. NH-HI-1(279)	
Scale: 1" = 40'	
Signature: 04/30/22	
EXPIRATION DATE OF THE LICENSE	
Scale: 1" = 40'	
Date: August 2021	

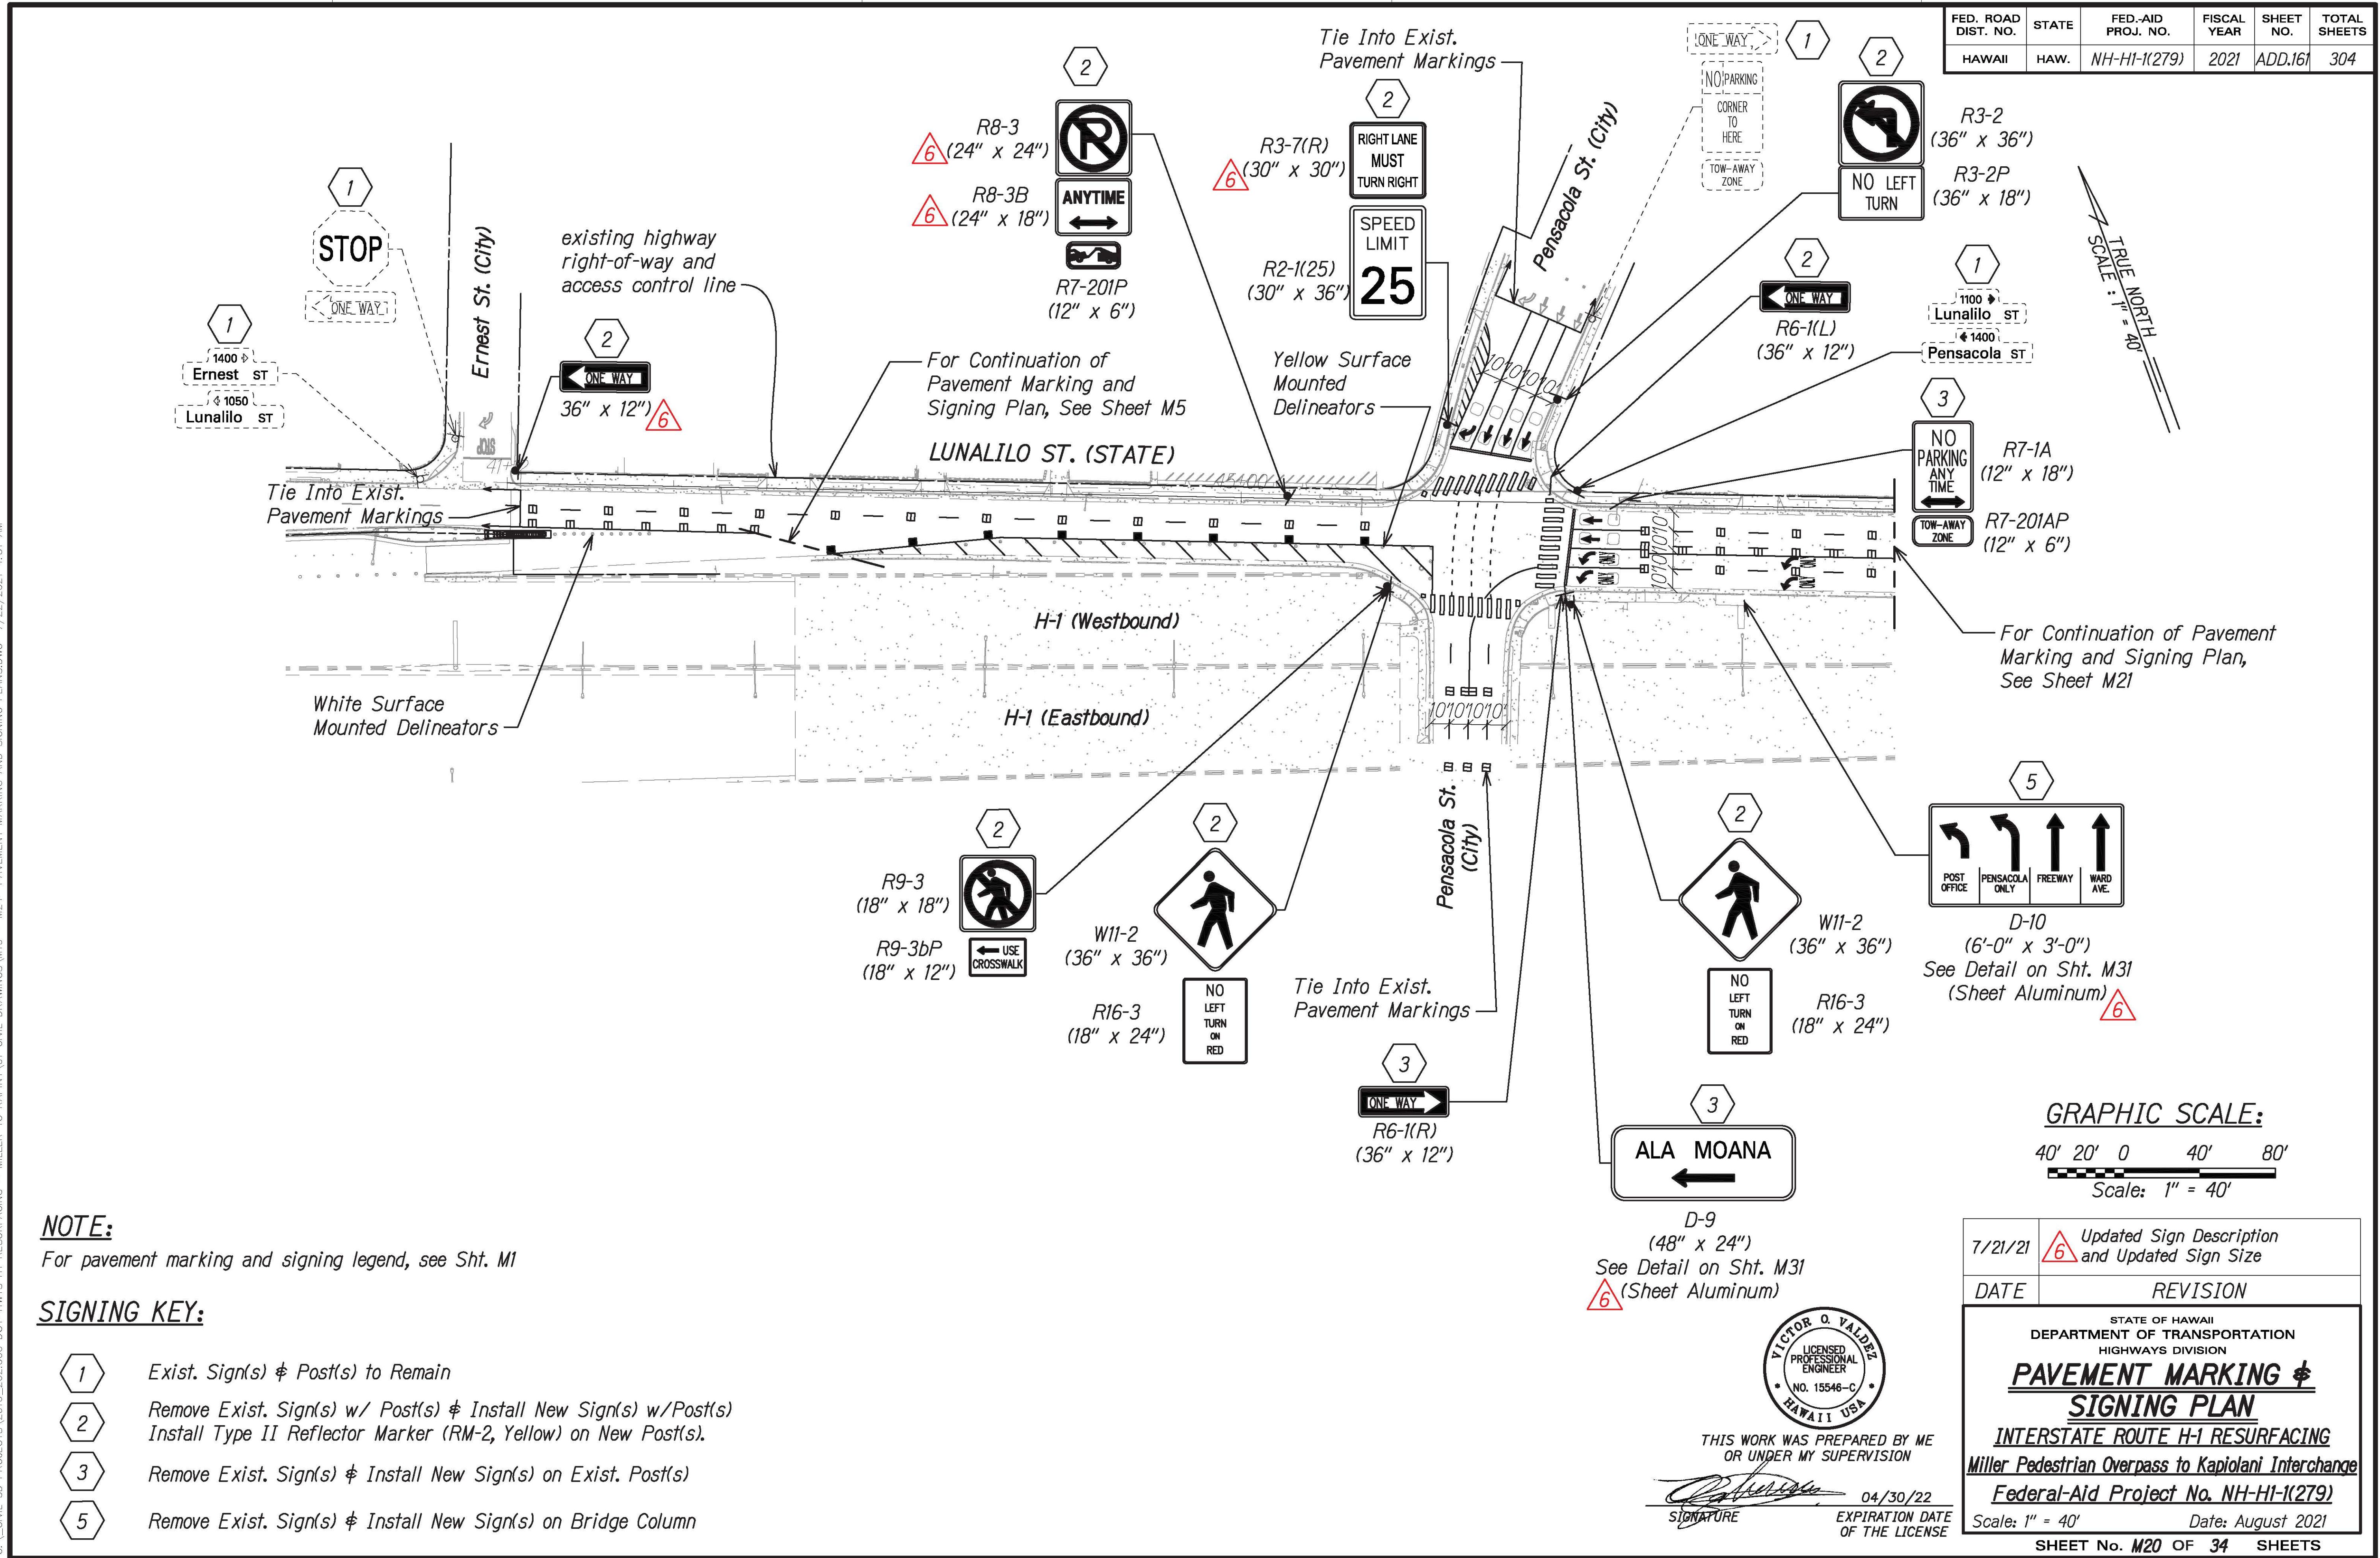


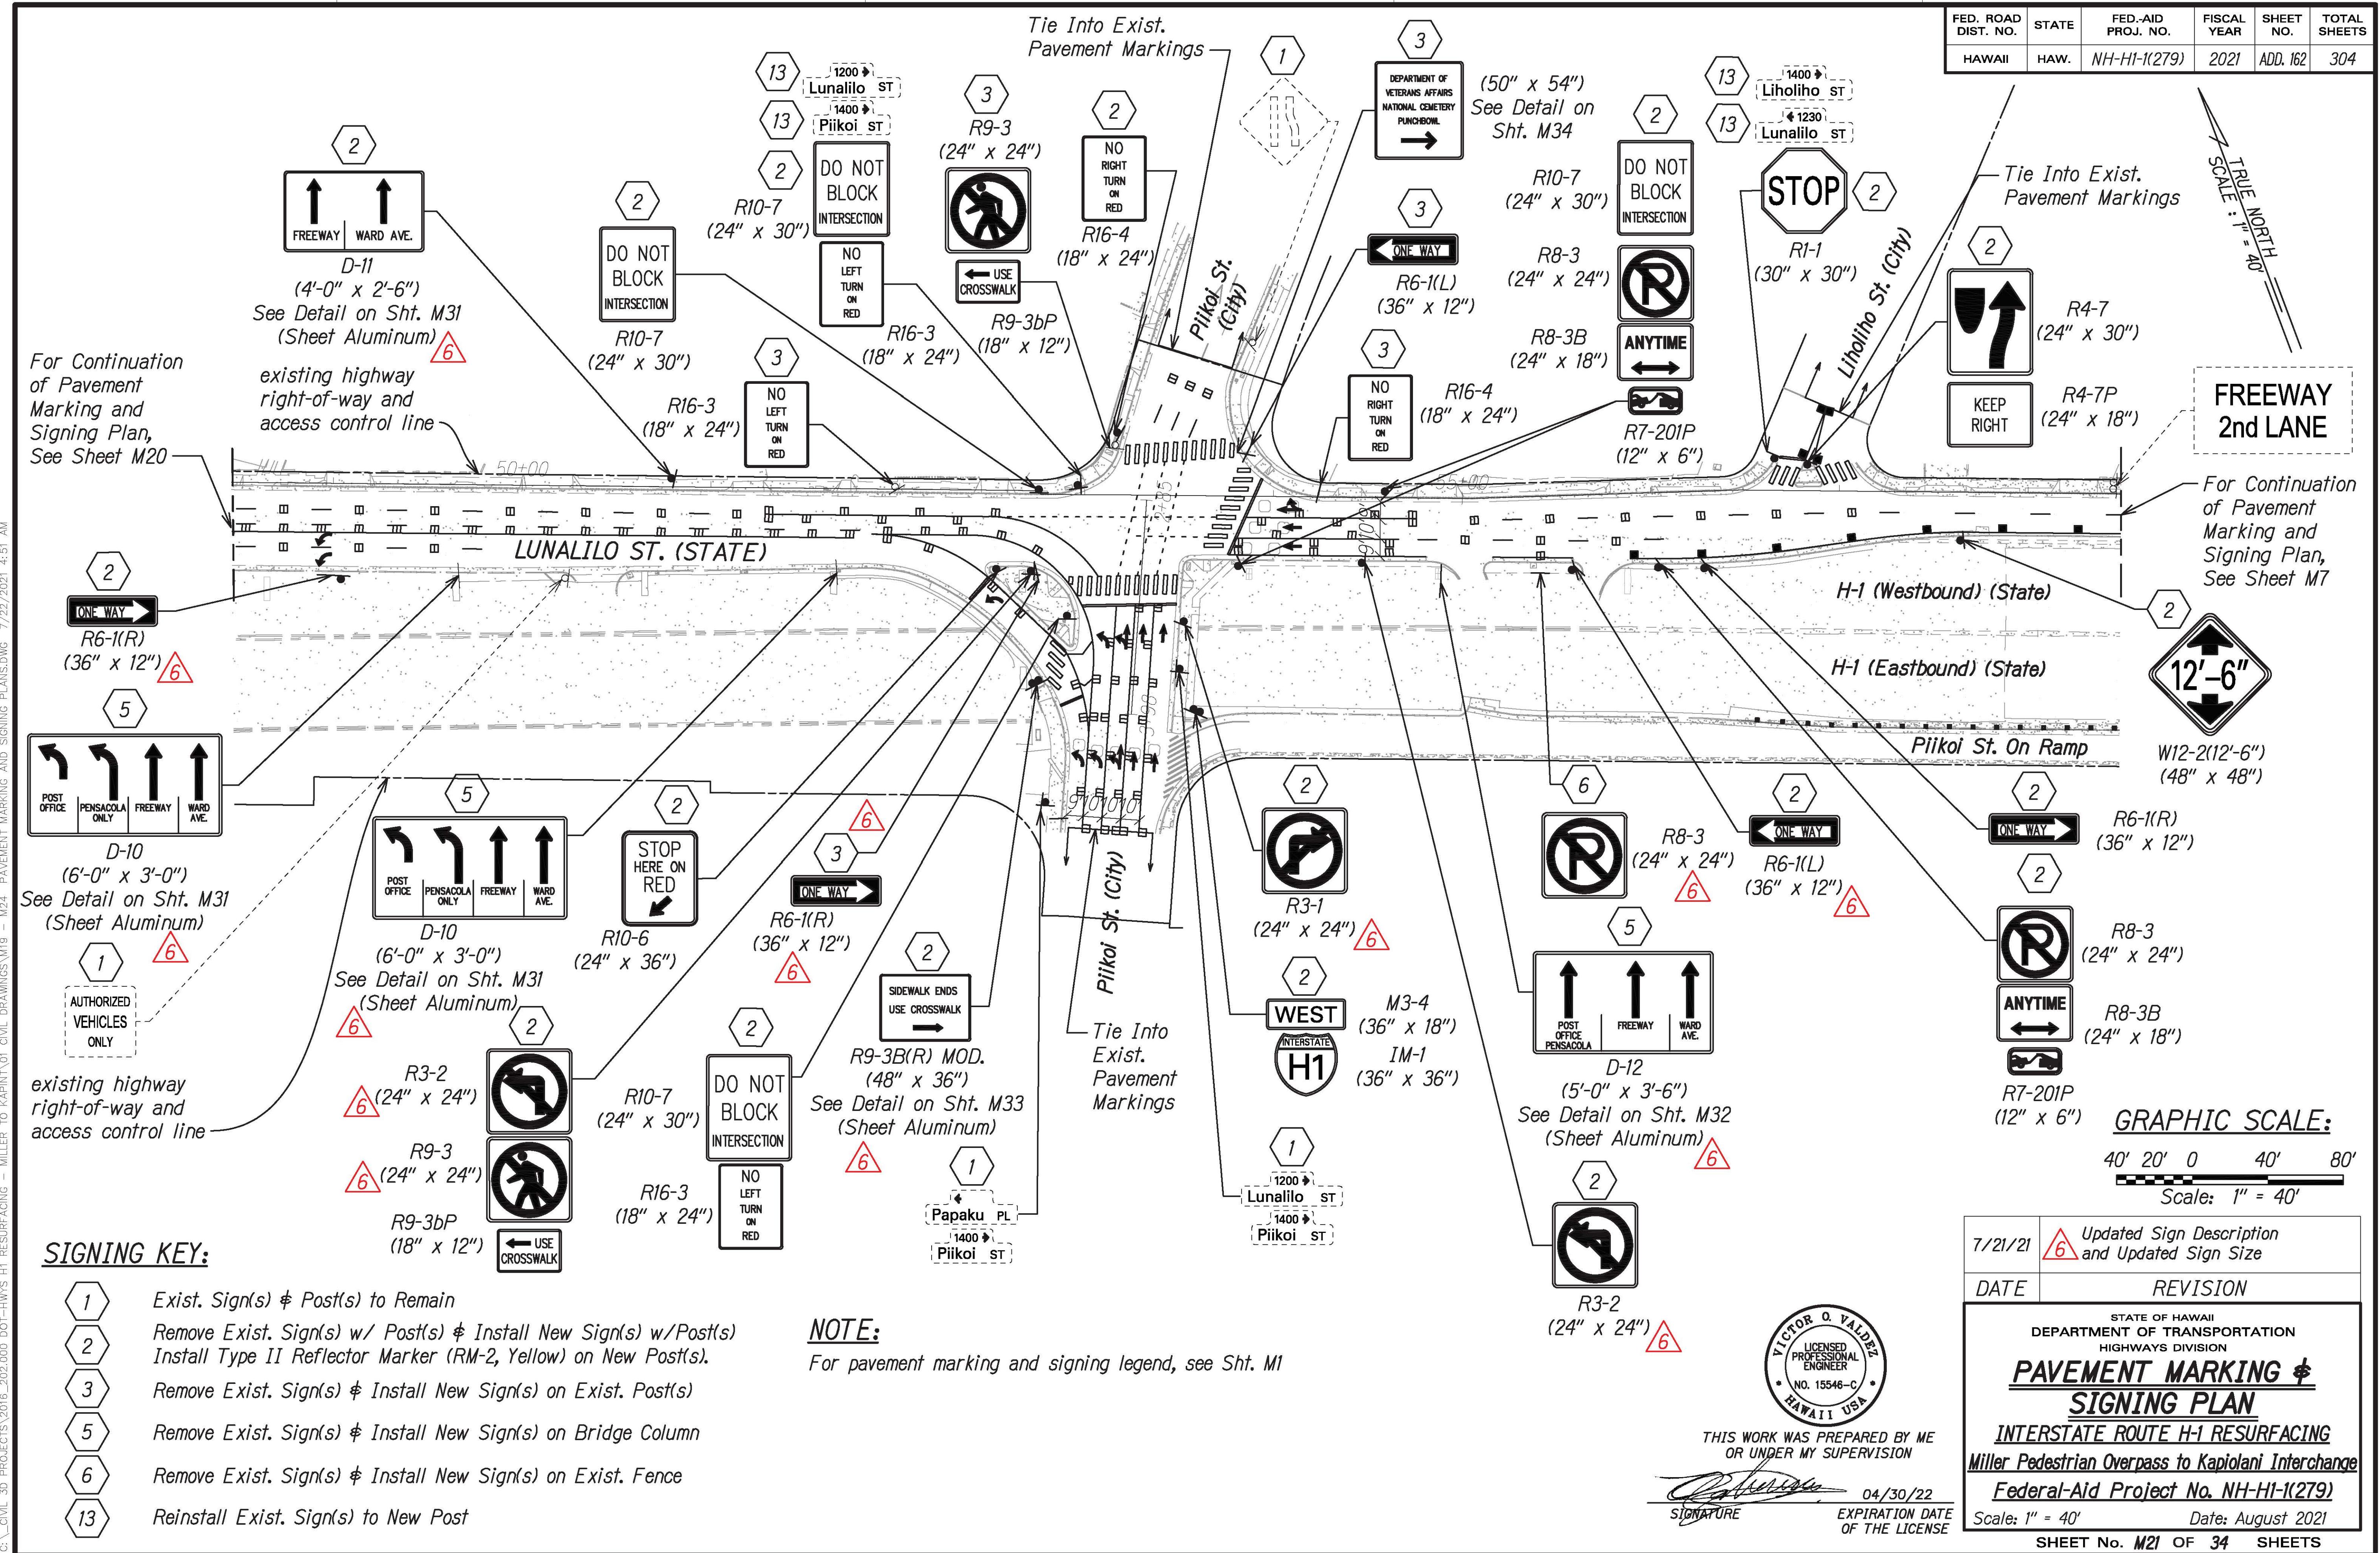


TRUE NORTH  
SCALE : 1" = 40'

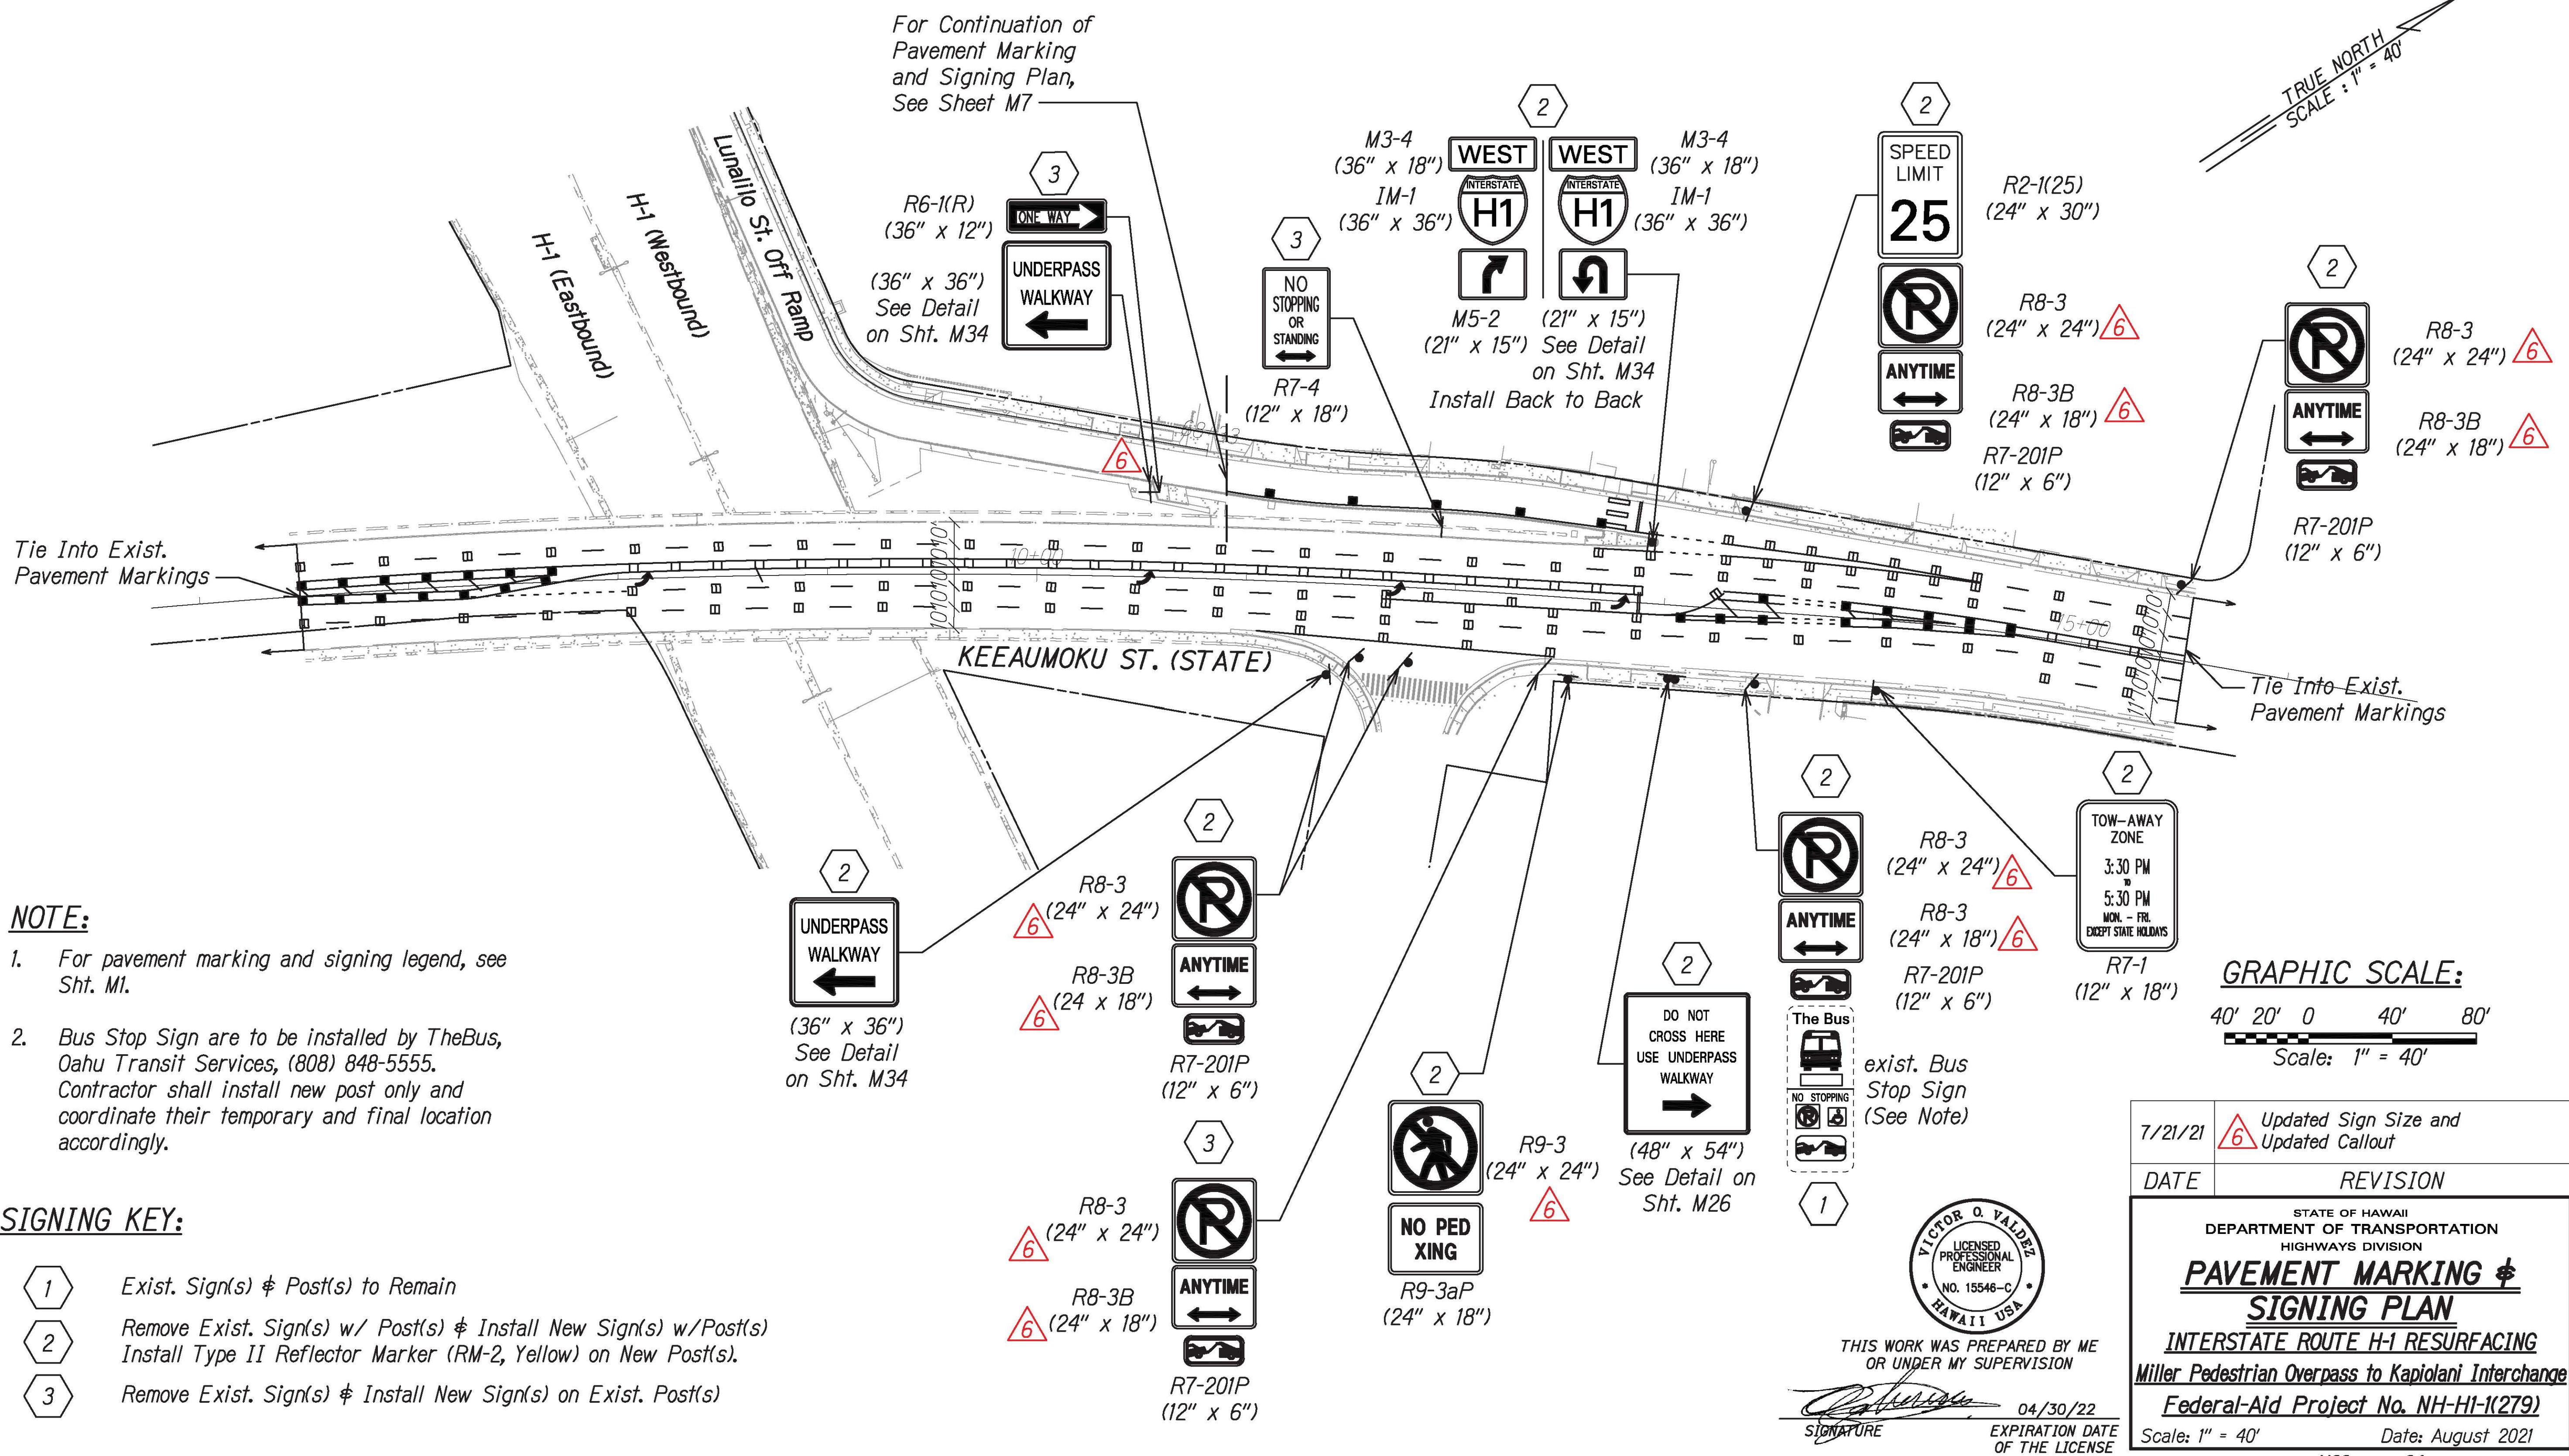

FED. ROAD DIST. NO.	STATE	FED.-AID PROJ. NO.	FISCAL YEAR	SHEET NO.	TOTAL SHEETS
HAWAII	HAW.	NH-HI-1(279)	2021	ADD. 164	304

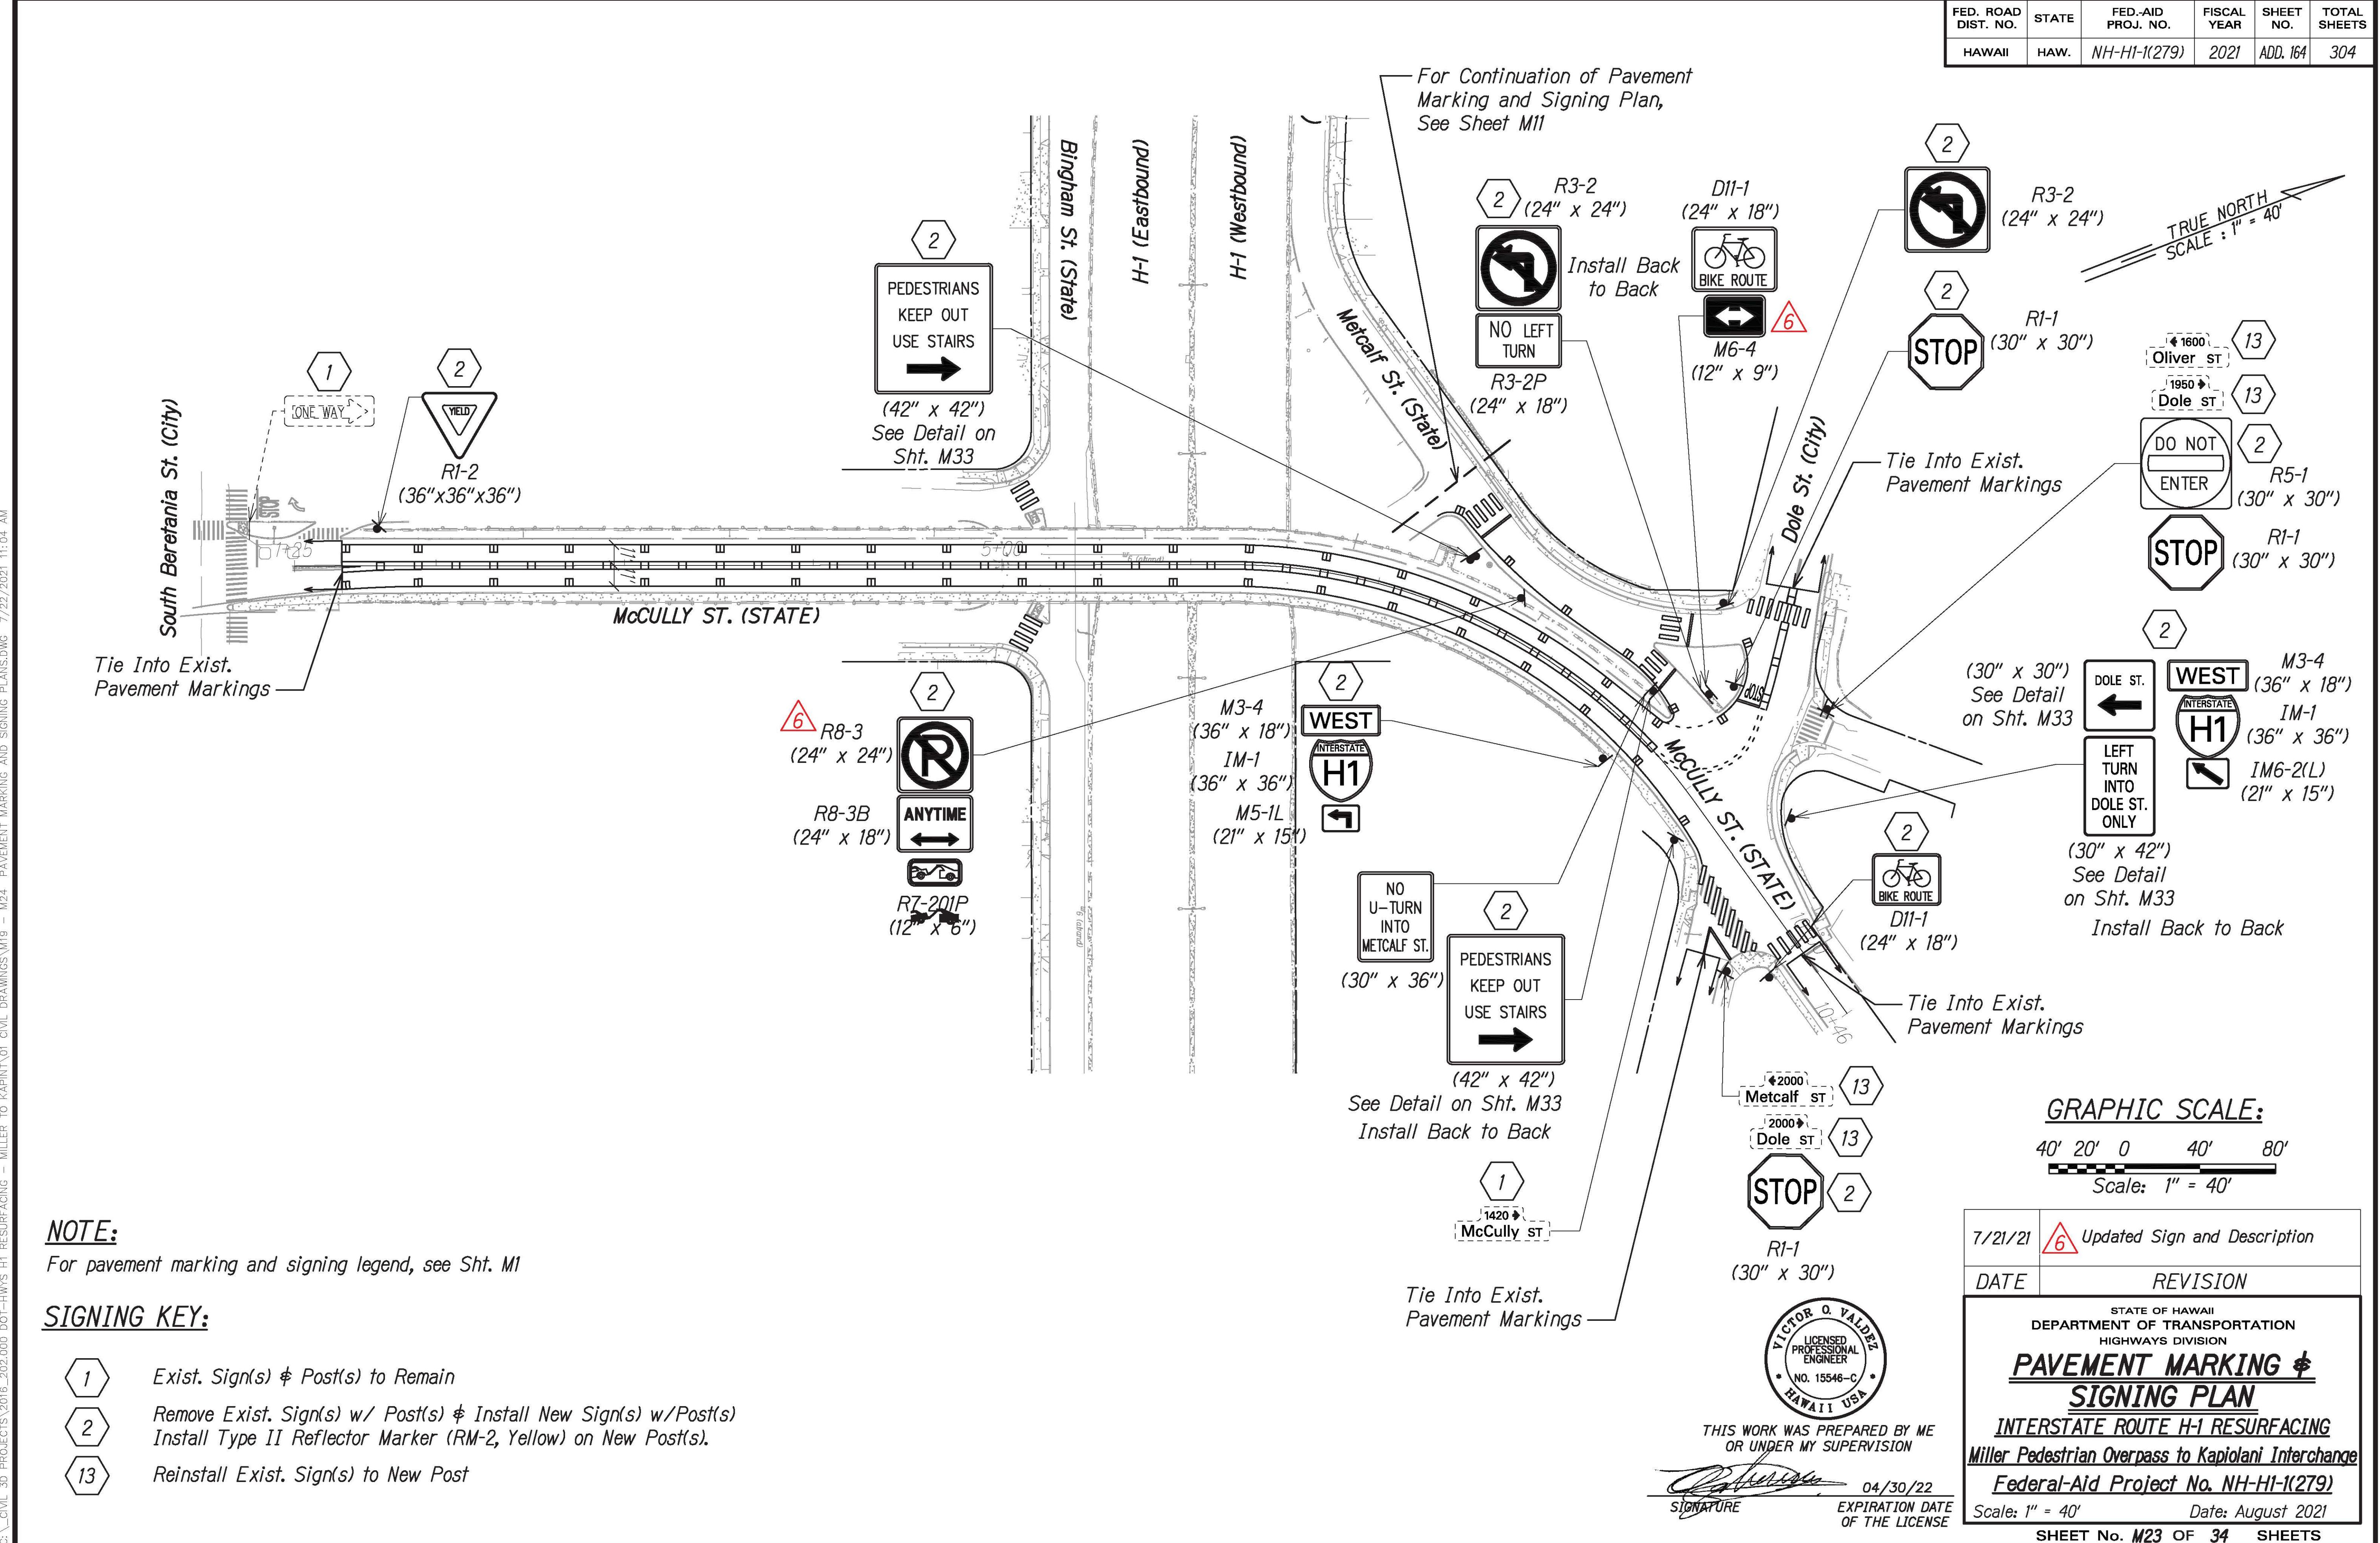


FED. ROAD DIST. NO.	STATE	FED-AID PROJ. NO.	FISCAL YEAR	HEET NO.	TOTAL SHEETS
HAWAII	HAW.	NH-HI-1(279)	2021	ADD. 165	304

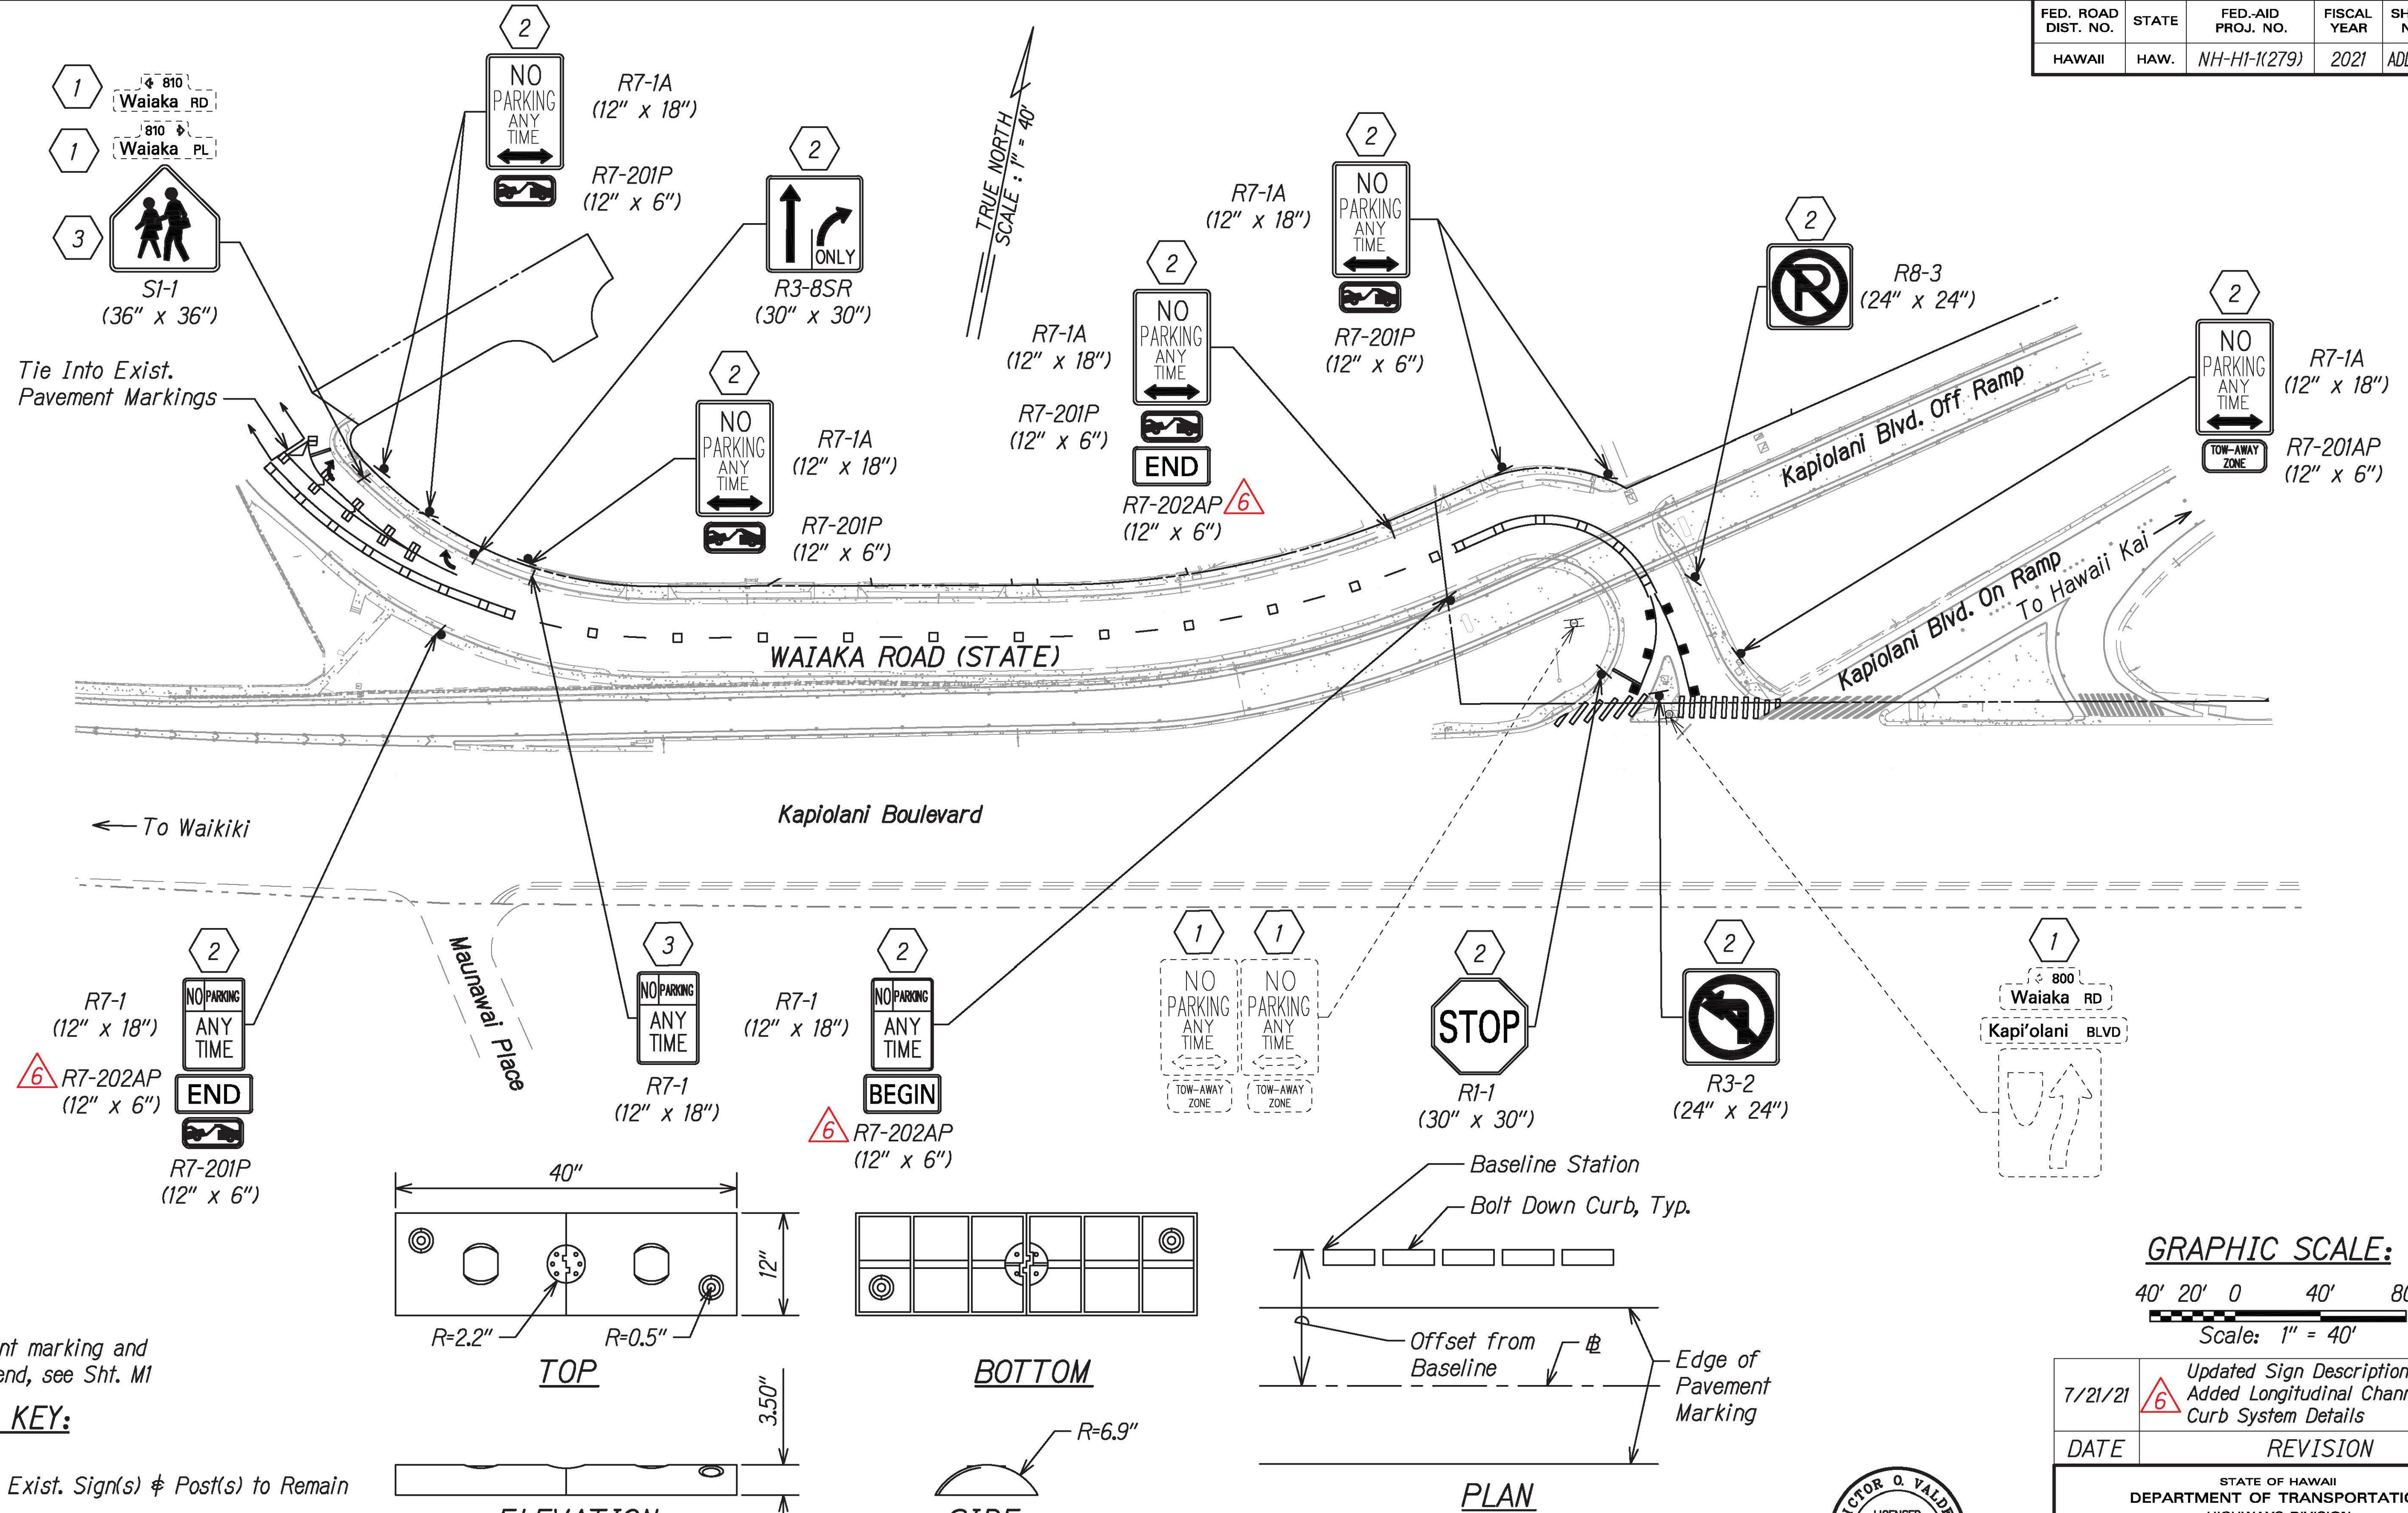

### LONGITUDINAL CHANNELIZING CURB SYSTEM

NOT TO SCALE

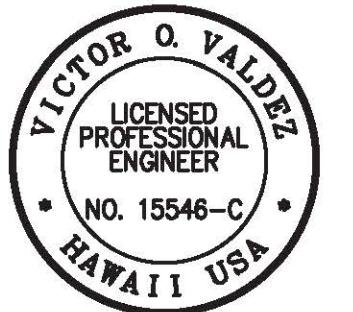




THIS WORK WAS PREPARED BY ME  
OR UNDER MY SUPERVISION

*[Signature]* 04/30/22  
SIGNATURE EXPIRATION DATE OF THE LICENSE

DATE	REVISION
7/21/21	Updated Sign Description and Added Longitudinal Channelizing Curb System Details
STATE OF HAWAII DEPARTMENT OF TRANSPORTATION HIGHWAYS DIVISION	
<b>PAVEMENT MARKING &amp; SIGNING PLAN</b>	
INTERSTATE ROUTE H-1 RESURFACING	
Miller Pedestrian Overpass to Kapiolani Interchange	
Federal-Aid Project No. NH-HI-1(279)	
Scale: 1" = 40'	
Date: August 2021	

SHEET No. M24 OF 34 SHEETS



ADD. 165

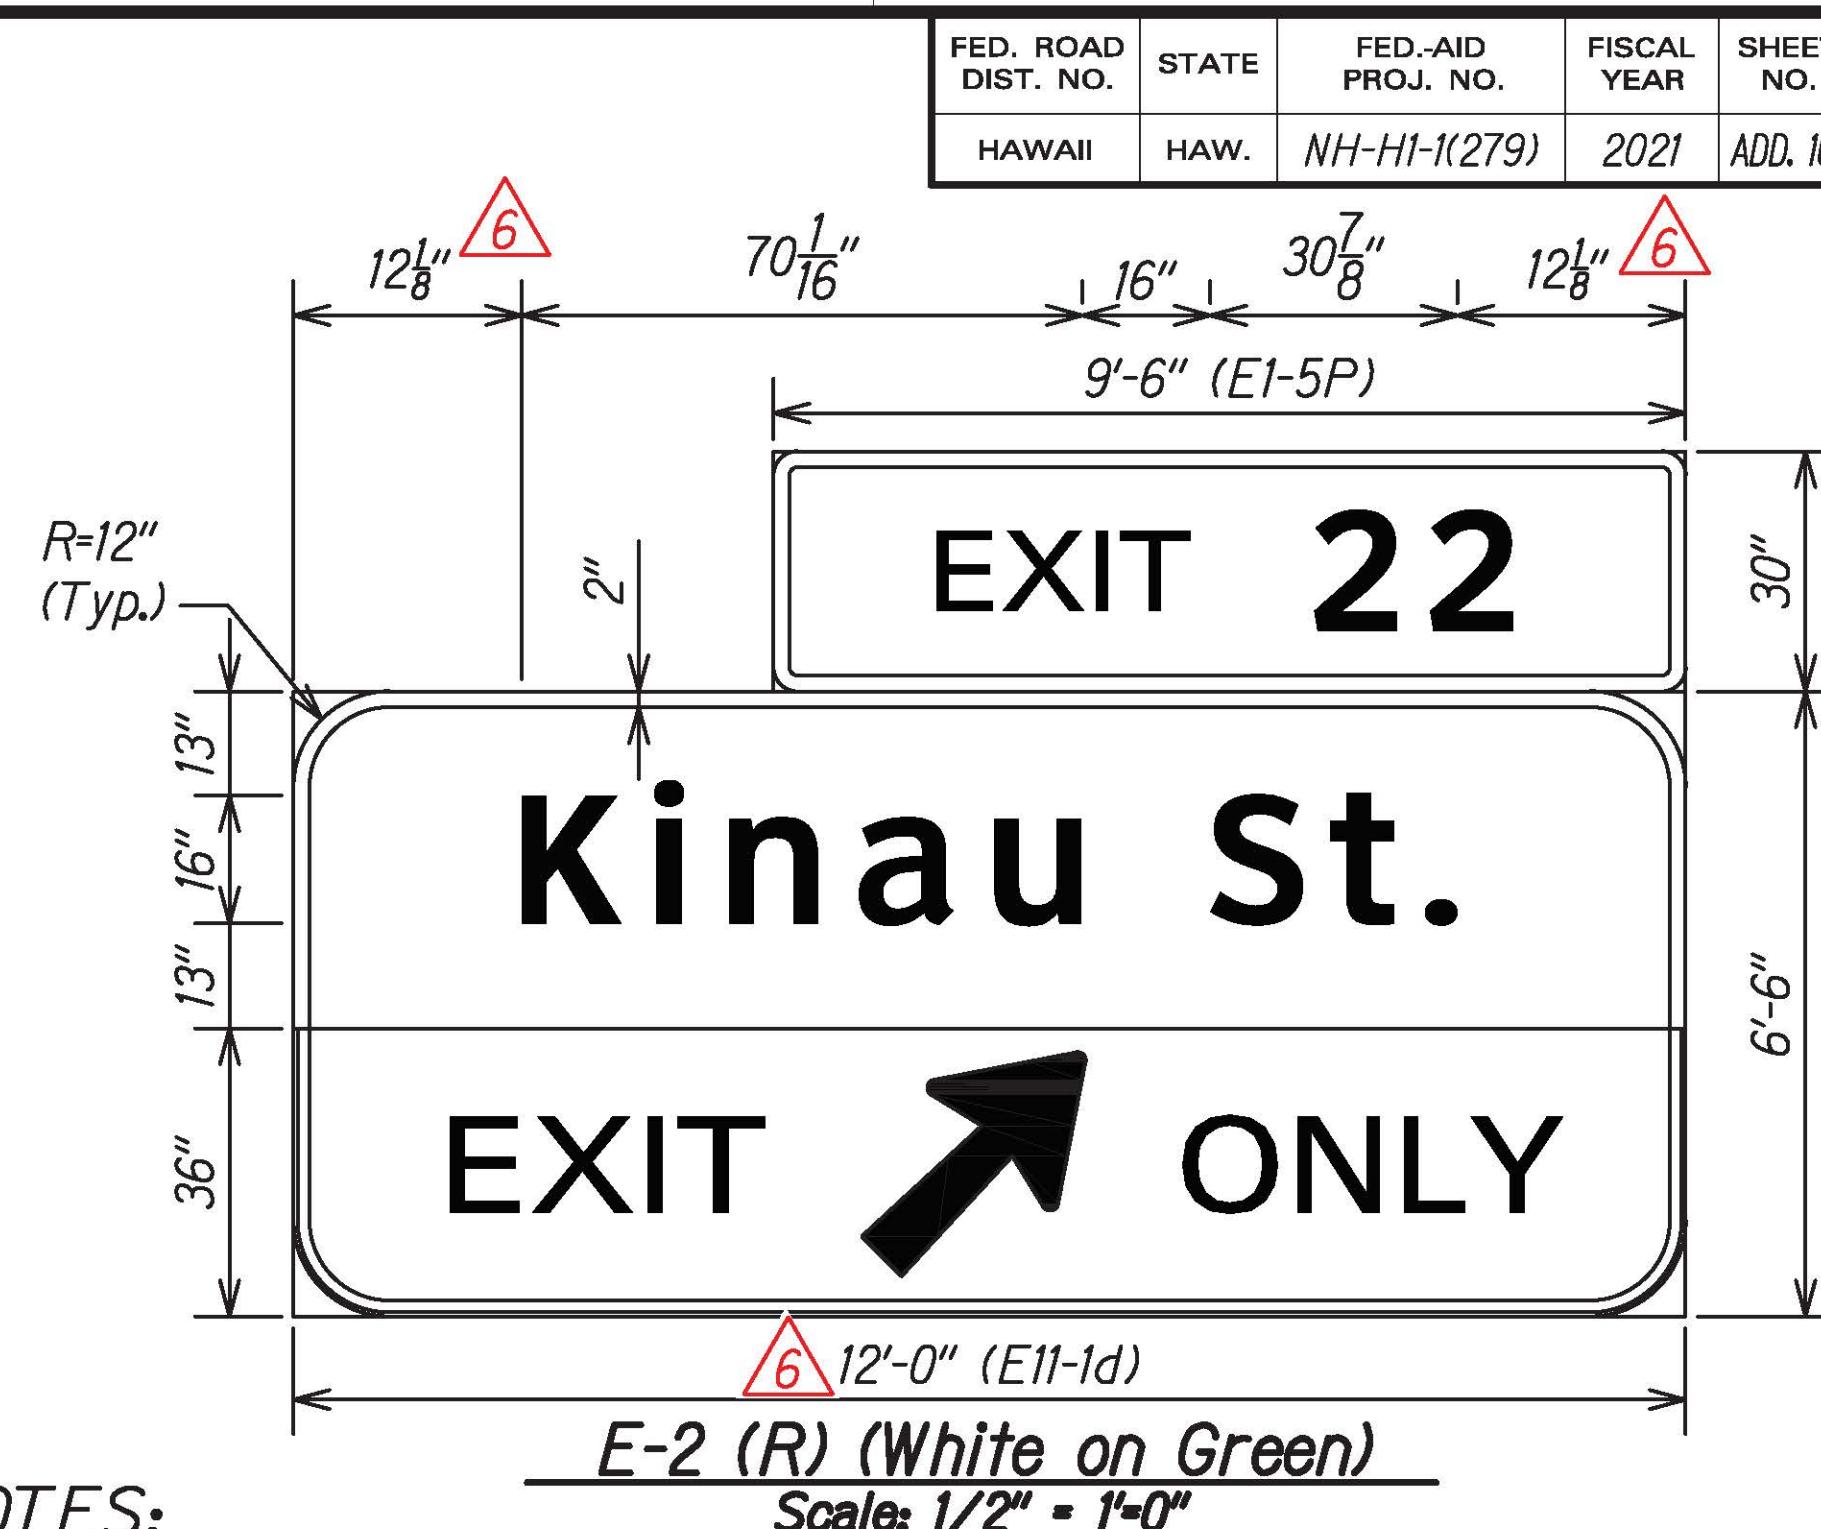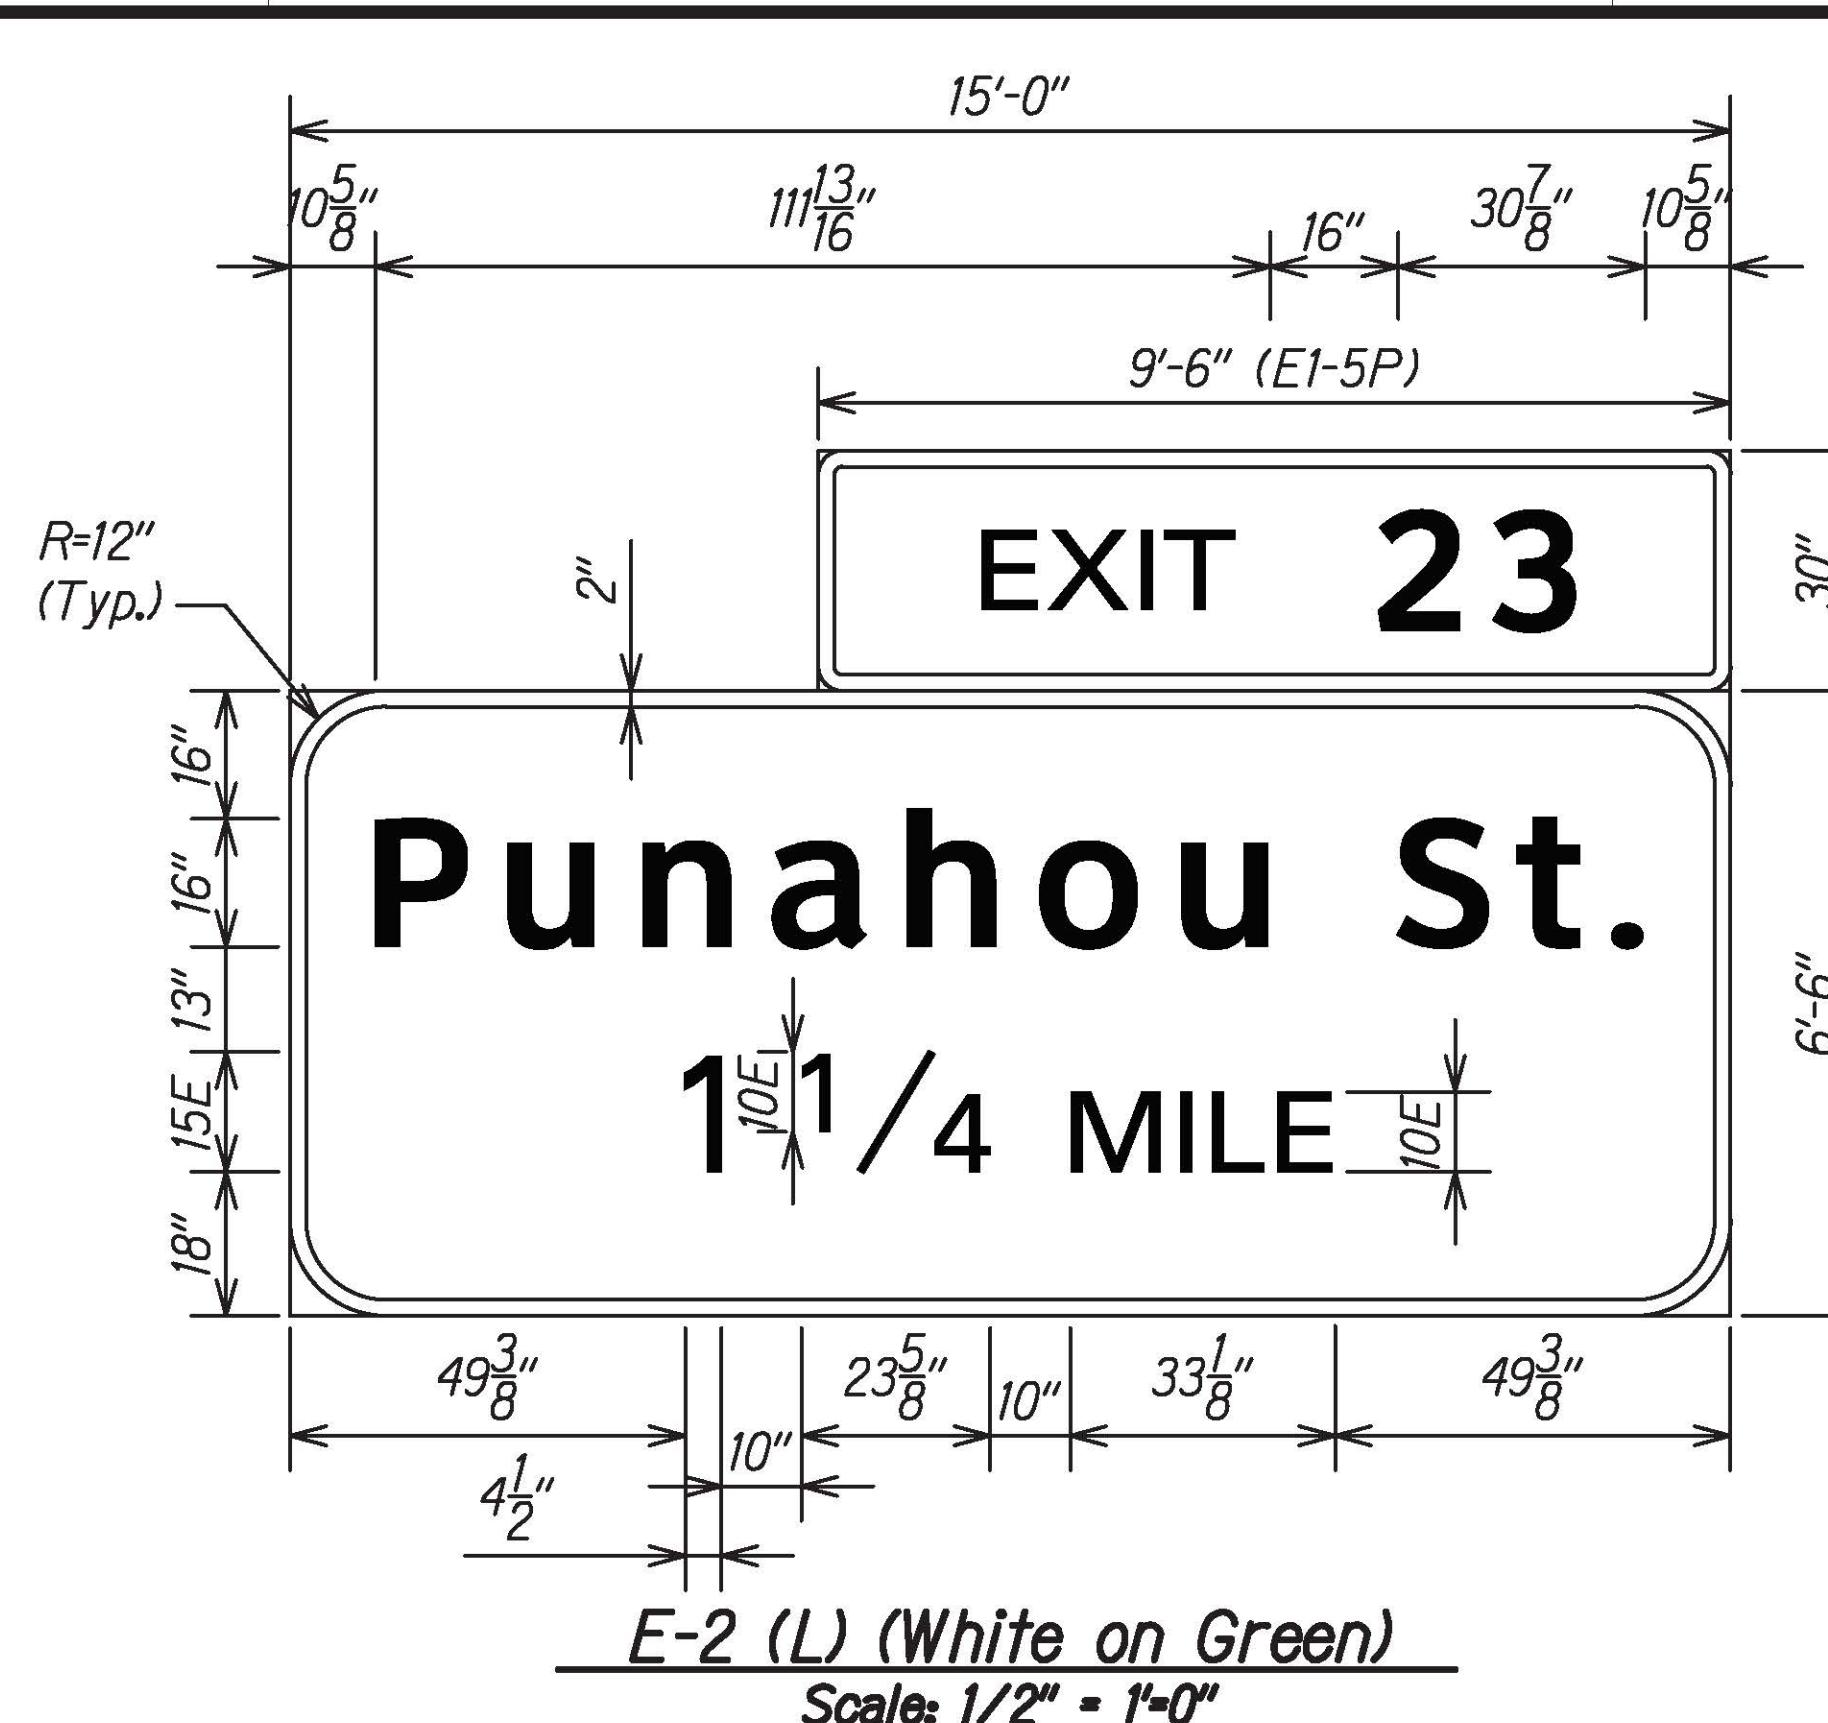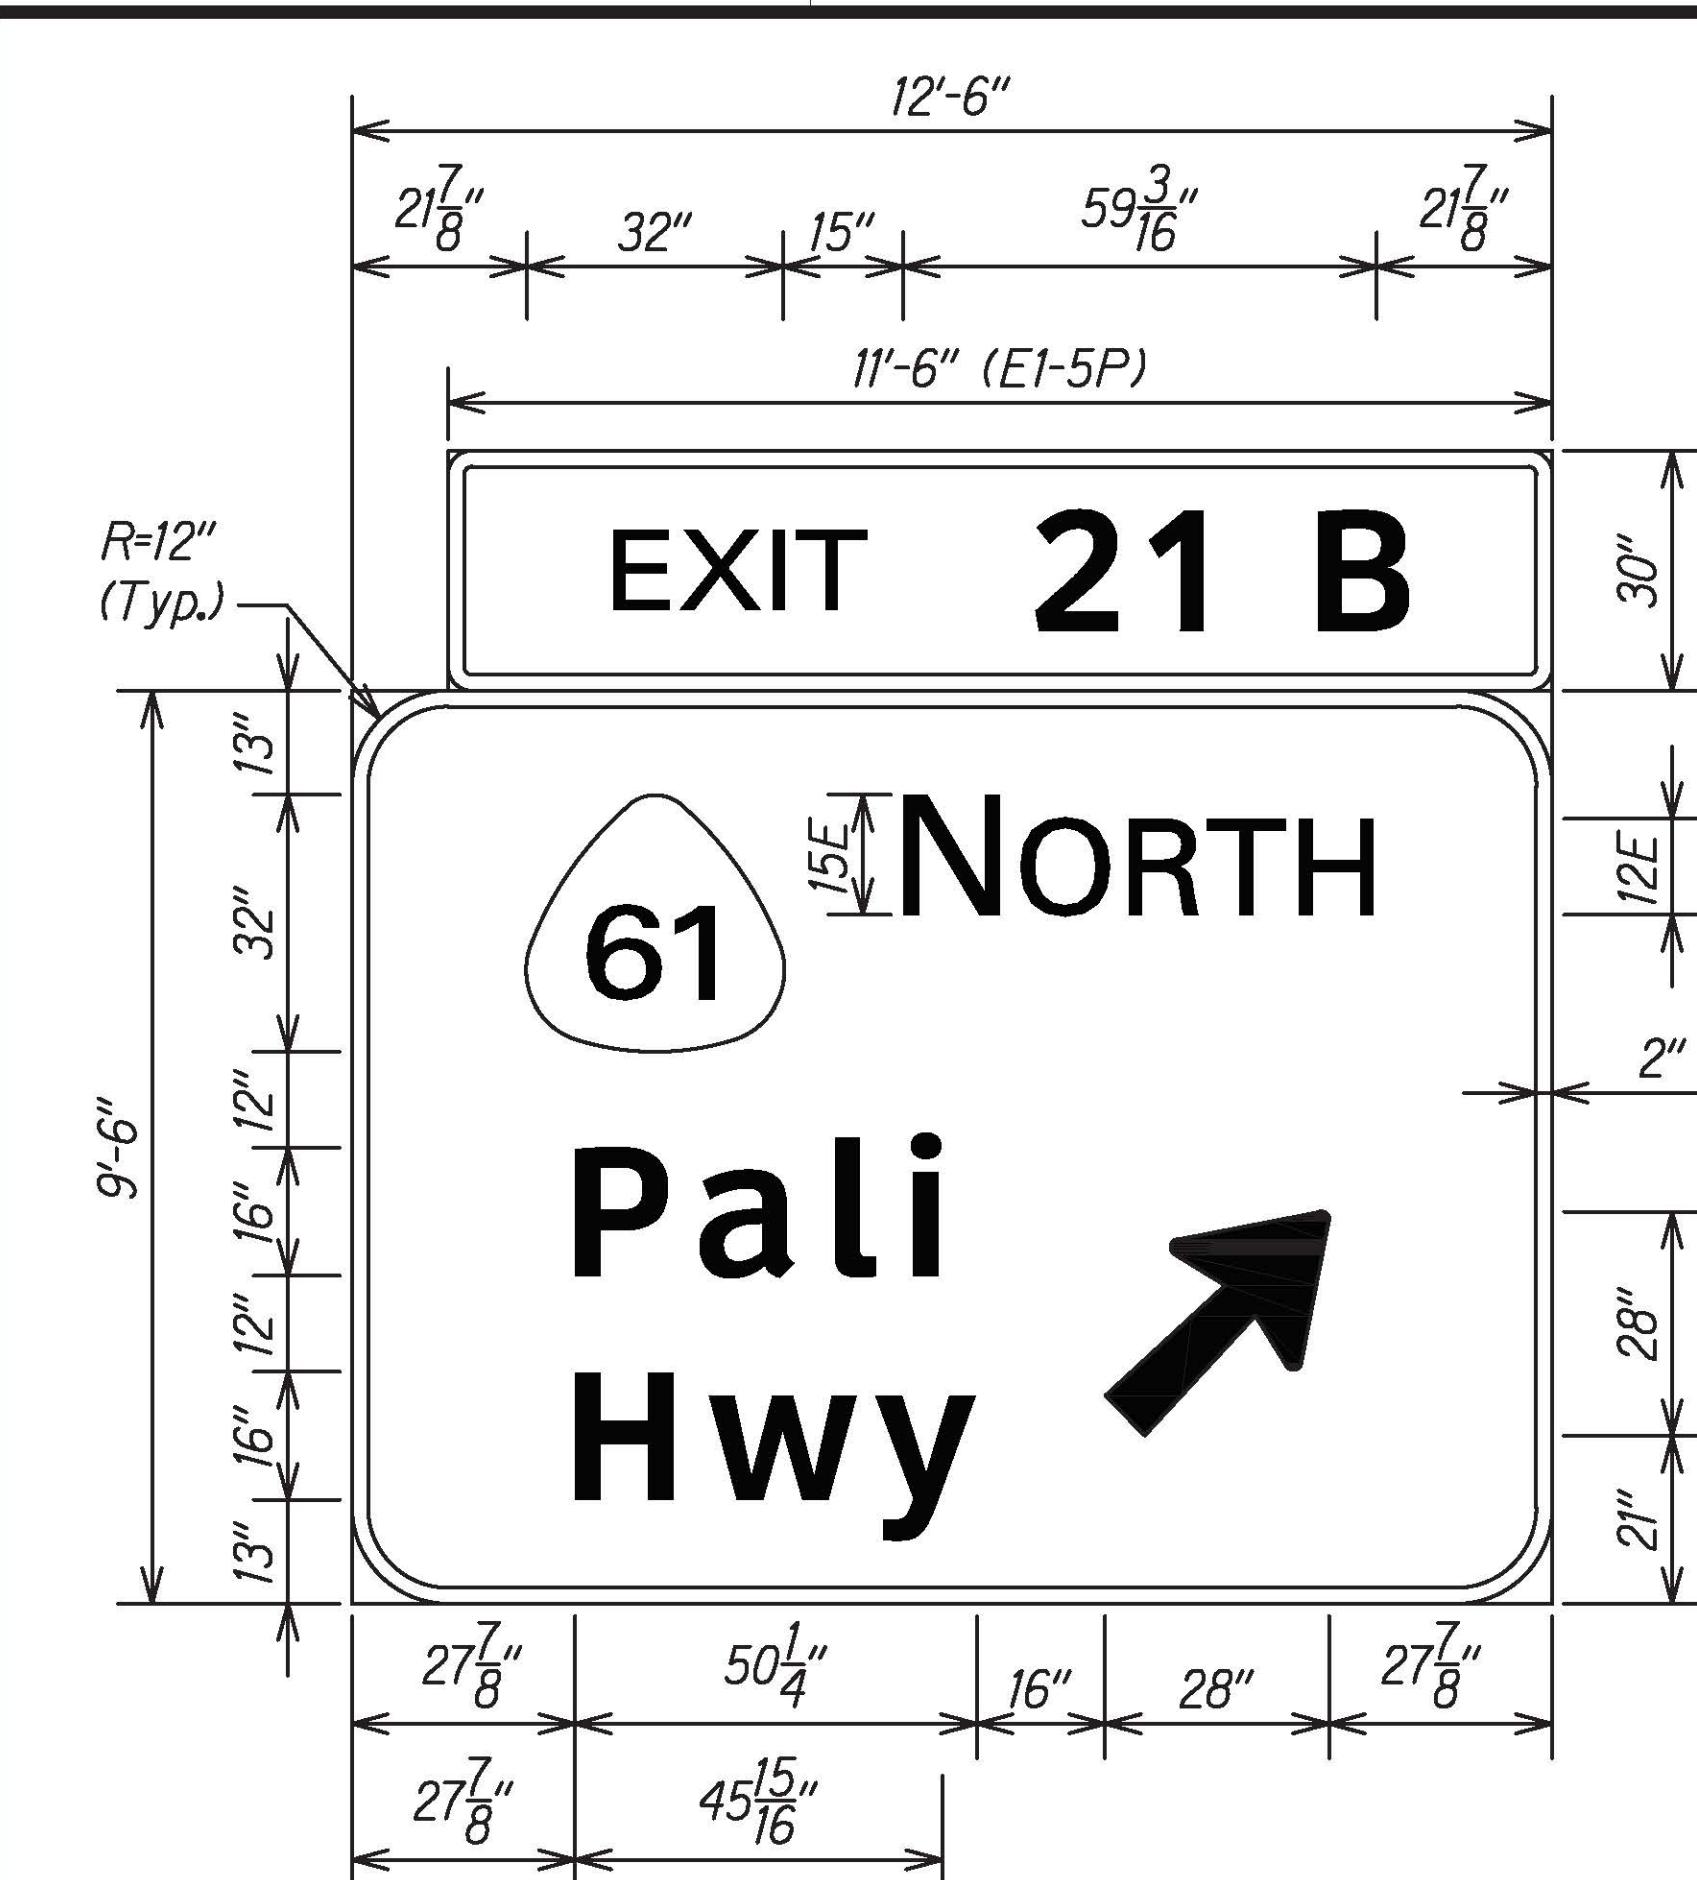**NOTES:**

- All signs conform to Section 630 - Traffic Control Guide Signs of the Standard Specifications and the latest editions amendments of the following FHWA publications:
  - "Manual on Uniform Traffic Control Devices for Streets and Highways" (MUTCD)
  - "Standard Highway Signs"
  - "Standard Alphabets for Highway Signs"
- Borders, messages, arrows symbols and shield conform to details as shown on the plans and as specified in the MUTCD.
- Sign messages shall be as indicated on the plans.
- All panels shall be retroreflectorized in accordance with subsection 750.01(A)(1) - Retroreflectorization of the Standard Specifications.
- Contractor shall submit all sign splicing details to the Engineer for acceptance.

**EXPRESSWAY (E) AND DESTINATION (D) SIGN NOTES:**

- The Contractor shall verify the locations and dimensions of existing Sign Panels and supports.
- New sign panels shall be laminated aluminum or extruded aluminum.
- Letter size:
  - When letters are all uppercase, use series "E".
  - When initial uppercase letter is used in conjunction with lowercase letters, use Clearview 5-W.
- Incidental parts and services not shown on the plans or specified but deemed necessary for the sign installation, shall be furnished and installed by the Contractor as part of the work contracted.
- Removal and disposal of existing sign panels, posts with foundation, luminaries and supports will not be paid for separately, but shall be considered incidental to the various signing items.

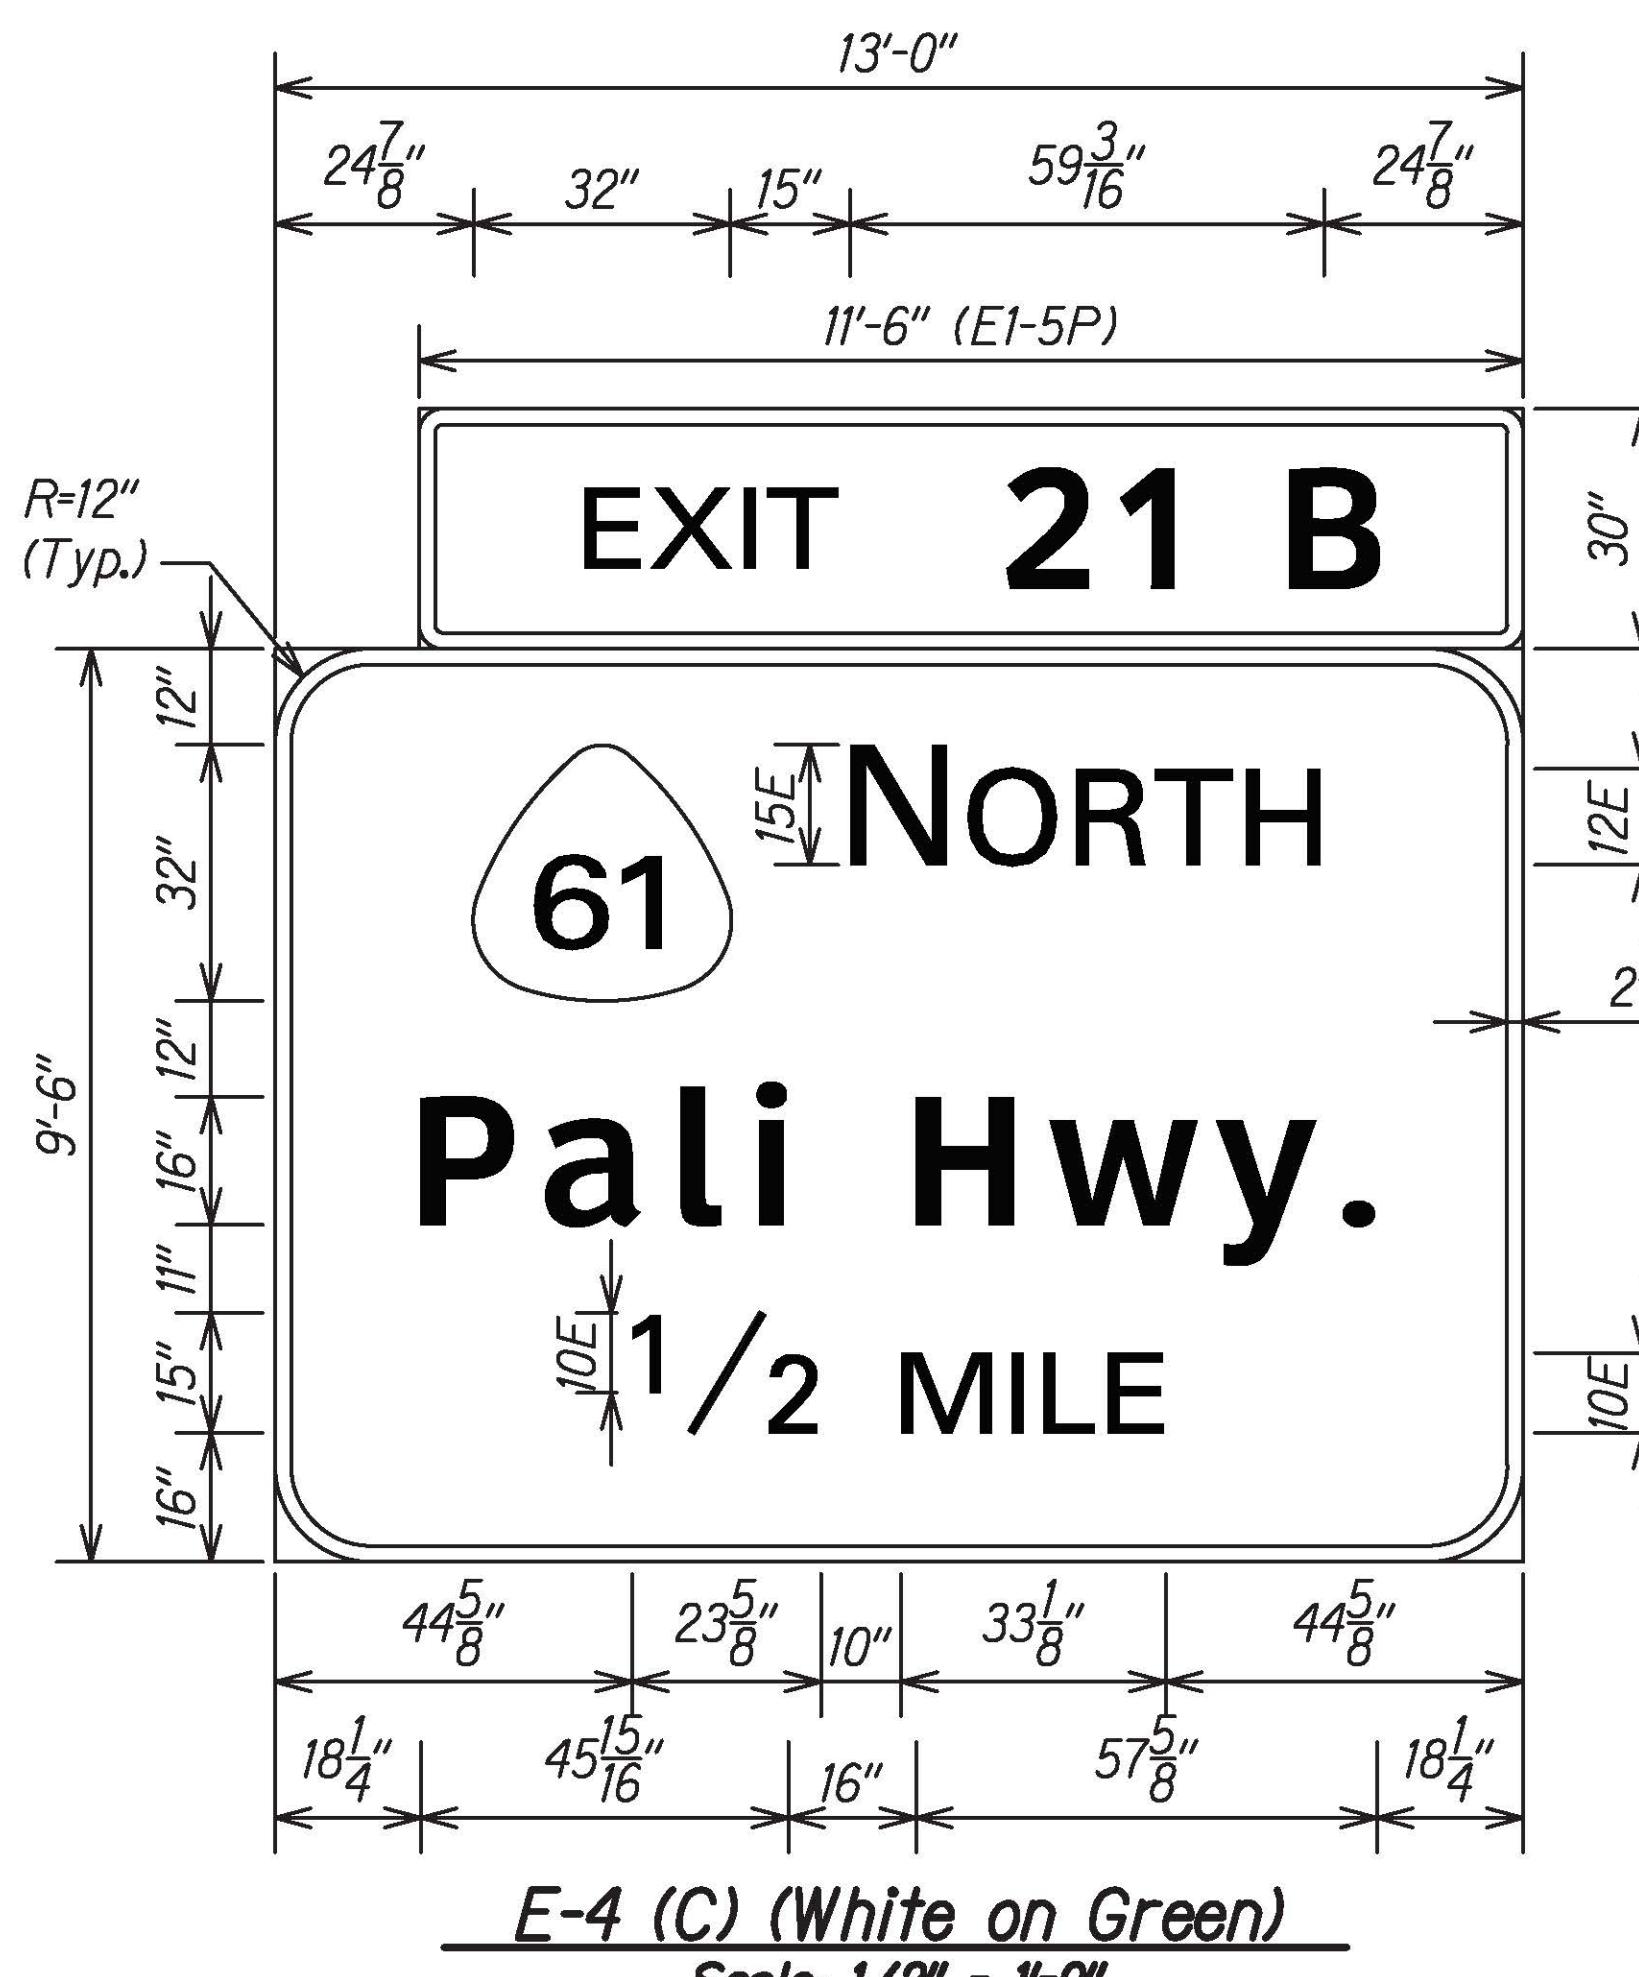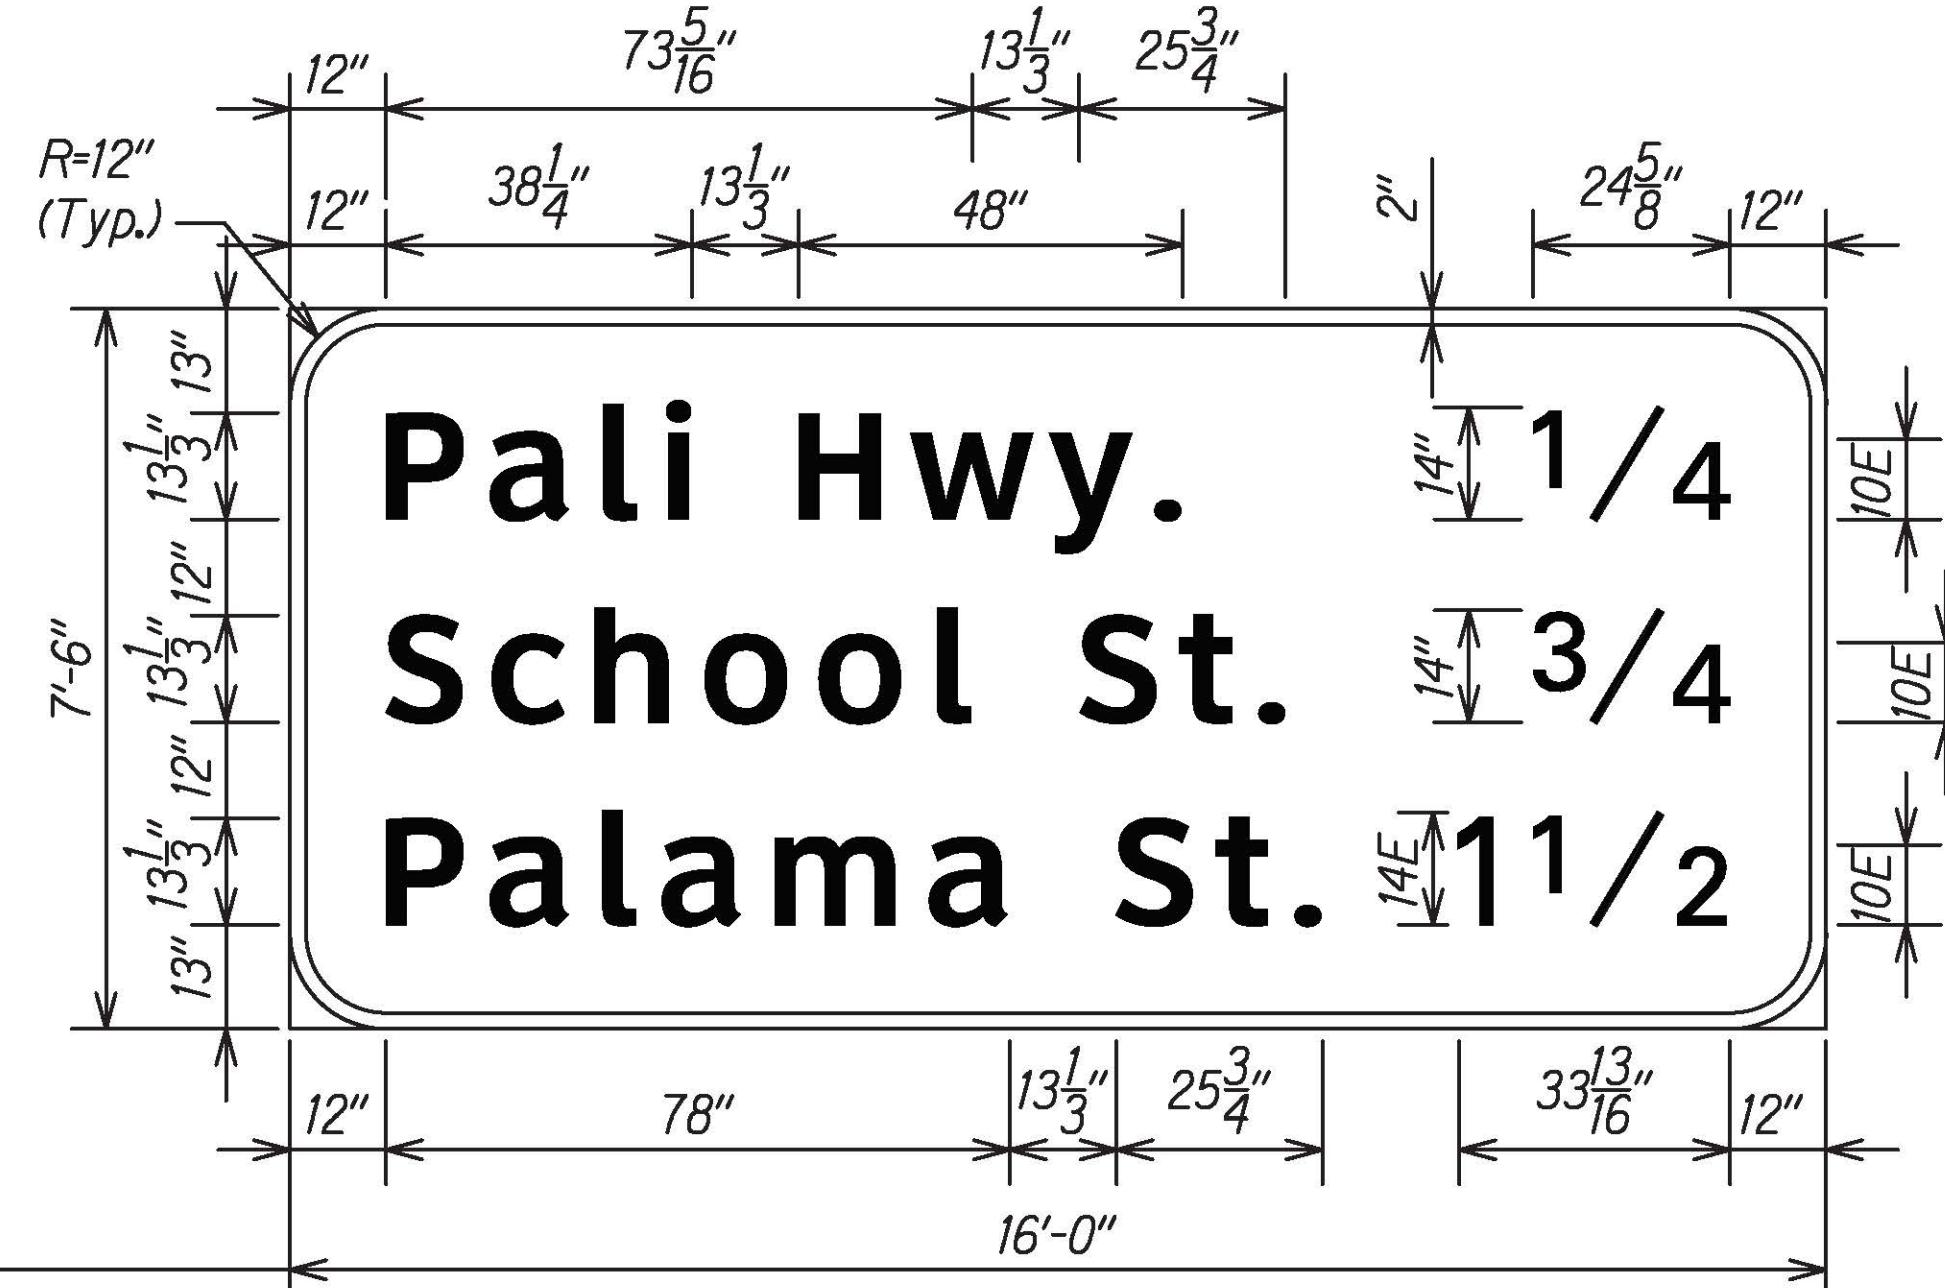THIS WORK WAS PREPARED BY ME  
OR UNDER MY SUPERVISIONSIGNATURE 04/30/22 EXPIRATION DATE  
OF THE LICENSE

FED. ROAD DIST. NO.	STATE	FED.-AID PROJ. NO.	FISCAL YEAR	HEET NO.	TOTAL SHEETS
HAWAII	HAW.	NH-HI-1(279)	2021	ADD. 166	304

DATE	REVISION
STATE OF HAWAII DEPARTMENT OF TRANSPORTATION HIGHWAYS DIVISION	
<b>SIGNAGE DETAILS</b>	
INTERSTATE ROUTE H-1 RESURFACING Miller Pedestrian Overpass to Kapiolani Interchange	
Federal-Aid Project No. NH-HI-1(279)	
Scale: 1/2" = 1'-0"	
Date: August 2021	