
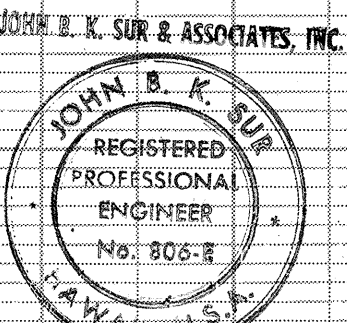
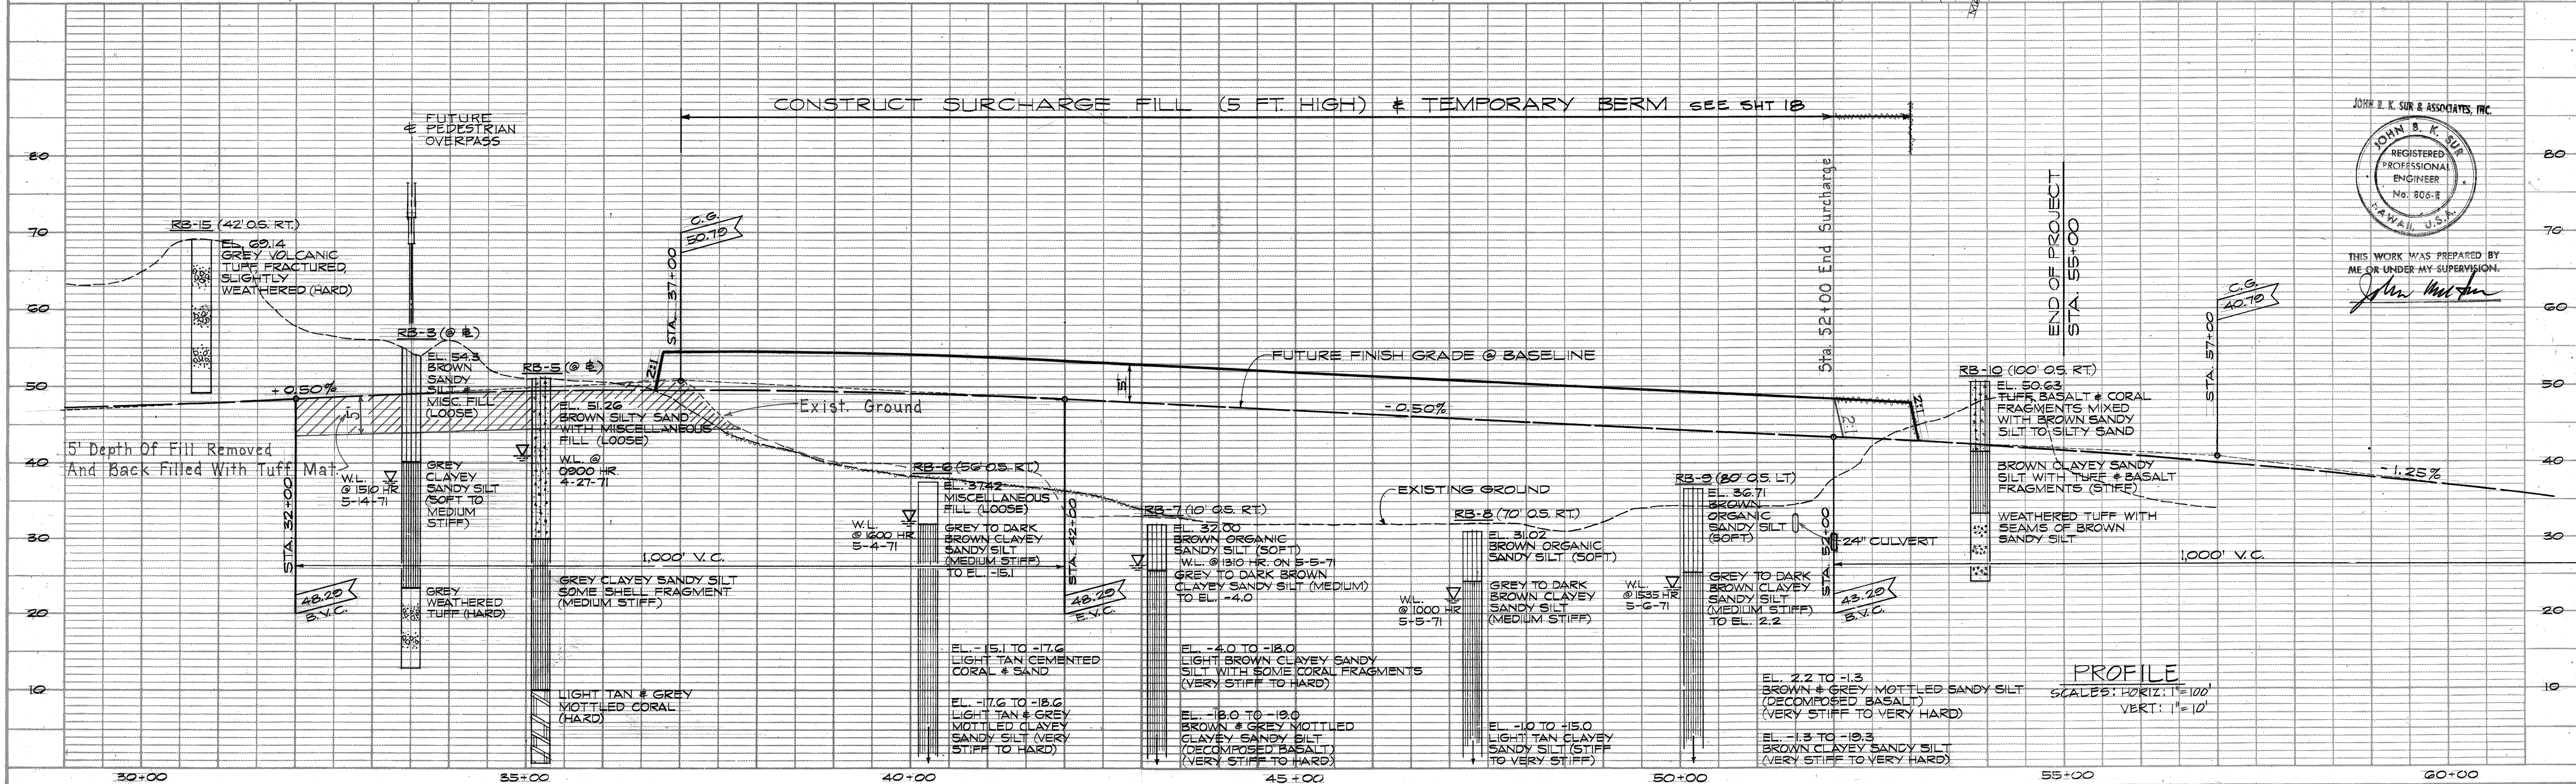


FED. ROAD DIST. NO.	STATE	FED. AID PROJ. NO.	FISCAL YEAR	SHEET NO.	TOTAL SHEETS
HAWAII	HAW.	1-H1-1 (103):14	1972	4	46

DATE	BY	NO.

DATE	BY	NO.

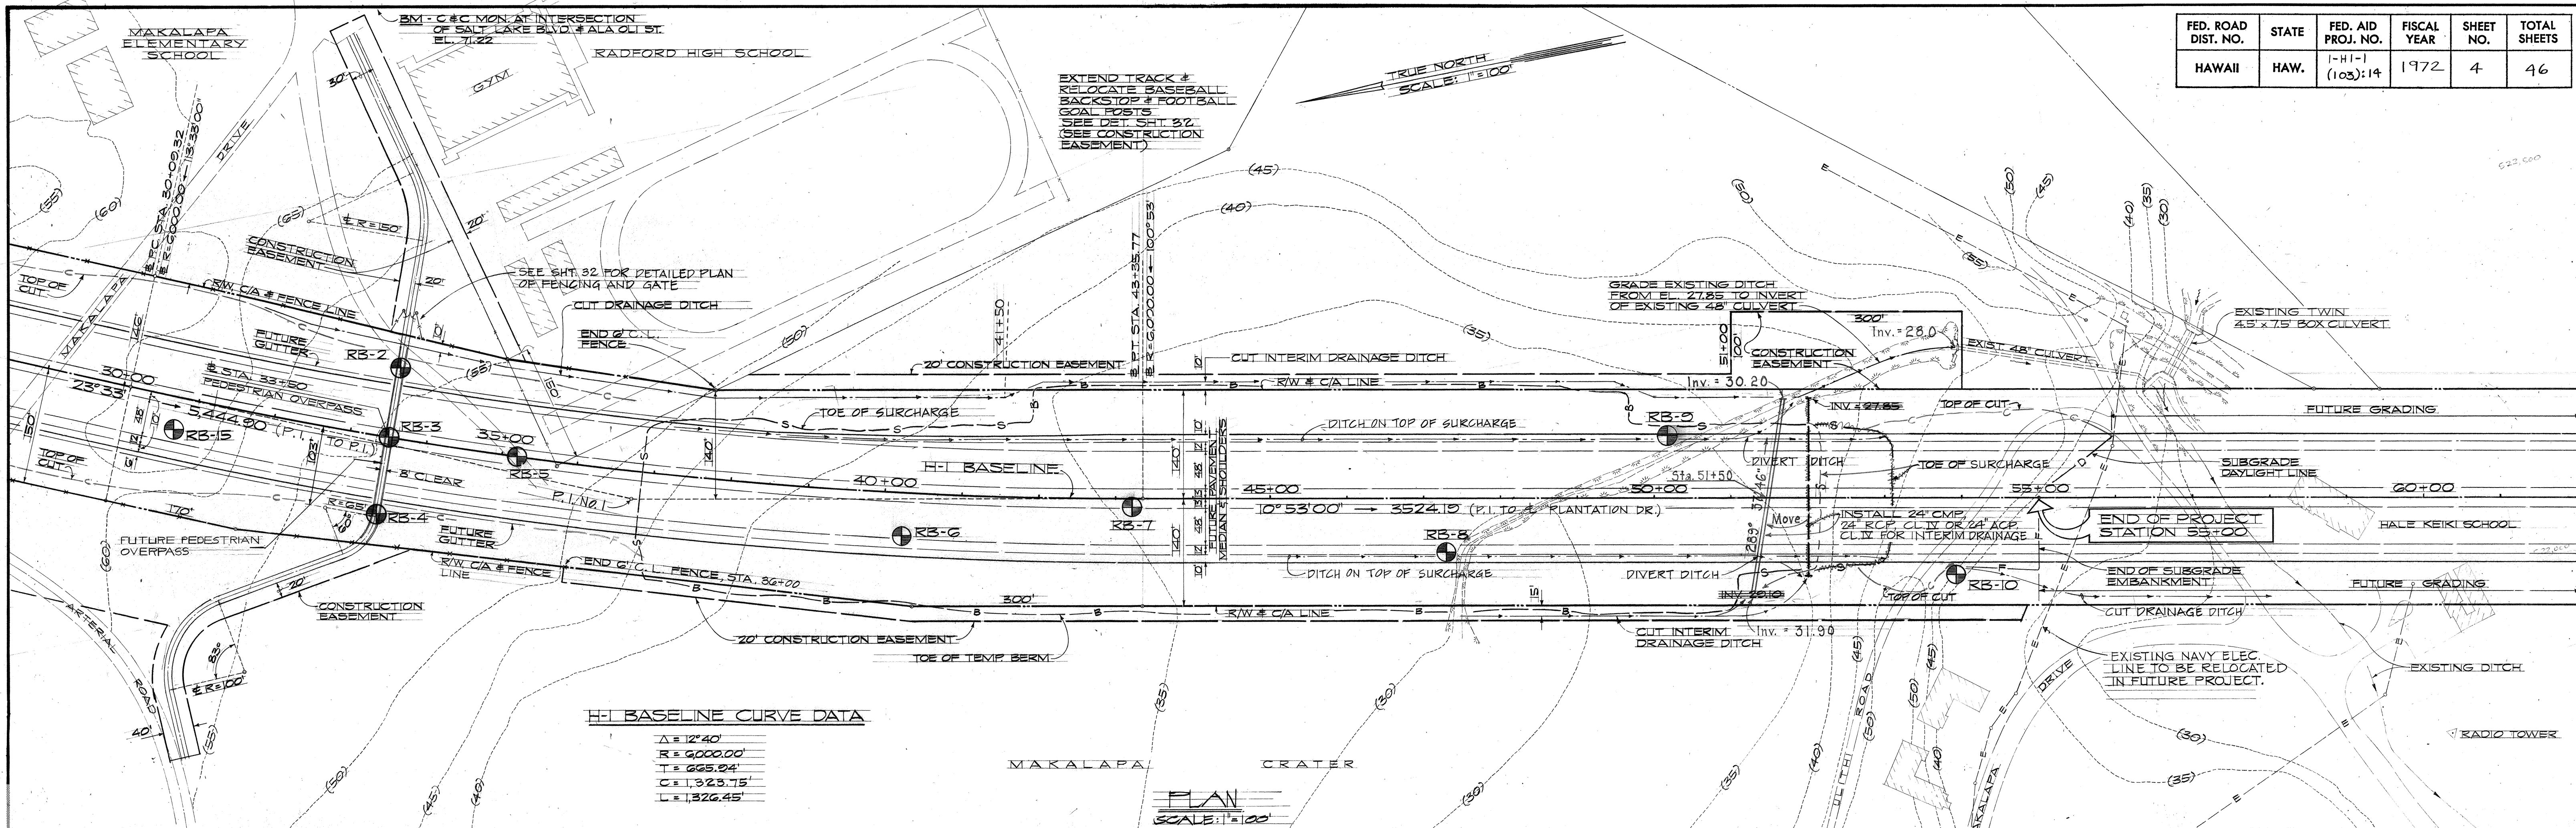

THIS WORK WAS PREPARED BY ME OR UNDER MY SUPERVISION.

John B. K. Sun