	INDEX TO DRAWINGS
SHEET NO.	DESCRIPTION
	TITLE SHEET
2	STANDARD PLANS SUMMARY
3 – 5	GENERAL NOTES AND LEGEND
6 - 8	WATER POLLUTION & EROSION CONTROL NOTES
9	SEDIMENT & EROSION CONTROL DETAILS
10 - 17	SEDIMENT & EROSION CONTROL PLANS
18 – 21	TYPICAL SECTIONS & DETAILS
22 – 28	GUARDRAIL DETAILS & NOTES
29 – 30	TEMPORARY BARRIER PLANS
31 – 39	ROADWAY PLANS
40 – 41	PAVEMENT GRADE PLANS
42 _ 46	RADAR TRAFFIC COUNTING SYSTEM PLANS
47 – 65	SIGNING & PAVEMENT MARKING PLANS

STATE OF HAWAII

## DEPARTMENT OF TRANSPORTATION

HIGHWAYS DIVISION HONOLULU, HAWAII


## PLANS FOR

## INTERSTATE ROUTE H-1 REHABILITATION

SALT LAKE BOULEVARD TO AIRPORT VIADUCT FEDERAL-AID PROJECT NO. NH-H1-1(275)

DISTRICTS OF EWA & HONOLULU

ISLAND OF OAHU

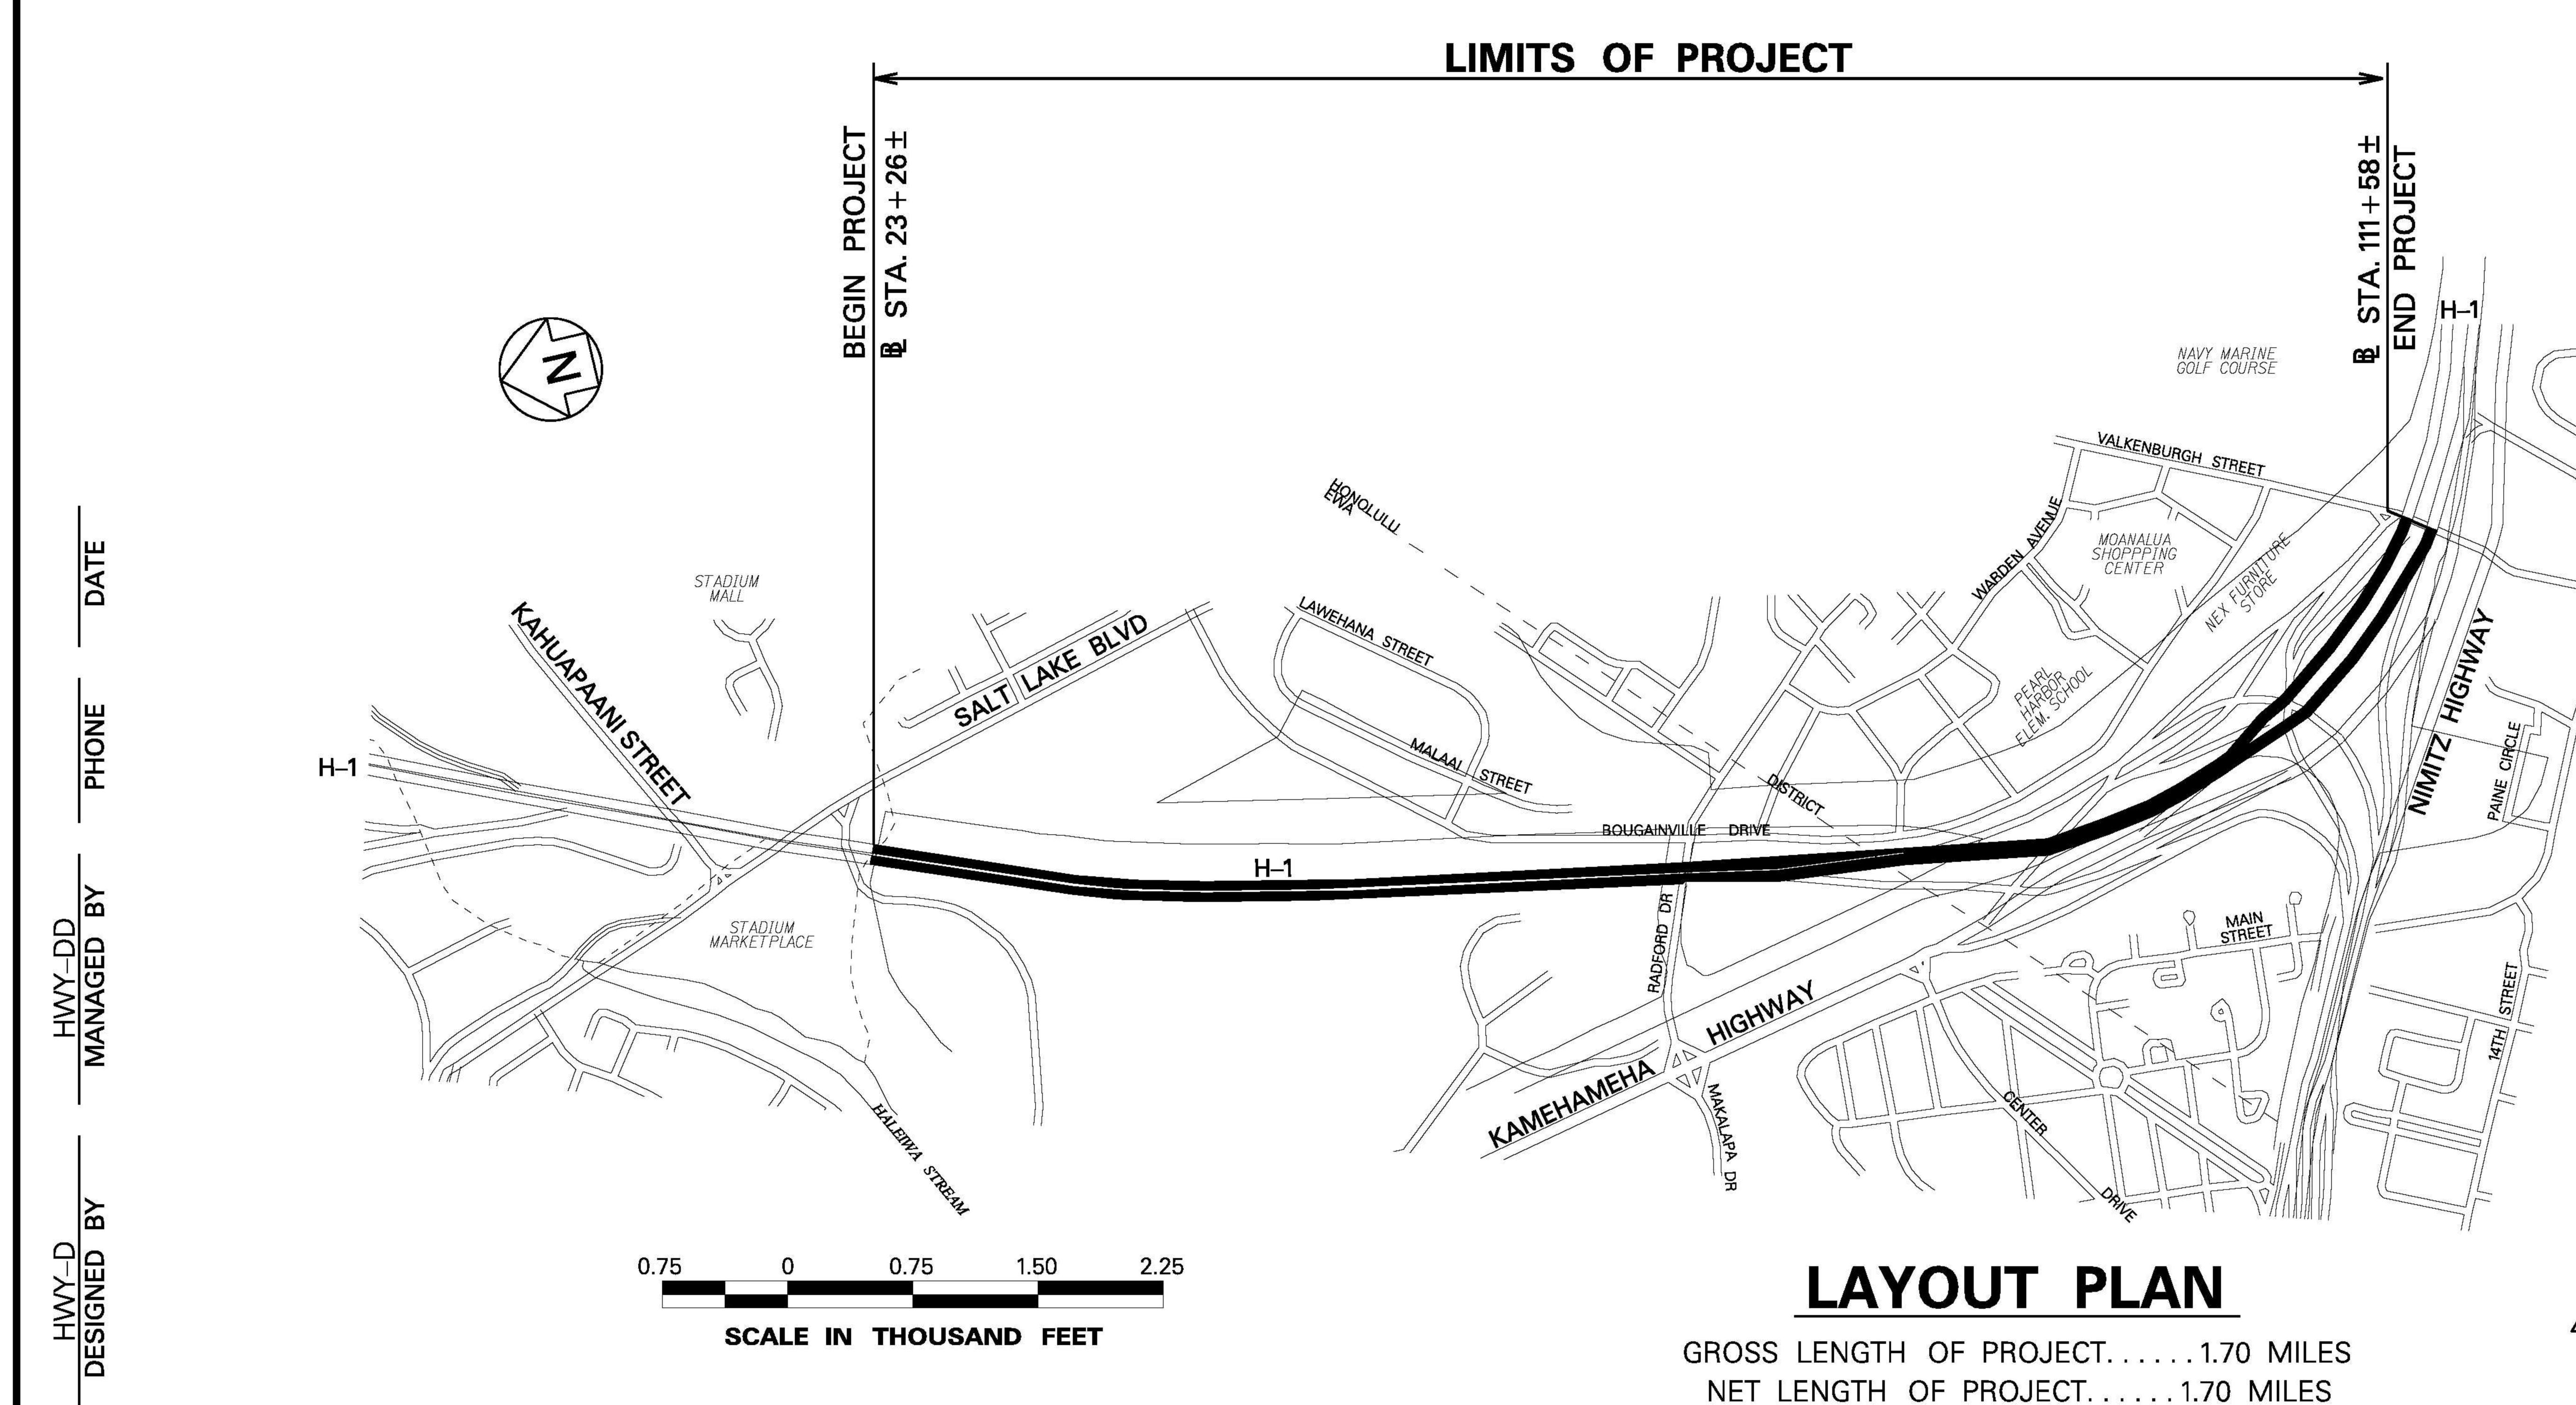

Walanae

Wal

CONSTRUCTED OR UNDER CONSTRUCTION

MILE POST 14.05 TO MILE POST 15.75

1 1/21/22 Removed all Radar Traffic Counting System Plans from the scope of work.

REVISION

DEPARTMENT OF TRANSPORTATION STATE OF HAWAII

APPROVED:
Oct 21, 2021

DIR. OF TRANSPORTATION DATE

HAW. NH\_H1\_1(275) 2021 ADD. 1