


FED. ROAD DIST. NO.	STATE	FED. AID PROJ. NO.	FISCAL YEAR	SHEET NO.	TOTAL SHEETS
HAWAII	HAW.	I-HI-1(60)-23	1978	C.O.1205-1	18

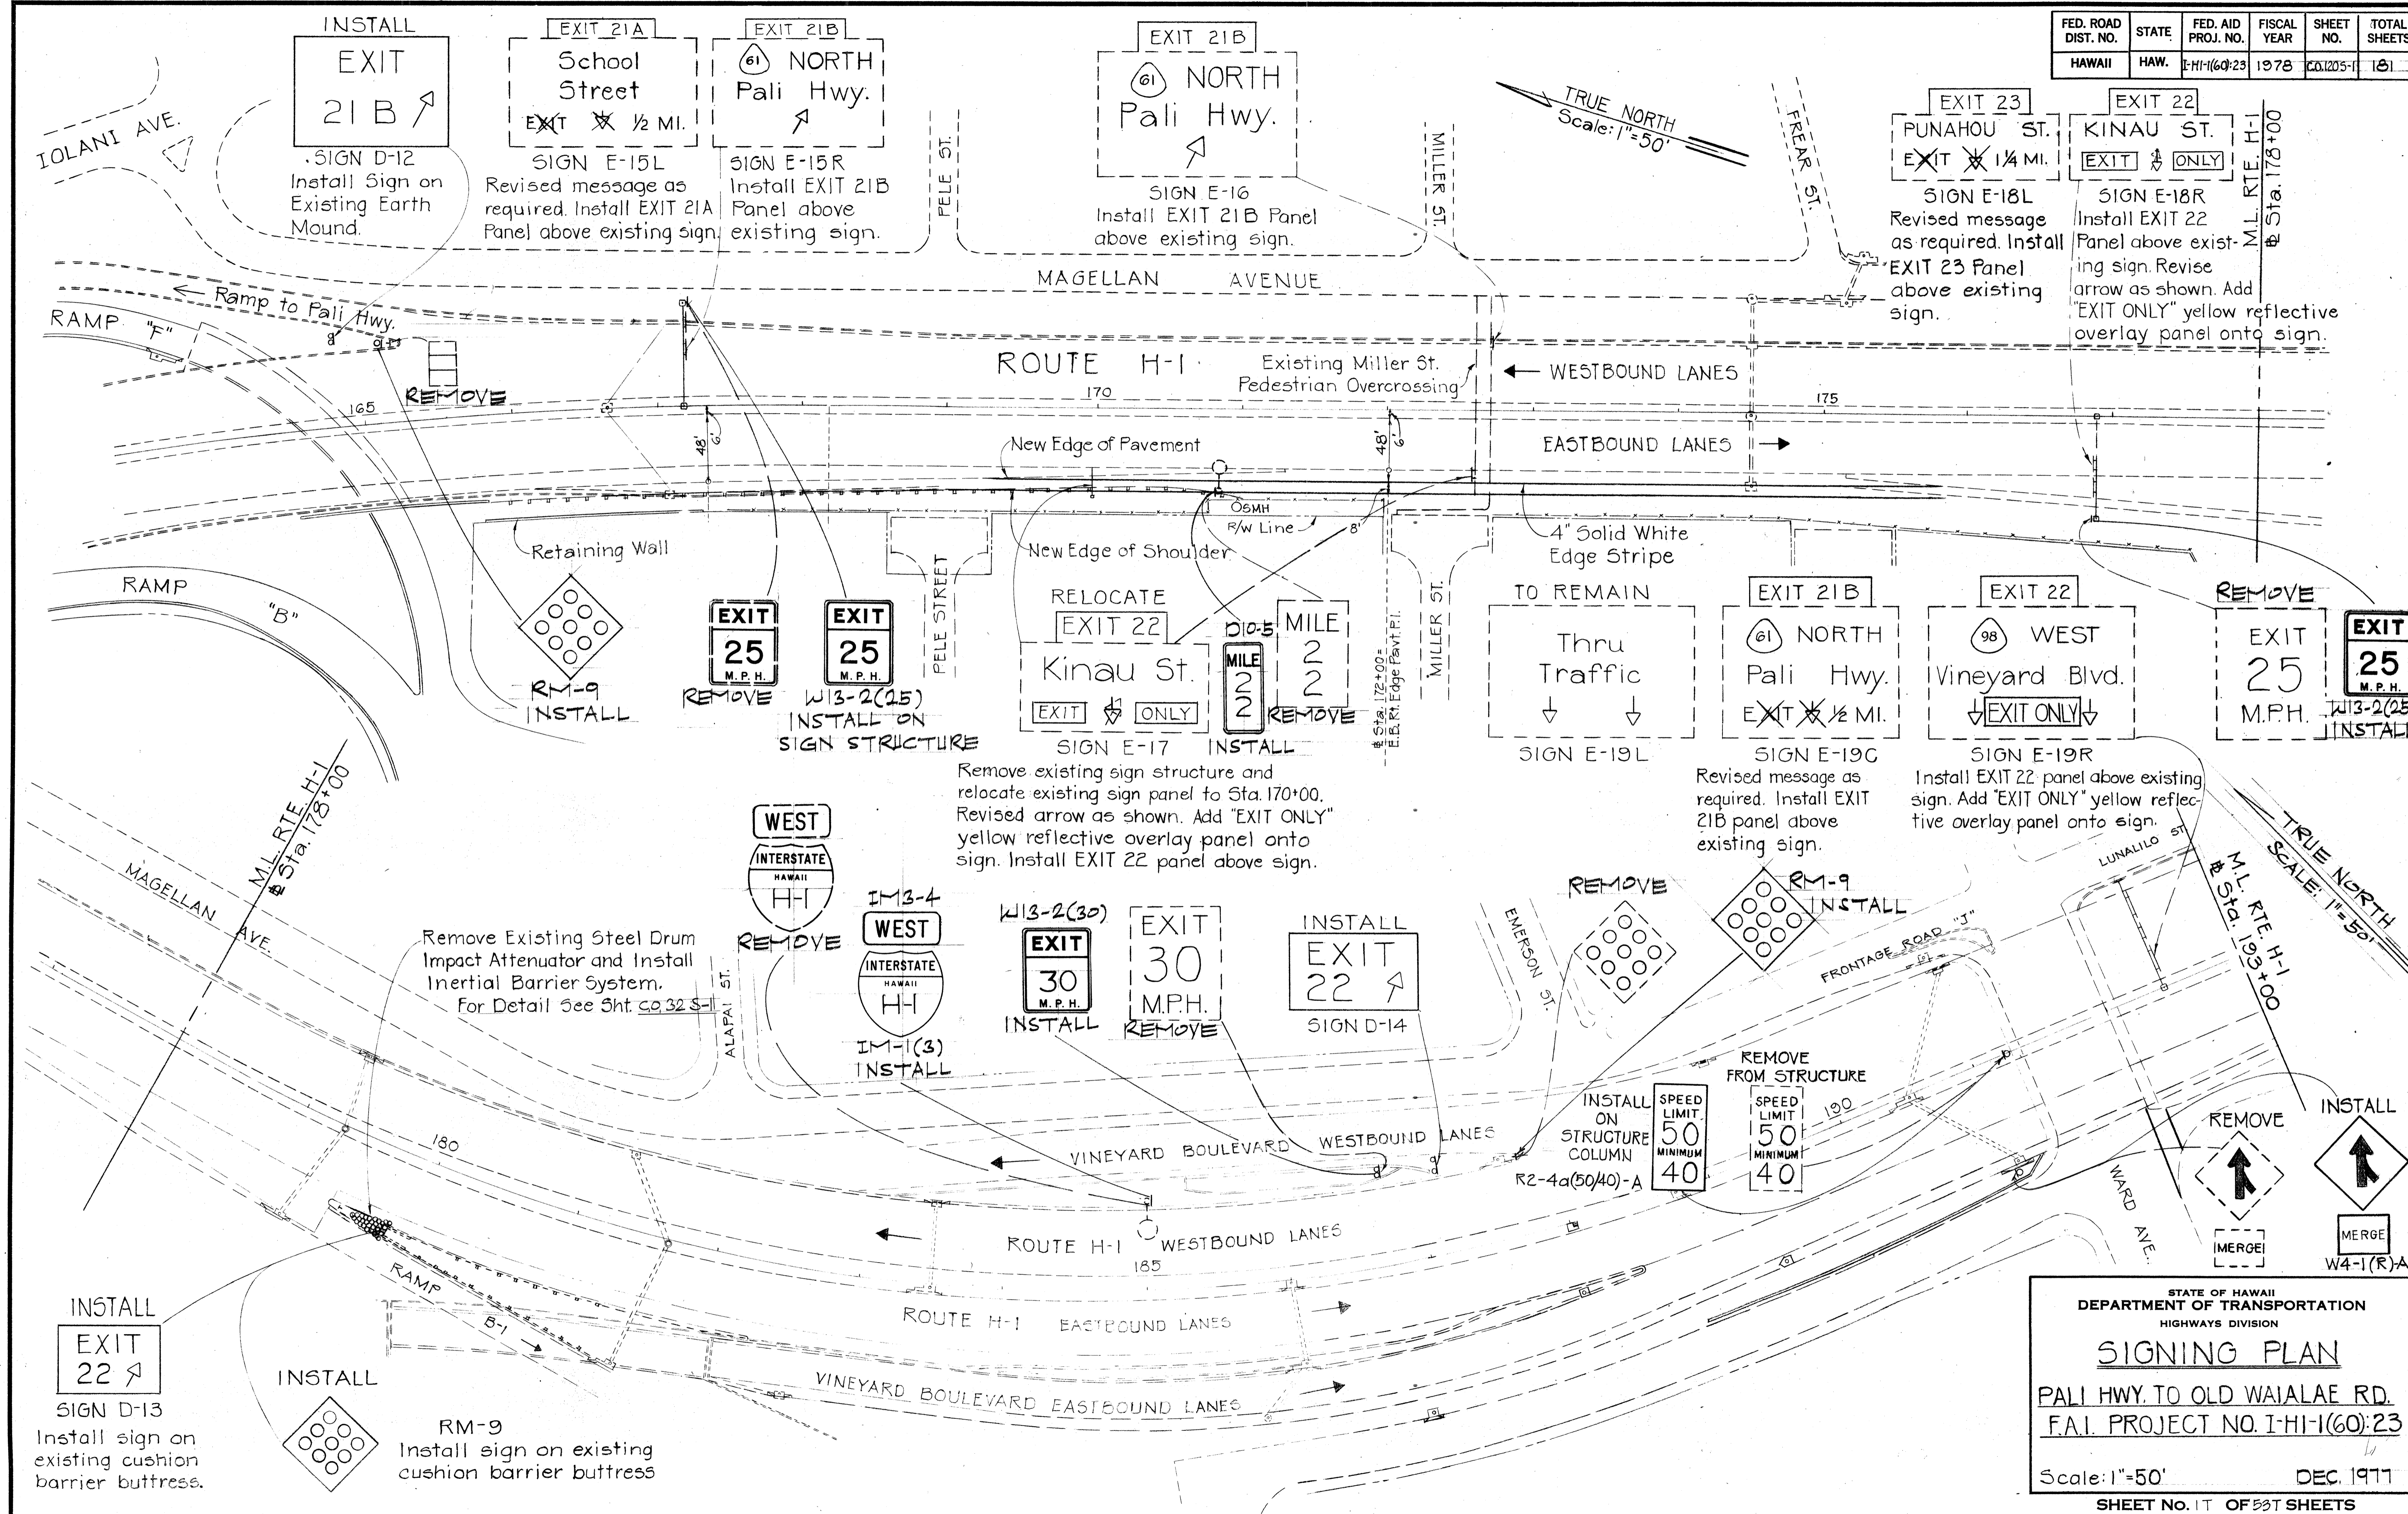

DATE	_____
SURVEY PLOTTED BY	_____
ORIGINAL PLAN	_____
DESIGNED BY	_____
TRACED BY	_____
NOTE BOOK	_____
QUANTITIES BY	_____
CHECKED BY	_____
No.	_____

STATE OF HAWAII  
DEPARTMENT OF TRANSPORTATION  
HIGHWAYS DIVISION

### SIGNING PLAN

PALI HWY. TO OLD WAIALAE RD.  
F.A.I. PROJECT NO. I-HI-1(60)-23

Scale: 1"=50'      DEC. 1977

SHEET No. 17 OF 53 SHEETS


C.O.1205-1



FED ROAD DIST. NO.	STATE	FED AID PROJ. NO.	FISCAL YEAR	SHEET NO.	TOTAL SHEETS
HAWAII	HAW	I-HI-1(60):23	1976	121	181

DATE	
BY	
SURVEYED	
PLOTTED	
GRADES CHECKED	
STRUCTURE NOTATIONS CHECKED	
NOTE BOOK NO.	
PLAN NO.	

DATE	
BY	
SURVEYED	
PLOTTED	
GRADES CHECKED	
STRUCTURE NOTATIONS CHECKED	
NOTE BOOK NO.	
PROFILE NO.	

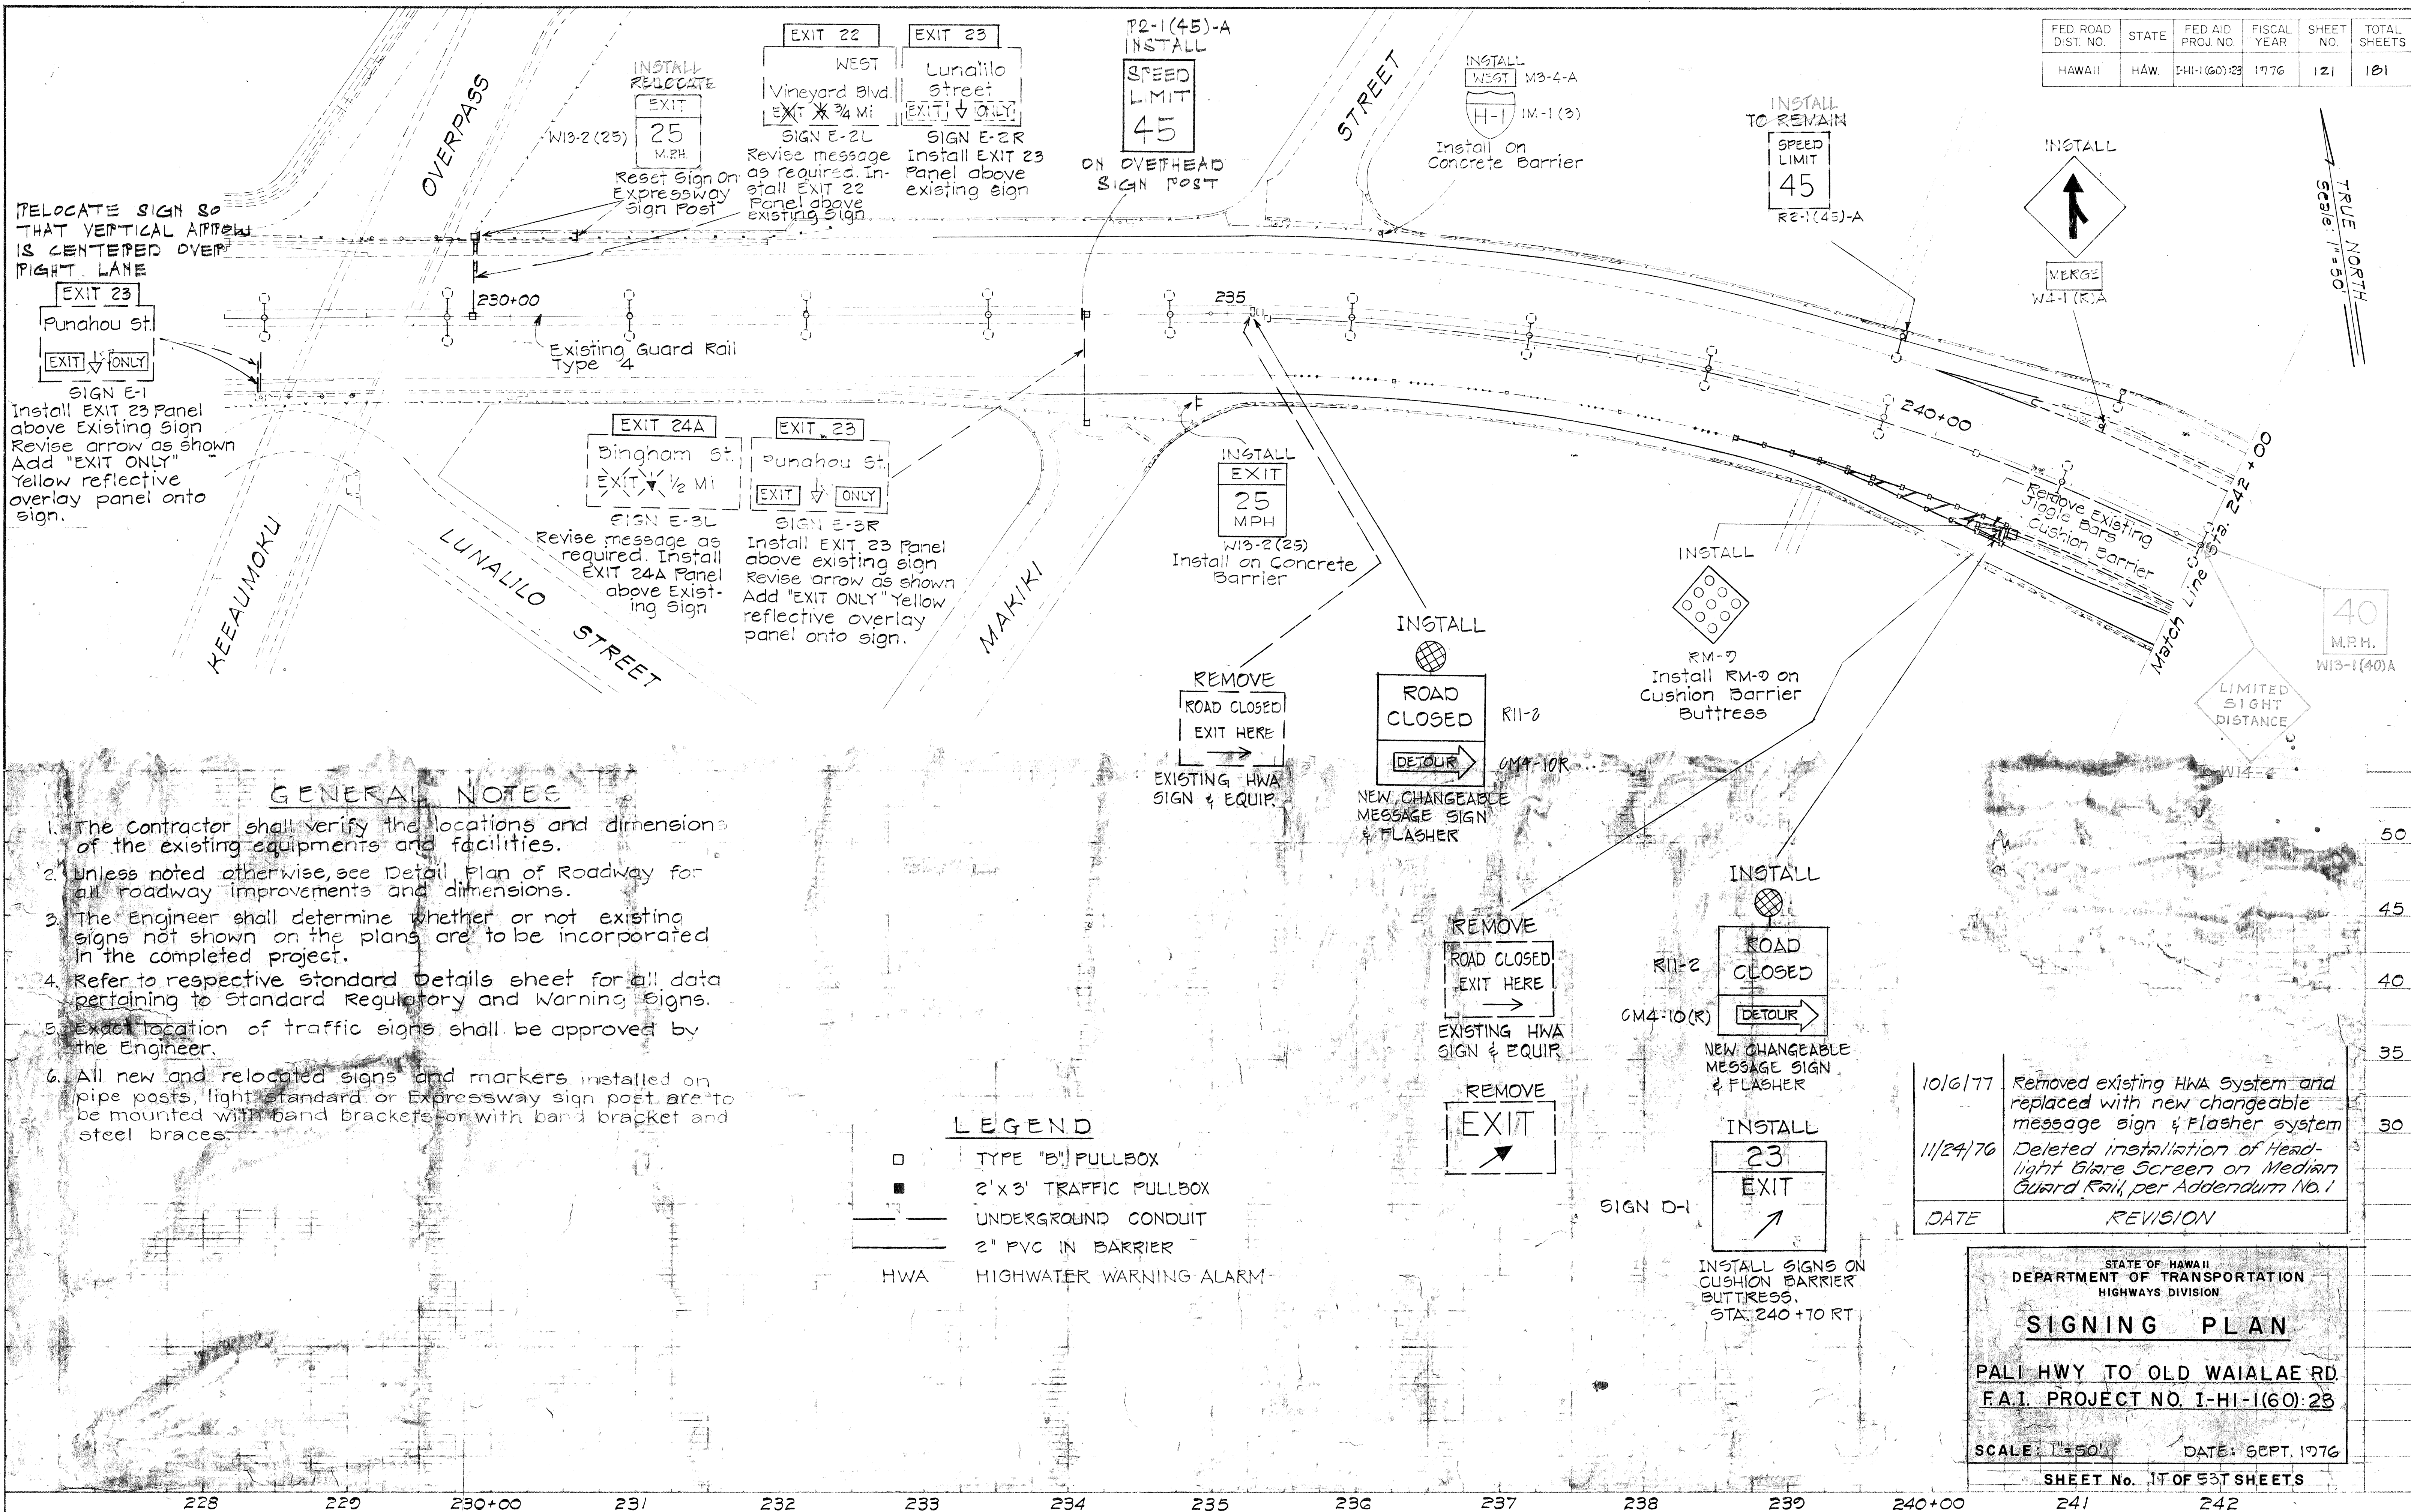

RELOCATE SIGN SO THAT VERTICAL ARROW IS CENTERED OVER RIGHT LANE

INSTALL EXIT 23 Panel above Existing Sign. Revise arrow as shown. Add "EXIT ONLY" Yellow reflective overlay panel onto sign.

**GENERAL NOTES**

- The Contractor shall verify the locations and dimensions of the existing equipments and facilities.
- Unless noted otherwise, see Detail Plan of Roadway for all roadway improvements and dimensions.
- The Engineer shall determine whether or not existing signs not shown on the plans are to be incorporated in the completed project.
- Refer to respective standard details sheet for all data pertaining to Standard Regulatory and Warning Signs.
- Exact location of traffic signs shall be approved by the Engineer.
- All new and relocated signs and markers installed on pipe posts, light standard or Expressway sign post are to be mounted with band brackets or with band bracket and steel braces.

**LEGEND**

- TYPE "B" PULLBOX
- 2'x3' TRAFFIC PULLBOX
- UNDERGROUND CONDUIT
- 2" PVC IN BARRIER
- HWA HIGHWATER WARNING ALARM

DATE	REVISION
10/6/77	Removed existing HWA System and replaced with new changeable message sign & Flasher system
11/24/76	Deleted installation of Headlight Glare Screen on Median Guard Rail, per Addendum No. 1

STATE OF HAWAII  
DEPARTMENT OF TRANSPORTATION  
HIGHWAYS DIVISION

**SIGNING PLAN**

PALI HWY TO OLD WAIALAE RD.  
F.A.I. PROJECT NO. I-HI-1(60):23

SCALE: 1"=50' DATE: SEPT. 1976


SHEET No. 11 OF 53 SHEETS

C.O. ADD. 121R

FED. ROAD DIST. NO.	STATE	FED. AID PROJ. NO.	FISCAL YEAR	SHEET NO.	TOTAL SHEETS
HAWAII	HAW.	IHI-1(60):23	1976	122	181

INSTALL  
WEST  
FREEWAY →  
SIGN D-2  
Construct Sign Structure D-2 STA. 256+00 LT.

REMOVE  
Lunalilo Freeway WEST

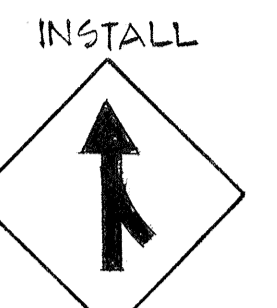

INSTALL  
W4-1(R)-A  
Install On Concrete Barrier

RELOCATE  
STOP RI-1  
Reset on Concrete Barrier

INSTALL  
ONE WAY

RELOCATE  
Reset on Concrete Barrier R6-1(R)

REMOVE  
SPEED LIMIT 45  
R2-1(45)

REMOVE  
SPEED LIMIT 45  
R2-1(45)

INSTALL  
NO STOPPING OR STANDING  
R7-4  
Install on Concrete Barrier

INSTALL  
RELOCATE  
SPEED LIMIT 45  
R2-1(45)-A  
Install on Concrete Barrier

INSTALL  
WEST M3-4-A  
H-1 IM-1(3)  
Install on Concrete Barrier

REMOVE  
NO STOPPING OR STANDING  
R7-4

REMOVE  
NO STOPPING OR STANDING  
R7-4

REMOVE  
NO STOPPING OR STANDING  
R7-4

INSTALL  
ROAD CLOSED  
RII-2

NEW CHANGEABLE MESSAGE SIGN & FLASHER



REMOVE  
ROAD CLOSED  
DO NOT ENTER

INSTALL  
RELOCATE  
ONE WAY  
Reset on Concrete Barrier R6-1(R)

REMOVE  
NO STOPPING OR STANDING  
R7-4

REMOVE  
SPEED LIMIT 45 M.P.H.  
R2-1(45)

DATE	REVISION
10/6/77	Removed existing HWA System and replaced with new changeable sign & Flasher System.
11/24/76	Deleted installation of Headlight Glare Screen on Median Guard Rail, per Addendum No. 1

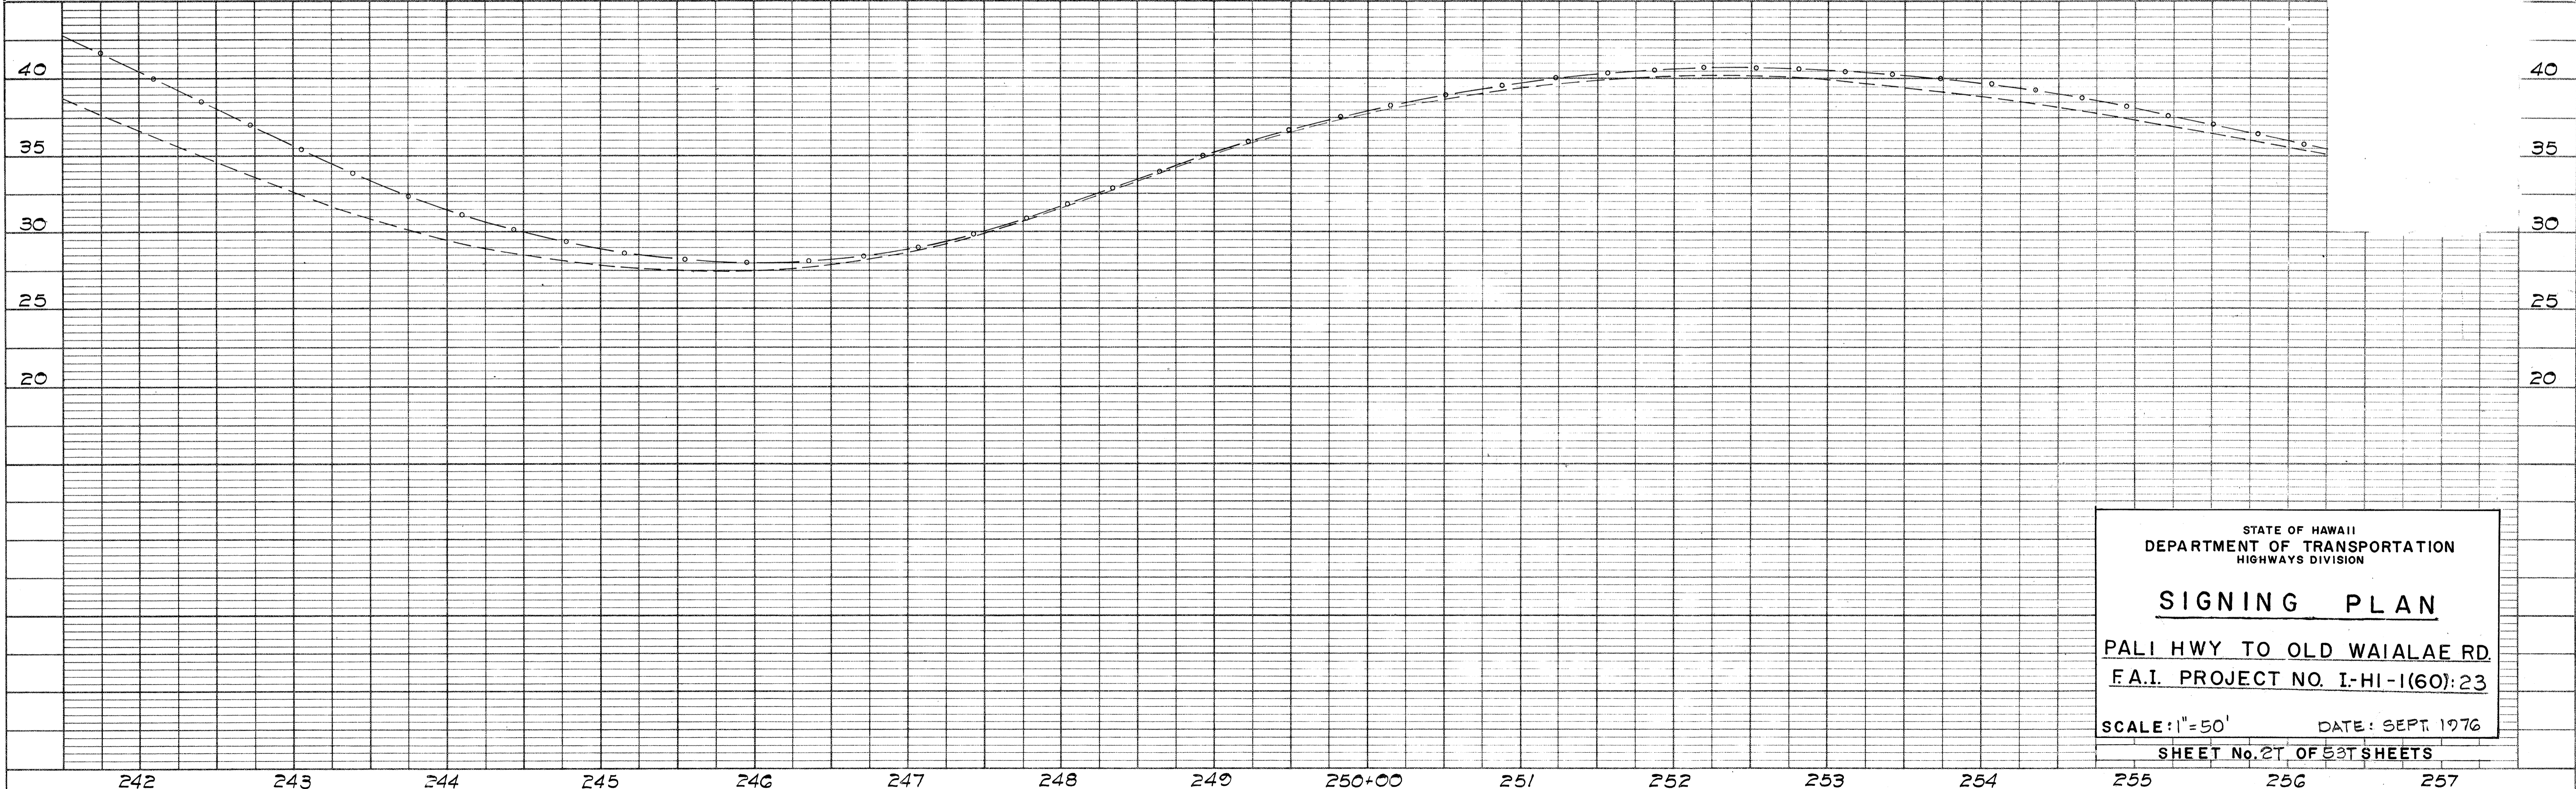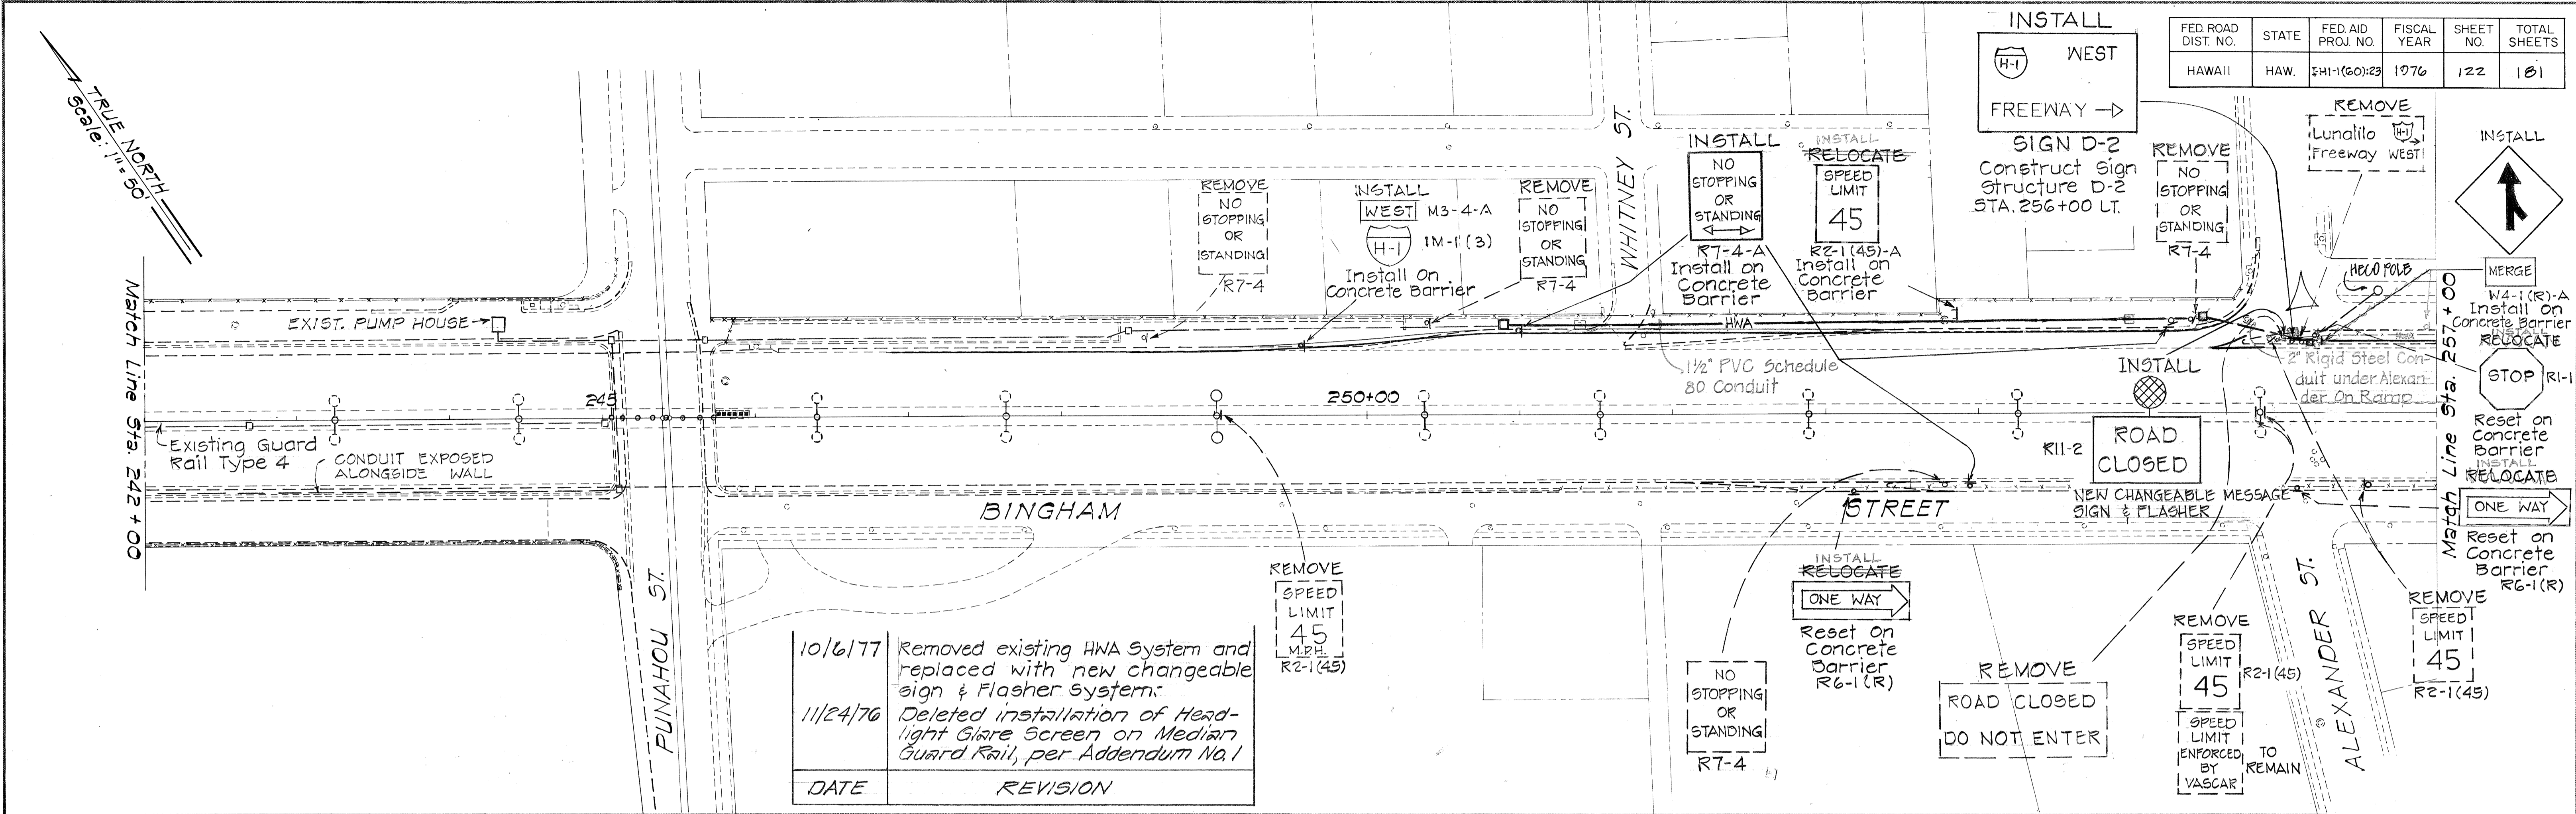

STATE OF HAWAII  
DEPARTMENT OF TRANSPORTATION  
HIGHWAYS DIVISION  
**SIGNING PLAN**  
PALI HWY TO OLD WAIALAE RD.  
F.A.I. PROJECT NO. I-HI-1(60):23  
SCALE: 1"=50' DATE: SEPT. 1976  
SHEET No. 21 OF 53 SHEETS

C.O. ADD. 122R

PLATE 1—PLAN PROFILE S. P. A. STANDARD  
THE FREDERICK POST CO., CHICAGO

PLAN	SURVEYED	DATE
	PLOTTED	BY
	ALIGNED	
	CHECKED	
	BY	
	NO.	



PROFILE	SURVEYED	DATE
	PLOTTED	BY
	GRADES	
	CHECKED	
	BY	
	NO.	























FED. ROAD DIST. NO.	STATE	FED. AID PROJ. NO.	FISCAL YEAR	SHEET NO.	TOTAL SHEETS
HAWAII	HAW.	I-11(60)23	1976	C.O. ADD. 125R	181




Note:  
Sign W9-3(L) shall conform to Plans & Specifications for Warning Signs.  
Install on Concrete Barrier

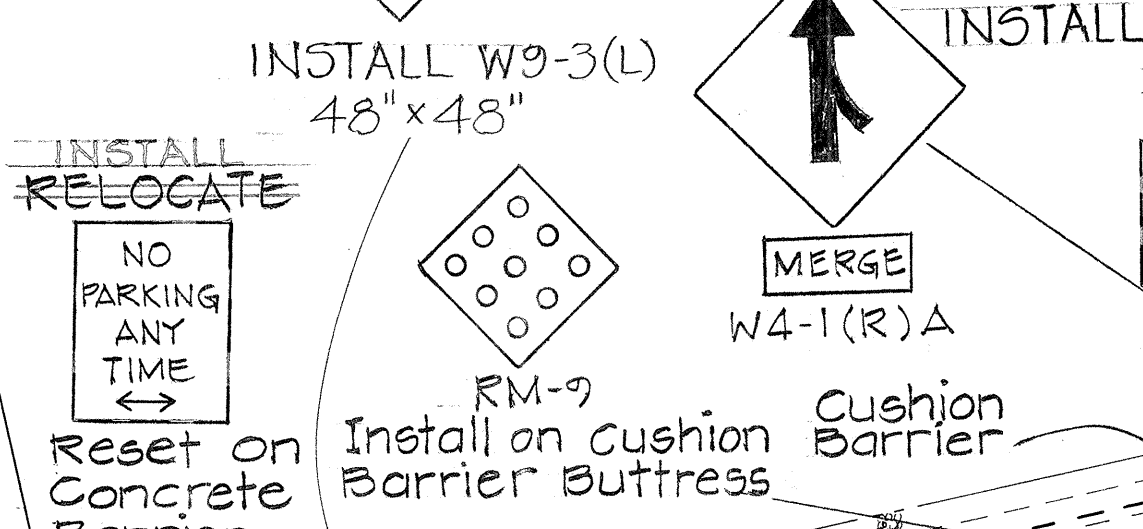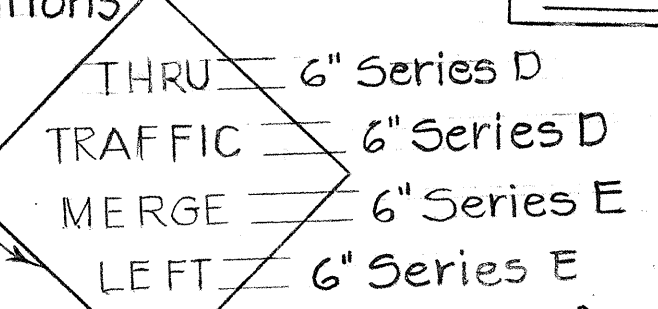

Match Line Sta. 8+00

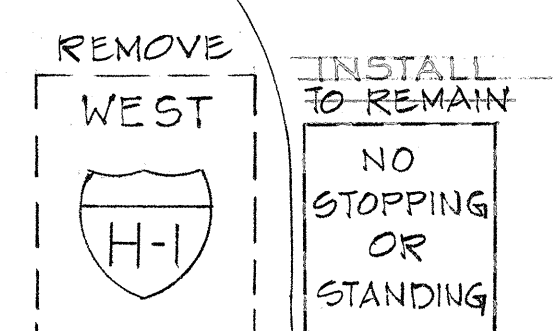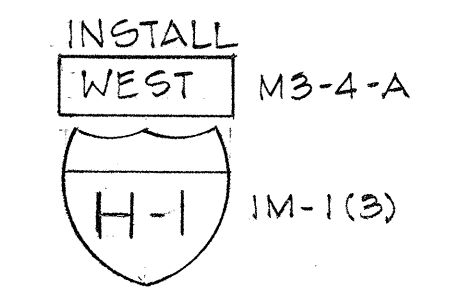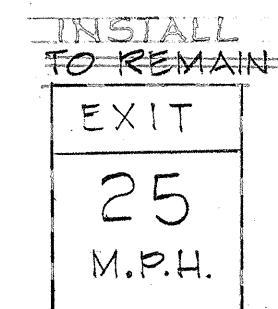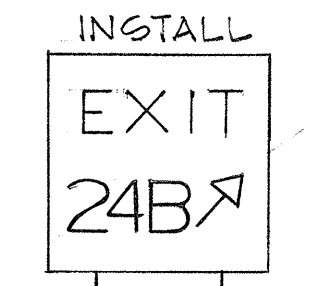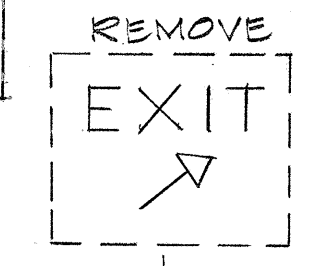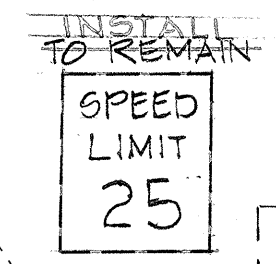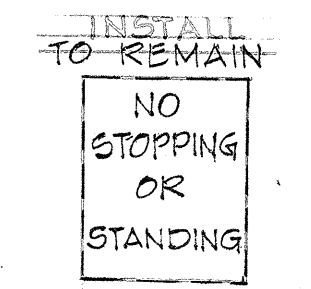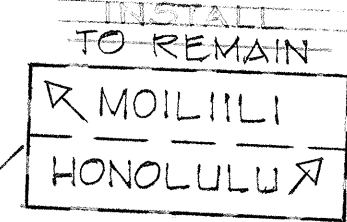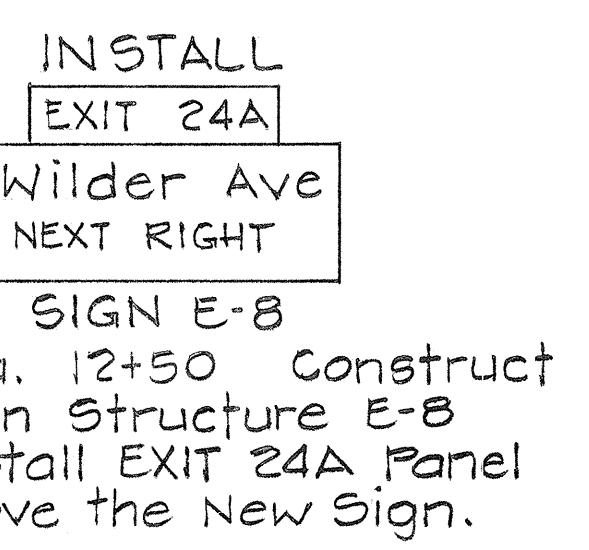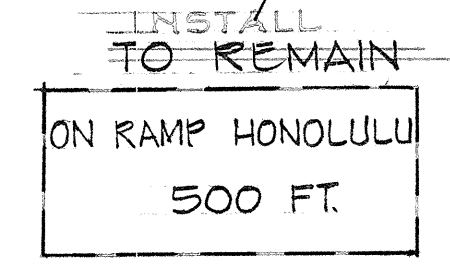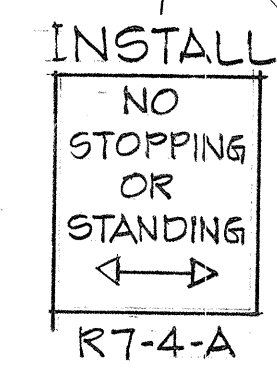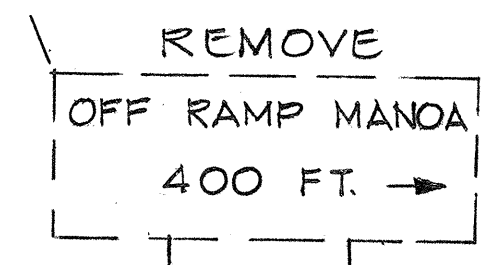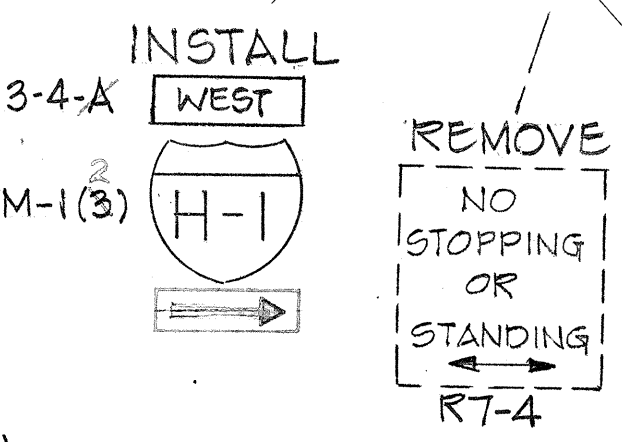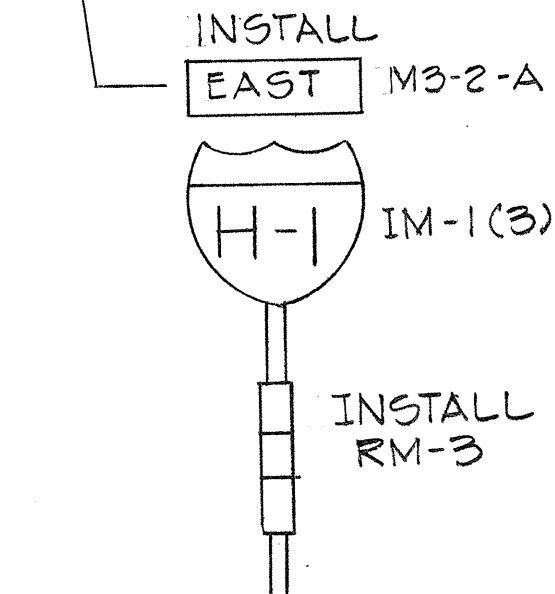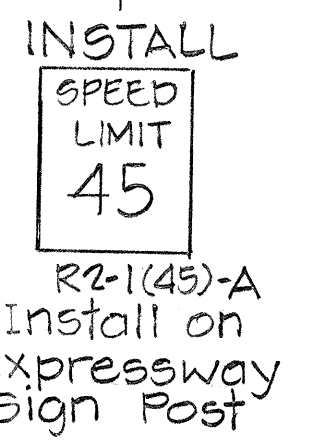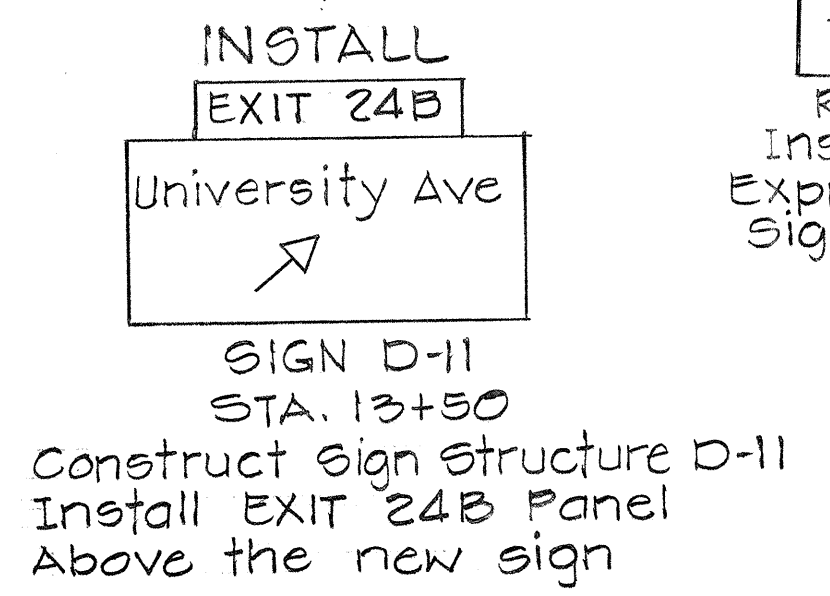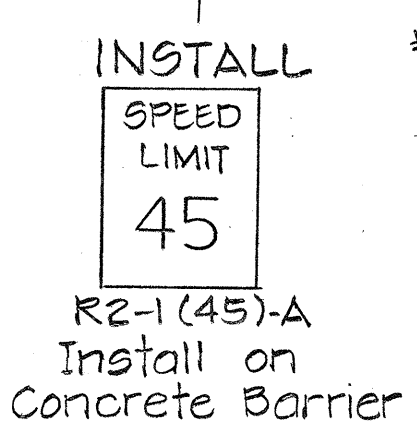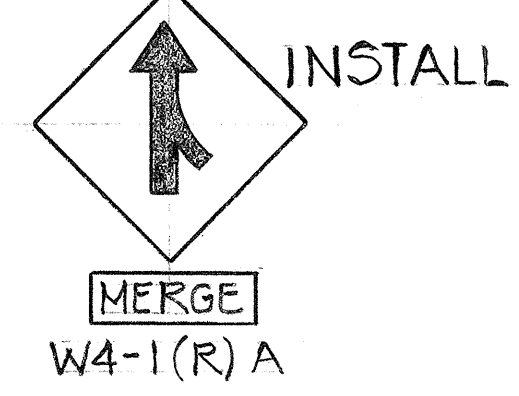

Match Line Sta. 23+00

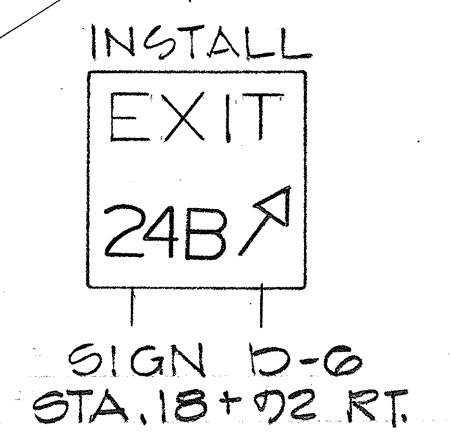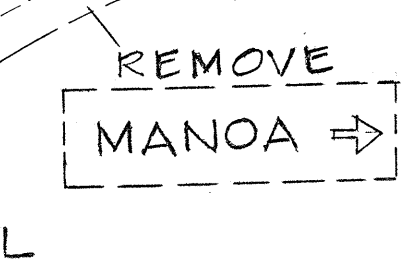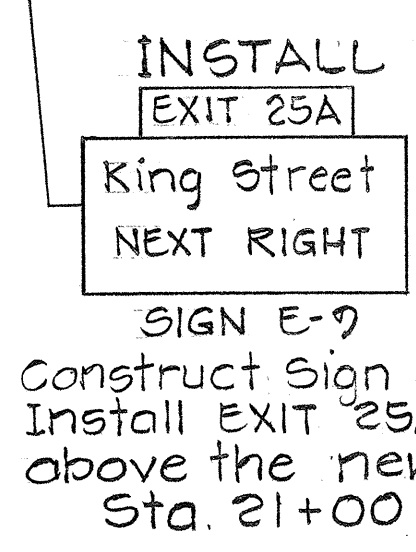

LEGEND  
RM-2 DELINEATOR (DOUBLE UNIT AMBER)  
RM-3 DELINEATOR (TRIPLE UNIT AMBER)

DATE	REVISION
8/24/77	Install W9-3(L) 48" x 48"
11/24/76	Deleted installation of Head-light Glare Screen on Median Guard Rail, per Addendum No. 1

STATE OF HAWAII  
DEPARTMENT OF TRANSPORTATION  
HIGHWAYS DIVISION

**SIGNING PLAN**

PALI HWY TO OLD WAIALAE RD.  
F.A.I. PROJECT NO. I-HI-1(60) 23

SCALE: 1"=50' DATE: SEPT. 1976  
SHEET No. 51 OF 53 SHEETS


DATE	
DRAWN BY	
DESIGNED BY	
CHECKED BY	
ORIGINAL PLAN	
NOTE BOOK	
No.	

FED. ROAD DIST. NO.	STATE	FED. AID PROJ. NO.	FISCAL YEAR	SHEET NO.	TOTAL SHEETS
HAWAII	HAW.	1-HI(60):23	1976	126	181

DATE	REVISION
11/24/76	Deleted installation of Headlight Glare Screen on Median Guard Rail, per Addendum No. 1

DATE	BY

DATE	BY

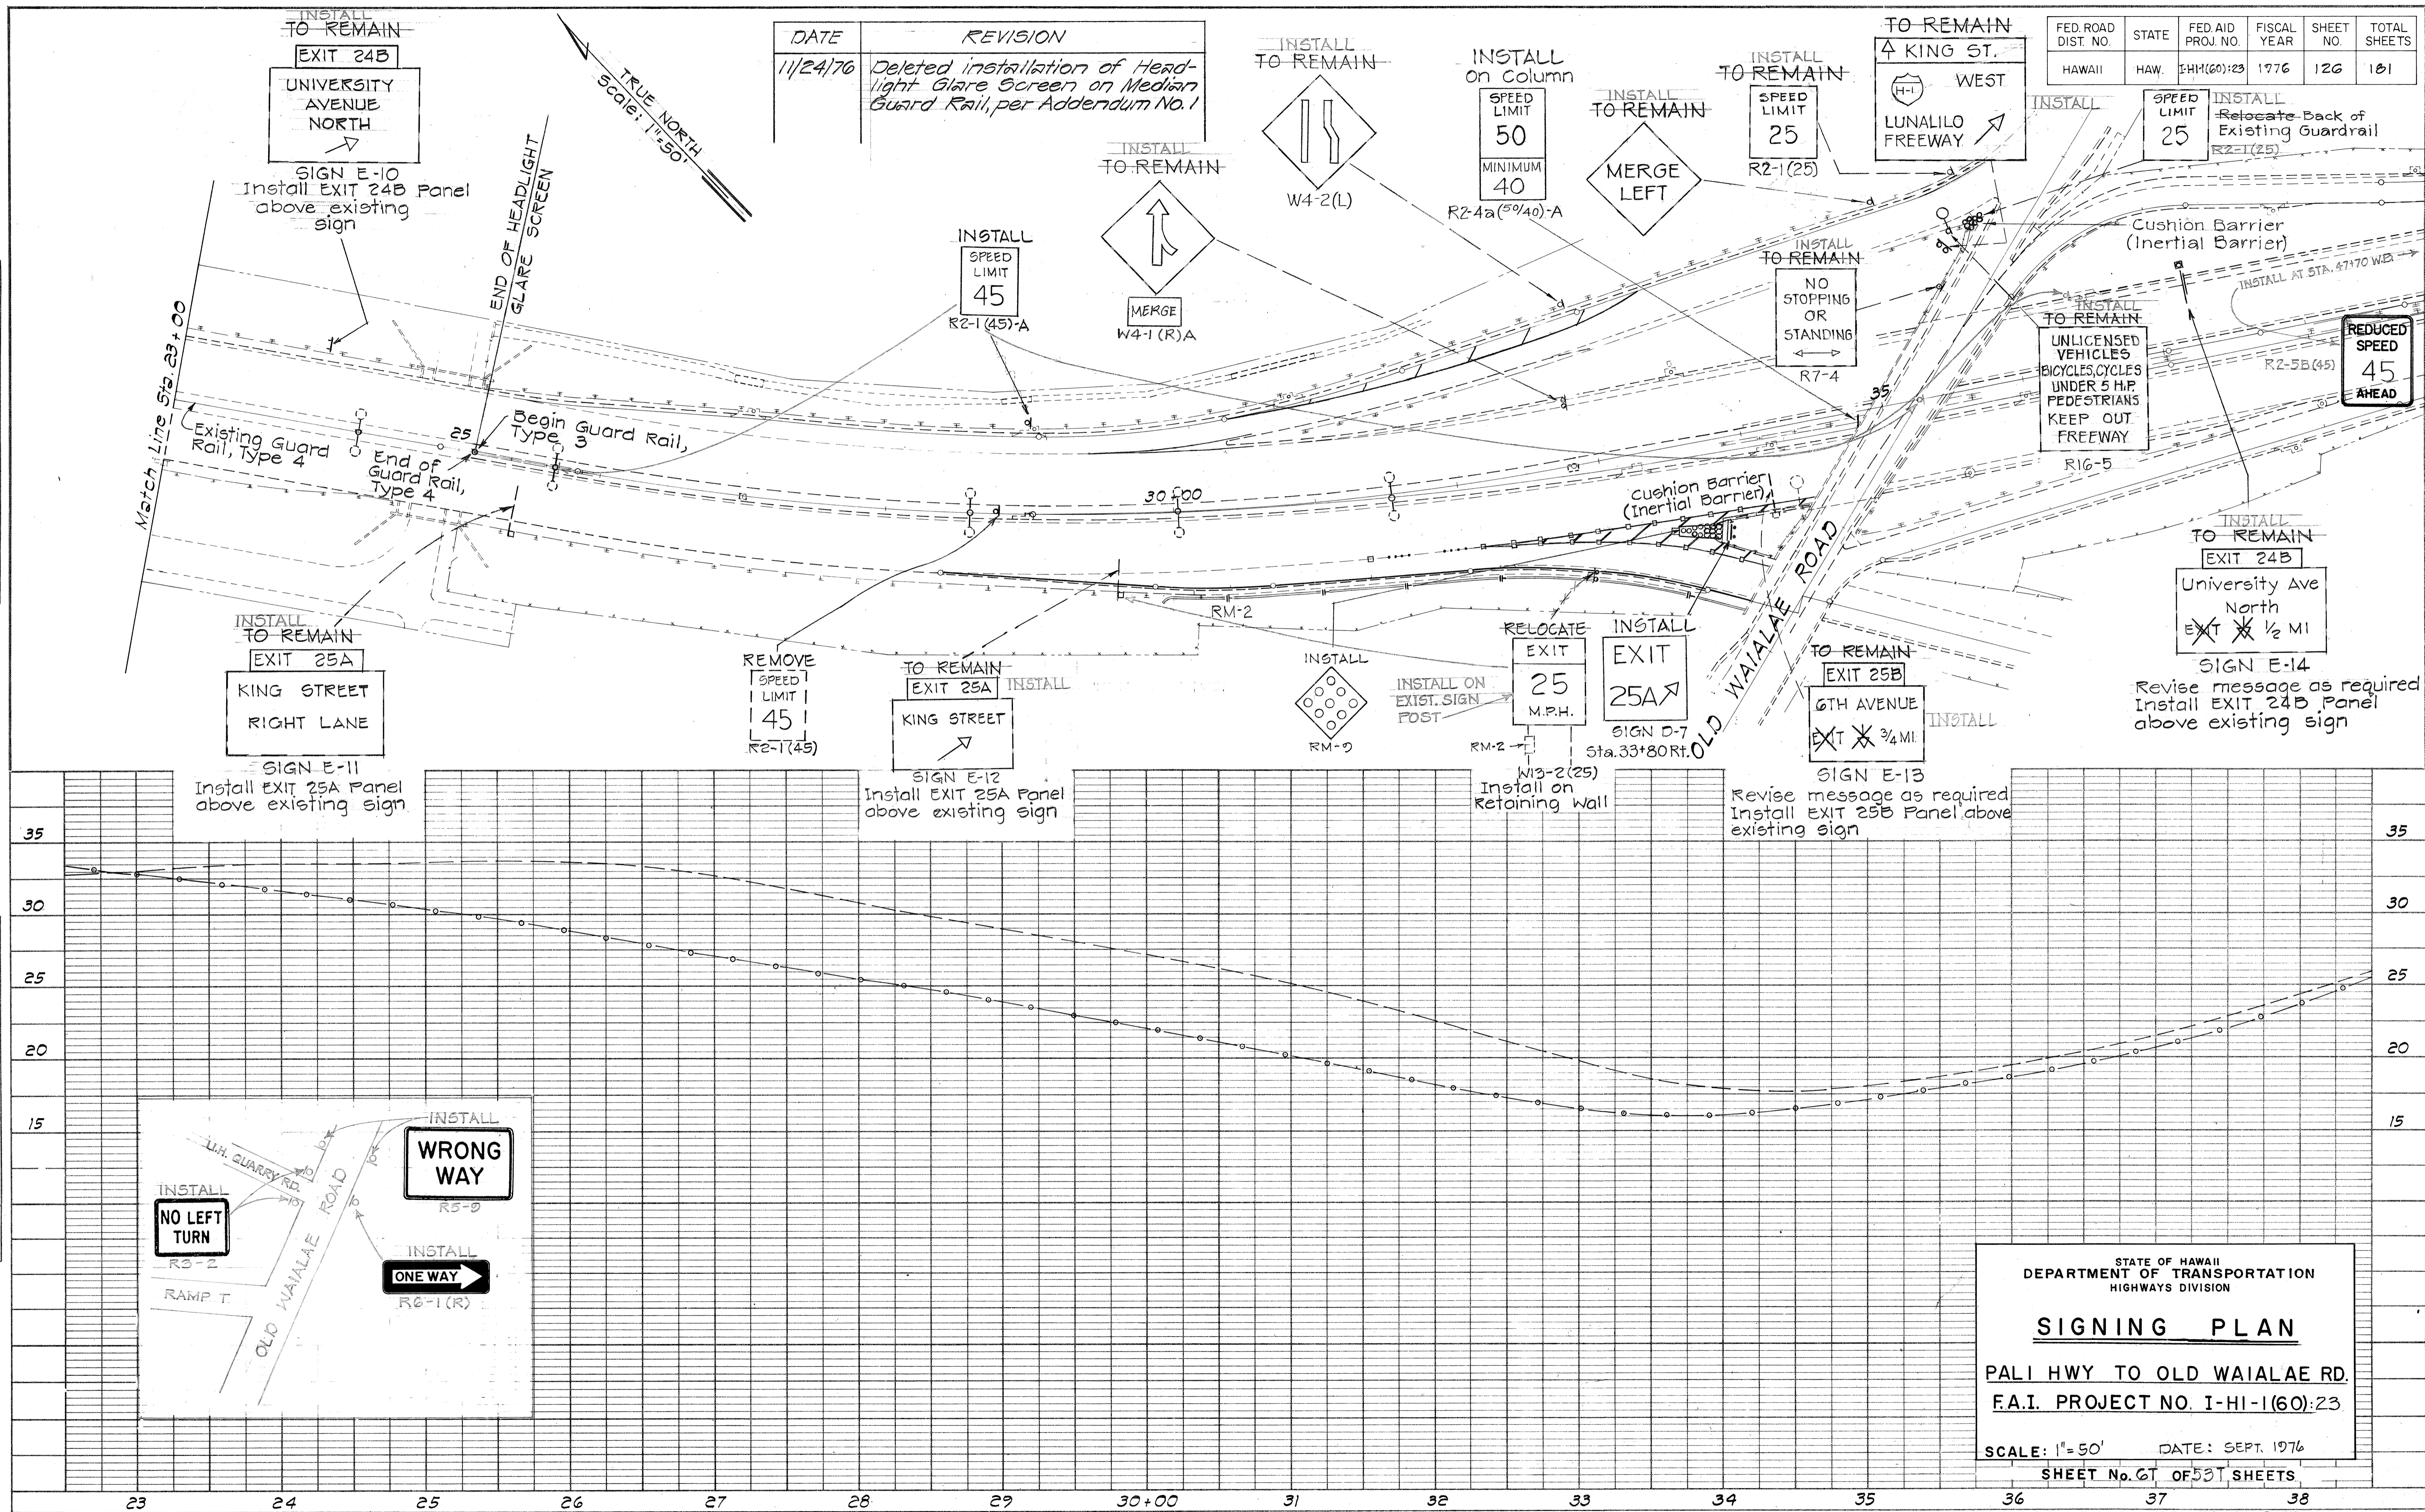

STATE OF HAWAII  
 DEPARTMENT OF TRANSPORTATION  
 HIGHWAYS DIVISION

**SIGNING PLAN**


PALI HWY TO OLD WAI'ALAE RD.  
 F.A.I. PROJECT NO. I-HI-1(60):23

SCALE: 1" = 50'      DATE: SEPT. 1976  
 SHEET No. 61 OF 531 SHEETS

ADD.126R

PLATE 1—PLAN PROFILE S. P. R. STANDARD  
 THE FREDERICK POST CO., CHICAGO

FED. ROAD DIST. NO.	STATE	FED. AID PROJ. NO.	FISCAL YEAR	SHEET NO.	TOTAL SHEETS
HAWAII	HAW.	I-HI-1(60):23	1978	C.O. 126 S-1	181

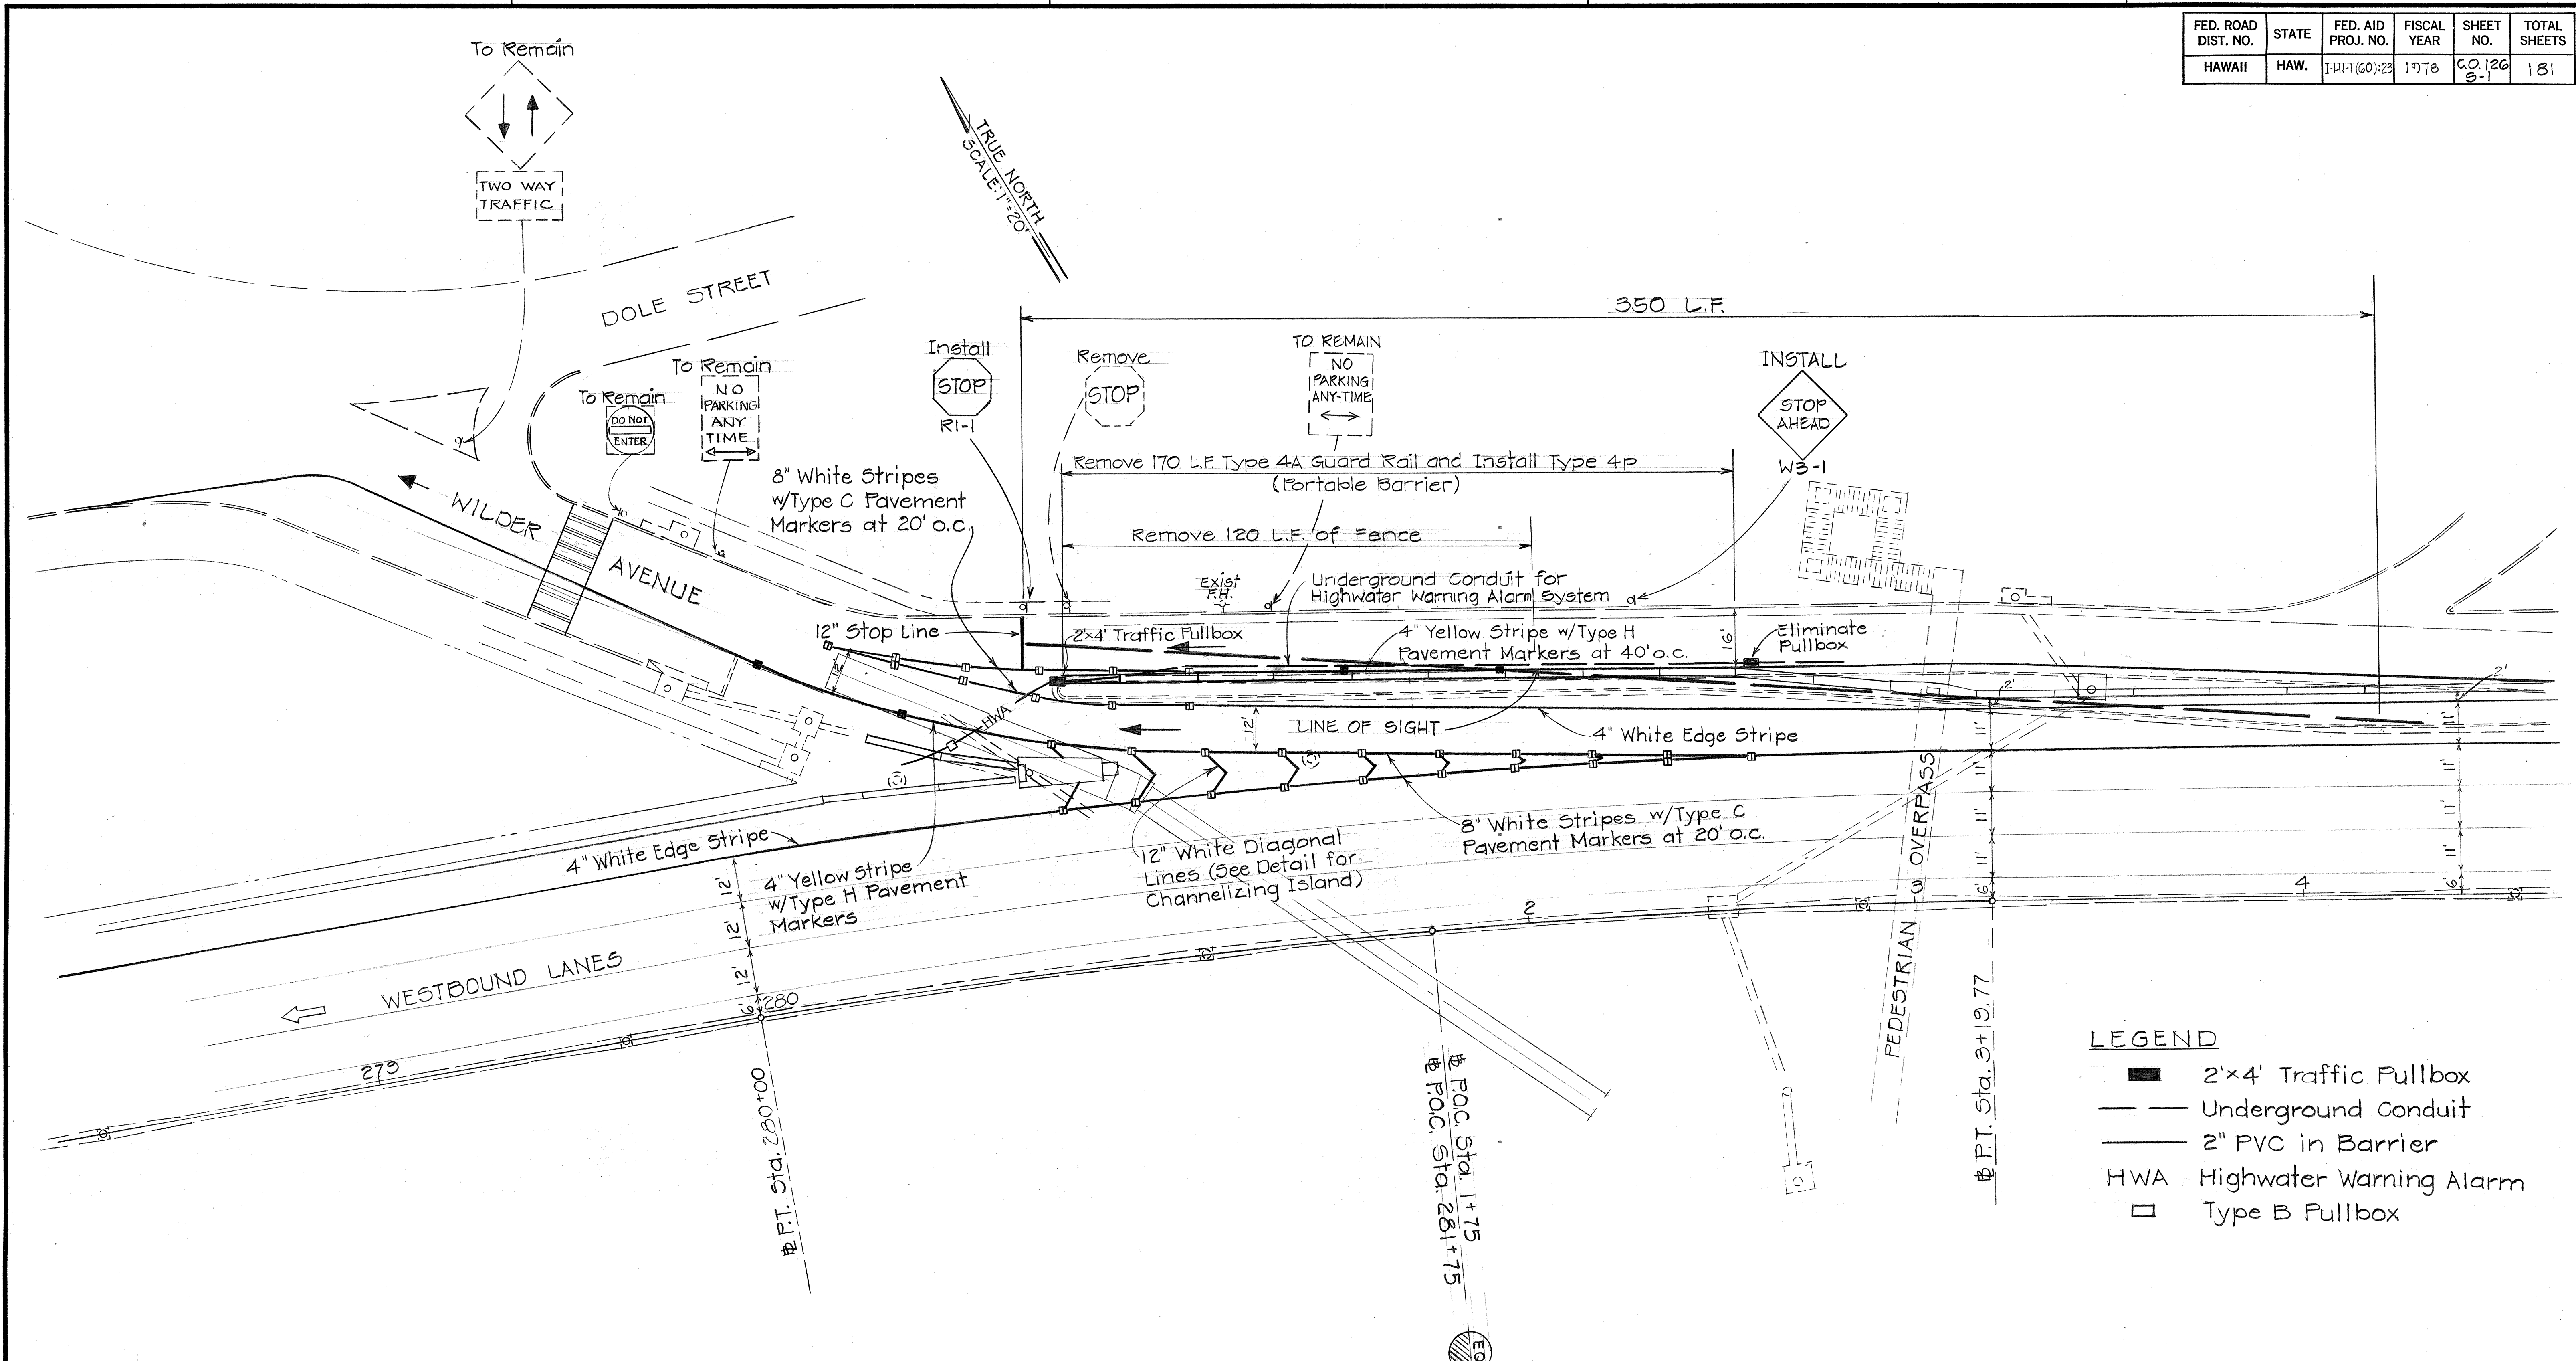

**LEGEND**

- 2'x4' Traffic Pullbox
- Underground Conduit
- 2" PVC in Barrier
- HWA Highwater Warning Alarm
- Type B Pullbox

STATE OF HAWAII  
DEPARTMENT OF TRANSPORTATION  
LAND TRANSPORTATION FACILITIES DIVISION

**DETAIL PLAN OF ROADWAY  
SHOWING REVISIONS AT  
WILDER AVE. OFF-RAMP**

F.A.I. Proj. No. I-HI-1(60):23

Scale: 1" = 20'    Date: July, 1978

SHEET NO.    OF SHEETS

C.O. 126 S-1

ORIGINAL PLAN	DATE
SURVEY PLOTTED BY	
DRAWN BY	
DESIGNED BY	
CHECKED BY	
NO. _____	