




FED. ROAD DIST. NO.	STATE	FED. AID PROJ. NO.	FISCAL YEAR	SHEET NO.	TOTAL SHEETS
HAWAII	HAW.	I-HI-1(60):23	1976	2	181

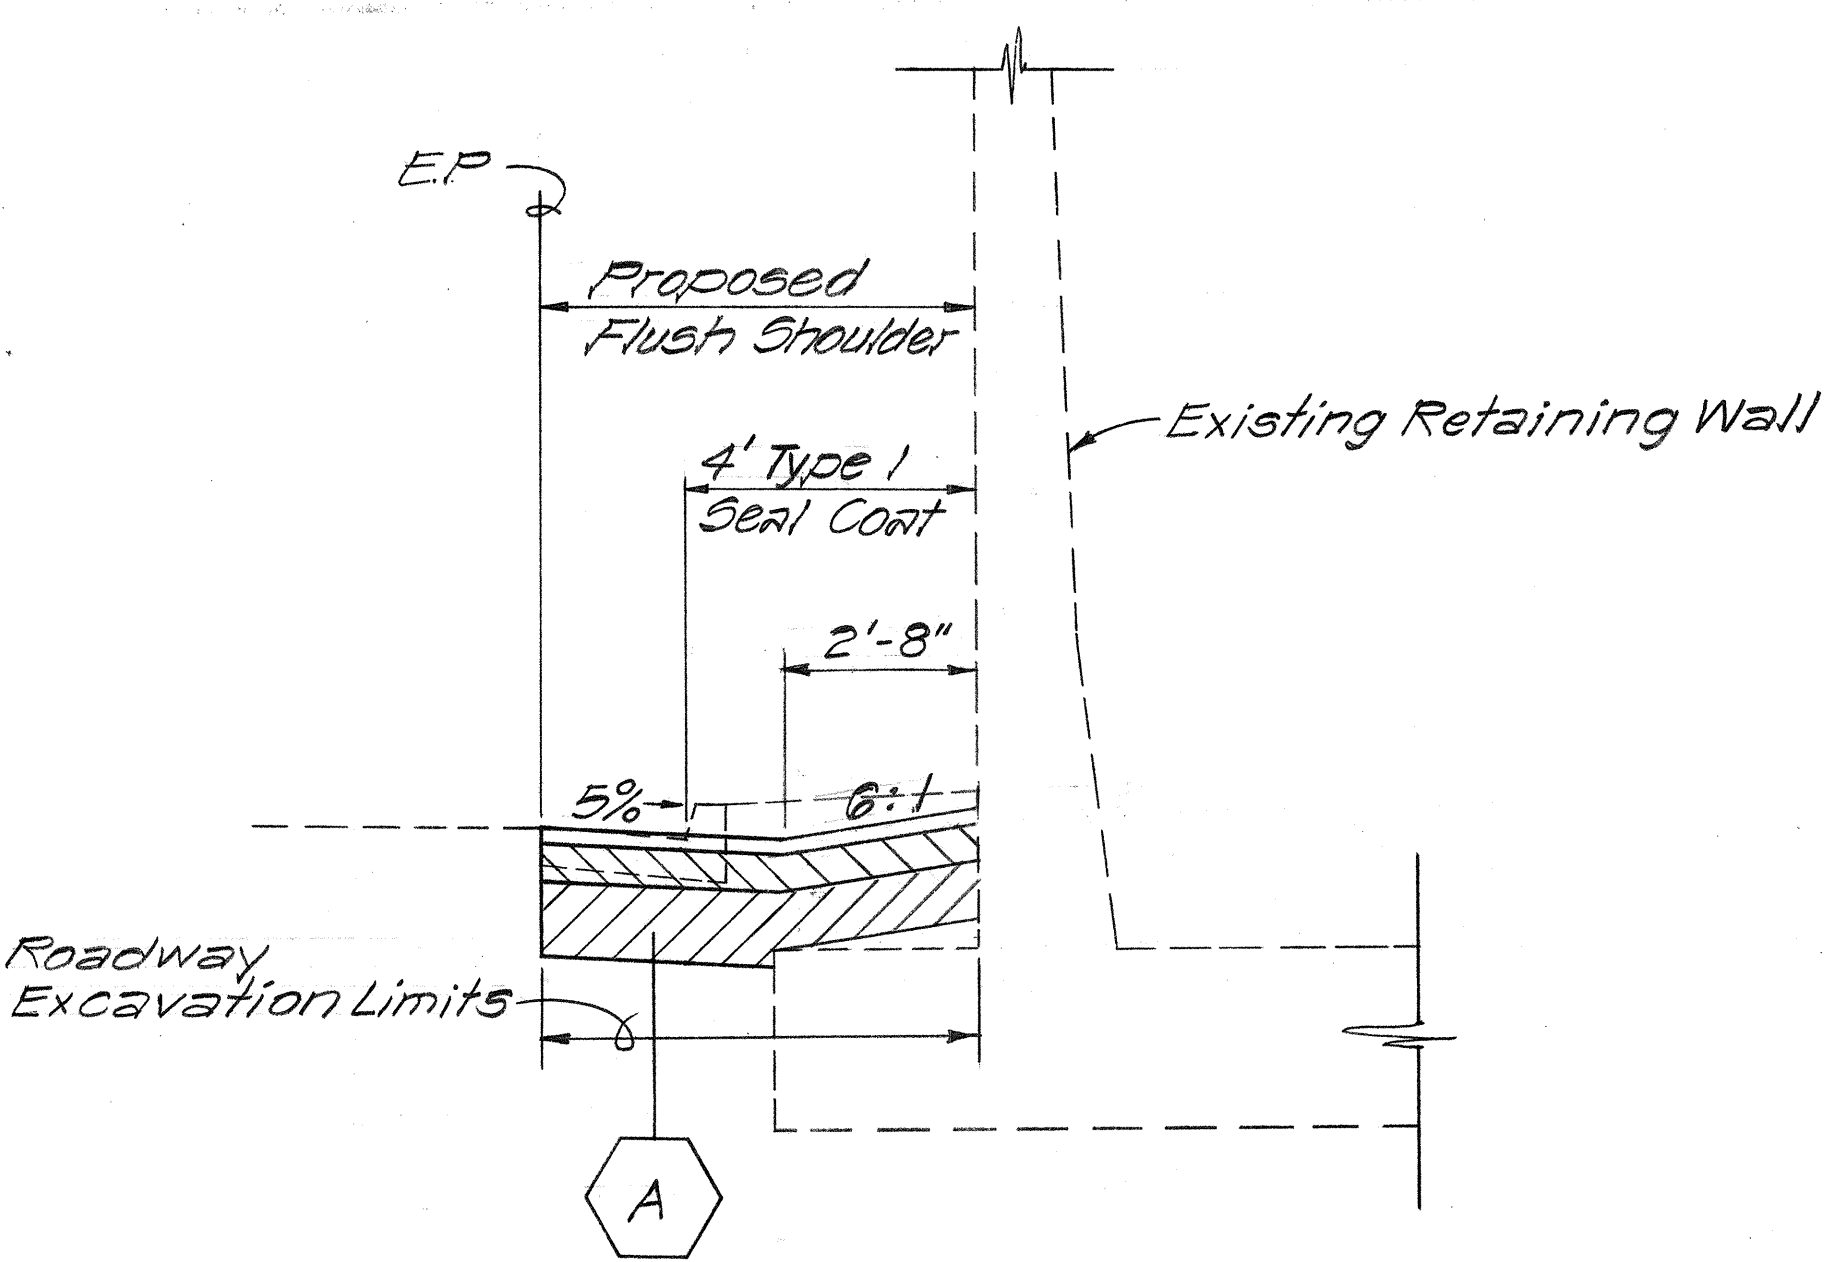


TS-1 # STA. 240+74± to STA. 251+26± E.B.
 # STA. 241+05± to STA. 248+39± W.B.
 # STA. 2+73± to STA. 4+80± E.B.
 * Revised from A to B per Addendum No. 1

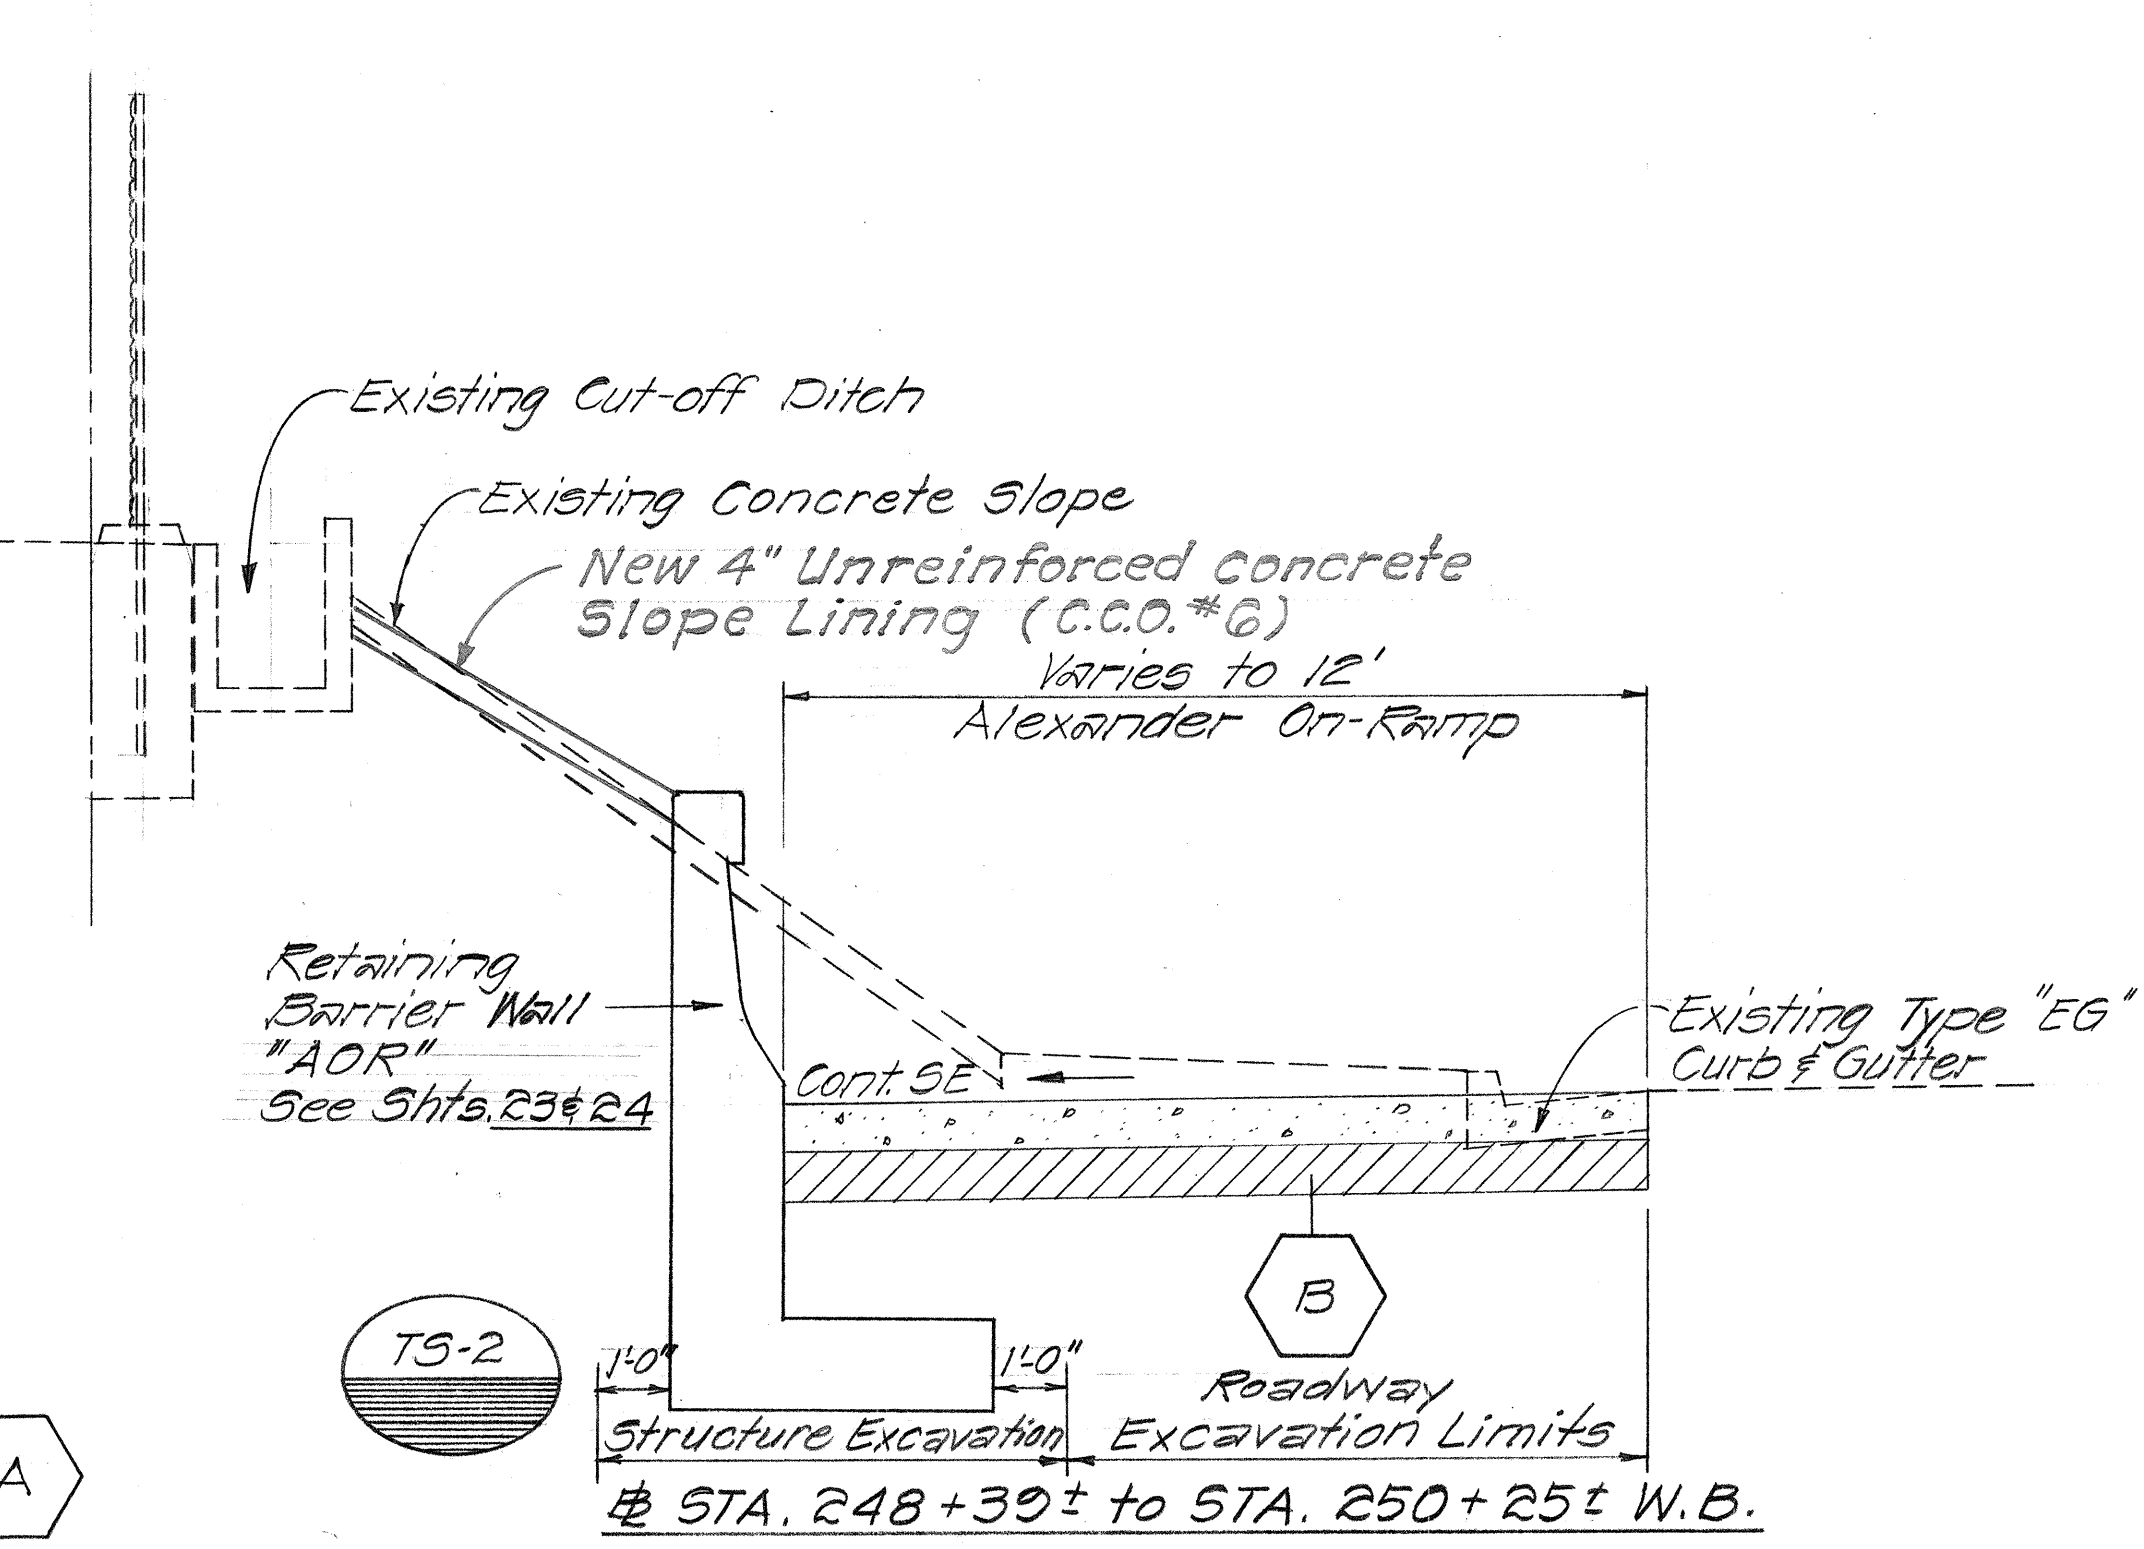


TS-2 # STA. 248+39± to STA. 250+25± W.B.

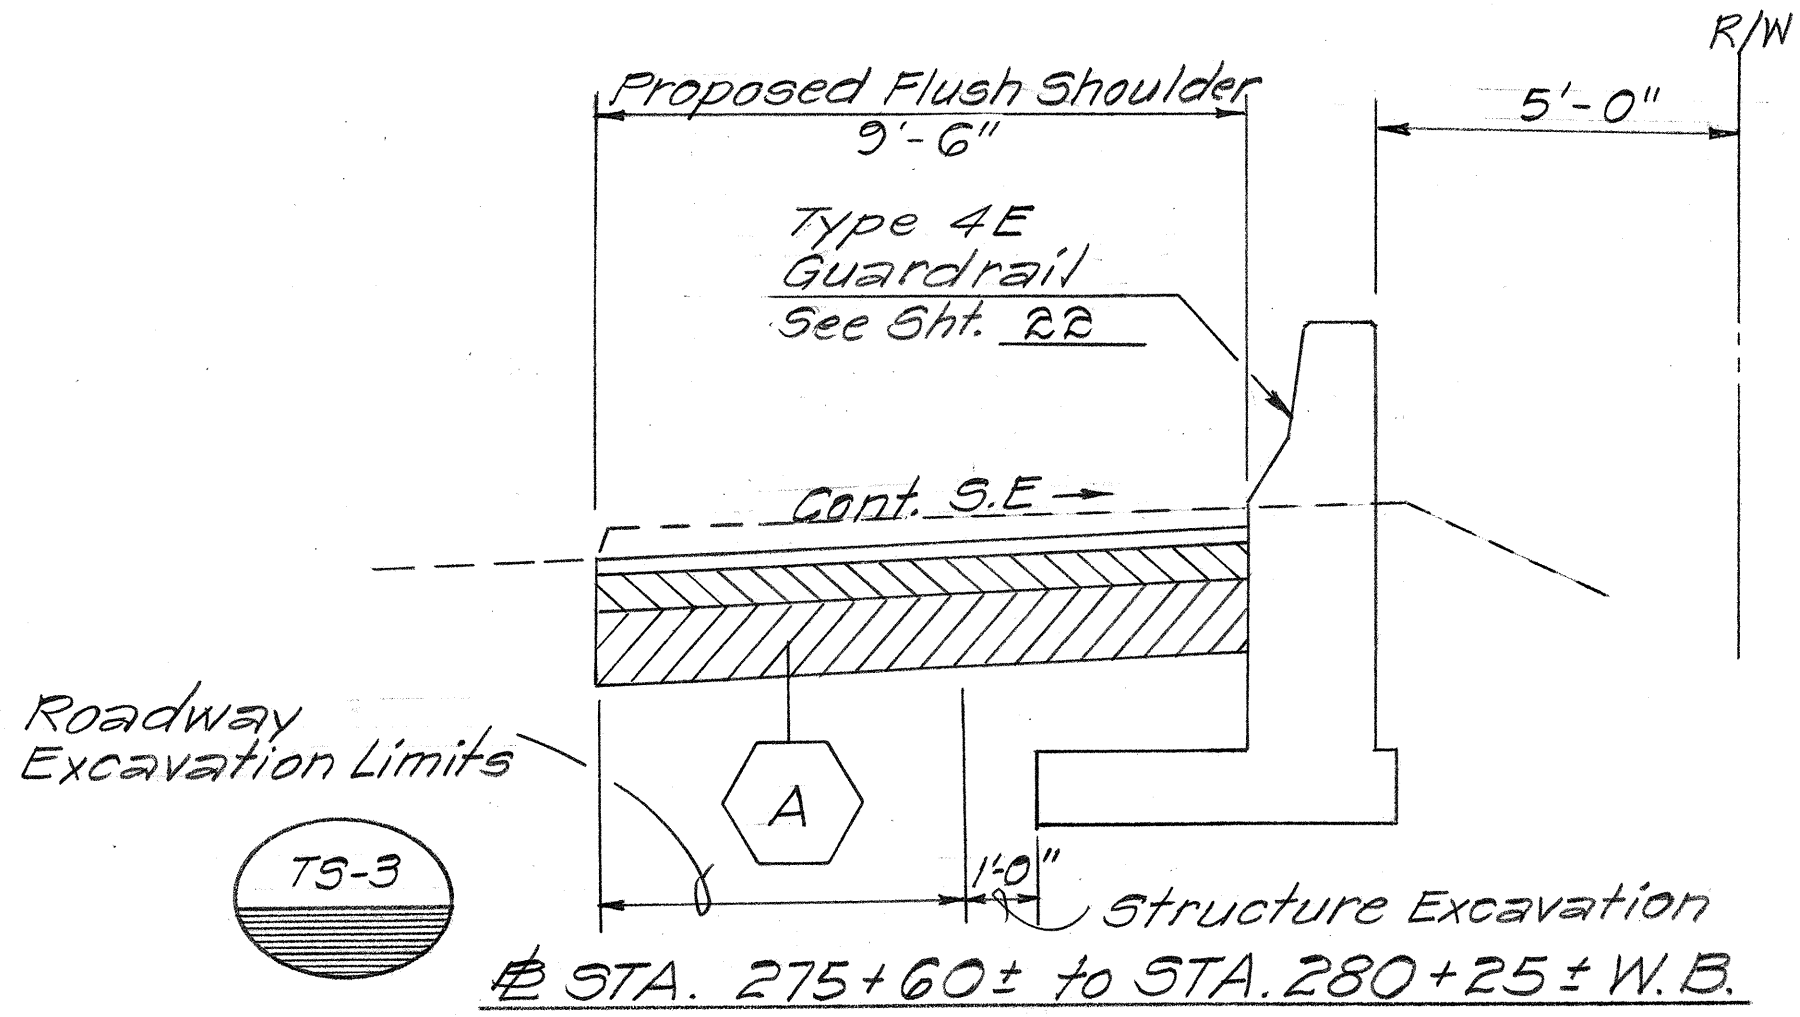


TS-3 # STA. 275+60± to STA. 280+25± W.B.

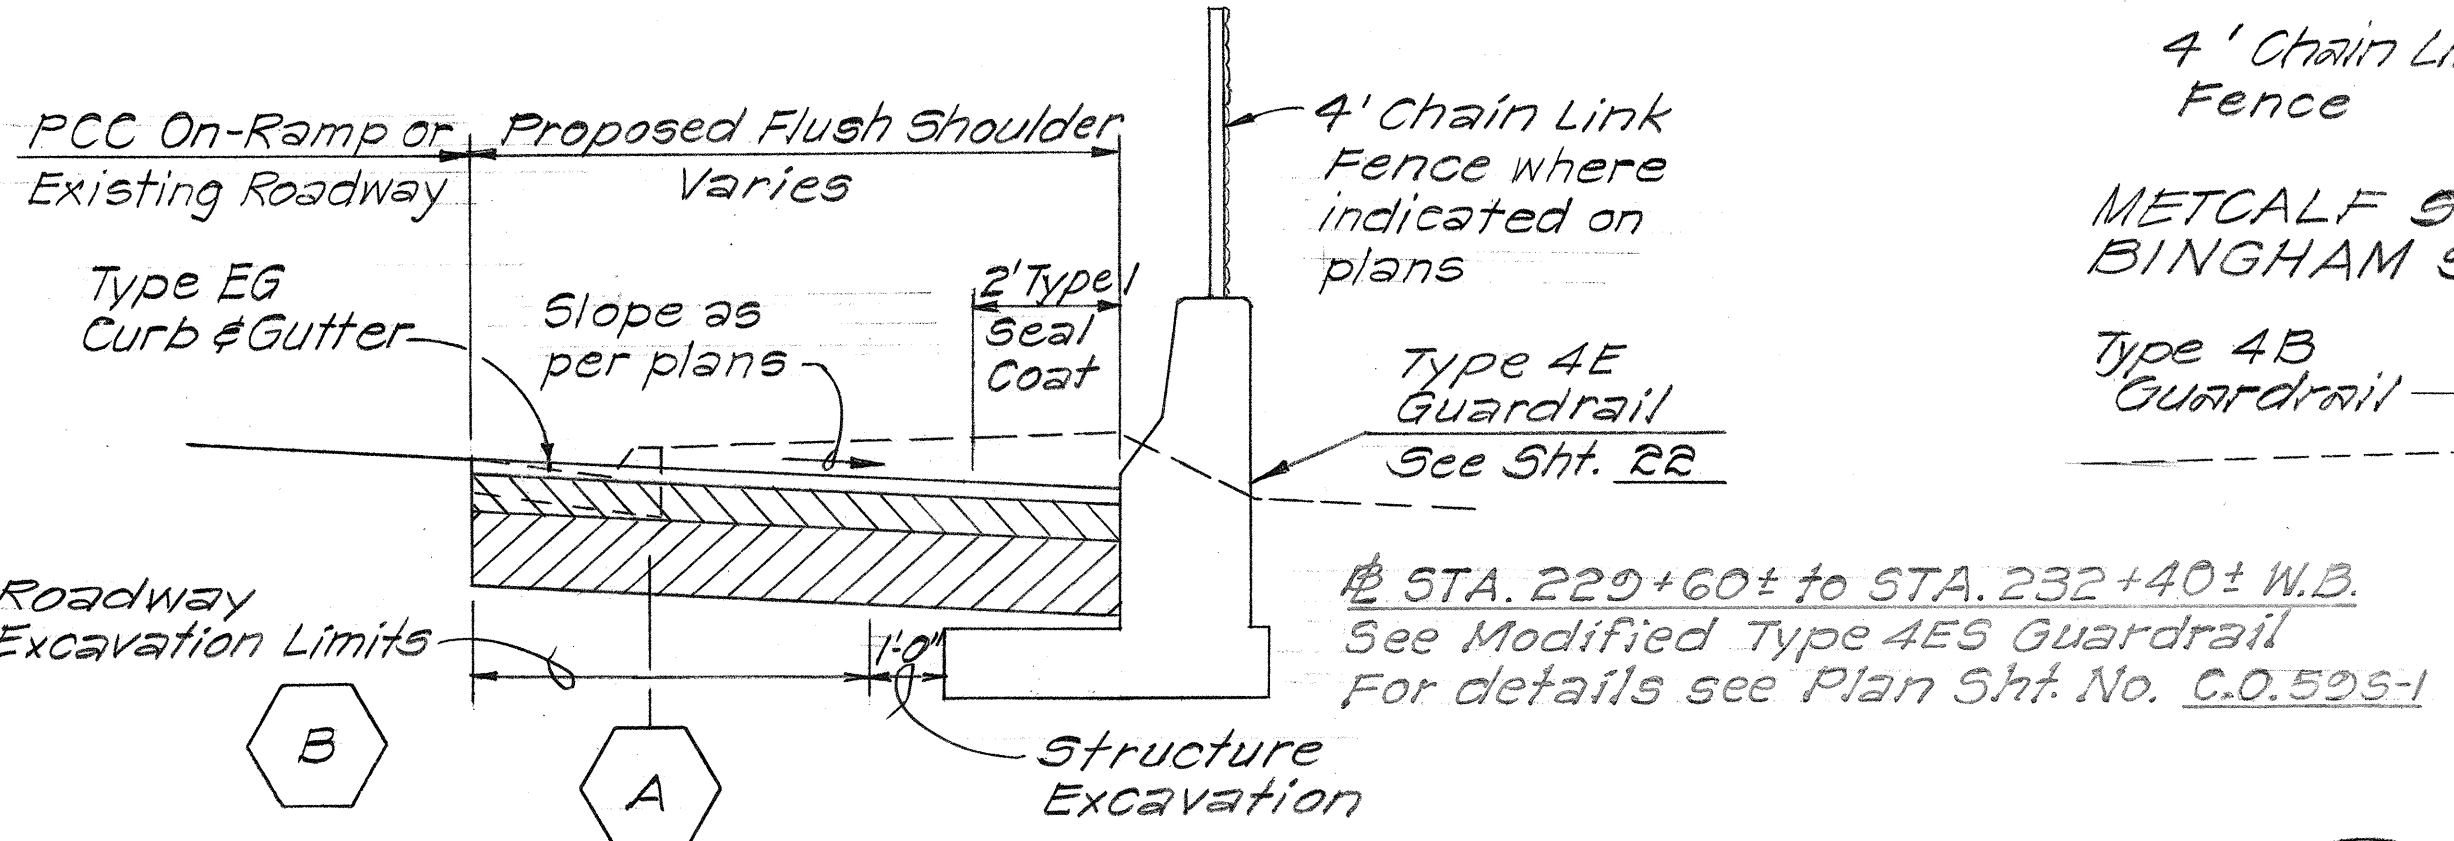




TS-4 # STA. 228+96± to STA. 235+00± E.B.
 # STA. 229+59± to STA. 236+19± W.B.
 # STA. 250+25± to STA. 255+75± W.B.
 # STA. 263+00± to STA. 264+28± W.B.

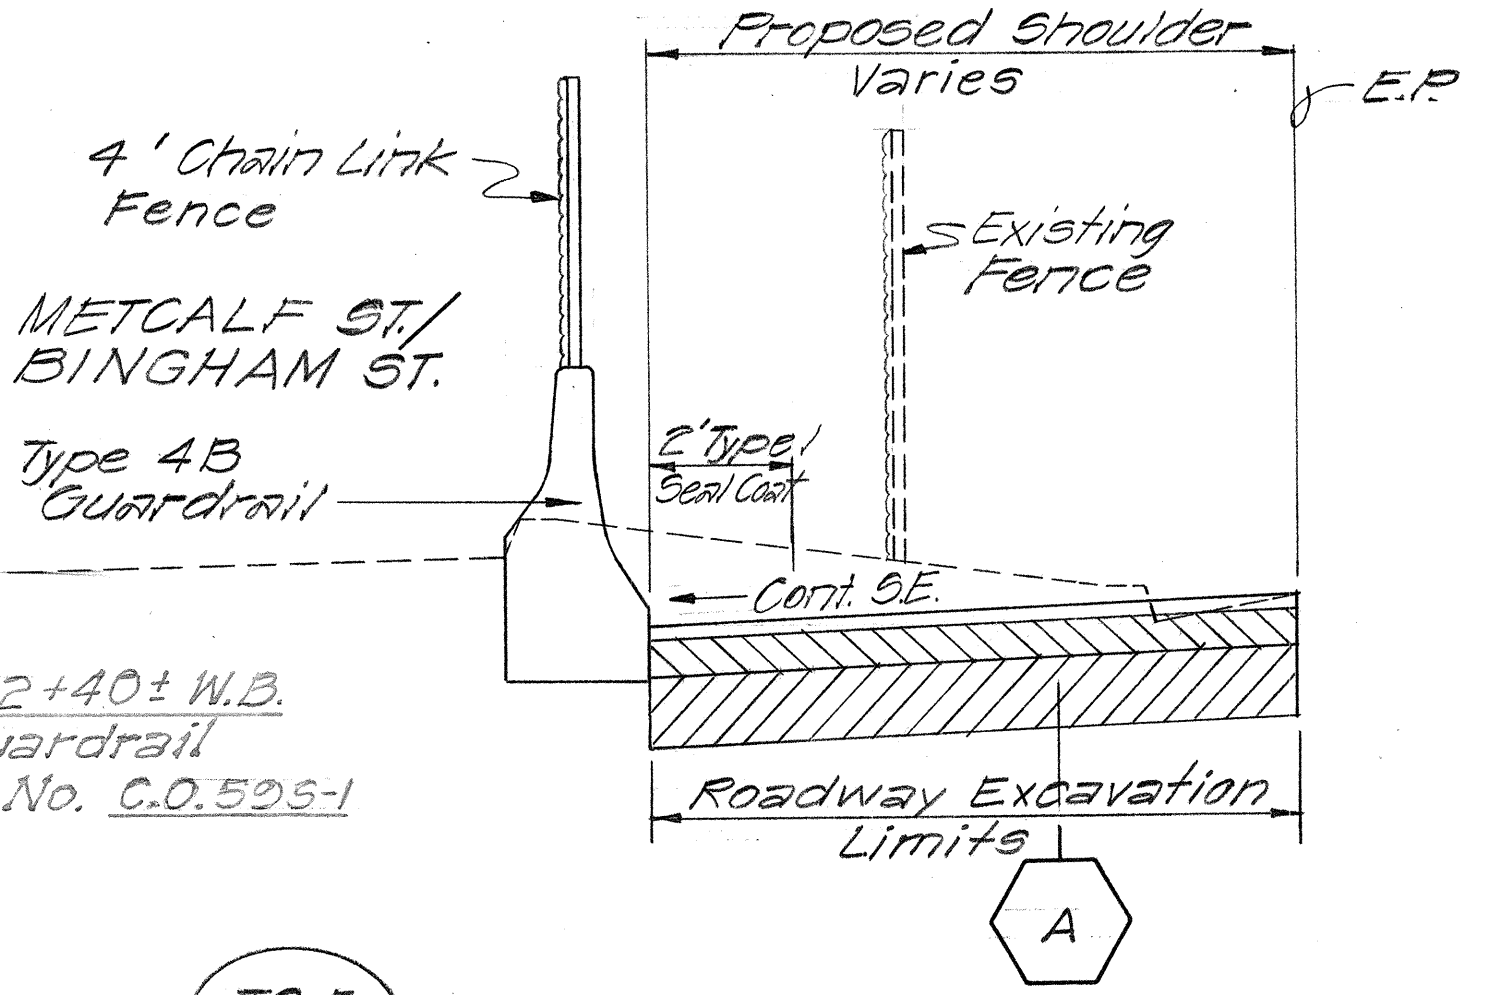

TS-5 # STA. 255+72± to STA. 256+40± W.B.
 # STA. 257+65± to STA. 259+20± W.B.

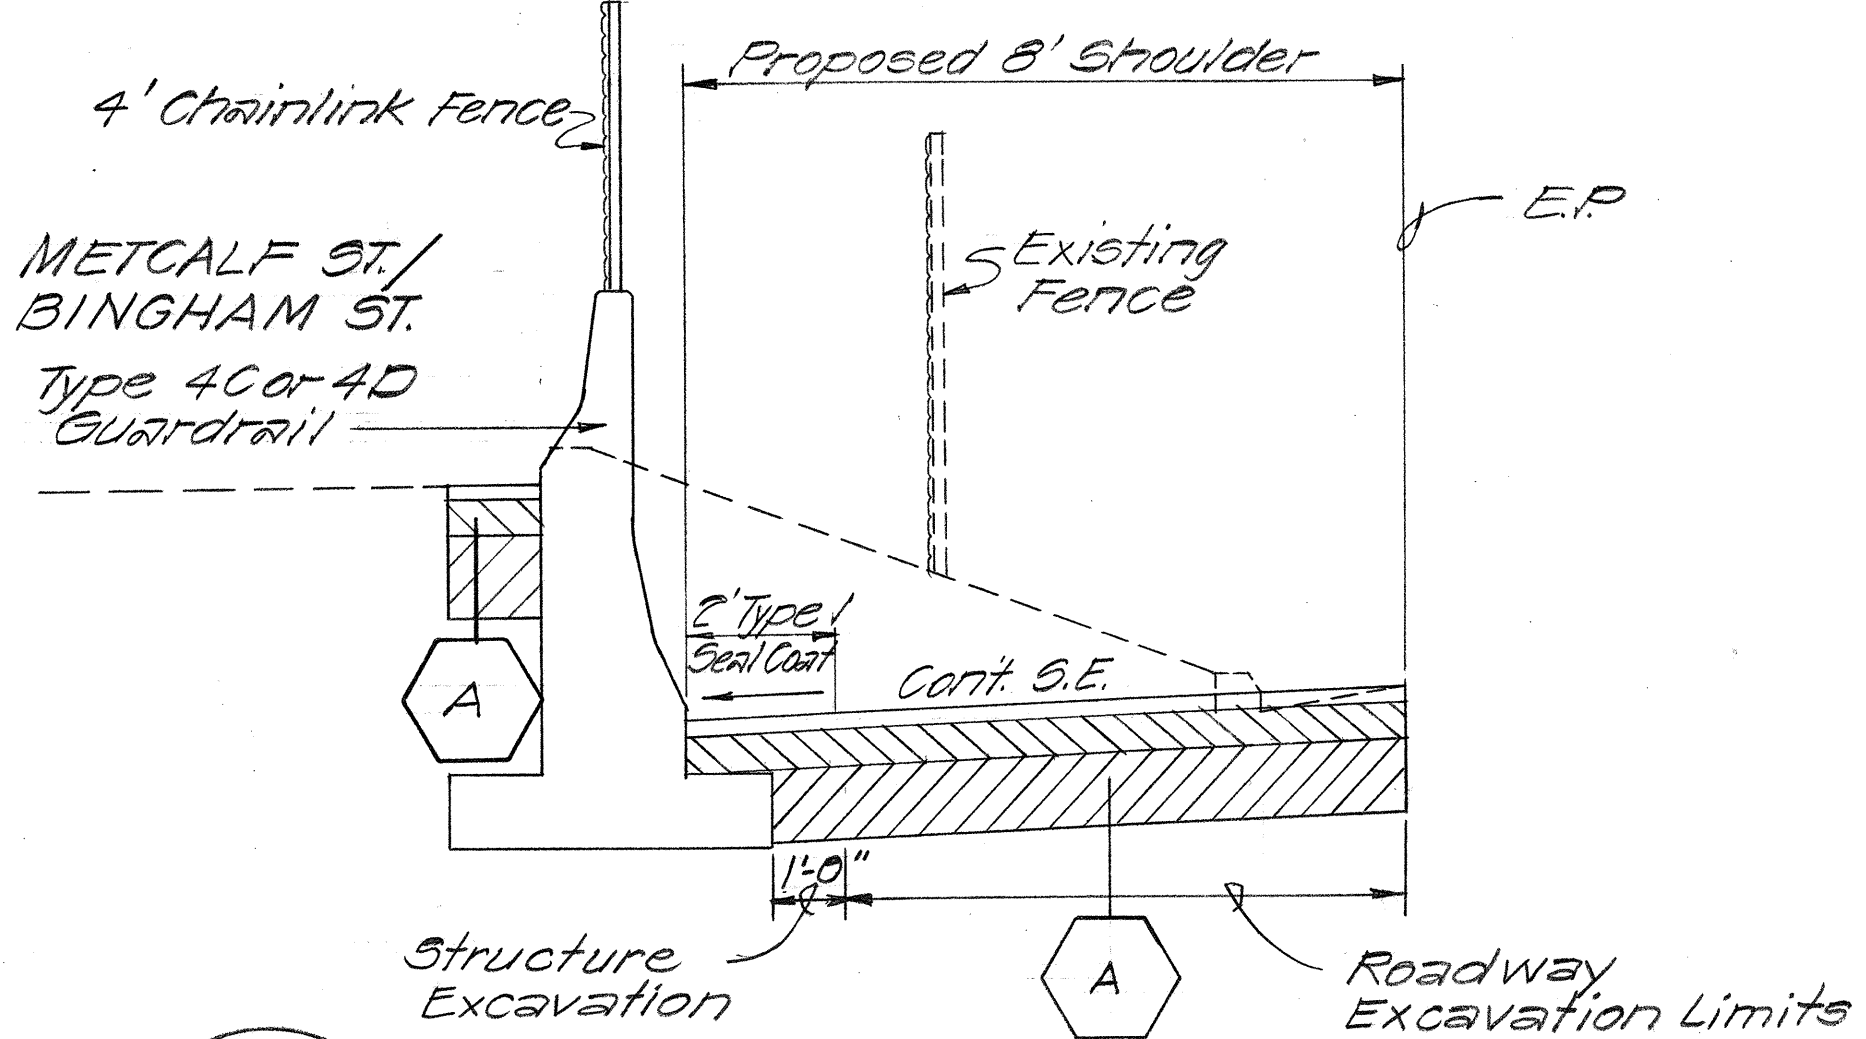

TS-6 # STA. 251+26± to STA. 251+55± E.B.
 # STA. 256+40± to STA. 257+65± W.B.
 # STA. 259+20± to STA. 263+00± W.B.

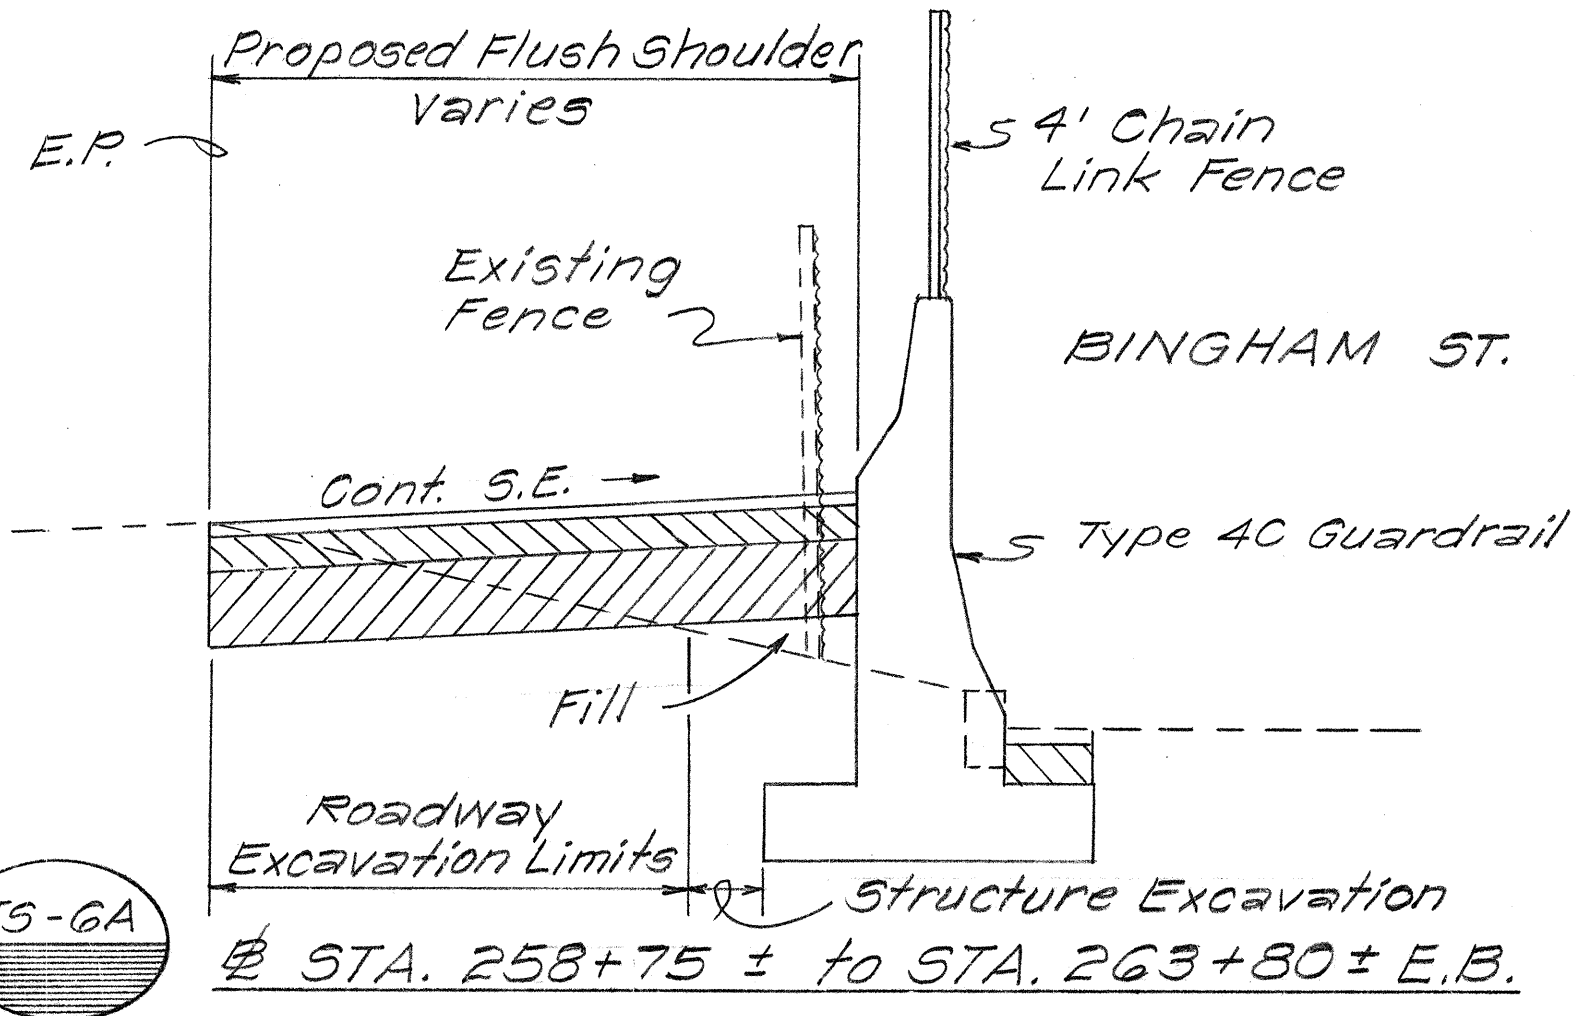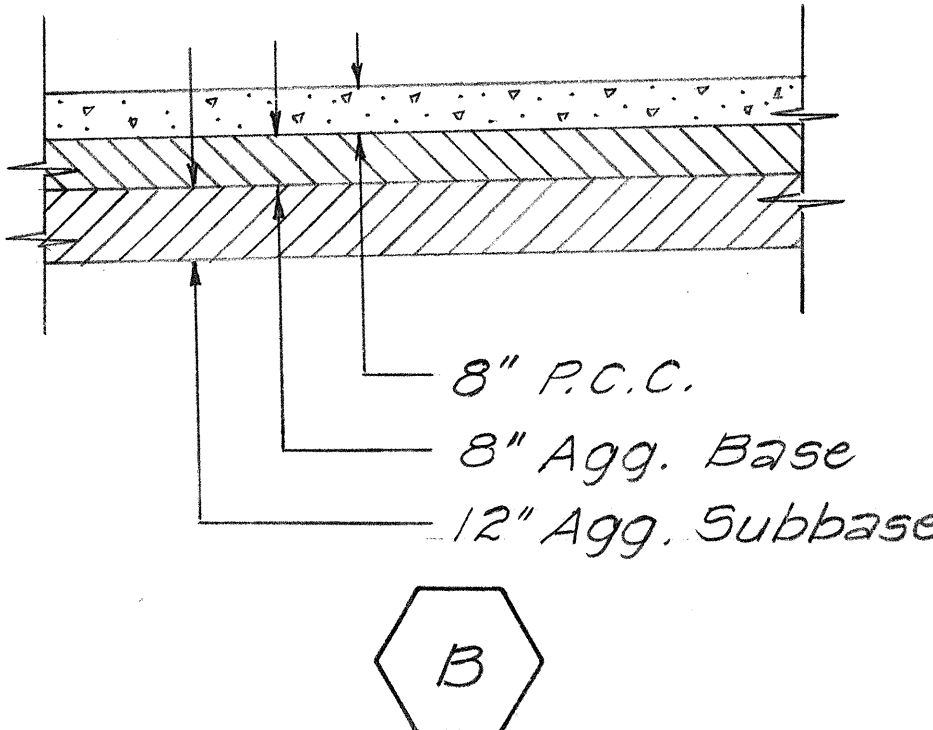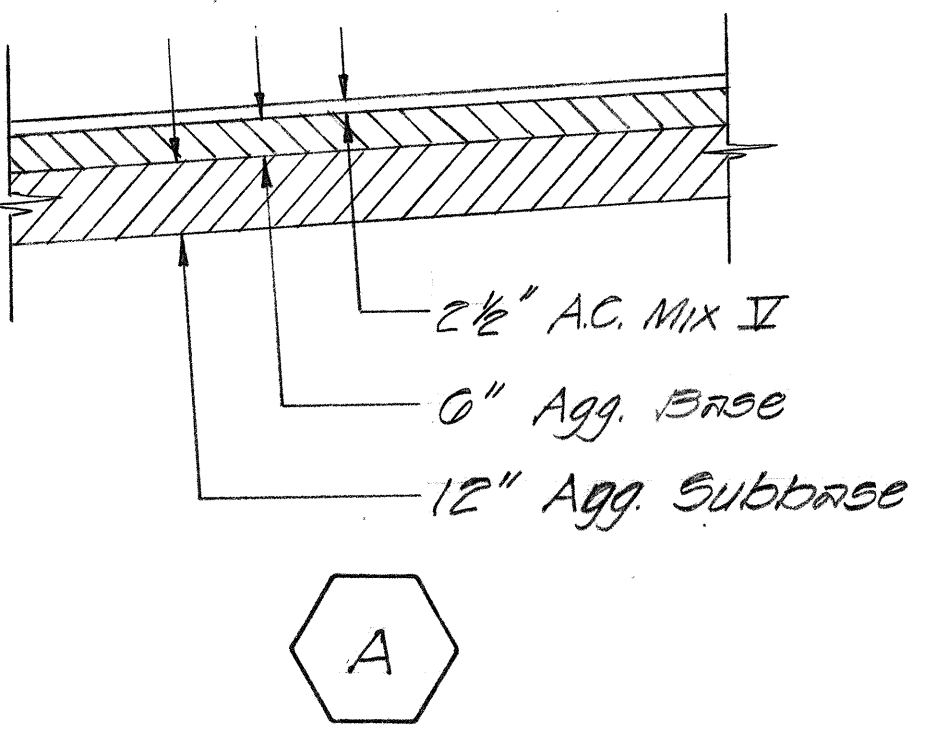

TS-6A # STA. 258+75± to STA. 263+80± E.B.

DATE	REVISION
11/24/76	Revised Pavement Design for Section, per Addendum No. 1
11/24/76	Revised all 3' high chain link fence to 4', per Addendum No. 1

STATE OF HAWAII
 DEPARTMENT OF TRANSPORTATION
 HIGHWAYS DIVISION


TYPICAL SECTIONS

F.A.I. Proj. No. I-HI-1(60):23


Scale: 3/8" = 1'-0" Date: Sept. 1976

SHEET NO. 1 OF 3 SHEETS


FED. ROAD DIST. NO.	STATE	FED. AID PROJ. NO.	FISCAL YEAR	SHEET NO.	TOTAL SHEETS
HAWAII	HAW.	I-HI-1(60):23	1976	3	181

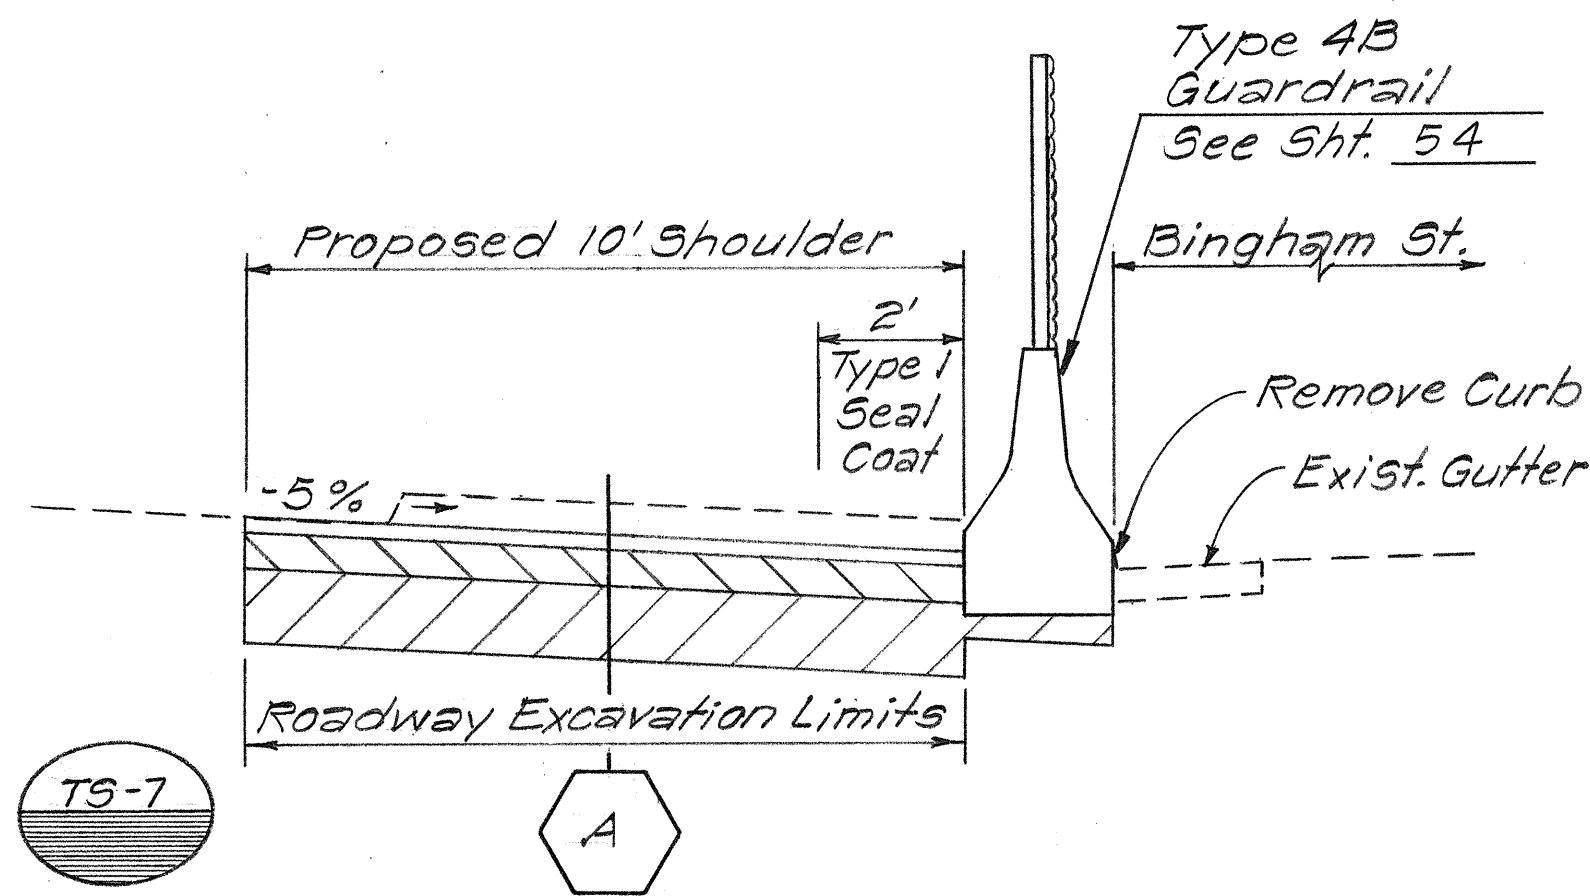


STA. 251+55± to STA. 258+75± E.B.
 # STA. 263+80± to STA. 264+13± E.B.
 # STA. 265+36± to STA. 267+82± E.B.
 # STA. 268+97± to STA. 281+55± E.B.

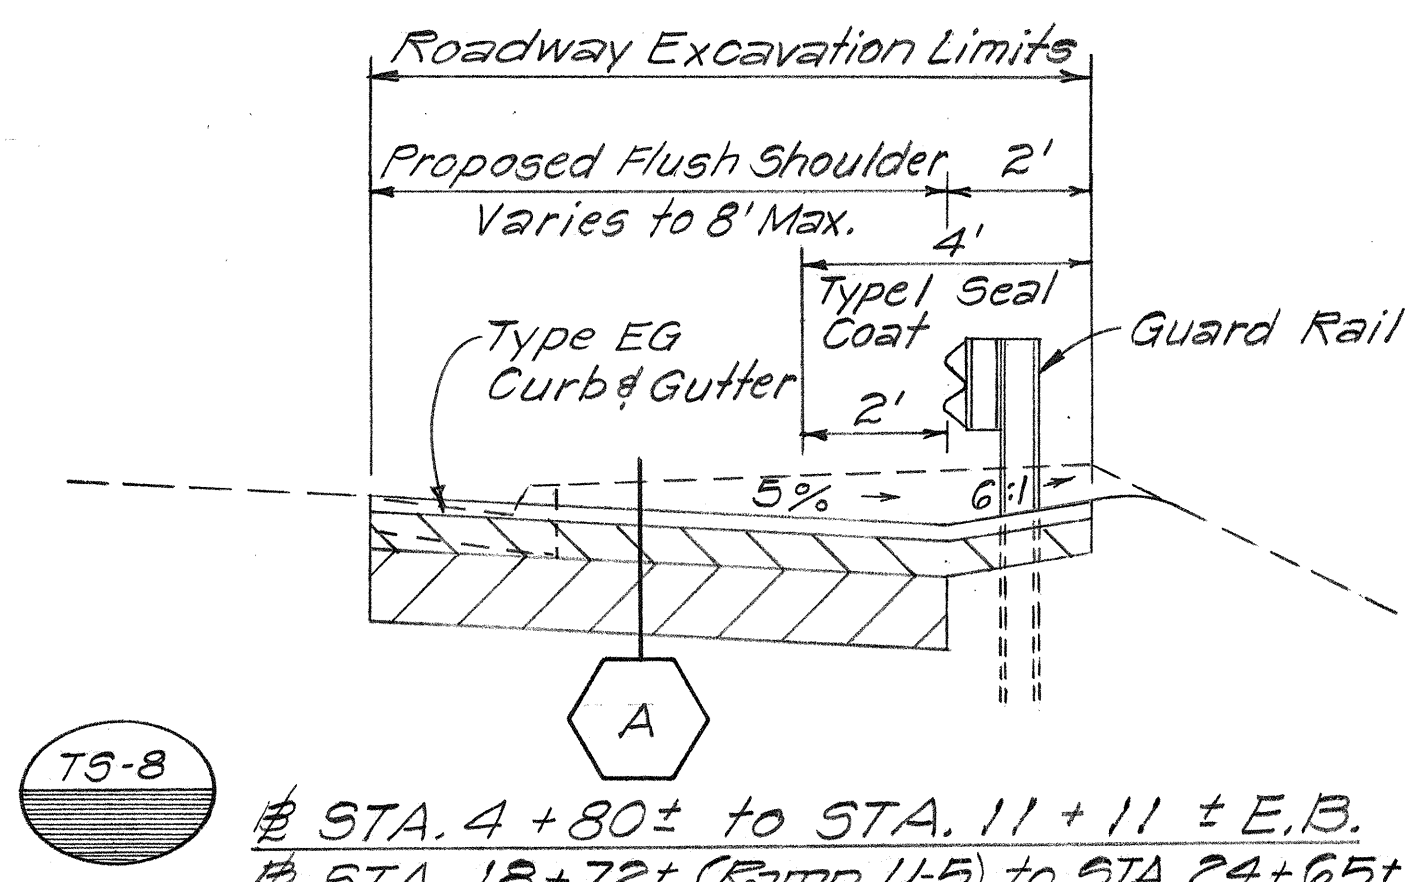


STA. 4+80± to STA. 11+11± E.B.
 # STA. 18+72± (Ramp U-5) to STA. 24+65± W.B.
 # STA. 20+26± to STA. 22+80± E.B.
 # STA. 25+10± to STA. 25+79± W.B.
 Ramp "T" STA. 7+40± to STA. 12+26± W.B.

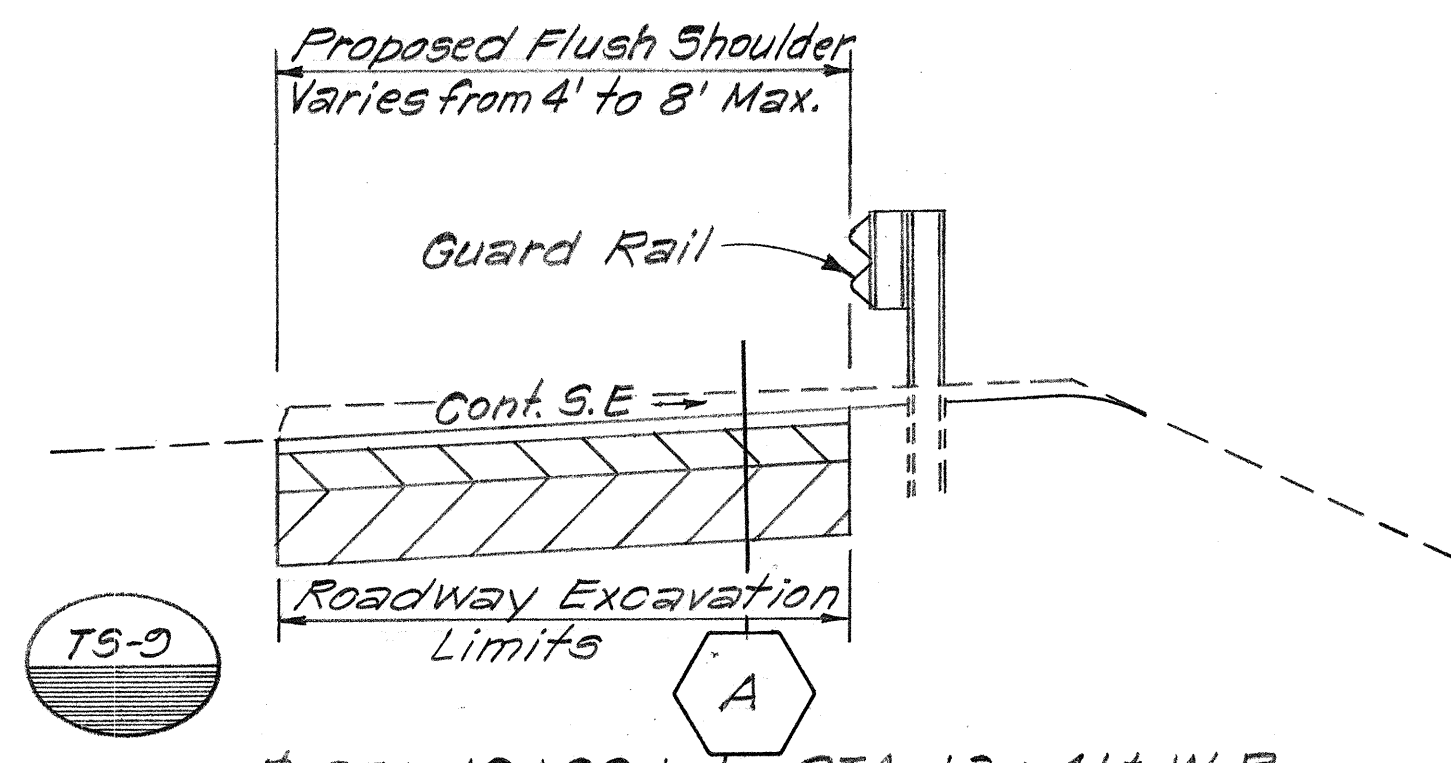


STA. 10+82± to STA. 13+41± W.B.
 # STA. 22+80± to STA. 24+65± E.B.
 # STA. 25+10± to RAMP "T-1" STA. 5+58± E.B.

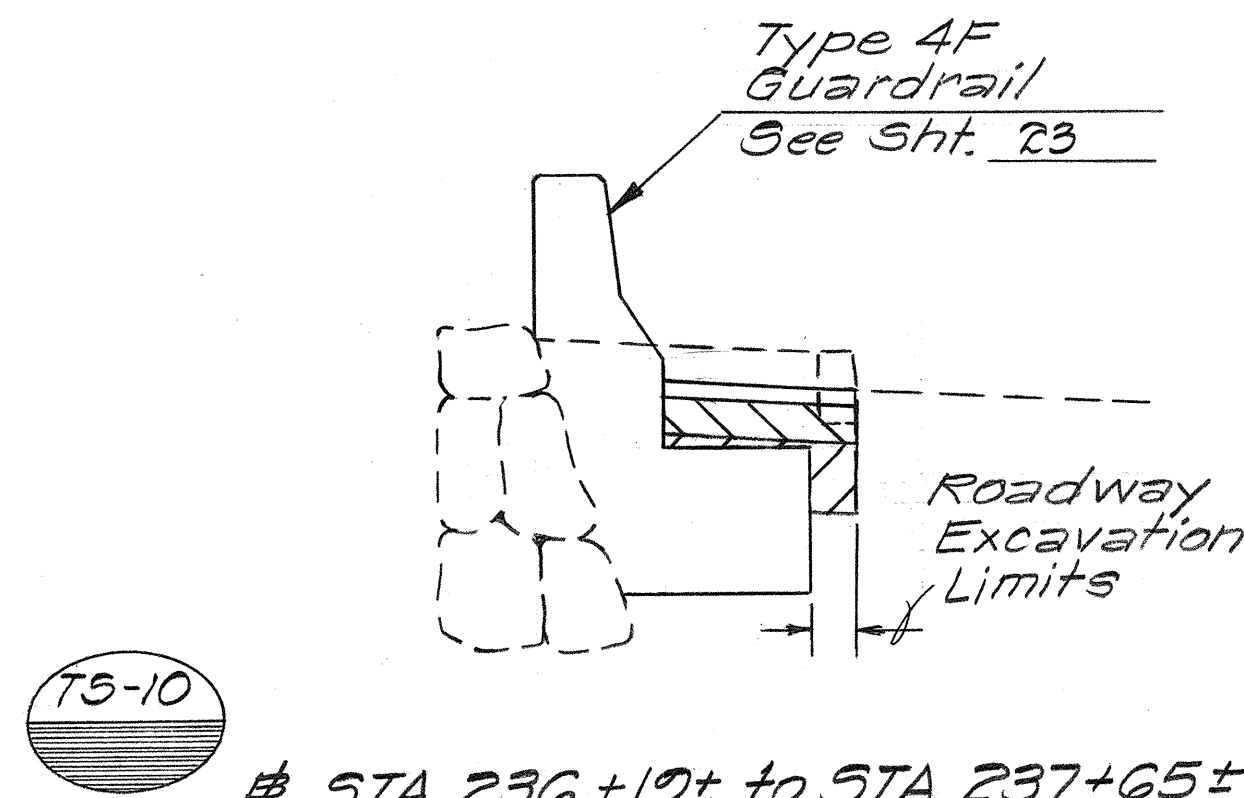


STA. 236+19± to STA. 237+65± W.B.
 # STA. 238+89± to STA. 239+27± W.B.
 # STA. 239+54± to STA. 240+78± W.B.

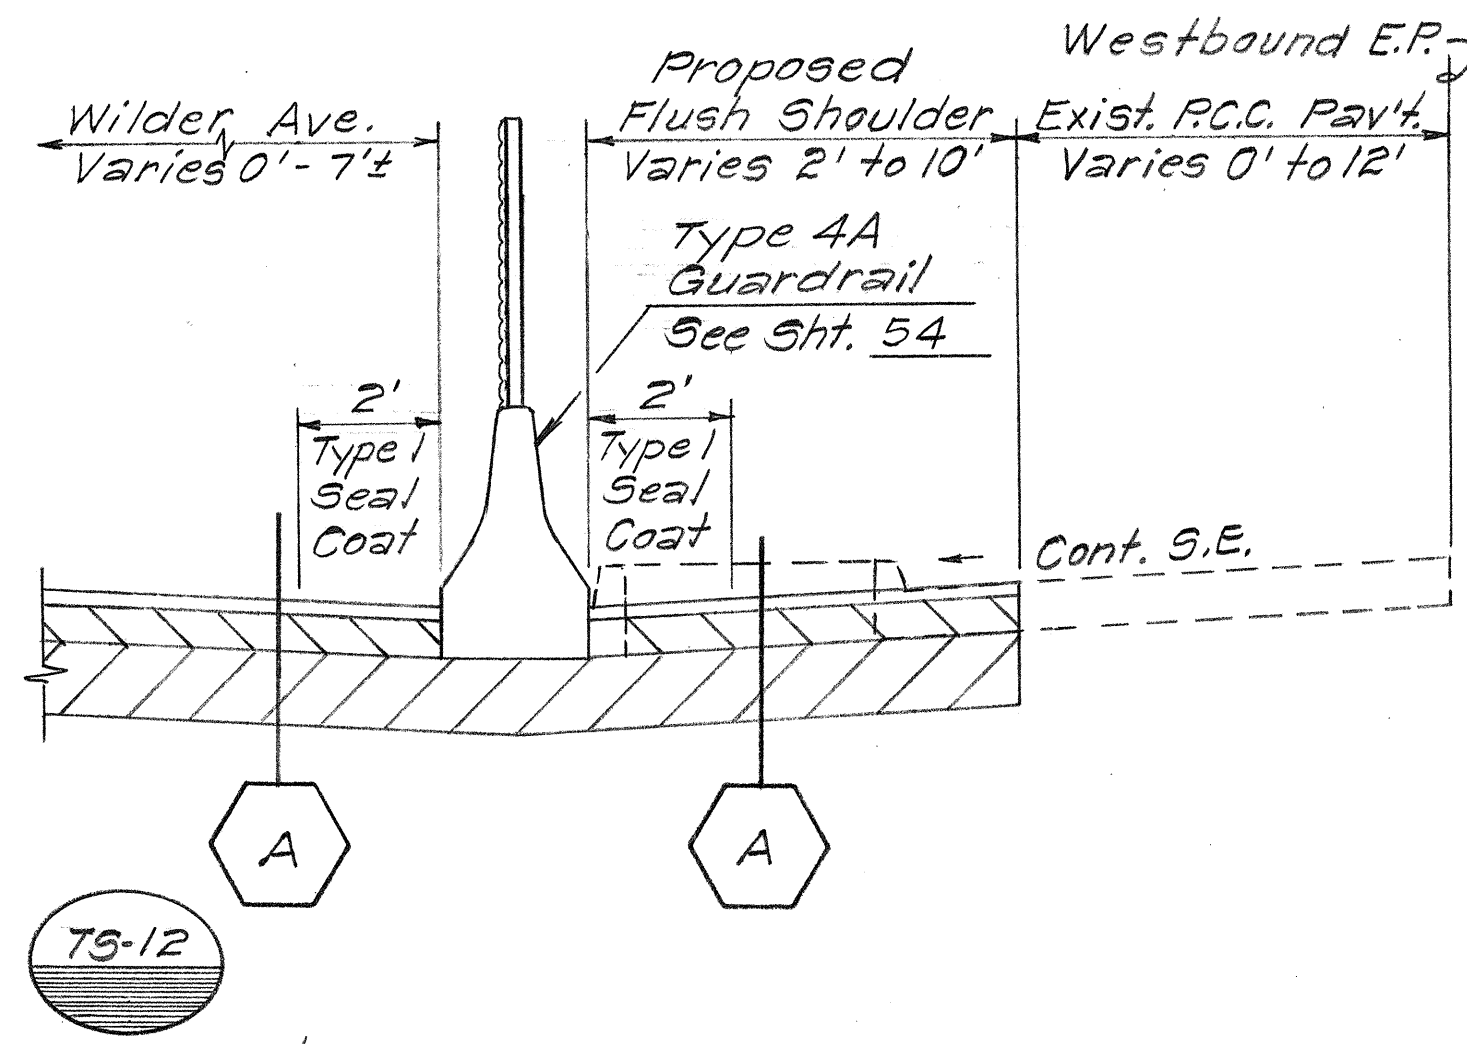



STA. 4+17± to STA. 10+82± W.B.

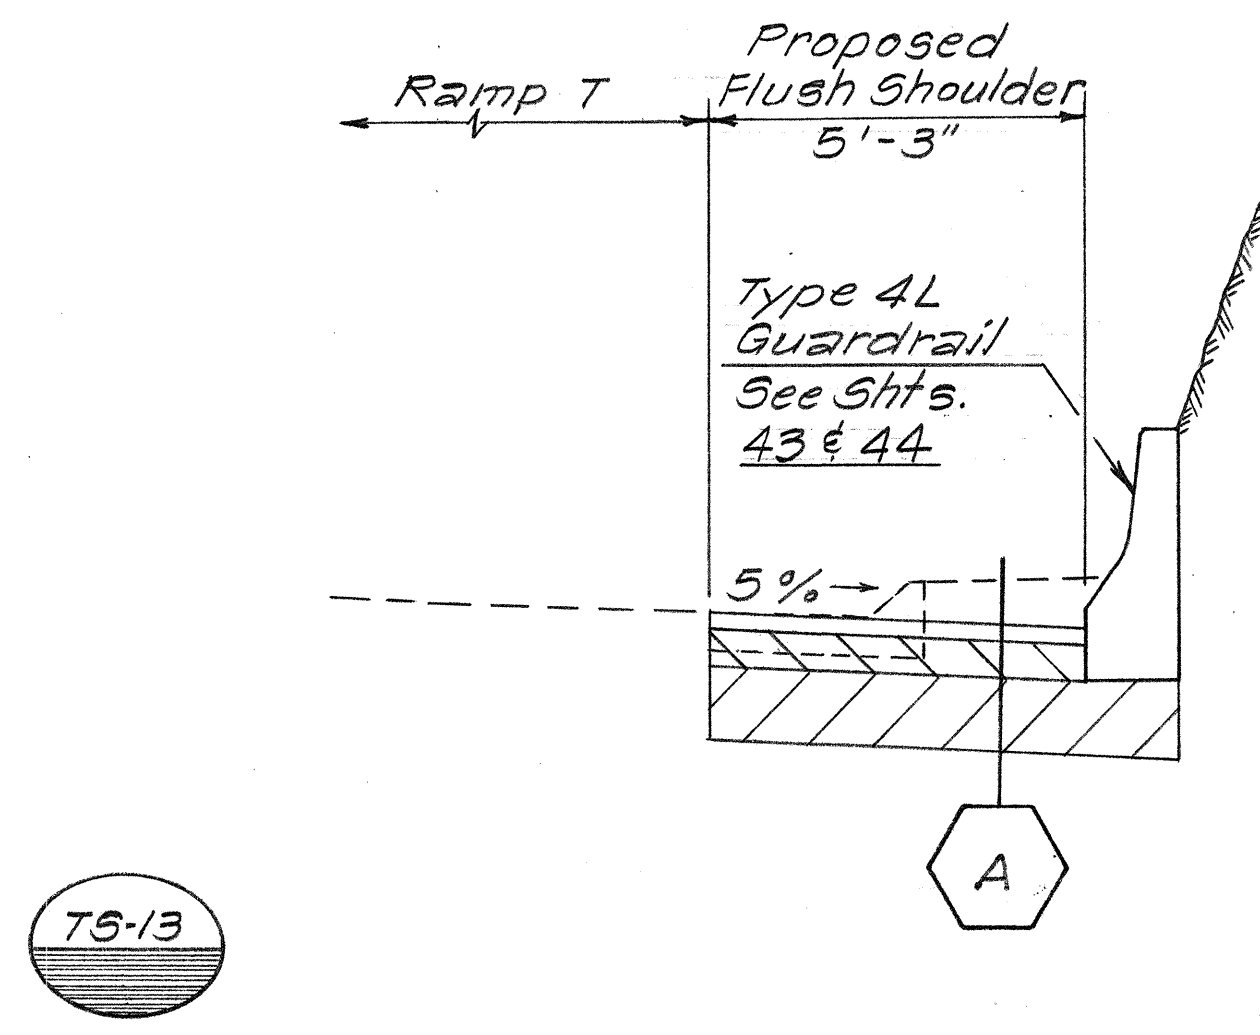


RAMP "T-1" STA. 5+58± to STA. 9+43± E.B.

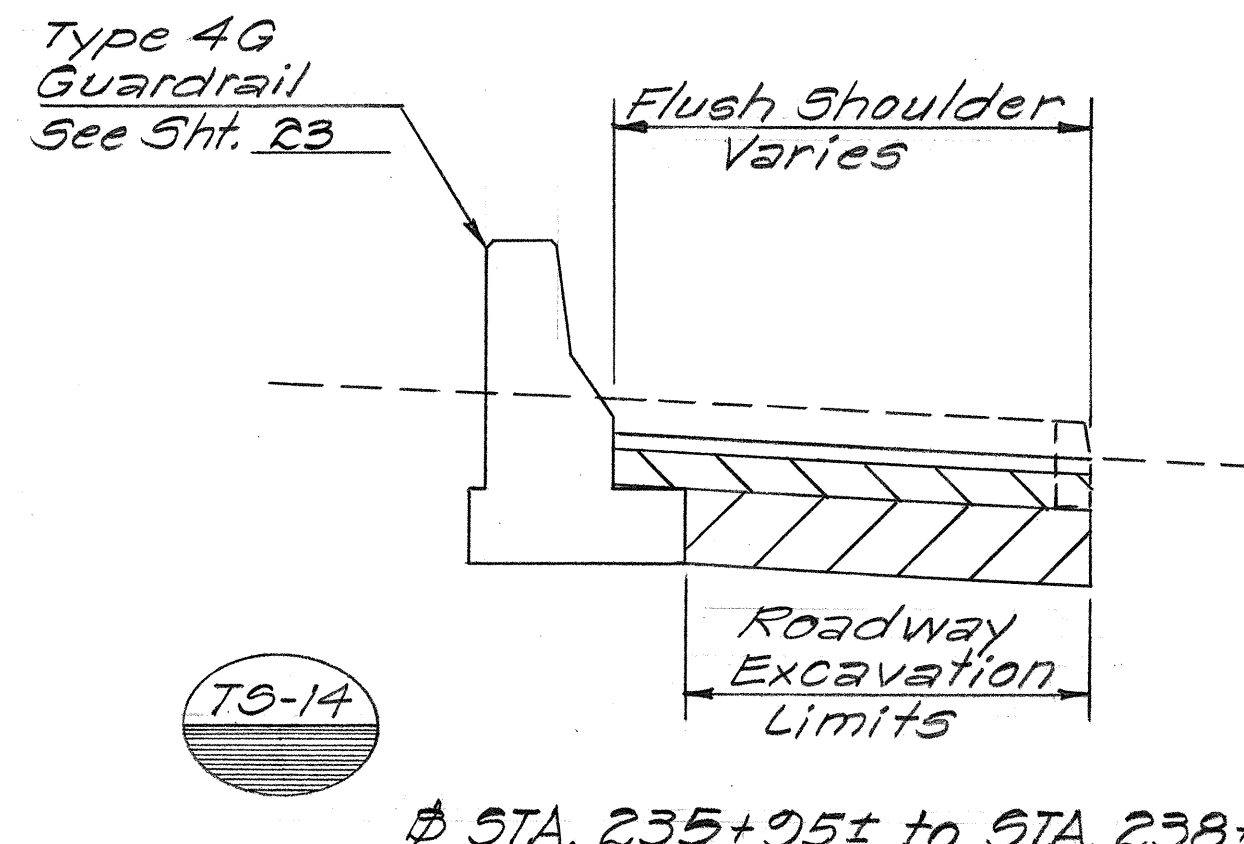

STA. 235+95± to STA. 238+55± E.B.
 # STA. 237+65± to STA. 238+89± W.B.
 # STA. 239+38± to STA. 239+65± E.B.
 # STA. 264+28± to STA. 275+00± W.B.
 # STA. 264+13± to STA. 265+30± E.B.

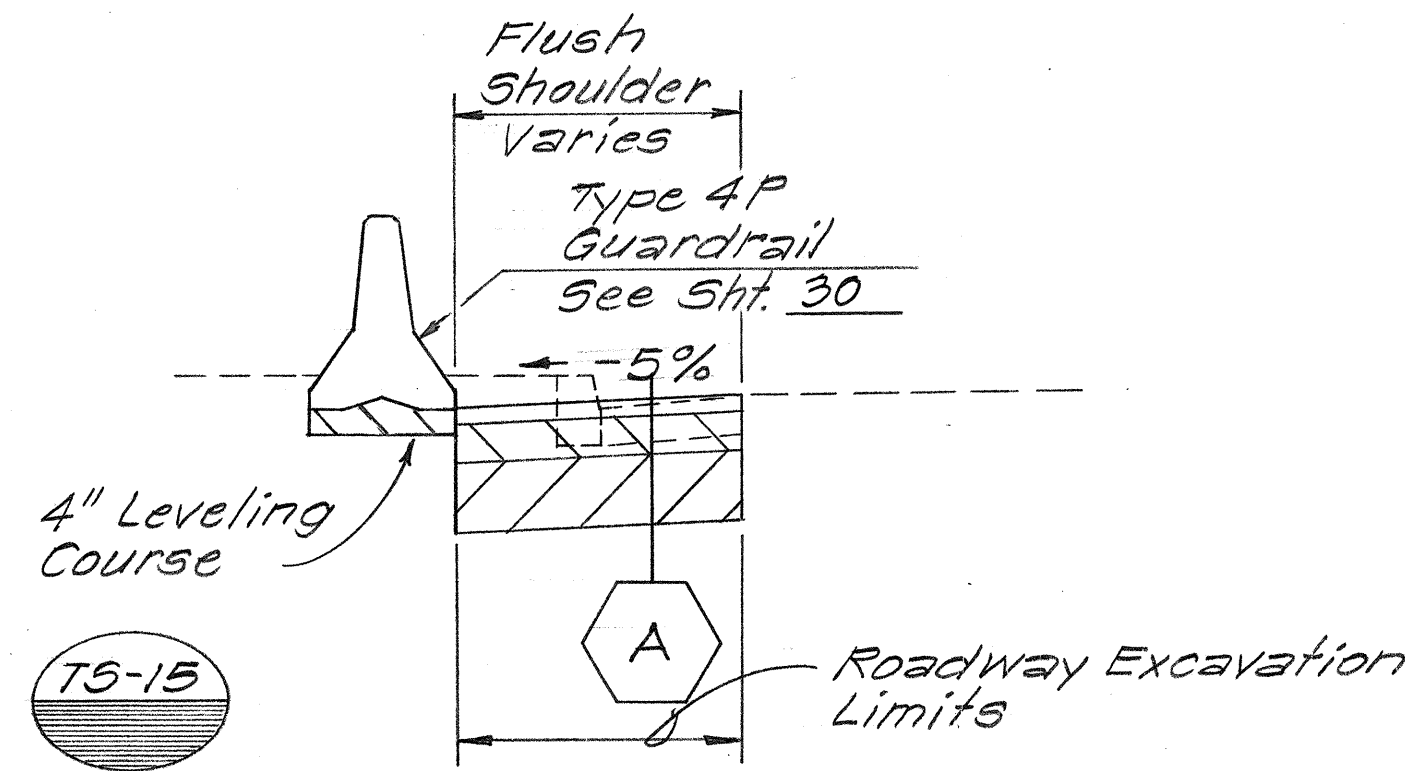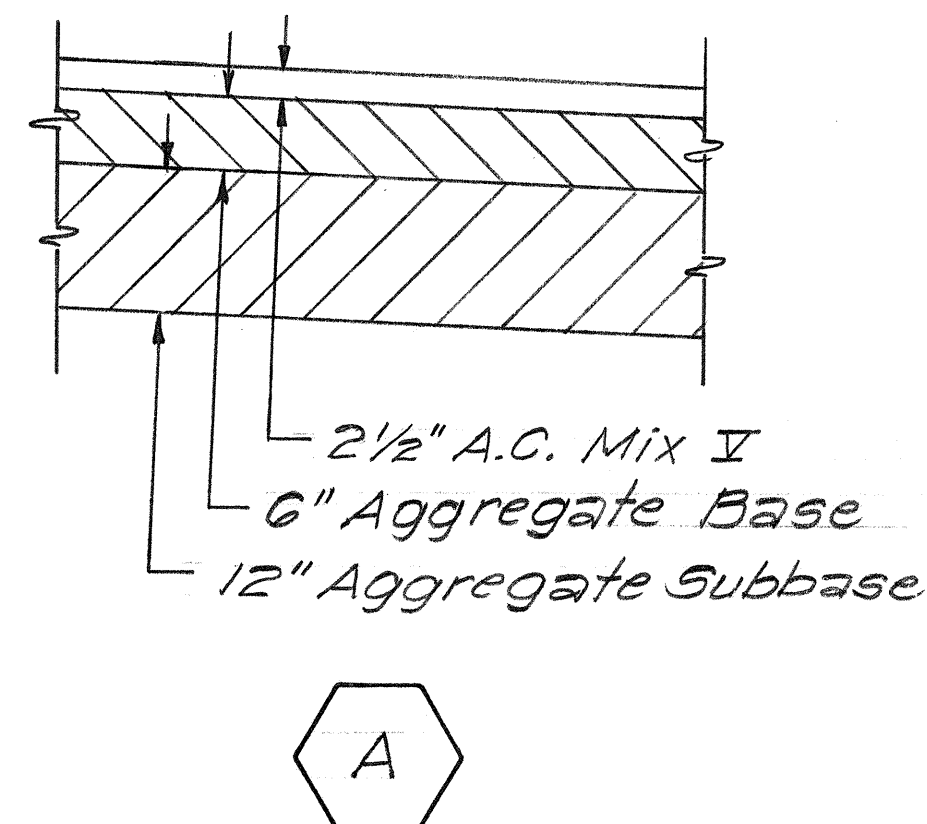

STA. 280+25± to STA. 280+73± W.B.
 # STA. 281+55± to EQ. STA. 3+73± E.B.
 # STA. 2+56± to STA. 2+95± W.B.
 # STA. 3+17± to STA. 4+17± W.B.

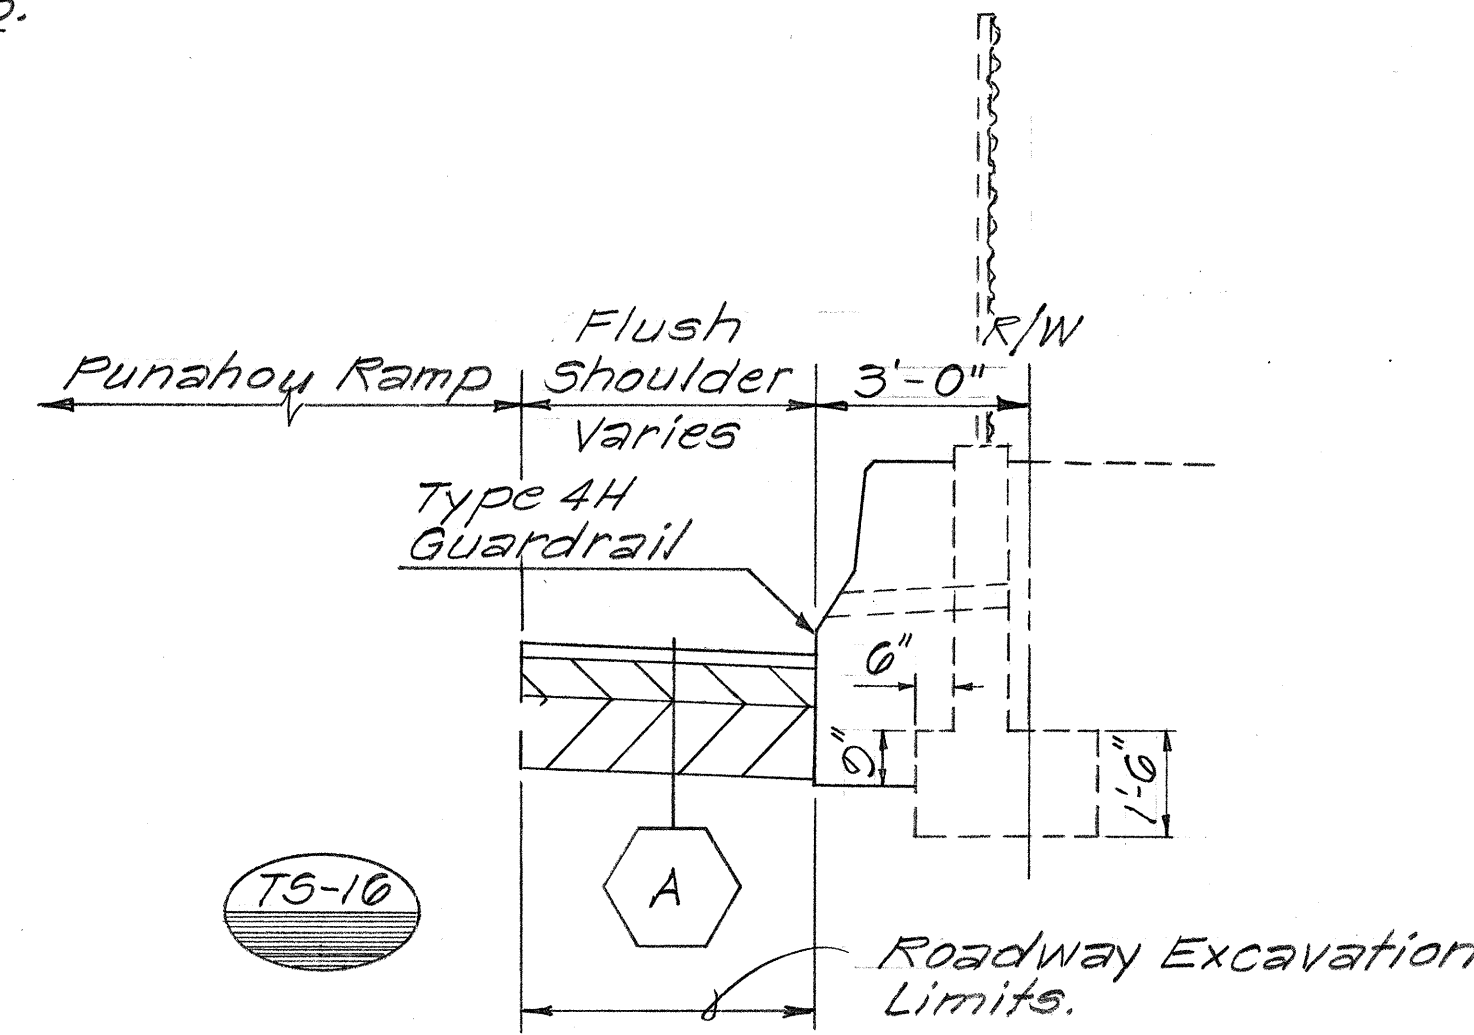

STA. 238+55± to STA. 239+11± E.B.

11/24/76	Revised all 3' high chain link fence to 4' per Addendum No. 1
DATE	REVISION

STATE OF HAWAII
DEPARTMENT OF TRANSPORTATION
HIGHWAYS DIVISION

TYPICAL SECTIONS

FAI. Proj. No. I-HI-1(60):23


Scale: 3/8" = 1'-0" Date: Sept. 1976

SHEET NO. 2 OF 3 SHEETS


ADD. 3R

SURVEY PLOTTED BY	DATE
DRAWN BY	
DESIGNED BY	
QUANTITIES BY	
CHECKED BY	
ORIGINAL PLAN	
NOTE BOOK	
NO.	


FED. ROAD DIST. NO.	STATE	FED. AID PROJ. NO.	FISCAL YEAR	SHEET NO.	TOTAL SHEETS
HAWAII	HAW.	I-HI-1(60):23	1976	494	181

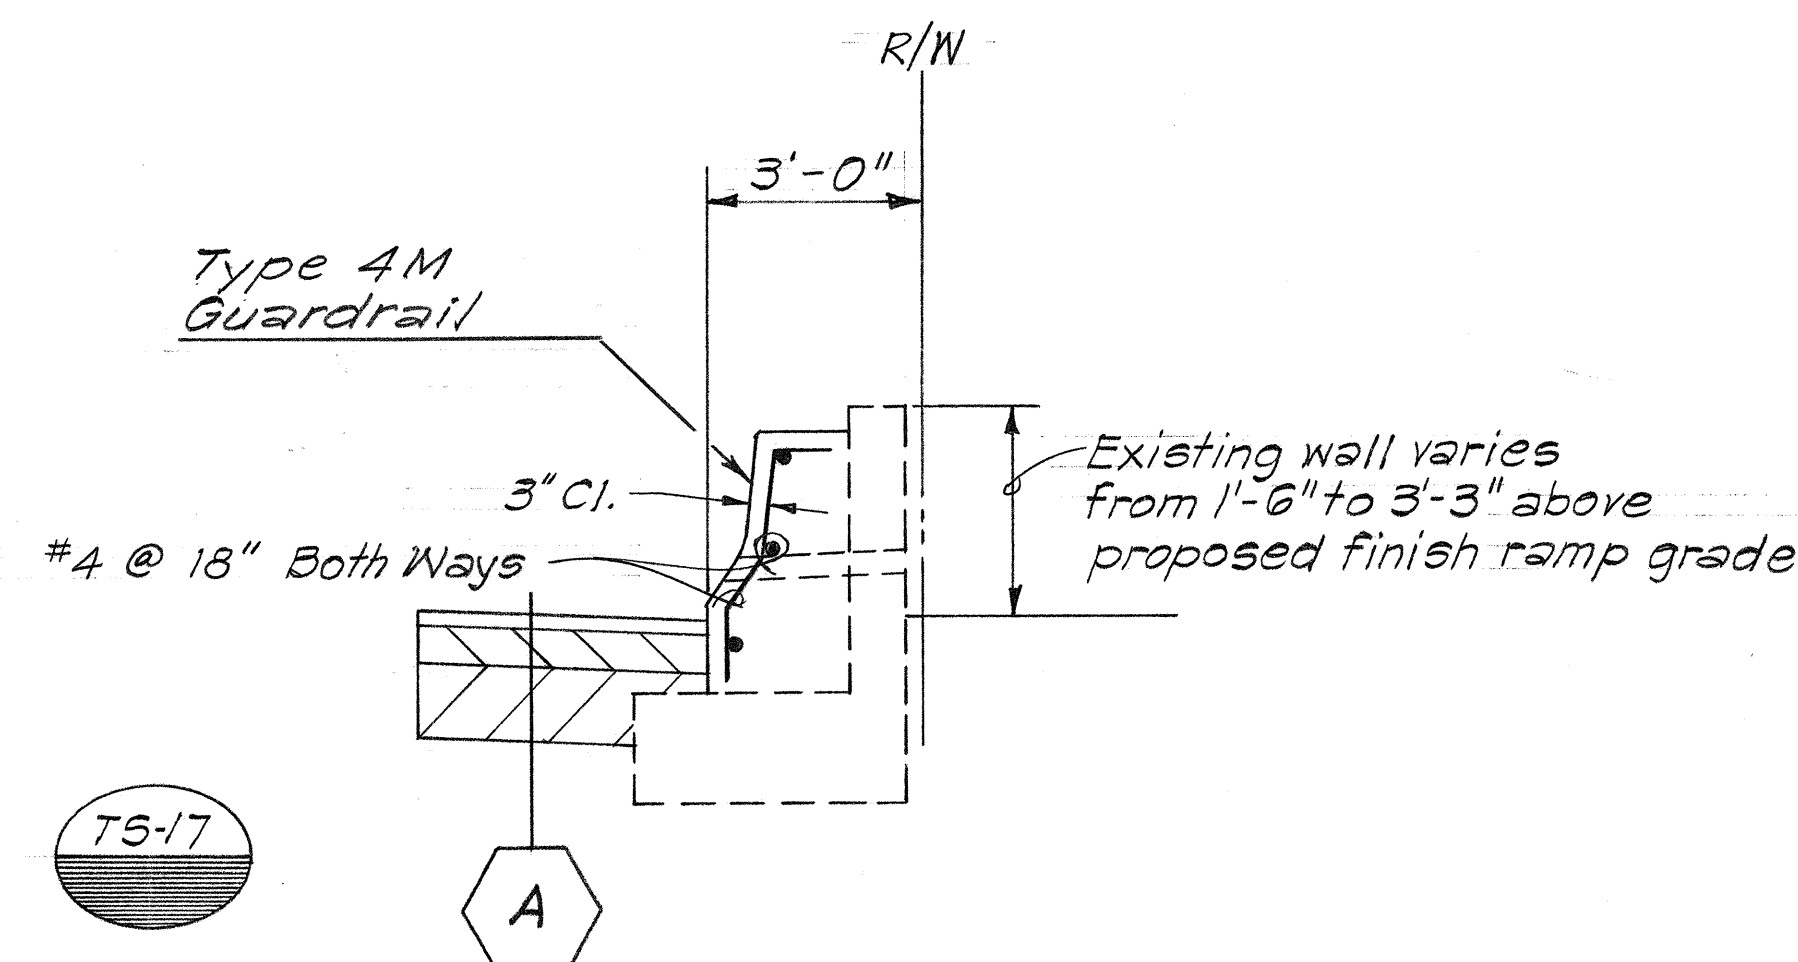


± STA. 235+00± to STA. 235+95± E.B.

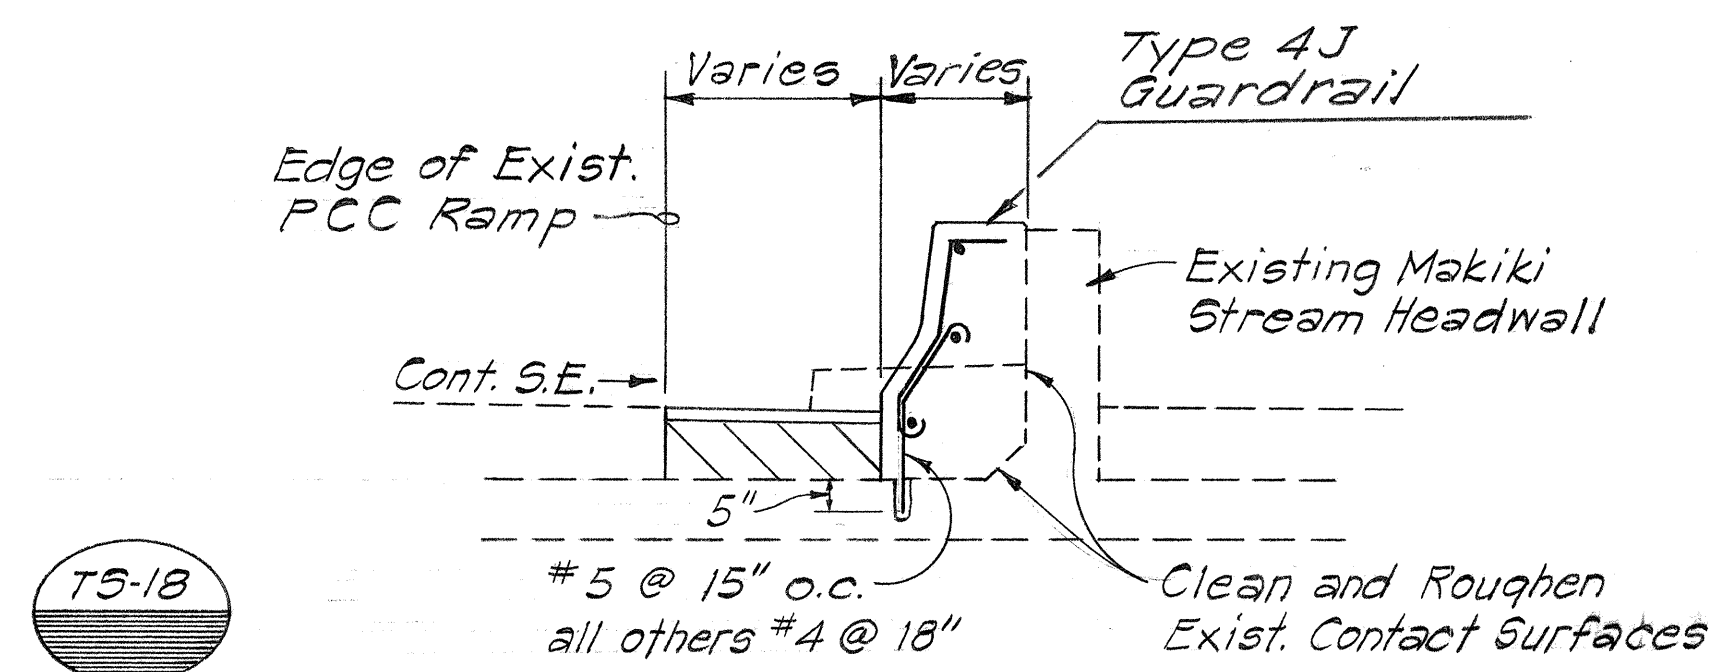


± STA. 239+11± to STA. 239+38± E.B.
± STA. 239+27± to STA. 239+54± W.B.

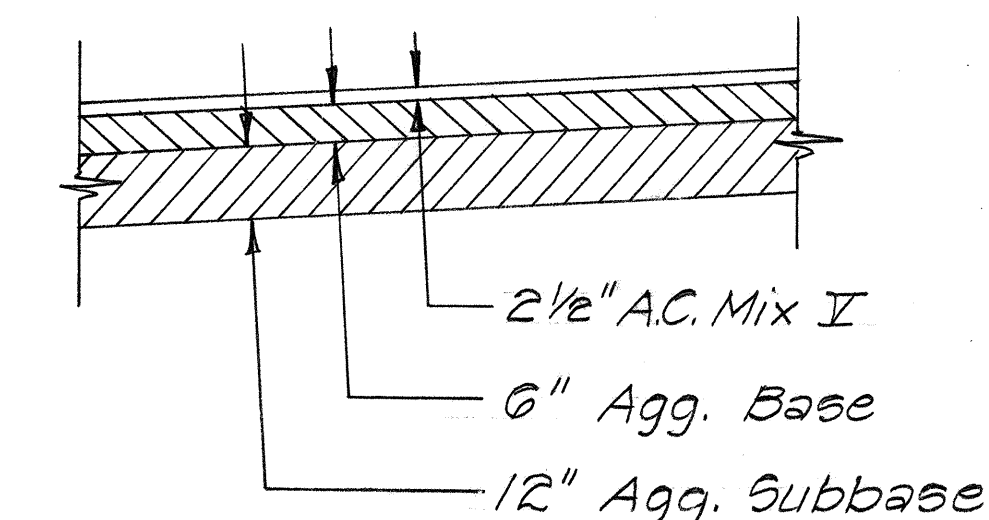


A

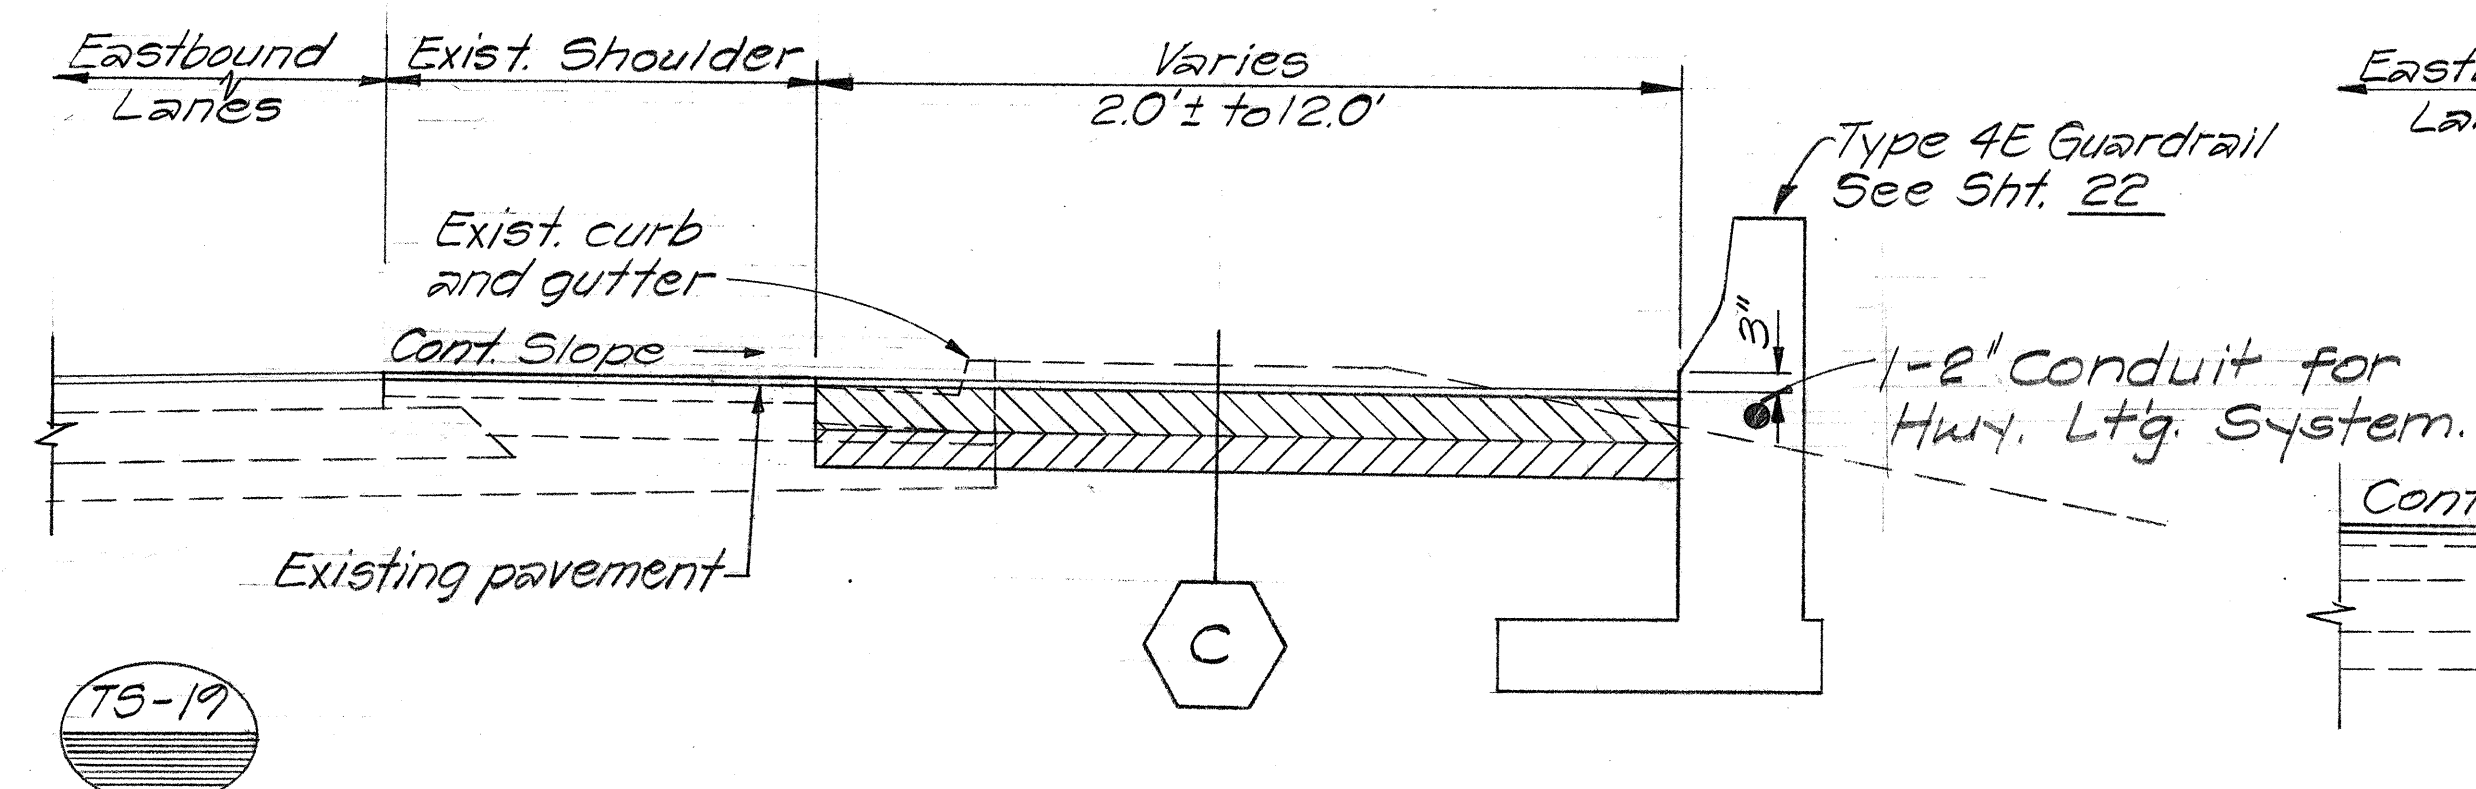

± STA. 167+73± to STA. 171+00 E.B.
± STA. 175+80 to STA. 176+92± E.B.

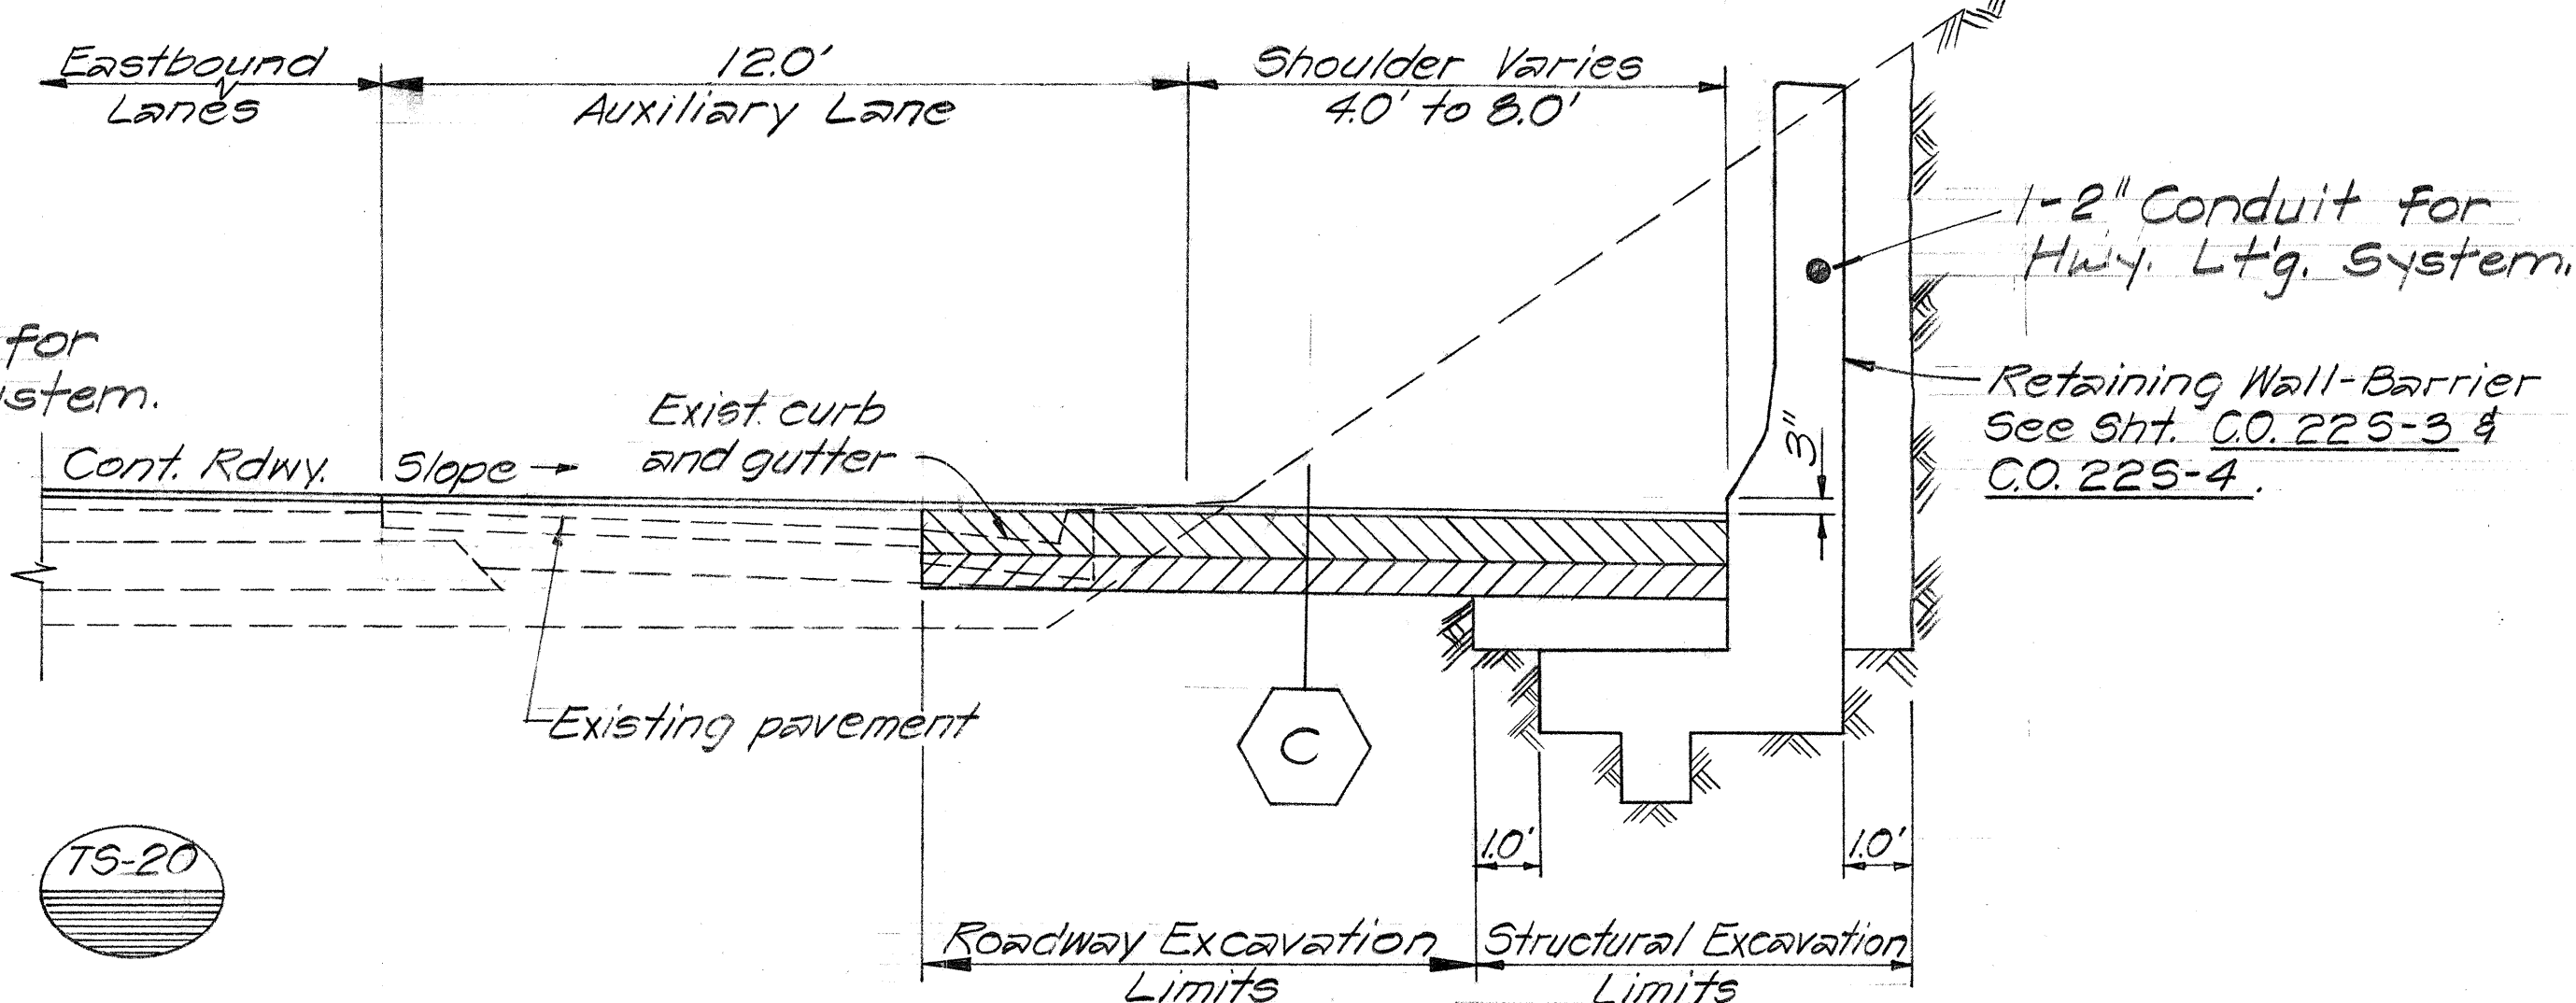

± STA. 171+00 to STA. 175+80 Rt. E.B.

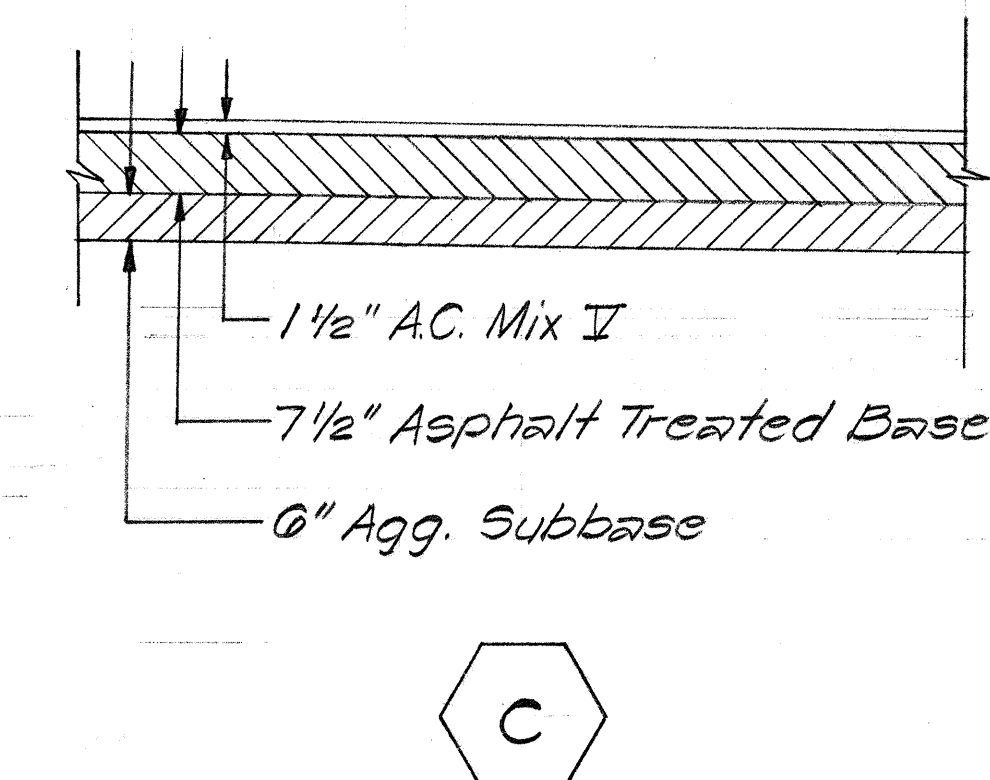

C

ORIGINAL PLAN	DATE
DRAWN BY	
DESIGNED BY	
QUANTITIES BY	
CHECKED BY	

1/5/78	Added Typical (TS-19), (TS-20) & Pavement Design C.
DATE	REVISION

STATE OF HAWAII DEPARTMENT OF TRANSPORTATION HIGHWAYS DIVISION
TYPICAL SECTIONS
F.A.I. Proj. No. I-HI-1(60): 23
Scale: 3/8"=1'-0" Date: Sept, 1976
SHEET No. 3 OF 3 SHEETS

C.O. 4