

FED. ROAD DIST. NO.	STATE	FED. AID PROJ. NO.	FISCAL YEAR	SHEET NO.	TOTAL SHEETS
HAWAII	HAW	I-HI(99)15	1977	158	350

GENERAL:

- ALL ELEVATIONS ARE BASED ON MEAN SEA LEVEL DATUM.
- UNLESS OTHERWISE SPECIFIED, ALL MATERIALS AND CONSTRUCTION OF WATER, SEWER AND GAS SYSTEM FACILITIES AND APPURTENANCES SHALL BE IN ACCORDANCE WITH THE STANDARD SPECIFICATIONS FOR ROAD AND BRIDGE CONSTRUCTION DATED 1976 AND ALL SUBSEQUENT AMENDMENTS AND ADDITIONS.
- THE CONTRACTOR SHALL NOTIFY THE AIR FORCE AND NAVY IN WRITING TWO (2) WEEKS PRIOR TO COMMENCEMENT ON UTILITIES WORK.
- DURING CONSTRUCTION, ALL UTILITY SERVICES SHALL BE MAINTAINED WITH THE LEAST AMOUNT OF DISTURBANCE TO EXISTING SERVICES.
- THE CONTRACTOR SHALL COORDINATE ALL UTILITIES RELOCATIONS WITH CONSTRUCTION AND PHASING OF DETOUR ROADS. THE CONTRACTOR SHALL ALSO COORDINATE ALL ADJACENT PROJECT CONTRACTORS AS TO WHEN THE UTILITIES SYSTEMS MAY BE PLACED IN OPERATION.
- WHERE PUMPING IS REQUIRED, THE CONTRACTOR SHALL POST A CUSTODIAN DURING THE ENTIRE PUMPING OPERATION. THE CUSTODIAN MUST HAVE A WORKING KNOWLEDGE OF THE PUMP USED.
- CARE SHALL BE EXERCISED IN THE INSTALLATION OF ALL UTILITIES TO PREVENT AS LITTLE DAMAGE OR INJURIES TO TREES AND SHRUBBERIES DESIGNATED ON THE PLANS TO REMAIN.
- THE EXISTENCE AND LOCATION OF UNDERGROUND UTILITIES APPURTENANCES AND STRUCTURES SHOWN ARE BASED ON AVAILABLE RECORDS VERIFIED WHENEVER POSSIBLE BY FIELD SURVEYS. THE CONTRACTOR SHALL VERIFY LOCATIONS AND INVERTS OF EXISTING LINES AND SHALL BE REQUIRED TO MAKE ADJUSTMENTS TO ANY NEW OR EXISTING SYSTEMS AS NECESSARY WITH THE APPROVAL OF THE ENGINEER, OR WHENEVER DIRECTED BY THE ENGINEER. THE CONTRACTOR SHALL NOT ASSUME THAT WHERE NO EXISTING UTILITIES ARE SHOWN, THAT NONE EXIST.
- CONTRACTOR SHALL BE RESPONSIBLE AND PAY FOR ALL DAMAGES TO EXISTING UTILITIES.
- UNLESS OTHERWISE INDICATED, ALL EXISTING UTILITY LINES SHOWN ON THE DRAWINGS SHALL REMAIN.
- THE CONTRACTOR IS CAUTIONED THAT MILITARY ELEVATIONS AND BENCH MARKS ARE NOT BASED ON MEAN SEA LEVEL DATUM AND MUST BE ADJUSTED TO MATCH THE STATE HIGHWAY DIVISION BENCH MARKS SHOWN ON THE PLANS.
- WHERE REQUIRED, RESTORATION OF EXISTING PAVEMENTS AND IMPROVEMENTS DEMOLISHED BY UTILITY RELOCATION WORK SHALL BE INCIDENTAL TO THE VARIOUS CONTRACT ITEMS. RESTORATION SHALL BE TO ORIGINAL OR BETTER CONDITION.

SURVEY PLOTTED BY _____
 DATE _____
 DRAWN BY _____
 DESIGNED BY _____
 QUANTITIES BY _____
 CHECKED BY _____

 ORIGINAL PLAN _____
 NOTE BOOK _____
 NO. _____

WATER :

- THE CONTRACTOR SHALL PRESSURE TEST AND DISINFECT ALL NEW WATER SYSTEMS IN ACCORDANCE WITH THE SPECIFICATIONS AND SPECIAL PROVISIONS, AND IN THE PRESENCE OF THE ENGINEER, AND RESPECTIVE AIR FORCE AND NAVY INSPECTORS.
- THE CONTRACTOR SHALL PLUG THE ENDS OF ABANDONED WATER MAINS WITH CLASS "C" CONCRETE. PAYMENT FOR CLASS "C" CONCRETE USED AS PLUGS SHALL BE CONSIDERED INCIDENTAL TO THE VARIOUS CONTRACT ITEMS FOR THE WATER SYSTEM.
- CONCRETE IN REACTION AND TEST BLOCKS AND REINFORCED CONCRETE JACKET SHALL BE CLASS "B".
- WATER MAINS SHALL BE DUCTILE IRON, CAST IRON OR CONCRETE CYLINDER, CLASS 150 UNLESS OTHERWISE NOTED.
- ANY EXCAVATION WORK AROUND EXISTING WATER MAINS SHALL BE BY HAND ONLY.
- HECO AND HICO UTILITY POLES, HATCHES, MANHOLES, DUCTLINES AND SEWER MAINS AND APPURTENANCES SHALL HAVE A MINIMUM OF THREE (3) FEET CLEARANCE FROM WATER MAINS AND OTHER WATER SYSTEM APPURTENANCES. DUCTLINES, SEWER LINES, AND GAS LINES CROSSING WATER MAINS SHALL HAVE A MINIMUM OF 6" VERTICAL CLEARANCE.
- IN FILL AREAS WHERE THE COVER (FROM THE EXISTING GROUND) OVER THE NEW MAIN IS LESS THAN THREE (3) FEET, THE CONTRACTOR SHALL FIRST FILL AND COMPACT THE AREA (TO PROVIDE A MINIMUM OF THREE (3) FEET COVER) PRIOR TO TRENCHING FOR THE NEW MAIN.
- A.C. COUPLINGS AS ITEMIZED ON THE PLANS SHALL BE CONSIDERED INCIDENTAL AND INCLUDED IN THE PAYMENT FOR A.C. PIPES.
- ALL GATE VALVES, FIRE HYDRANTS AND OTHER APPURTENANCES INDICATED AS "RE LOCATED" ON THE PLANS SHALL BE REMOVED, CLEANED, PAINTED AND REINSTALLED AT THE NEW LOCATION BY THE CONTRACTOR UNLESS OTHERWISE SPECIFIED.
- ALL EXISTING WATER LINES SHALL BE ABANDONED IN PLACE UNLESS OTHERWISE NOTED. THE CONTRACTOR HAS THE OPTION OF EITHER PLUGGING OR REMOVING ABANDONED WATER LINES.
- DO NOT IMPRINT "BOARD OF WATER SUPPLY" ON THE CAST IRON COVER FOR TYPE III METER BOX.
- THE WATER SUPPLY INTO HICKAM AND WITHIN AIR FORCE WATER SYSTEMS WILL BE CUT OFF ONLY UNDER THE FOLLOWING CONDITIONS:
 - HICKAM SHALL BE GIVEN 2 WEEKS NOTICE PRIOR TO EACH WATER OUTAGE. IF THE PROPOSED WATER OUTAGE INTERFERES WITH CRITICAL MILITARY OPERATIONS, THE OUTAGE SHALL BE RESCHEDULED.
 - EACH WATER OUTAGE SHALL BE LIMITED TO 8 HOURS MAXIMUM. OUTAGES SHALL BE BETWEEN THE HOURS OF 9:30 P.M. AND 5:30 A.M.
 - NO AREA SHALL HAVE A WATER OUTAGE 2 CONSECUTIVE DAYS.
- MINIMUM CLEARANCES BETWEEN FIRE HYDRANTS AND UTILITY POLES OR LIGHT STANDARDS SHALL BE 3 FEET.
- CONNECTIONS TO NAVY WATER SYSTEMS:
 - THE CONTRACTOR SHALL NOTIFY THE NAVY PUBLIC WORKS CENTER (PWC) 2 WEEKS PRIOR TO CONDUCTING ANY WORK ON EXISTING NAVY WATER SYSTEMS.
 - THE CONTRACTOR SHALL OBTAIN PERMISSION FROM THE NAVY PWC PRIOR TO OPERATING ANY VALVES.
 - ONCE SERVICE HAS BEEN INTERRUPTED, THE CONTRACTOR SHALL WORK CONTINUOUSLY UNTIL THE CONNECTIONS HAVE BEEN COMPLETED AND SERVICE RESTORED.
 - CONNECTIONS SHALL BE MADE IN THE PRESENCE OF NAVY PWC INSPECTORS.

SEWER :

- THE UPPER THREE (3) FEET OF ABANDONED NAVY SEWER MANHOLES SHALL BE COMPLETELY REMOVED AND ALL MANHOLES SHALL BE FILLED WITH SAND.
- ALL EXISTING SEWER LINES TO BE ABANDONED UNLESS OTHERWISE NOTED. THE CONTRACTOR HAS THE OPTION OF EITHER PLUGGING OR REMOVING ABANDONED SEWER LINES.
- SEWER LINES SHALL BE CLASS III REINFORCED CONCRETE PIPES UNLESS OTHERWISE NOTED.
- 21-INCH SEWERS SHALL BE INSTALLED WITH CONTINUOUS CONCRETE CRADLE EXCEPT AT REINFORCED CONCRETE JACKET.

GAS :

- ALL TRENCH & STRUCTURAL EXCAVATION FOR THE RELOCATION OF THE GAS MAIN FACILITIES SHALL BE DONE BY THE CONTRACTOR. FURNISHING OF PIPE, FITTINGS, VALVES & APPURTENANCES AND THE INSTALLATION OF GAS MAIN FACILITIES SHALL BE THE RESPONSIBILITY OF GASCO, INC. THE CUTTING, PLUGGING, AND RECONNECTING OF LIVE GAS LINES SHALL BE DONE BY GASCO, INC. BOTH PARTIES SHALL MUTUALLY COORDINATE THE WORK TO MINIMIZE CONFLICTS AND DELAYS TO EITHER PARTY.
- ALL GAS LINES SHALL HAVE A MINIMUM OF 12" CLEARANCE FROM ANY STRUCTURE OR UTILITY. WHERE THE CLEARANCE IS LESS THAN 12", THE GAS LINE SHALL BE PROTECTED WITH A GASCO, INC. APPROVED INSULATED MATERIAL.
- THE GASCO, INC. GAS PIPE LINES IN THE PROJECT AREA ARE PLASTIC COATED AND CATHODICALLY PROTECTED. THE CONTRACTOR SHALL BE EXTREMELY CAREFUL WHEN WORKING NEAR THESE GAS PIPE LINES.
- THE CONTRACTOR SHALL CALL GASCO, INC. A MINIMUM OF 48 HOURS BEFORE STARTING EXCAVATION TO ARRANGE FOR FIELD LOCATION OF ALL EXISTING GAS PIPE LINES. THE TELEPHONE NUMBER IS 548-2126 DURING BUSINESS HOURS, AND 548-2123 AFTER HOURS.
- THE CONTRACTOR SHALL EXCAVATE AND BACKFILL AROUND GAS PIPE LINES IN THE PRESENCE OF A GASCO, INC. REPRESENTATIVE. ALL BACKFILL WITHIN SIX INCHES OF GAS PIPE LINE SHALL BE SELECT CUSHION MATERIAL APPROVED BY GASCO, INC.
- FOR RELOCATION OF ANY GAS PIPE LINE, THE CONTRACTOR SHALL NOTIFY GASCO, INC. FIVE WORKING DAYS BEFORE STARTING WORK. THE CONTRACTOR SHALL PROVIDE THE NECESSARY EXCAVATION AND BACKFILL, ARRANGE FOR TRAFFIC PERMITS AND RESTORE SIDEWALK PAVEMENT OR OTHER FACILITIES.
- THE CONTRACTOR SHALL NOTIFY GASCO, INC. IMMEDIATELY AFTER ANY DAMAGE HAS BEEN CAUSED TO EXISTING GAS PIPELINES. THEIR COATINGS OR THEIR CATHODIC PROTECTION DEVICES. REPAIR WORK ON THIS DAMAGE SHALL BE DONE BY GASCO, INC. WITH PAYMENT FOR THIS WORK TO BE BORNE BY THE CONTRACTOR.
- MINIMUM VERTICAL OR HORIZONTAL CLEARANCE BETWEEN GAS PIPE LINES AND OTHER PIPELINES, CONDUITS, OR DUCTLINES SHALL BE 12 INCHES. ADEQUATE SUPPORT AND PROTECTION FOR GAS PIPE LINES EXPOSED IN THE TRENCH SHALL BE PROVIDED. SUCH SUPPORT AND PROTECTION SHALL BE APPROVED BY GASCO, INC.
- THE CONTRACTOR SHALL WORK IN AN EXPEDITIOUS MANNER IN ORDER TO KEEP UNCOVERED GAS PIPE LINES EXPOSED FOR AS SHORT A PERIOD OF TIME AS POSSIBLE.
- CATHODIC PROTECTION DEVICES WILL BE FURNISHED AND INSTALLED BY GASCO.

12/13/76 WATER NOTES: REVISED NOTE 1 AND 12
ADDED NOTE 14
DATE _____
REVISION _____


STATE OF HAWAII
DEPARTMENT OF TRANSPORTATION
HIGHWAYS DIVISION

NIMITZ SPUR

GENERAL UTILITY NOTES
WATER, SEWER & GAS


INTERSTATE ROUTE H-1
PROJ. NO. I-HI-1(99)-15

NO SCALE: DATE: AUG 4 1976
SHEET NO. 1 OF 10 SHEETS

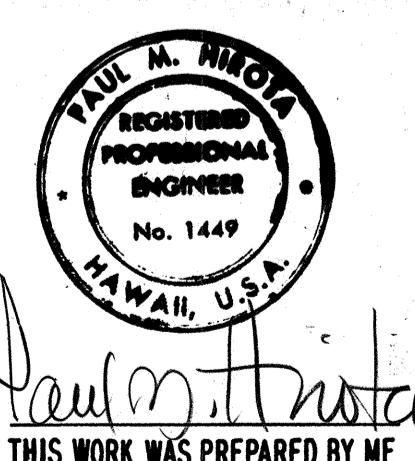


This work was prepared by me
or under my supervision


ADD. 158

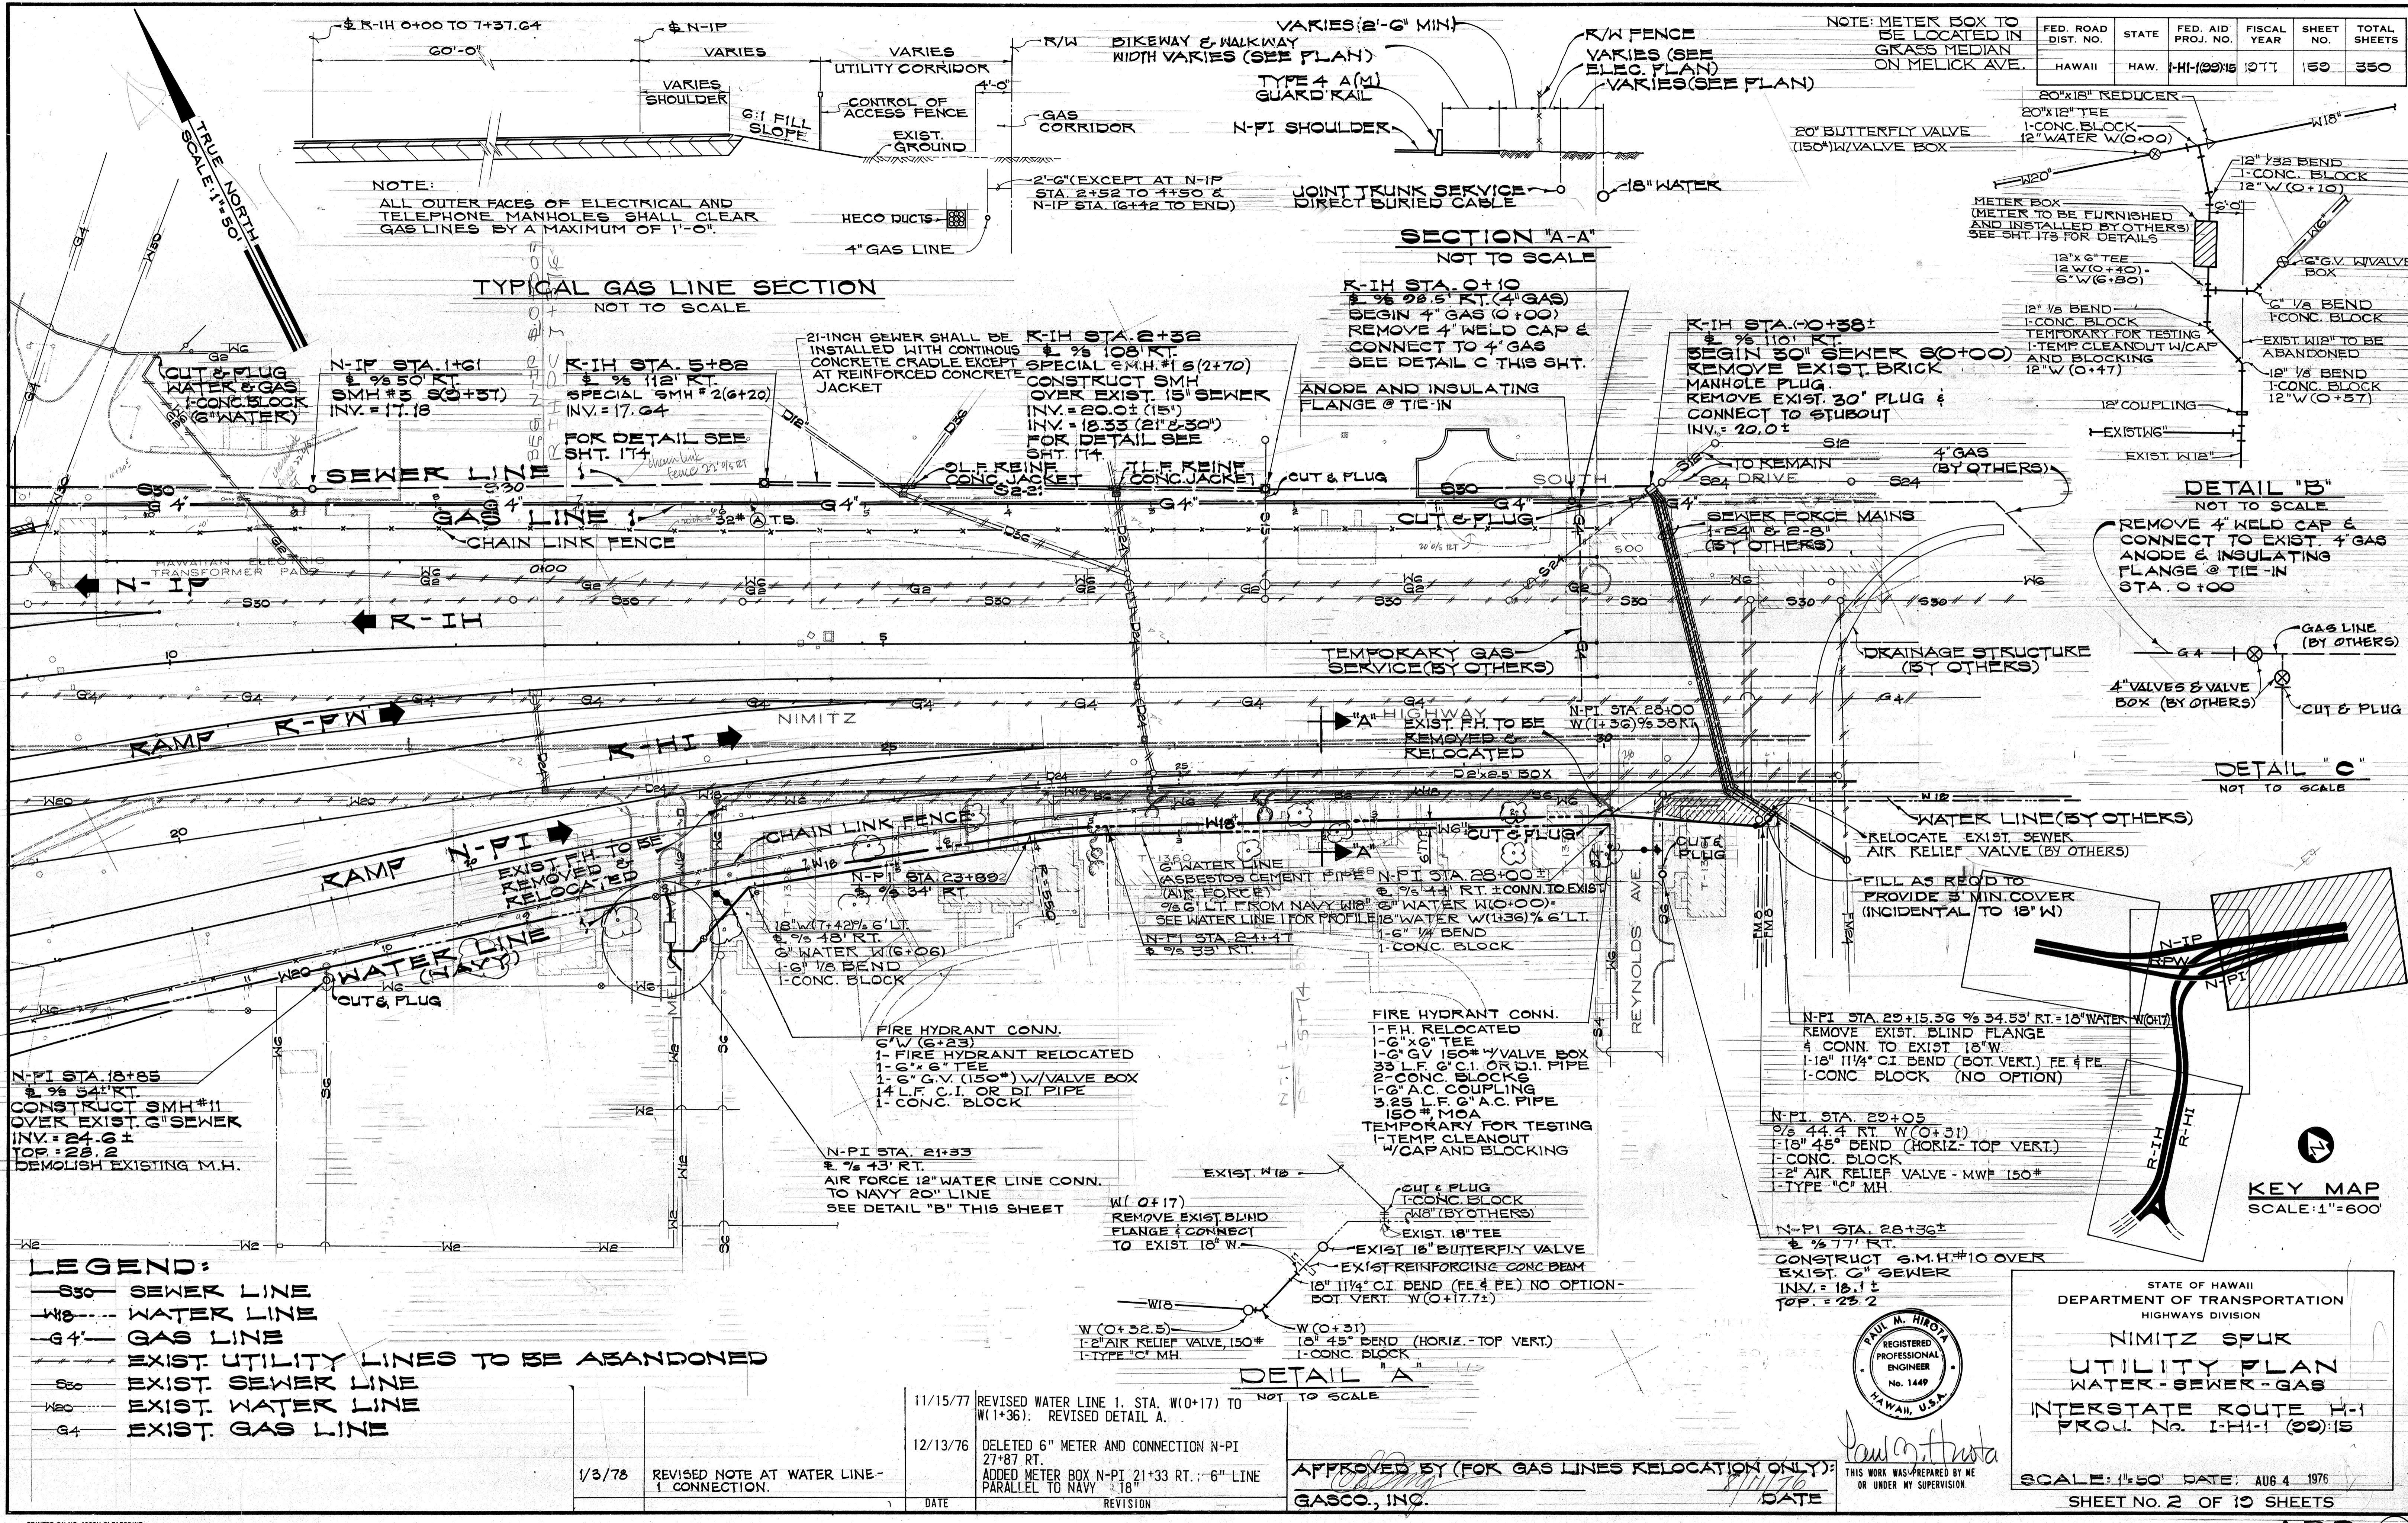


FED. ROAD DIST. NO.	STATE	FED. AID PROJ. NO.	FISCAL YEAR	SHEET NO.	TOTAL SHEETS
HAWAII	HAW.	I-HI-10015	1977	160	350

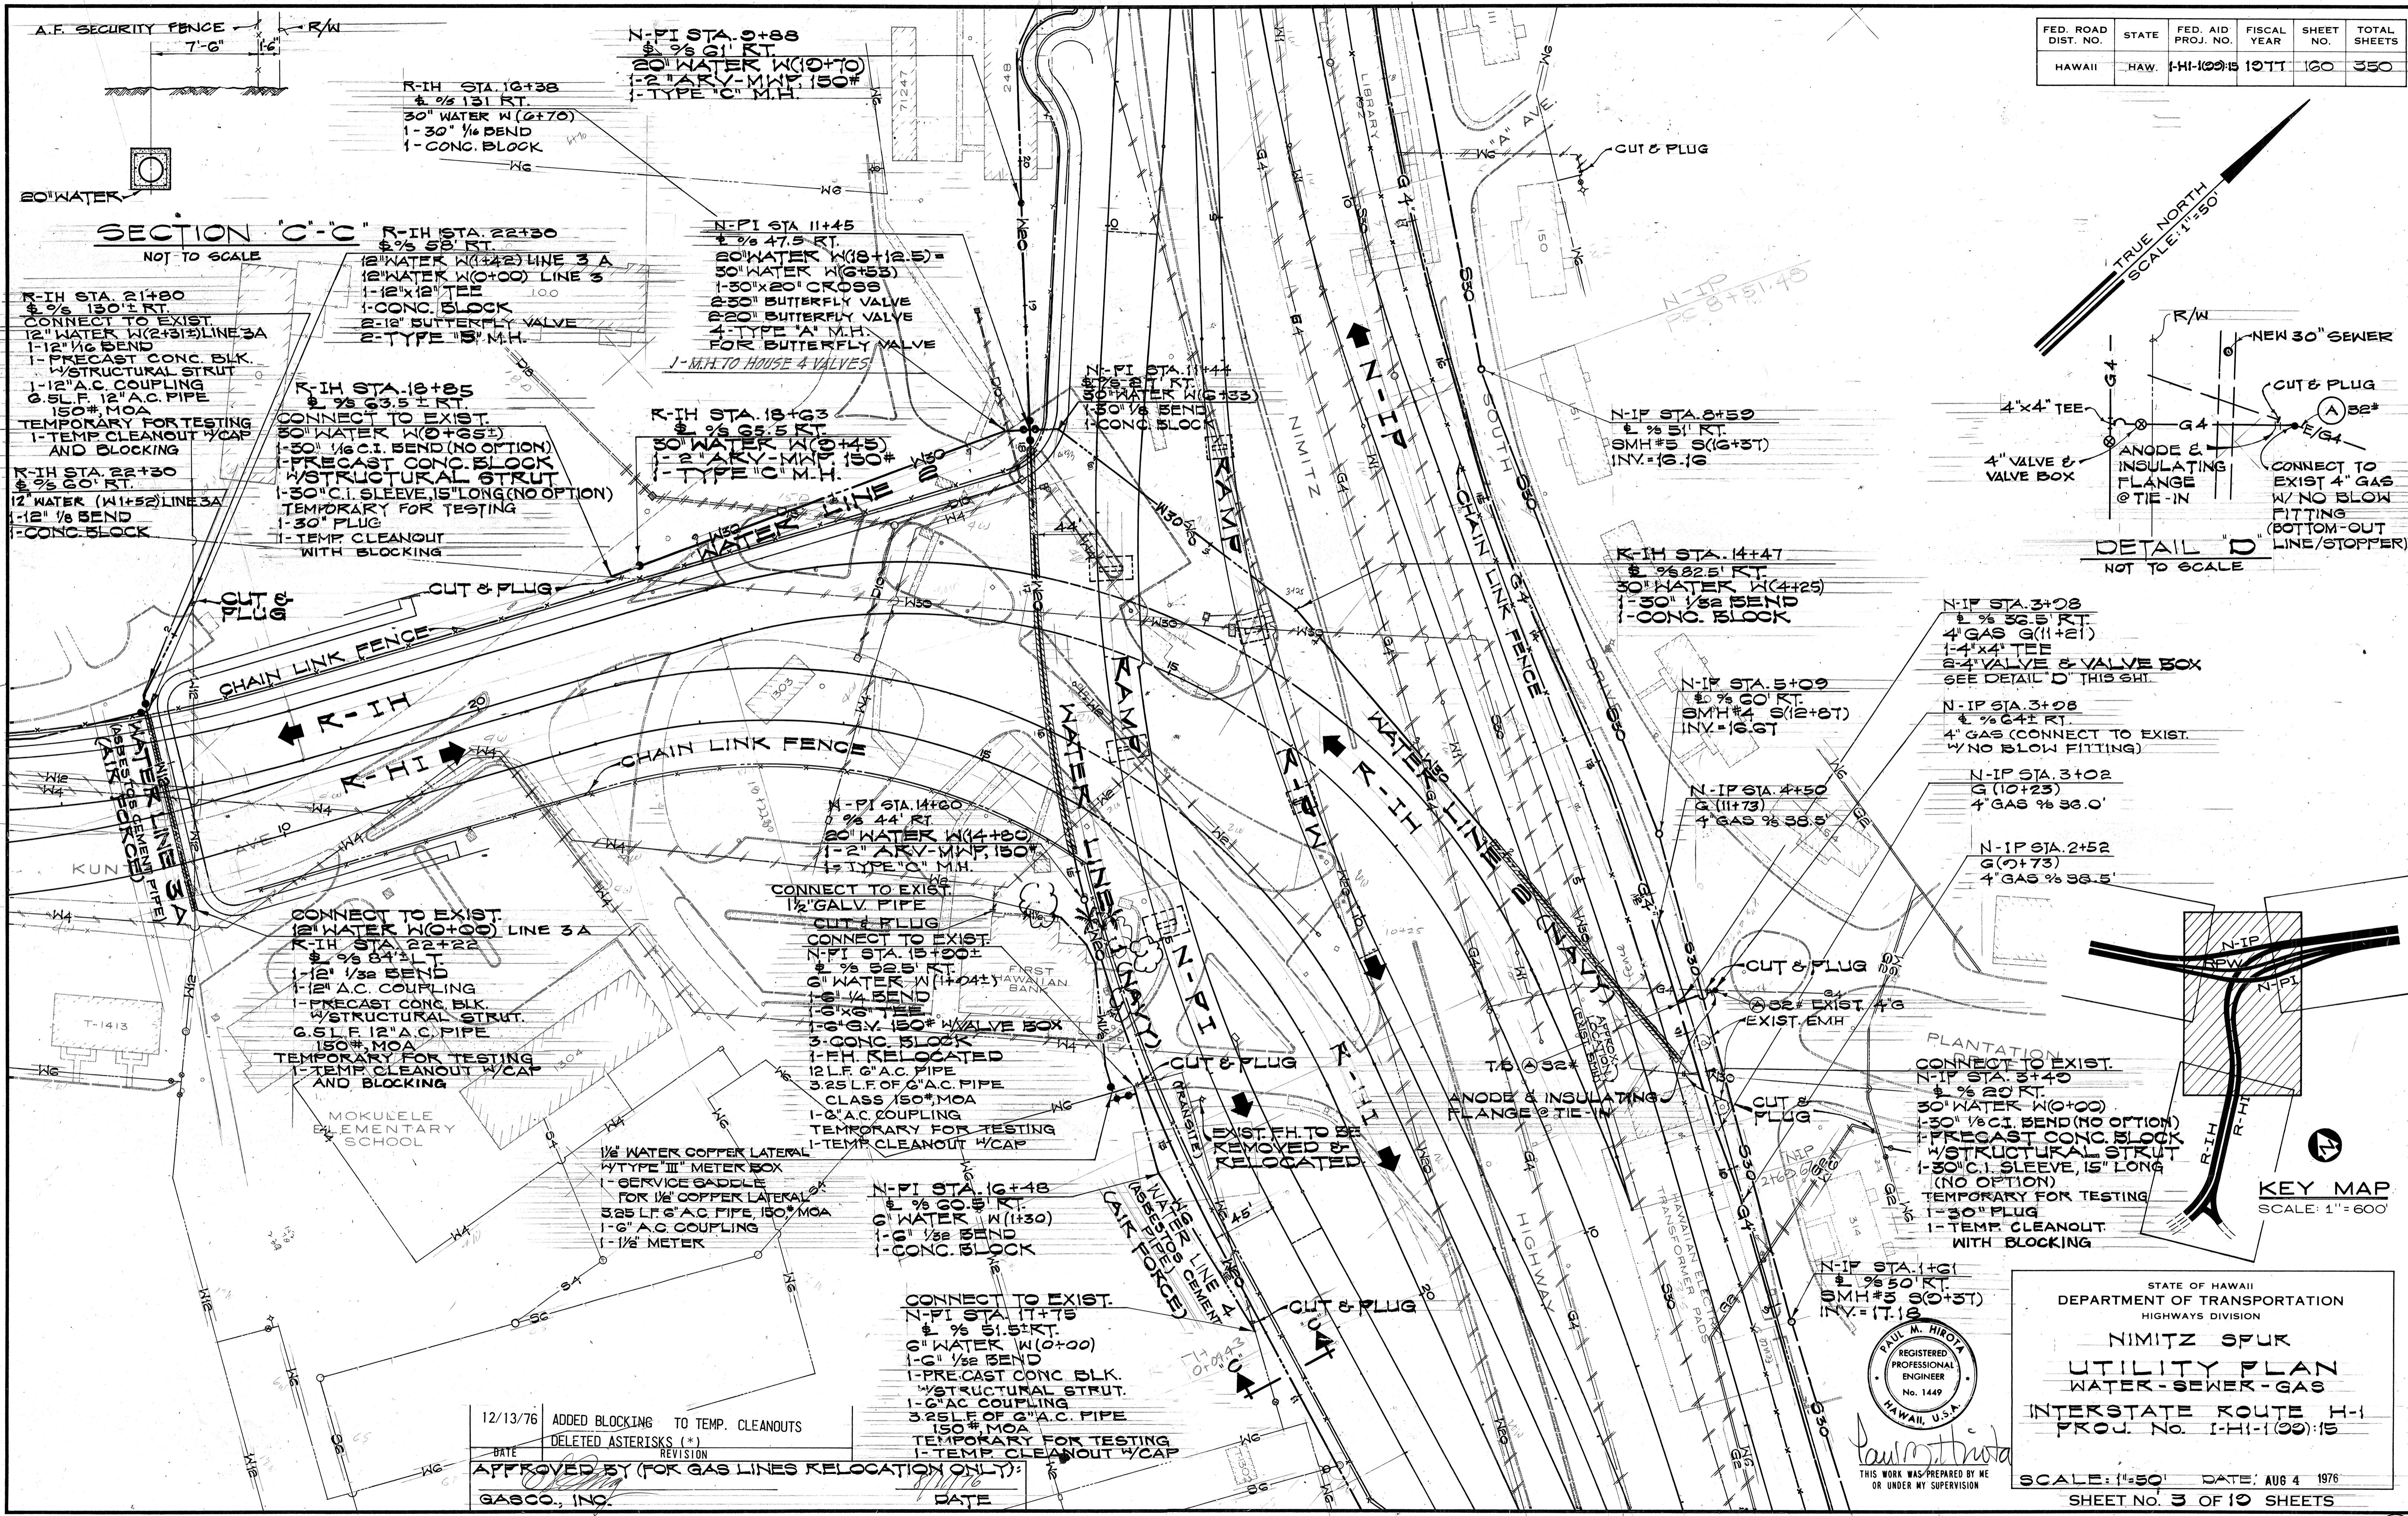

FED. ROAD DIST. NO.	STATE	FED. AID PROJ. NO.	FISCAL YEAR	SHEET NO.	TOTAL SHEETS
HAWAII	HAW.	I-HI-1(39)-15	1977	161	350

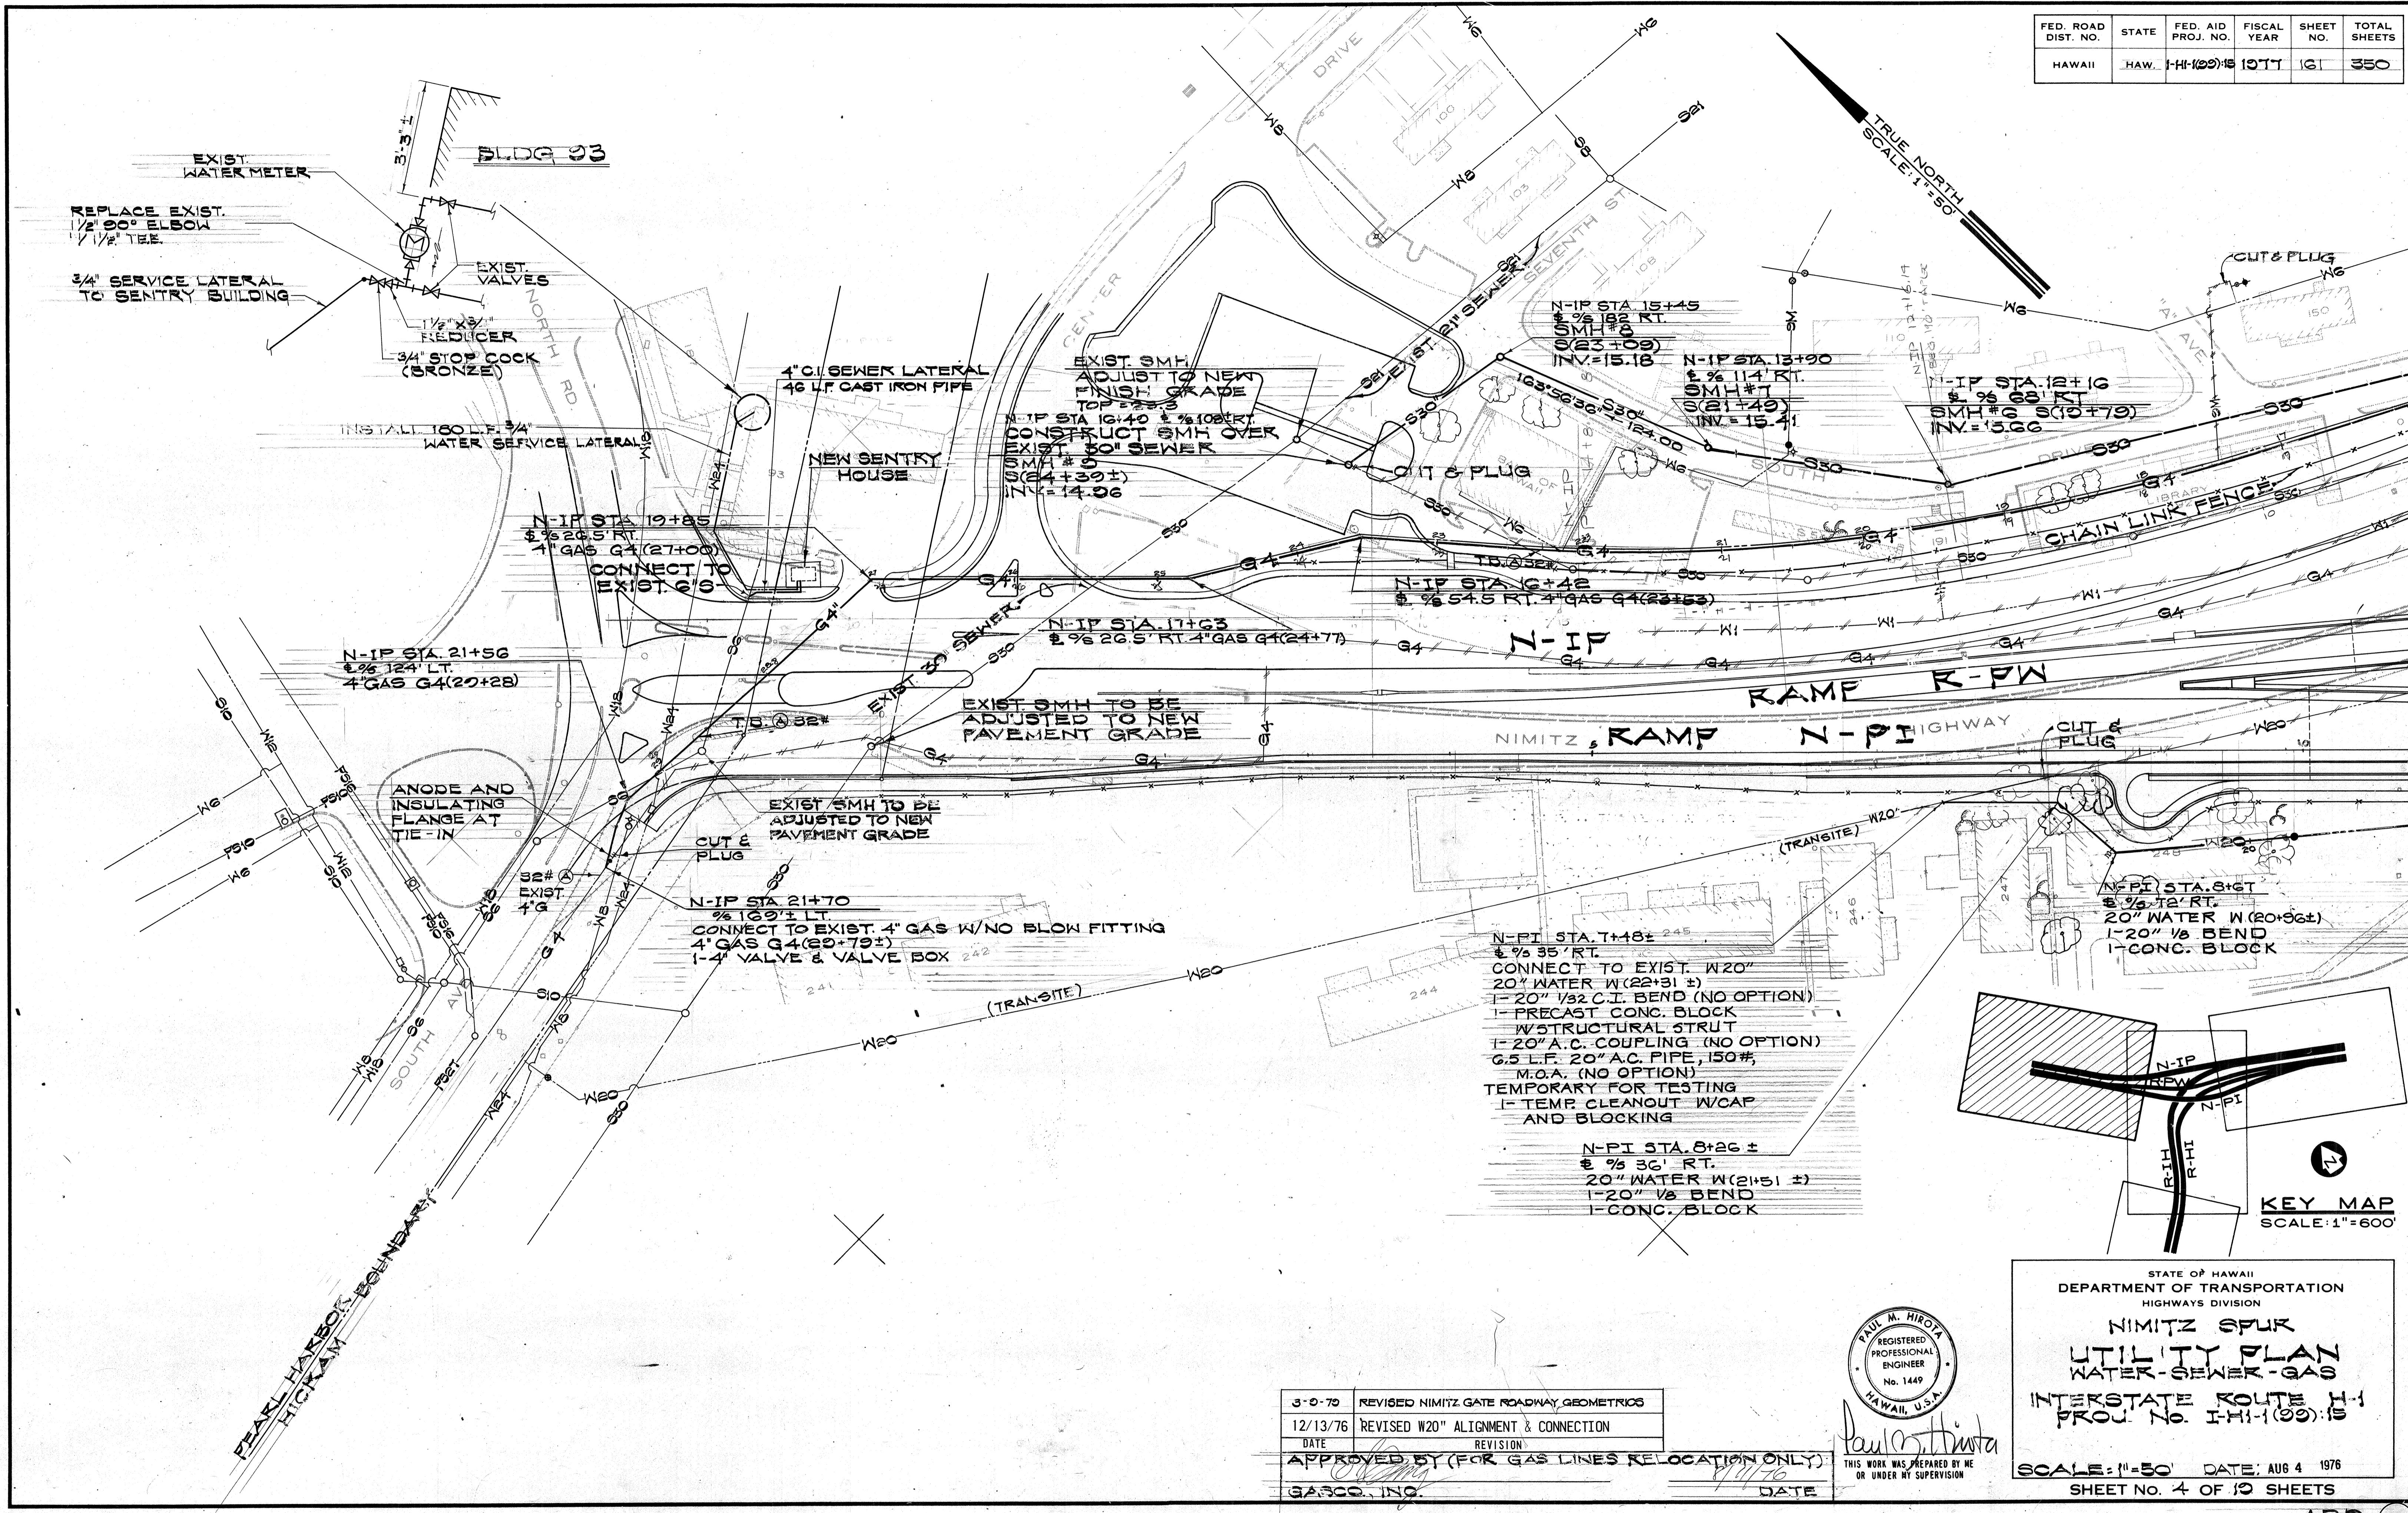


FED. ROAD DIST. NO.	STATE	FED. AID PROJ. NO.	FISCAL YEAR	HEET NO.	TOTAL SHEETS
HAWAII	HAW.	I-HI-0015	1977	162	350

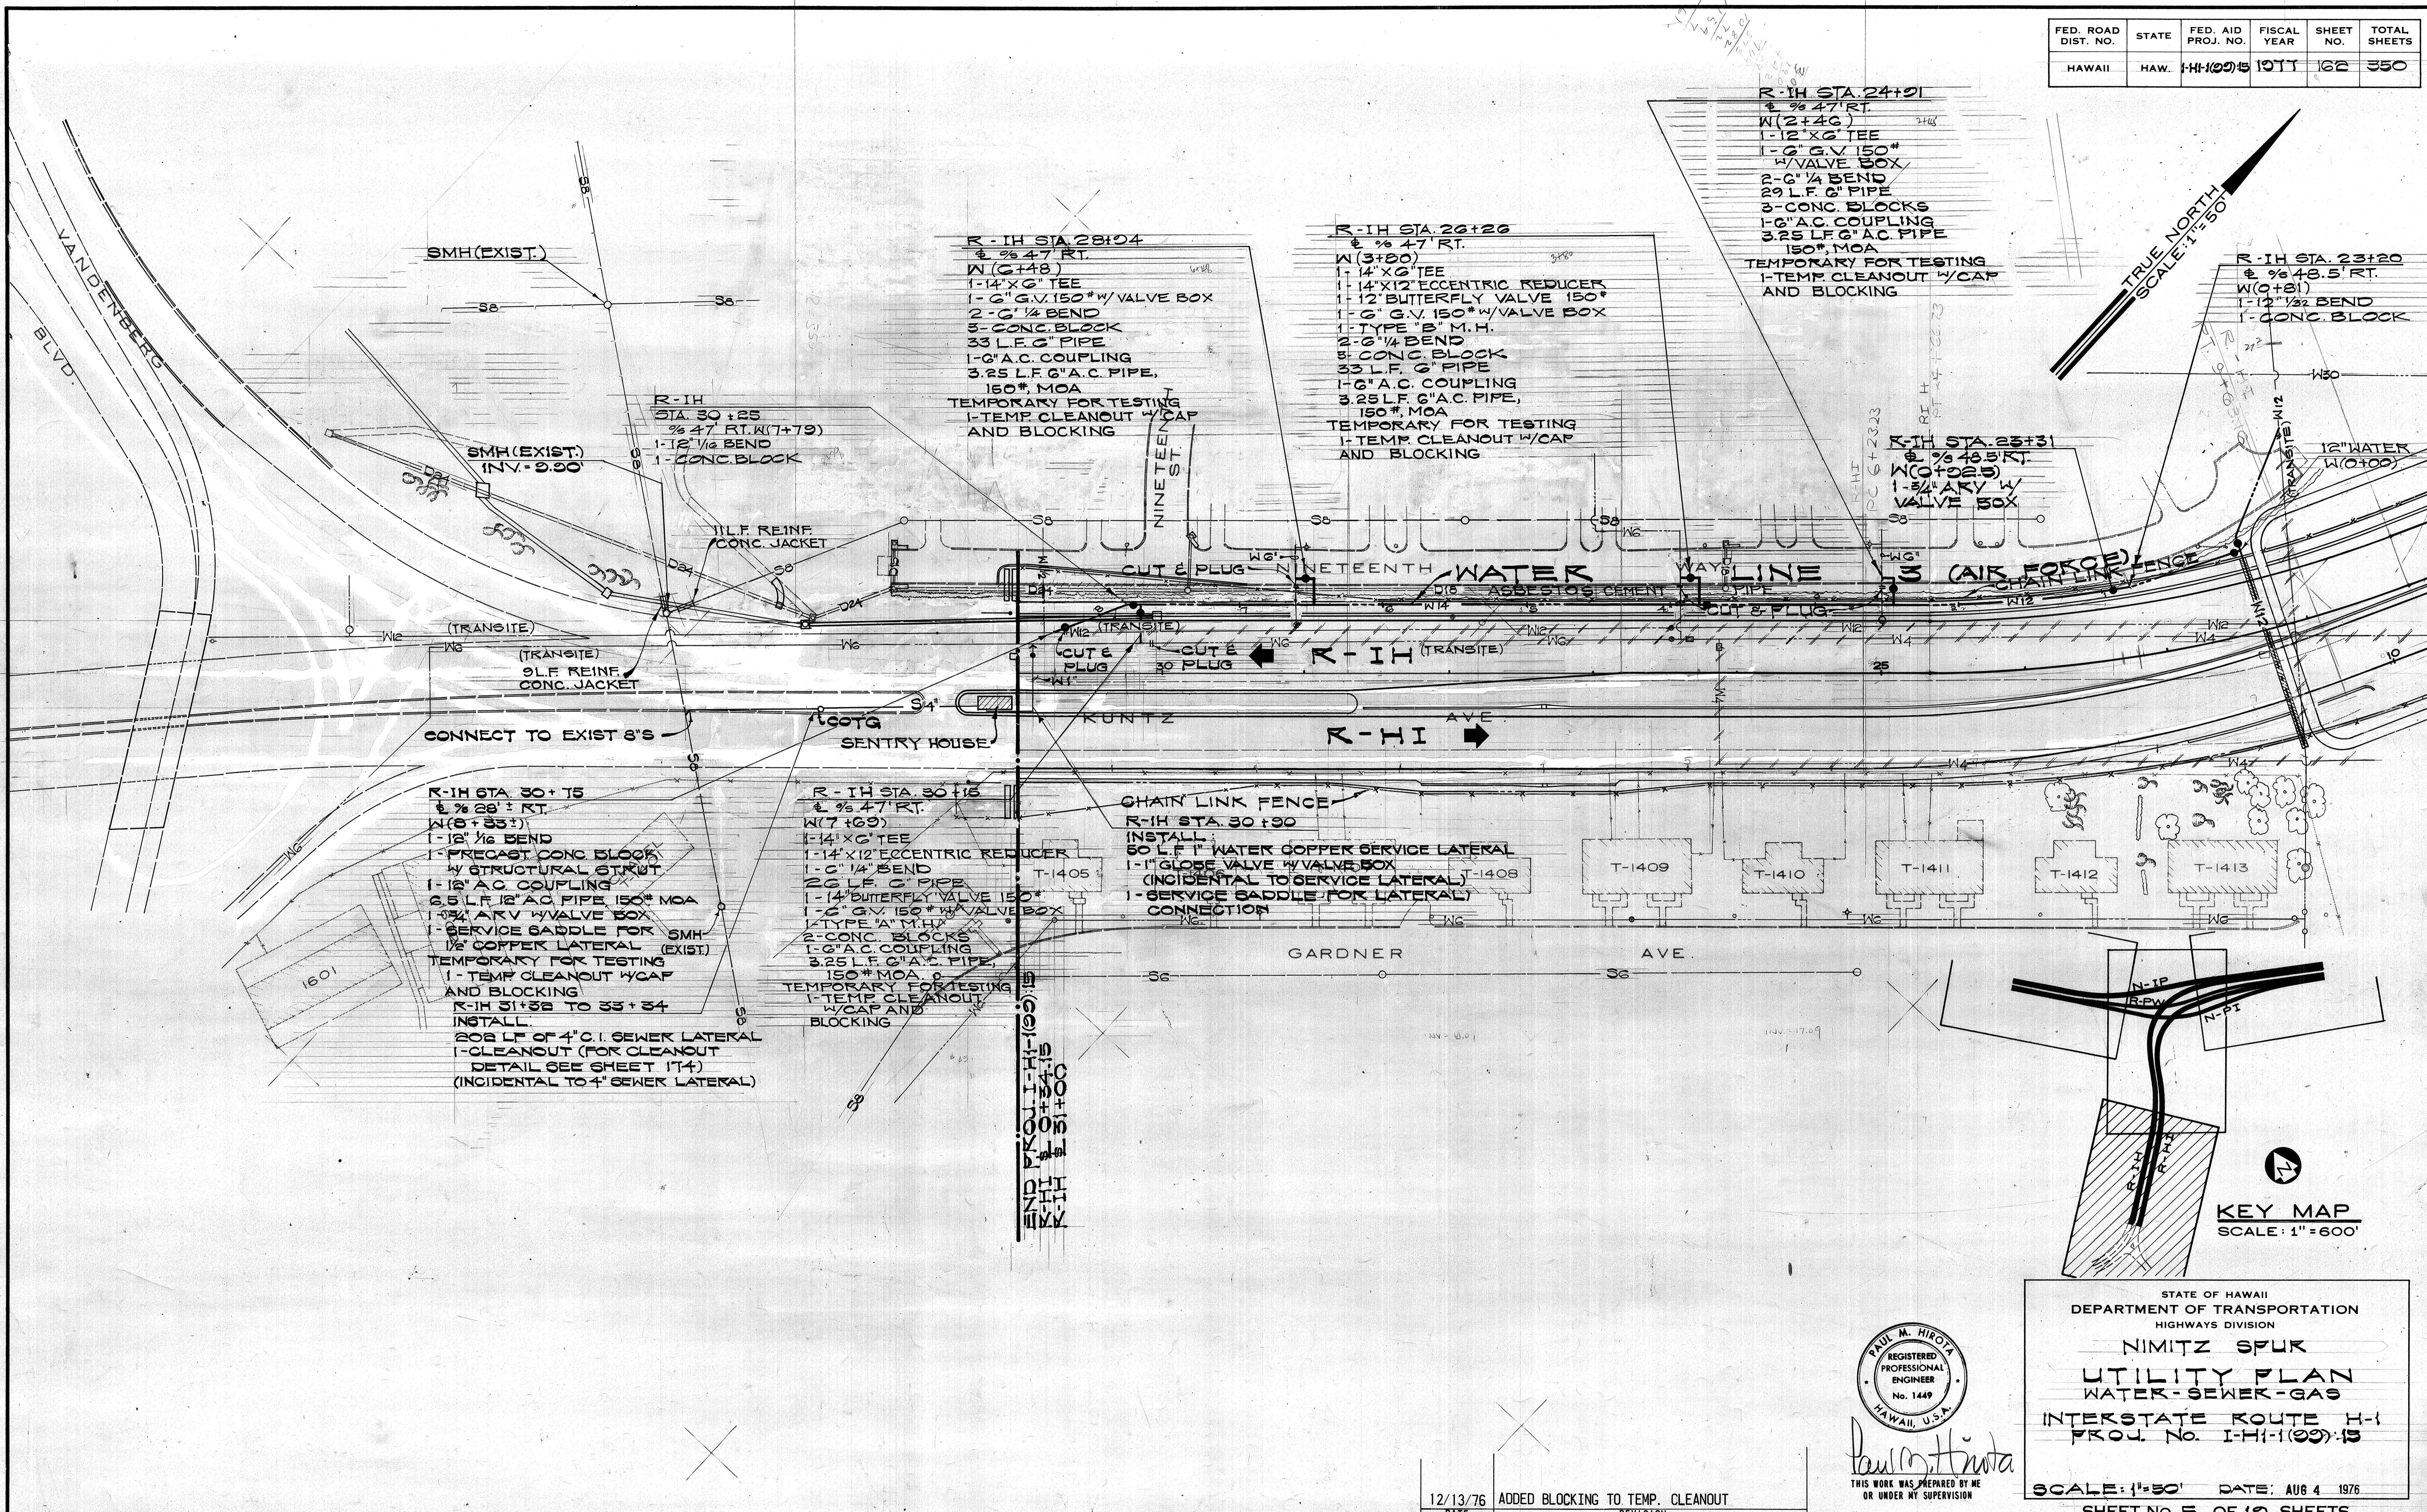

ORIGINAL PLAN SURVEY PLOTTED BY DRAWN BY RECORDED BY QUANTITIES BY CHECKED BY
NOTE BOOK

L-1-7

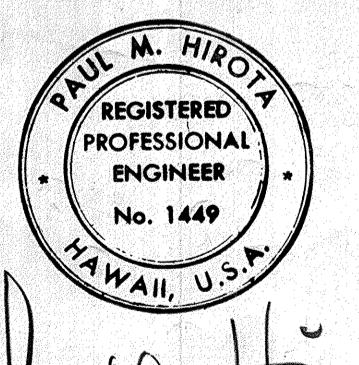



THIS WORK WAS PREPARED BY ME
OR UNDER MY SUPERVISION

STATE OF HAWAII
DEPARTMENT OF TRANSPORTATION
HIGHWAYS DIVISION
NIMITZ SPUR
UTILITY PLAN
WATER-SEWER-GAS
INTERSTATE ROUTE H-1
PROJ. NO. I-HI-199-15




SCALE: 1"=50' DATE: AUG 4 1976
SHEET NO. 5 OF 19 SHEETS ADD. 162

FED. ROAD DIST. NO.	STATE	FED. AID PROJ. NO.	FISCAL YEAR	SHEET NO.	TOTAL SHEETS
HAWAII	HAW.	I-HI-1(99)15	1977	163	350


NOTE:
FILL AS REQUIRED TO PROVIDE
3" MINIMUM COVER
(INCIDENTAL TO 18" WATER)

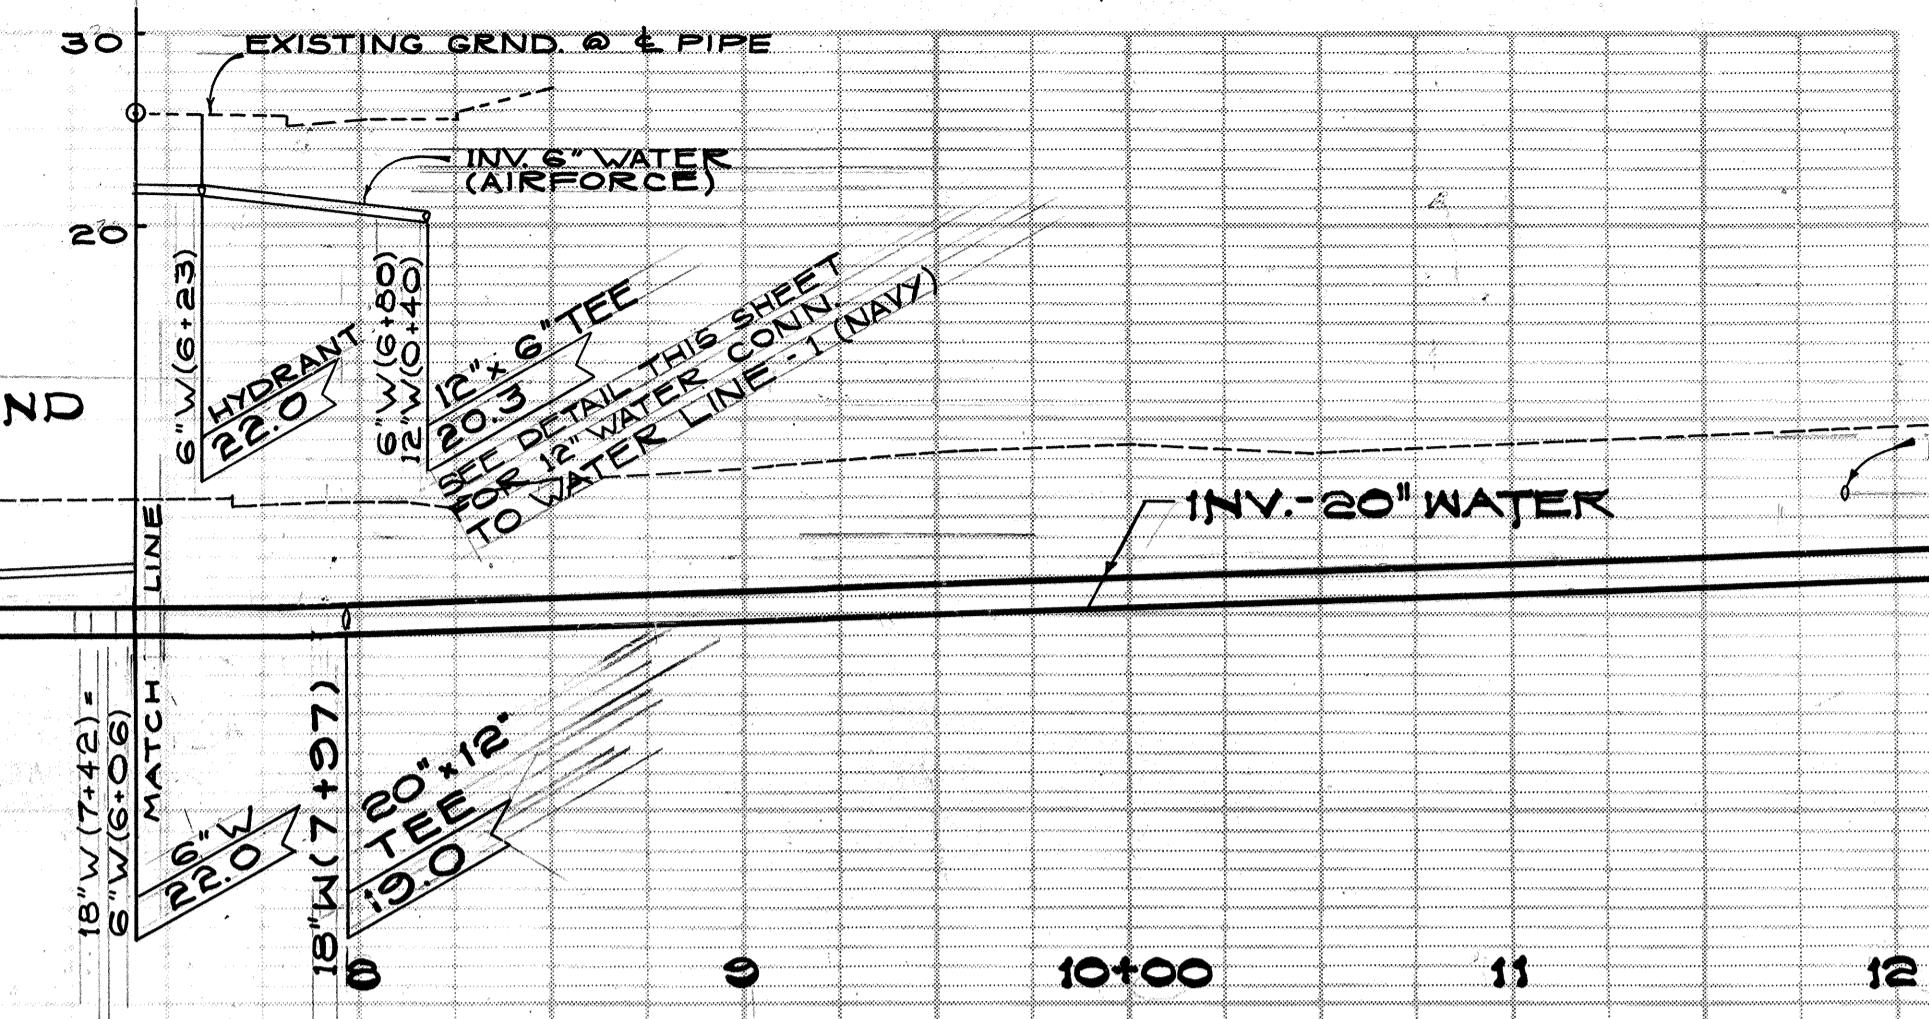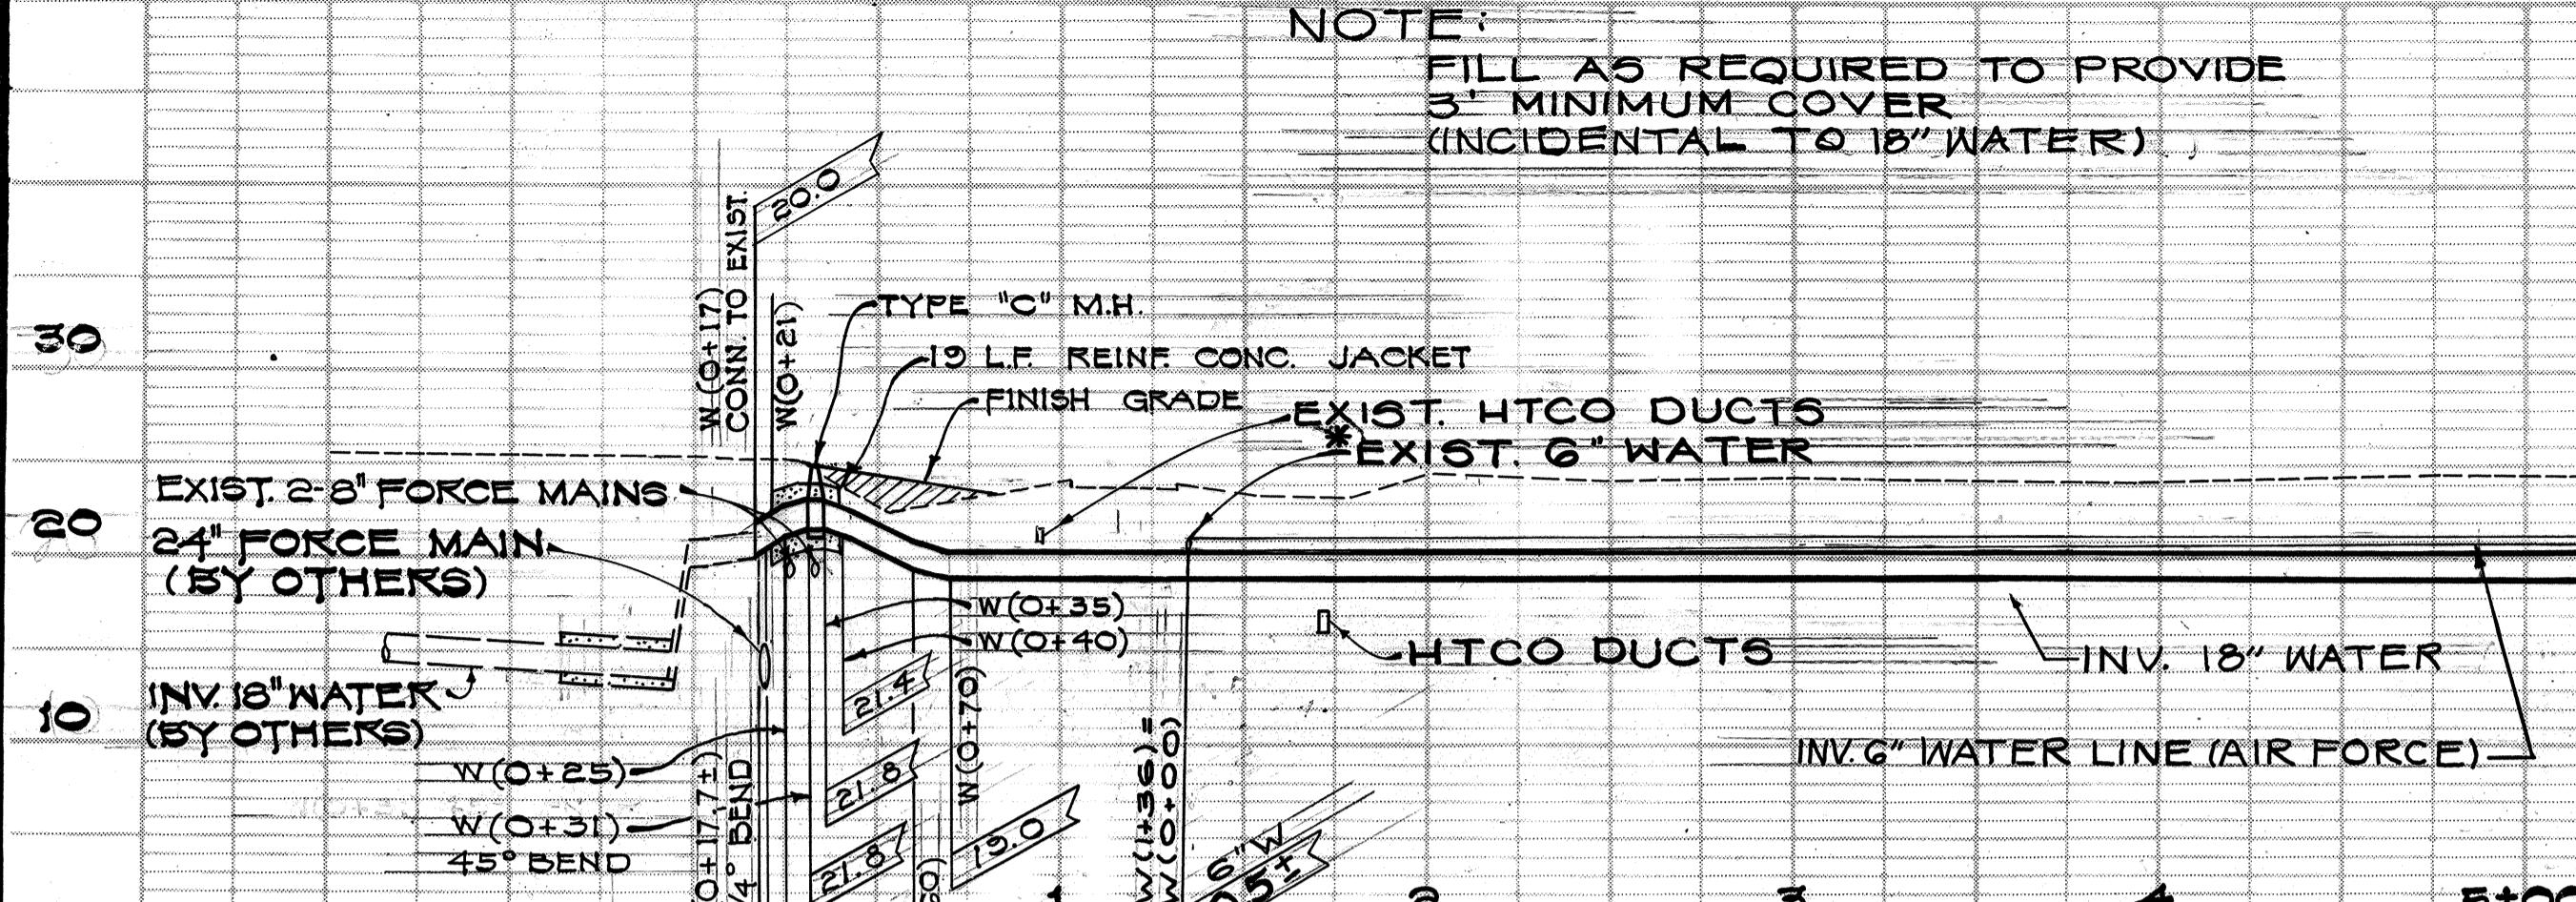

WATER LINE -1 (NAVY) AND 6" WATER (AIR FORCE)

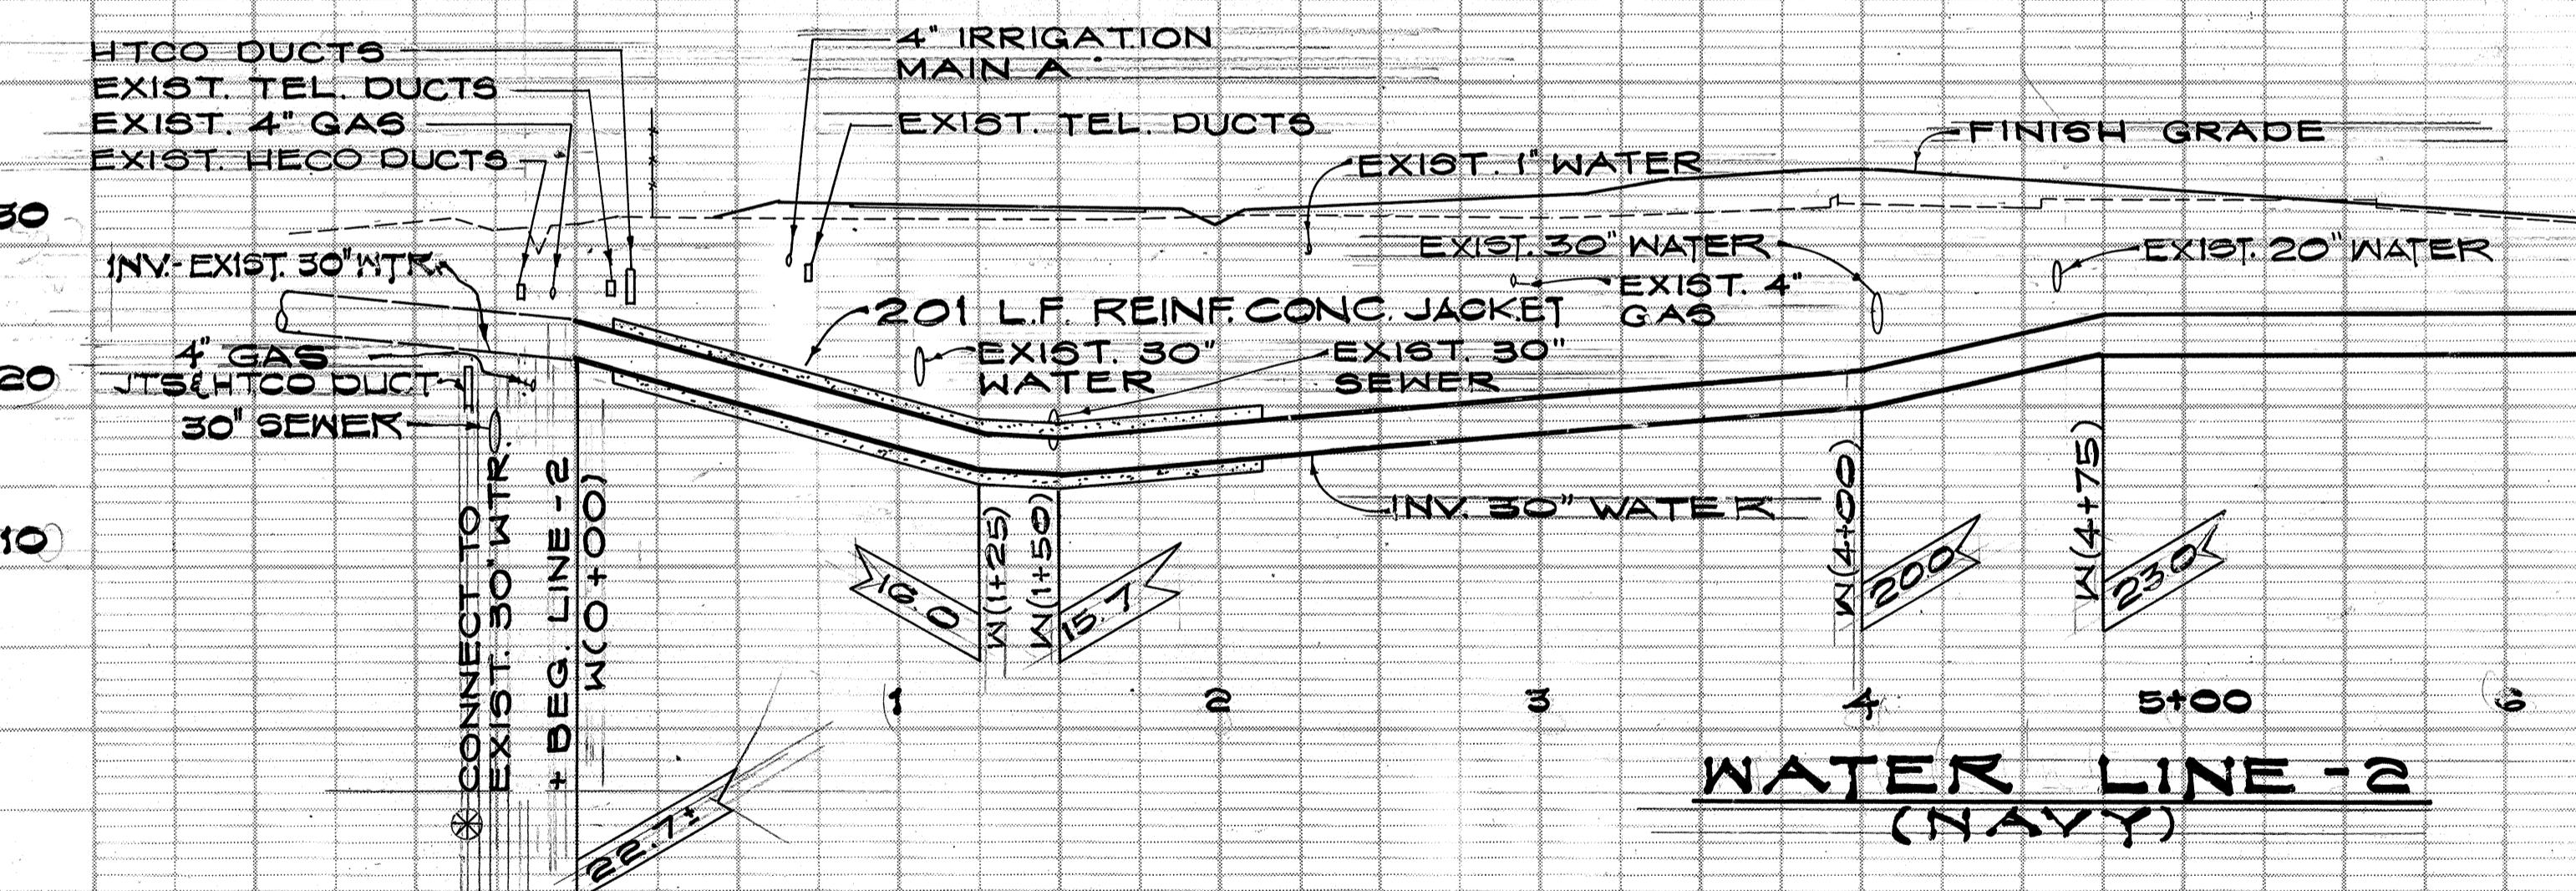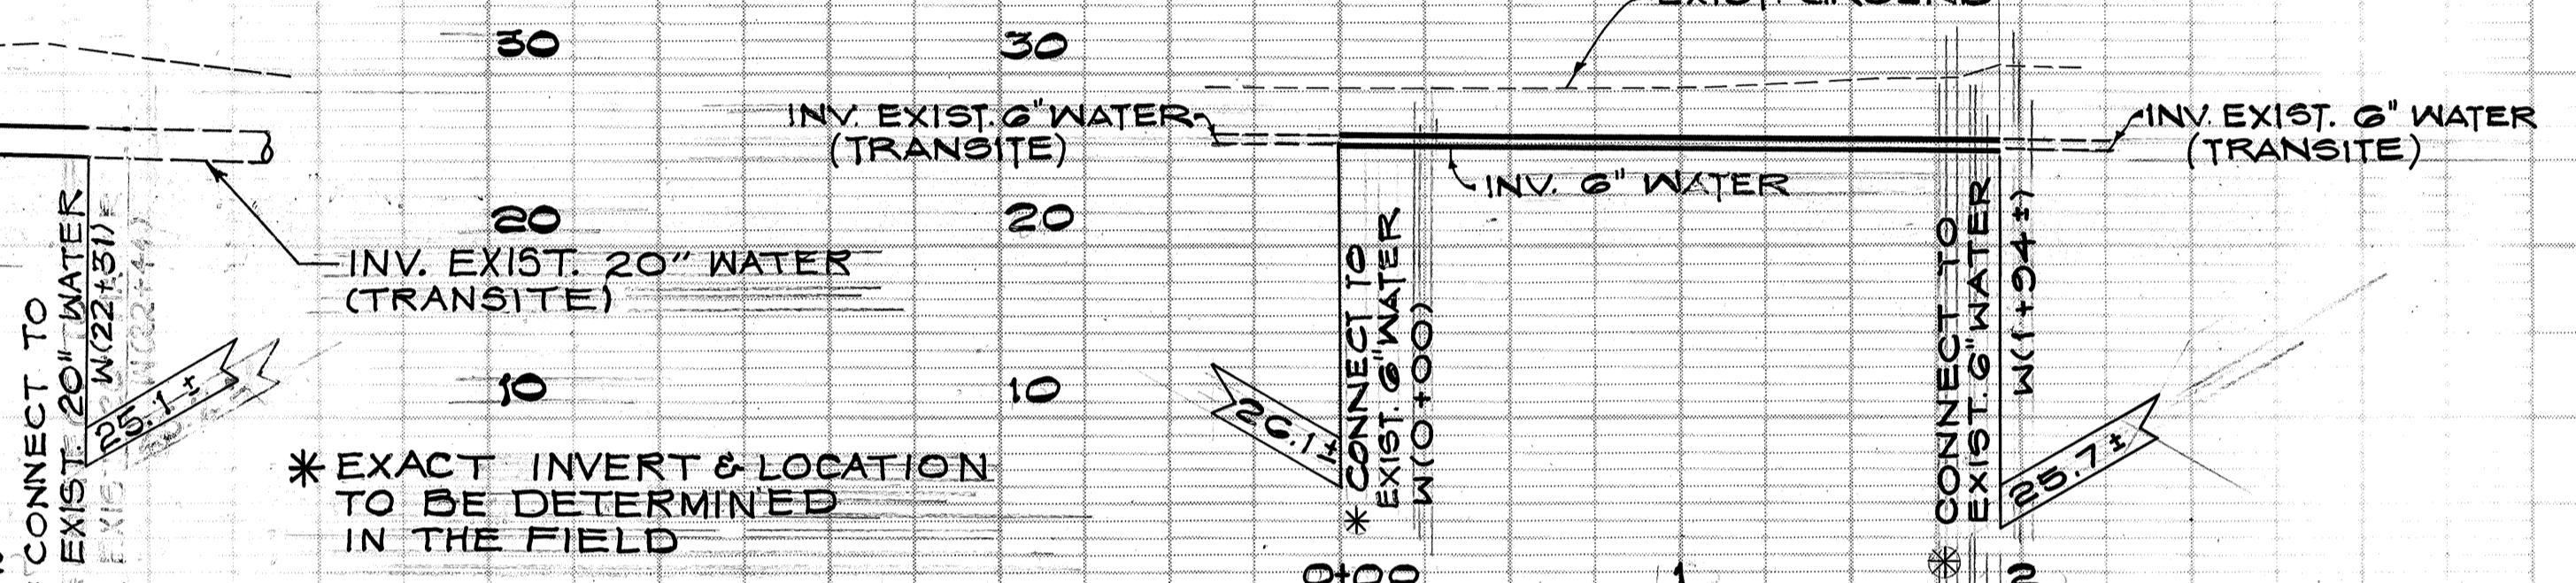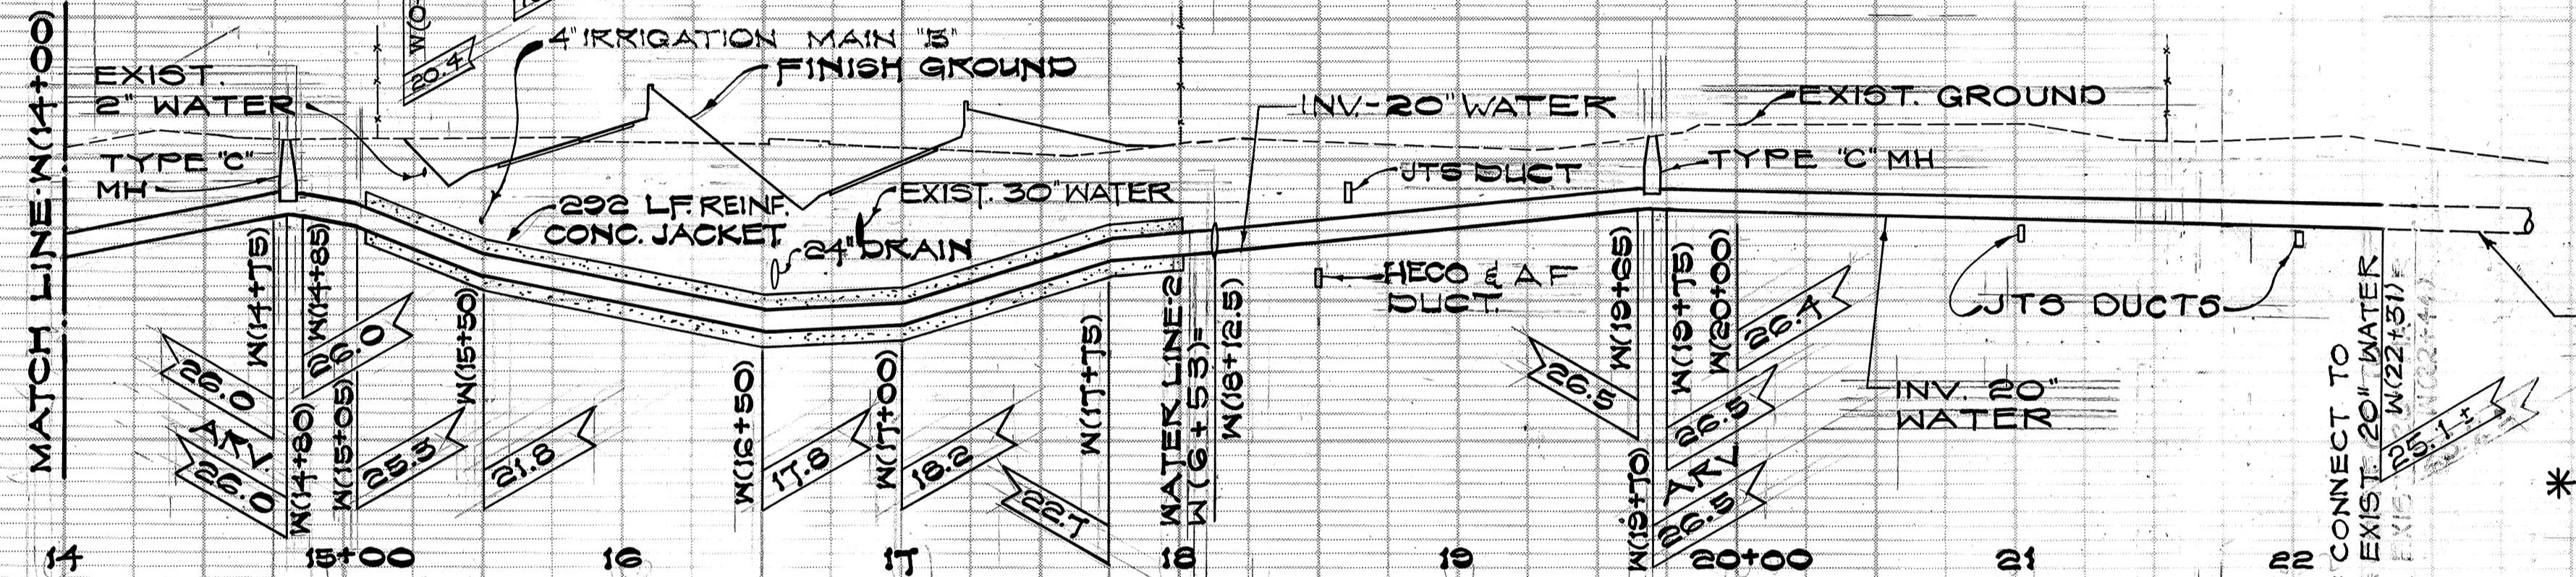

WATER LINE -2 (NAVY)

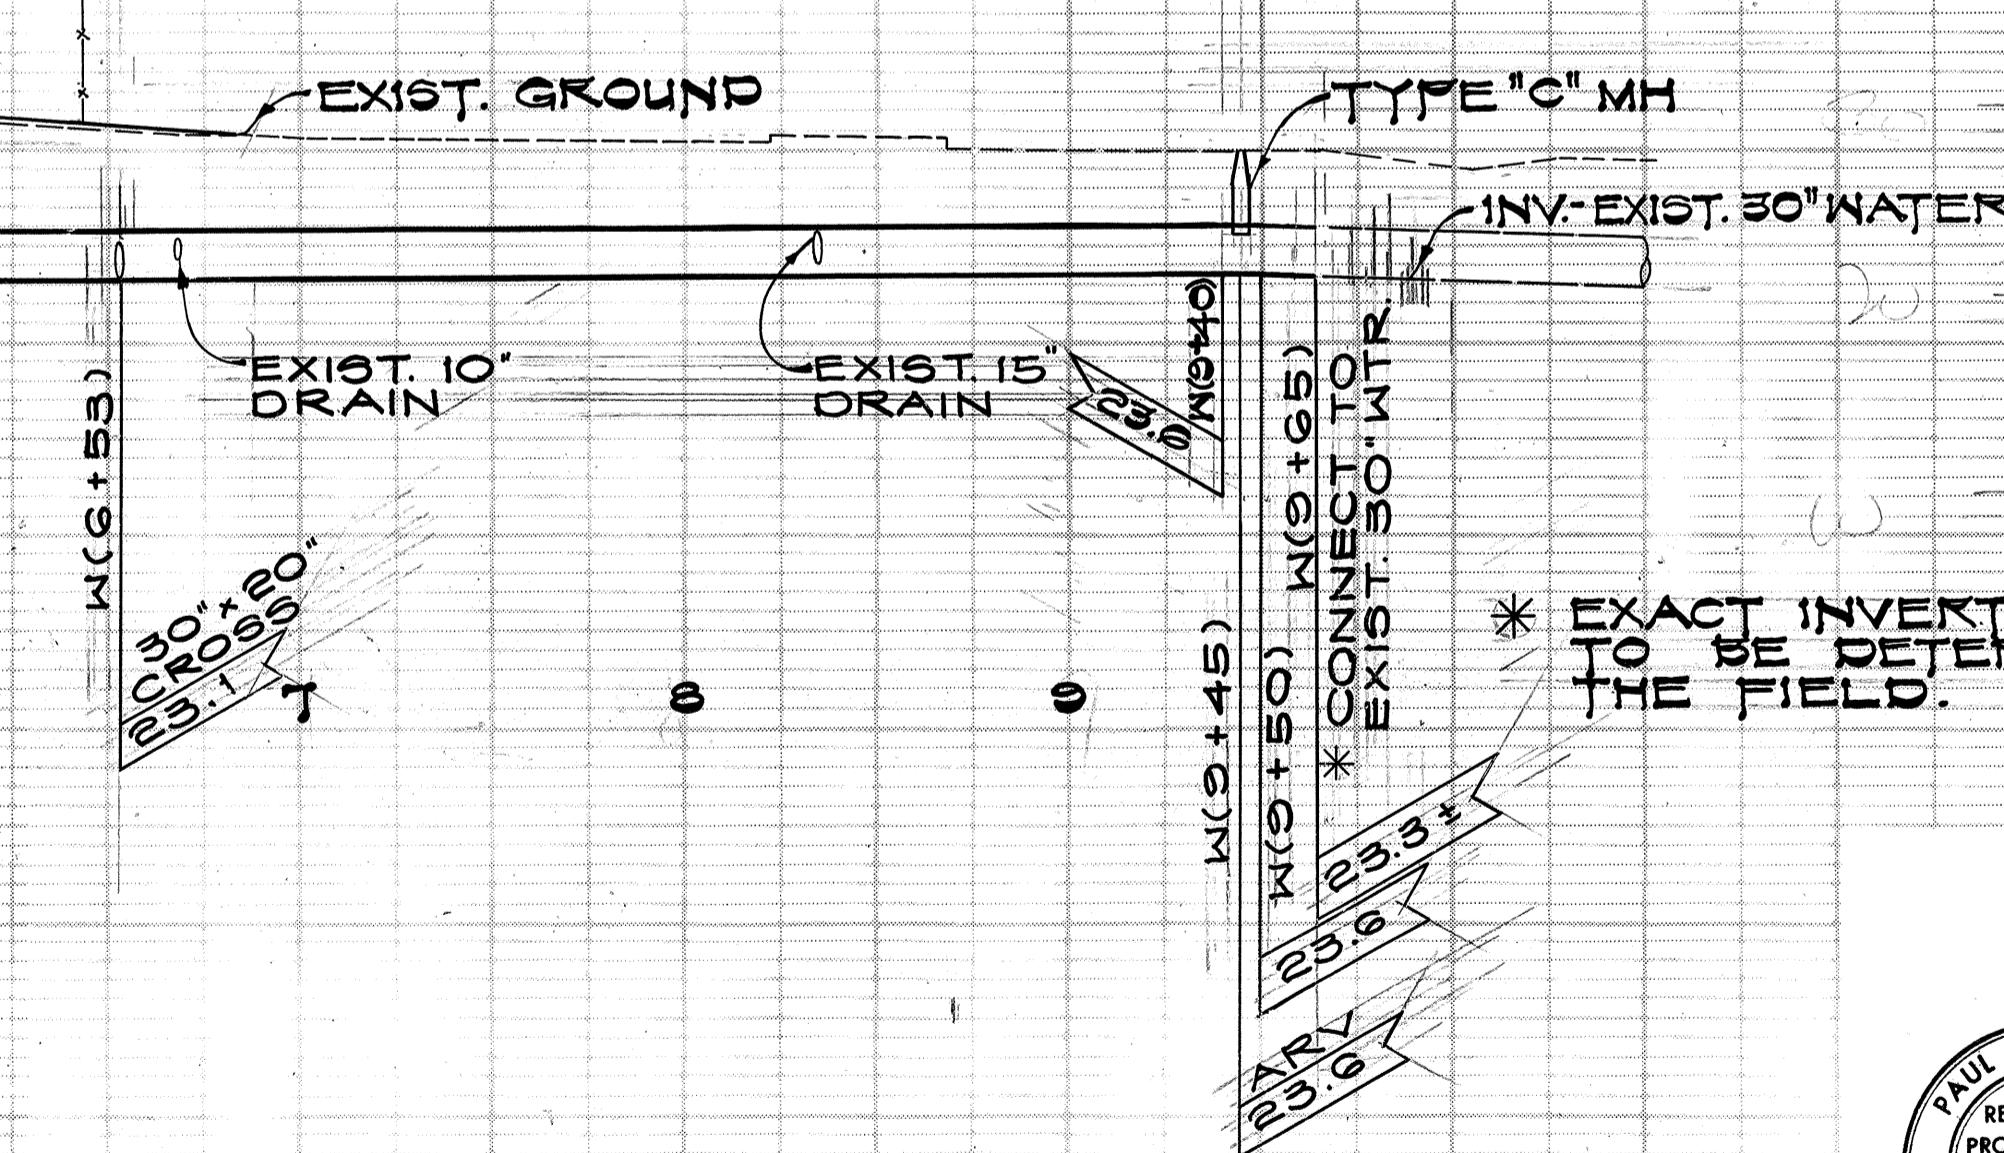

* EXACT INVERT & LOCATION
TO BE DETERMINED
IN THE FIELD.

11/15/77 REVISED WATER LINE 1 PROFILE
STA. W(O+17) TO W(O+36)
ADDED PROFILE 12" AIR FORCE W/L CONN.
ADJUSTED LINE 1 PROFILE
ADDED 6" PROFILE WATER LINE I
DATE

12/13/76

REVISION

STATE OF HAWAII
DEPARTMENT OF TRANSPORTATION
HIGHWAYS DIVISION


NIMITZ SPUR

UTILITY PROFILES
WATER LINE - 1, 2 & 4

INTERSTATE ROUTE H-1
PROJ. NO. I-HI-1(99)15

SCALE: AS NOTED DATE: AUG 4 1976

SHEET NO. 6 OF 10 SHEETS




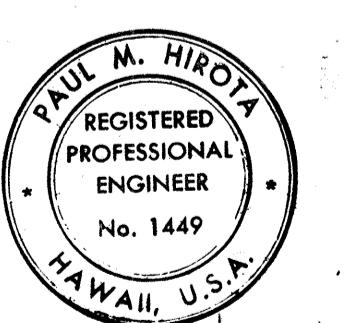


Paul M. Hirata
THIS WORK WAS PREPARED BY ME
OR UNDER MY SUPERVISION

ORIGINAL PLAN	SURVEY PLOTTED BY
DRAWN BY	TRACED BY
QUANTITIES BY	NOTES BOOK
CHECKED BY	No. _____




PROFILES
SCALES: HORIZONTAL 1" = 50'
VERTICAL 1" = 10'

ED. ROAD DIST. NO.	STATE	FED. AID PROJ. NO.	FISCAL YEAR	SHEET NO.	TOTAL SHEETS
HAWAII	HAW.	1-HI-1(99)-15	1977	163A	330

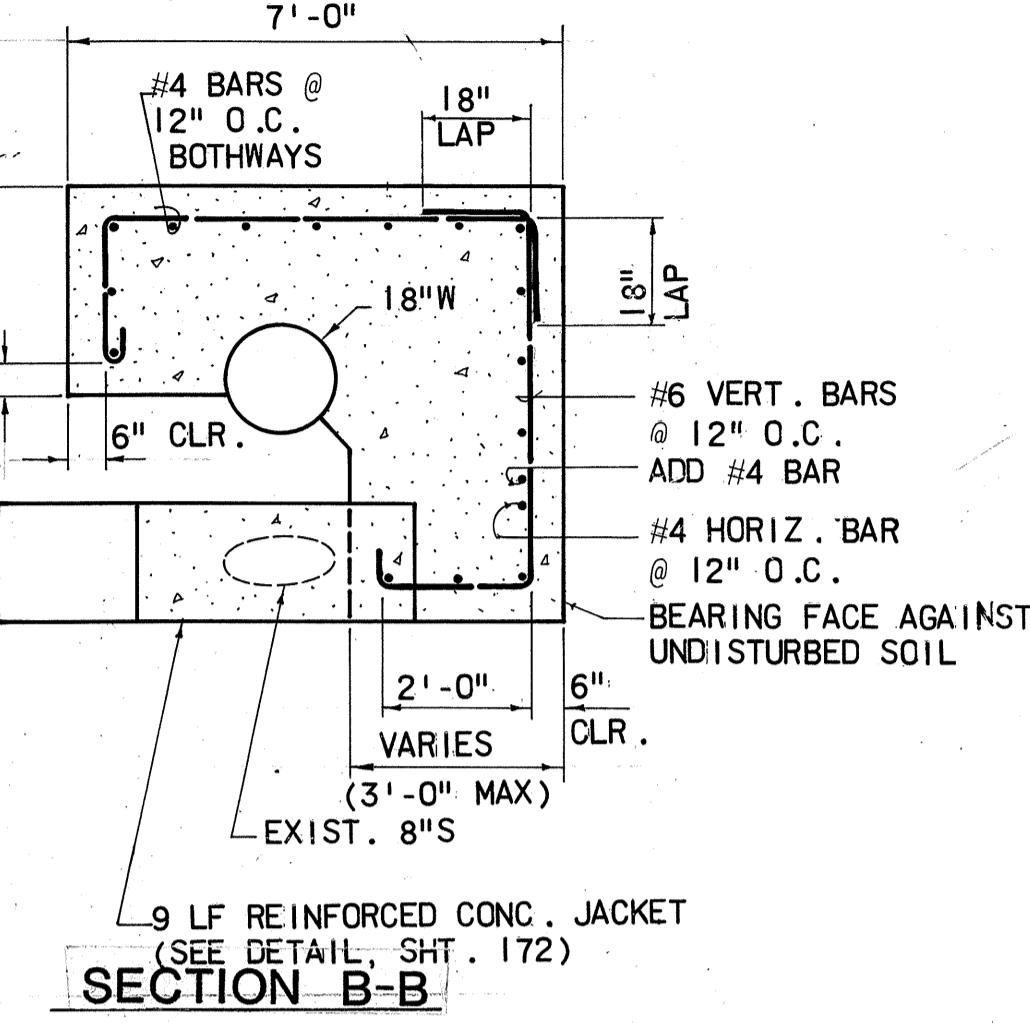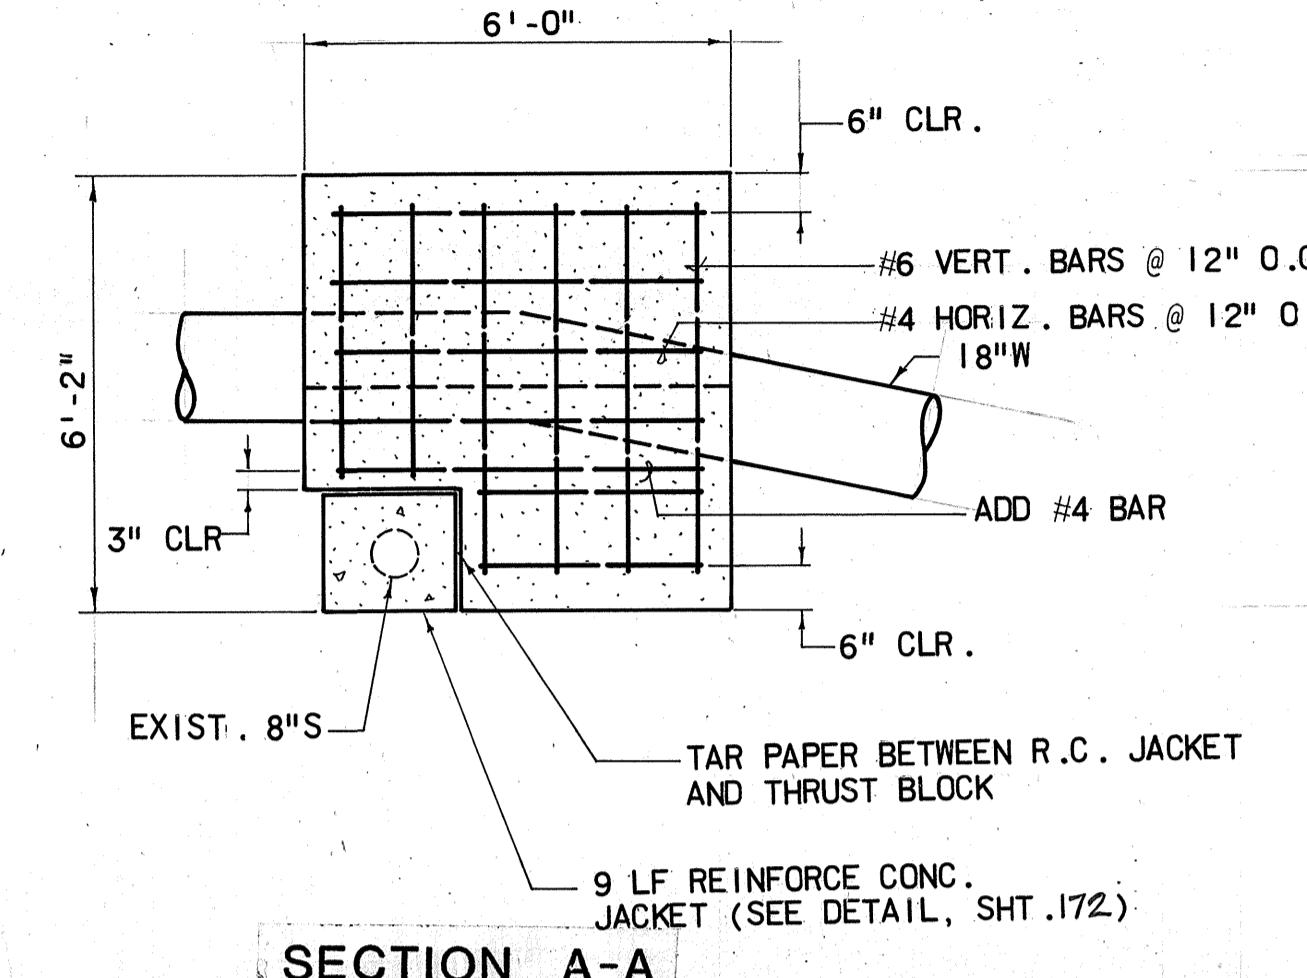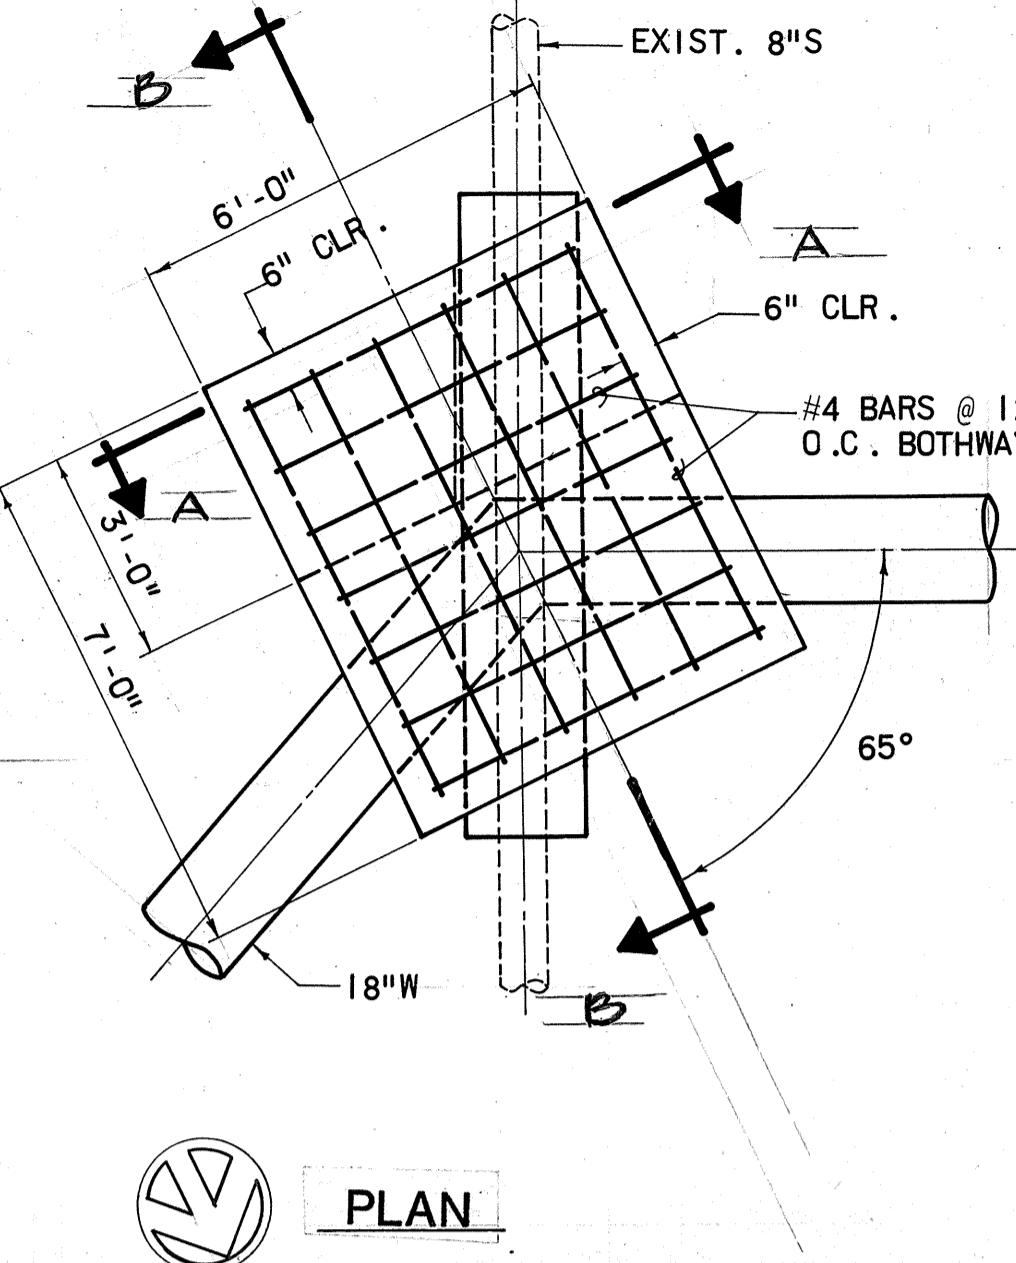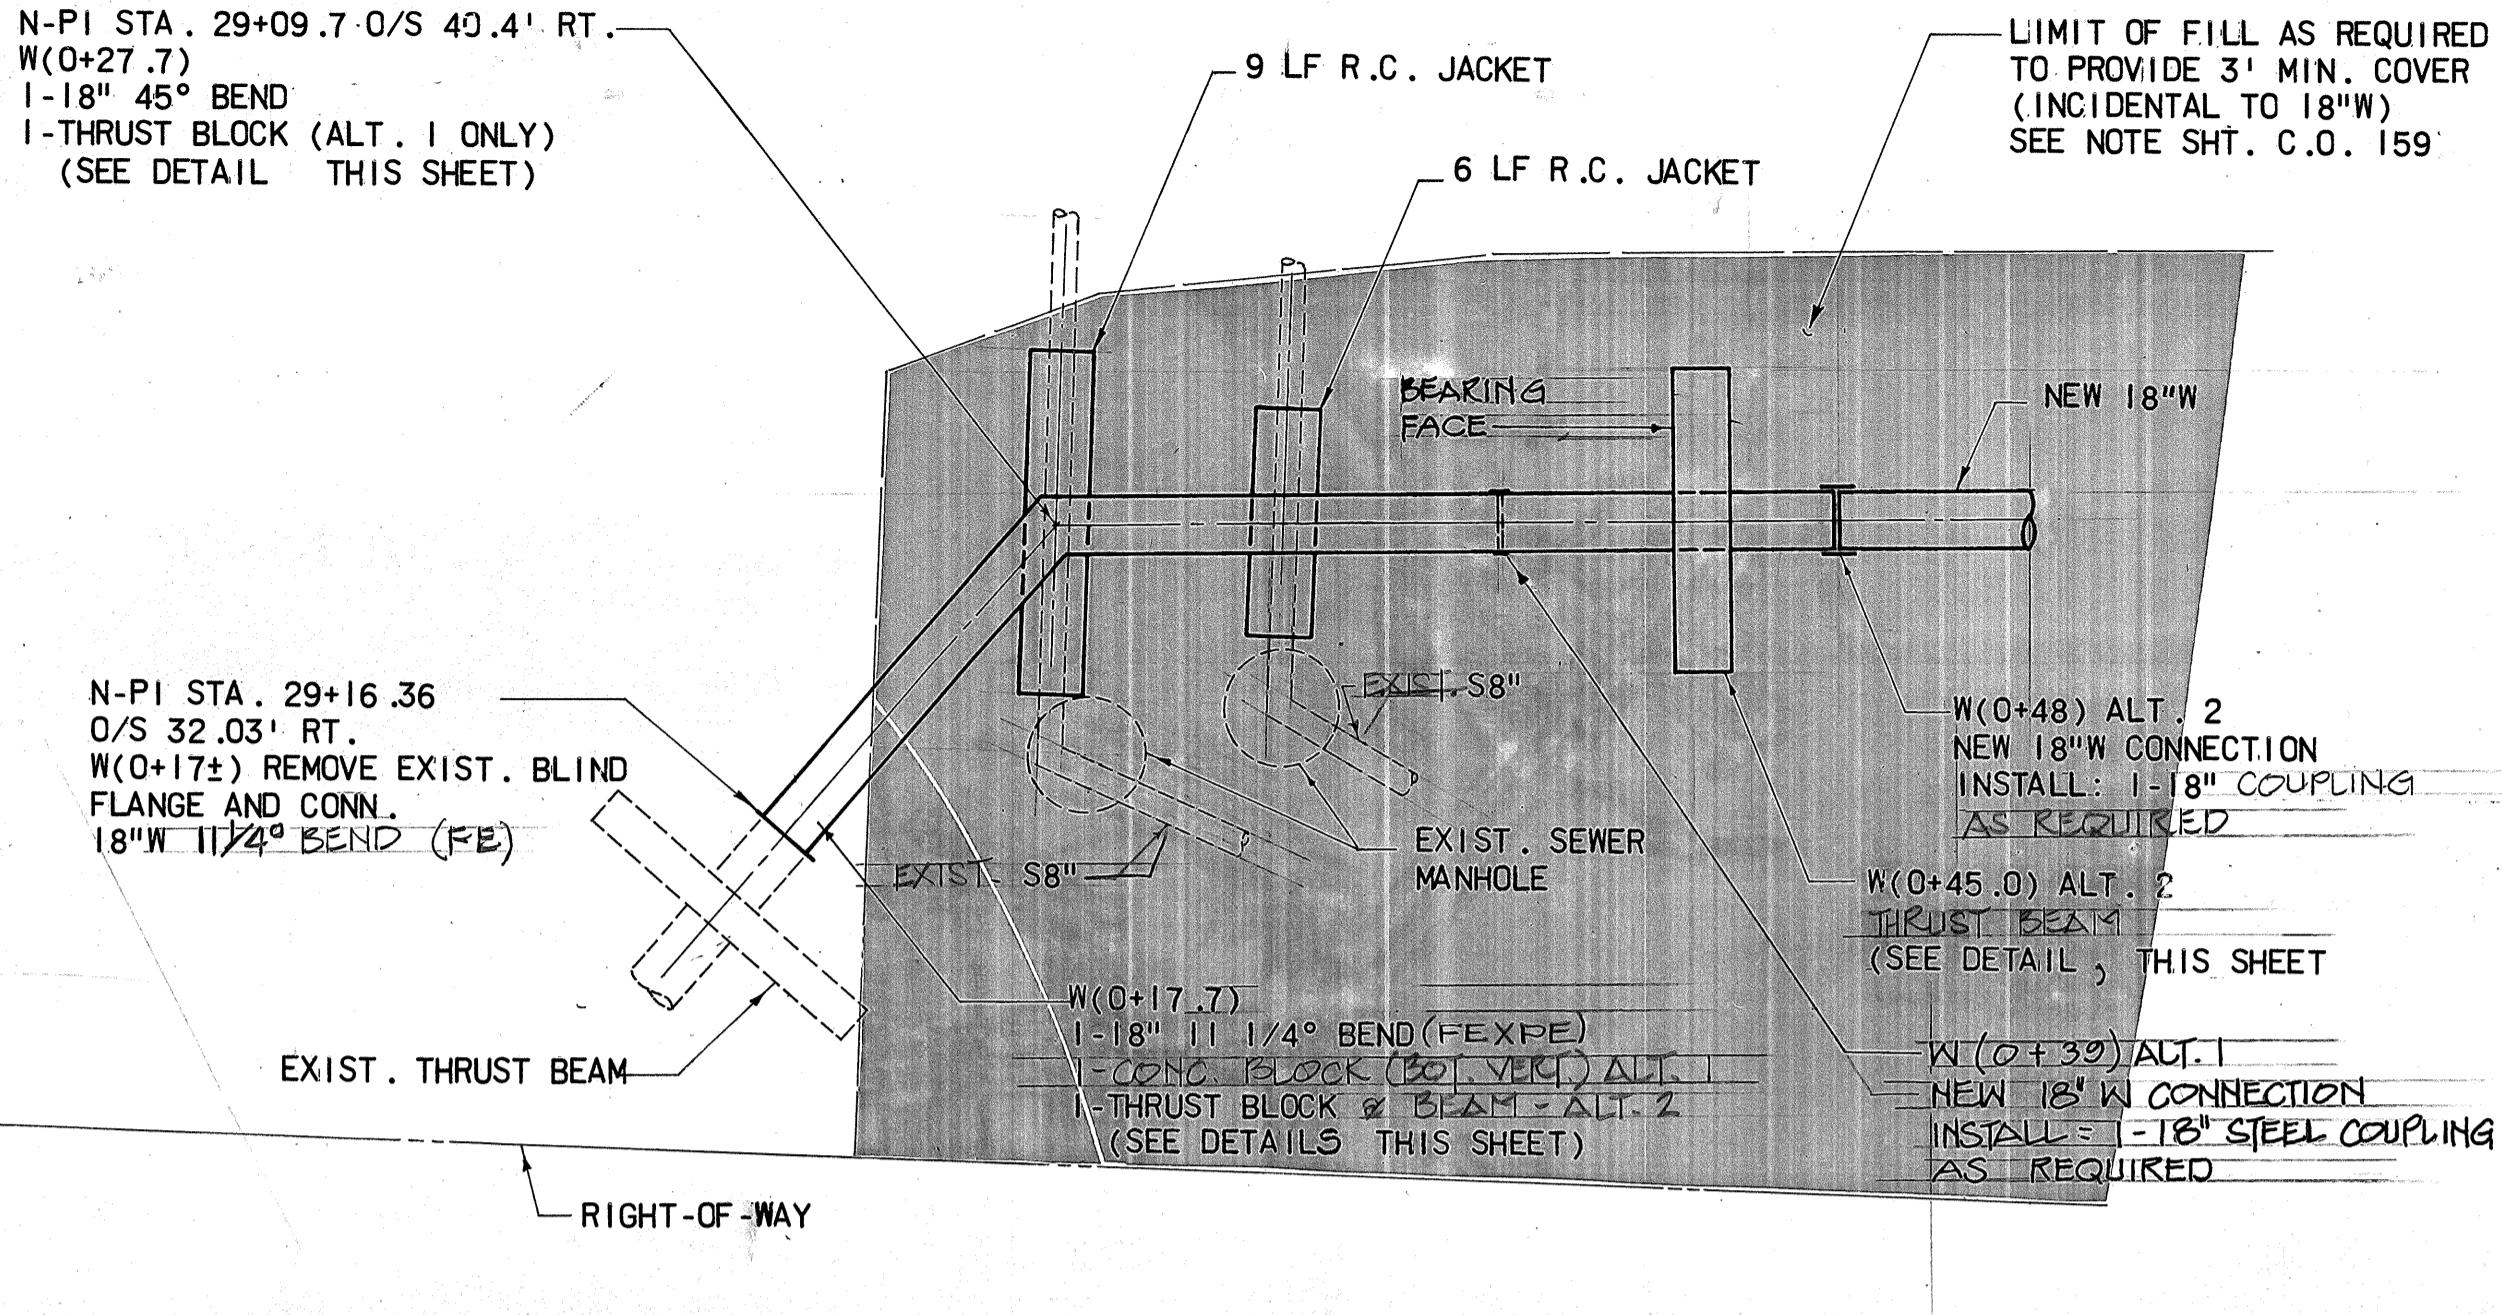



ALT. I - THRUST BLOCK DETAIL @ 45° BEND

SCALE: 3/8" = 1'-0"

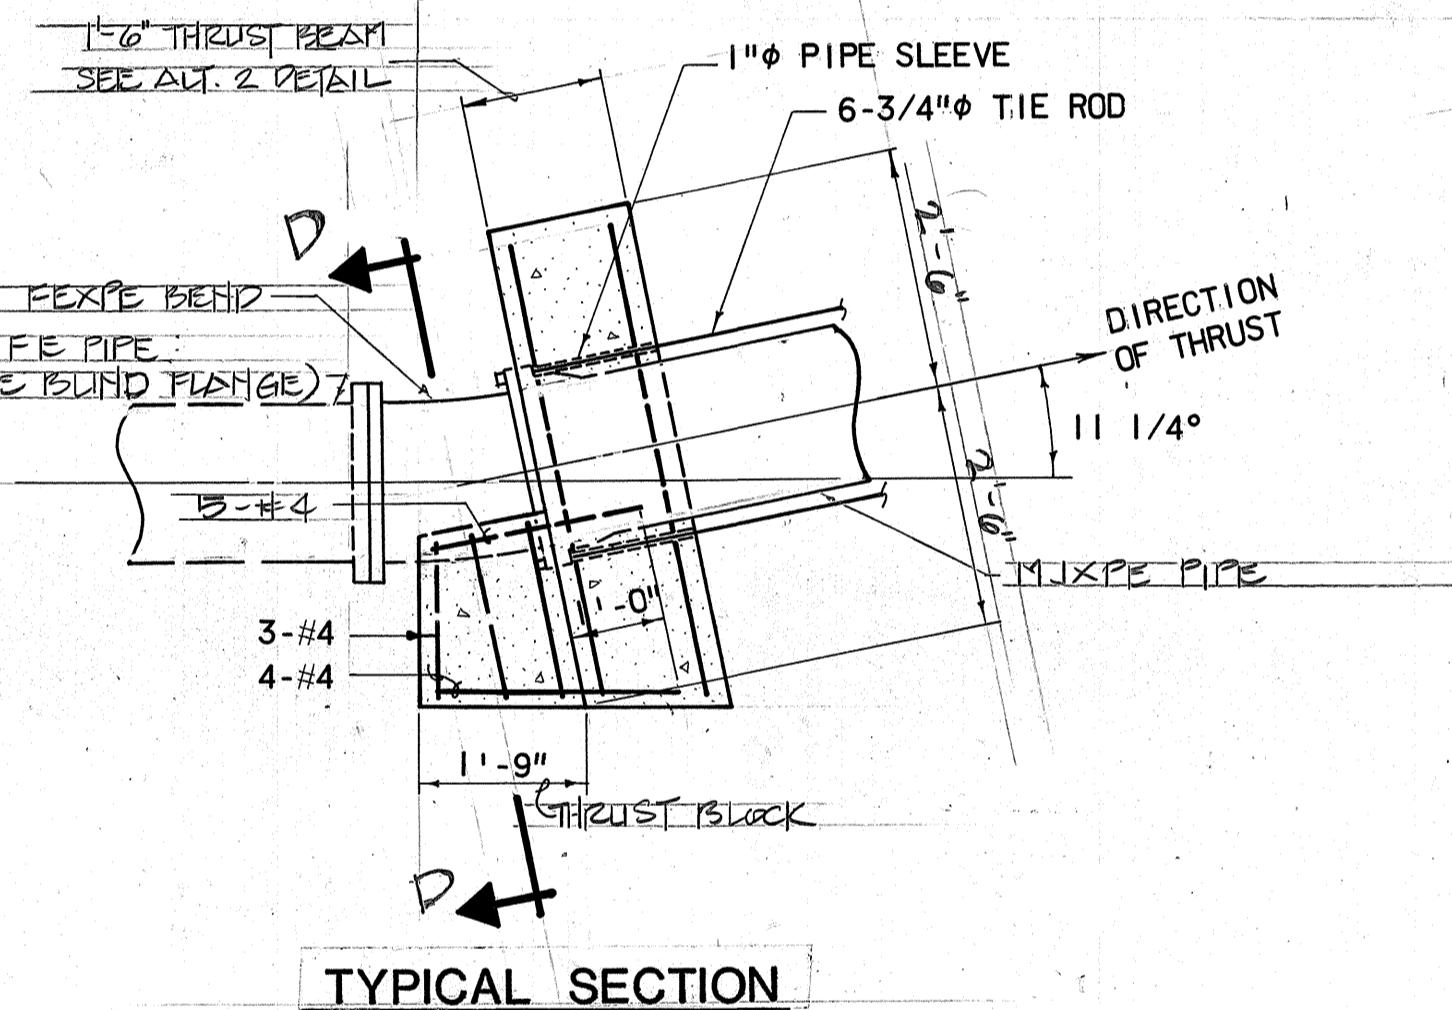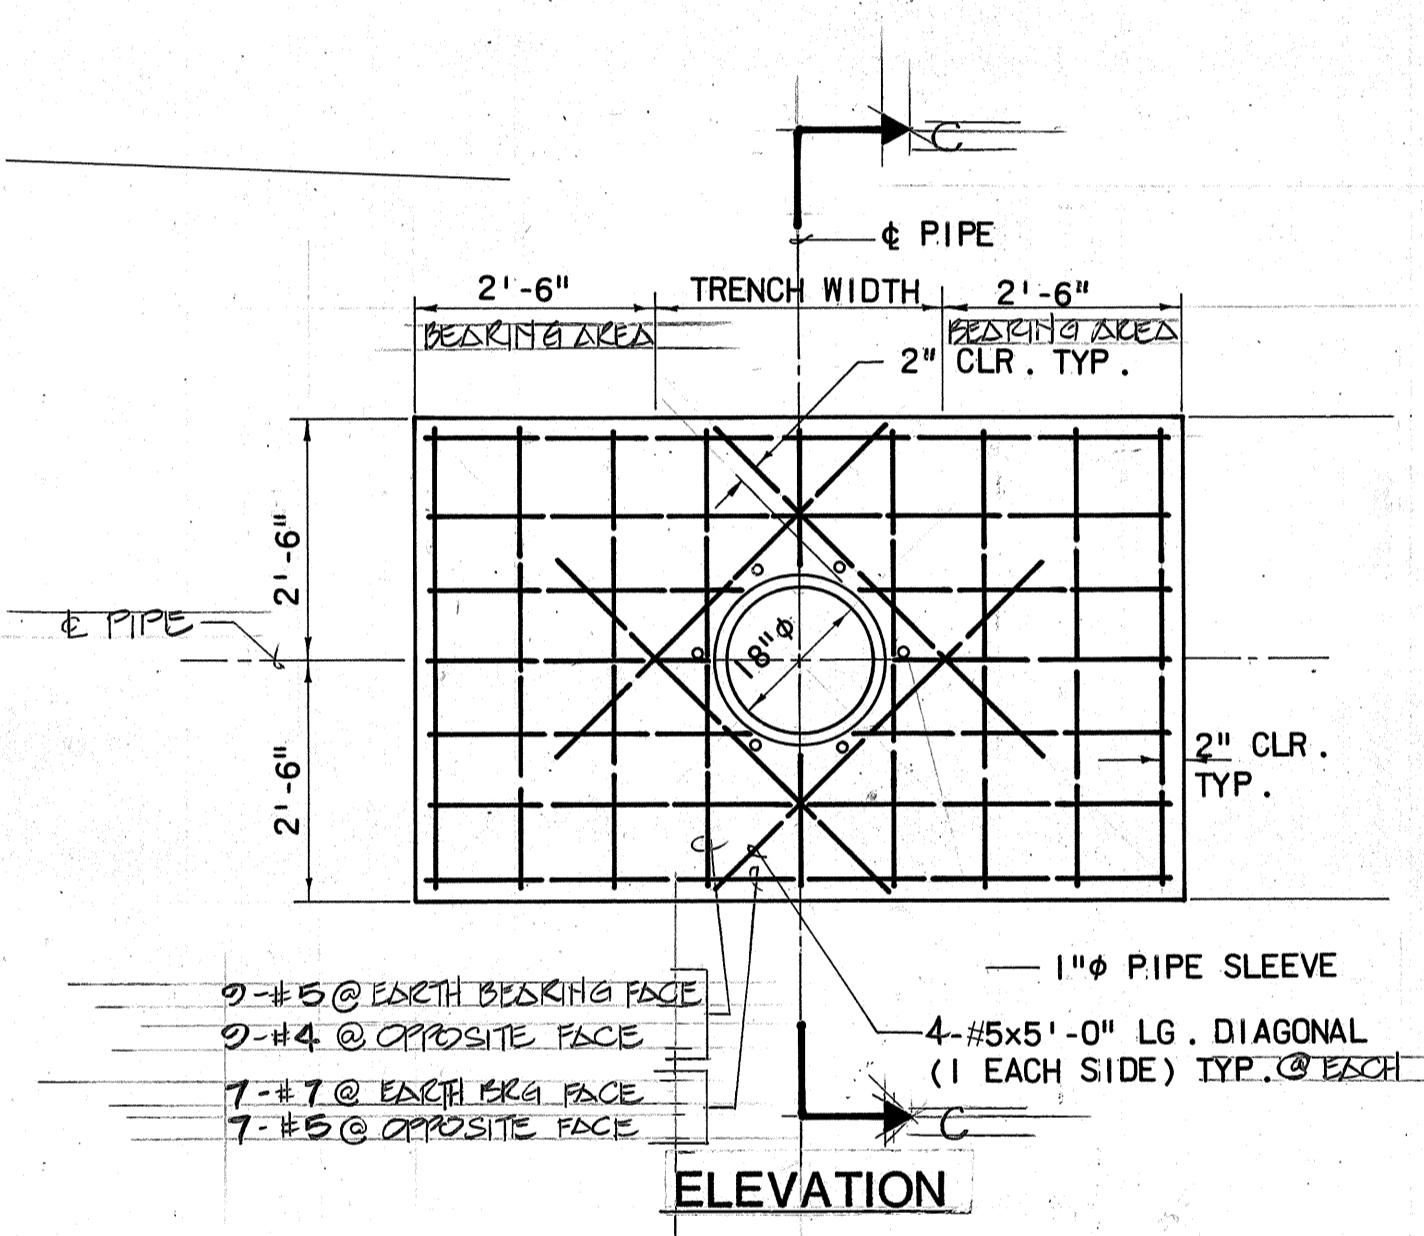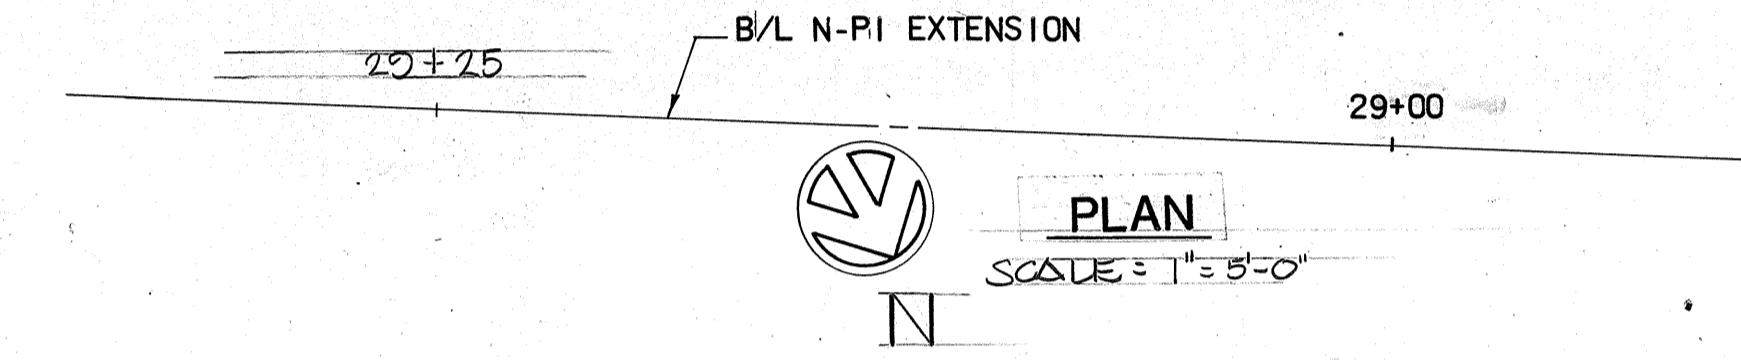

GENERAL NOTES

1. CONCRETE SHALL BE CLASS "B" WITH MINIMUM CONCRETE STRENGTH EQUAL TO 2500 PSI @ 28 DAYS.
 2. TIE RODS & BOLTS SHALL CONFORM TO THE REQUIREMENTS OF ASTM A307 OR APPROVED EQUIVALENT. $f_y=60,000$ PSI
 3. TIE RODS & BOLTS, PREPRIMED WITH AN ASPHALT TYPE PAINT SHALL RECEIVE ONE HEAVY COVER COAT OF KOPPERS INERTOL TAB STOP OR APPROVED EQUIVALENT AND AN INTERMEDIATE AND FINISH FILM AS SPECIFIED BELOW FOR FACTORY FINISHED METAL SURFACES:
INTERMEDIATE: KEELER LONG #8250 POLY-SILICONE STAINLESS STEEL PRIMER OR APPROVED EQUIVALENT, 2 MIL DFT. MIN.
FINISH: KEELER LONG POLY-SILICONE ENAMEL OR APPROVED EQUIVALENT, 2 MIL DFT. MIN.
 4. BEARING AREAS SHALL REST AGAINST UNDISTURBED GROUND.

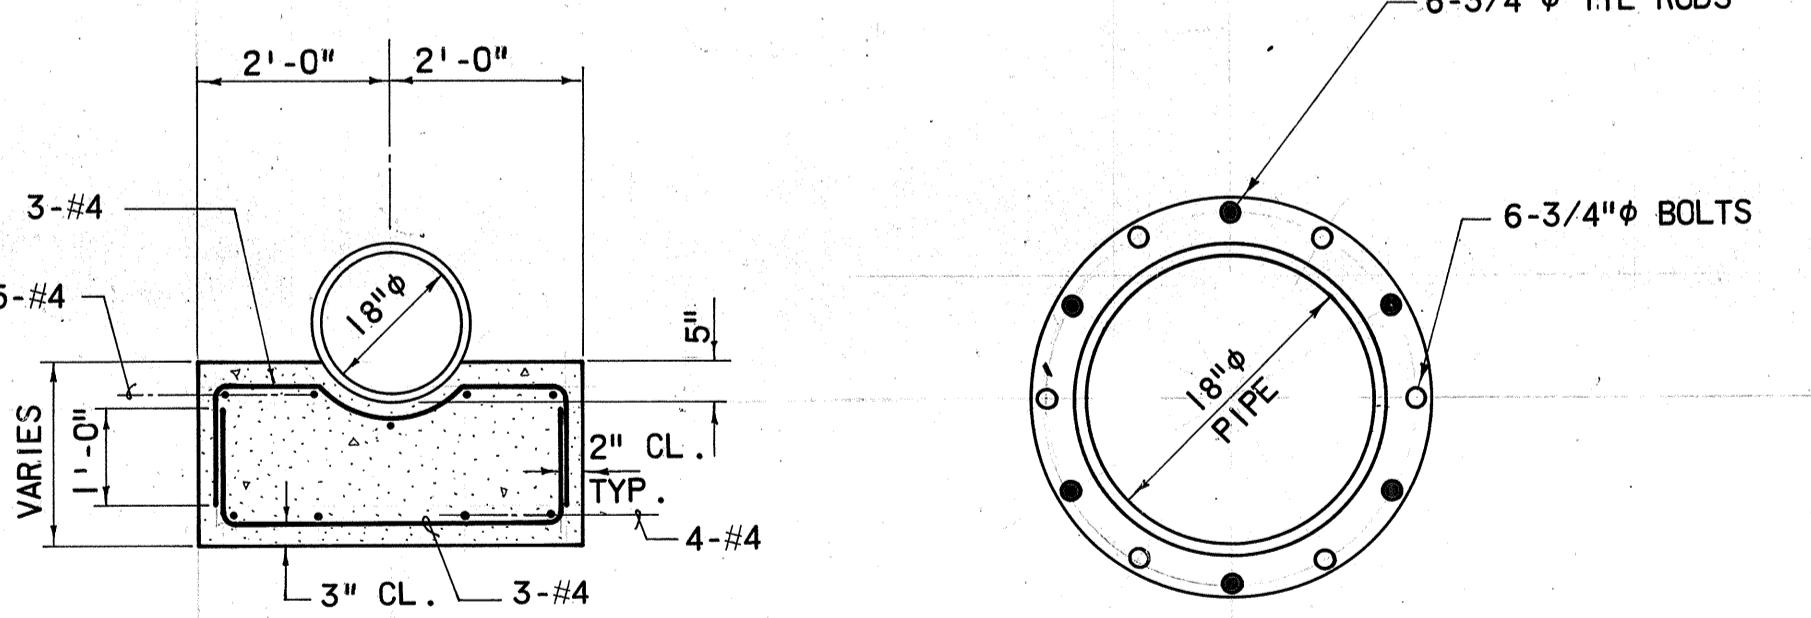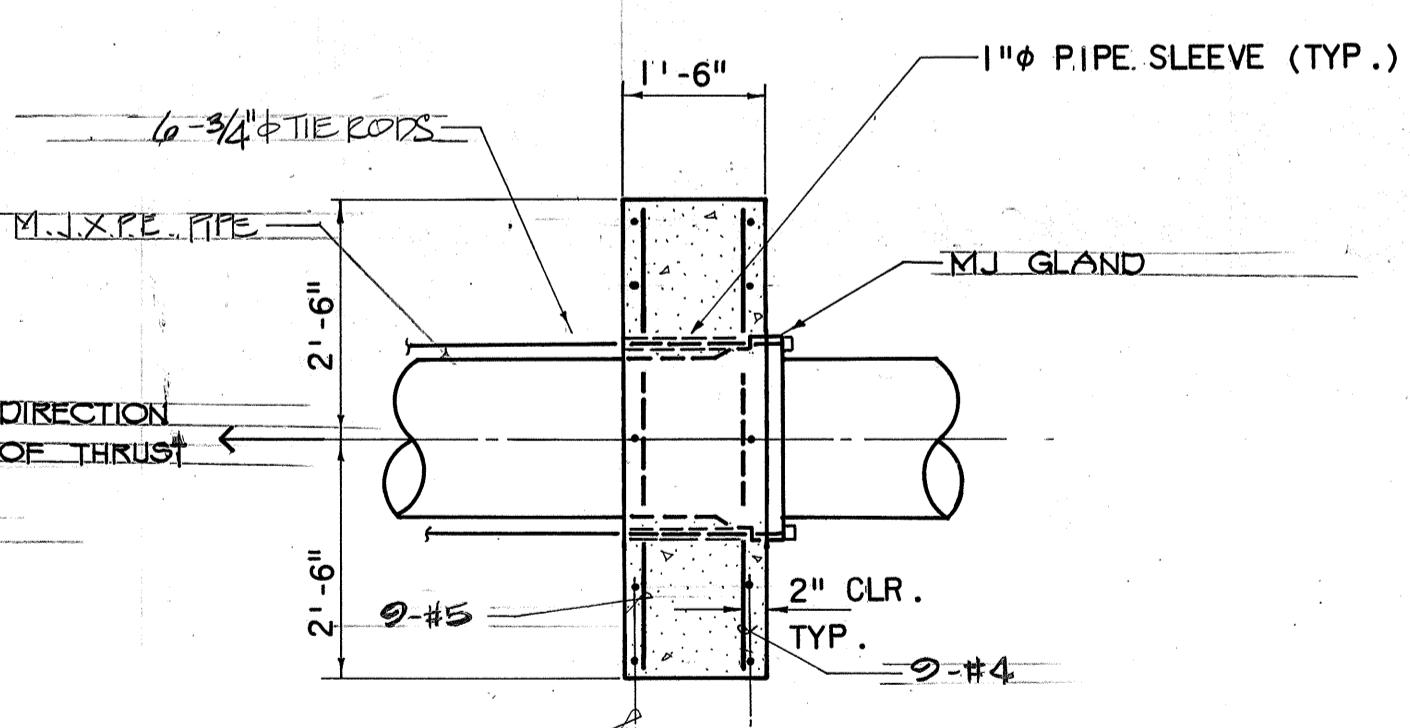


TIE ROD LOCATION

—

ALT. 2 - THRUST BLOCK DETAIL

SCALE: 3/8" = 1'-0"

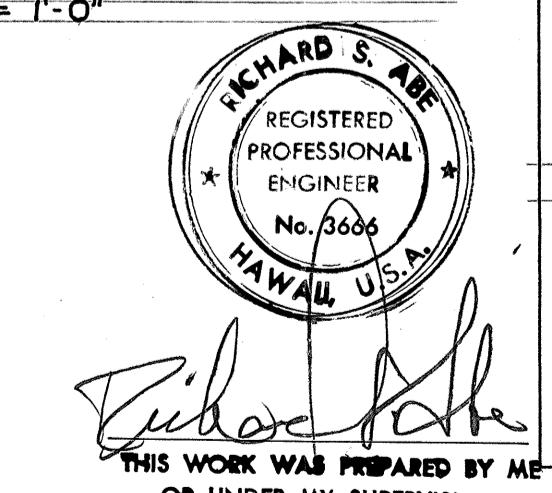

STATE OF HAWAII
DEPARTMENT OF TRANSPORTATION
HIGHWAYS DIVISION
NIMITZ SPUR

INTERSTATE ROUTE H-1
PROJ. NO. I - H-1(99):15

ALE: AS SHOWN DATE: JUNE 28,78
SHEET No. 1 OF 1 SHEETS

HEET NO. 1 OF 1 SHEETS

CO 163 A


ALTERNATIVES 1 & 2 MODIFICATIONS WATERLINE

PRINTED ON NO. 1000H CLEARPRINT


ALT. 2 - THRUST BEAM DETAIL

SCALE: 1/2" = 1'-0"

FED. ROAD DIST. NO.	STATE	FED. AID PROJ. NO.	FISCAL YEAR	SHEET NO.	TOTAL SHEETS
HAWAII	HAW.	I-HI-100:15	1977	164	350

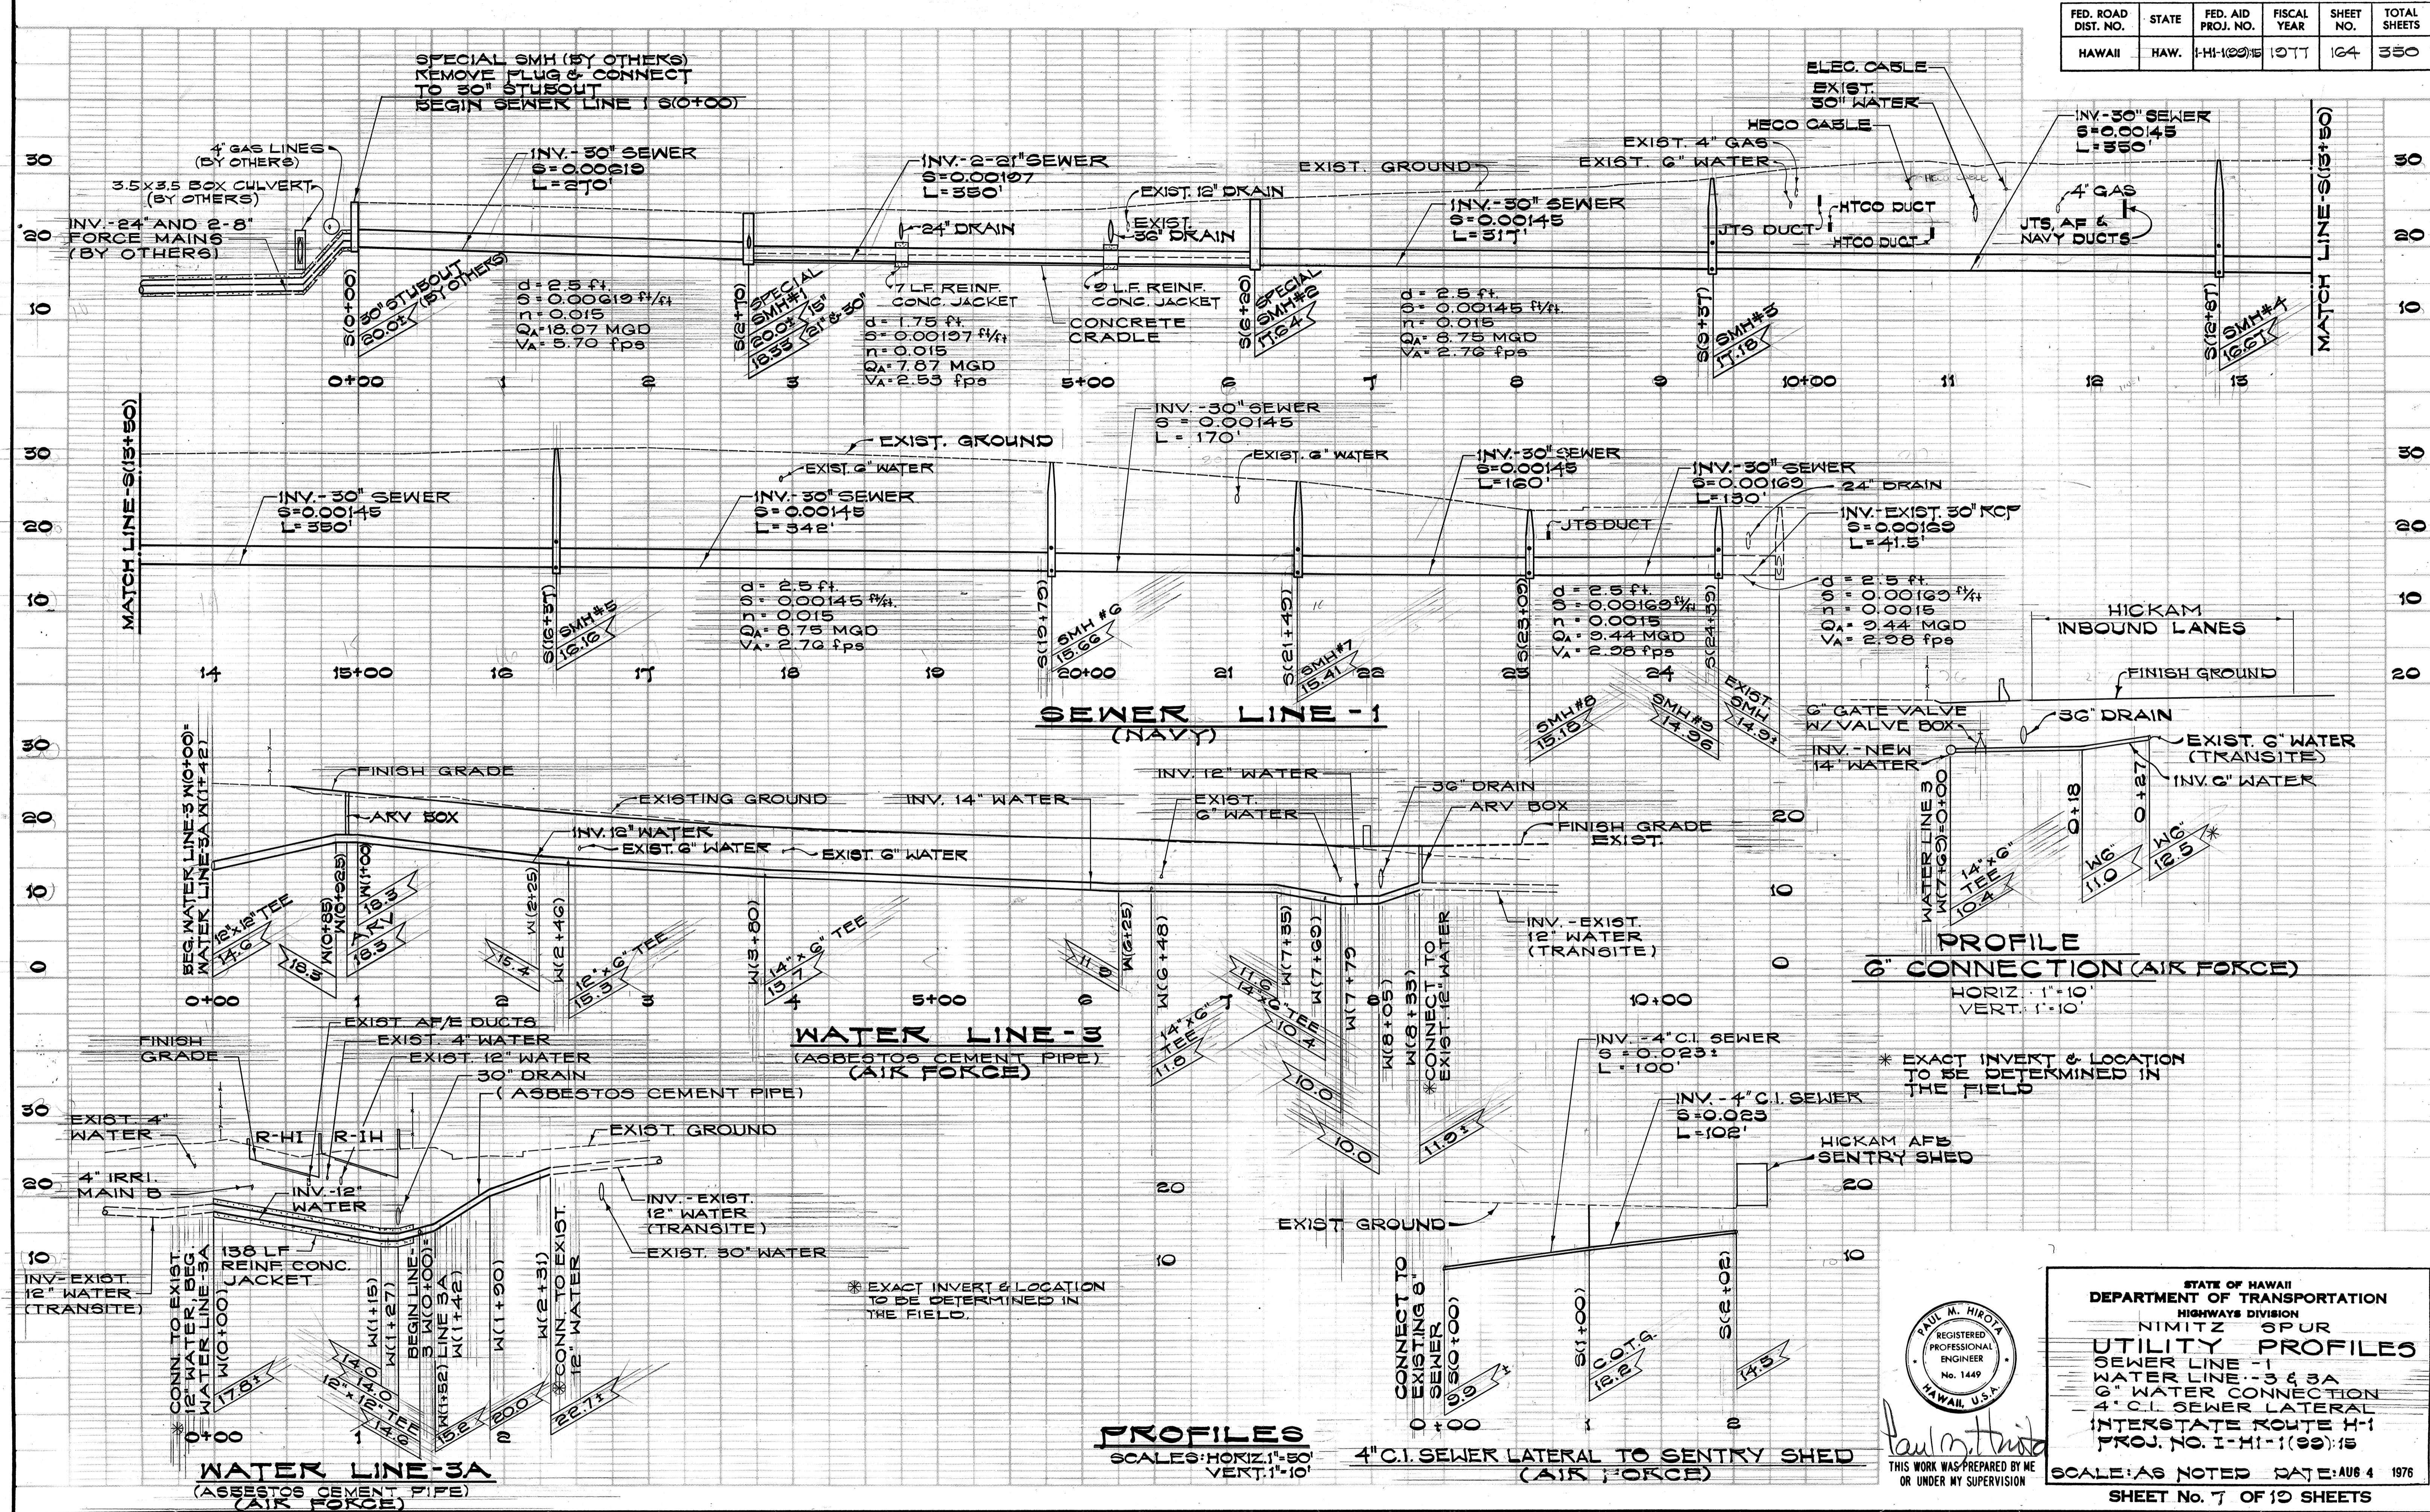


STATE OF HAWAII
DEPARTMENT OF TRANSPORTATION
HIGHWAYS DIVISION
NIMITZ SPUR
UTILITY PROFILES
SEWER LINE - 1
WATER LINE - 3 & 3A
6" WATER CONNECTION
4" C.I. SEWER LATERAL
INTERSTATE ROUTE H-1
PROJ. NO. I-HI-1 (88):15
SCALE: AS NOTED DATE: AUG 4 1976
SHEET NO. 7 OF 10 SHEETS

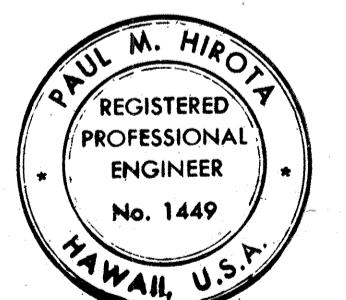


Paul M. Hirota
THIS WORK WAS PREPARED BY ME
OR UNDER MY SUPERVISION

FED. ROAD DIST. NO.	STATE	FED. AID PROJ. NO.	FISCAL YEAR	SHEET NO.	TOTAL SHEETS
HAWAII	HAW.	I-HI-1(99)15	1977	165	350

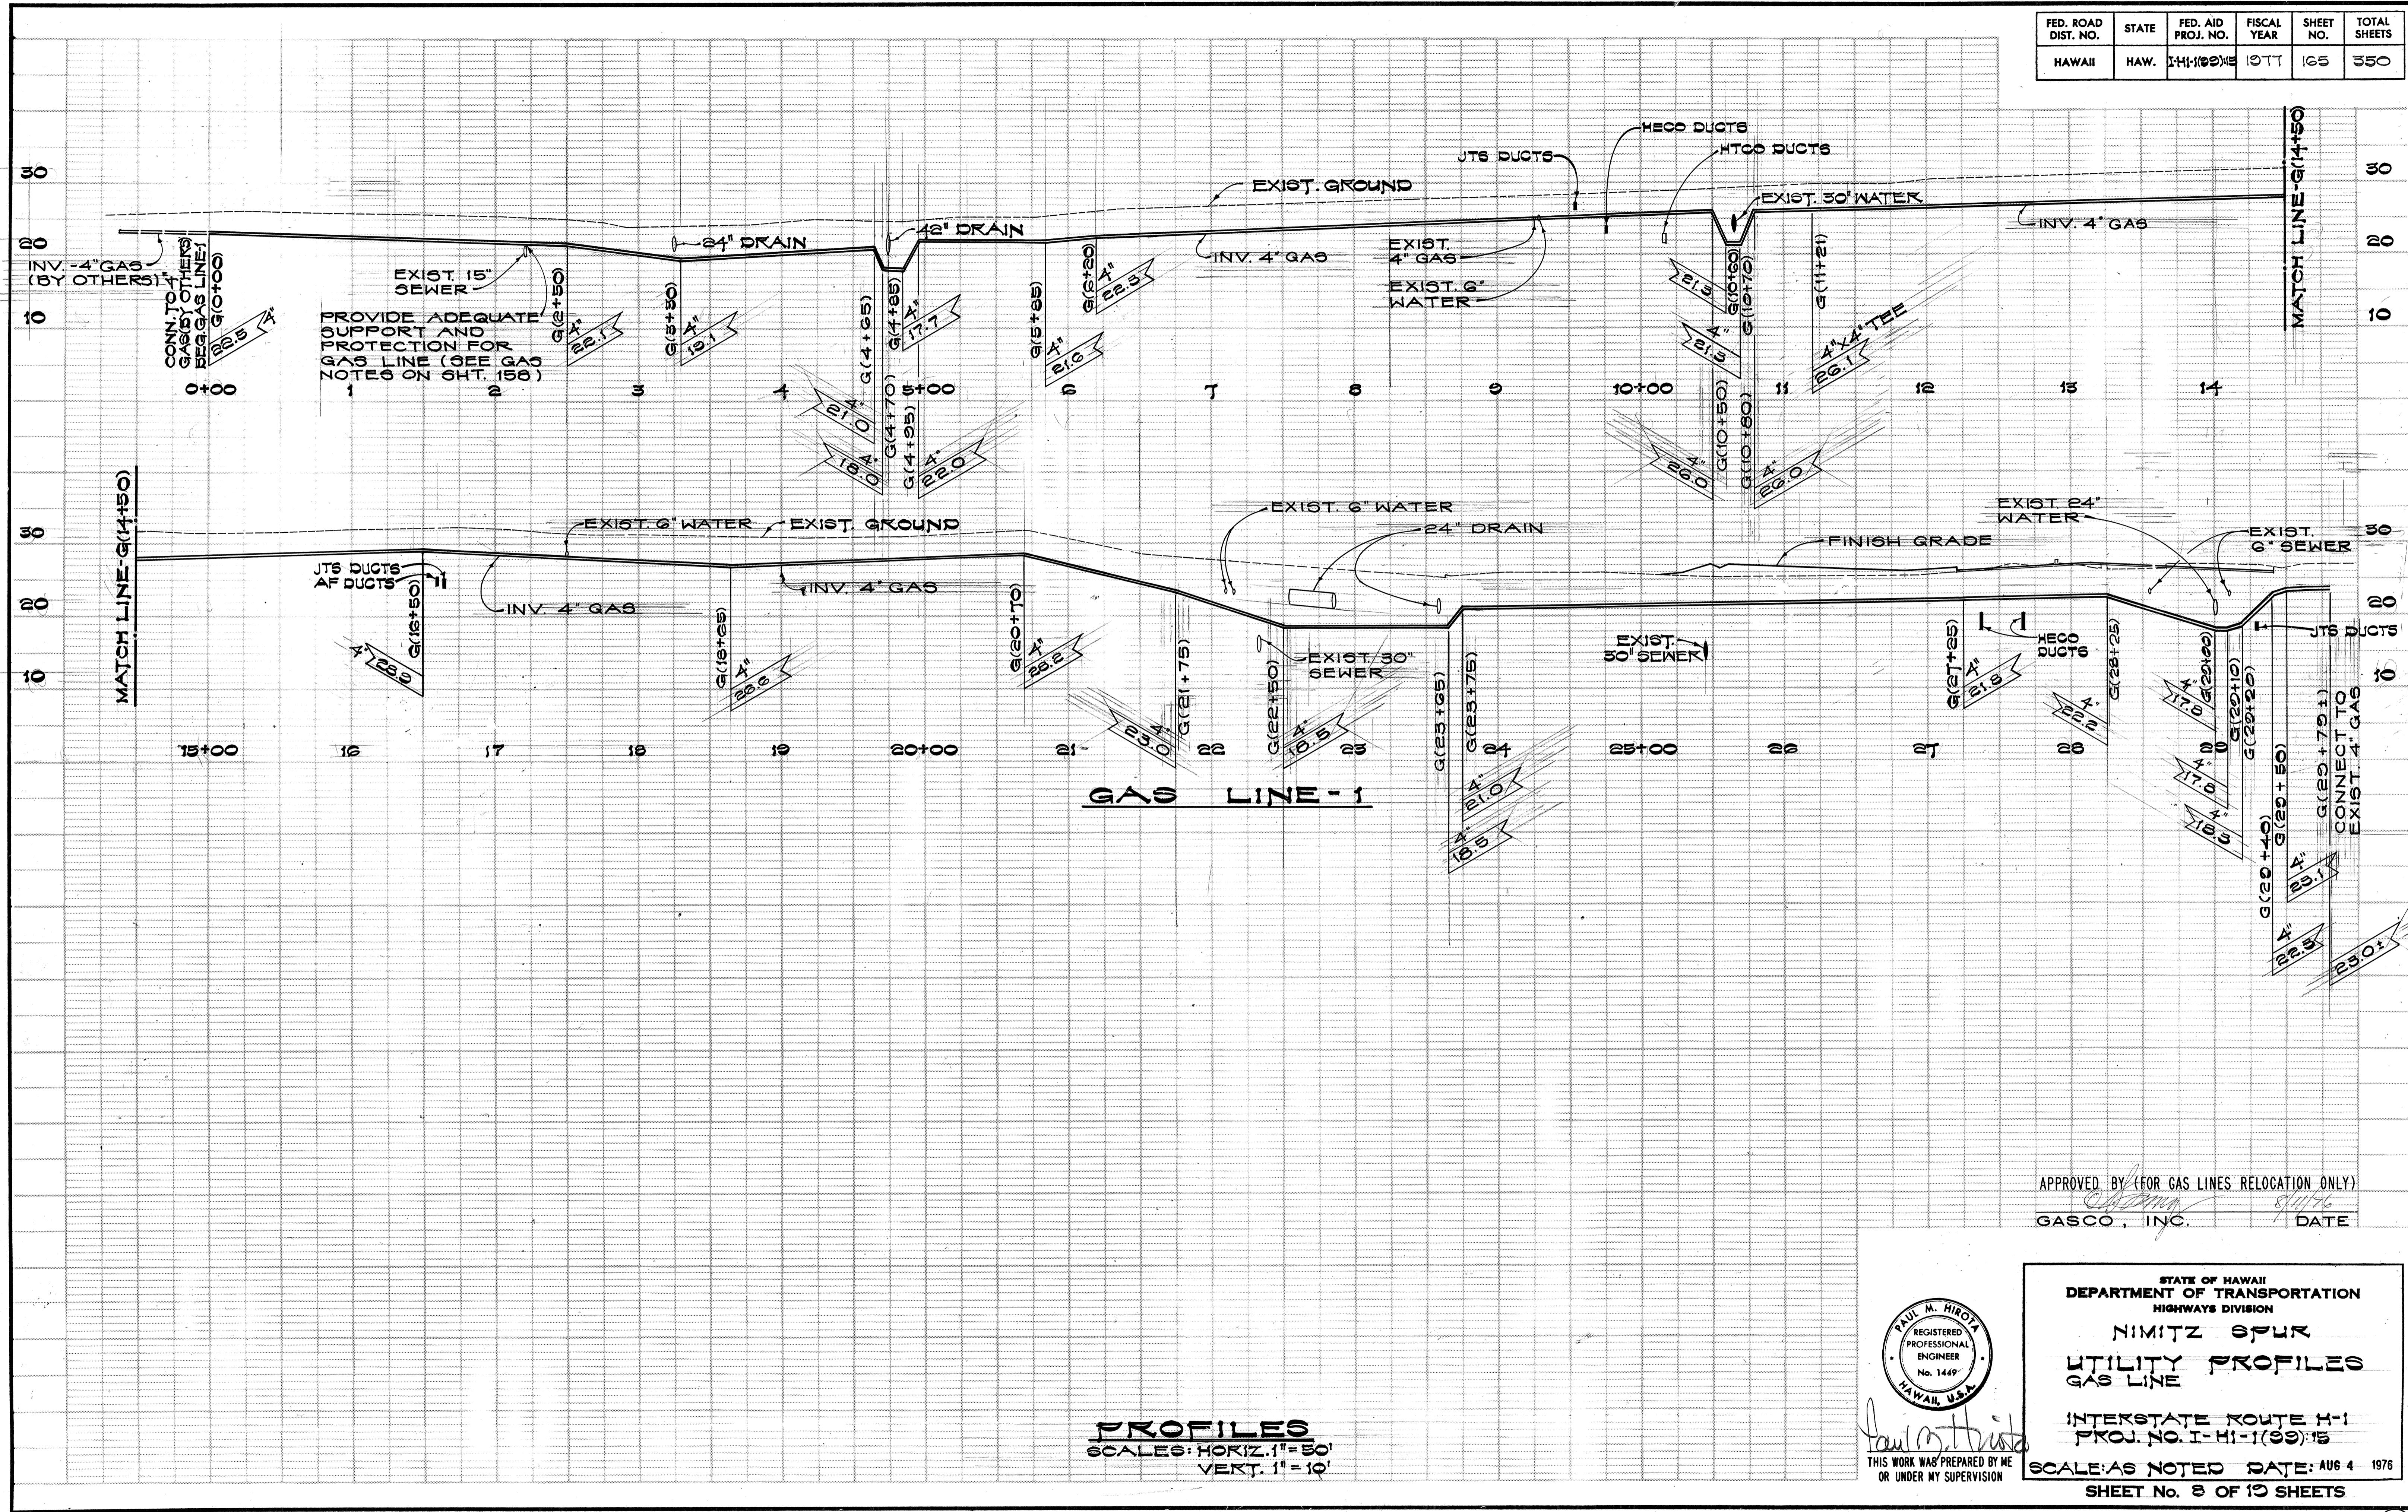

ORIGINAL	SURVEY PLOTTED BY
PLAN	DRAWN BY
NOTE BOOK	TRACED BY
CHECKED BY	QUANTIFIED BY
No.	

FED. ROAD DIST. NO.	STATE	FED. AID PROJ. NO.	FISCAL YEAR	SHEET NO.	TOTAL SHEETS
HAWAII	HAW.	I-HI-1(99)15	1977	166	350

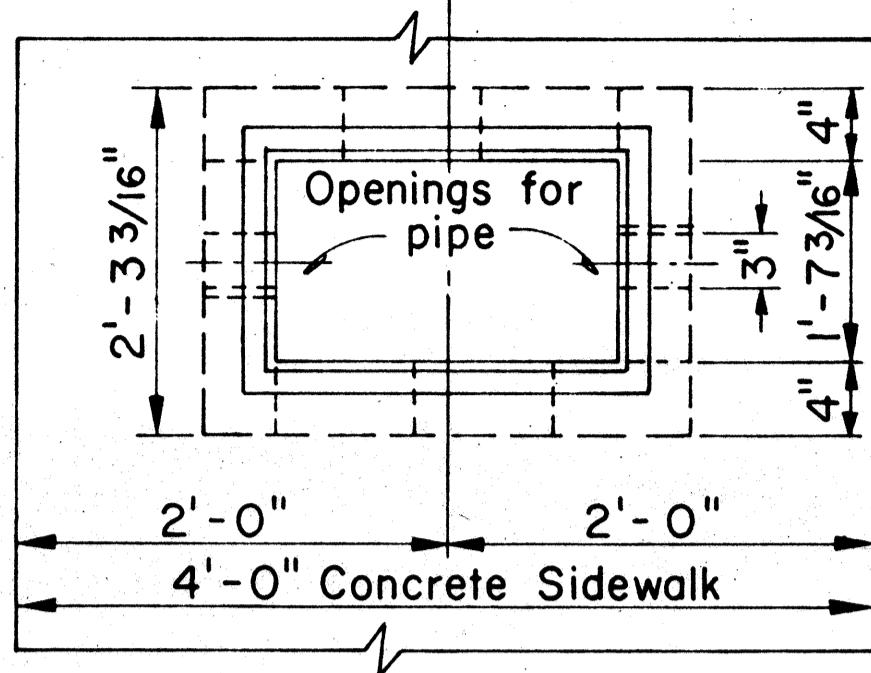

TYPE III METER BOX




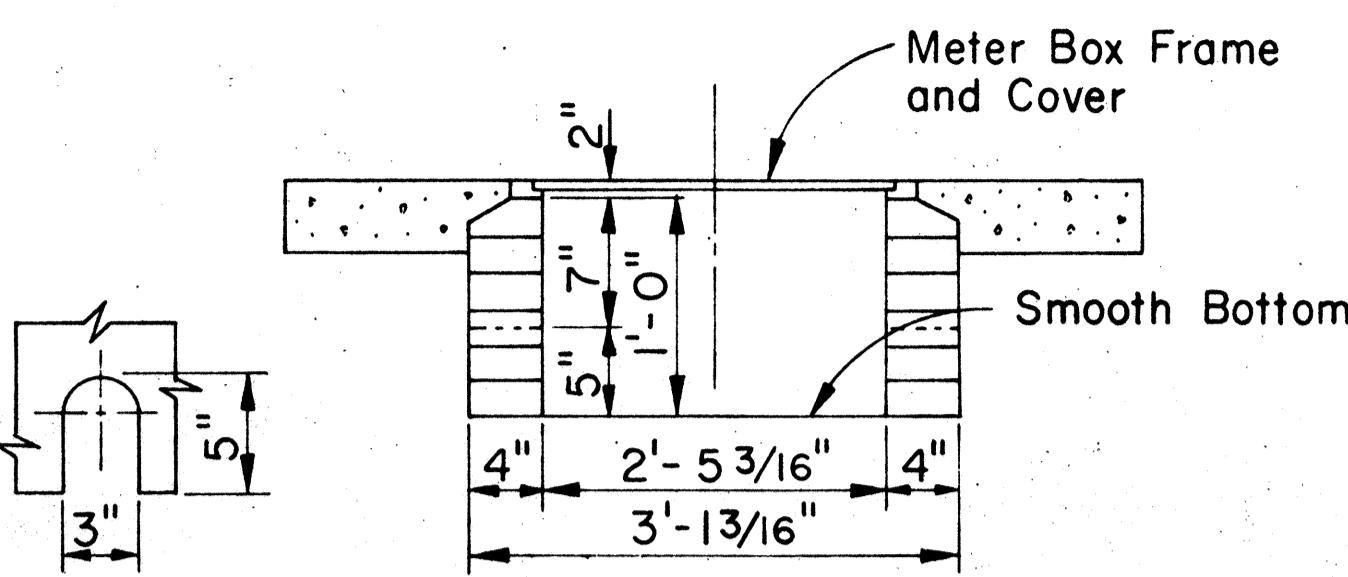



FIGURE 28

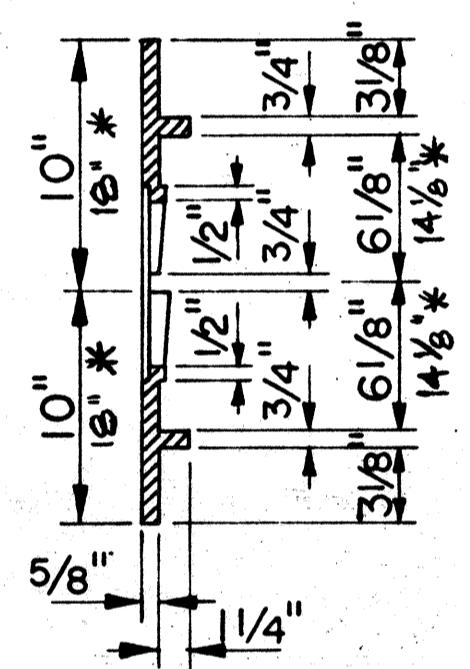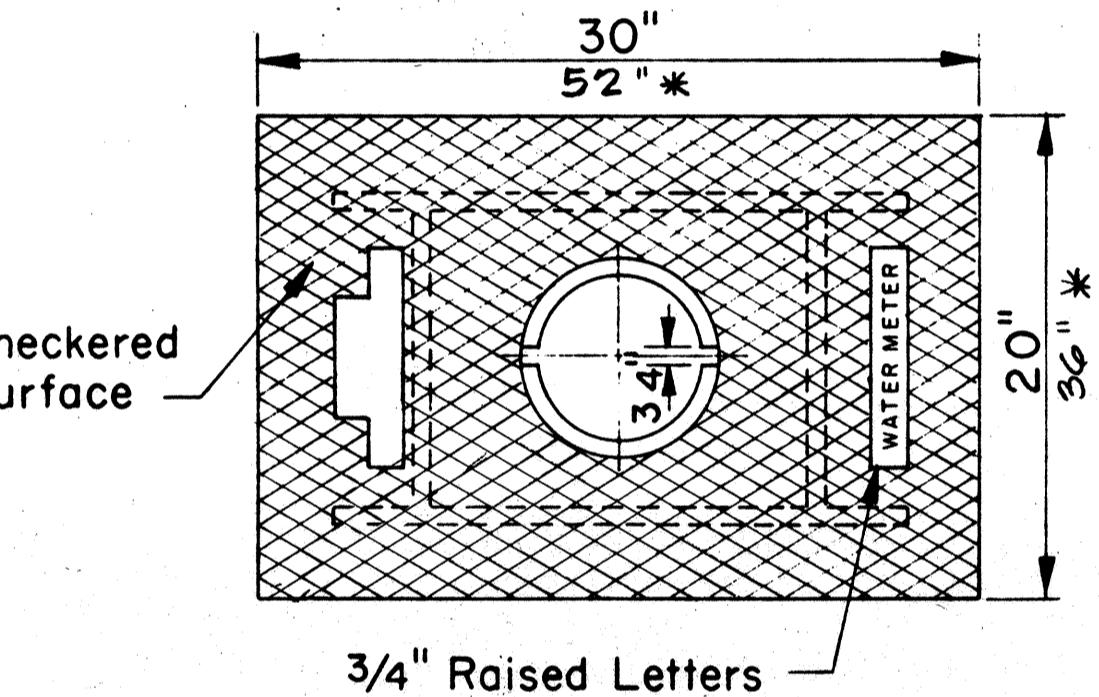

FRAME

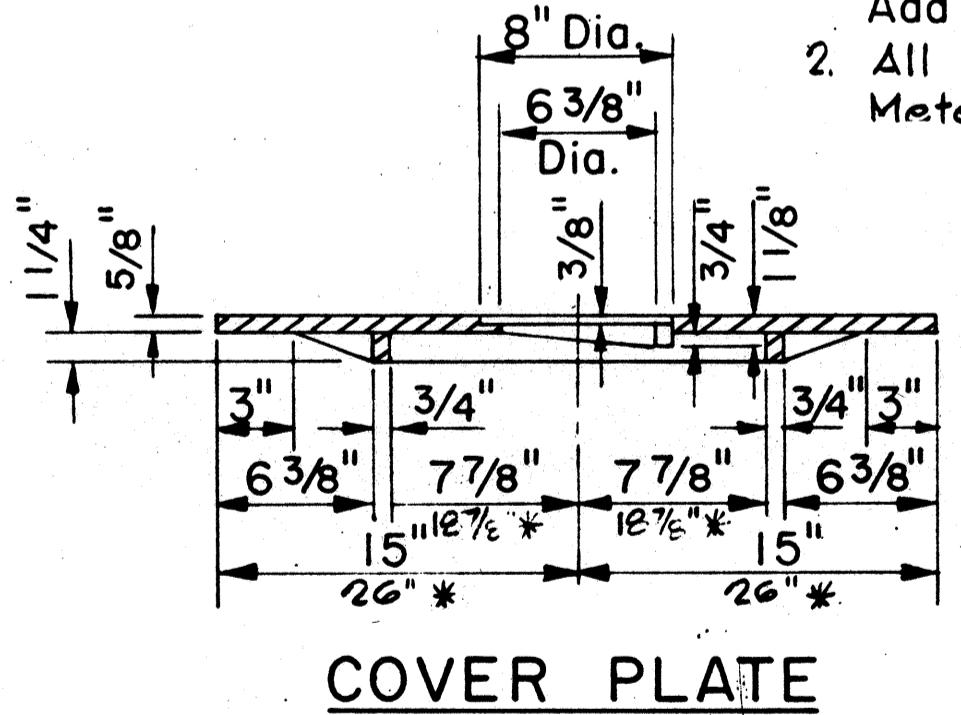

CHECKERED PATTERN

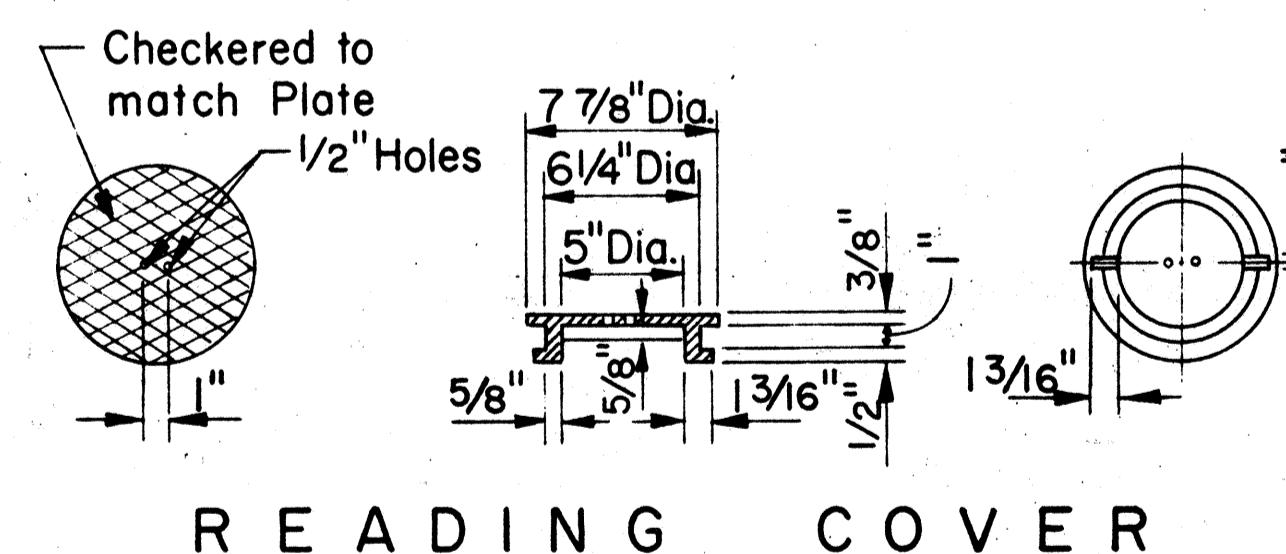

READING COVER


CAST IRON FRAME, PLATE AND COVER

TYPE III

FIGURE 28


ORIGINAL DRAWN BY
PLOTTED BY
TRACED BY
NOTE BOOK
QUANTITIES BY
CHECKED BY

PRINTED ON NO. 1000H CLEARPRINT

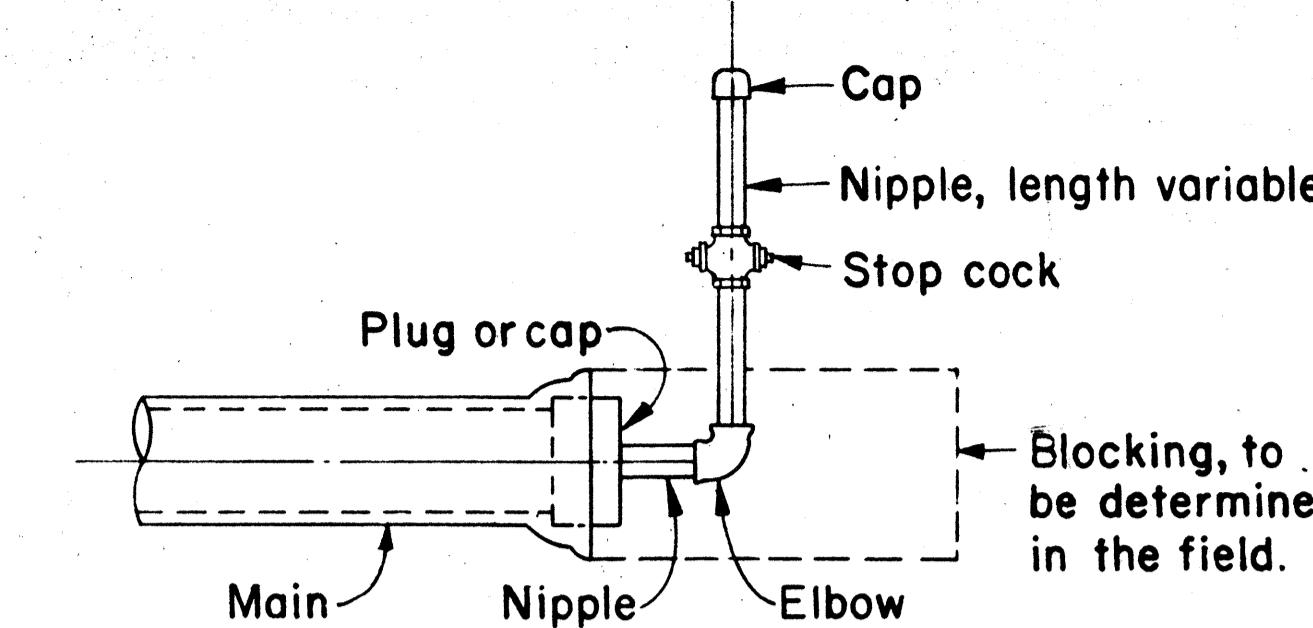

DETAIL OF TEMPORARY CLEANOUT


- NOTES:
- The sizes of cleanout unless otherwise shown on the plans or directed by the Engineer shall be:
8 inch and smaller mains - 2 1/2 inch cleanout
12 inch to 20 inch mains - 4 inch cleanout
24 inch and larger mains - 6 inch cleanout
 - TEMPORARY CLEANOUT SHALL INCLUDE THE PLUG OR CAP, CONCRETE BLOCK, AND ALL APPURTENANCES AS SHOWN. CONTRACTOR MAY UTILIZE TEMPORARY BLOCKING METHODS OTHER THAN CONCRETE TO FACILITATE REMOVAL. BLOCKING SHALL BE ADEQUATE TO WITHSTAND TEST PRESSURES.

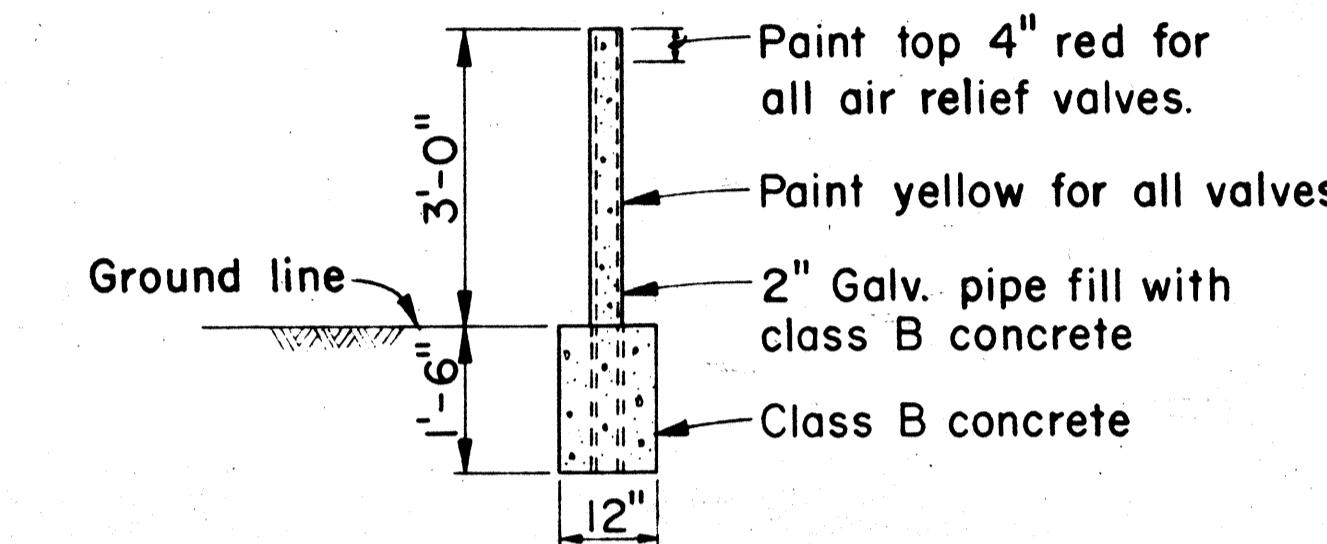

DETAIL OF VALVE MARKER


CLEANOUTS, RISERS AND VALVE MARKERS

FIGURE 16

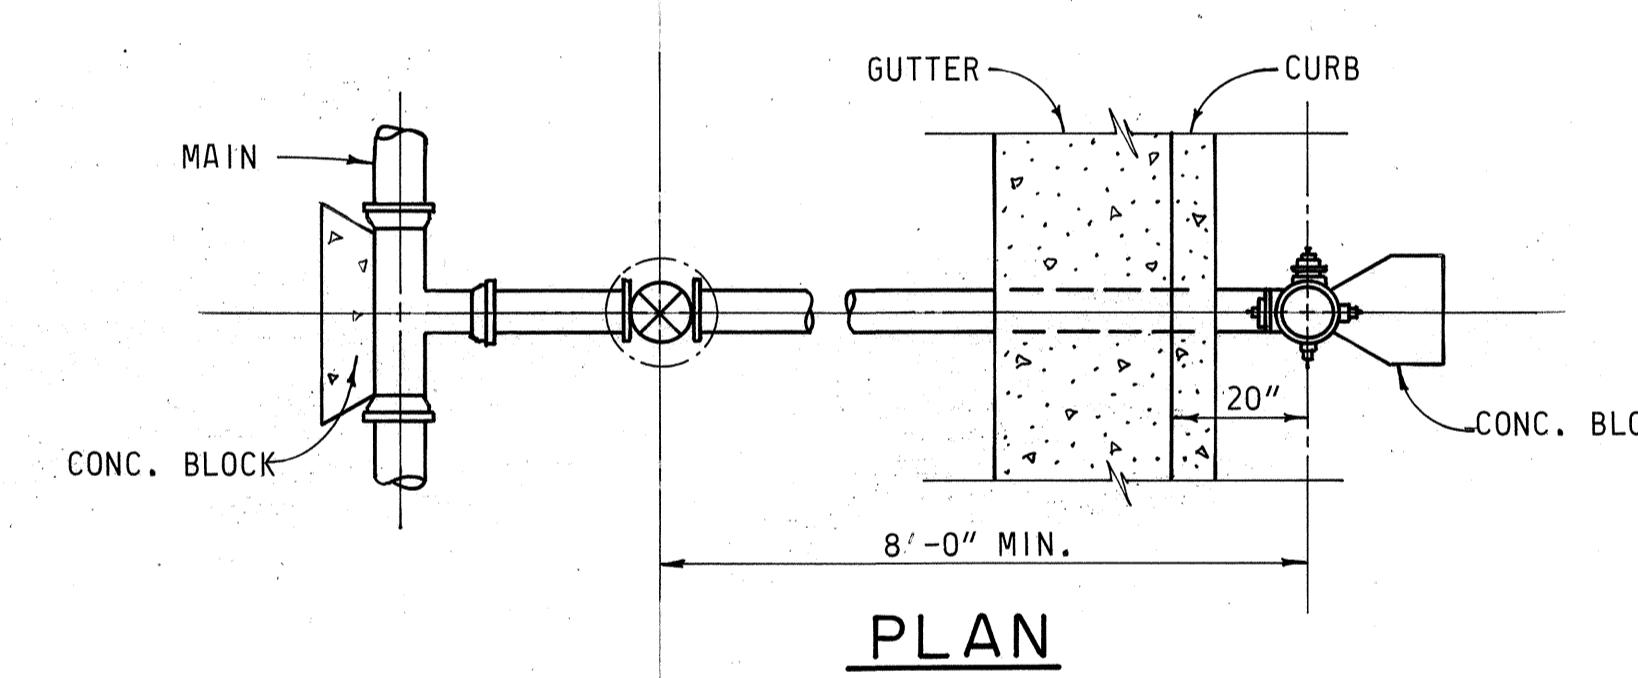


STANDARD LENGTHS FOR HYDRANT ELBOW
30"
36"
42"
48"

STANDARD HYDRANT EXTENSIONS ARE AVAILABLE IN THE FOLLOWING LENGTHS:
6 TO 30 INCHES LONG IN INCREMENTS OF 6 INCHES.

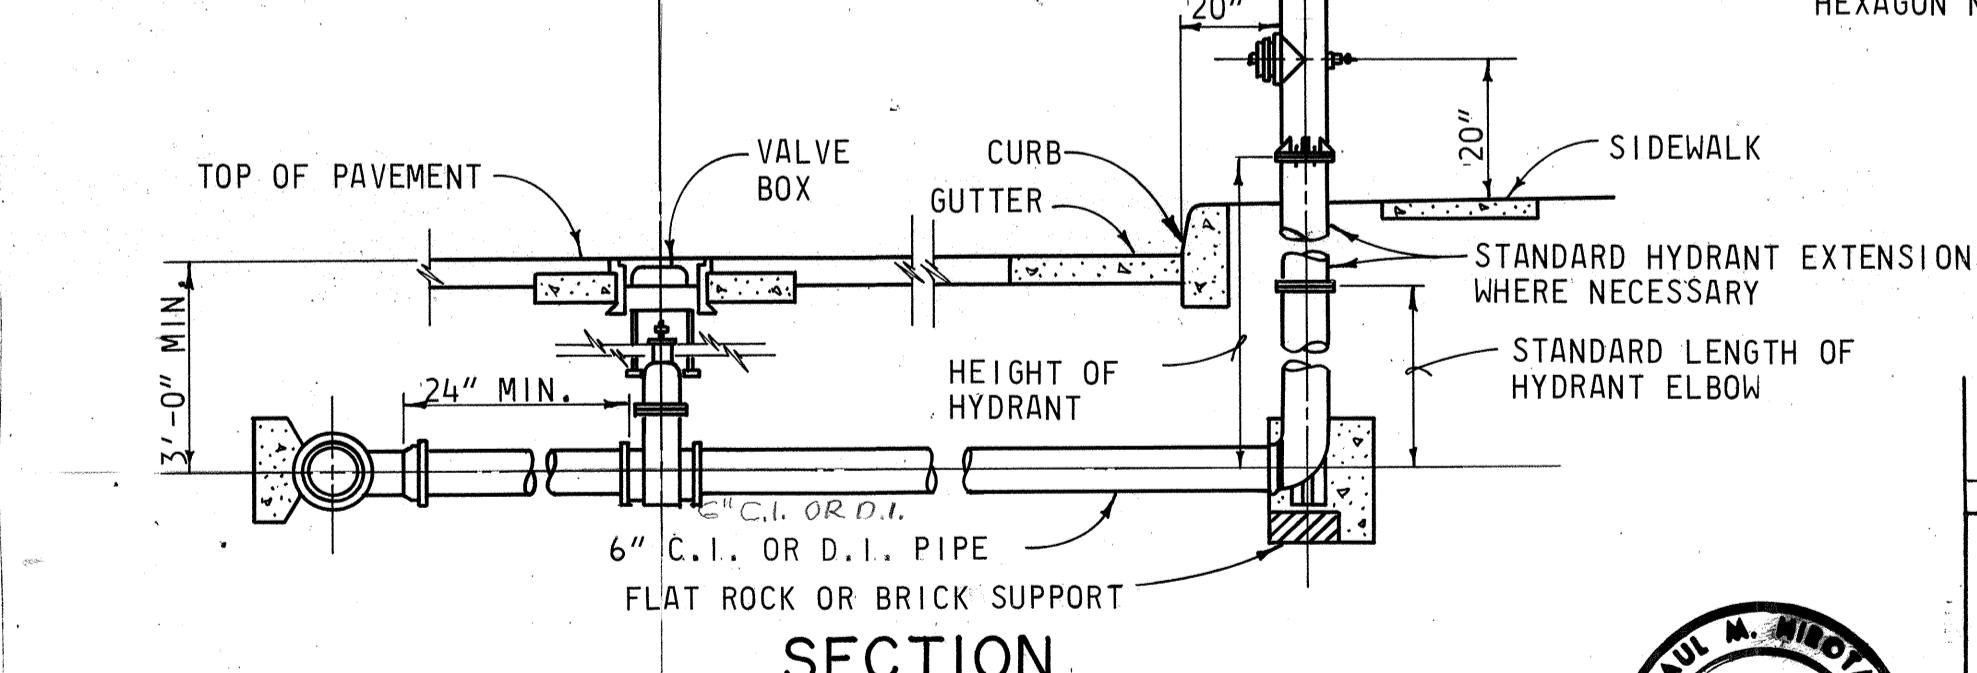

HYDRANT CONNECTION
STRAIGHT RUN

SCALE: 1/2" = 1'-0"

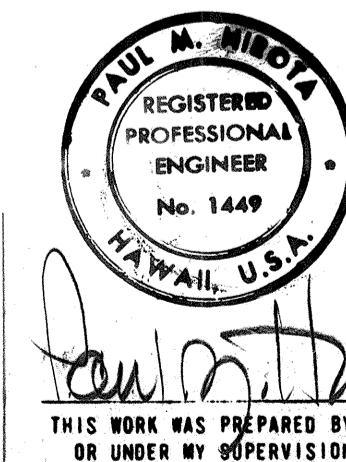

THIS WORK WAS PREPARED BY ME
OR UNDER MY SUPERVISION

FIGURE 13

12/13/76 ADDED TO CLEANOUT NOTE 2.
DATE REVISION
STATE OF HAWAII
DEPARTMENT OF TRANSPORTATION
HIGHWAYS DIVISION
NIMITZ SPUR





WATER DETAILS
INTERSTATE ROUTE H-1
PROJ. NO. I-HI-1(99) 15

SCALE AS NOTED
DATE AUG 4 1976
SHEET NO. 5 OF 10 SHEETS

ADD. 166

All dimensions are in inches. Thread dimensions must be as shown. Dimensions A, C and D may vary but shall not be less than the minimums shown in the accompanying table. Minimum acceptable weight of complete fitting may be 5% less than average weight. Metal composition shall conform to A.S.T.M. Designation B 62. The stopcock shall have either a raised boss or a groove cut into the head to indicate the open and closed position of the stopcock. The net area (in square inches) of the opening through the stopcock shall be not less than that shown in the accompanying table (E). The taper of the plug of the stopcock shall be approximately $1\frac{1}{8}$ inches to the foot. Suitable markings on all stopcocks must be made to indicate the manufacturer.

SIZE	Minim- um A	Pipe Thread B	Min- um C	Min- um D	Average Weight of Complete Fitting lbs. oz.	Minim- um E
1/2	1 1/8	1/2"	3/8	5/8	0 9	0.190
3/4	1 3/8	3/4"	9/16	5/8	1 2	0.428
1	1 5/8	1 "	5/8	5/8	1 10	0.746
1 1/4	2	1 1/4"	11/16	5/8	2 12	1.166
1 1/2	2 3/8	1 1/2"	3/4	3/4	4 0	1.679
2	2 7/8	2 "	7/8	7/8	6 11	2.922
2 1/2	3 5/8	2 1/2"	13/16	15/16	10 6	4.000

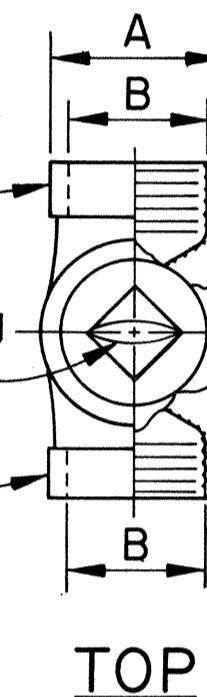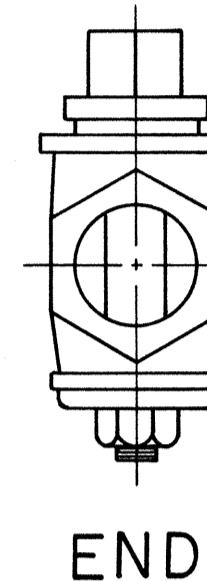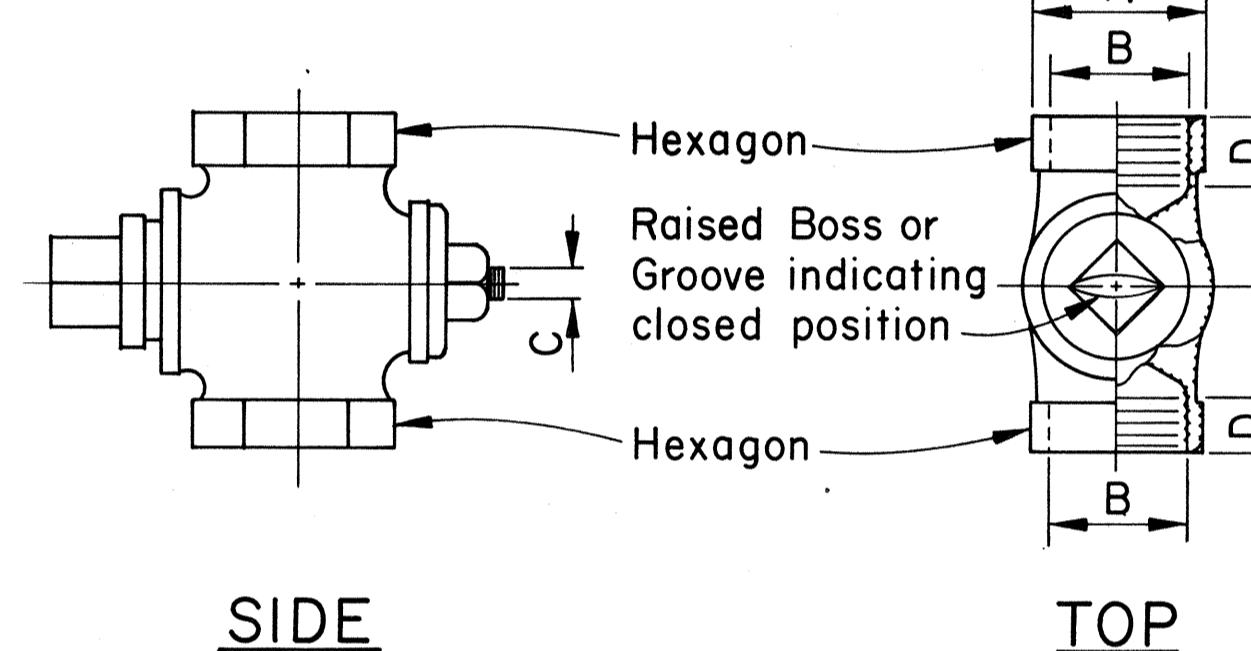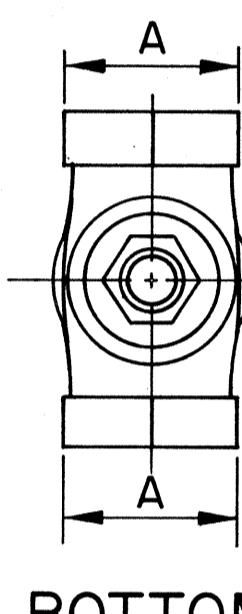

STOP COCK
NOT TO SCALE

FIGURE 31

ORIGINAL PLAN
DRAWN BY _____
TADED BY _____
NOTE BOOK
QUANTITIES BY
CHECKED BY
No. _____

NOTE:
For 2" air relief valve, size of corp. stop shall be $1\frac{1}{2}" \times 2"$. Union, vertical check valve and nipple shall be 2".

Vertical check valve required when air relief valve is immersed in water.

STANDARD CONNECTION FOR AIR RELIEF VALVE
NOT TO SCALE


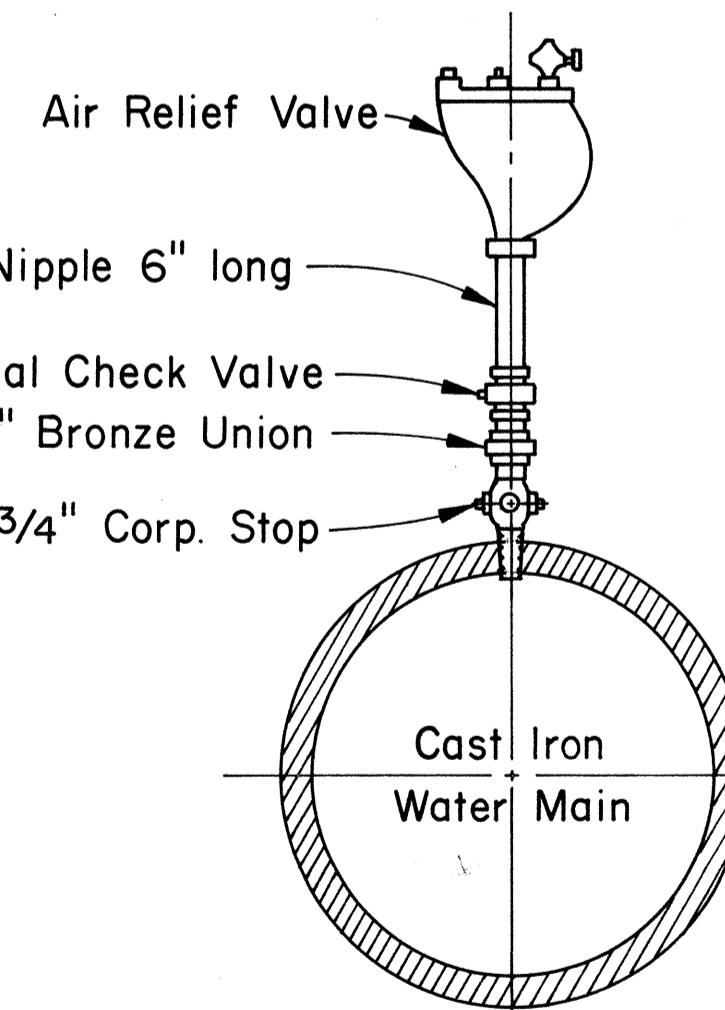



FIGURE 32

LIST OF MATERIALS

ITEM	NO. REQ.	DESCRIPTION
1	1	1 1/2" x 2" Corporation Stop
2	2	2" Union, bronze
3	3	2" 90° Elbow, bronze
4	2	2" Brass Pipe, cut to fit
5	3	2" Street Elbow
6	1	2" Stop Cock
7	2	Brick Support
8	1	2" Dia. x 4" Nipple, brass
9	1	2" Air Relief Valve
10	2	2" Dia. x 6" Nipple, brass

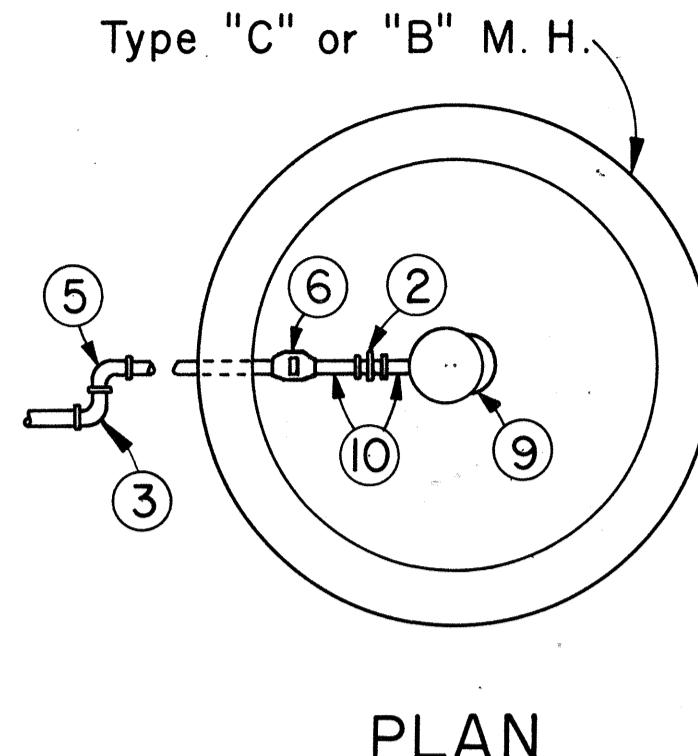

PLAN

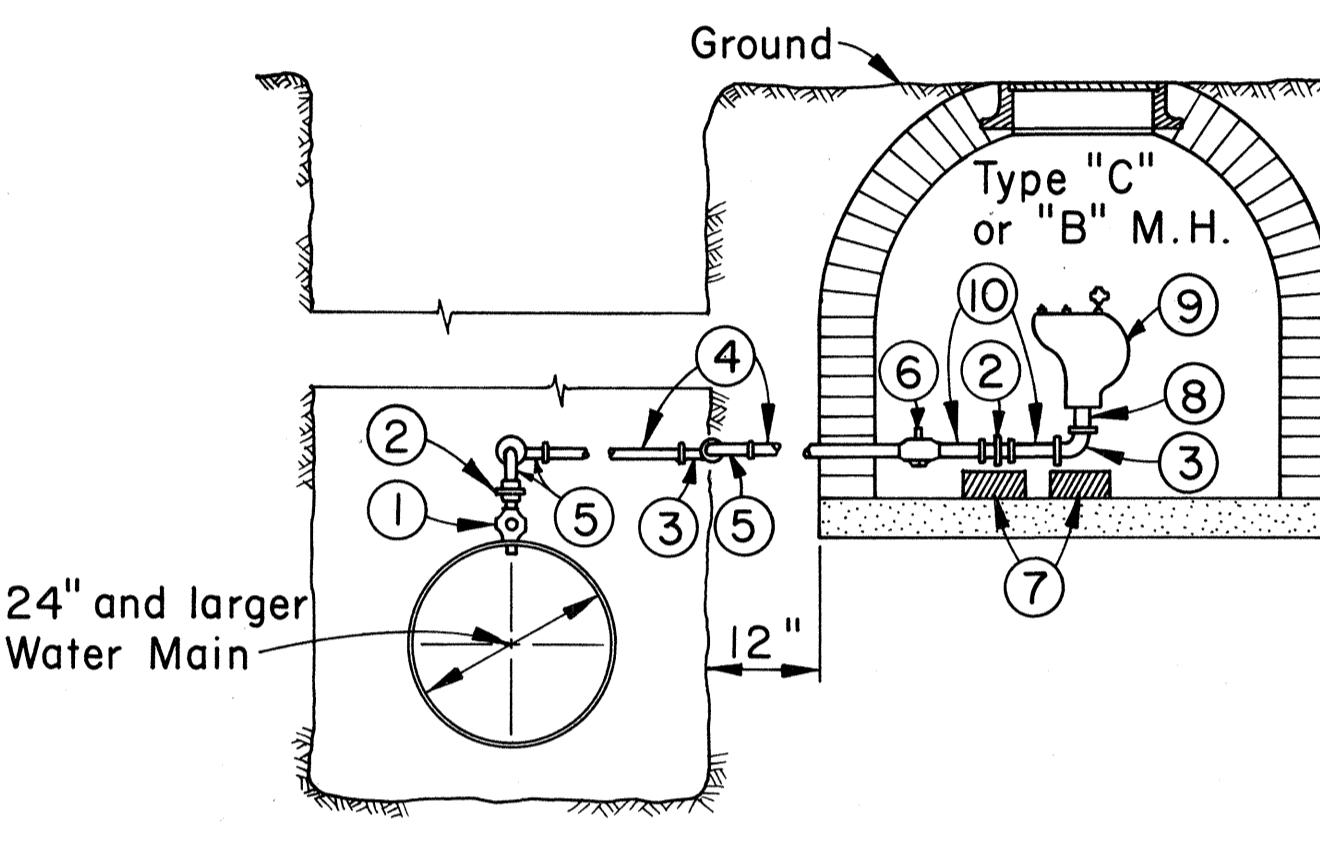


ELEVATION

OFFSET MANHOLE FOR AIR RELIEF VALVE

NOT TO SCALE

FIGURE 33


FED. ROAD DIST. NO.	STATE	FED. AID PROJ. NO.	FISCAL YEAR	SHEET NO.	TOTAL SHEETS
HAWAII	HAW.	I-HI-19915	1977	167	350

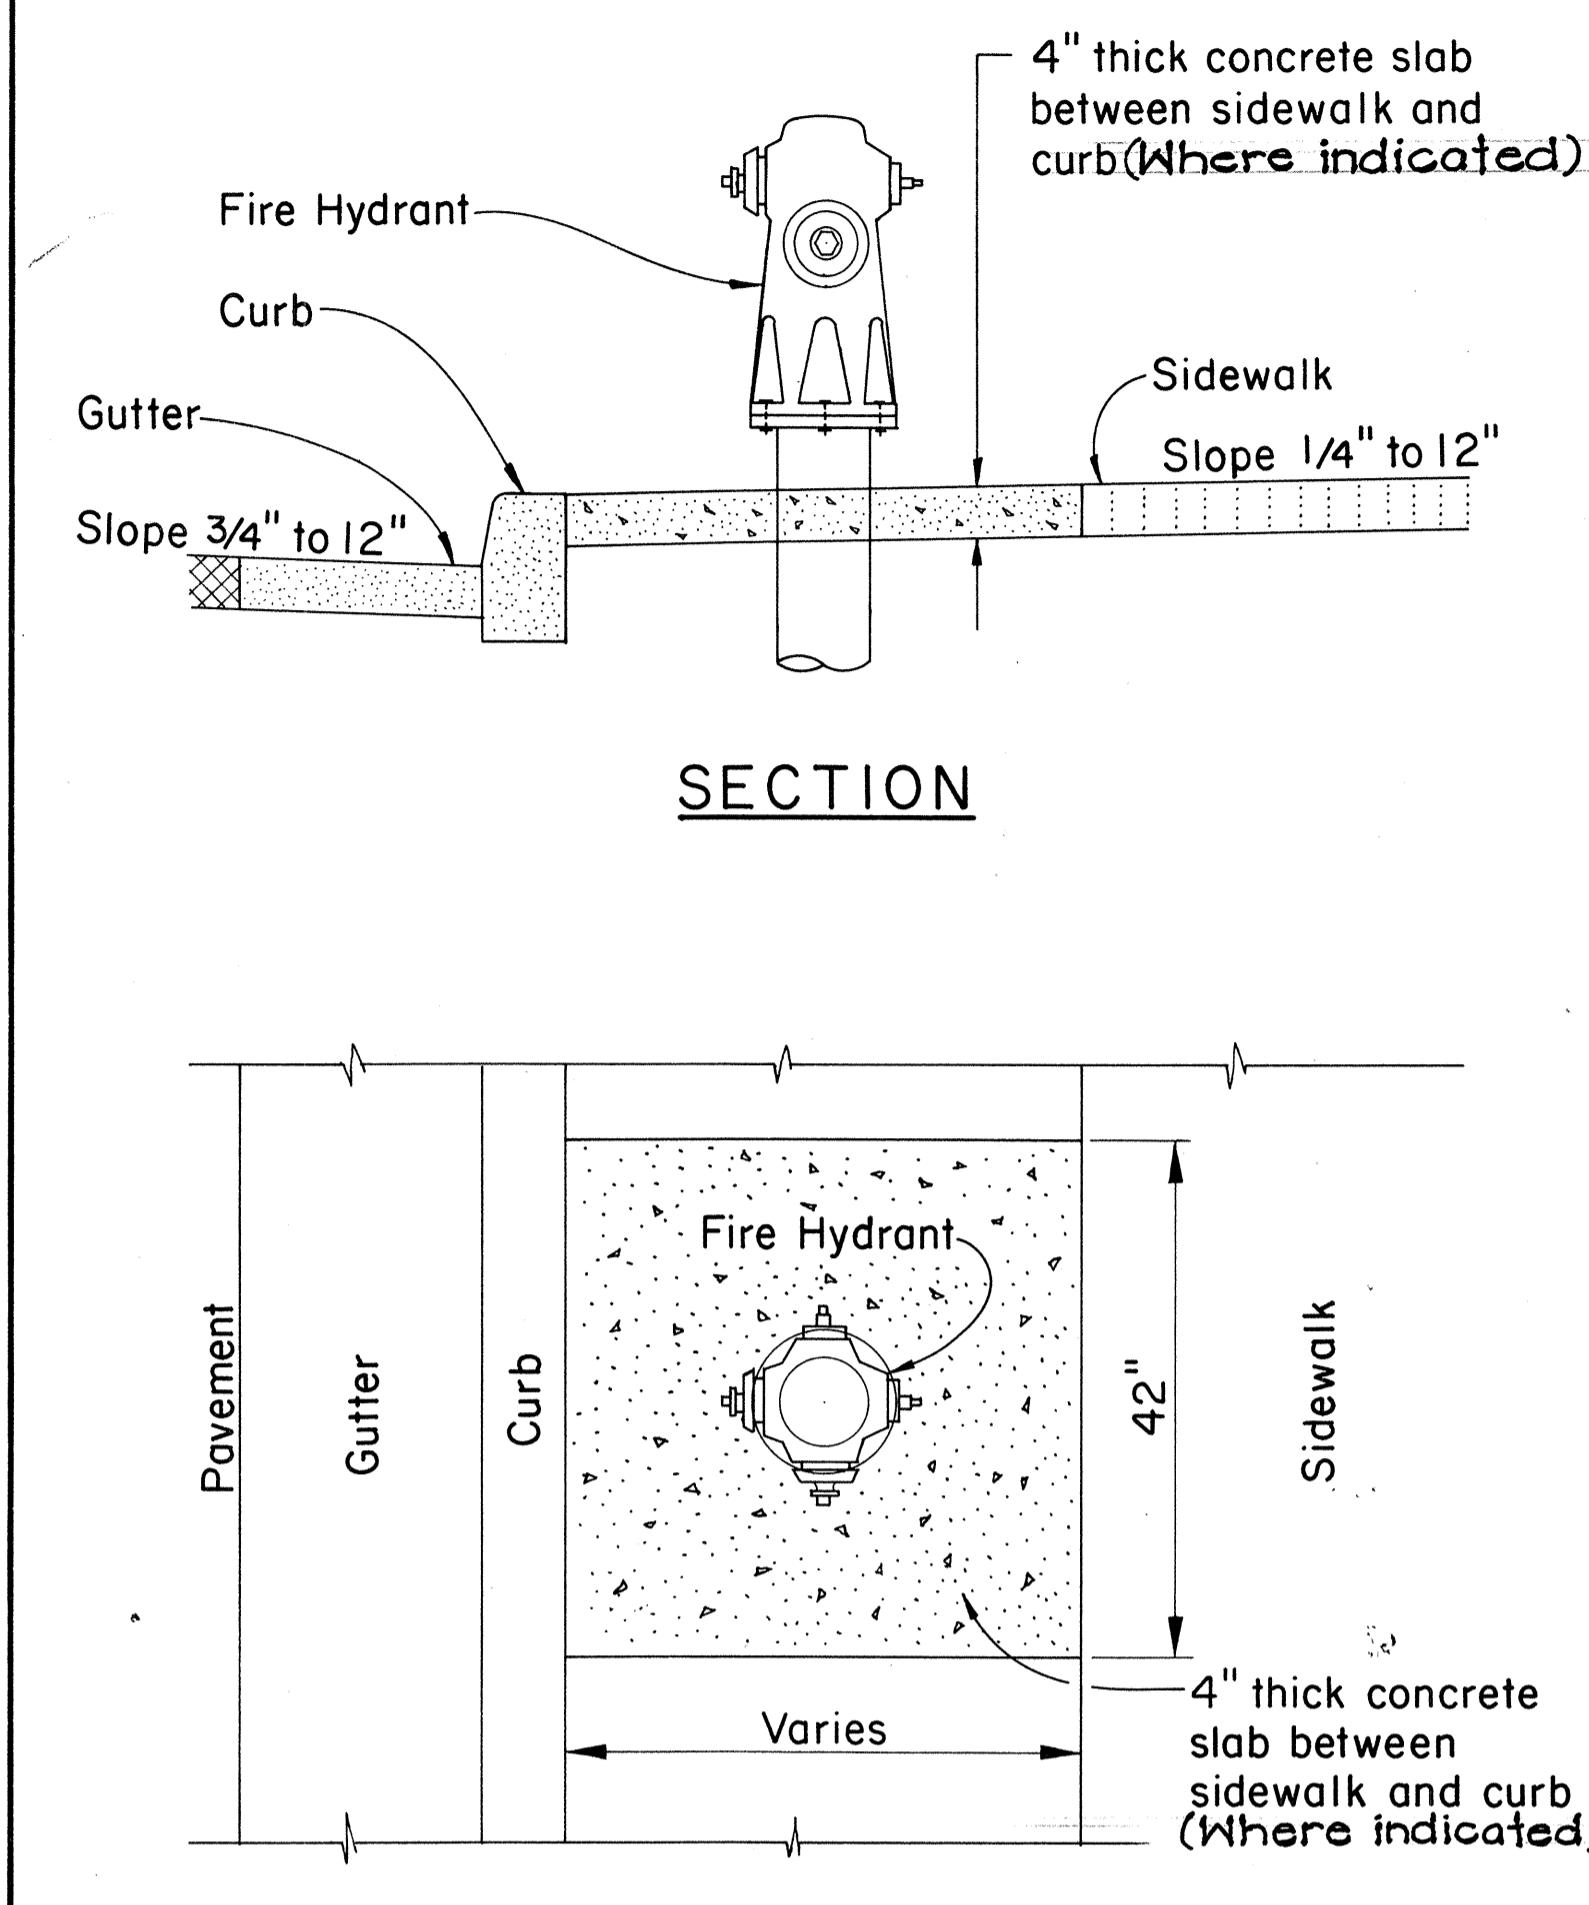

DETAIL OF FIRE HYDRANT CONCRETE PAD

SCALE: $3/4" = 1'-0"$


FIGURE 34

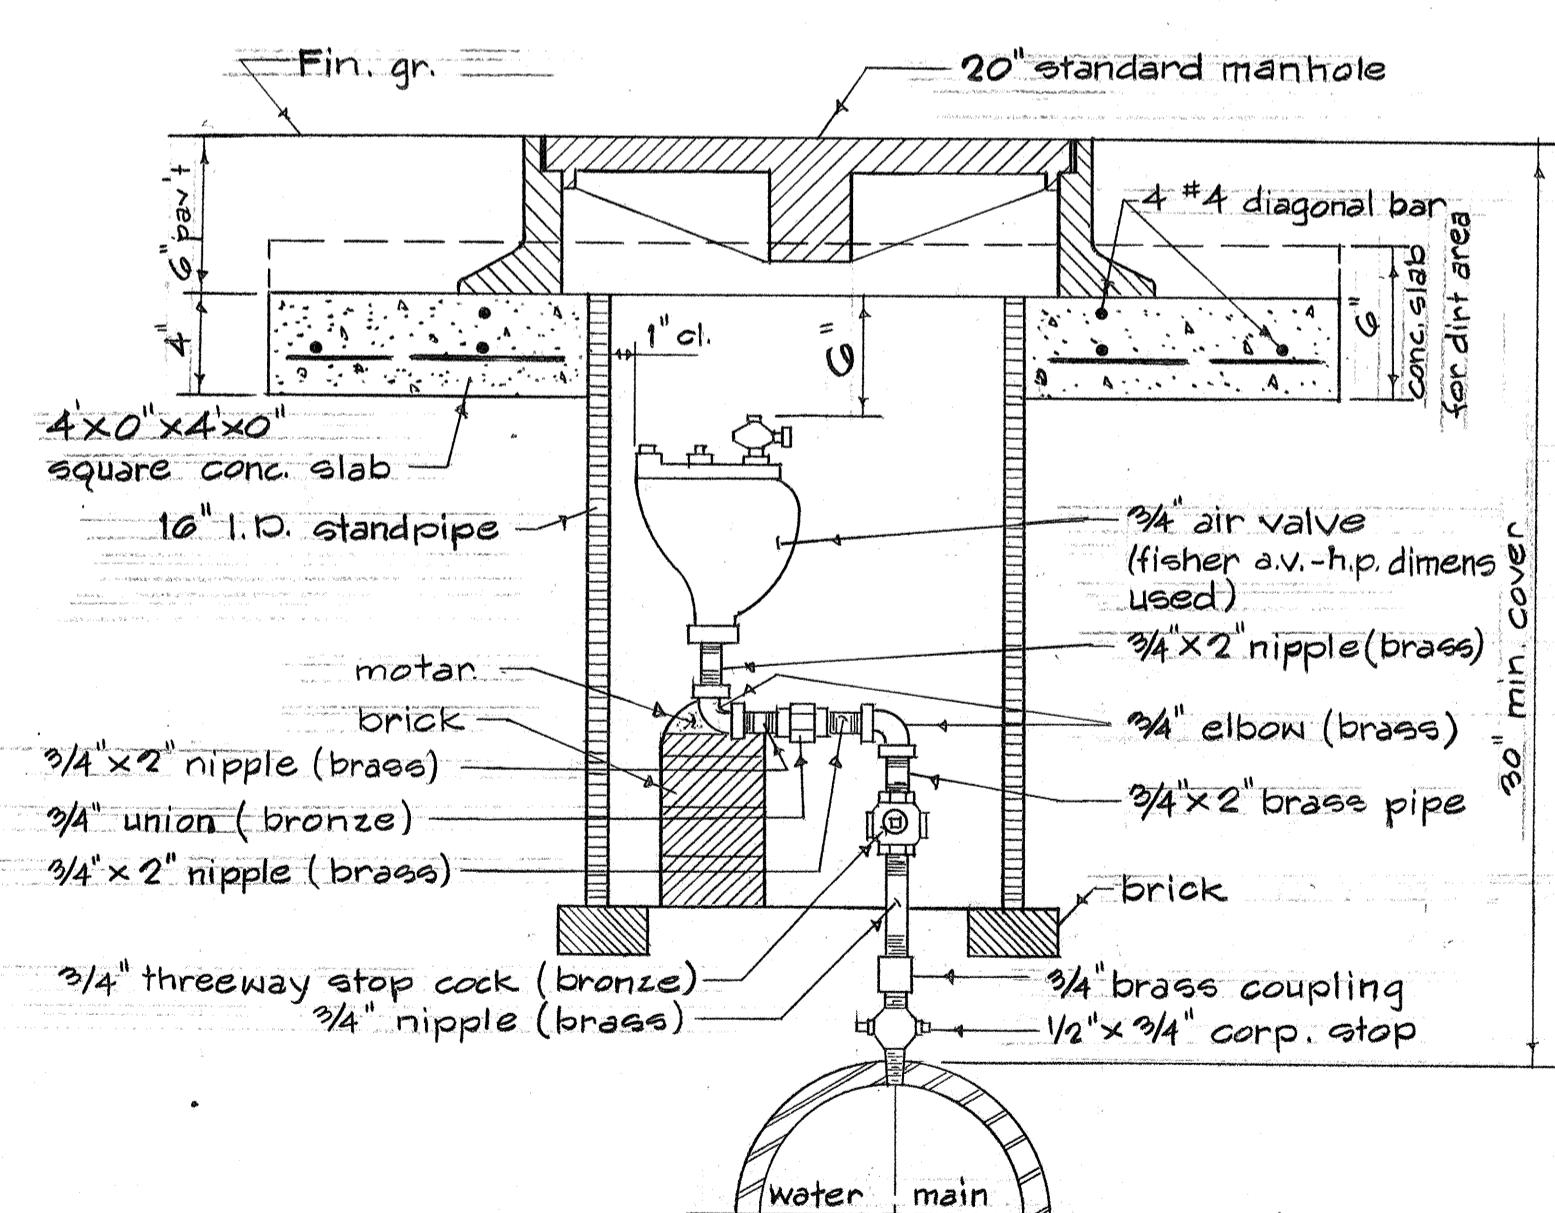

**STANDARD CONNECTION FOR
3/4" AIR RELIEF VALVE AT VALVE BOX**

NOT TO SCALE

FIGURE 35

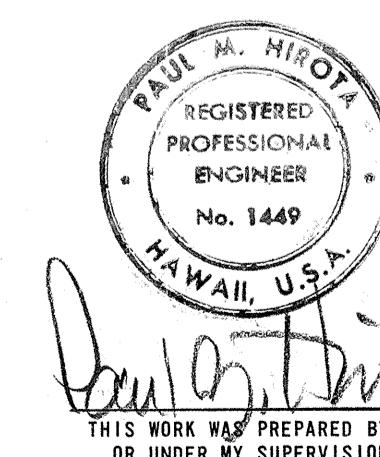

THIS WORK WAS PREPARED BY ME
OR UNDER MY SUPERVISION

STATE OF HAWAII
DEPARTMENT OF TRANSPORTATION
HIGHWAYS DIVISION

NIMITZ SPUR

WATER DETAILS

INTERSTATE ROUTE H-1
PROJ. NO. I-HI-1(99)15


DATE: AUG 4 1976

SCALE: AS SHOWN

DATE: AUG 4 1976

SHEET NO. 10 OF 10 SHEETS

FED. ROAD DIST. NO.	STATE	FED. AID PROJ. NO.	FISCAL YEAR	NO.	TOTAL SHEETS
HAWAII	HAW.	I-HI-199:15	1977	168	350

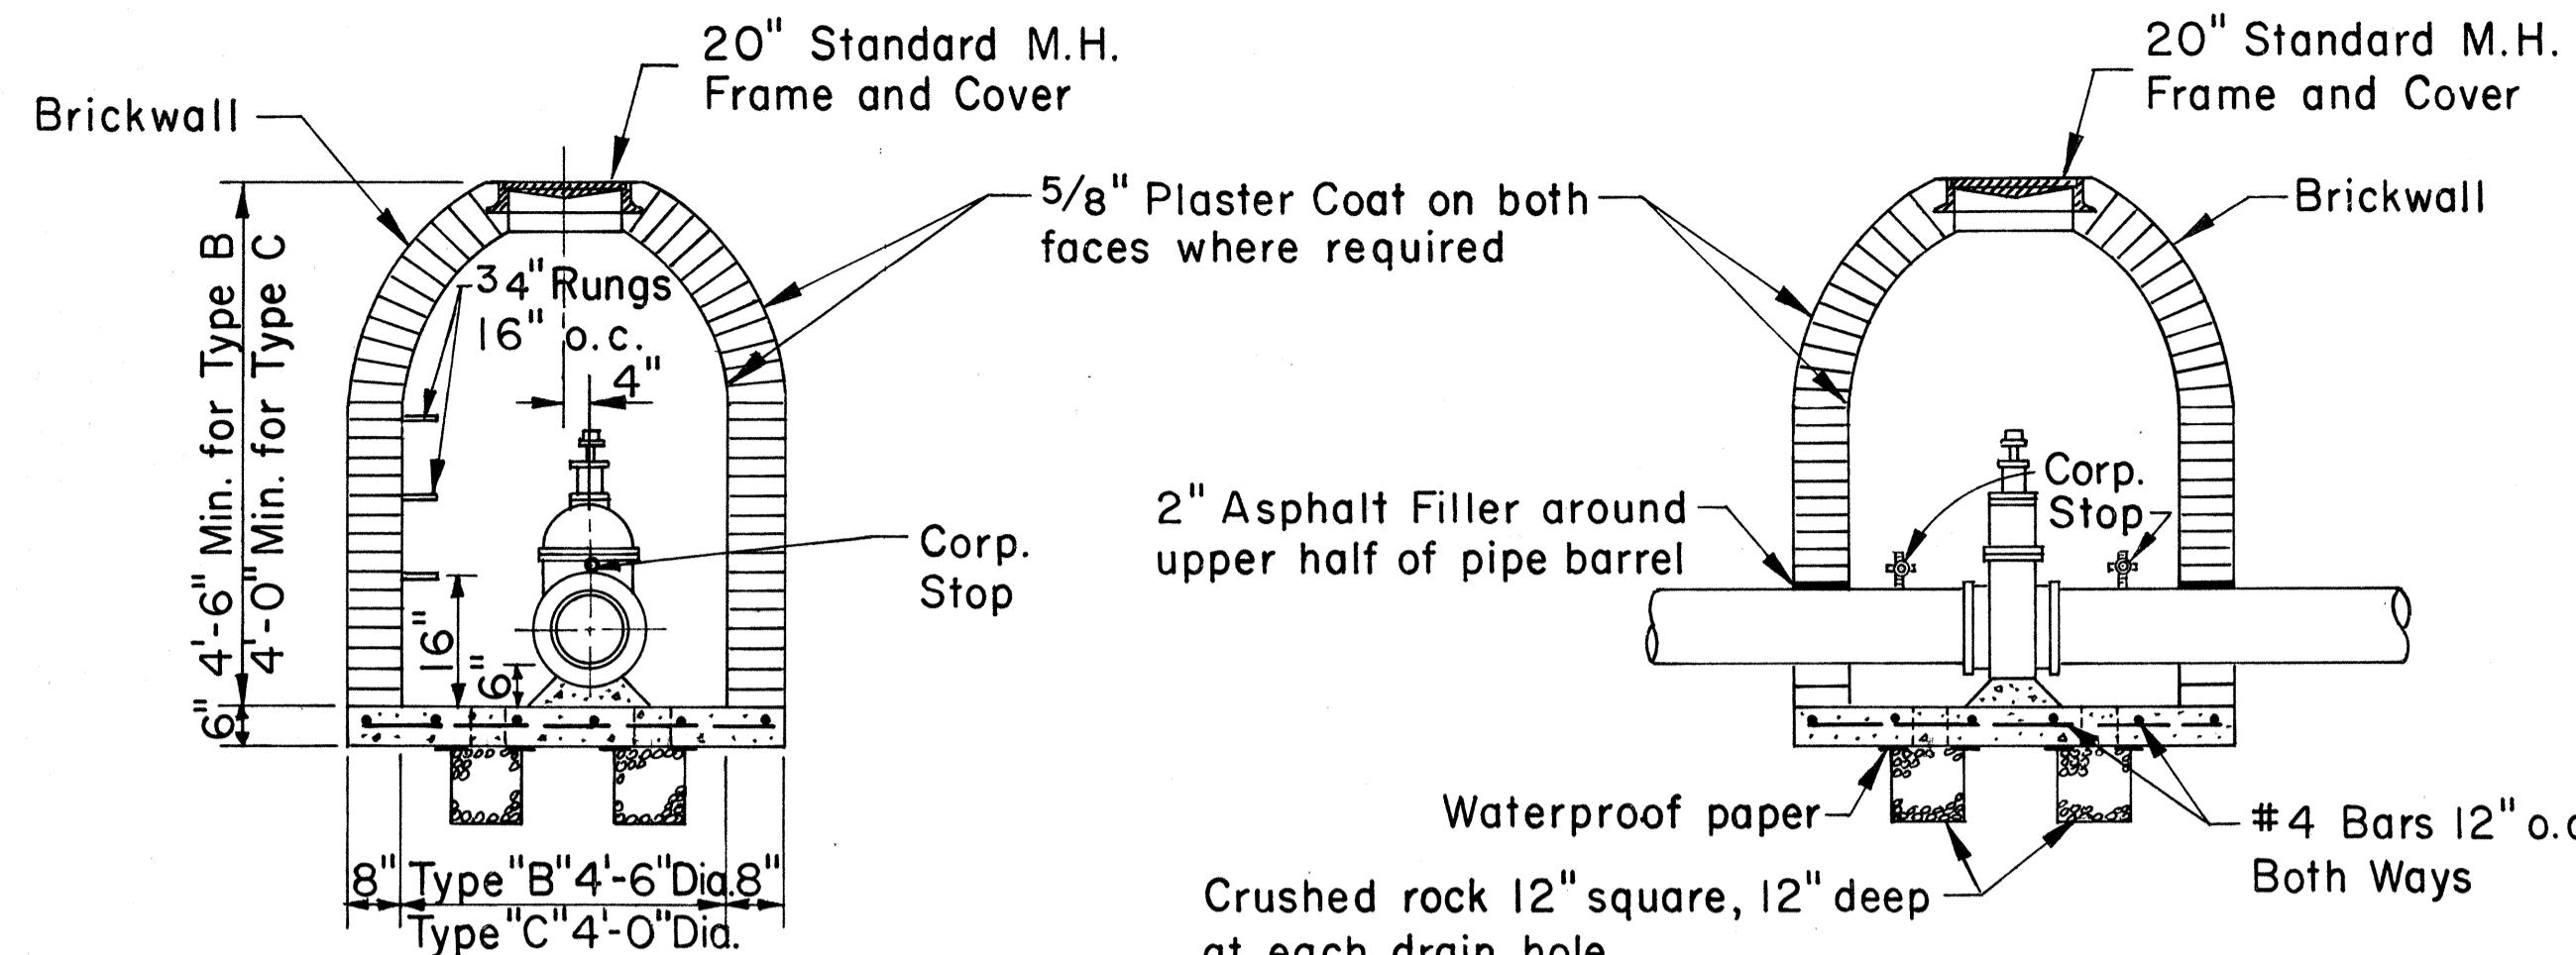


- NOTE:
1. Refer to Figure 8 for Details.
 2. Refer to Figure 9 for Corp. Stop Layout and required Corp. Stop sizes.
 3. Omit Drain Holes and Crushed Rock for Waterpoofed Manholes.
 4. Concrete shall be Class B

TYPE B & C MANHOLES GENERAL ARRANGEMENT


SCALE: 1/2" = 1'-0"

FIGURE 7

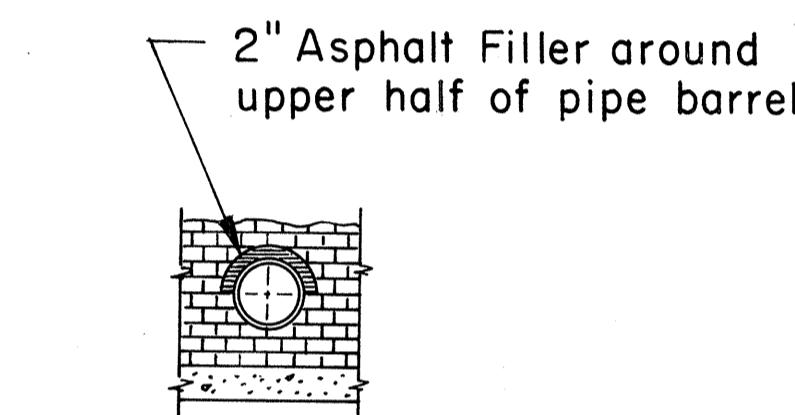


FILLER DETAIL

SCALE: 1/2" = 1'-0"

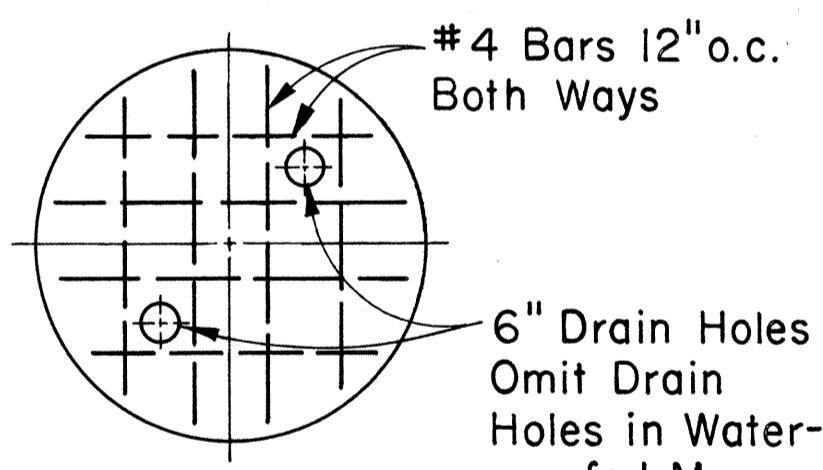

BOTTOM SLAB PLAN

SCALE: 1/2" = 1'-0"

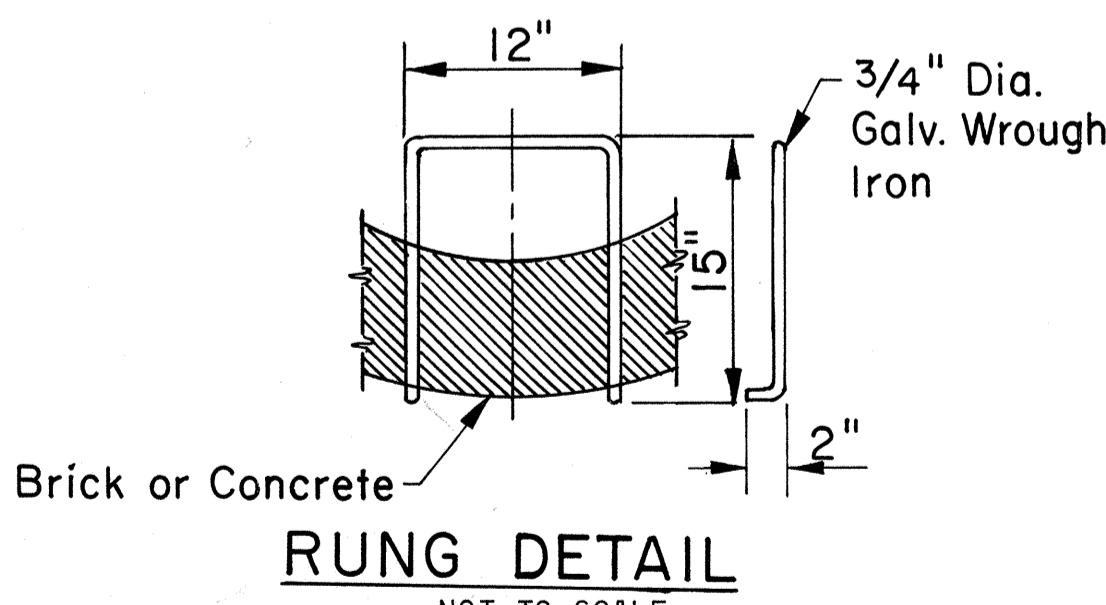


TYPE B & C MANHOLES

DETAILS


SCALE AS SHOWN

FIGURE 8

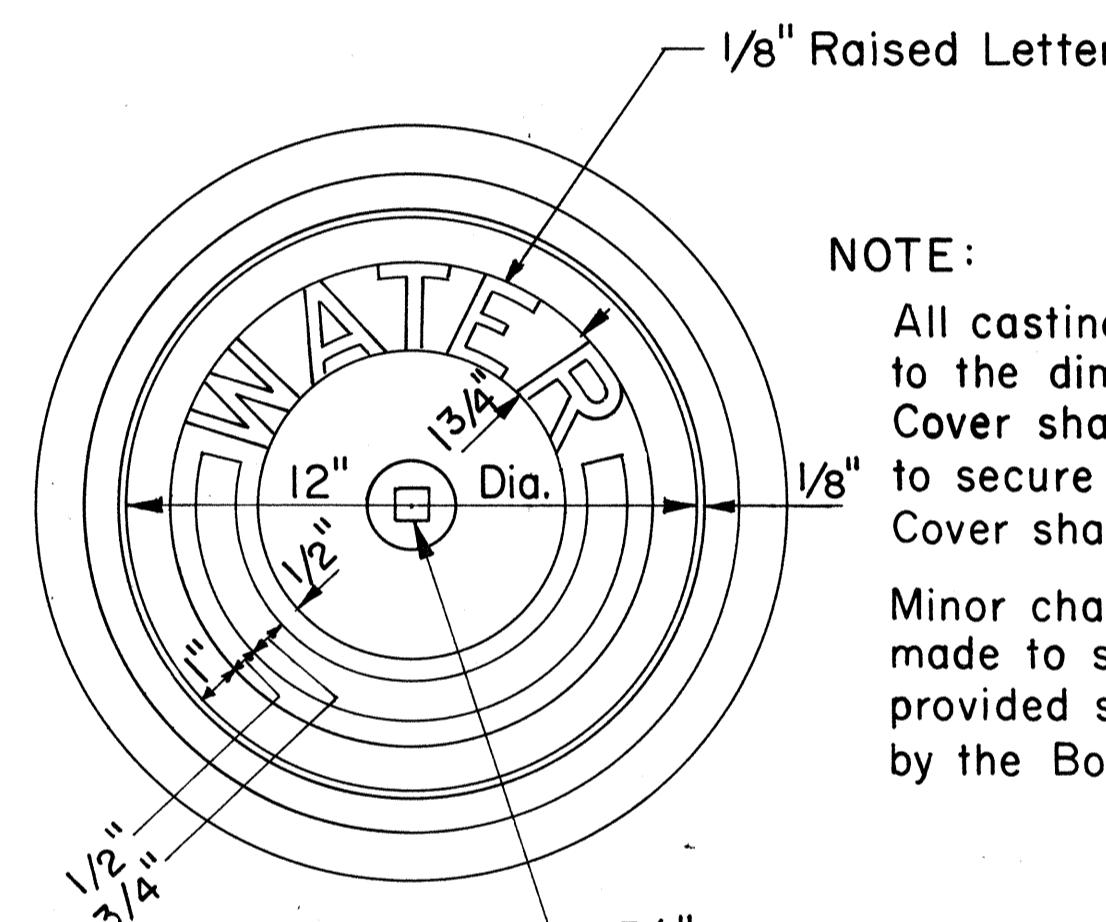

NOTE:

All castings shall be made accurately to the dimensions shown. Seat and Cover shall be machined, not ground to secure flat and true surfaces. The Cover shall not rattle in any position. Minor changes in dimensions may be made to suit foundry conditions provided such changes are approved by the Board of Water Supply.

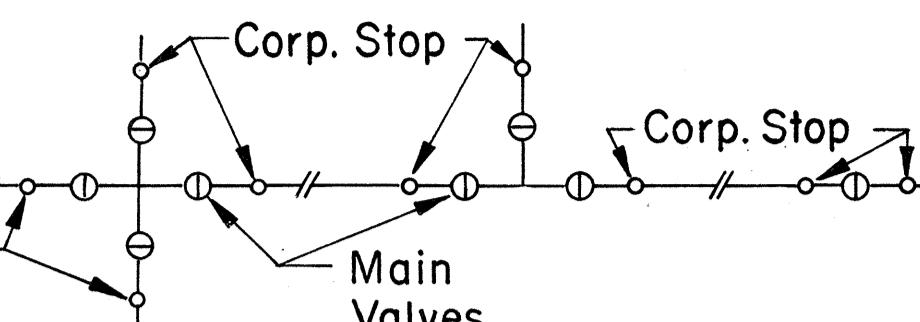

CORPORATION STOP LAYOUT

NOTE:

For Valves on the "run" the size of one Corp. Stop shall be as shown in Table A. The other Corp. Stop shall be 1" x 1 1/4" for all sizes of pipes.

Whenever the Corp. Stop at the Valve must be used for flushing the main, the size of the Corp. Stop shall be the maximum size permitted for the main.


TABLE A
REQUIRED CORP. STOP SIZES AT MAIN VALES

DIA. OF MAINS (INCHES)	SIZE OF CORP. STOP
4	1" x 1 1/4"
6	1" x 1 1/4"
8	1" x 1 1/4"
12	1" x 1 1/4"
16	1" x 1 1/4"
20	1" x 1 1/4"
24	1 1/2" x 2"
30	1 1/2" x 2"
36	1 1/2" x 2"

CORPORATION STOP LAYOUT AND SIZES

NOT TO SCALE

FIGURE 9

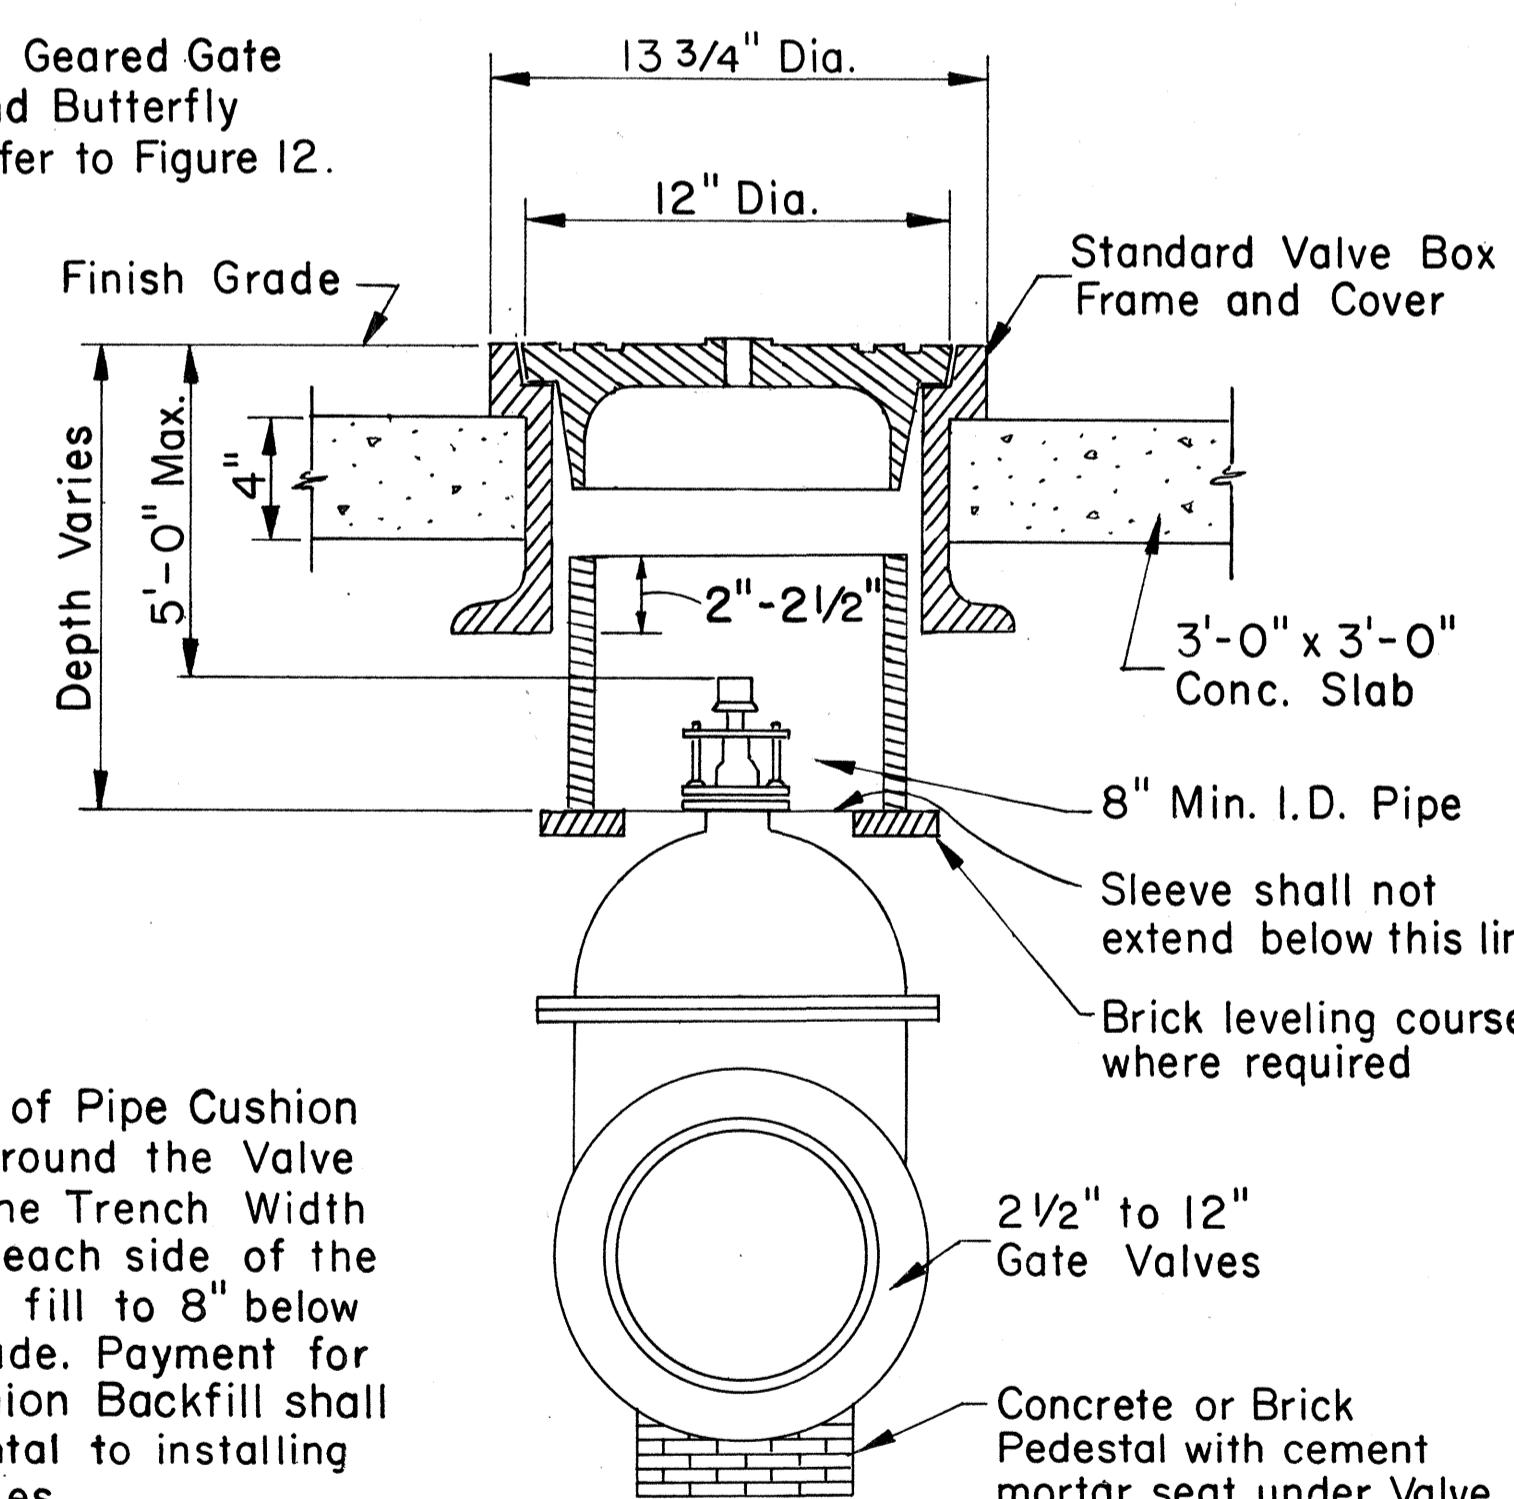

The limit of Pipe Cushion Backfill around the Valve shall be the Trench Width x 4 ft. on each side of the Valve and fill to 8" below Finish Grade. Payment for Pipe Cushion Backfill shall be incidental to installing valve boxes.

VALVE BOX FRAME AND COVER


SCALE: 3" = 1'-0"

FIGURE 10

VALVE BOX INSTALLATION FOR GATE VALVES

NOT TO SCALE

FIGURE 11

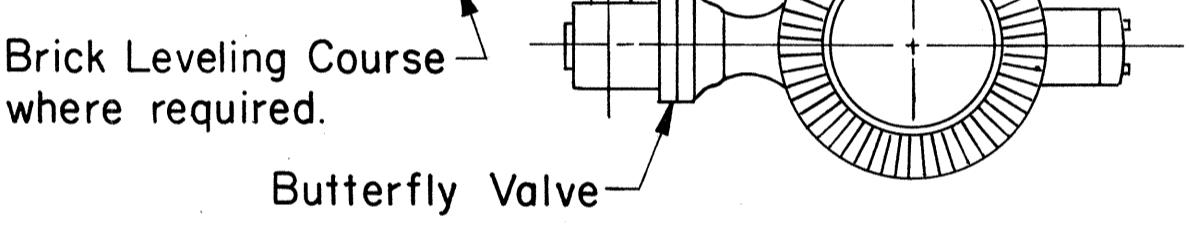

VALVE BOX INSTALLATION FOR BGGV AND BUTTERFLY VALVES

NOT TO SCALE

FIGURE 12



STATE OF HAWAII
DEPARTMENT OF TRANSPORTATION
HIGHWAYS DIVISION

NIMITZ SPUR

WATER DETAILS


INTERSTATE ROUTE H-1
PROJ. NO. I-HI-1(99):15

SCALE: AS SHOWN


DATE AUG 4 1976

SHEET No. 11 OF 12 SHEETS

FED. ROAD DIST. NO.	STATE	FED. AID PROJ. NO.	FISCAL YEAR	SHEET NO.	TOTAL SHEETS
HAWAII	HAW.	I-HI-1(99)15	1977	169	350

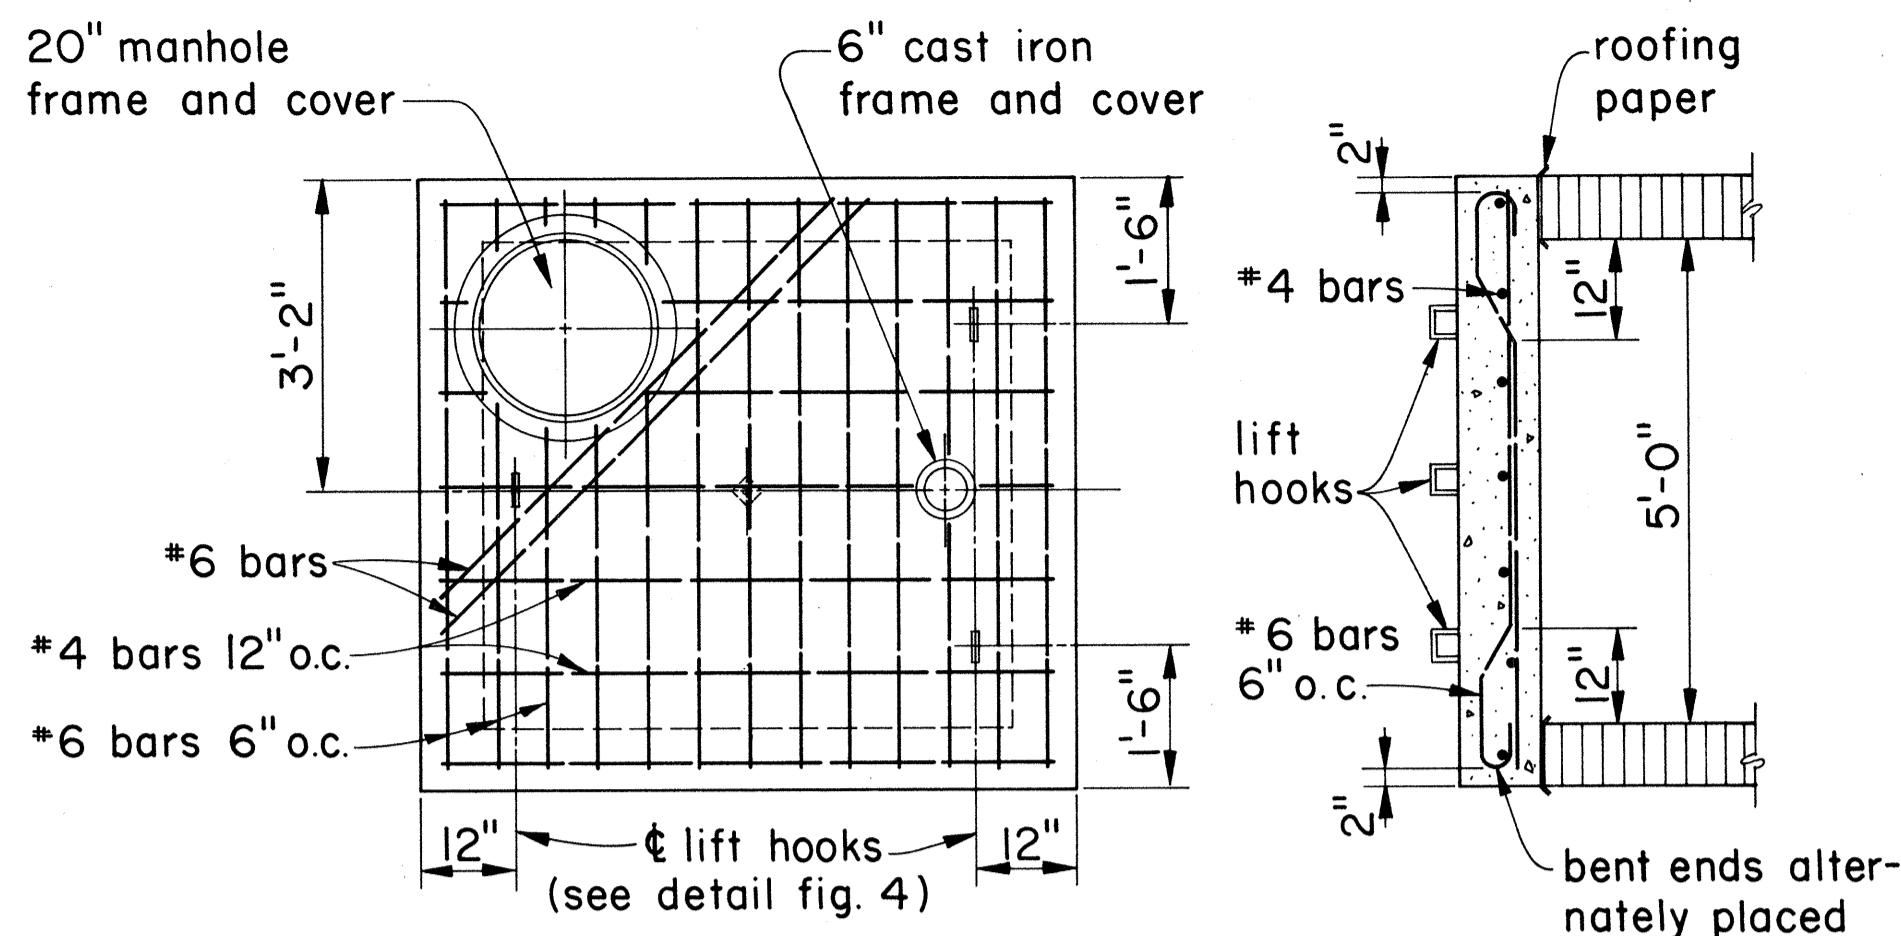


PLAN OF TOP SLAB

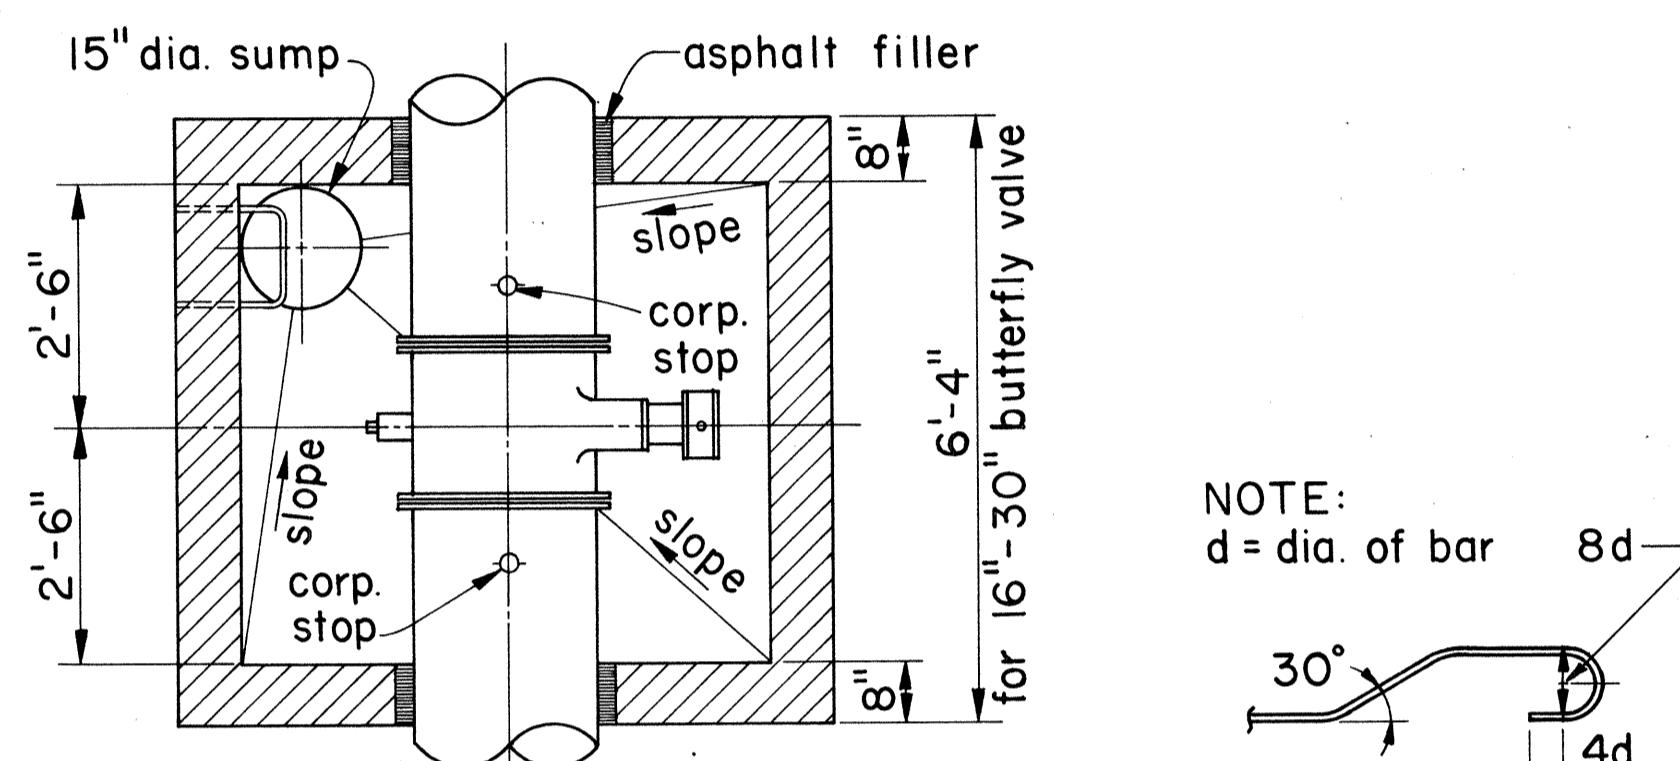

SECTION

BAR BENDING DETAIL

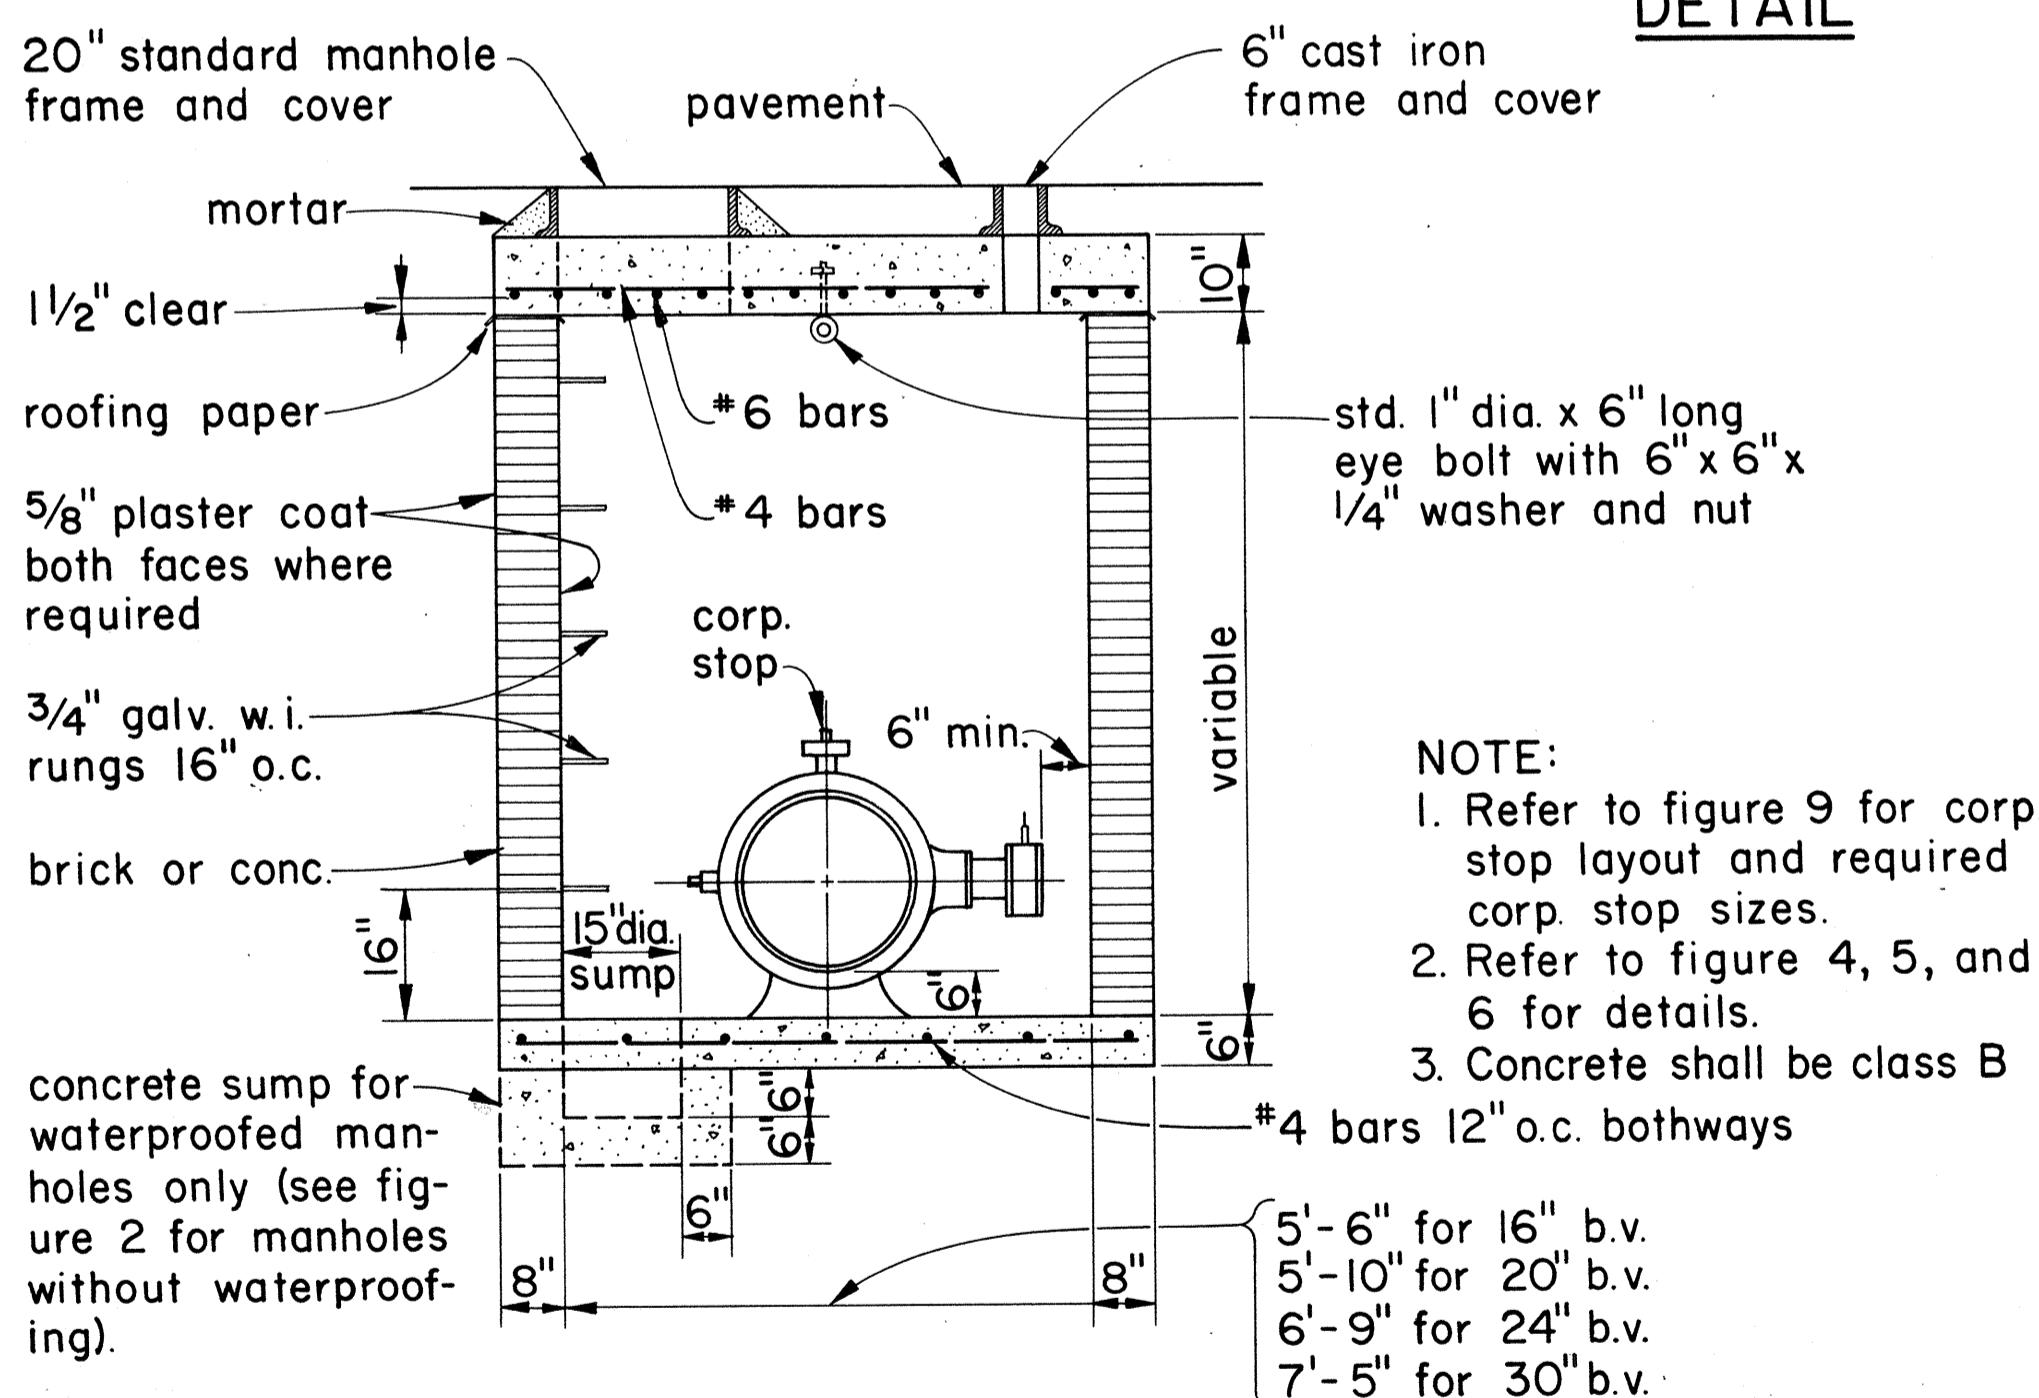


SECTION


TYPE A MANHOLE FOR BUTTERFLY VALVES

SCALE: 1/2" = 1'-0"


FIGURE 3

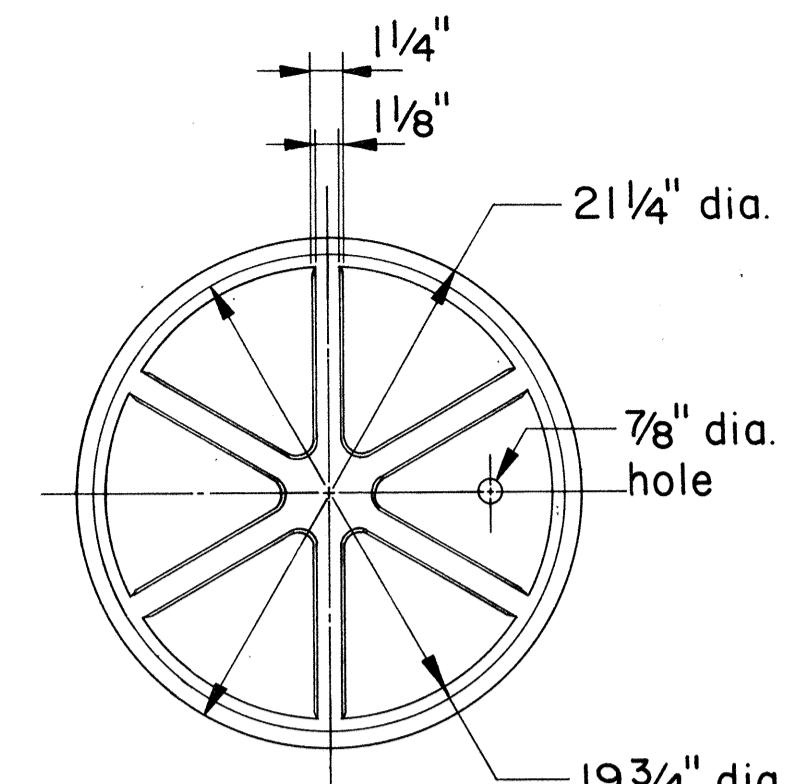


BOTTOM VIEW

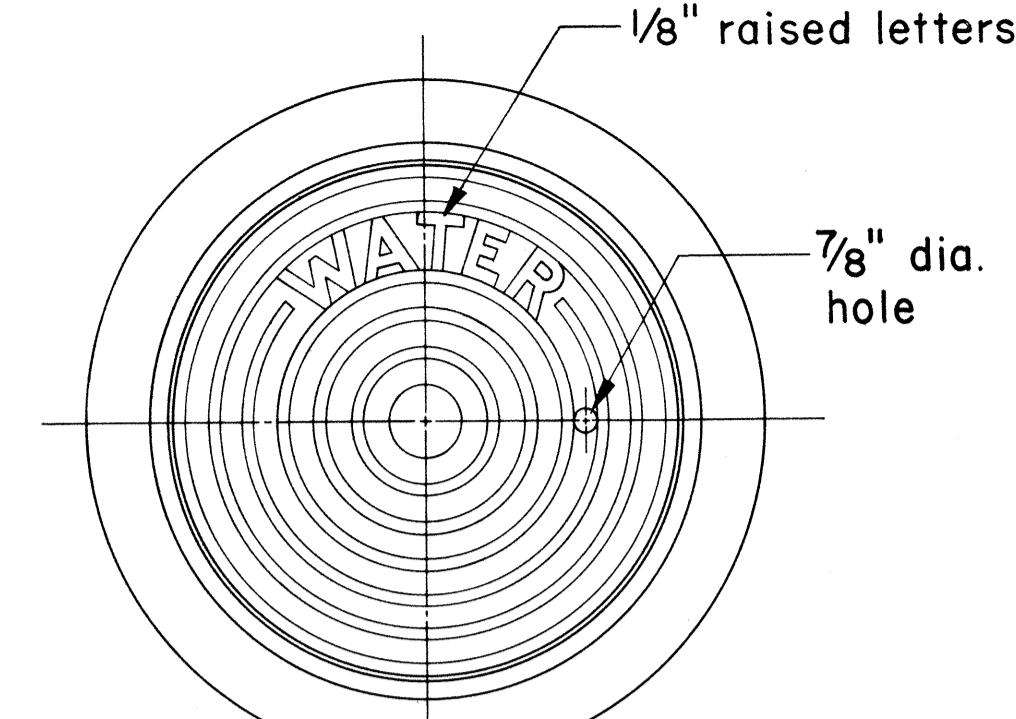

PLAN OF TOP

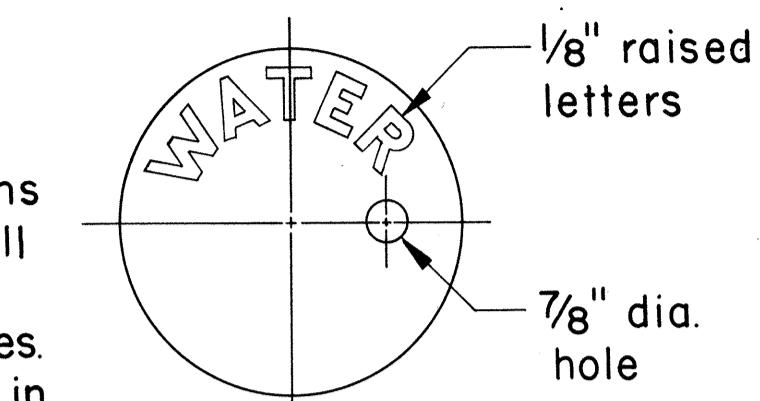

PLAN OF COVER


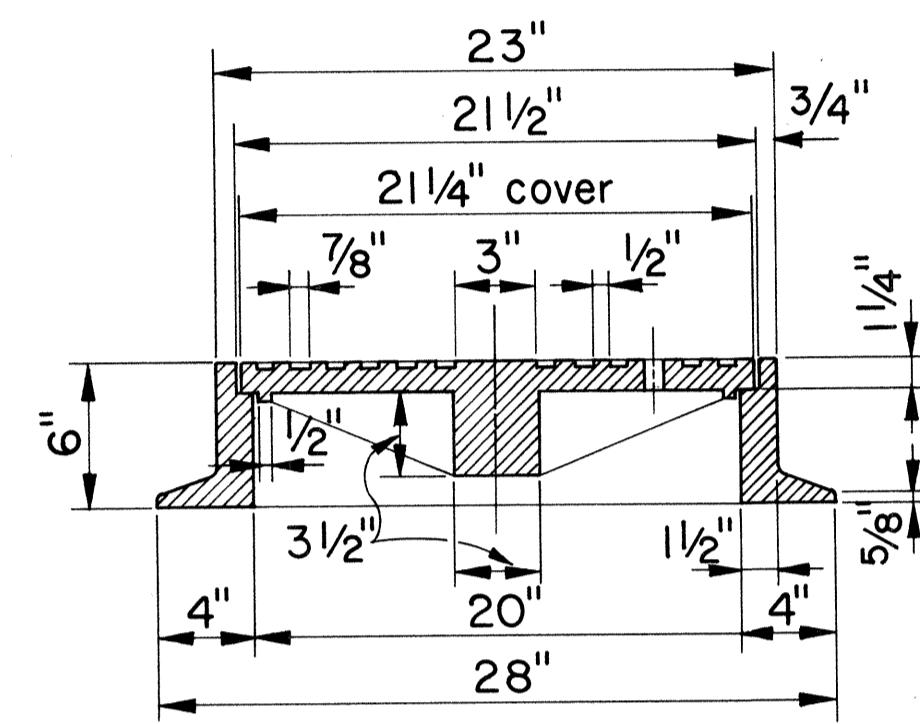


SECTION



MANHOLE FRAME AND COVER CAST IRON, 20" SIZE

SCALE: 1 1/2" = 1'-0"

FIGURE 6

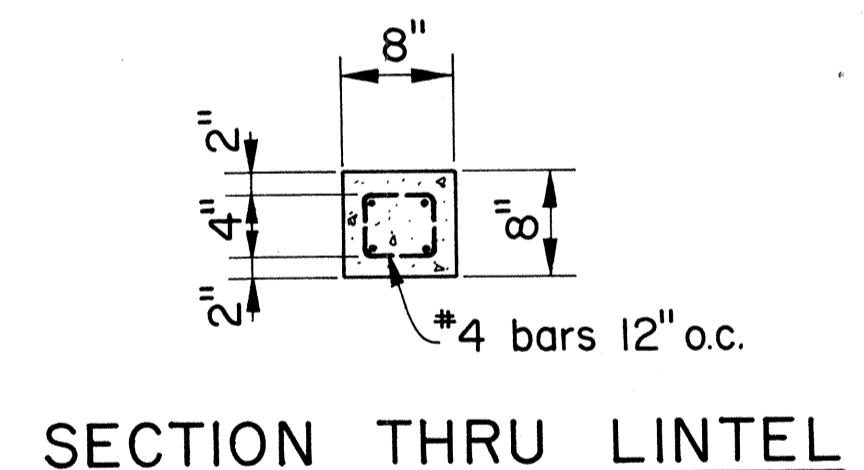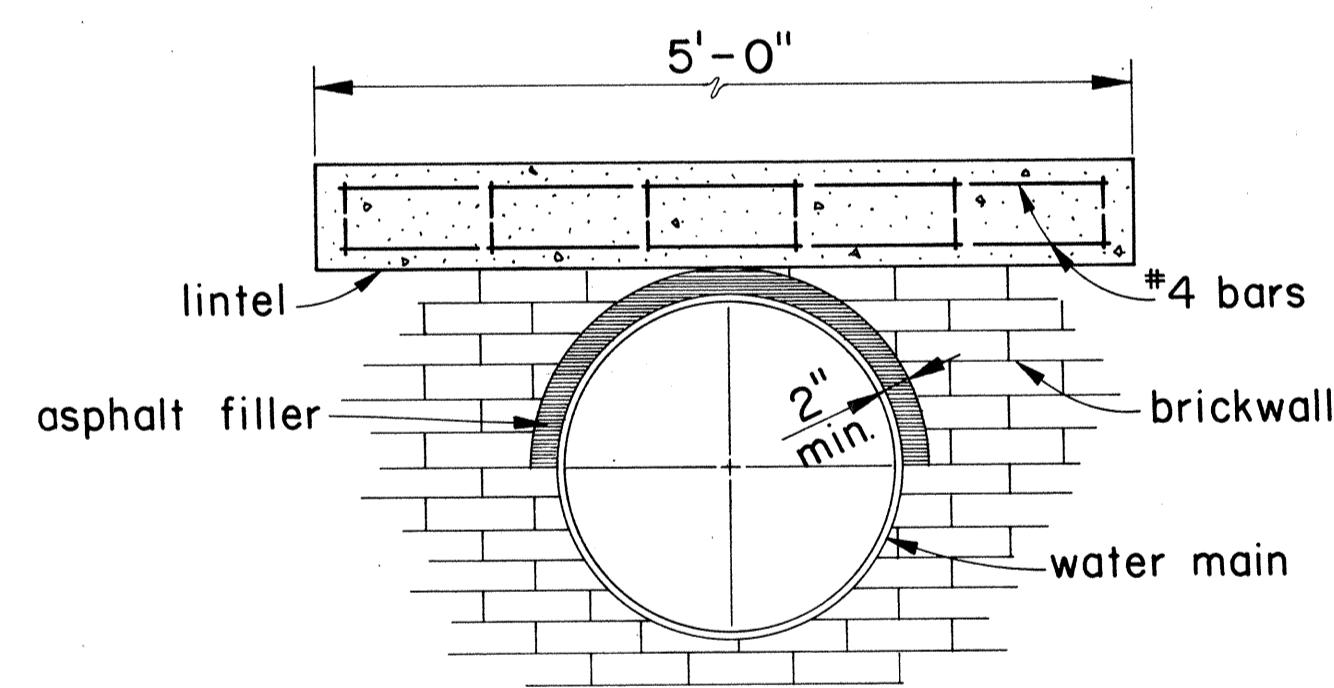

SECTION THRU LINTEL

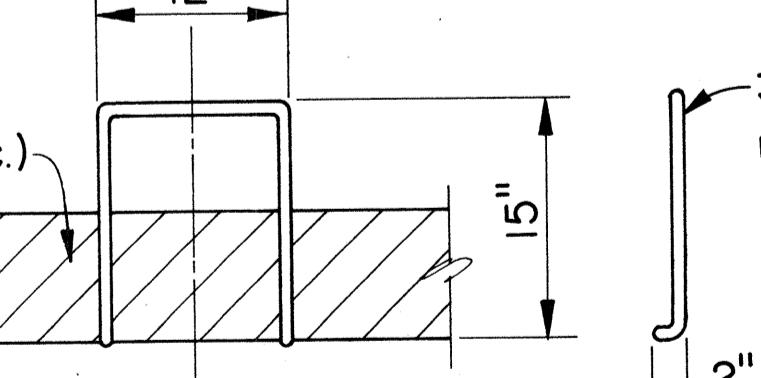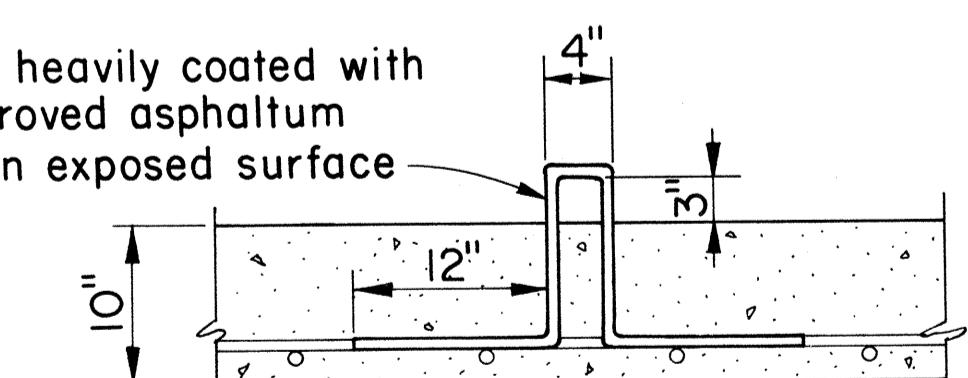

DETAIL OF RUNG

TYPE A MANHOLE DETAIL OF RUNG, LINTEL, FILLER, & LIFT HOOK

SCALE: 1" = 1'-0"

FIGURE 4

STATE OF HAWAII
DEPARTMENT OF TRANSPORTATION
HIGHWAYS DIVISION

NIMITZ SPUR


WATER DETAILS

INTERSTATE ROUTE H-1
PROJ. NO. I-HI-1(99):15

SCALE: AS NOTED



DATE: AUG 4 1976

SHEET No. 12 OF 10 SHEETS

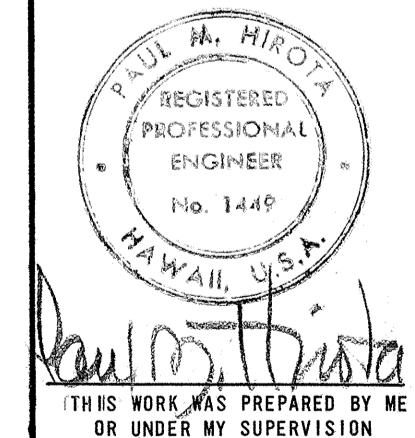


THIS WORK WAS PREPARED BY ME
OR UNDER MY SUPERVISION

FED. ROAD DIST. NO.	STATE	FED. AID PROJ. NO.	FISCAL YEAR	SHEET NO.	TOTAL SHEETS
HAWAII	HAW.	I-HI-1099:15	1977	170	350

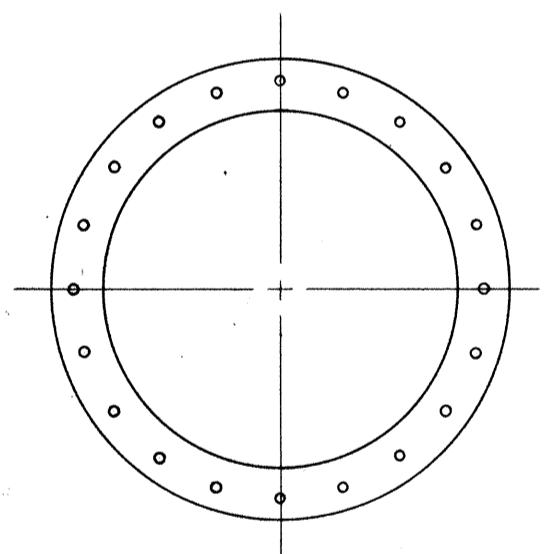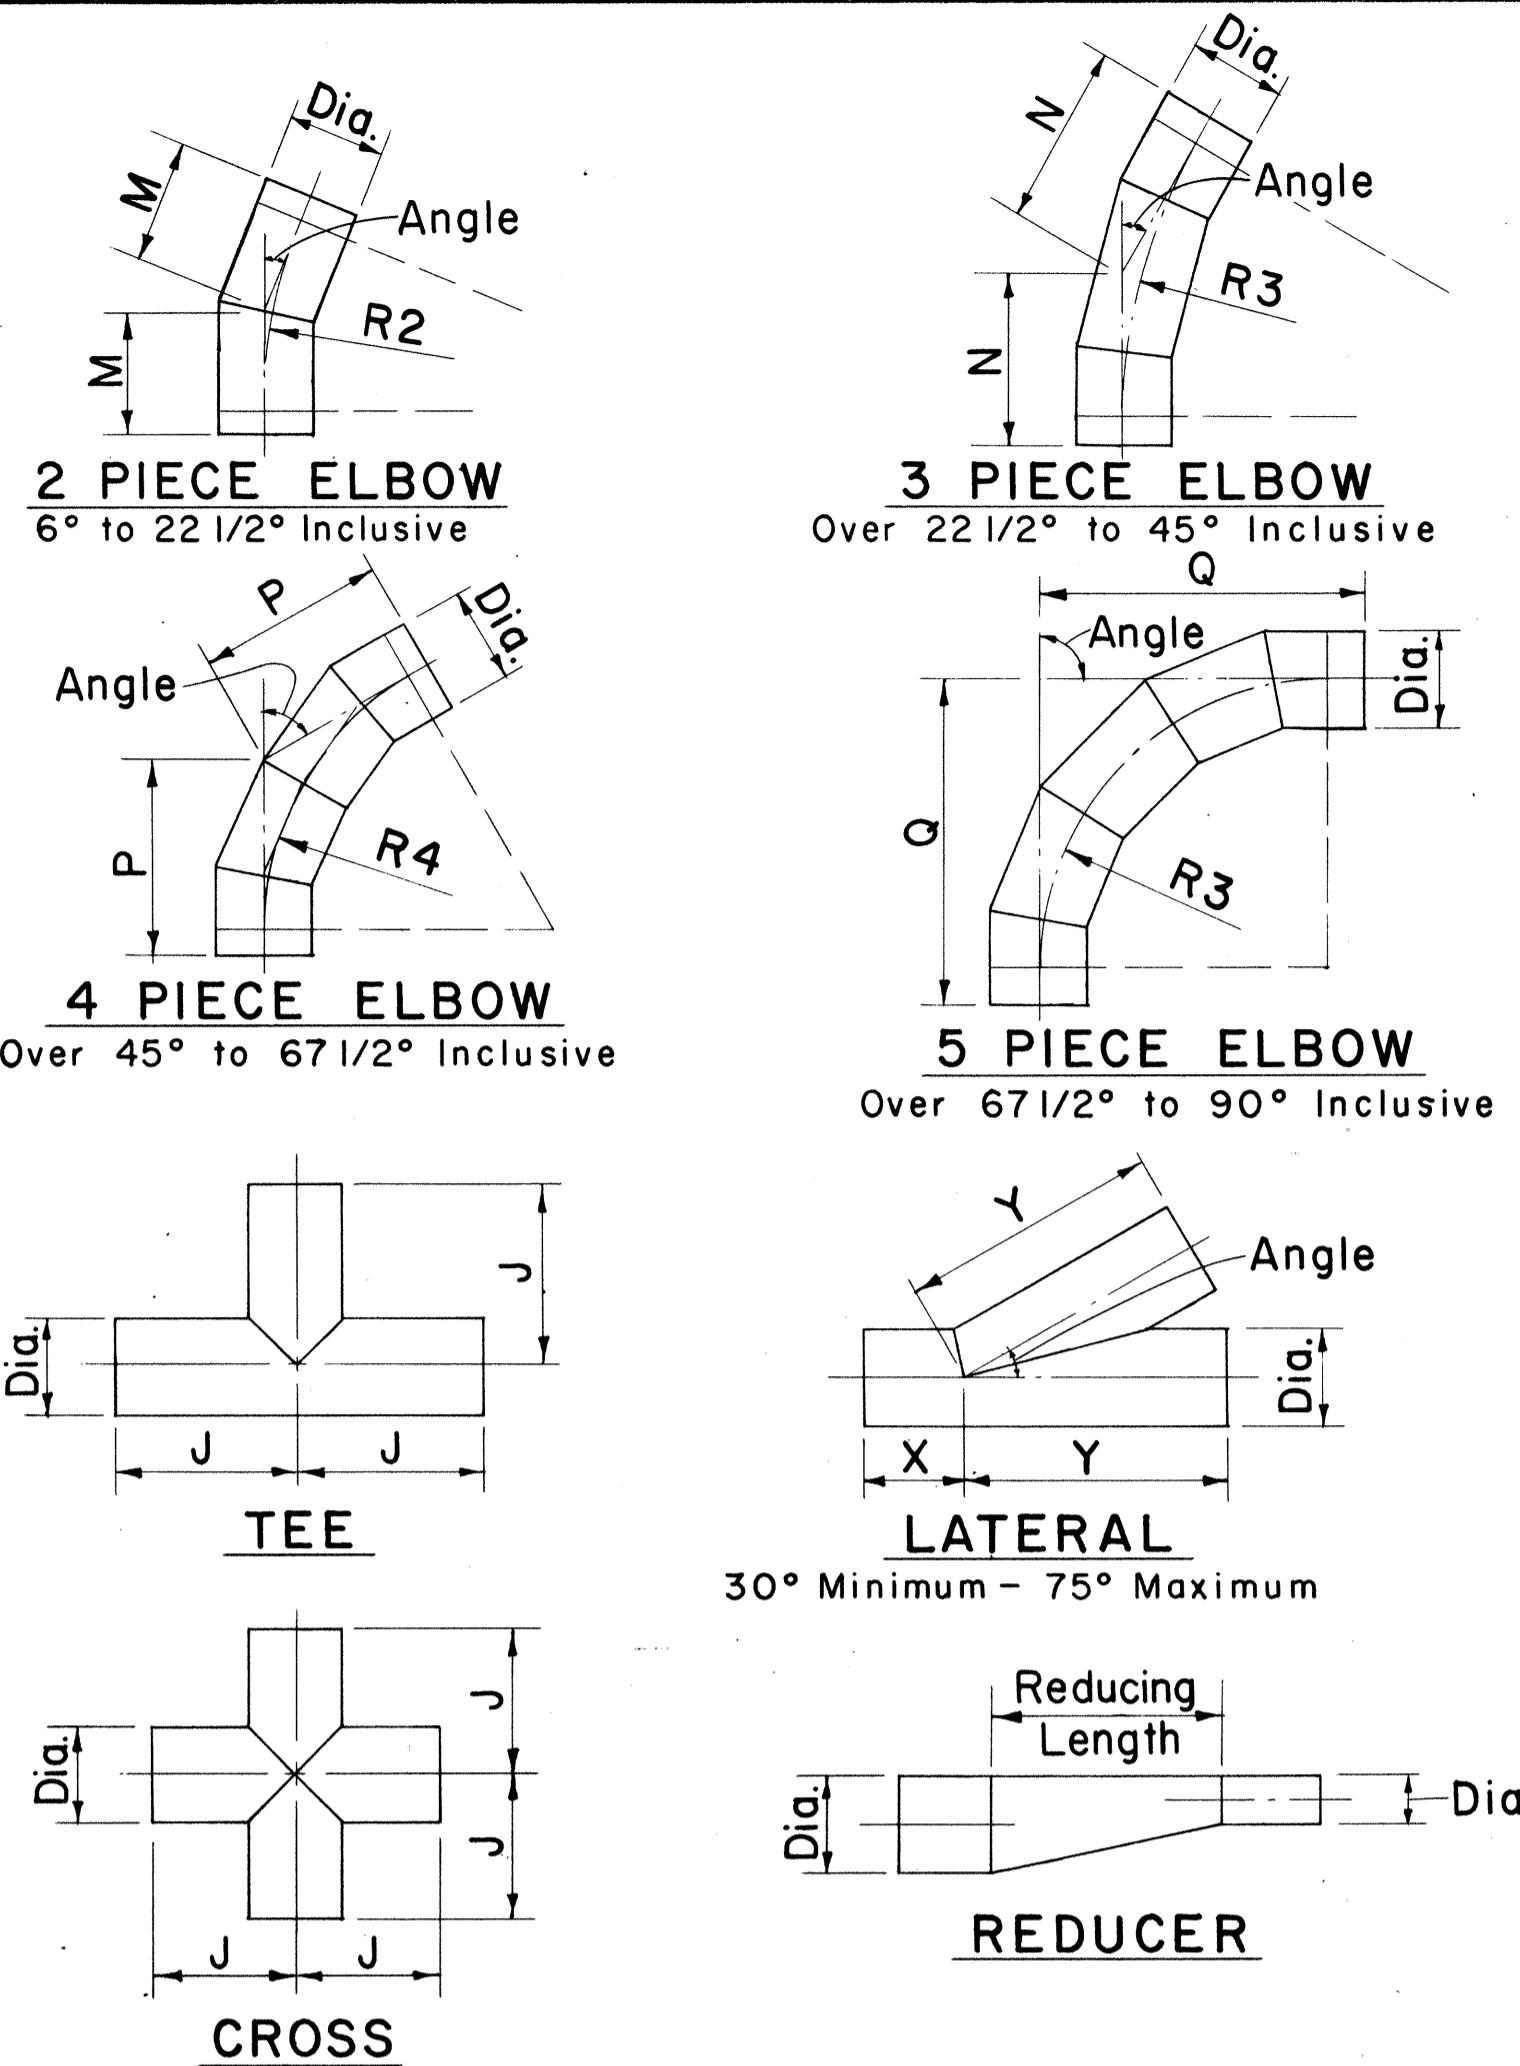


See Specs. for Flange Class




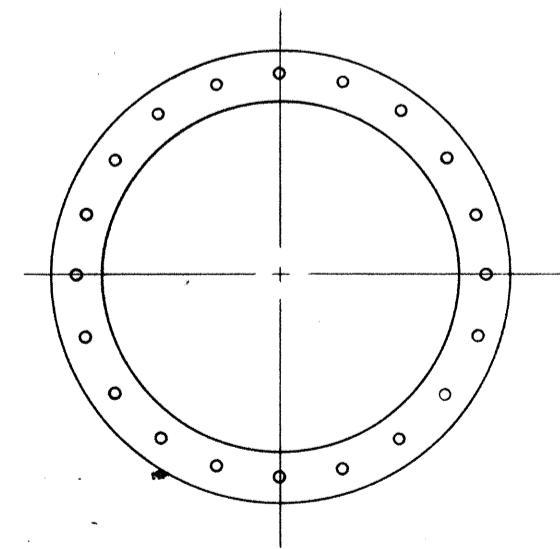


See Specs. for Flange Class


TYPICAL DETAIL OF ADAPTER

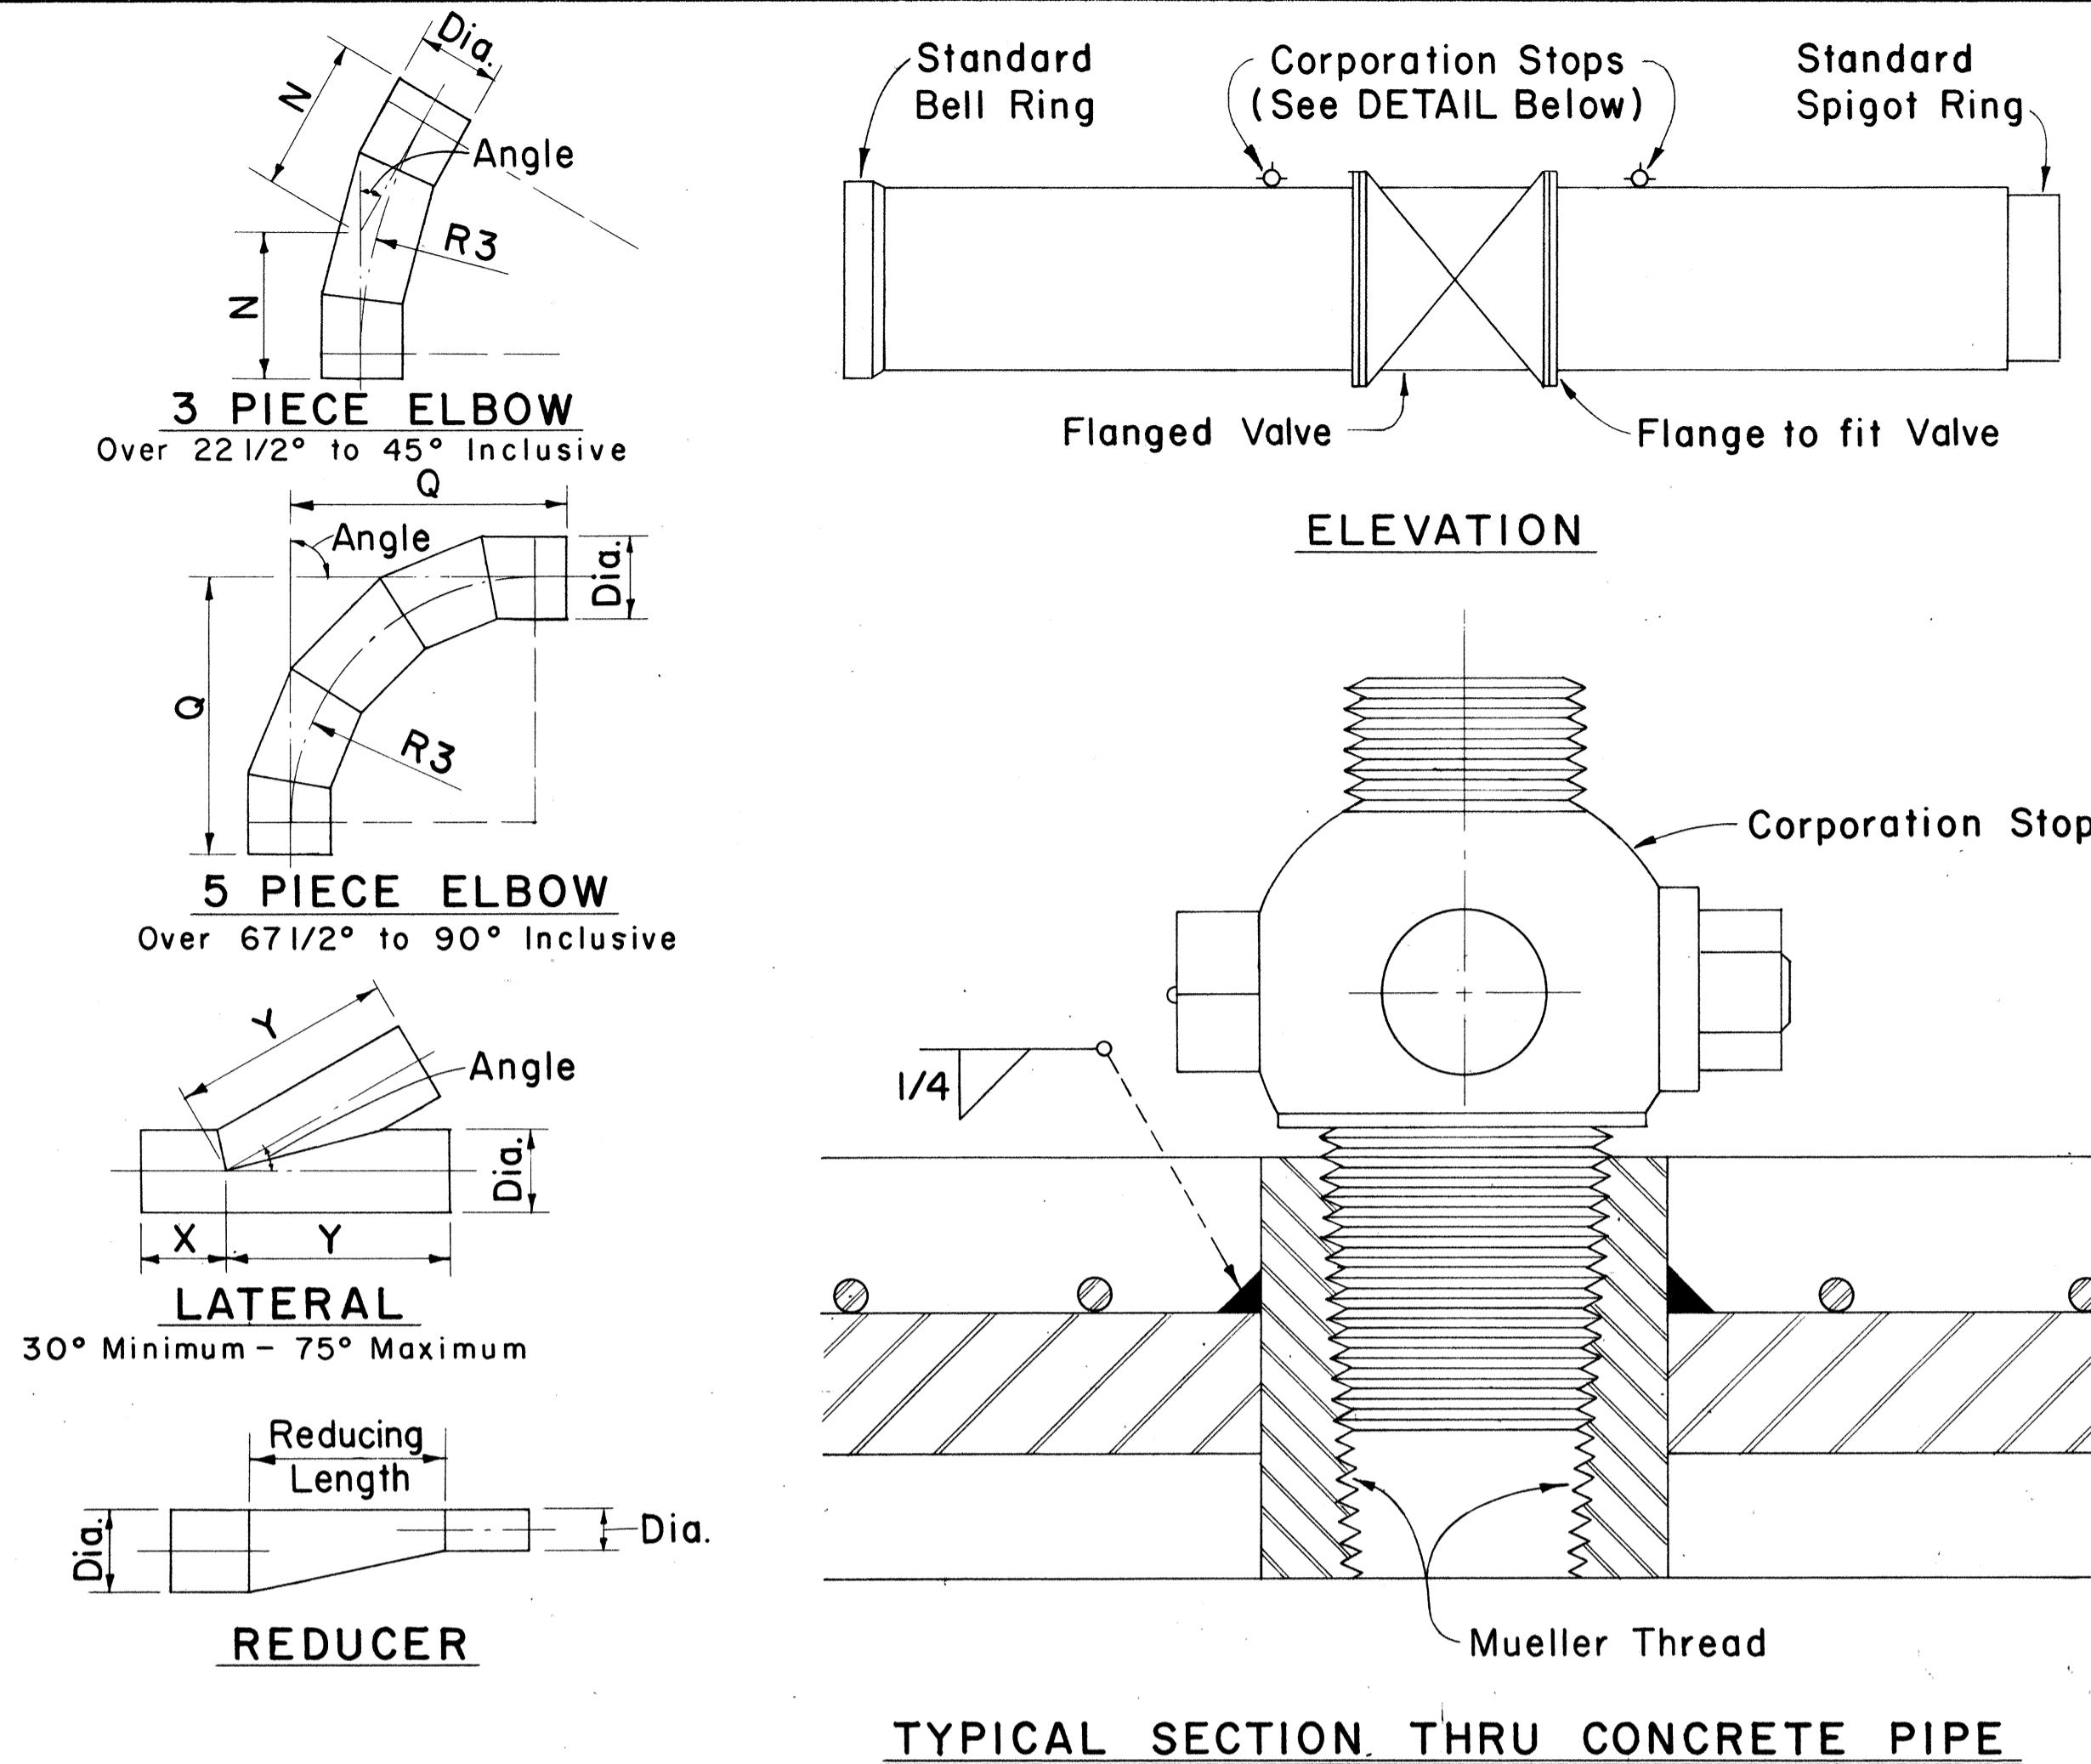

TYPICAL SECTION THRU CONCRETE PIPE
AT CORPORATION STOP

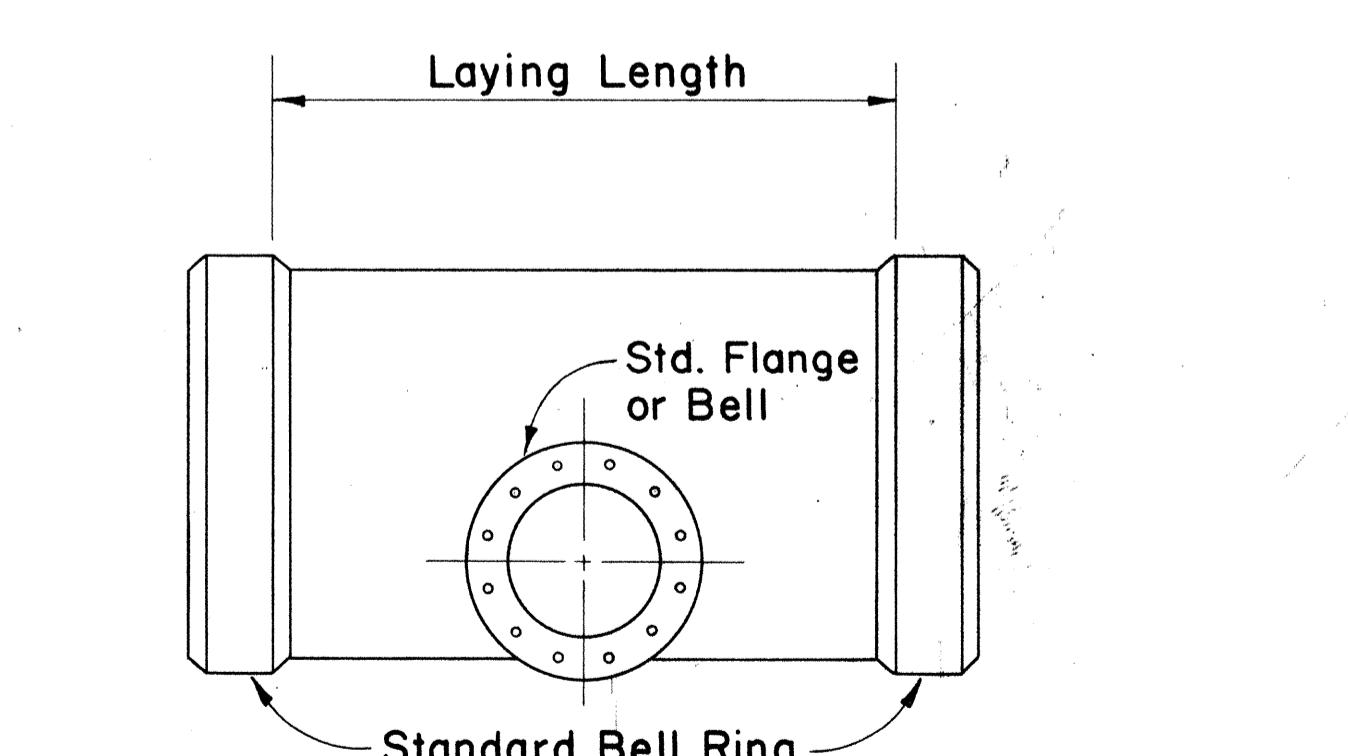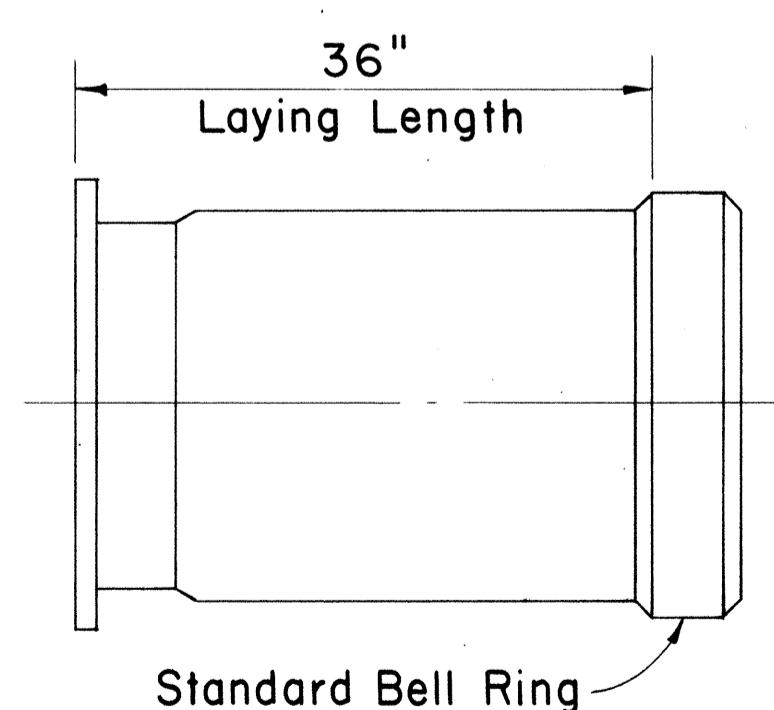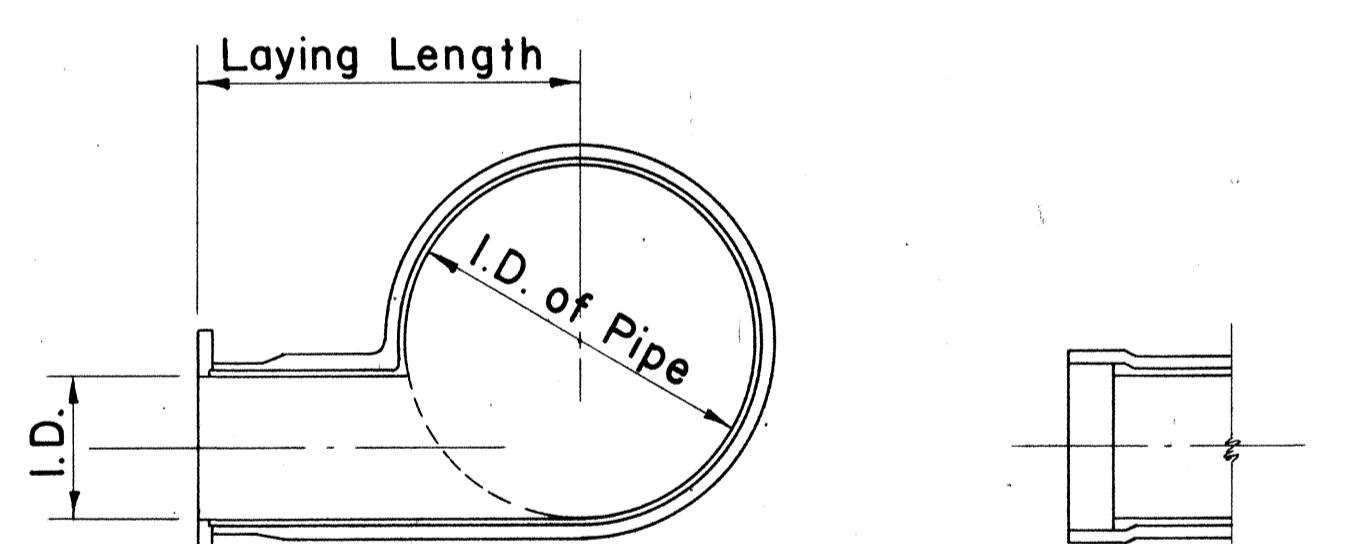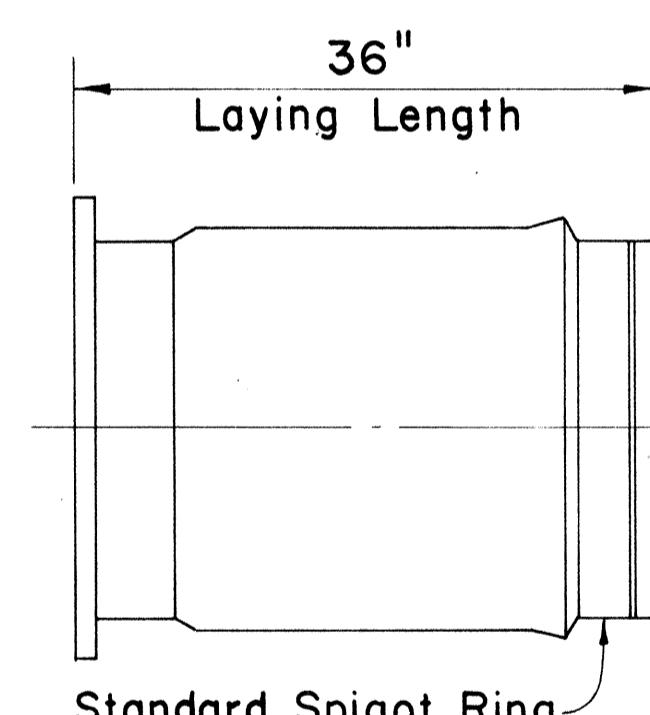


TYPICAL DETAIL OF BLOW-OFF TEE

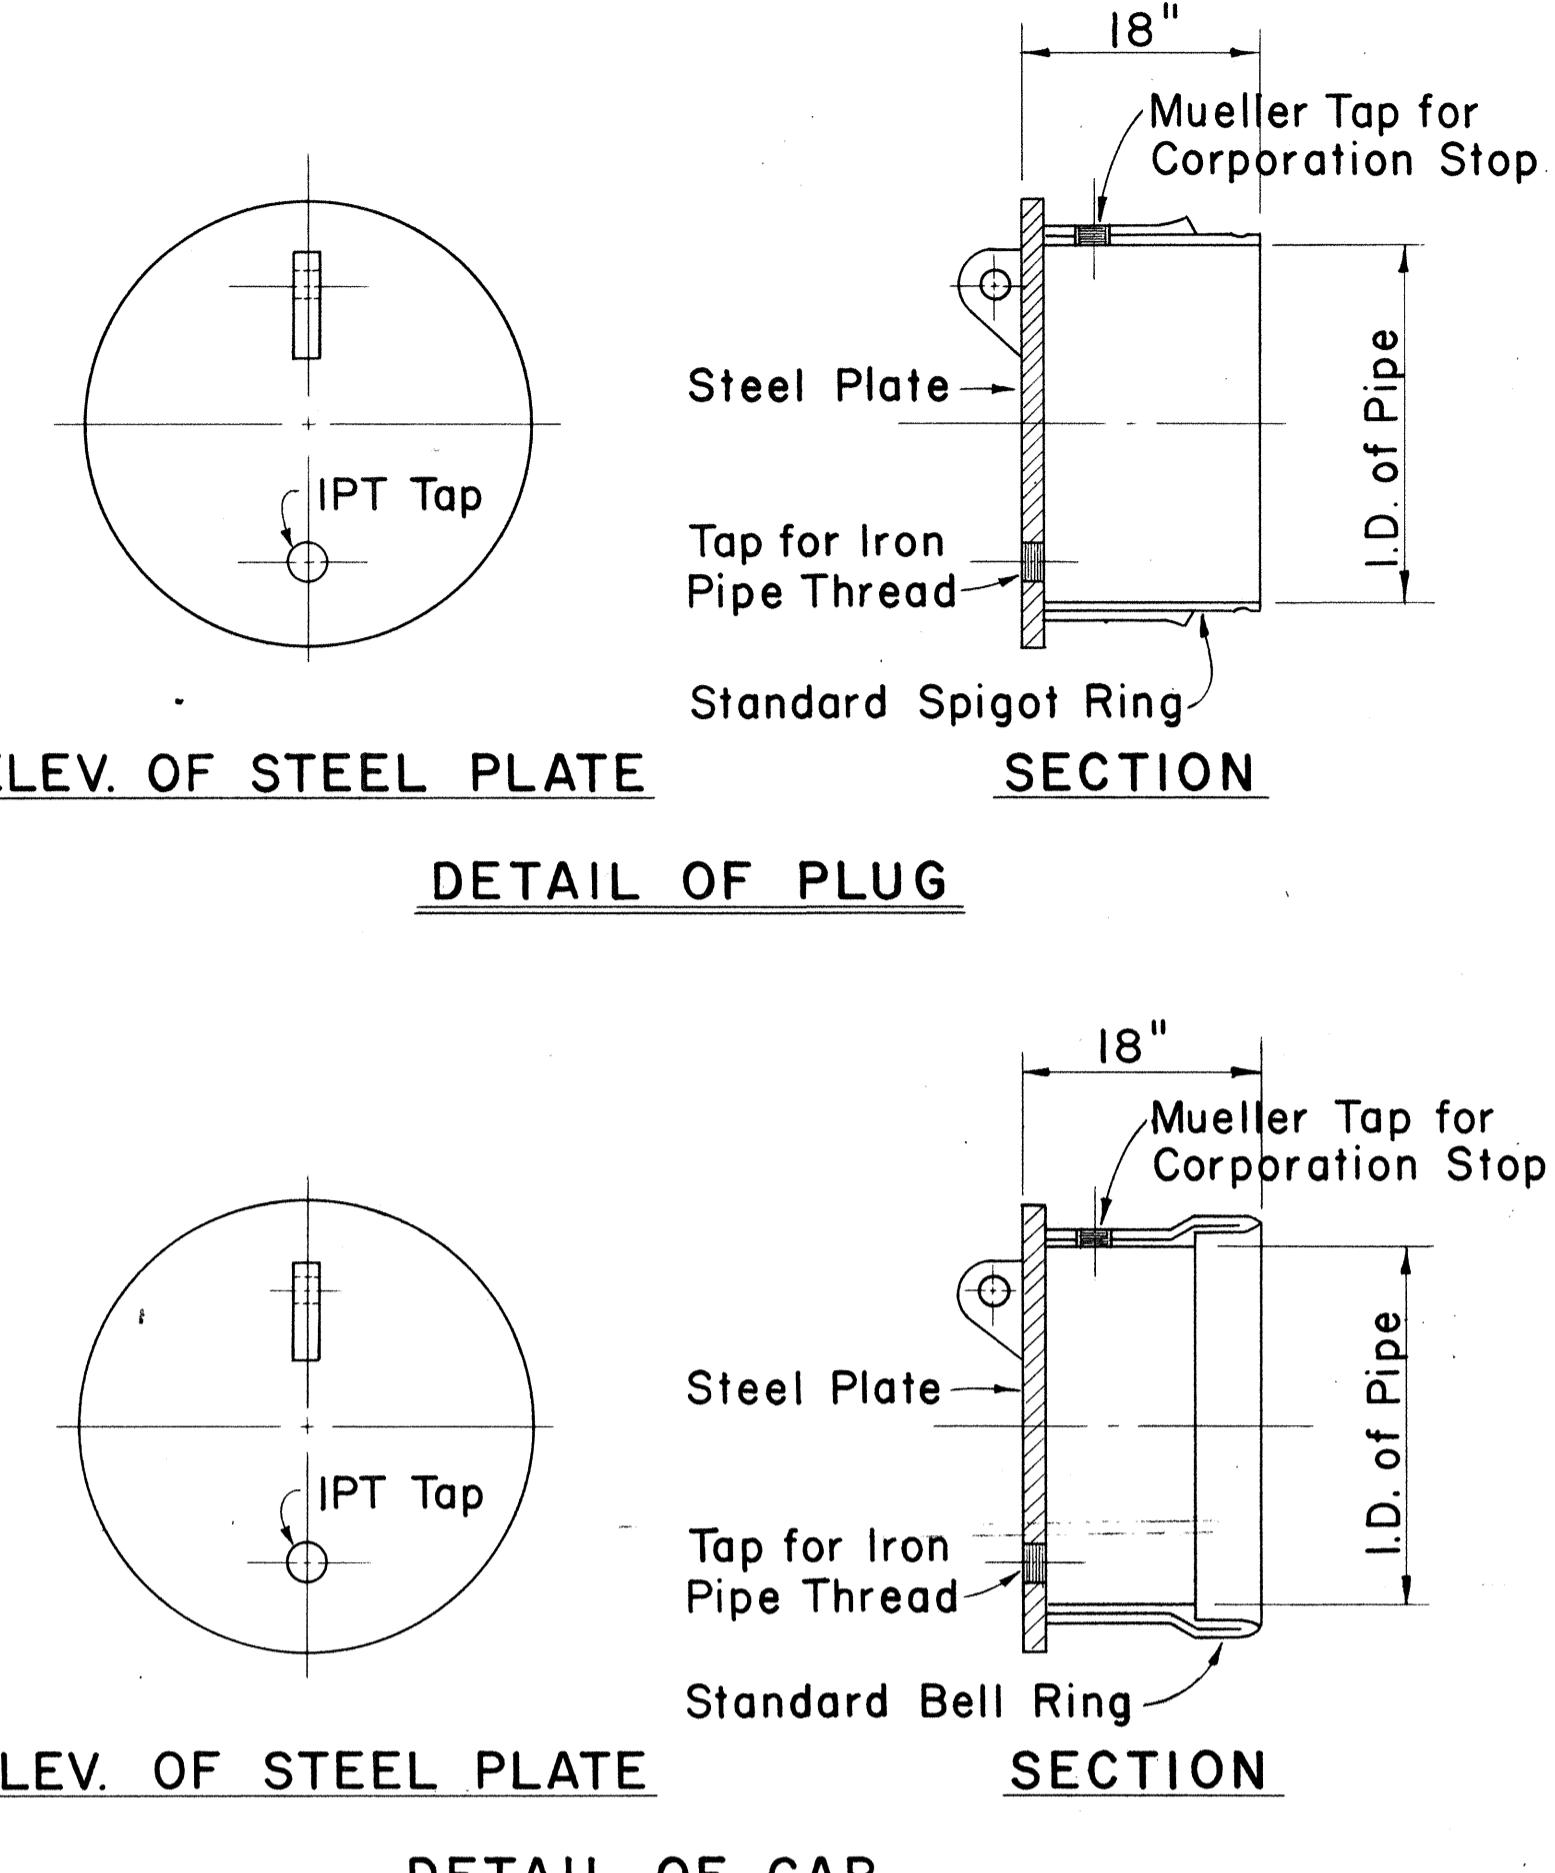

ELEV. OF STEEL PLATE

SECTION

DETAIL OF PLUG

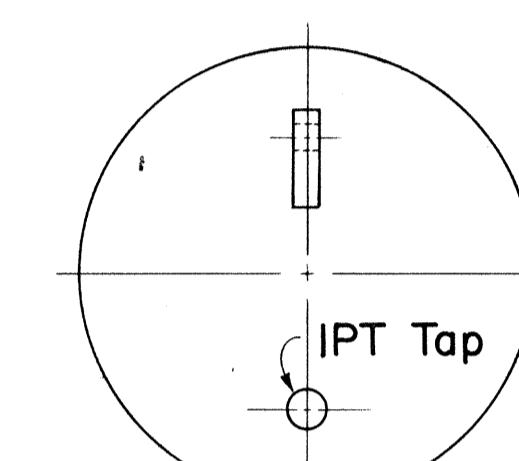

ELEV. OF STEEL PLATE

SECTION

DETAIL OF CAP



STANDARD FITTING DIMENSIONS


DIAMETER	TEE		CROSS (Both Ways)	LATERAL (30° to 75°)		ELBOWS (Center to End)								
	Run J+J	Outlet J		Run X+Y	Outlet Y	2 Piece		3 Piece		4 Piece		5 Piece		
						M	R2	N	R3	P	R4	Q	R5	
16"	34"	17"	34"	62"	52"	12"	60"	18"	44"	26"	39"	44"	40"	
18"	36"	18"	36"	66"	56"	12"	60"	19"	47"	27"	41"	36"	32"	
20"	38"	19"	38"	72"	60"	13"	65"	20"	49"	28"	42"	54"	50"	
22"	40"	20"	40"	78"	66"	13"	65"	21"	51"	30"	45"	41"	37"	
24"	42"	21"	42"	84"	72"	14"	70"	22"	54"	32"	48"	64"	60"	
30"	60"	30"	60"	96"	84"	15"	75"	25"	61"	37"	51"	79"	75"	
36"	66"	33"	66"	110"	96"	16"	80"	27"	66"	40"	60"	94"	90"	
42"	72"	36"	72"	124"	108"	17"	85"	30"	71"	49"	69"	109"	105"	

DIMENSIONS FOR ECCENTRIC REDUCER REDUCING SECTION

36" x 30" Eccentric Reducer — Length 66"
30" x 24" Eccentric Reducer — Length 66"
24" x 20" Eccentric Reducer — Length 26"
20" x 16" Eccentric Reducer — Length 26"
42" x 36" Eccentric Reducer — Length 66"
42" x 30" Eccentric Reducer — Length 66"

NOTE :

All dimensions shown are laying lengths.
All fittings and specials shall be fabricated independent from pipe sections and in accordance with the dimensions shown.
All fittings and specials shall be all bell unless otherwise noted.
All tees, wyes, crosses and reducers 16-inch in diameter and larger shall be reinforced with steel ribs or steel crotch plates welded continuously to the cylinder or by other methods to withstand the longitudinal crushing effect caused by the test pressure as called for in the plans.

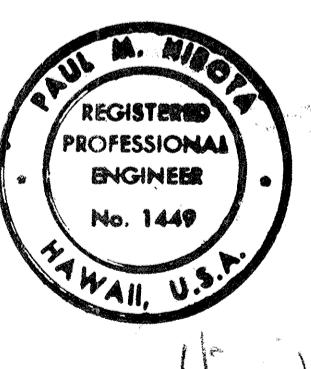


This work was prepared by me
or under my supervision

STATE OF HAWAII
DEPARTMENT OF TRANSPORTATION
HIGHWAYS DIVISION
NIMITZ SPUR


CONCRETE CYLINDER PIPE
MISCELLANEOUS DETAILS
INTERSTATE ROUTE H-1
PROJ. NO. I-HI-1099:15

Scale: No Scale Date: AUG 4 1976

SHEET NO. 13 OF 10 SHEETS

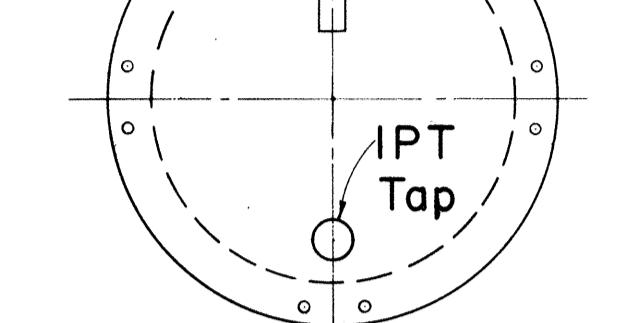



ELEV. OF BLIND FLANGE

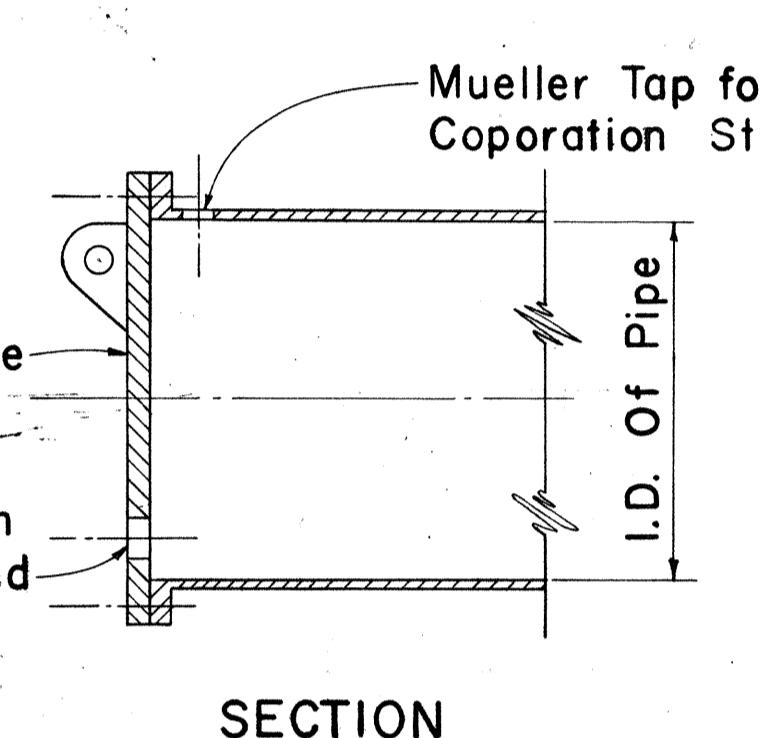


SECTION

DETAIL OF BLIND FLANGE


FED. ROAD DIST. NO.	STATE	FED. AID PROJ. NO.	FISCAL YEAR	SHEET NO.	TOTAL SHEETS
HAWAII	HAW.	I-HI-001	1977	171	350

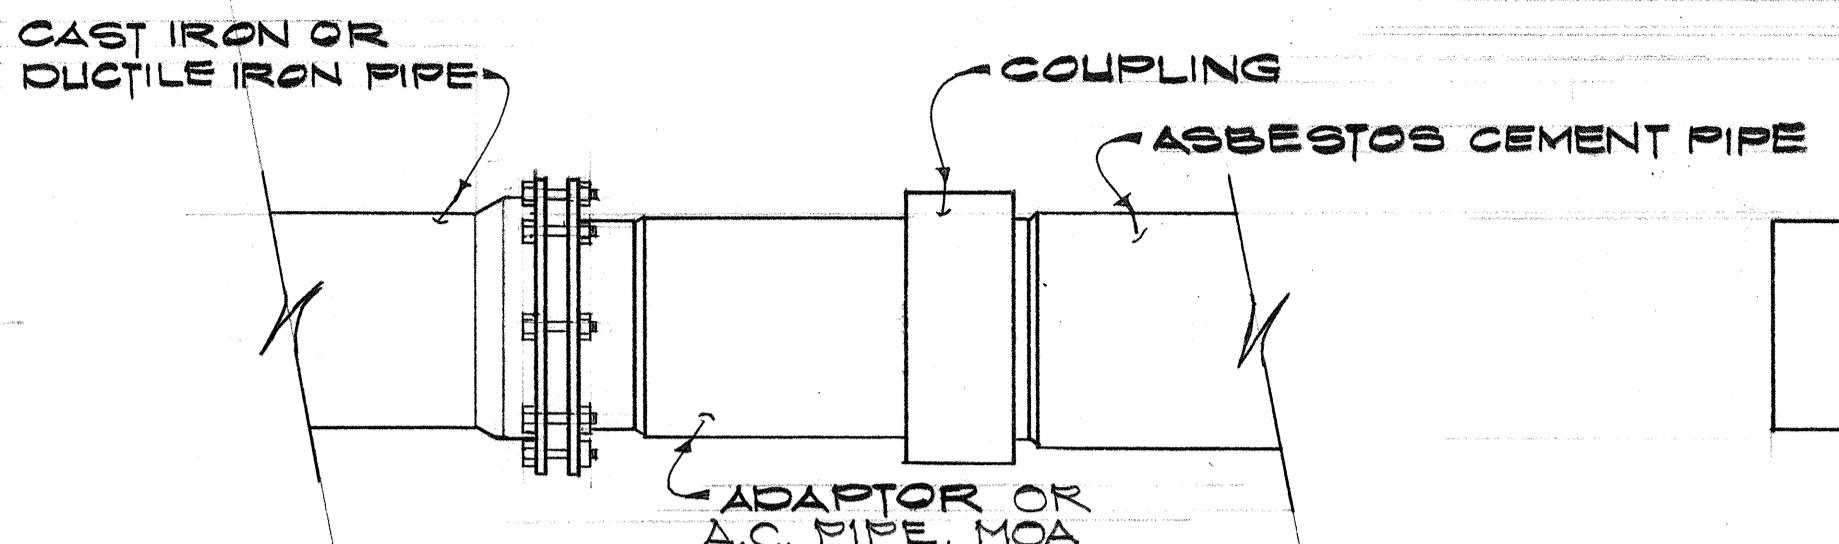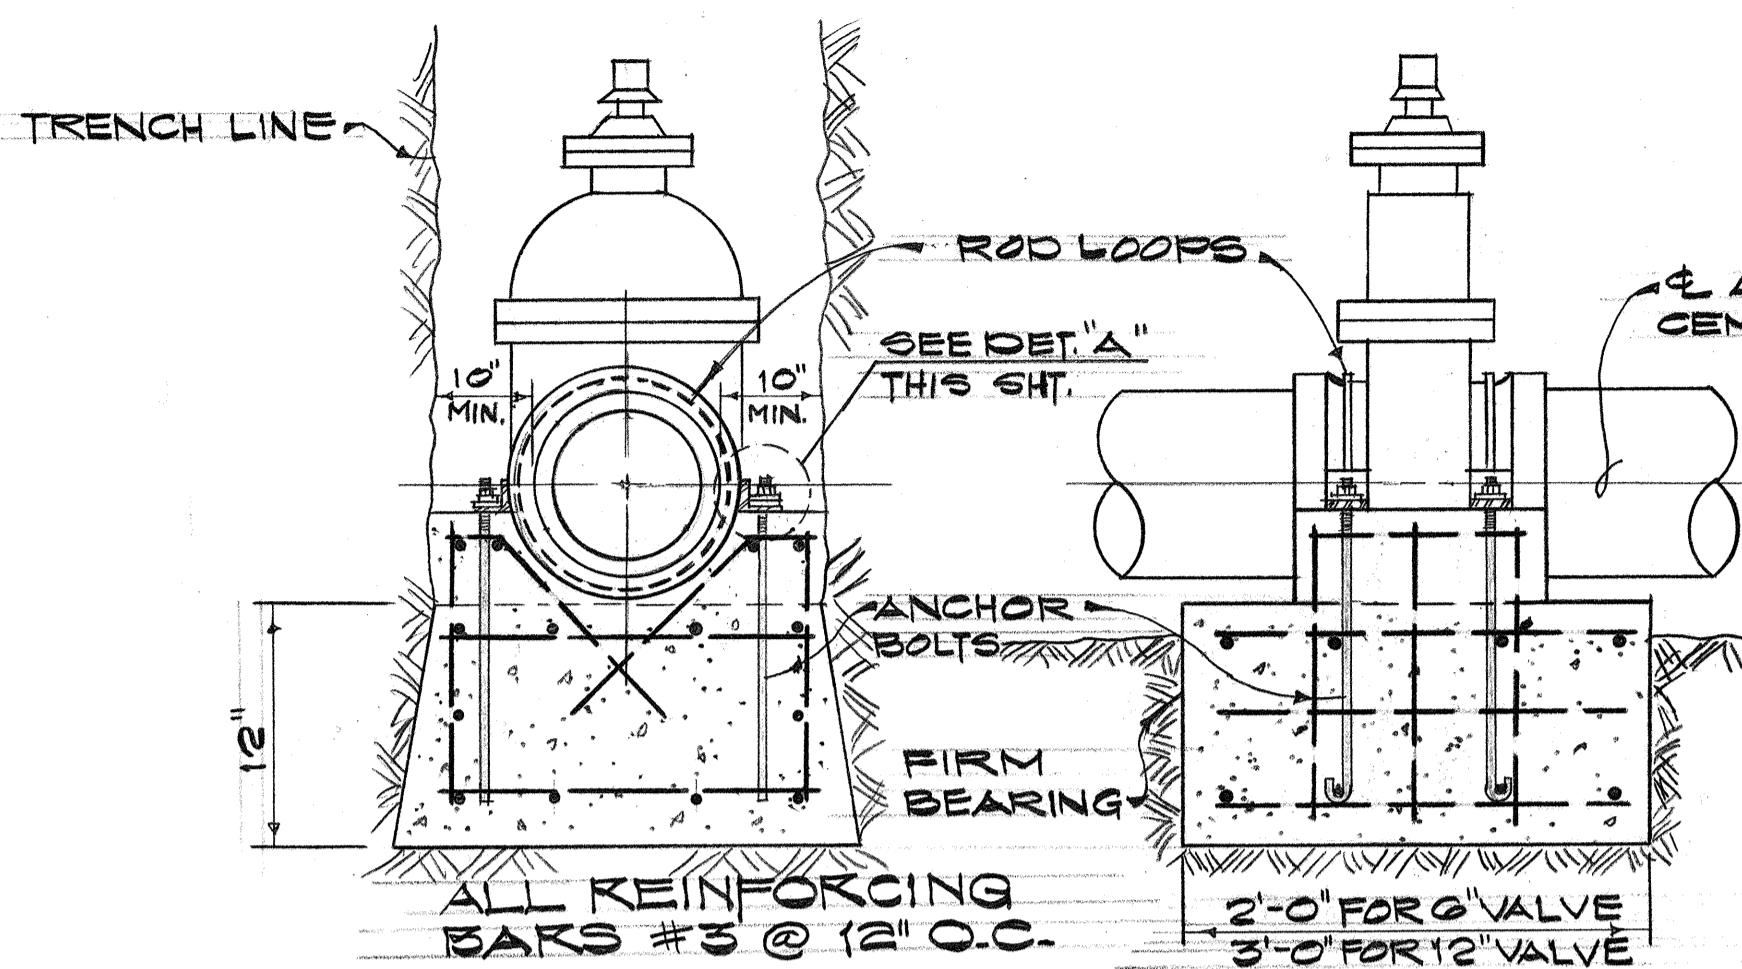

TYPICAL CONNECTION FOR MECHANICAL JOINT FITTING
NOT TO SCALE

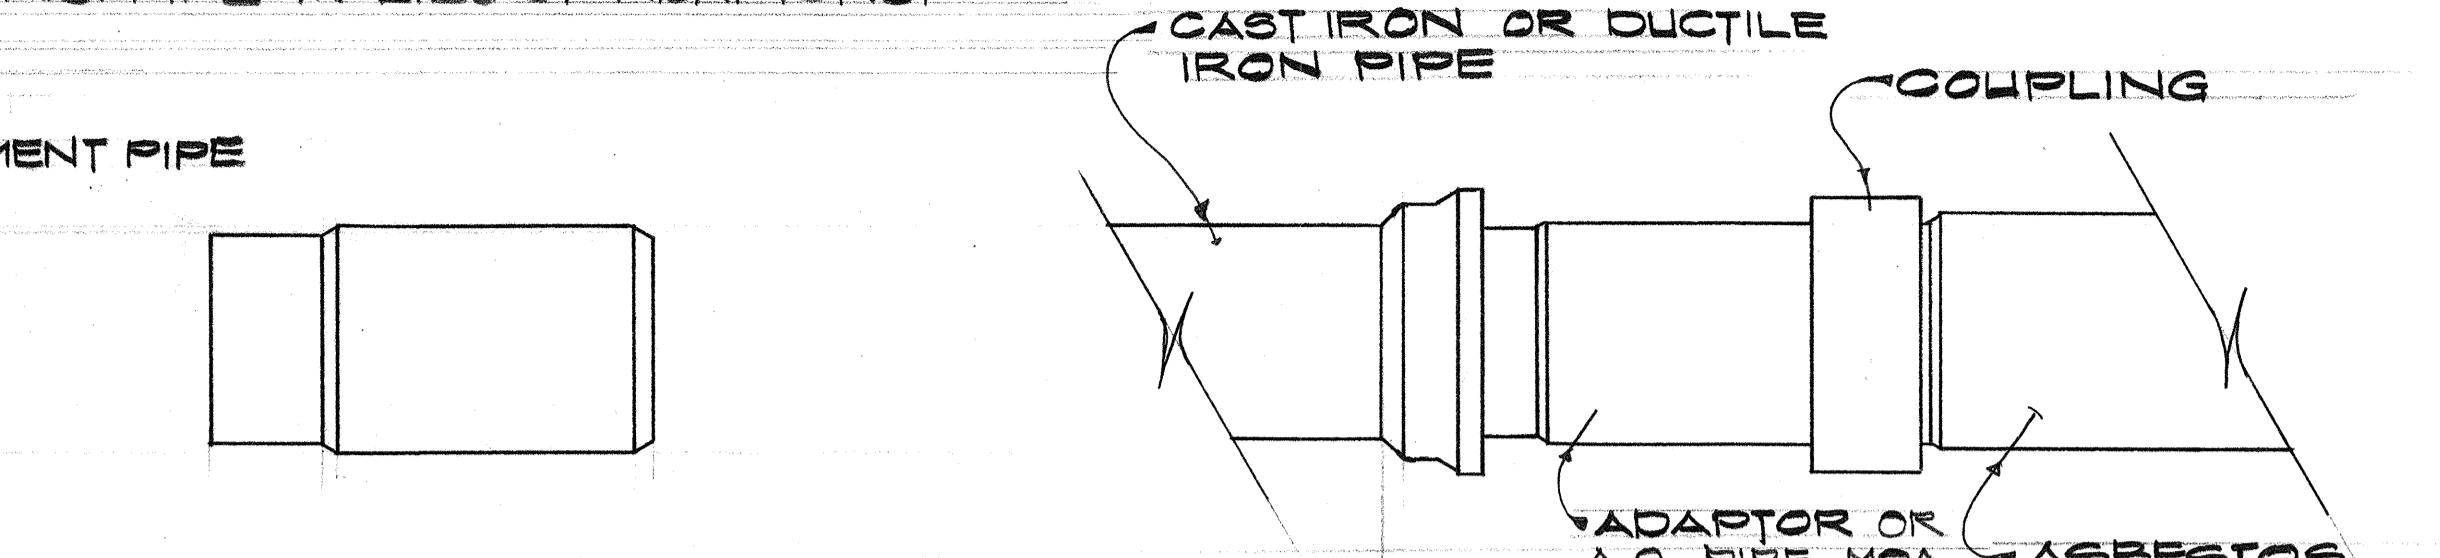



TYPICAL A.C. PIPE ADAPTOR
NOT TO SCALE

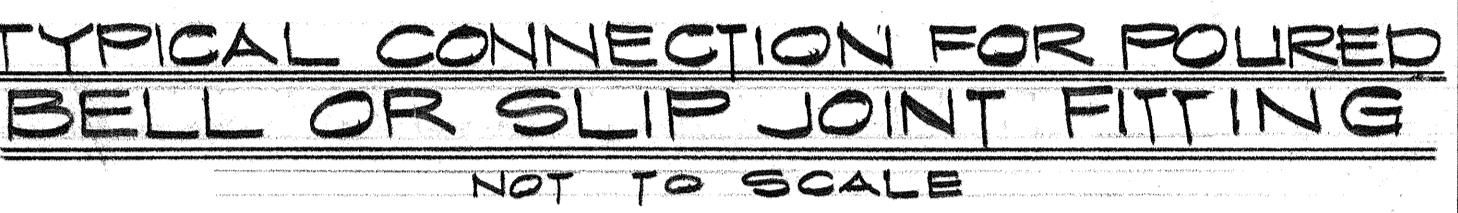

TYPICAL CONNECTION FOR Poured BELL OR SLIP JOINT FITTING
NOT TO SCALE

NOTES:


1. APPLY BOND BREAKER BETWEEN GATE VALVE AND CONCRETE
2. ALL ANCHOR MATERIALS SHALL BE OF NON-CORROSIVE METAL
3. 3" CLEARANCE FOR ALL REINFORCING STEEL.
4. ANCHOR BLOCK FOR GATE VALVES INCLUDING REINFORCING STEEL, ANCHOR BOLTS & ALL ACCESSORIES SHALL BE CONSIDERED INCIDENTAL & INCLUDED IN THE PRICE BID FOR A.C. PIPE.

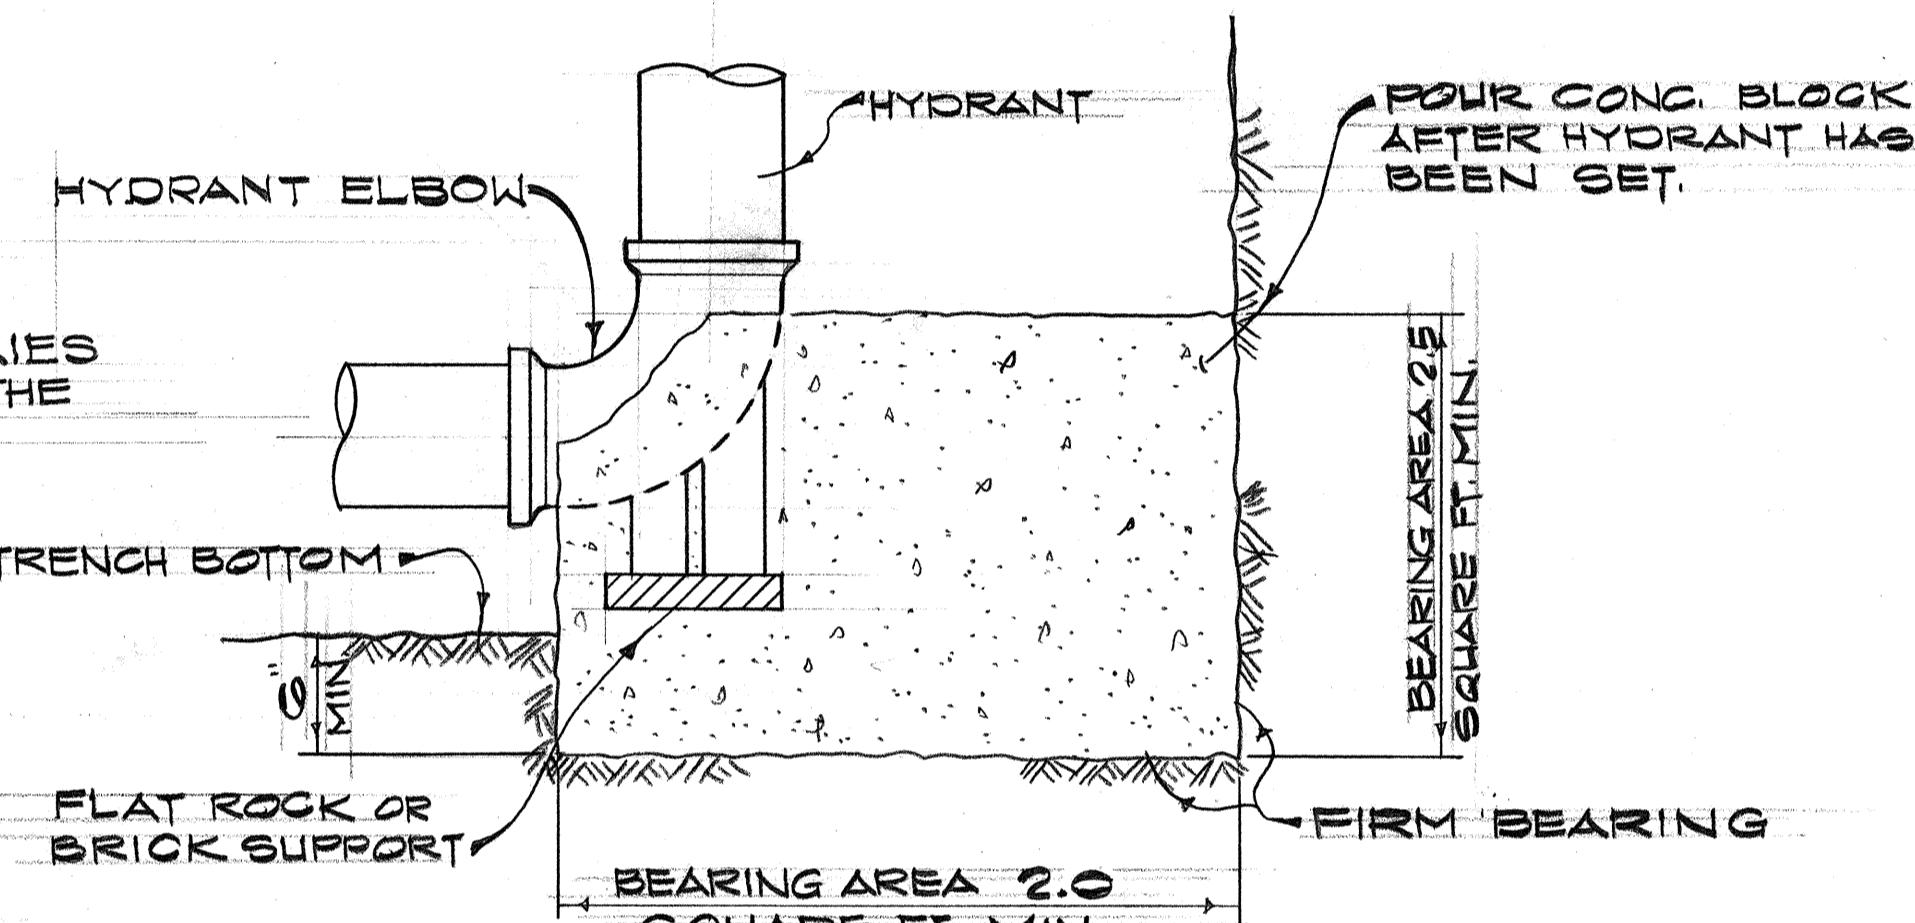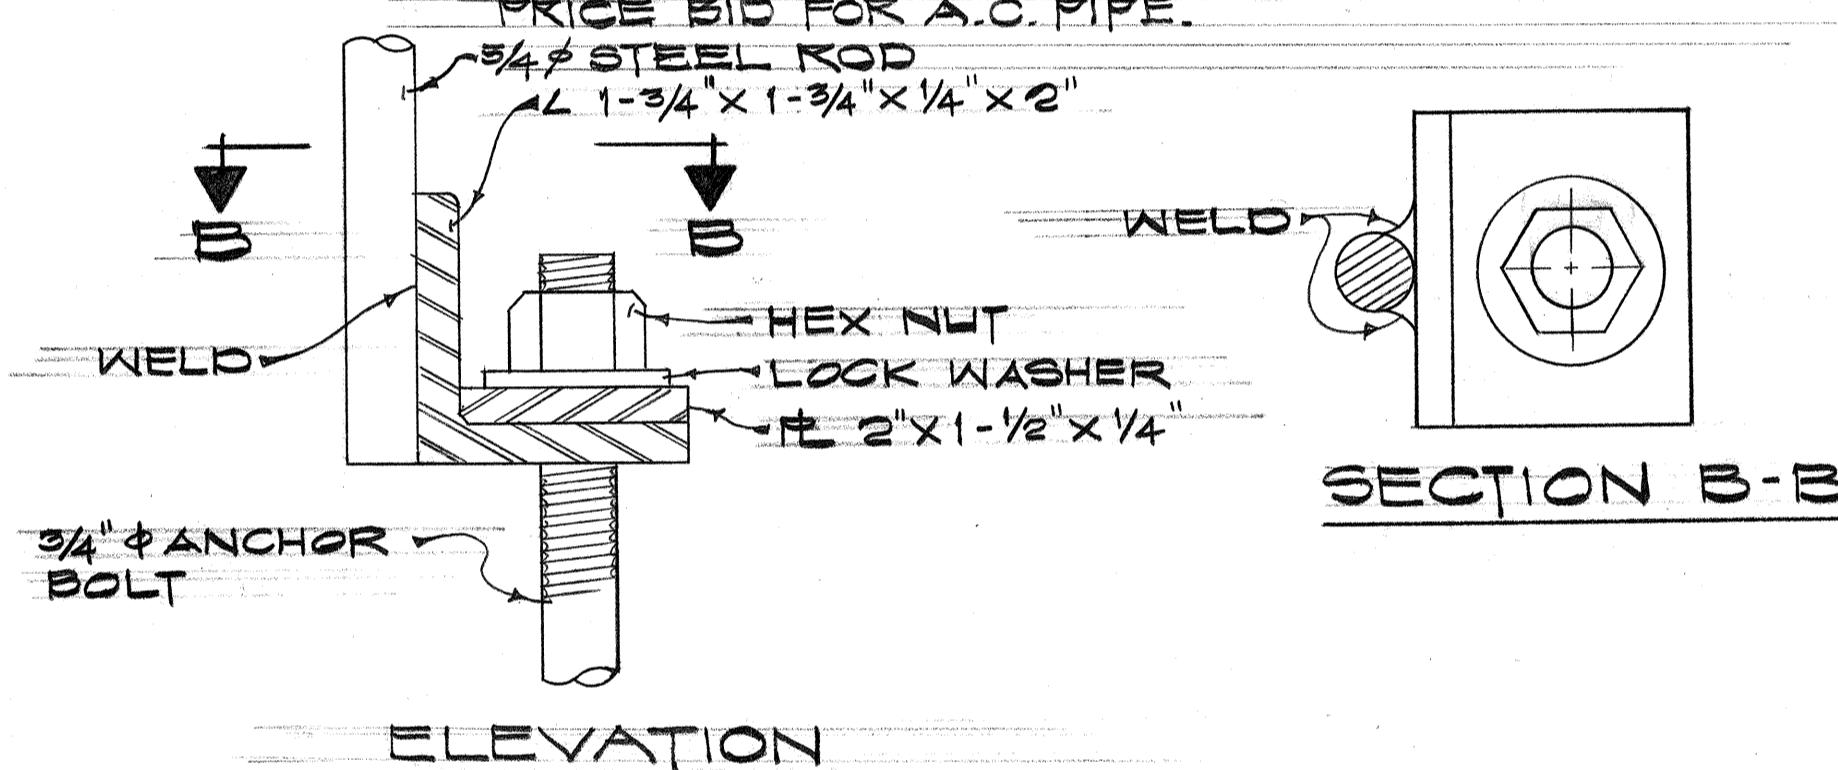

CONCRETE BLOCK FOR HYDRANT
NOT TO SCALE

DETAIL "A" - FOR WATER VALVES
NOT TO SCALE 12" & SMALLER (TYP.)


ASBESTOS CEMENT PIPE CONNECTION DETAILS

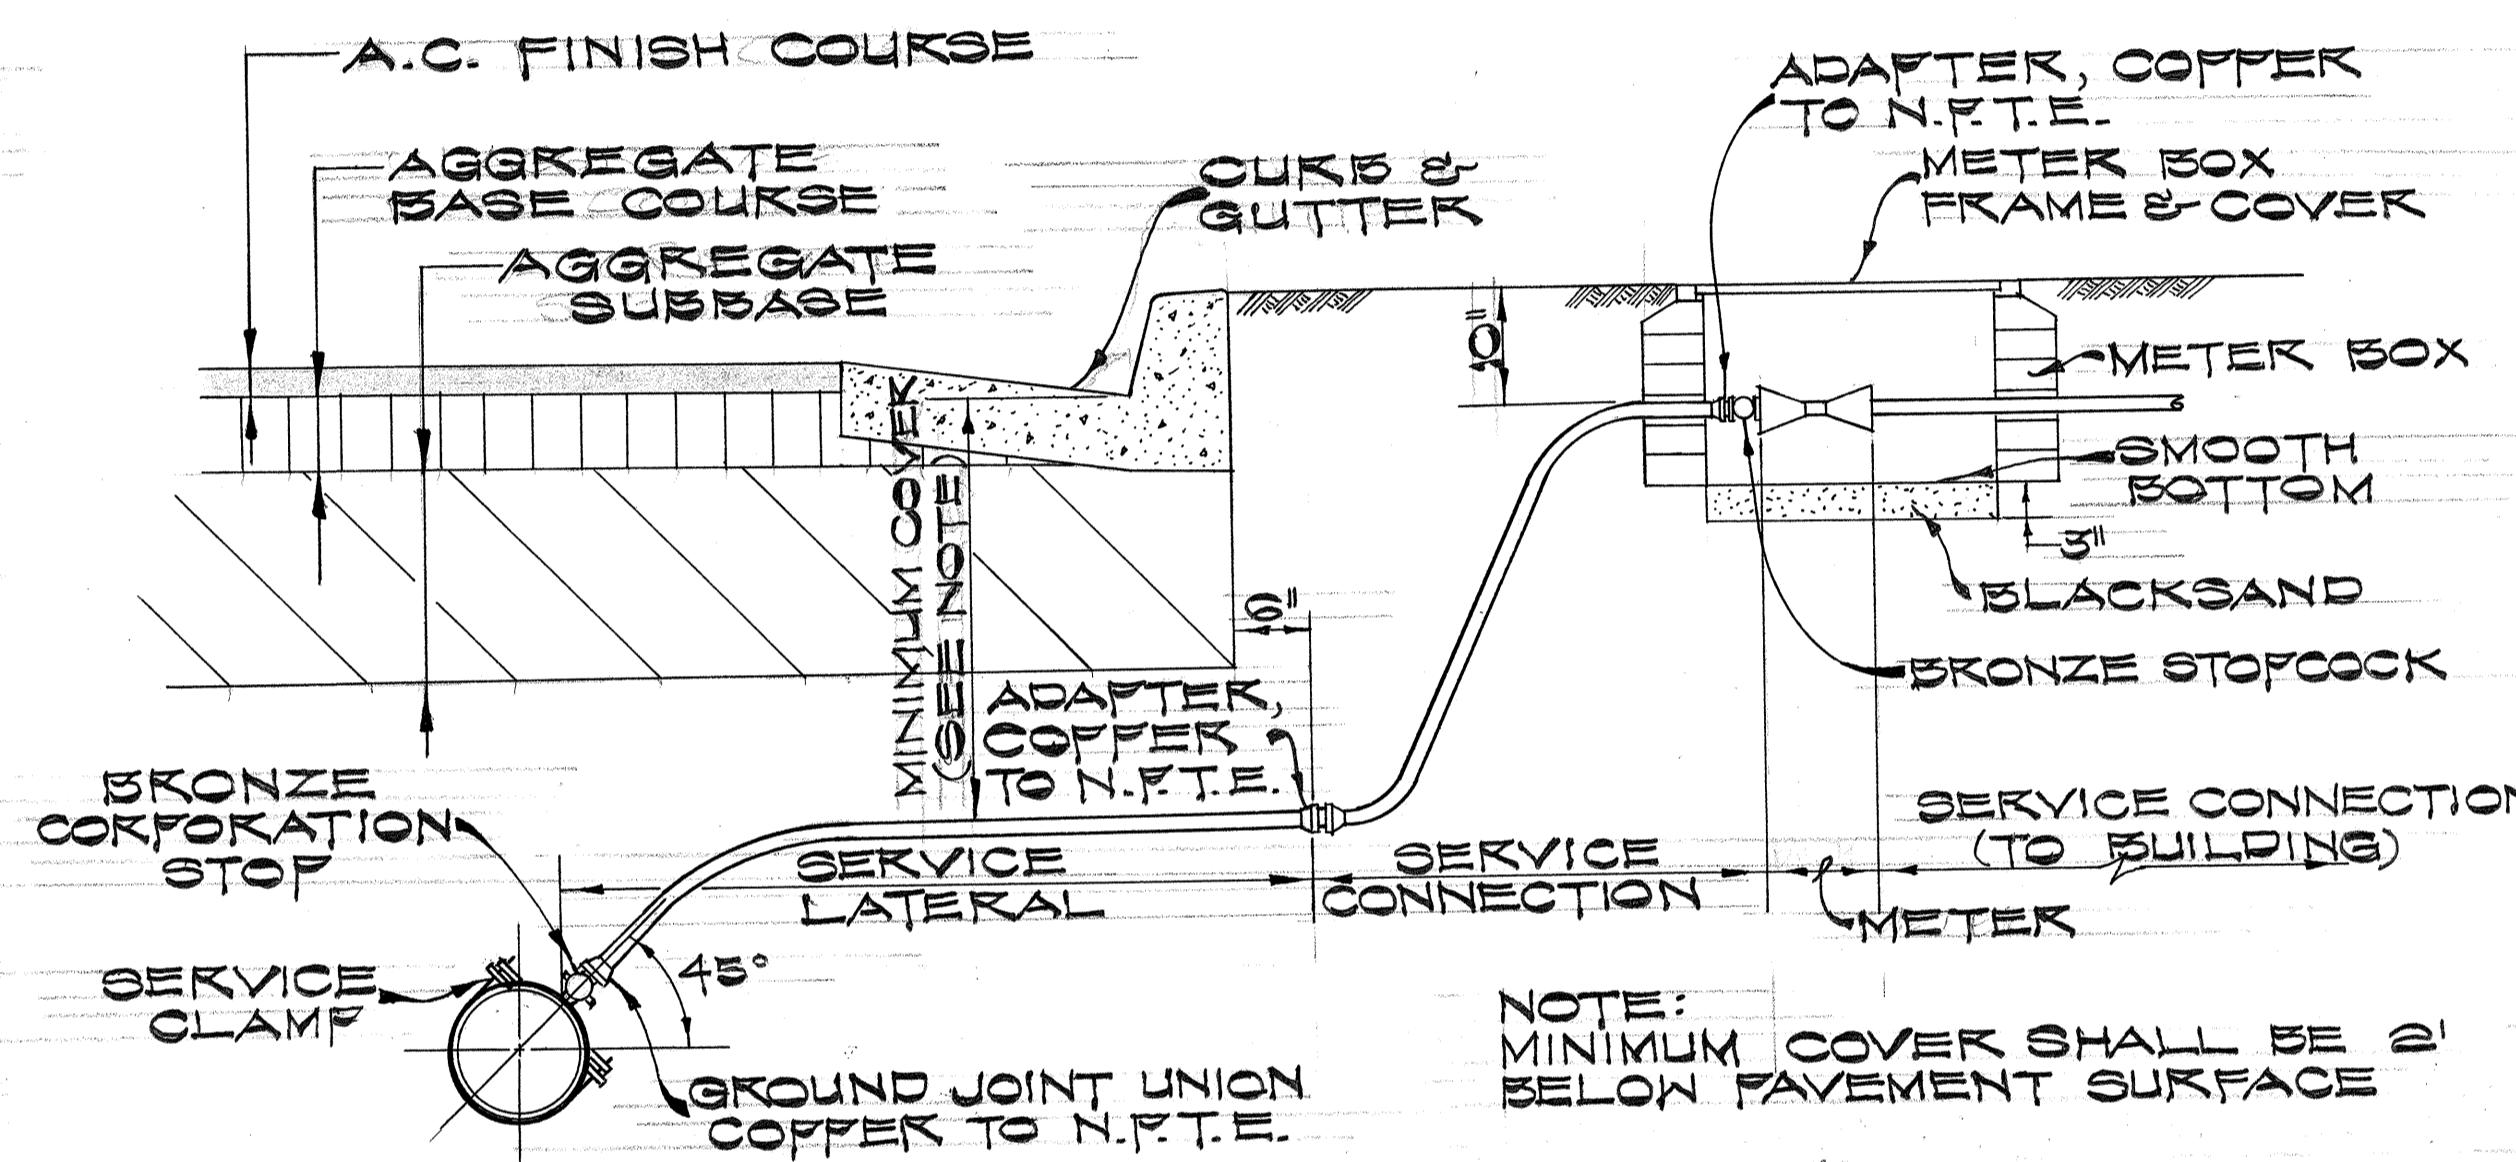

NOTE:
MINIMUM COVER SHALL BE 6'
BELOW PAVEMENT SURFACE

SERVICE LATERAL, SERVICE CONNECTION AND WATER METER
NOT TO SCALE

DATE
SURVEY PLOTTED BY
DRAWN BY
DESIGNED BY
QUANTITIES BY
CHECKED BY
ORIGINAL PLAN NOTE BOOK No. _____

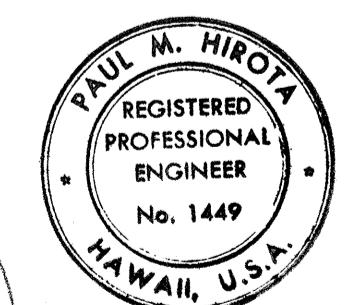

Paul M. Hirota
THIS WORK WAS PREPARED BY ME
OR UNDER MY SUPERVISION


STATE OF HAWAII
DEPARTMENT OF TRANSPORTATION
HIGHWAYS DIVISION

NIMITZ SPUR

WATER DETAILS


INTERSTATE ROUTE HI
PROJ. NO. I-HI-1(09):15
SCALE AS NOTED DATE: AUG 4 1976
SHEET NO. 14 OF 10 SHEETS

FED. ROAD DIST. NO.	STATE	FED. AID PROJ. NO.	FISCAL YEAR	SHEET NO.	TOTAL SHEETS
HAWAII	HAW.	IHH0915	1977	172	350

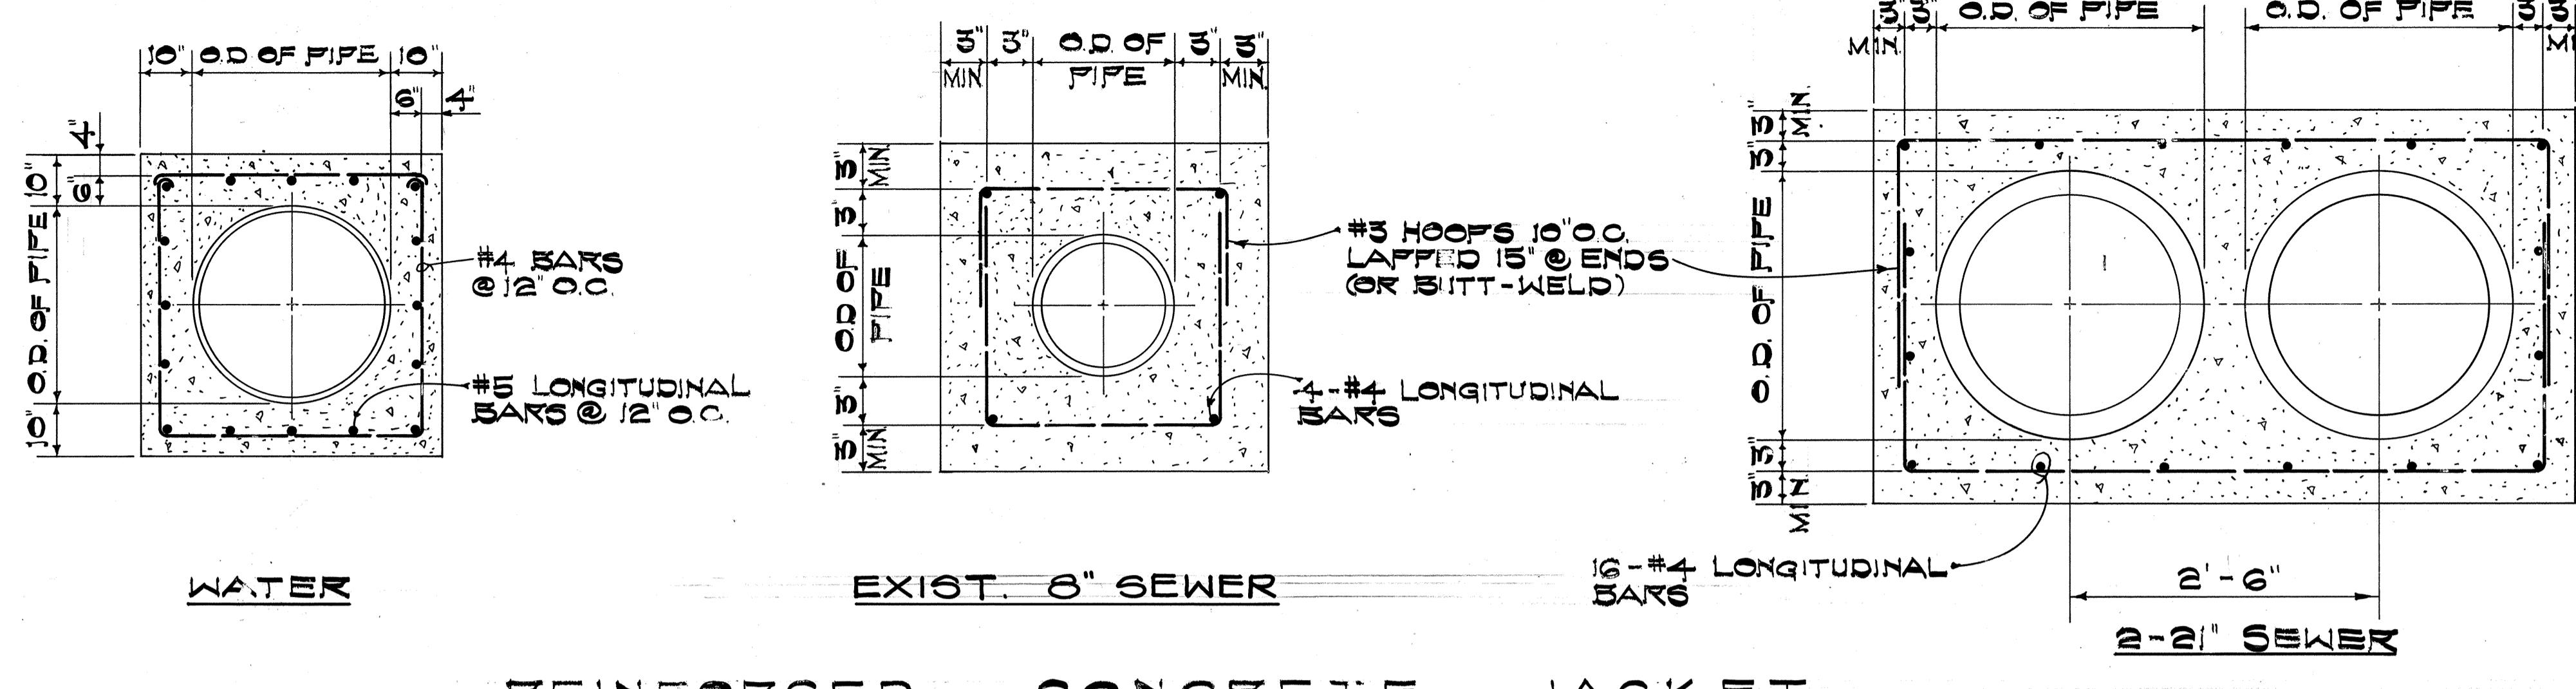


REINFORCED CONCRETE JACKET
NOT TO SCALE

HORIZ. & VERT. BARS
SEE TABLE THIS SHT.

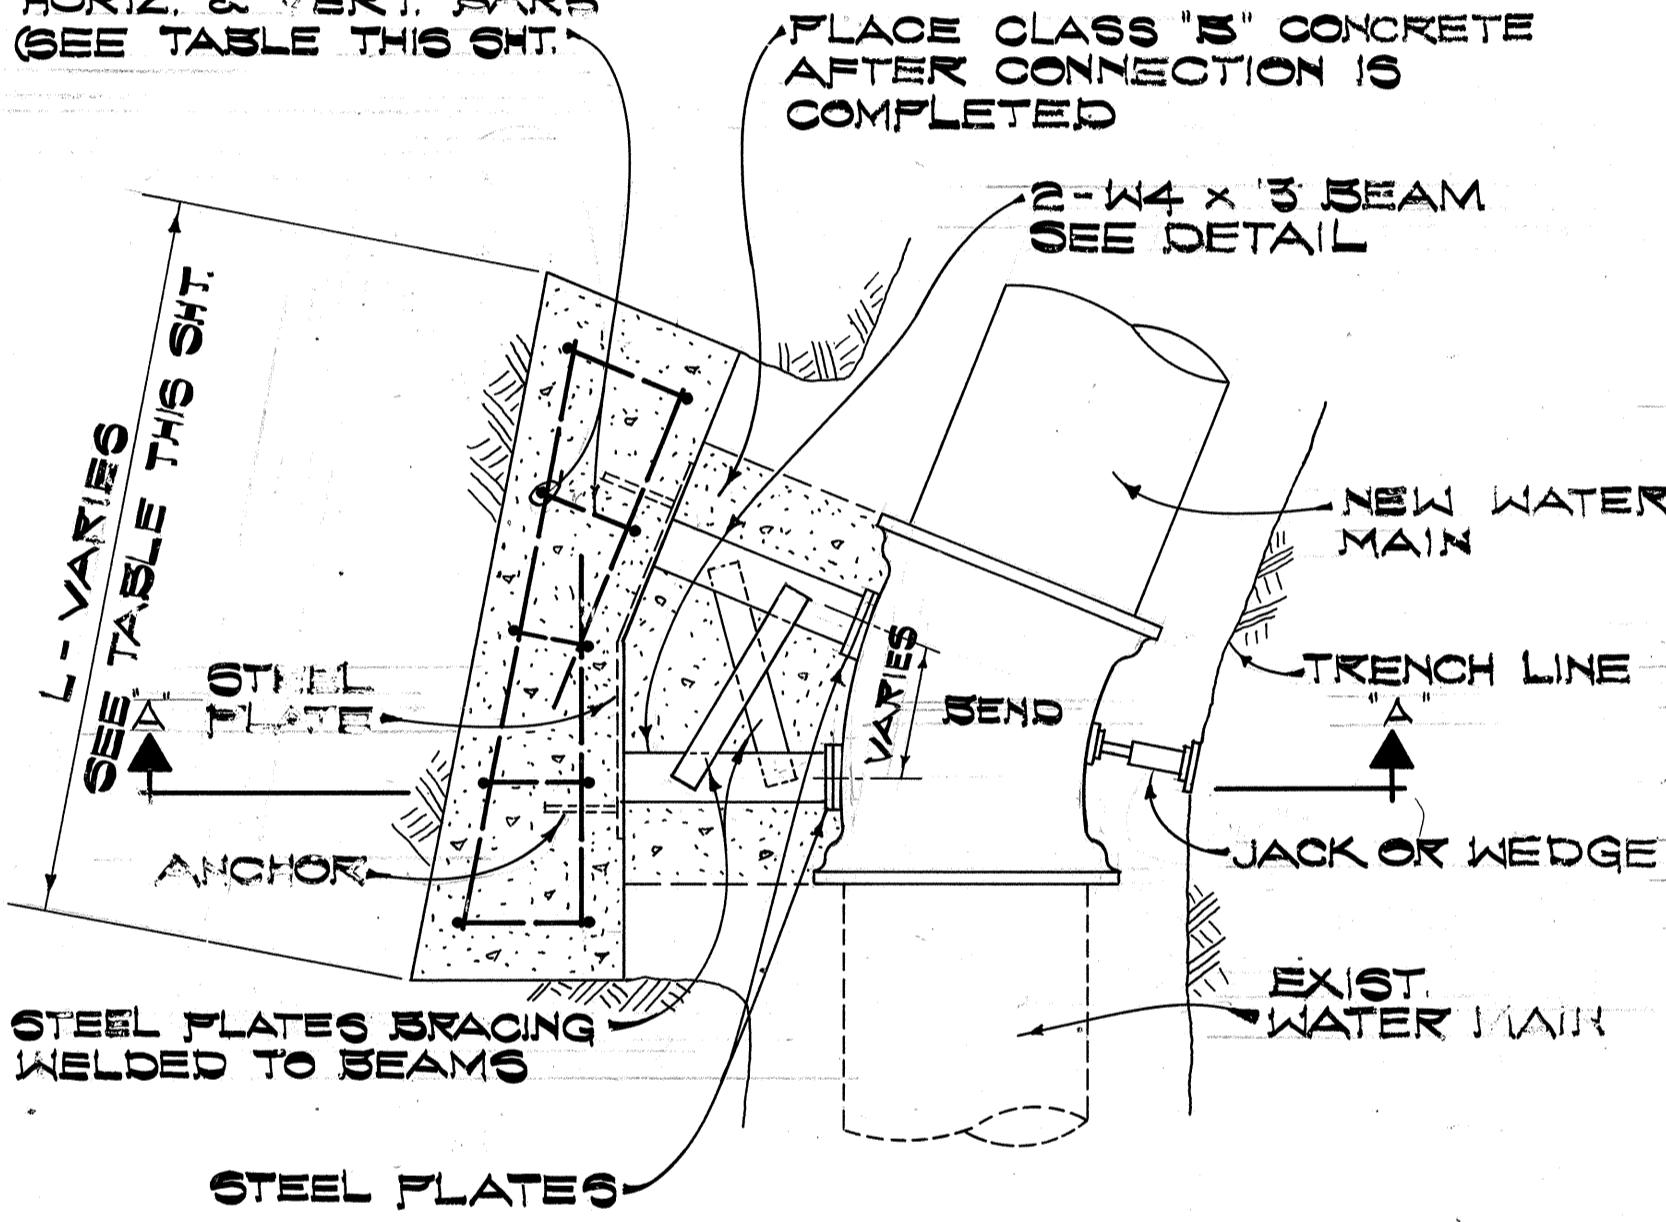

WATER LINE SIZE	H	L	HORIZONTAL REINFORCING	VERTICAL REINFORCING	WATER PRESSURE OR CLASS PIPE	DEGREE BEND
20"	4'-0"	8'-0"	#G@10° E.F.	#G@10° E.F.	150 P.S.I.	1/8"
30"	4'-0"	4'-0"	#G@8° E.F.	#G@8° E.F.	"	1/16
30"	5'-0"	8'-0"	#B@12° E.F.	#B@12° E.F.	"	1/8
6"	2'-0"	3'-4"	#4@12° E.F.	#4@12° E.F.	"	1/32
12"	2'-0"	5'-0"	#4@12° E.F.	#4@12° E.F.	"	1/32
12"	2'-0"	5'-0"	#4@12° E.F.	#4@12° E.F.	"	1/16

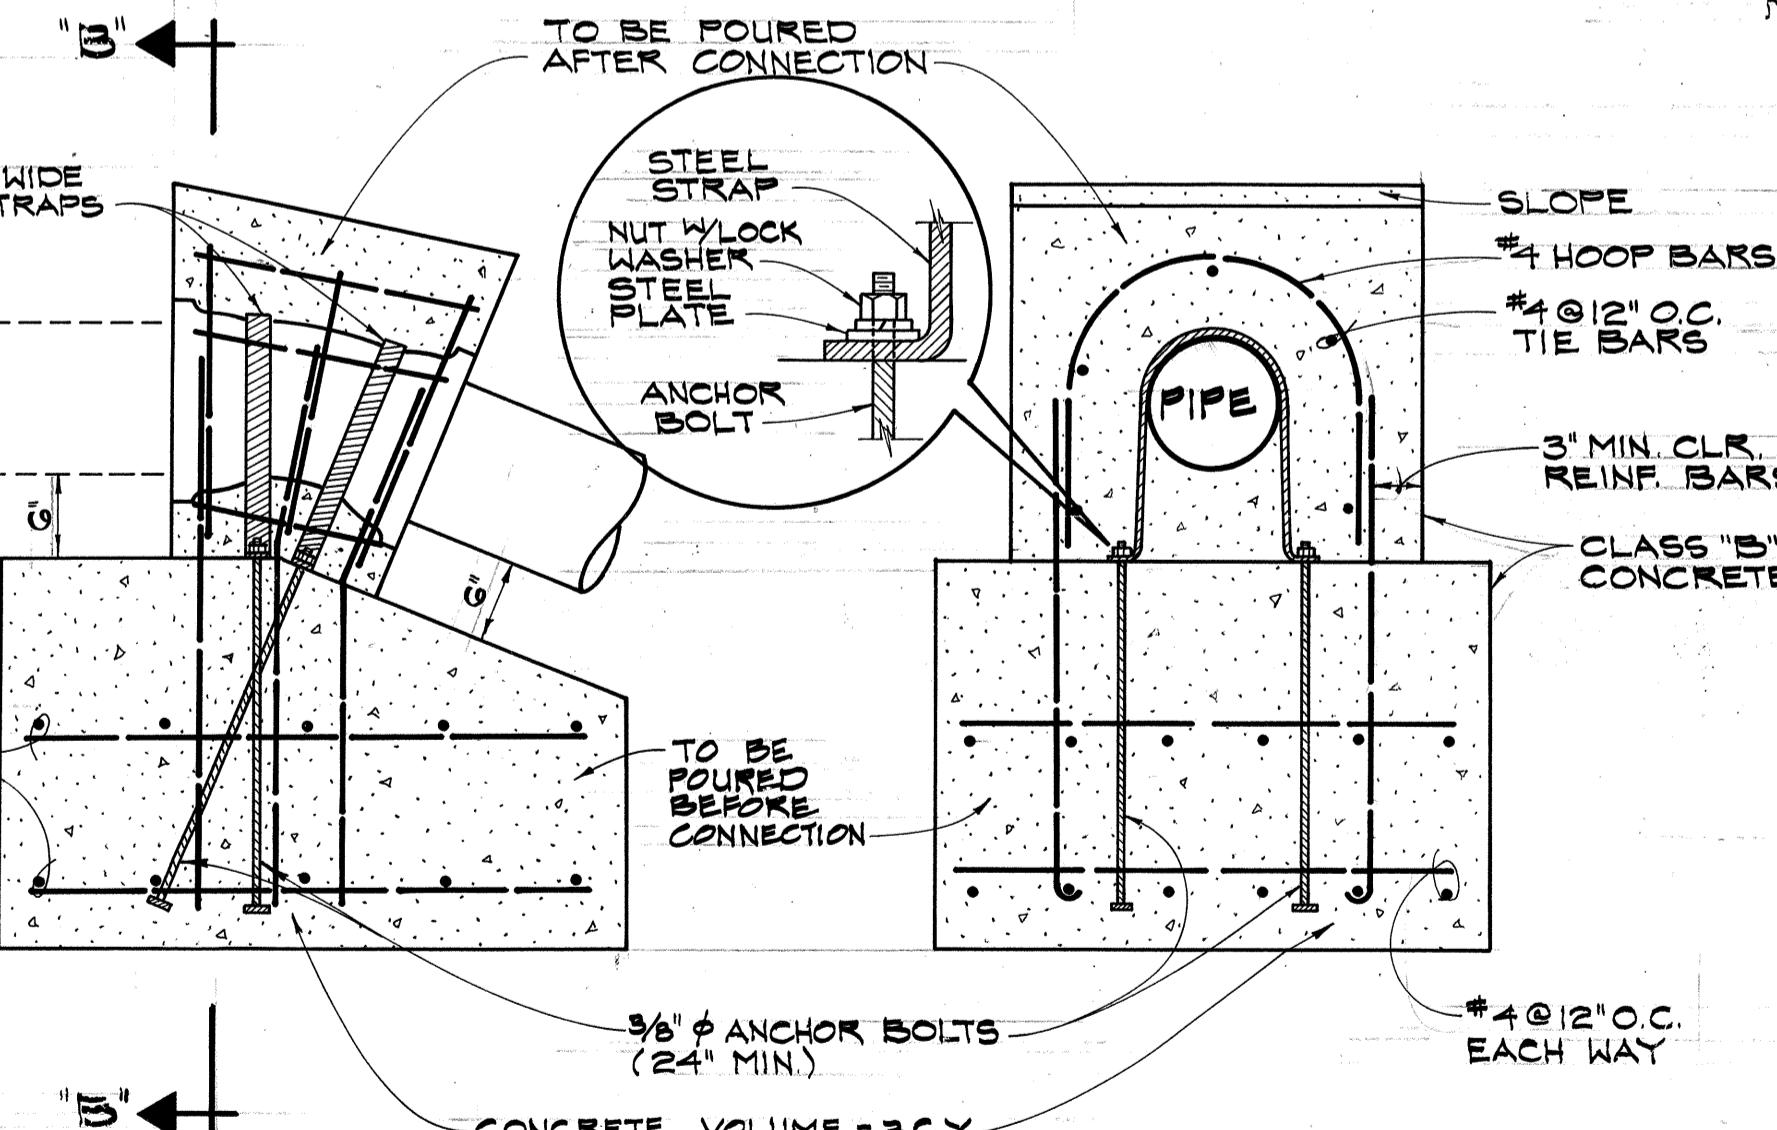

**PRECAST CONCRETE BLOCK
WITH STRUCTURAL STRUT**
NOT TO SCALE


**ELEVATION
TOP VERTICAL REACTION BLOCK**
NOT TO SCALE

SECTION "B-B"

11/23/77 ADDED TOP VERTICAL REACTION BLOCK DETAIL

12/13/76 CONC. BLOCK TABLE: ADDED 6" 1/8 BEND, 12" 1/16 BEND, & DELETED 18"X6" TEE MINIMUM COVER EXCEPTION FOR AIR FORCE 6" WATER ADDED TO TRENCH DETAIL

DATE: 12/13/76
REVISION: 1

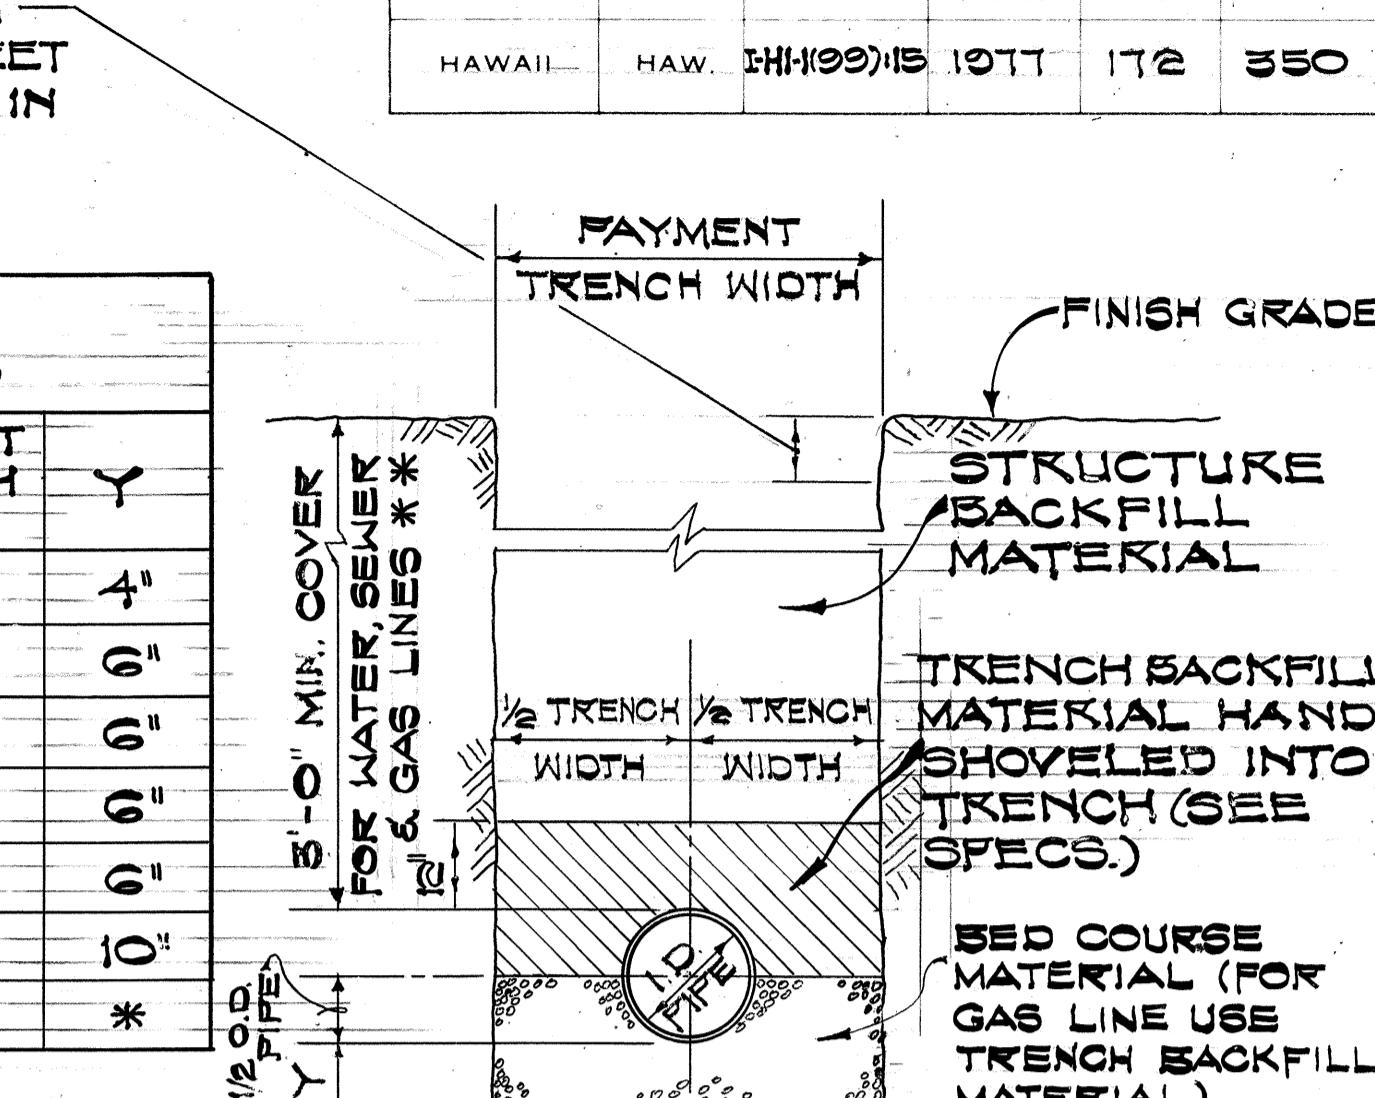

TRENCH DETAIL
NOT TO SCALE

FITTING	BEARING AREA SQ. FT.
G" 1/32 BEND	0.3
G" 1/8 BEND	1.6
G" 1/4 BEND	2.0
G" TEE	1.5
8" 1/4 BEND	2.5
12" 1/32 BEND	1.1
12" 1/16 BEND	3.3
12" 1/8 BEND	4.3
12"X6" TEE	1.5
12"X12" TEE	5.7
14" 1/16 BEND	3.0
14"X6" TEE	1.5
18" 1/8 BEND	9.7
18" PLUG	12.7
20" 1/32 BEND	3.1
20" 1/16 BEND	6.1
20" 1/8 BEND	12.0
20"X12" TEE	5.7
30" 1/32 BEND	6.9
30" 1/16 BEND	13.6
30" 1/8 BEND	27.1

APPROVED BY (FOR GAS LINES RELocation ONLY)

GASCO, INC. DATE

STATE OF HAWAII
DEPARTMENT OF TRANSPORTATION
HIGHWAYS DIVISION


HIMITZ SPUR

MISC. DETAILS
WATER, SEWER & GAS

INTERSTATE ROUTE H-1
PROJECT NO. I-HI-1(90)15

SCALE: AS NOTED DATE: AUG 4 1976



SHEET NO. 15 OF 19 SHEETS

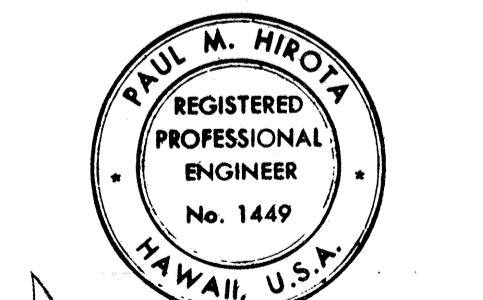

Paul M. Hirota
THIS WORK WAS PREPARED BY ME
OR UNDER MY SUPERVISION

ADD. 172


FED. ROAD DIST. NO.	STATE	FED. AID PROJ. NO.	FISCAL YEAR	SHEET NO.	TOTAL SHEETS
HAWAII	HAW.	I-HI-1(99)15	1977	173	350

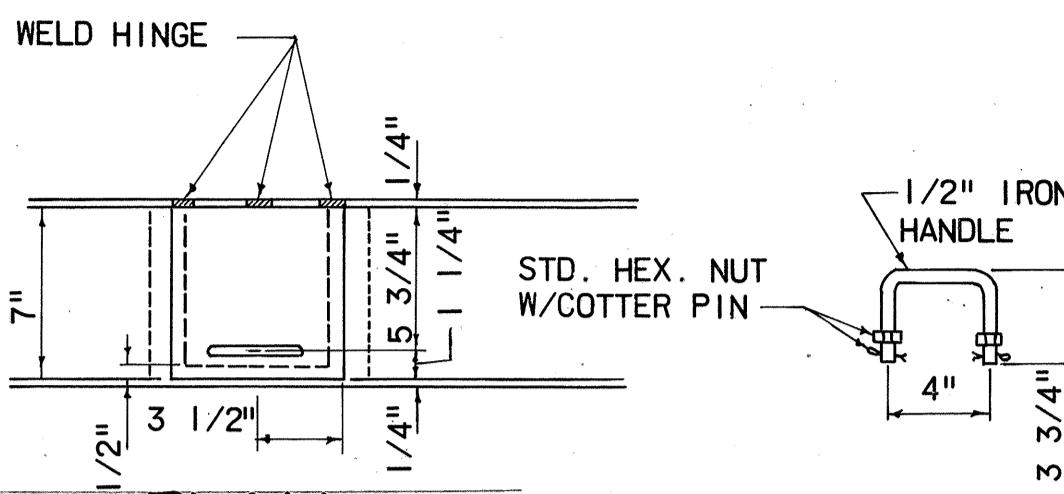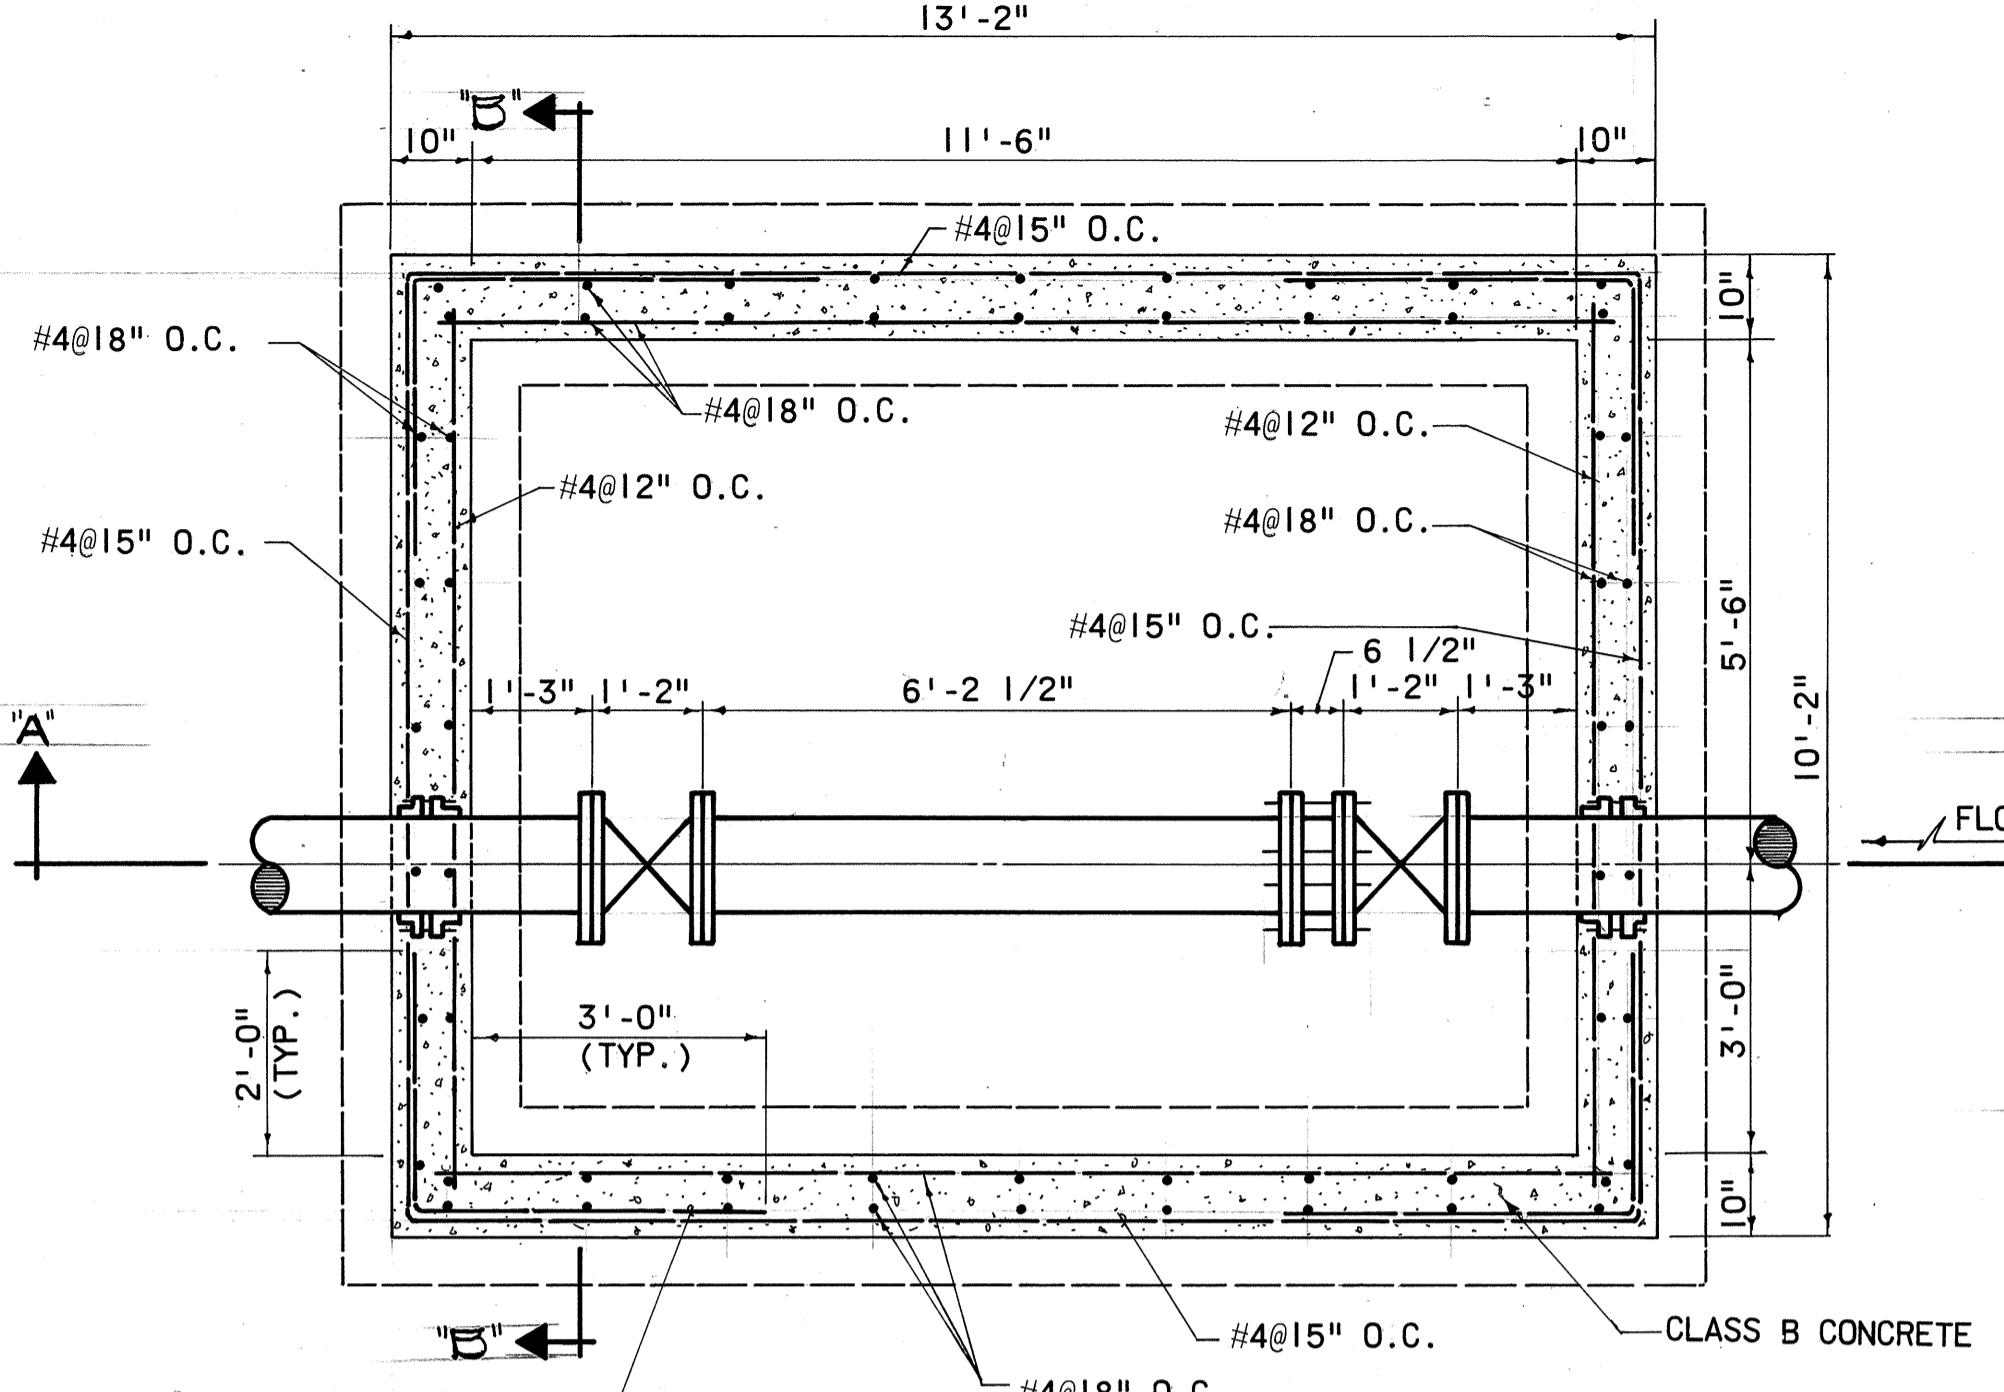


PLAN

ELEVATION


READING COVER DETAIL
SCALE: 1/2"=1'-0"

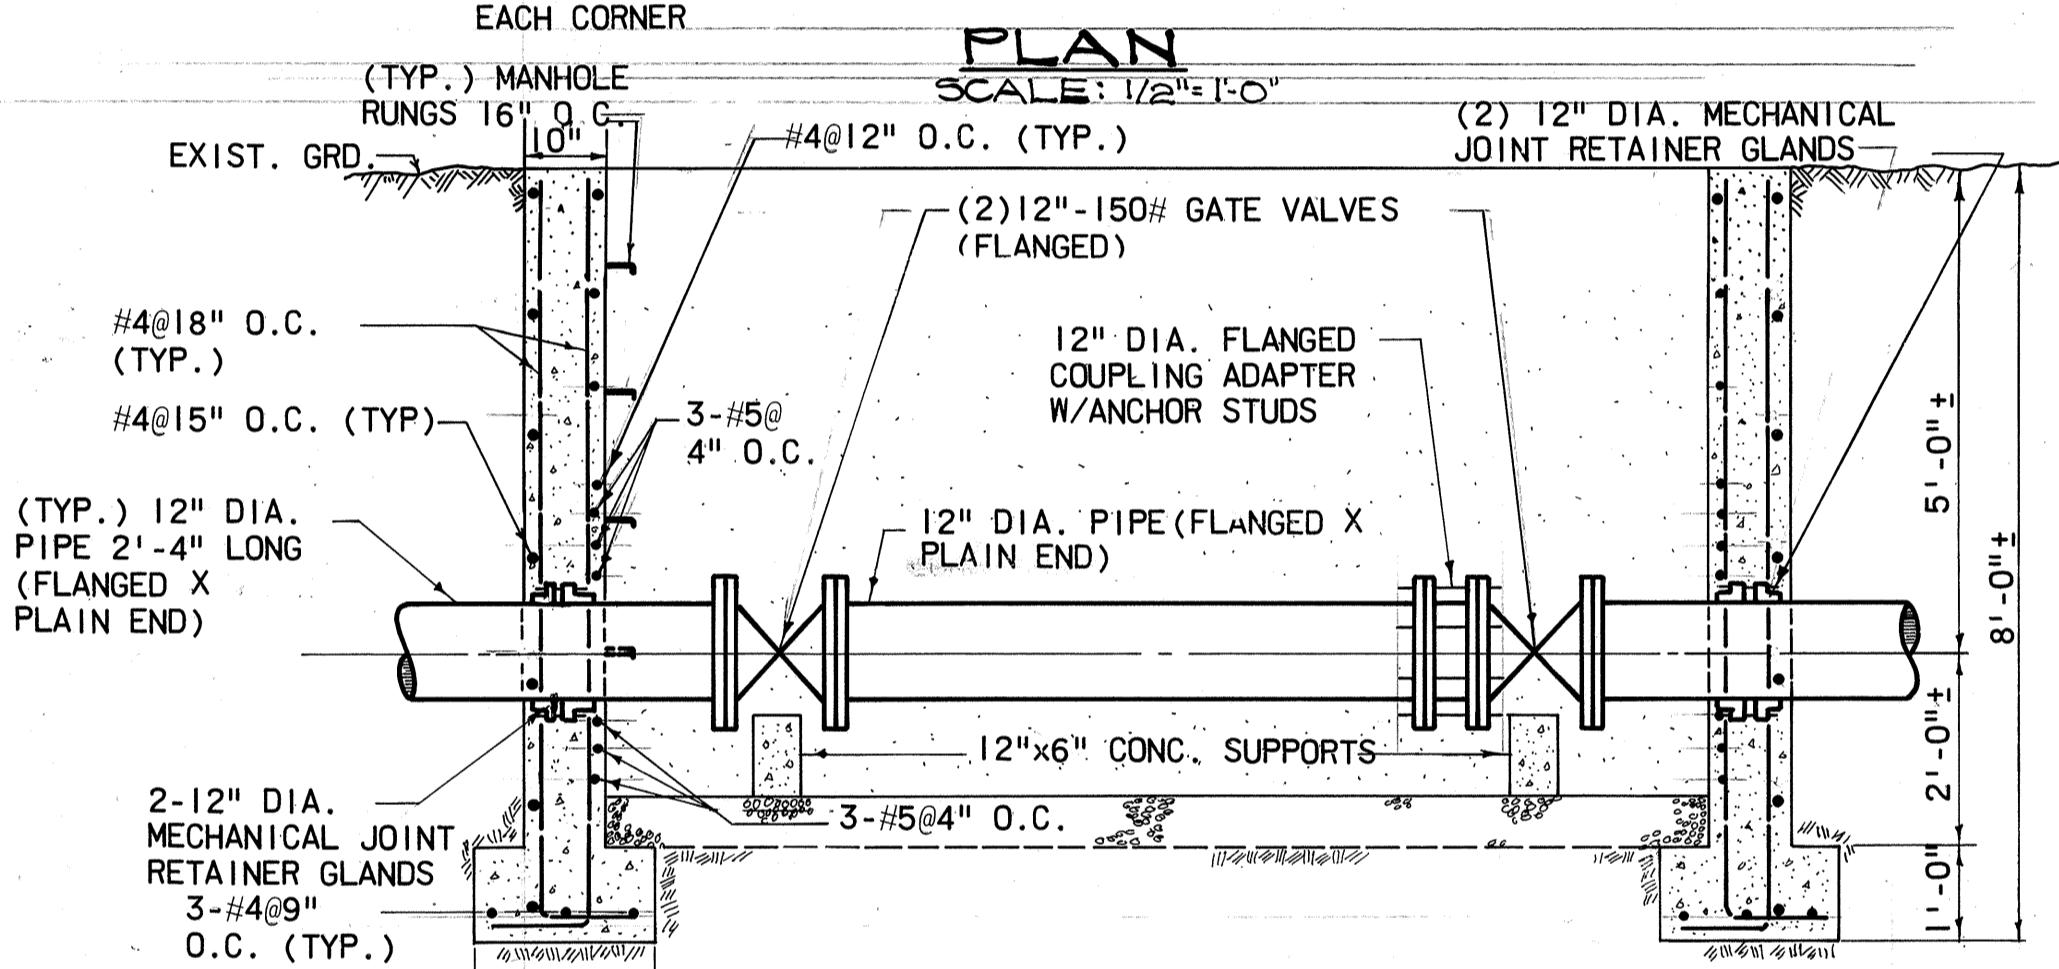


SECTION "A-A"
SCALE: 1/2"=1'-0"
13'-2"

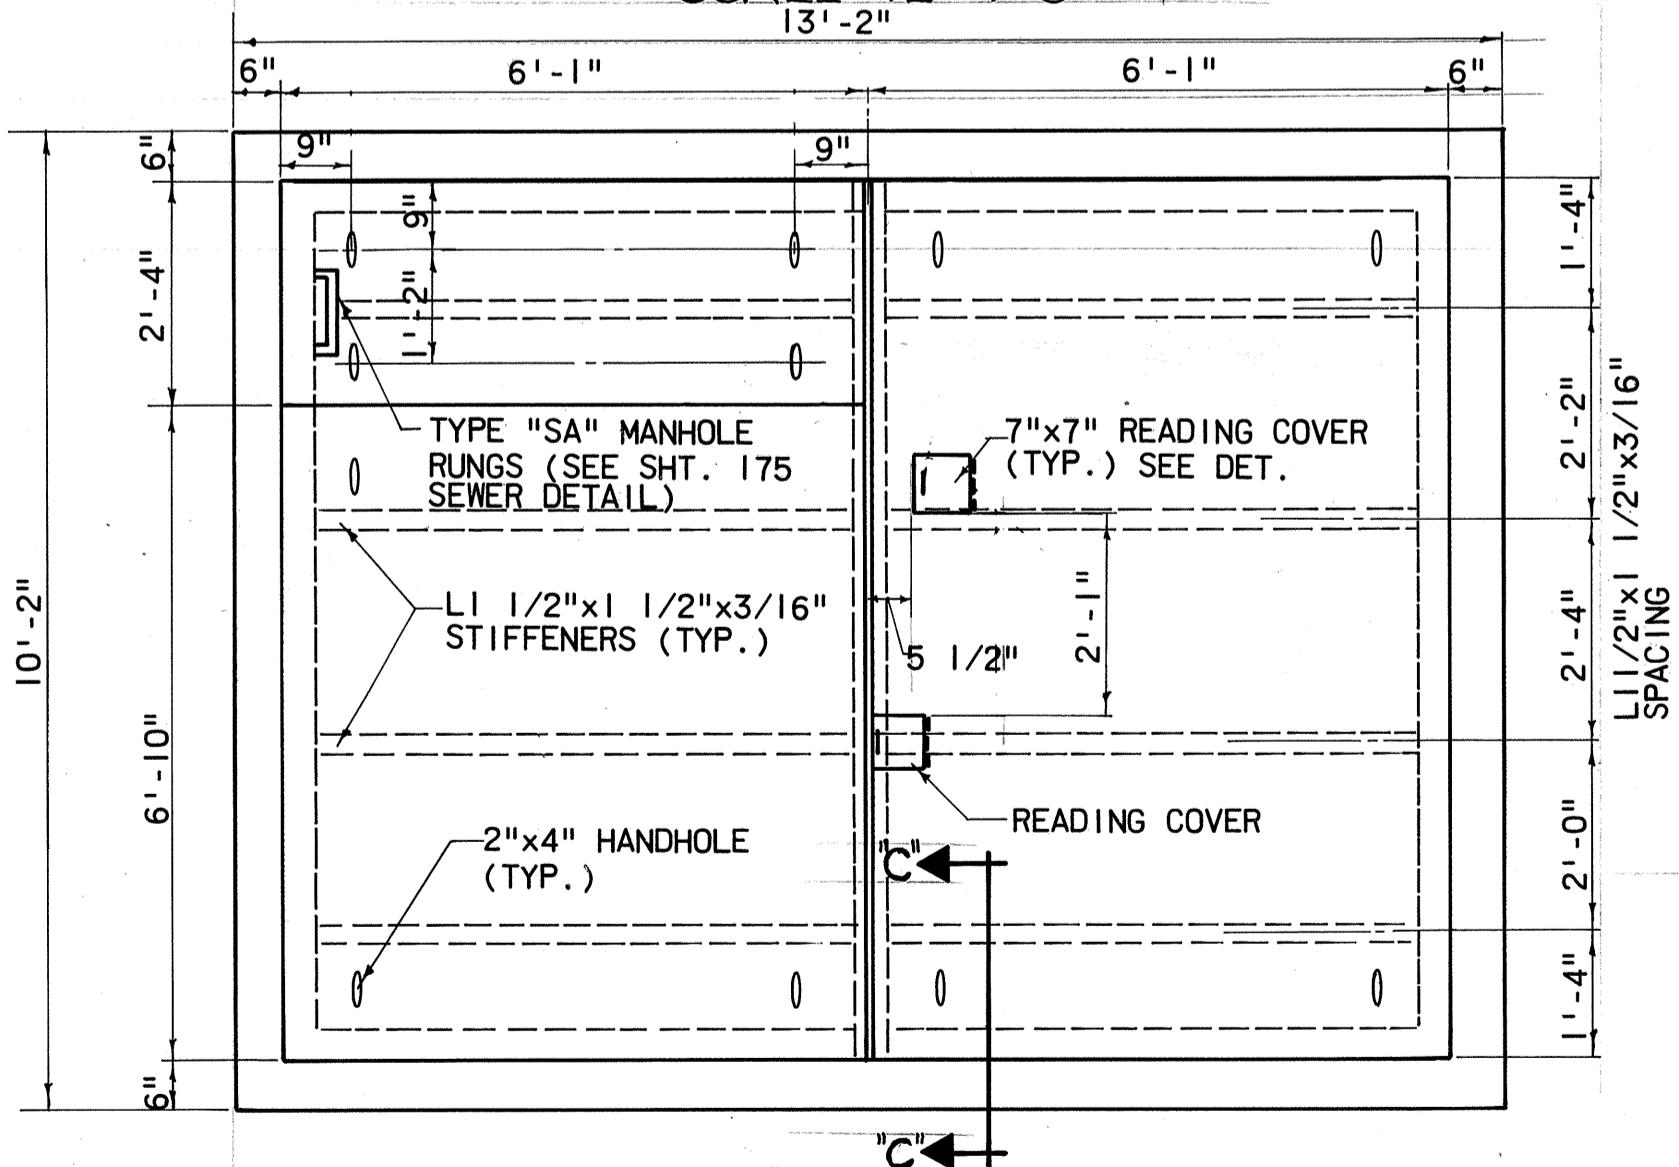

COVER PLATE DETAIL
SCALE: 1/2"=1'-0"

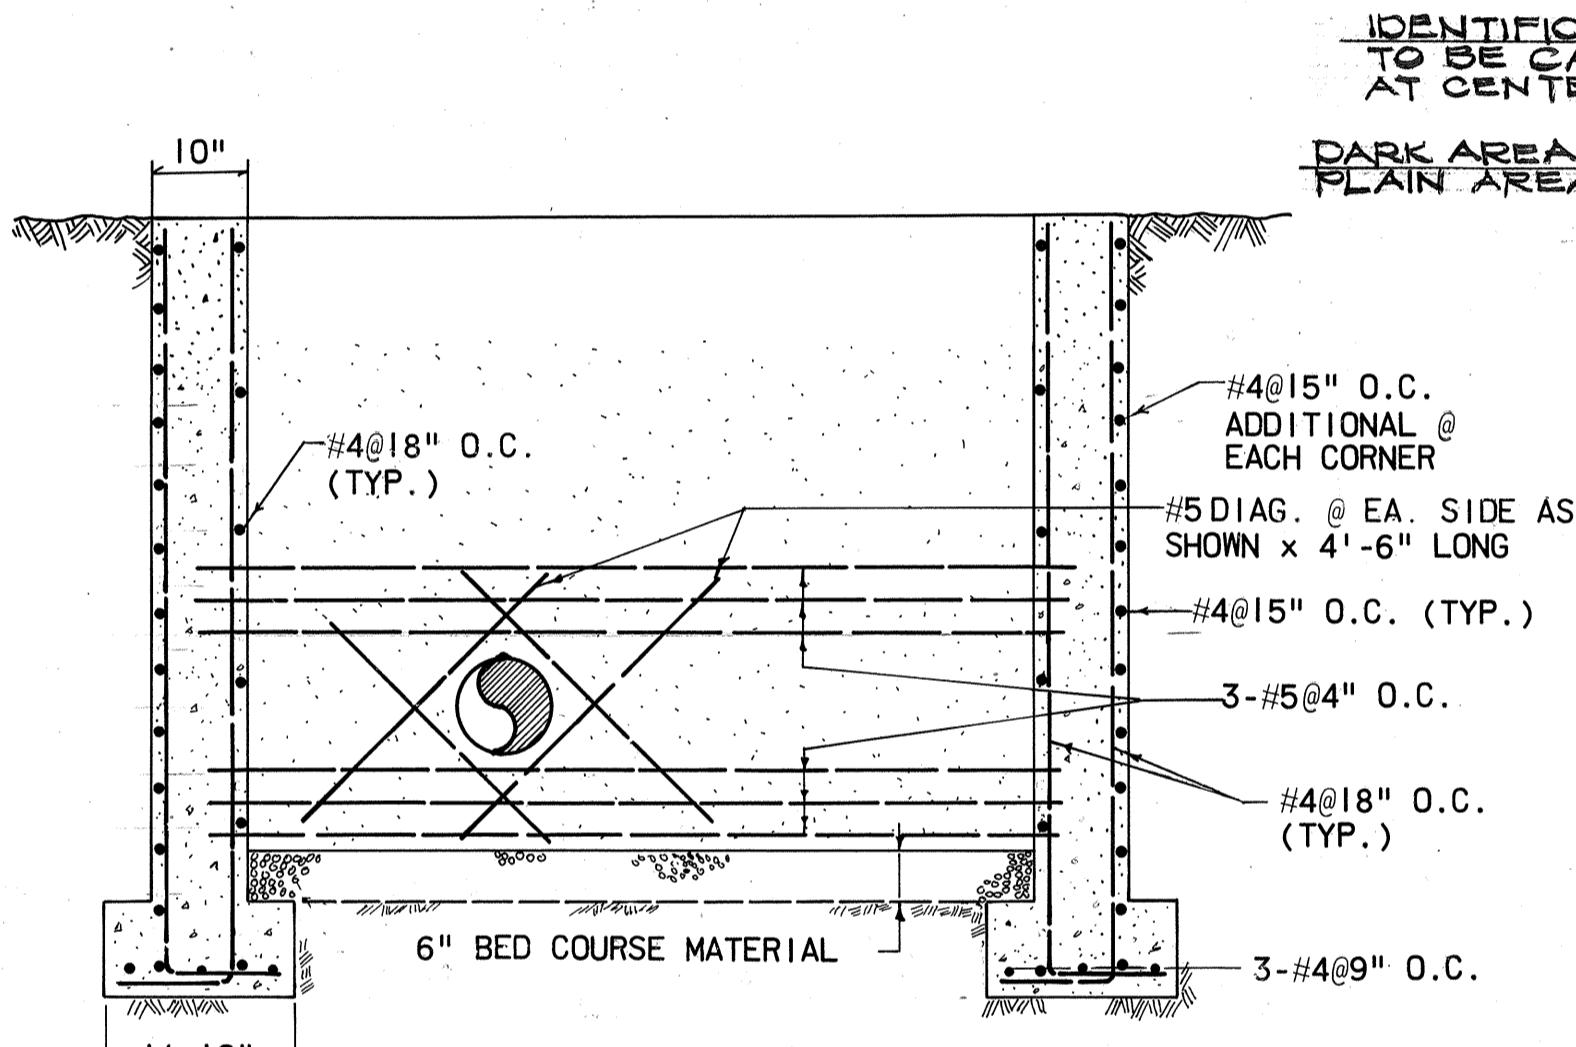

SECTION "B-B"
SCALE: 1/2"=1'-0"

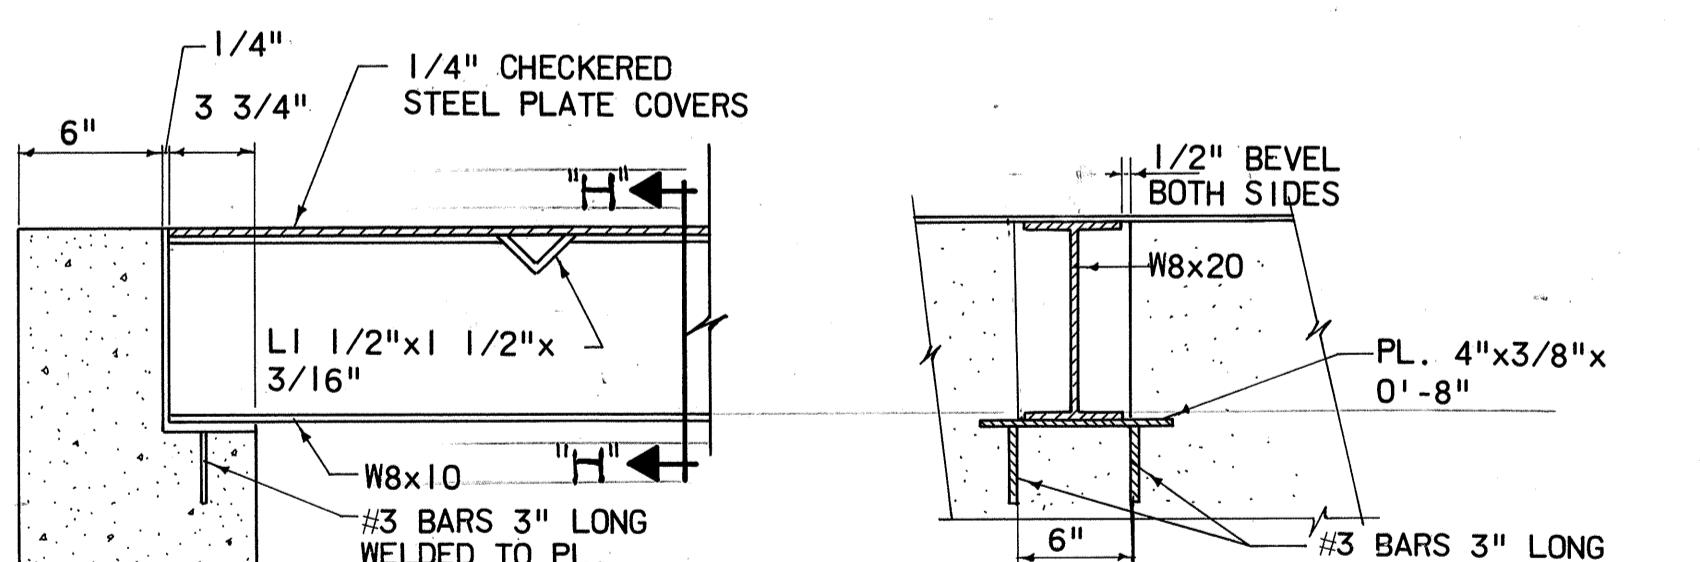

SECTION "C-C"
SCALE: 1/2"=1'-0"


SECTION "H-H"
SCALE: 1/2"=1'-0"

12/13/76

DELETED WATER METER BOX "F" DETAILS
ADDED: NAVY WATER METER BOX DETAILS
DELETED 30" SEWER MANHOLE DETAIL (TO
SEWER DETAIL SHEET 175)

DATE

REVISION

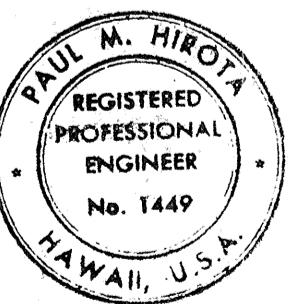


Paul M. Hirota
THIS WORK WAS PREPARED BY ME
OR UNDER MY SUPERVISION

STATE OF HAWAII
DEPARTMENT OF TRANSPORTATION
HIGHWAYS DIVISION
NIMITZ SPUR
MISC. DETAILS
(WATER & SEWER)


INTERSTATE ROUTE H-1
PROJECT NO. I-HI-1(99)-15

SCALE: AS NOTED DATE: AUG 4 1976
SHEET NO. 16 OF 10 SHEETS

ADD. 173

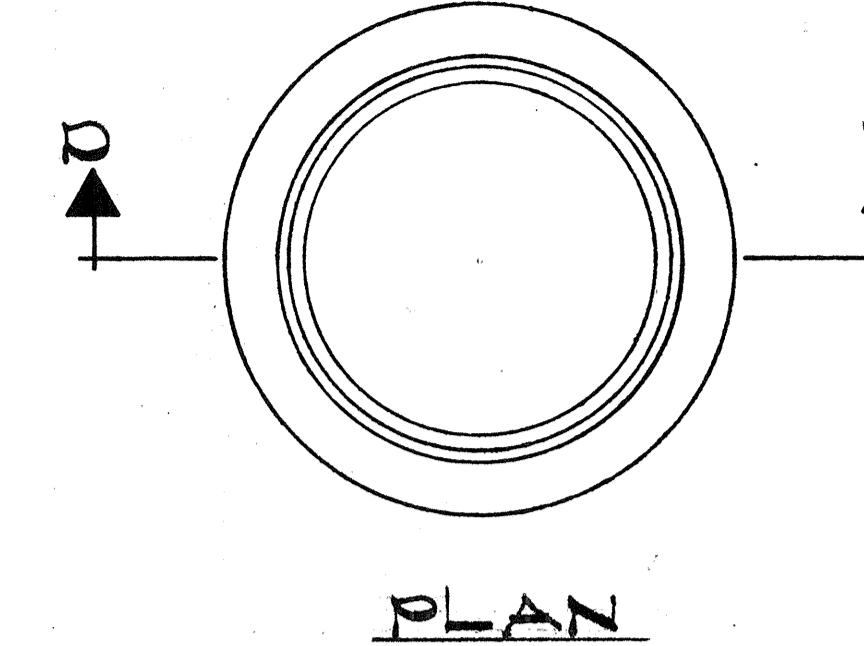


PLAN

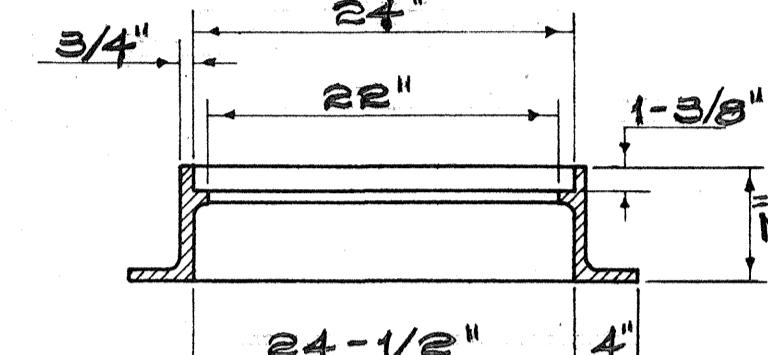


SECTION D-D

FRAME (SMH#345,6,7,8&9)
FOR TRAFFIC AREA

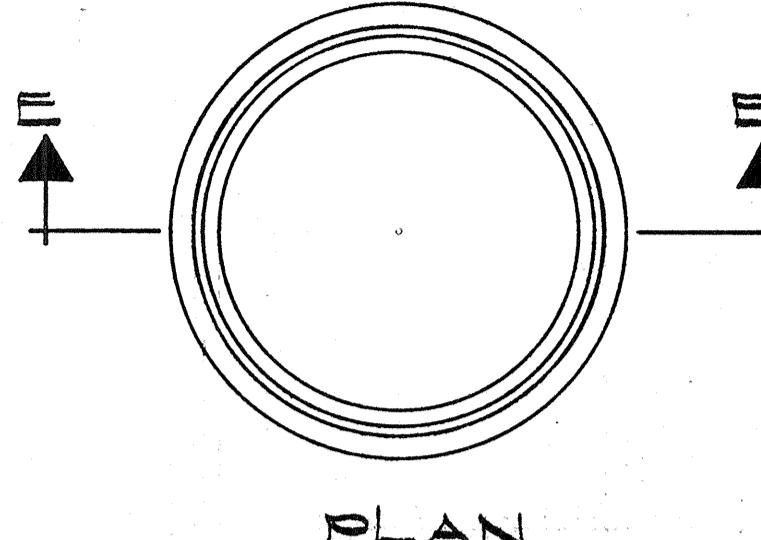


PLAN

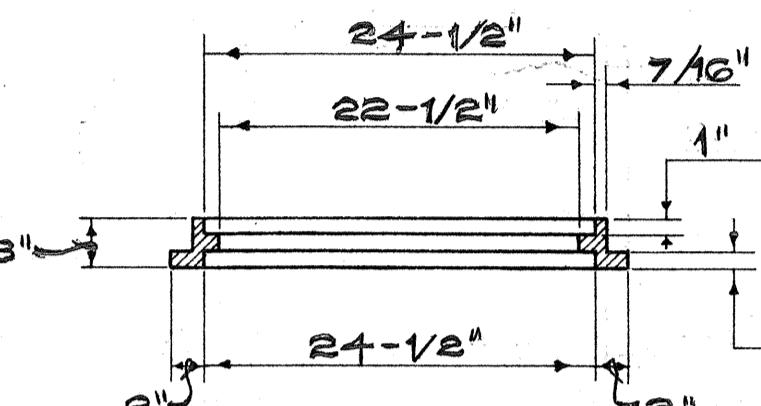


SECTION E-E


FRAME (SMH#1,2,10&11)
FOR NON-TRAFFIC AREA

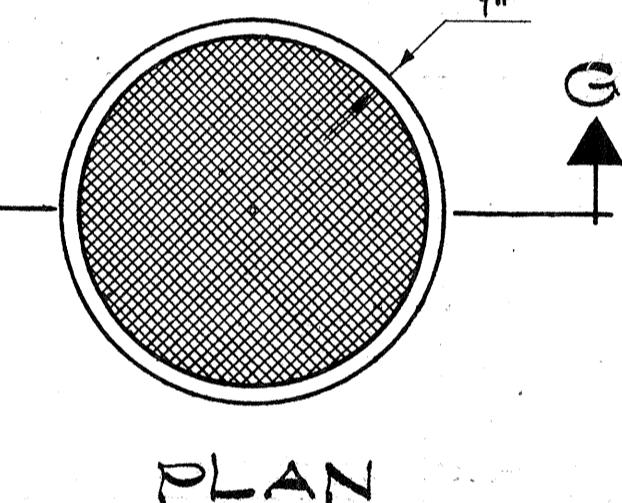

PLAN

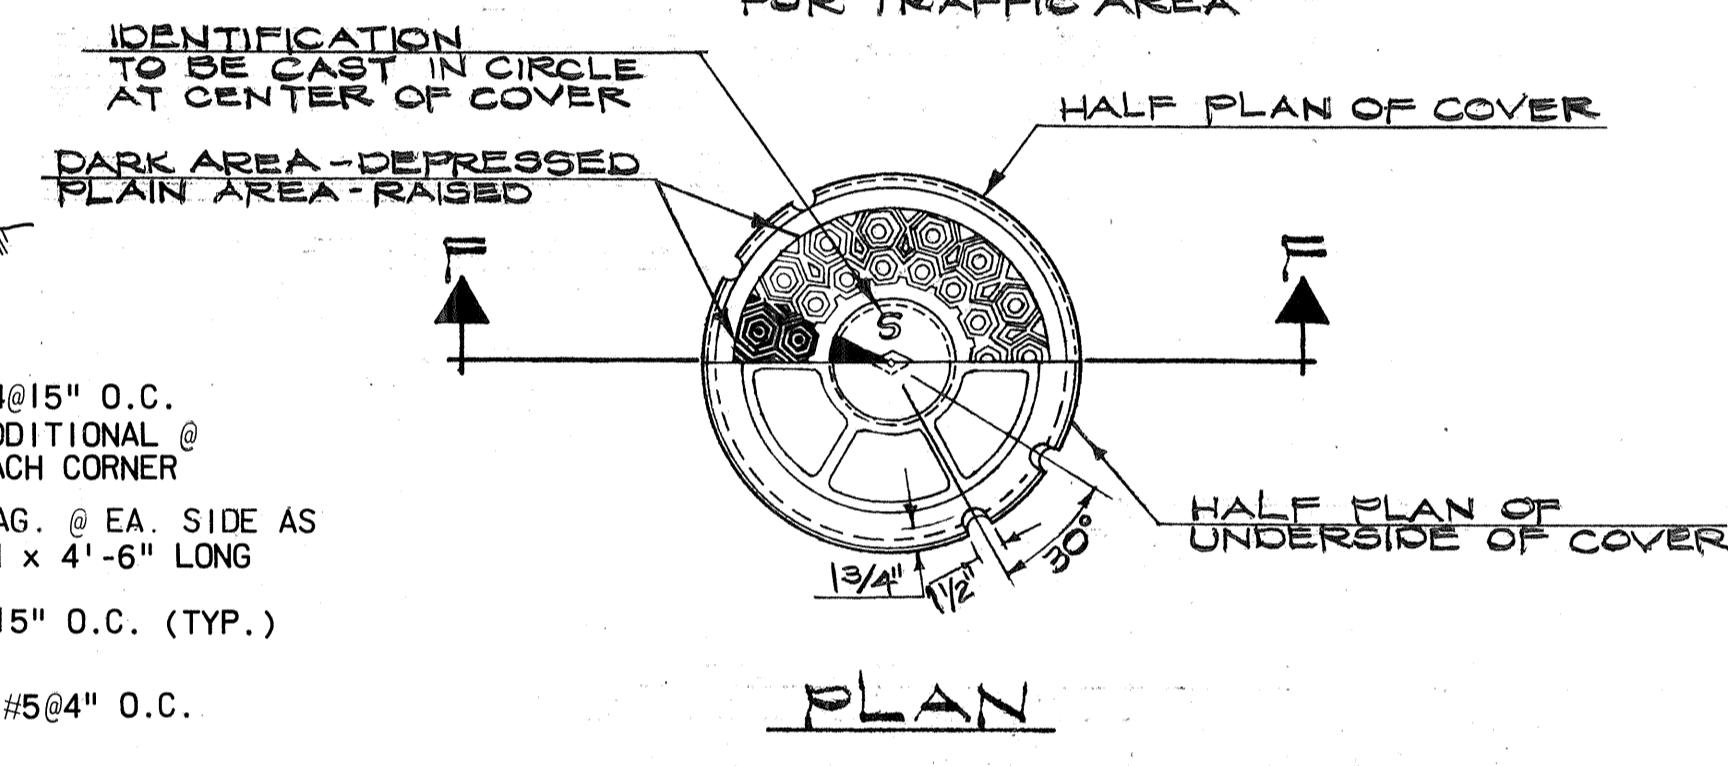


PLAN

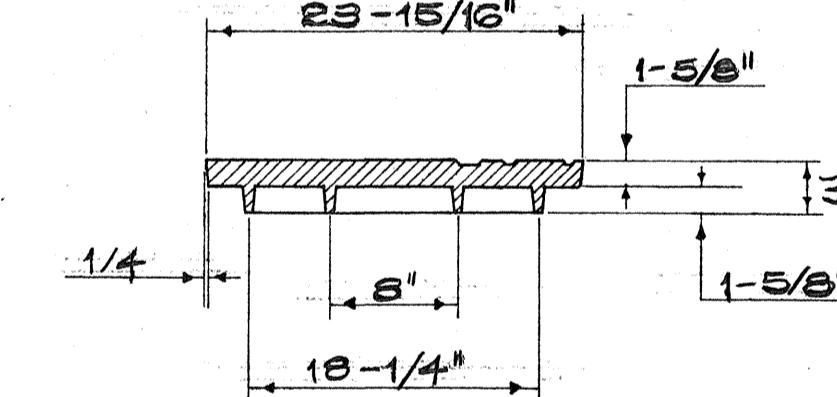

SECTION F-F

COVER (SMH#3,4,5,6,7,8&9)
FOR TRAFFIC AREA

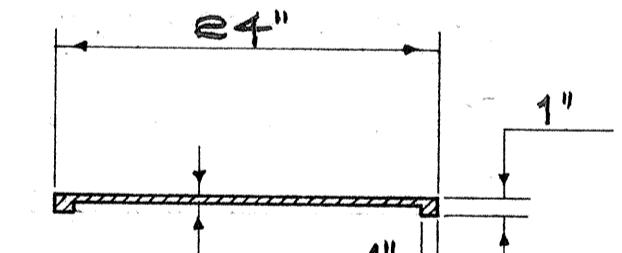

SECTION G-G


COVER (SMH#1,2,10&11)
FOR NON-TRAFFIC AREA

NAVY SEWER MANHOLE FRAMES & COVERS (OPTIONAL)

SCALE: 1"=1'-0"

REINFORCED CONCRETE WATER METER BOX

FED. ROAD DIST. NO.	STATE	FED. AID PROJ. NO.	FISCAL YEAR	SHEET NO.	TOTAL SHEETS
HAWAII	HAW.	I-HI-10915	1971	174	350

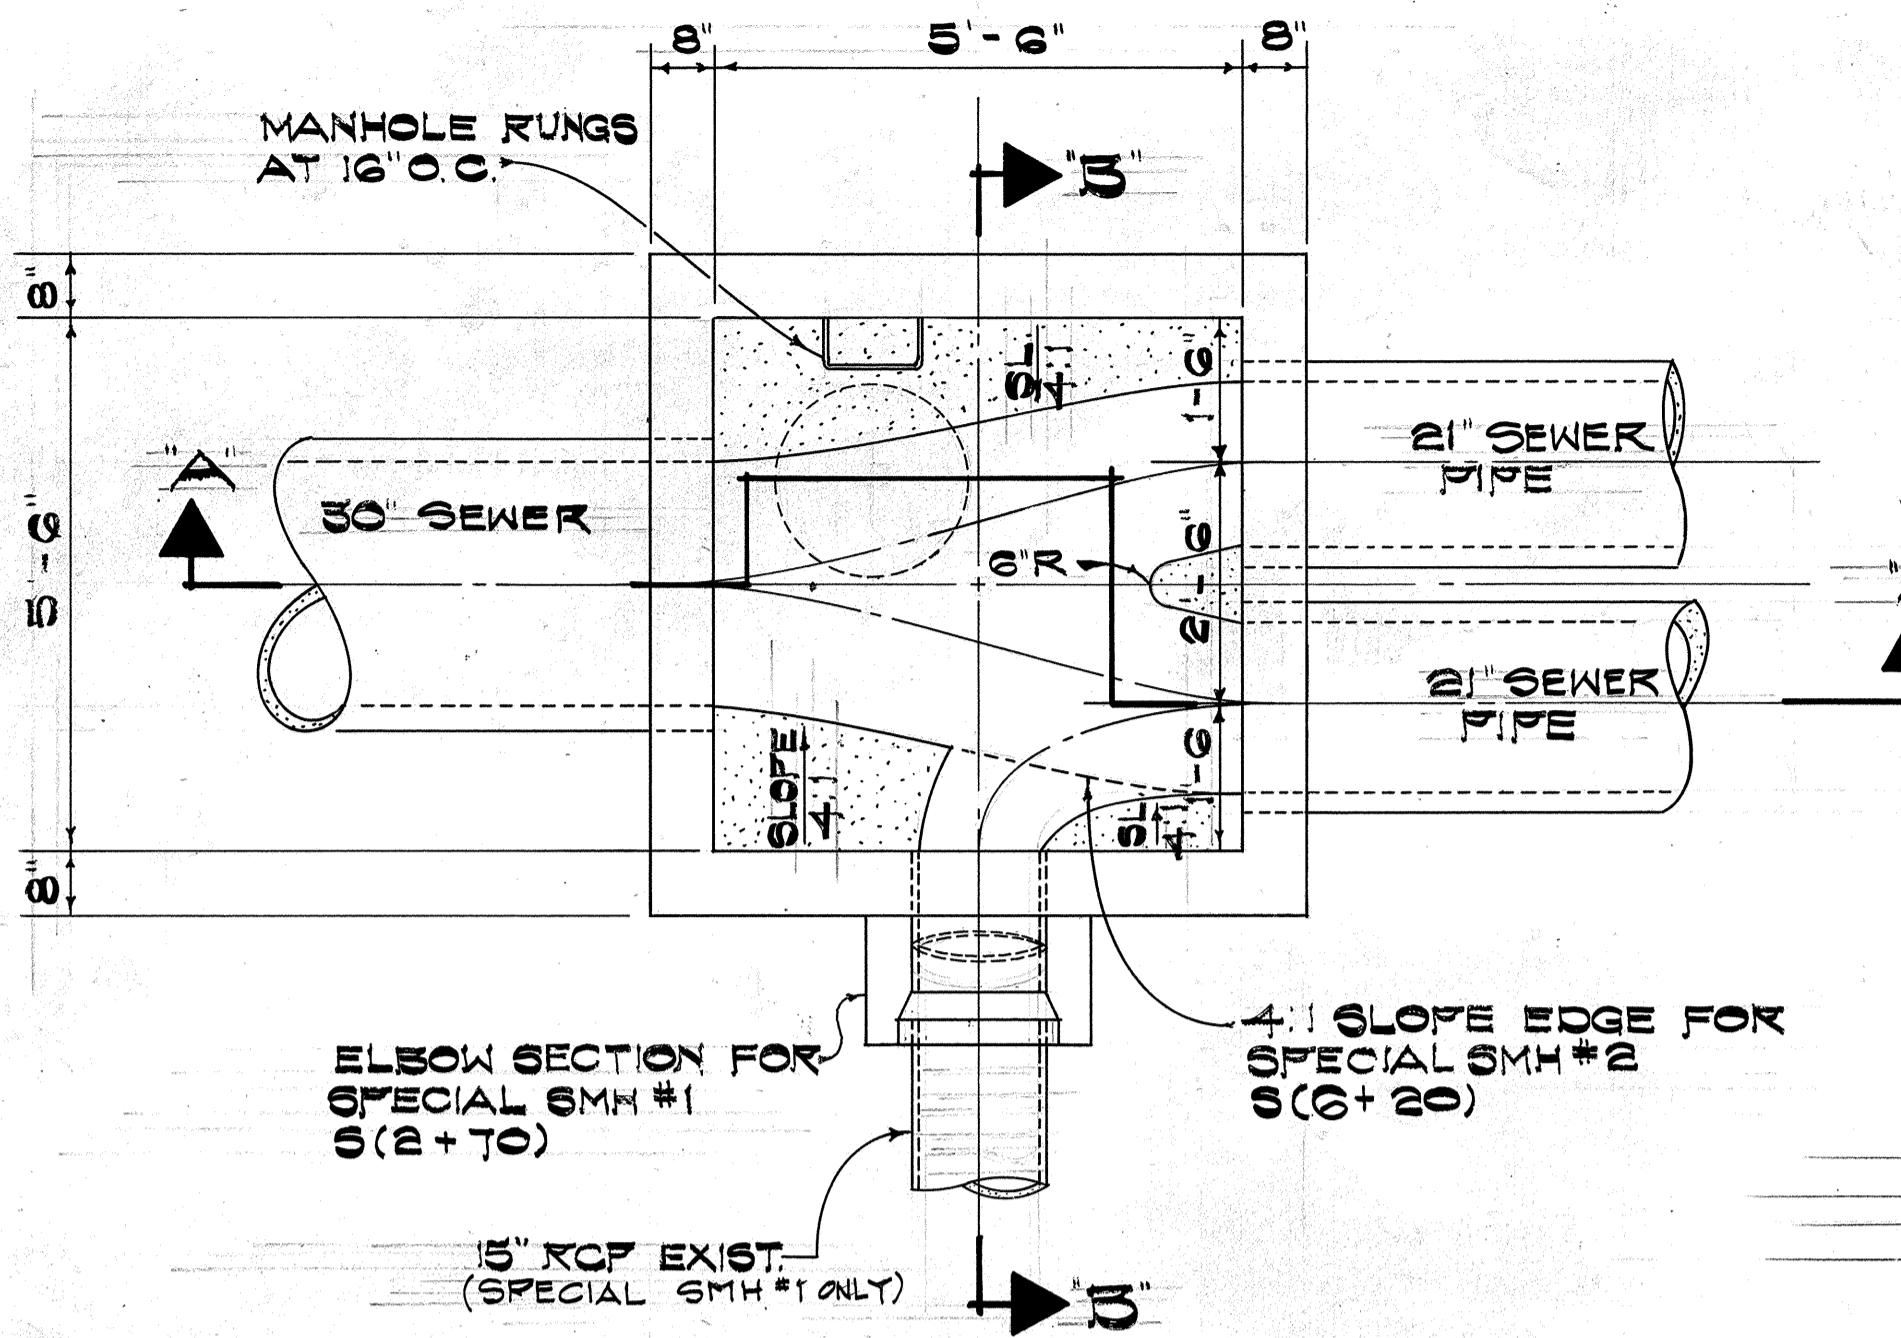

SPECIAL SMH #1 AND SMH #2 PLAN


SCALE: $\frac{1}{2}'' = 1'-0''$

SPECIAL SMH #1 & SMH #2
TOP SLAB REINFORCING

SCALE: $\frac{1}{2}'' = 1'-0''$


NOTE:

1. PAYMENT FOR SPECIAL M.H. WALLS AND TOP & BOTTOM SLABS SHALL BE MADE UNDER CONCRETE & STEEL FOR SEWER SYSTEM.
2. PAYMENT FOR MANHOLE FRAME & COVER SHALL BE PER EACH.

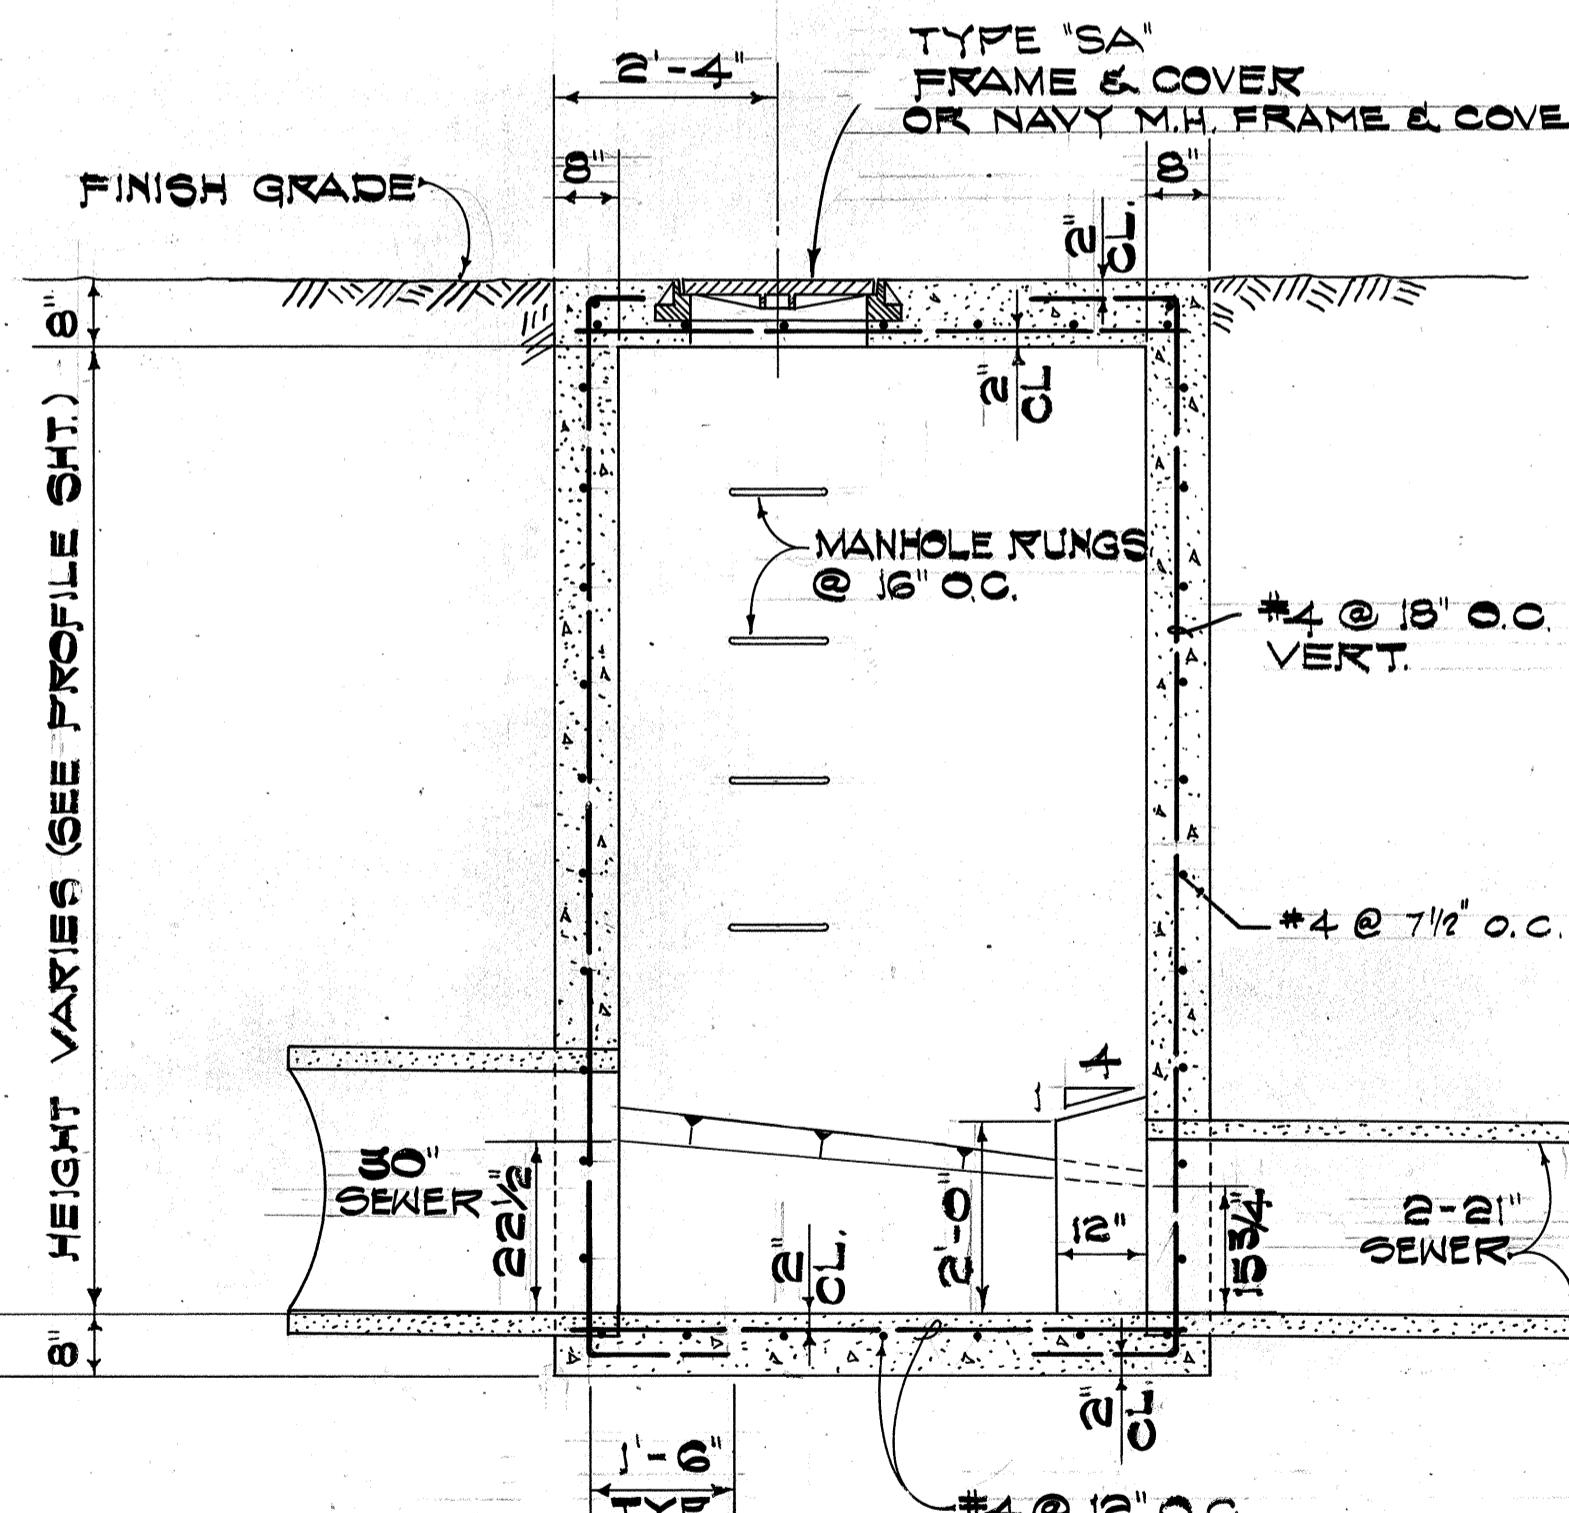



SECTION "A-A"

SCALE: $\frac{1}{2}'' = 1'-0''$

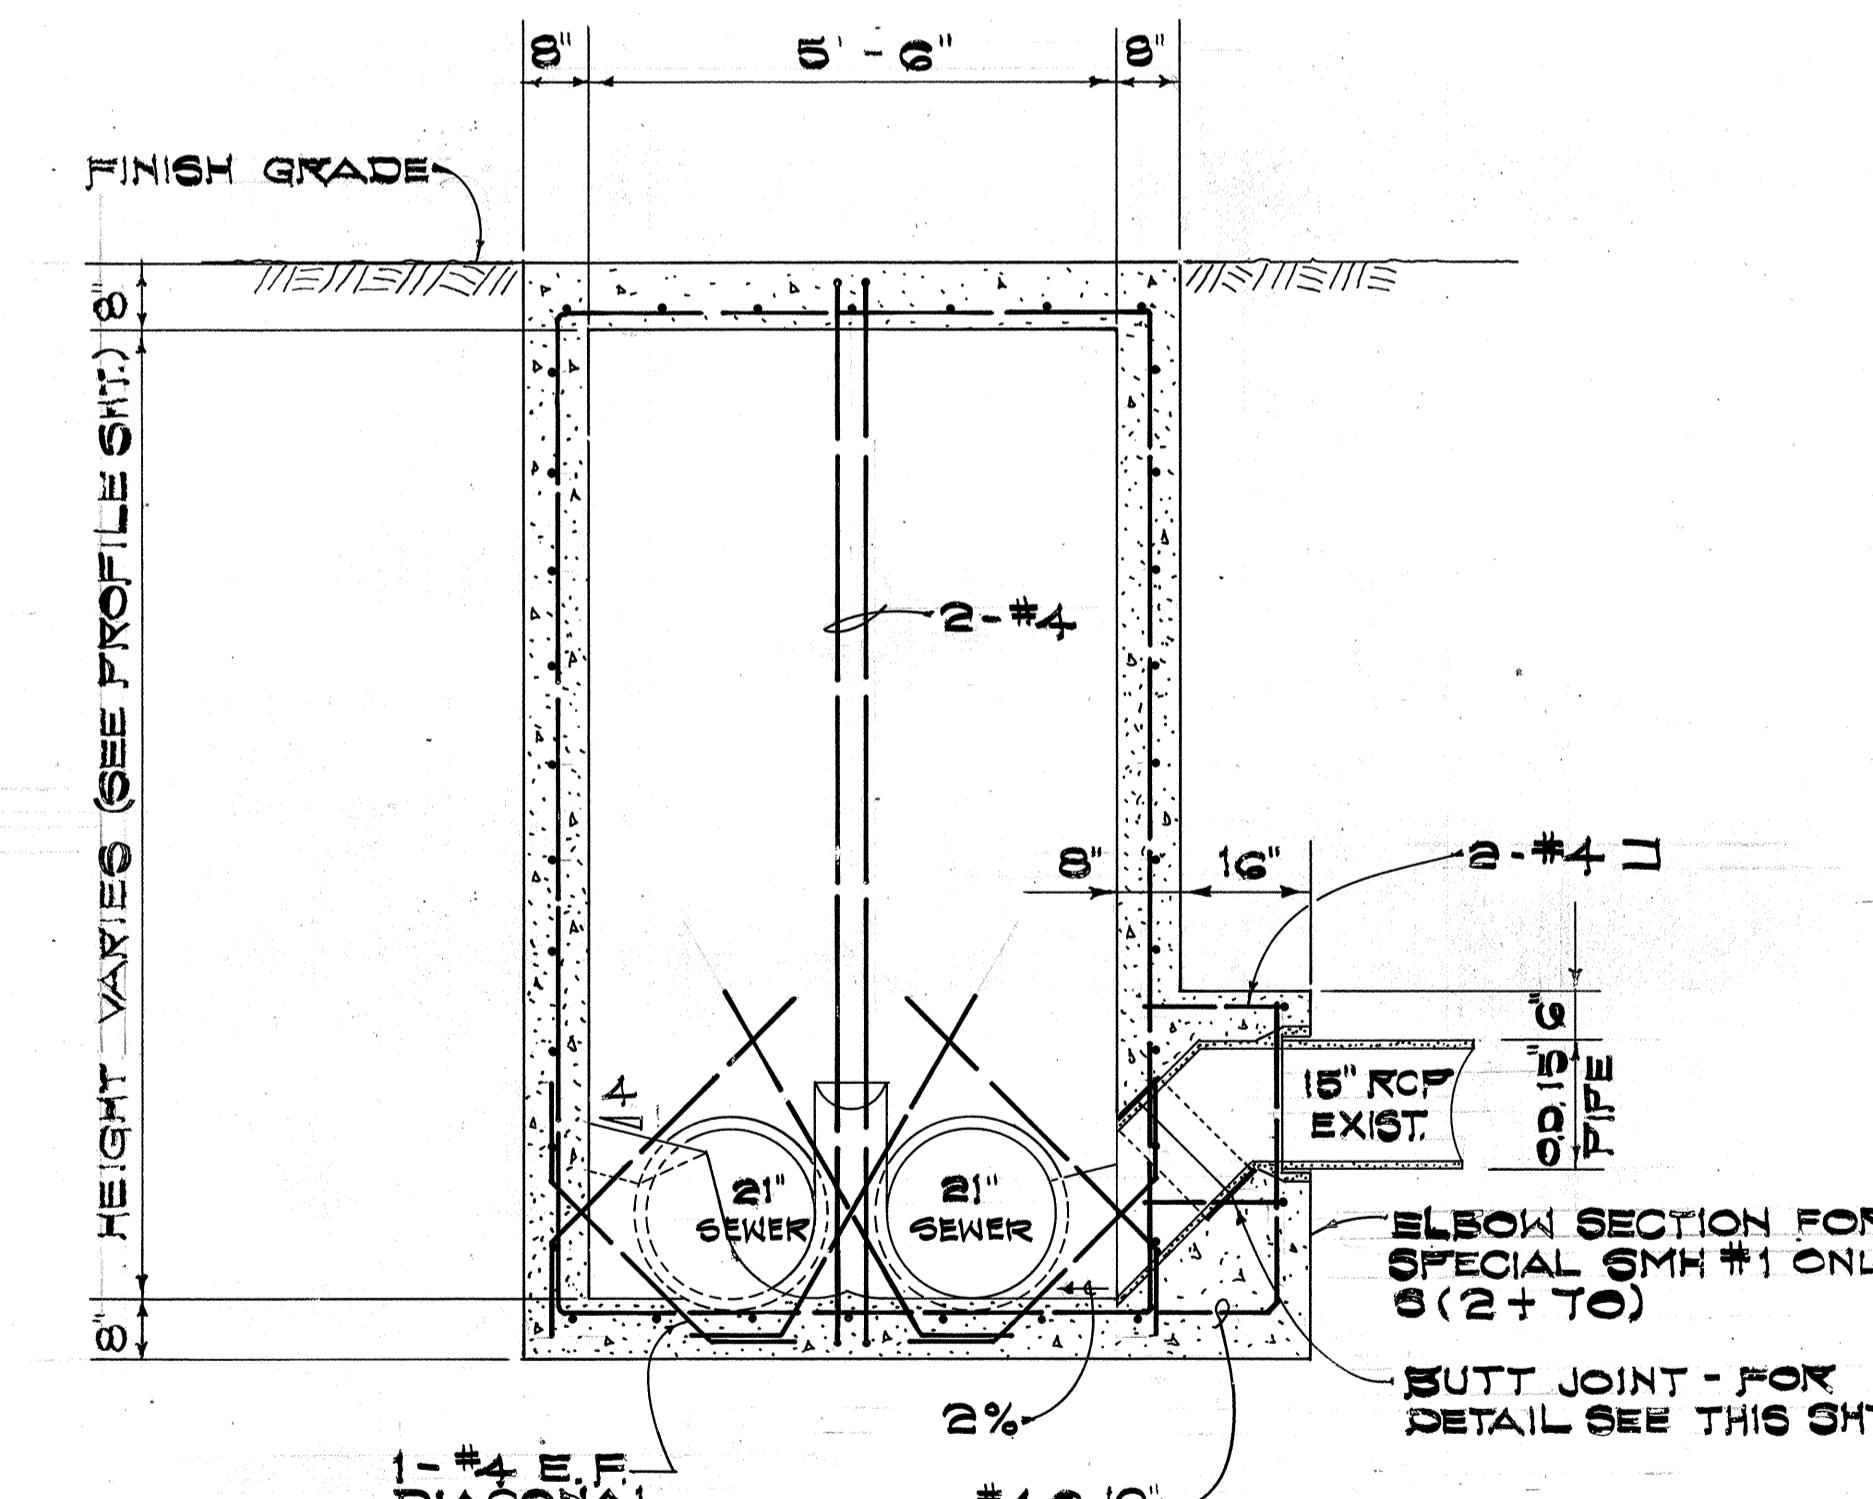


SECTION "B-B"

SCALE: $\frac{1}{2}'' = 1'-0''$

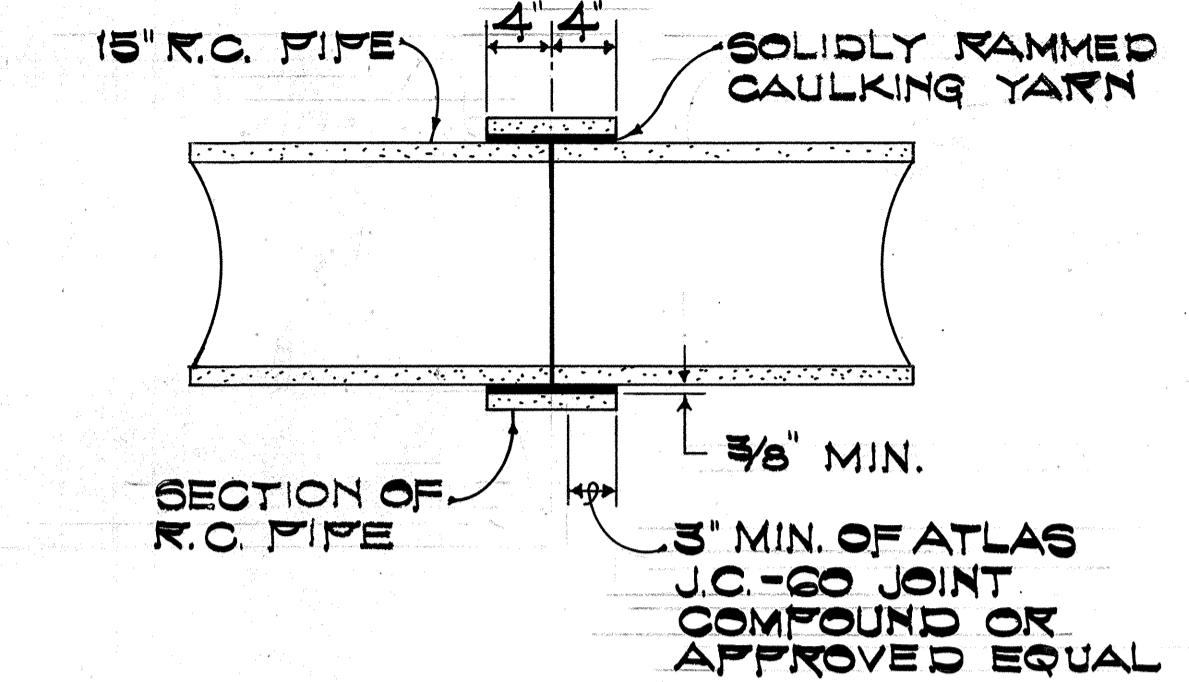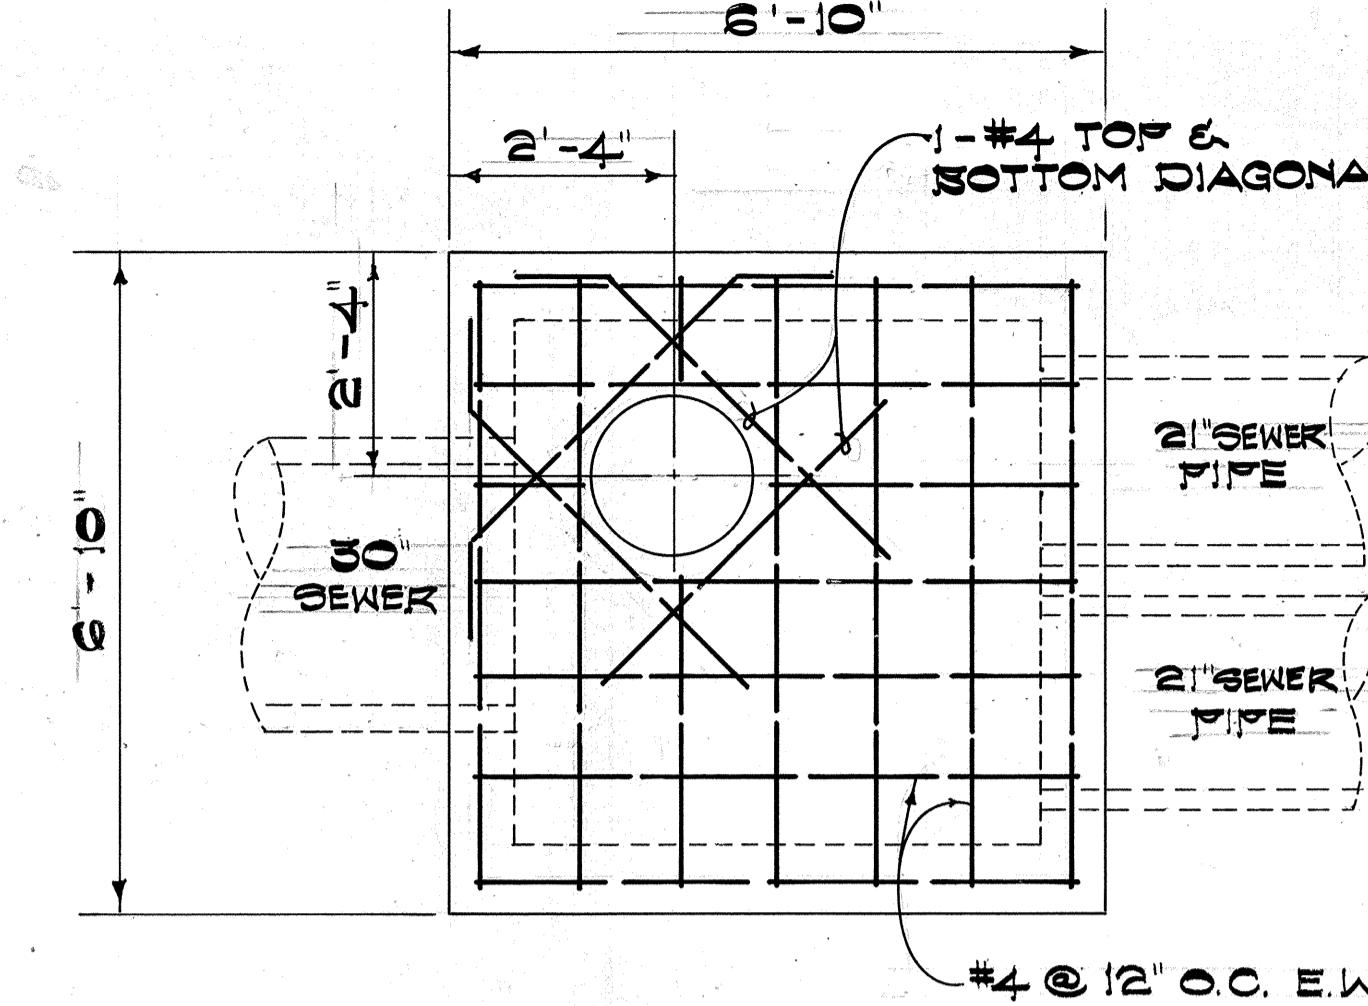

BUTT JOINT DETAIL

SCALE: $1'' = 1'-0''$

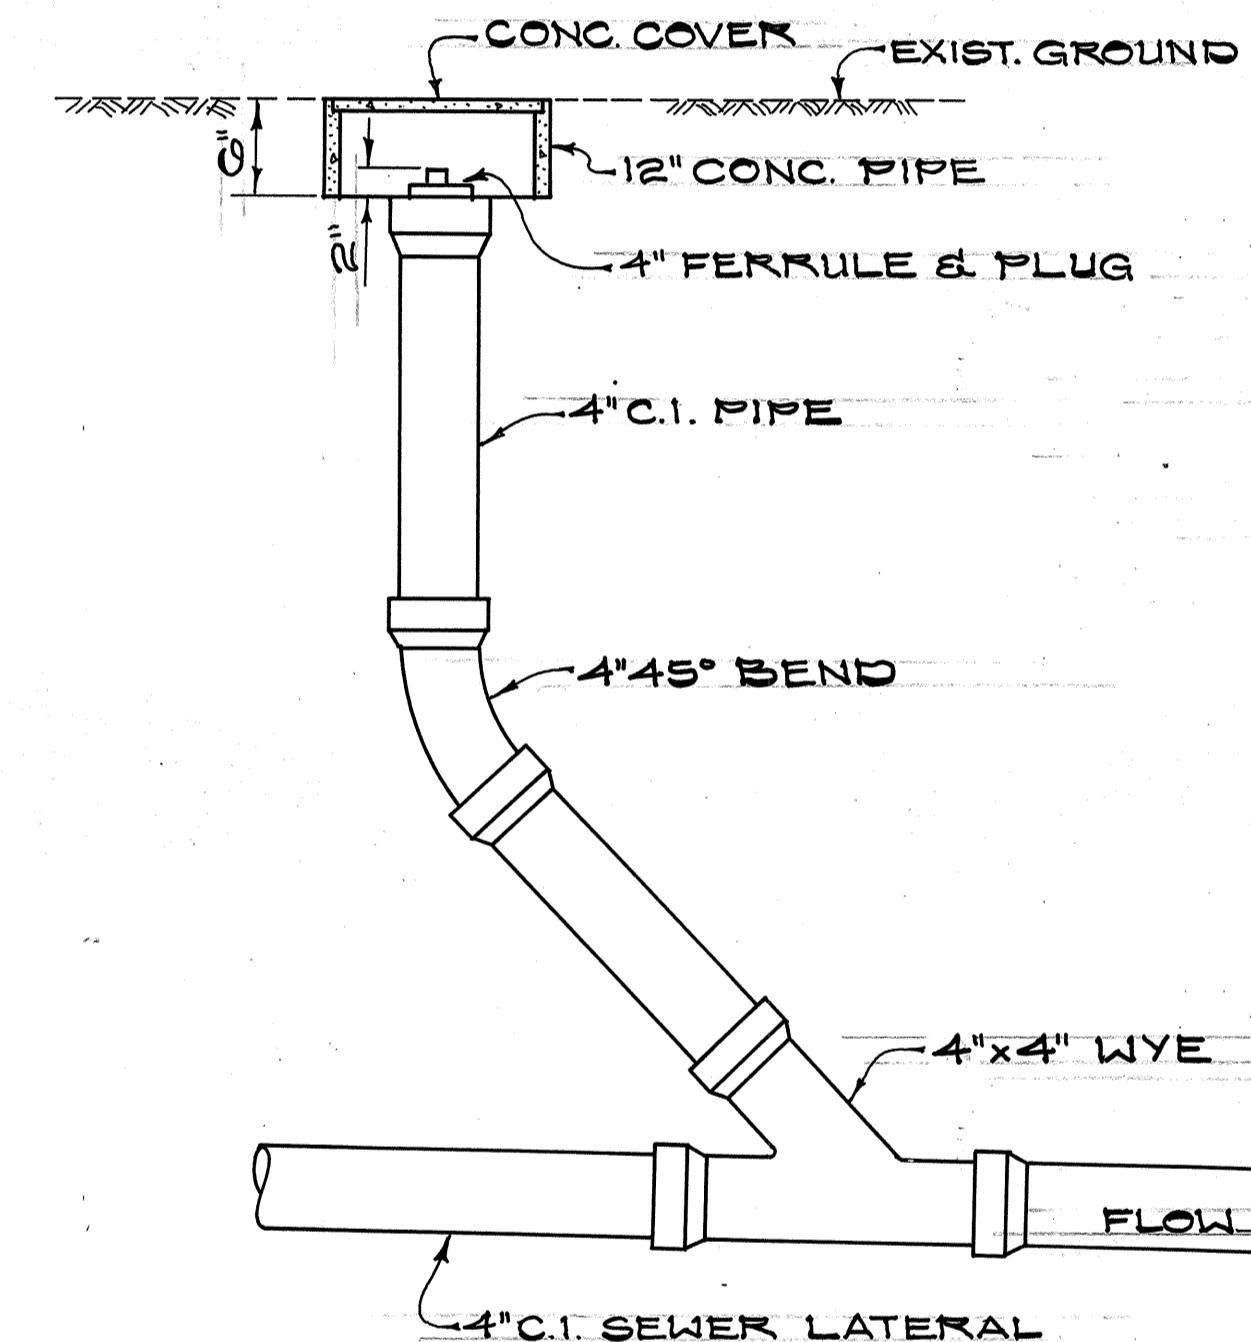

CLEANOUT TO GRADE

SCALE: $1\frac{1}{2}'' = 1'-0''$

STATE OF HAWAII
DEPARTMENT OF TRANSPORTATION
HIGHWAYS DIVISION

NIMITZ SPUR

SEWER DETAILS


INTERSTATE ROUTE H-1
PROJECT NO I-HI-10915



This work was prepared by me
or under my supervision

SCALE: AS NOTED DATE: AUG 4 1976
SHEET NO. 17 OF 19 SHEETS

FED. ROAD DIST. NO.	STATE	FED. AID PROJ. NO.	FISCAL YEAR	SHEET NO.	TOTAL SHEETS
HAWAII	HAW.	I-HI-1(99).15	1976	175	350

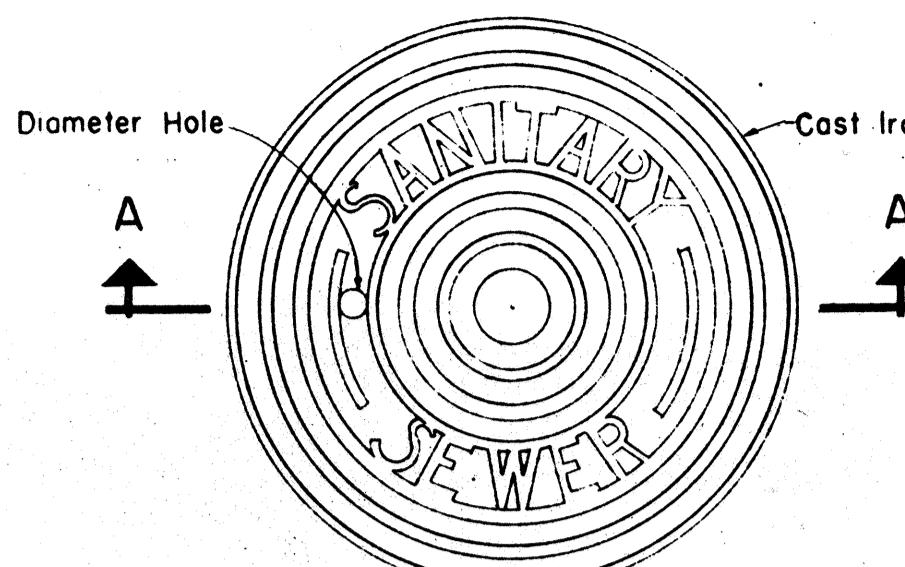

PLAN OF MANHOLE COVER

Scale: $1\frac{1}{2}'' = 1'-0''$

24" Diameter

$3'' + 7 \text{ at } 1\frac{1}{2}'' = 10\frac{1}{2}''$

$\frac{1}{4}'' + \frac{3}{4}'' + \frac{3}{4}'' = 2\frac{1}{2}''$

$1\frac{1}{2}'' + 1\frac{1}{2}'' = 3''$

SECTION A-A

Scale: $1\frac{1}{2}'' = 1'-0''$

NOTE: This cover is used with the "SA" frame

SECTION B-B

Scale: $1\frac{1}{2}'' = 1'-0''$

BOTTOM VIEW OF COVER

Scale: $1\frac{1}{2}'' = 1'-0''$

Cast Iron

8-Ribs Spaced Equally

C C

PLAN OF MANHOLE FRAME

Scale: $1\frac{1}{2}'' = 1'-0''$

24"

$\frac{1}{4}''$

22"

$30\frac{3}{4}''$


SECTION C-C

Scale: $1\frac{1}{2}'' = 1'-0''$

TYPE "SA" SEWER MANHOLE

FRAME AND COVER

Scale: $1\frac{1}{2}'' = 1'-0''$

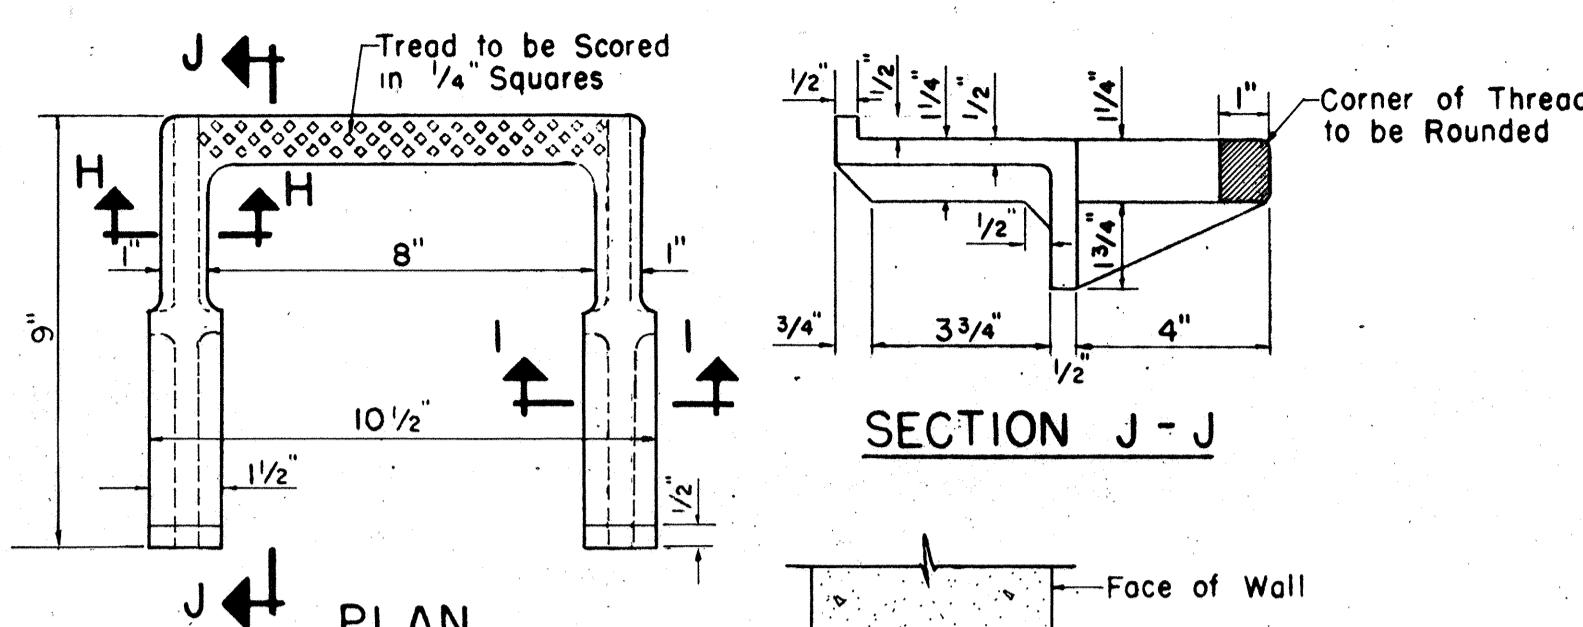

SECTION J-J

PLAN

SECTION H-H

SECTION I-I

METHOD OF INSTALLATION

TYPE "SB" MANHOLE RUNGS (CAST IRON)

Scale: $3'' = 1'-0''$

G G

PLAN

SECTION G-G

TYPE "SA" MANHOLE RUNGS (WROUGHT IRON)

Scale: $1\frac{1}{2}'' = 1'-0''$

NOTE:

Reinforced concrete manhole walls (See detail of plain manhole) shall be used for portions below the water table.

Type "SA" Manhole Frame and Cover

Type "SA" Rung

Type "SB" Rungs 16" o.c.

"Cement Plaster

Interior to be bagged or plastered smooth

8"

4'-0"

8"

2'-0" Max.

#4 Bars

12" o.c. bothways

(MAXIMUM HEIGHT - 10.0 FEET)

BRICK MANHOLE

Scale: $1\frac{1}{2}'' = 1'-0''$

A A

3-#4 @ EACH CORNER

3-#4 @ EACH SIDE

30" SEWER

Payment for excavation for manholes shall be made under unit price for trench excavation and shall be measured to one foot outside of walls from original ground elevation to authorized bottom elevation.

Payment for manhole walls (brick, or cast-in-place concrete) shall include brick, mortar, concrete, reinforcing steel, cast-iron steps, galvanized wrought iron rungs, and plastering.

12/13/76 ADDED 30" PRECAST CONC. SEWER MH DETAILS
DATE REVISION

STATE OF HAWAII
DEPARTMENT OF TRANSPORTATION
HIGHWAYS DIVISION
NIMITZ SPUR

SEWER DETAILS

INTERSTATE ROUTE H-1
PROJ. NO I-HI-1(99) 15

SCALE AS NOTED

DATE AUG 4 1976


SHEET NO. 18 OF 19 SHEETS



Paul M. Hirota
THIS WORK WAS PREPARED BY ME
OR UNDER MY SUPERVISION


ADD. 175

FED. ROAD DIST. NO.	STATE	FED. AID PROJ. NO.	FISCAL YEAR	SHEET NO.	TOTAL SHEETS
HAWAII	HAW	I-HI-1(99).15	1077	ITG	350

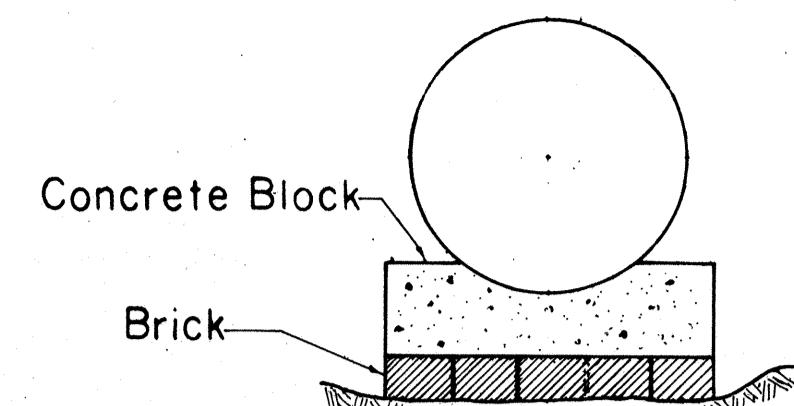

METHOD OF USING BRICKS UNDER CONCRETE BLOCKS


Not To Scale

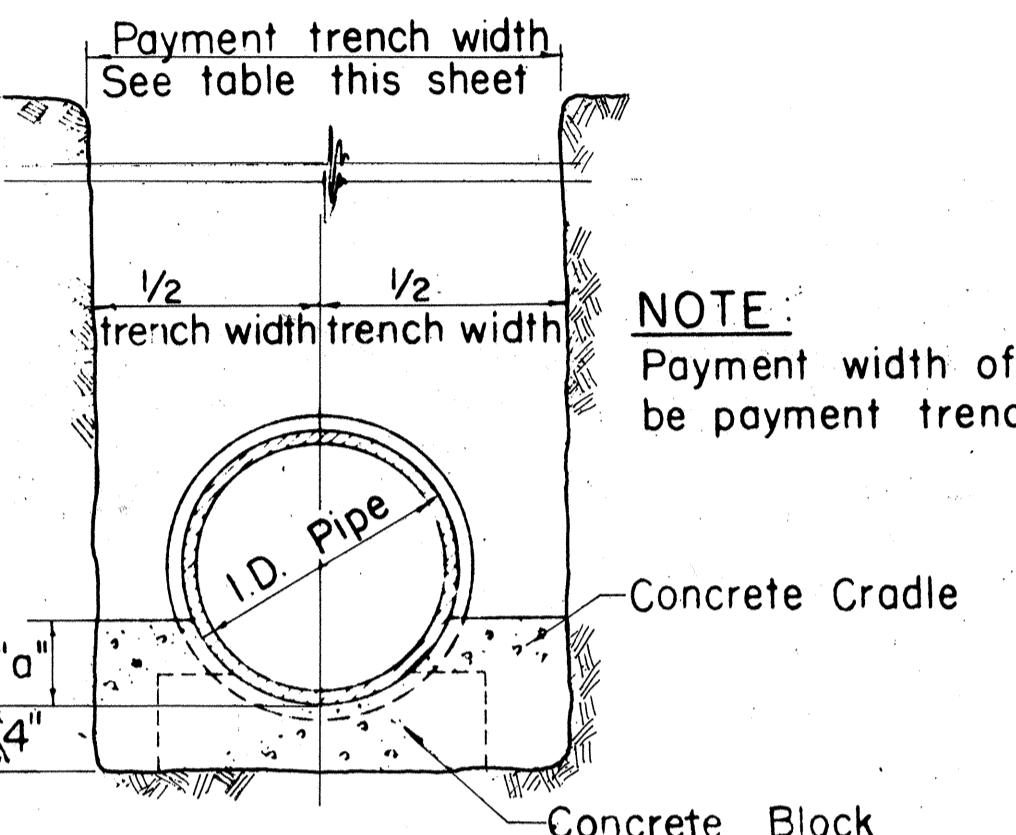

CONCRETE CRADLE FOR CONCRETE PIPE

Not To Scale


Contractor shall see Concrete Blocks on undisturbed ground. Where ground is too low, the contractor shall not heap up dirt under the Concrete Block but use Concrete Bricks to take up the deficiency, scraping away beneath Concrete Block to give sufficient room for Brick

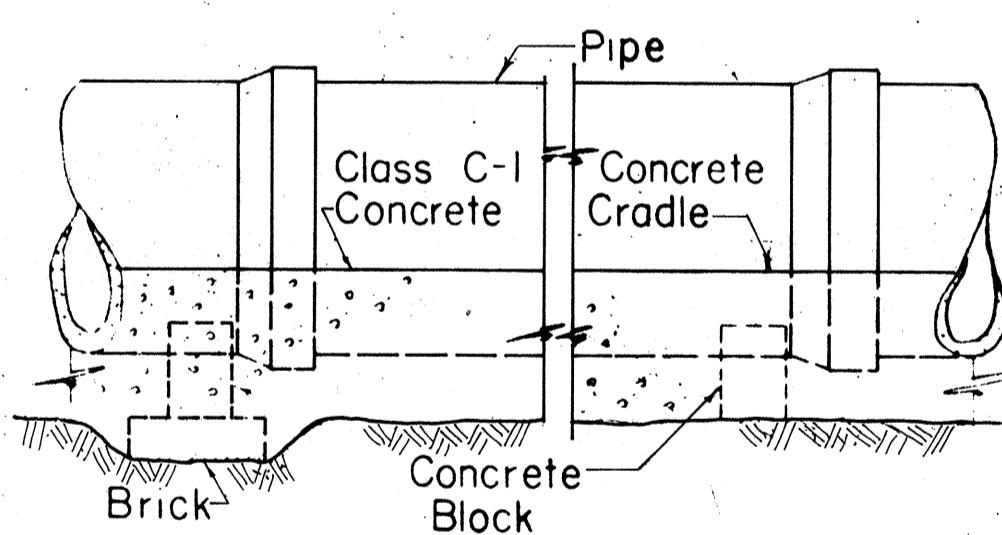

ELEVATION SHOWING METHOD OF LAYING PIPE

Not To Scale

CONCRETE PIPE TABLE			
TRENCH WIDTHS		DIM. OF CONC. CRADLE	
PIPE SIZE	PAY. WIDTH	PIPE SIZE	"a"
6"	2 4"	6"	3"
8"	2 4"	8"	3"
10"	2 4"	10"	3"
12"	3 0"	12"	3"
15"	3 8"	15"	4"
18"	4 1"	18"	5"
21"	4 5"	21"	5"
24"	5 0"	24"	6"
27"	5 3"	27"	7"
30"	5 7"	30"	7"

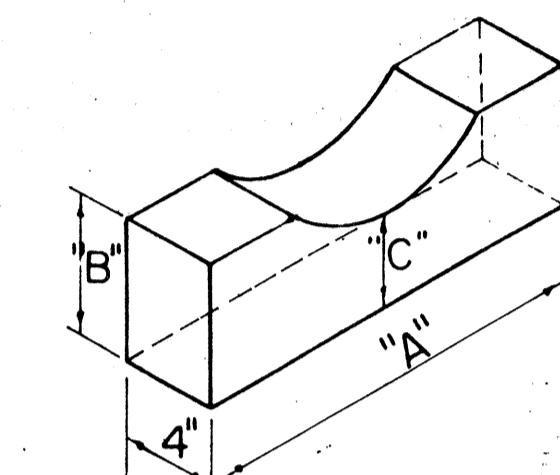

DETAIL OF PRECAST CONC. PIPE BLOCK

CONCRETE BLOCK DIMENSIONS		
PIPE SIZE	"A"	"B"
	"C"	
6"	1'-2"	6"
8"	1'-5"	6"
10"	1'-7"	6"
12"	1'-7"	6"
15"	1'-8"	6"
18"	1'-9"	6"
21"	1'-10"	6"
24"	1'-11"	6"
27"	2'-0"	6"
30"	2'-3"	6"

SURVEY PLOTTED BY
DRAWN BY
TRACED BY
DESIGNED BY
CHECKED BY

L-5-7

PRINTED ON NO. 1000 CLEARPRINT



Paul M. Hiboa

THIS WORK WAS PREPARED BY ME
OR UNDER MY SUPERVISION

STATE OF HAWAII
DEPARTMENT OF TRANSPORTATION
HIGHWAYS DIVISION
NIMITZ SPUR

SEWER DETAILS

INTERSTATE ROUTE H-1
PROJ. NO I-HI-1(99) 15

SCALE AS NOTED
DATE AUG 4 1976
SHEET NO. 19 OF 19 SHEETS