




SIGNAL	PHASES					
	A1	A2	B	C	A1+A2	C+A2
1,2,3,4	G/↑	R	R	R	G/↑	R
5,6	R	↑	R	R	↑	↑
7,8,9	R	R	G/←	R	R	R
10,11	R	R	R	←	R	←
12,13,14,15	DW	DW	W/FDW	DW	DW	DW
16,17	W/FDW	DW	DW	DW	W/FDW	DW

SIGNAL INDICATIONS					
1 7 8	2 3 4	9 11	10	12 13 14	15 16 17
			Programmed Visibility Signal		

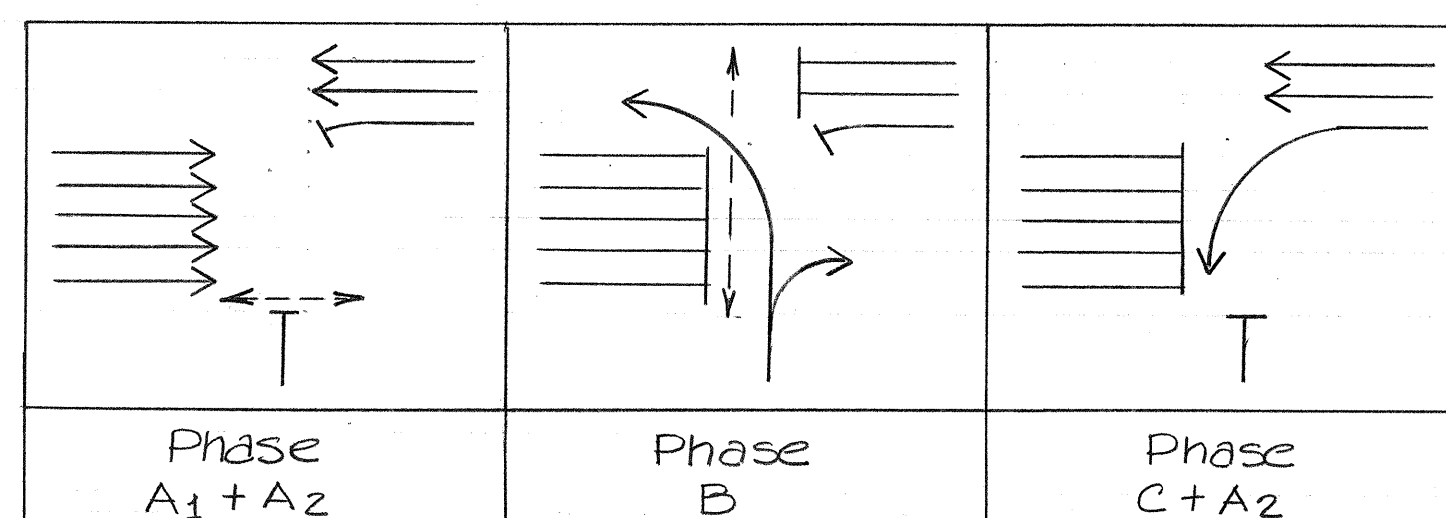

FED. ROAD DIST. NO.	STATE	FED. AID PROJ. NO.	FISCAL YEAR	SHEET NO.	TOTAL SHEETS
HAWAII	HAW.	EHI-1(23)16	1976	106	444

10-10-78	Revised Intersection Layout at Paiea St.-Aolele St.
10-10-77	Revised Intersection Layout at Paiea St.-Aolele St.
12-1-76	Added Detour Signals at Paiea St.-Nimitz
	Changed Intersection Layout at Paiea St.-Aolele
DATE	REVISION

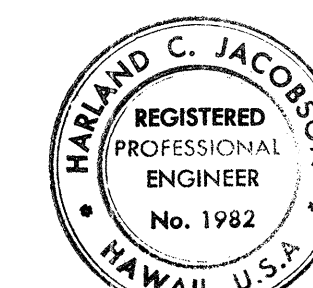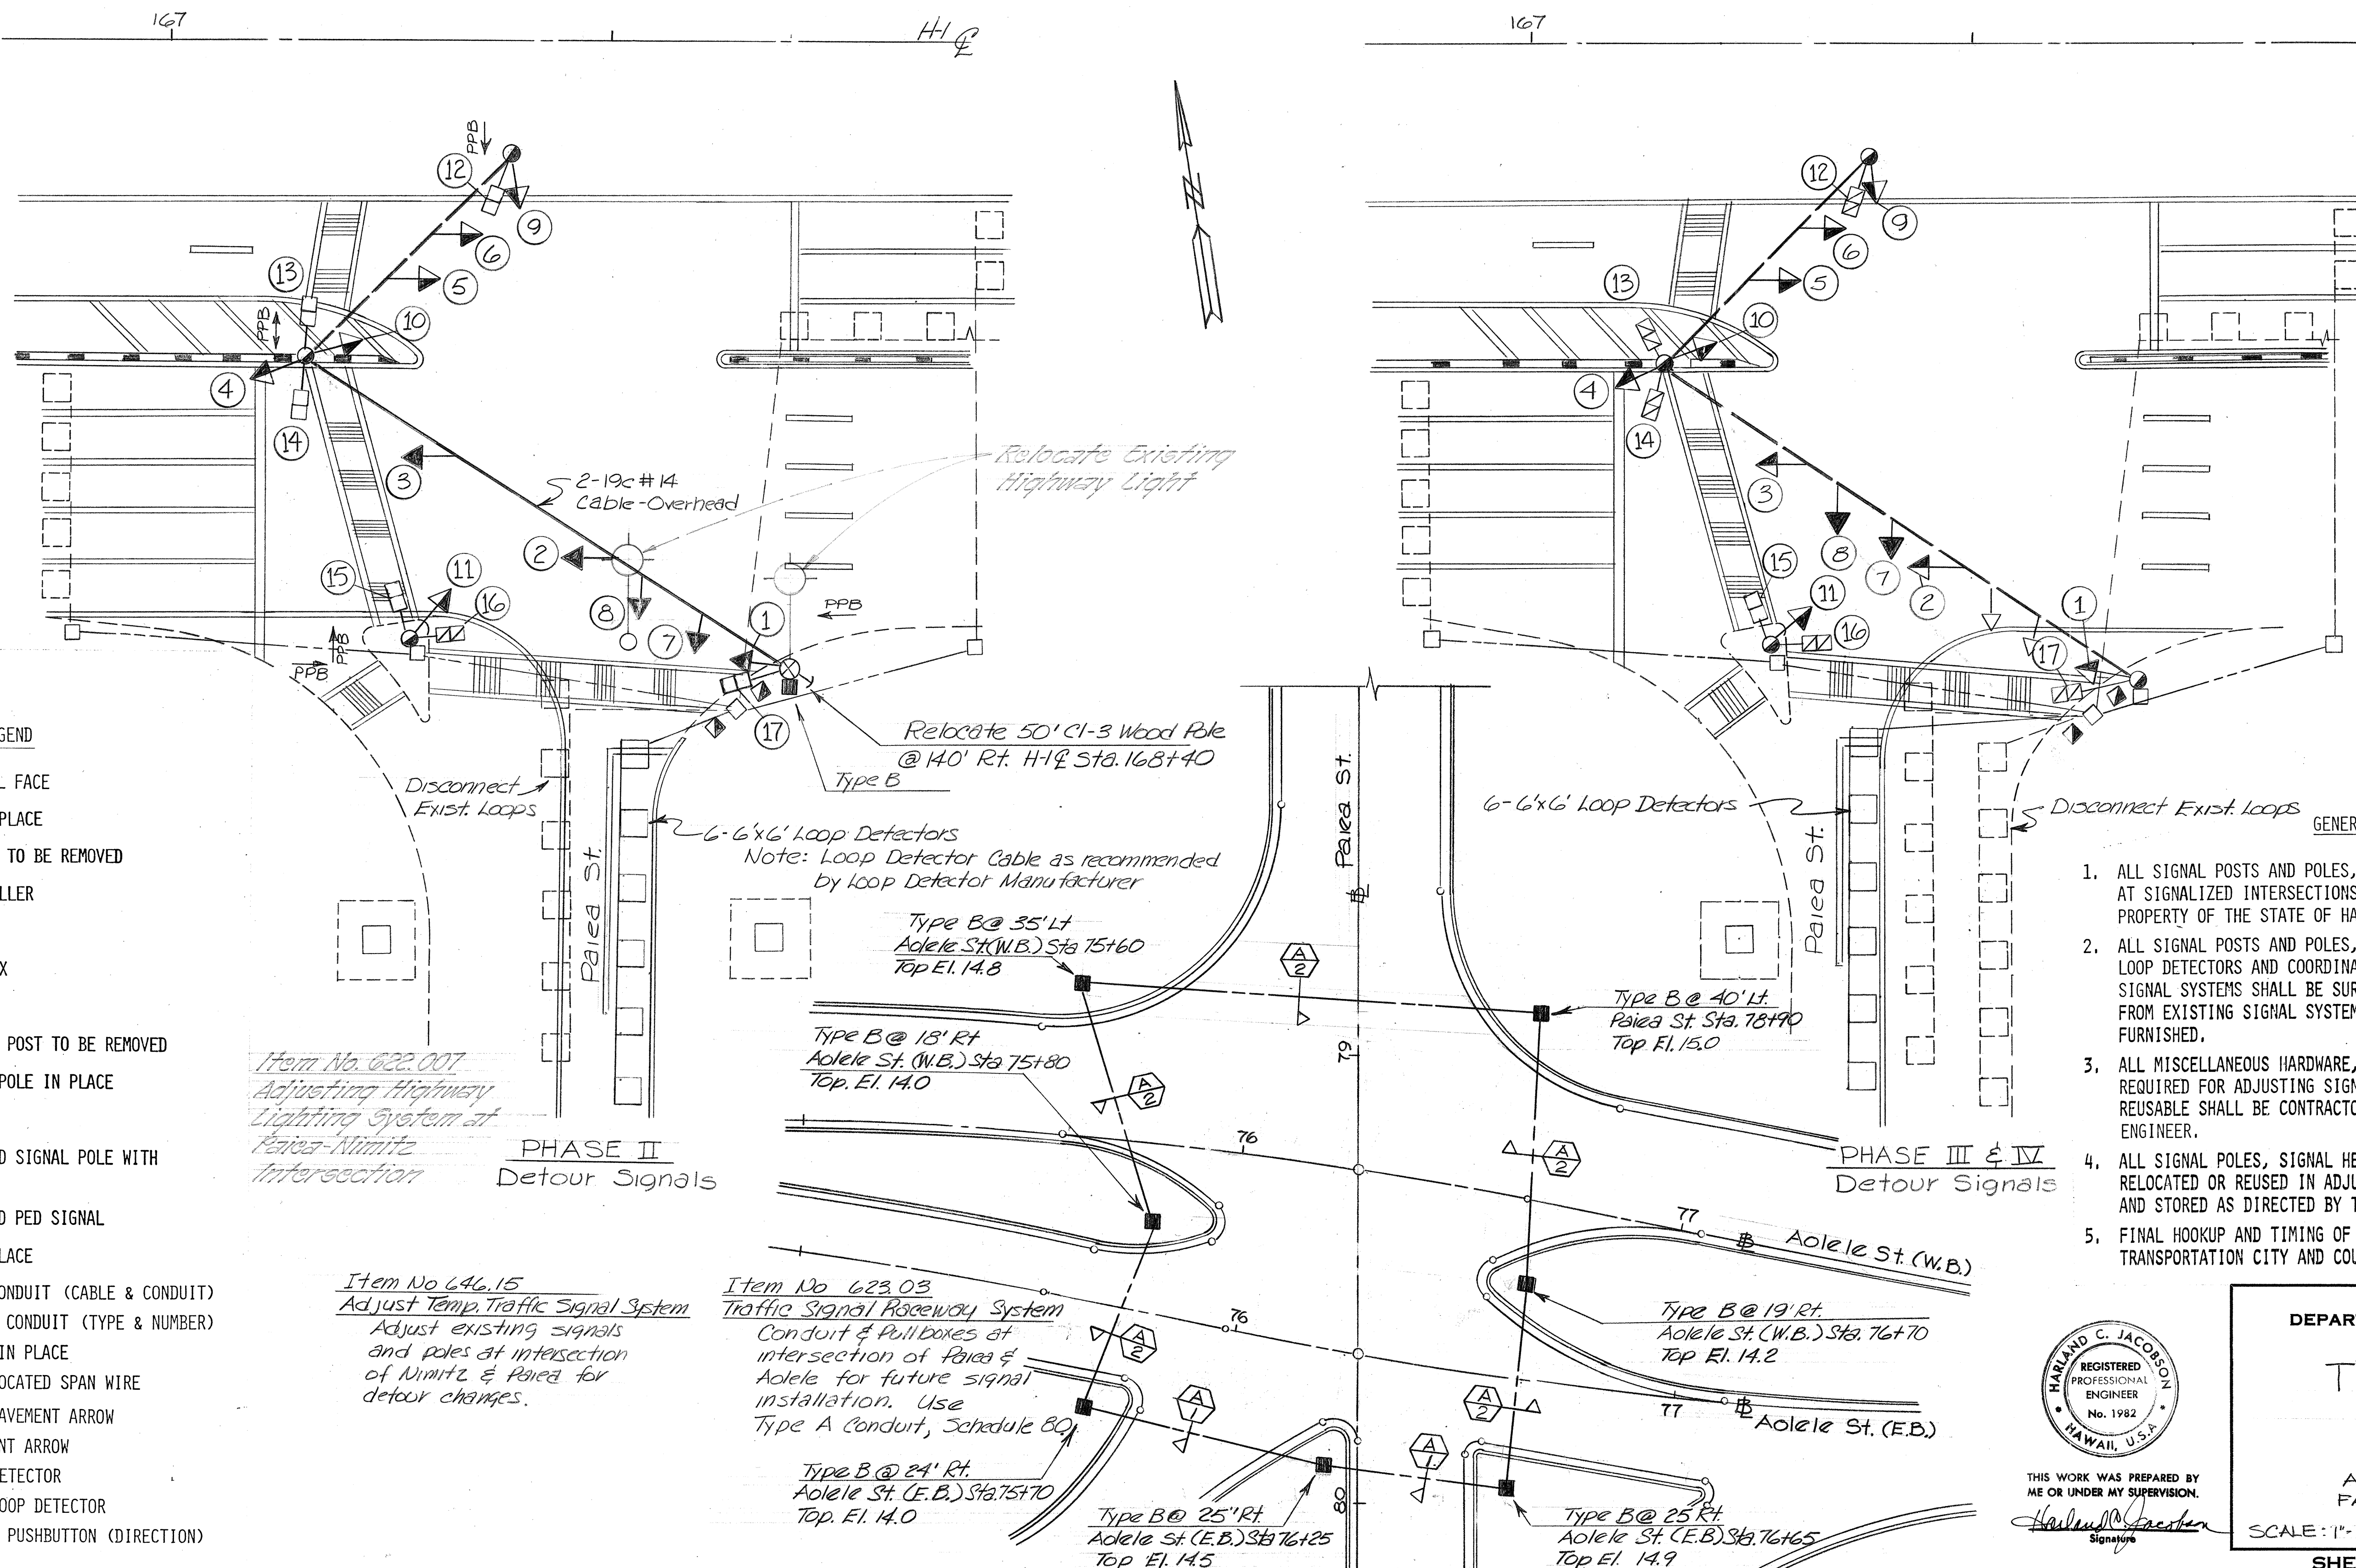

THIS WORK WAS PREPARED BY ME OR UNDER MY SUPERVISION.
Signature

STATE OF HAWAII
DEPARTMENT OF TRANSPORTATION
HIGHWAYS DIVISION

TRAFFIC SIGNALS










AIRPORT INTERCHANGE
FAI PROJ NO. IHI-1(23)16

SCALE: 1"=20' DATE: AUG. 28, 1976


SHEET No. 1 OF 2 SHEETS

COADD 106

FED. ROAD DIST. NO.	STATE	FED. AID PROJ. NO.	FISCAL YEAR	SHEET NO.	TOTAL SHEETS
HAWAII	HAW.	I-H-1(123)14	1976	106A	444

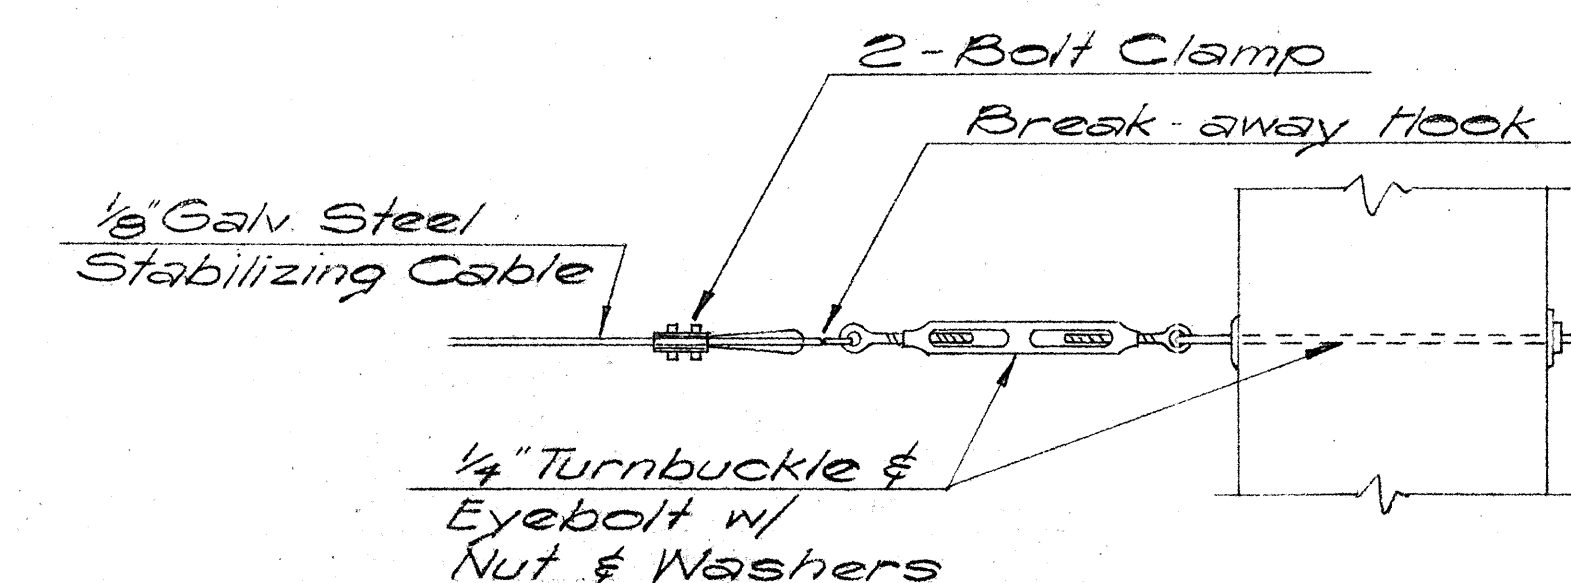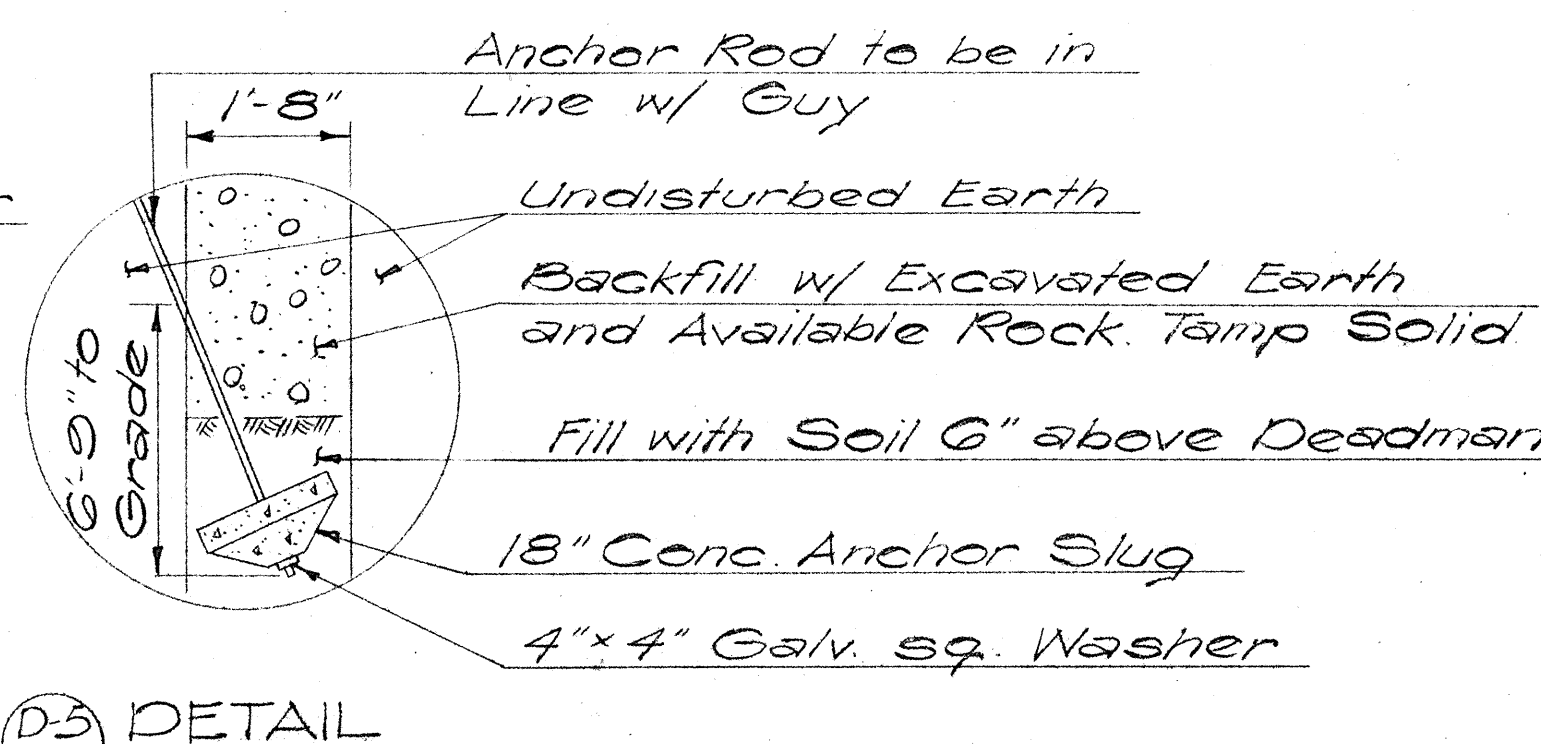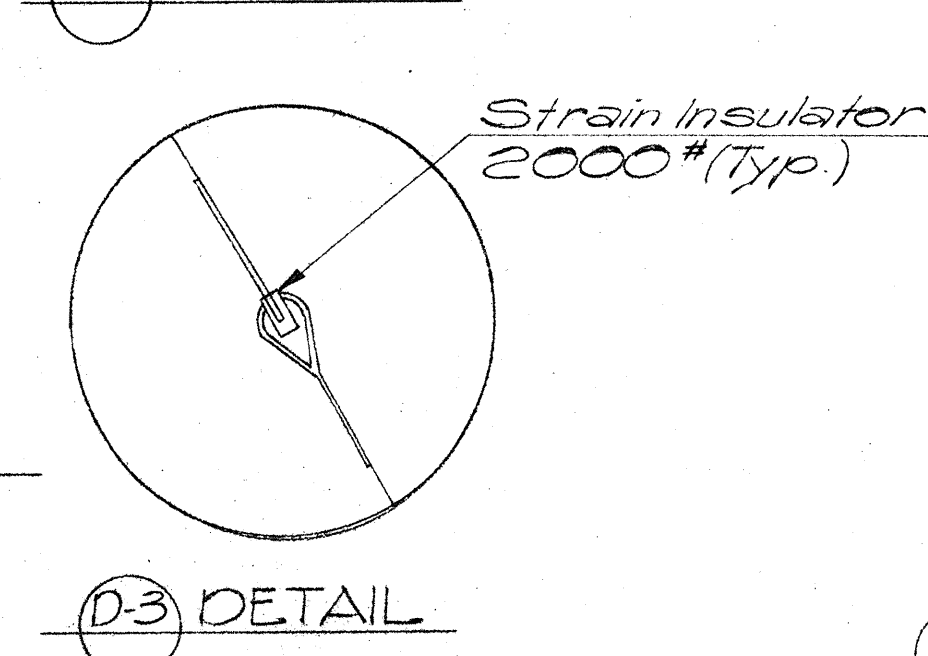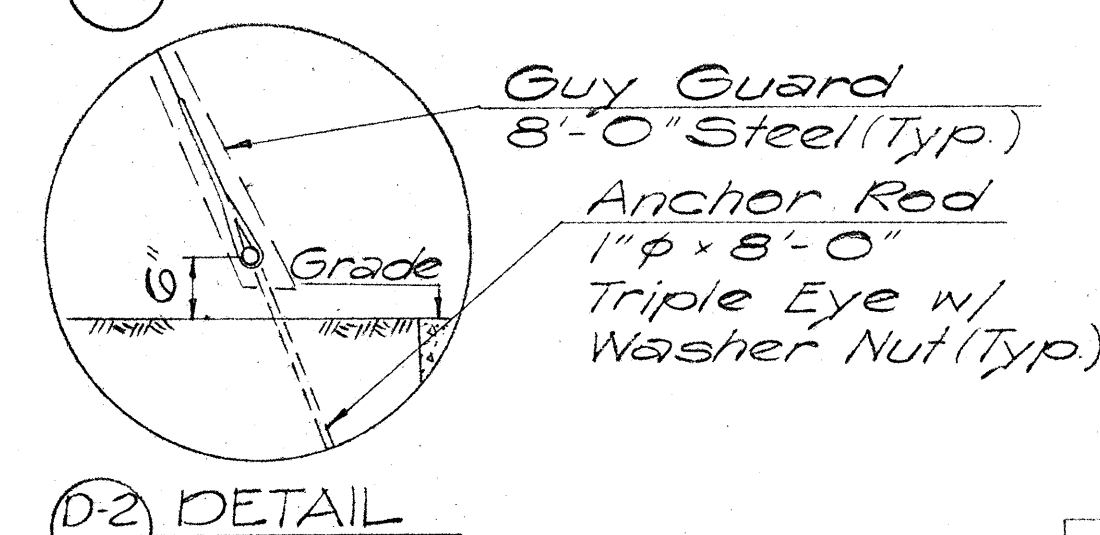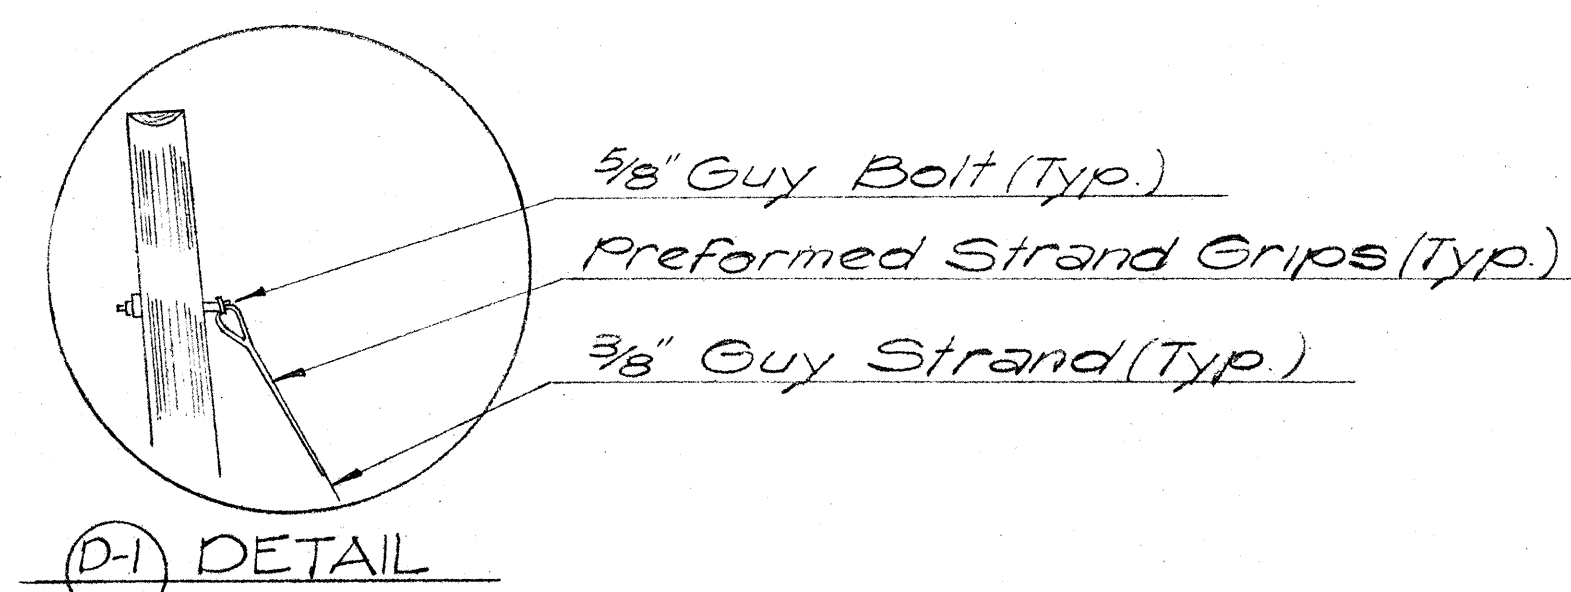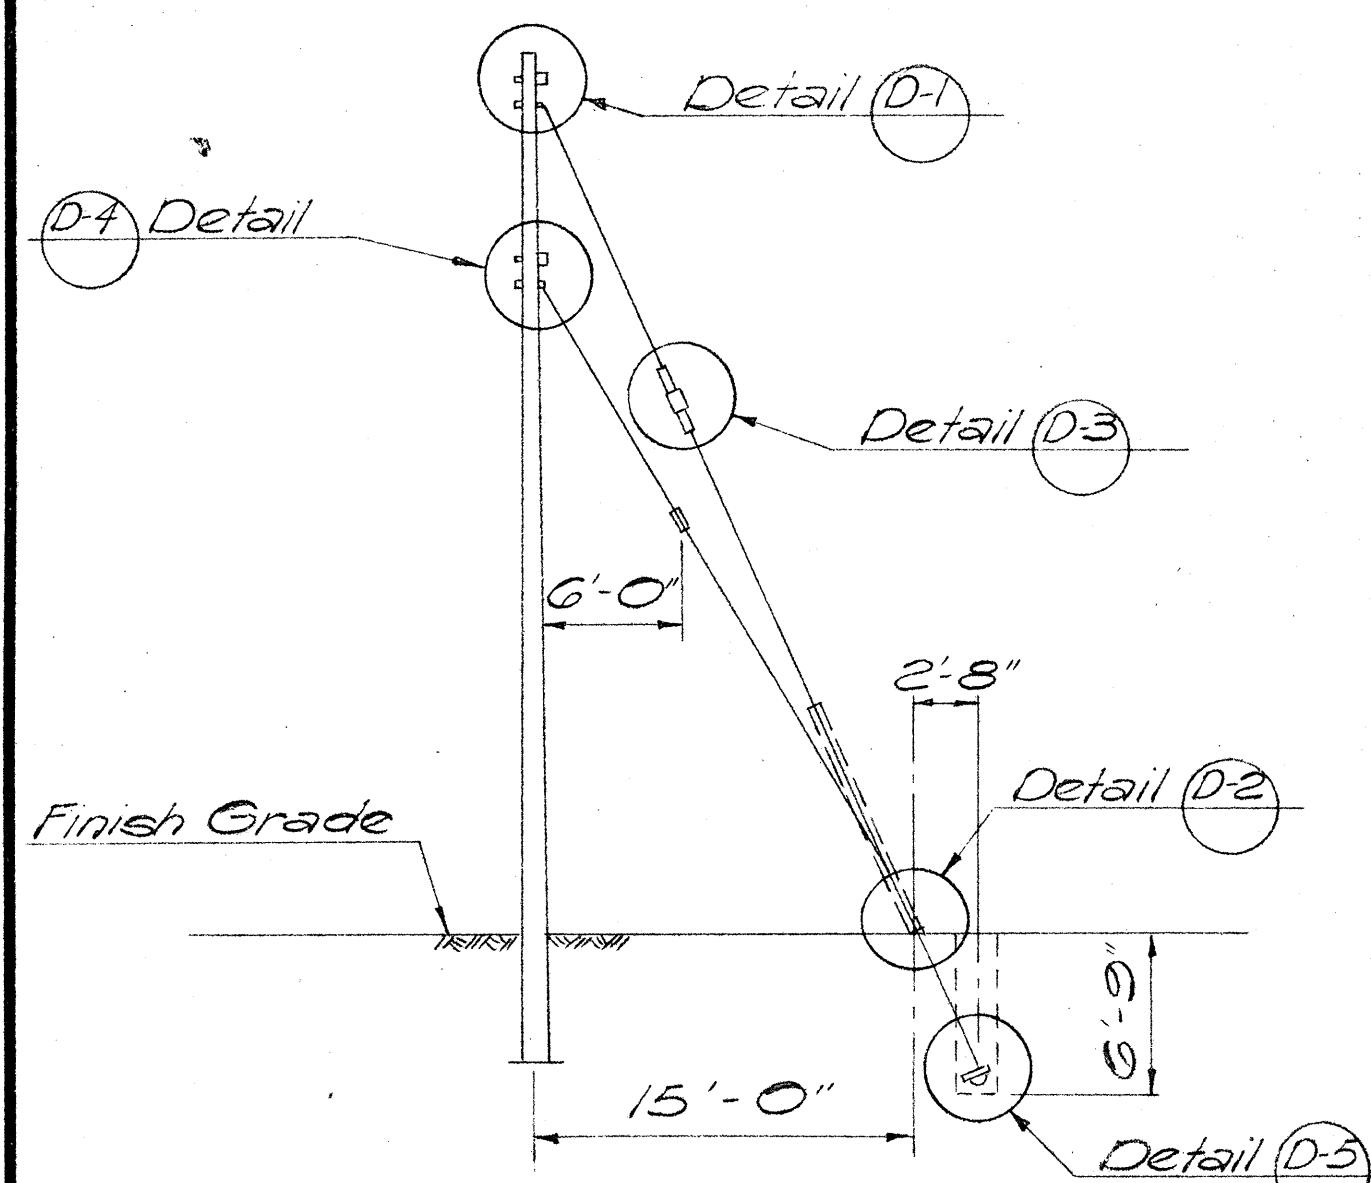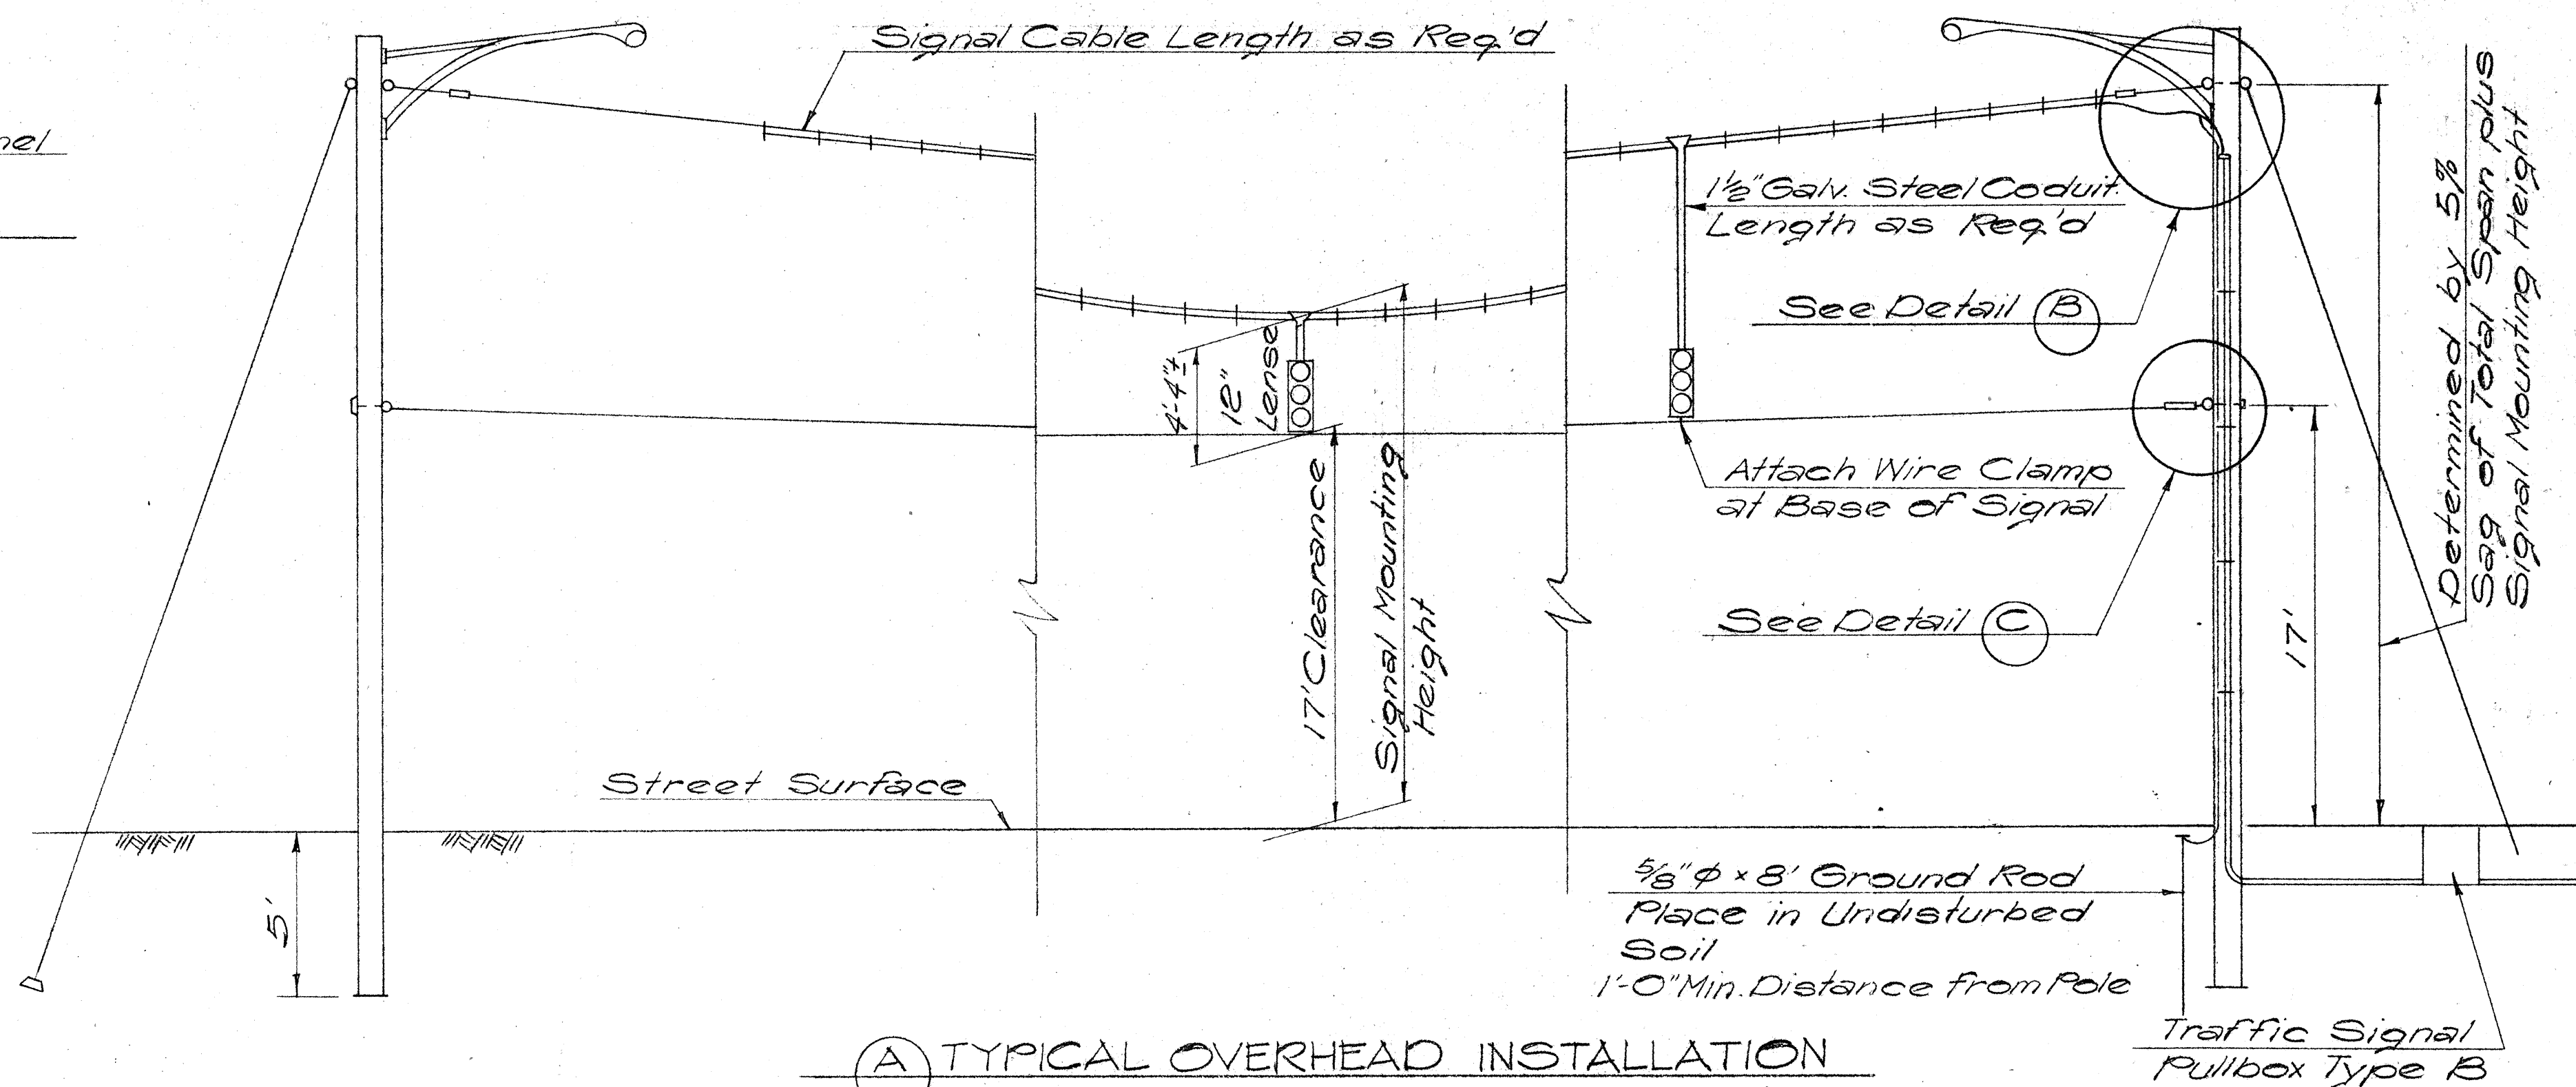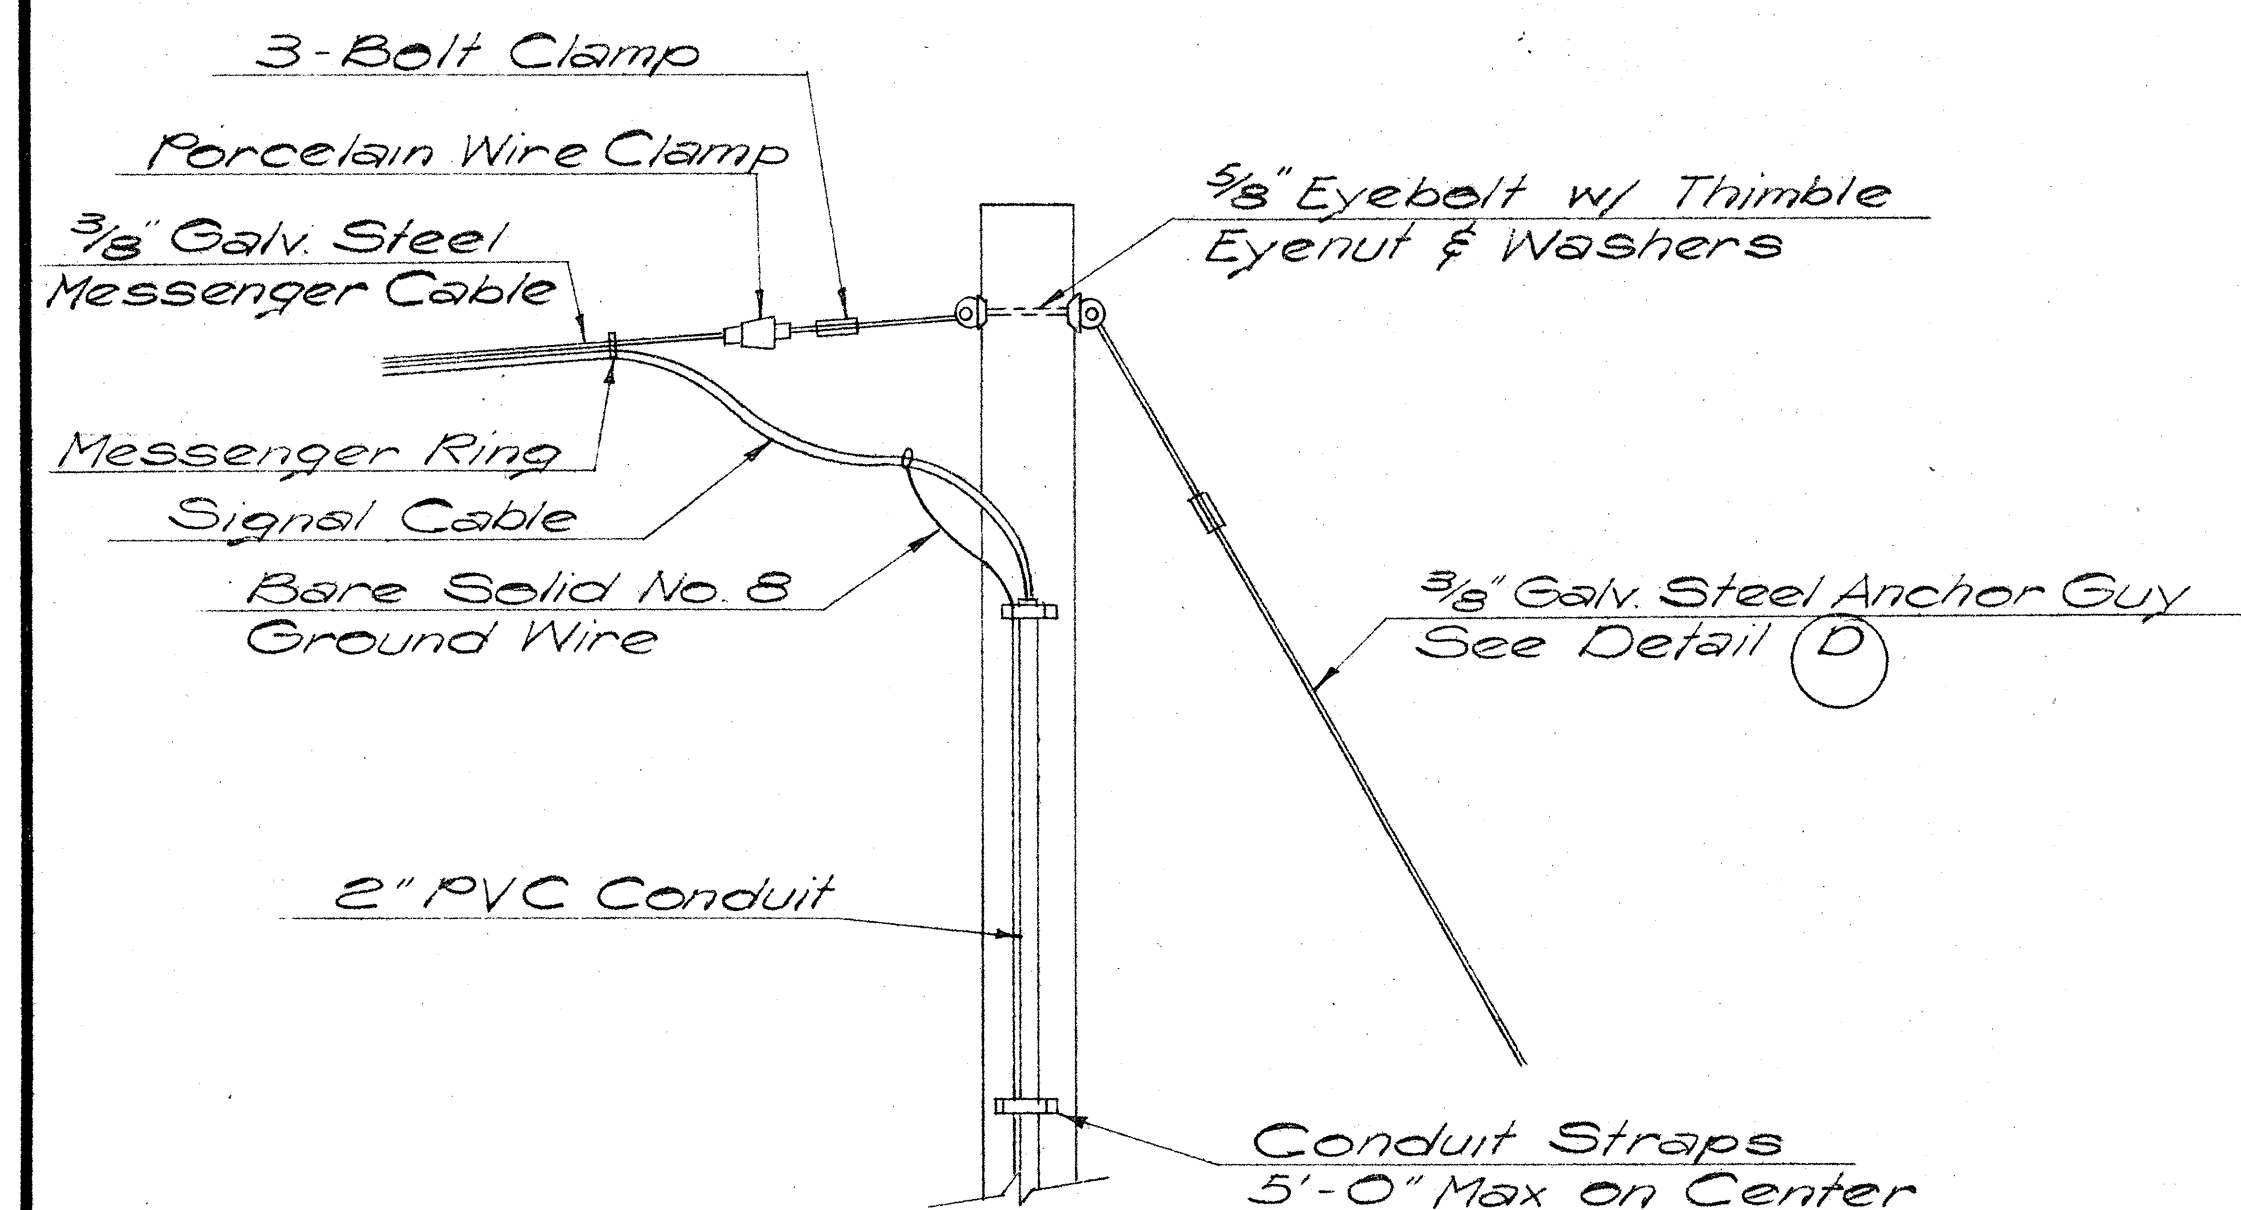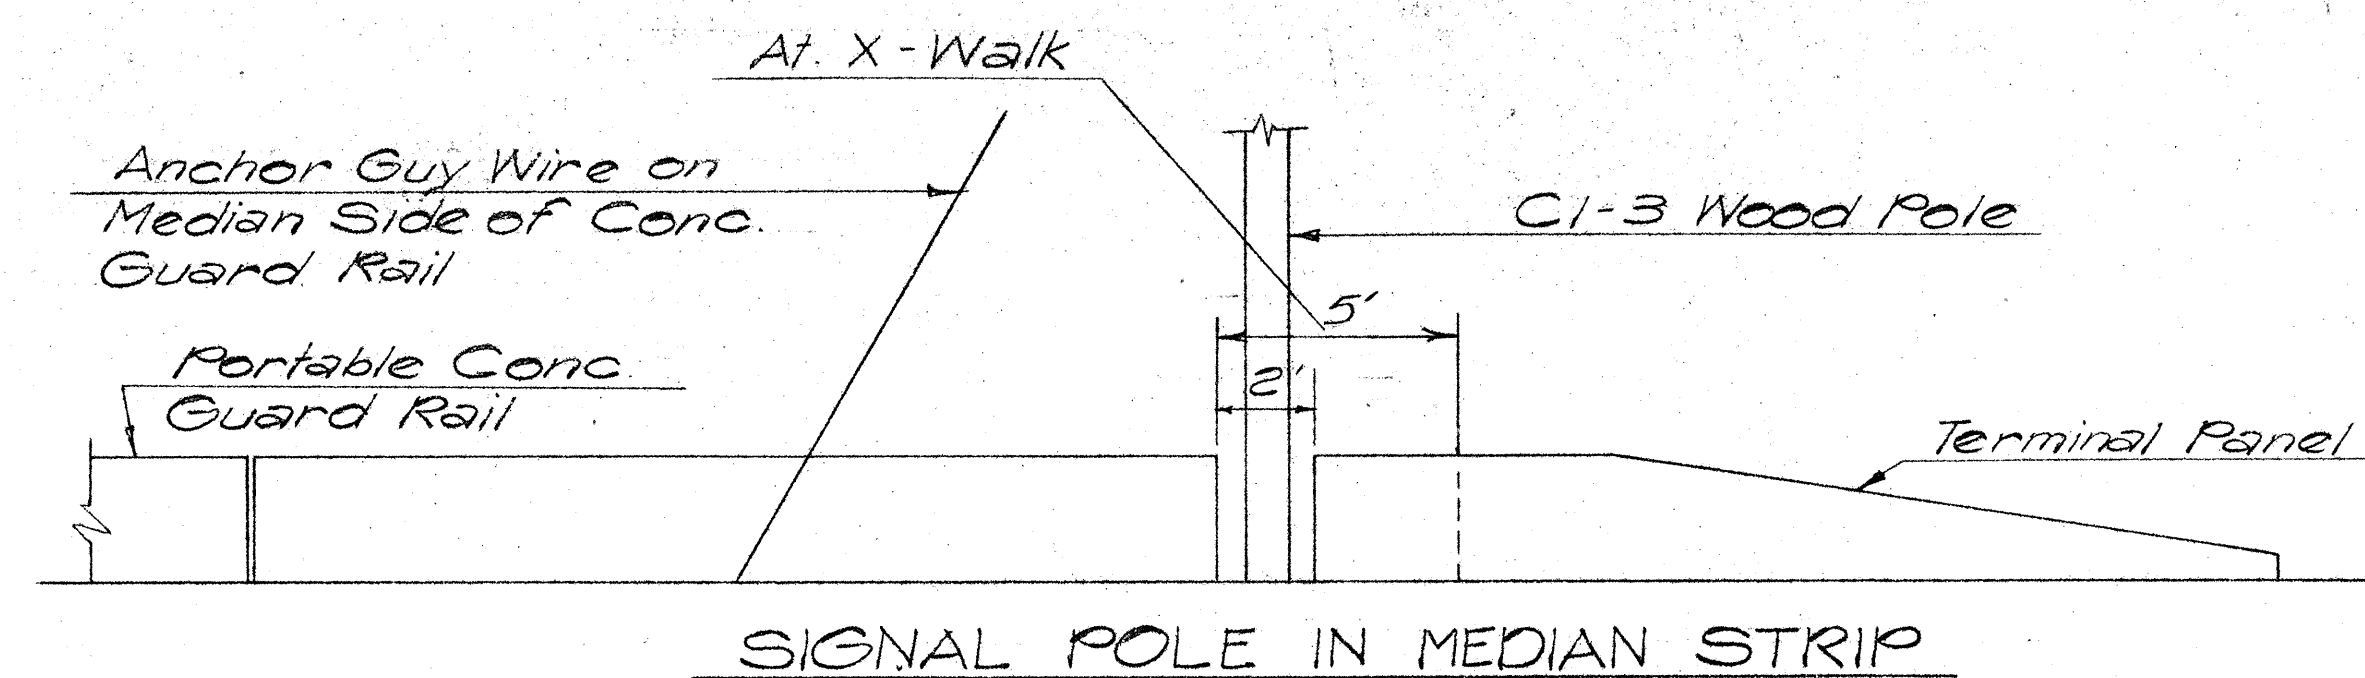

12-14-76	Added Sheet to Plans
DATE	REVISION

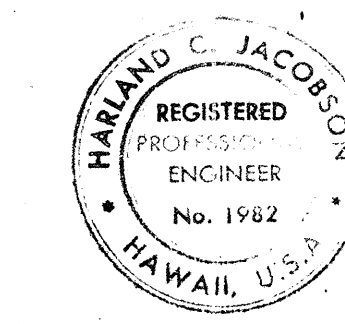

THIS WORK WAS PREPARED BY ME OR UNDER MY SUPERVISION.

Harold C. Jacobson
Signal

STATE OF HAWAII
DEPARTMENT OF TRANSPORTATION
HIGHWAYS DIVISION

DETOUR SIGNAL DETAILS

AIRPORT INTERCHANGE
F.A.I. PROJ. I-H-1(123):16

SCALE: NONE DATE: AUG. 28, 1976

SHEET No. 2 OF 2 SHEETS

ADD 106A

DATE	_____
SURVEY PLOTTED BY	_____
DRAWN BY	_____
DESIGNED BY	_____
NOTED BY	_____
CHECKED BY	_____
ORIGINAL PLAN	_____
NOTE BOOK	_____
No.	_____