



FED. ROAD DIST. NO.	STATE	FED. AID PROJ. NO.	FISCAL YEAR	SHEET NO.	TOTAL SHEETS
HAWAII	HAW.	1-HI-11(22)-16	1977	170	181

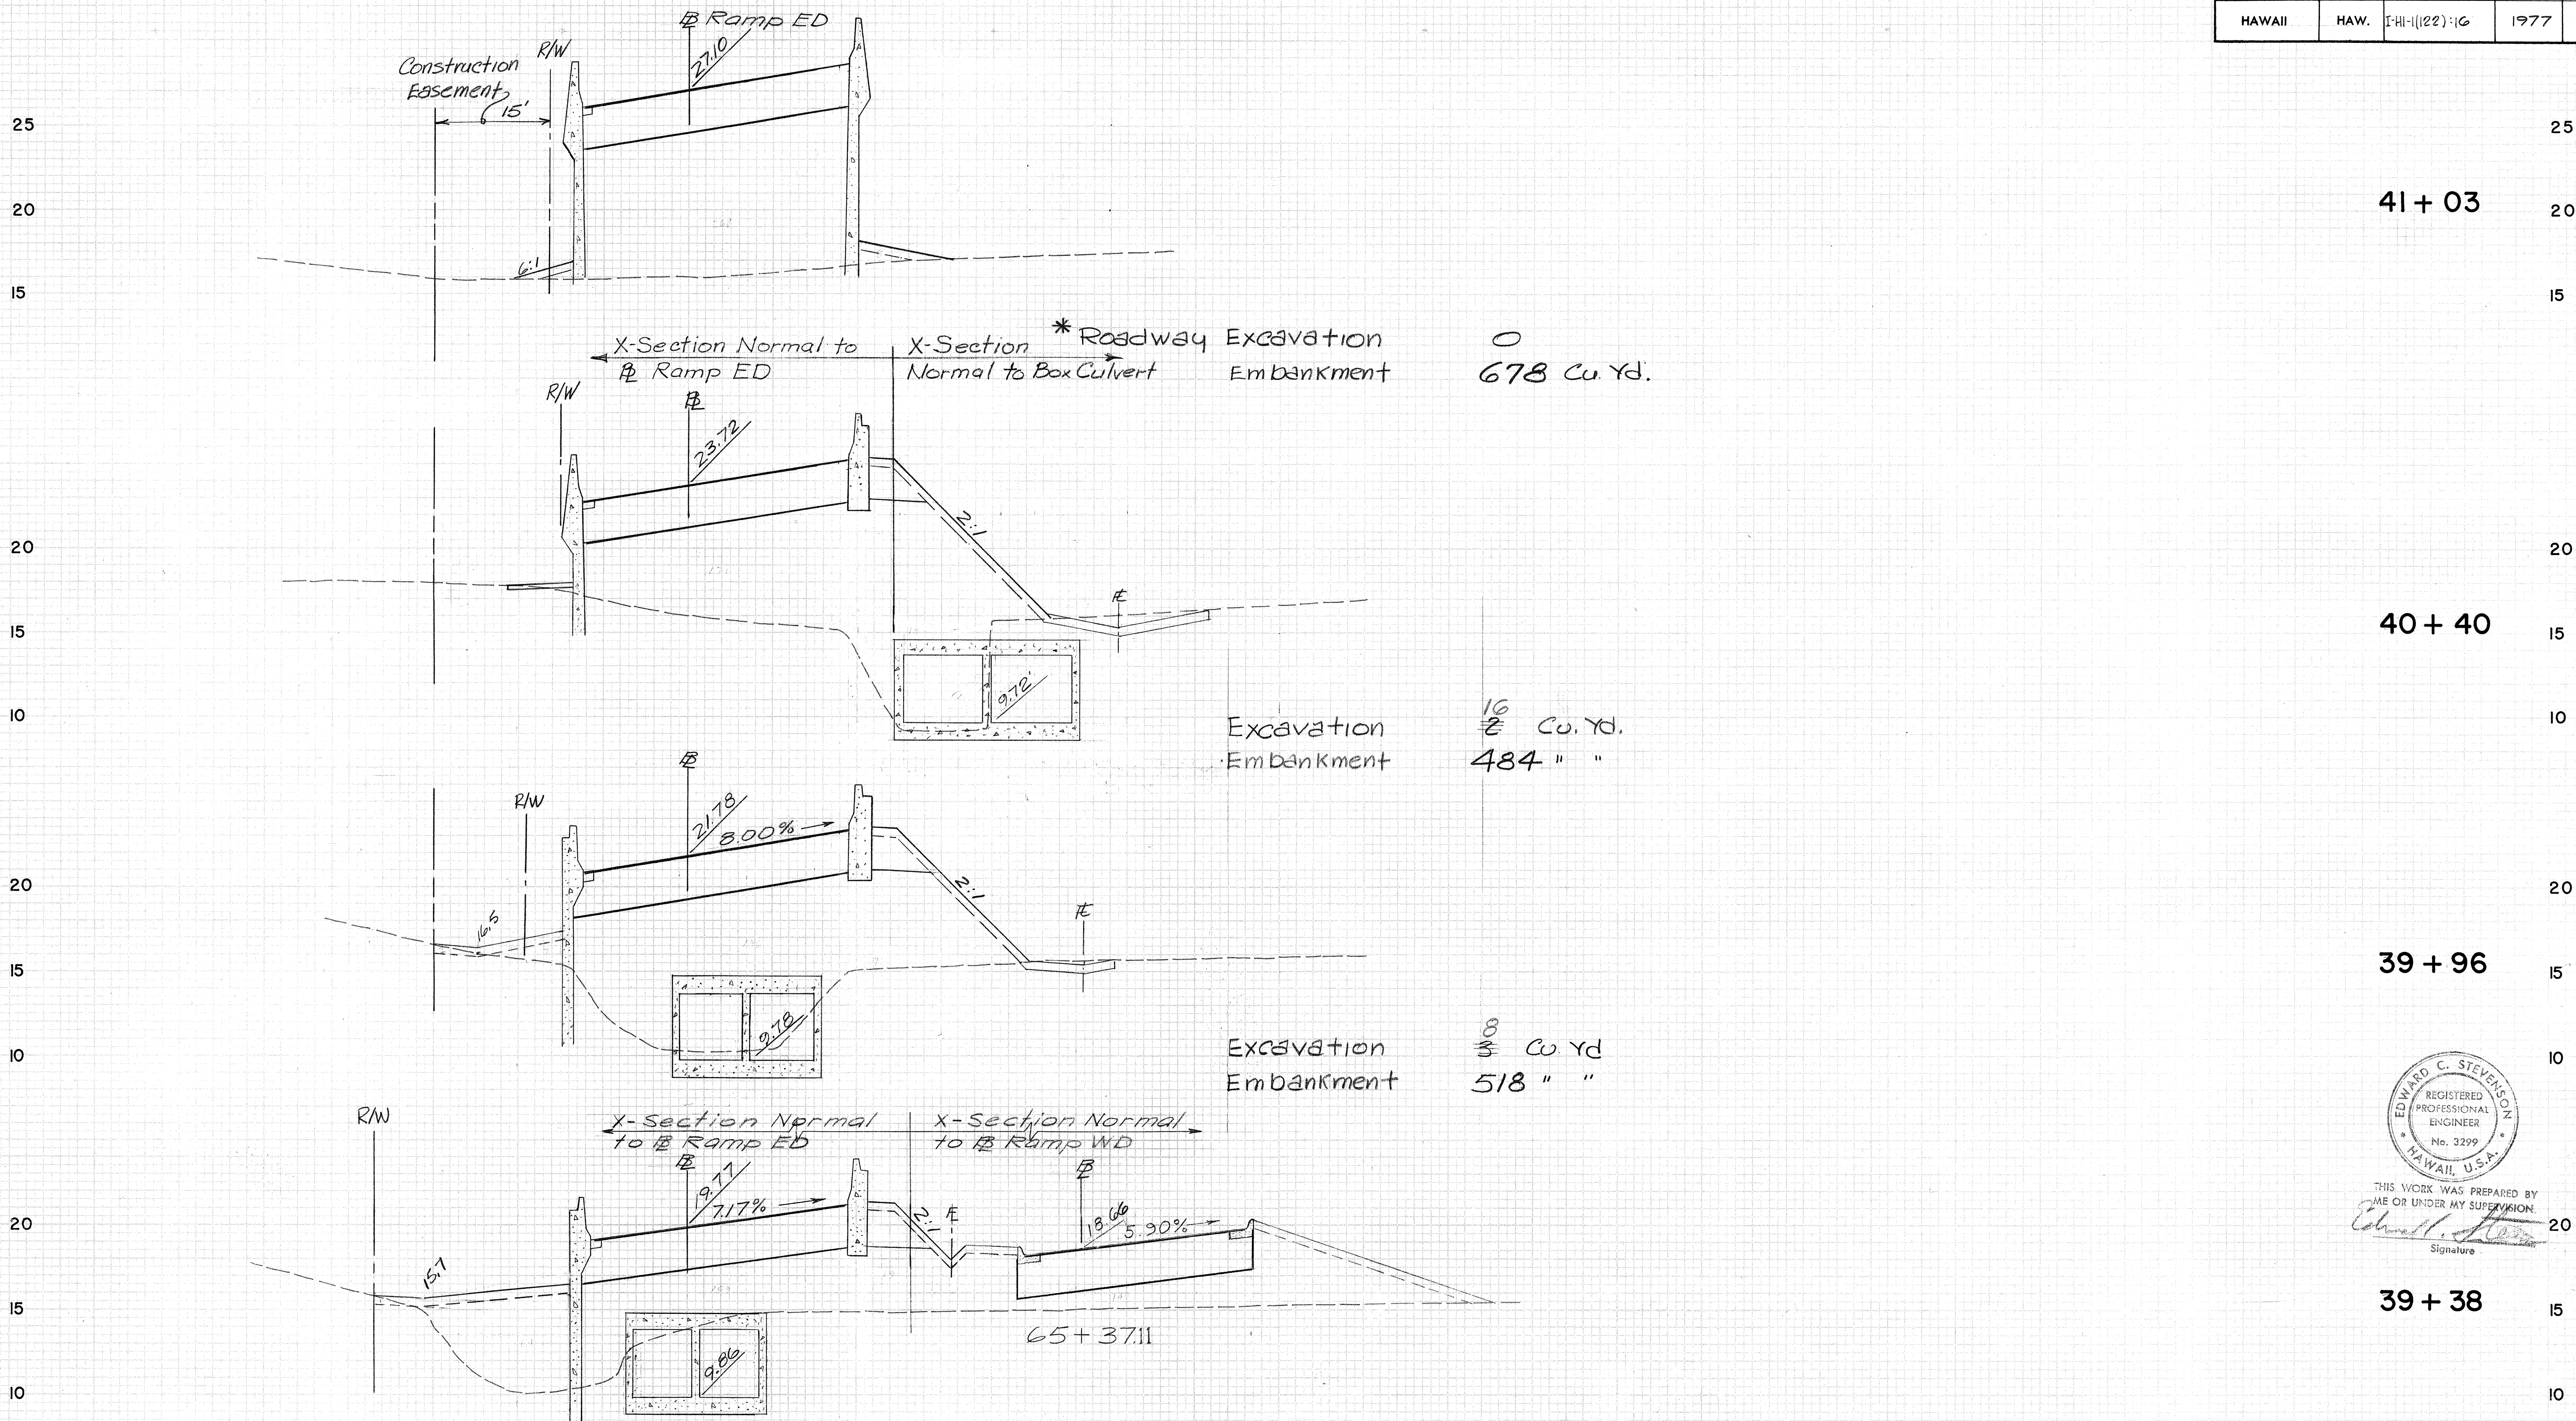

FED. ROAD DIST. NO.	STATE	FED. AID PROJ. NO.	FISCAL YEAR	SHEET NO.	TOTAL SHEETS
HAWAII	HAW.	I-H-1(122)-16	1977	171	181

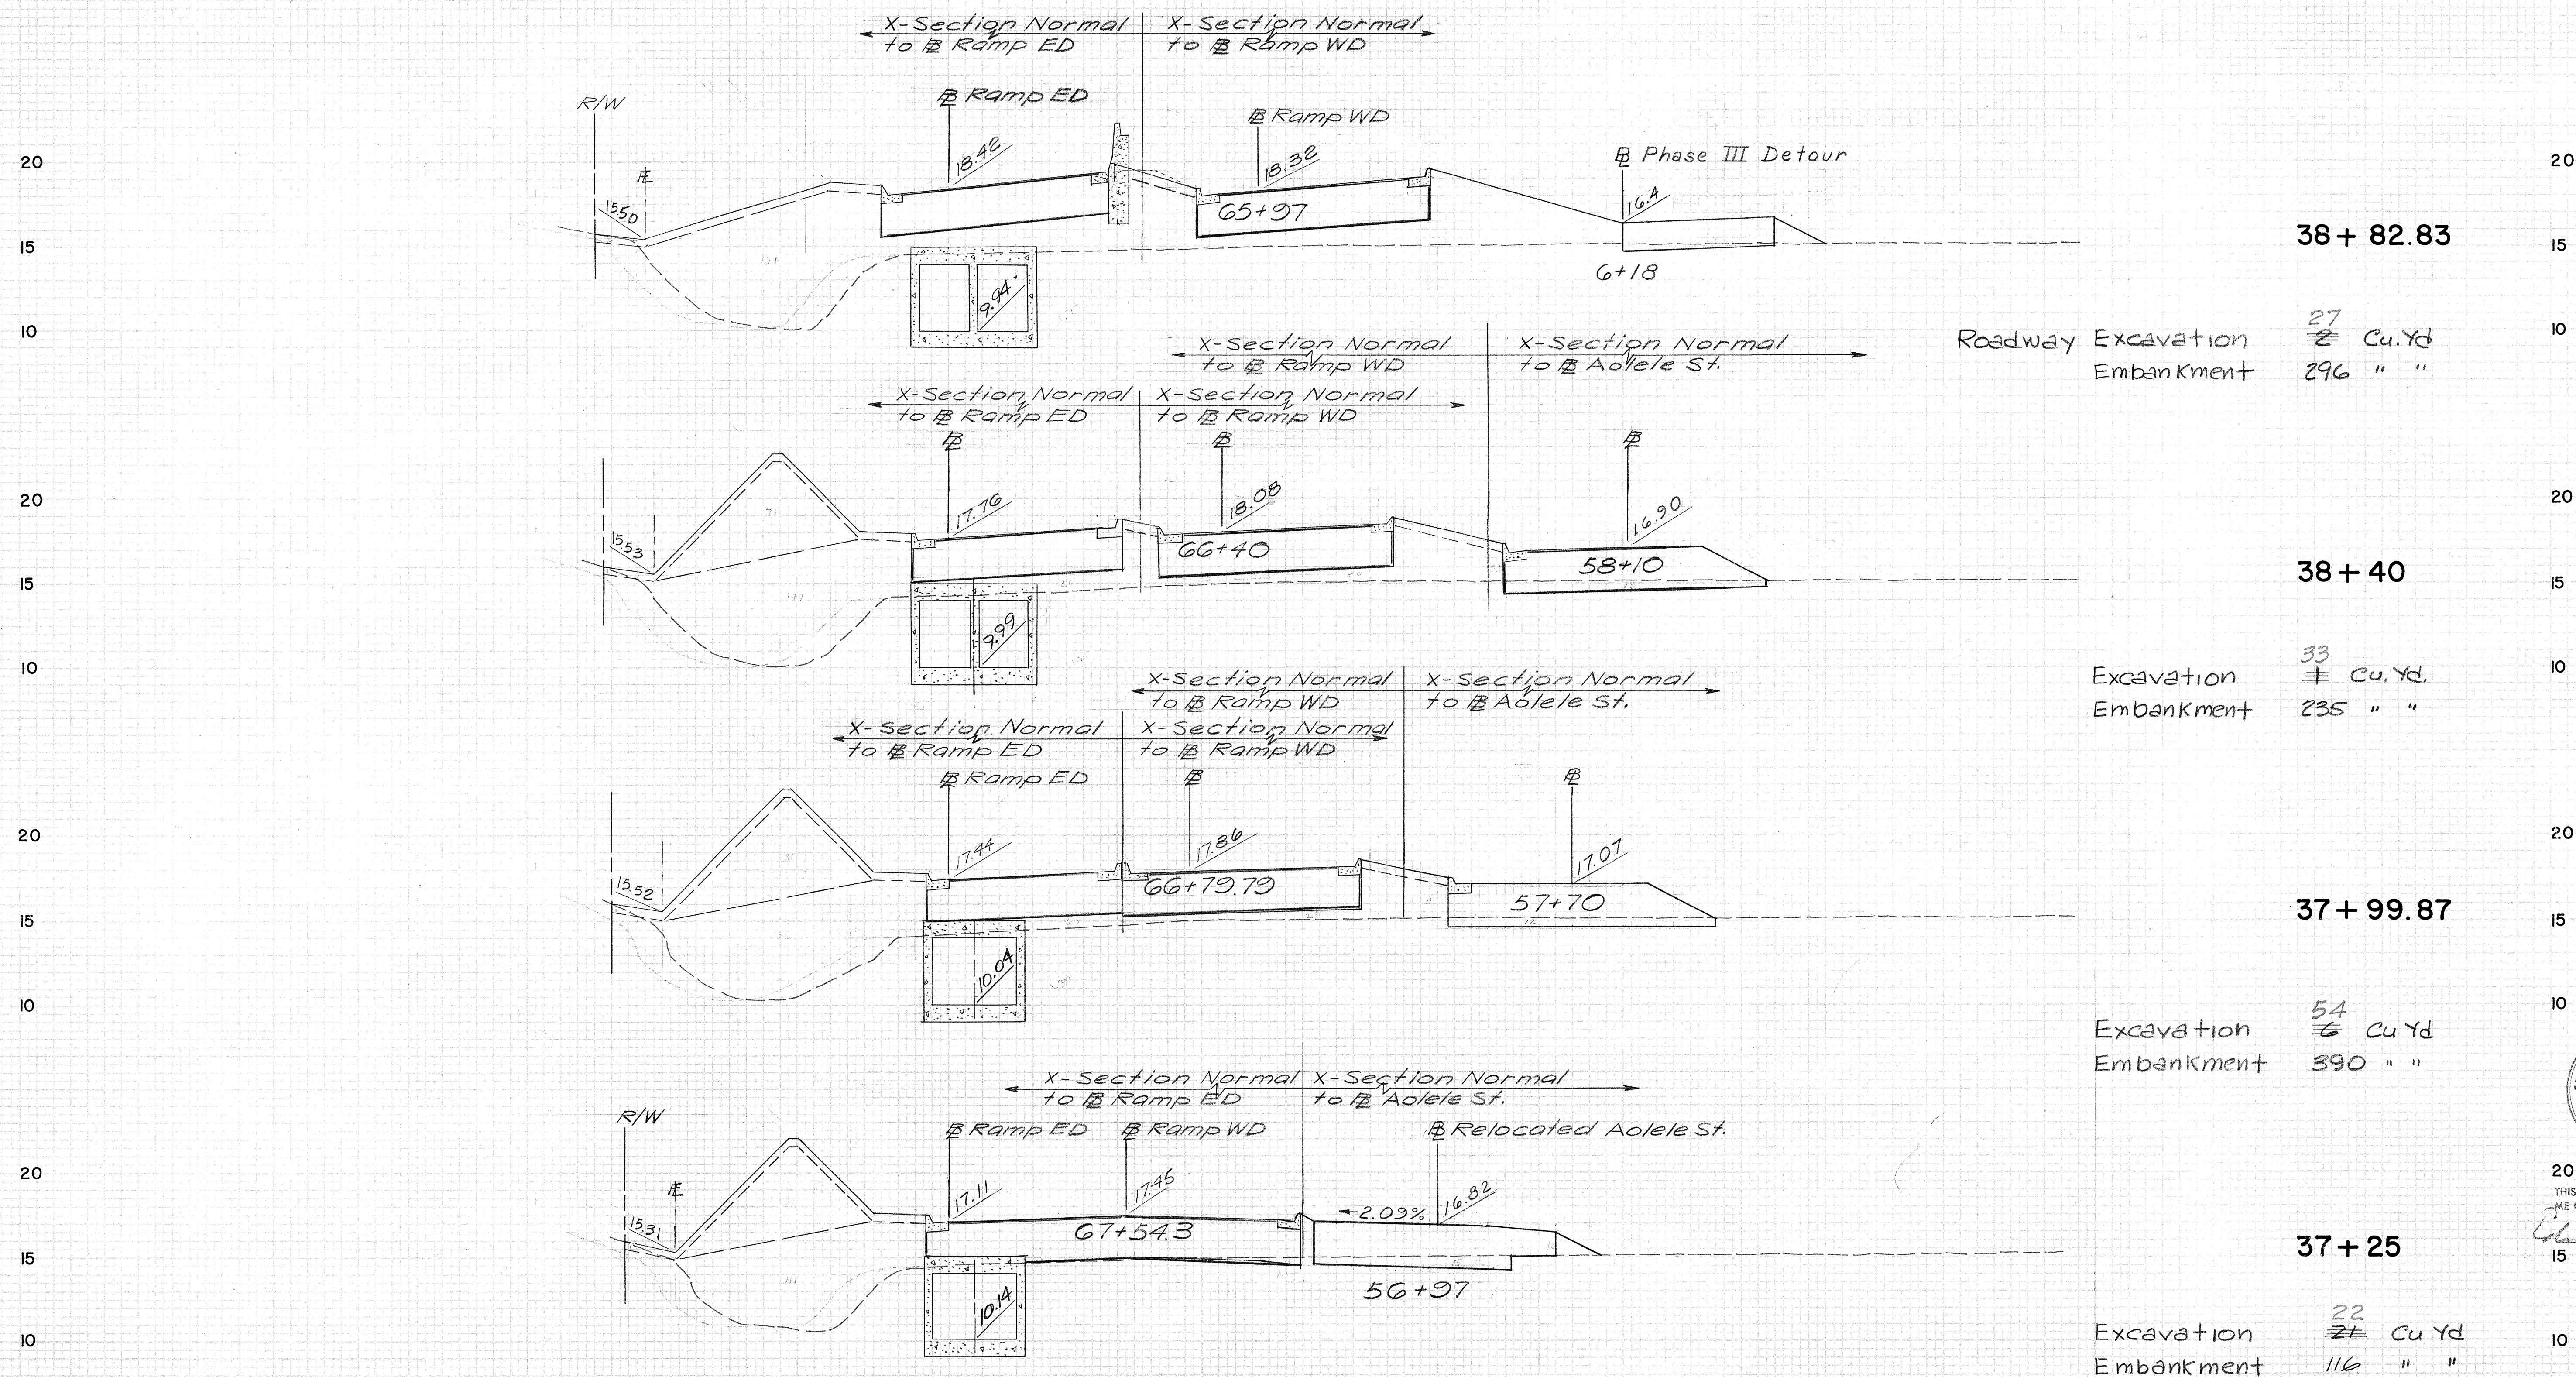


NO	DATE	REVISION
2	4-28-78	Revised Section at Sta. 56+97 Aolele St.
1	8-18-77	Removed Retaining Wall ED-1 and added Fill Slope & Guard Rail, Type 4E

HORIZ. 1 INCH = 10 FT.
VERT. 1 INCH = 5 FT.






RAMP ED

COADDI71

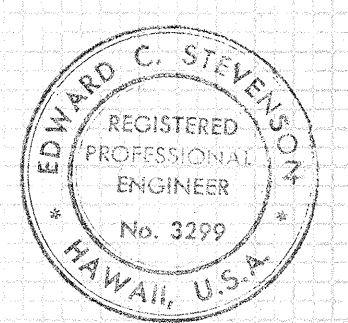

THIS WORK WAS PREPARED BY ME OR UNDER MY SUPERVISION
Signature

FED. ROAD DIST. NO.	STATE	FED. AID PROJ. NO.	FISCAL YEAR	SHEET NO.	TOTAL SHEETS
HAWAII	HAW.	I-H-11(22)-10	1977	172	181

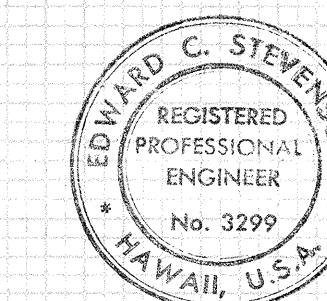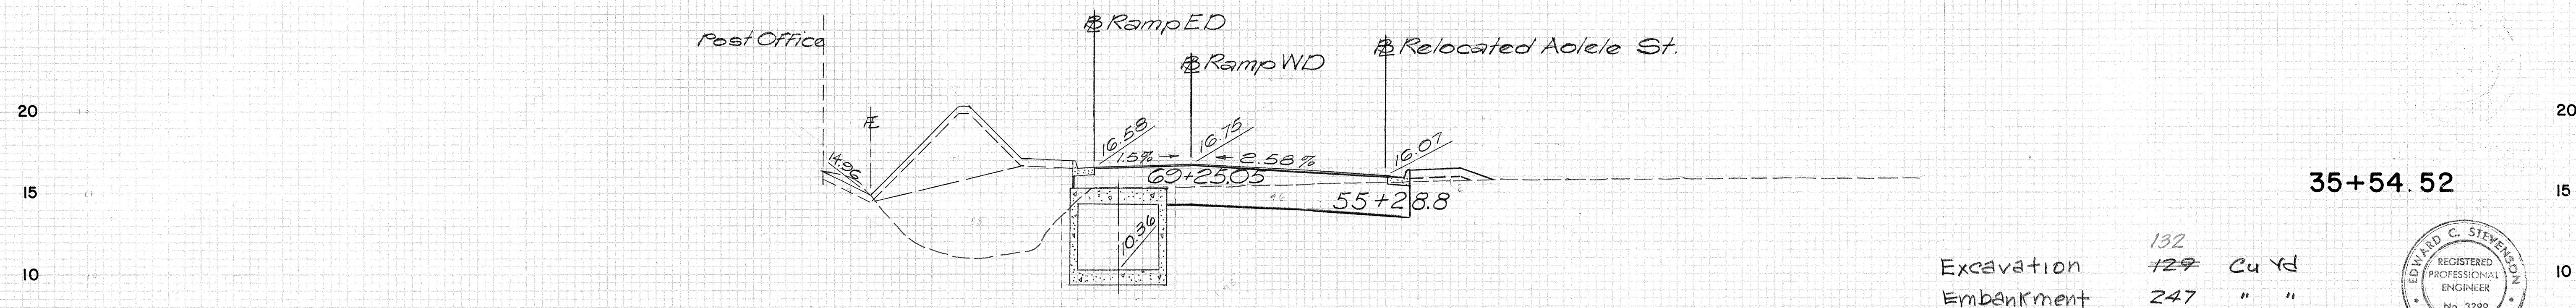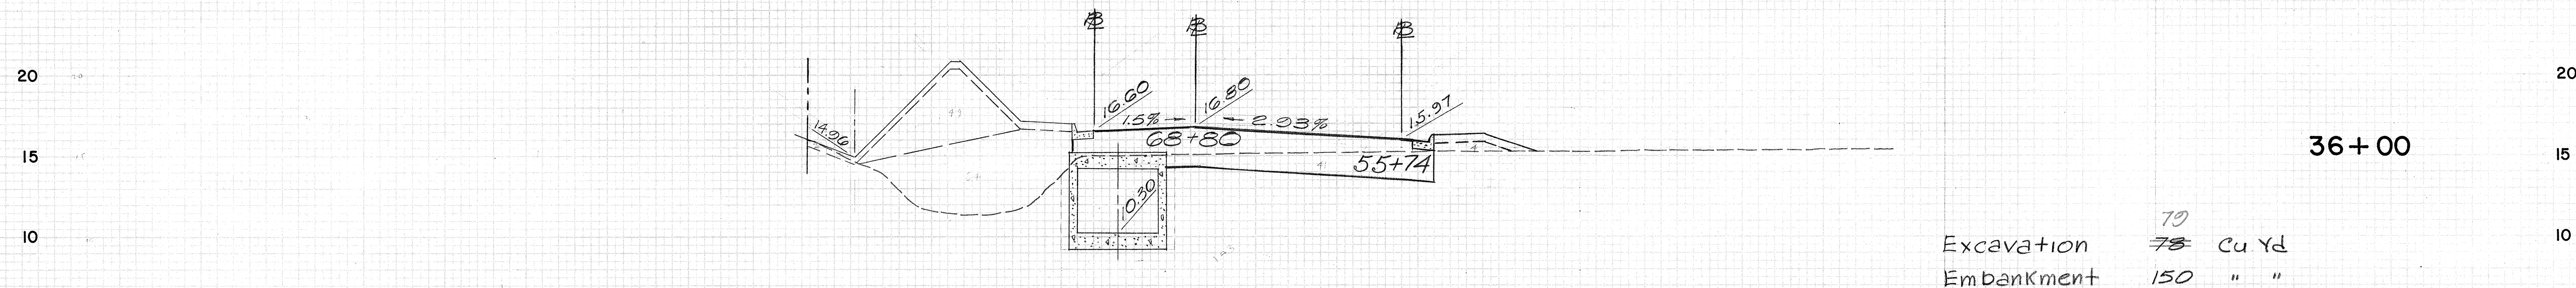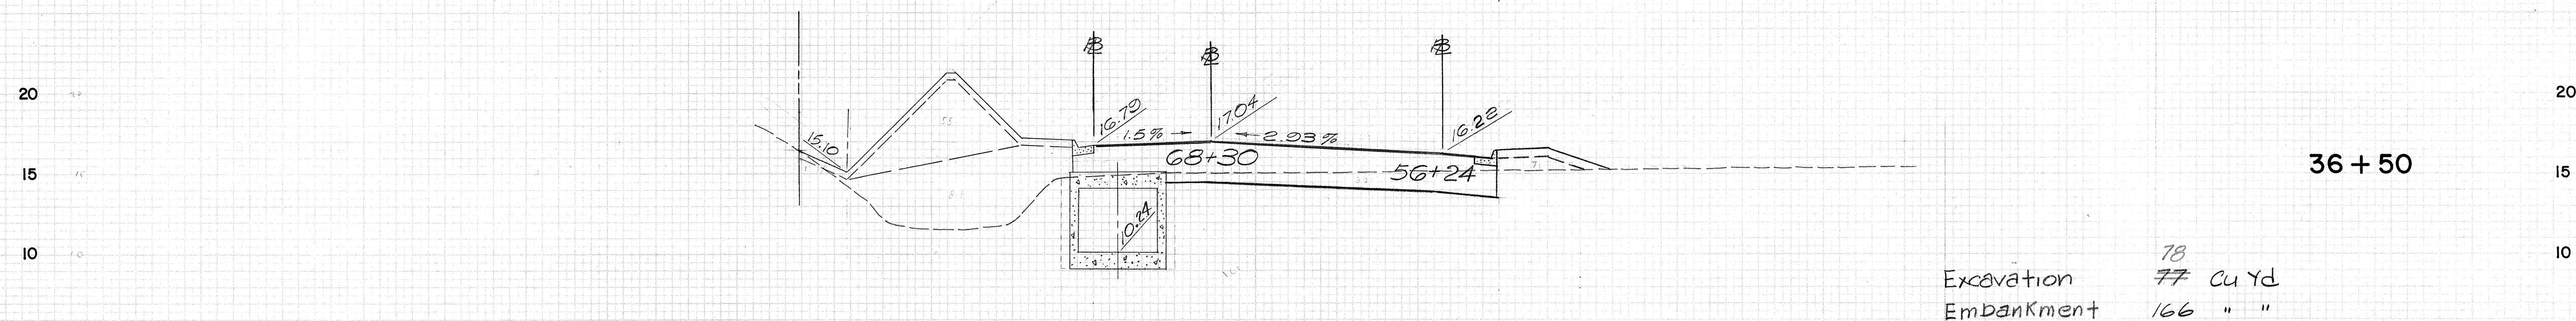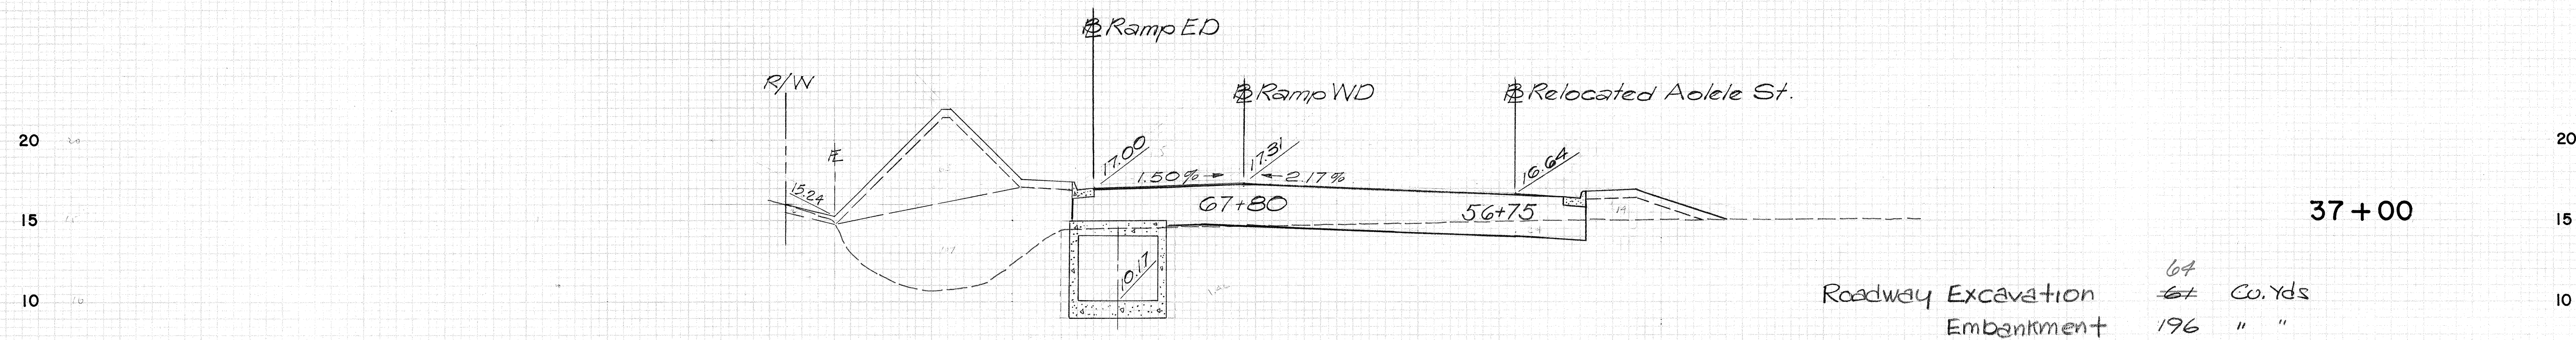

THIS WORK WAS PREPARED BY
ME OR UNDER MY SUPERVISION.
Edward C. Stevenson
Signature



HORIZ. 1 INCH = 10 FEET
VERT. 1 INCH = 5 FEET

RAMP ED

FED. ROAD DIST. NO.	STATE	FED. AID PROJ. NO.	FISCAL YEAR	SHEET NO.	TOTAL SHEETS
HAWAII	HAW.	1-H-1(22)-16	1977	173	181

DATE	BY	FINAL SURVEY	PLOTTED	NOTED	AREAS CHECKED

DATE	BY	ORIGINAL SURVEY	PLOTTED	NOTED	AREAS CHECKED

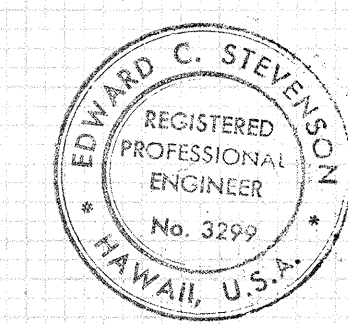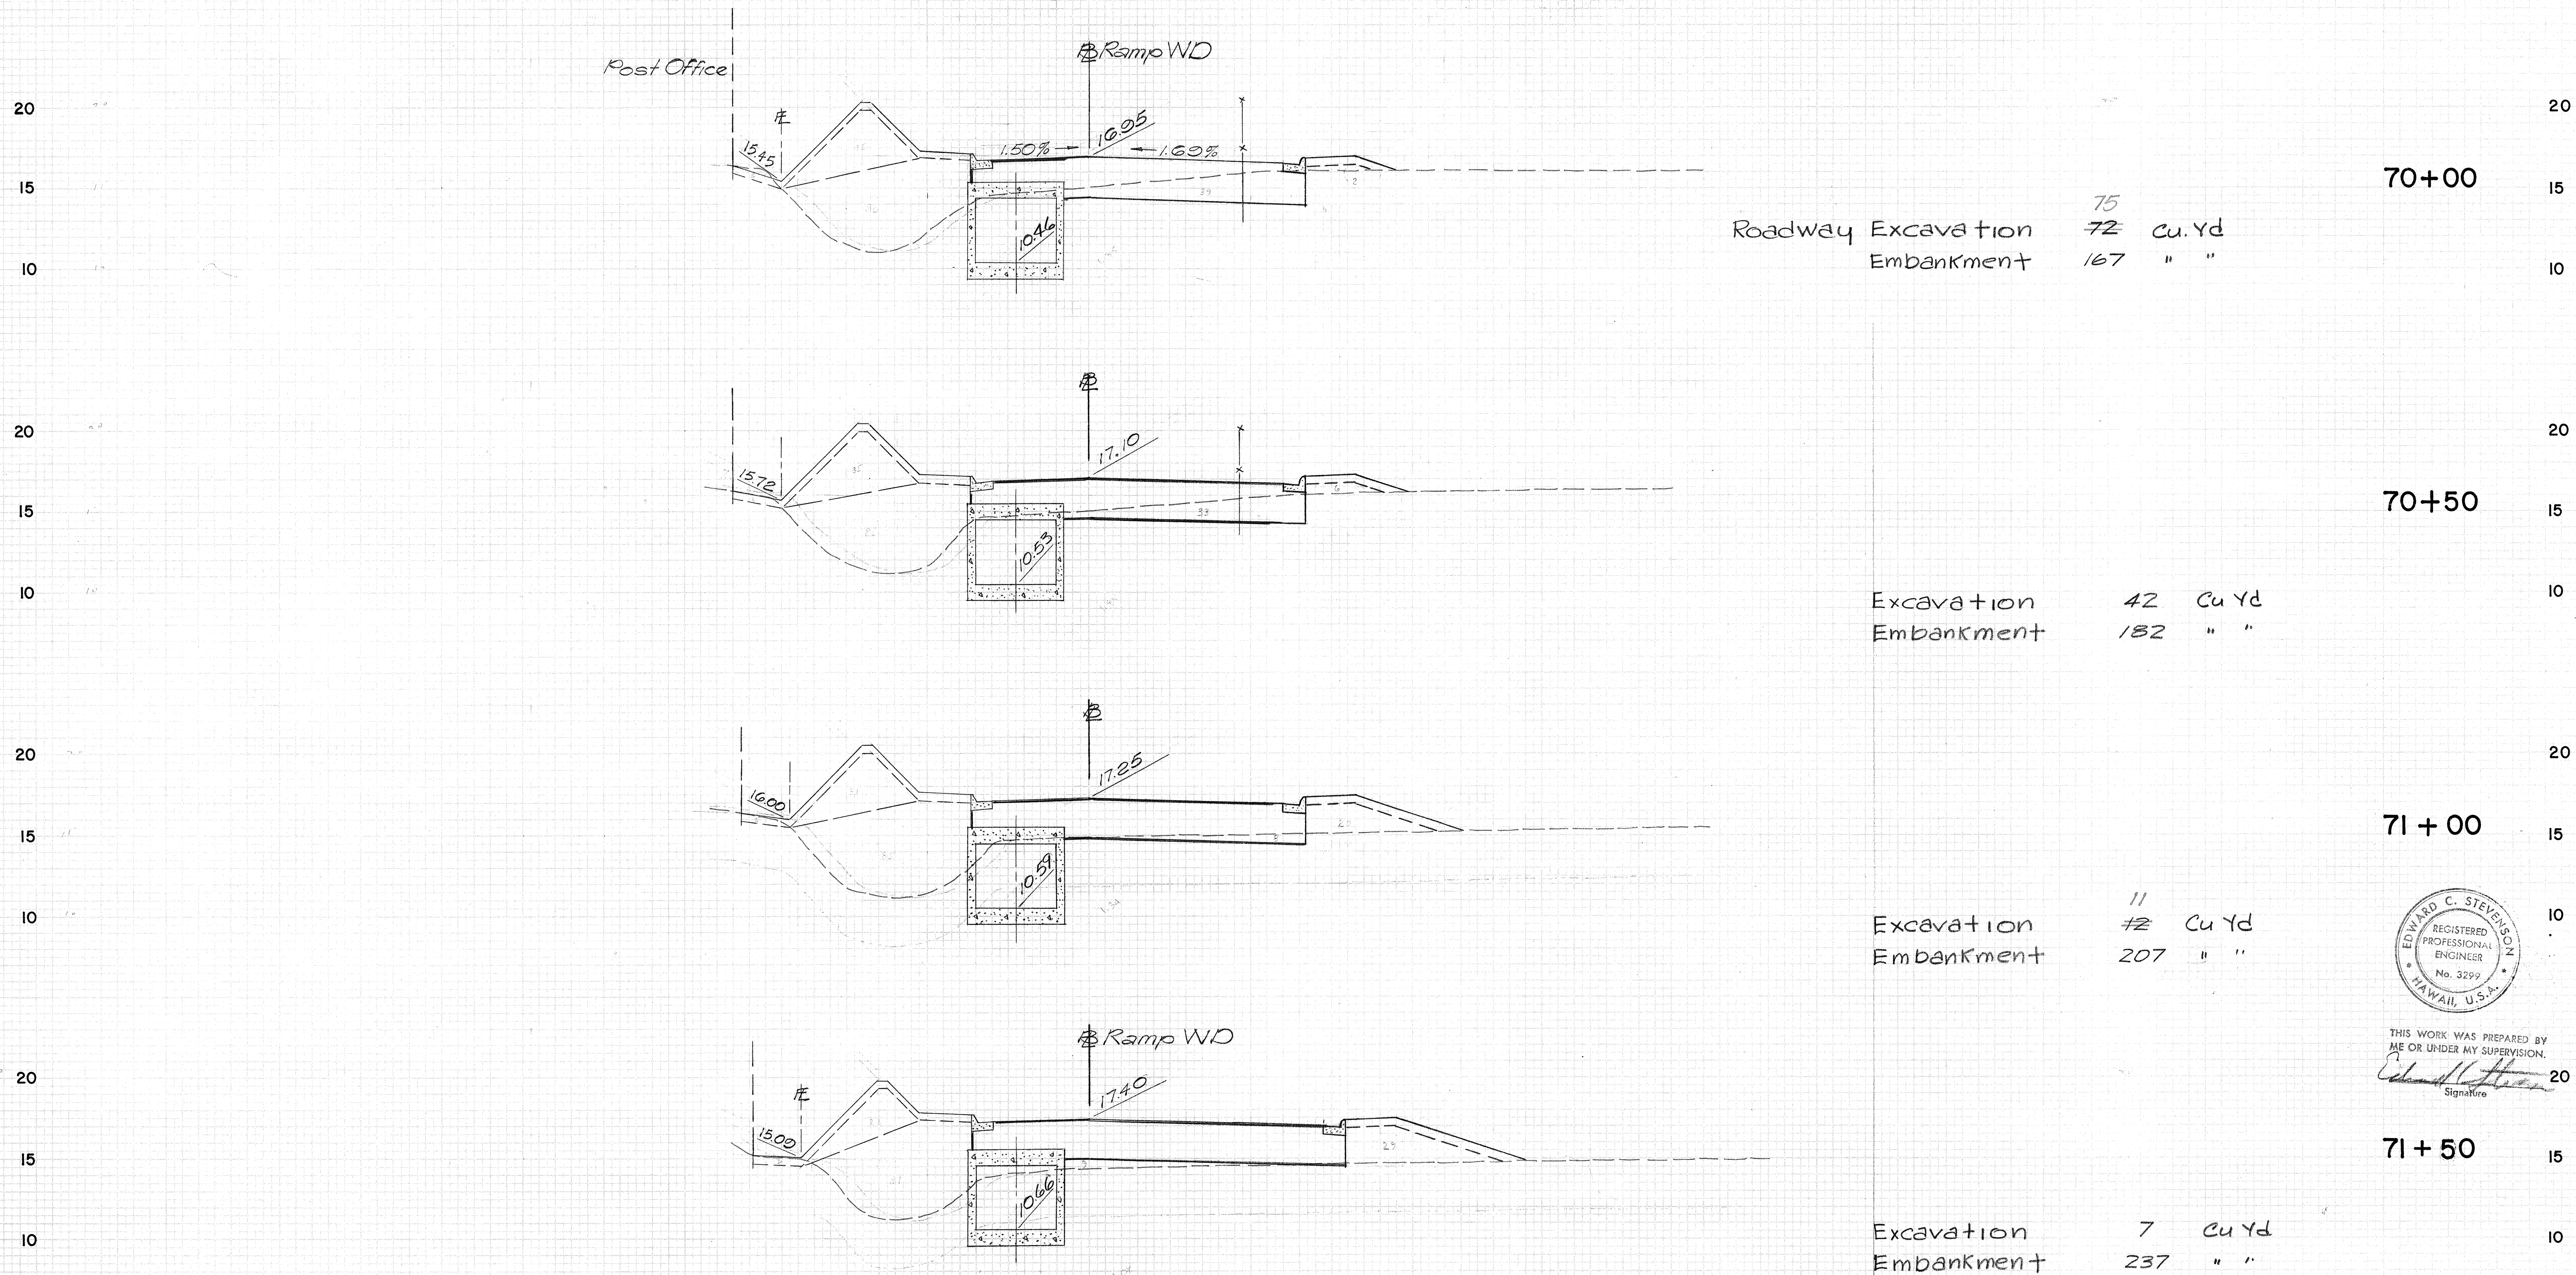

THIS WORK WAS PREPARED BY
ME OR UNDER MY SUPERVISION.
Edward C. Stevenson
Signature

HORIZ. 1 INCH = 10 FEET
VERT. 1 INCH = 5 FEET

RAMP WD




RAMP WD

FED. ROAD DIST. NO.	STATE	FED. AID PROJ. NO.	FISCAL YEAR	SHEET NO.	TOTAL SHEETS
HAWAII	HAW.	I-HI-11(122)-16	1977	175	181

DATE	BY	REVIEWED	DATE	BY	REVIEWED
NO.	NO.	NO.	NO.	NO.	NO.

DATE	BY	REVIEWED	DATE	BY	REVIEWED
NO.	NO.	NO.	NO.	NO.	NO.

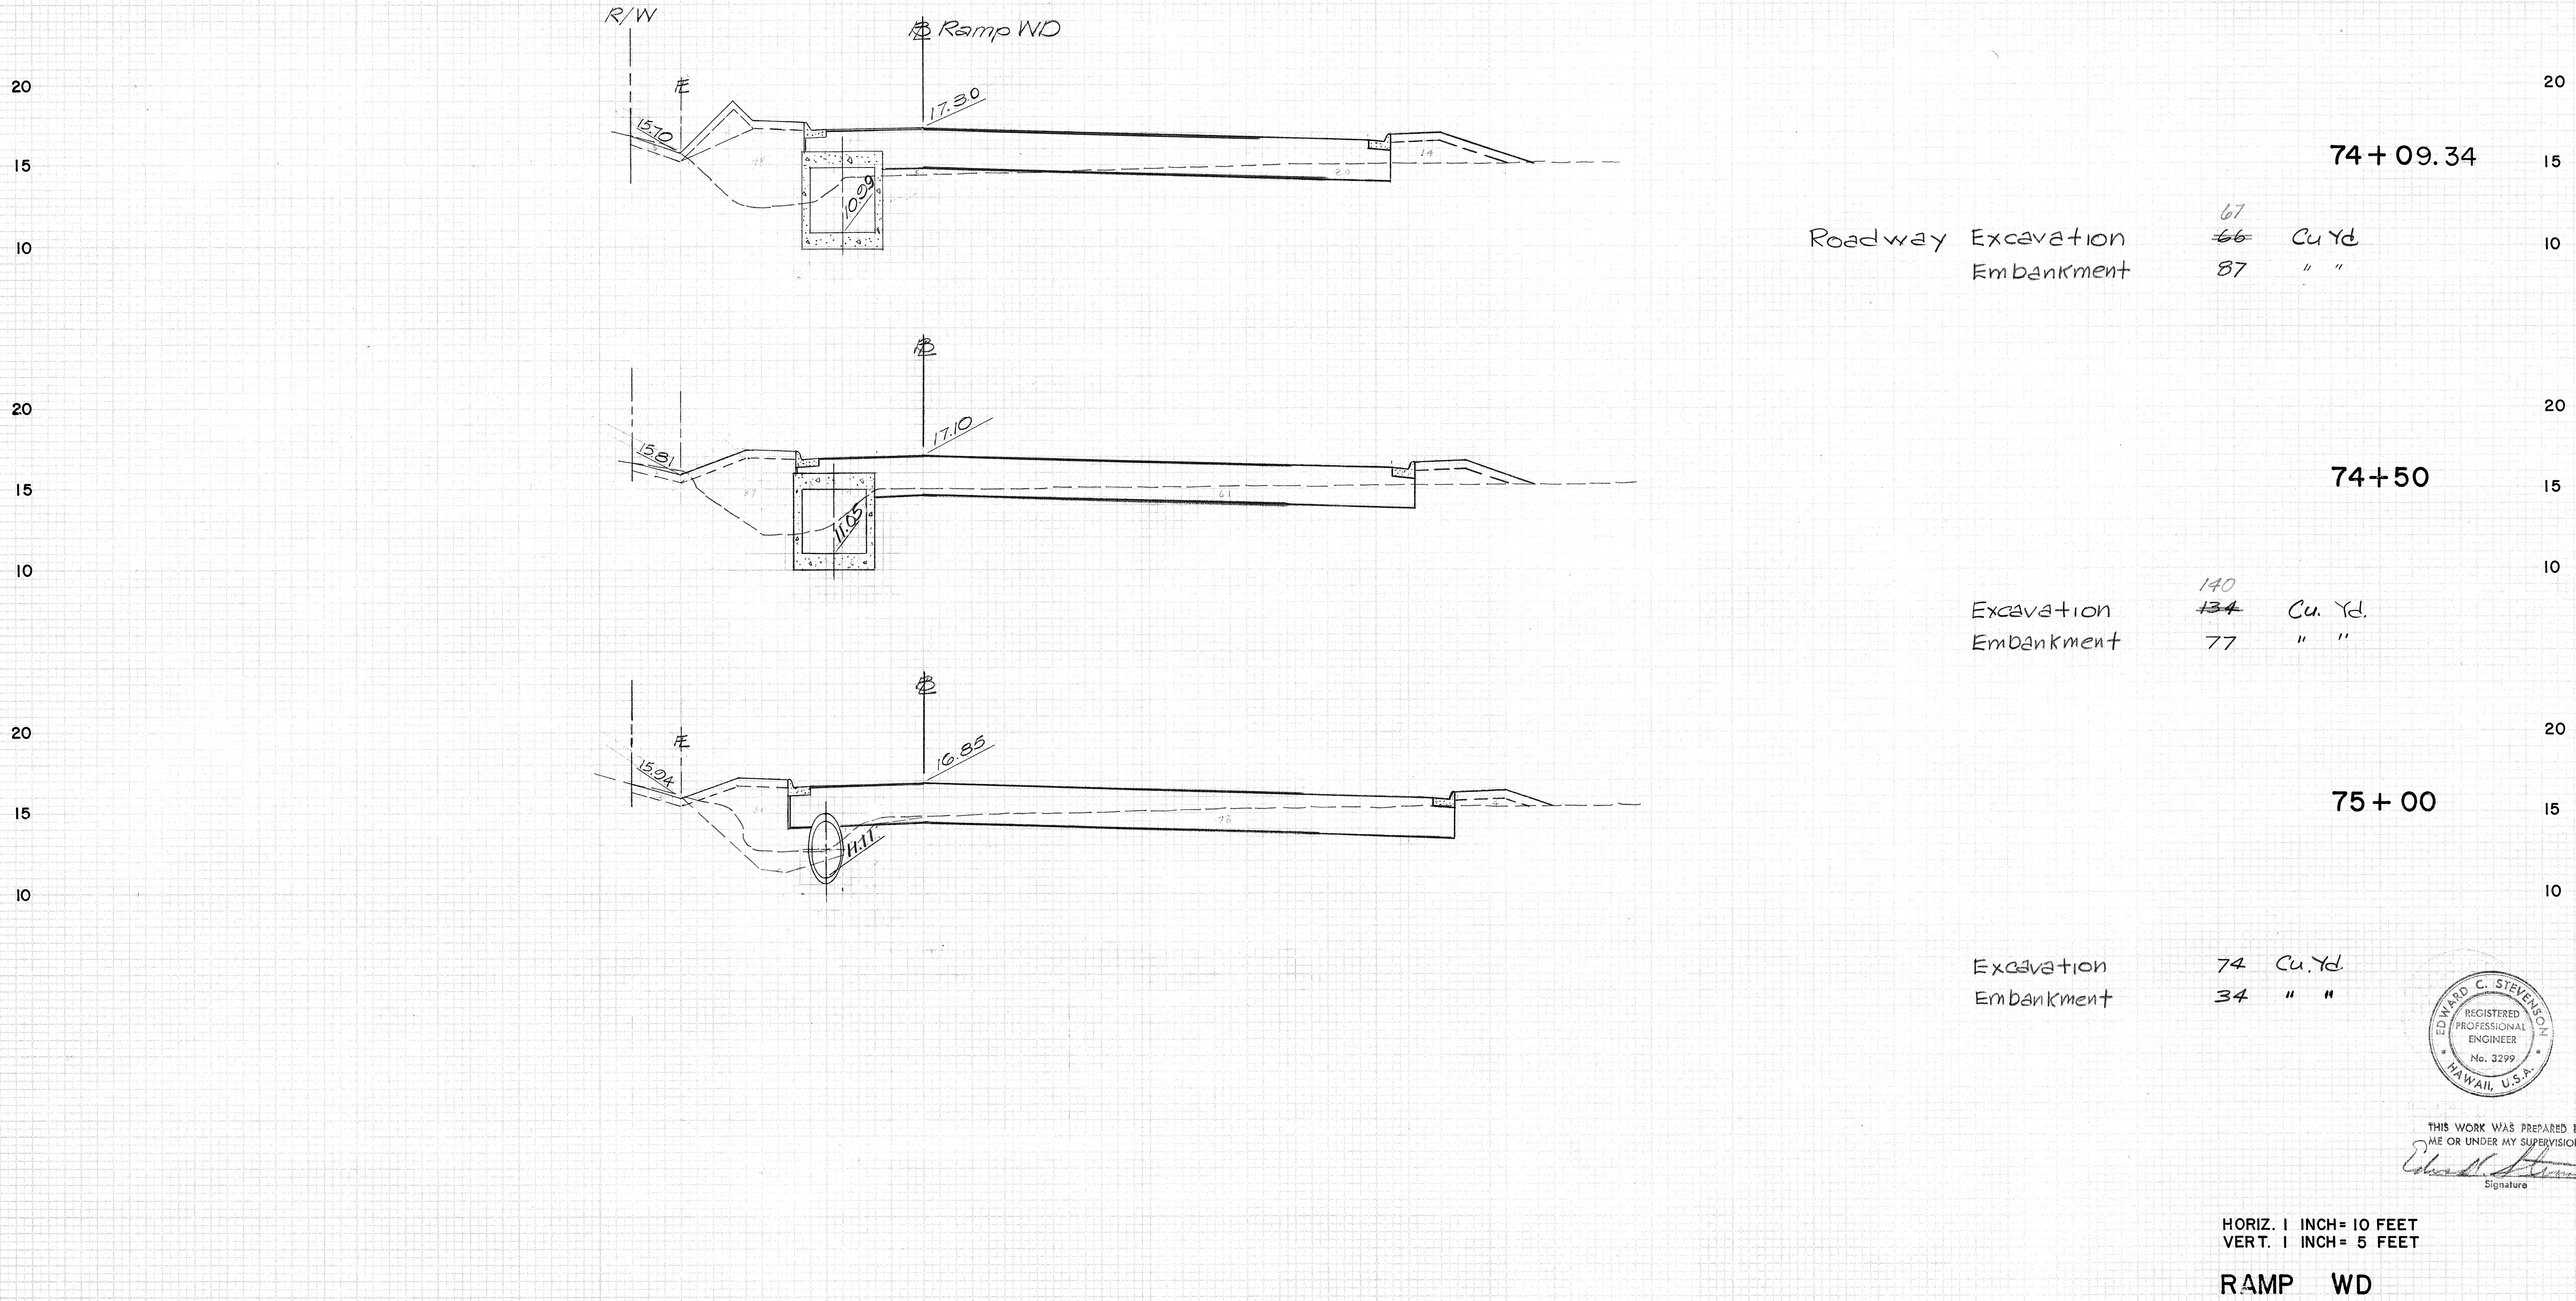


THIS WORK WAS PREPARED BY
ME OR UNDER MY SUPERVISION.
[Signature]
Signature

HORIZ. 1 INCH = 10 FEET
VERT. 1 INCH = 5 FEET


RAMP WD

FED. ROAD DIST. NO.	STATE	FED. AID PROJ. NO.	FISCAL YEAR	SHEET NO.	TOTAL SHEETS
HAWAII	HAW.	1-H1-1(122)116	1977	176	181

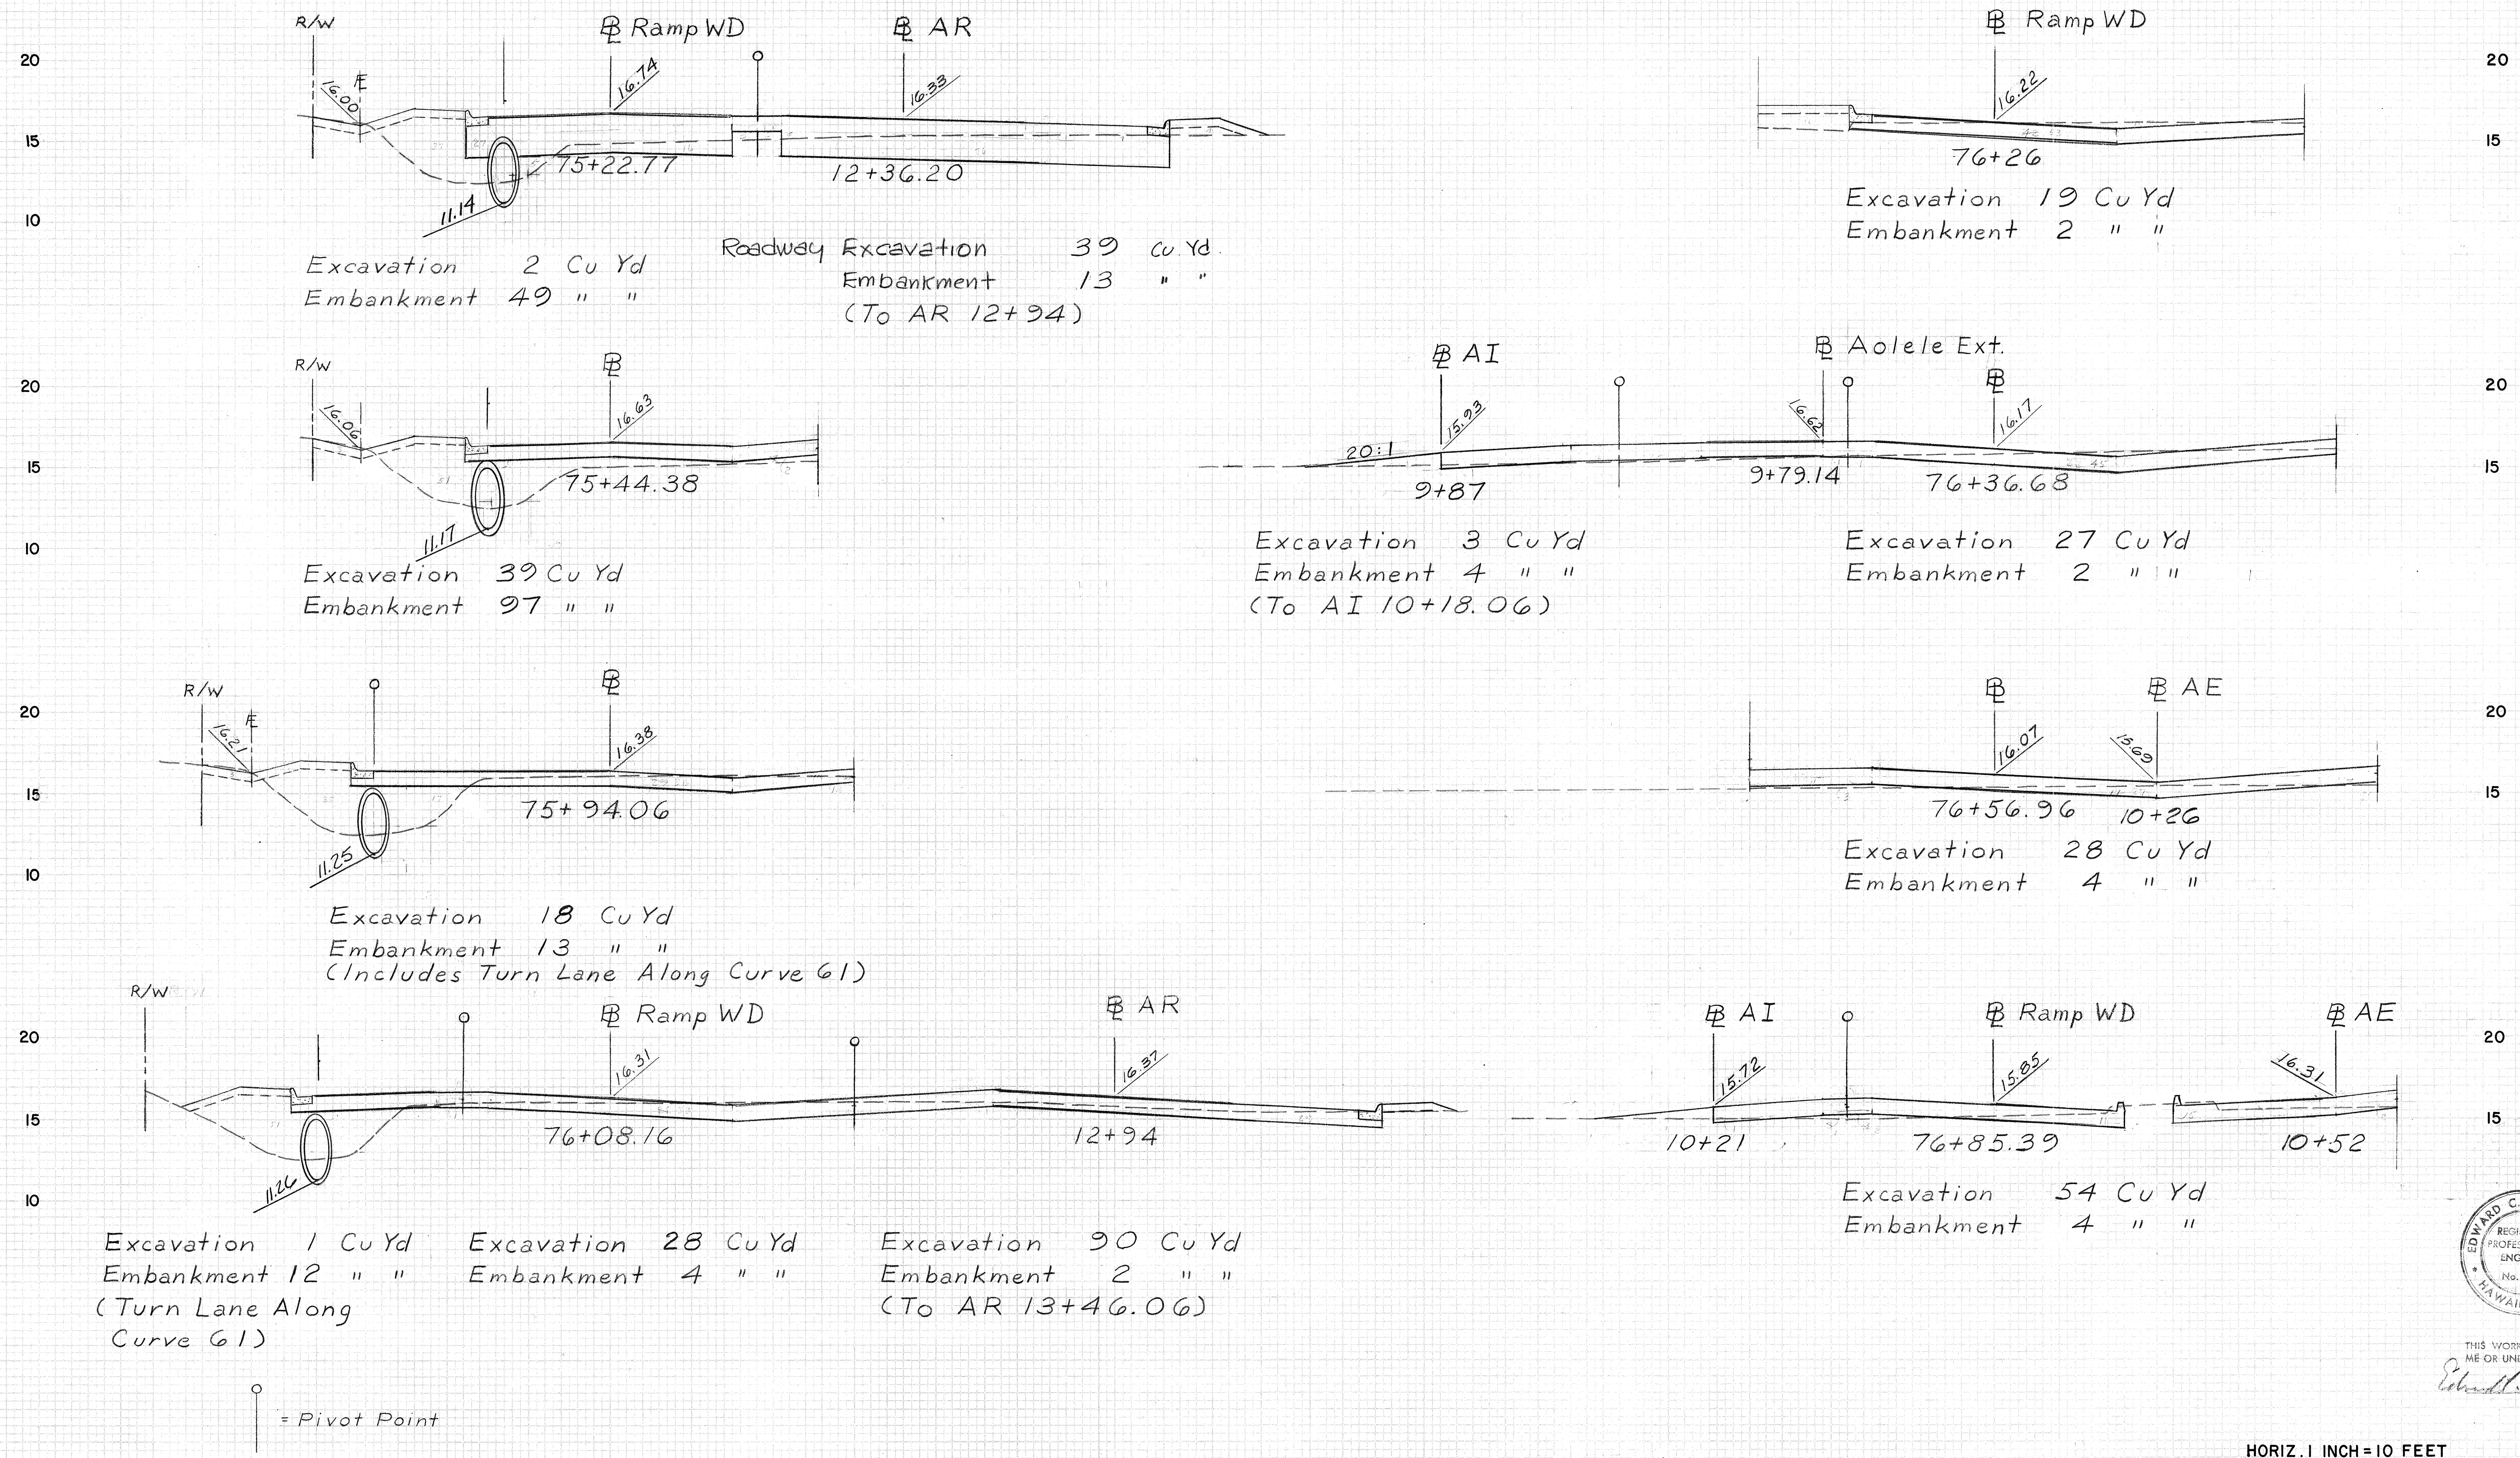


HORIZ. 1 INCH = 10 FEET
VERT. 1 INCH = 5 FEET

NO.	DATE	REVISION
1	4-28-78	Sections and Quantities Revised to reflect Deletion of Curb & Gutter from Traffic Islands

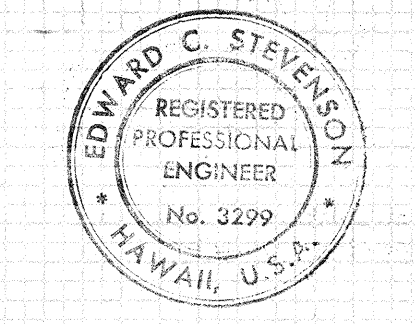


THIS WORK WAS PREPARED BY ME OR UNDER MY SUPERVISION.
Edward C. Stevenson
Signature


FED. ROAD DIST. NO.	STATE	FED. AID PROJ. NO.	FISCAL YEAR	SHEET NO.	TOTAL SHEETS
HAWAII	HAW.	I-HI-1(122)116	1977	177	181

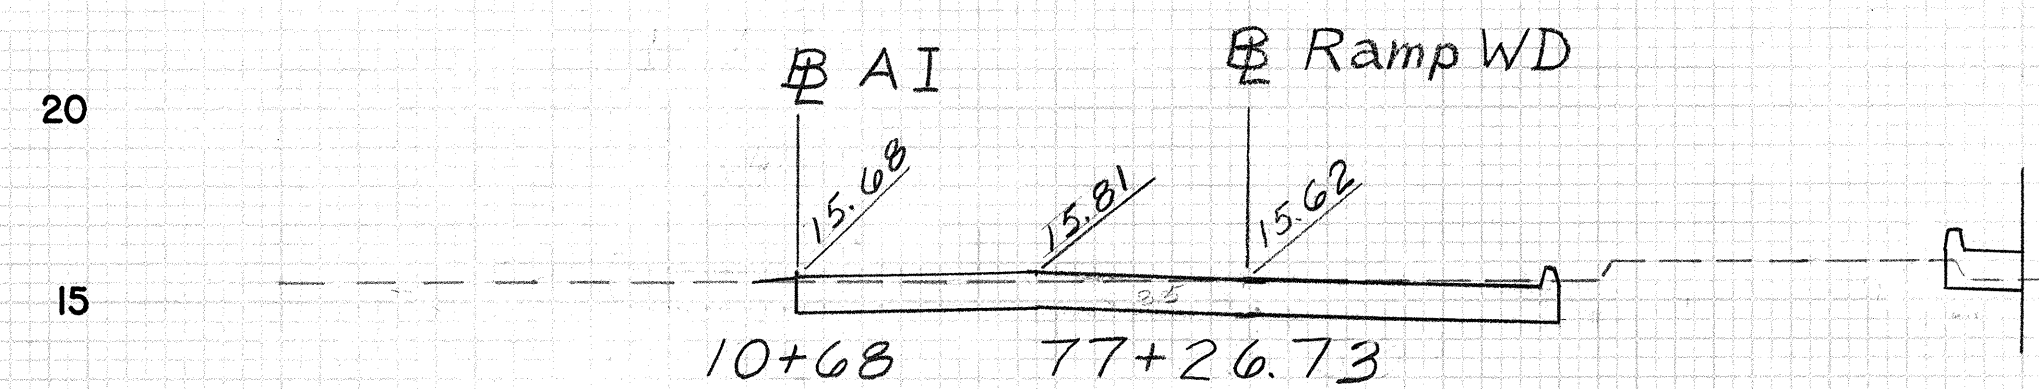

Excavation 60 Cu Yd
Embankment 1 " "

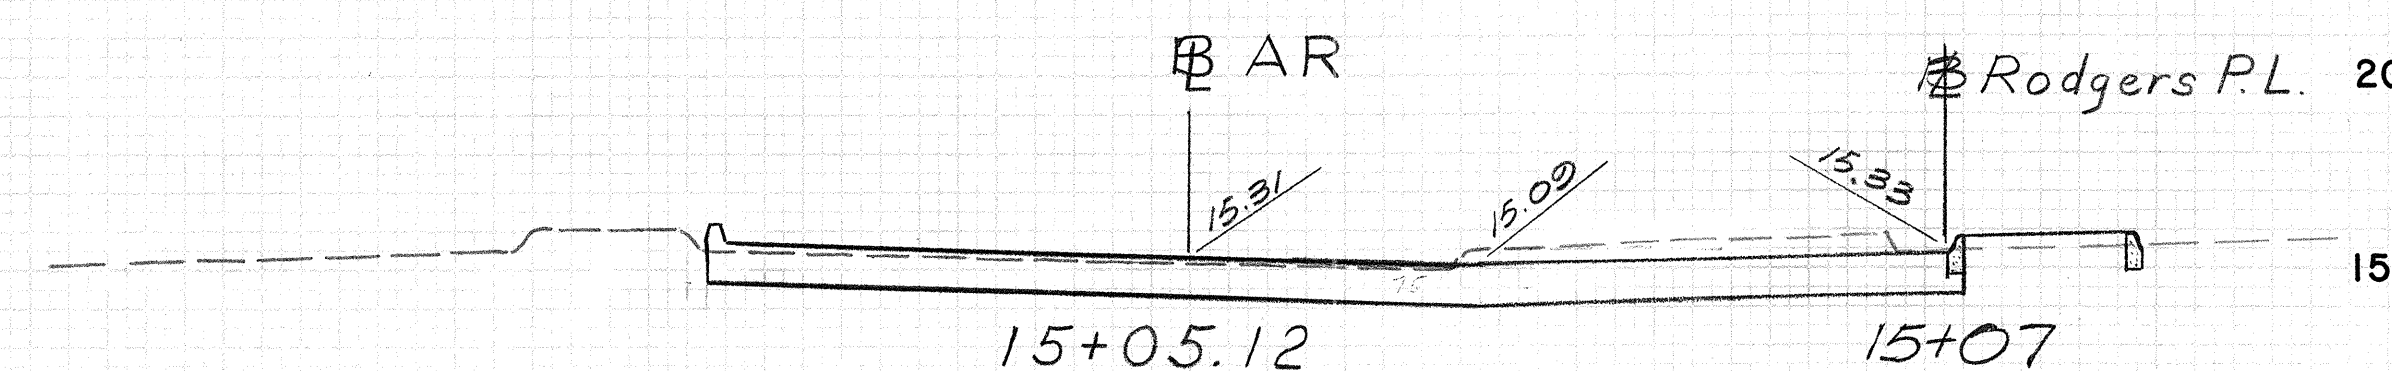


Excavation 72 Cu. Yd.
Embankment 0 " "
(To Rodgers P.L. B 15+50)

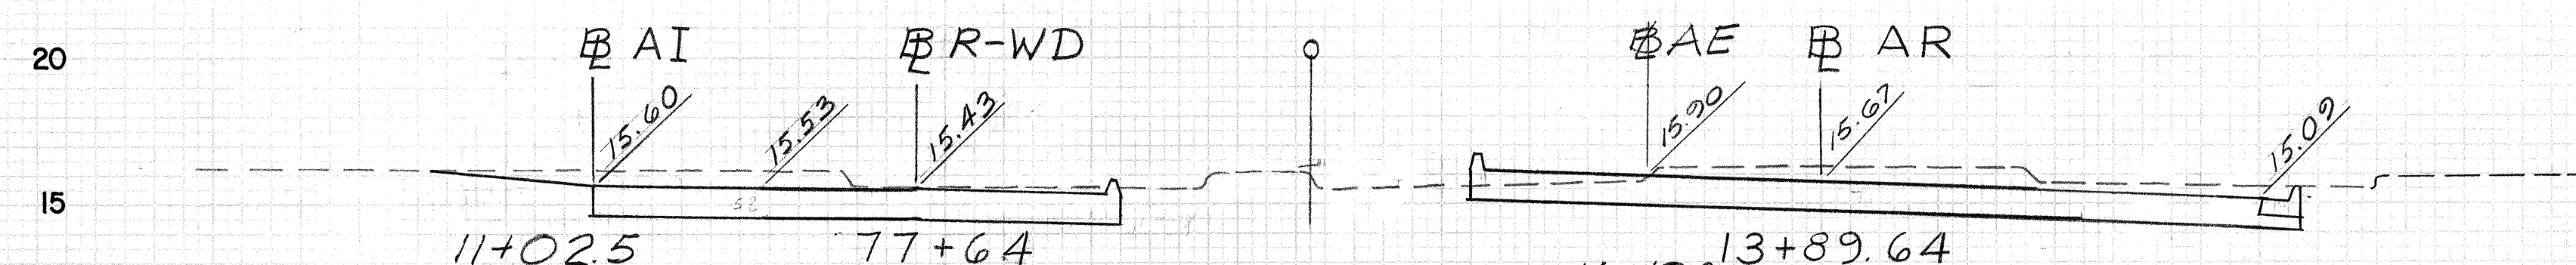


Excavation 64 Cu Yd
Embankment 1 " "

Excavation 103 Cu Yd
Embankment 3 " "

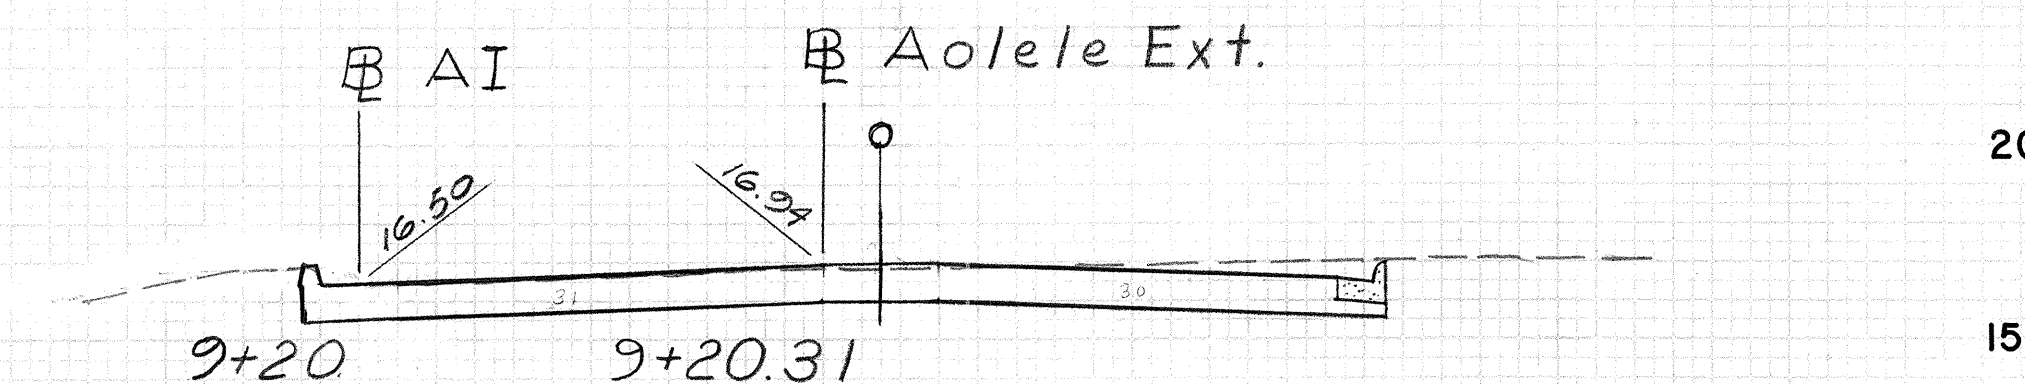


Excavation 21 Cu Yd
Embankment 0 " "

Excavation 13 Cu Yd
Embankment 1 " "

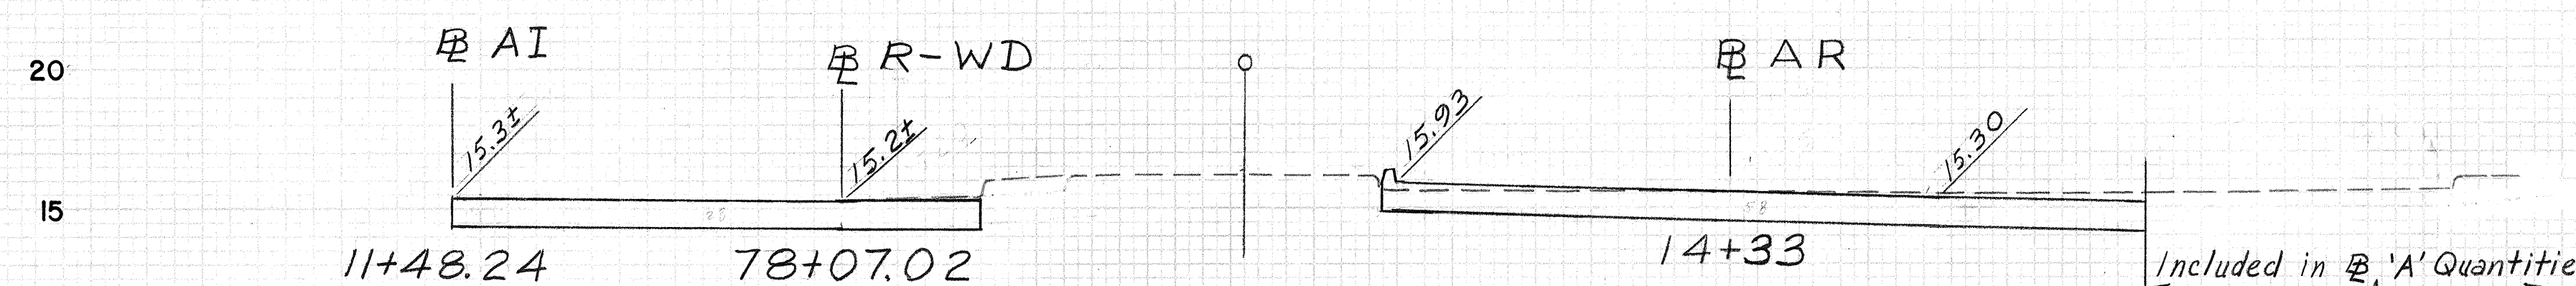


Excavation 177 Cu Yd.
Embankment 0 " "
(To AR 15+05.12)

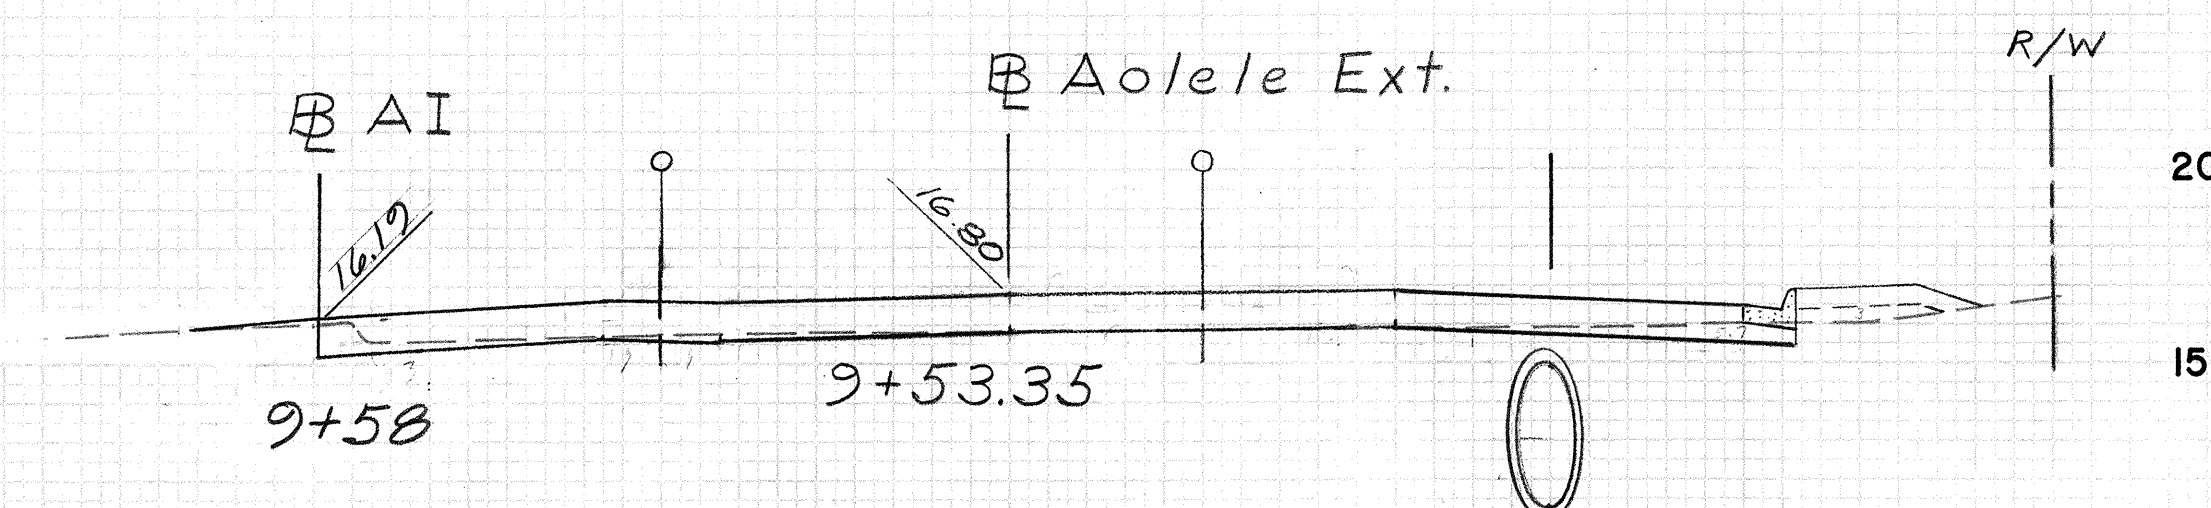


Excavation 7 Cu Yd
Embankment 1 " "
(To AI 9+83 and
AE 9+79.14)

Excavation 10 cu Yd
Embankment 0 " "
(Turn Lane Along Curve 61)

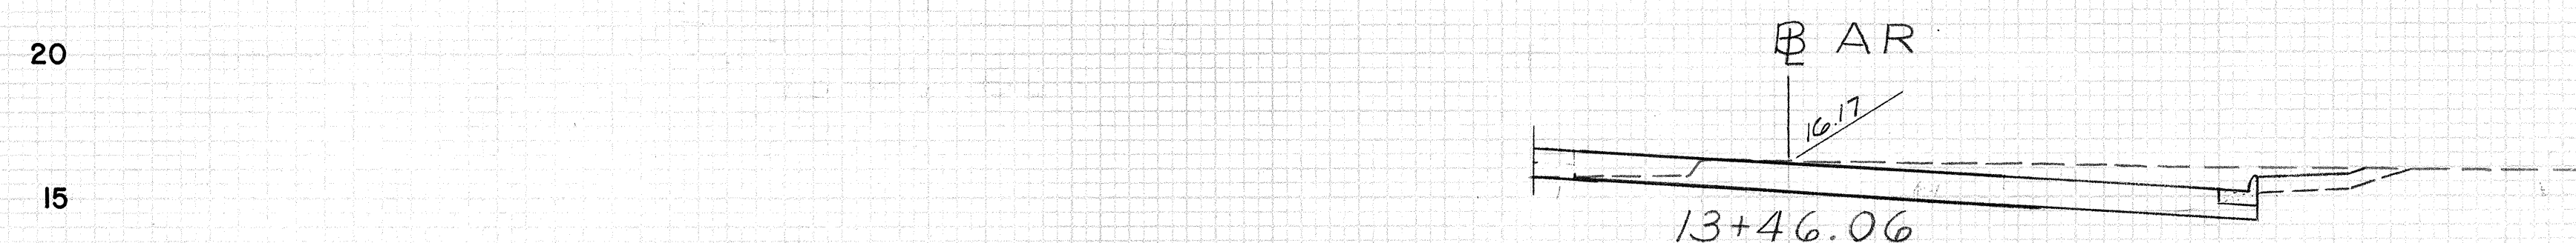

Excavation 111 Cu Yd
Embankment 4 " "
(To AR 13+89.64)

○ = Pivot Point

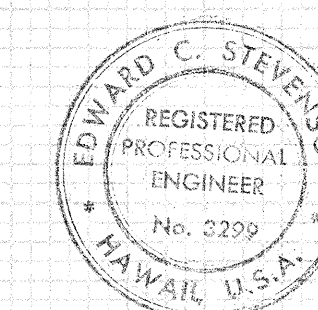



THIS WORK WAS PREPARED BY
ME OR UNDER MY SUPERVISION.
Edward C. Stevenson
Signature

HORIZ. 1 INCH = 10 FEET
VERT. 1 INCH = 5 FEET

NO.	DATE	REVISION
1	4-28-78	Sections & Quantities revised to reflect Deletion of Curb & Gutter from Traffic Islands

CO177


FED. ROAD DIST. NO.	STATE	FED. AID PROJ. NO.	FISCAL YEAR	SHEET NO.	TOTAL SHEETS
HAWAII	HAW.	F-HI-1(122):16	1977	178	181

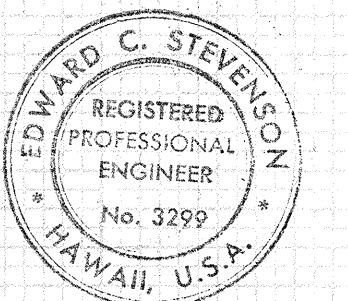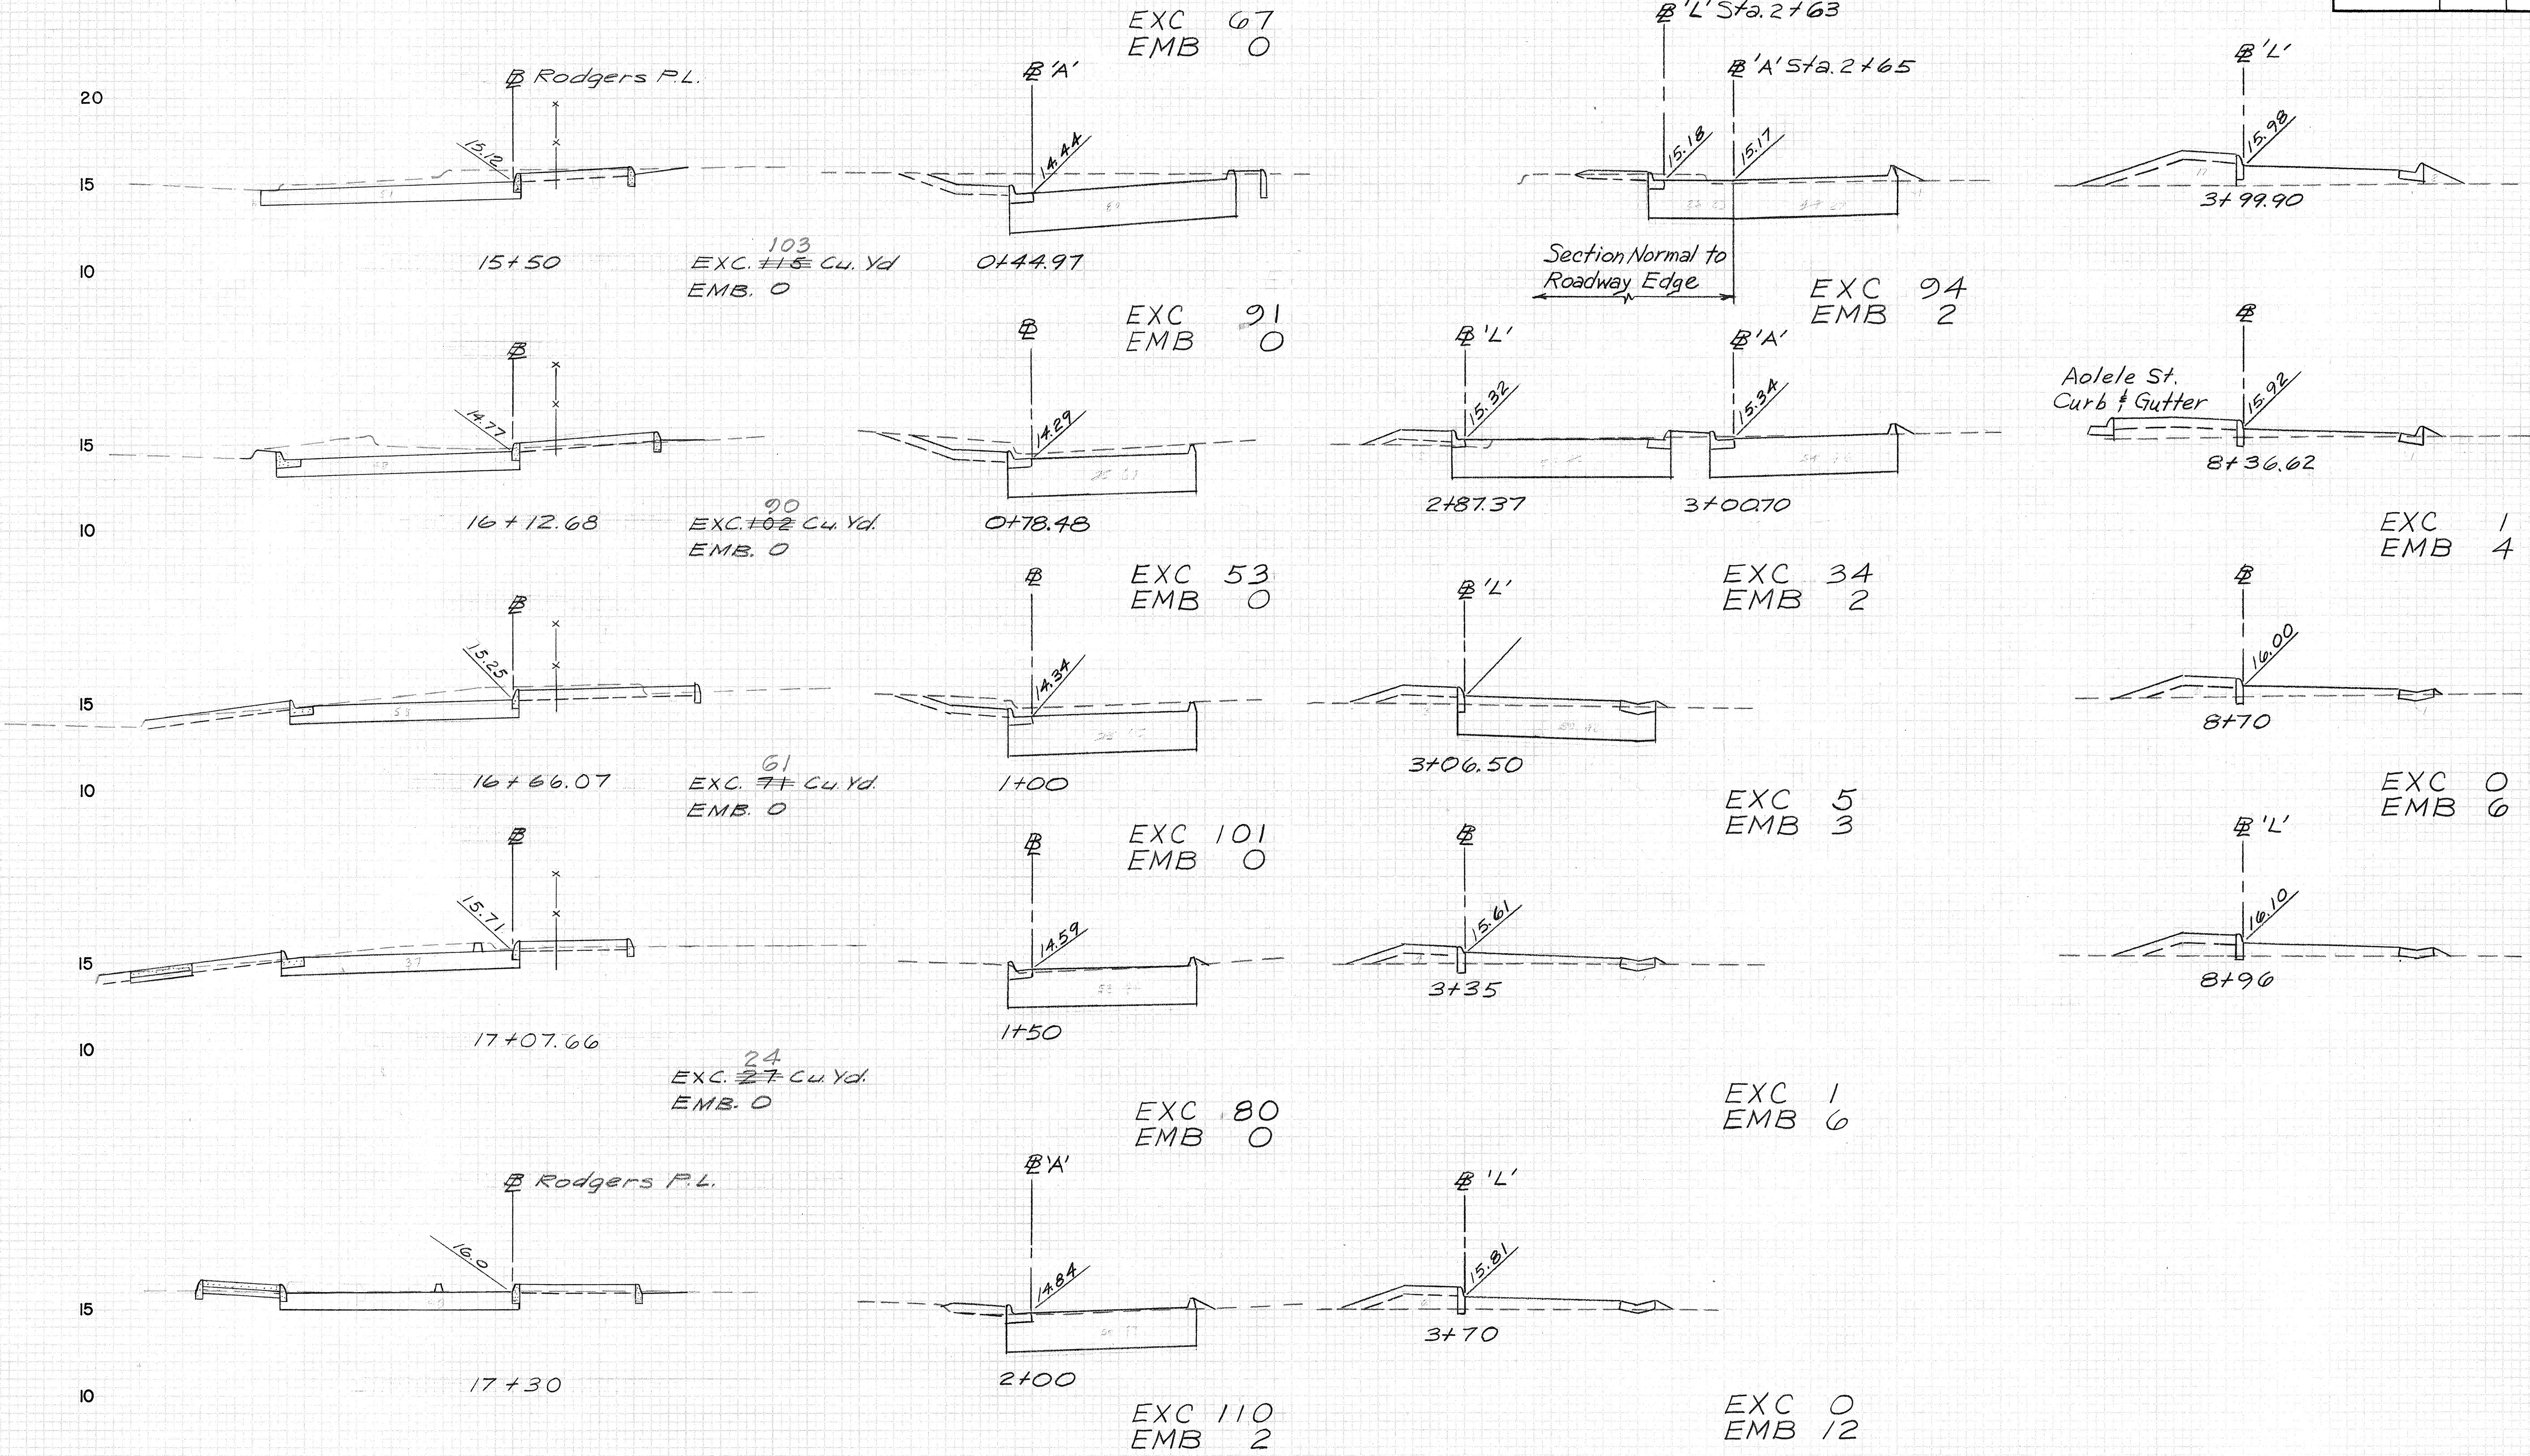


THIS WORK WAS PREPARED BY
ME OR UNDER MY SUPERVISION.
Edward C. Stevenson
Signature

NO.	DATE	REVISION
2		Added Sections for B's 'A' & 'L'
1	10-11-77	New Sections at 16+66.07, 17+07.66, and 17+30

FED. ROAD DIST. NO.	STATE	FED. AID PROJ. NO.	FISCAL YEAR	SHEET NO.	TOTAL SHEETS
HAWAII	HAW.	IHI-1(122)14	1977	179	181

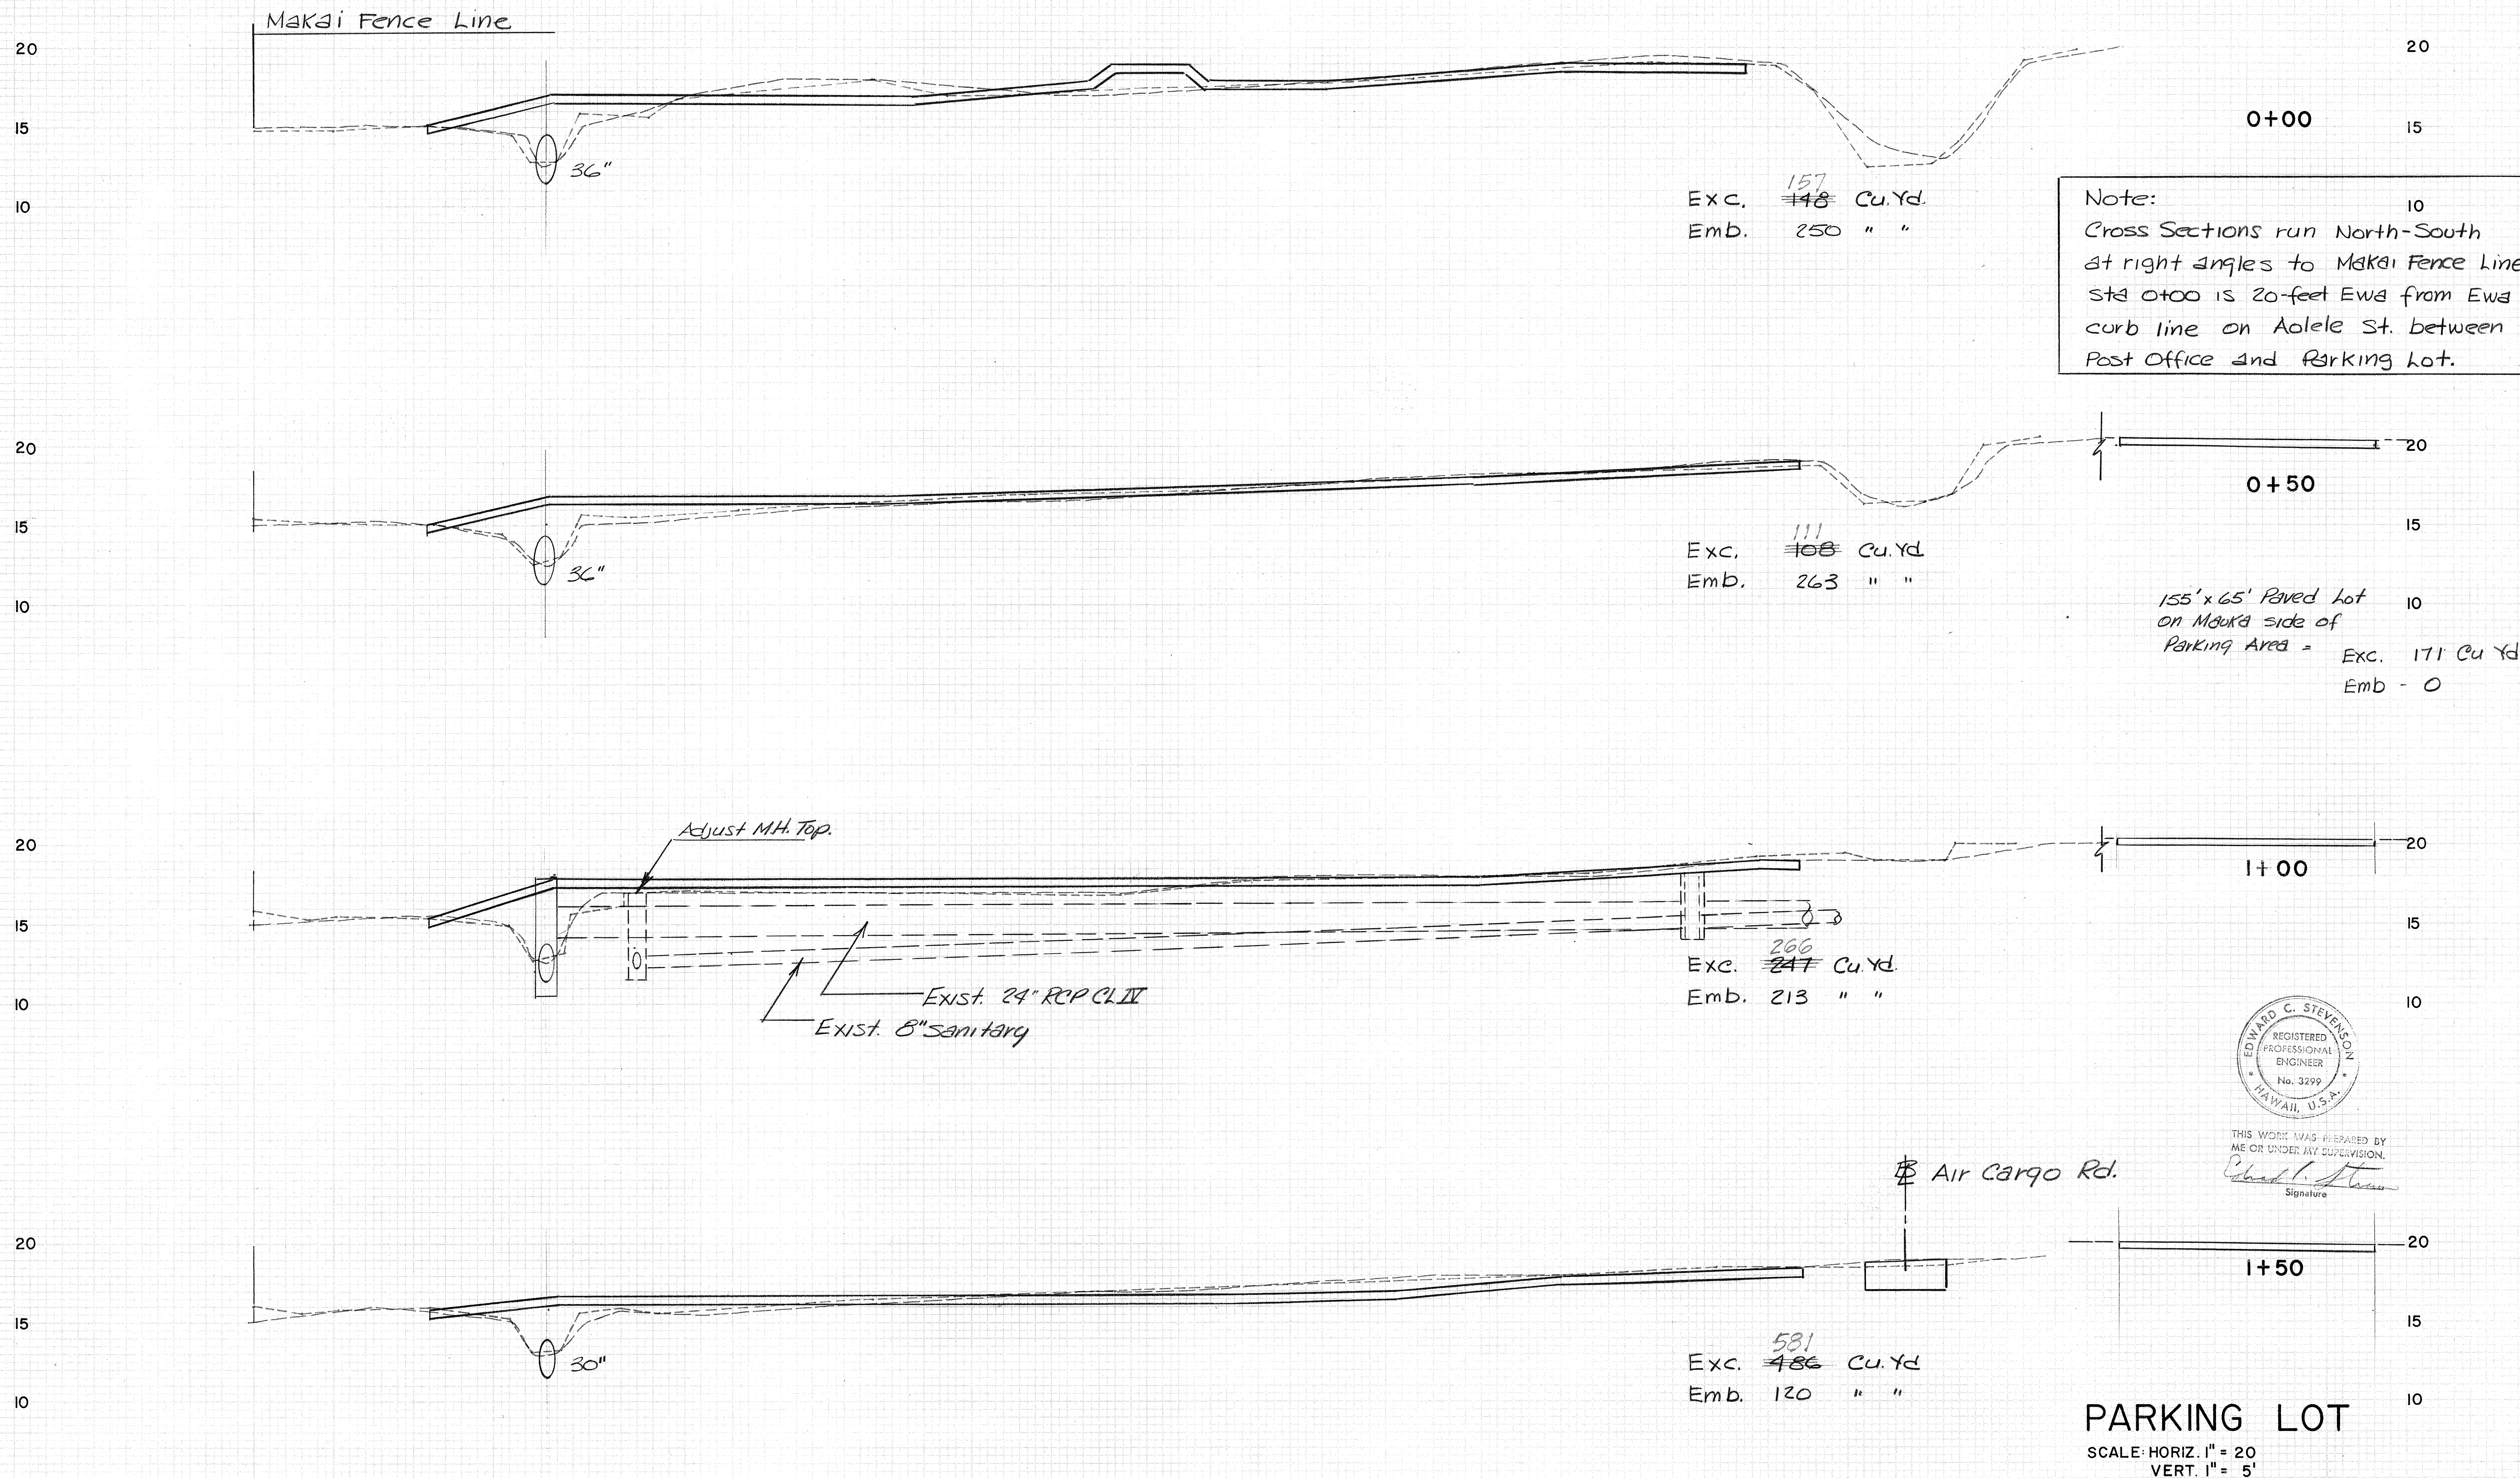

Note:
Cross Sections run North-South
at right angles to Makai Fence Line.
Sta 0+00 is 20-foot Ewa from Ewa
curb line on Aolele St. between
Post Office and Parking Lot.

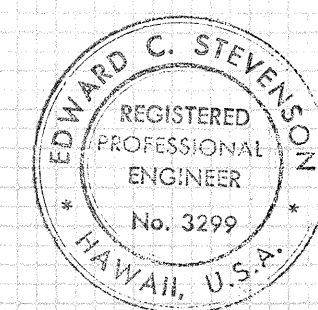



THIS WORK WAS PREPARED BY
ME OR UNDER MY SUPERVISION.
Edward C. Stevenson
Signature

PARKING LOT
SCALE: HORIZ. 1" = 20'
VERT. 1" = 5'

FED. ROAD DIST. NO.	STATE	FED. AID PROJ. NO.	FISCAL YEAR	SHEET NO.	TOTAL SHEETS
HAWAII	HAW.	I-HI-1(22)16	1977	180	181

FINAL SURVEY	DATE
BY	
NO.	






ORIGINAL SURVEY	DATE
BY	
NO.	

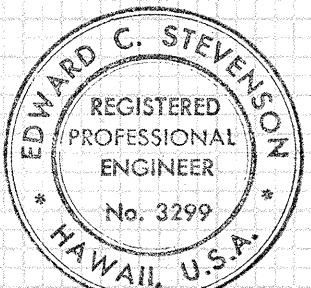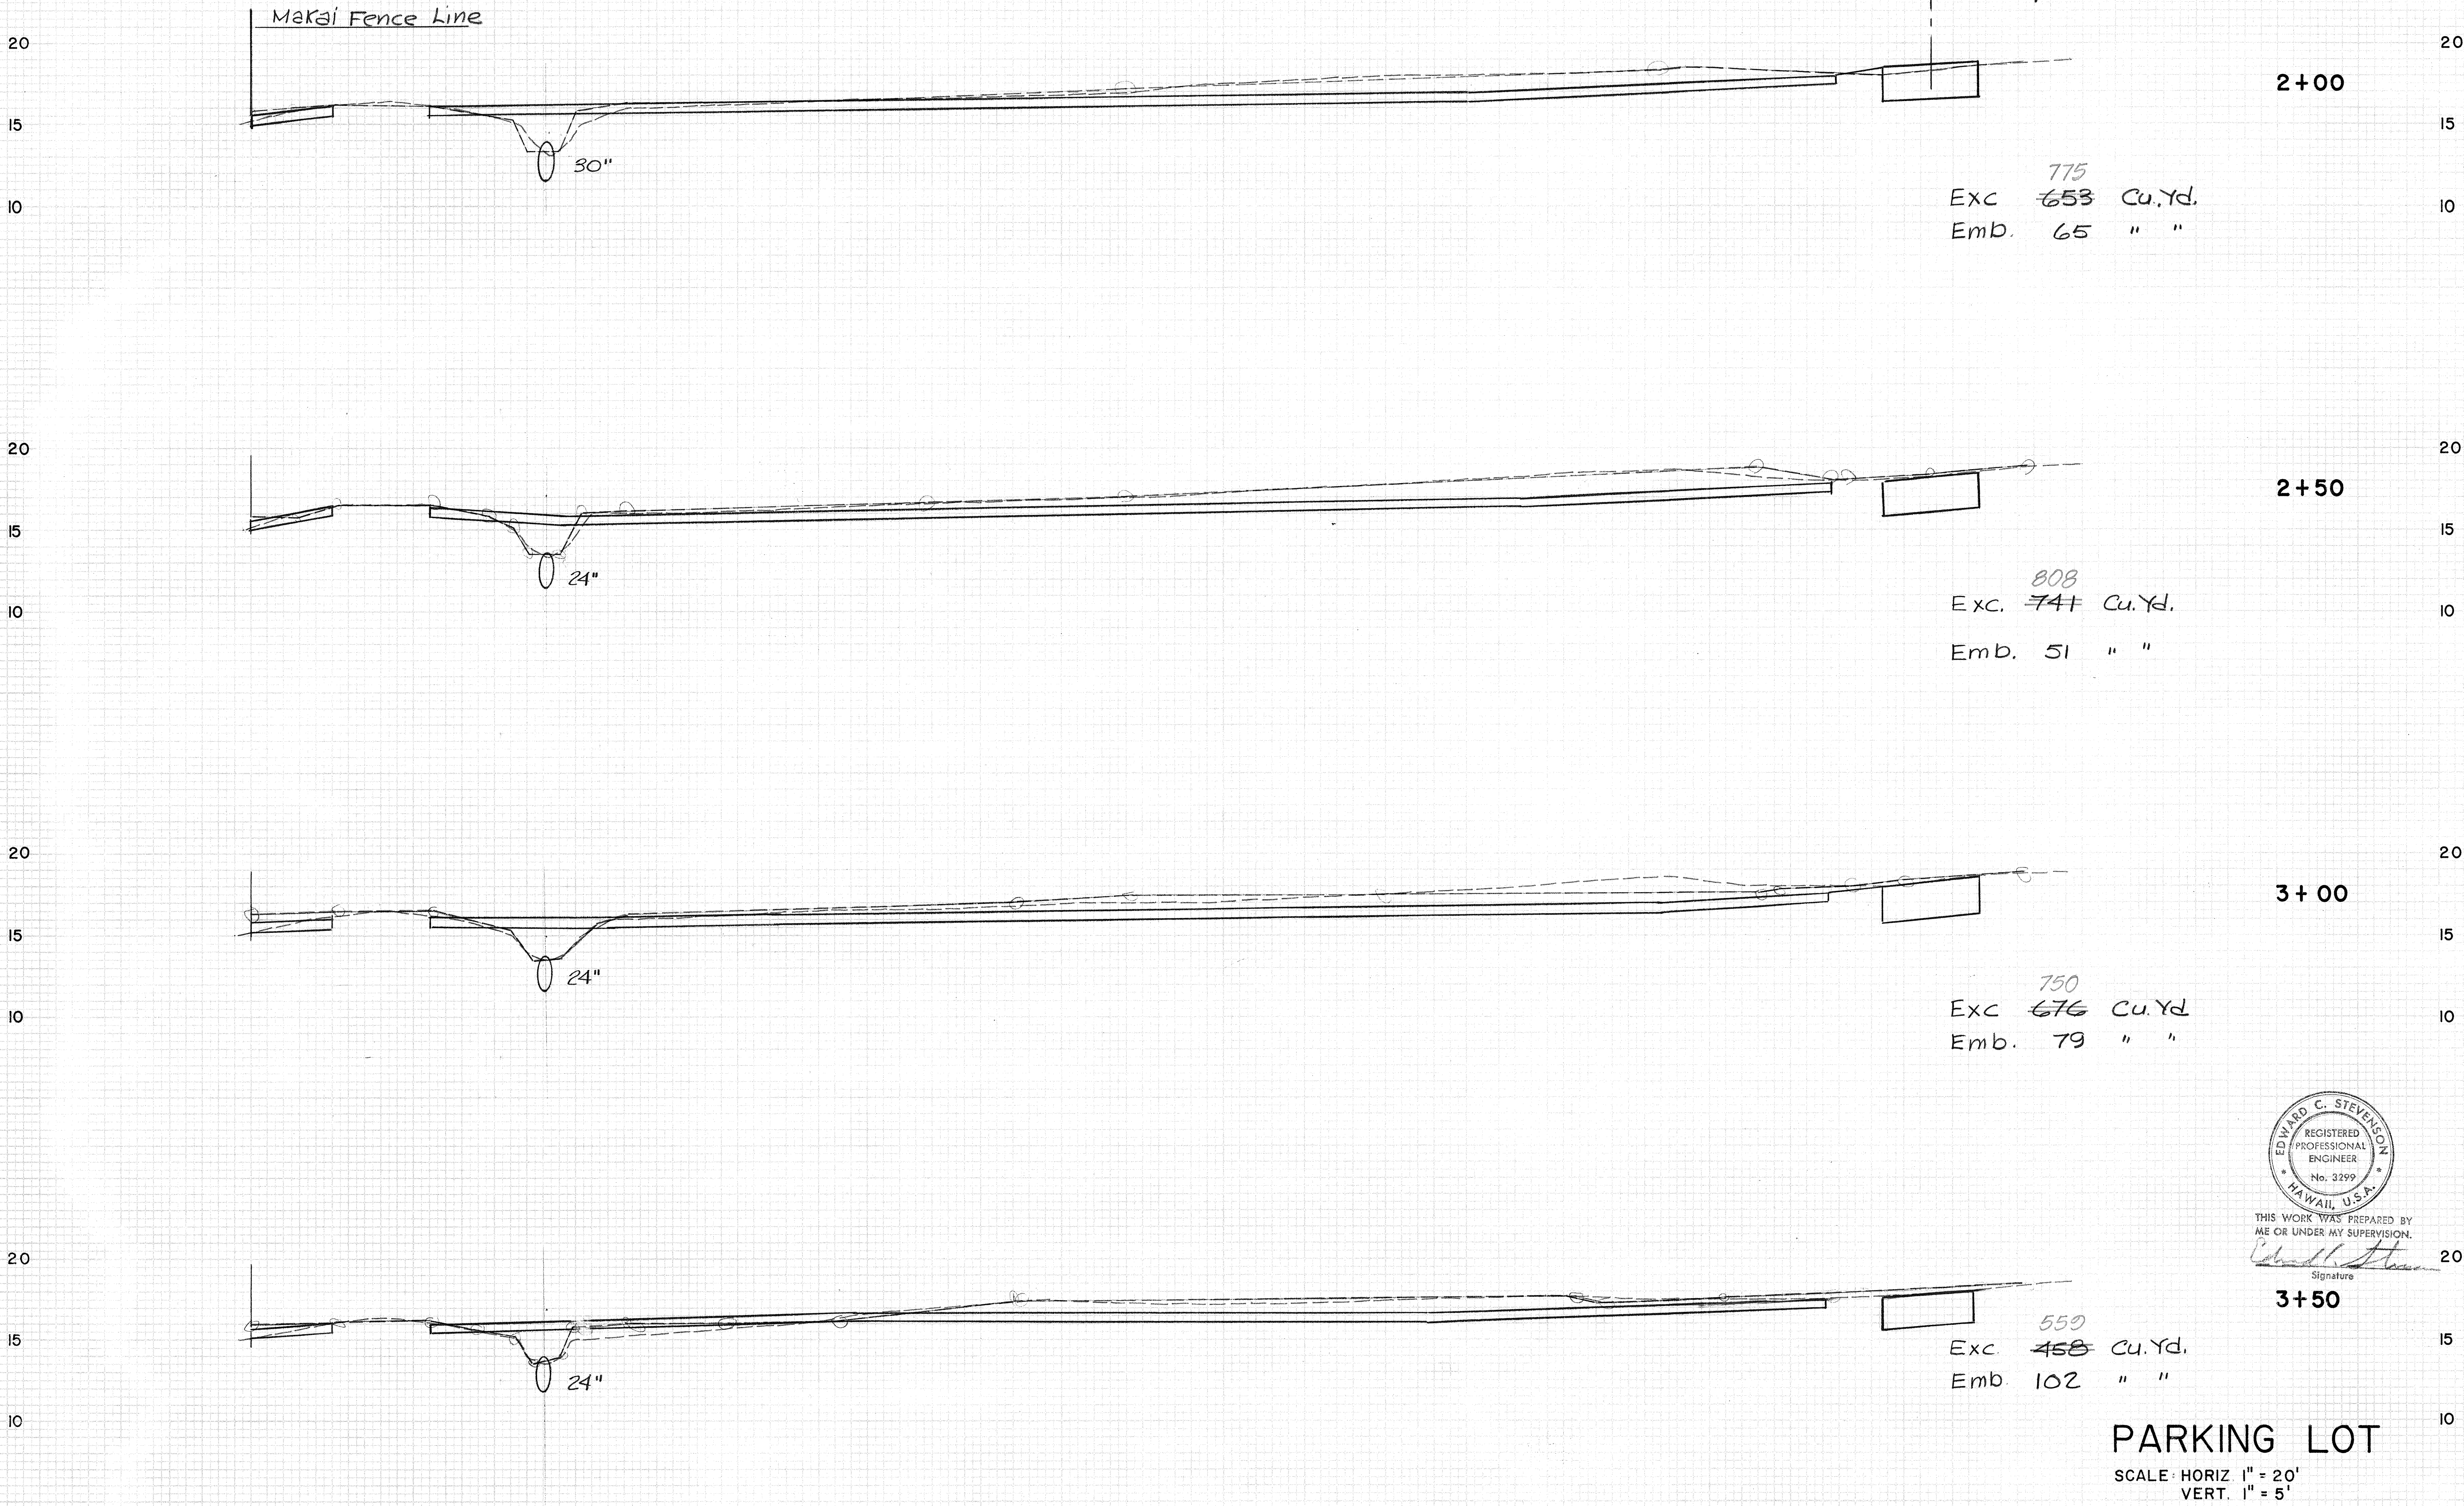

THIS WORK WAS PREPARED BY
ME OR UNDER MY SUPERVISION.

Signature

FED. ROAD DIST. NO.	STATE	FED. AID PROJ. NO.	FISCAL YEAR	SHEET NO.	TOTAL SHEETS
HAWAII	HAW.	IHI-1(122)16	1977	181	181

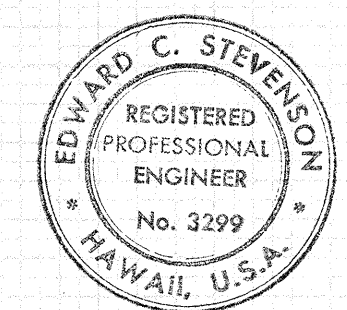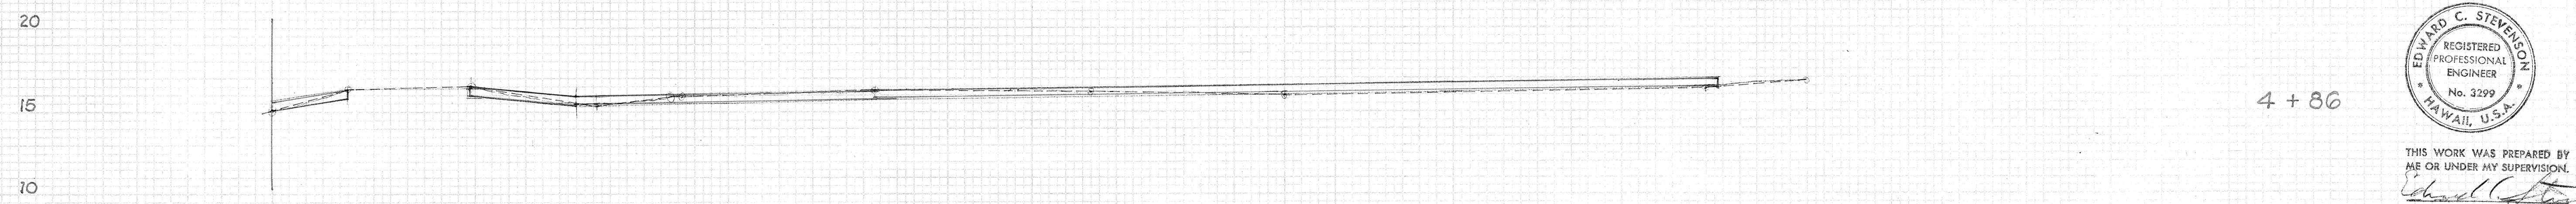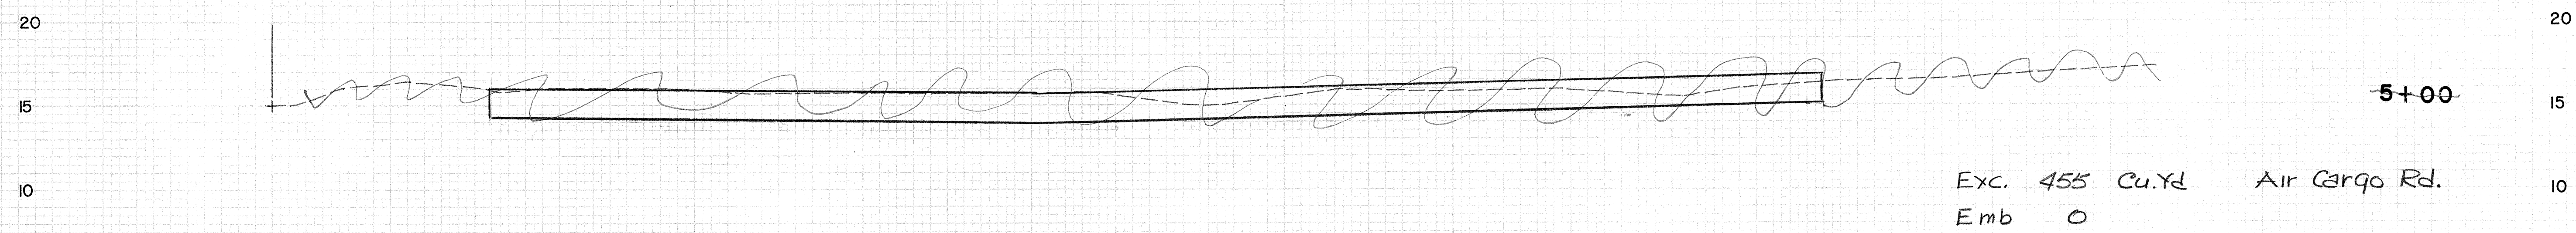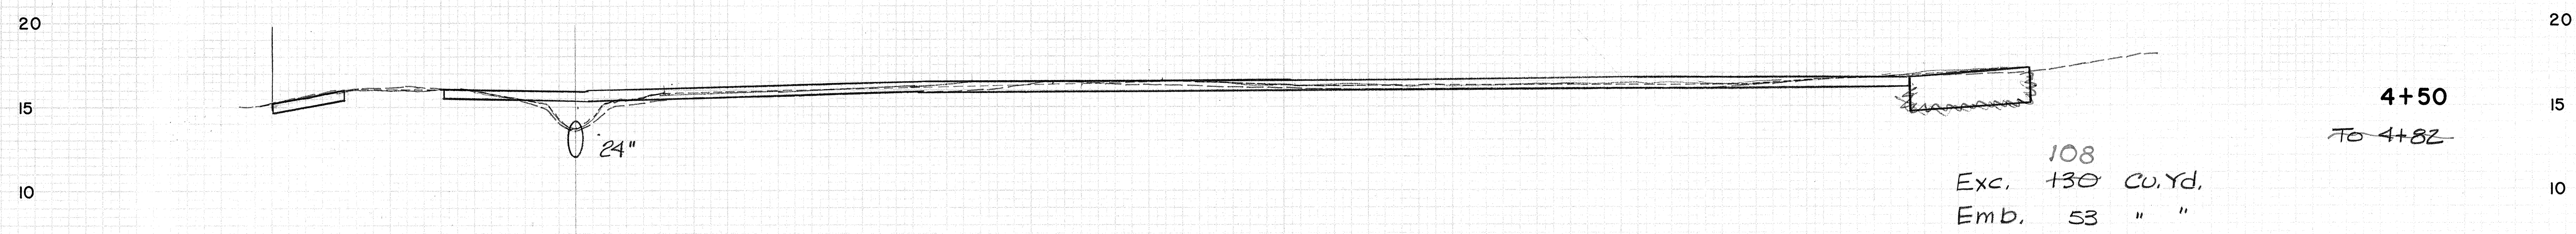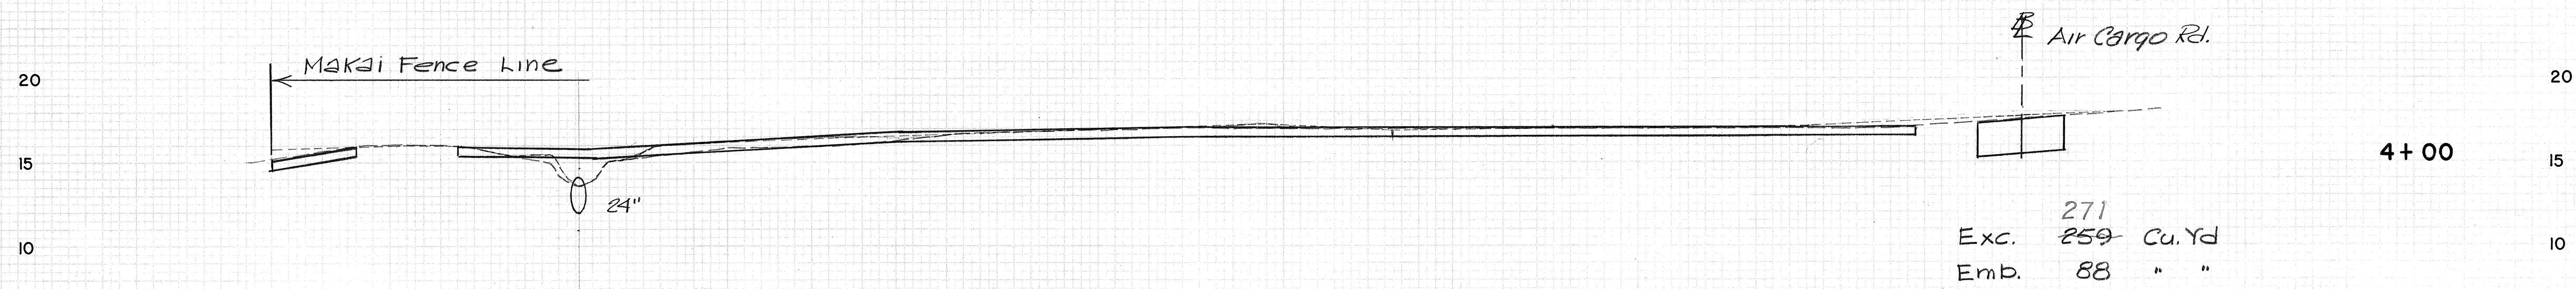

THIS WORK WAS PREPARED BY
ME OR UNDER MY SUPERVISION.
Signature