



FED. ROAD DIST. NO.	STATE	FED. AID PROJ. NO.	FISCAL YEAR	SHEET NO.	TOTAL SHEETS
HAWAII	HAW.	FHH(122)-16	1977	28	121

GUARD RAIL, TYPE 4E

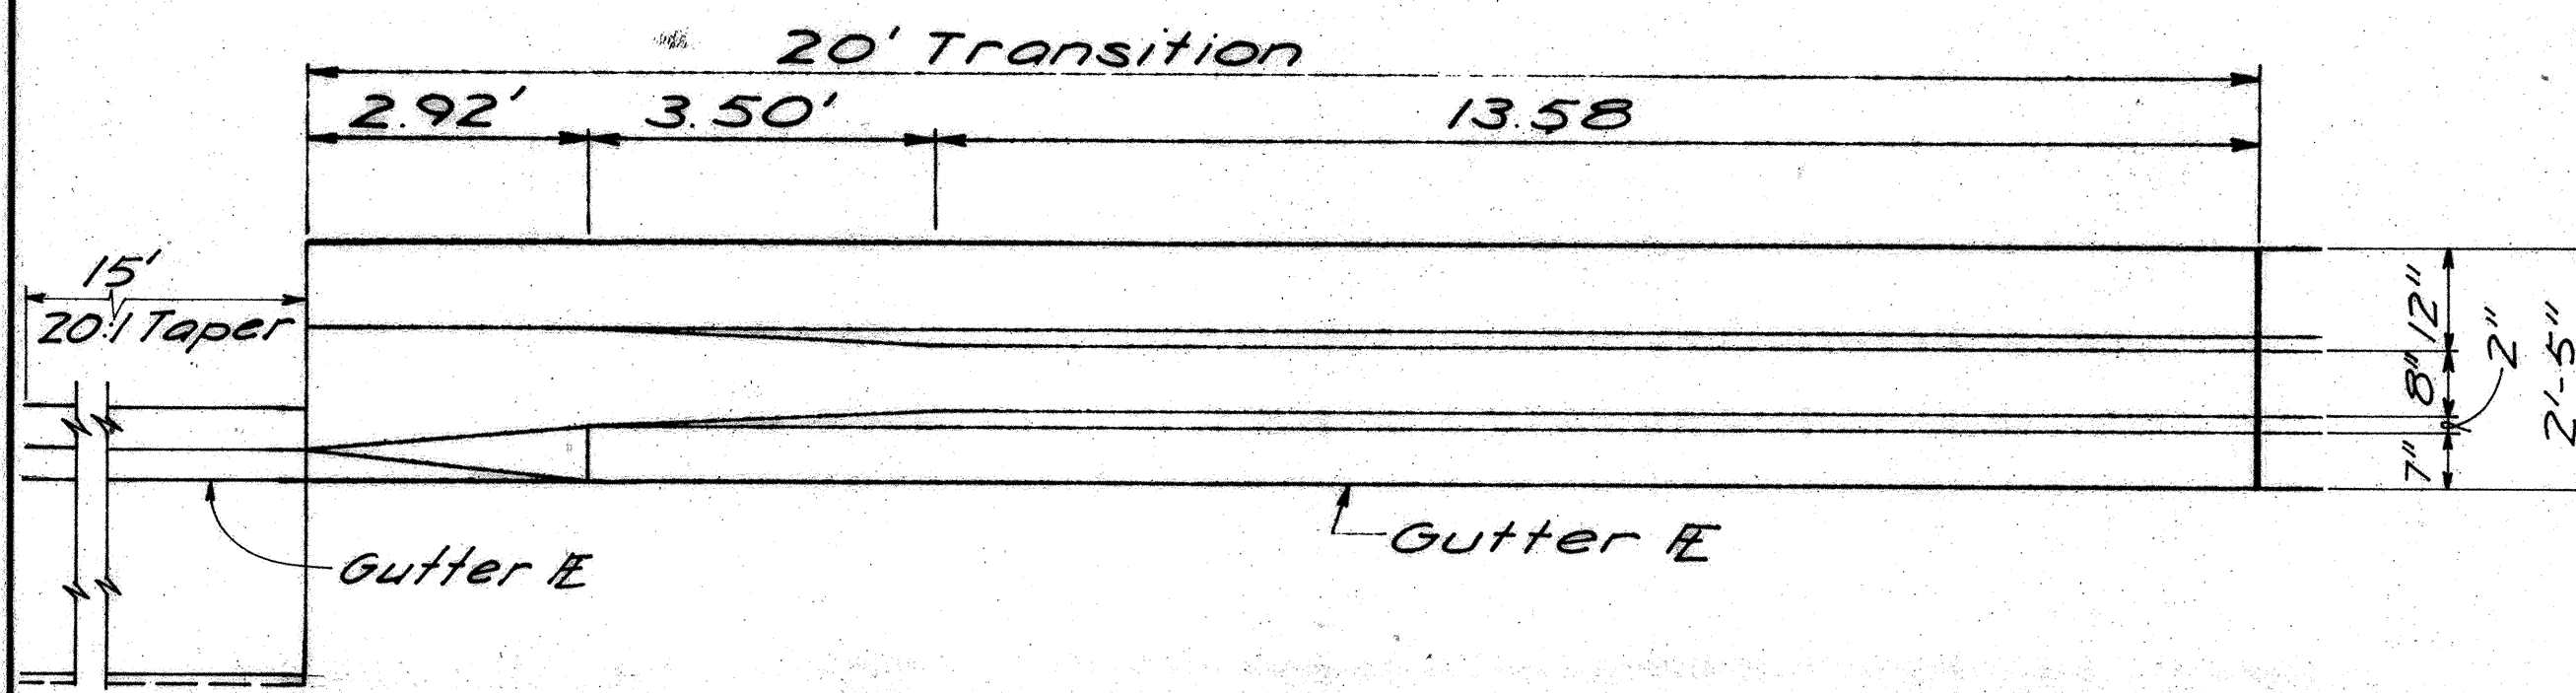

PLAN VIEW

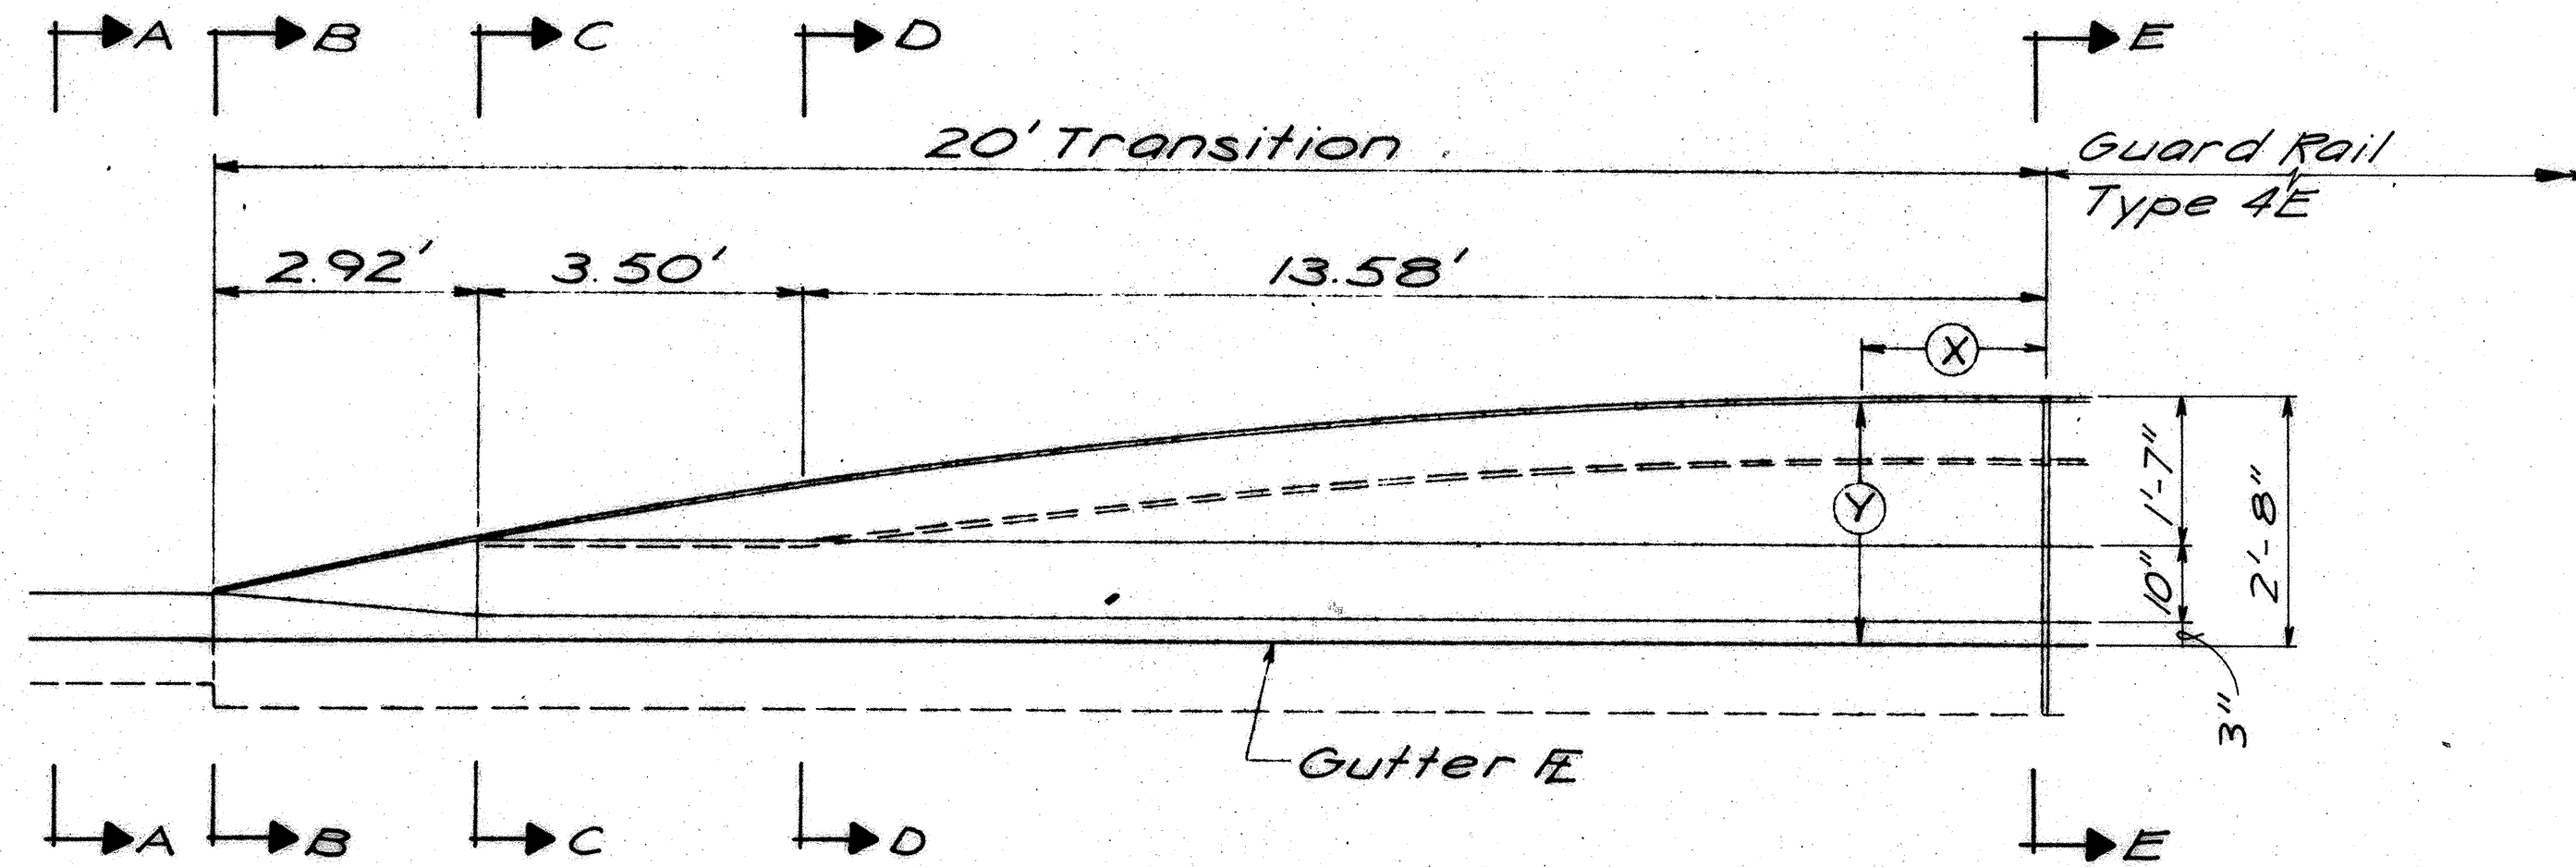


ELEVATION

20' TRANSITION SECTION
SCALE: 1/2" = 1'-0"

HEIGHT OF TRANSITION	
X	Y
0	2.67'
1	2.66'
2	2.65'
3	2.62'
4	2.58'
5	2.53'
6	2.47'
7	2.40'
8	2.32'
9	2.23'
10	2.13'
11	2.01'
12	1.89'
13	1.75'
13.58'	1.67'
14	1.61'
15	1.45'
16	1.28'
17	1.10'
17.08'	1.00'
18	0.91'
19	0.71'
20	0.50'


PORTABLE CONC. GUARD RAIL

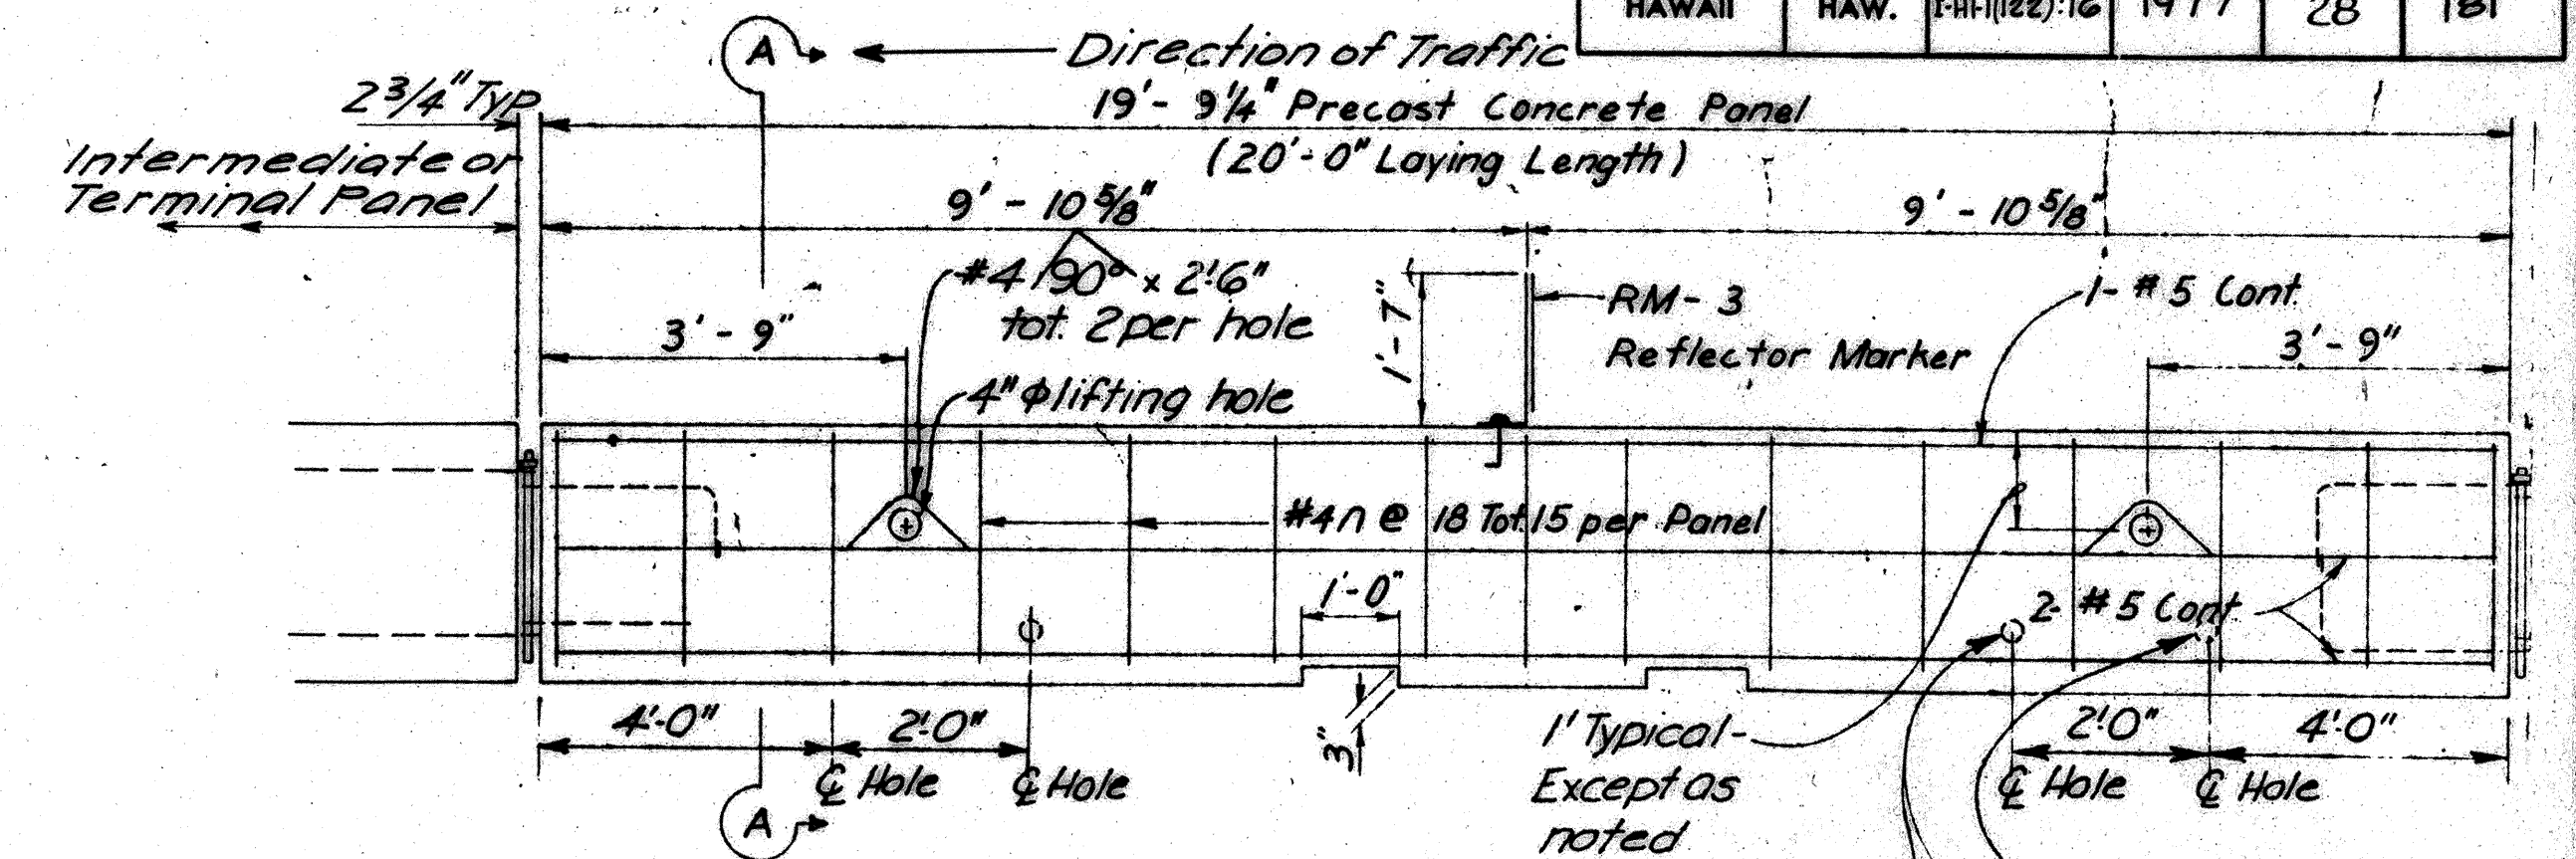


TYPICAL INTERMEDIATE PANEL

Concrete: 1.93 c.y. per Panel
Reinf: 169 lbs. per Panel
Weight: 3.9 tons per Panel


ELEVATION
Scale: 1/2" = 1'-0"

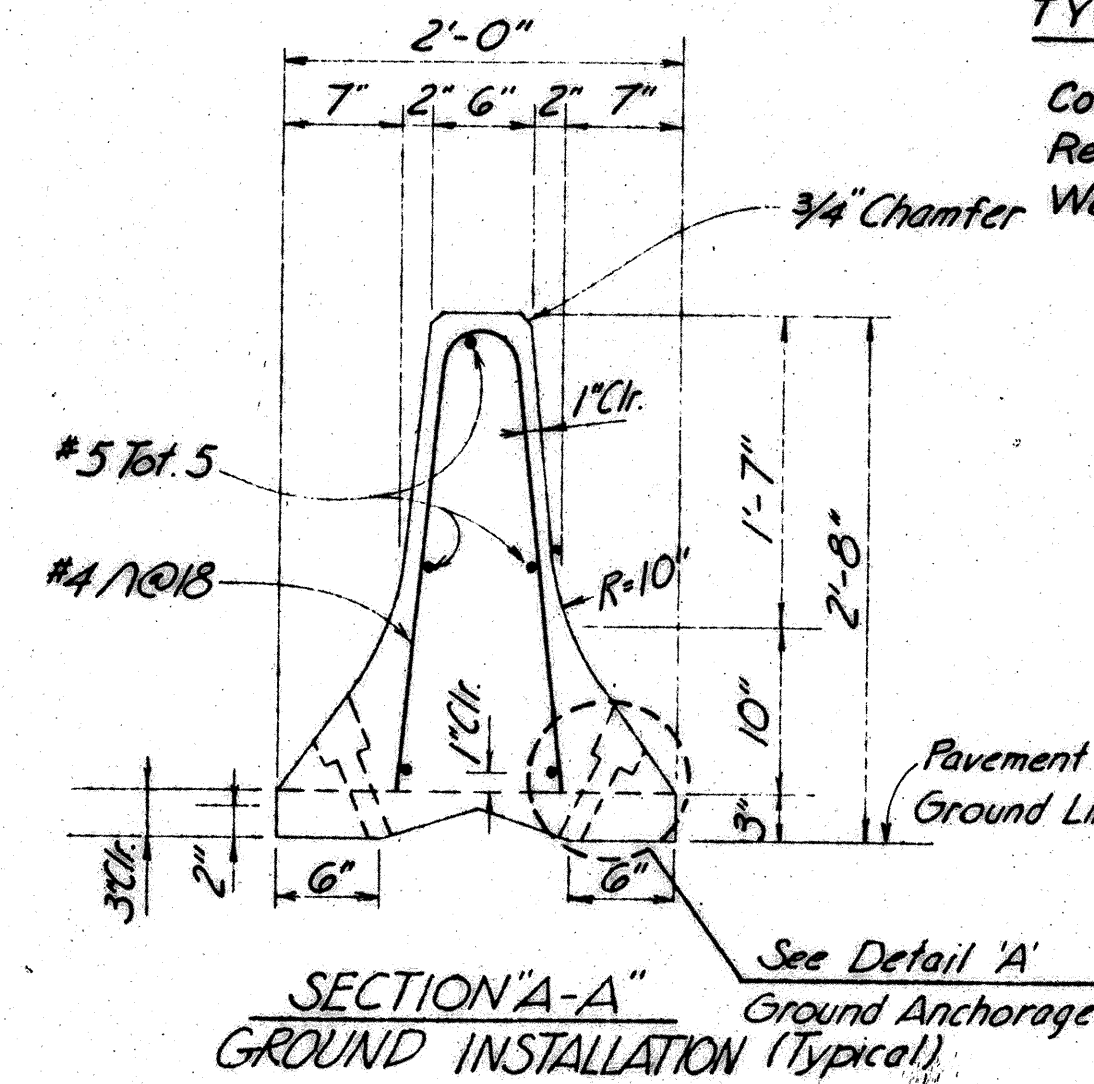

SECTION A-A
GROUND INSTALLATION (Typical)

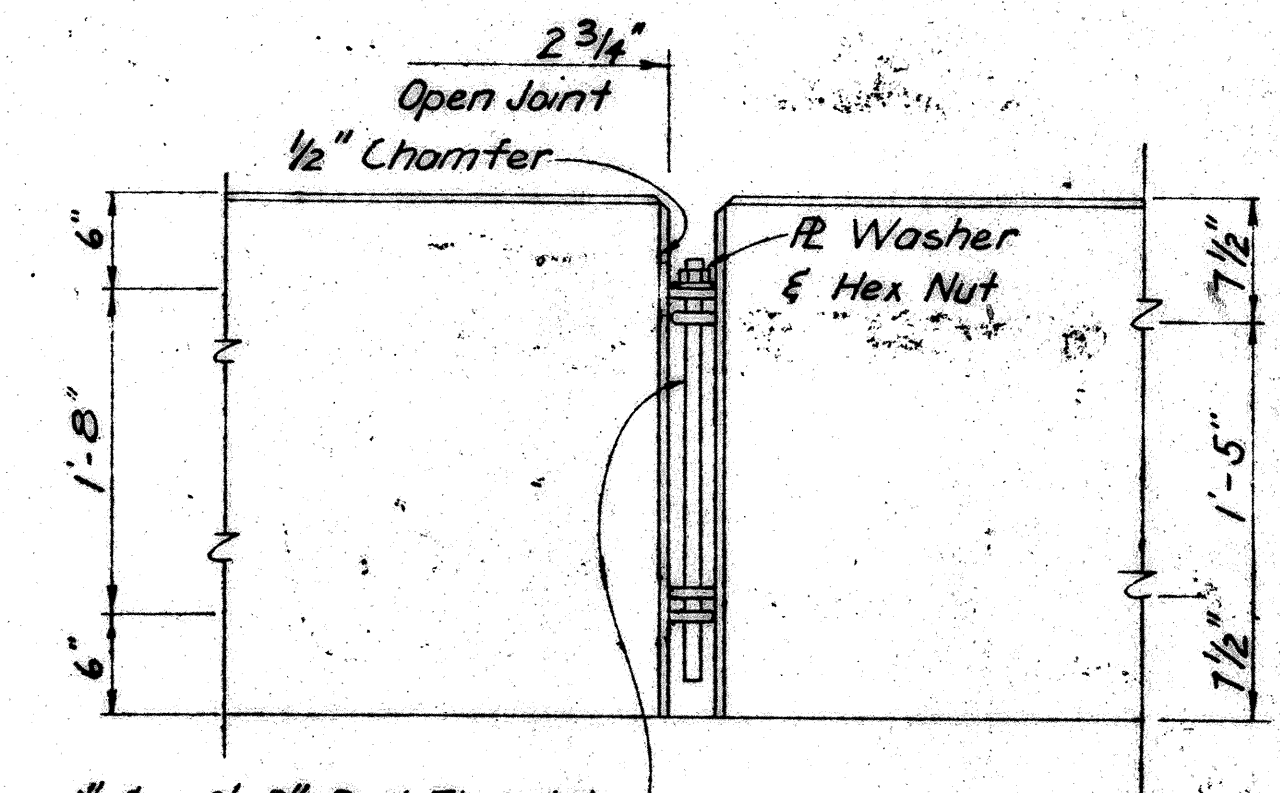


EXISTING PIN CONNECTION DETAIL
Scale: 1" = 1'-0"

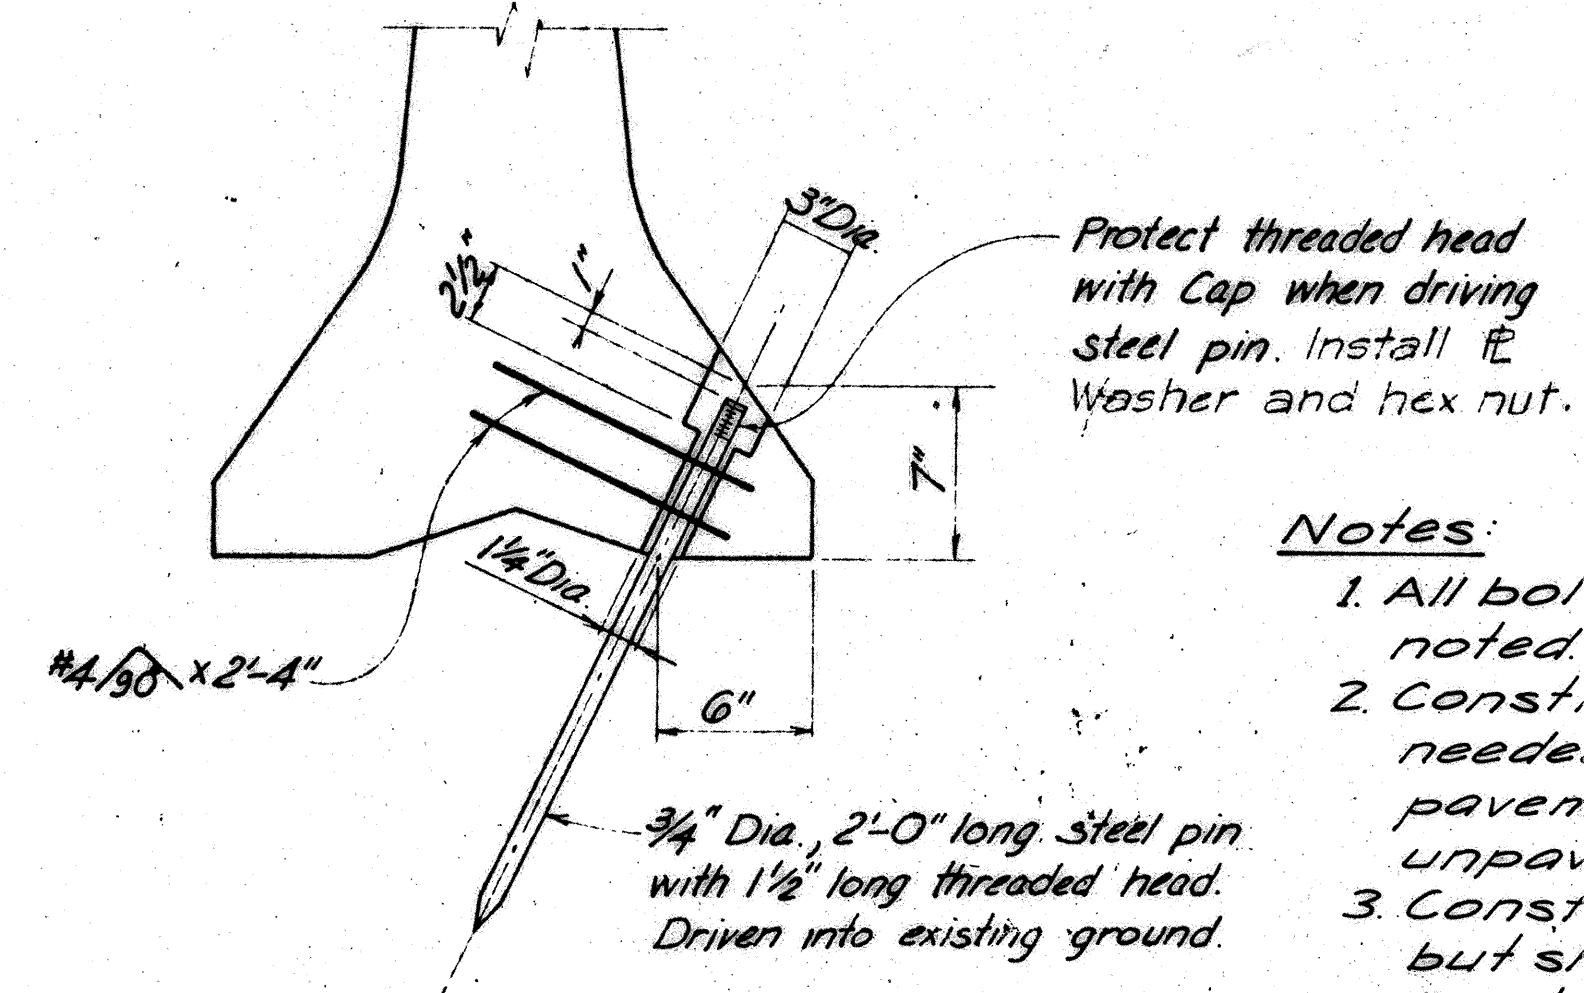

DETAIL A - GROUND ANCHORAGE
Scale: 1/2" = 1'-0"

Notes:

1. All bolts to have cut washers unless otherwise noted.
2. Construct asphalt concrete or mortar base where needed for proper sitting at Guard Rail on Exist. pavement and use aggregate base material on unpaved areas.
3. Construction of base shall not be paid separately but shall be considered incidental to "Reset Portable Concrete Guard Rail."
4. Portable Conc. Guard Rail shall be cut as necessary or add lengths cast to fit end stations as directed. Incidental to Portable Conc. Guard Rail.


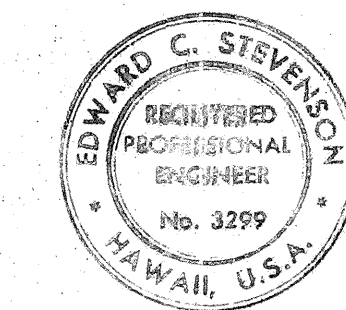


THIS WORK WAS PREPARED BY ME OR UNDER MY SUPERVISION.
Edward C. Stevenson
Signature


STATE OF HAWAII
DEPARTMENT OF TRANSPORTATION
HIGHWAYS DIVISION

SPECIAL DETAILS
GUARD RAIL, TYPE 4E
PORTABLE CONC. GUARD RAIL
AIRPORT INTERCHANGE
F.A.I. PROJ. NO. I-HI-1(122)-16
SCALE: AS SHOWN DATE: FEB. 1, 1977
SHEET NO. 1 OF 1 SHEETS

NO.	DATE	REVISION
1	8-18-77	Underground Portion of Guard Rail, Type 4E changed from 1'-6" to 3'-0"

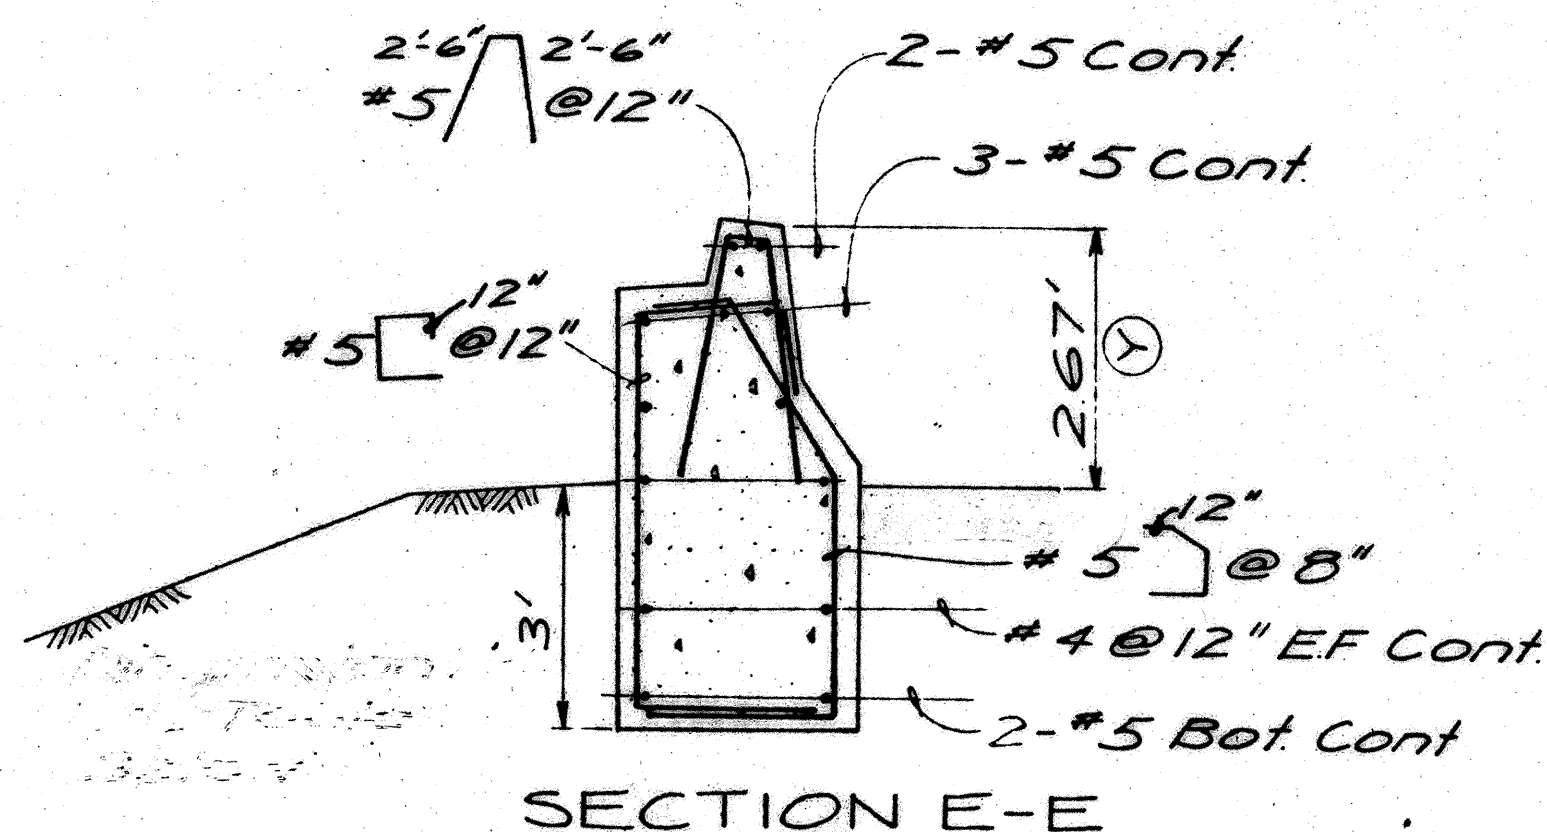
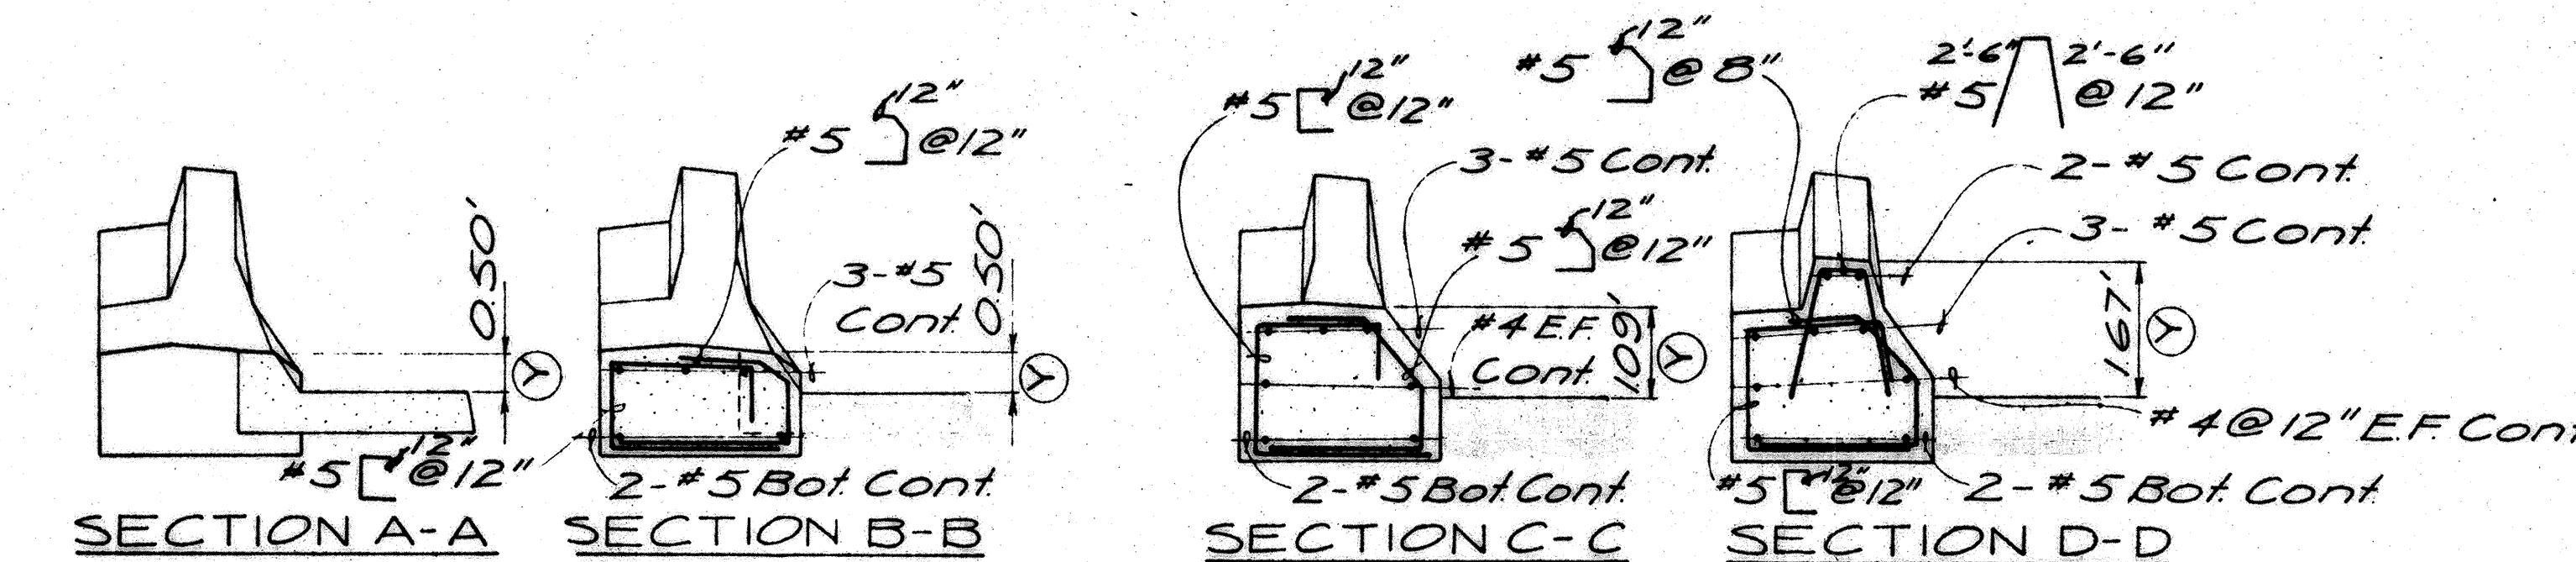


SECTION E-E

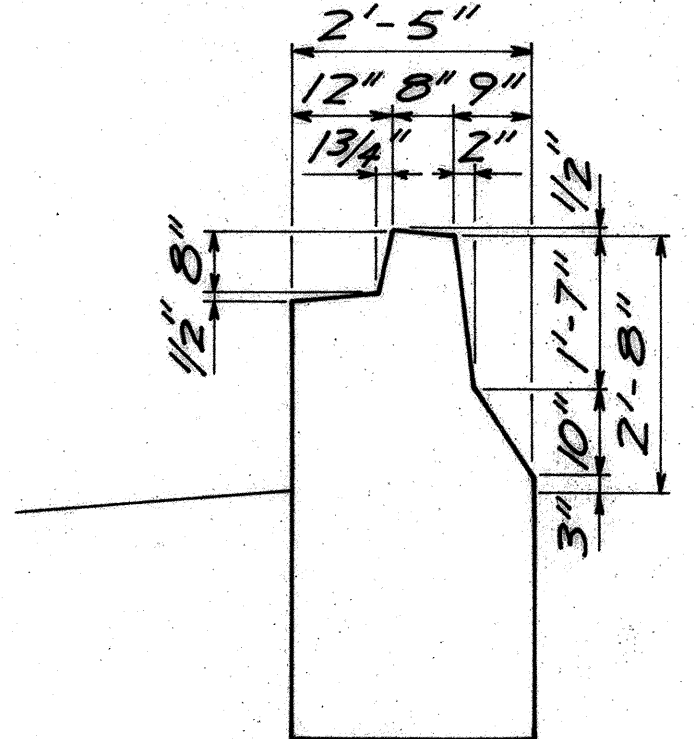


END VIEW


FED. ROAD DIST. NO.	STATE	FED. AID PROJ. NO.	FISCAL YEAR	SHEET NO.	TOTAL SHEETS
HAWAII	HAW.	I-H-1(122)16	1977	29	181

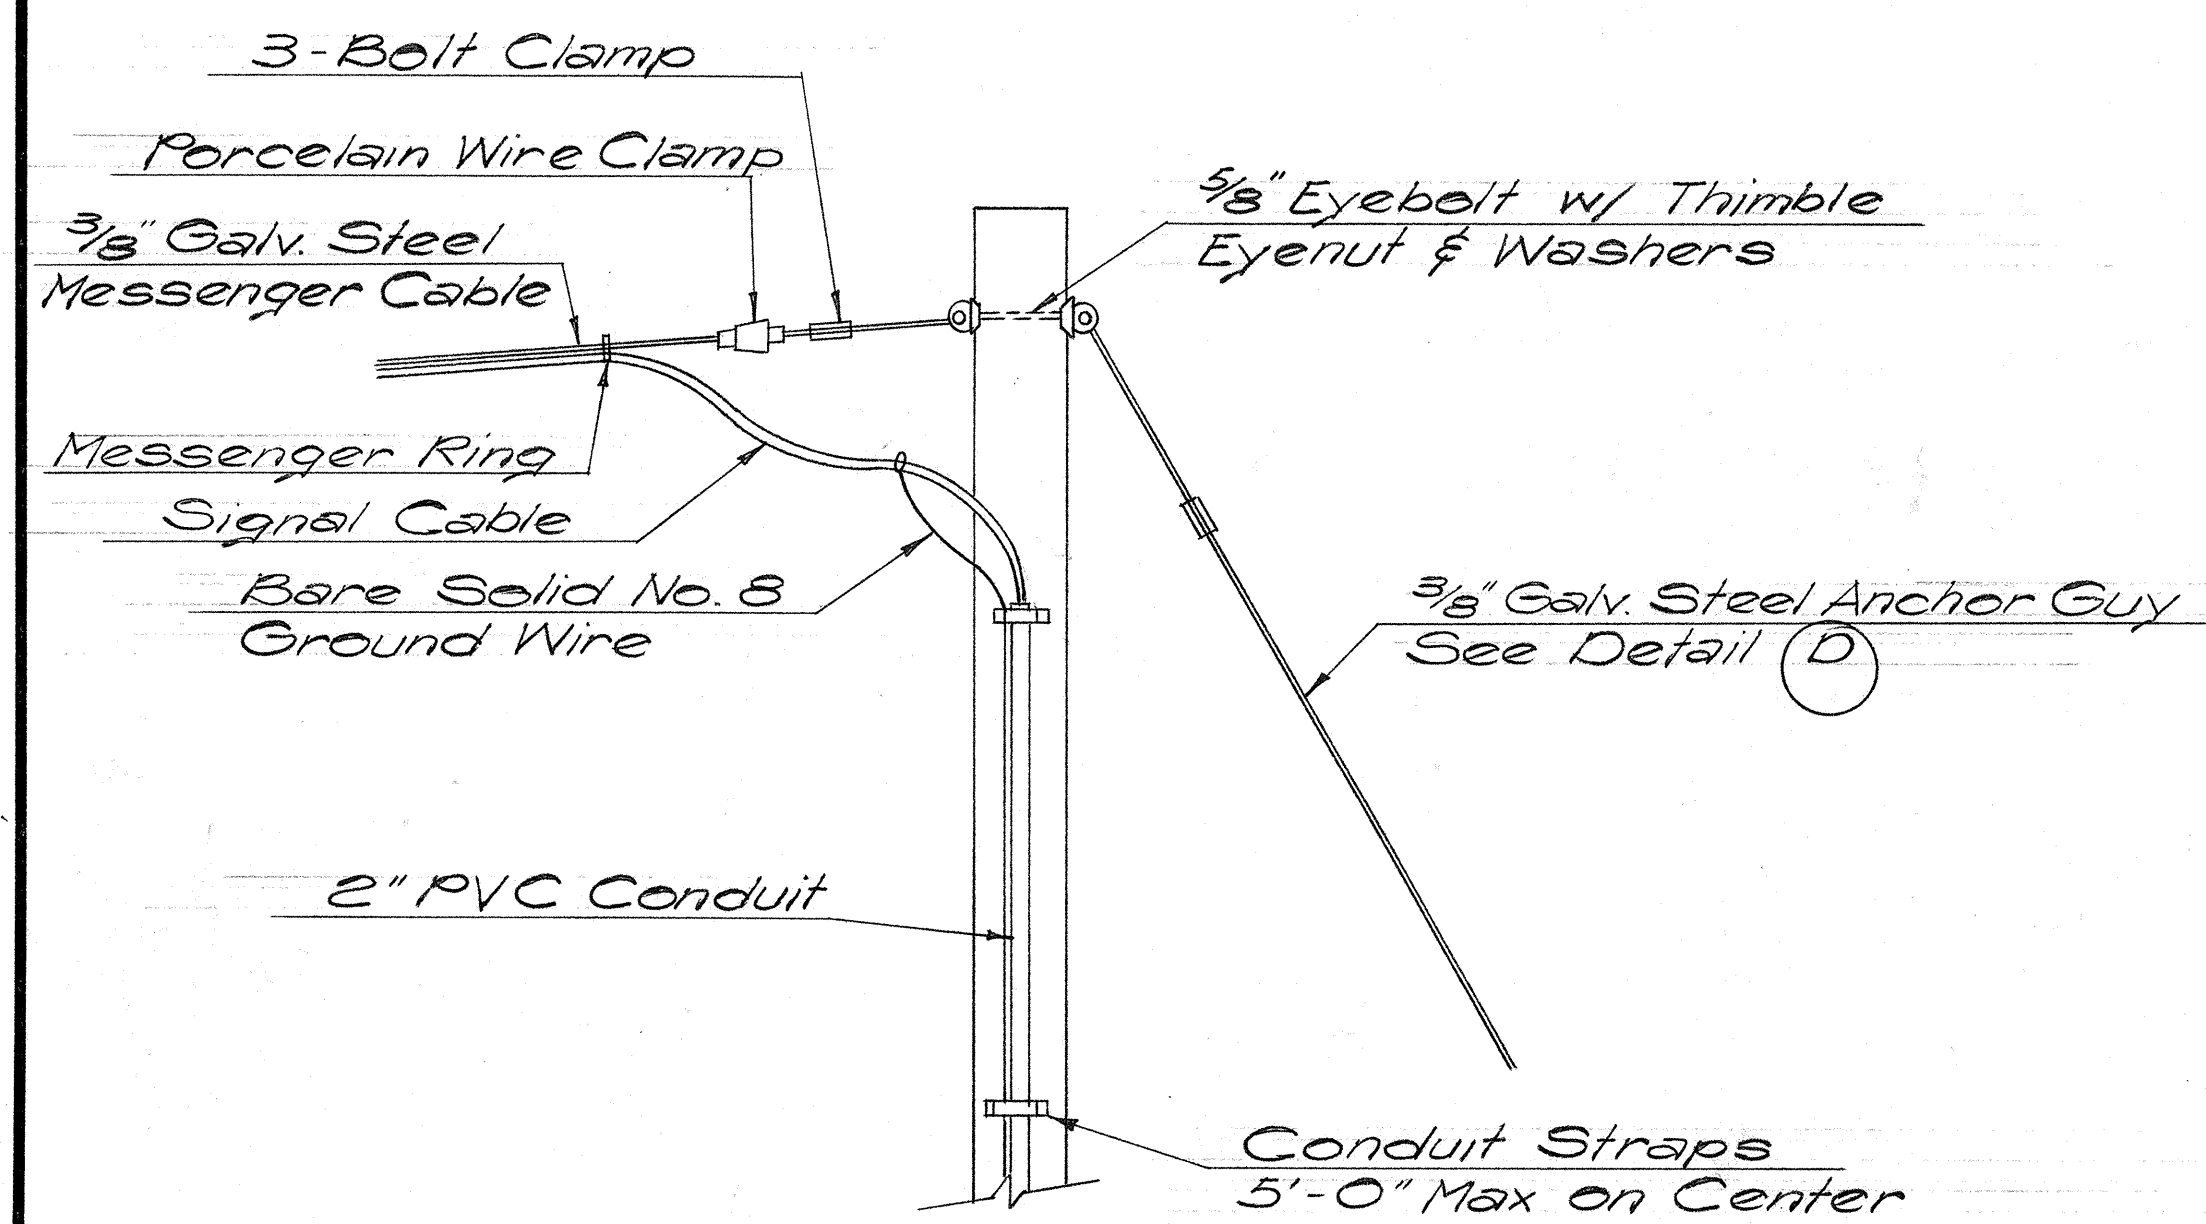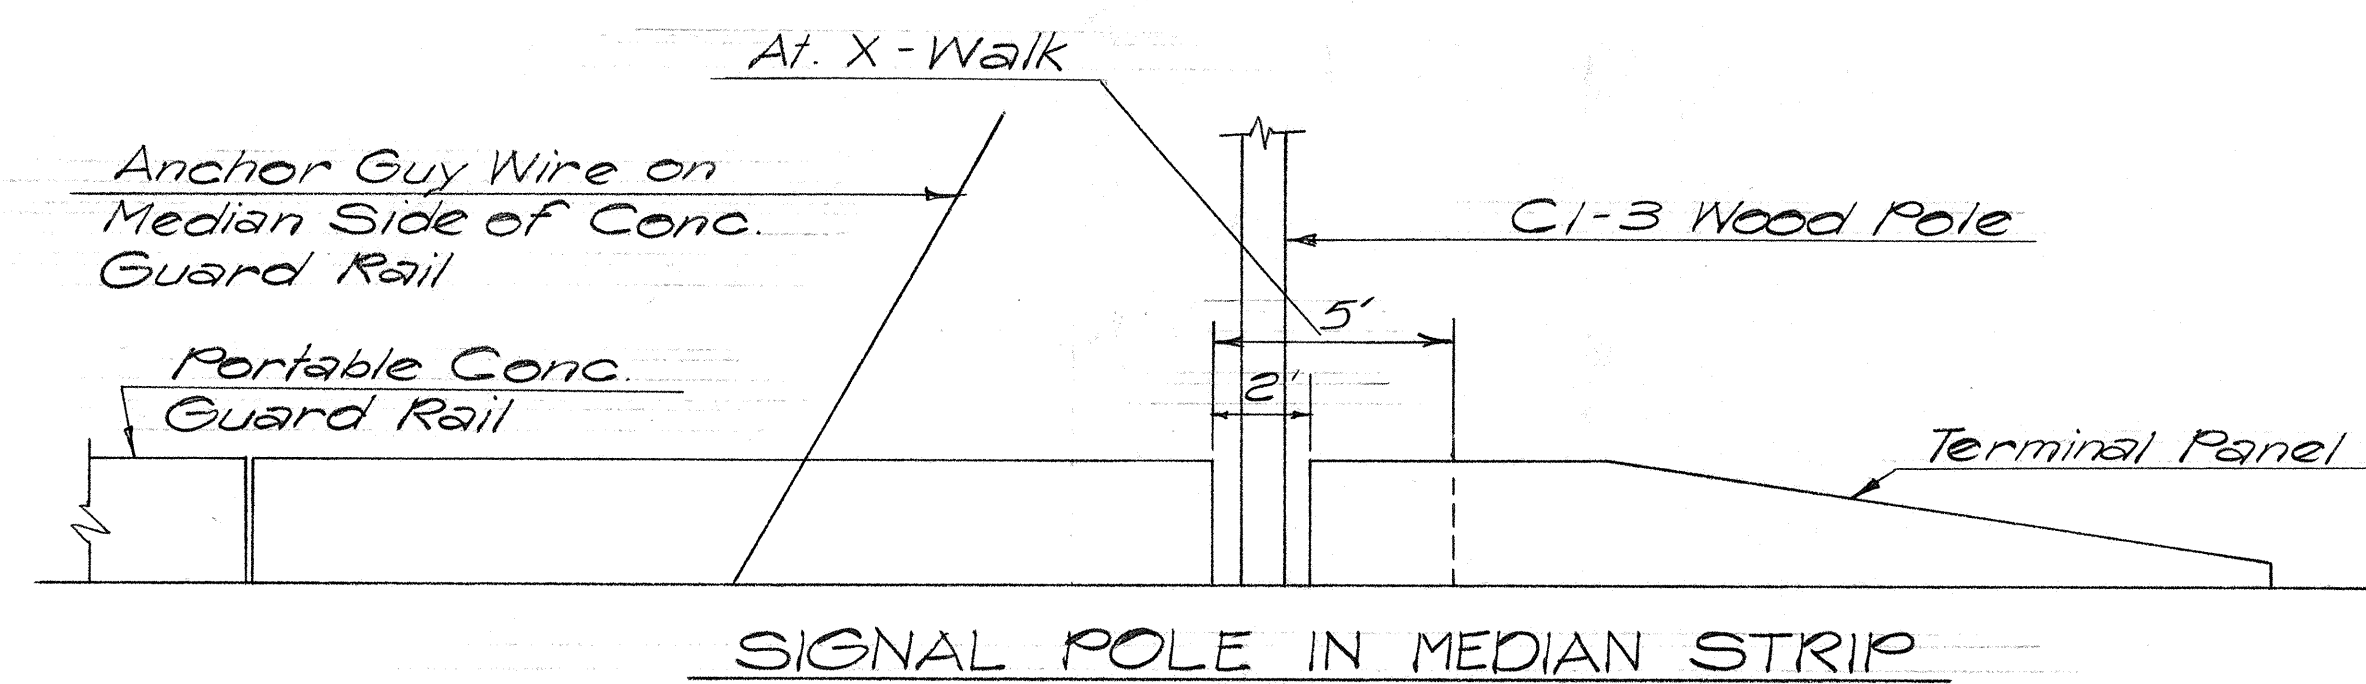


(B) TRAFIC SIGNAL POLE DETAIL

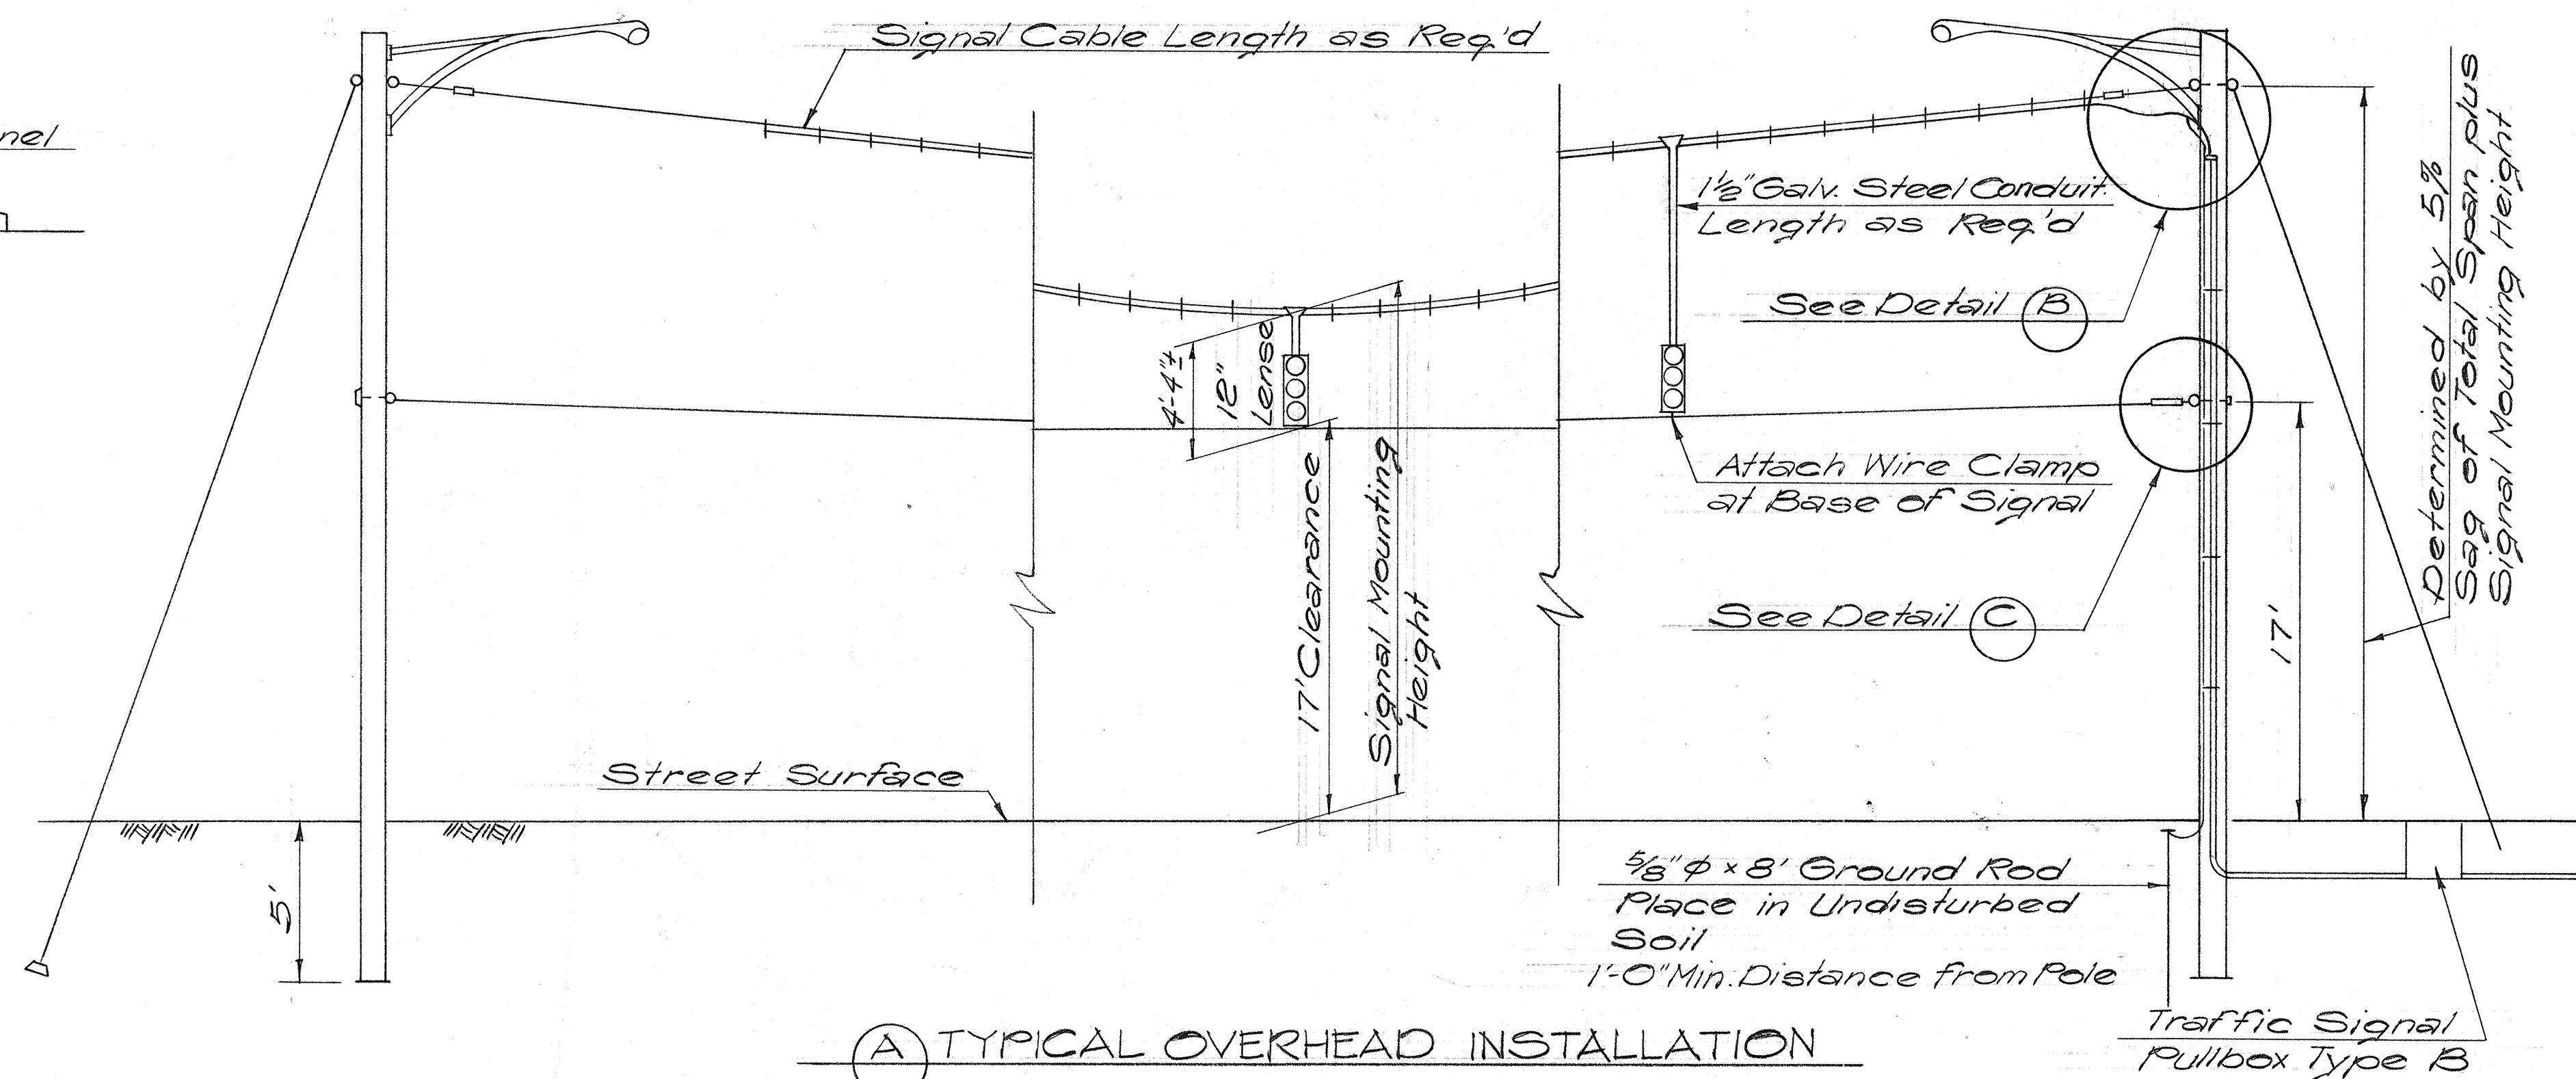


(A) TYPICAL OVERHEAD INSTALLATION

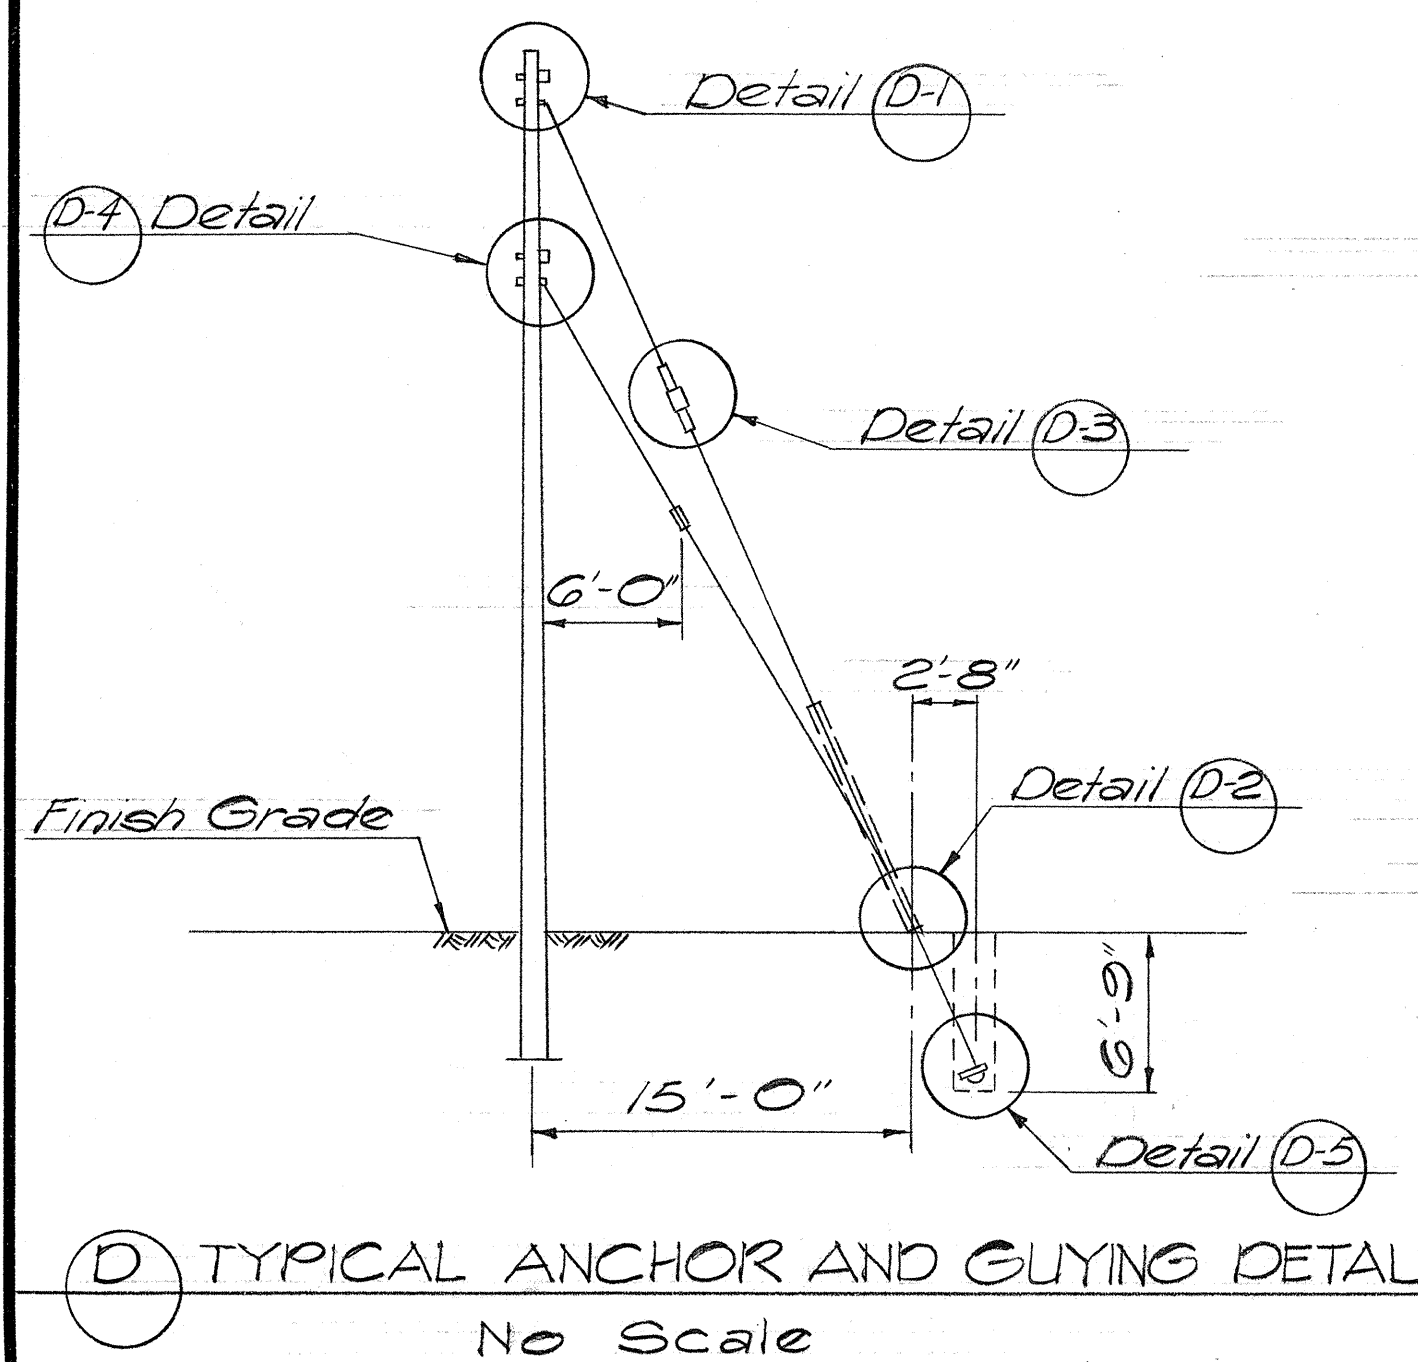


(D) TYPICAL ANCHOR AND GUYING DETAIL
No Scale

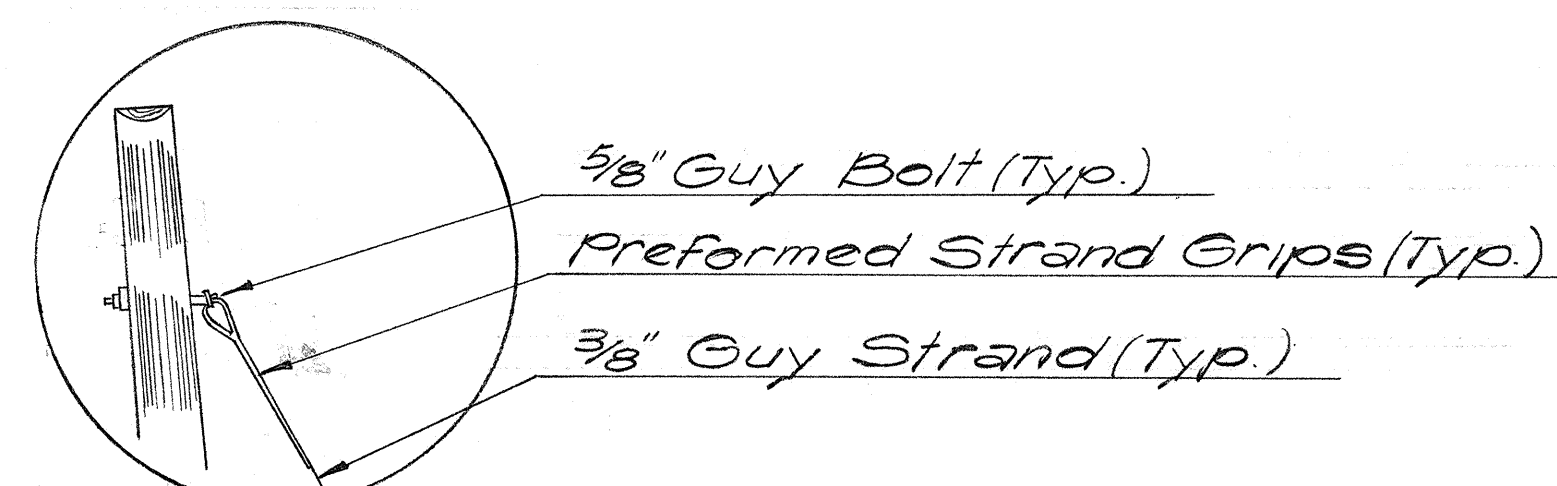

(D-1) DETAIL

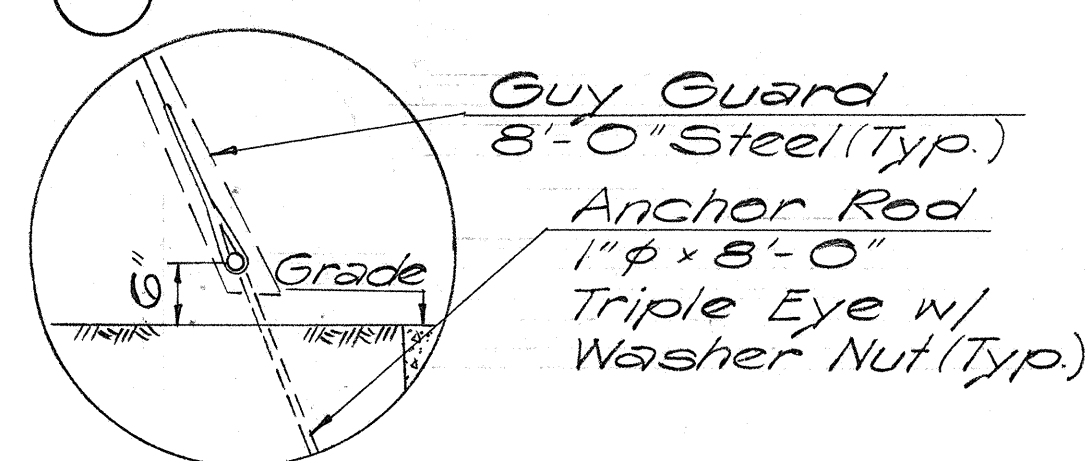


(D-2) DETAIL

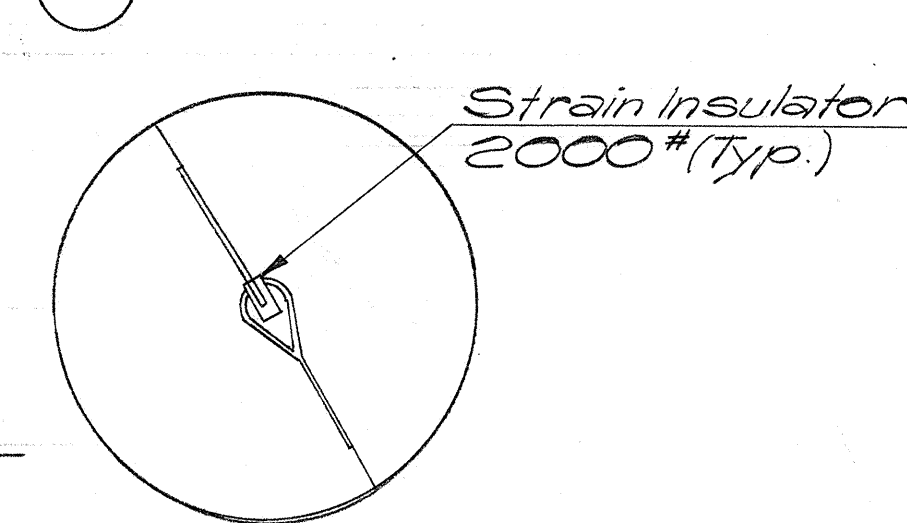


(D-3) DETAIL



(D-3) DETAIL

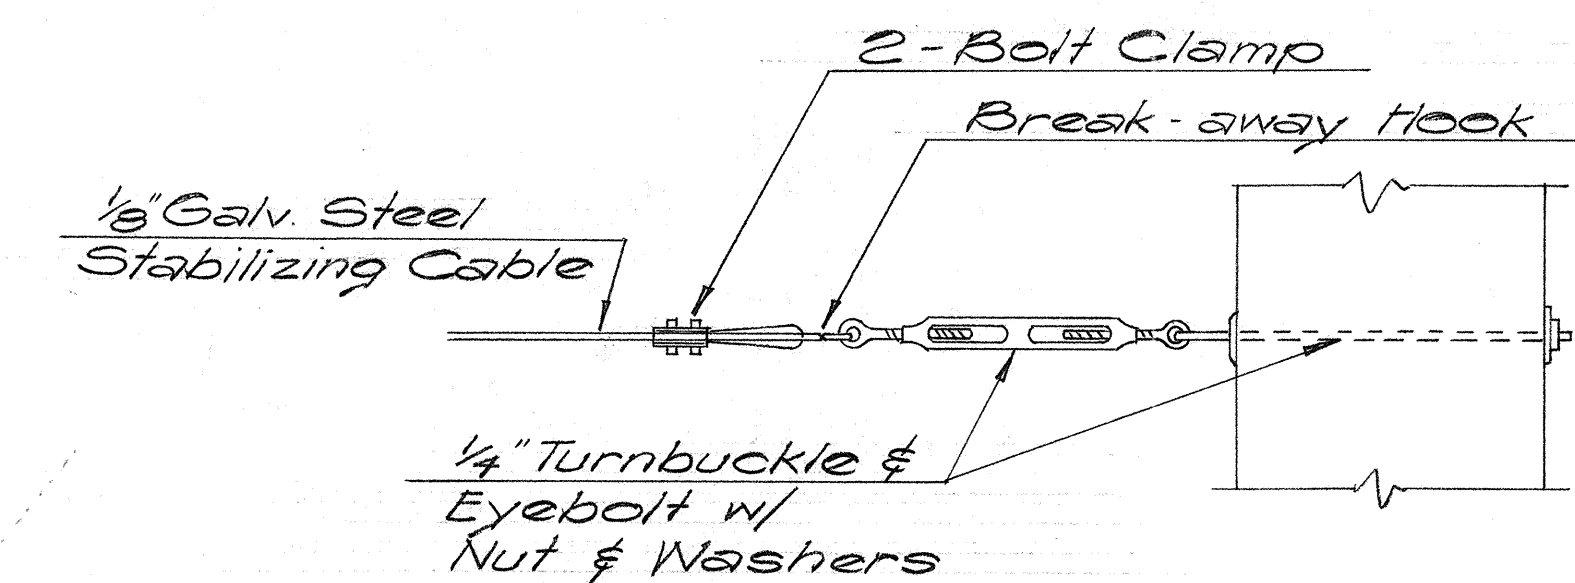

(C) STABILIZER CABLE DETAIL

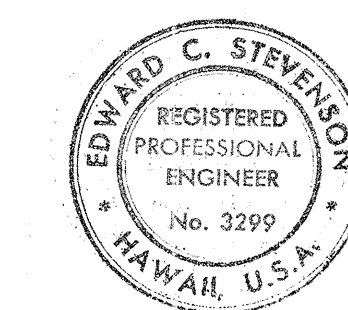

THIS WORK WAS PREPARED BY
ME OR UNDER MY SUPERVISION.
Edward C. Stevenson
Signature

STATE OF HAWAII
DEPARTMENT OF TRANSPORTATION
HIGHWAYS DIVISION

DETOUR SIGNAL DETAILS



AIRPORT INTERCHANGE
F.A.I. PROJ. I-H-1(122):16

SCALE: NONE DATE: FEB 1, 1977

SHEET NO. 1 OF 1 SHEETS

FED. ROAD DIST. NO.	STATE	FED. AID PROJ. NO.	FISCAL YEAR	SHEET NO.	TOTAL SHEETS
HAWAII	HAW.	HI-1(122)-16	1977	30	181

- NOTES:**
1. Relocation of Light Poles included in item 622.0750
 2. The conc. bases from the relocated Light Post shall be removed and disposed of by the contractor.

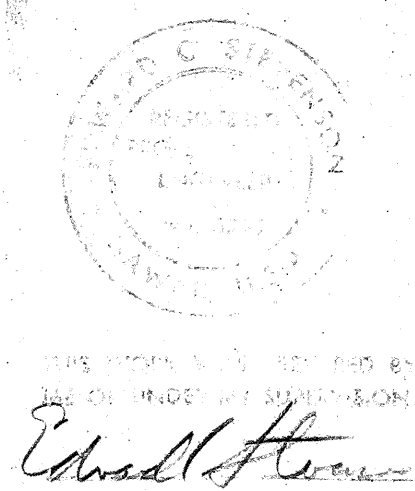
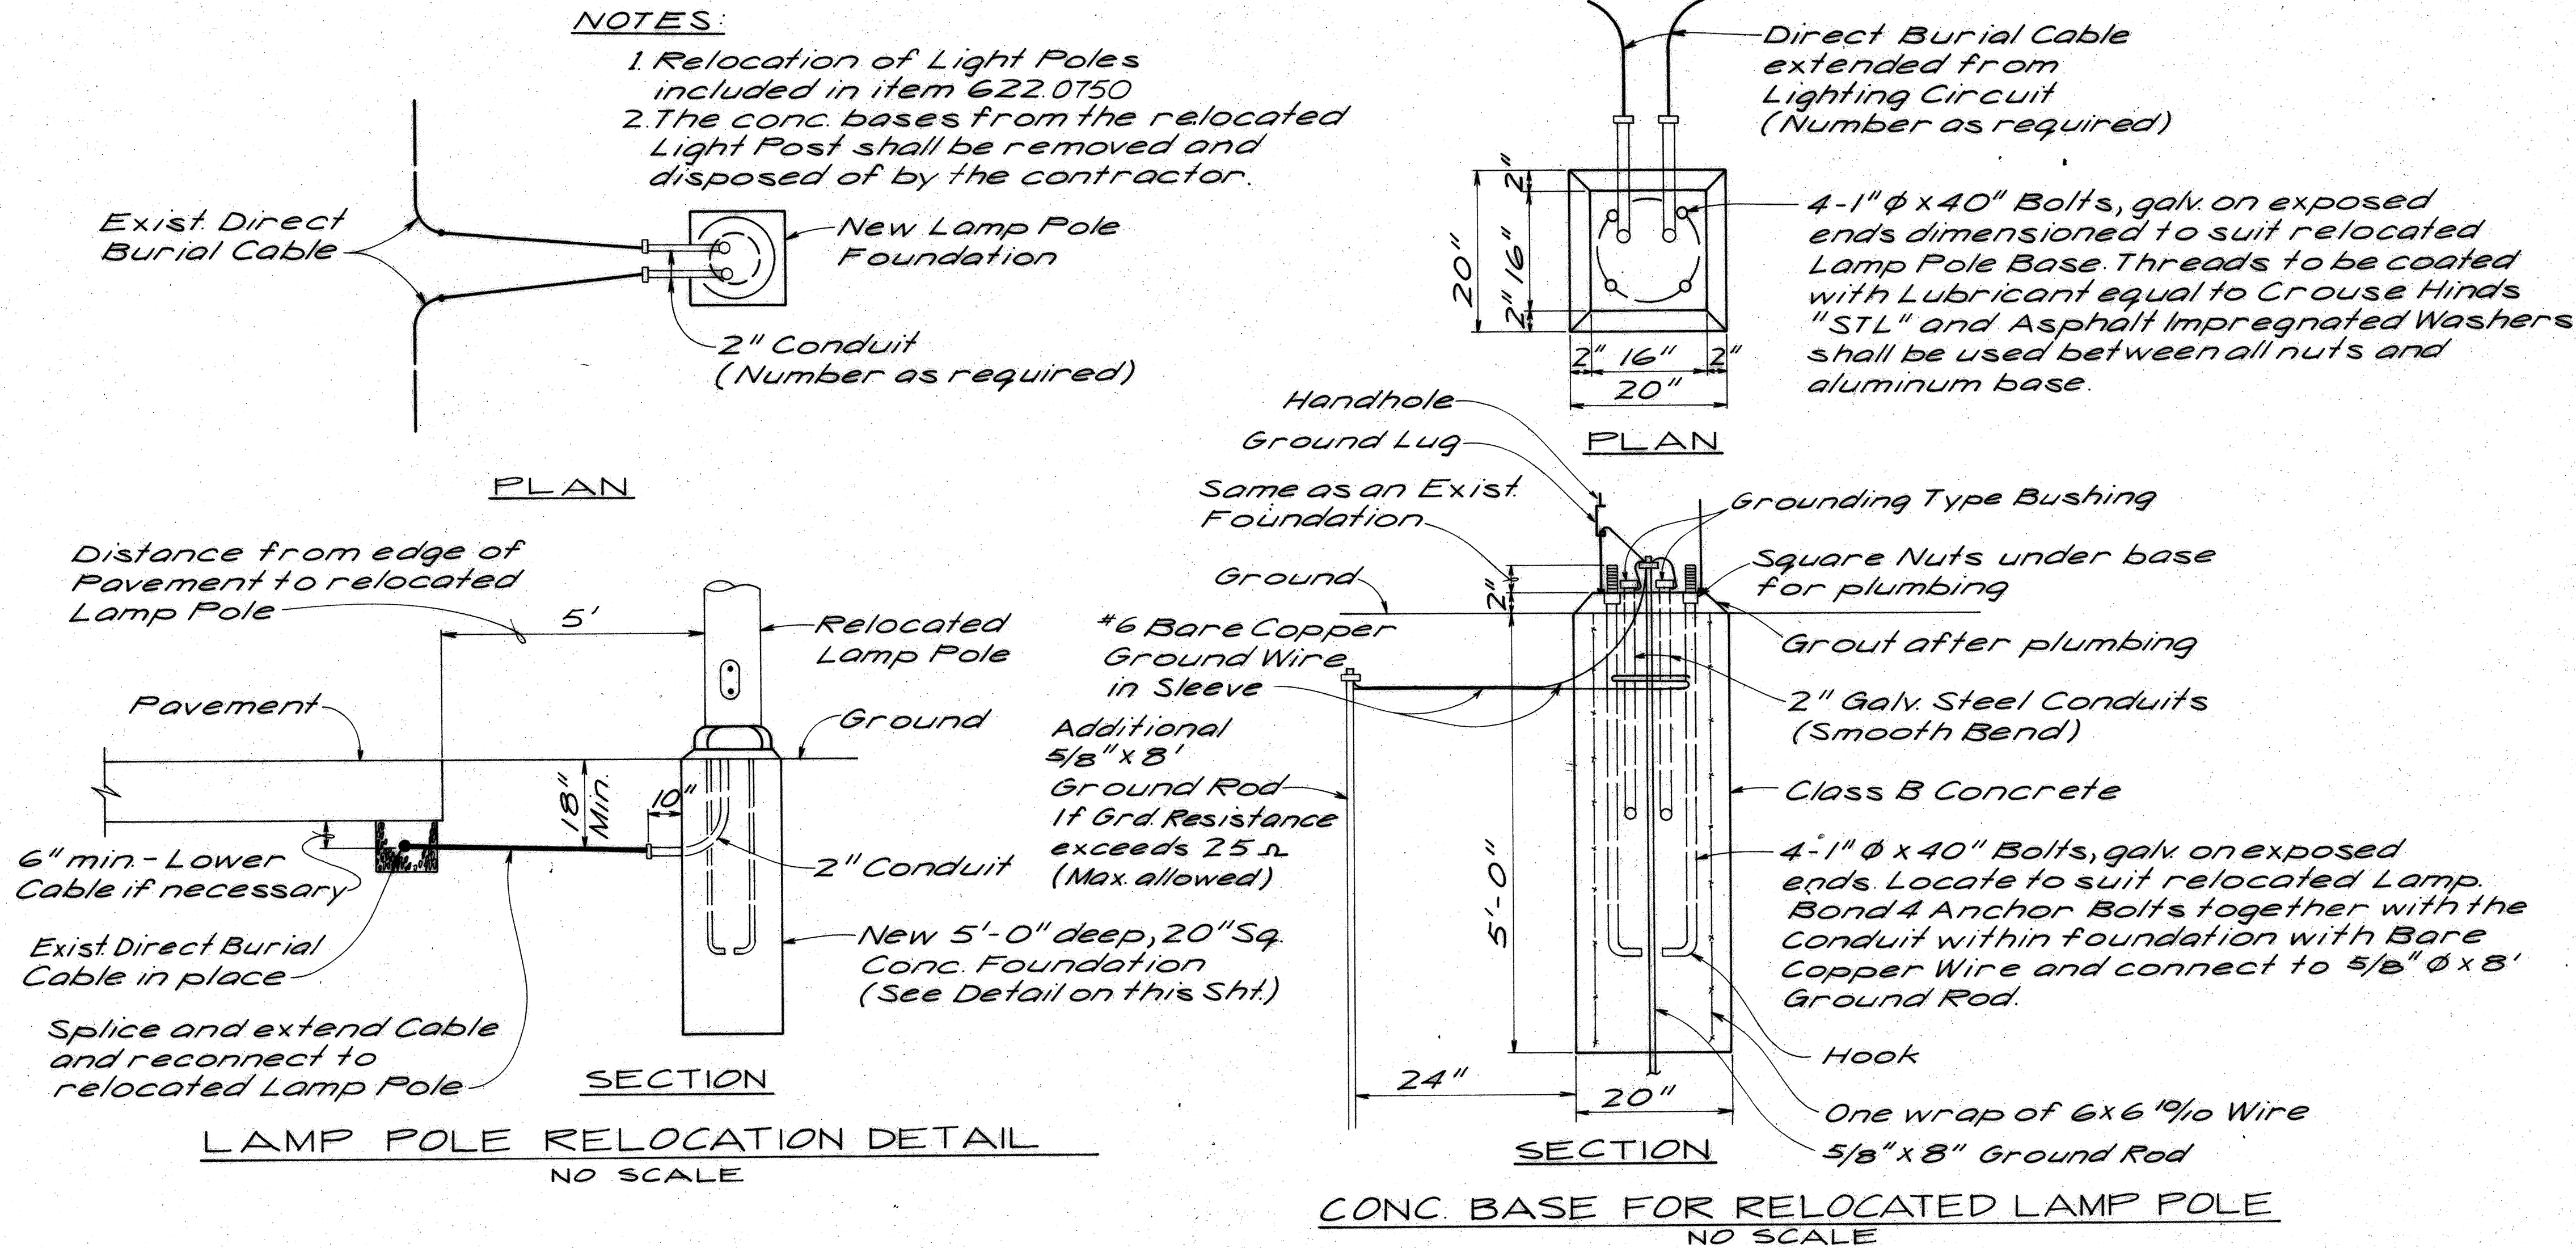


STATE OF HAWAII
DEPARTMENT OF TRANSPORTATION
HIGHWAYS DIVISION

RODGERS BLVD DETOUR
LIGHT POLE RELOCATION
AIRPORT INTERCHANGE
F.A.I. PROJ. NO. I-HI-1(122)-16

SCALE: AS SHOWN DATE: FEB. 1, 1977
SHEET No. 1 OF 1 SHEETS

FED. ROAD DIST. NO.	STATE	FED. AID PROJ. NO.	FISCAL YEAR	SHEET NO.	TOTAL SHEETS
HAWAII	HAW.	I-HI-1(122):16	1977	31	181

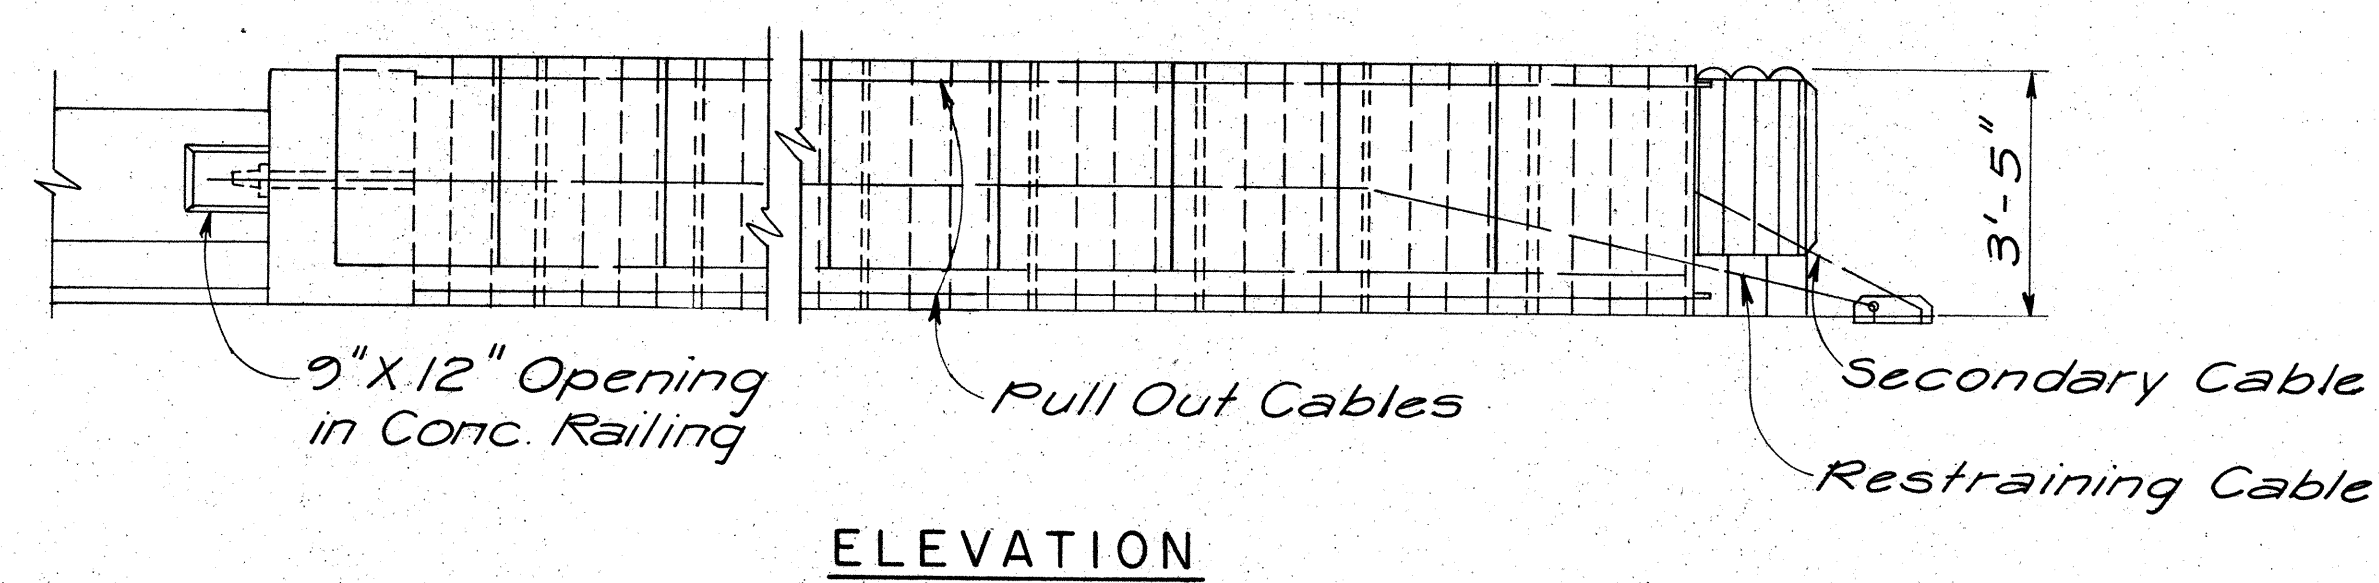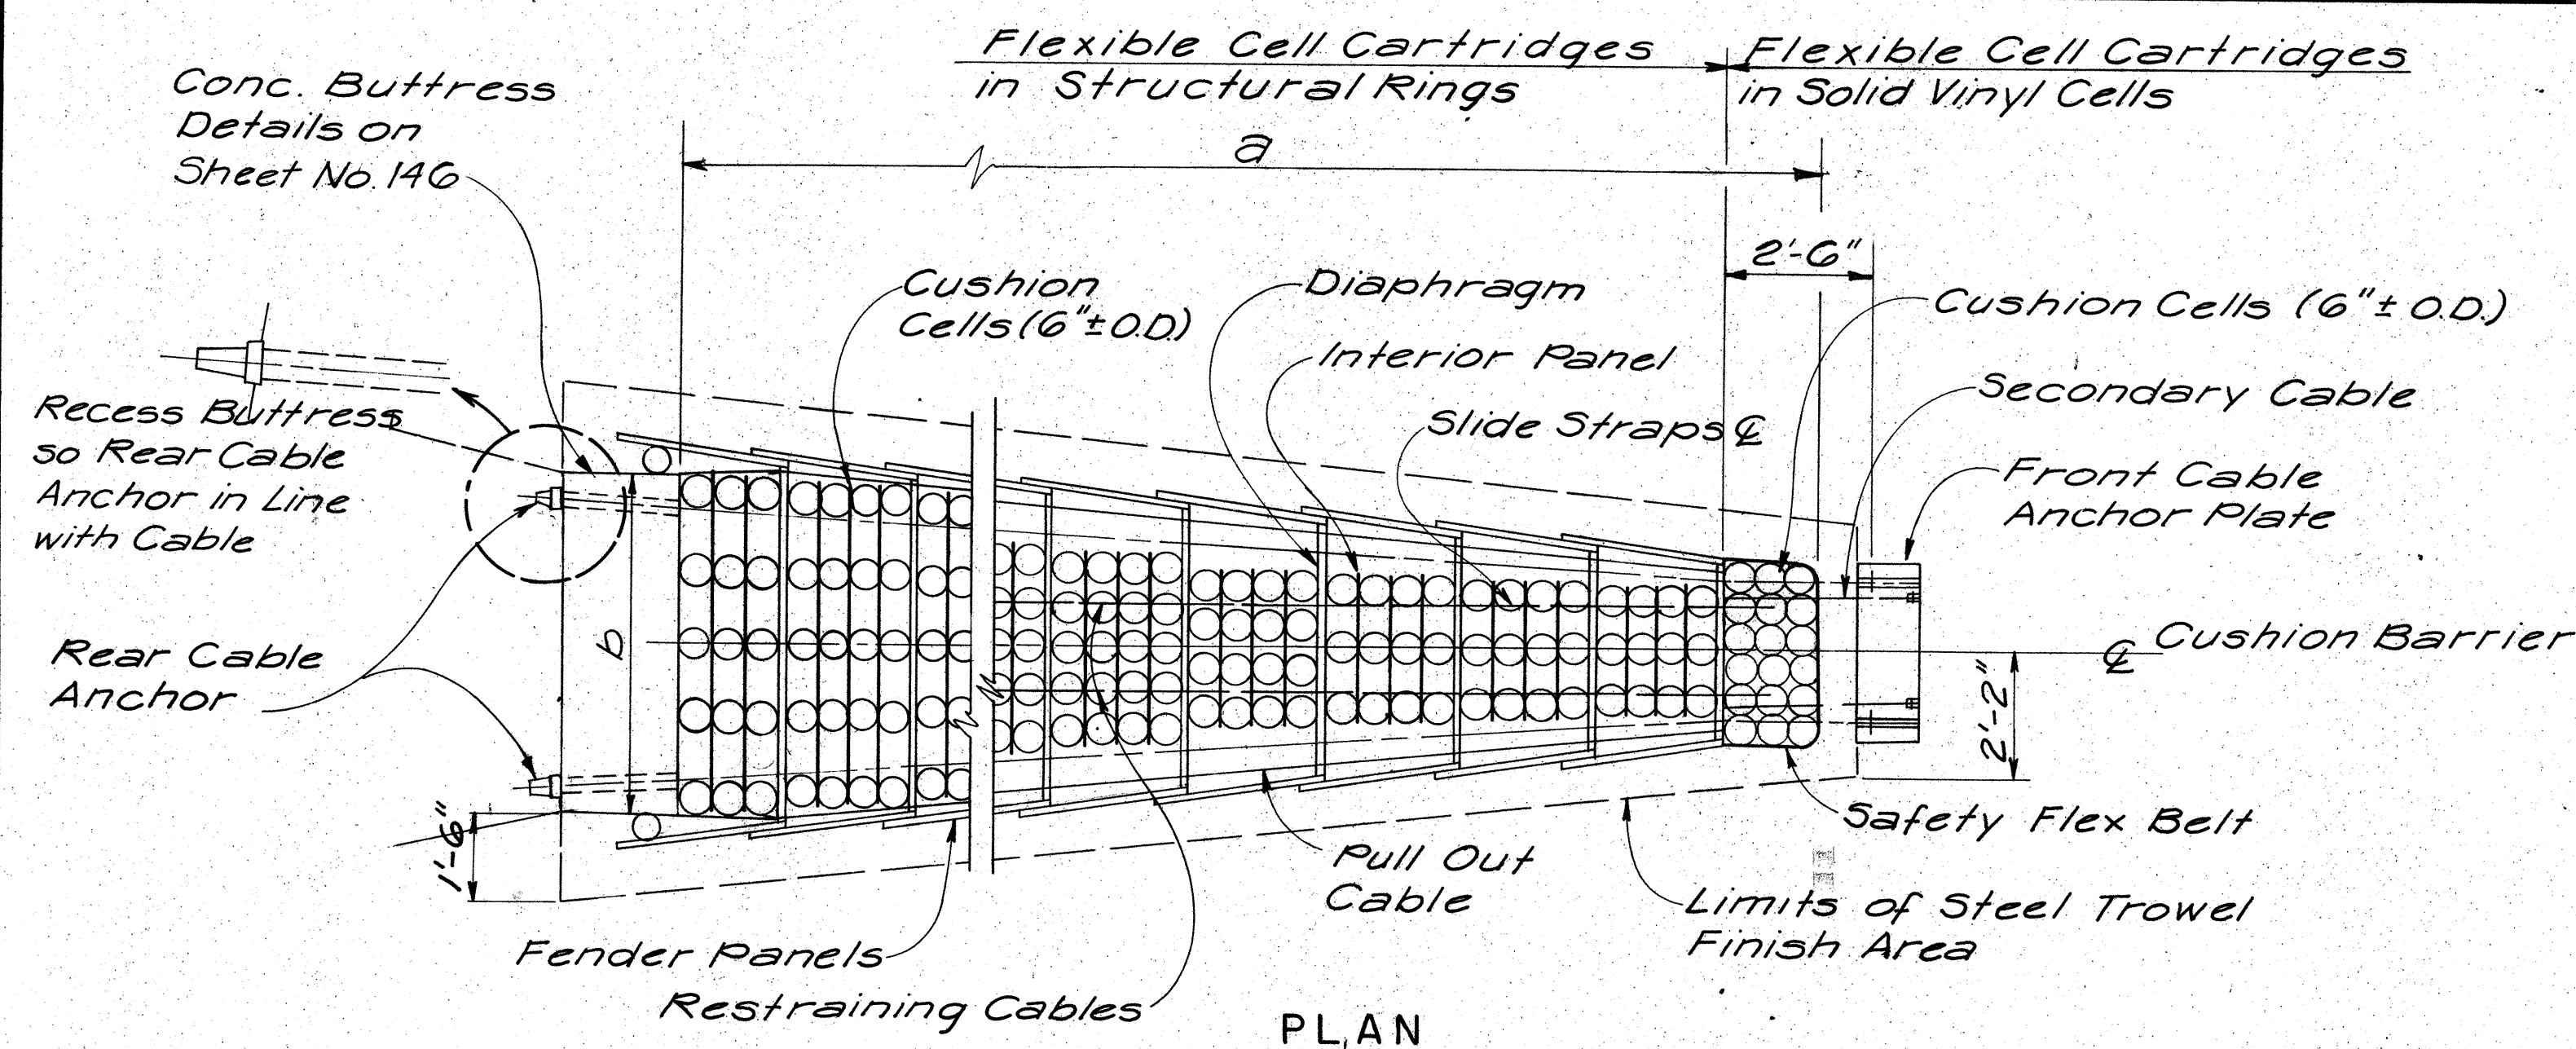


CUSHION BARRIER LAYOUT
SCALE: $\frac{3}{8}" = 1'-0"$

UNITS	LOCATION	a	b
8-Bay	R-ED Sta. 43+80.24	18'-11 1/2"	5'-2"
* 10-Bay	R-ED Sta. 74+63.57	23'-5 1/2"	7'-6"


* Anchor bolts for Front Cable Anchor Plate shall be furnished to Contractor for Project I-HI-1(122):16 for installation.

NOTES:


1. Steel trowel finish area shall be in one plane.
2. The Contractor shall verify all dimensions.
3. Front cable anchorage mounting straps and concrete anchor bolts shall be incidental to cushion barrier and not be paid for separately.
4. All structural steel shall be galvanized after fabrication.
5. The installation of the concrete anchor bolts to secure front cable anchor plate shall not reduce the area of reinforcing steel in the concrete deck below the allowable design limits.
6. Front end anchorage details and buttress connection details shall be as recommended by the manufacturer.

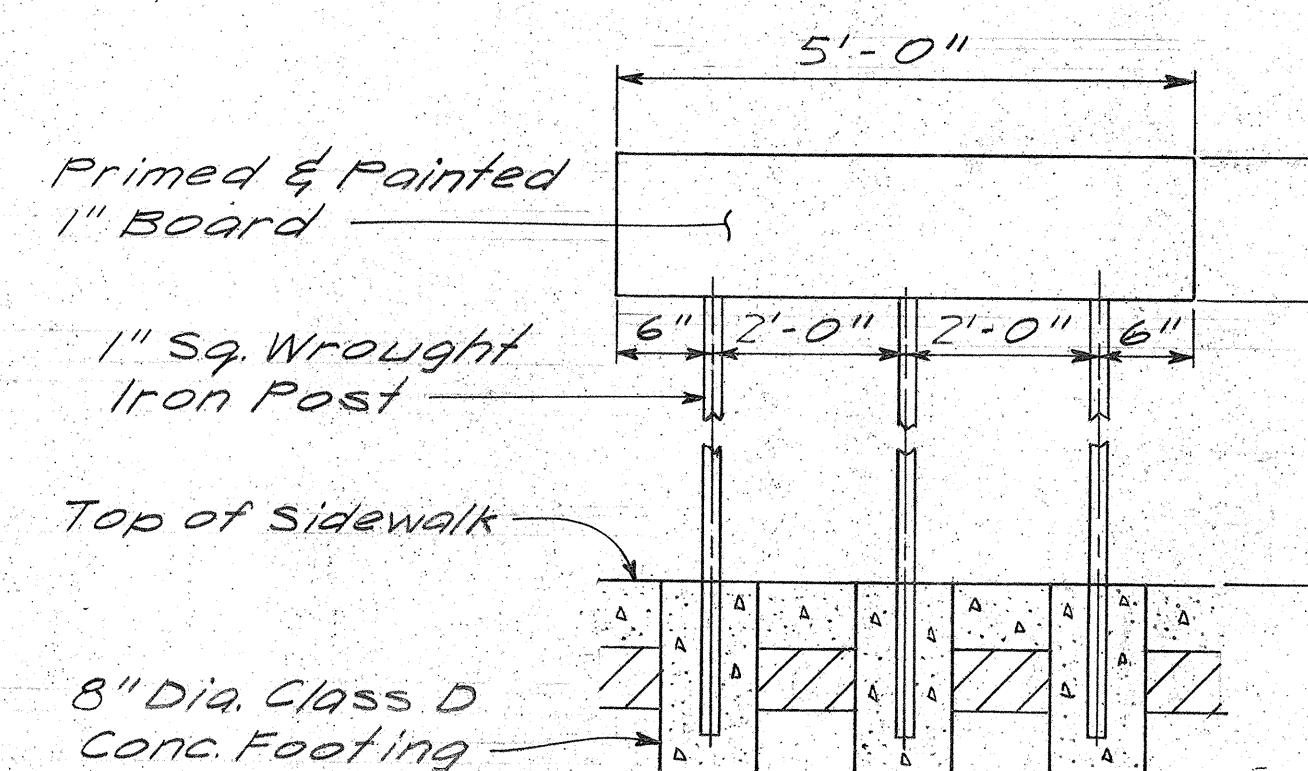

GUARD POST DETAIL
NOT TO SCALE

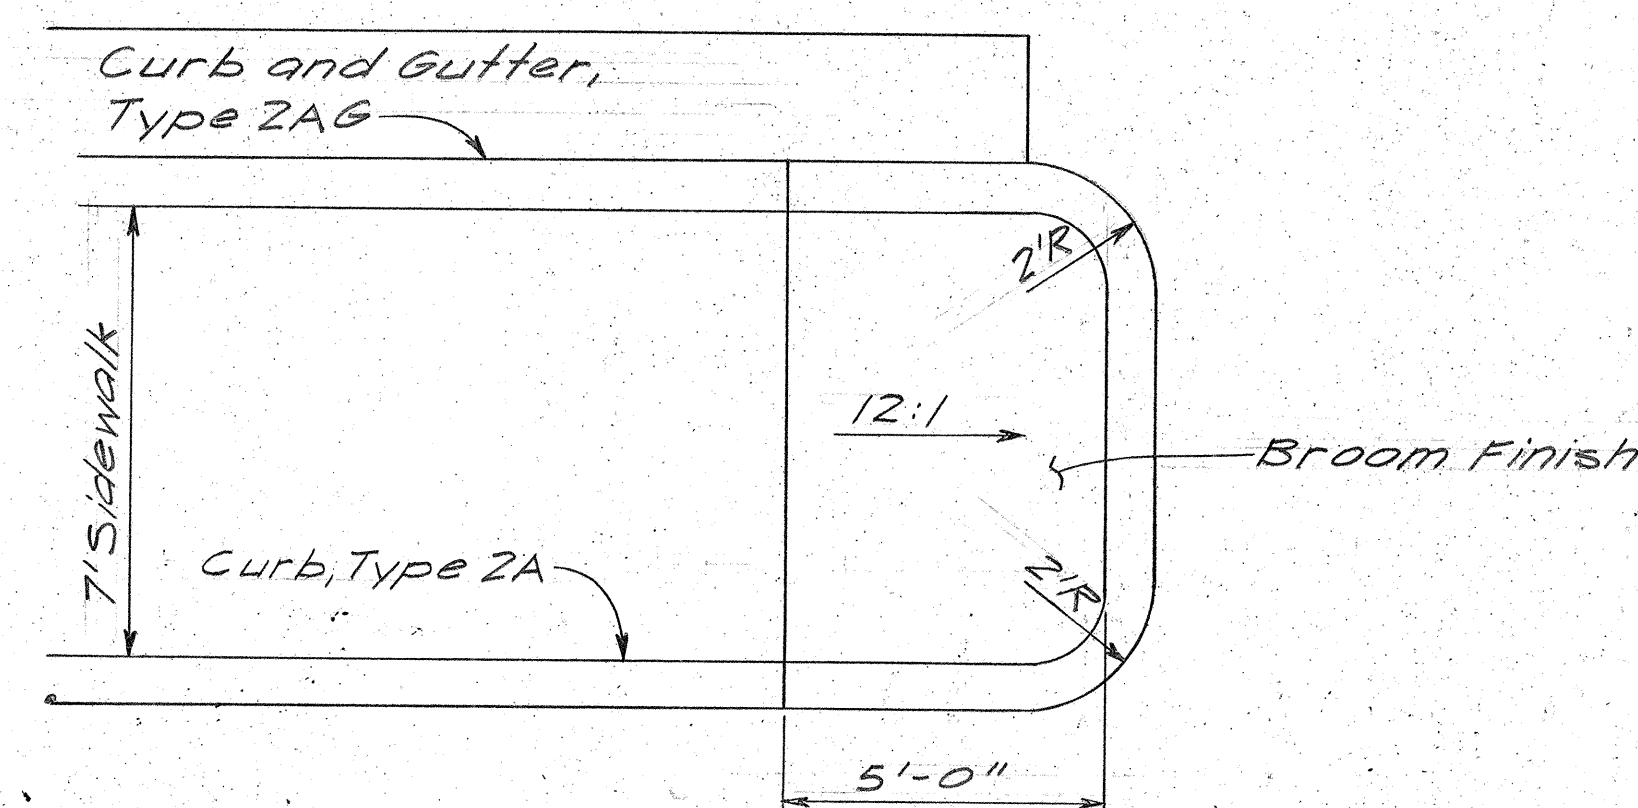


PLAN
SCALE: 1" = 3'-0"

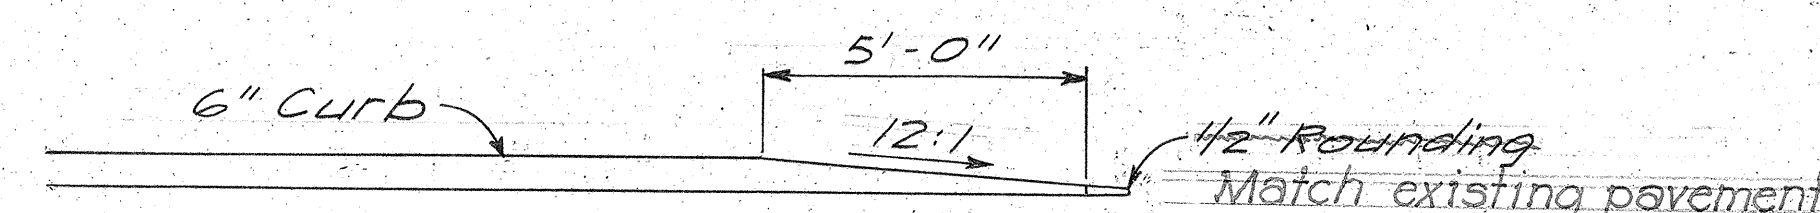

ELEVATION
SCALE: 1" = 3'-0"


WHEEL CHAIR RAMP (Rt. of Sta. 17+29.16 Rodgers P.L. #)

Note: Construction cost of Guard Rail and Wheel Chair Ramp shall be incidental to pay item 608.0100, Plain Concrete Sidewalk

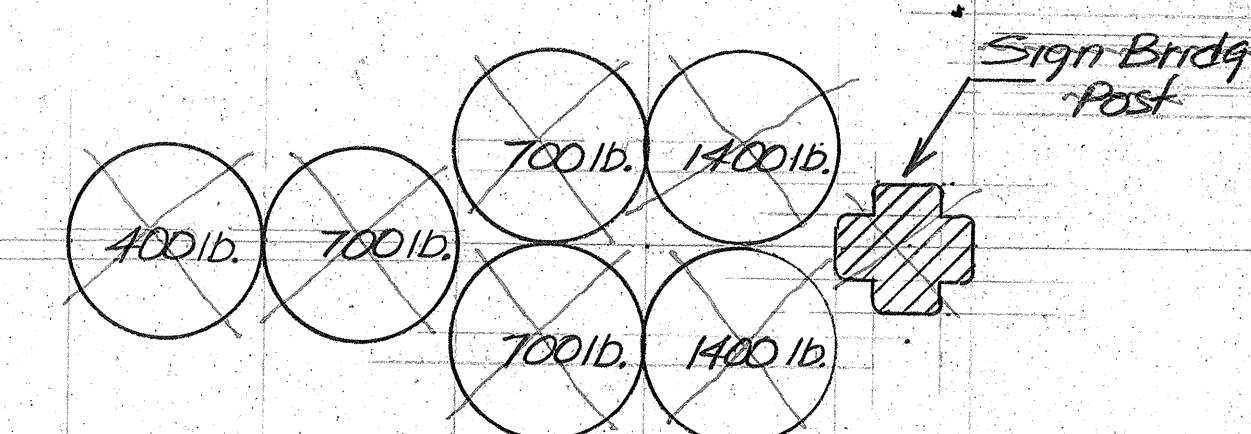

INERTIAL BARRIER AT SIGN BRIDGE POSTS

Note: Level installation site and install barriers as recommended by Manufacturer.

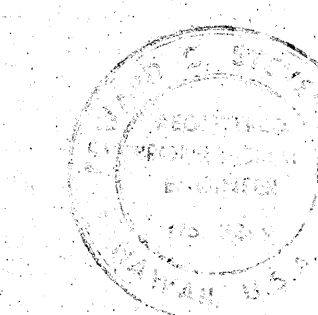

THIS WORK WAS PREPARED BY
FAC 08 UNDER CONTRACT NO. 100-100-0000
Edward H. [Signature]



STATE OF HAWAII
DEPARTMENT OF TRANSPORTATION
HIGHWAYS DIVISION

CUSHION BARRIER, GUARD POST, & WHEEL CHAIR RAMP

AIRPORT INTERCHANGE
F.A.I. PROJ. NO. I-HI-1 (122):16
SCALE: AS SHOWN DATE: FEB. 1, 1977
SHEET No. 1 OF 1 SHEETS

32

DATE	_____
DESIGNED BY	_____
CHECKED BY	_____
NOTED BY	_____
QUANTITIES BY	_____
ORIGINAL PLAN	_____

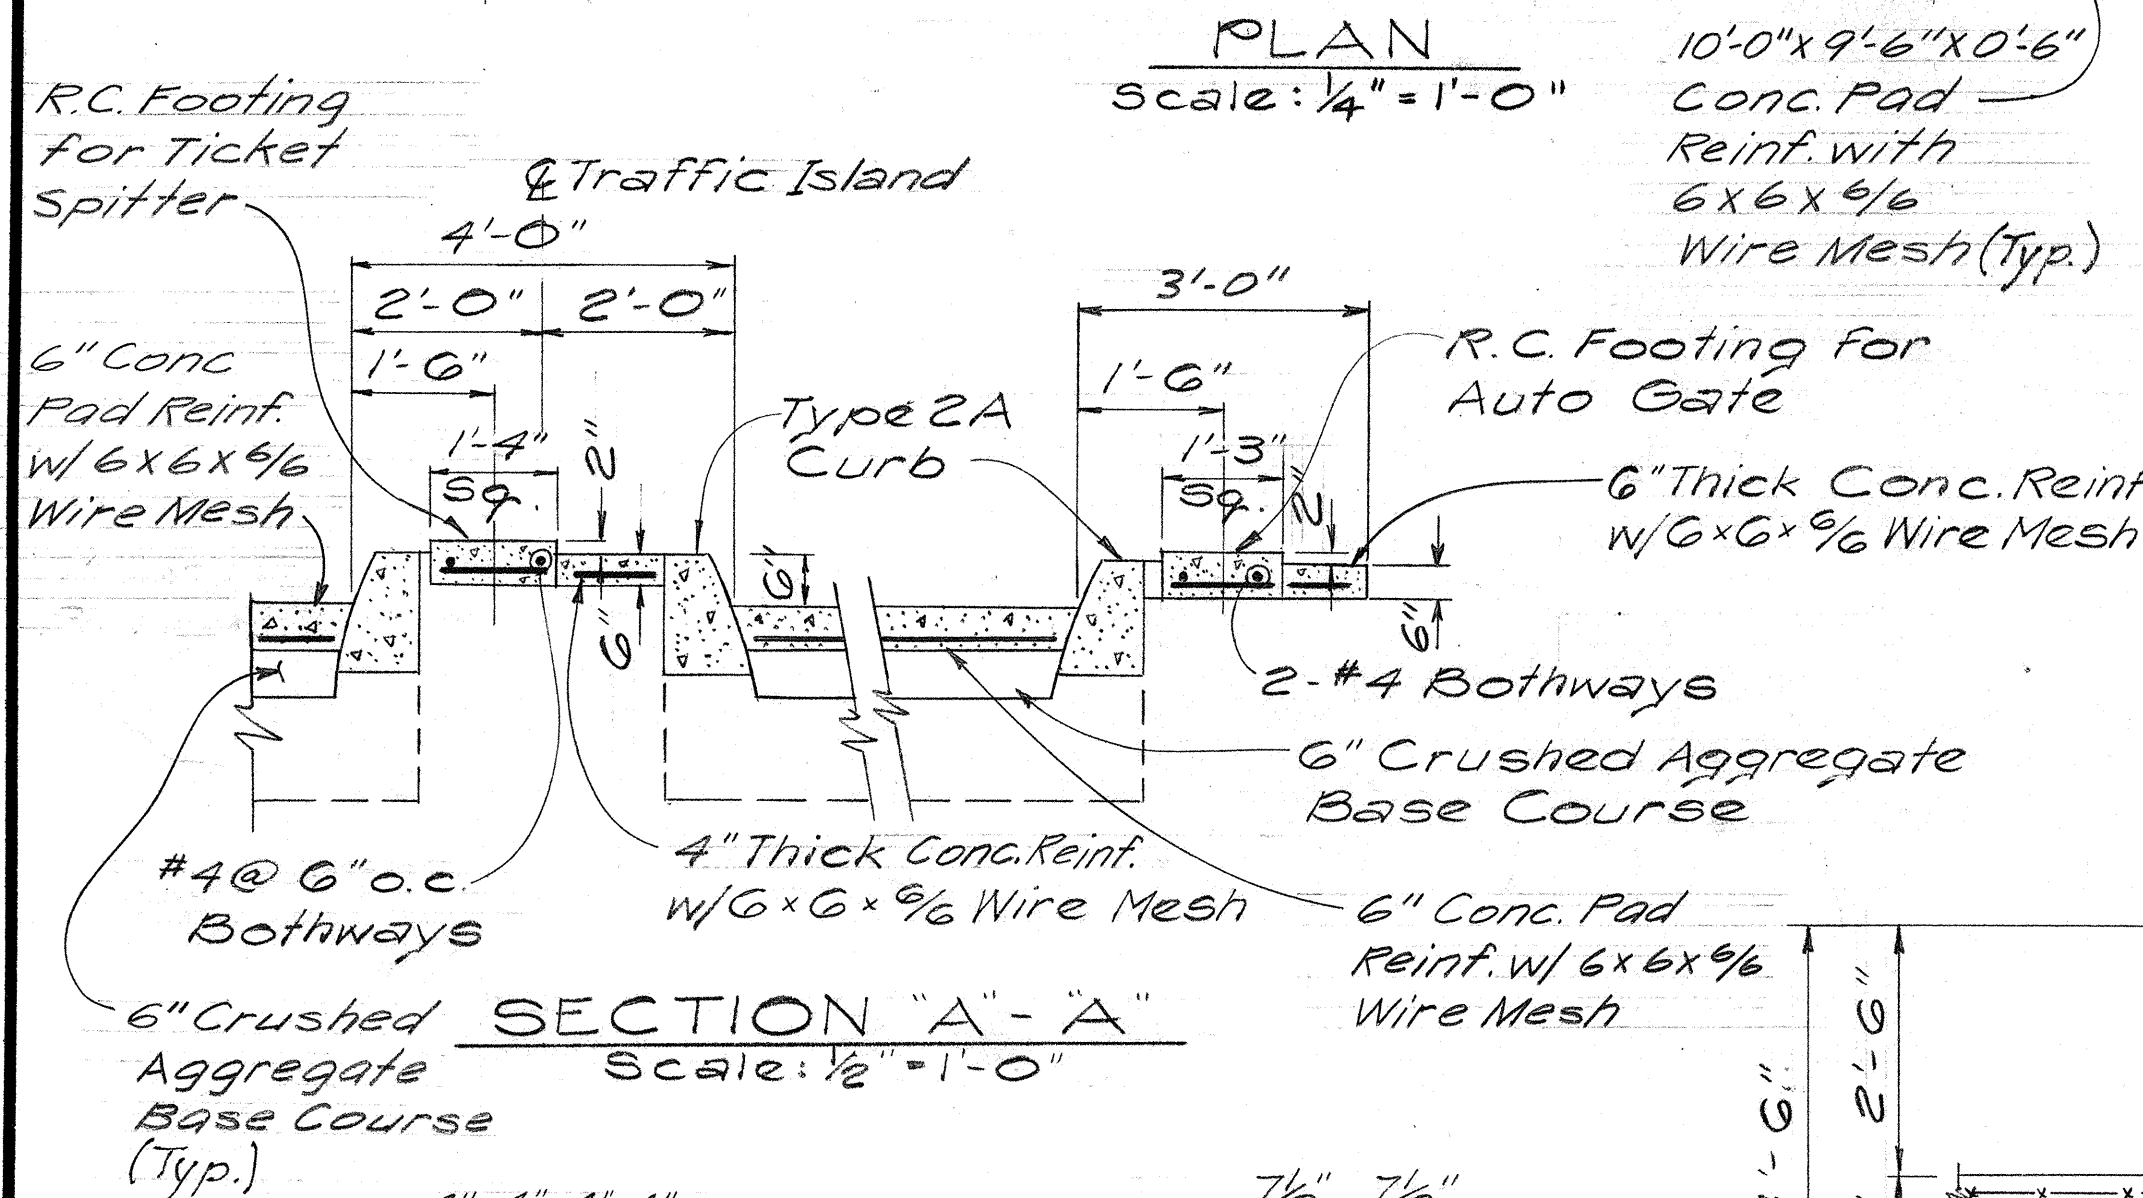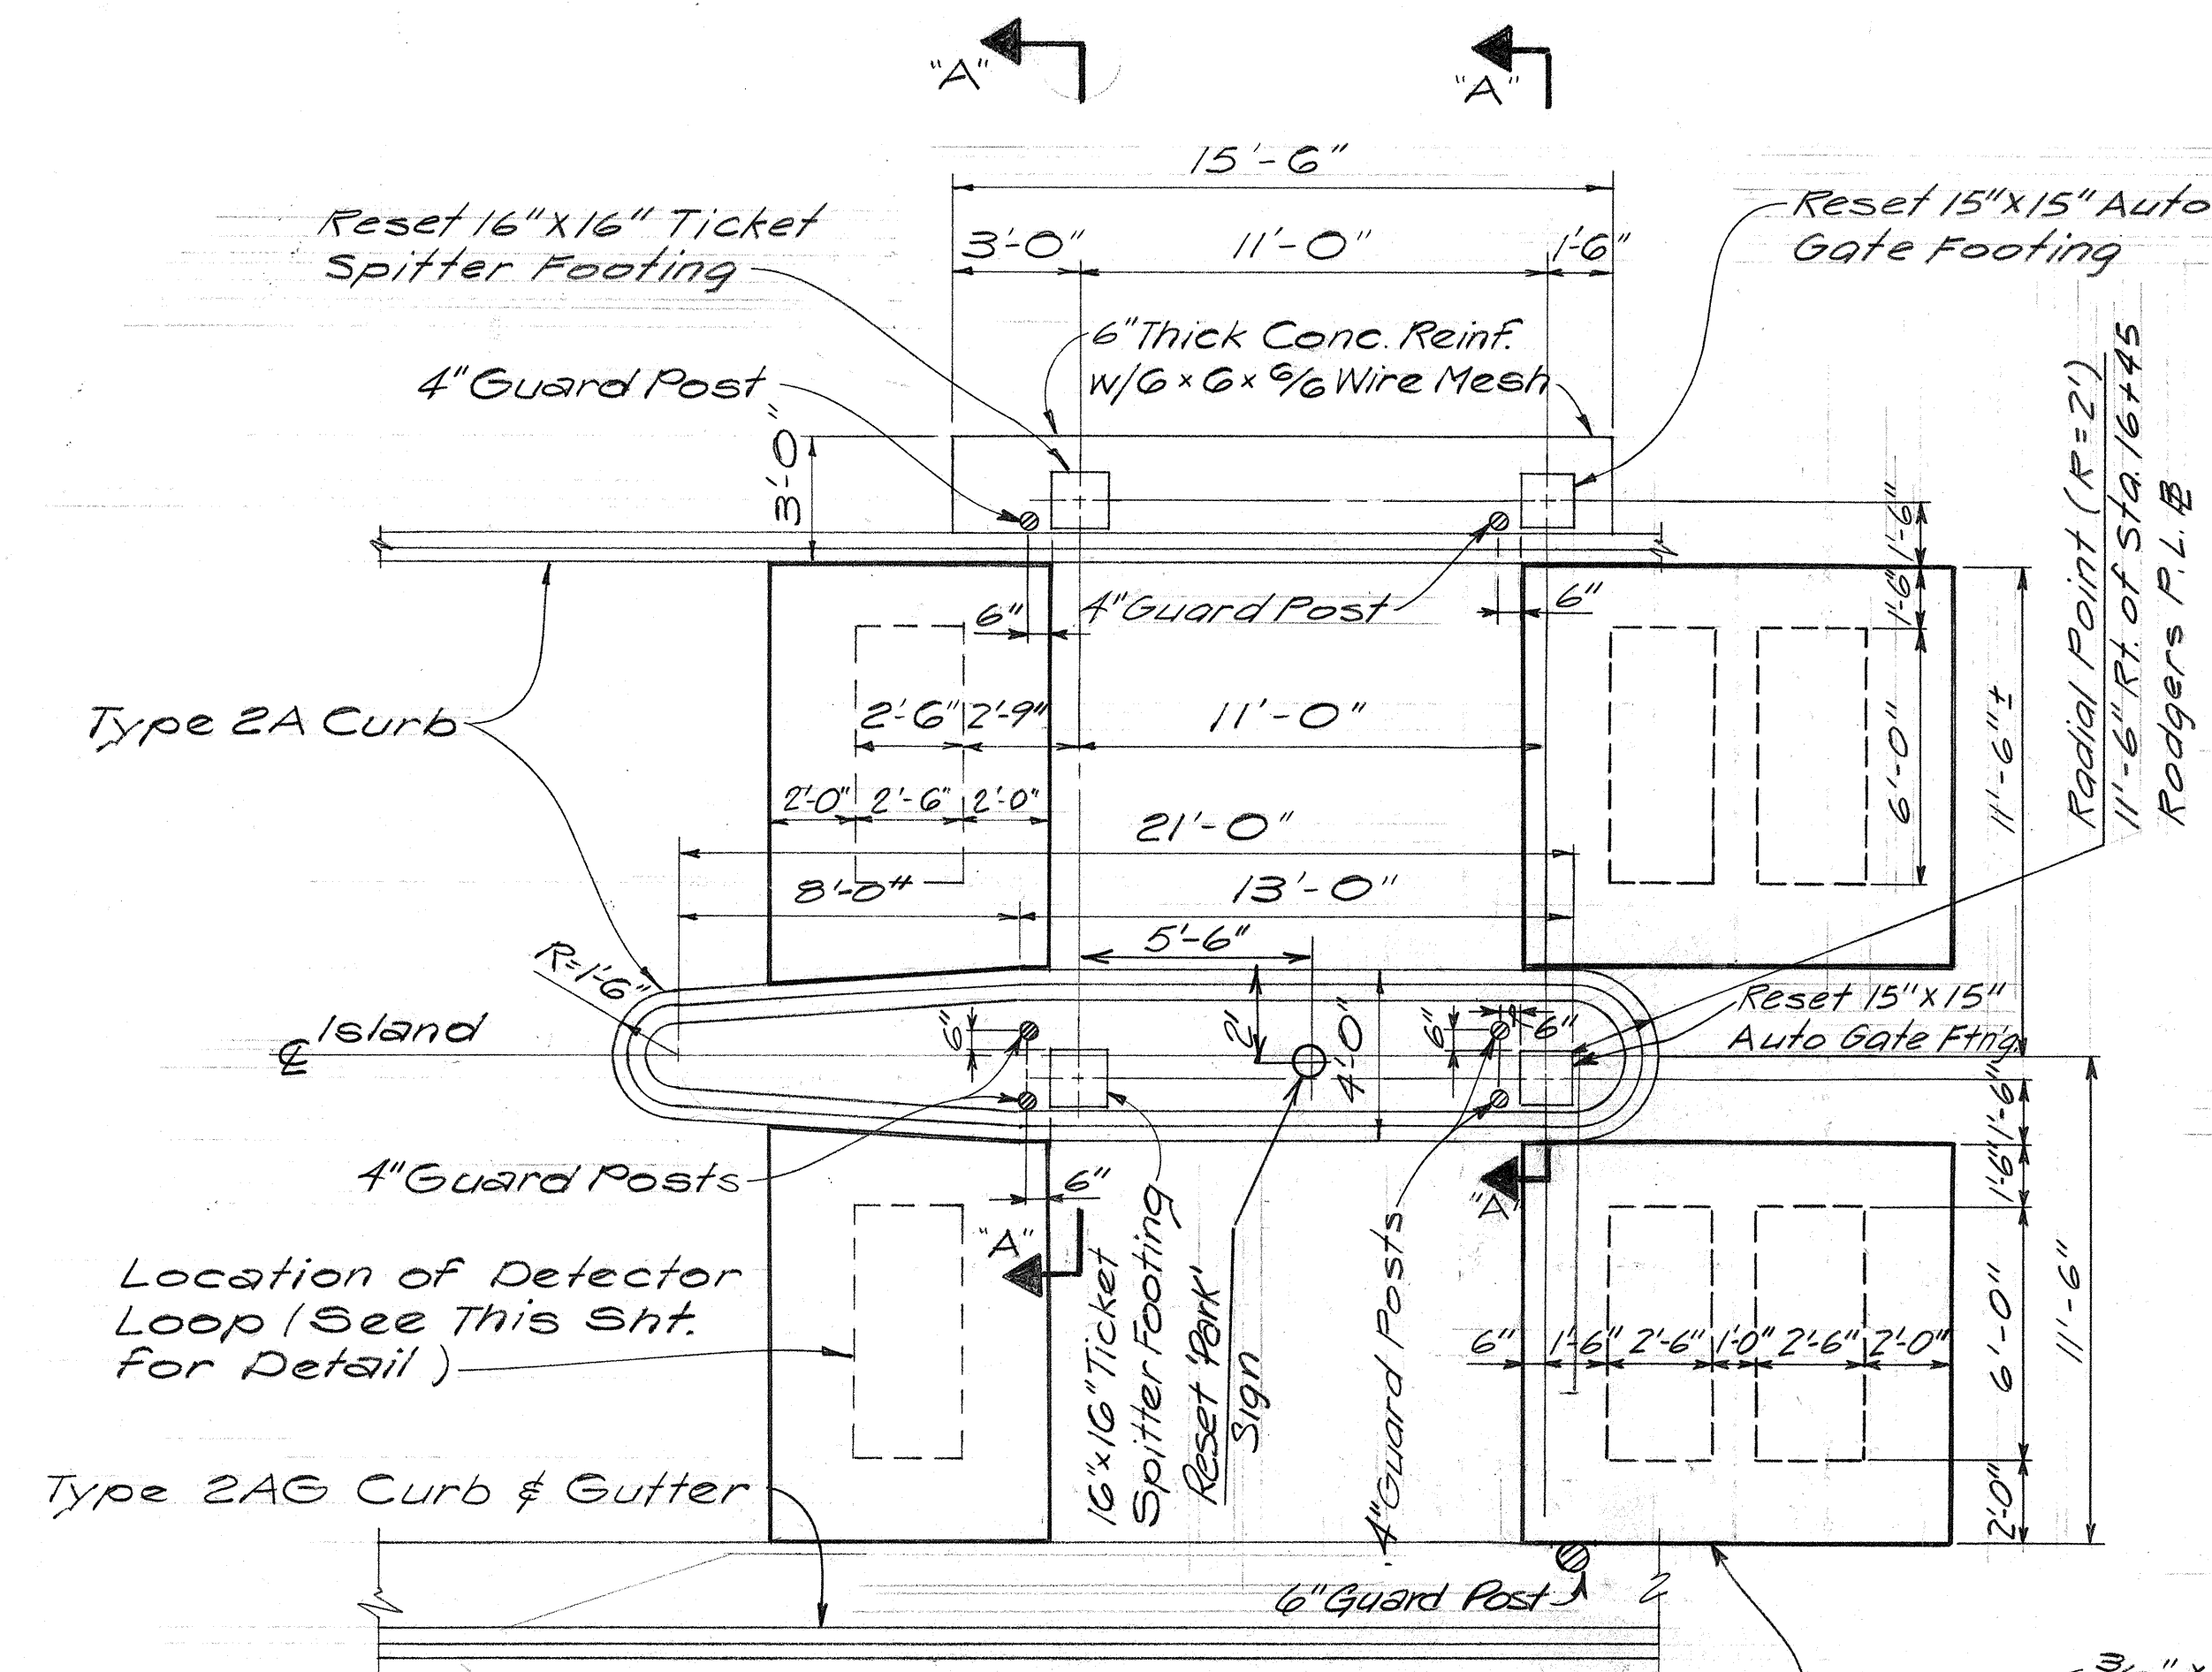


PLACEMENT OF CONDUIT FOR TICKET SPITTER
Scale: 1" = 1'-0"



PLACEMENT OF CONDUIT FOR AUTO GATE
Scale: 1" = 1'-0"

NOTE: 'A' = Conduit Area - Stub 2" above Surface.
'B' = All Holes 1/2" Dia. use 4 of 8 Holes in Ticket Spitter Base.

TICKET DISPENSER ASSEMBLY

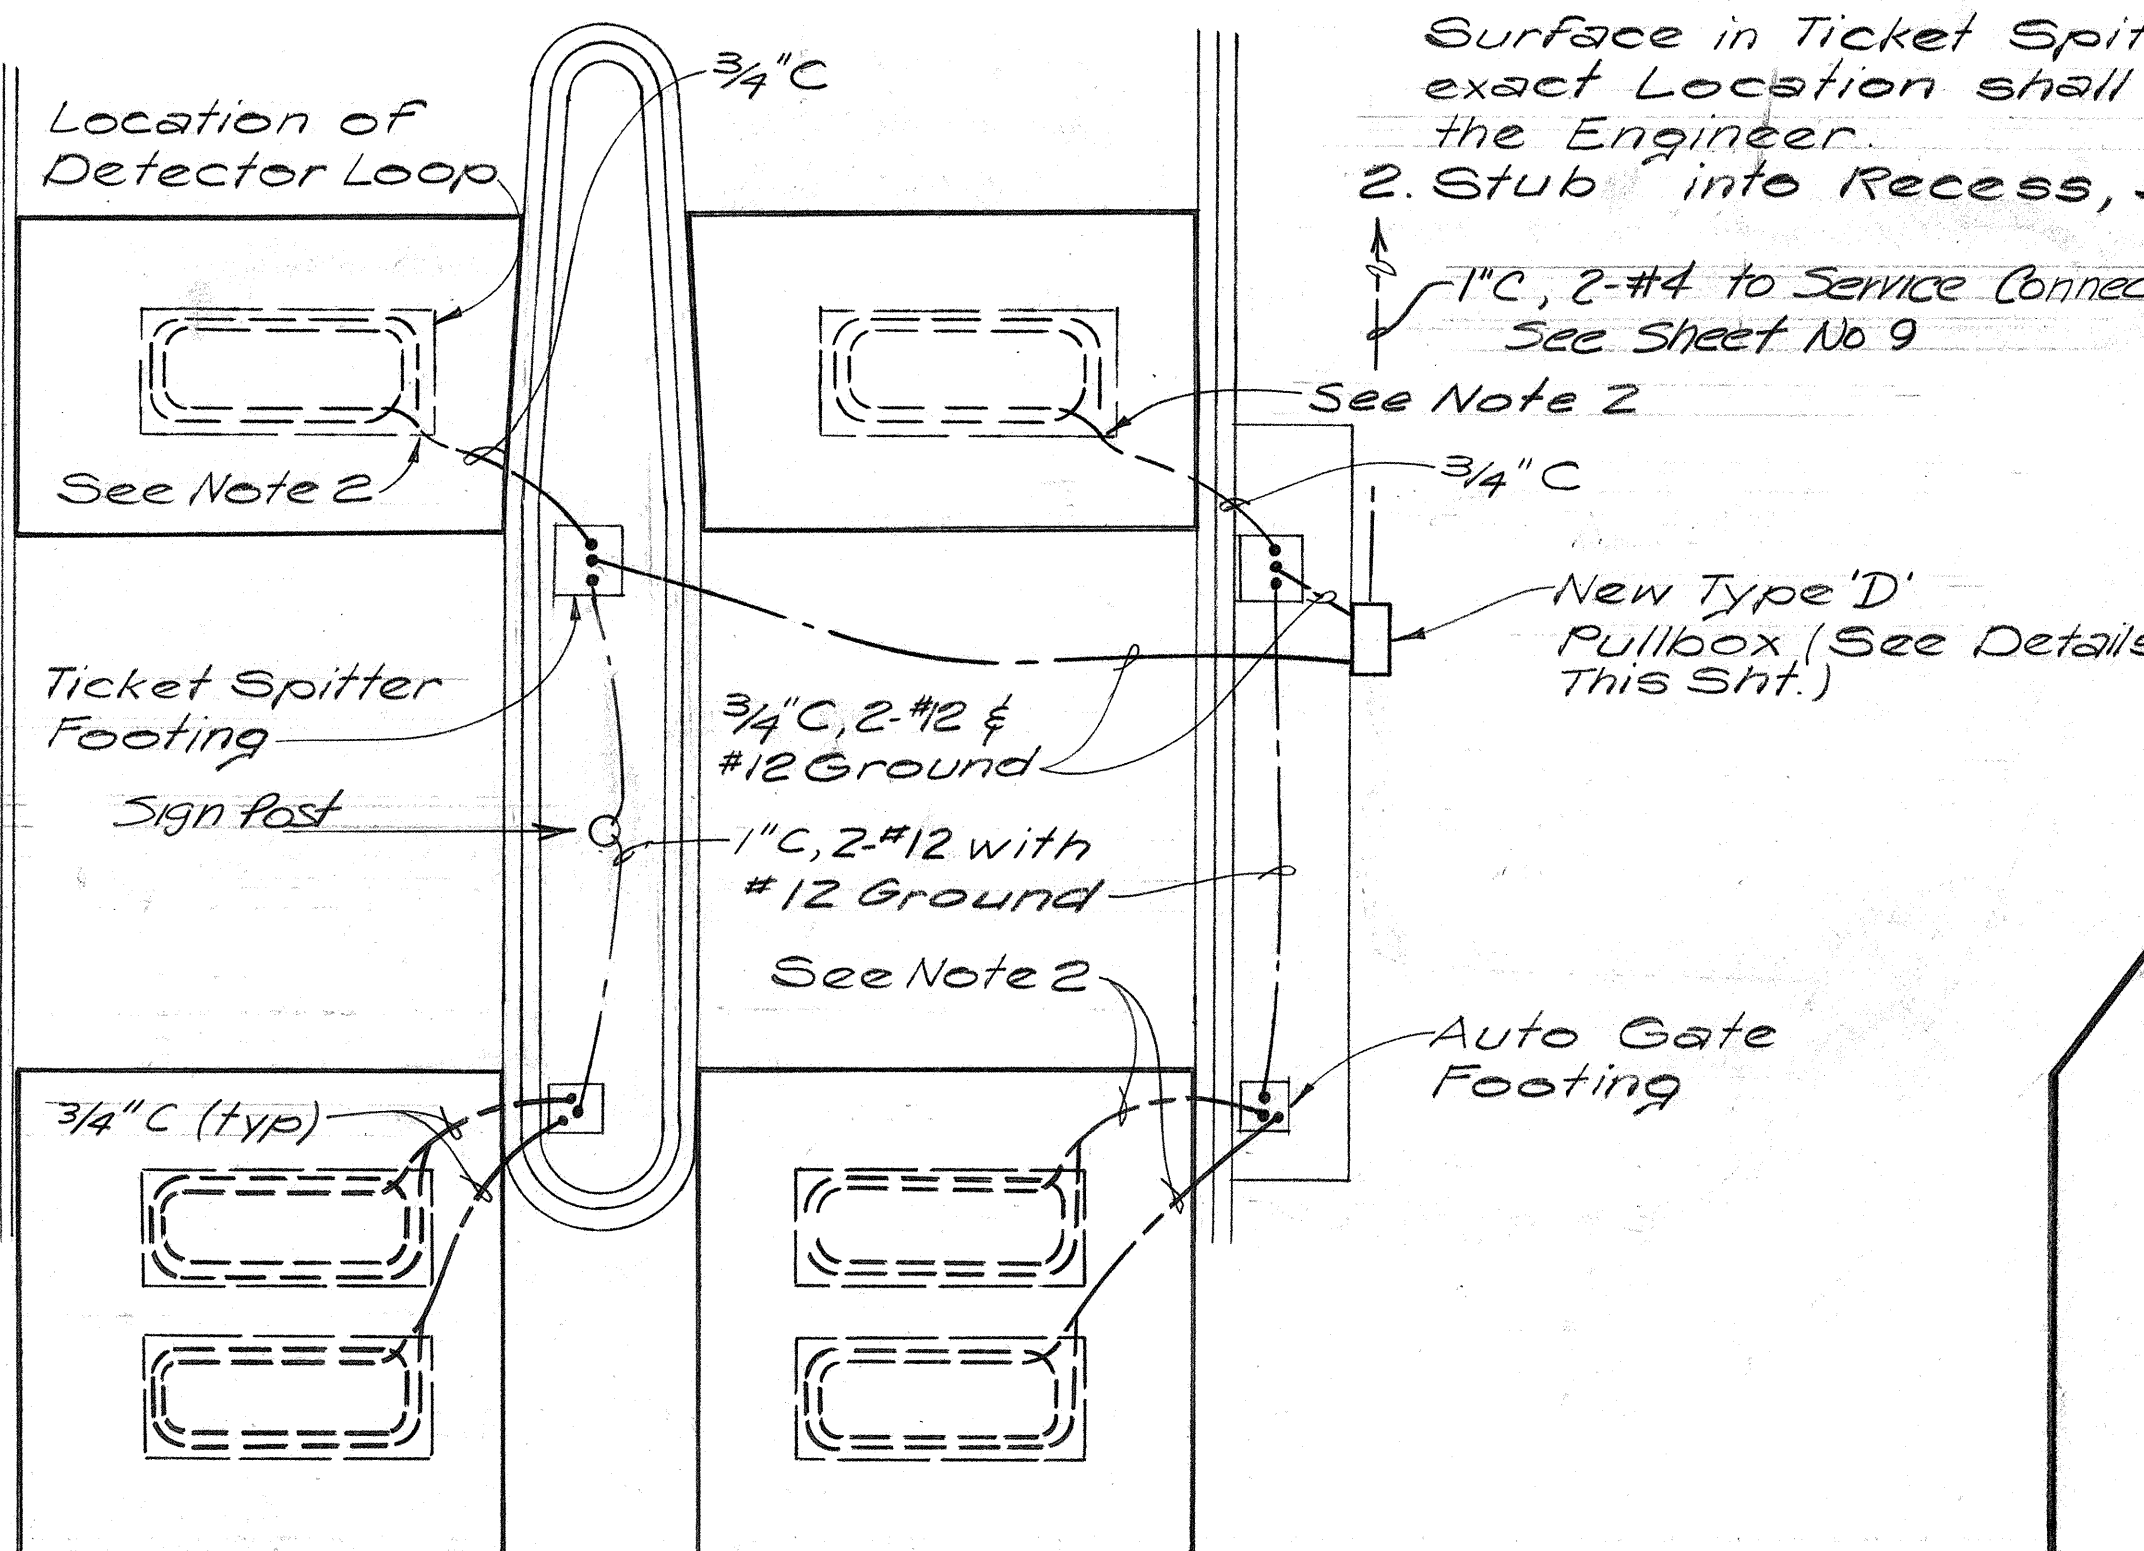

DETAIL ELECTRICAL PLAN
PARKING LOT ENTRANCE
No Scale

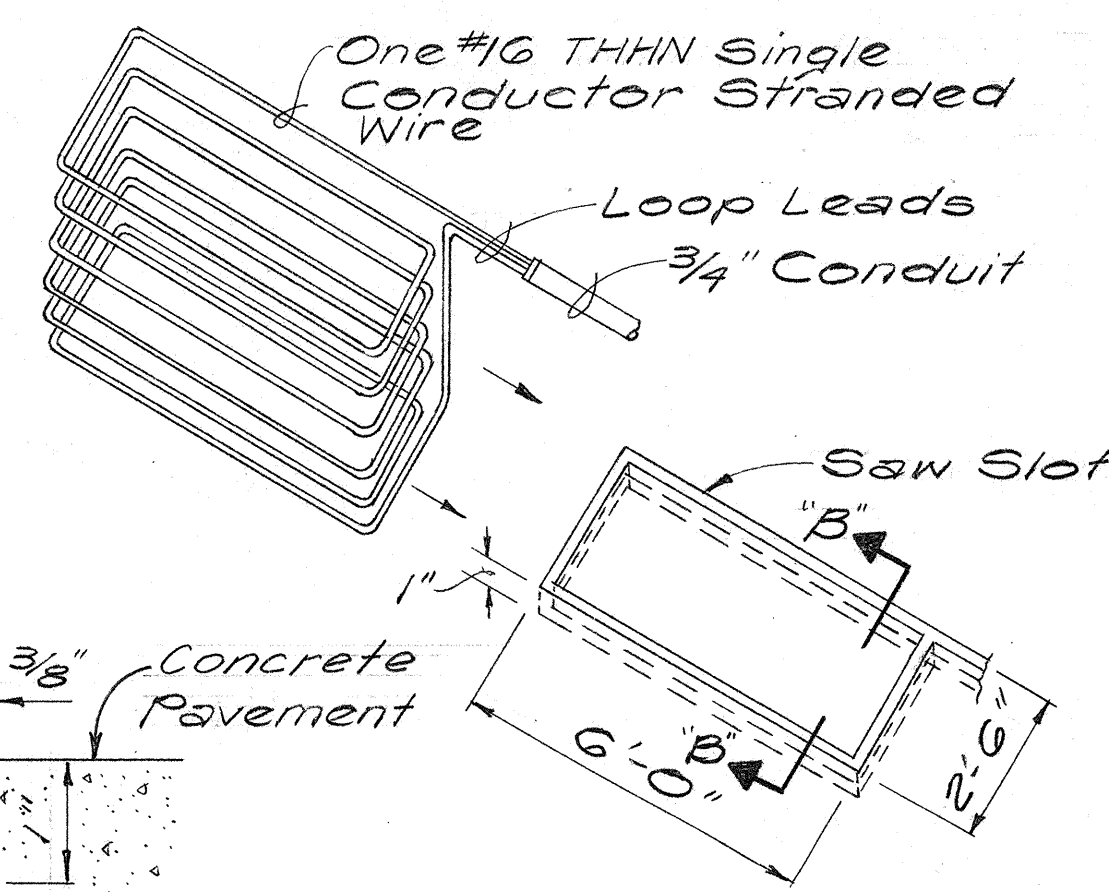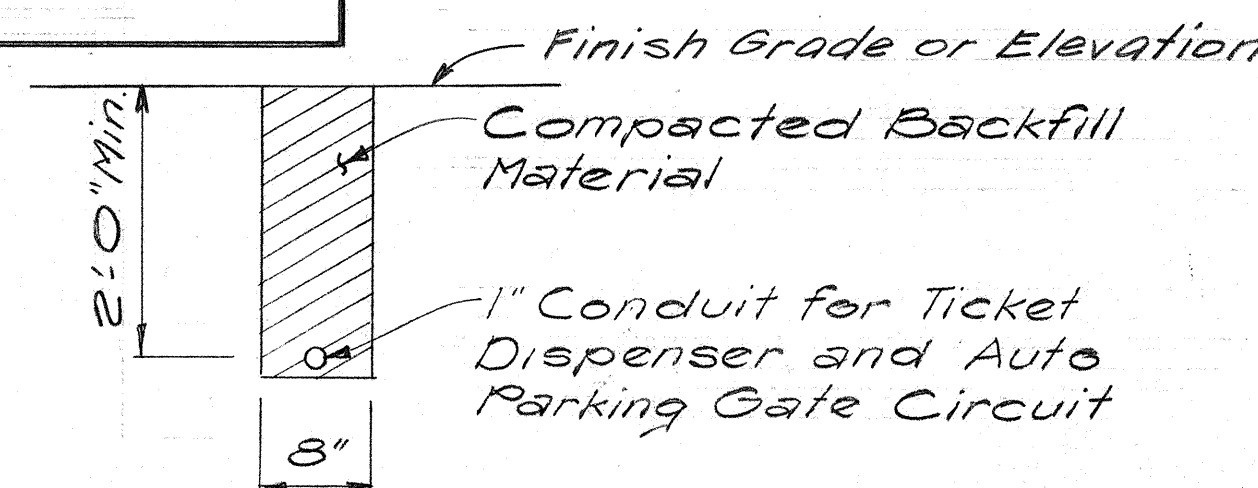

SECTION "B-B"
DETECTOR LOOP & SAW SLOT
No Scale

CAUTION: Do not fracture wire installation. Loop shorted to ground will cause detector malfunction. When placing wire in slot, do not use screwdriver or other sharp tools.

NOTES:

1. All Conduits shall be stubbed 2" above Surface in Ticket Spitter & Auto Gate exact Location shall be verified with the Engineer.
2. Stub into Recess, 3" below Surface

1" C, 2-#12 to Service Connection
See Sheet No. 9

See Note 2

See Note 2

FED. ROAD DIST. NO.	STATE	FED. AID PROJ. NO.	FISCAL YEAR	SHEET NO.	TOTAL SHEETS
HAWAII	HAW.	I-HI(122)16	1977	33	101
NO.	DATE	REVISION			
1	11-1-77	Relocated & increased Cast Iron Guard Posts. Added Conc. Pads at Loop Detectors.			
2	11-29-77	Added 2 more Loop Detectors			
3	8-14-77	Added 6" Guard Post.			

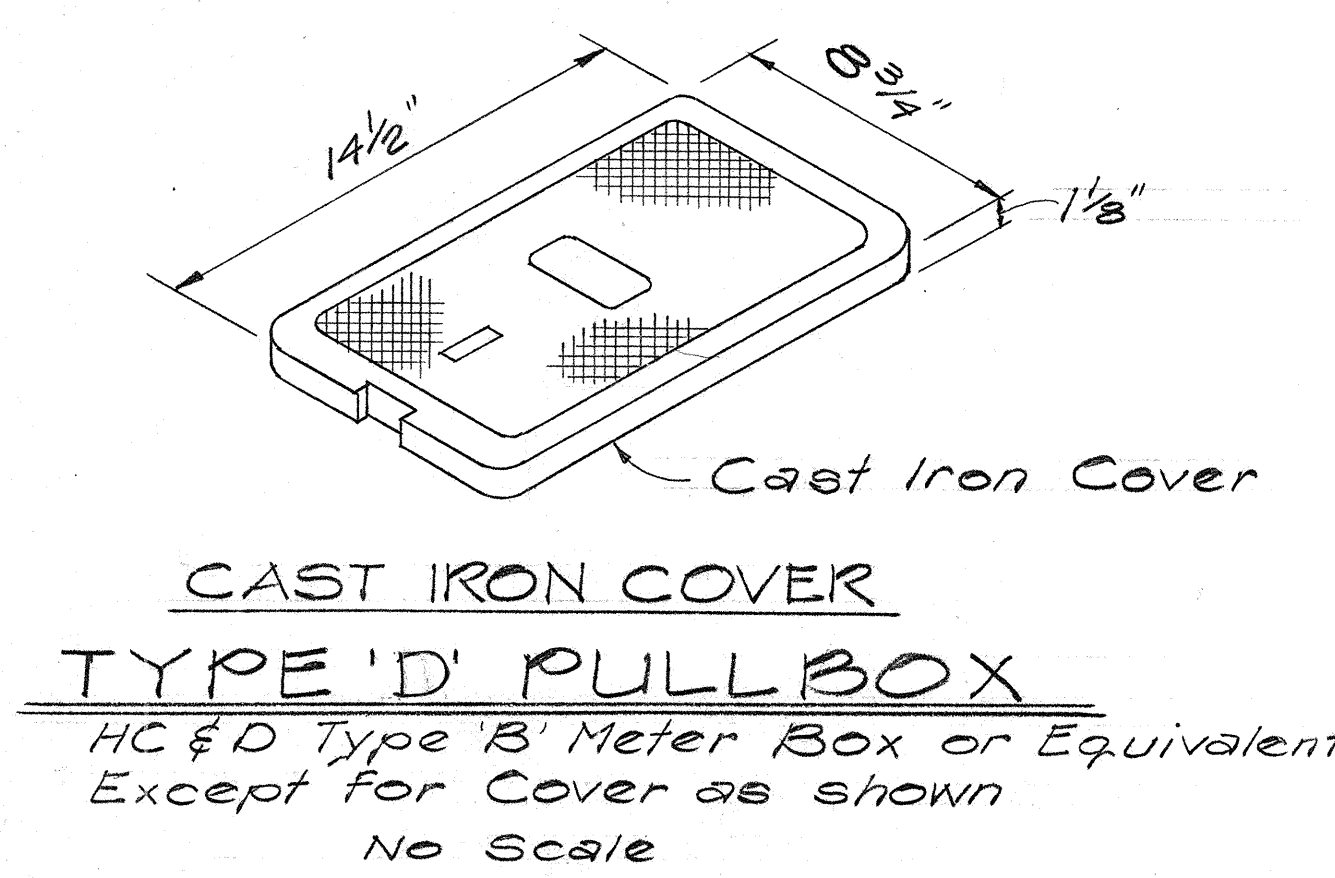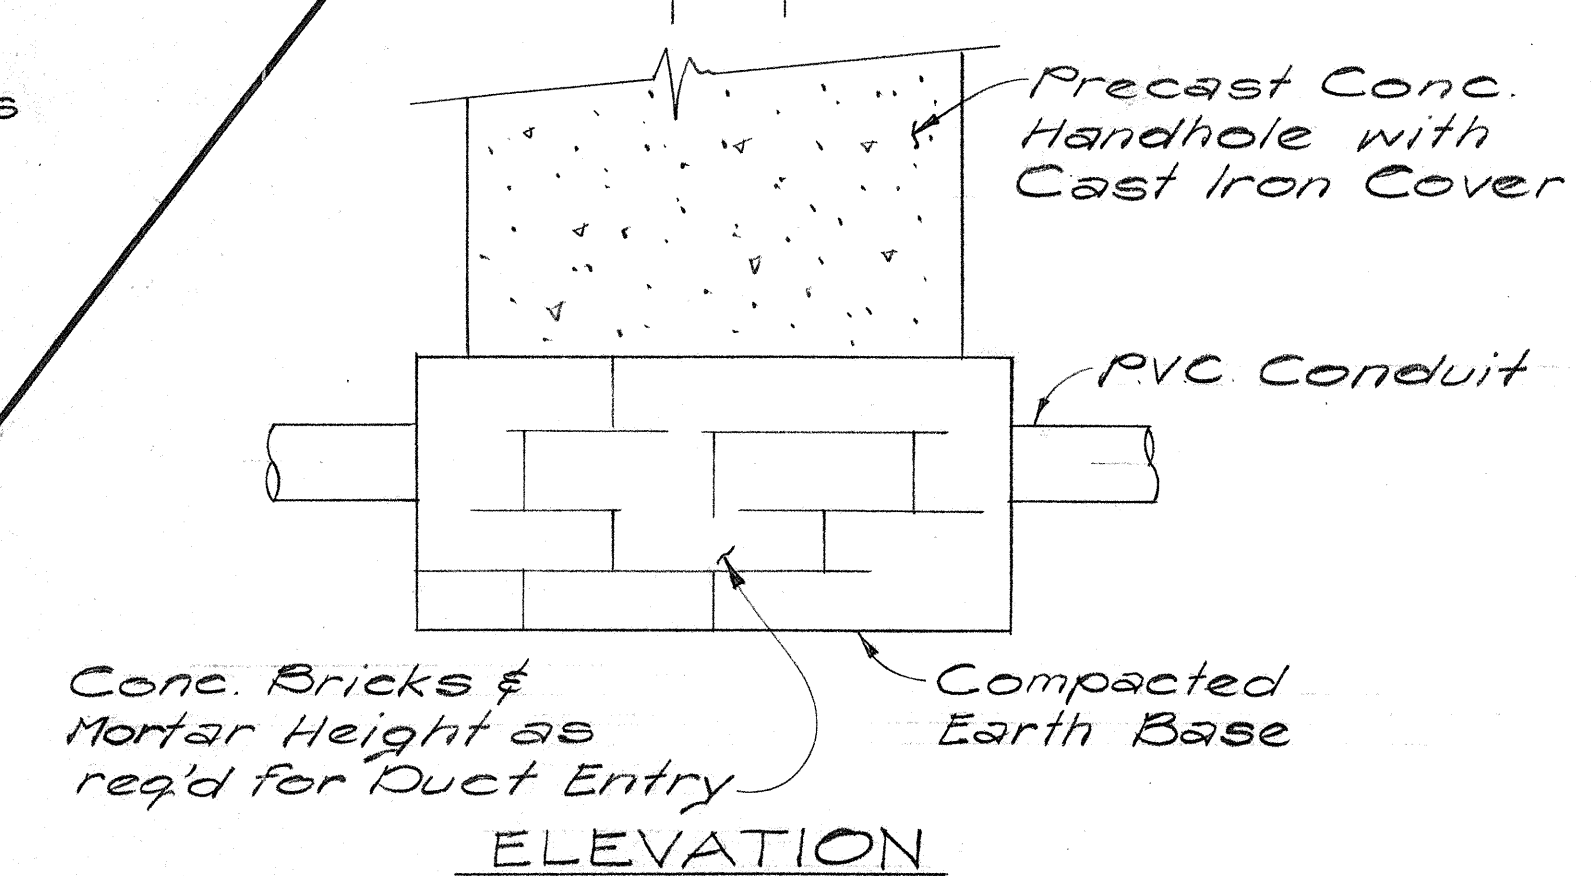

TYPICAL LAYOUT FOR LOOP
Saw Slot 3/8" Wide x 1" Deep. Make Rectangular Shape to specified Loop Dimensions plus Slot for Lead Conduit. Grout with No. 202 Weatherban Sealant, a product of 3M Co., or equal.

NOTES:

1. Loop Leads are limited to 100 Feet.
2. Loop Leads must have Four (4) Twist per Foot.
3. Loop must have Six (6) Turns.
4. Loop & Loop Leads must be located at least 18" from any Electrical Power Service or Runs.
5. Loop Leads must be in separate Conduit between Loop and Amplifier. They must not share Conduit with other wiring or Leads from other Loops.
6. Use #16 THHN Single Conductor Stranded Wire.

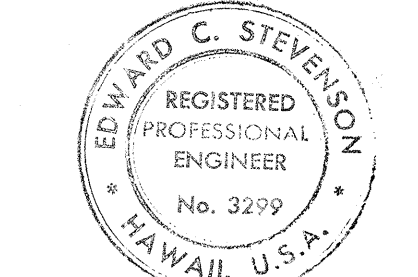

THIS WORK WAS PREPARED BY ME OR UNDER MY SUPERVISION.
Signature

STATE OF HAWAII
DEPARTMENT OF TRANSPORTATION
HIGHWAYS DIVISION

RESET PARKING GATE ASSEMBLY

AIRPORT INTERCHANGE
F.A.I. PROJ. NO. I-HI-1(122):16

SCALE: AS SHOWN DATE: MAY 1, 1977

SHEET NO. 1 OF 1 SHEETS