




FED. ROAD DIST. NO.	STATE	FED. AID PROJ. NO.	FISCAL YEAR	SHEET NO.	TOTAL SHEETS
HAWAII	HAW.	I-HI-1(131):17	1977	38	394

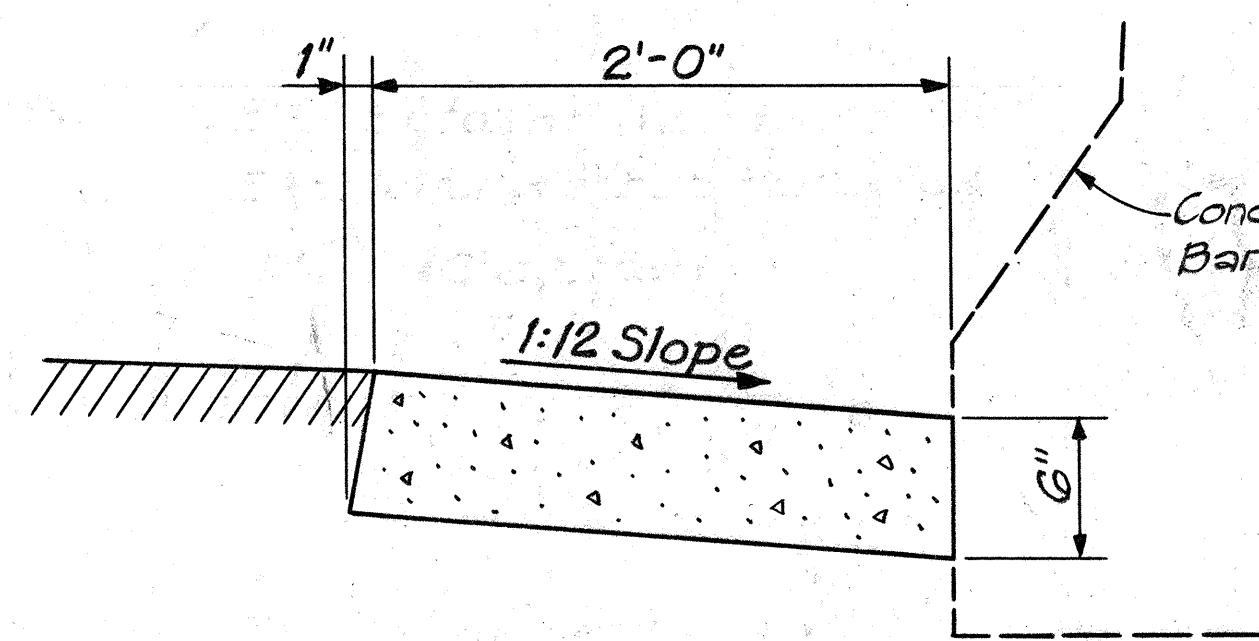


DETAIL-GUTTER, TYPE 2A
Scale: $1\frac{1}{2}''=1'-0''$

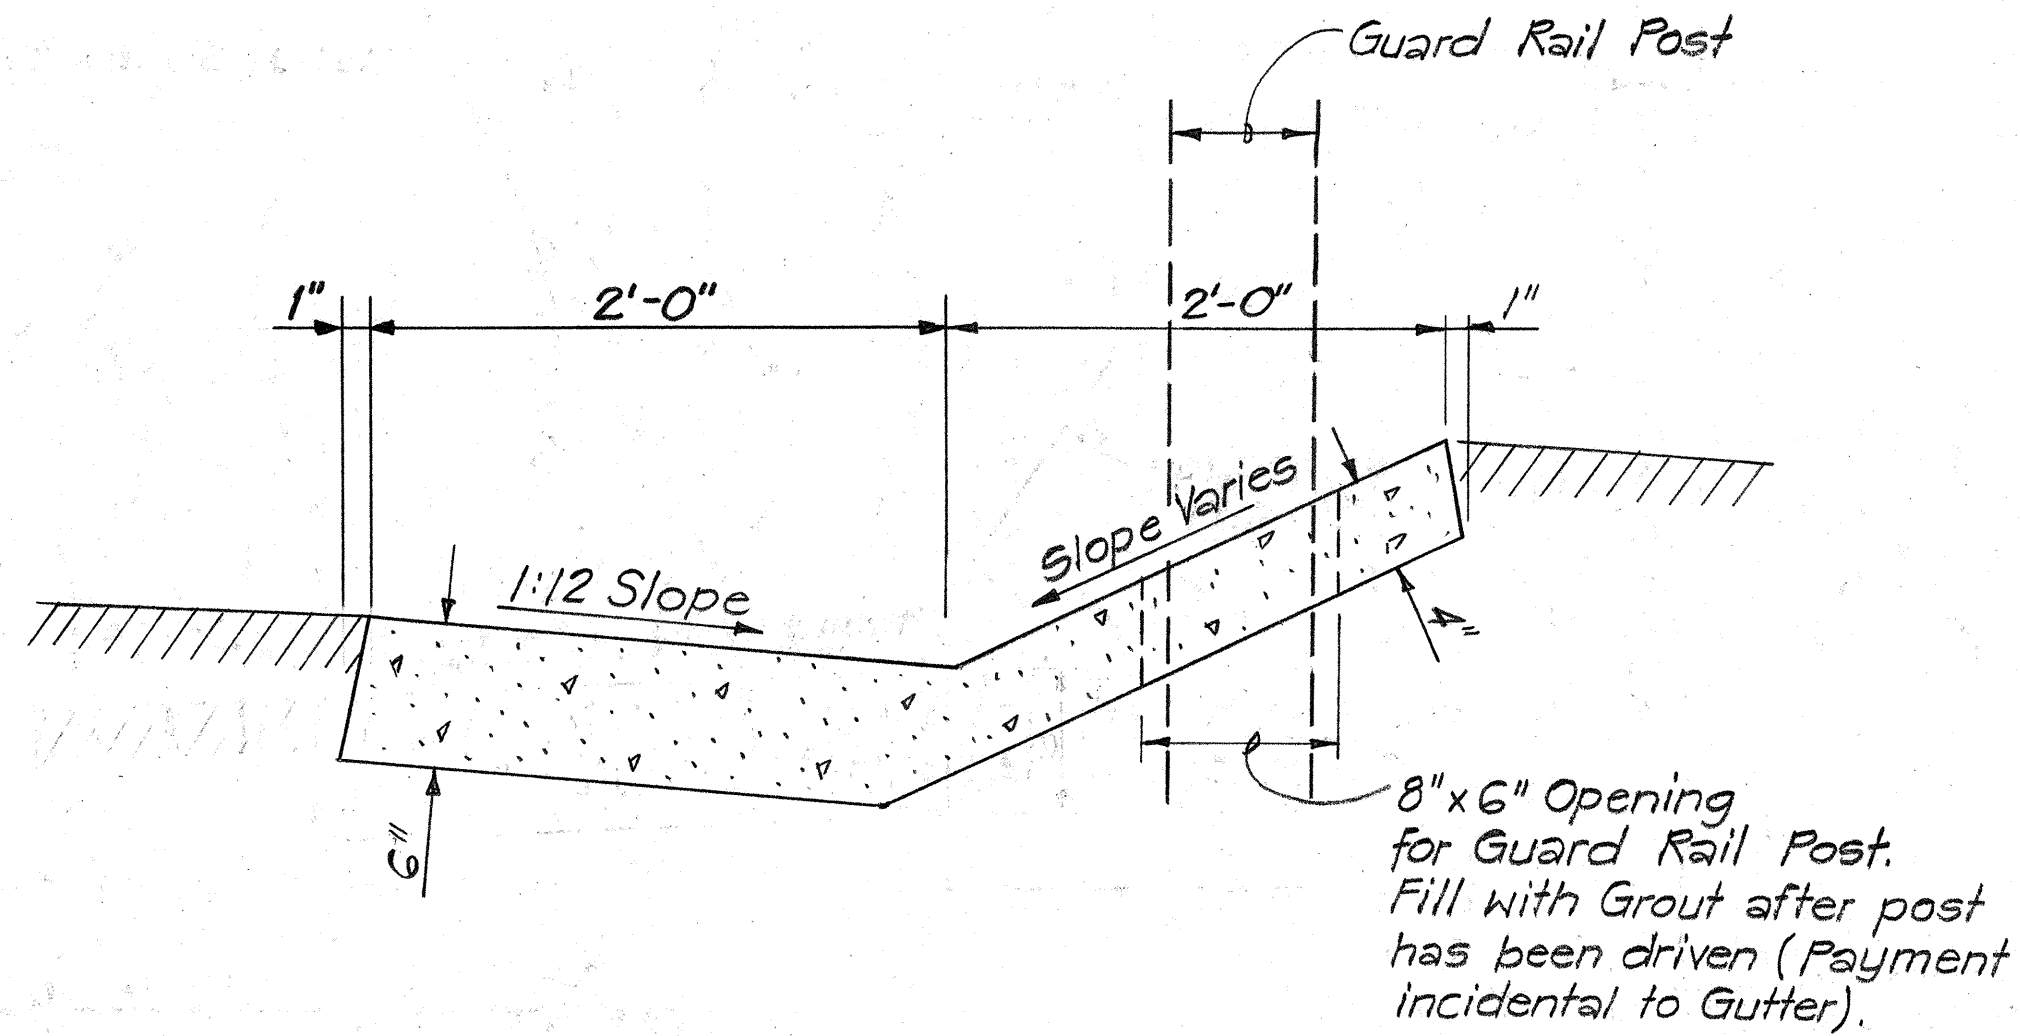


DETAIL-GUTTER, TYPE 2B
Scale: $1\frac{1}{2}''=1'-0''$

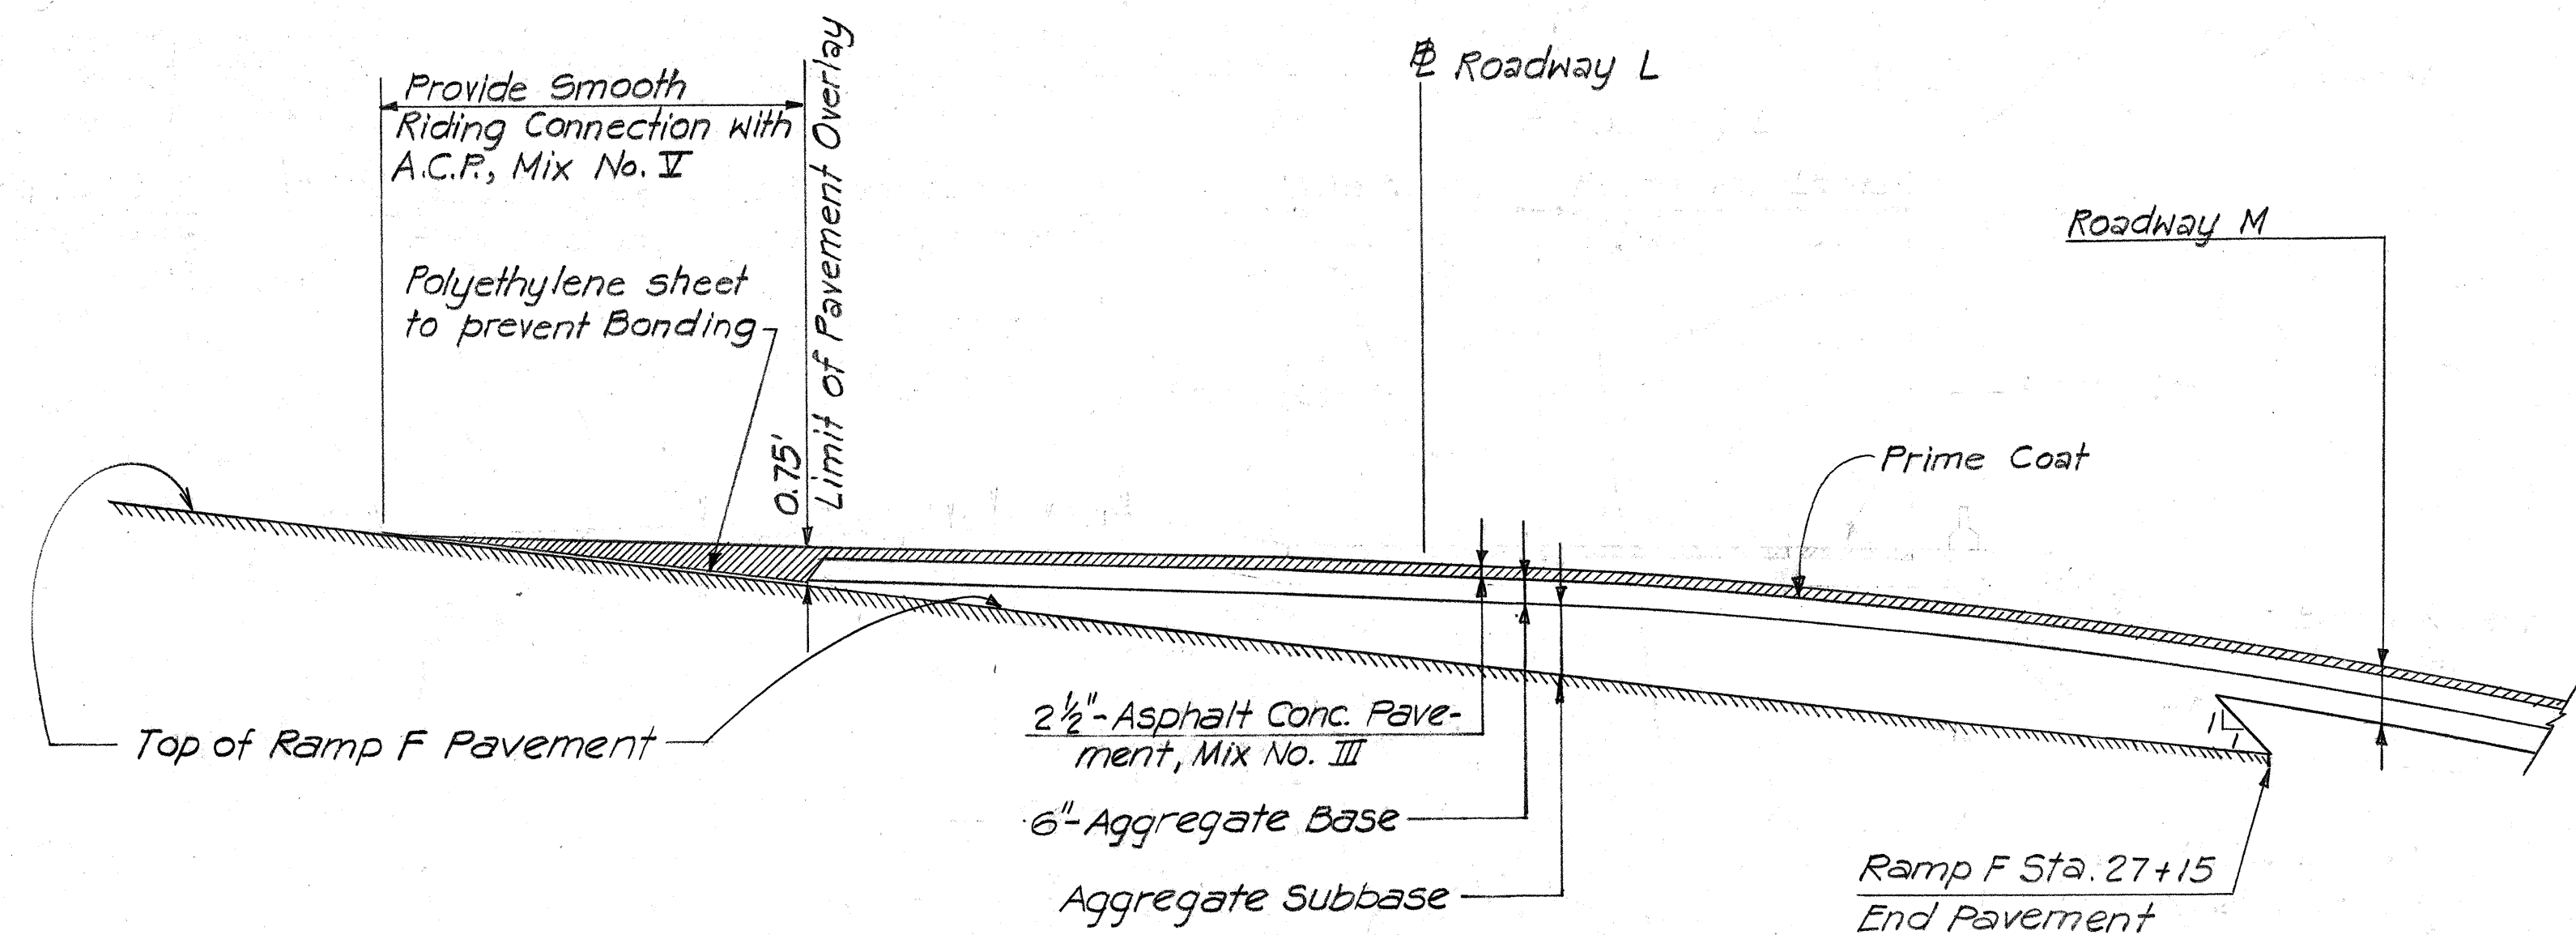


SECTION A (Ramp F, Roadway L & M Intersection)
N.T.S.

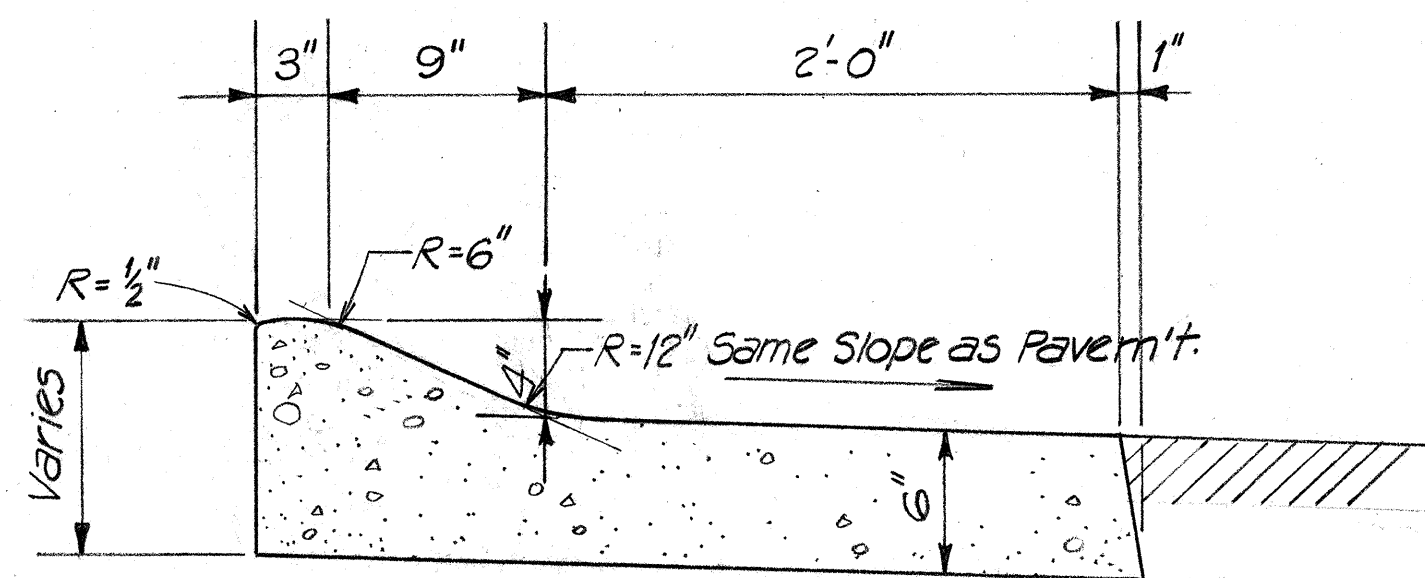


DETAIL-CURB & GUTTER, TYPE 2EGM
Scale: $1\frac{1}{2}''=1'-0''$

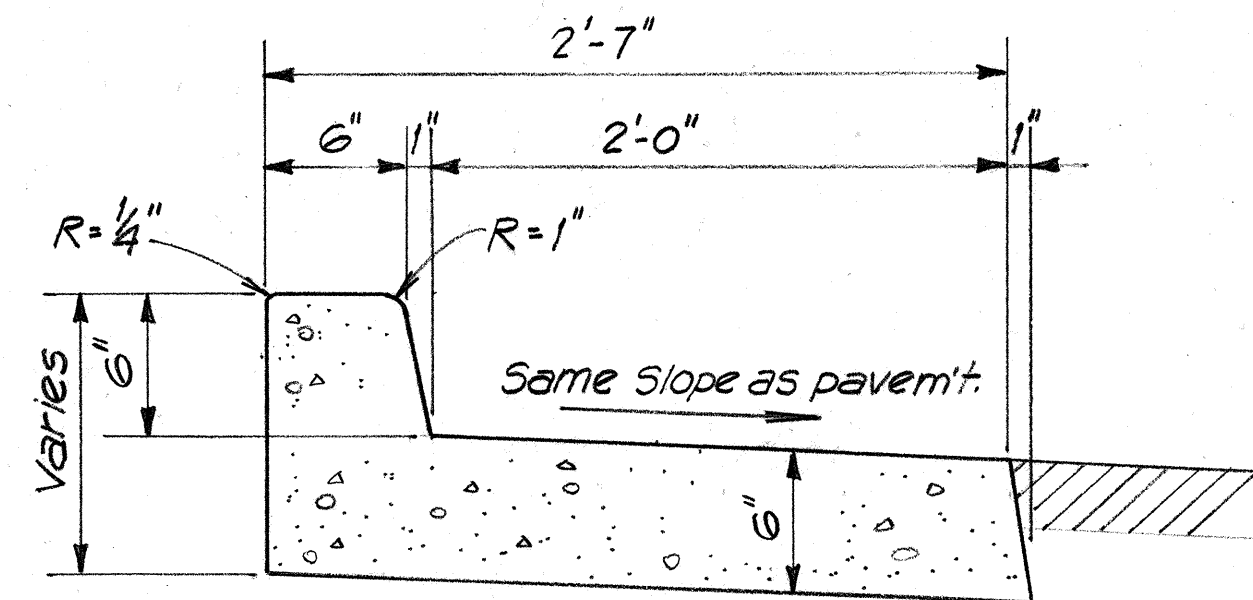

DETAIL-CURB & GUTTER, TYPE 2DGM
Scale: $1\frac{1}{2}''=1'-0''$

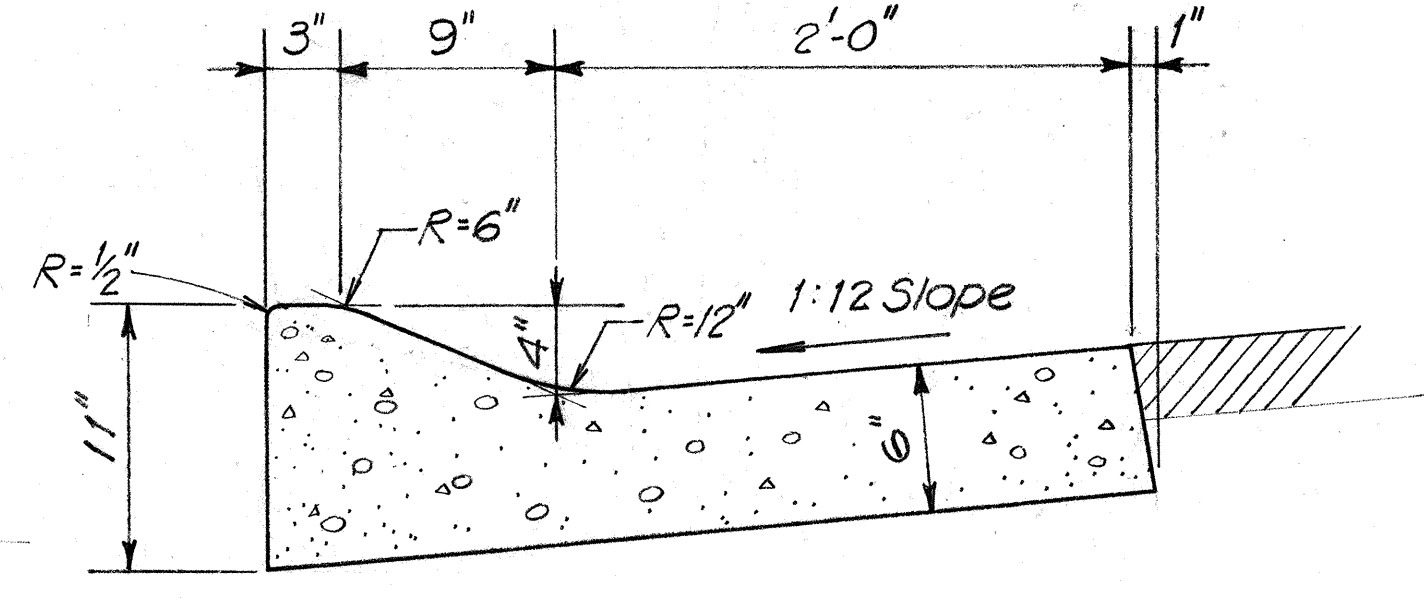



DETAIL-CURB & GUTTER, TYPE 2EG
Scale: $1\frac{1}{2}''=1'-0''$

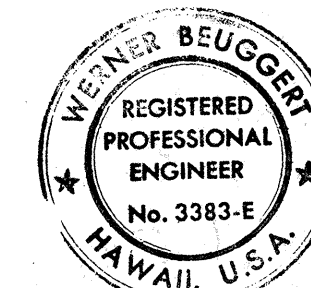


THIS WORK WAS PREPARED BY ME
OR UNDER MY SUPERVISION.
Werner Beugert

9/15/78	Revised Section A 33/38
DATE	REVISION
STATE OF HAWAII DEPARTMENT OF TRANSPORTATION HIGHWAYS DIVISION	
MISCELLANEOUS DETAILS	
INTERSTATE ROUTE H-1 PROJECT NO. I-HI-1 (131):17	
SCALE: AS SHOWN	DATE: AUG. 31, 1977
SHEET NO. 1 OF 26 SHEETS	


FED. ROAD DIST. NO.	STATE	FED. AID PROJ. NO.	FISCAL YEAR	SHEET NO.	TOTAL SHEETS
HAWAII	HAW.	1-HI-1(131):17	1977	39	394

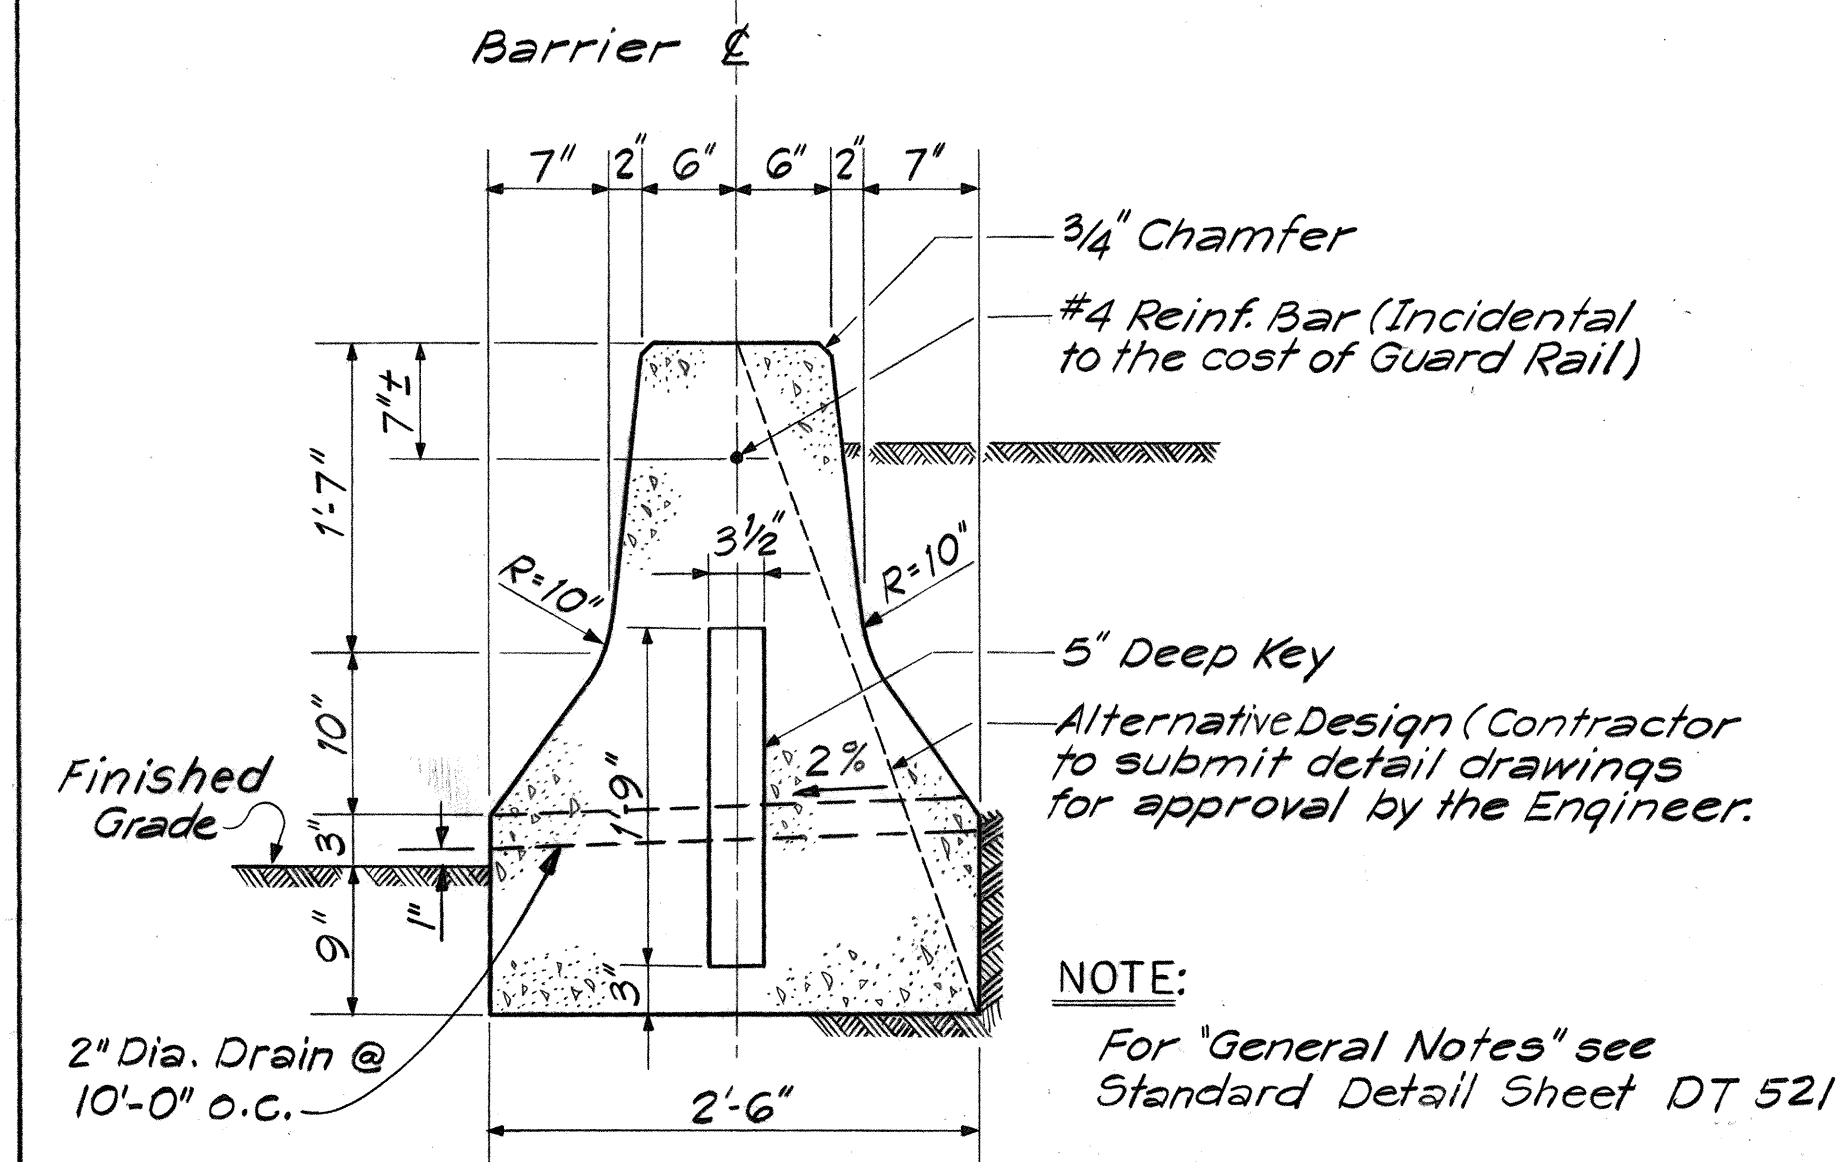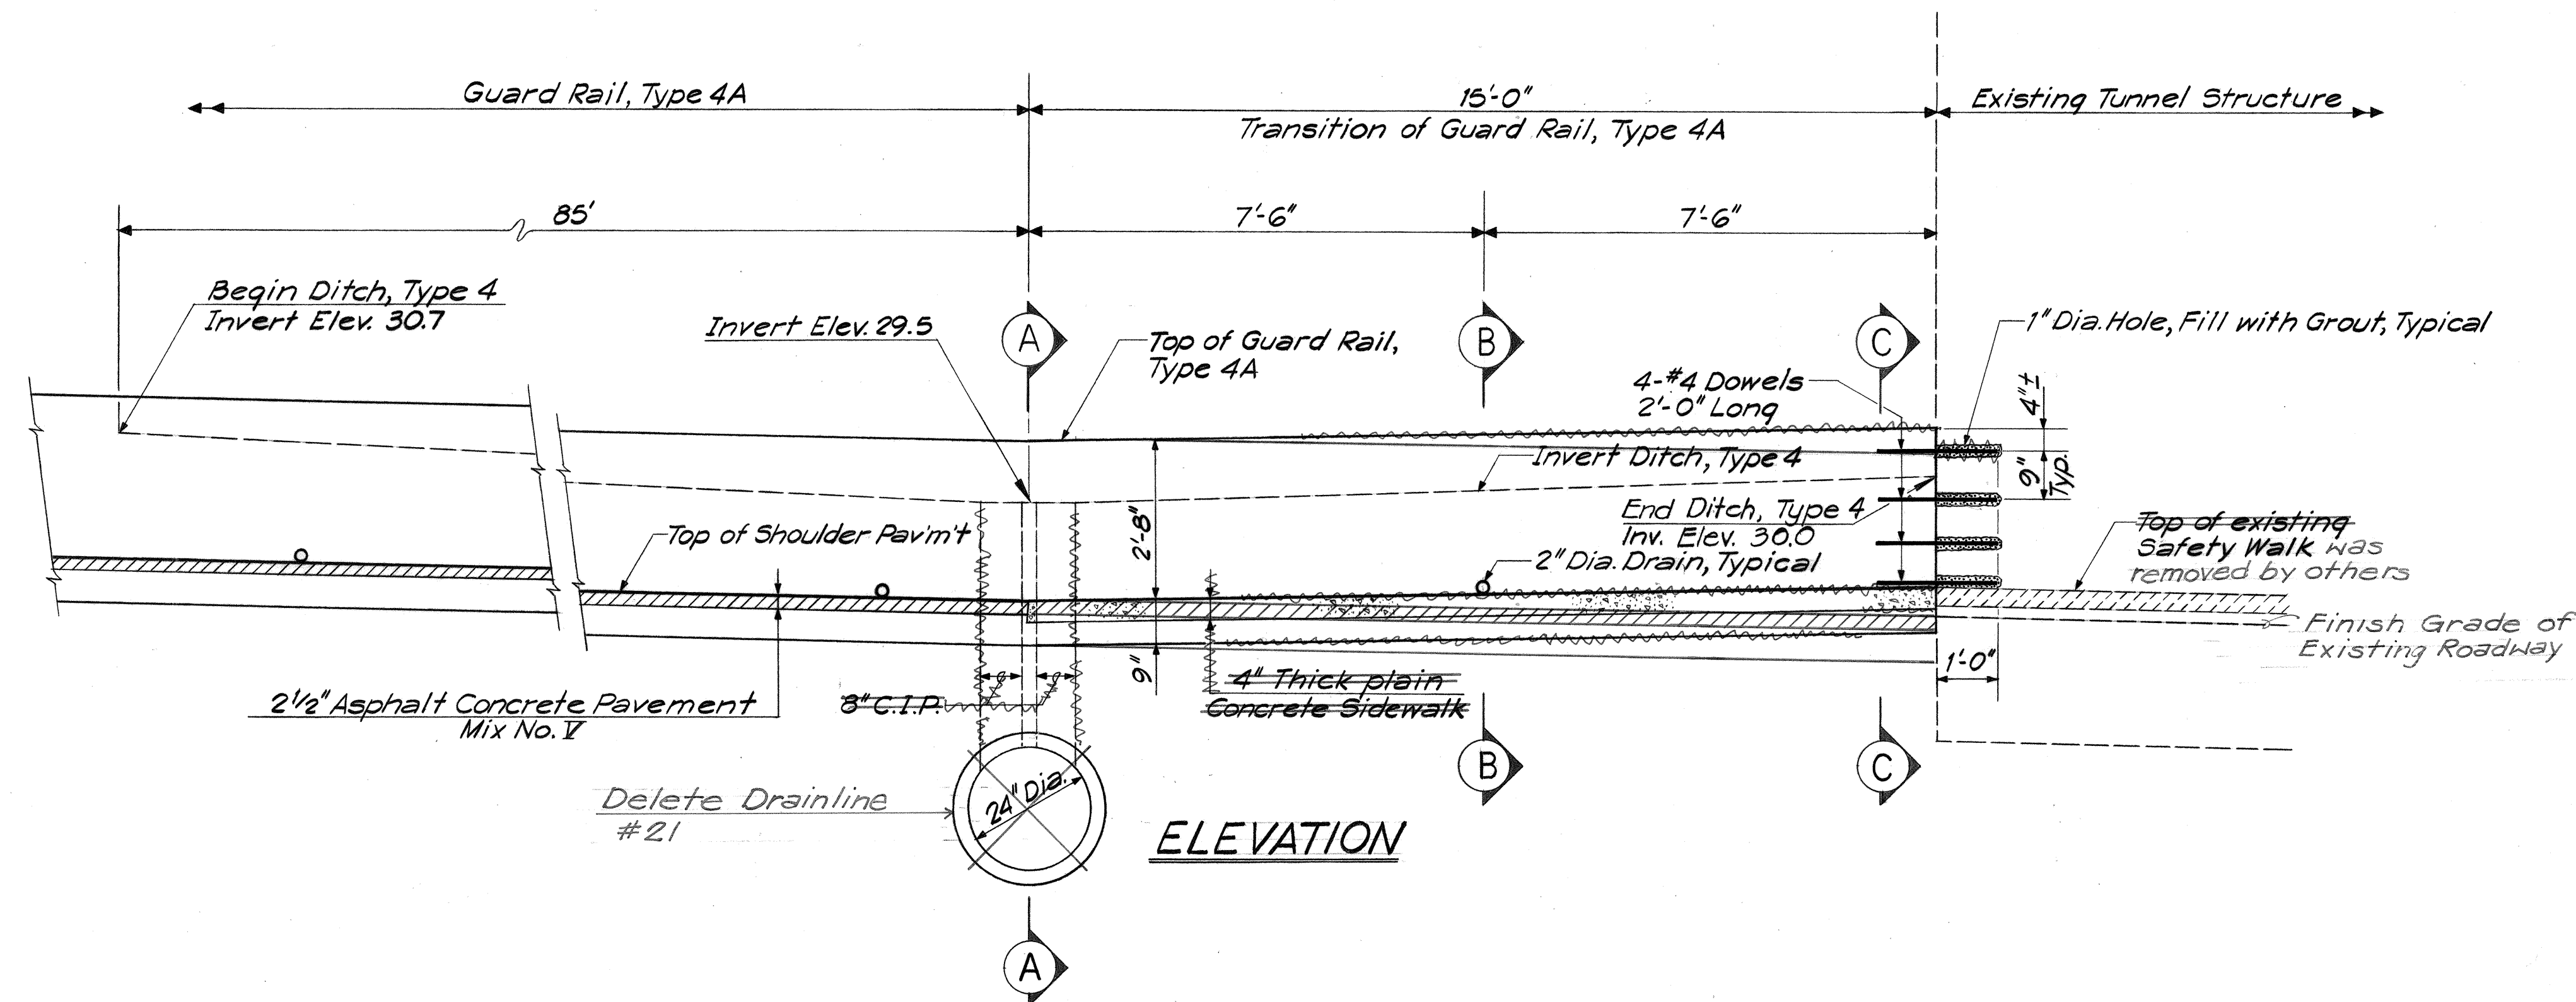


GUARD RAIL TYPE 4E
SCALE: 1" = 1'-0"

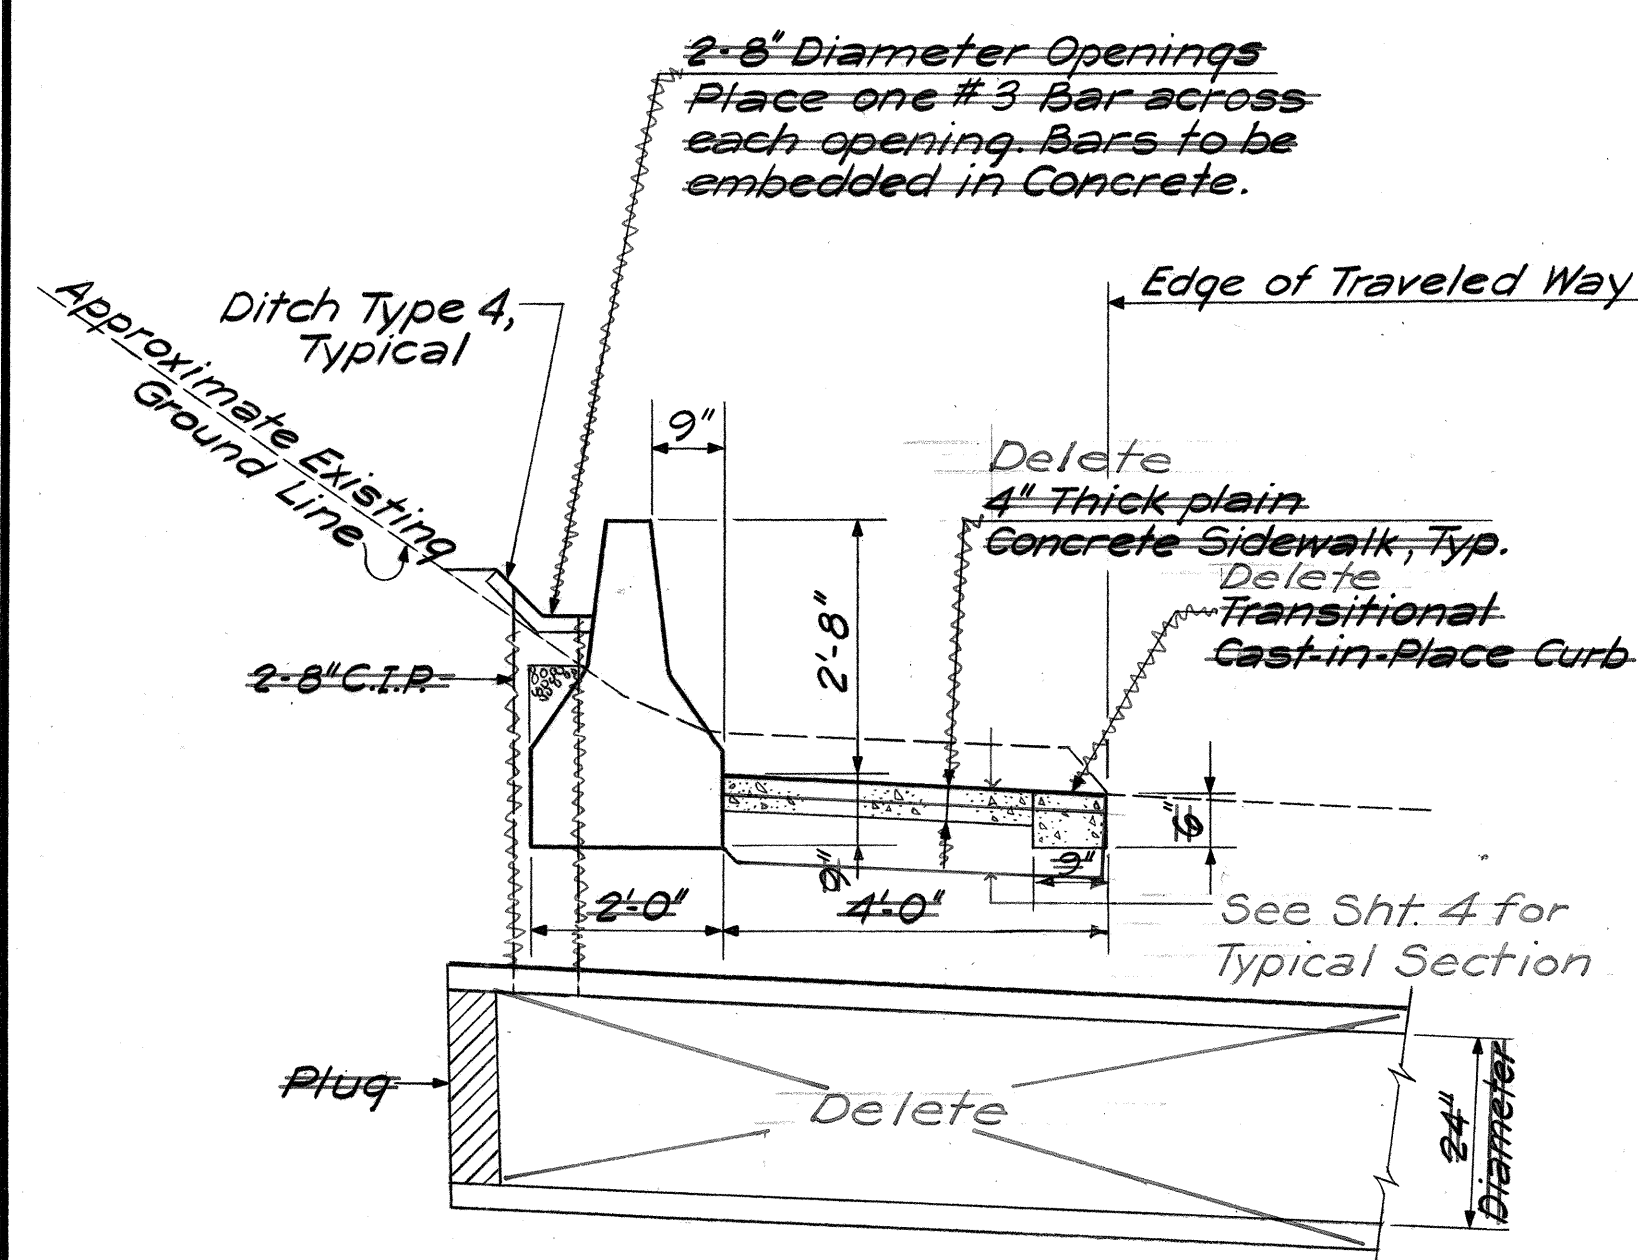


SECTION A

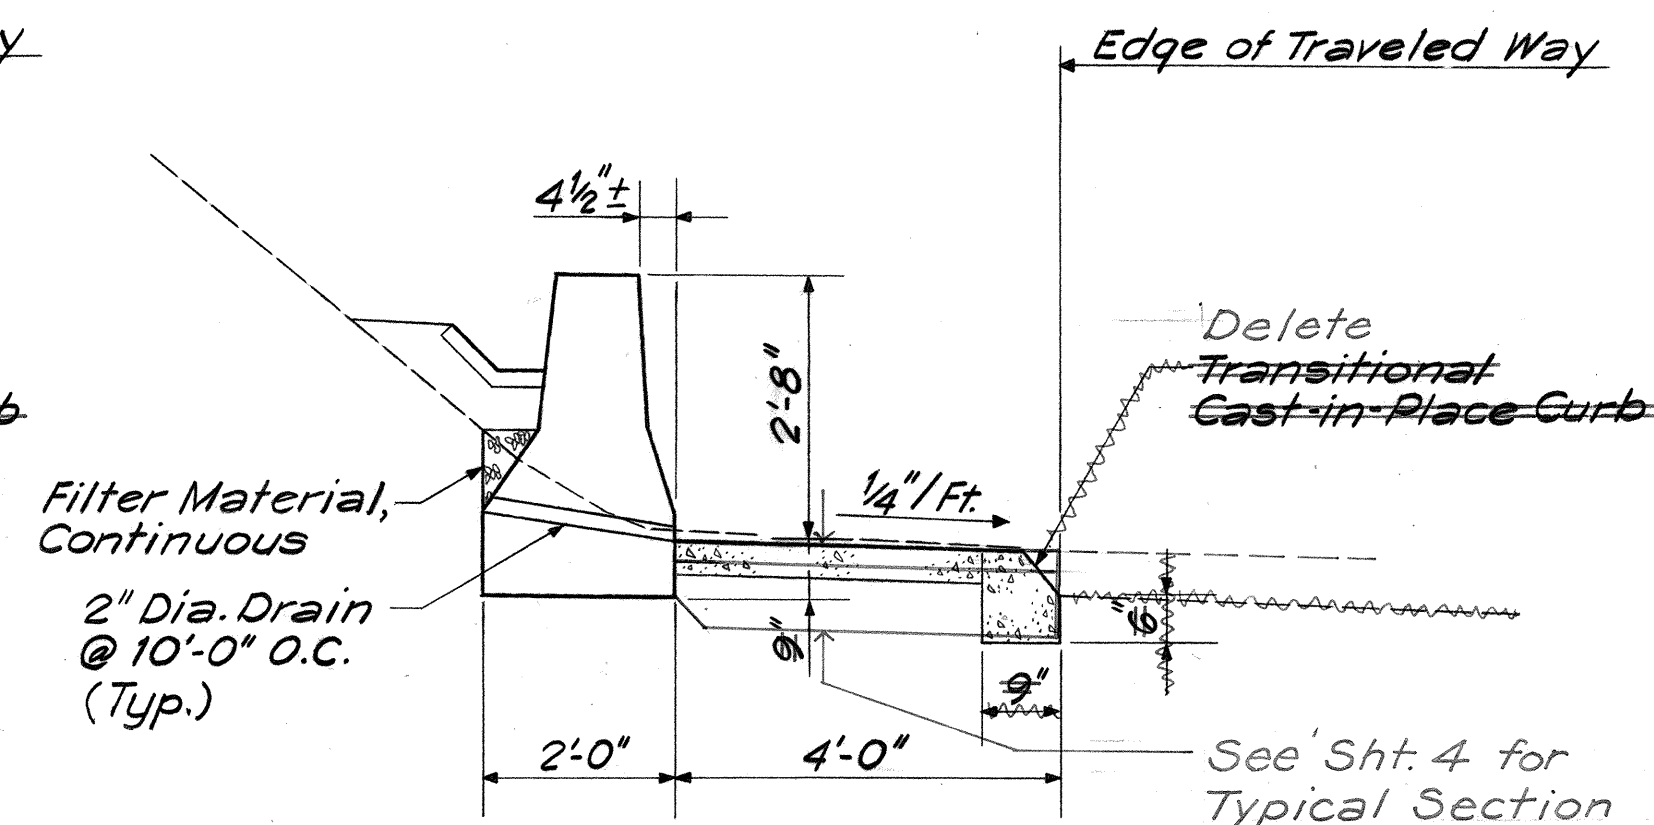

SECTION B

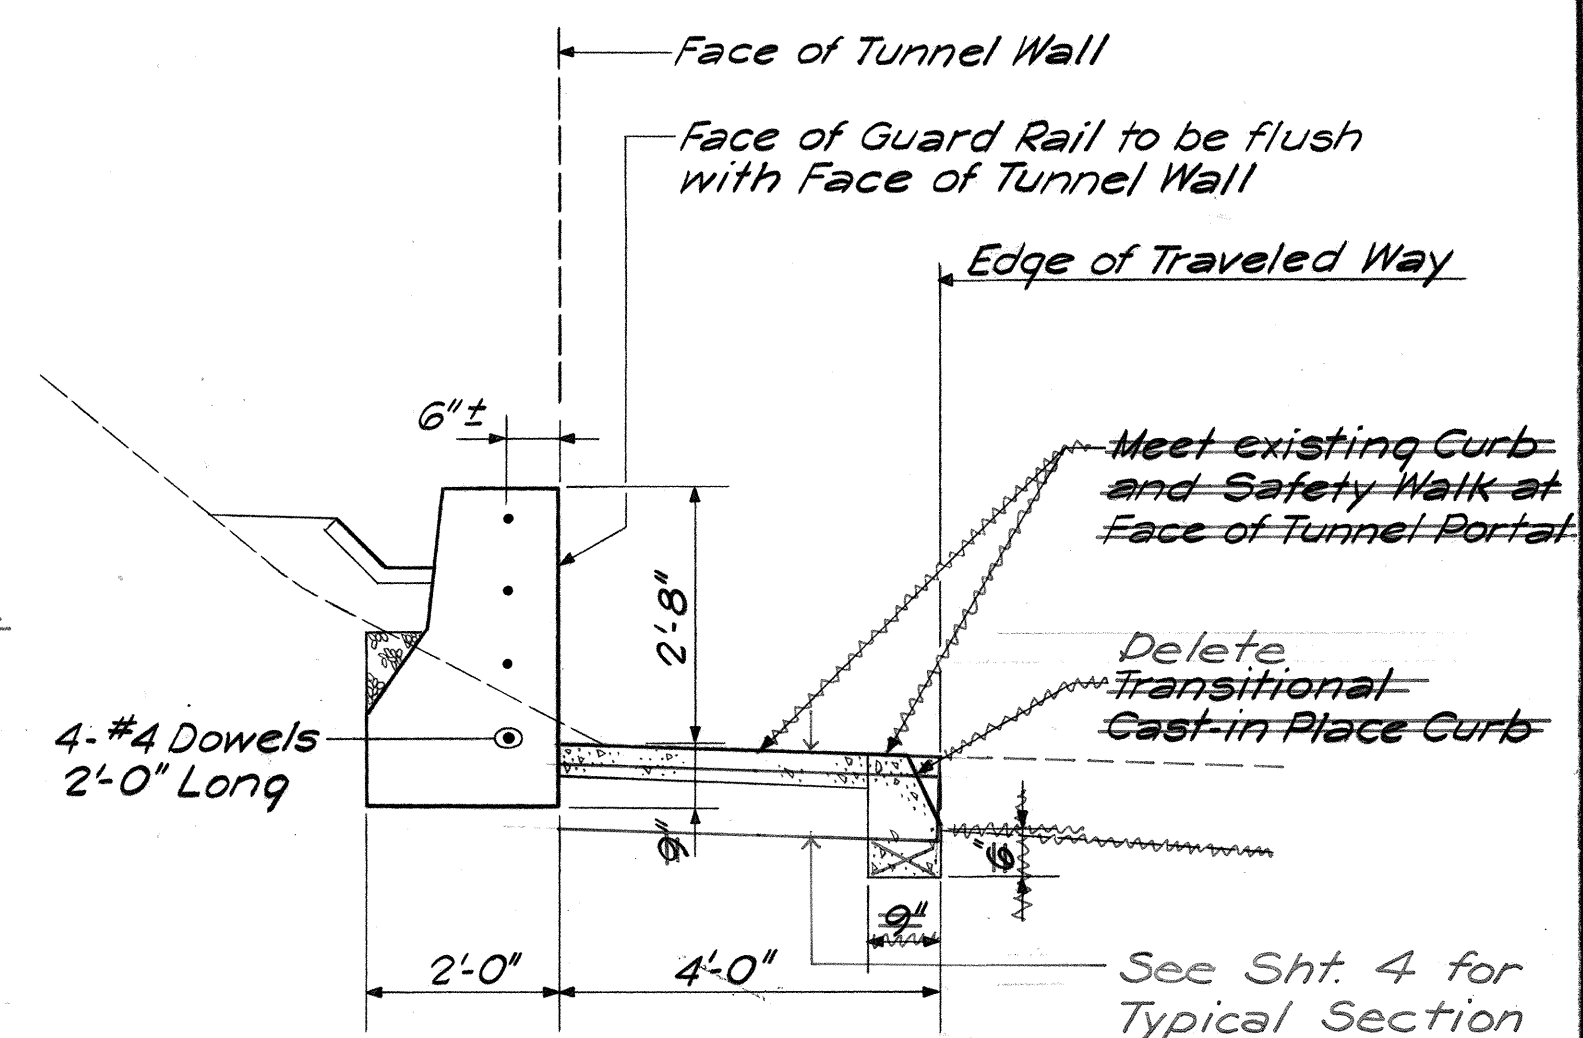

SECTION C

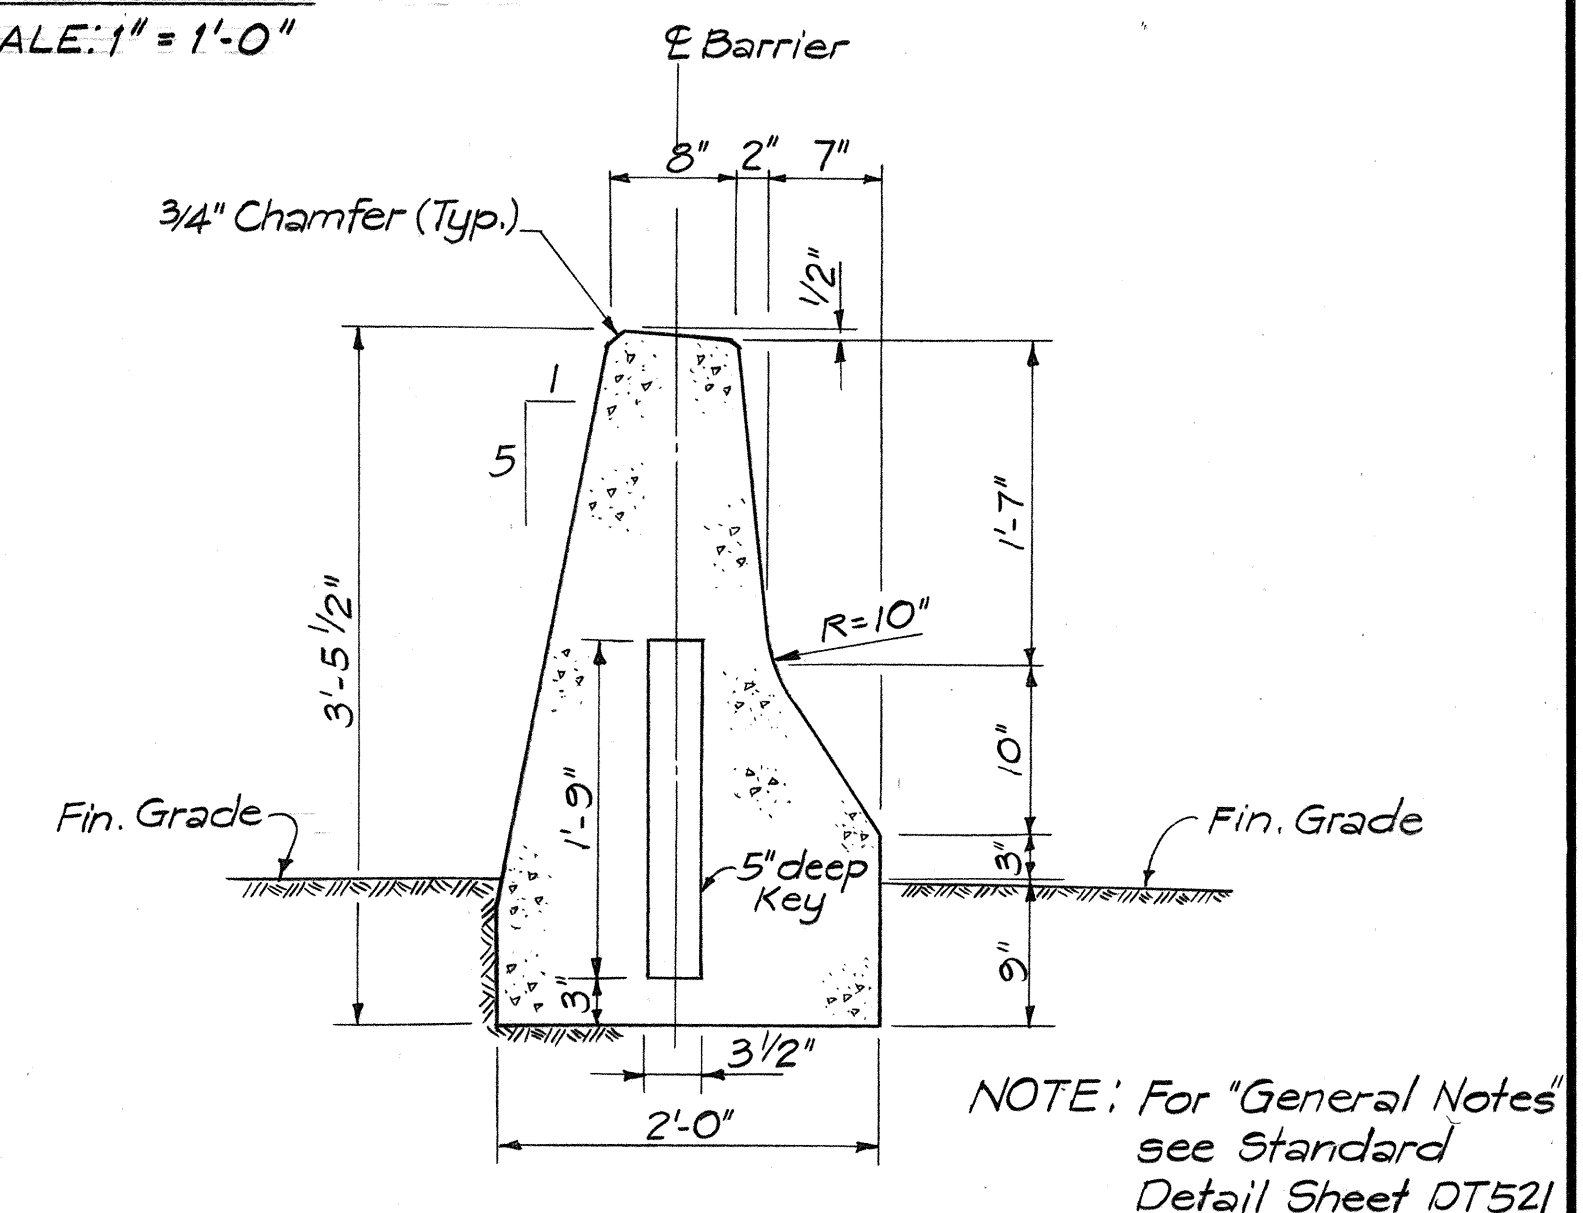

GUARD RAIL TYPE 4F
Scale: 1" = 1'-0"


GUARD RAIL TRANSITION TO MEET TUNNEL PORTAL

SCALE: 1/2" = 1'-0"

NOTES:

1. Transition of Guard Rail, Type 4A shall be paid for as "Guard Rail, Type 4A". Furnishing and installation of Dowels shall be considered incidental to "Guard Rail, Type 4A".
2. Payment for Transitional Cast-in-Place Curb shall be made under Curb, Type 2A.

DESIGNED BY	DATE
TRACED BY	
DESIGNED BY	
QUANTITIES BY	
CHECKED BY	
ORIGINAL	
PLAN	
NOTE BOOK	
No.	

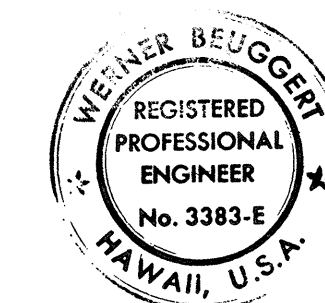

THIS WORK WAS PREPARED BY ME
OR UNDER MY SUPERVISION.

Werner Beugger

STATE OF HAWAII
DEPARTMENT OF TRANSPORTATION
HIGHWAYS DIVISION


MISCELLANEOUS DETAILS

INTERSTATE ROUTE H-1
PROJECT NO. 1-HI-1(131):17


SCALE: AS SHOWN DATE: AUG. 31, 1977

SHEET No. 2 OF 26 SHEETS


FED. ROAD DIST. NO.	STATE	FED. AID PROJ. NO.	FISCAL YEAR	SHEET NO.	TOTAL SHEET
HAWAII	HAW.	1-HI-1(13):17	1977	40	394

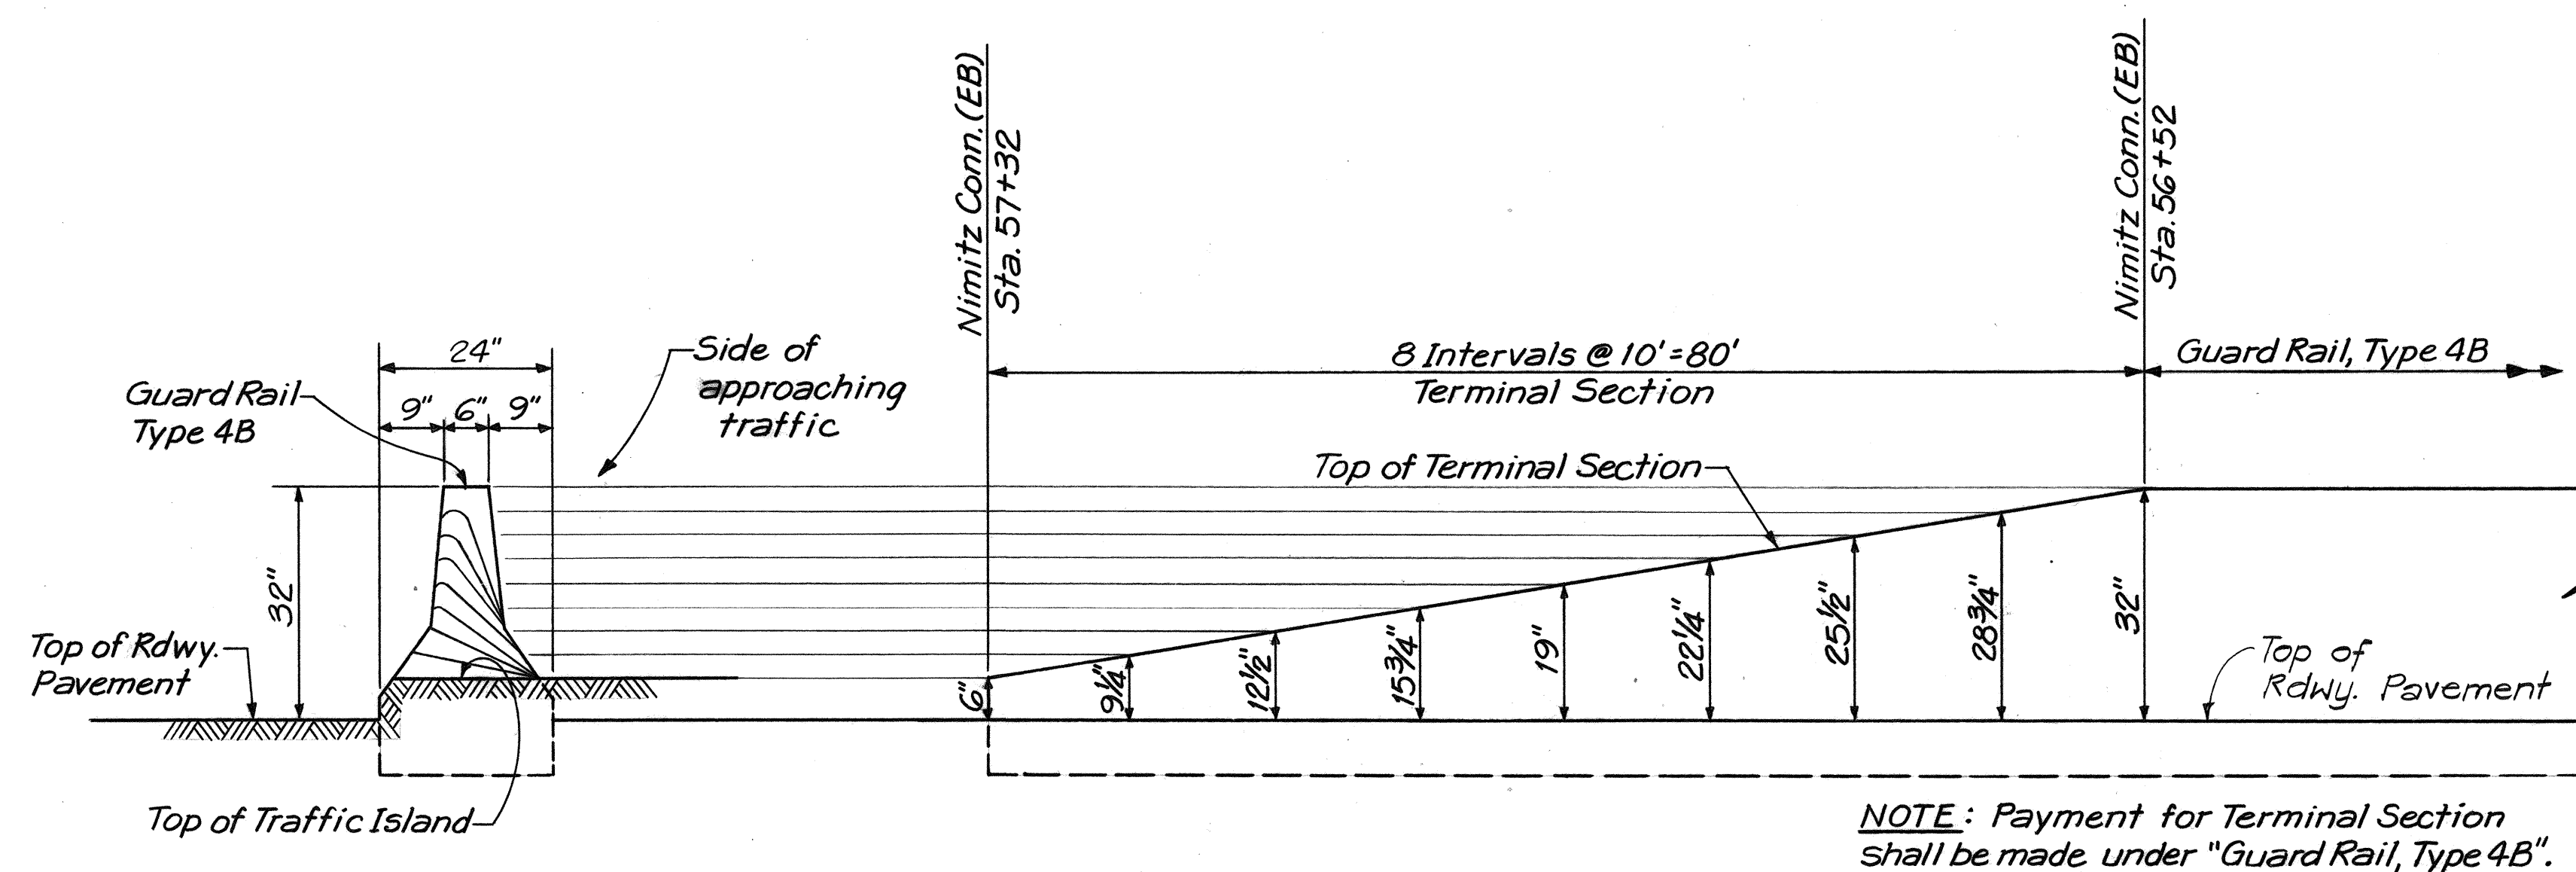

GUARD RAIL, TYPE 4B - TERMINAL SECTION
NOT TO SCALE

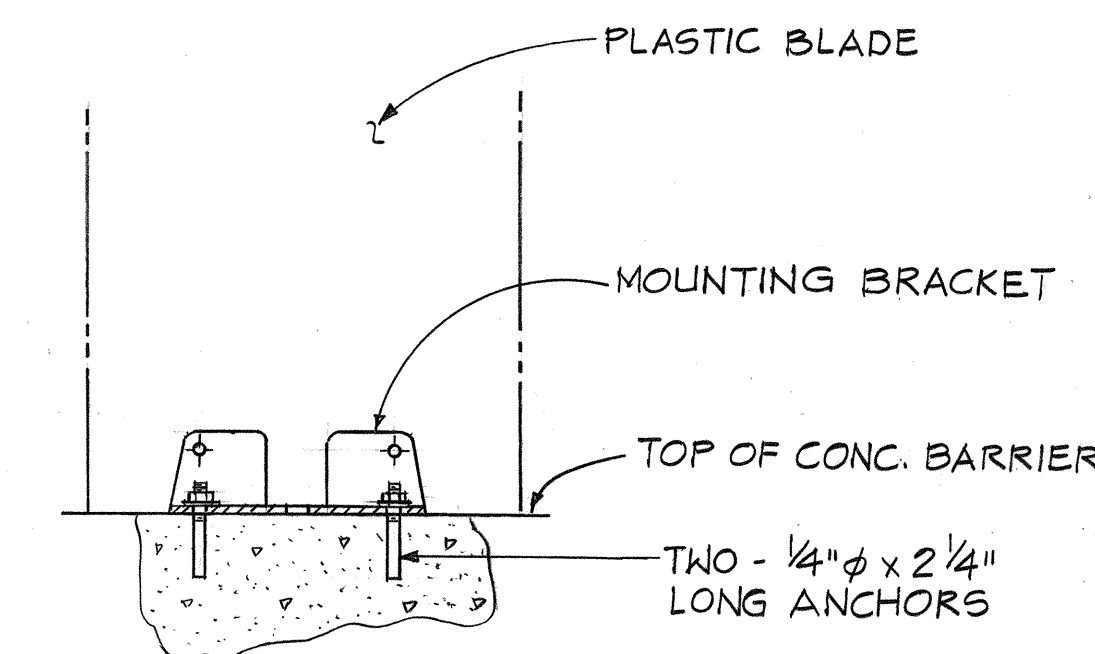


ELEVATION

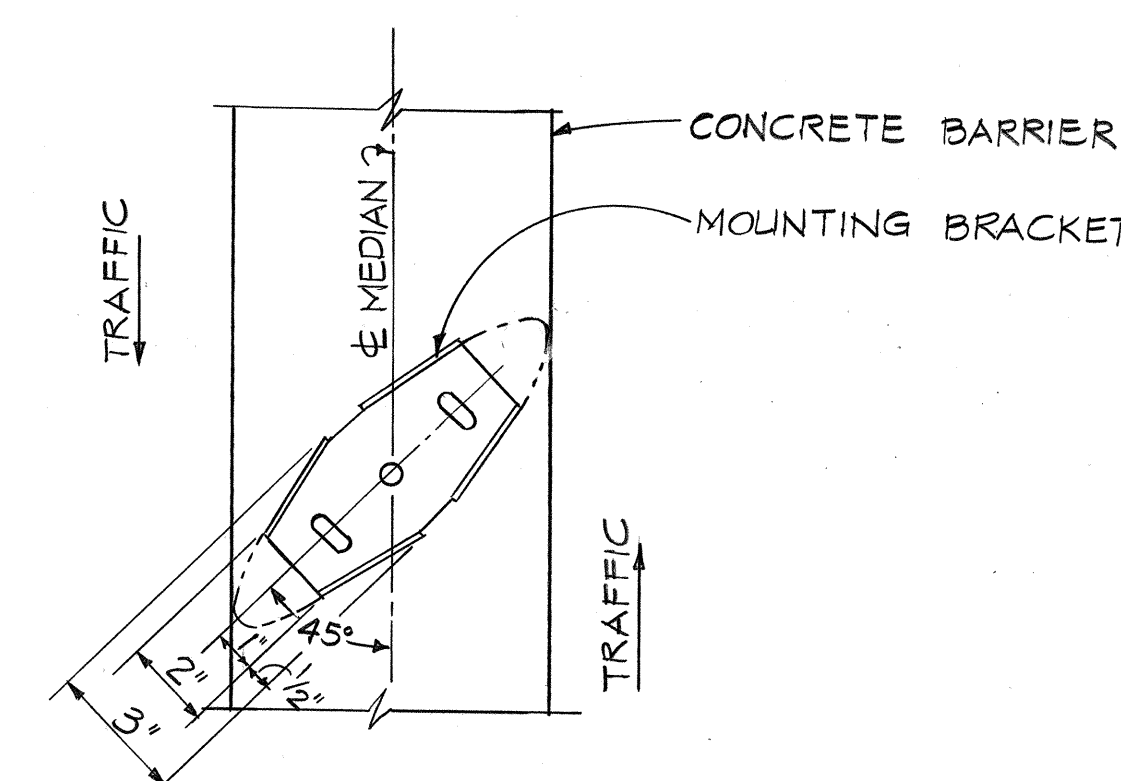

PLAN

MOUNTING DETAIL OF PLASTIC BLADE
HEADLIGHT GLARE SCREEN ON CONCRETE BARRIER
N.T.S.

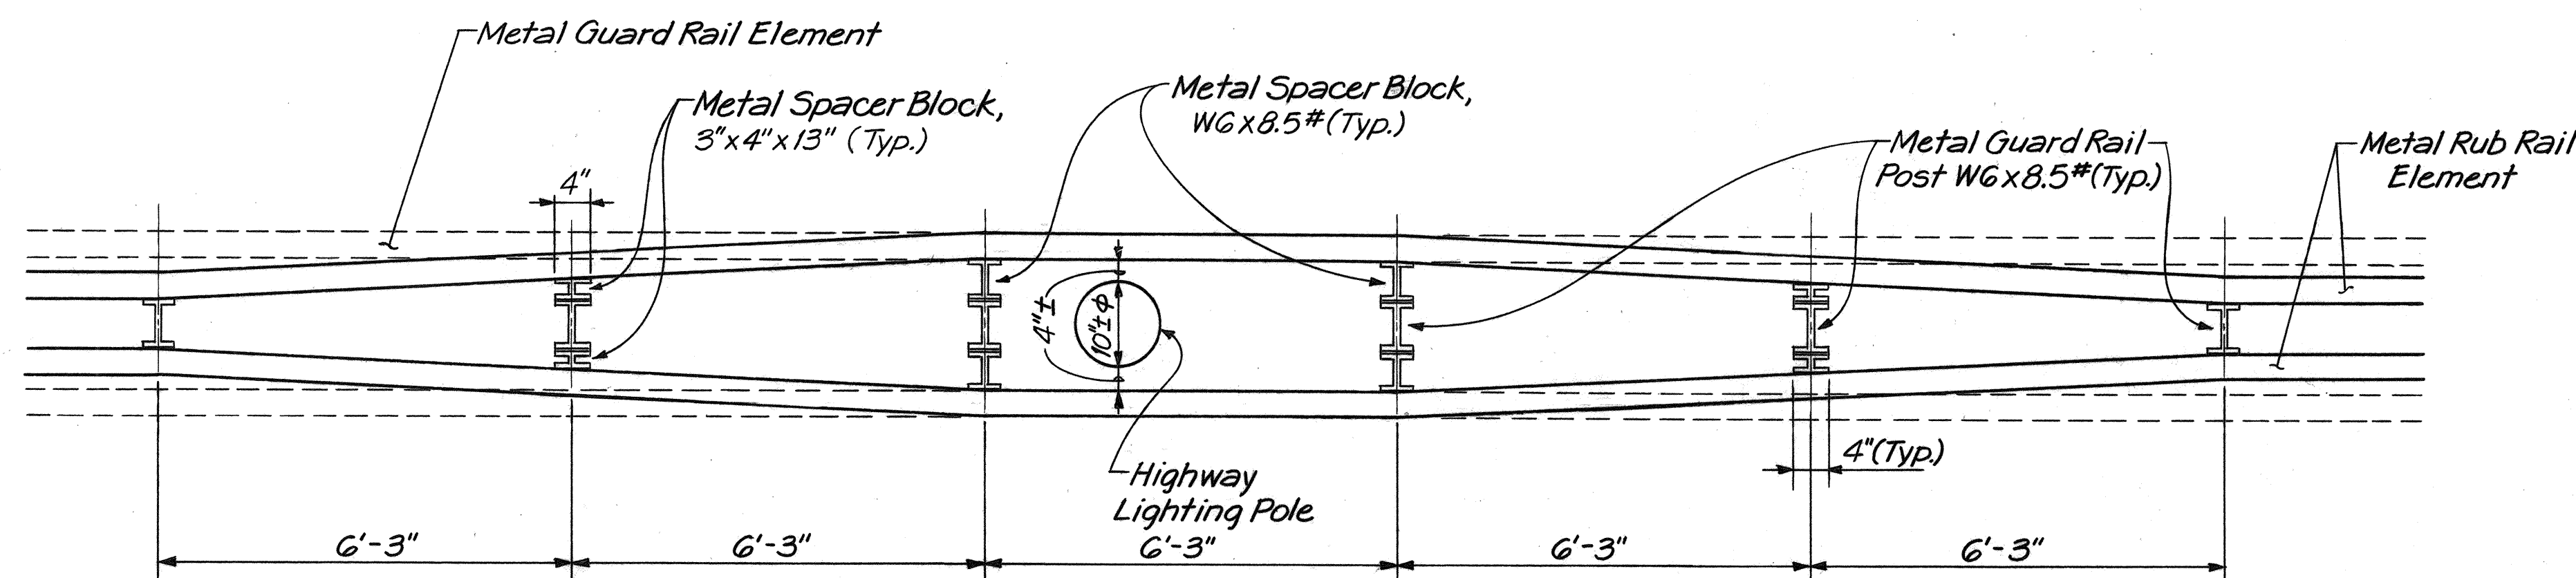

GUARD RAIL, TYPE 3-DOUBLE WITH RUBRAIL.
RUBRAIL TRANSITION AT HIGHWAY LIGHTING POLES
NOT TO SCALE

3/23/78	Replaced mounting detail for headlight glare screen.
DATE	REVISION

STATE OF HAWAII
DEPARTMENT OF TRANSPORTATION
HIGHWAYS DIVISION

MISCELLANEOUS DETAILS

INTERSTATE ROUTE H-1
PROJECT NO. I-HI-1(131) : 17

SCALE: AS SHOWN DATE: AUG. 31, 1978

SHEET No. 3 OF 26 SHEETS


STATE OF HAWAII
DEPARTMENT OF TRANSPORTATION
HIGHWAYS DIVISION

MISCELLANEOUS DETAILS

INTERSTATE ROUTE H-1
PROJECT NO. I-HI-1 (131) : 17

SCALE: AS SHOWN DATE: AUG. 31, 1977

SHEET No. 3 OF 26 SHEETS

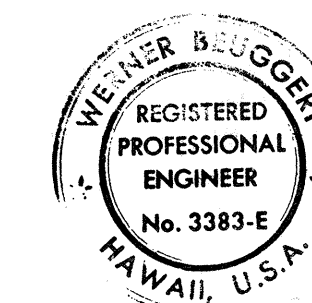


THIS WORK WAS PREPARED BY M.
OR UNDER MY SUPERVISION.
Werner Bengert


ADD.40

ORIGINAL PLAN	SURVEY PLOTTED BY _____	DATE _____
NOTE BOOK	DRAWN BY _____	" "
	TRACED BY _____	" "
	DESIGNED BY _____	" "
	QUANTITIES BY _____	" "
	CHECKED BY _____	" "
NO. _____		


FED. ROAD DIST. NO.	STATE	FED. AID PROJ. NO.	FISCAL YEAR	SHEET NO.	TOTAL SHEETS
HAWAII	HAW.	I-HI-1(131)-17	1977	41	394

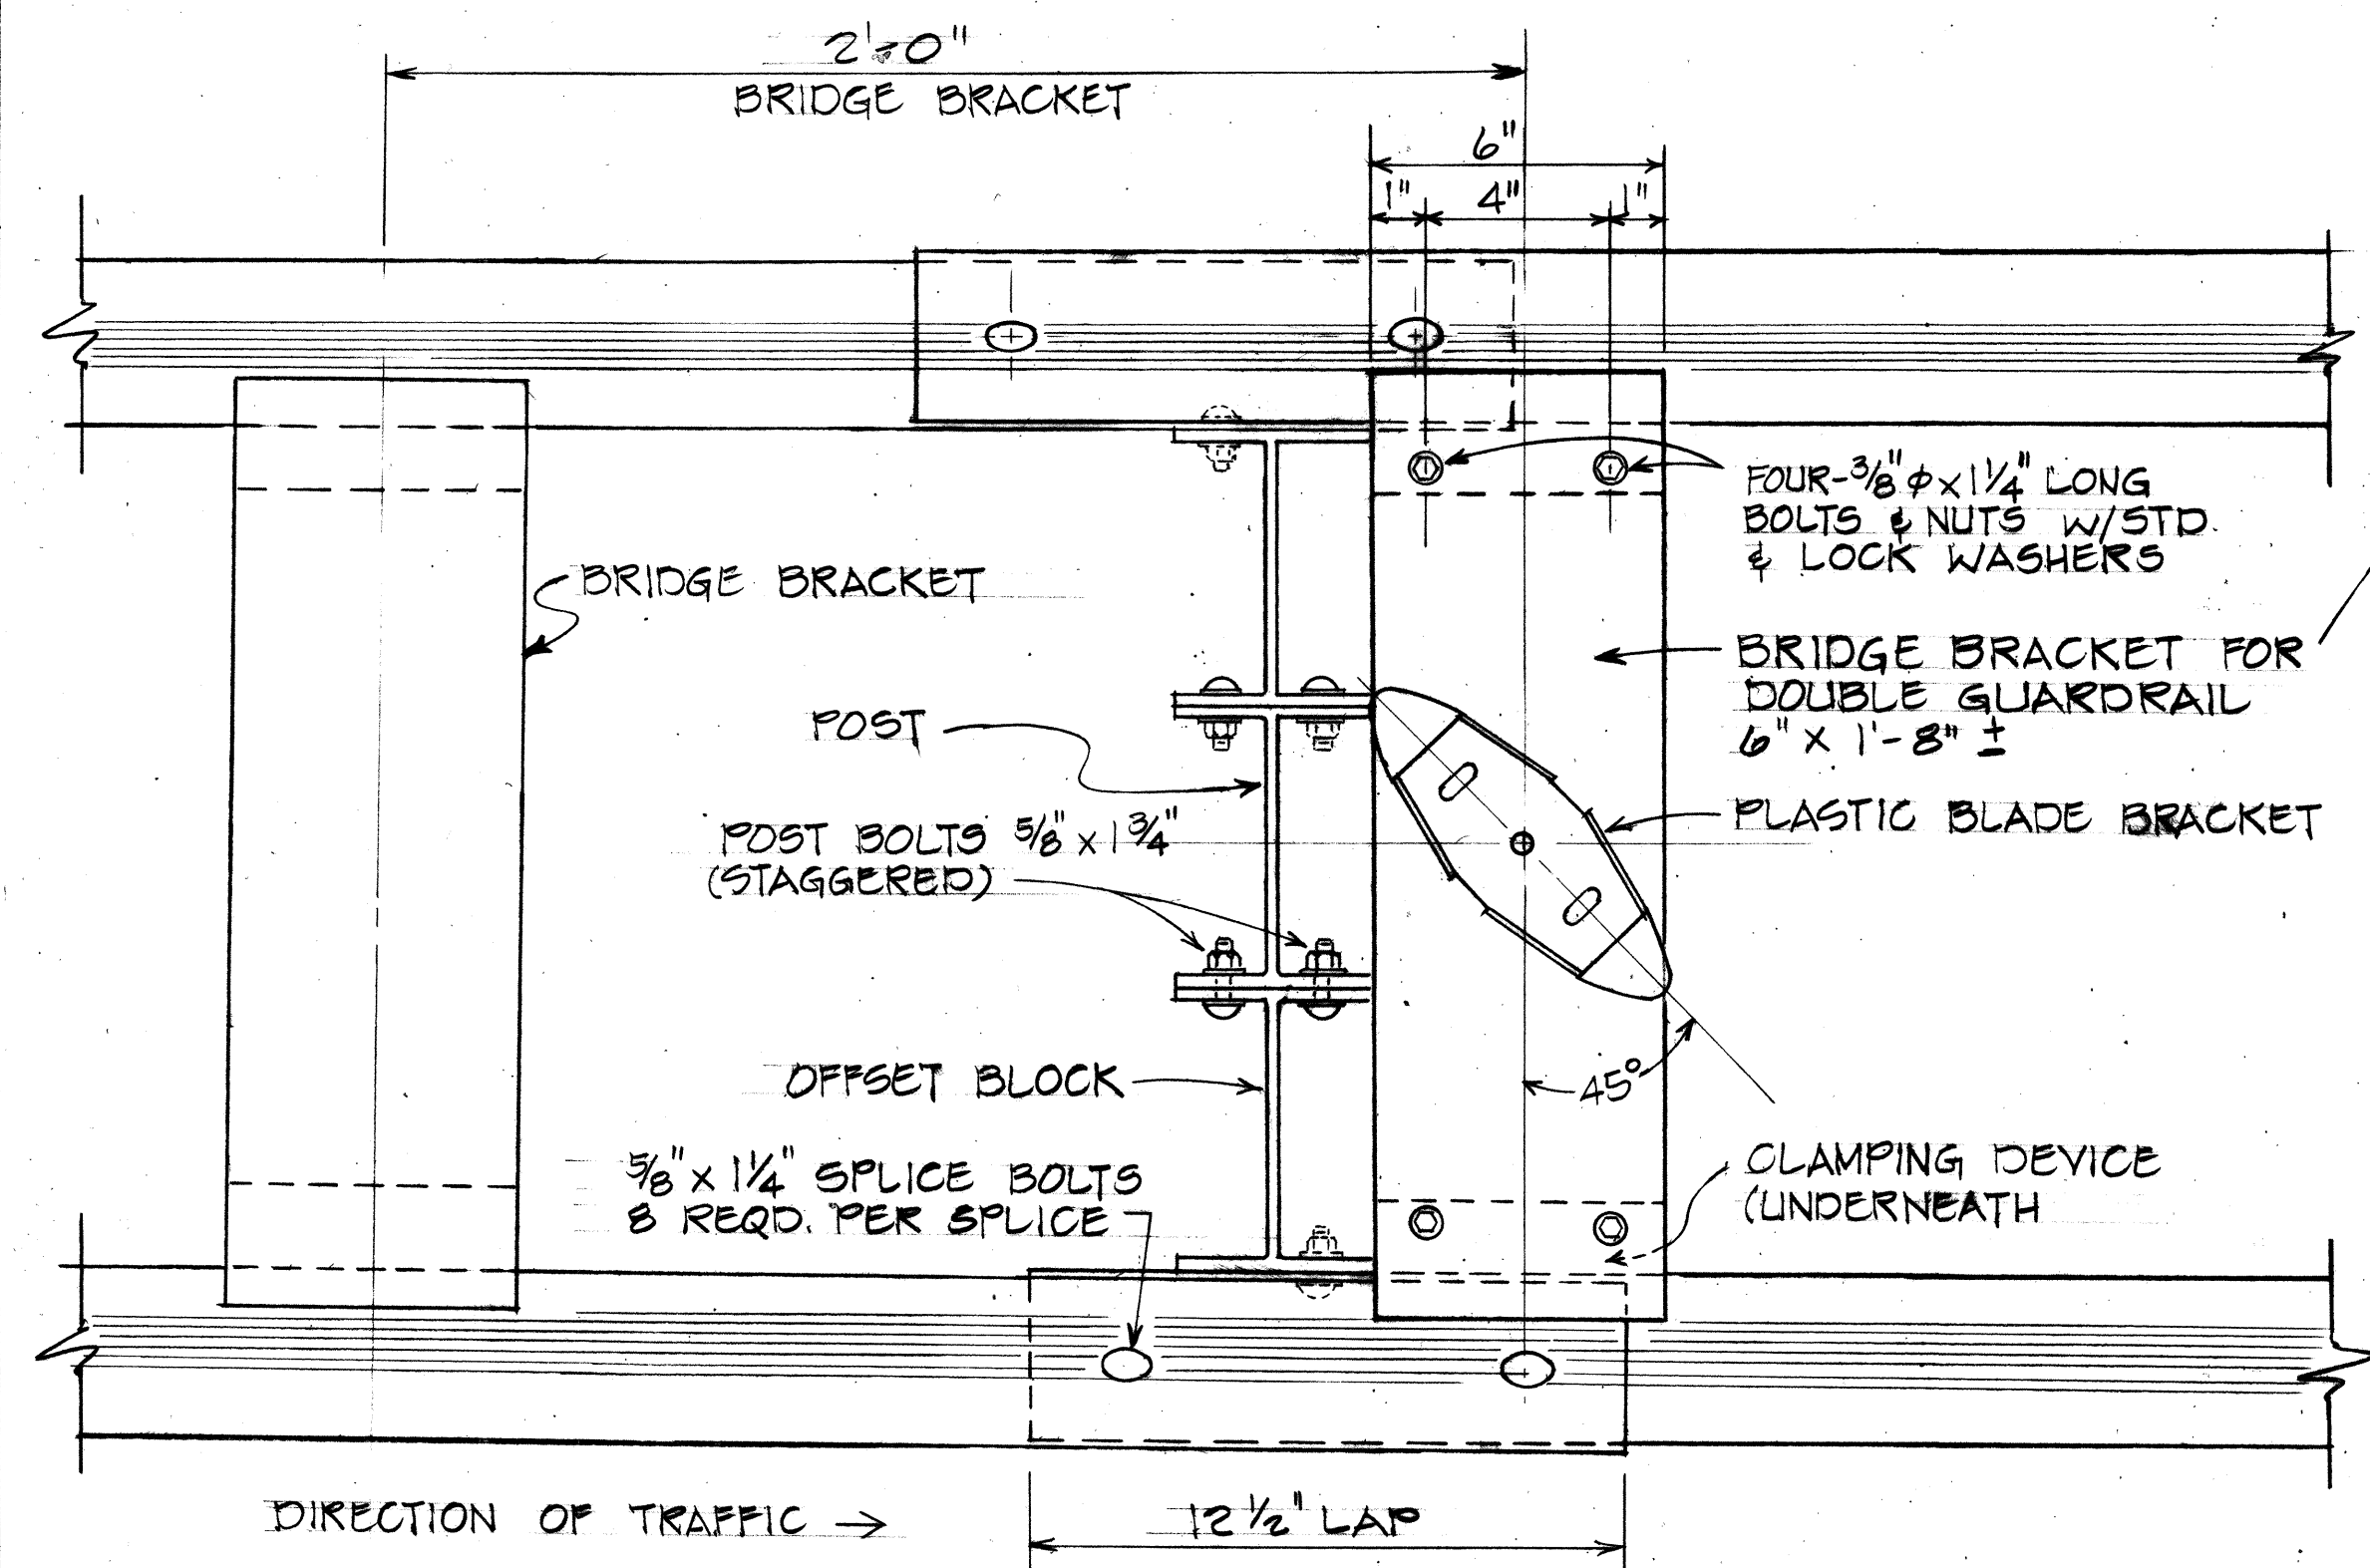


PLAN

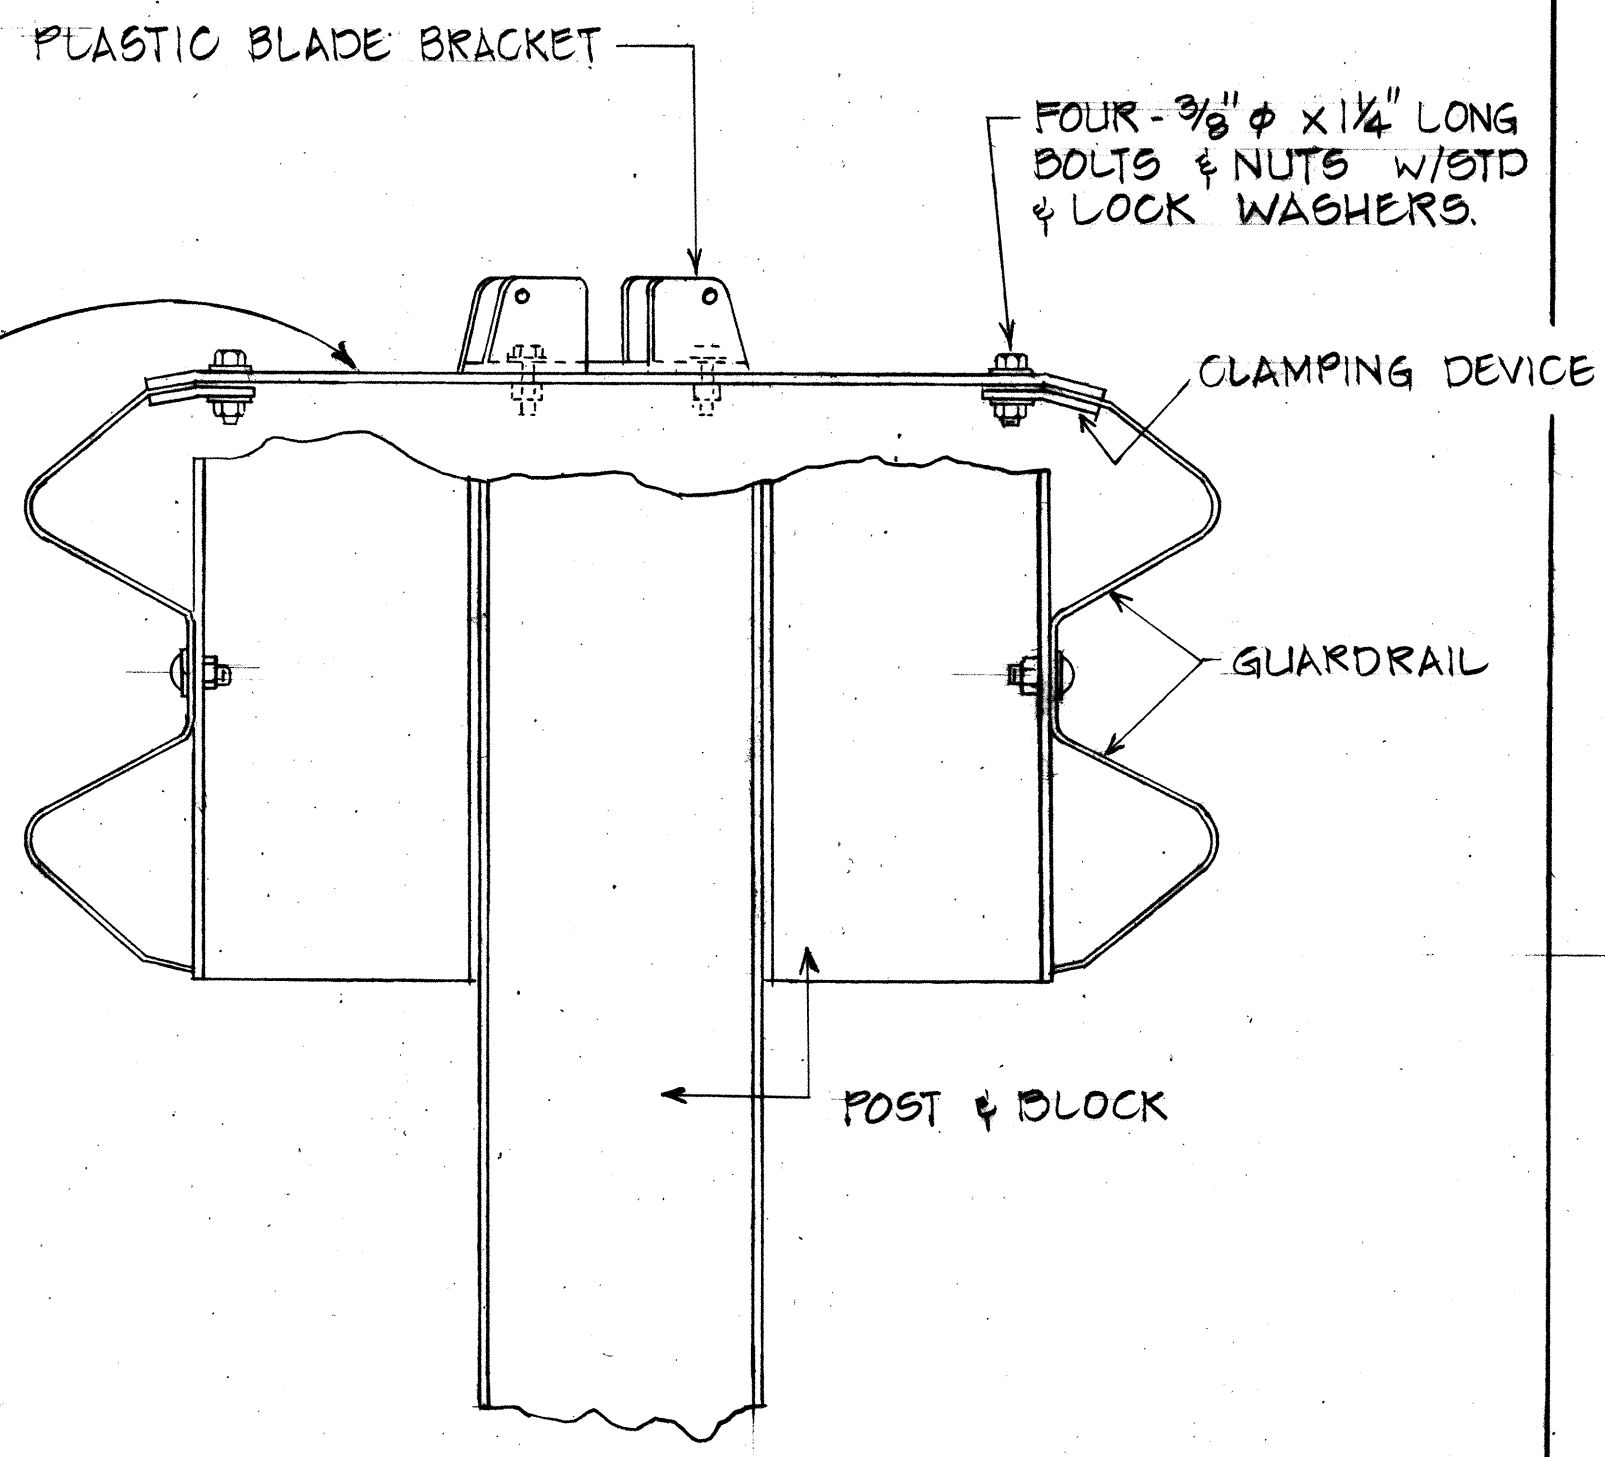

SIDE VIEW

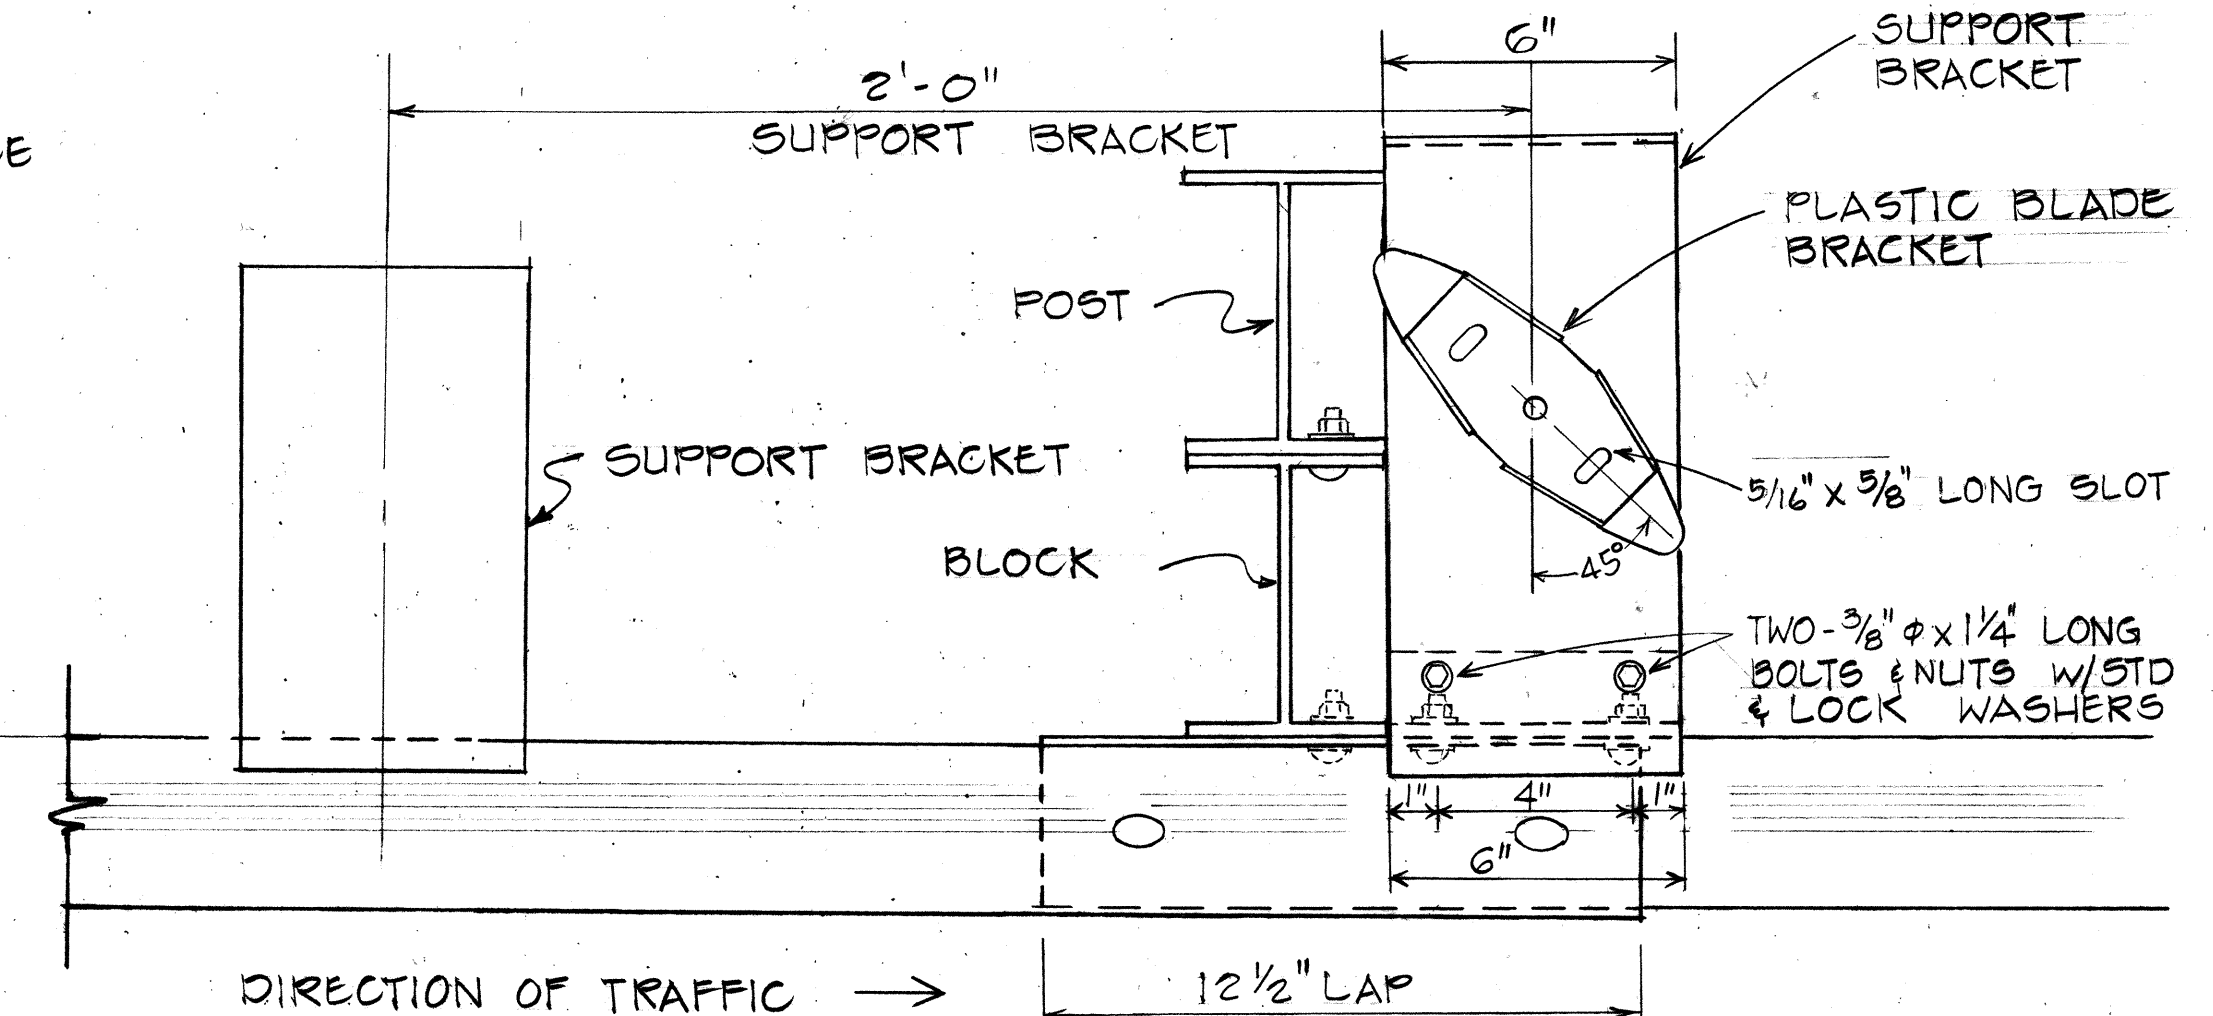


PLAN
Scale: 3" = 1'-0"

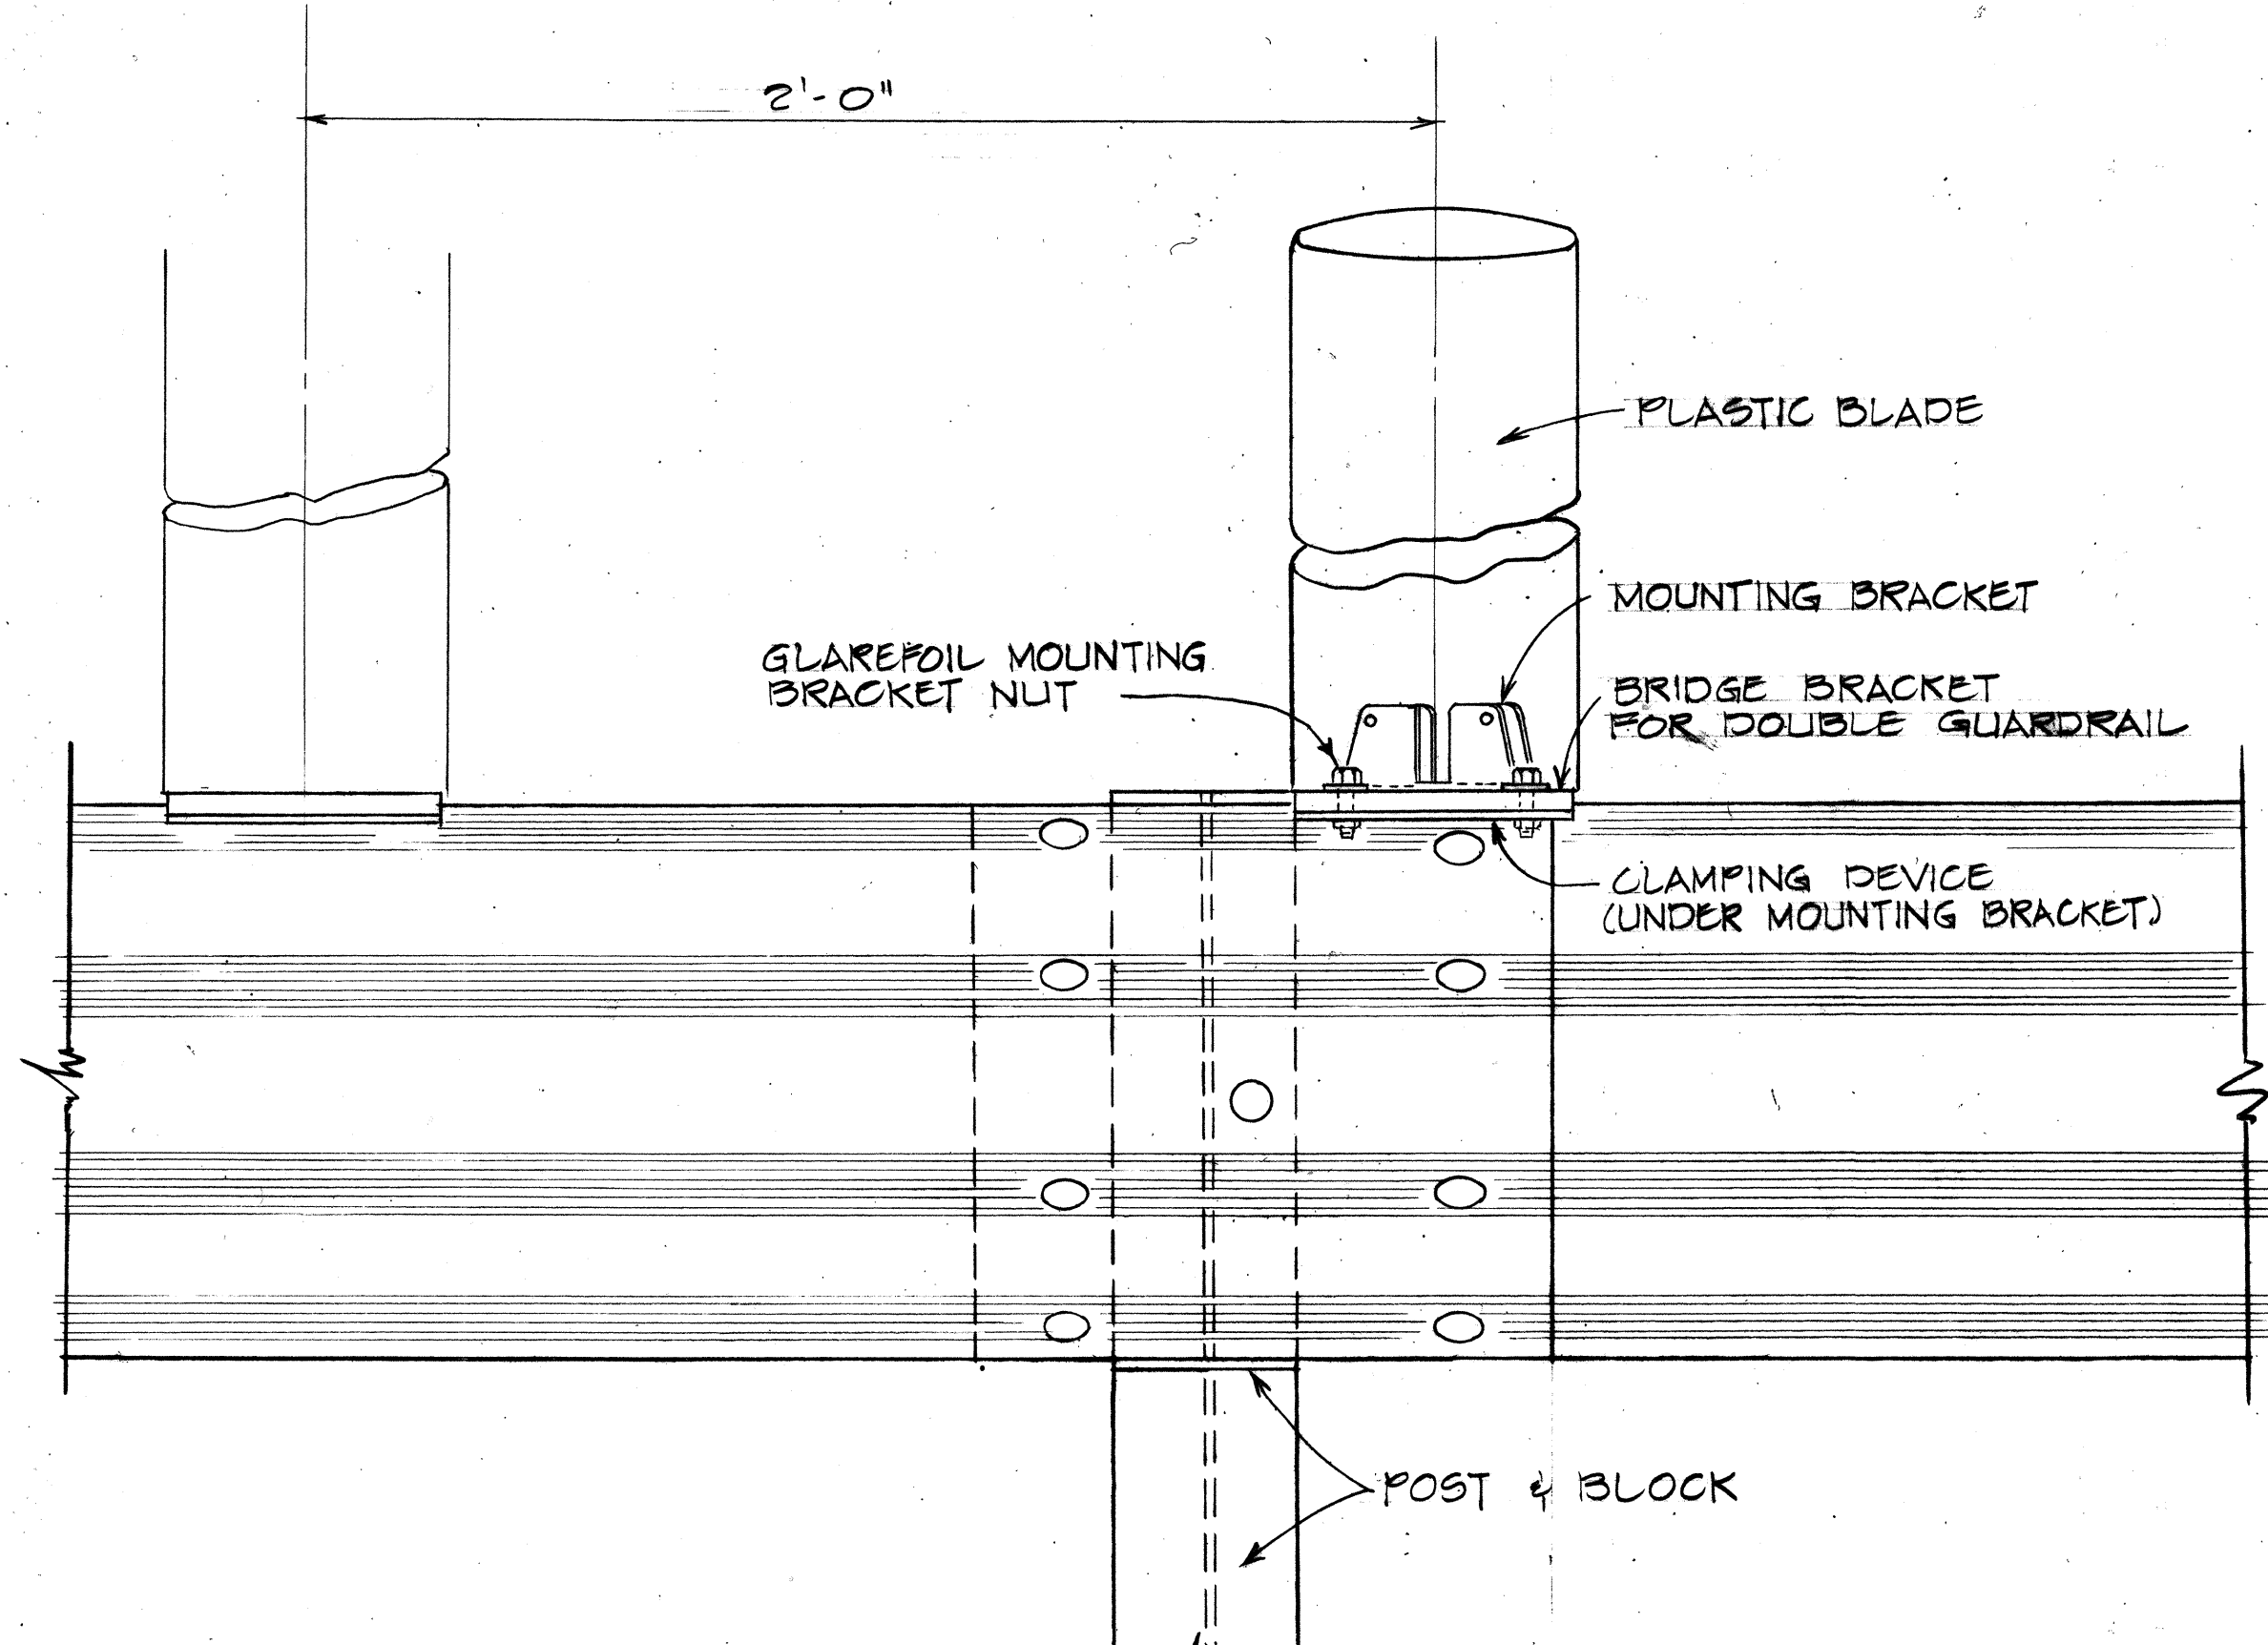


ELEVATION

DOUBLE RAIL PLASTIC BLADE MOUNTING

Scale: 3" = 1'-0"

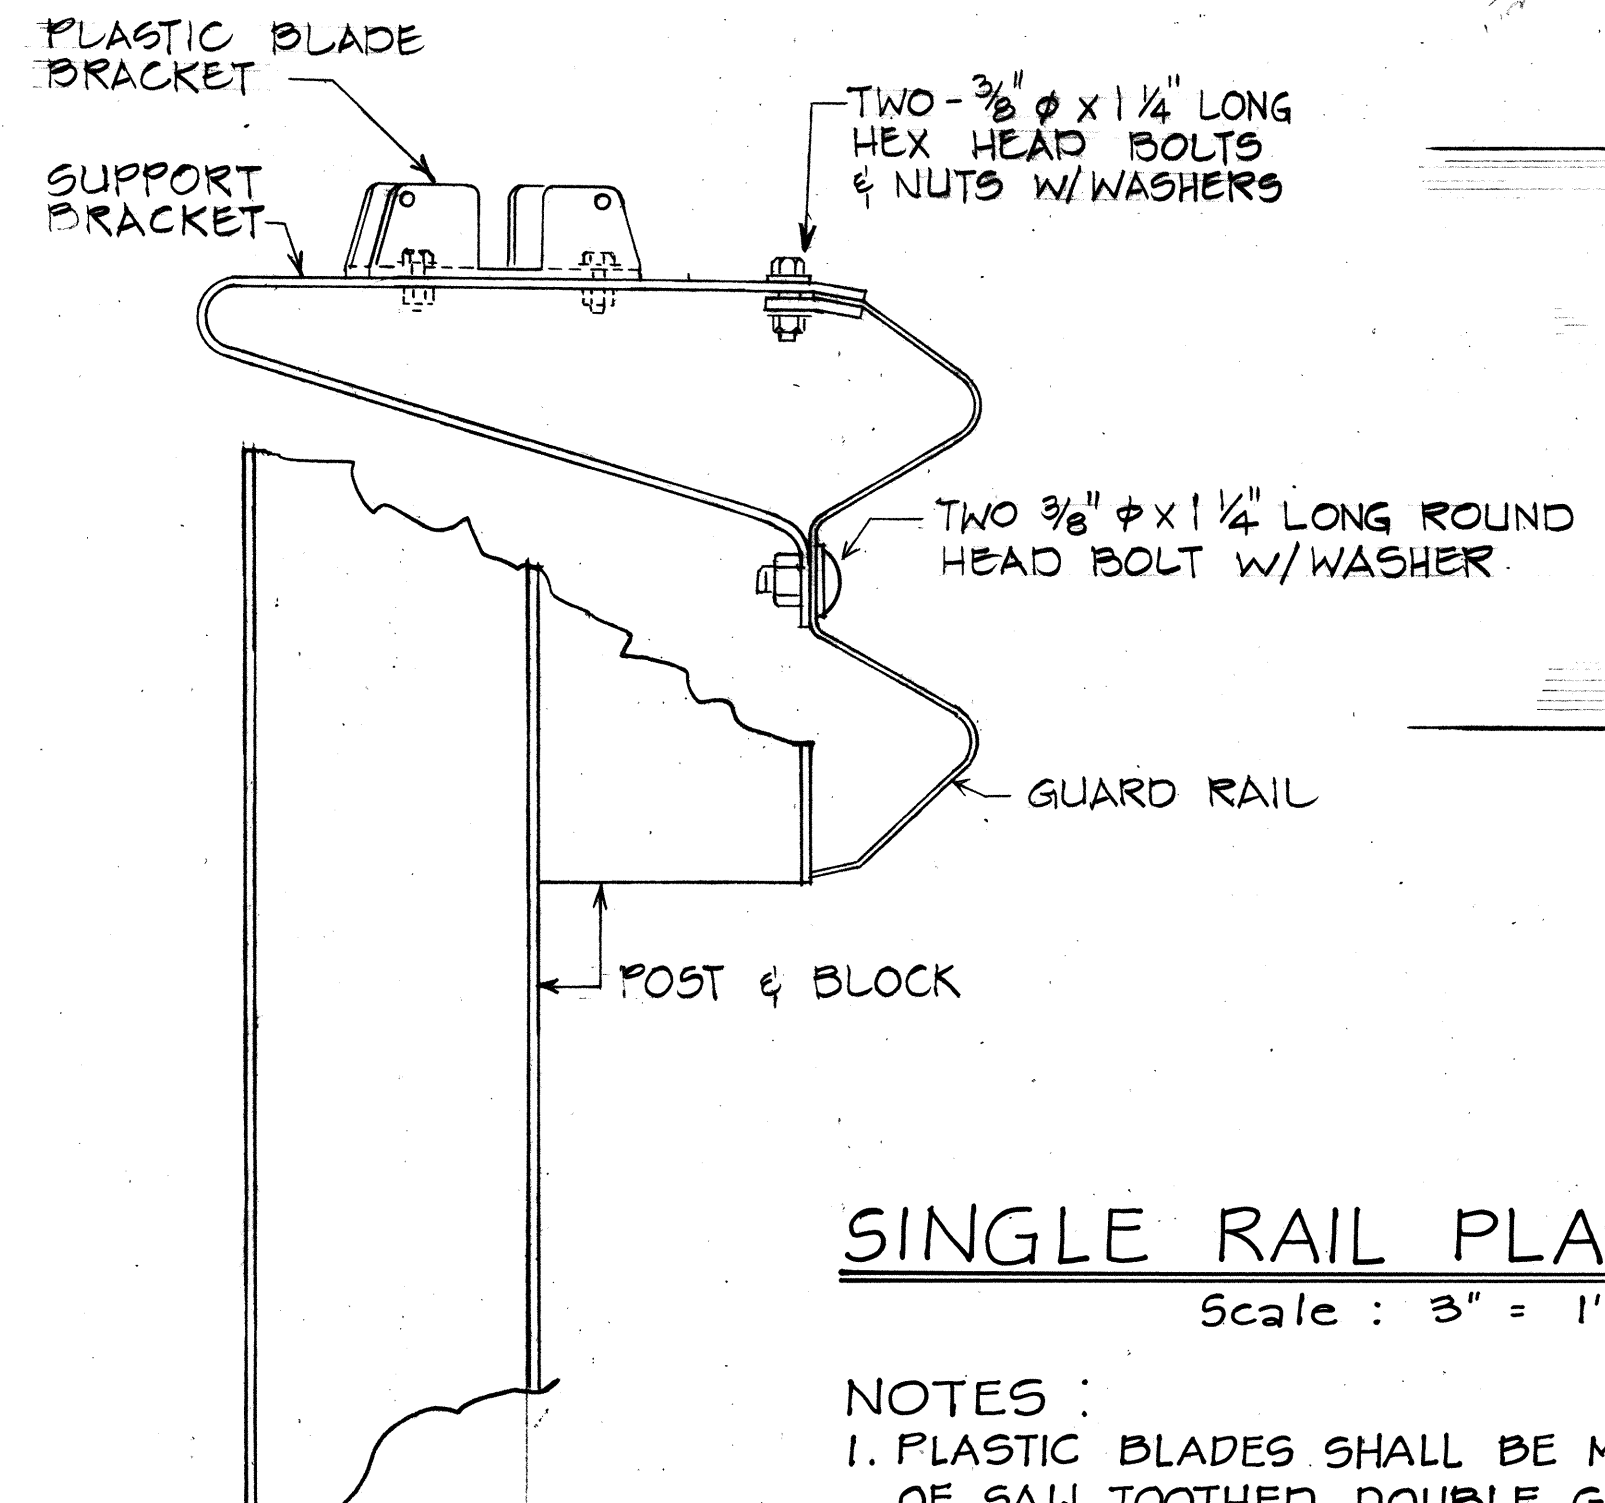

SIDE VIEW

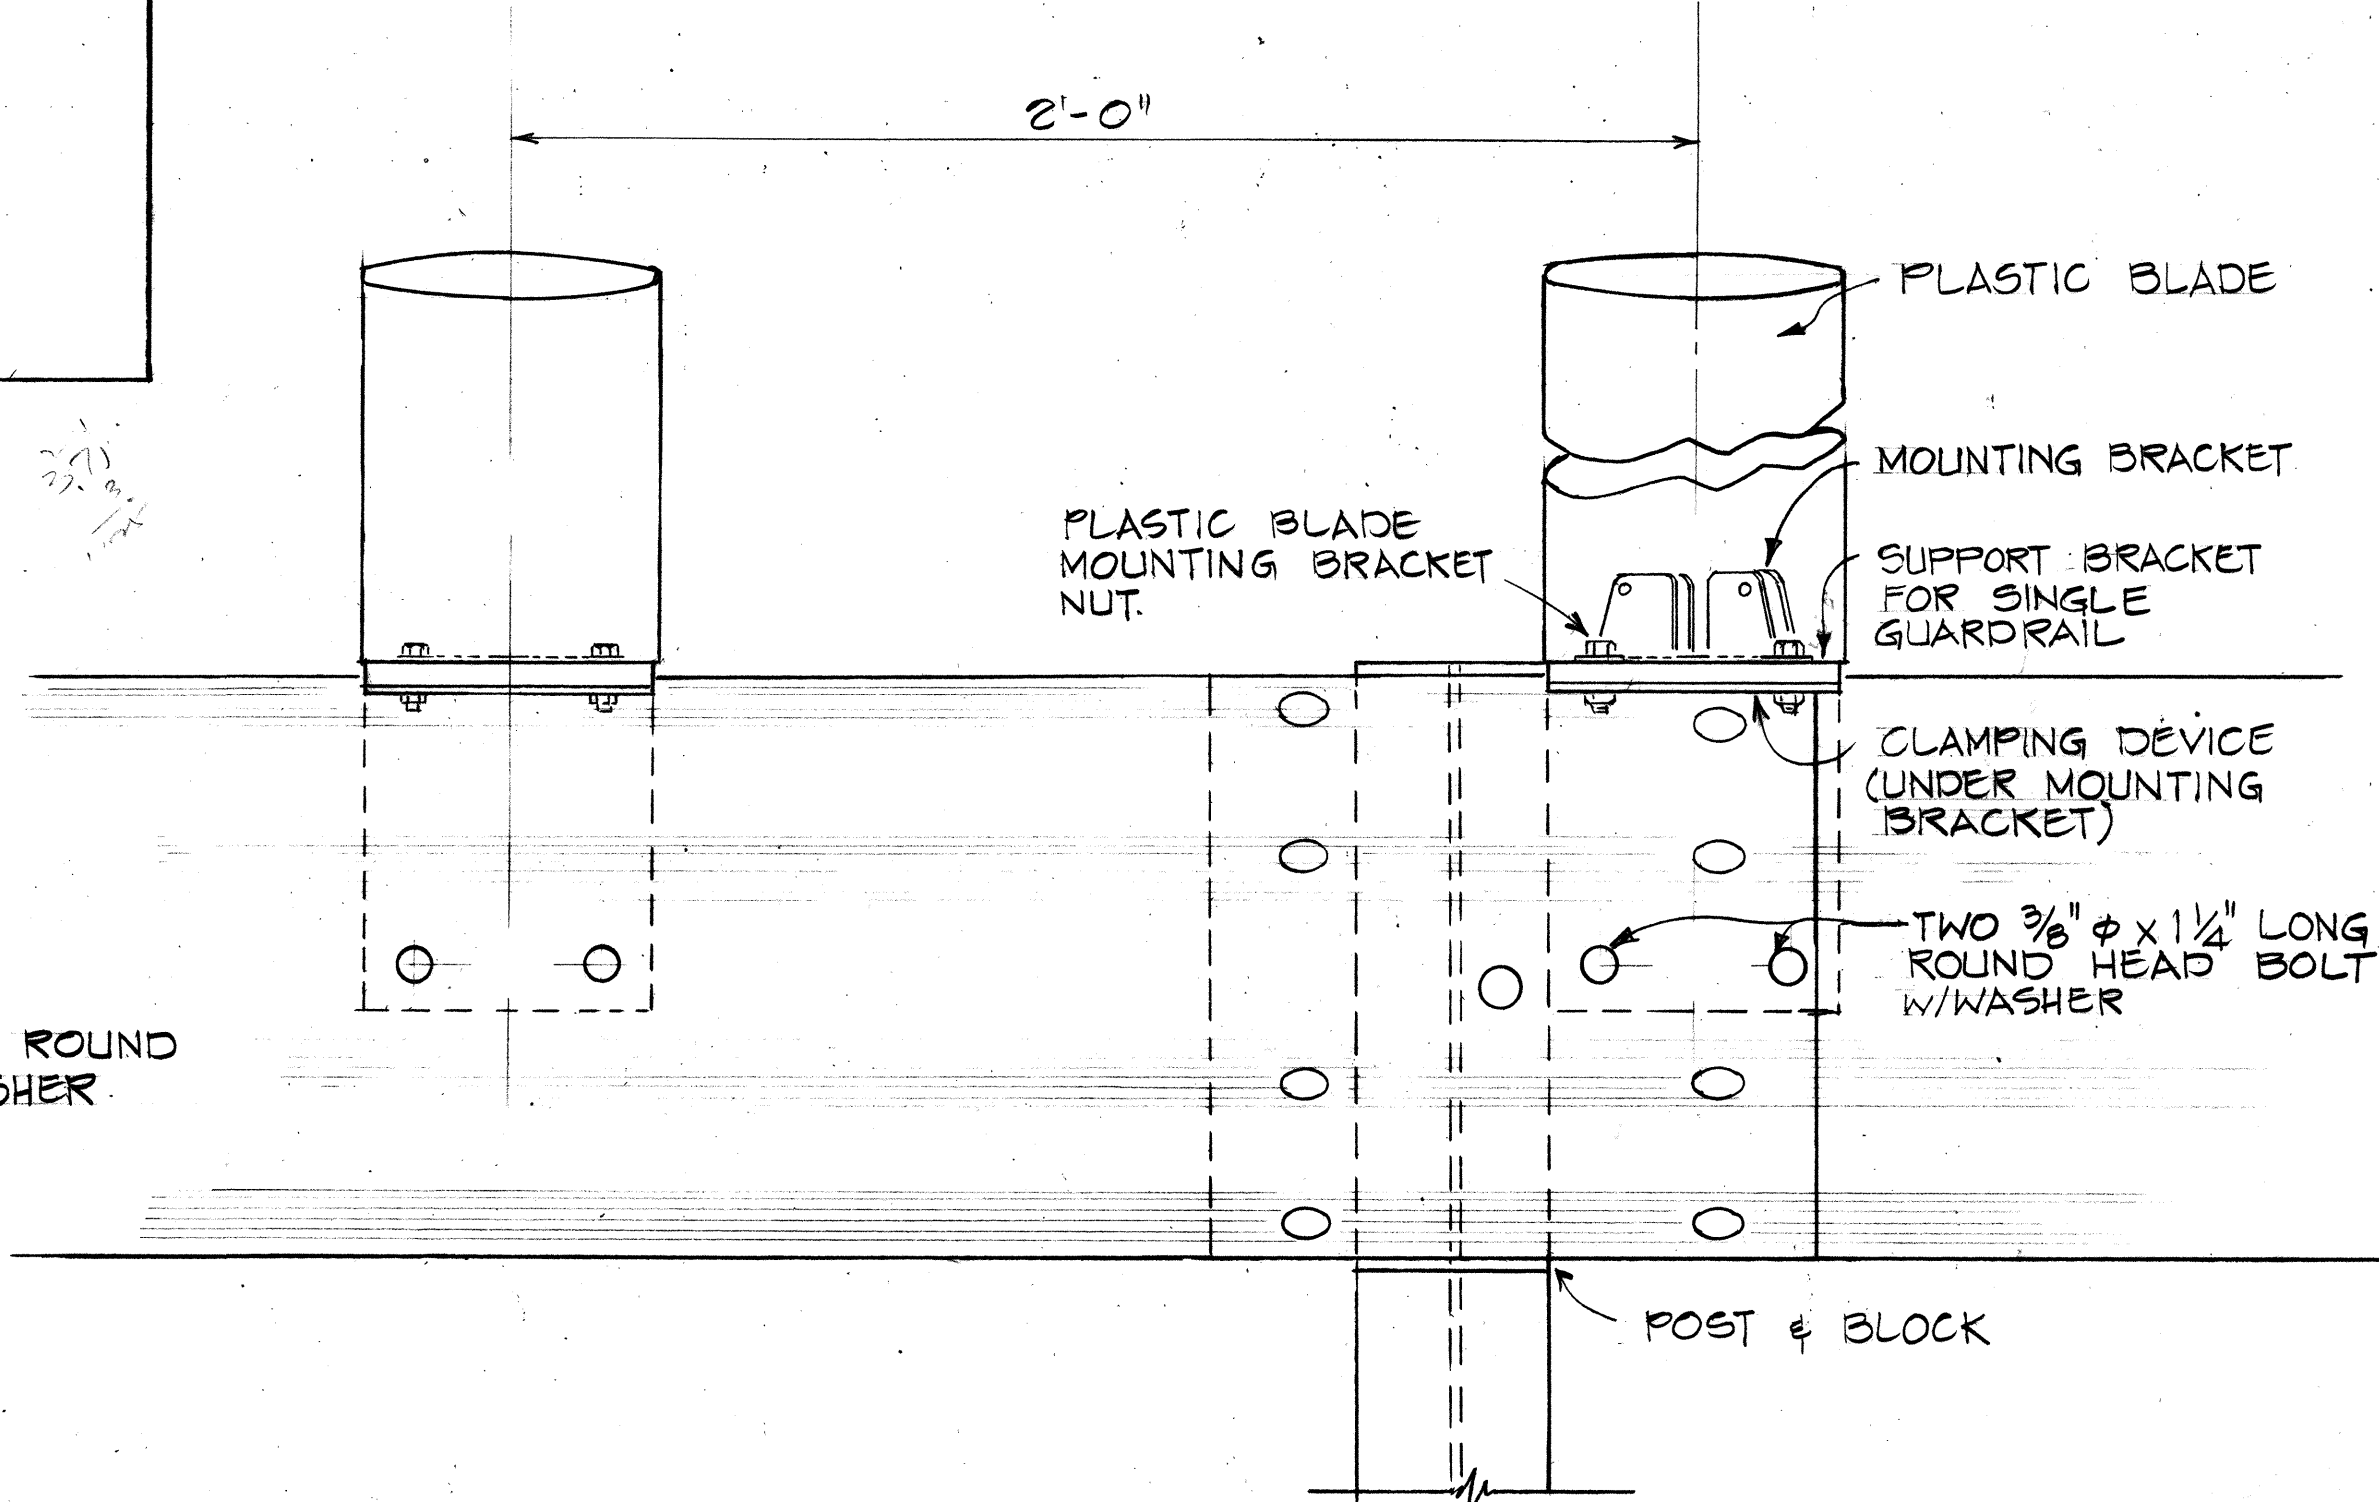


ELEVATION

SINGLE RAIL PLASTIC BLADE MOUNTING

Scale: 3" = 1'-0"

- NOTES:
1. PLASTIC BLADES SHALL BE MOUNTED ON UPPER RAIL OF SAW TOOTHED DOUBLE GUARD RAILS.
 2. FOR MOUNTING DETAILS OF GLARE SCREEN ON CONCRETE BARRIER SEE SHEET ADD. 40.

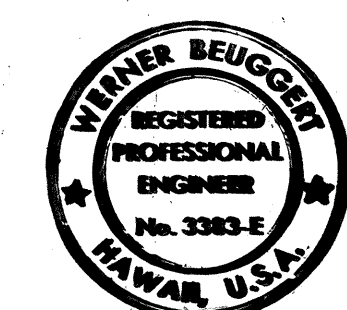


THIS WORK WAS PREPARED BY ME OR UNDER MY SUPERVISION
Werner Beugnot

3/23/78	DATE	DELETED ALL DETAILS RELATING TO STEEL MESH PANELS. ADDED DETAILS FOR PLASTIC BLADE GLARE SCREEN	REVISION
STATE OF HAWAII DEPARTMENT OF TRANSPORTATION LAND TRANSPORTATION FACILITIES DIVISION			
DETAILS OF PLASTIC BLADE HEADLIGHT GLARE SCREEN (FOR GUARDRAIL, TYPE 3)			
KEEHI INTERCHANGE F.A.I. PROJ. NO. I-HI-1 (131)-17			
Scale: As Shown Date: 1978			
SHEET No. 4 OF 26 SHEETS			

ORIGINAL PLAN	DATE
DRAWN BY	
DESIGNED BY	
NOTE BOOK	
QUANTITIES BY	
CHECKED BY	
No.	

FED. ROAD DIST. NO.	STATE	FED. AID PROJ. NO.	FISCAL YEAR	SHEET NO.	TOTAL SHEETS
HAWAII	HAW.	1-HI-1(131):17	1977	43	394

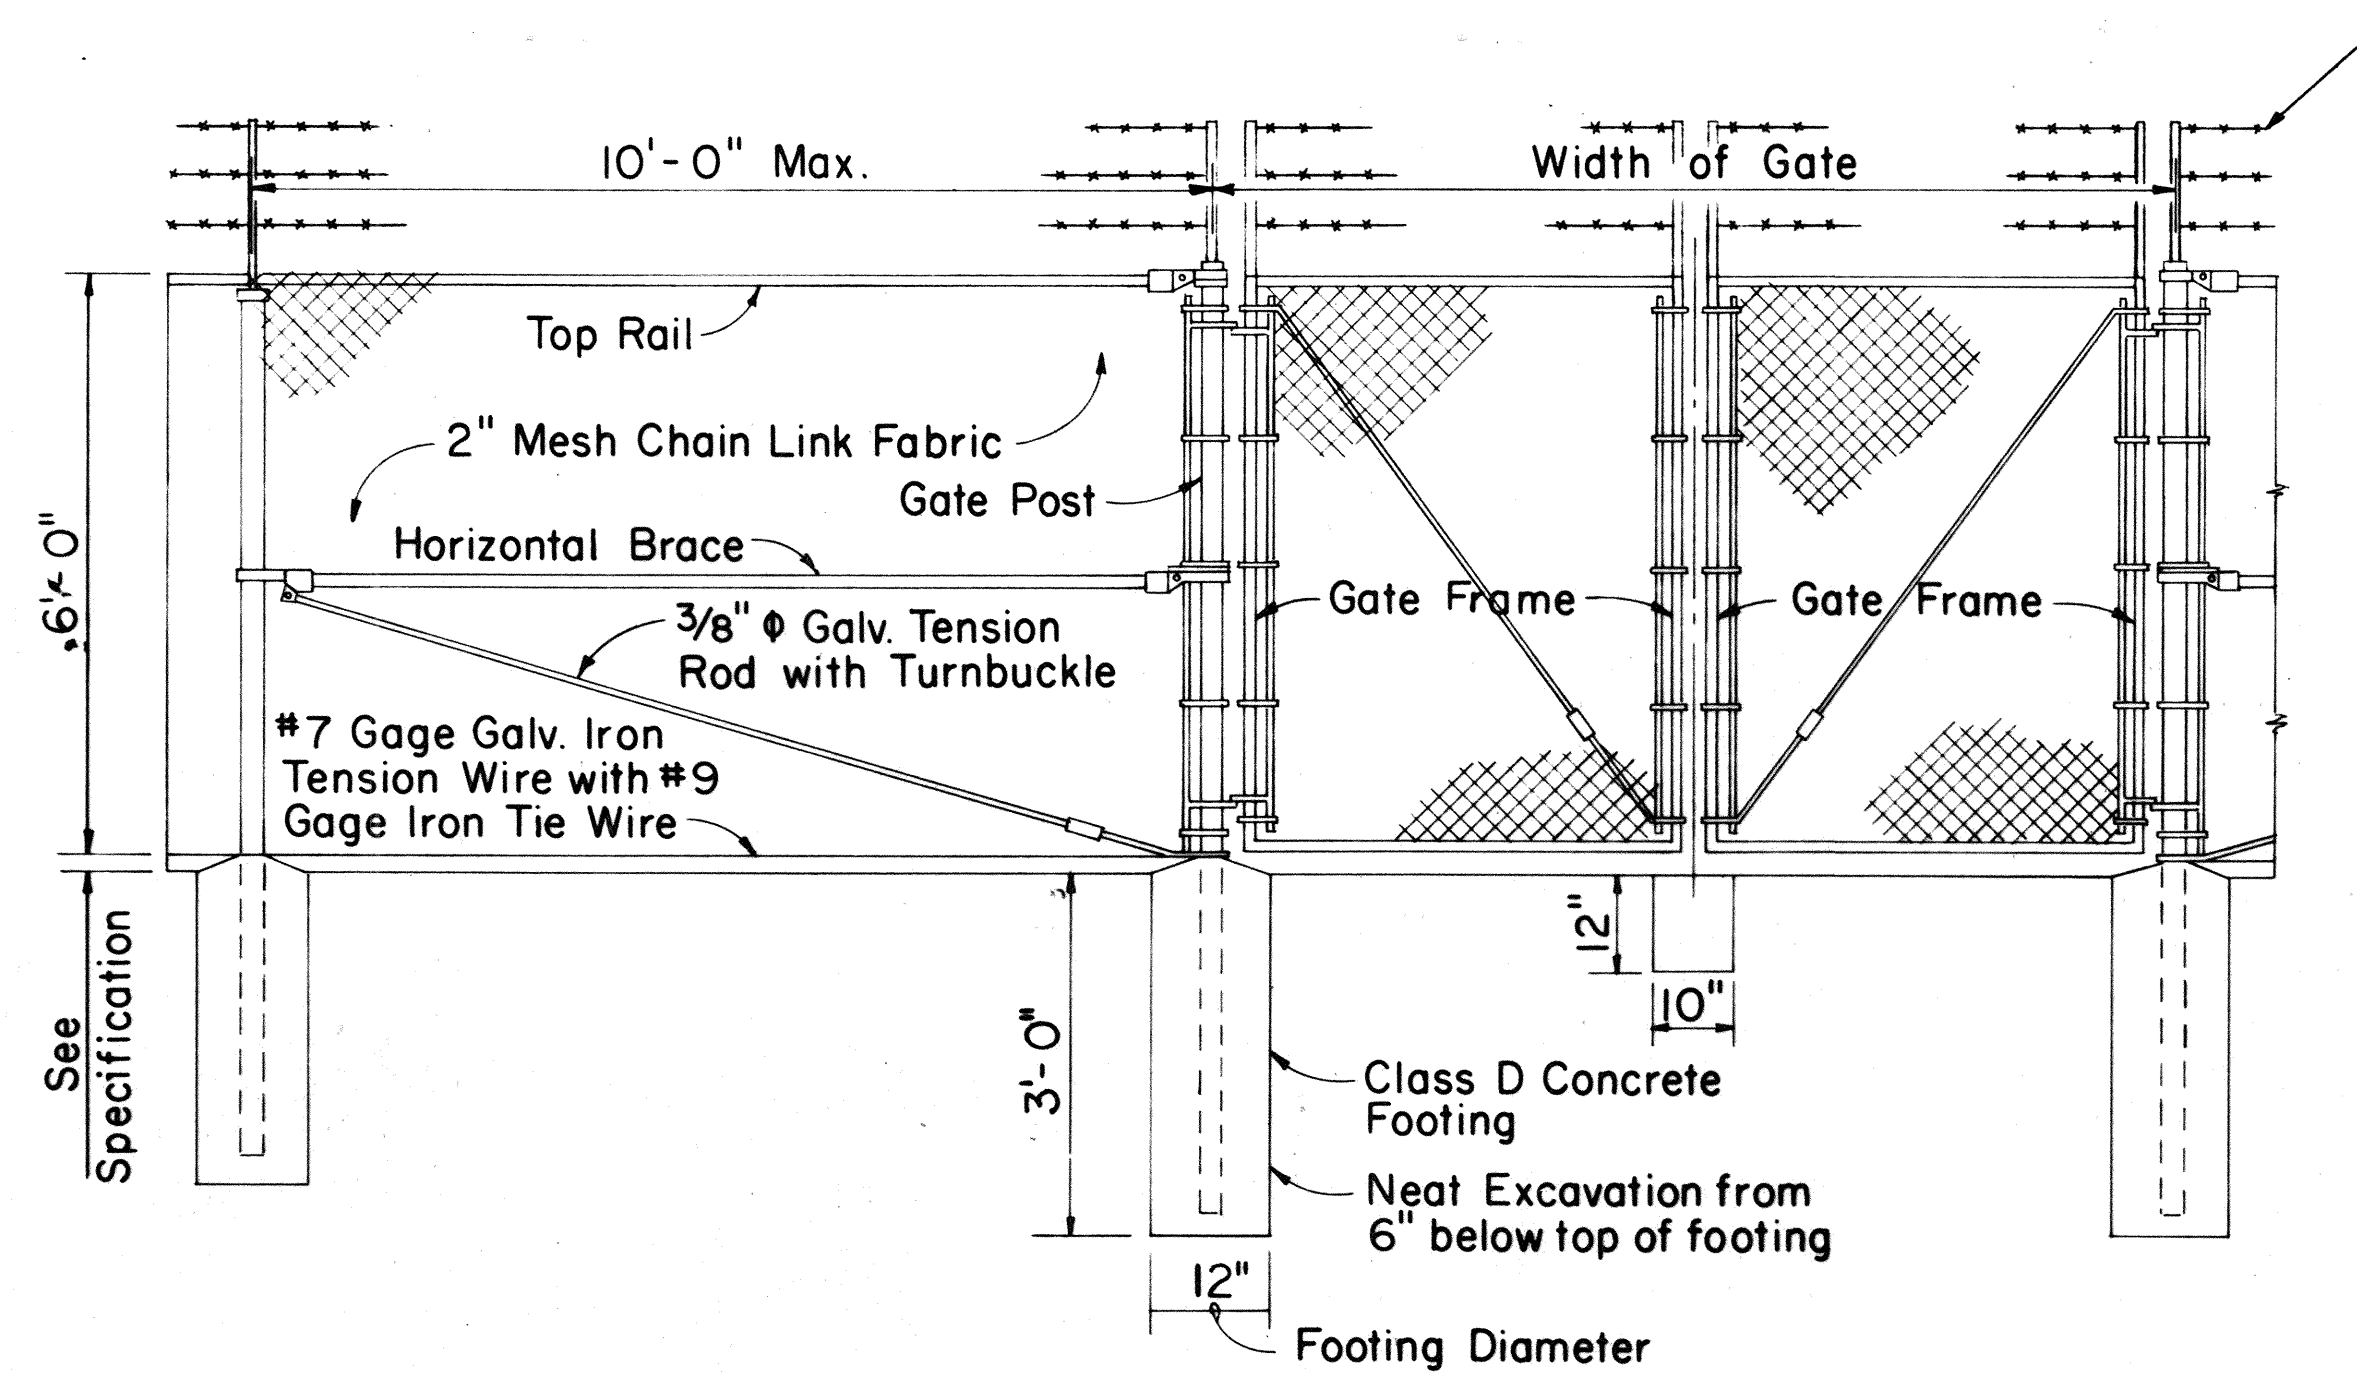


LINE POST

GATE POST

GATE POST

DETAIL OF CHAIN LINK GATE

- NOTE: 1. Gate fork latch and lock, flush plate and anchor, and plunger shall be installed with Gates, and shall be considered as incidental to Chain Link Fence Gate.
2. Gate frames shall be mitered and welded at corners.
3. Fence detail not shown shall be in accordance with the Standard Specifications.

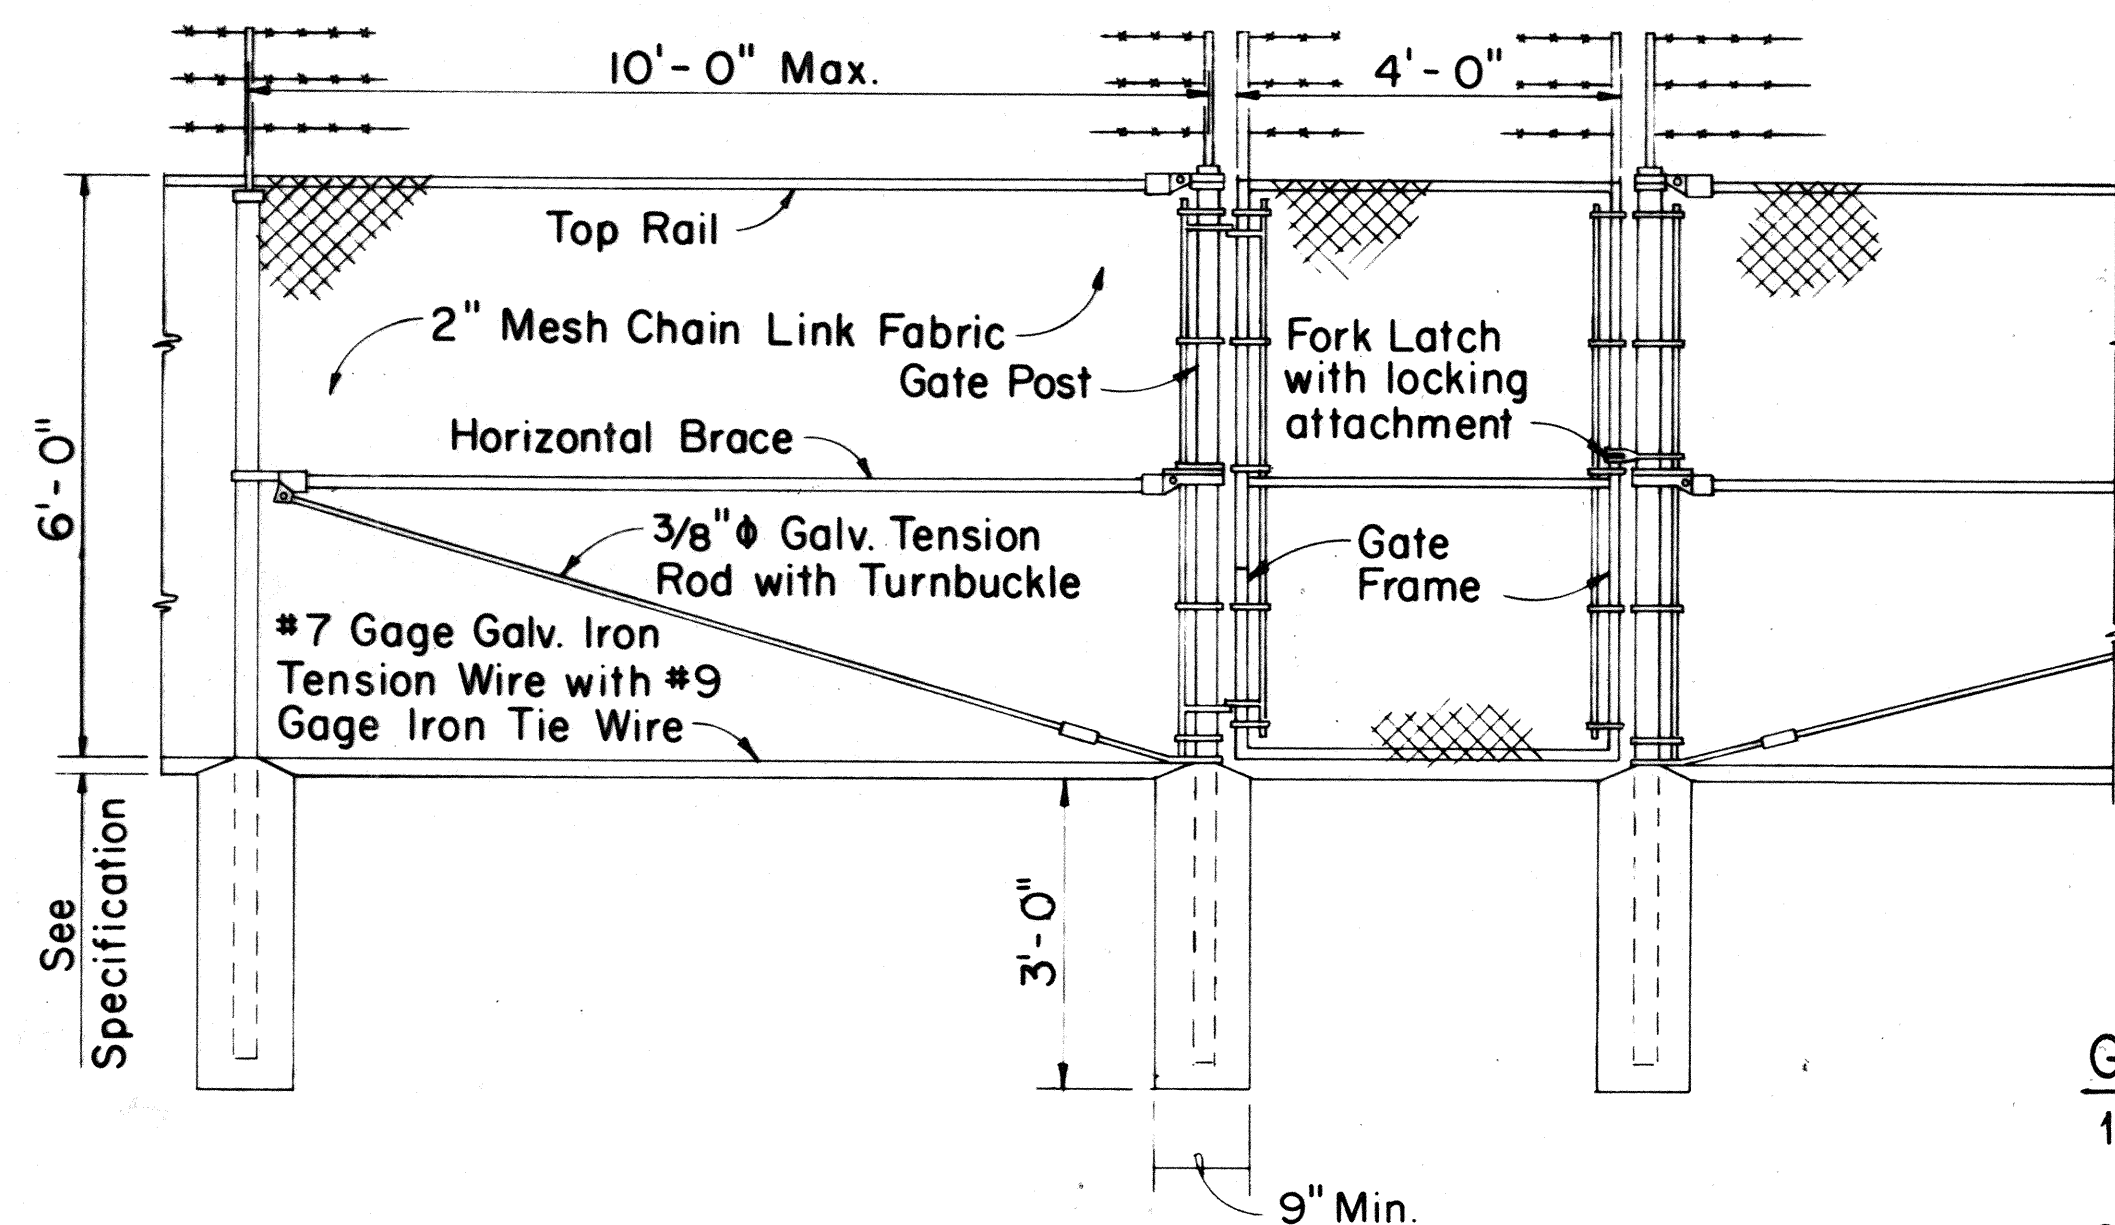


LINE POST

GATE POST

GATE POST


DETAIL OF 4 FT. CHAIN LINK GATE

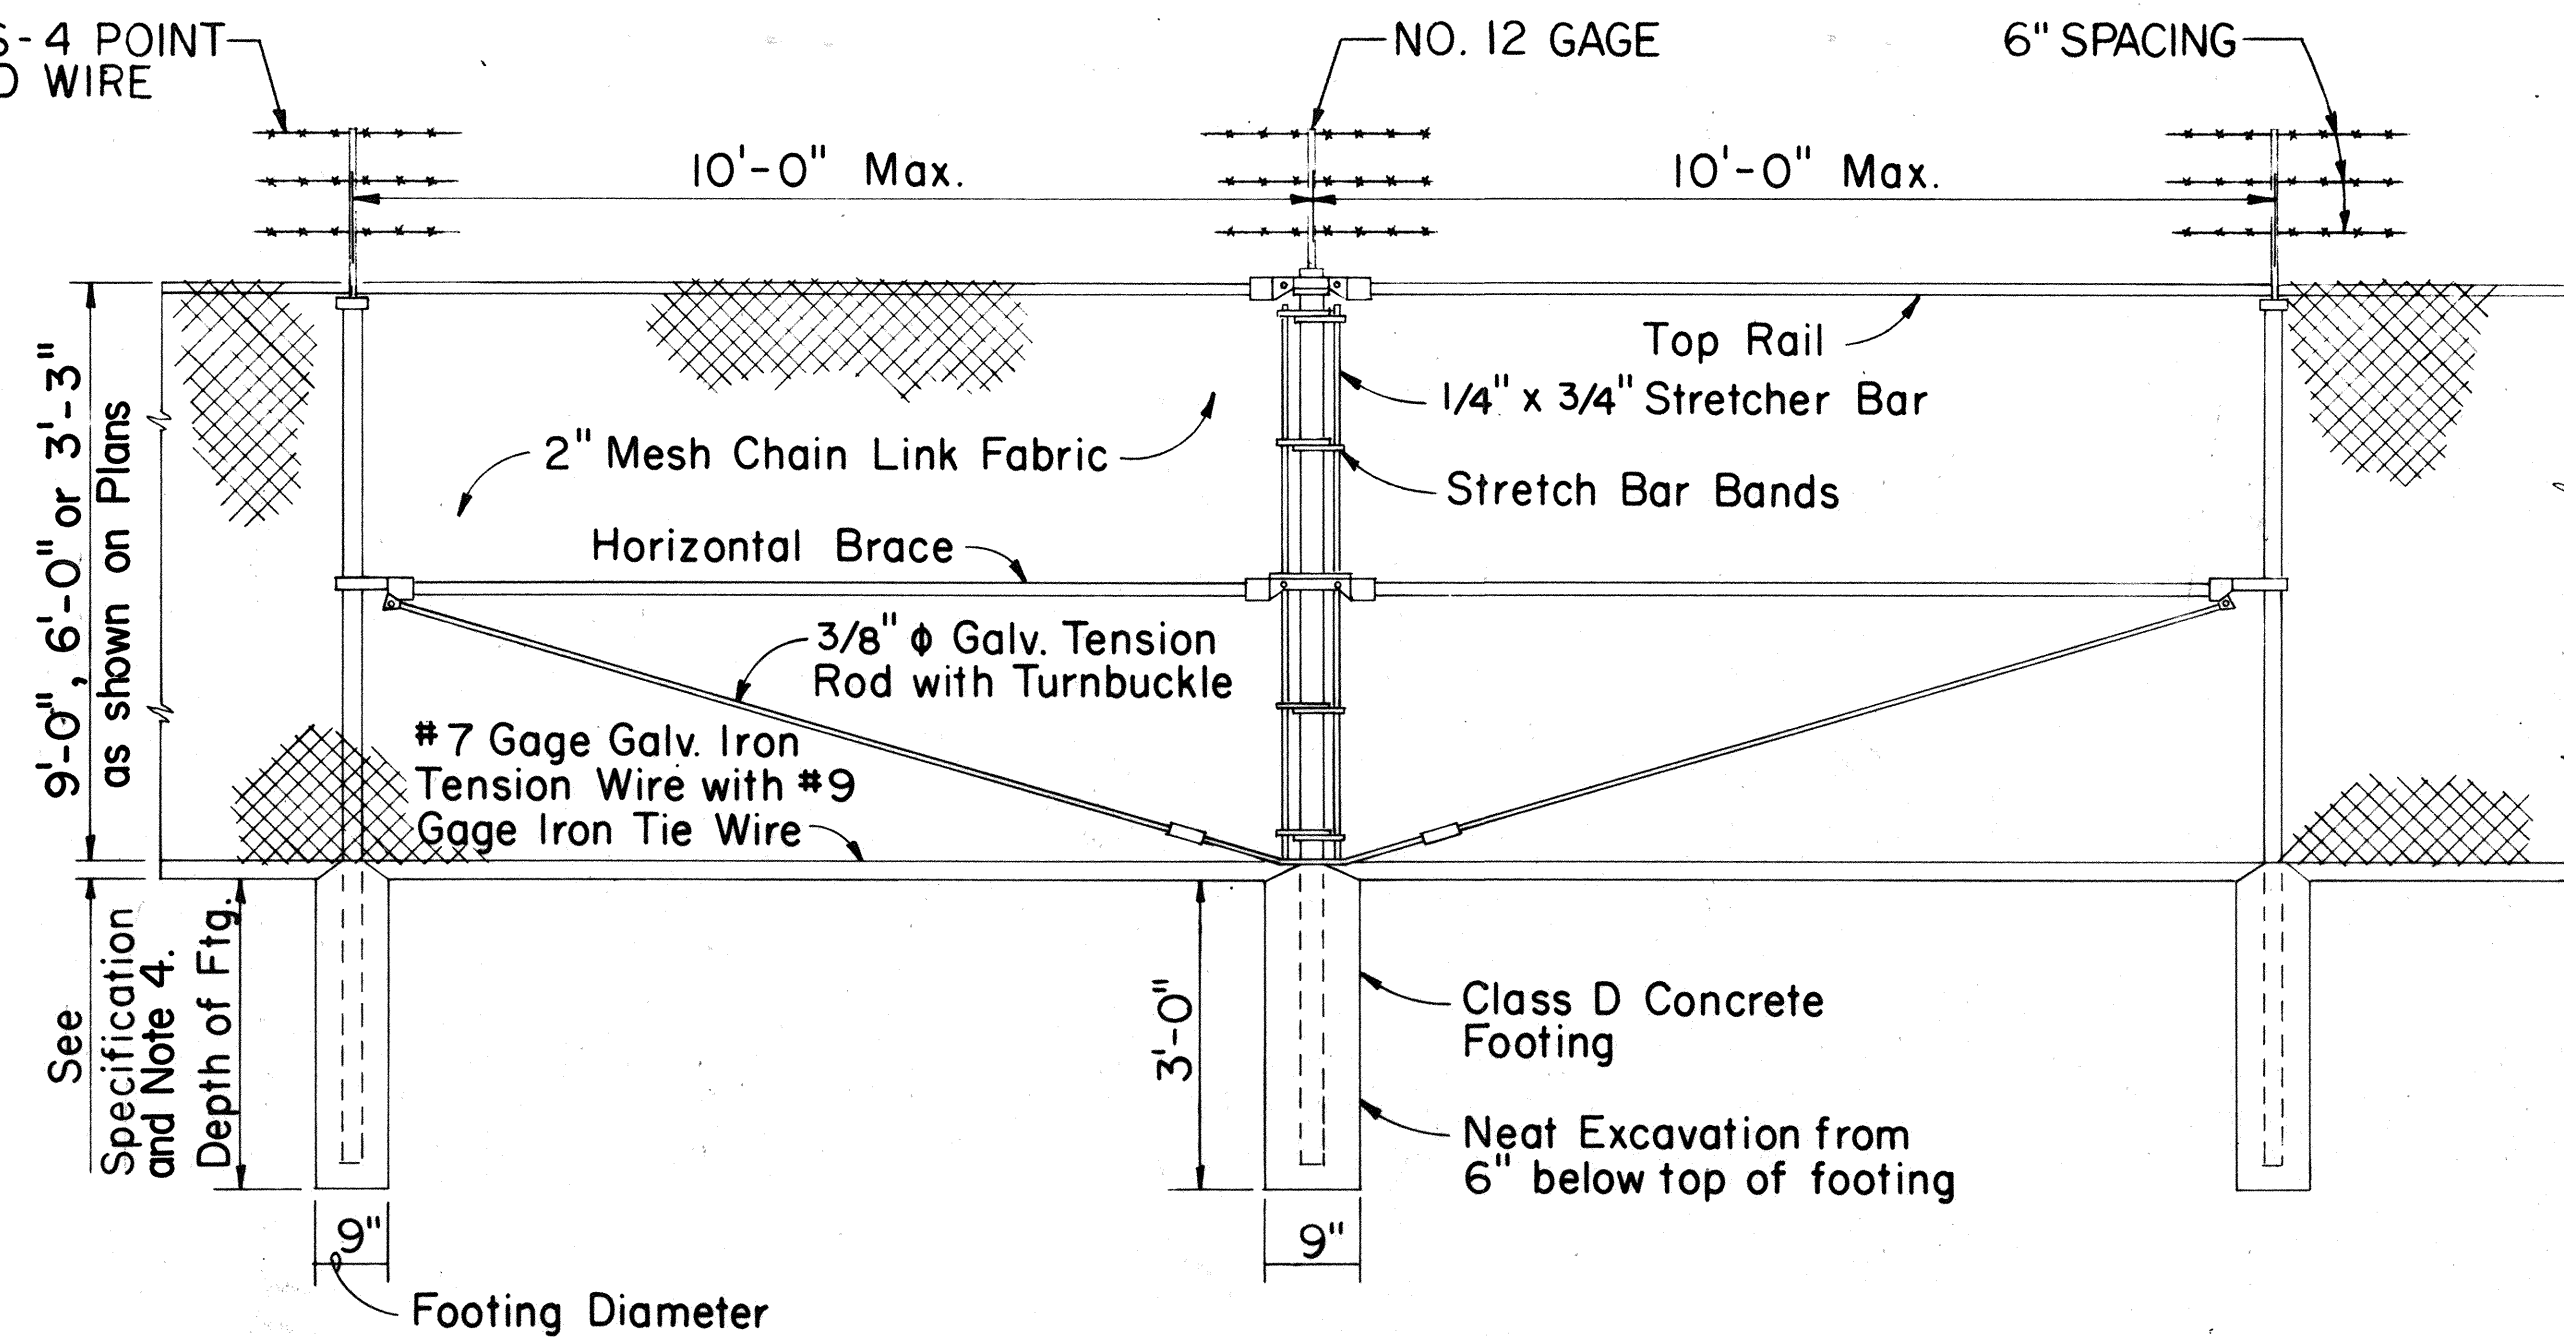

LINE POST

PULL POST

LINE POST

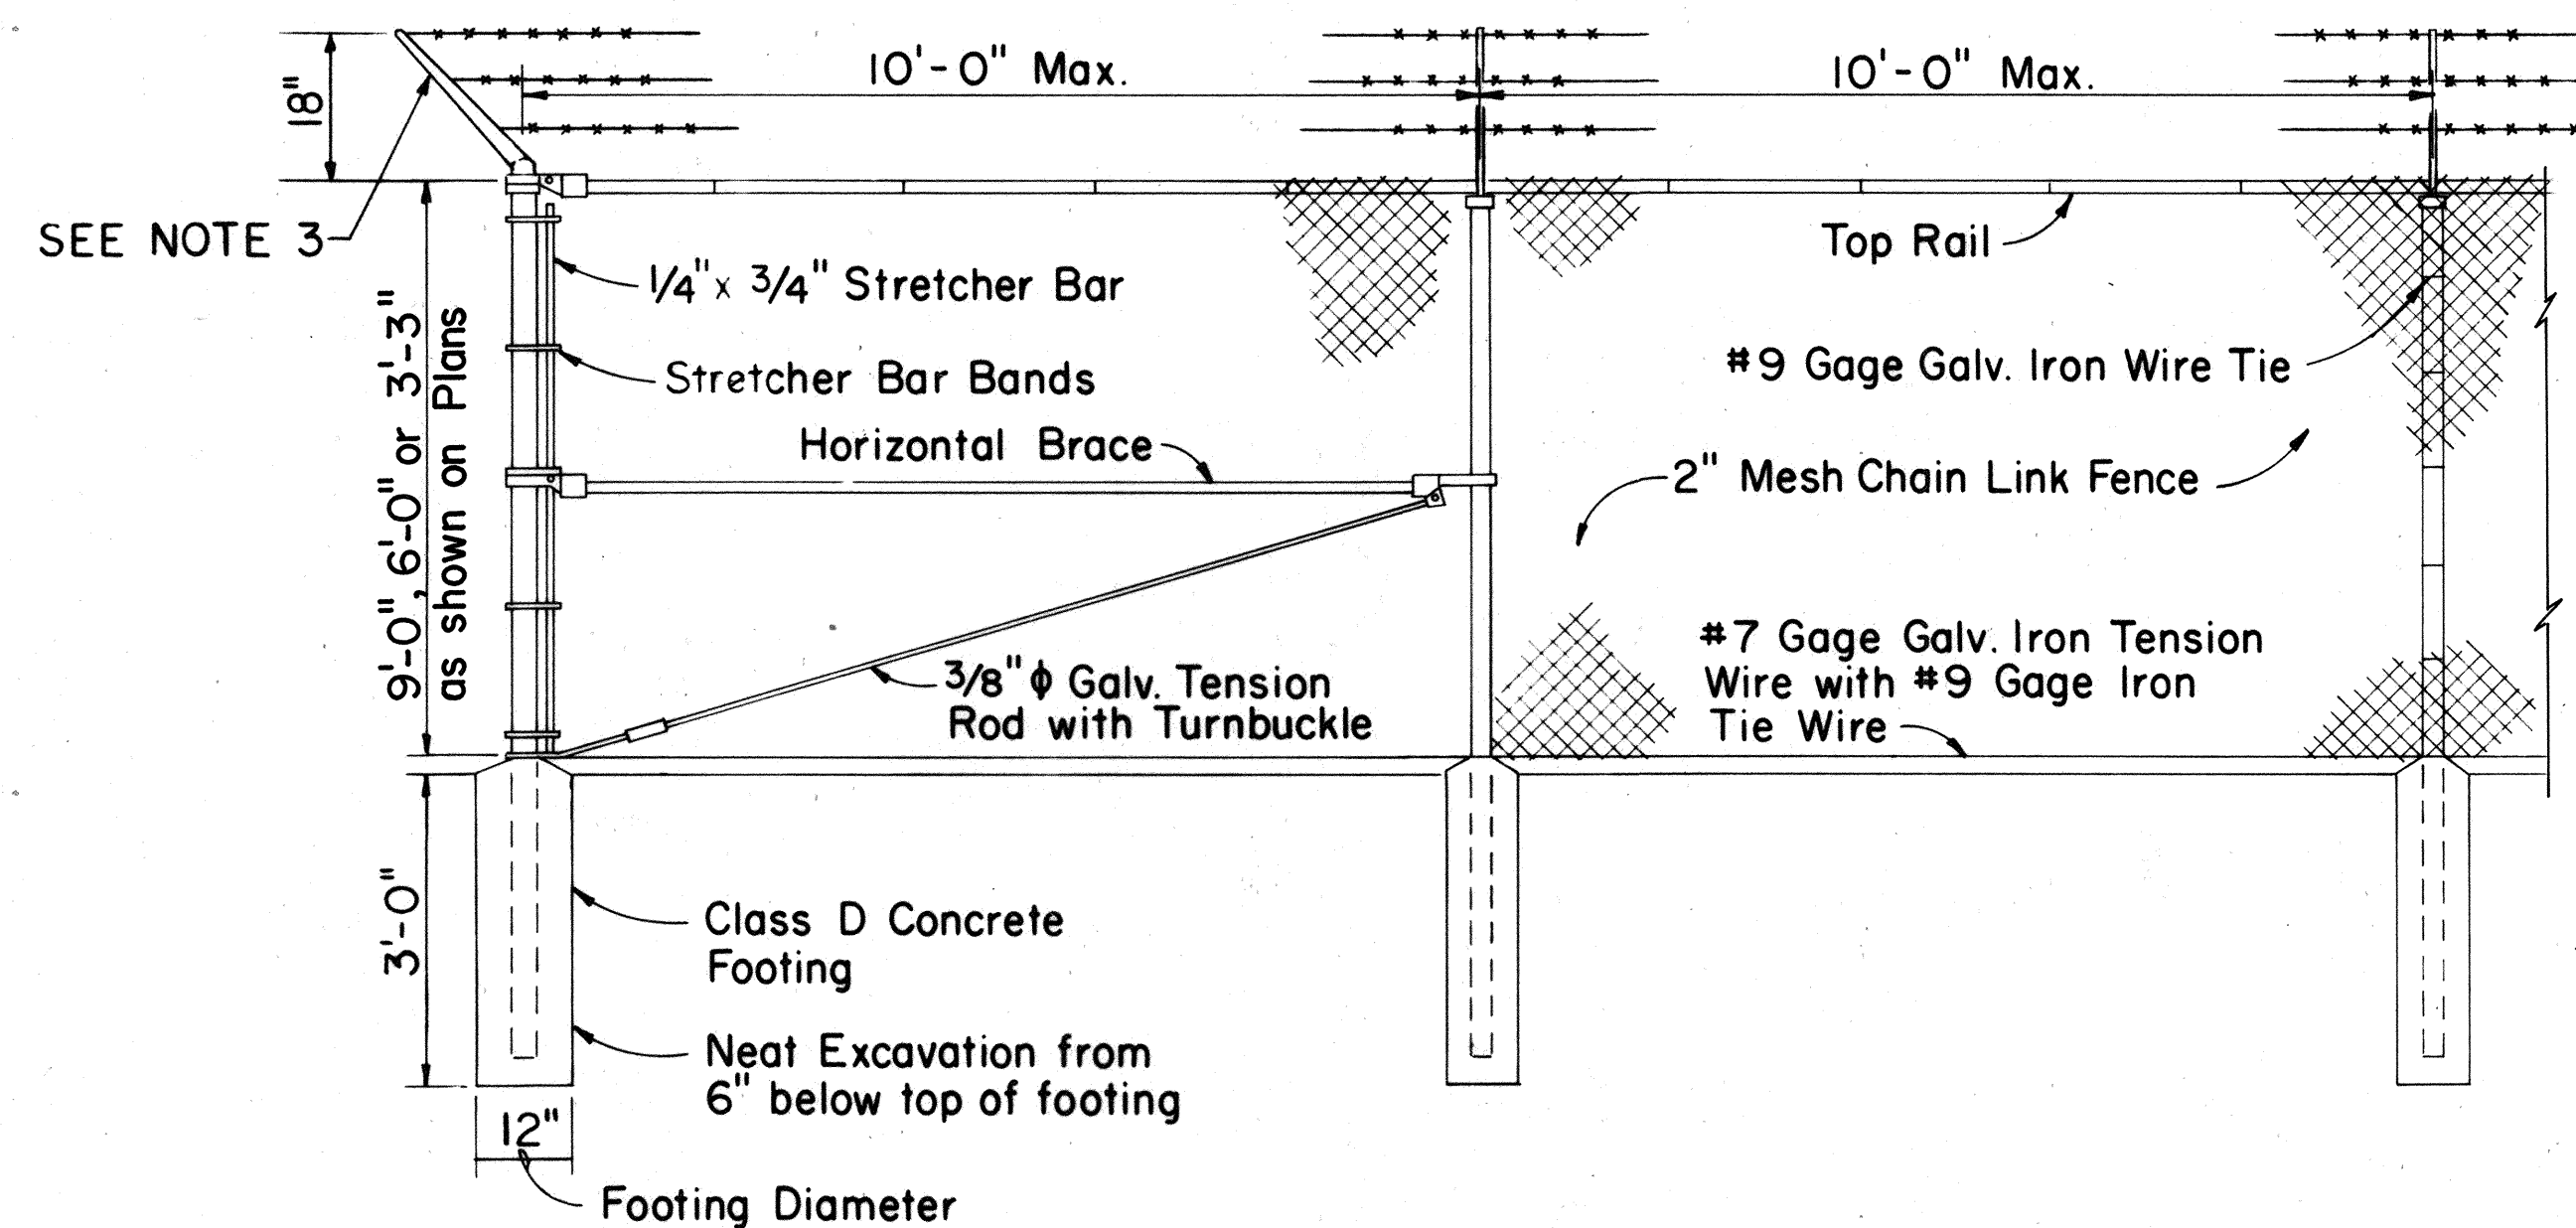

END POST


LINE POST

LINE POST

SECURITY CHAIN LINK FENCE DETAILS


GENERAL NOTES:

- ALL MESH TO BE #9 GAGE WIRE, WOVEN IN A 2" MESH. FENCE TOP AND BOTTOM EDGE TO BE TWISTED AND BARBED.
- FENCE TO BE PROVIDED WITH 3 STRANDS OF 4 POINT BARBED WIRE SECURELY ATTACHED TO SINGLE EXTENSION ARMS ALONG TOP OF FENCE.
- SINGLE EXTENSION ARMS SHALL POINT OUTWARD AT AN ANGLE OF 45°. ALL EXTENSION ARMS TO BE 12 GAGE PRESSED STEEL.
- MATERIALS FOR 9'-0" FENCE SHALL BE THE SAME AS FOR 6'-0", EXCEPT THE FOLLOWING:
LINE POST : 3" O.D.; 5.79#/FT.
END POST : 3 1/2" O.D.; 7.58#/FT.

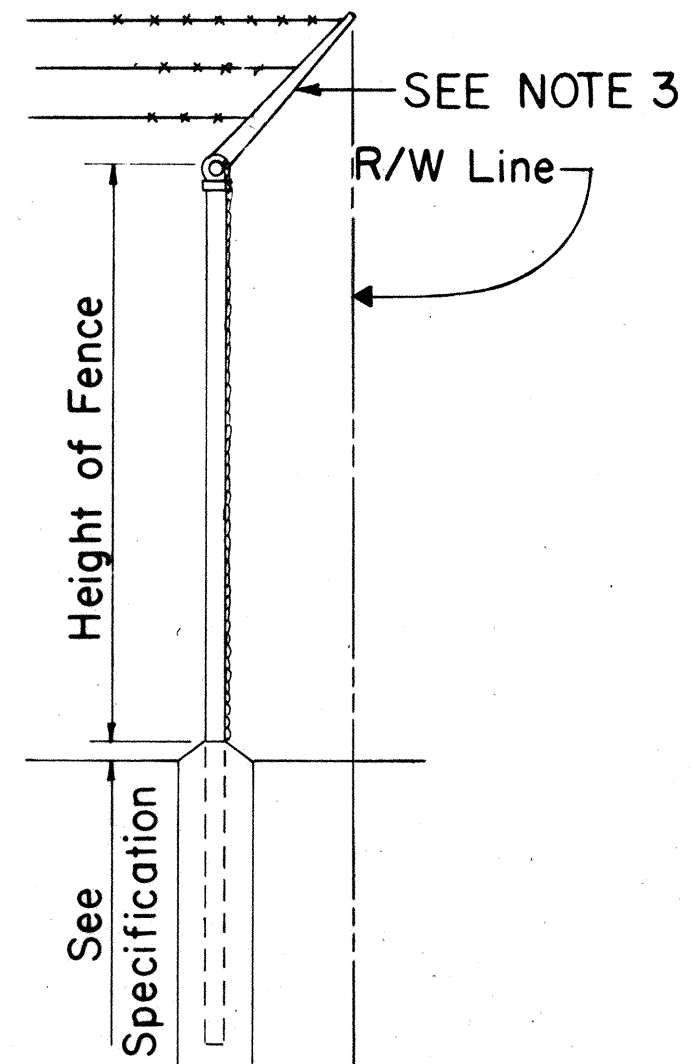

TYPICAL SECTION (WITH CONCRETE FOOTING)


Steel Strap 3/4" x 3/4" x 1'-0" (A36, Galv.) with Gasket in between post & strap (See Note A)

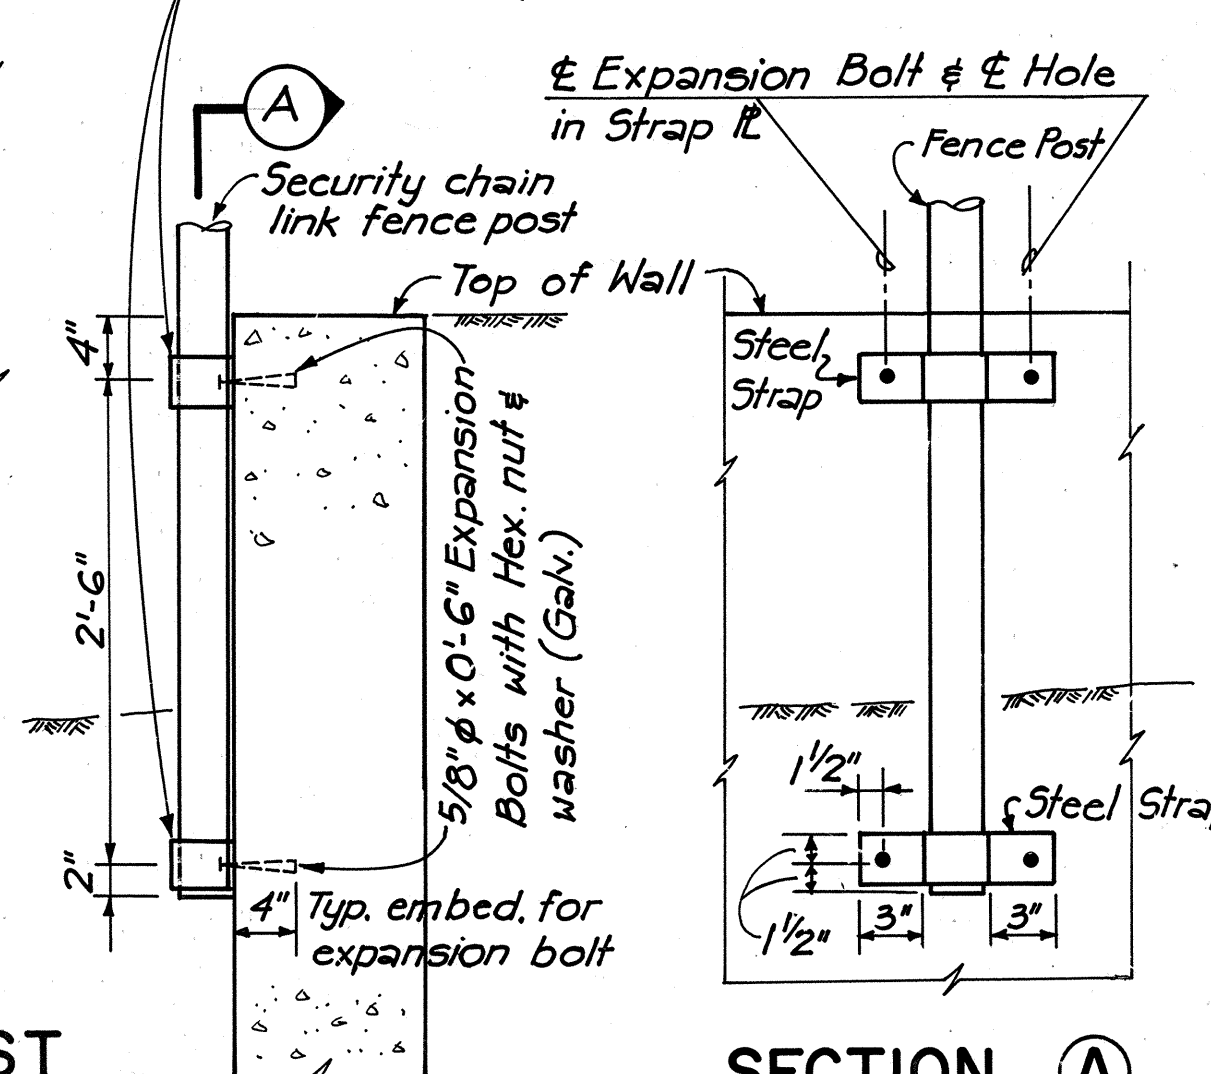

TYPICAL SECTION ON WALL

Scale: 1" = 1'-0"

NOTE 'A': Steel Strap shall be tight contact with fence post. The portion of fence post & steel strap embedded in ground shall be coated with bitumen.

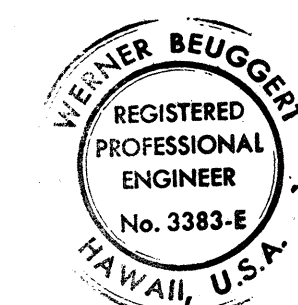

THIS WORK WAS PREPARED BY ME OR UNDER MY SUPERVISION.
Werner Beugger

STATE OF HAWAII
DEPARTMENT OF TRANSPORTATION
HIGHWAYS DIVISION

SECURITY CHAIN LINK FENCE DETAILS (WITH TOPRAIL)


INTERSTATE ROUTE H-1
PROJECT NO. 1-HI-1(131):17

Scale: 1/2" = 1'-0"

Date: Aug. 31, 1977

SHEET No. 6 OF 26 SHEETS


FED. ROAD DIST. NO.	STATE	FED. AID PROJ. NO.	FISCAL YEAR	SHEET NO.	TOTAL SHEETS
HAWAII	HAW.	1-HI-1(13)17	1977	44	394

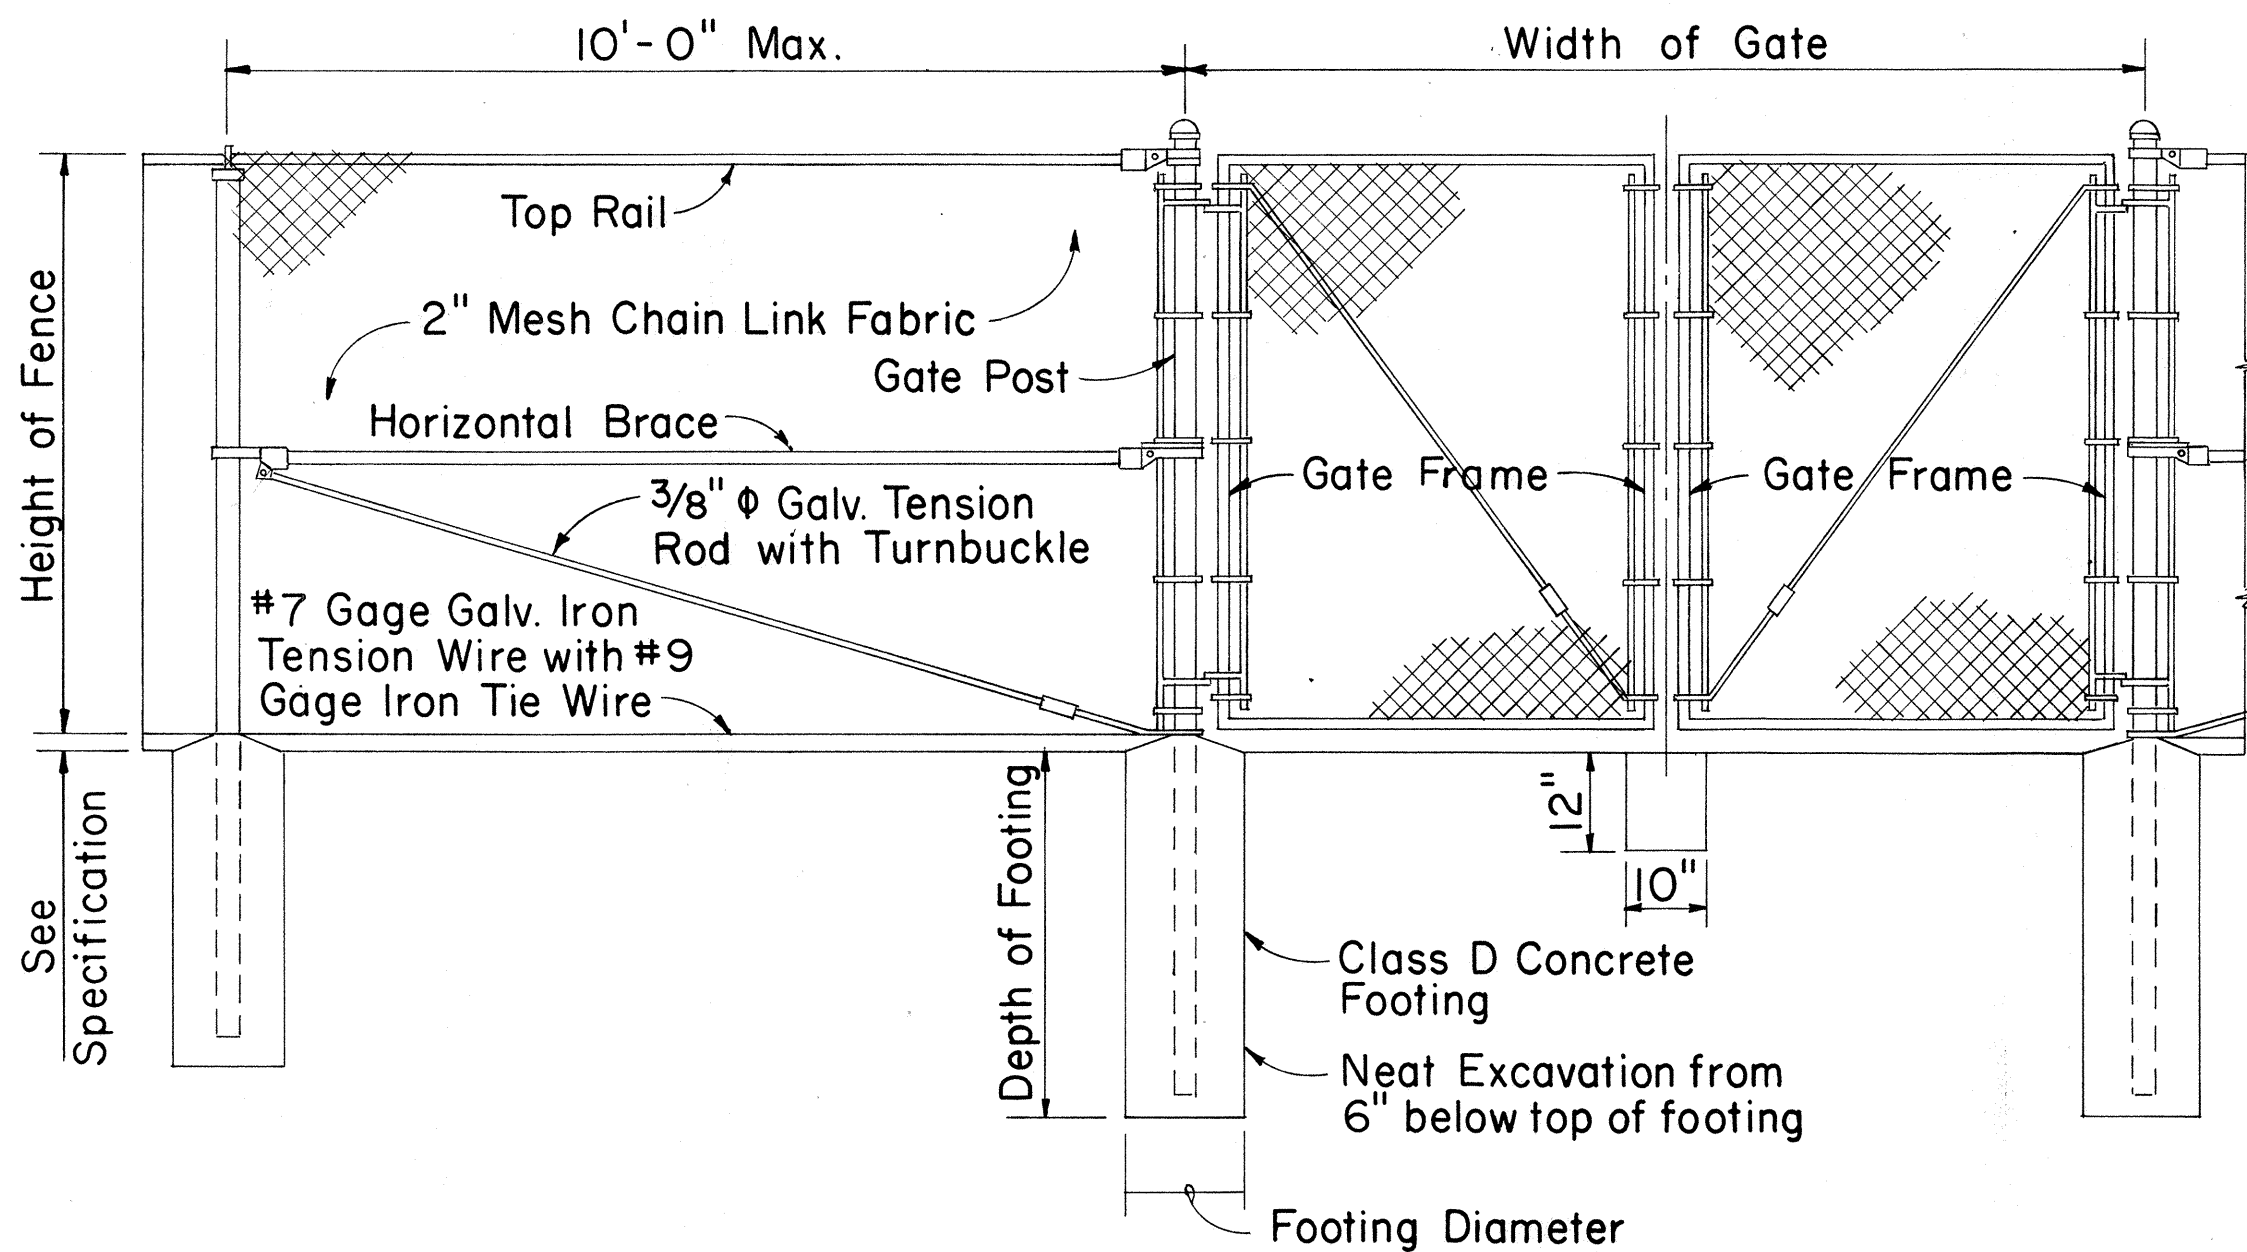

LINE POST GATE POST GATE POST


DETAIL OF CHAIN LINK GATE

- NOTE: 1. Gate fork latch and lock, flush plate and anchor, and plunger shall be installed with Gates, and shall be considered as incidental to Chain Link Fence Gate.
2. Gate frames shall be mitered and welded at corners.
3. Fence detail not shown shall be in accordance with the Standard Specifications.

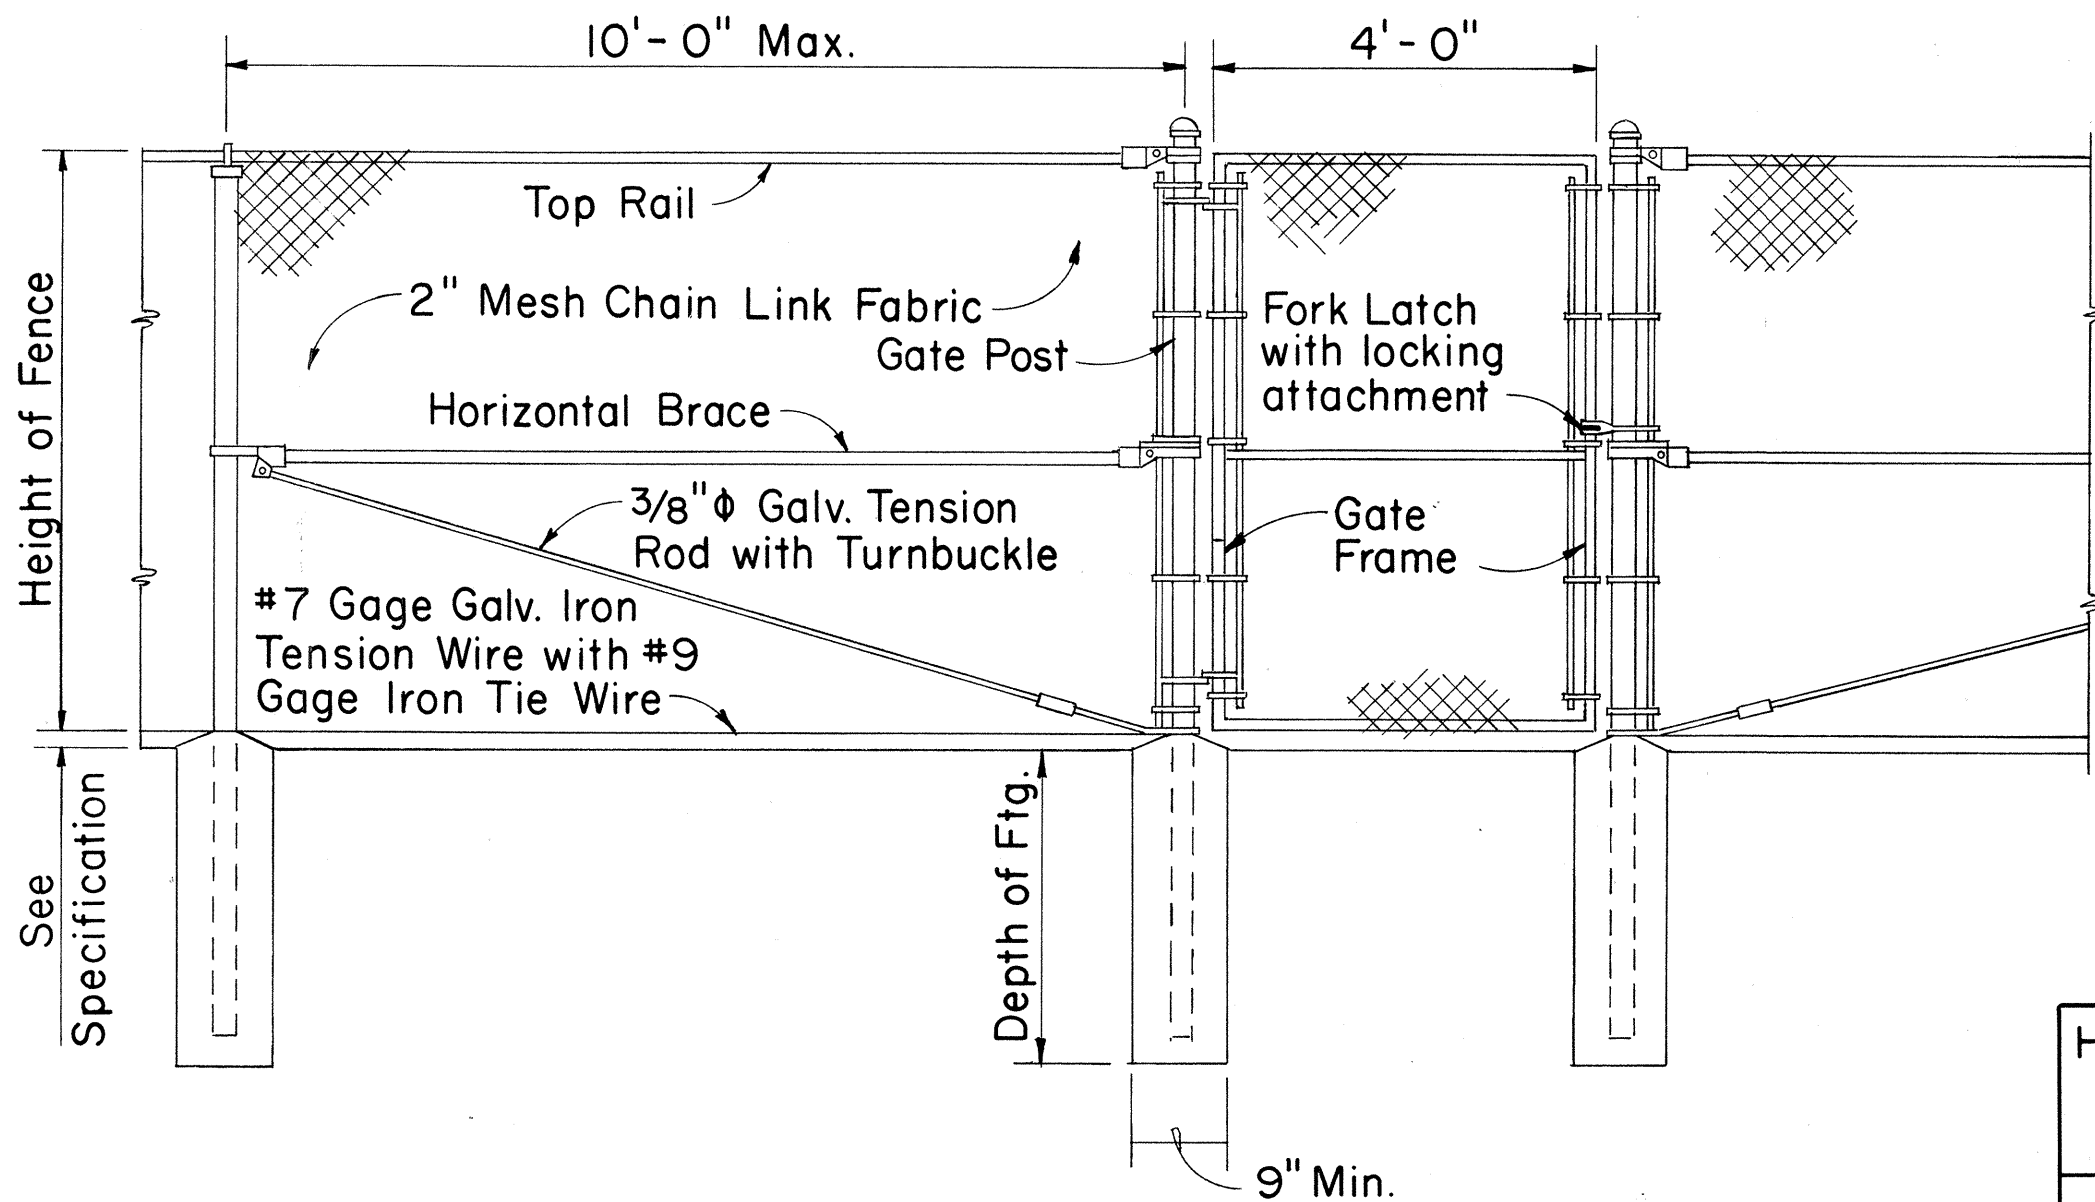


LINE POST GATE POST GATE POST

DETAIL OF 4 FT. CHAIN LINK GATE

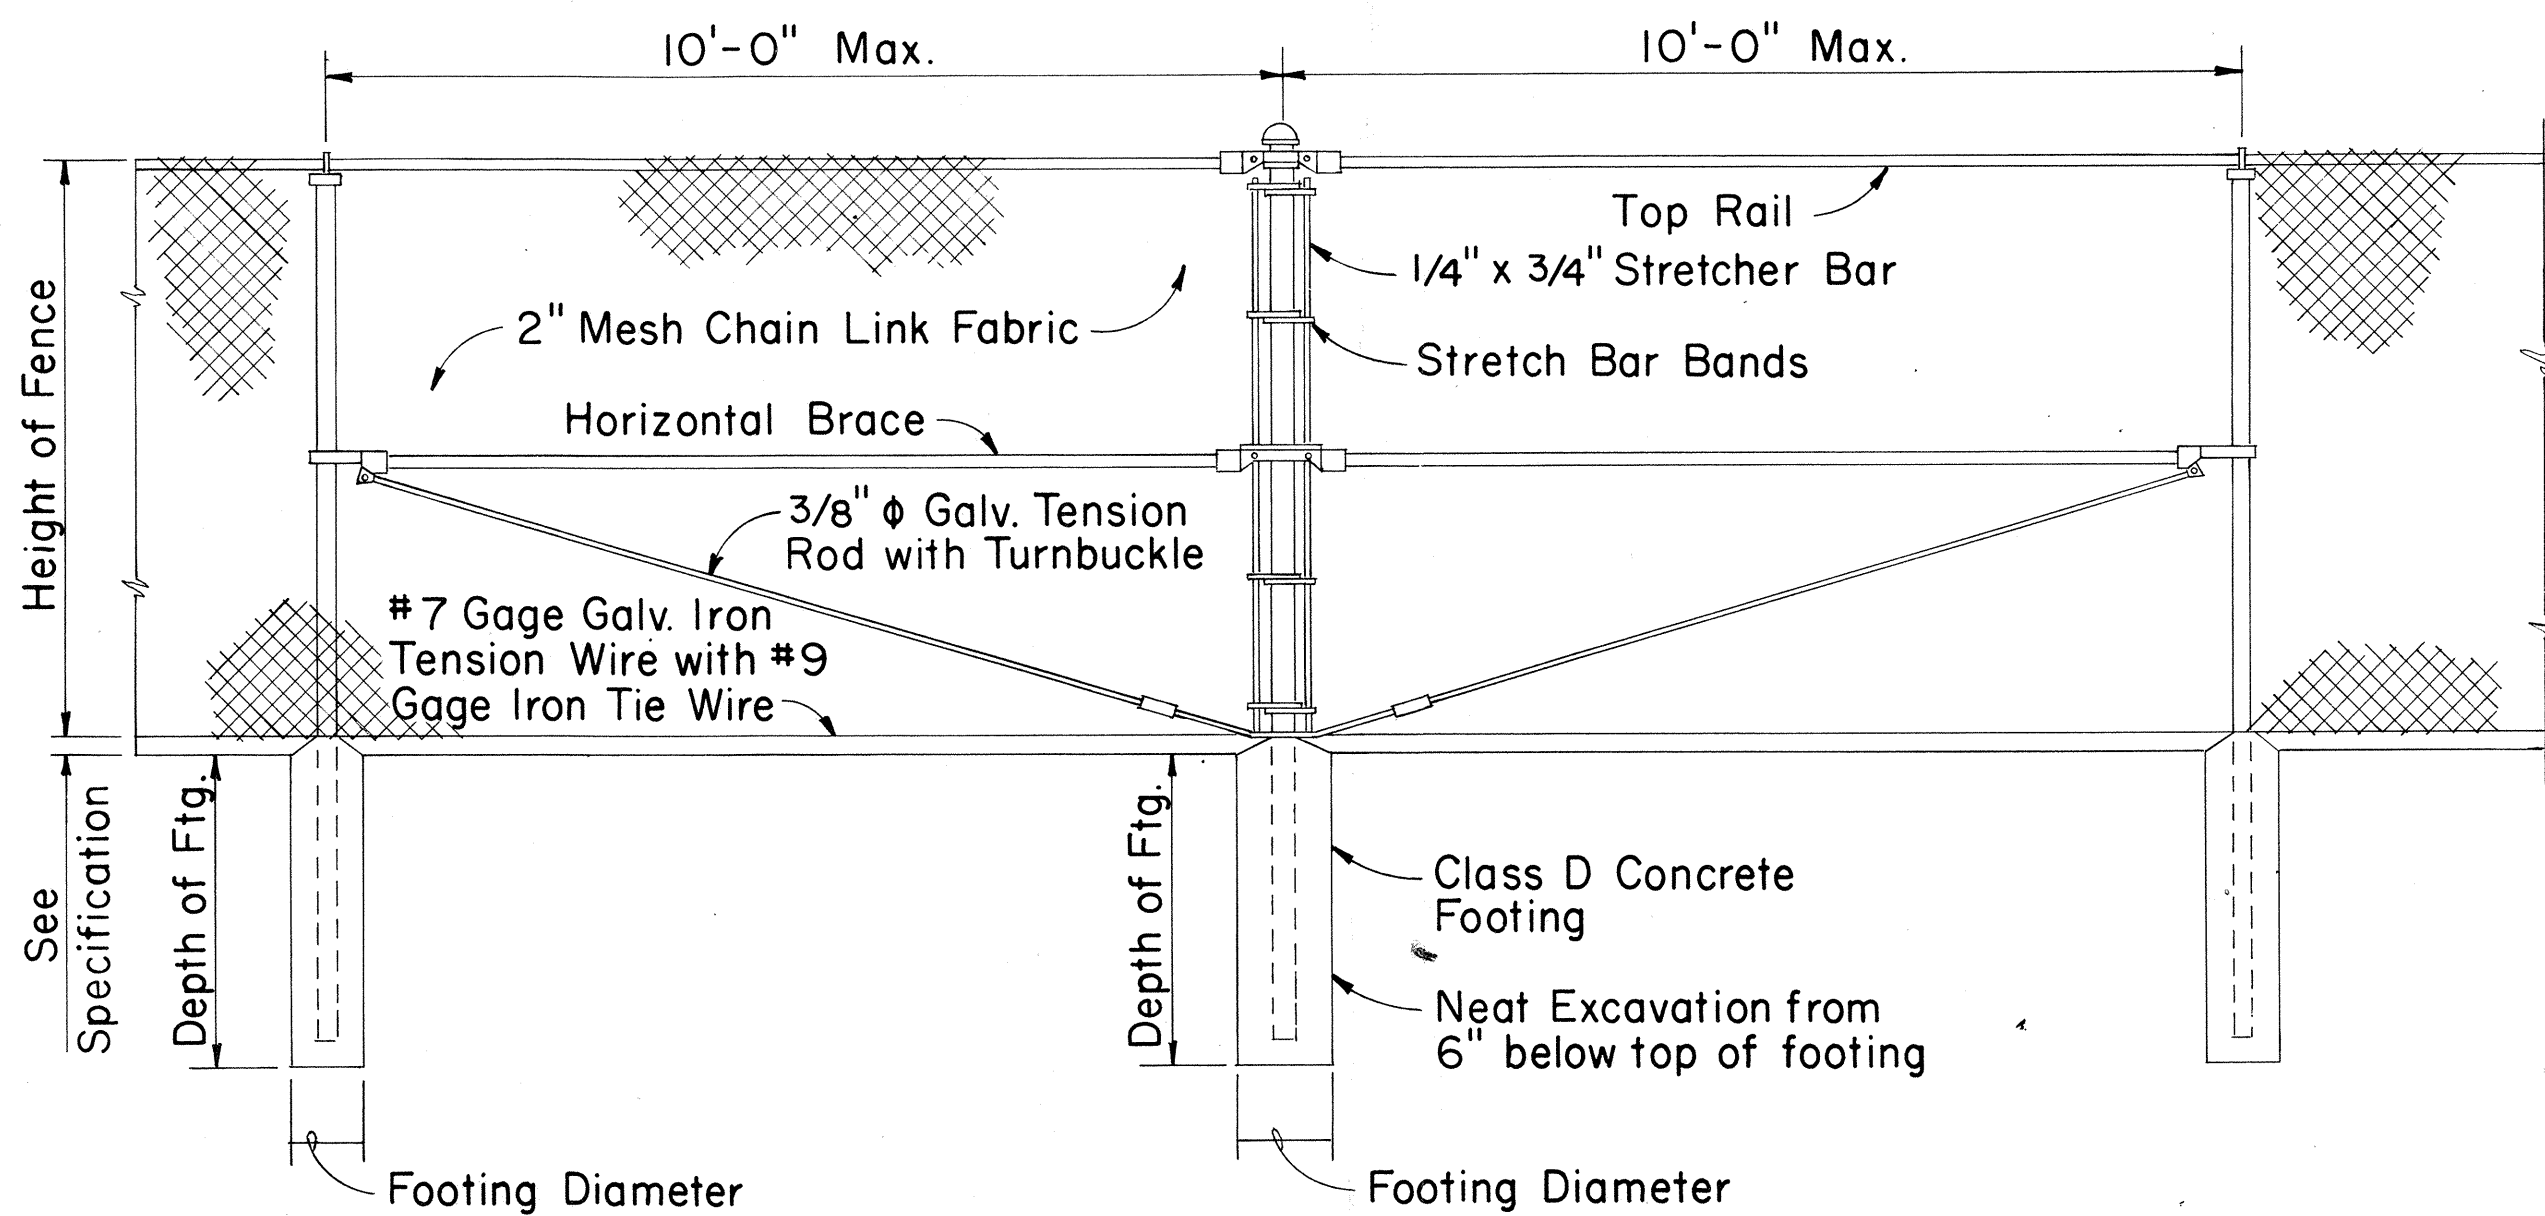

LINE POST PULL POST LINE POST

TYPICAL SECTION (WITH CONCRETE FOOTING)

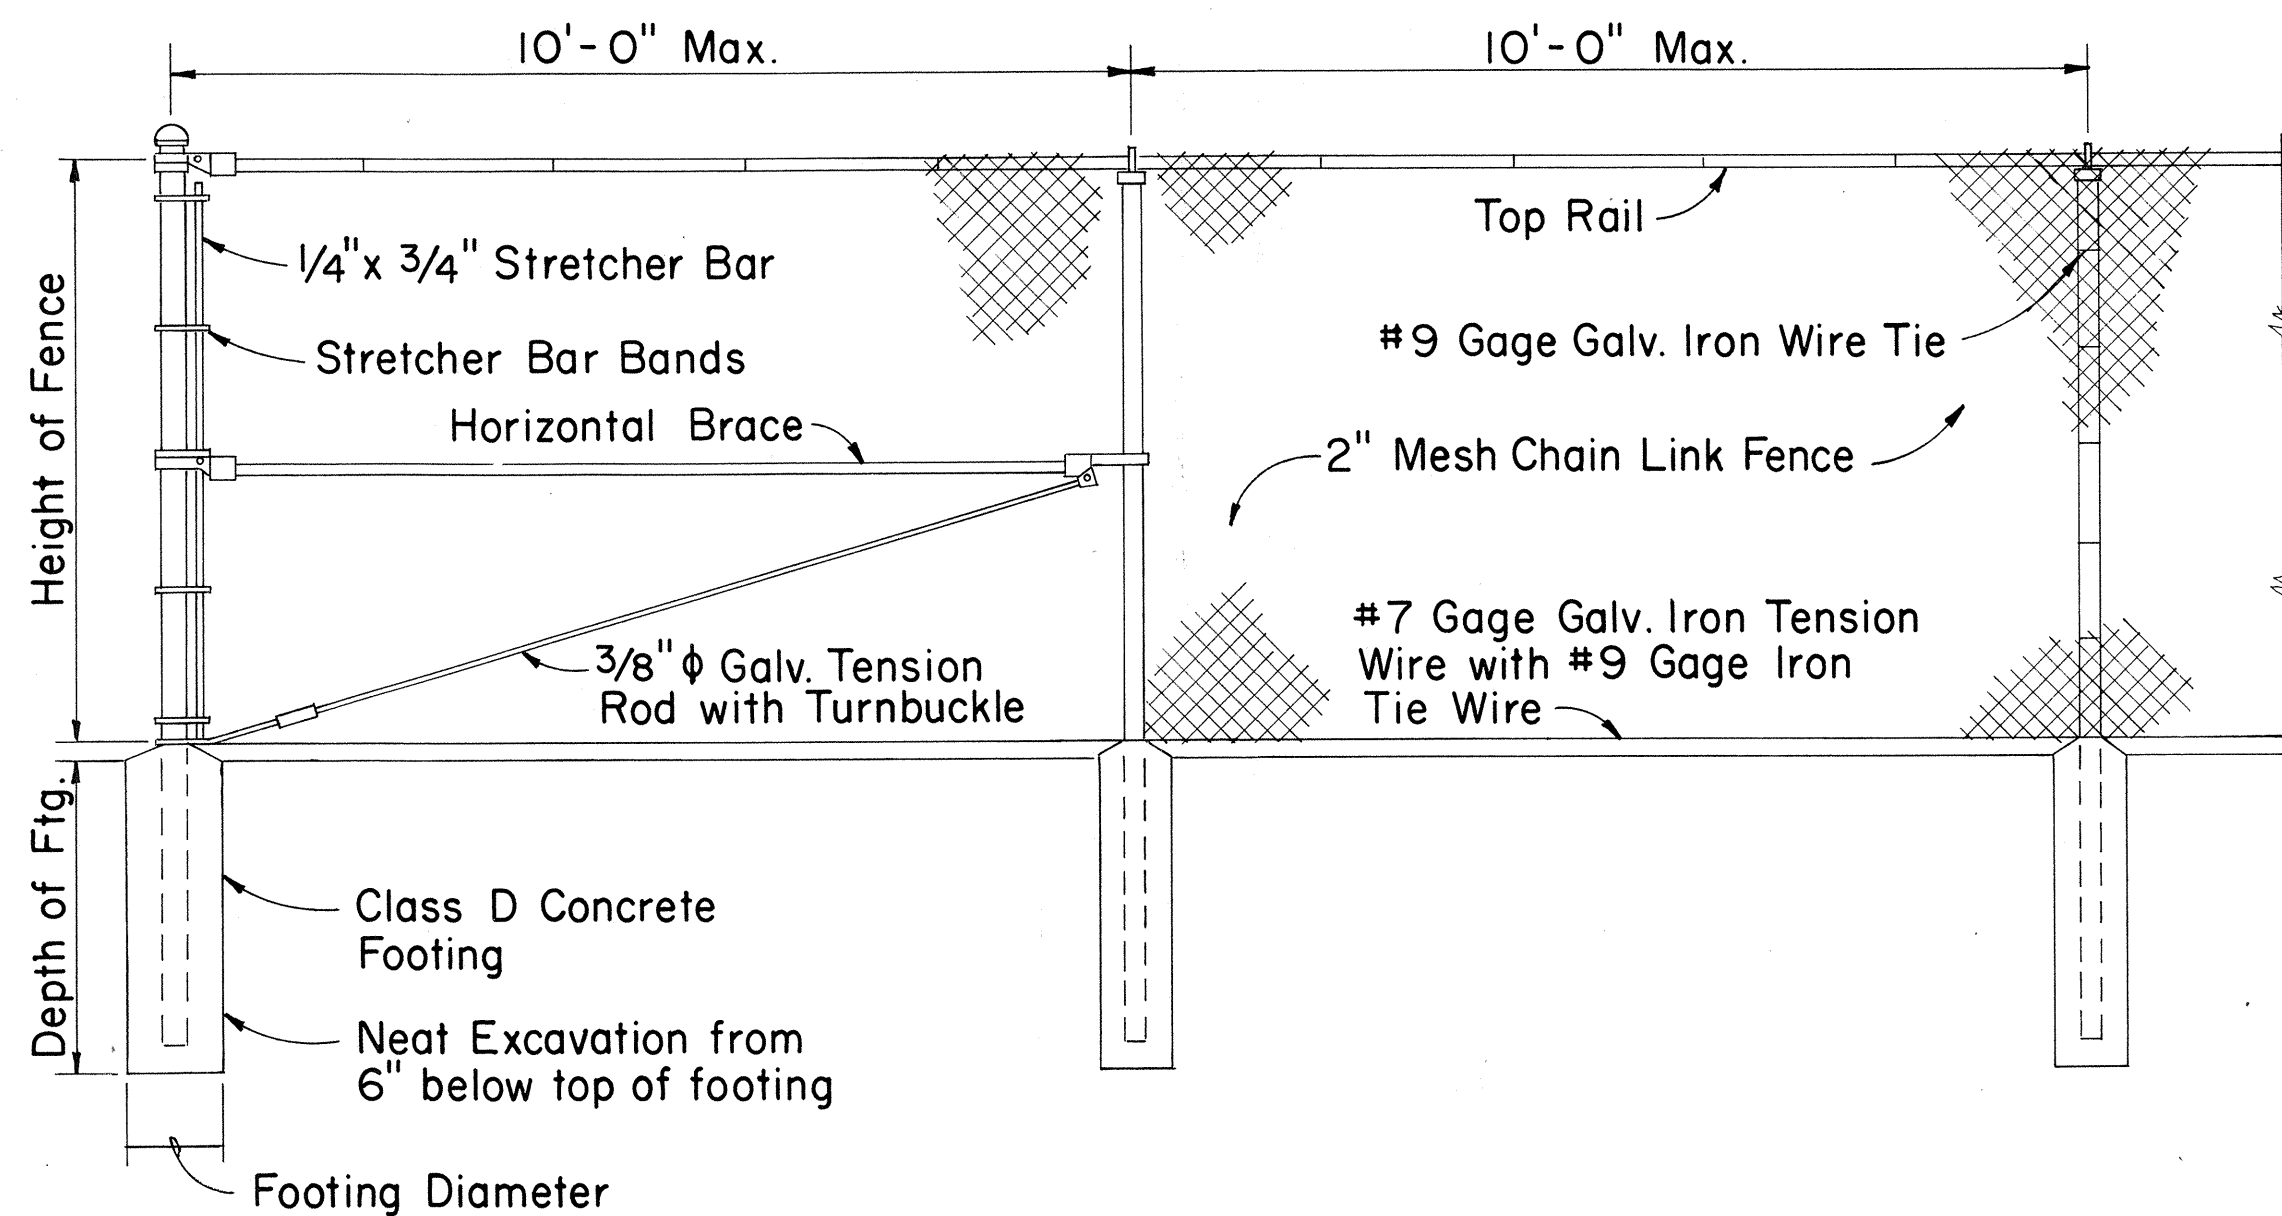

END POST LINE POST LINE POST

CHAIN LINK FENCE DETAILS

Height of Fence	Minimum Depth of Footing		Minimum Footing Diameter	
	Line Post	Corner, Pull, End and Gate Posts	Line Post	Corner, Pull and End Posts
3'	2'-0"	2'-6"	8"	8"
4'	2'-6"	2'-6"	8"	8"
5'	3'-0"	3'-0"	8"	8"
6'	3'-0"	3'-0"	8"	9"

APPROVAL, RECOMMENDED:
[Signature]
HIGHWAY DESIGN ENGINEER 12-4-69
DATE

APPROVED:
[Signature]
ASSISTANT CHIEF, ENGINEERING 12-10-69
DATE


NO.	REVISION	APPROVED BY	DATE

STATE OF HAWAII
DEPARTMENT OF TRANSPORTATION
LAND TRANSPORTATION FACILITIES DIVISION

STANDARD DETAILS
CHAIN LINK FENCE
(WITH TOPRAIL)


Scale: 1/2" = 1'-0"
Date:

FED. ROAD DIST. NO.	STATE	FED. AID PROJ. NO.	FISCAL YEAR	SHEET NO.	TOTAL SHEETS
HAWAII	HAW.	HI-1(13)17	1977	45	394

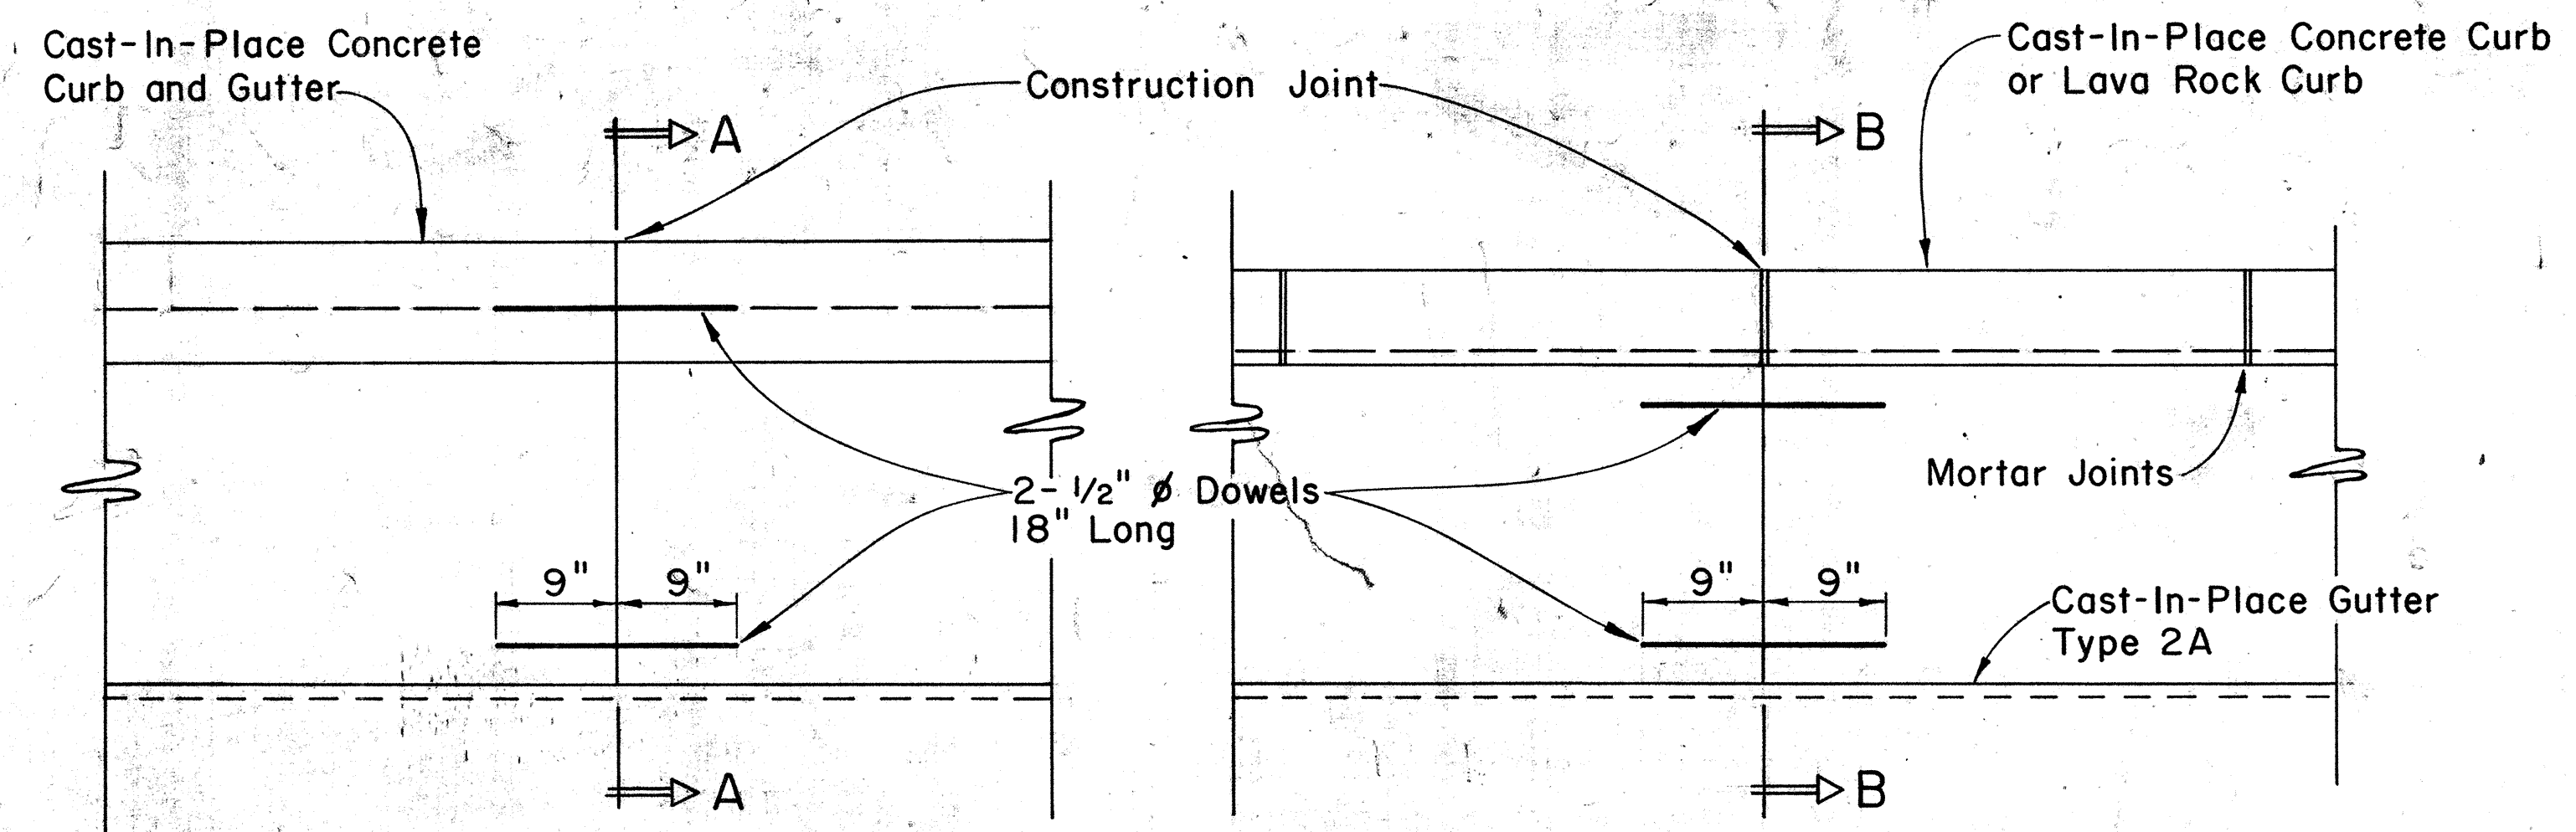


PLAN


PLAN

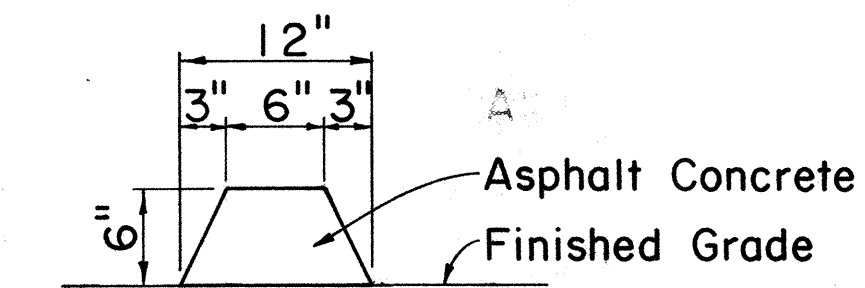


CURB, TYPE 6
BITUMINOUS CURB
Scale: 1 1/2" = 1'-0"

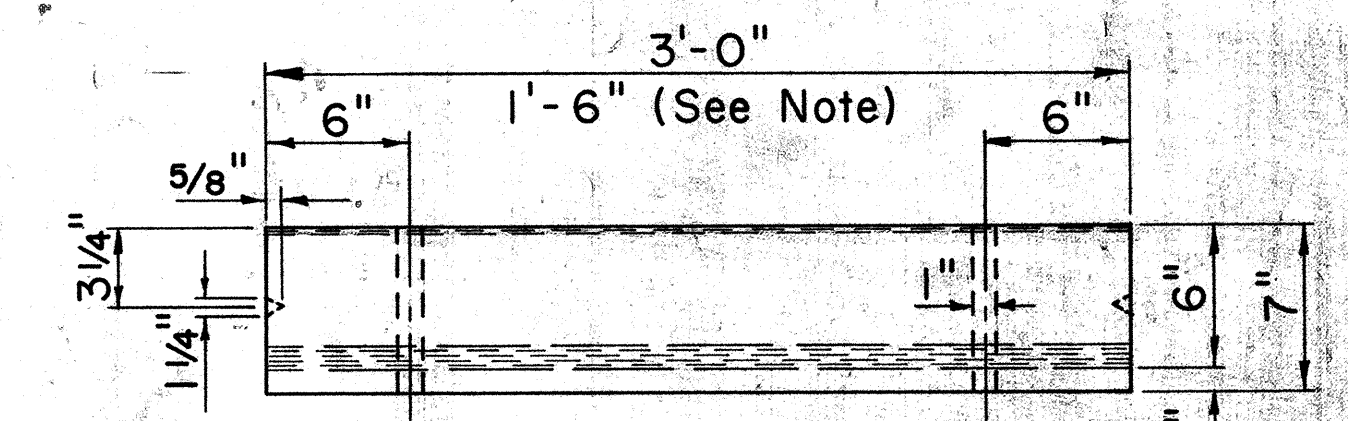

PLAN

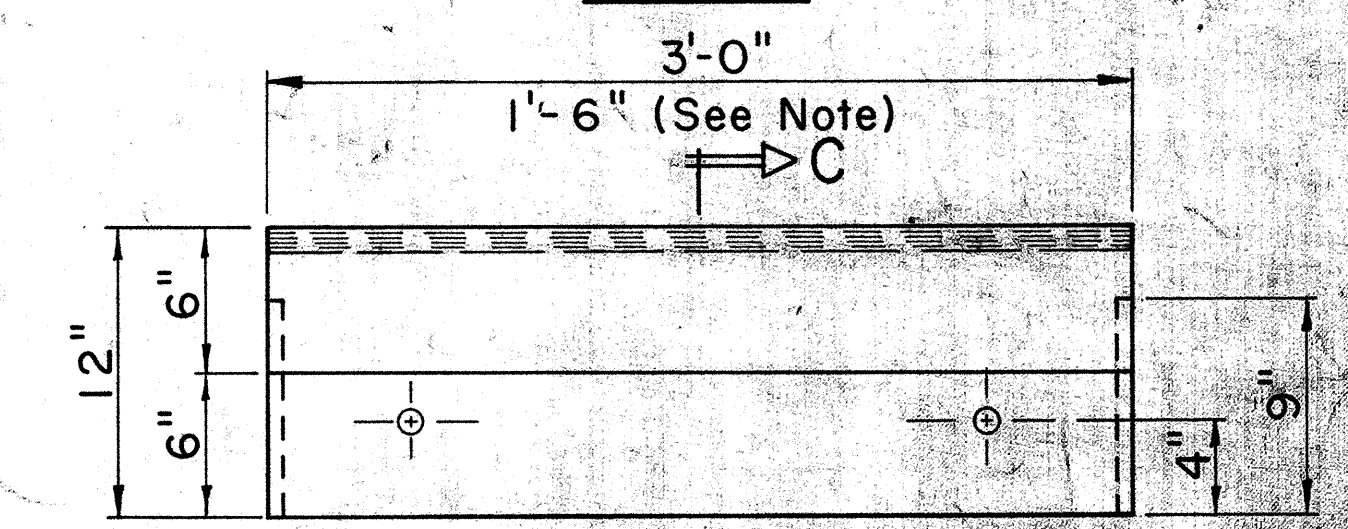


ELEVATION

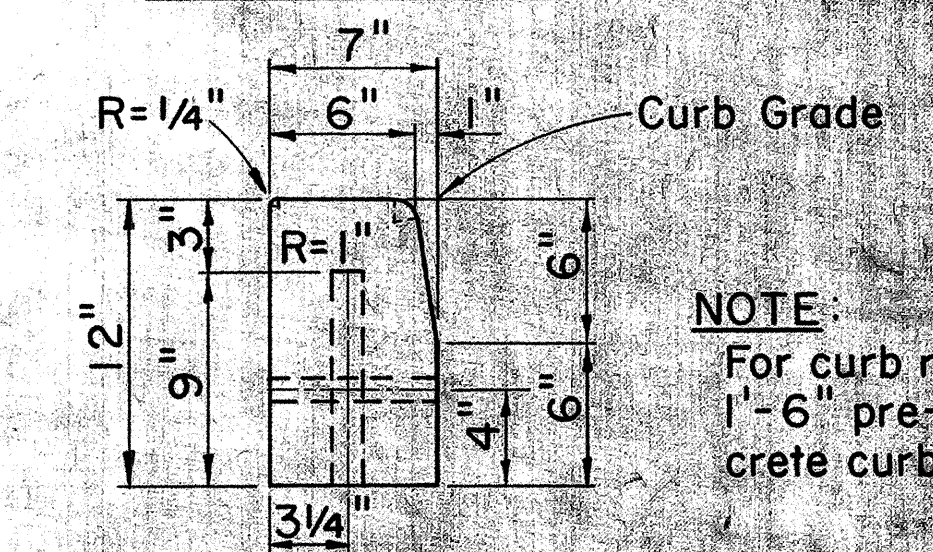

SECTION C-C

CURB, TYPE 3D
PRE-CAST CONC. CURB
Scale: 1 1/2" = 1'-0"

NOTE:
For curb returns use
1'-6" pre-cast con-
crete curbs.

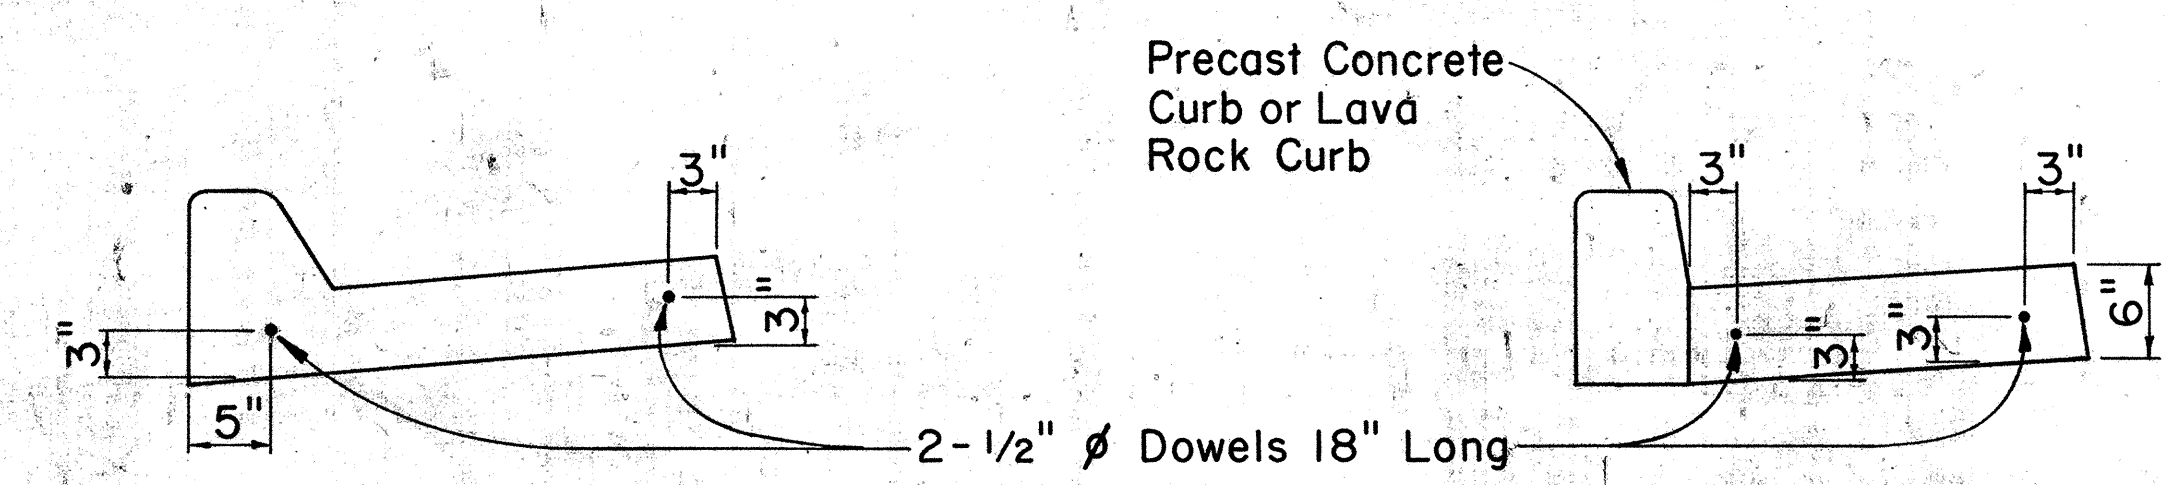

SECTION A-A


SECTION B-B

CAST-IN-PLACE CURB & GUTTER


CAST-IN-PLACE GUTTER

CONSTRUCTION JOINT DETAIL


Scale: 1" = 1'-0"

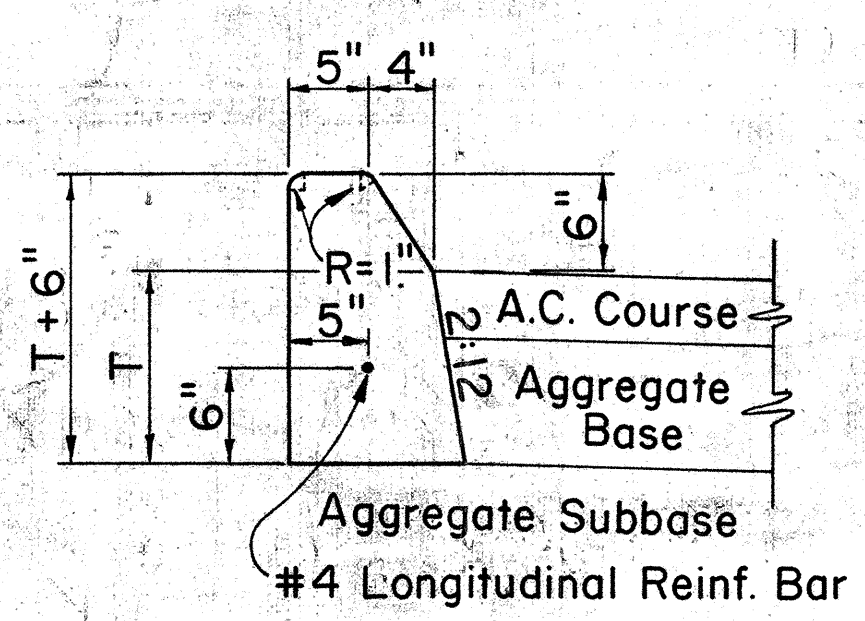


CURB, TYPE 2A

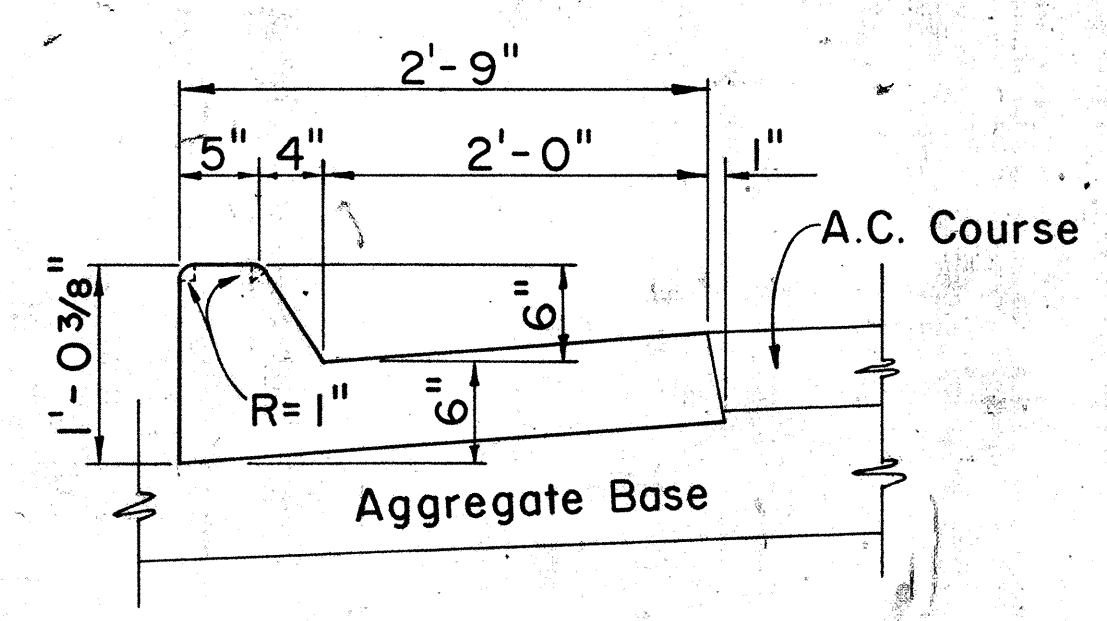


CURB & GUTTER, TYPE 2AG

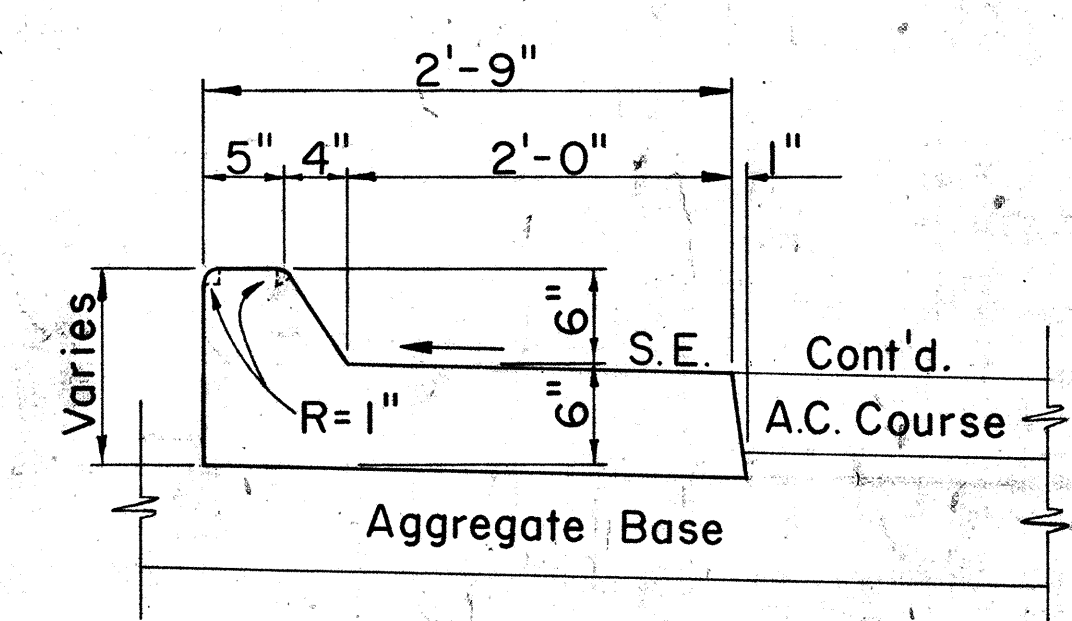


CURB & GUTTER, TYPE 2AGM

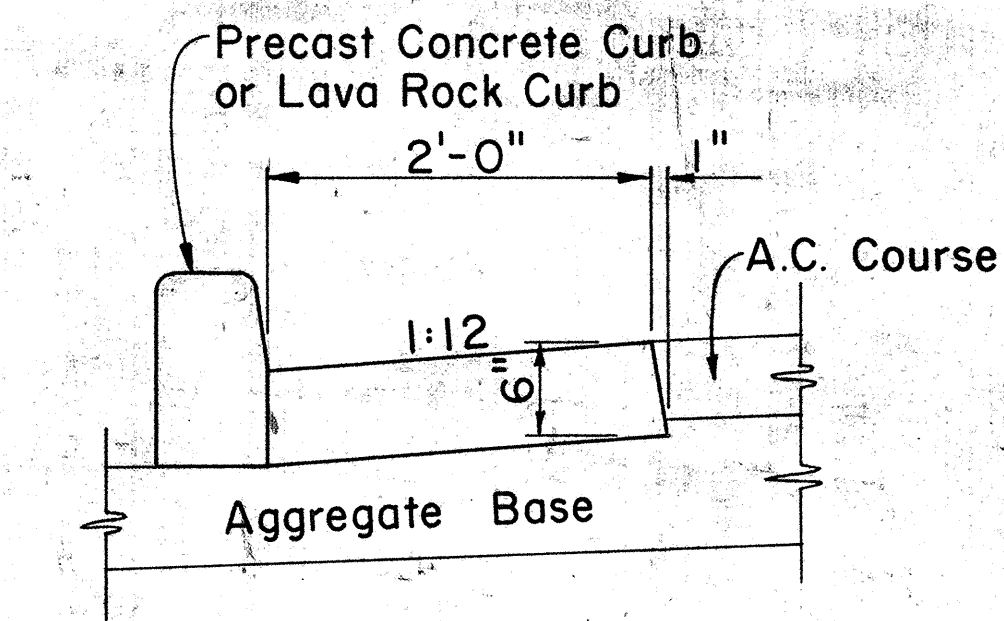


GUTTER, TYPE 2A

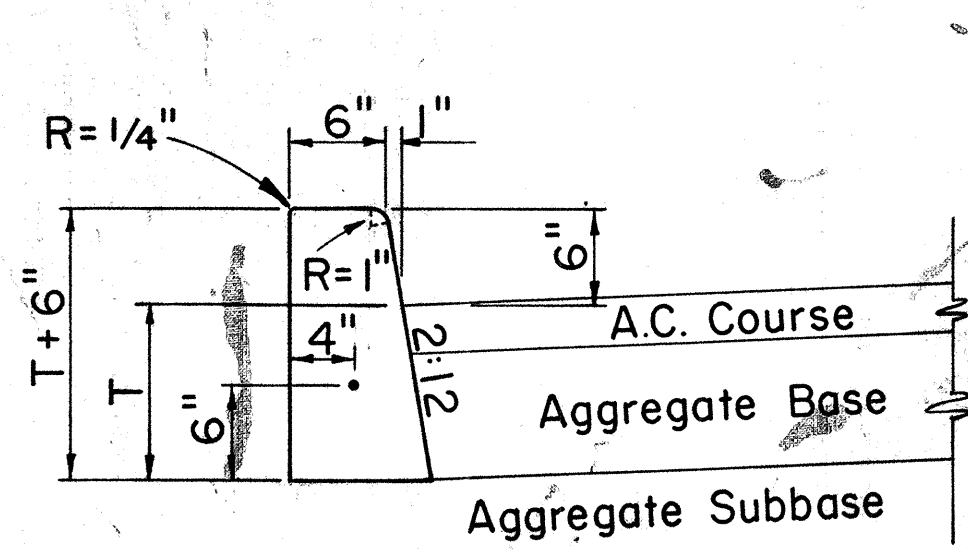

CURB, TYPE 2D

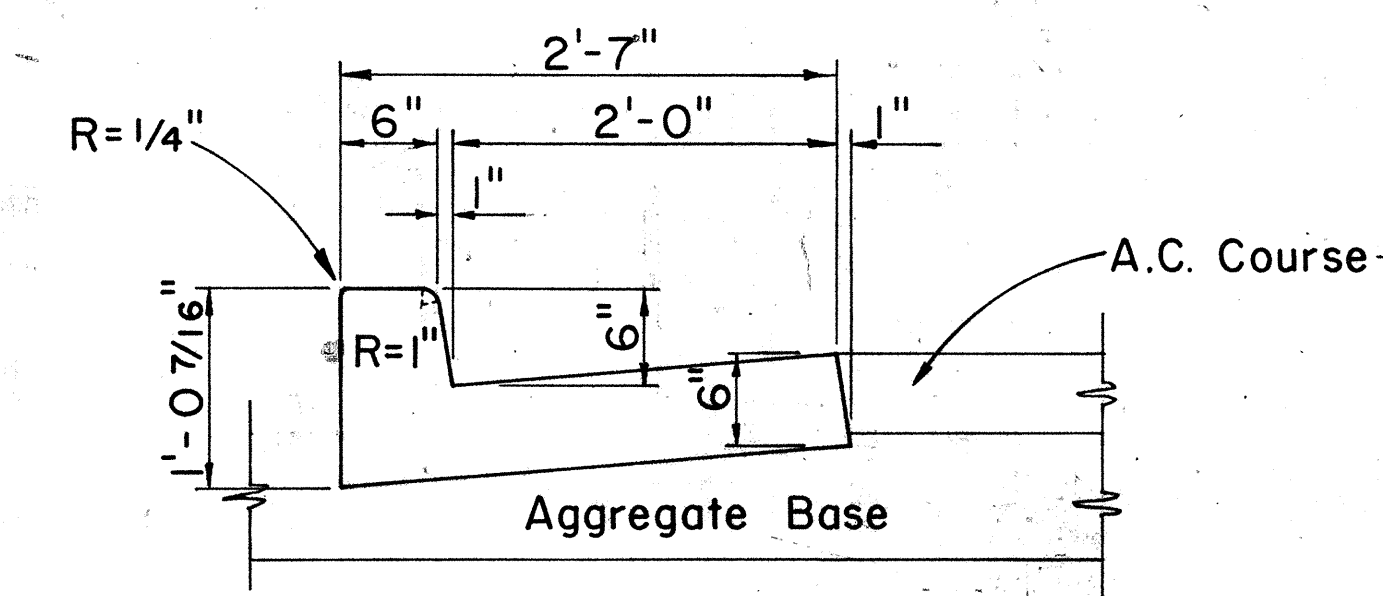

CURB & GUTTER, TYPE 2DG

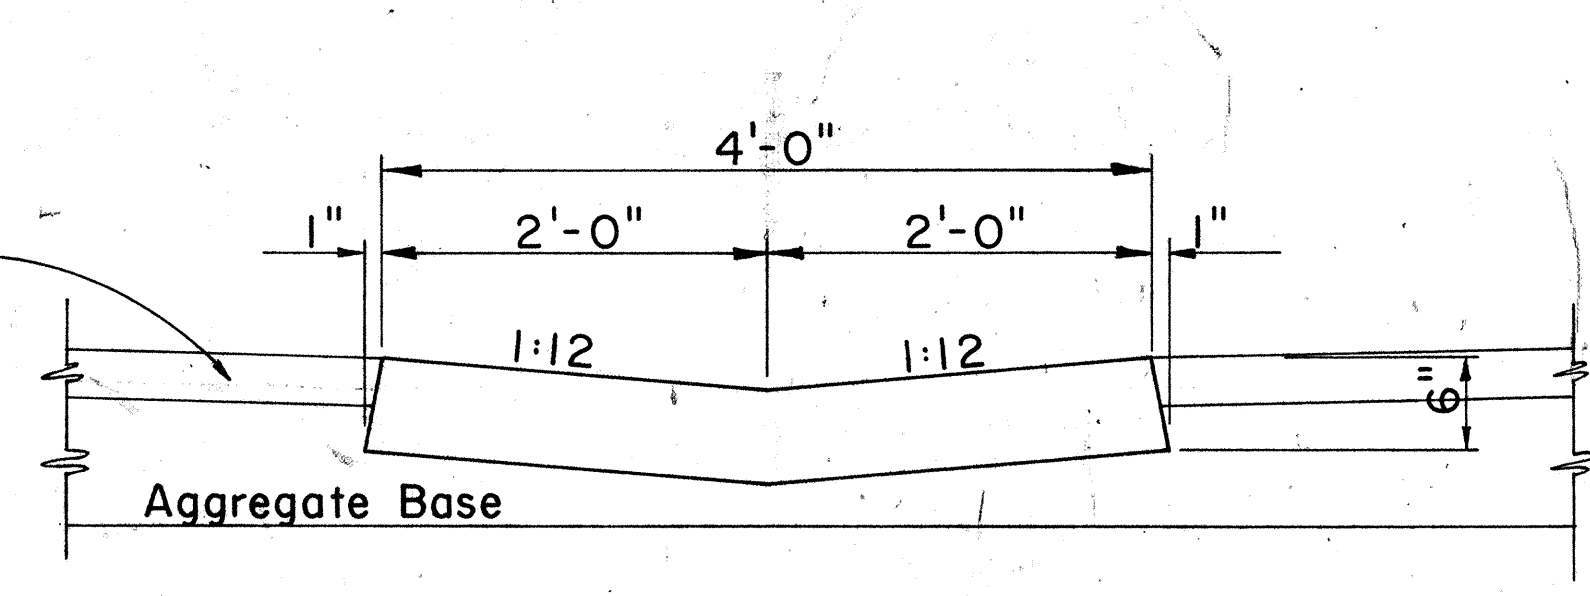

GUTTER, TYPE 2G

CAST-IN-PLACE CONCRETE CURBS AND/OR GUTTERS

Scale: 1" = 1'-0"



APPROVAL RECOMMENDED:
M. J. Jones
HIGHWAY DESIGN ENGINEER
12-1-69
DATE

APPROVED:
John P. Smith
ASSISTANT CHIEF, ENGINEERING
12-10-69
DATE



NO.	REVISION	APPROVED BY	DATE

STATE OF HAWAII
DEPARTMENT OF TRANSPORTATION
LAND TRANSPORTATION FACILITIES DIVISION
STANDARD DETAILS
TYPICAL DETAILS OF CURB
AND/OR GUTTERS
Scale: As Shown
SHEET No. 3 OF 26 SHEETS DD 6091



FED. ROAD DIST. NO.	STATE	FED. AID PROJ. NO.	FISCAL YEAR	SHEET NO.	TOTAL SHEETS
HAWAII	HAW.	1-H-1(13)-17	1977	46	394

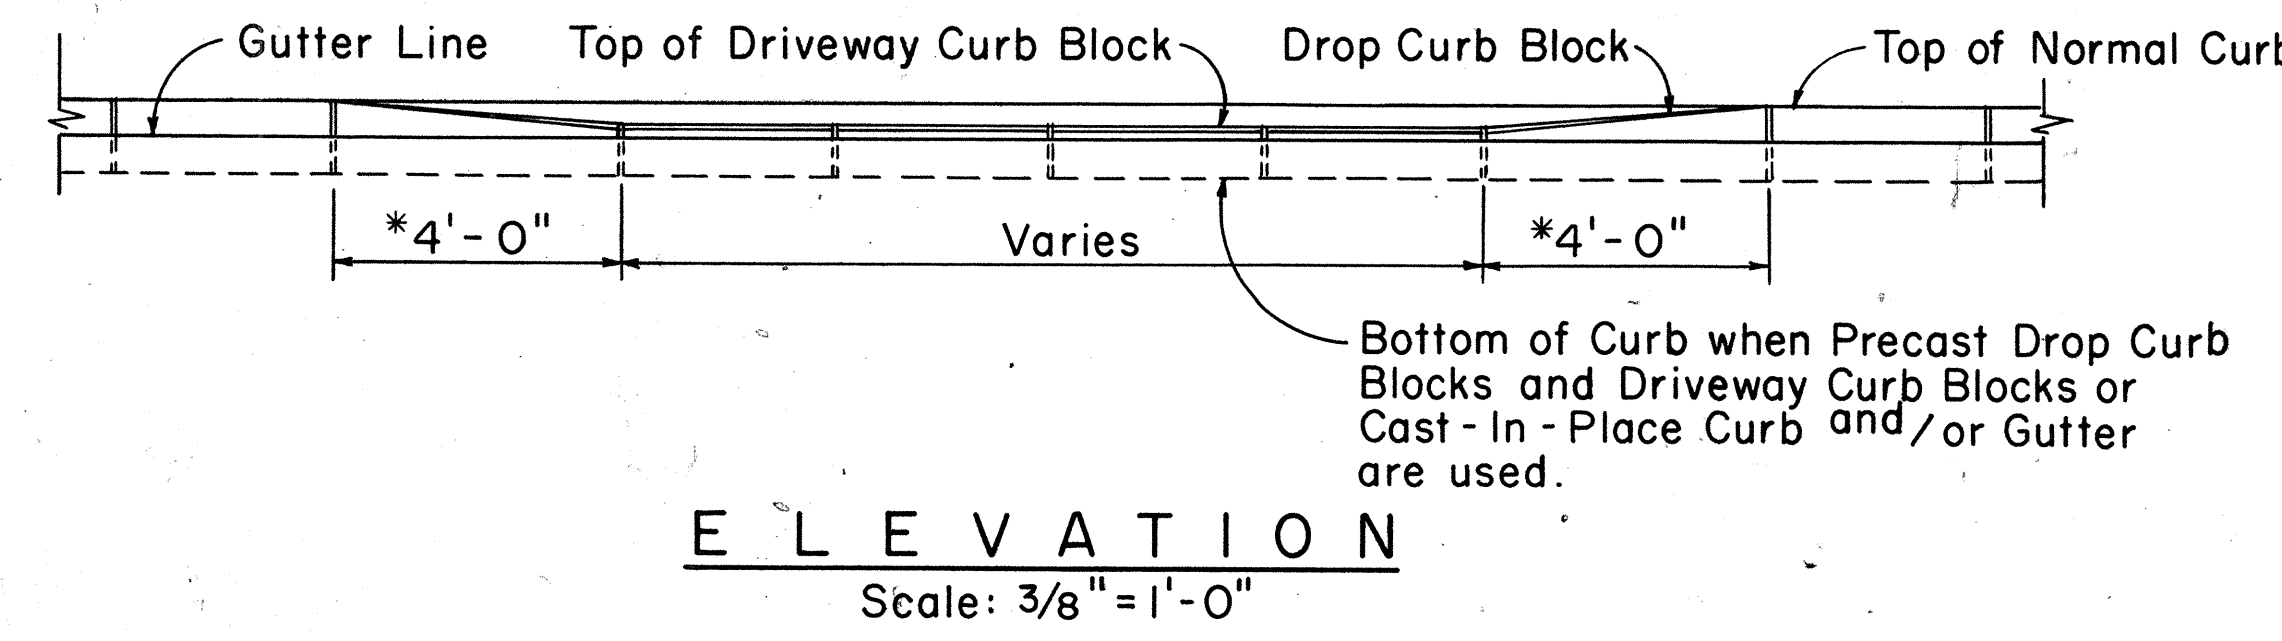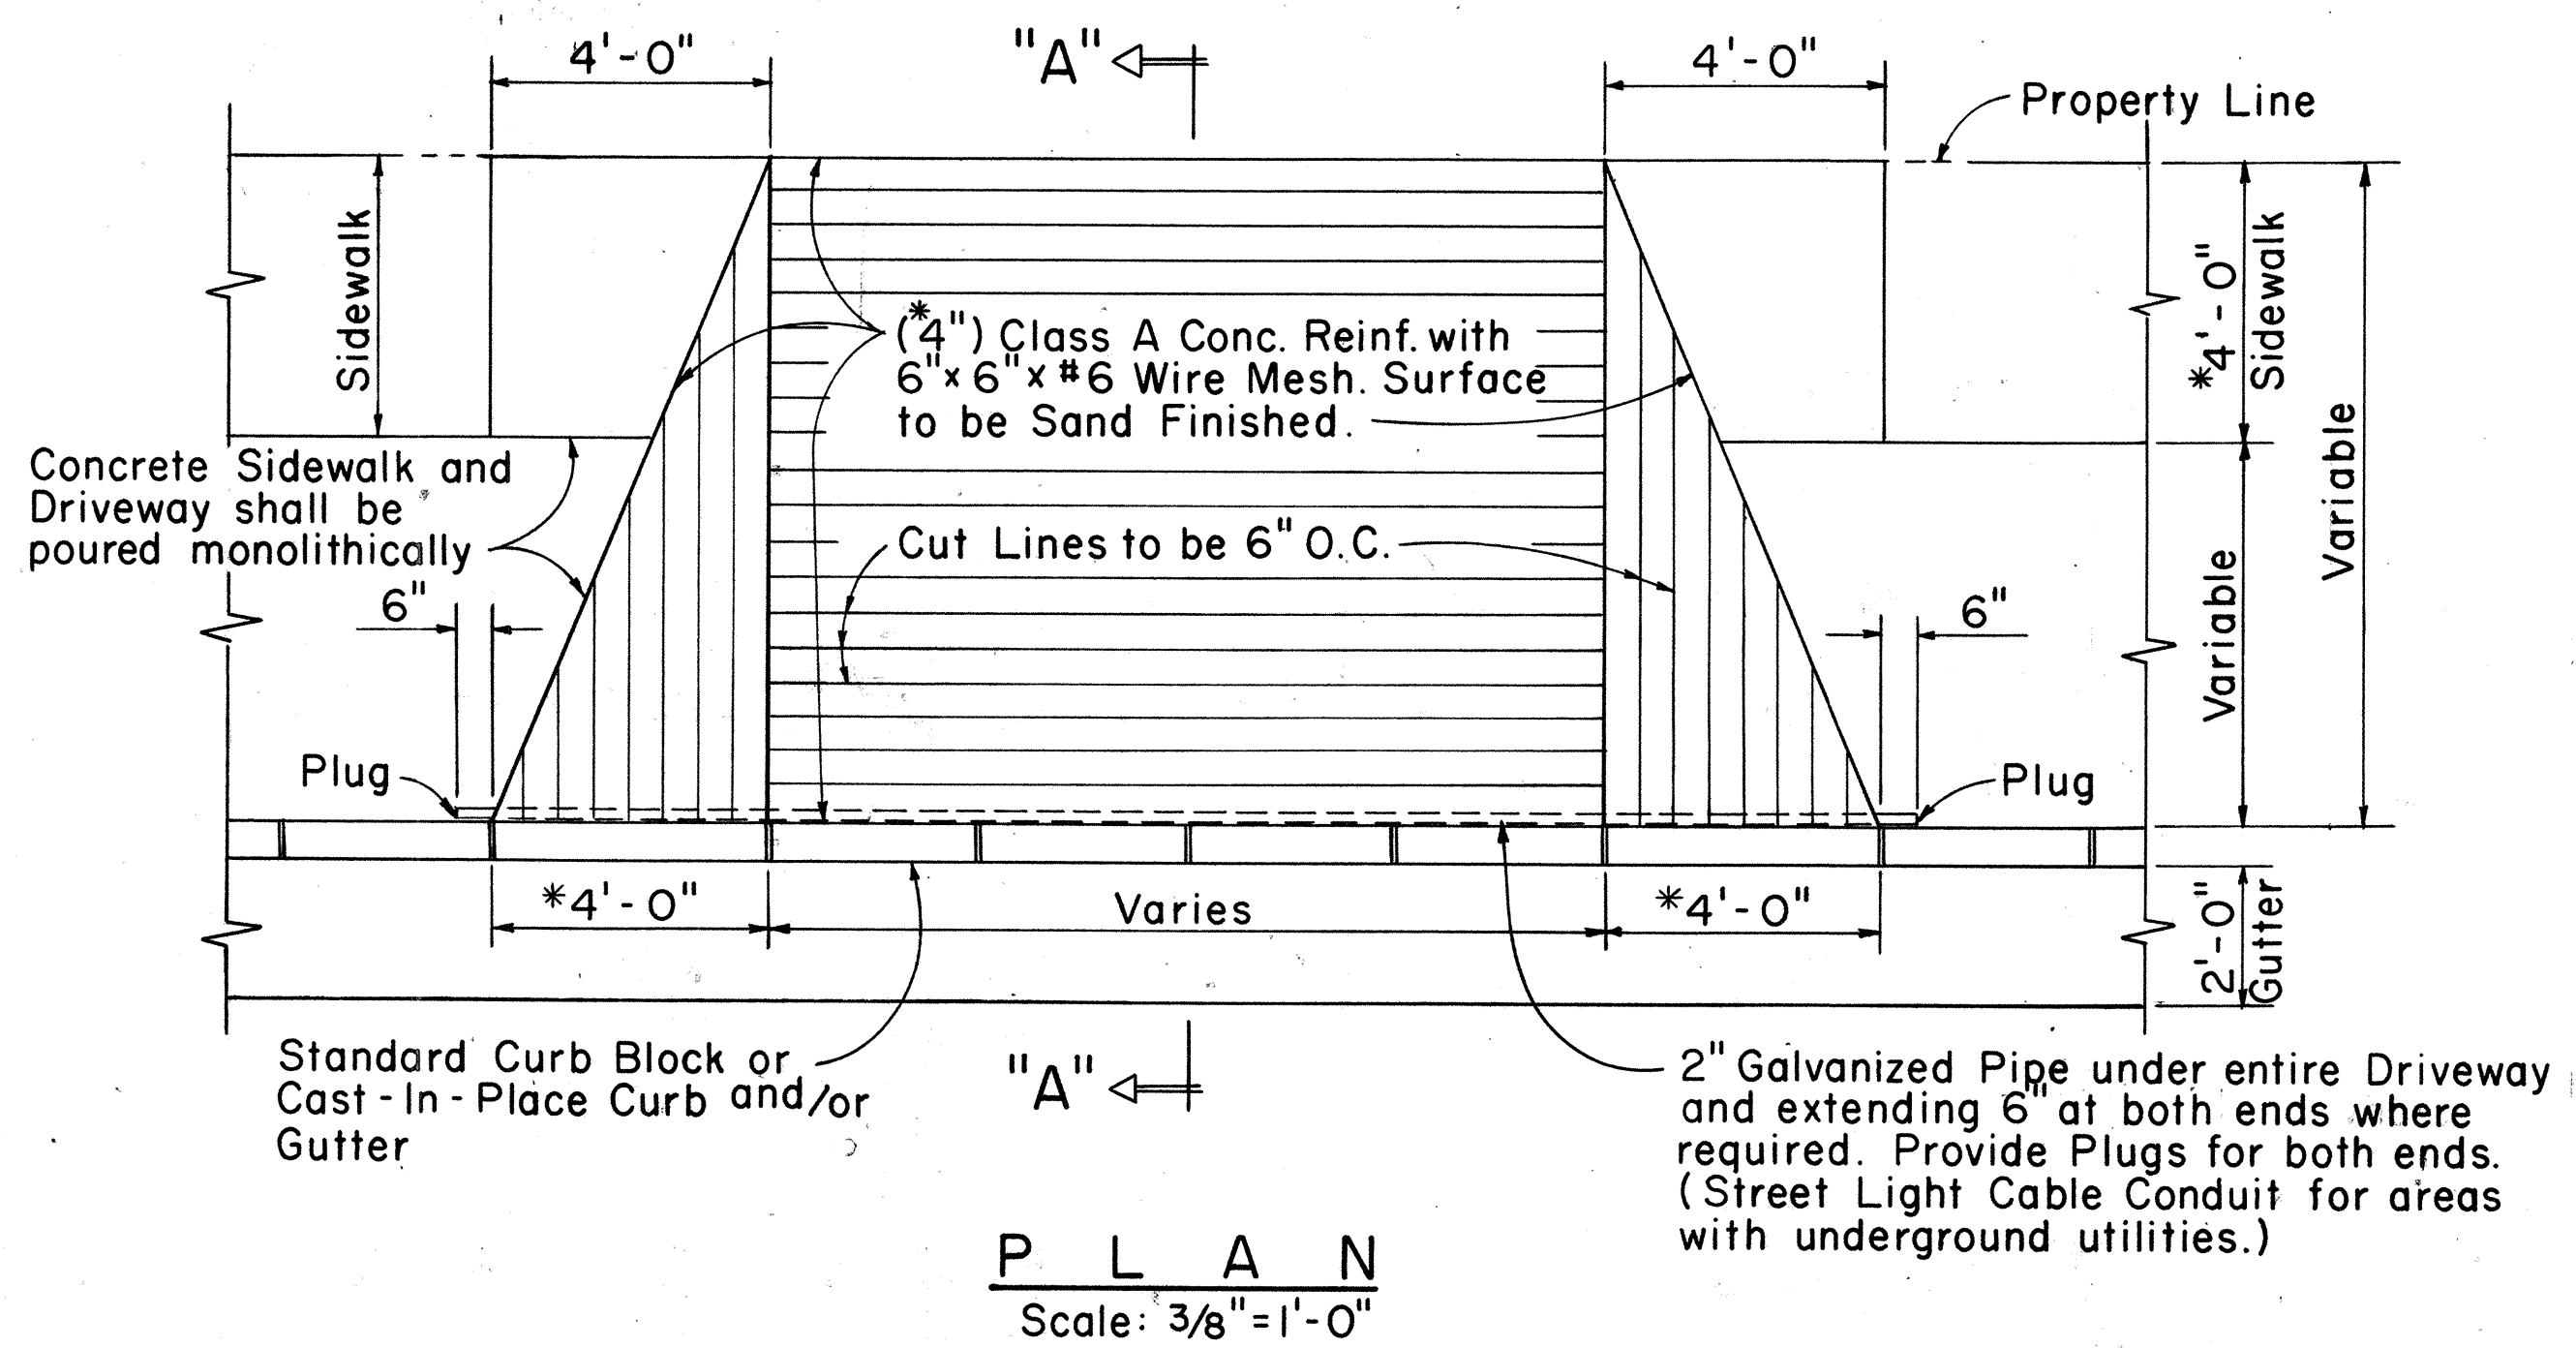


Dist. Curb Line to ℓ	Slope
12'	5/8" to 12"
10'	3/4" to 12"
8'	1" to 12"
7'	7/8" to 12"
6'	1" to 12"
3'	1 3/4" to 12"

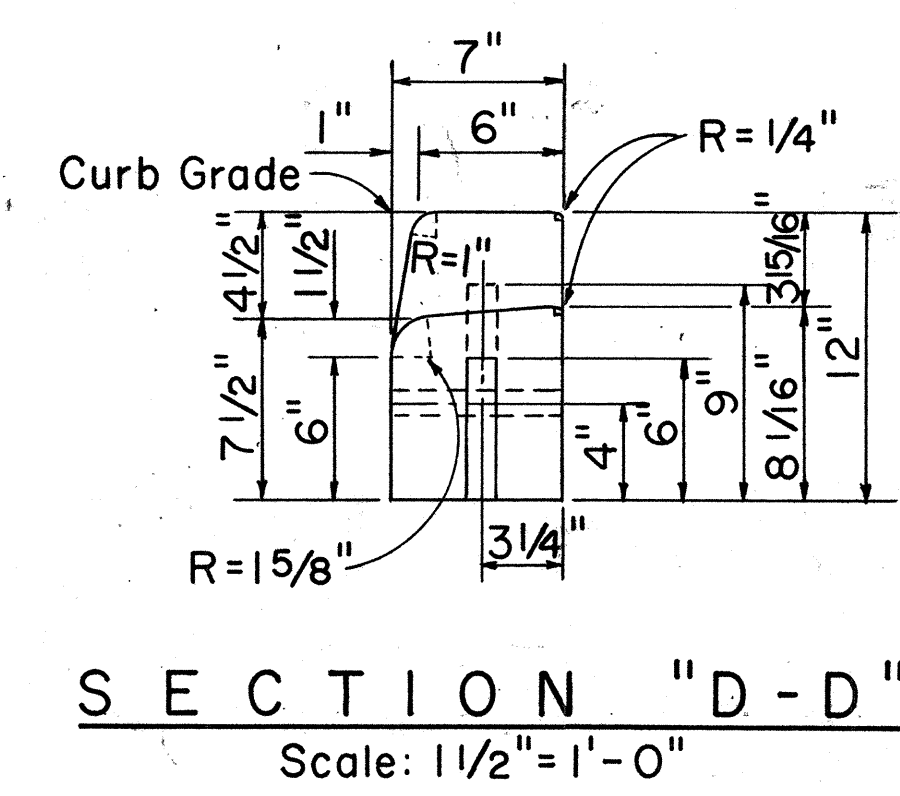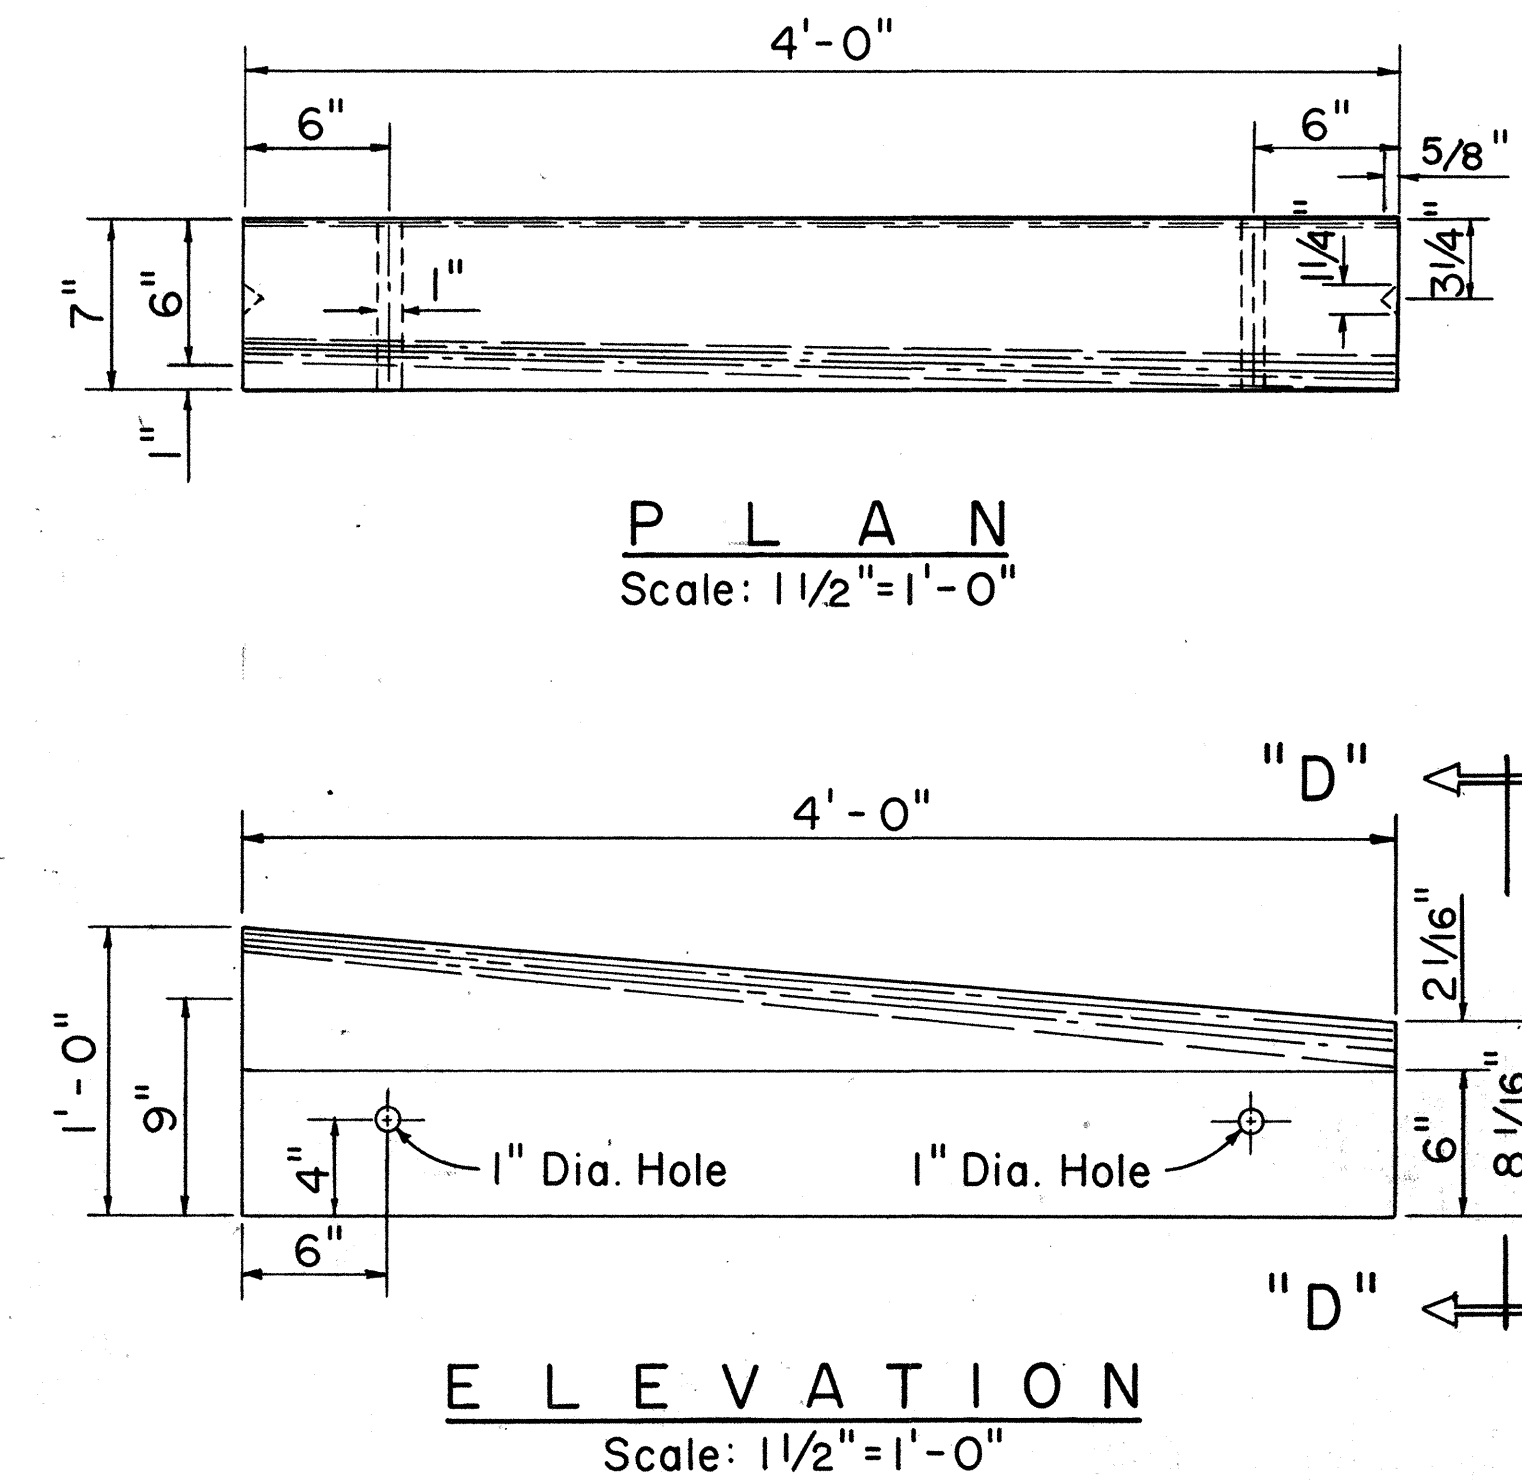


PRE-CAST CONC. DROP CURB BLOCK

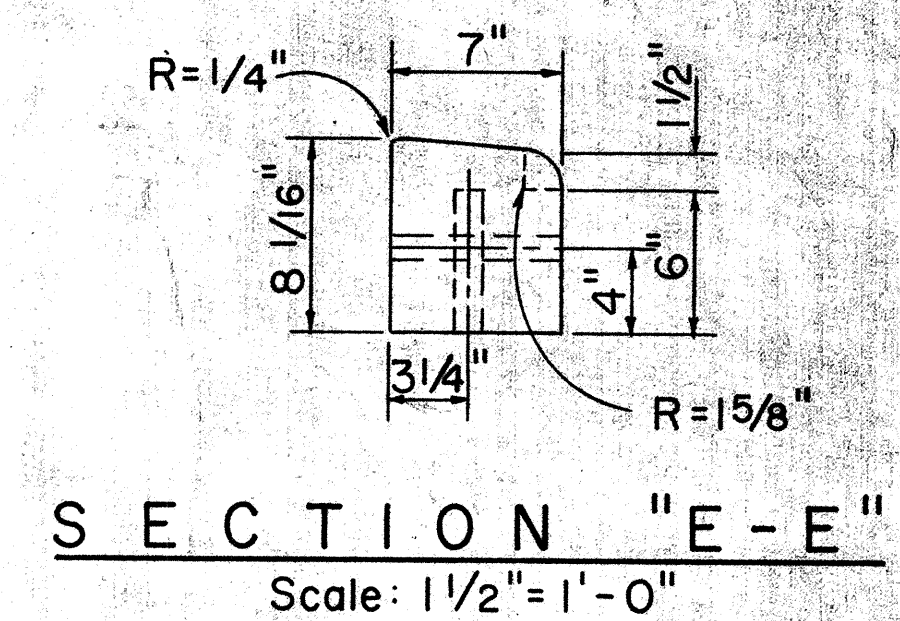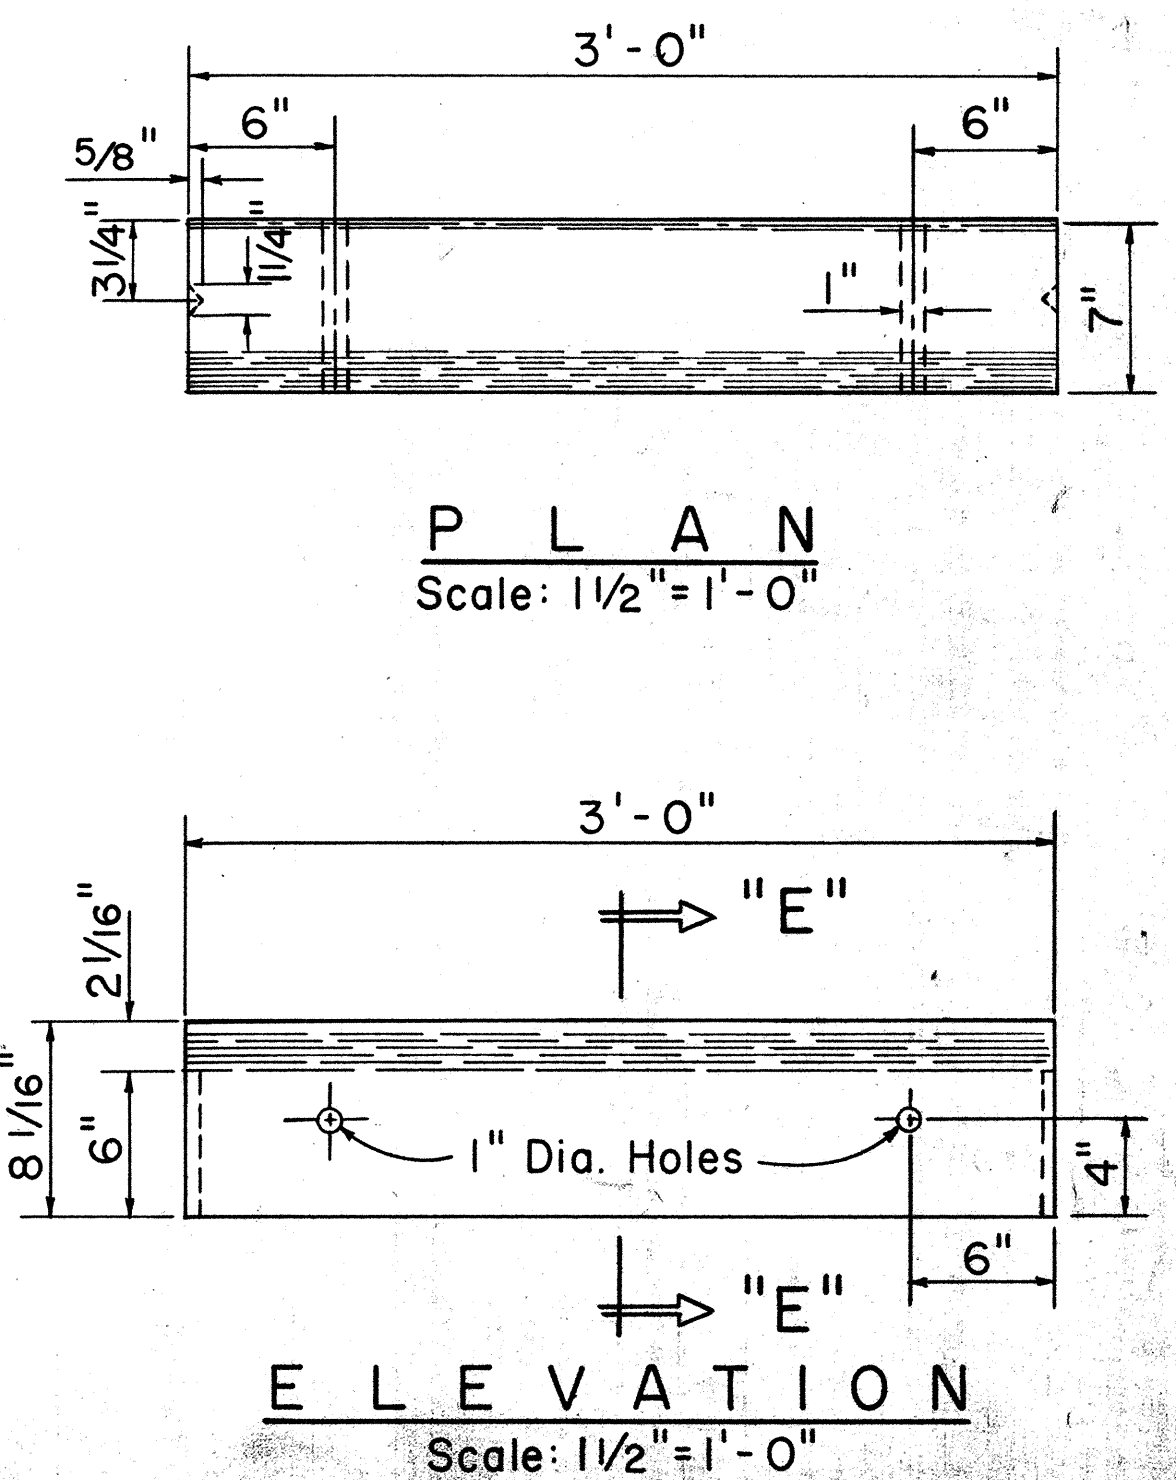


PRE-CAST CONC. DRIVEWAY CURB

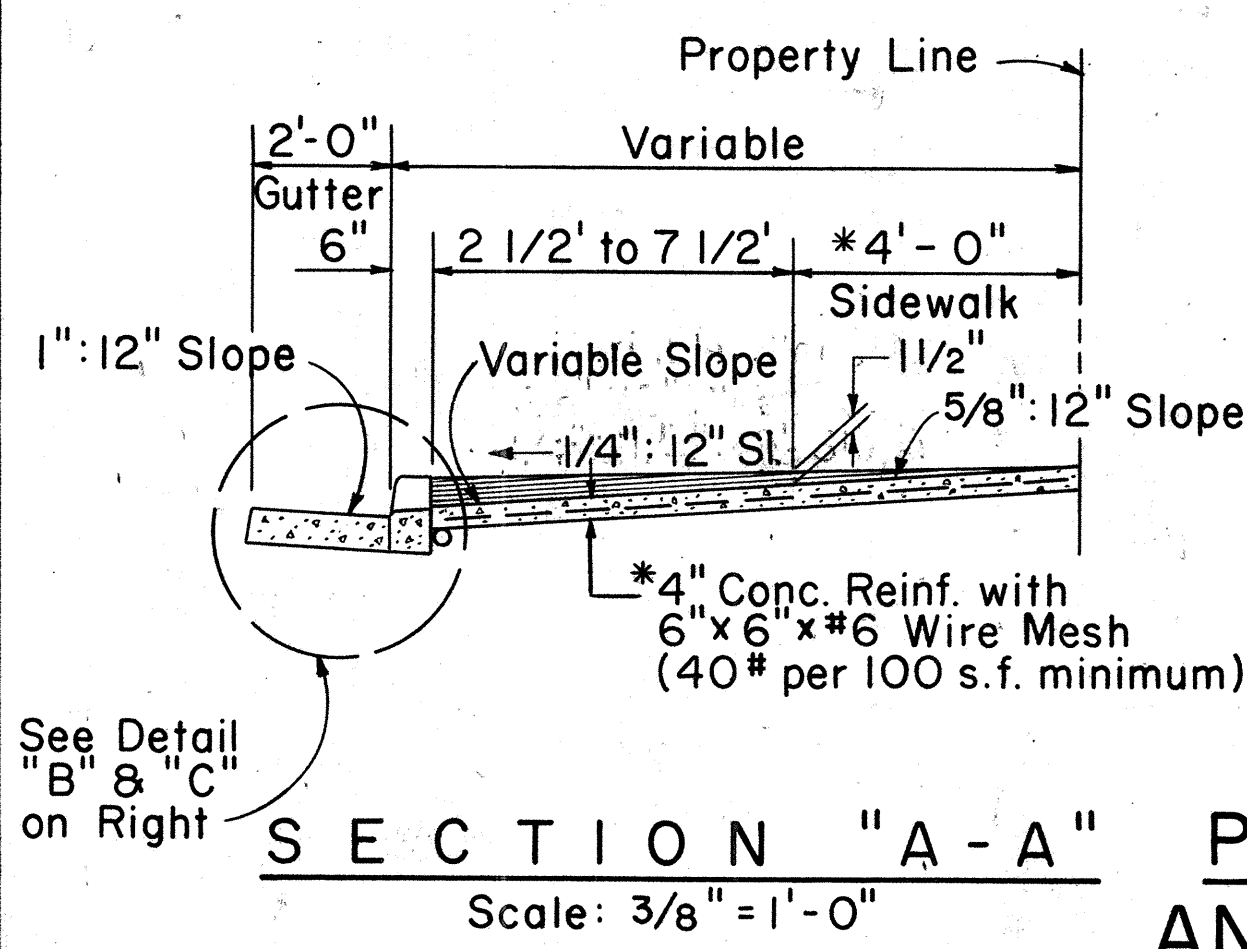

PRE-CAST DRIVEWAY CURB AND CAST-IN-PLACE GUTTER

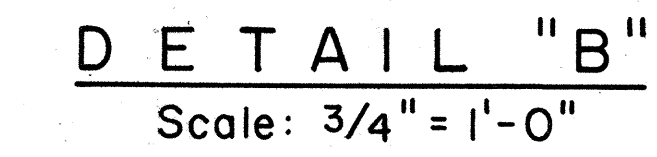

CAST-IN-PLACE INTEGRAL DRIVEWAY CURB AND GUTTER

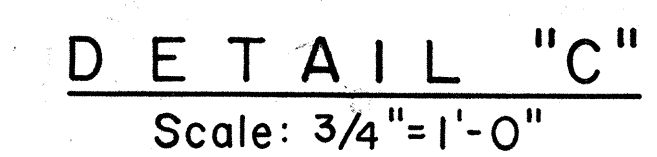

TYPICAL DETAILS OF REINF. CONC. DROP DRIVEWAY

NO.	REVISION	APPROVED BY	DATE

APPROVAL RECOMMENDED:

M. H. H. H. 12-4-69
HIGHWAY DESIGN ENGINEER DATE

APPROVED:


R. D. D. 12-10-69
ASSISTANT CHIEF, ENGINEERING DATE

STATE OF HAWAII
DEPARTMENT OF TRANSPORTATION
LAND TRANSPORTATION FACILITIES DIVISION
STANDARD DETAILS
TYPICAL DETAILS OF
REINF. CONC. DROP DRIVEWAY


Scale: As Shown

SHEET No. 9 OF 26 SHEETS DD 610/1


FED. ROAD DIST. NO.	STATE	FED. AID PROJ. NO.	FISCAL YEAR	SHEET NO.	TOTAL SHEETS
HAWAII	HAWAII	1-HI-1(13)	1977	47	394

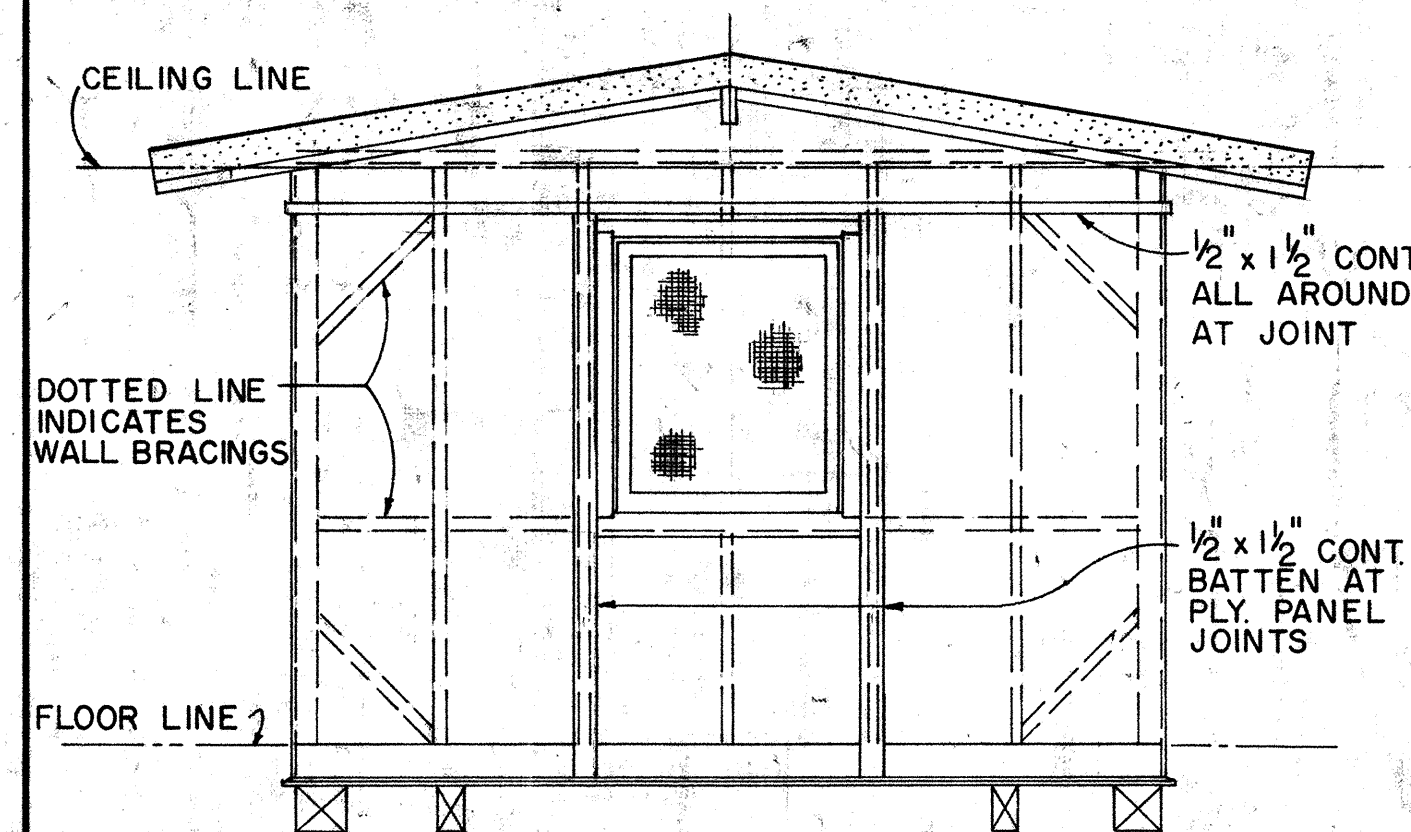


ELEVATION B
ELEVATION D SIMILAR
SCALE: 3/8" = 1'-0"

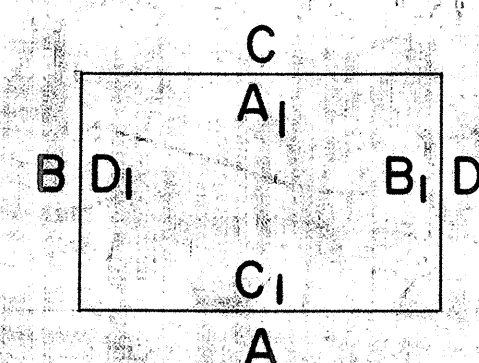


EXTERIOR & INTERIOR KEY

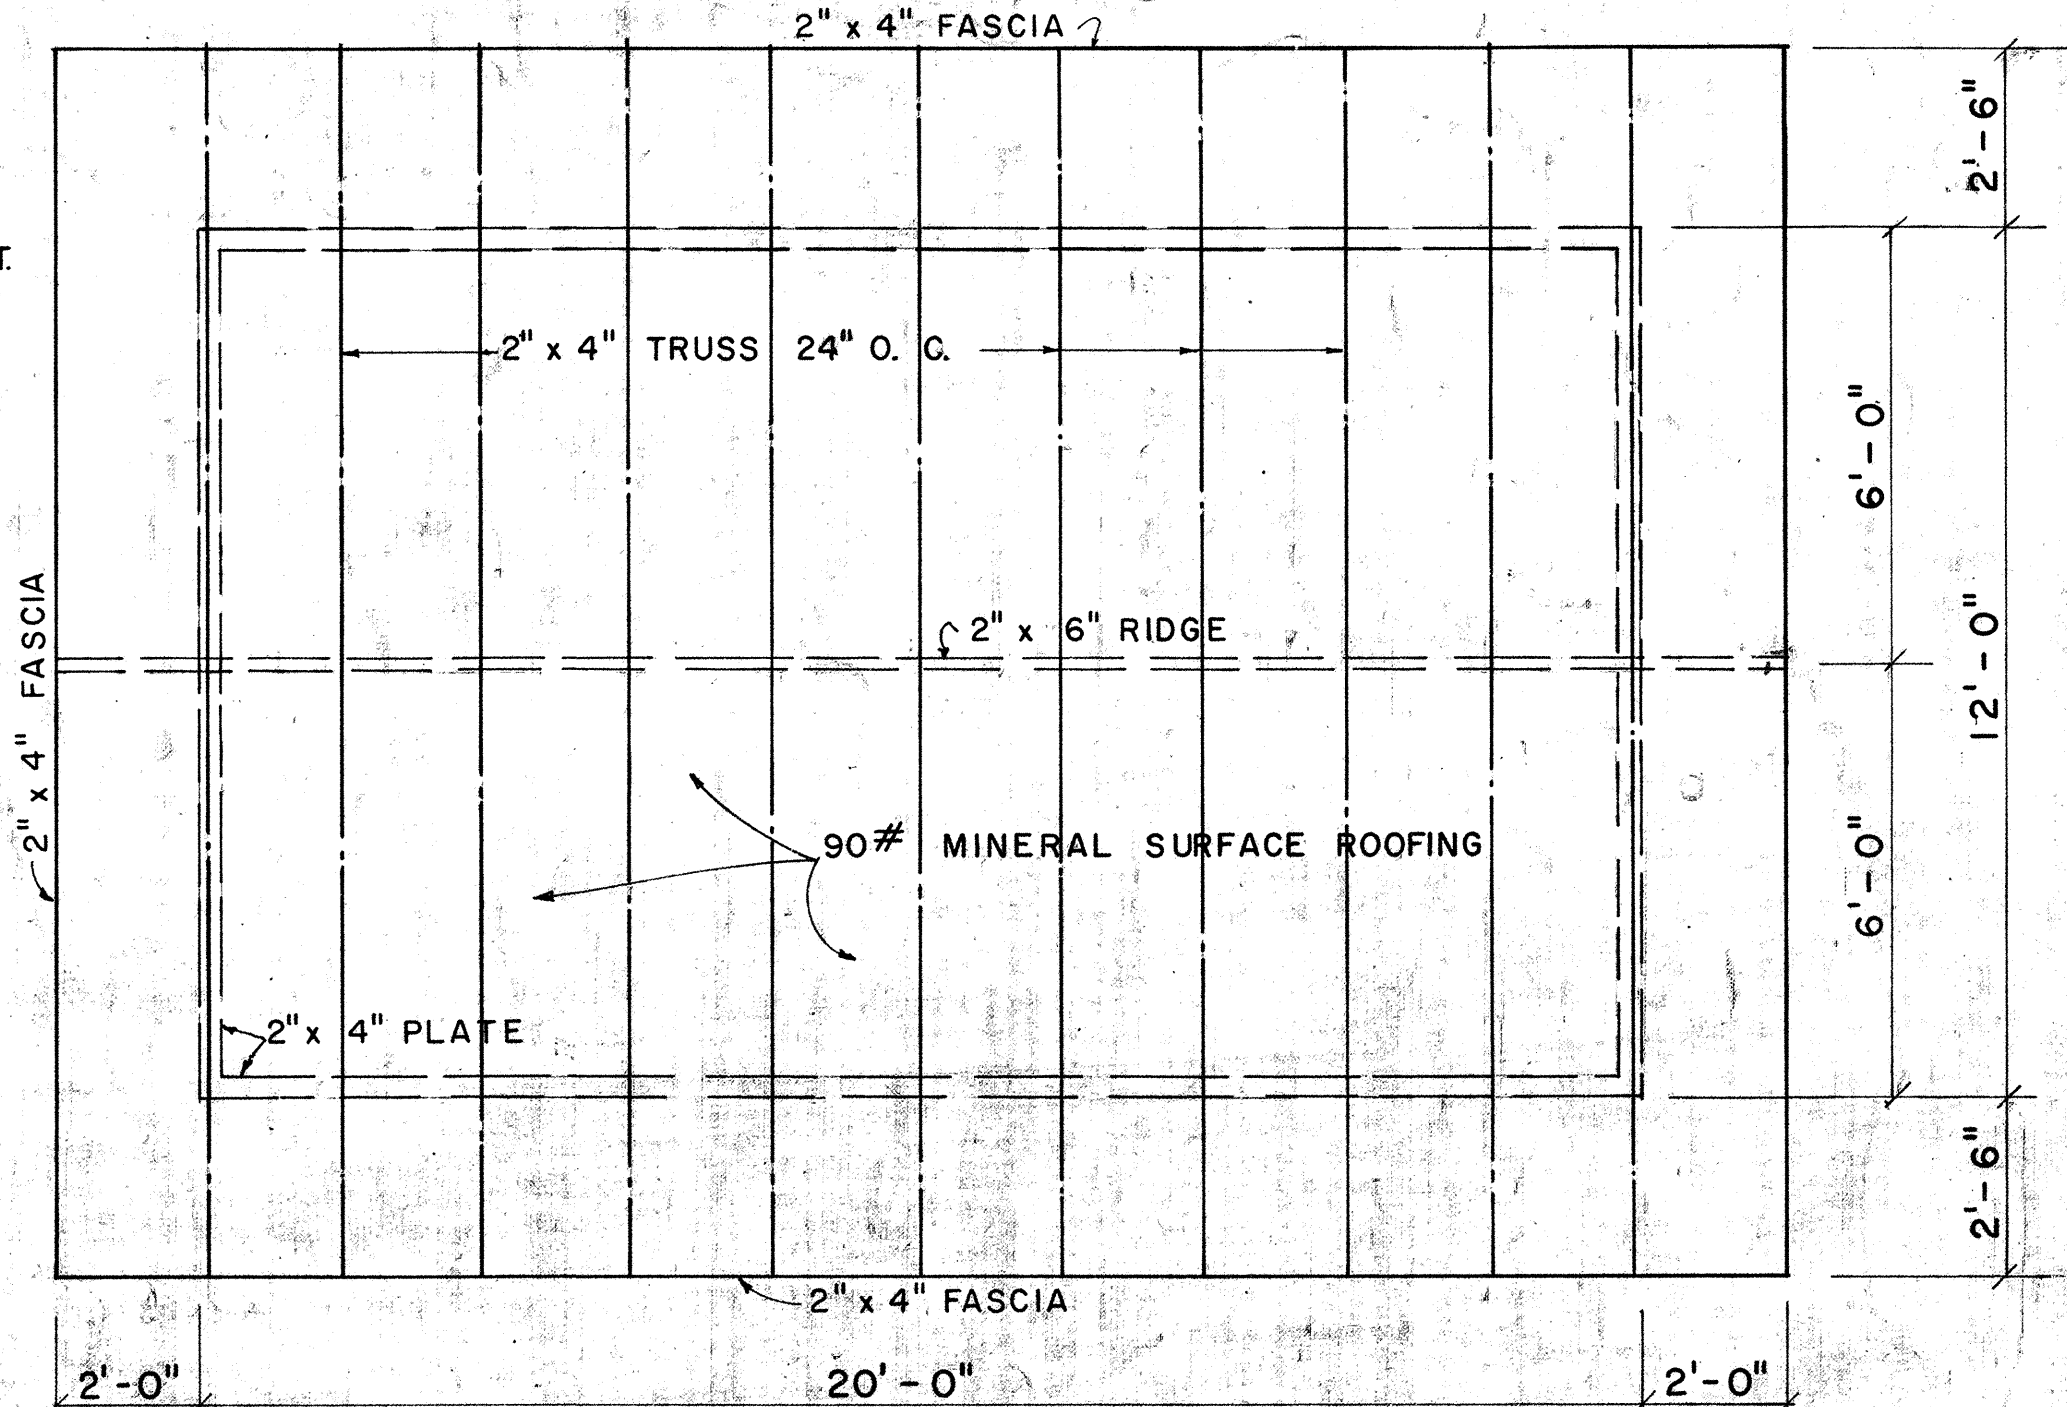


ROOF FRAMING PLAN
SCALE: 3/8" = 1'-0"

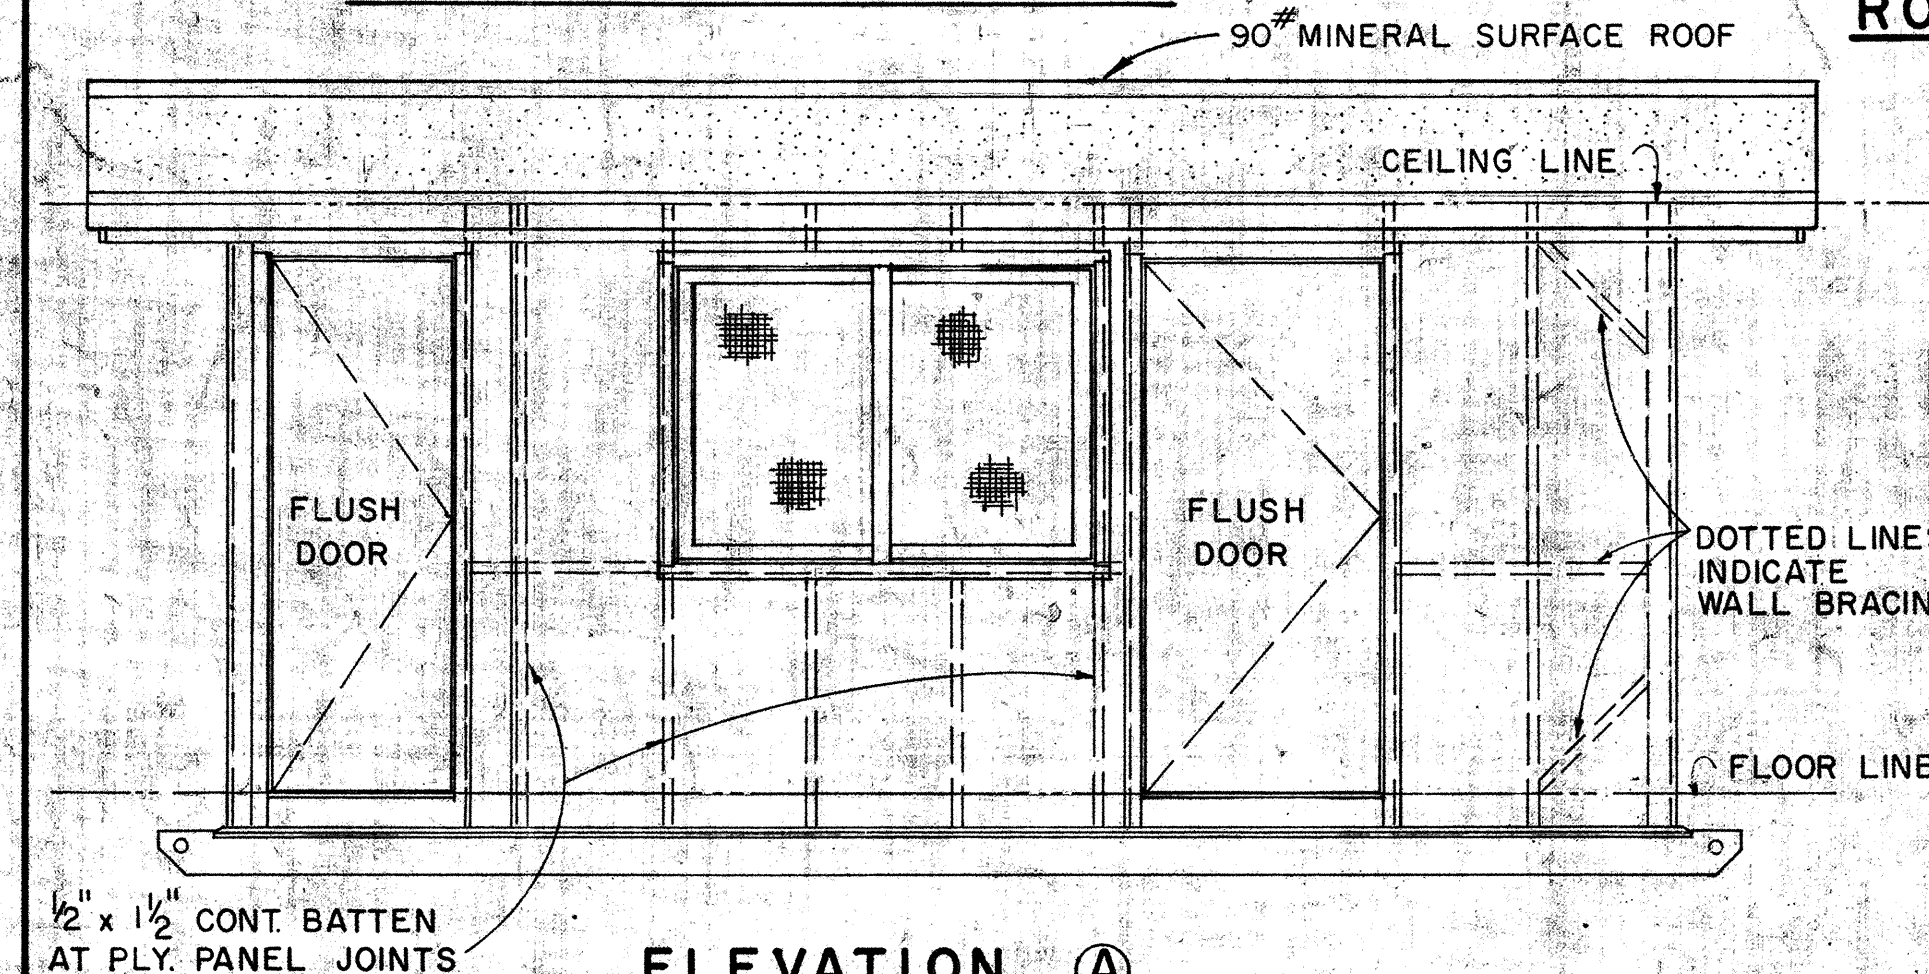


ELEVATION A
SCALE: 3/8" = 1'-0"

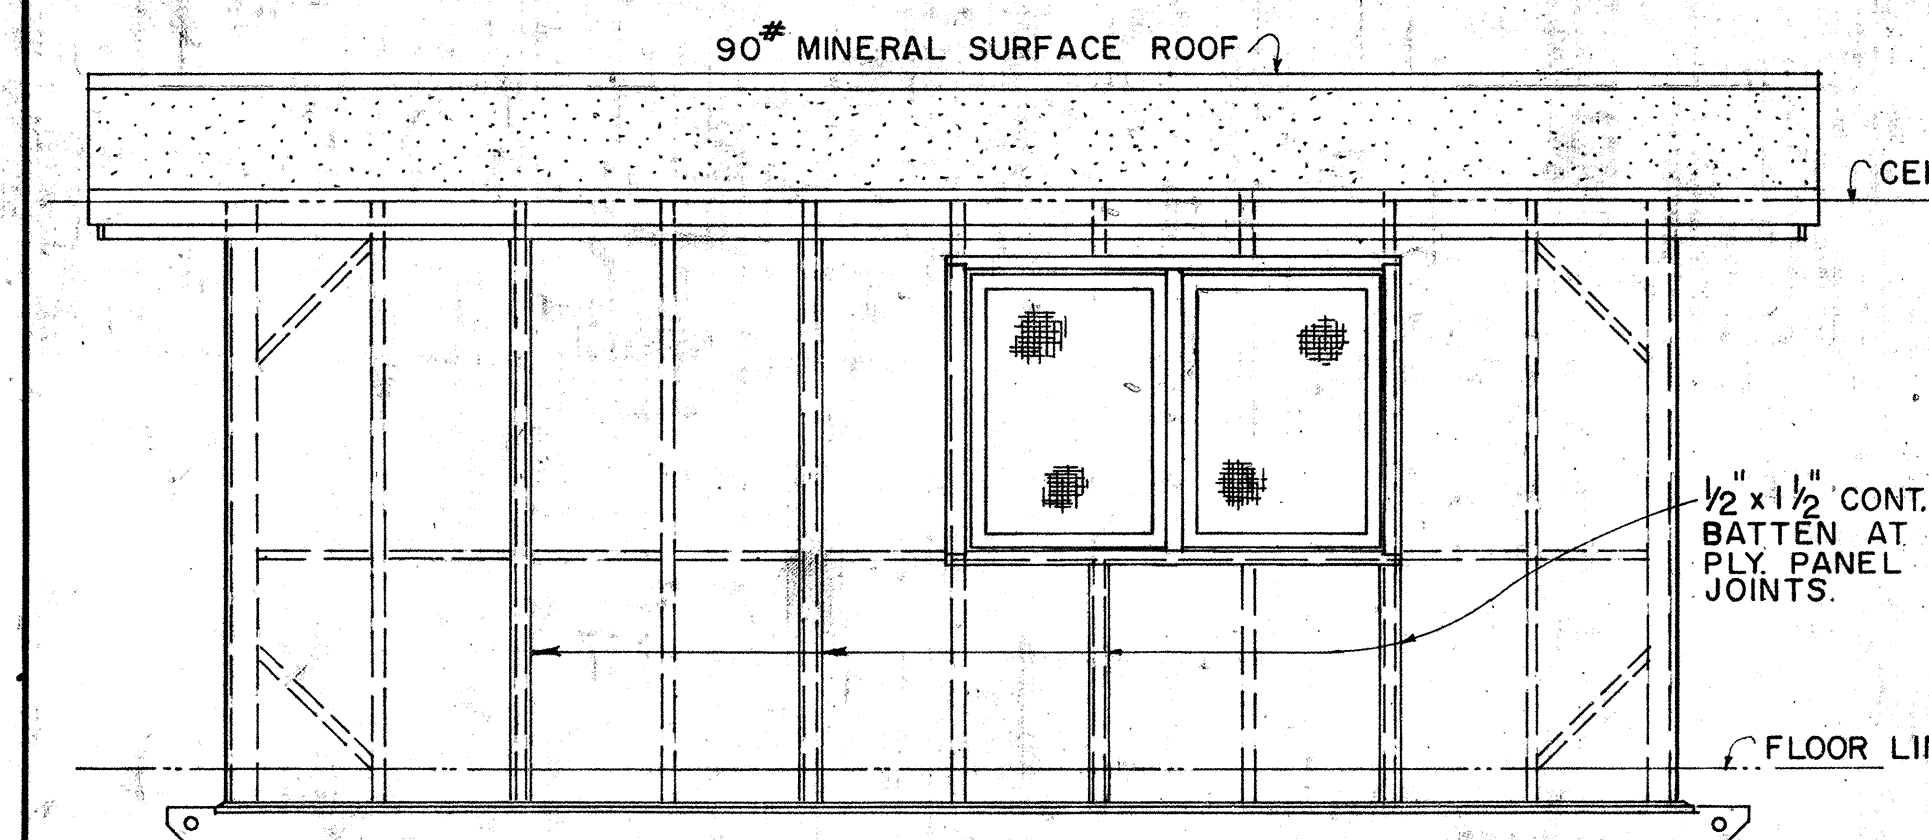


ELEVATION C
SCALE: 3/8" = 1'-0"

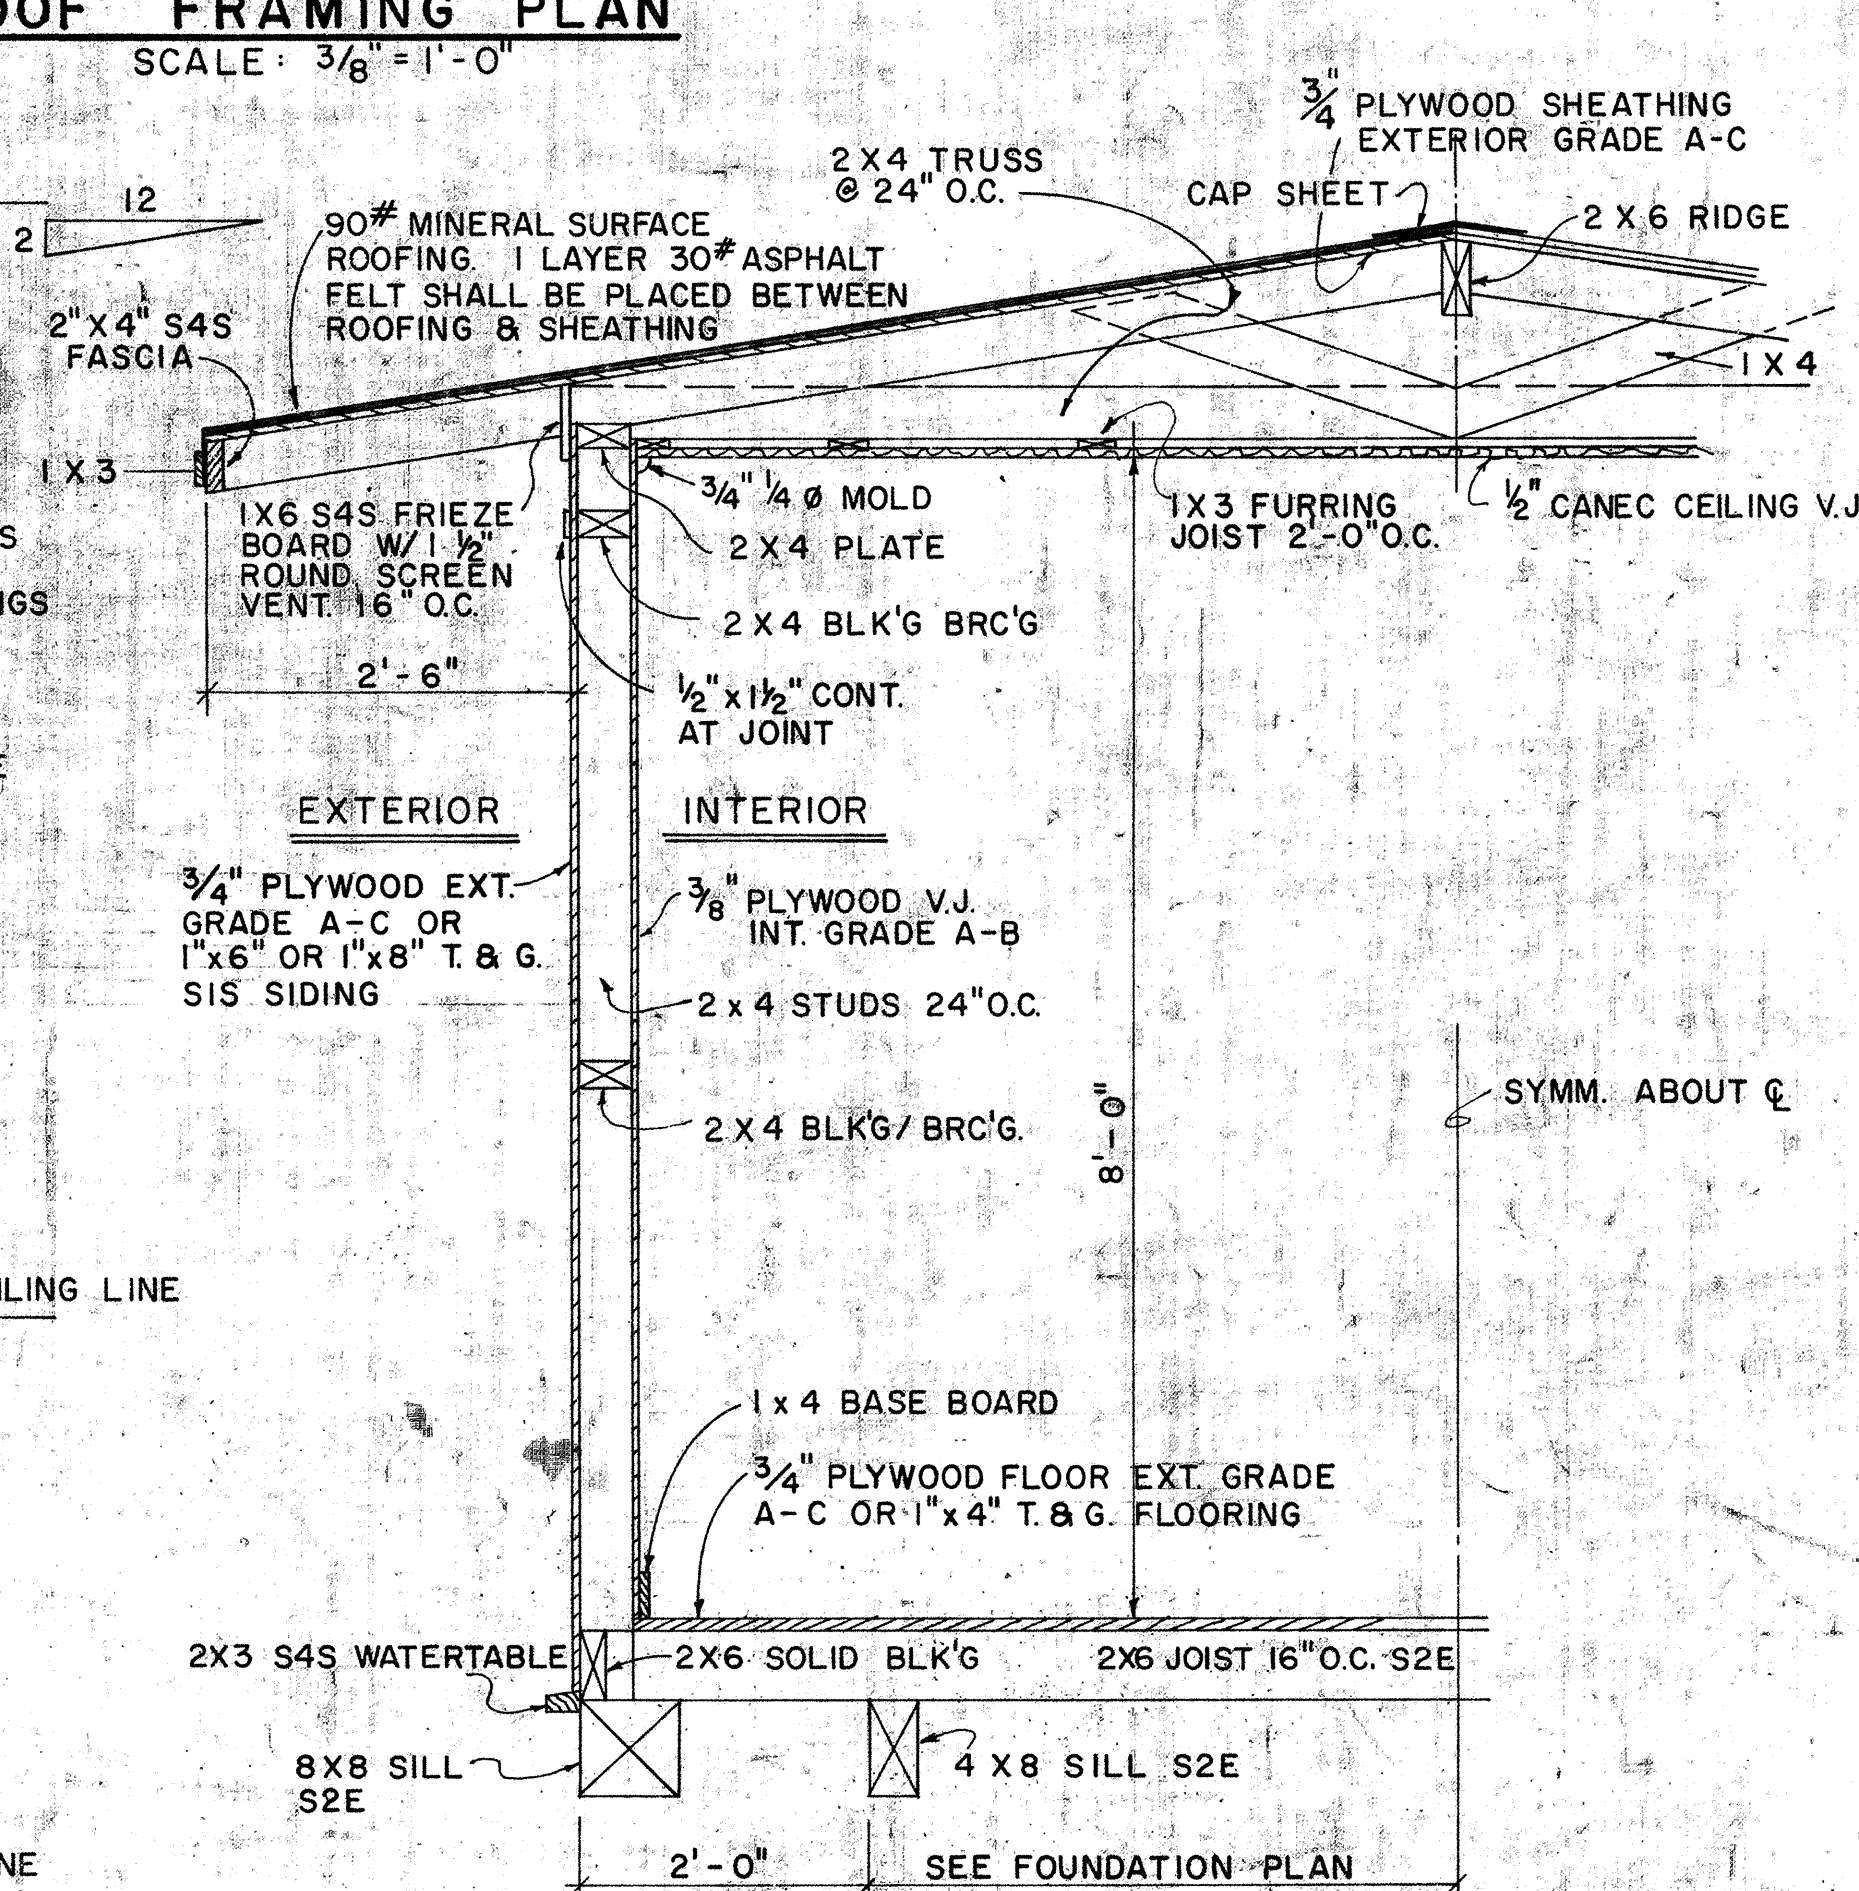

TYPICAL WALL SECTION
SCALE: 3/4" = 1'-0"

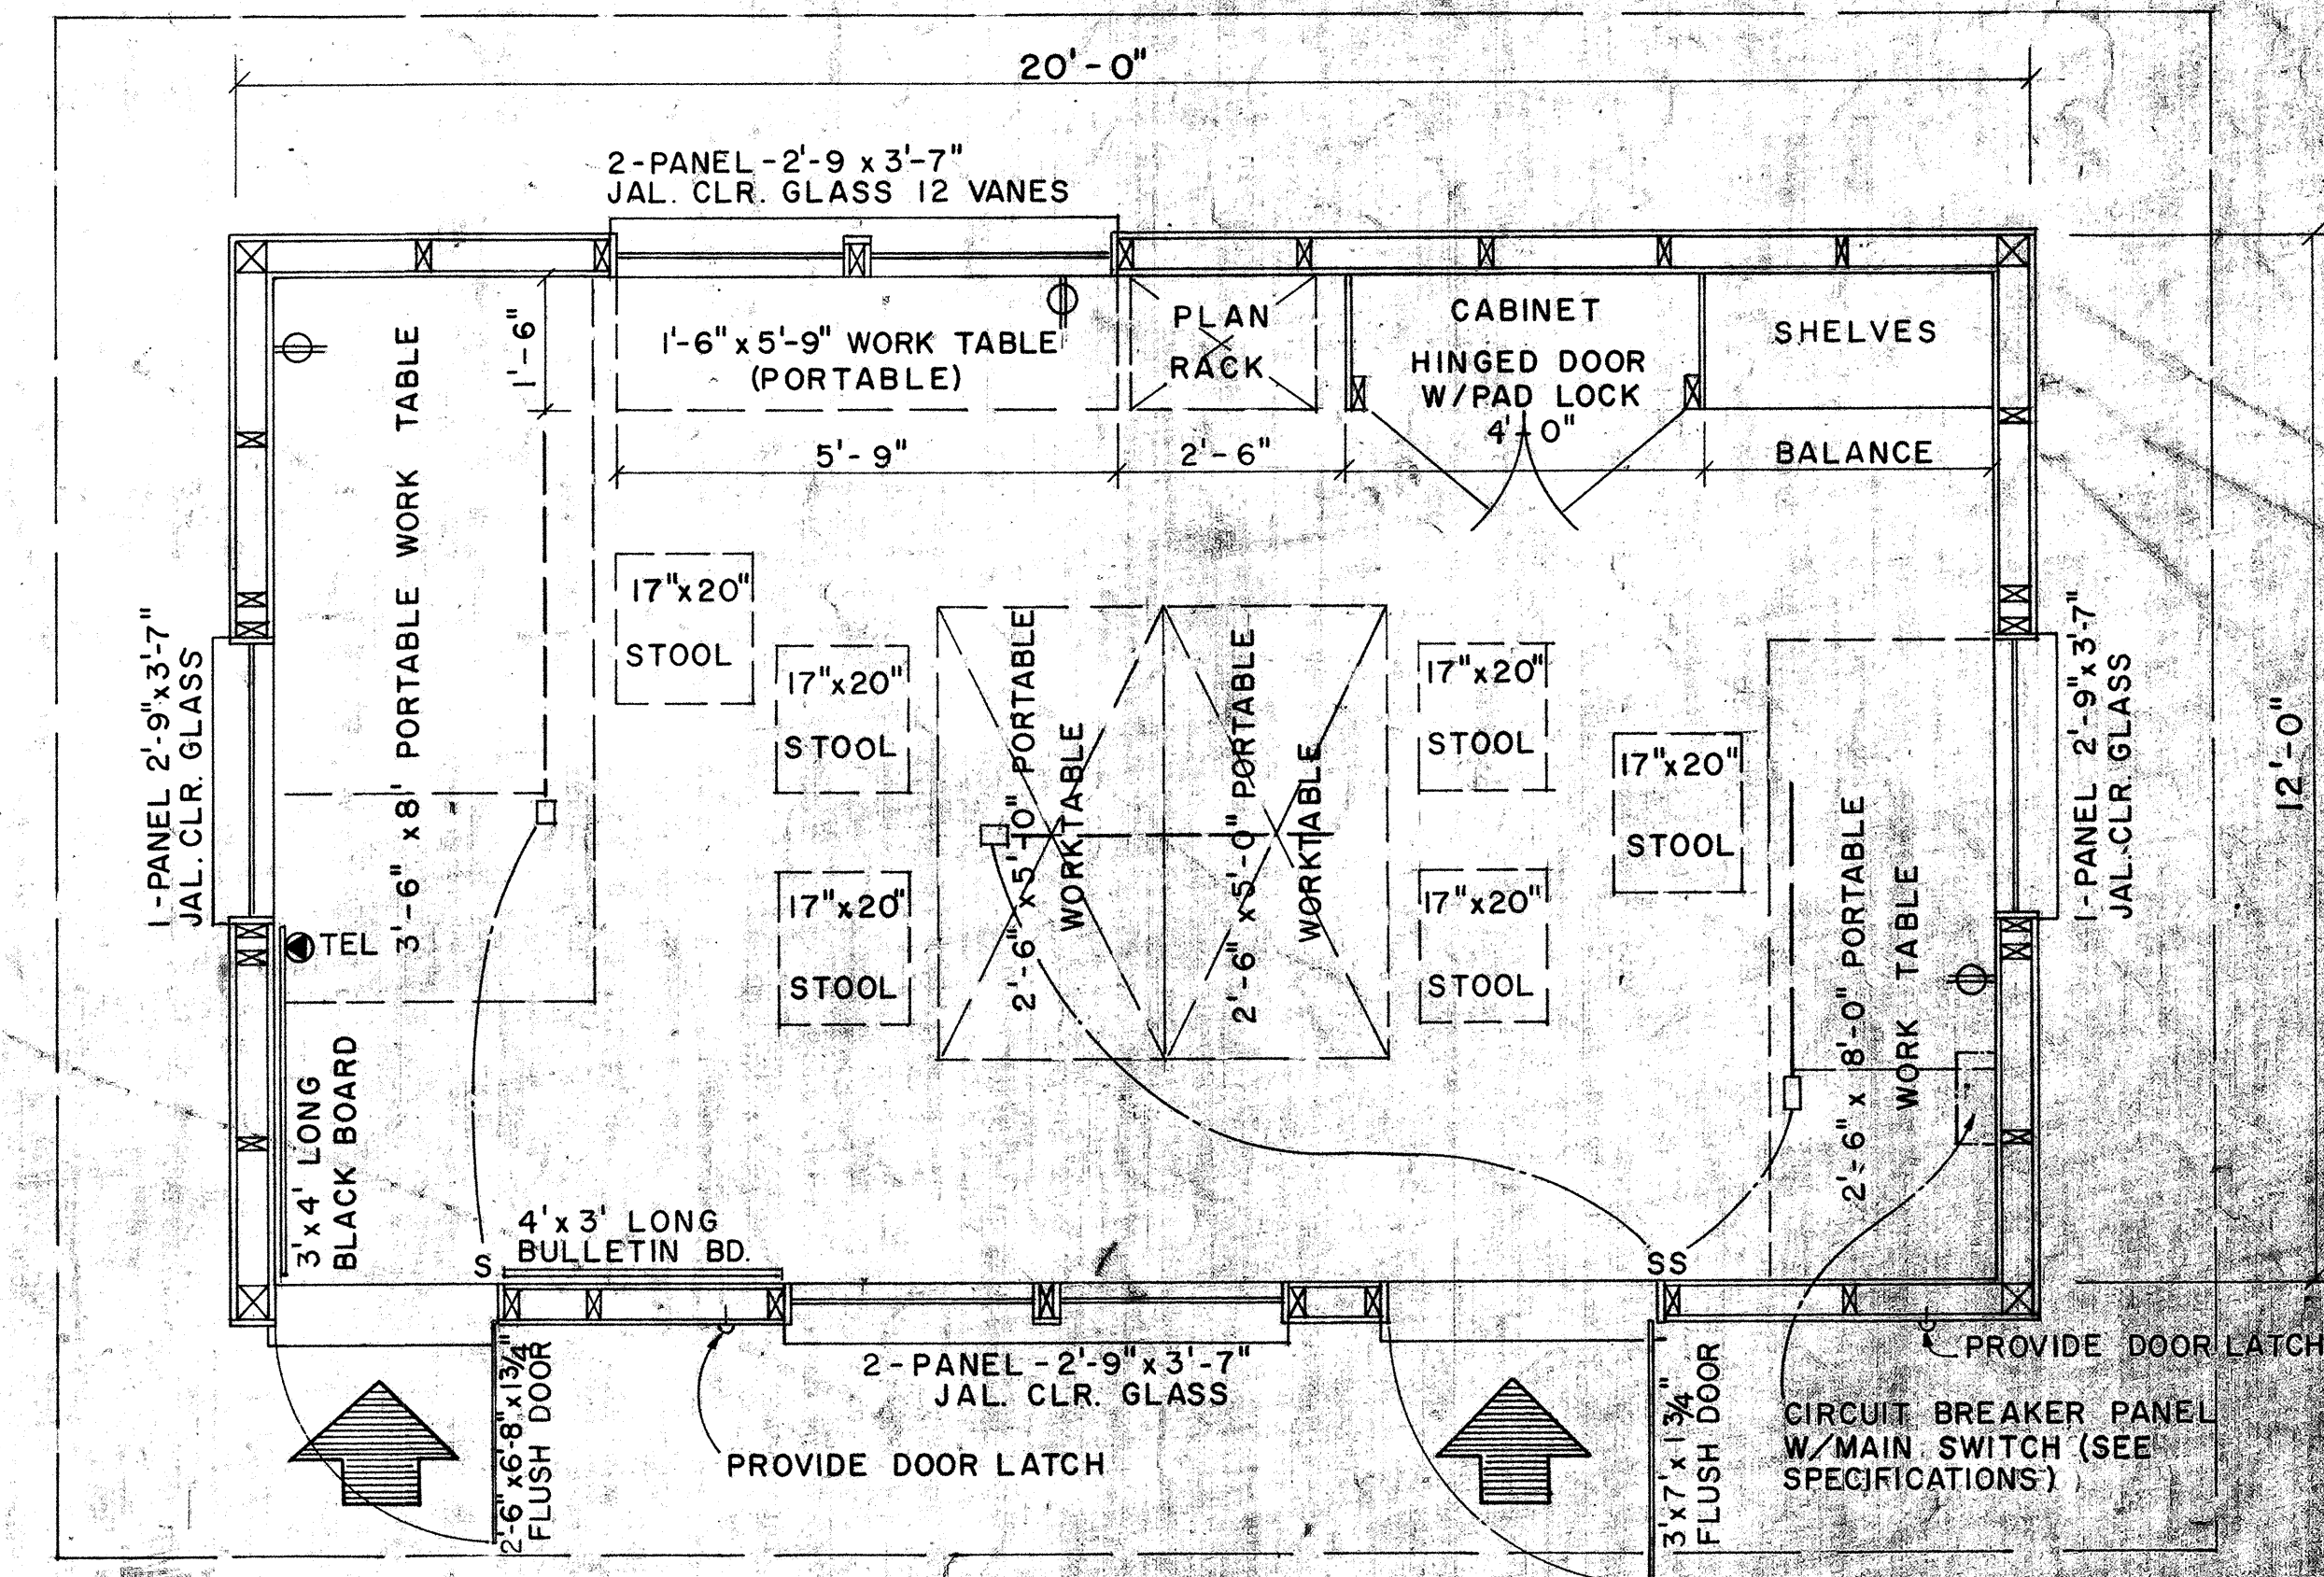

FLOOR PLAN
SCALE: 1/2" = 1'-0"

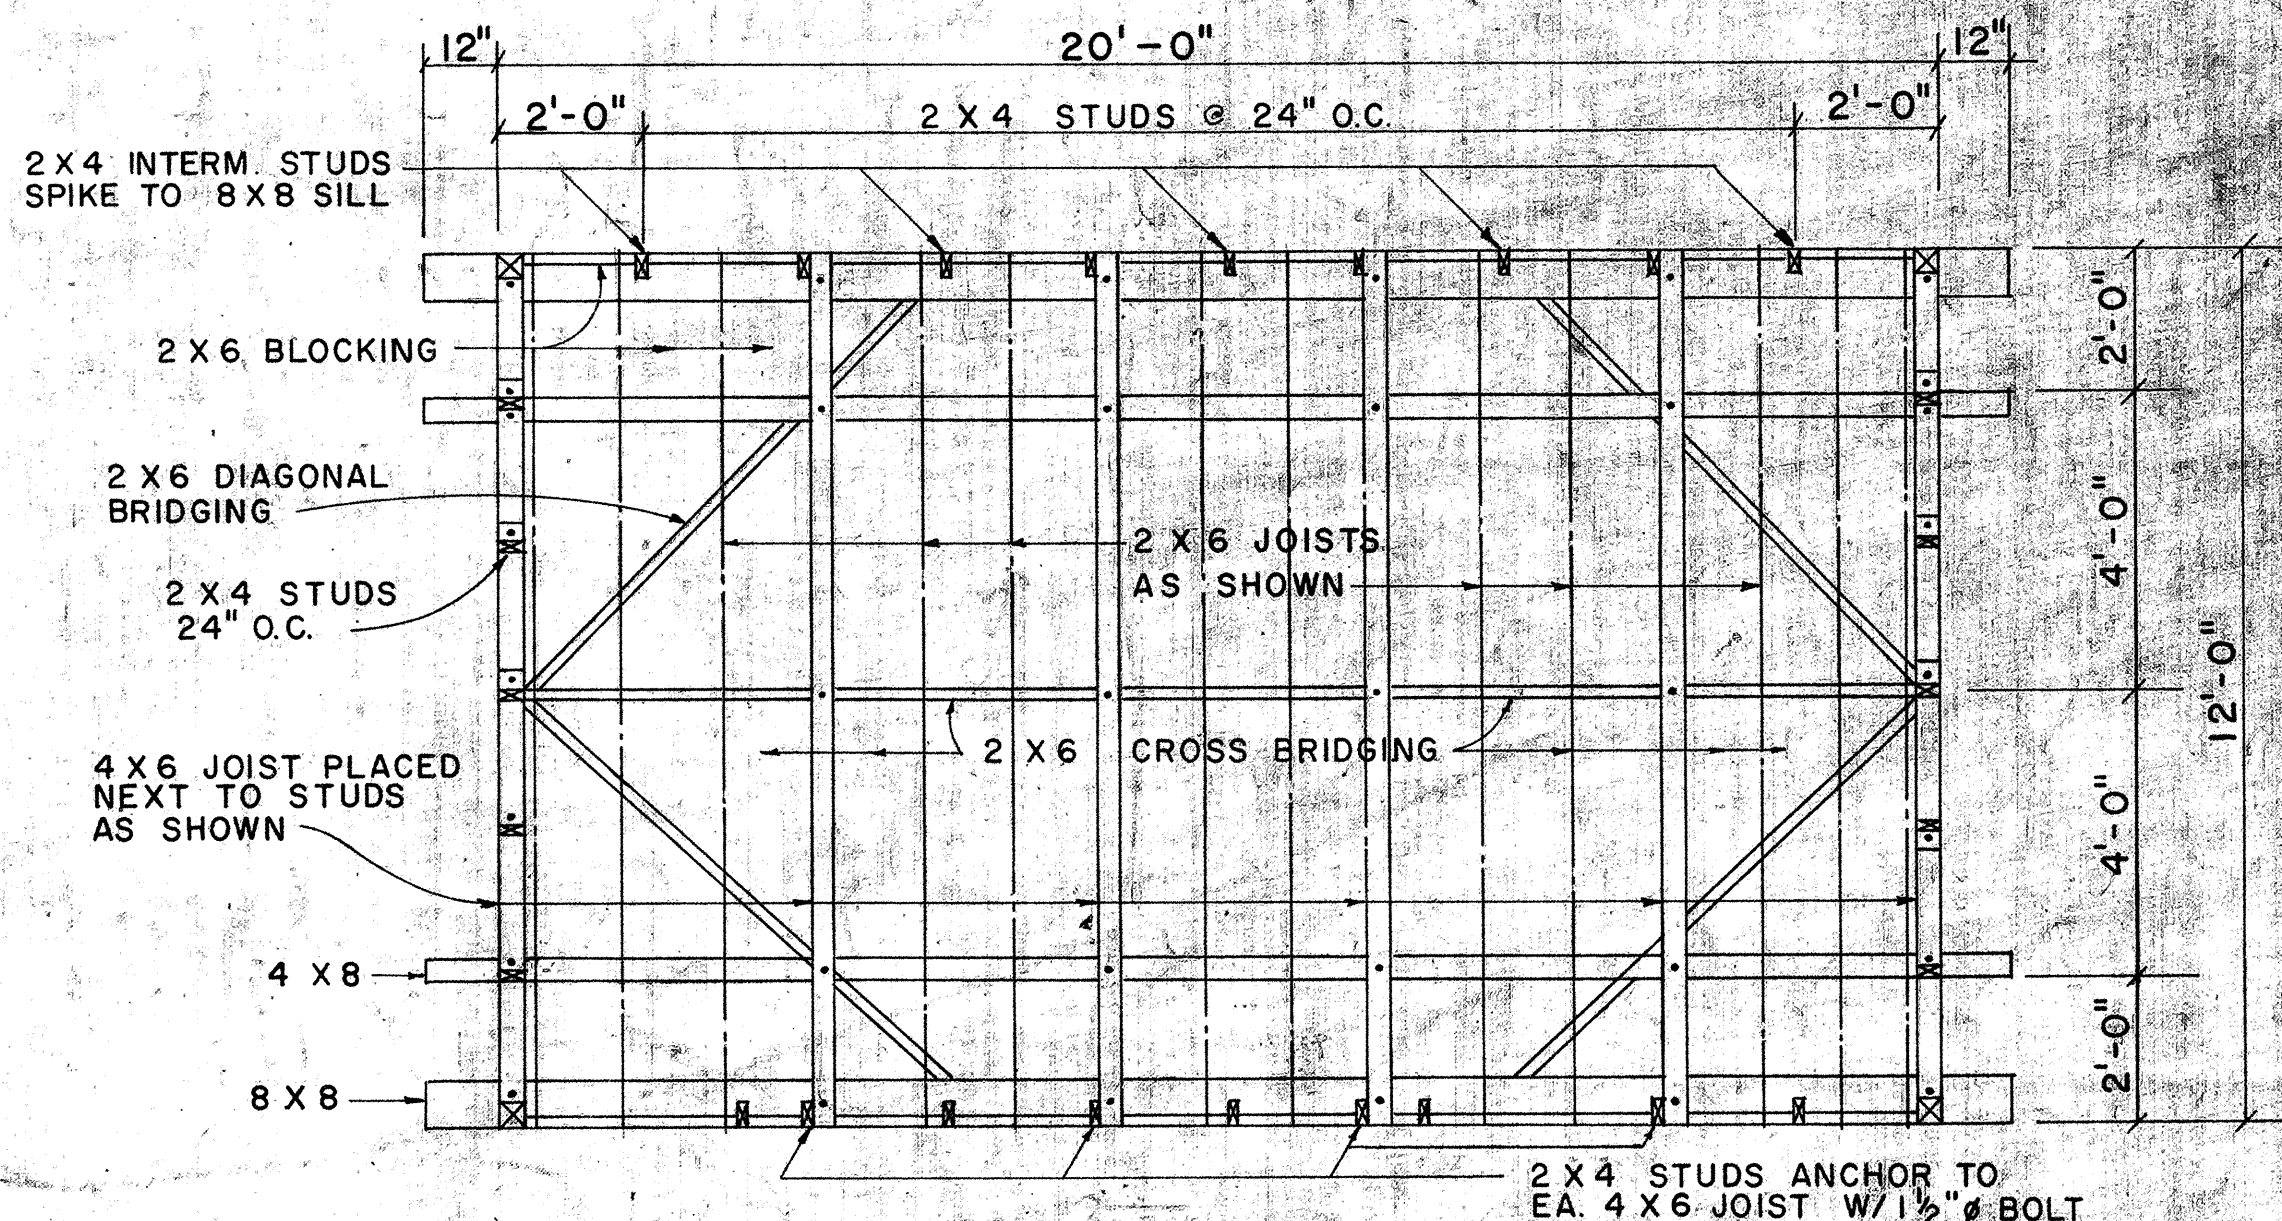

FOUNDATION FRAMING PLAN
SCALE: 3/8" = 1'-0"

APPROVAL RECOMMENDED:

HIGHWAY DESIGN ENGINEER

APPROVED:

ASSISTANT CHIEF, ENGINEERING

12-4-67
DATE

12-10-69
DATE




NO.	REVISION	APPROVED BY	DATE

STATE OF HAWAII DEPARTMENT OF TRANSPORTATION LAND TRANSPORTATION FACILITIES DIVISION FIELD OFFICE Scale: As Noted
--



SHEET NO. 10 OF 26 SHEETS / DD-636

SURVEY PLOTTED BY:	DATE:
ORIGINAL PLAN	DRAWN BY:
NOTE BOOK	TRACED BY:
No.	CHECKED BY:


FED. ROAD DIST. NO.	STATE	FED. AID PROJ. NO.	FISCAL YEAR	SHEET NO.	TOTAL SHEETS
HAWAII	HAWAII	1-HI-1(131)-17	1977	48	394

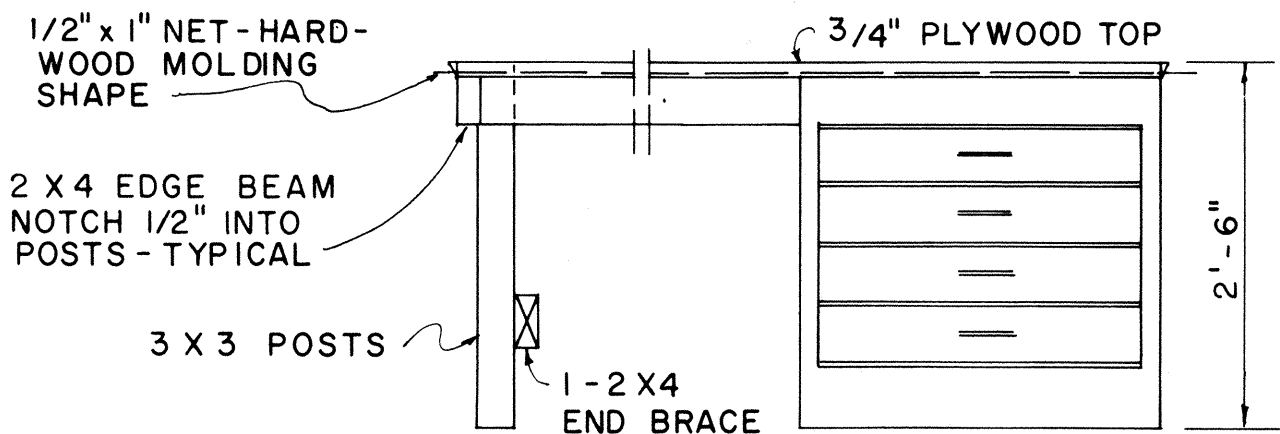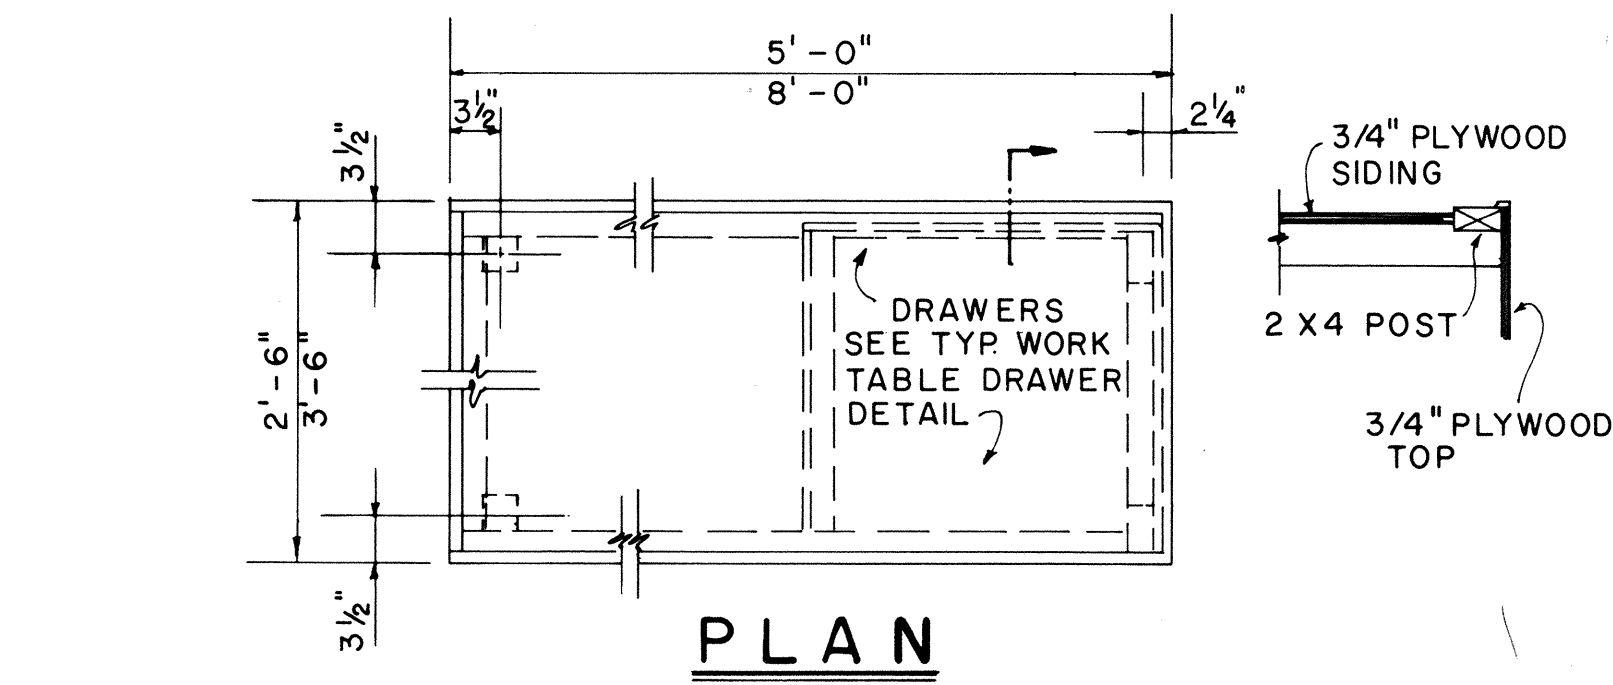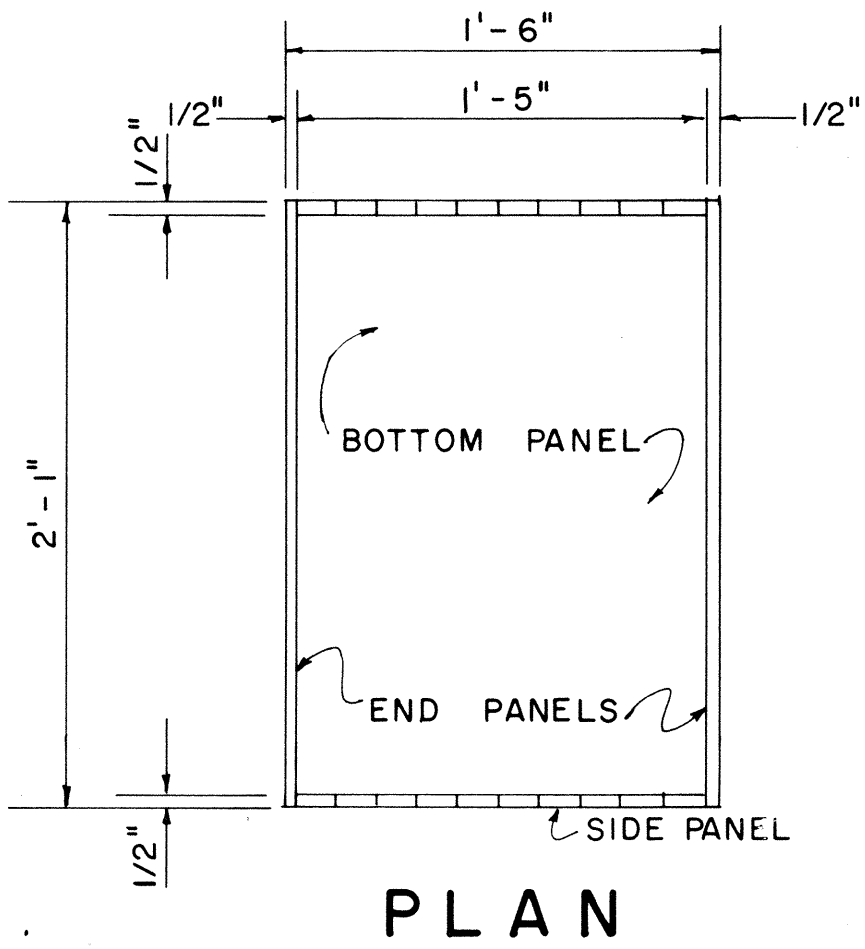


ELEVATION
 2'-6" x 5'-0" 2 REQ'D.
 3'-6" x 8'-0" 1 REQ'D.
 2'-6" x 8'-0" 1 REQ'D.
PORTABLE WORK TABLE DETAIL
 SCALE: 3/4" = 1'-0"

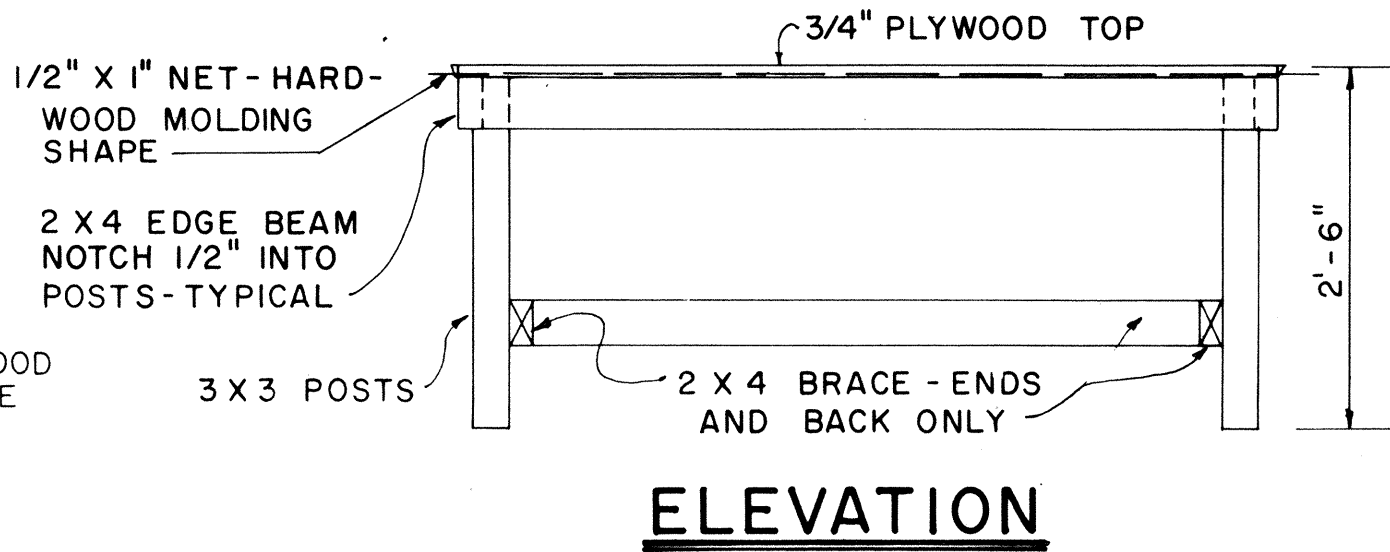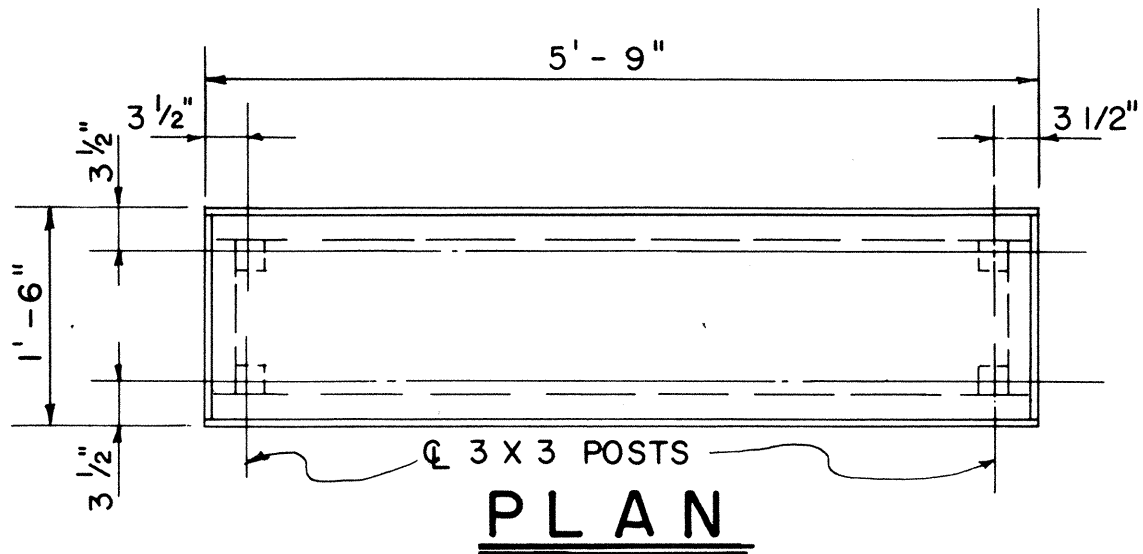


1'-6" x 5'-9" PORTABLE WORK TABLE DETAIL
 SCALE: 3/4" = 1'-0"

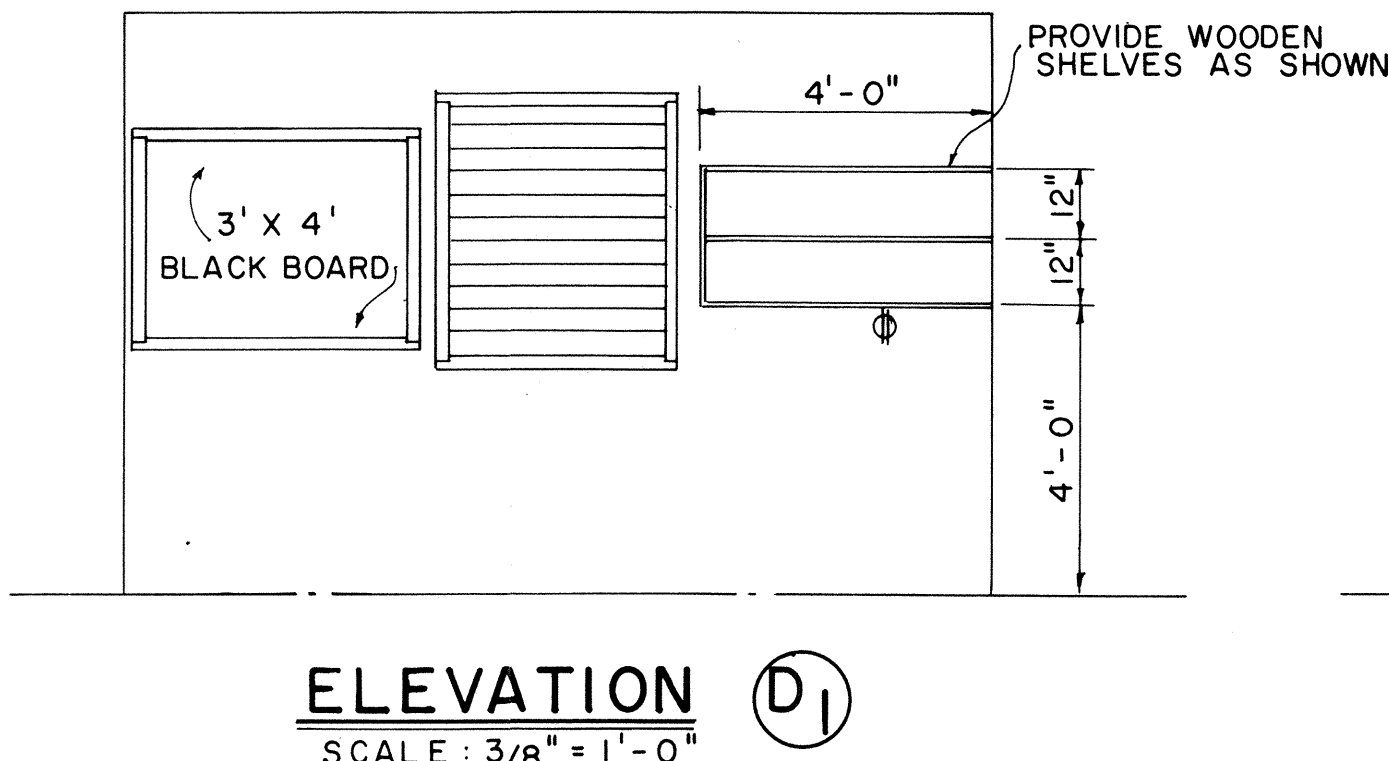


ELEVATION D1
 SCALE: 3/8" = 1'-0"

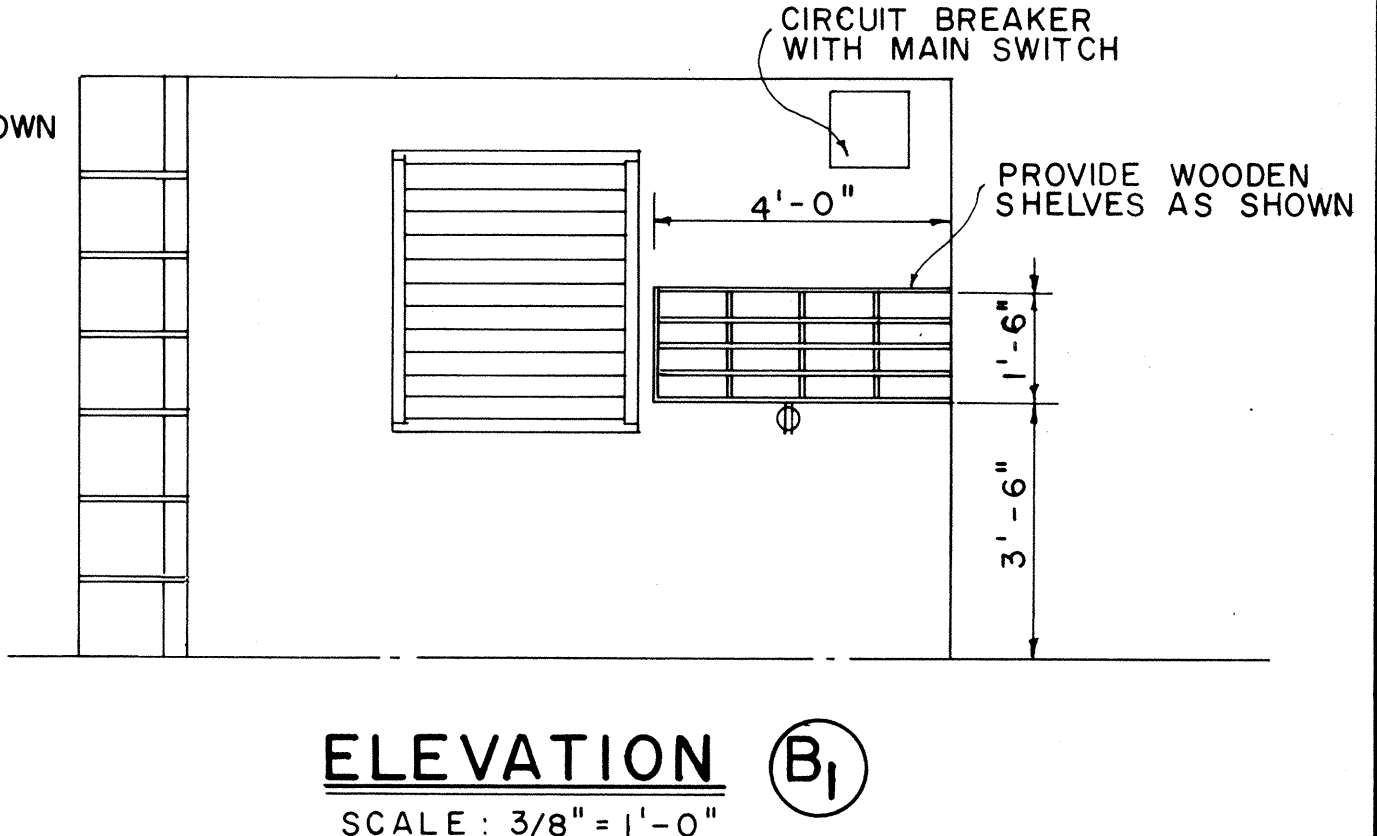


ELEVATION B1
 SCALE: 3/8" = 1'-0"

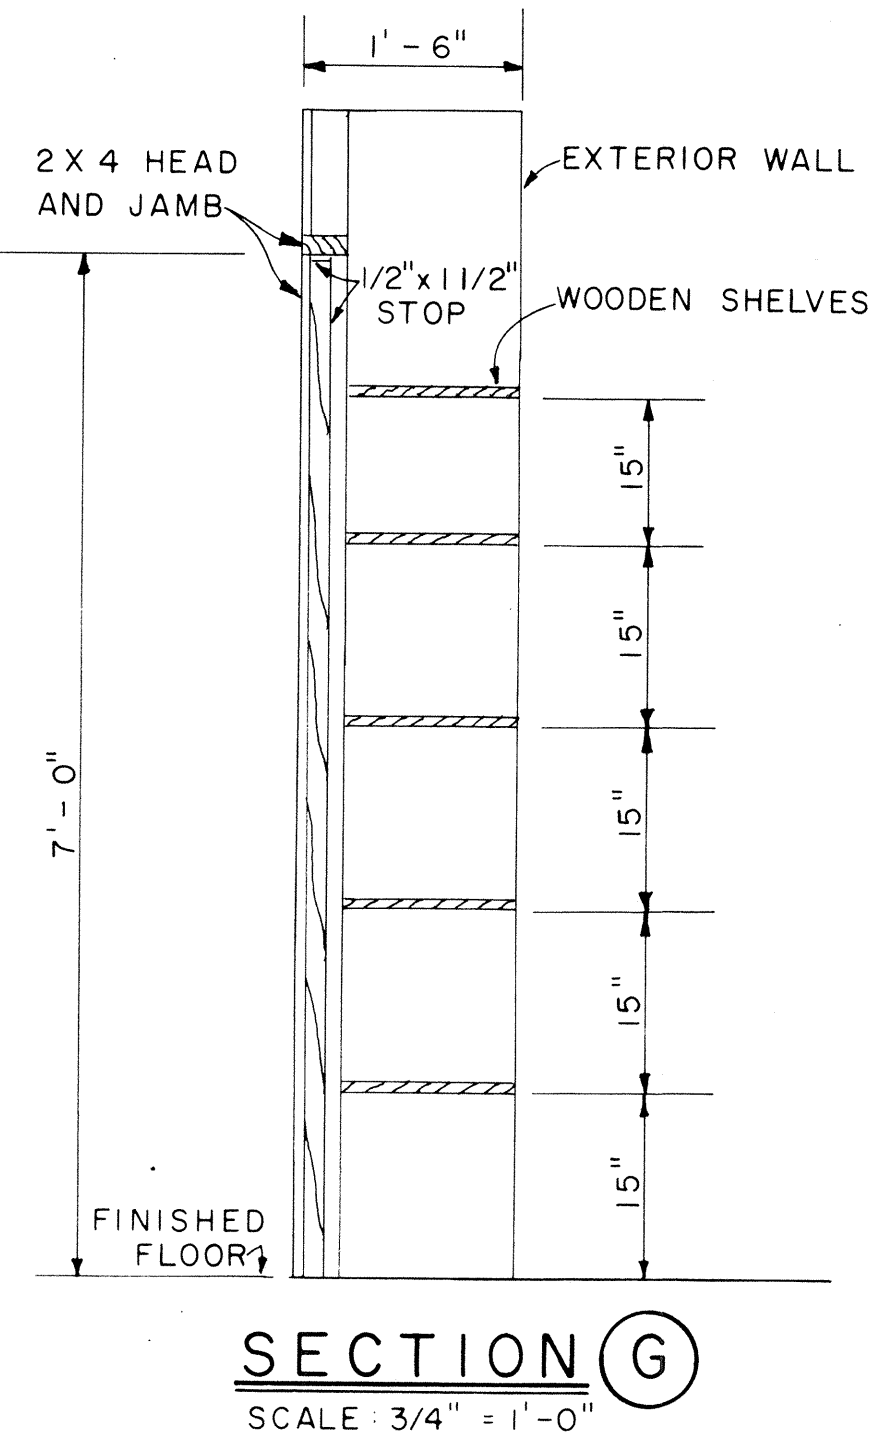

SECTION G
 SCALE: 3/4" = 1'-0"

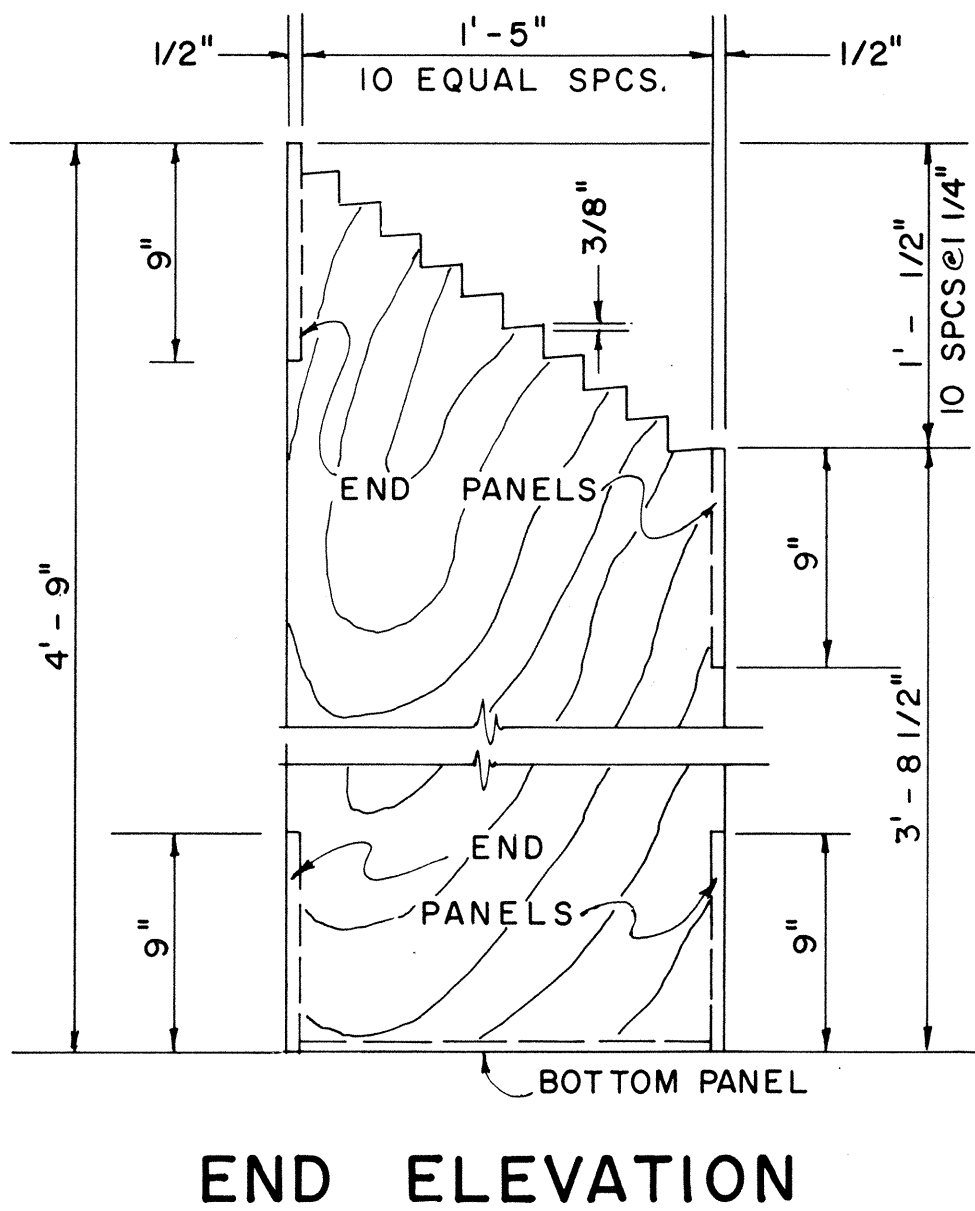

PLAN RACK DETAIL
 SCALE: 1 1/2" = 1'-0"
 (ONE REQUIRED)

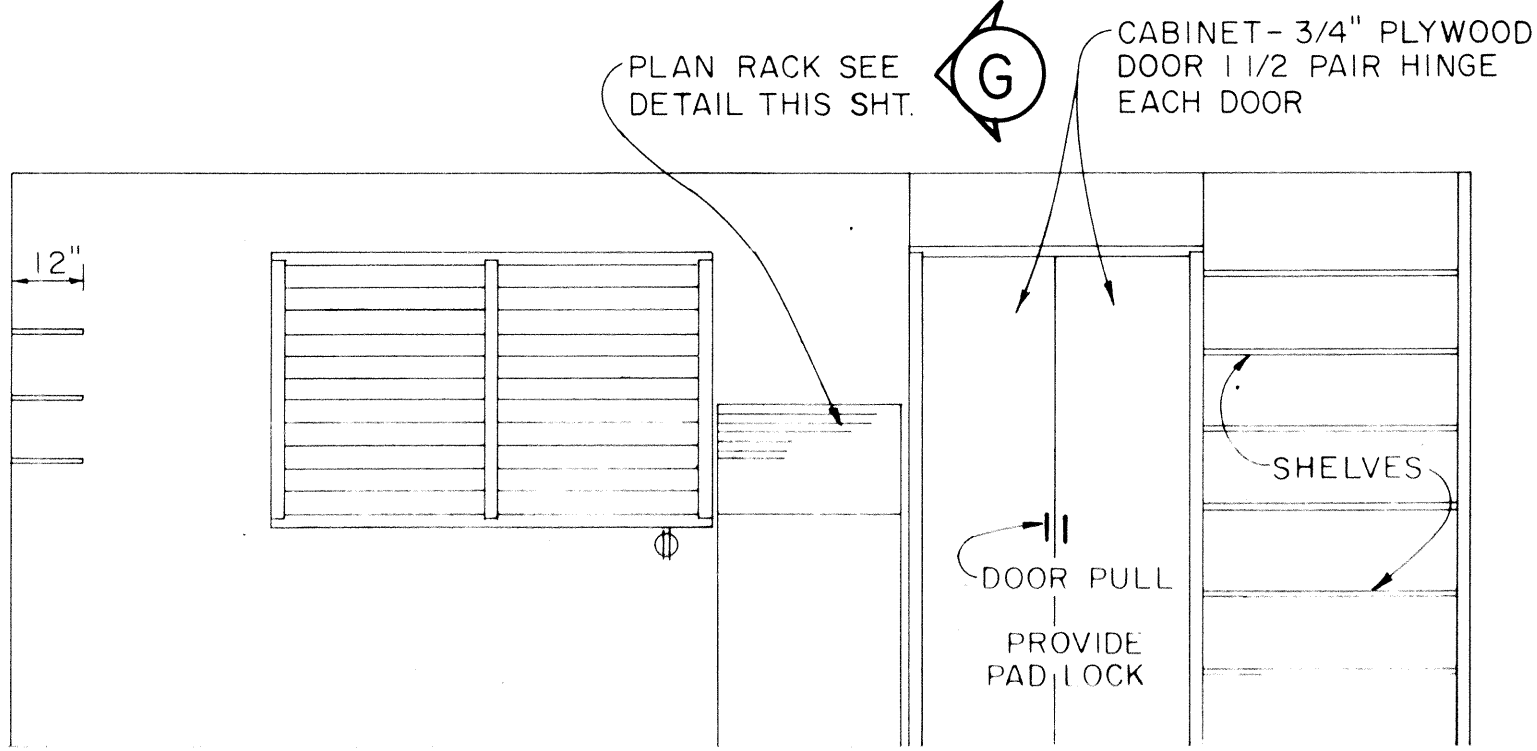

ELEVATION A1
 SCALE: 3/8" = 1'-0"

APPROVAL RECOMMENDED:
 HIGHWAY DESIGN ENGINEER 12-4-69 DATE
 APPROVED:
 ASSISTANT CHIEF, ENGINEERING 12-10-69 DATE


NO.	REVISION	APPROVED BY	DATE

STATE OF HAWAII
 DEPARTMENT OF TRANSPORTATION
 LAND TRANSPORTATION FACILITIES DIVISION
 FIELD OFFICE
 Scale: As Noted

ORIGINAL PLAN	SURVEY PLOTTED BY _____	DATE _____
NOTE BOOK	DRAWN BY _____	_____
	TRACED BY _____	_____
	DESIGNED BY _____	_____
	QUANTITIES BY _____	_____
No. _____	CHECKED BY _____	_____




FED. ROAD DIST. NO.	STATE	FED. AID PROJ. NO.	FISCAL YEAR	SHEET NO.	TOTAL SHEETS
HAWAII	HAW.	1-HI-1(13)17	1977	50	394

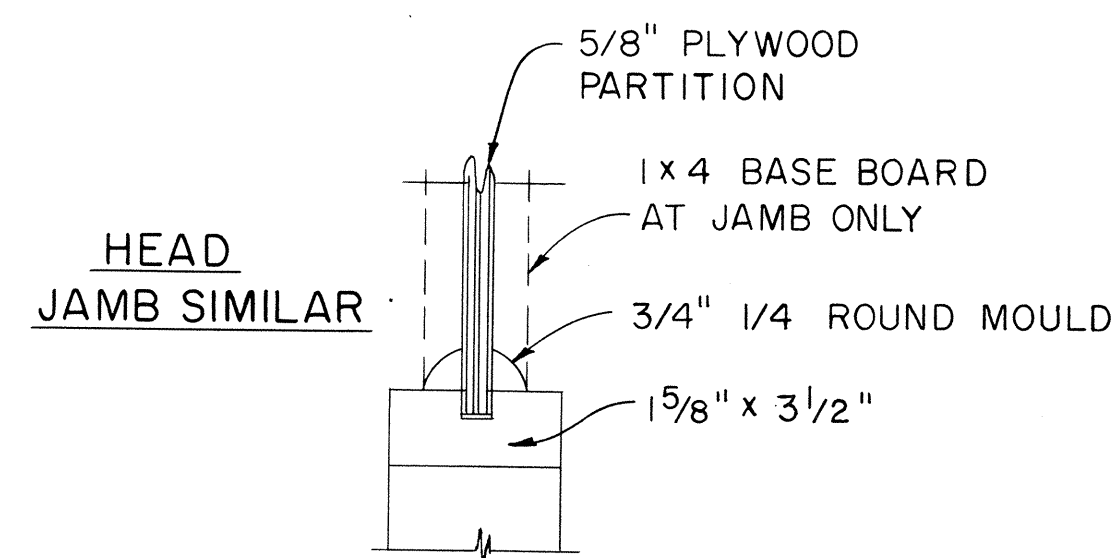


CASEMENT DETAIL

SCALE: 3" = 1'-0"

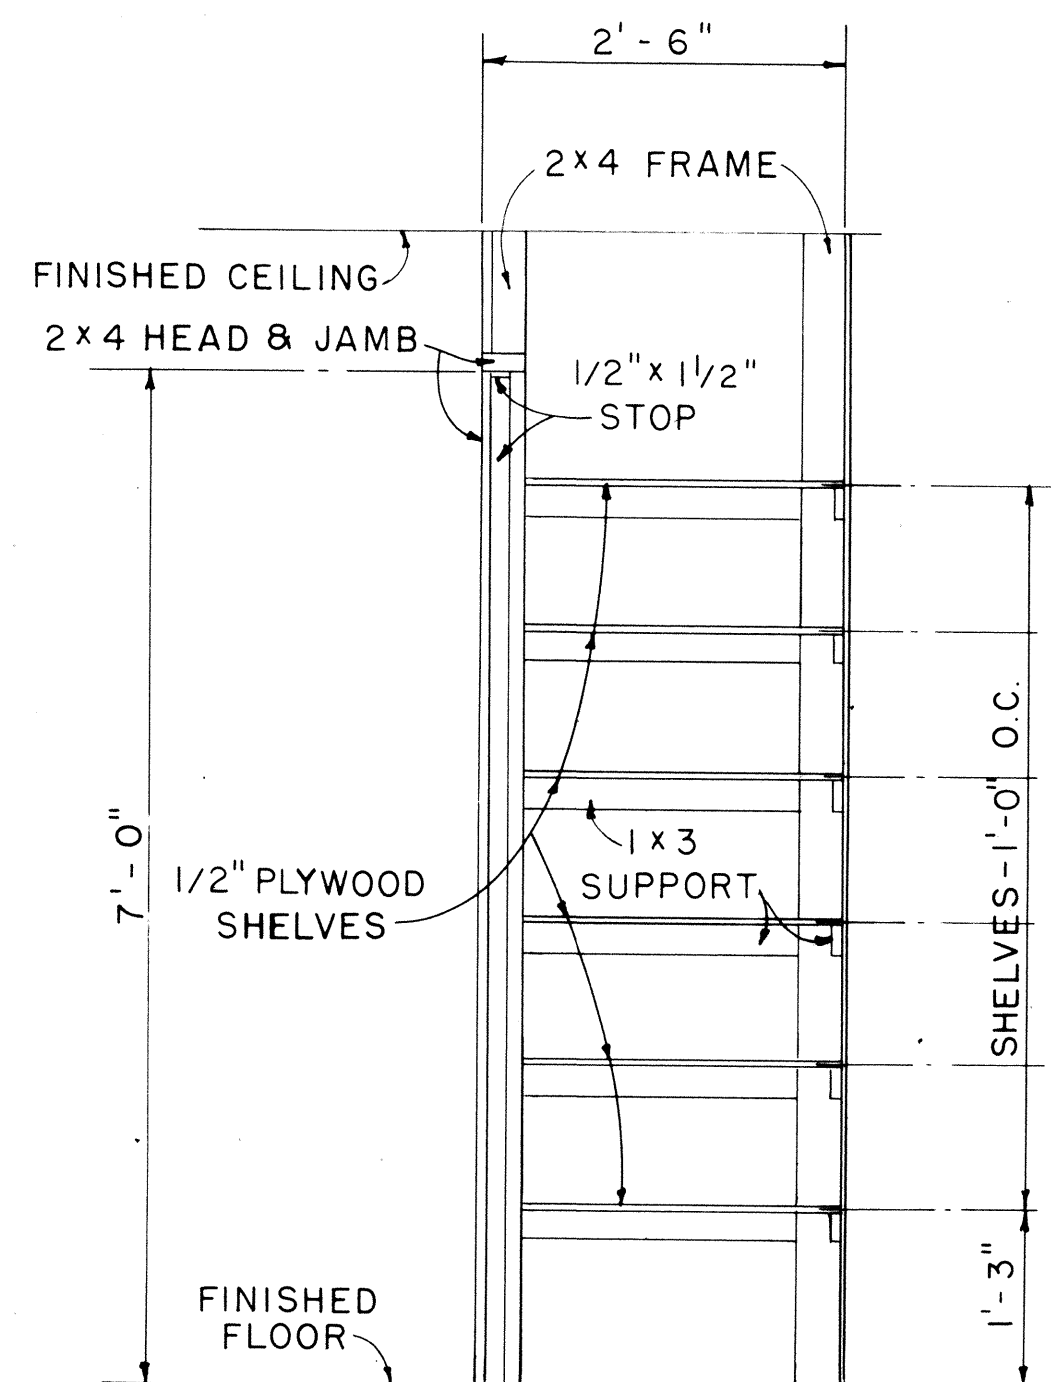


CABINET DETAIL

SCALE: 3/4" = 1'-0"

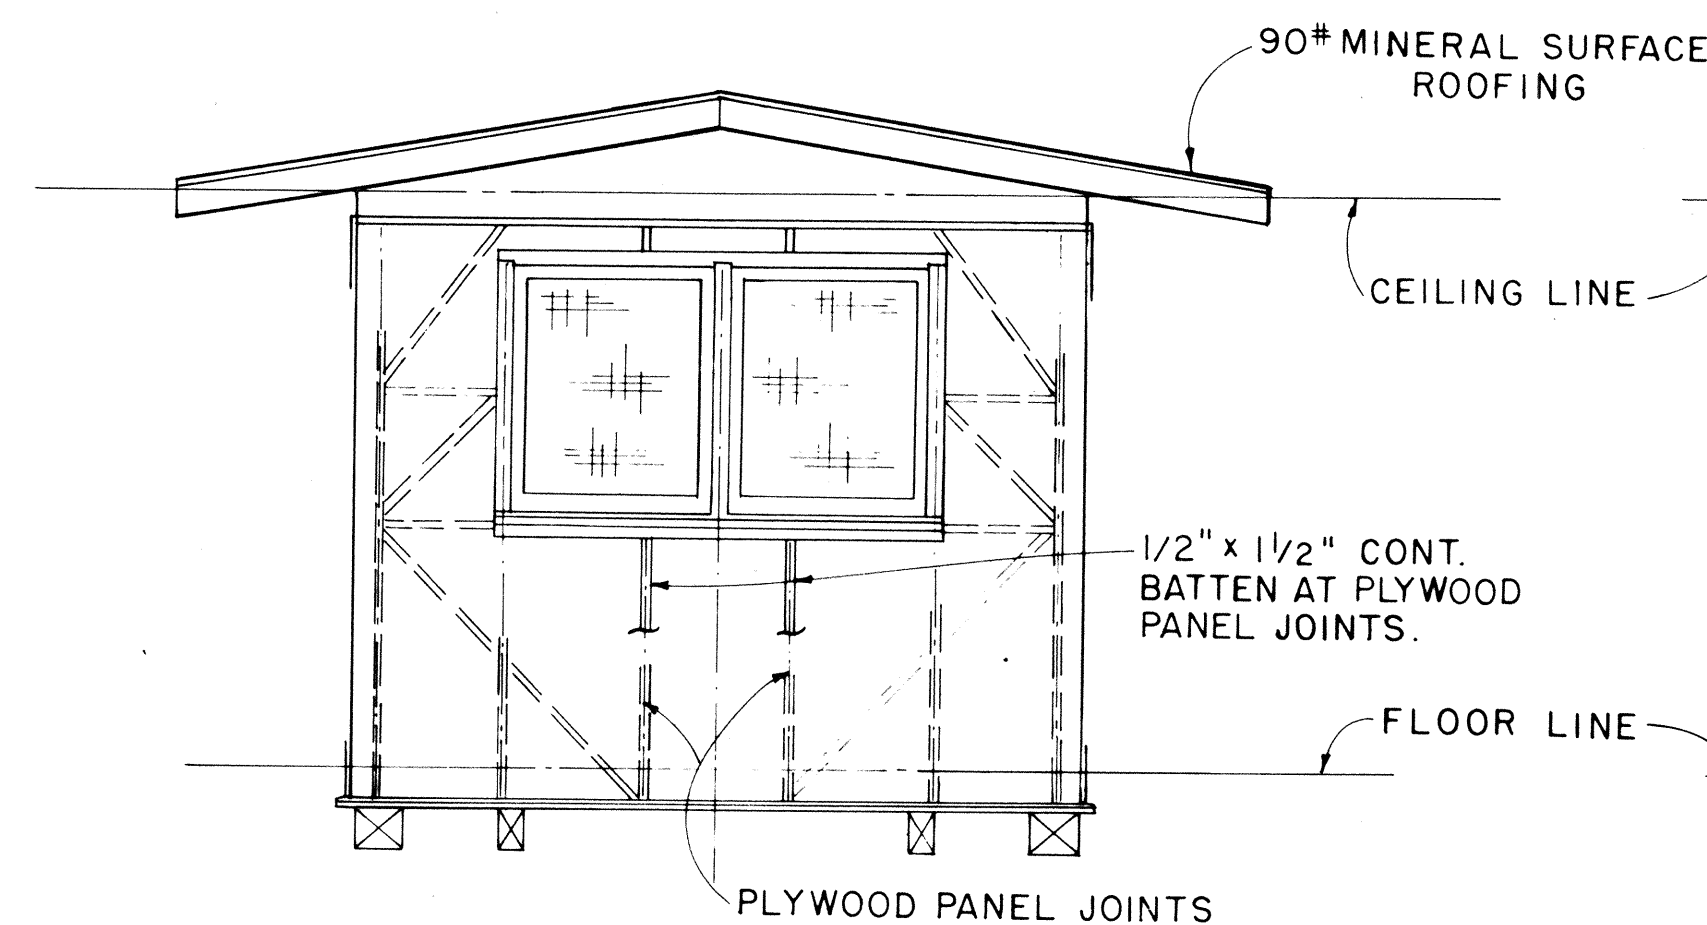


ELEVATION D

SCALE: 3/8" = 1'-0"

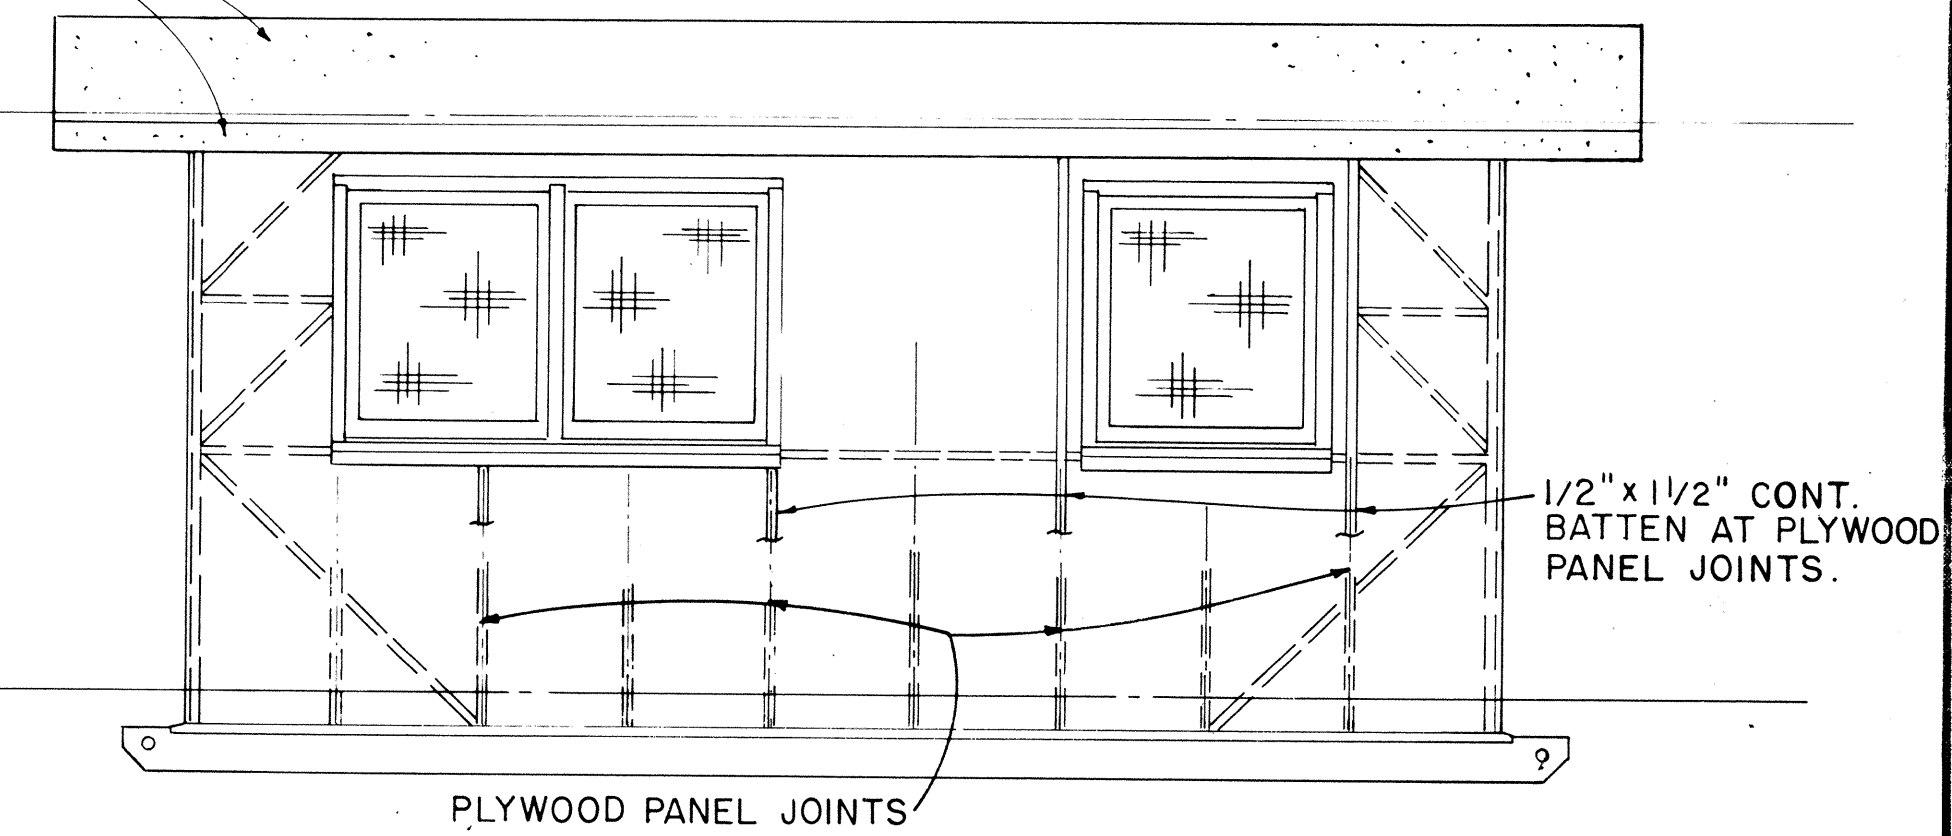


ELEVATION C

SCALE: 3/8" = 1'-0"

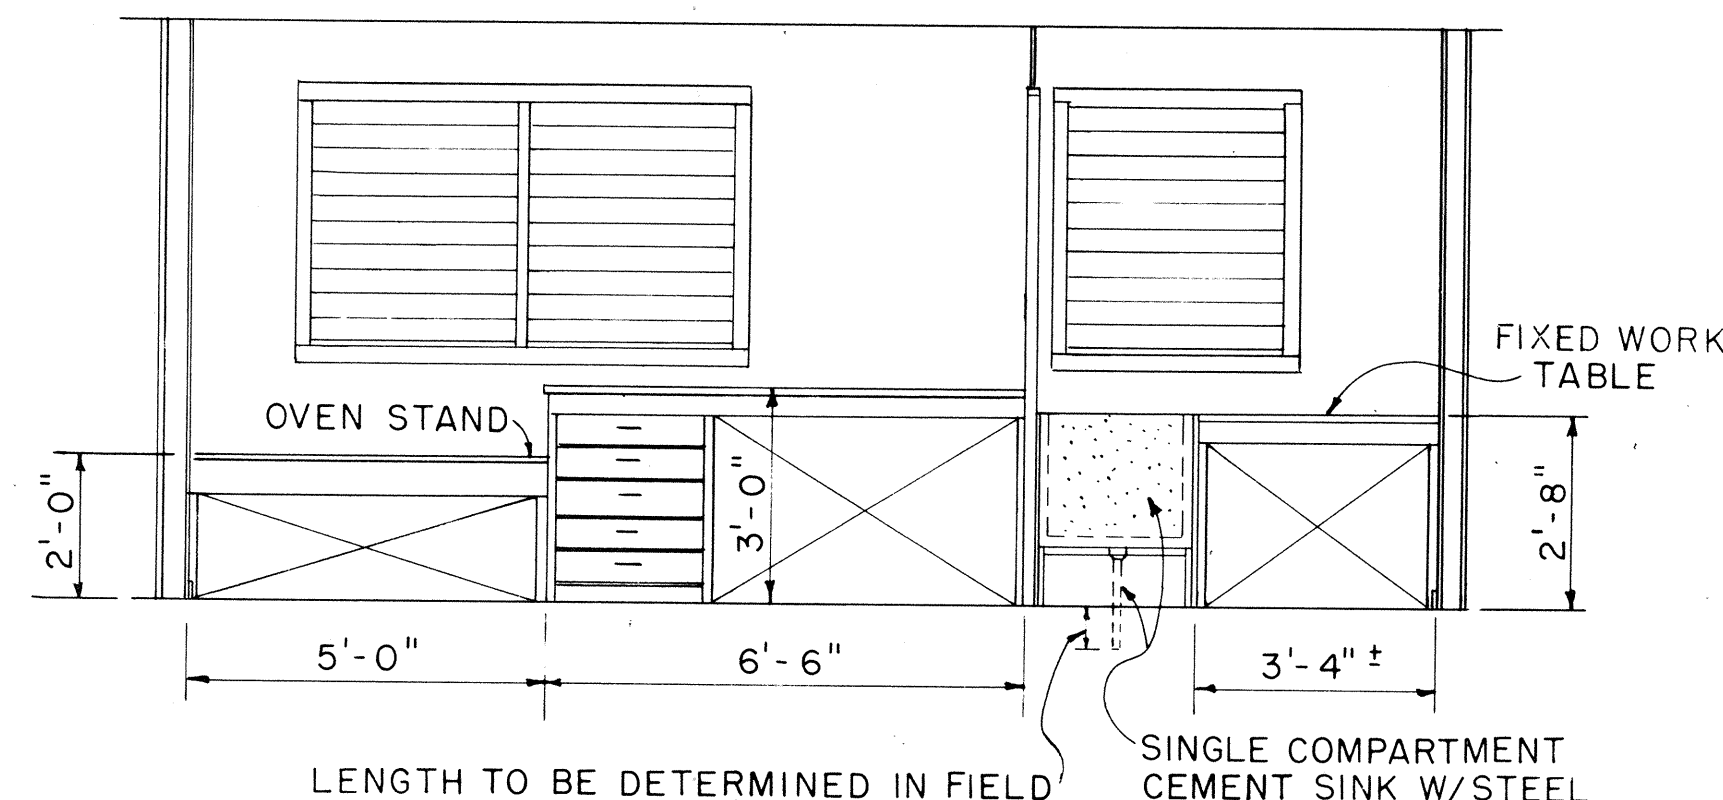

ELEVATION C1

SCALE: 3/8" = 1'-0"

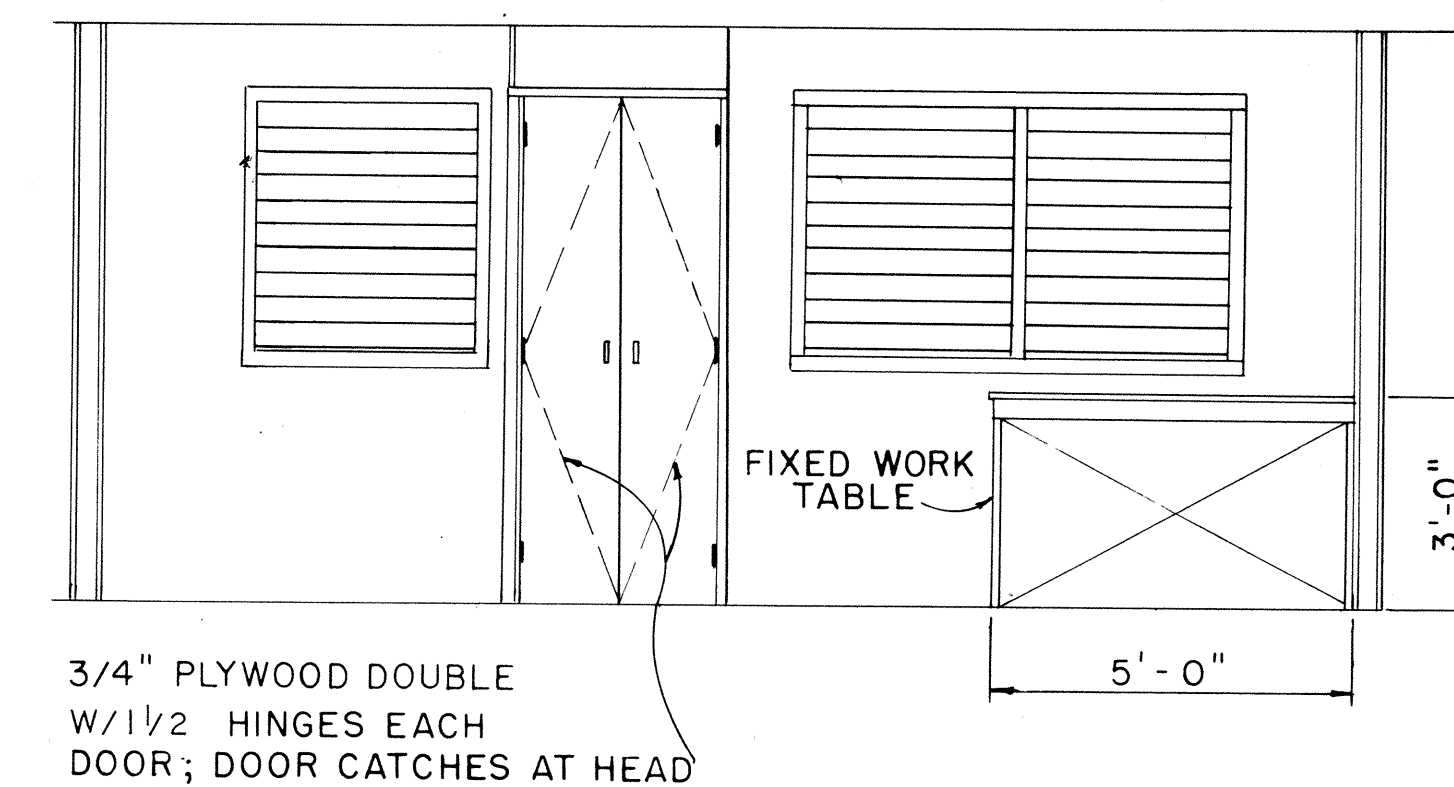


ELEVATION A1

SCALE: 3/8" = 1'-0"

DATE	_____
SURVEY PLOTTED BY	_____
DESIGNED BY	_____
NOTED BY	_____
CHECKED BY	_____
ORIGINAL PLAN	_____
NOTE BOOK	_____
No.	_____

APPROVAL RECOMMENDED:

HIGHWAY DESIGN ENGINEER
12-4-69
DATE

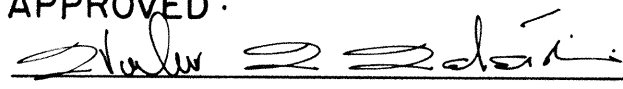APPROVED:

ASSISTANT CHIEF, ENGINEERING
12-10-69
DATE

NO.	REVISION	APPROVED BY	DATE

STATE OF HAWAII
DEPARTMENT OF TRANSPORTATION
LAND TRANSPORTATION FACILITIES DIVISION

PROJECT SITE LABORATORY





Scale: As Noted

The image contains two technical drawings of a display case, labeled 'CROSS SECTION' and 'END SECTION'.

CROSS SECTION: This drawing shows the side profile of the case. The total height is 2'-6". The interior face of the wall at the fixed table is 2'-6" or 3'-6" wide. The back panel is 3/4" plywood. The sides are 2x4. The bottom is 3/4" plywood. The interior shelves are 5/8" net back & sides. The top shelf is 1/2" x 1 1/2" stop. The bottom shelf is 3/4" x 1 1/2" stop. The distance between shelves is 5 1/4" o.c. (on center). The distance from the 2x4 to the 3/4" plywood is 35/8".

END SECTION: This drawing shows the front profile of the case. The top shelf is 1/2" x 1" HD' wood trim. The back panel is 3/4" plywood. The sides are 2x4. The bottom is 1/4" plywood or masonite bottom. The interior shelves are 5/8" net facing. The bottom shelf is 3/4" x 3 1/2" guides. The distance between shelves is 1/4". The distance from the 2x4 to the 3/4" plywood is 35/8".

SCALE: 3" = 1'-0"

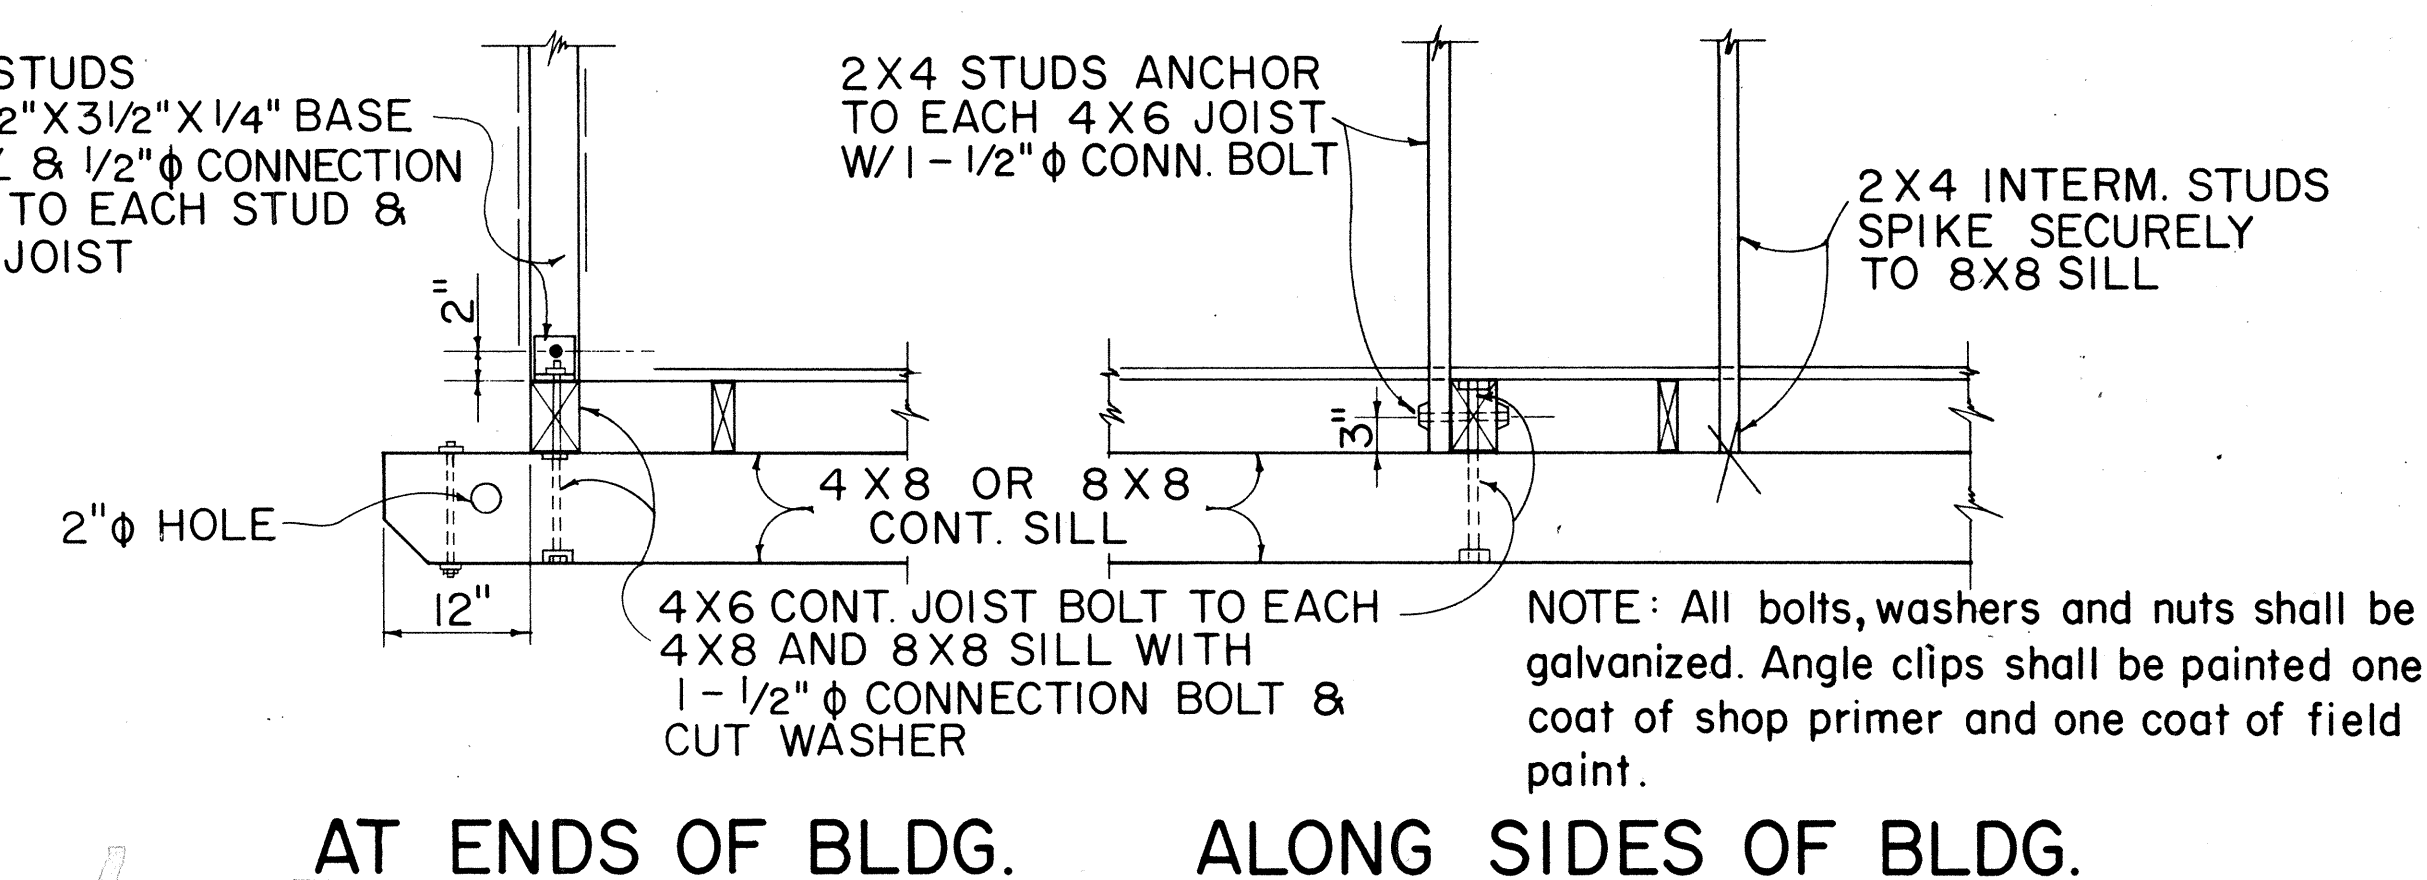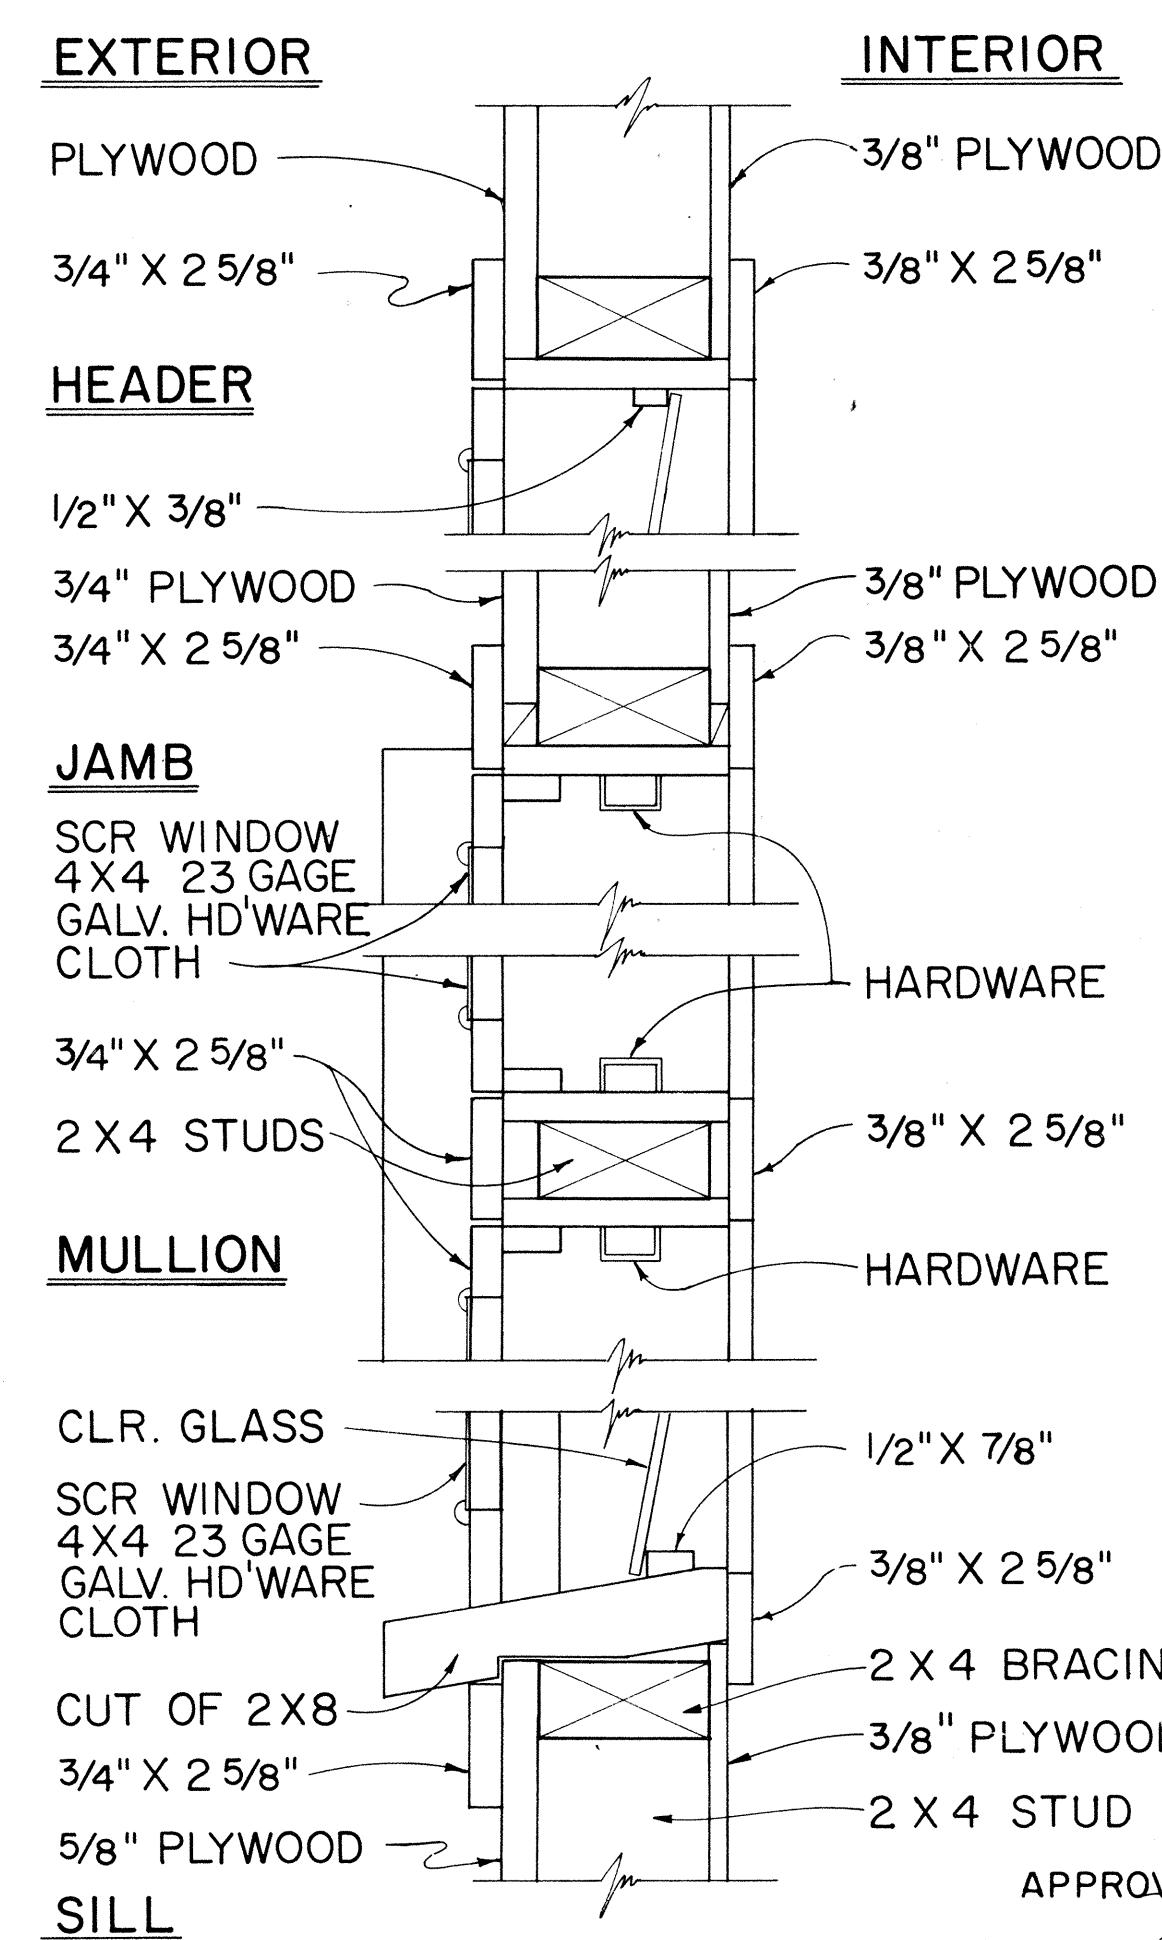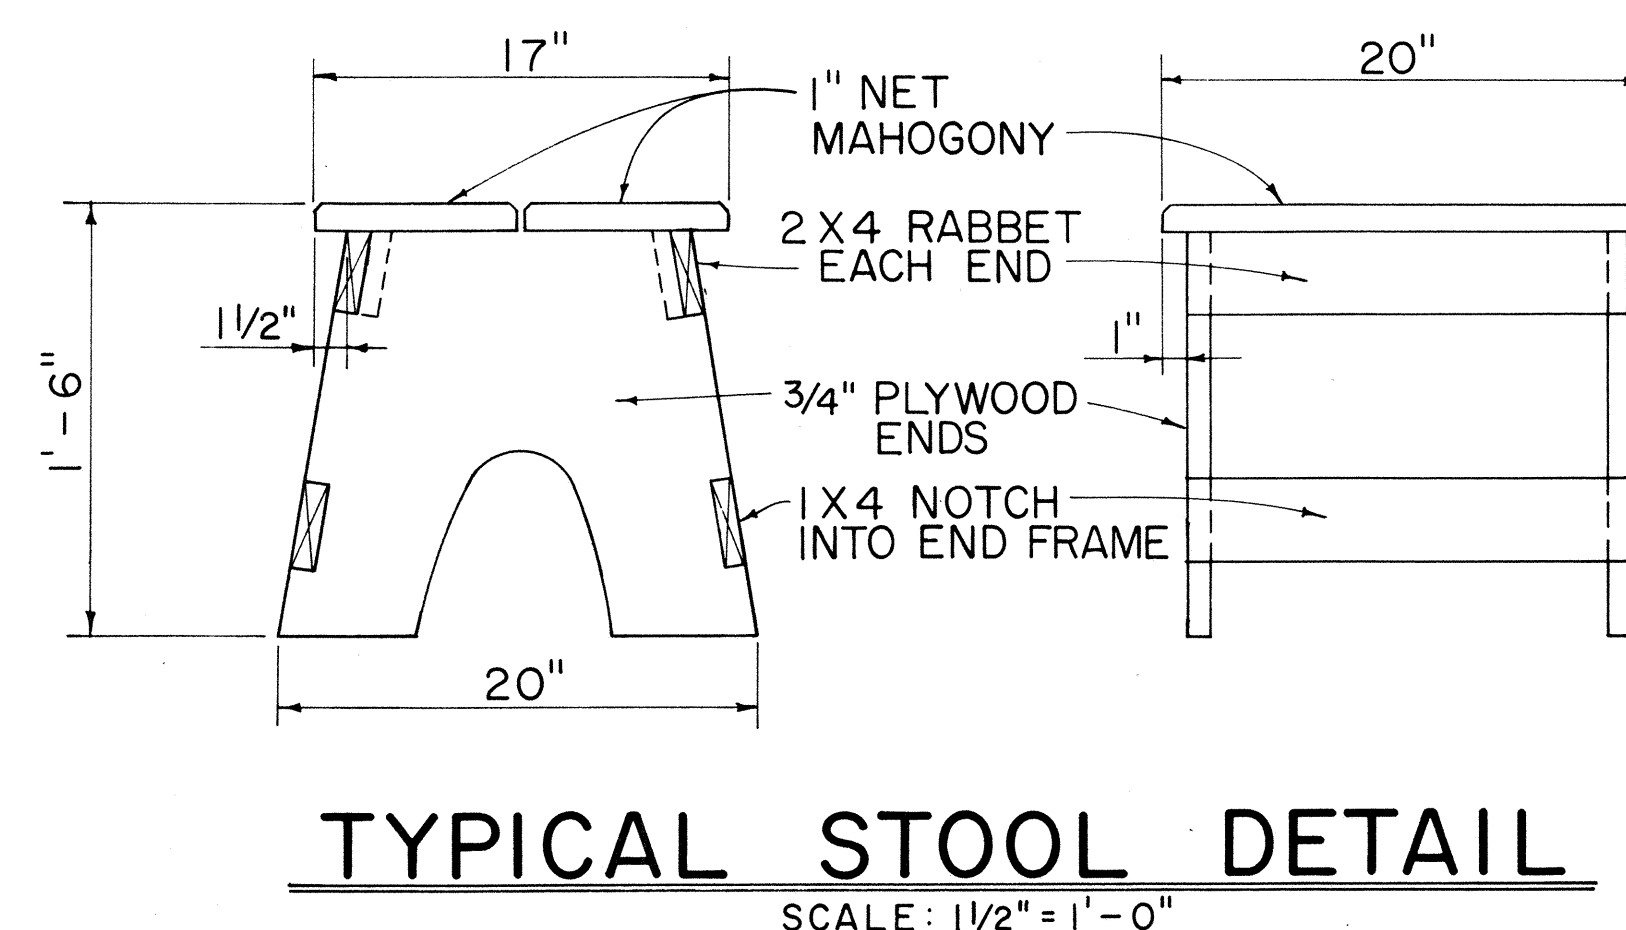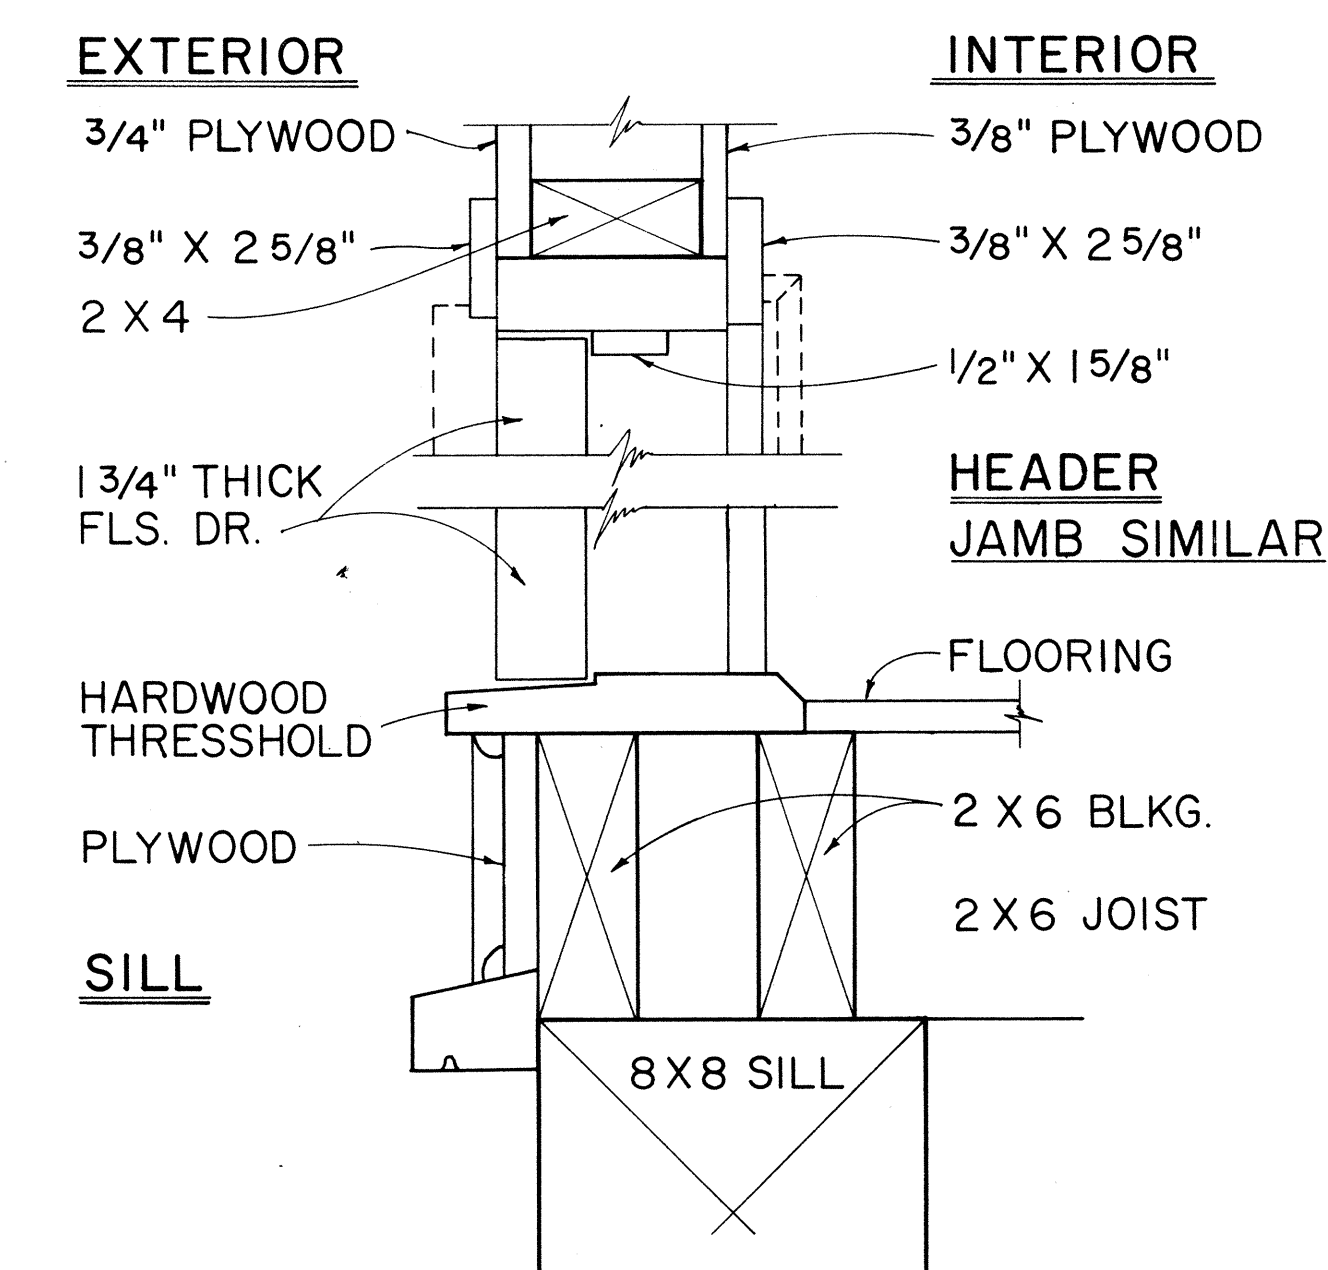

NOTE: CONTRACTOR MAY WITH THE APPROVAL OF THE ENGINEER
FURNISH THE FIELD OFFICE OR PROJECT SITE LABORATORY
WITH STOOLS OTHER THAN THE TYPE SHOWN IN THE
DETAIL.

APPROVAL RECOMMENDED:
M. H. Jones 12-4-69
 HIGHWAY DESIGN ENGINEER DATE

APPROVED: 24/10/2012 12-10-5
ASSISTANT CHIEF, ENGINEERING DATE




NO.	REVISION	APPROVED BY	DATE

STATE OF HAWAII
DEPARTMENT OF TRANSPORTATION
LAND TRANSPORTATION FACILITIES DIVISION








FIELD OFFICE
&
PROJECT SITE LABORATORY

Scale: As Noted


FED. ROAD DIST. NO.	STATE	FED. AID PROJ. NO.	FISCAL YEAR	SHEET NO.	TOTAL SHEETS
HAWAII	HAW.	1-41-1(12)	1977	52	394

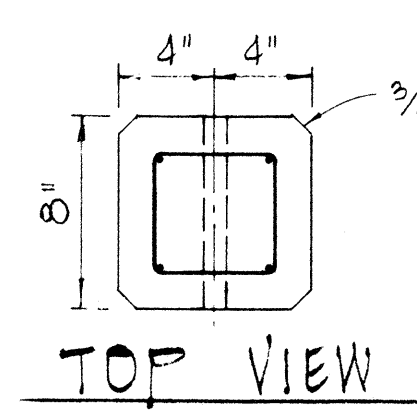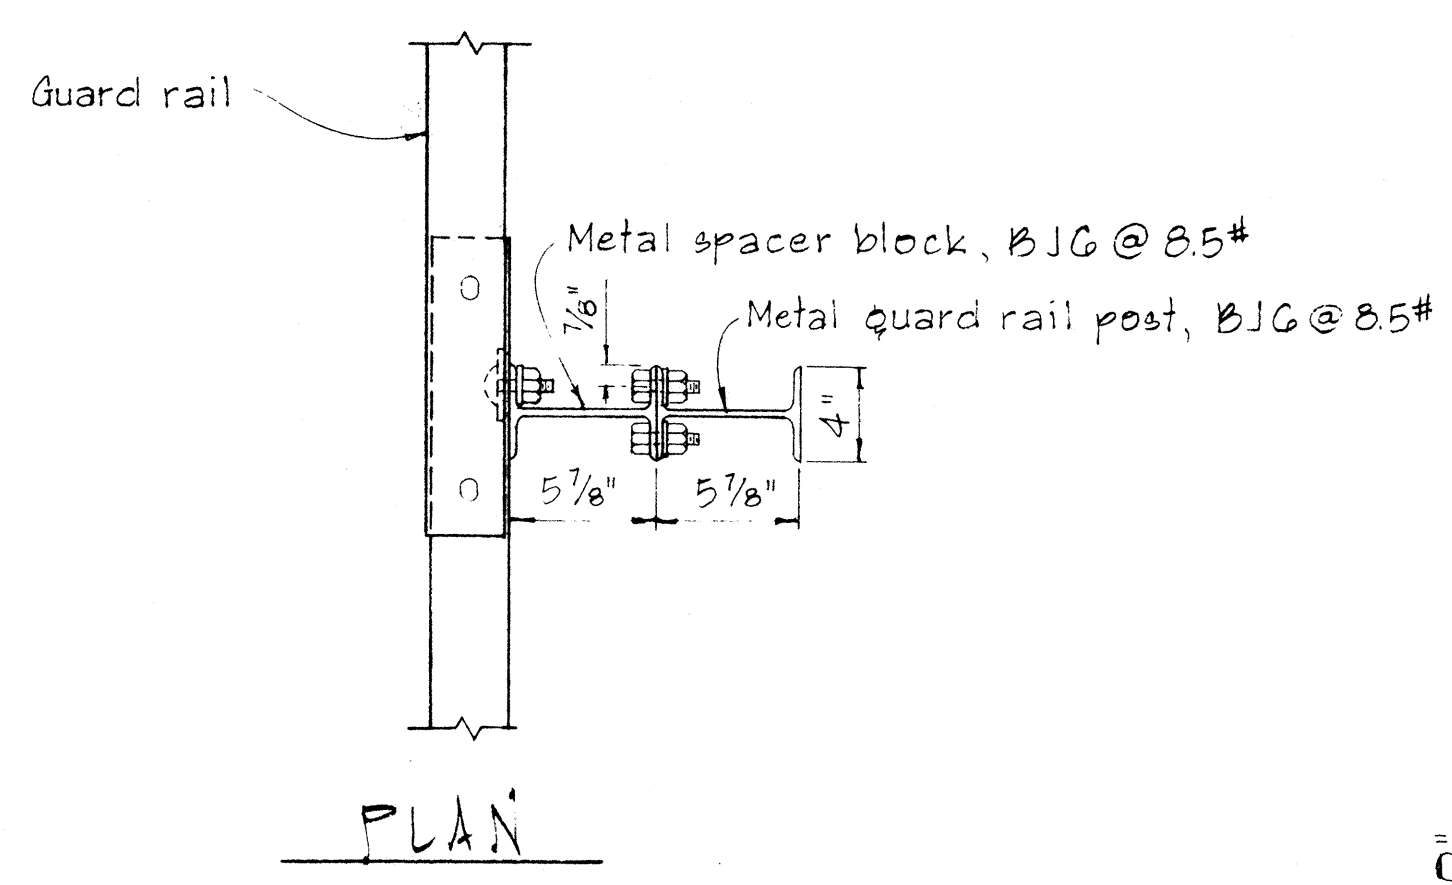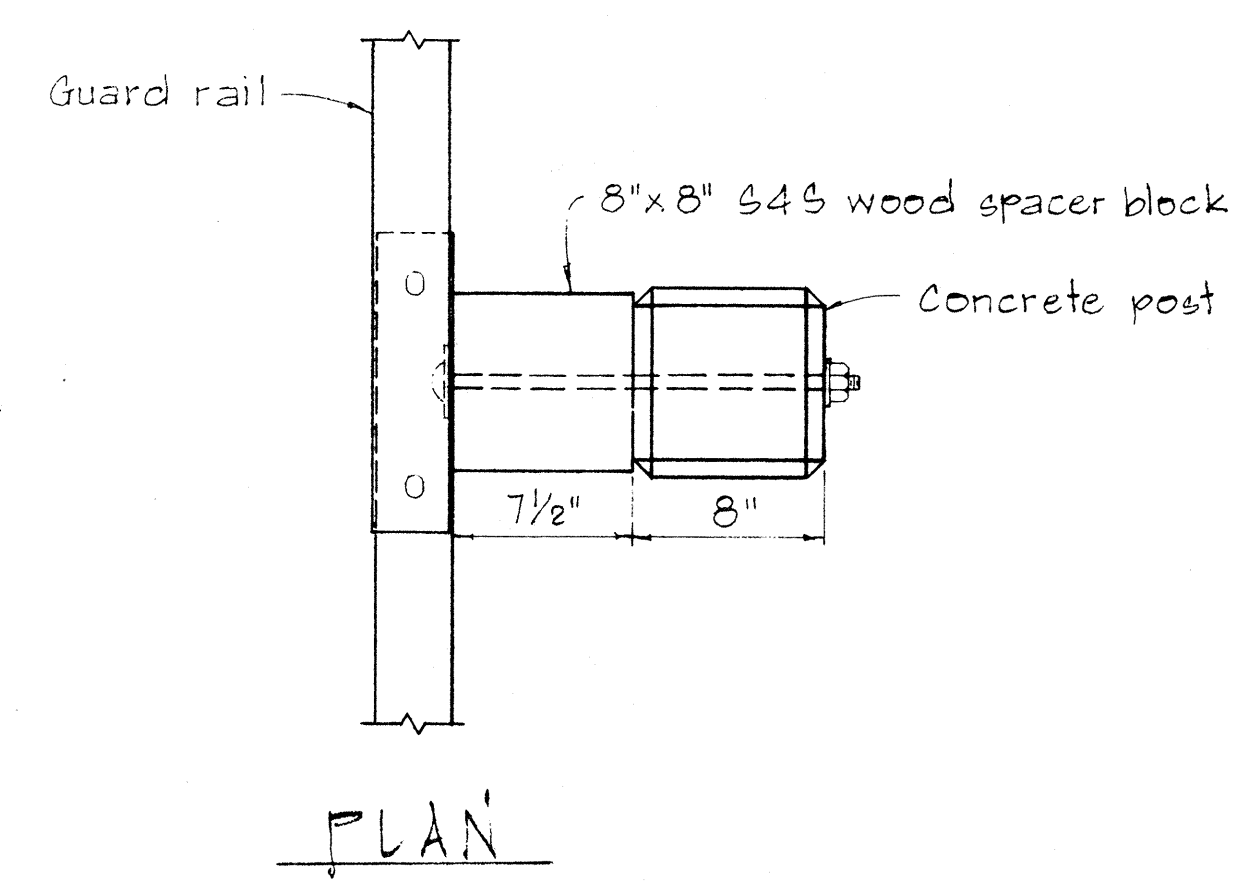


NOTE:
Concrete post shall be precast

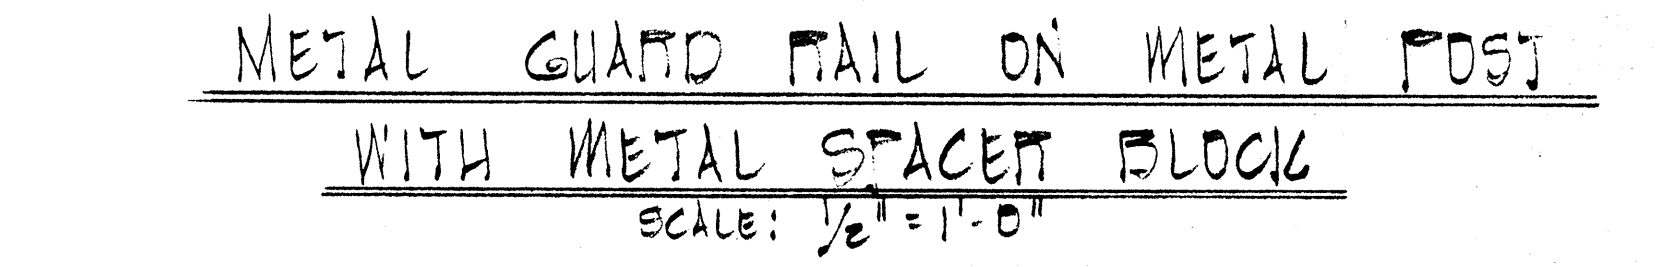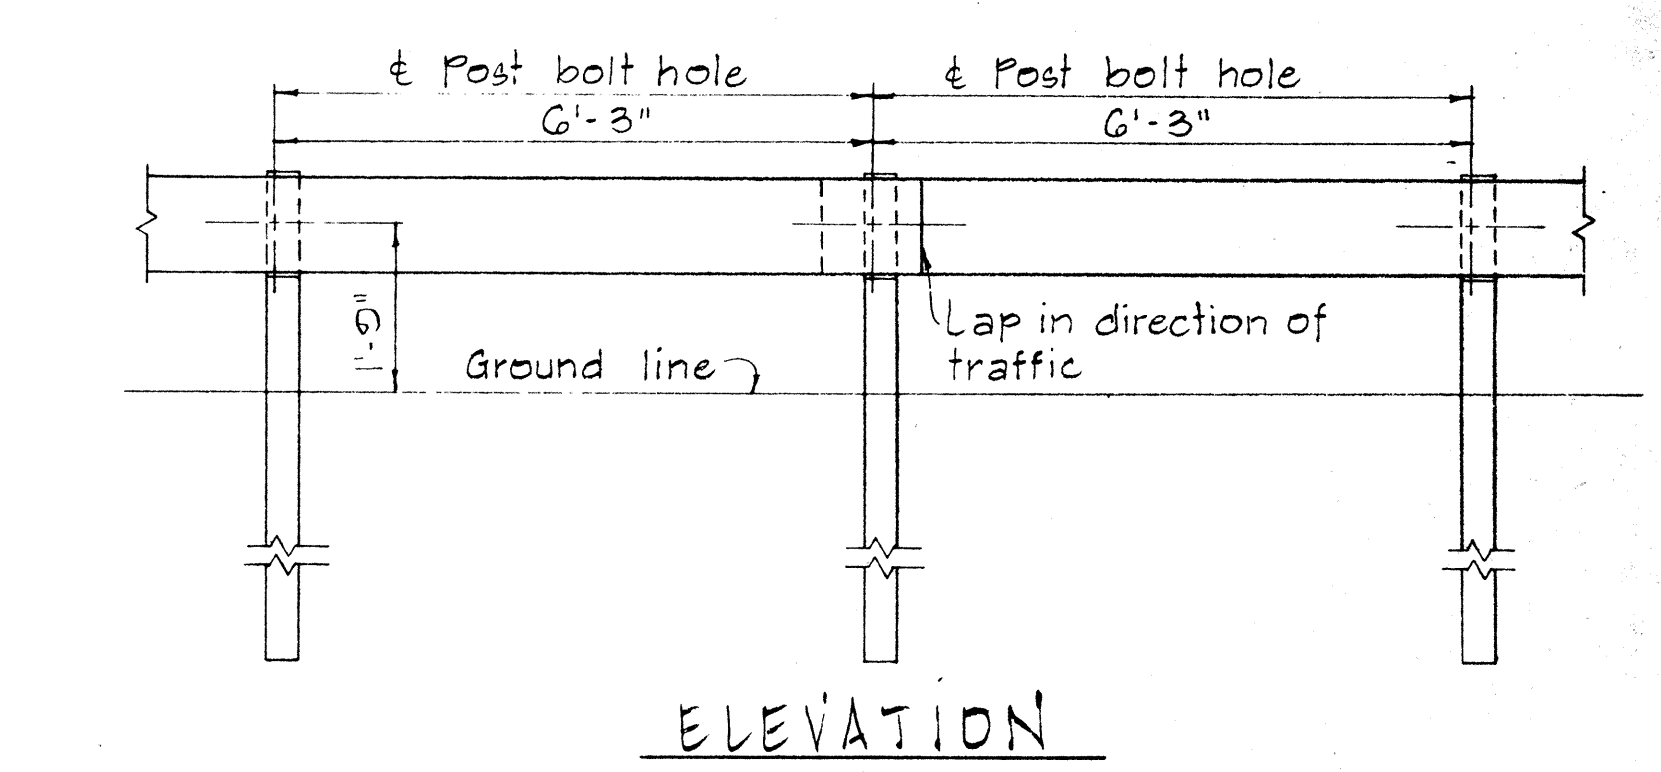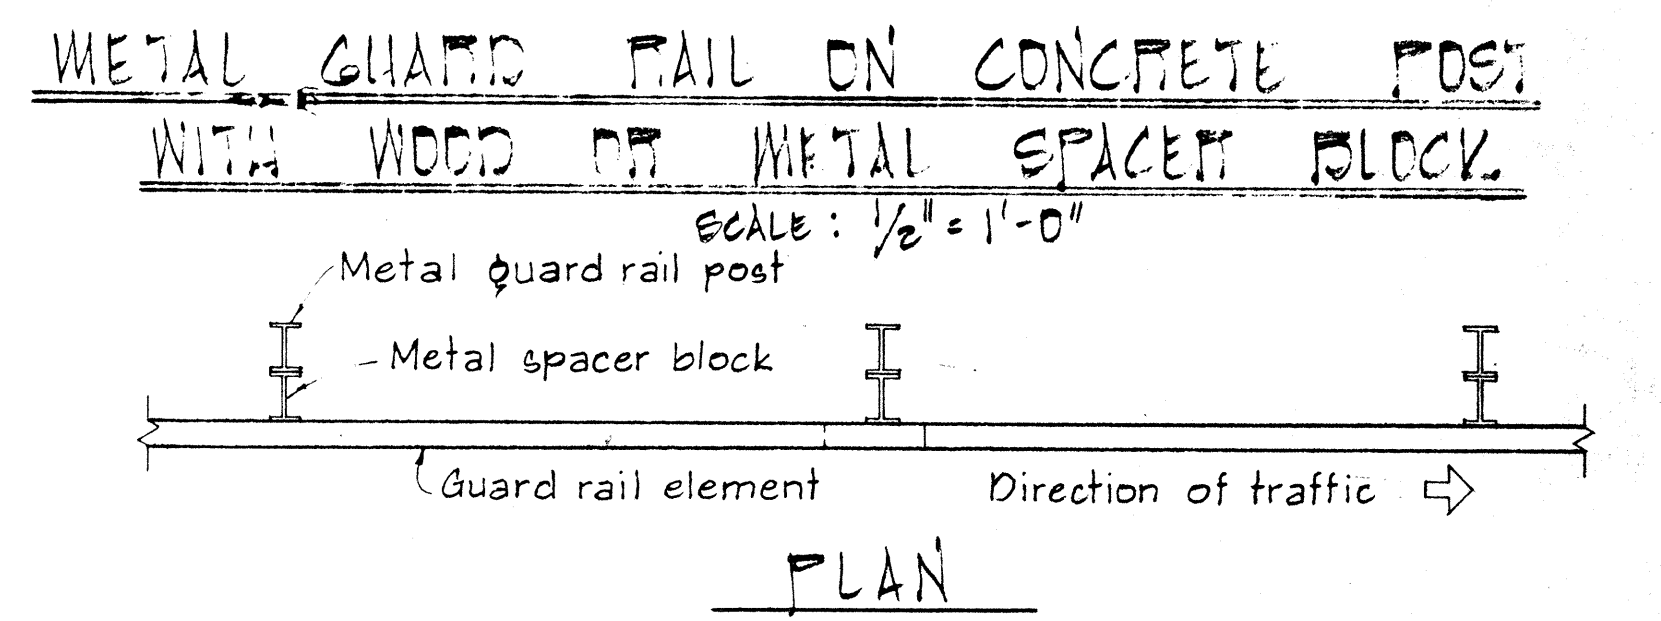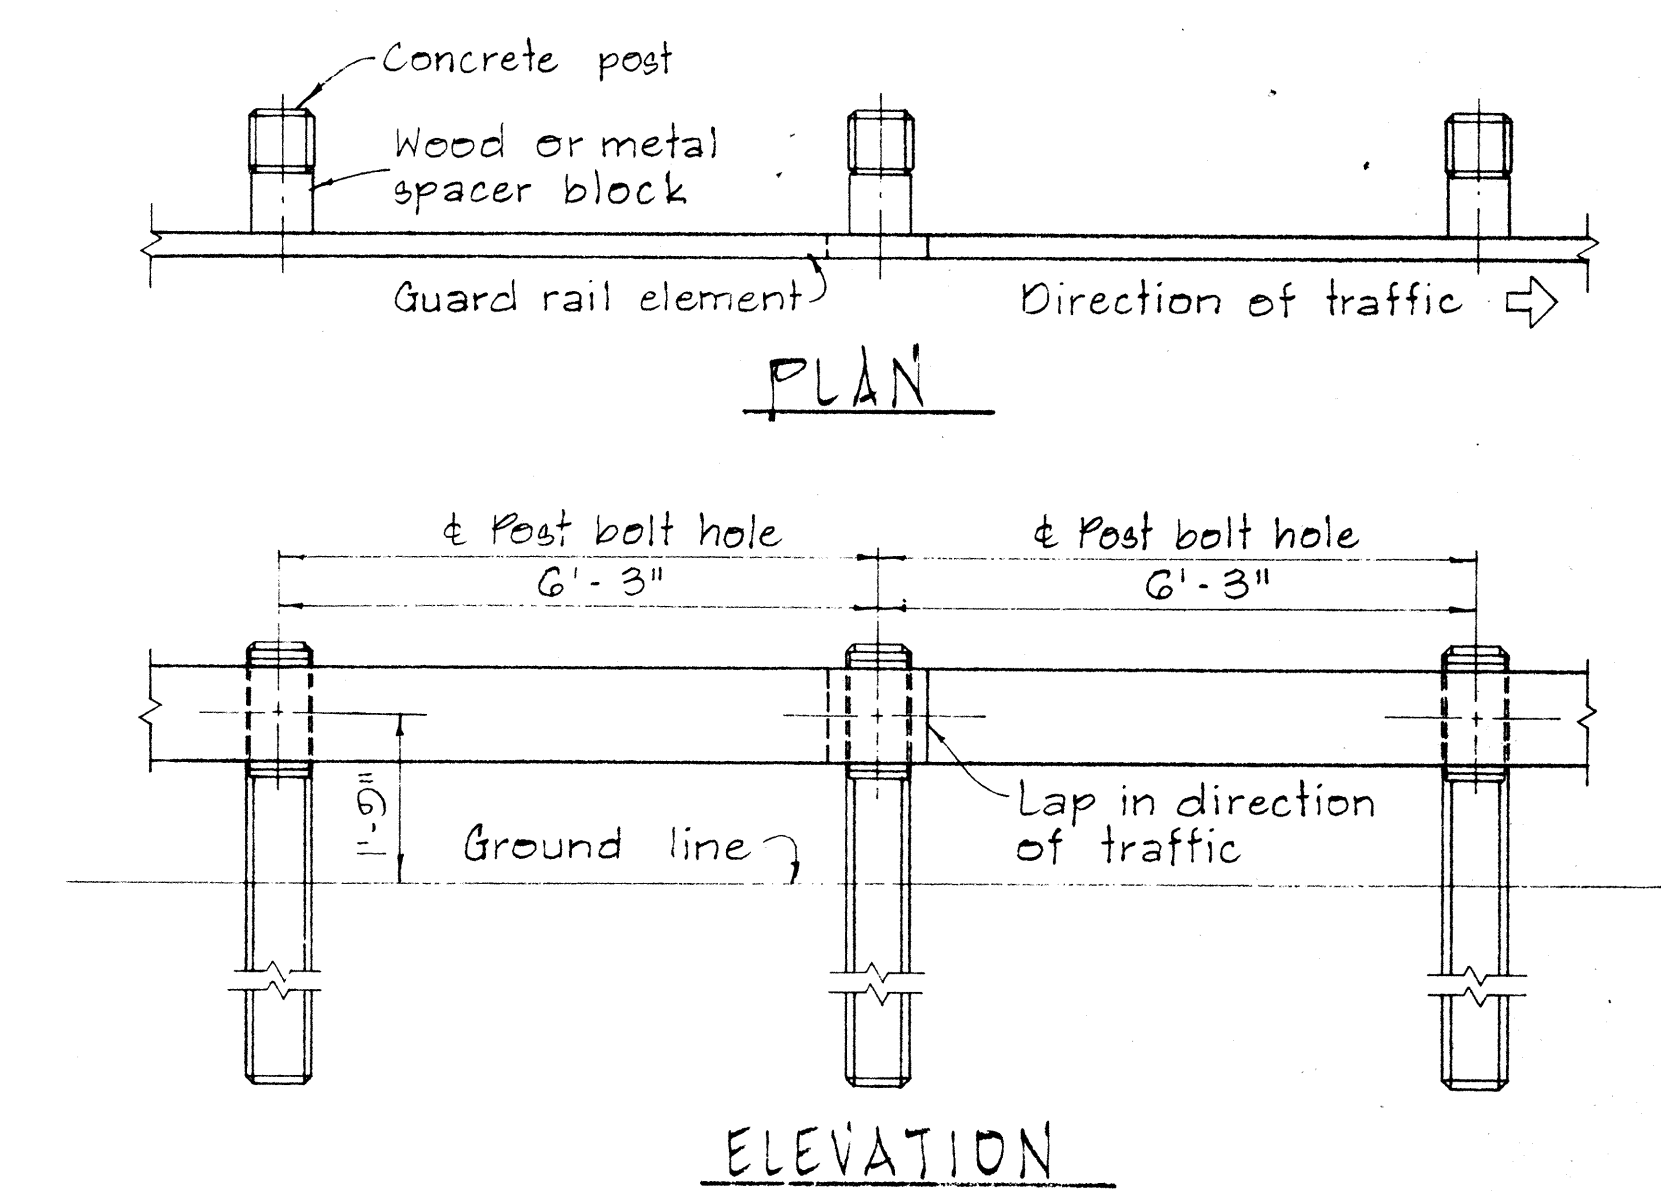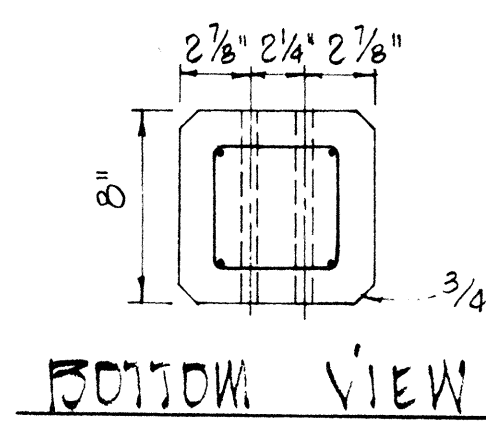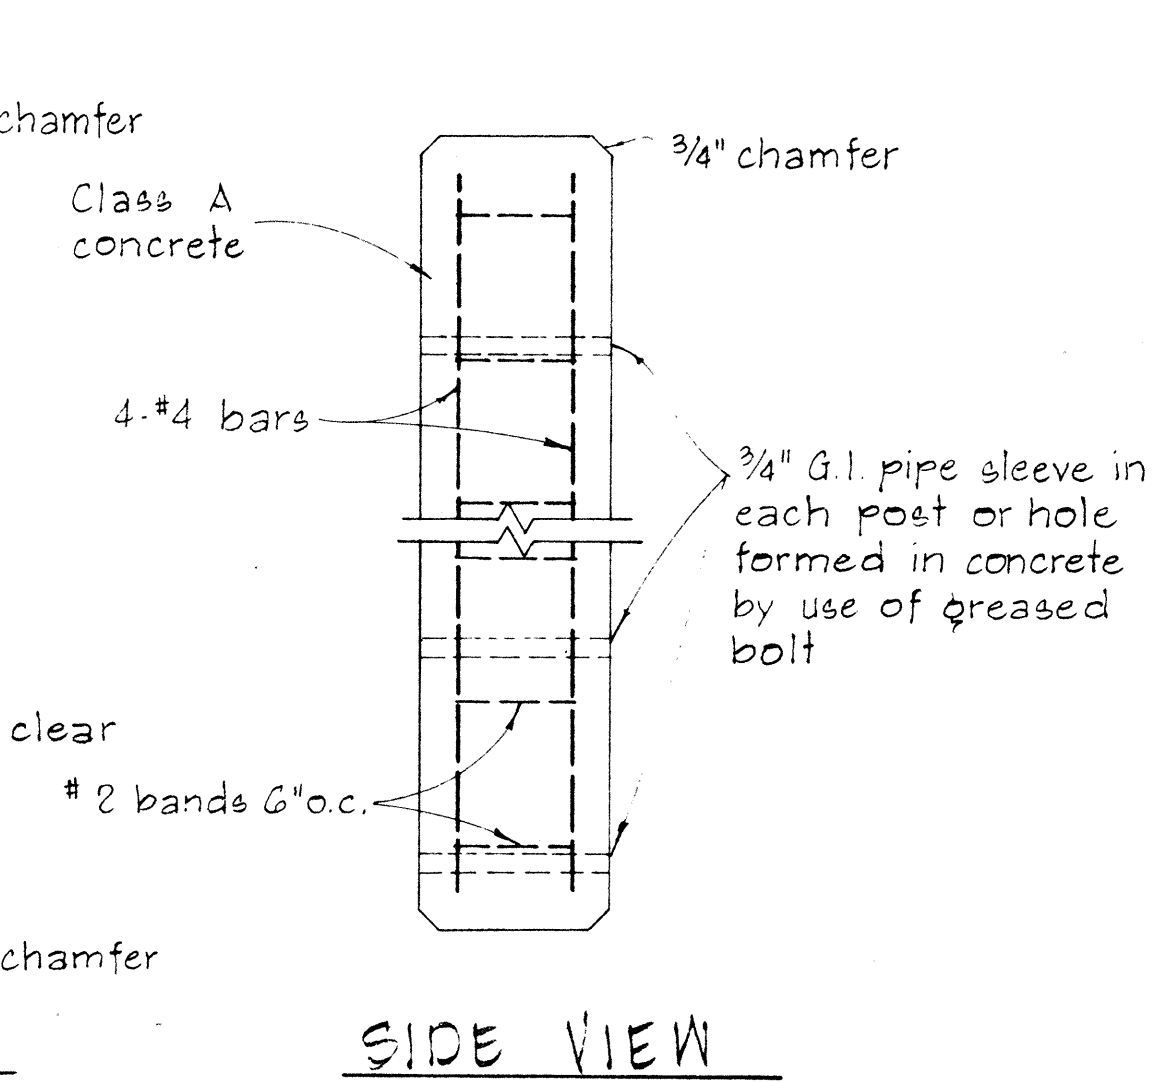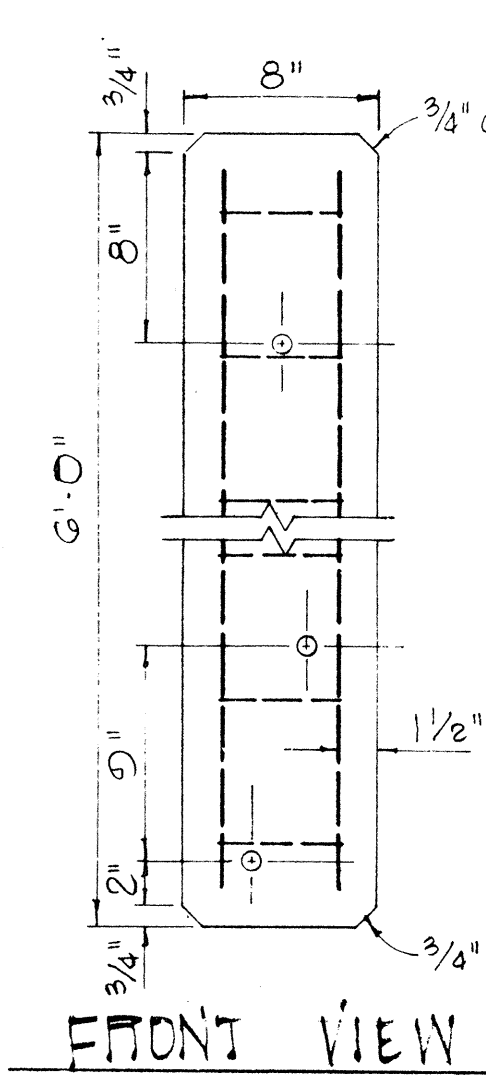


DETAIL OF CONCRETE POST
SCALE: 1 1/2" = 1'-0"

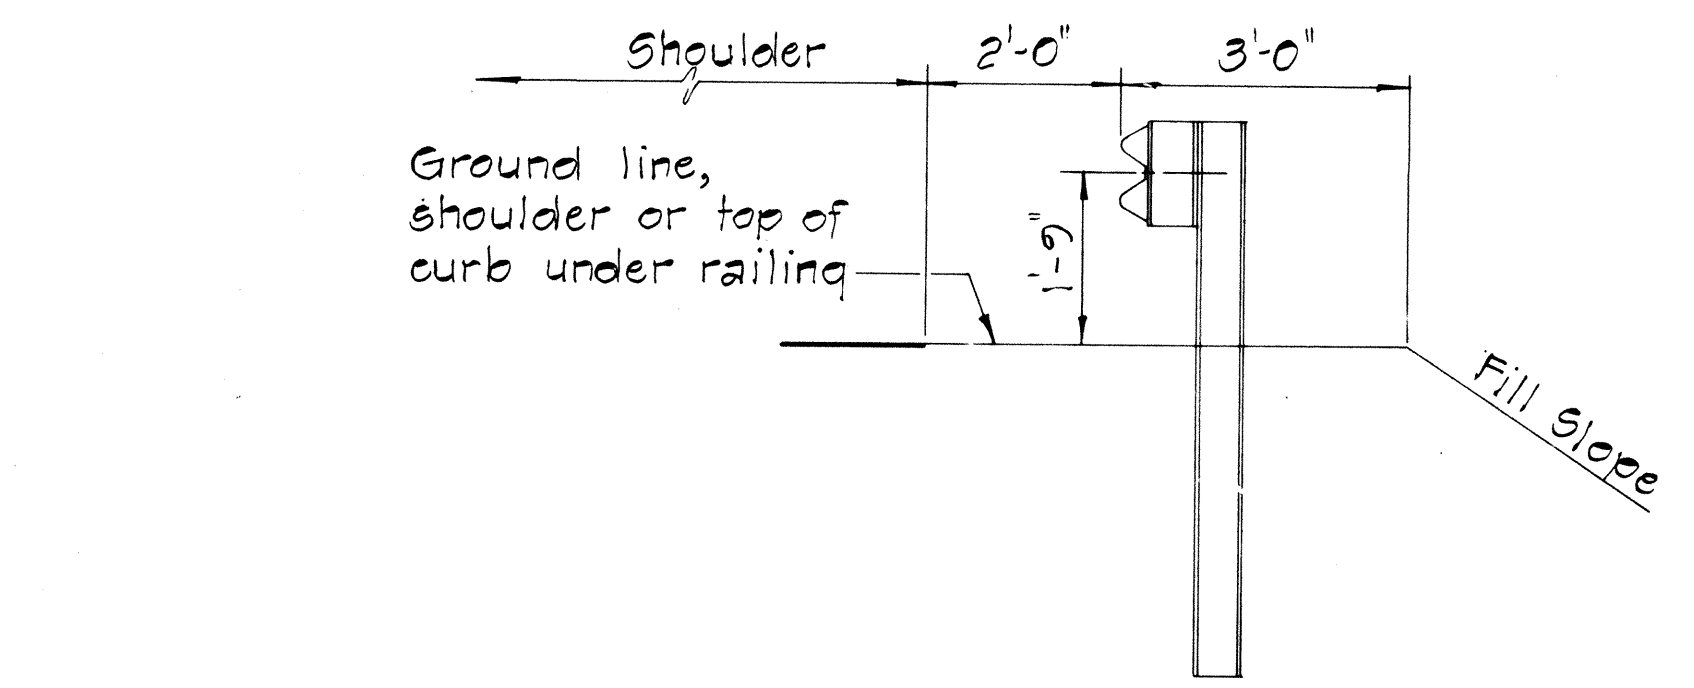

TYPICAL METAL GUARD RAIL DETAIL
SCALE: 1/2" = 1'-0"

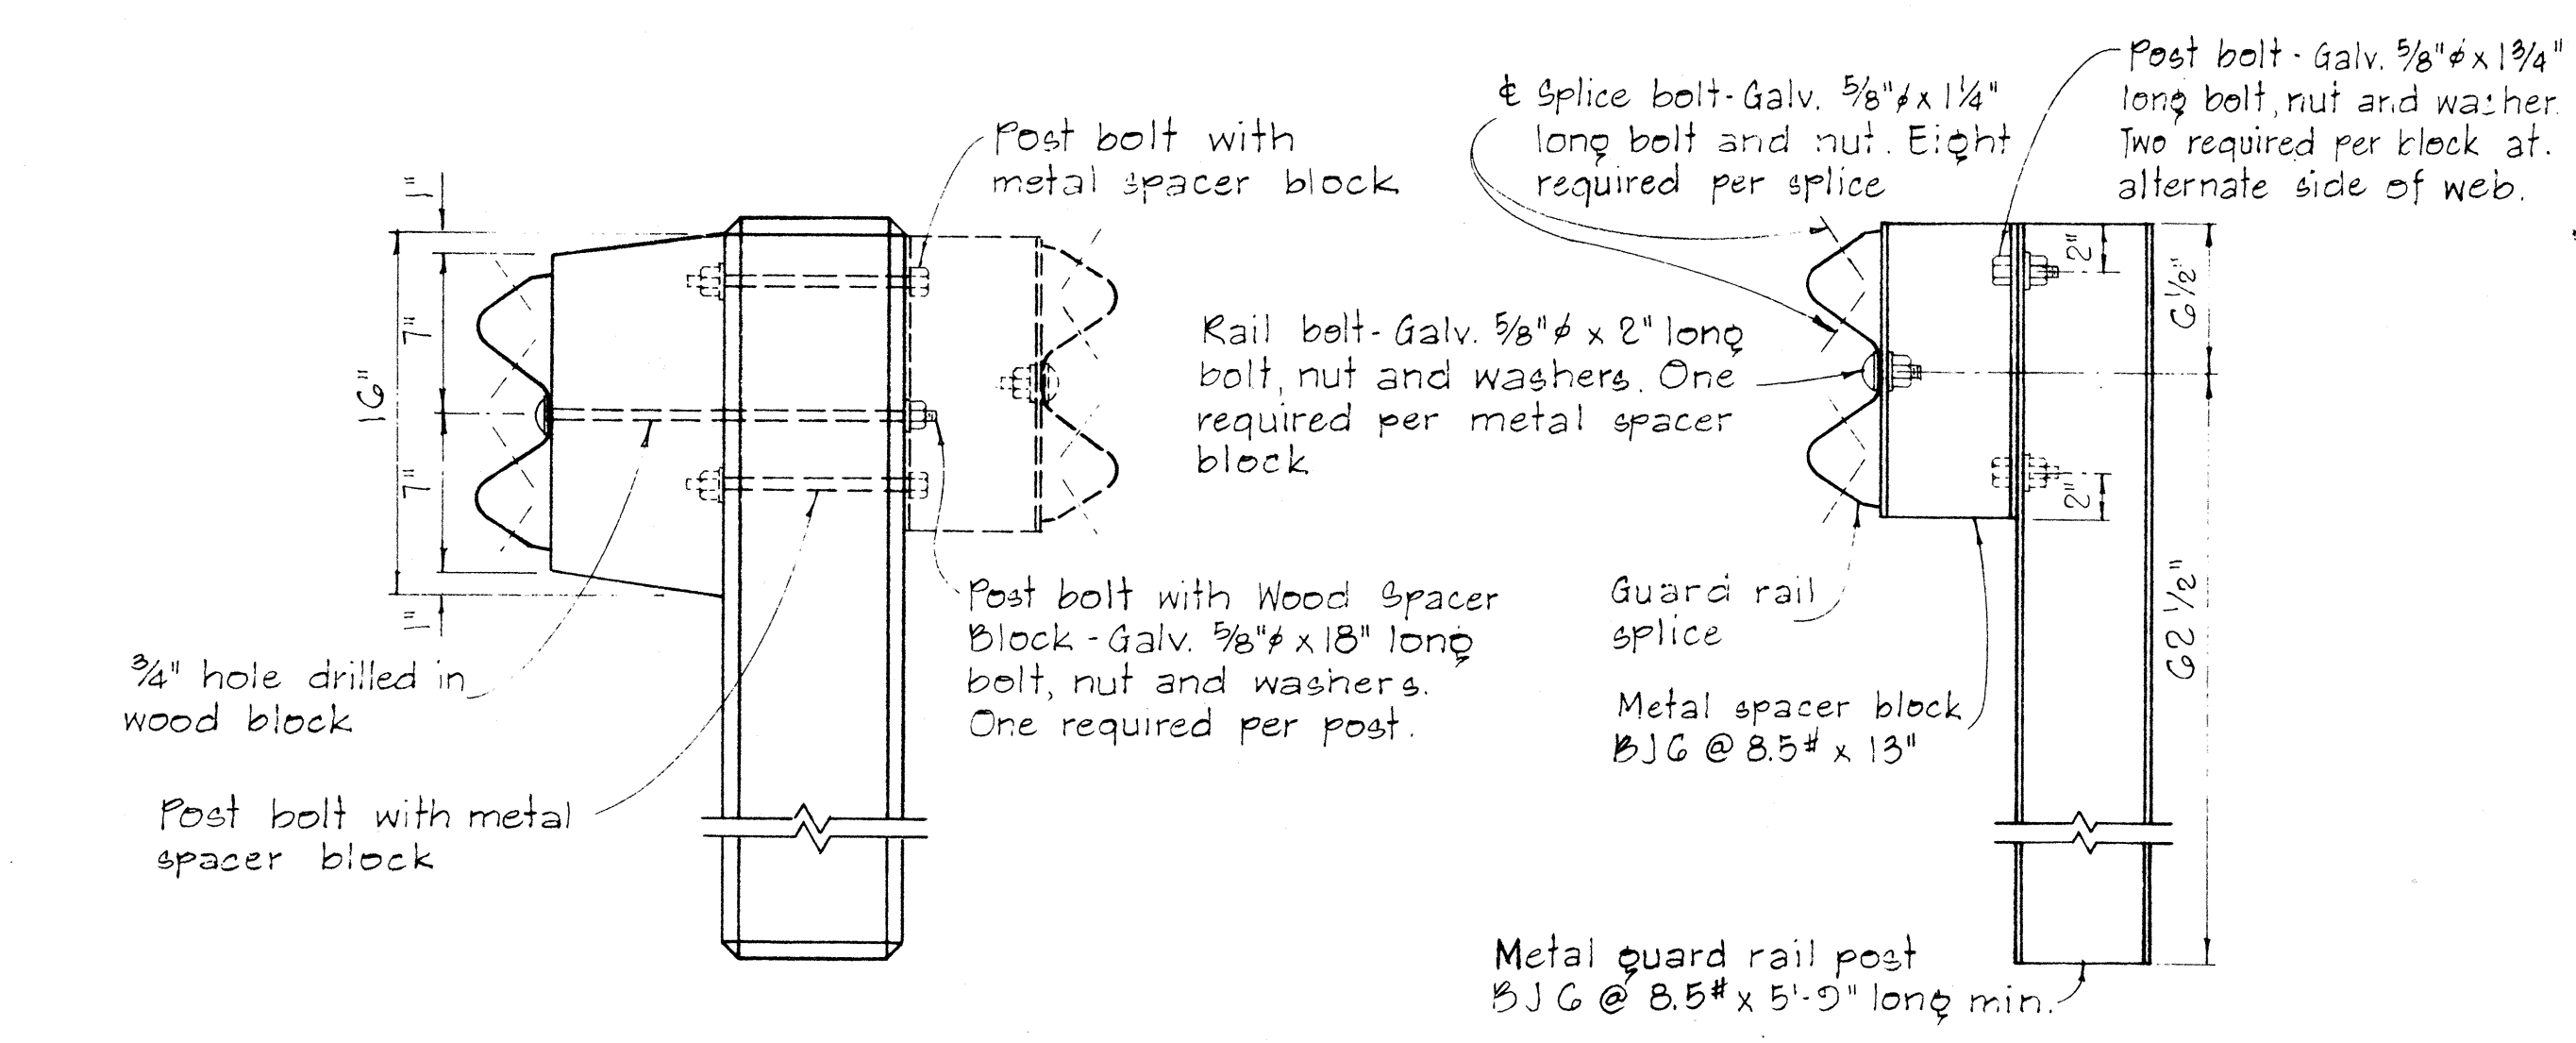

SINGLE METAL GUARD RAIL ON METAL POST WITH METAL SPACER BLOCK
SCALE: 1 1/2" = 1'-0"

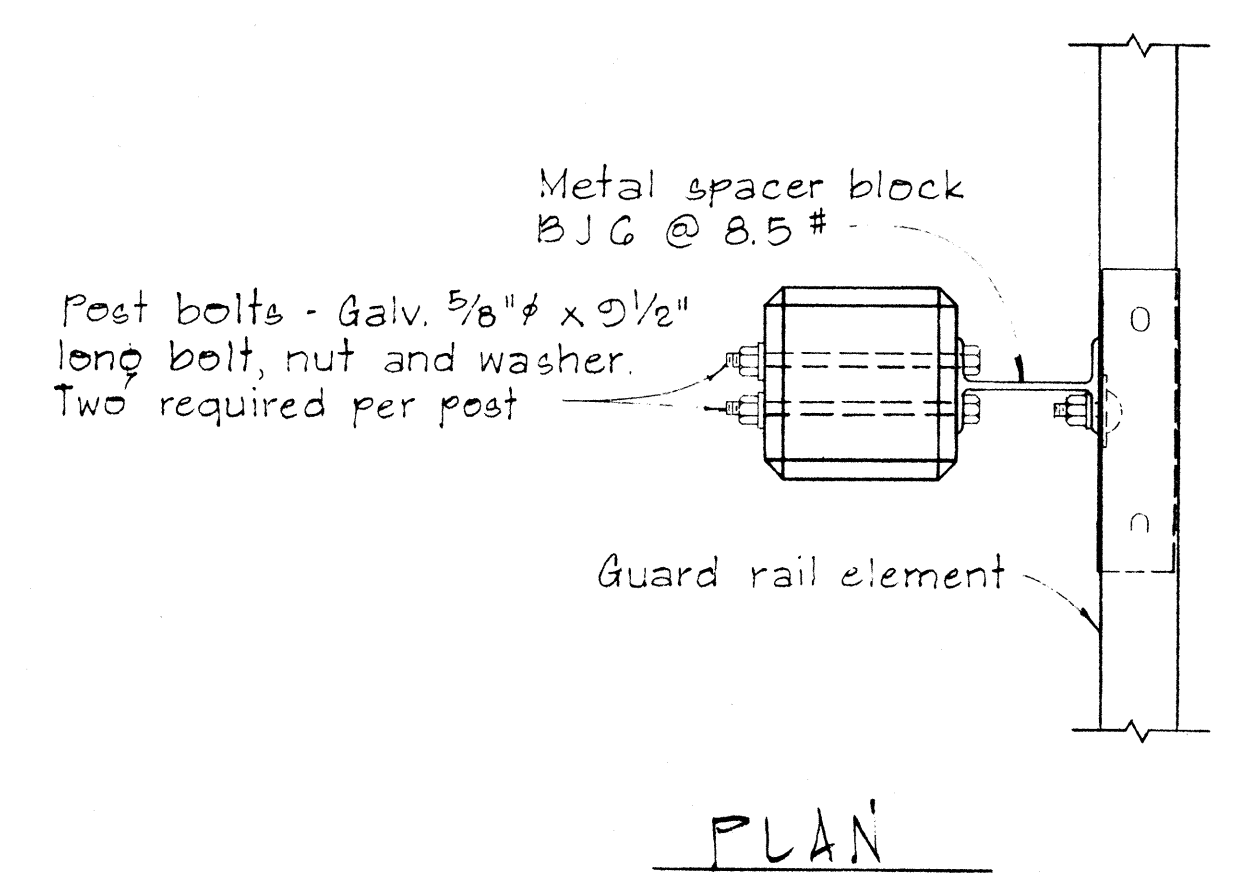

SINGLE METAL GUARD RAIL ON PRECAST CONCRETE POST WITH WOOD OR METAL SPACER BLOCK
SCALE: 1 1/2" = 1'-0"

APPROVAL RECOMMENDED:
Erich Tanaka
TRAFFIC ENGINEER
12/29/62
DATE

APPROVED:
Hubert J. Delia
ASSISTANT CHIEF, ENGINEERING
12-30-69
DATE

NO.	REVISION	APPROVED BY	DATE



STATE OF HAWAII
DEPARTMENT OF TRANSPORTATION
LAND TRANSPORTATION FACILITIES DIVISION

STANDARD DETAILS
METAL GUARD RAIL
SCALE: AS SHOWN
NOV. 1968

SHEET No. 15 OF 26 SHEETS

DATE	
DESIGNED BY	
CHECKED BY	
NOTED BY	



FED. ROAD DIST. NO.	STATE	FED. AID PROJ. NO.	FISCAL YEAR	SHEET NO.	TOTAL SHEETS
HAWAII	HAW.	1-H-1(13)17	1977	54	394

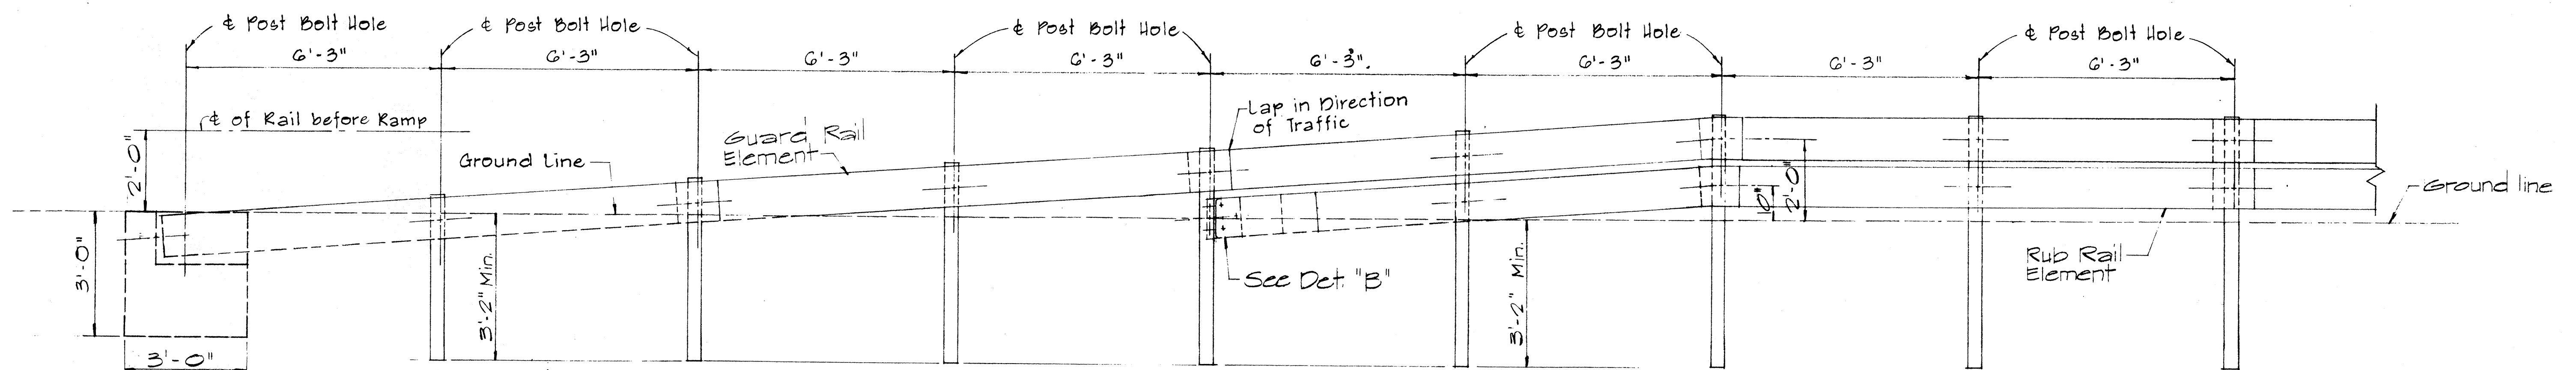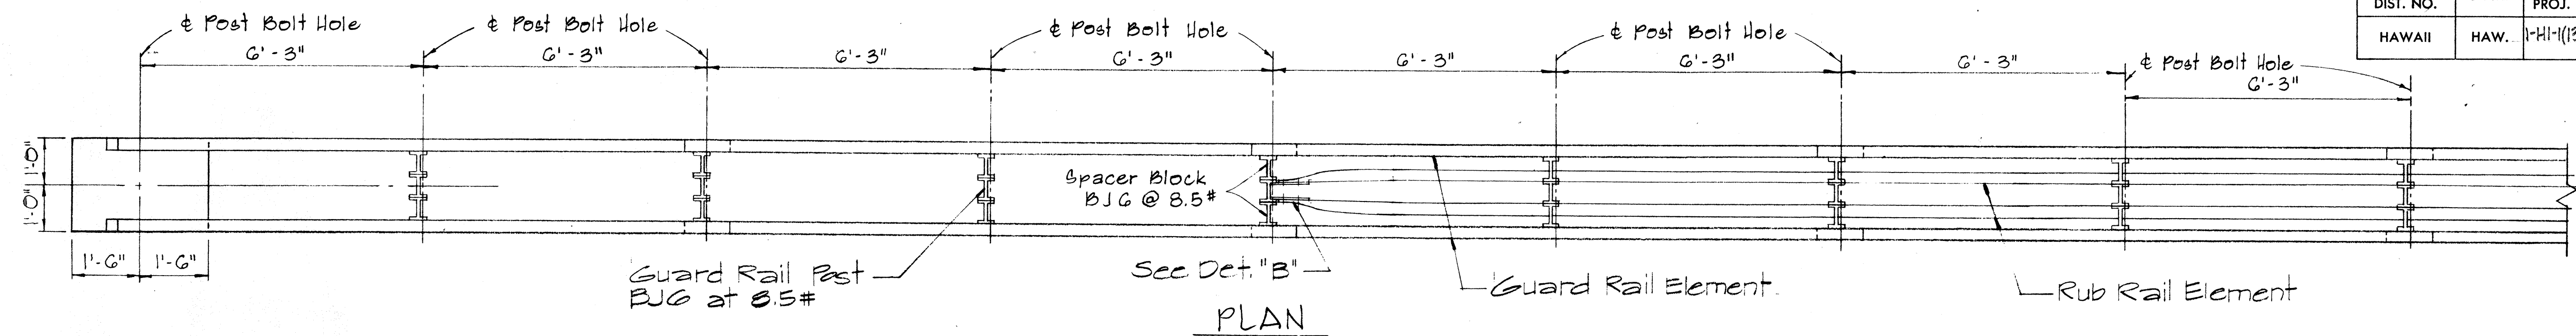

ELEVATION STRAIGHT APPROACH - RAMP END ANCHORAGE (MEDIAN)


Scale: 1/2" = 1'-0"

5/8" Bolts with 3/4" G.I. Pipe Sleeve in each hole. Incidental to Metal Guard Rail. All Metal Pieces shall be Galvanized.

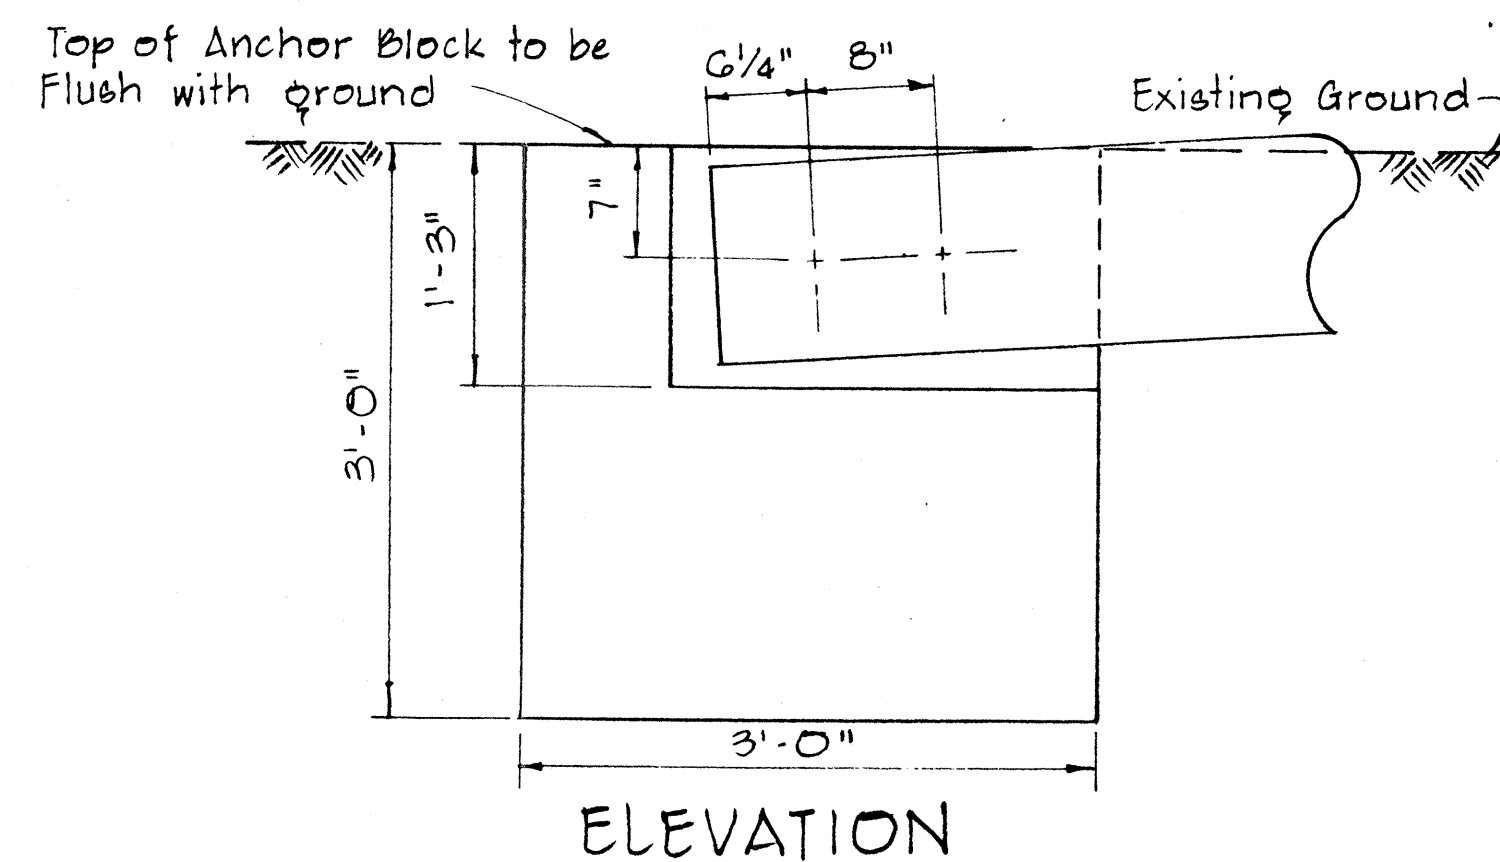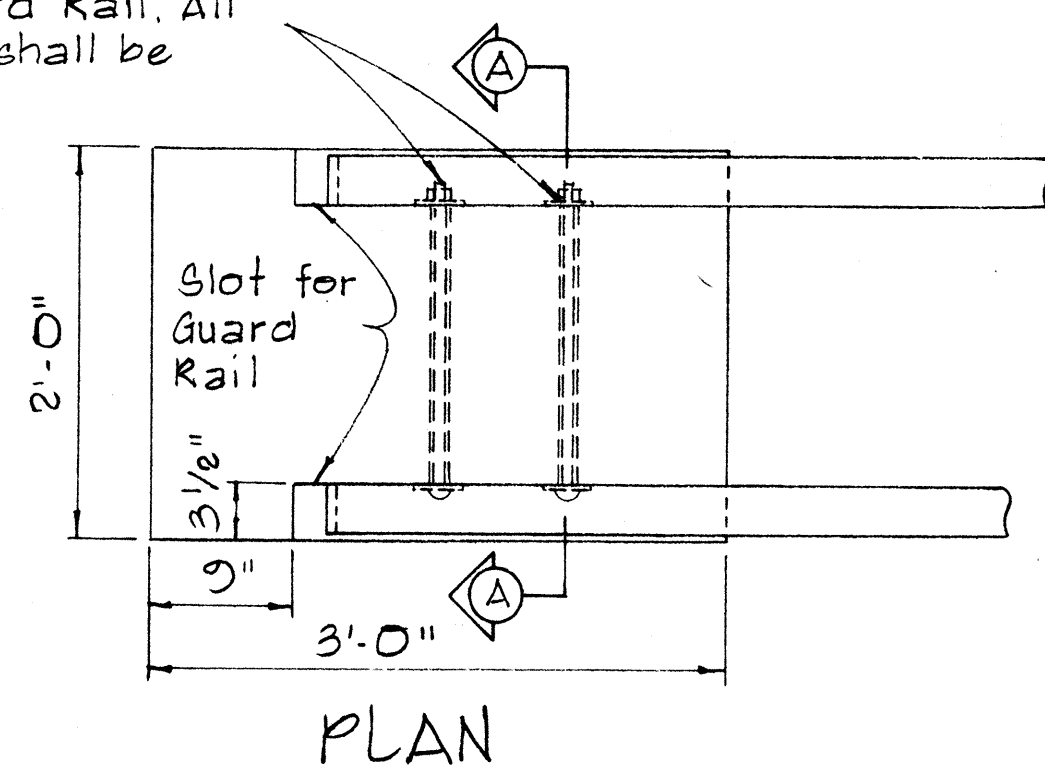


ELEVATION CONCRETE ANCHOR BLOCK FOR RAMP END


Scale: 1" = 1'-0"

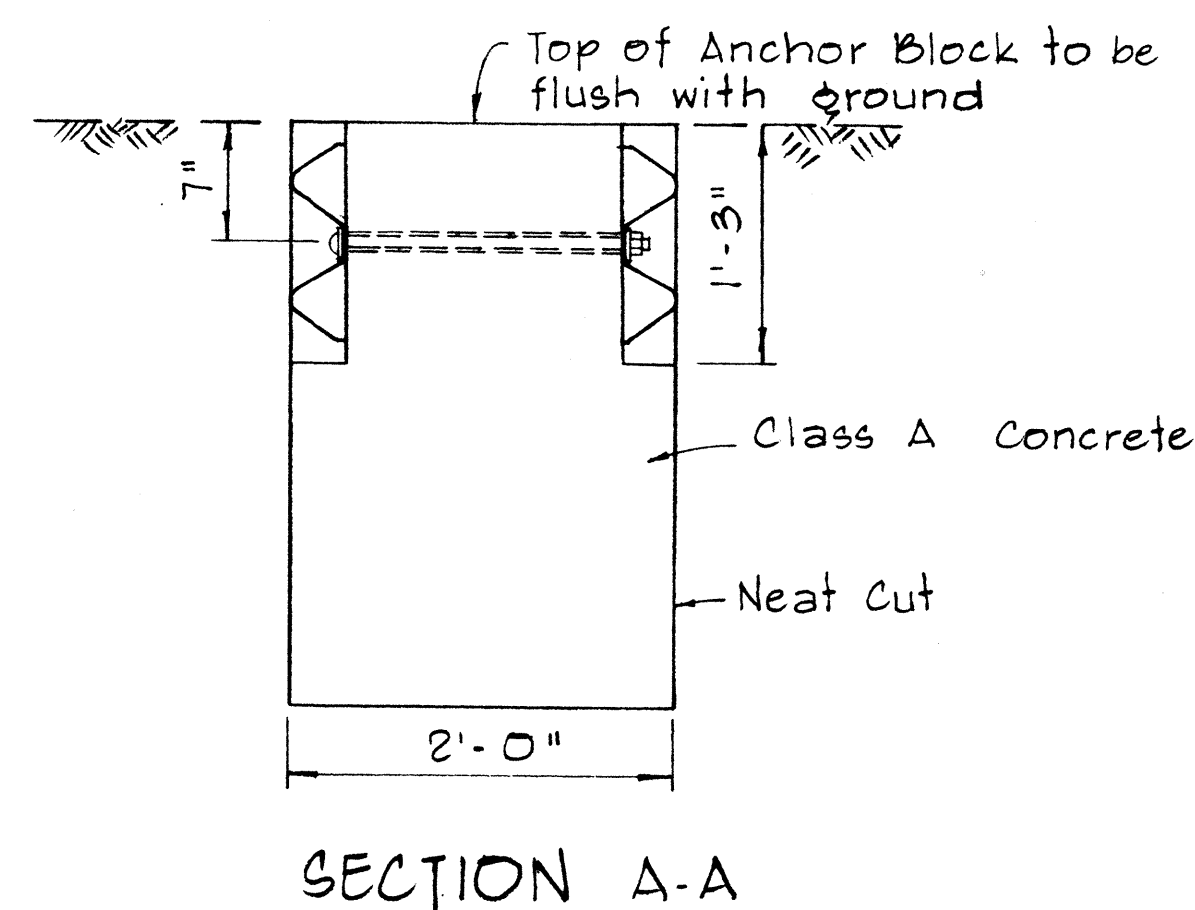

NOTE:
Concrete, Excavation, and Miscellaneous Appurtenances necessary to anchor the Guard Rail Ends, shall be incidental to the Metal Guard Rail.

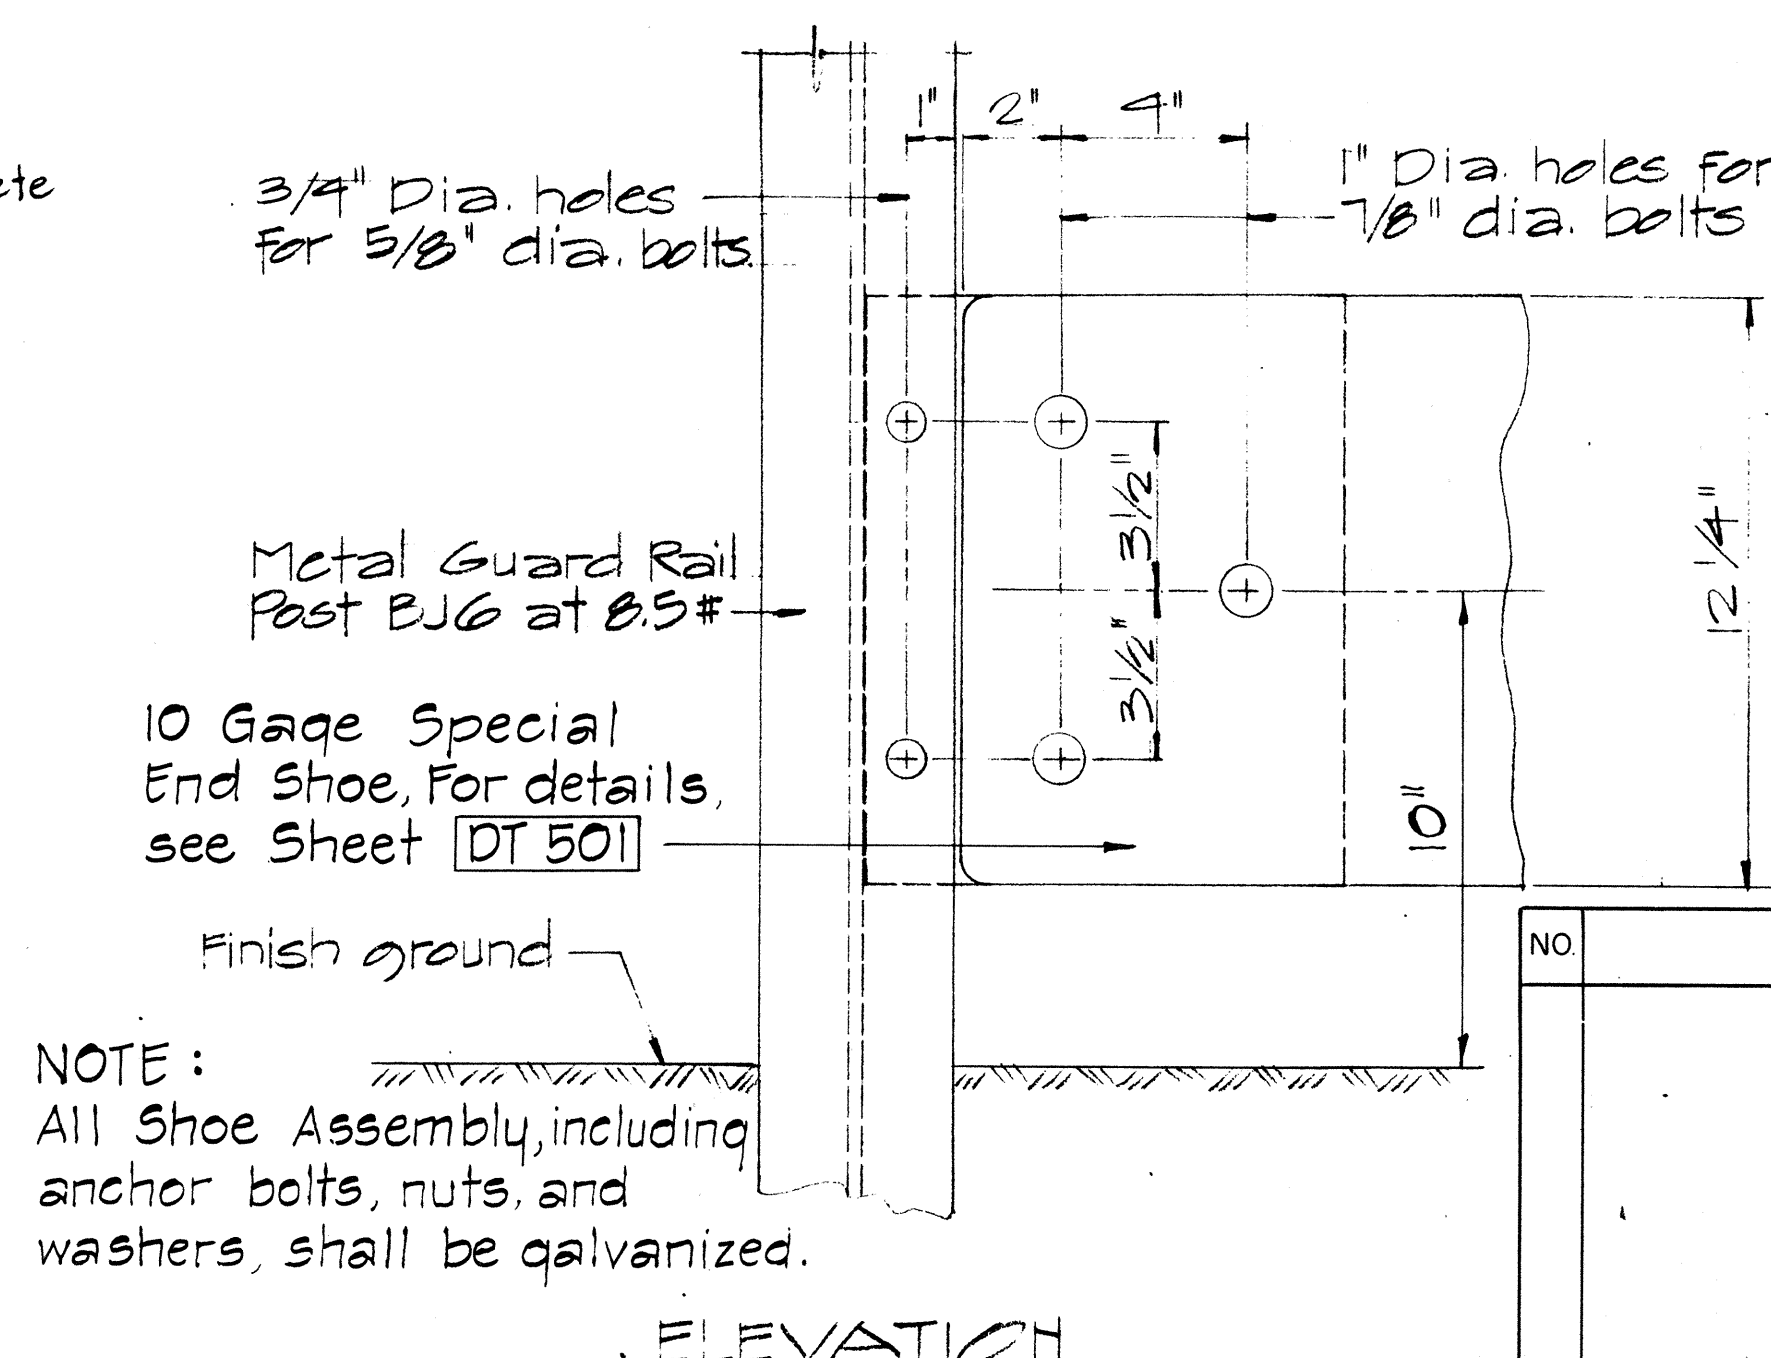

NOTE:
All Shoe Assembly, including anchor bolts, nuts, and washers, shall be galvanized.

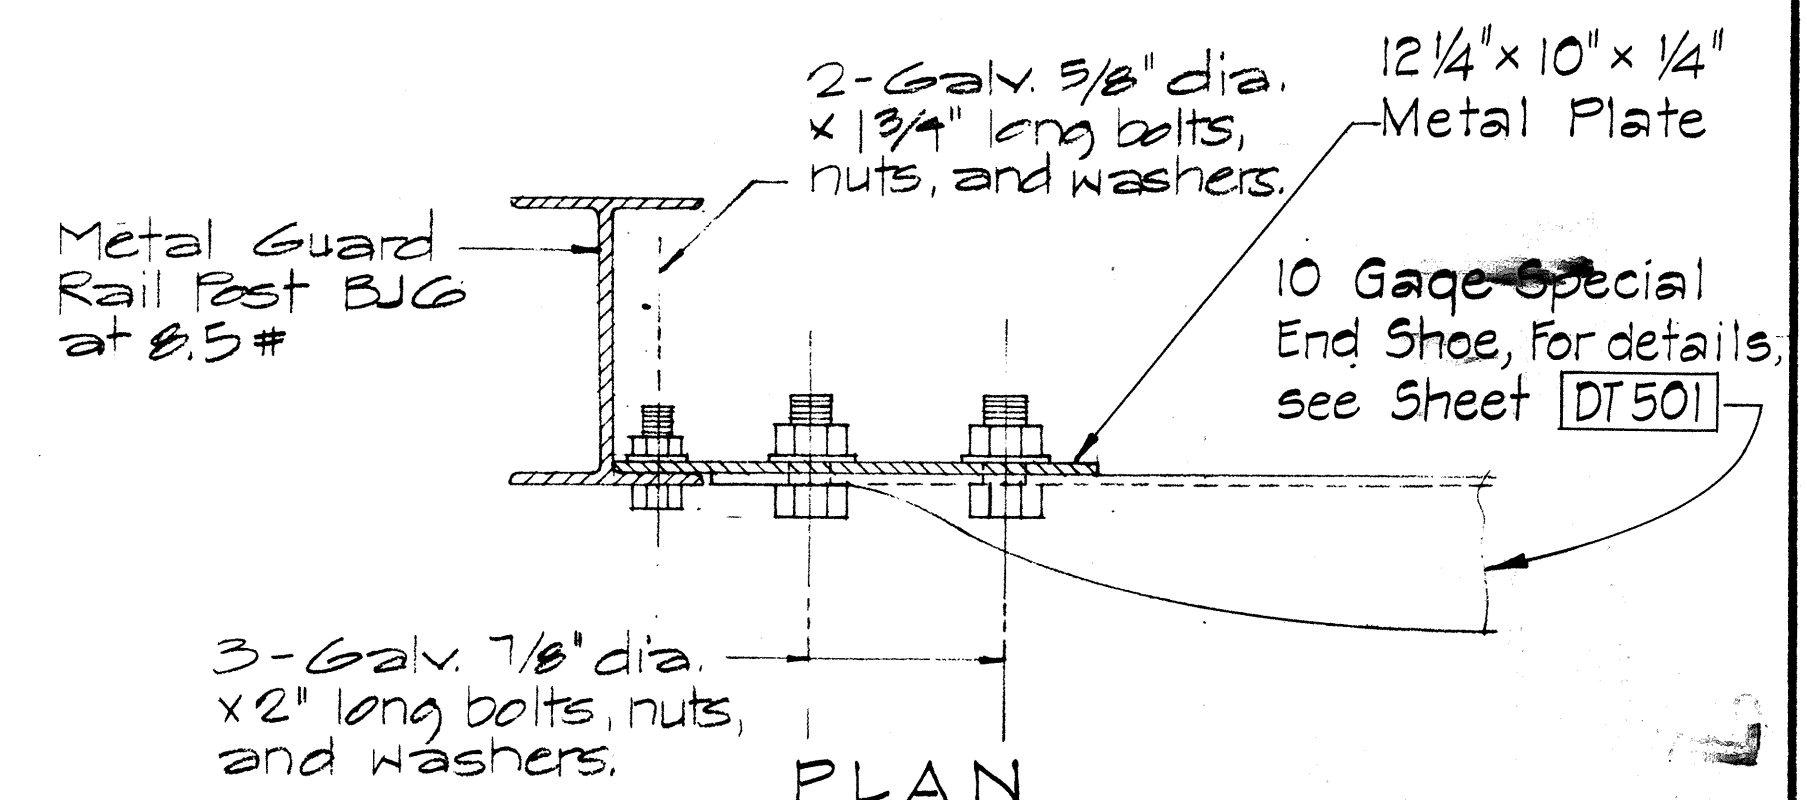

APPROVAL RECOMMENDED:
Eishi Tanaka
TRAFFIC ENGINEER

APPROVED:
M. J. Dela
ASSISTANT CHIEF, ENGINEERING

DATE

12-20-69
DATE



STATE OF HAWAII
DEPARTMENT OF TRANSPORTATION
LAND TRANSPORTATION FACILITIES DIVISION
STANDARD DETAIL
GUARD RAIL
RAMP END ANCHORAGE

Scale: as Noted



August, 1968

SHEET No. 17 OF 26 SHEETS DT 502

FED. ROAD DIST. NO.	STATE	FED. AID PROJ. NO.	FISCAL YEAR	SHEET NO.	TOTAL SHEETS
HAWAII	HAW.	1-H-1(13)17	1977	55	394

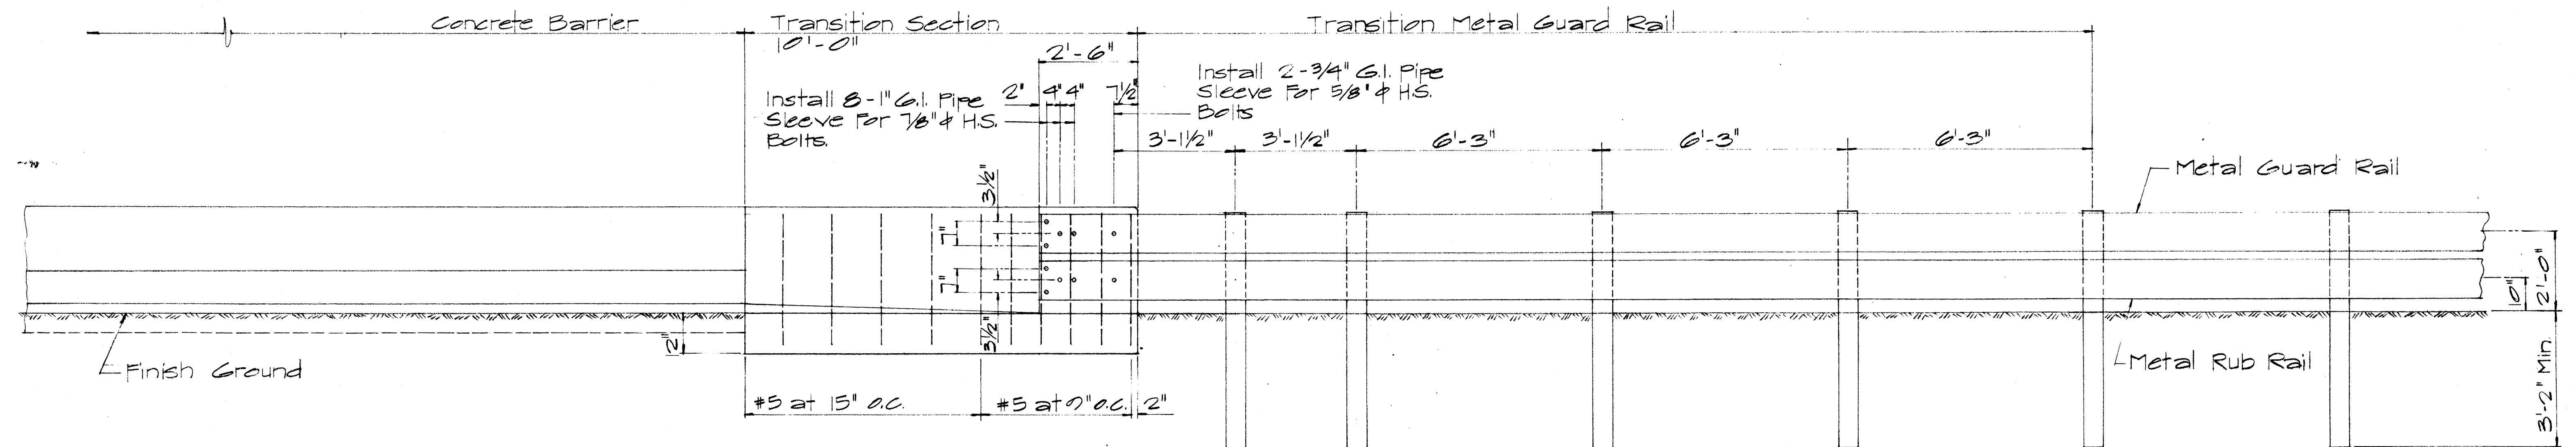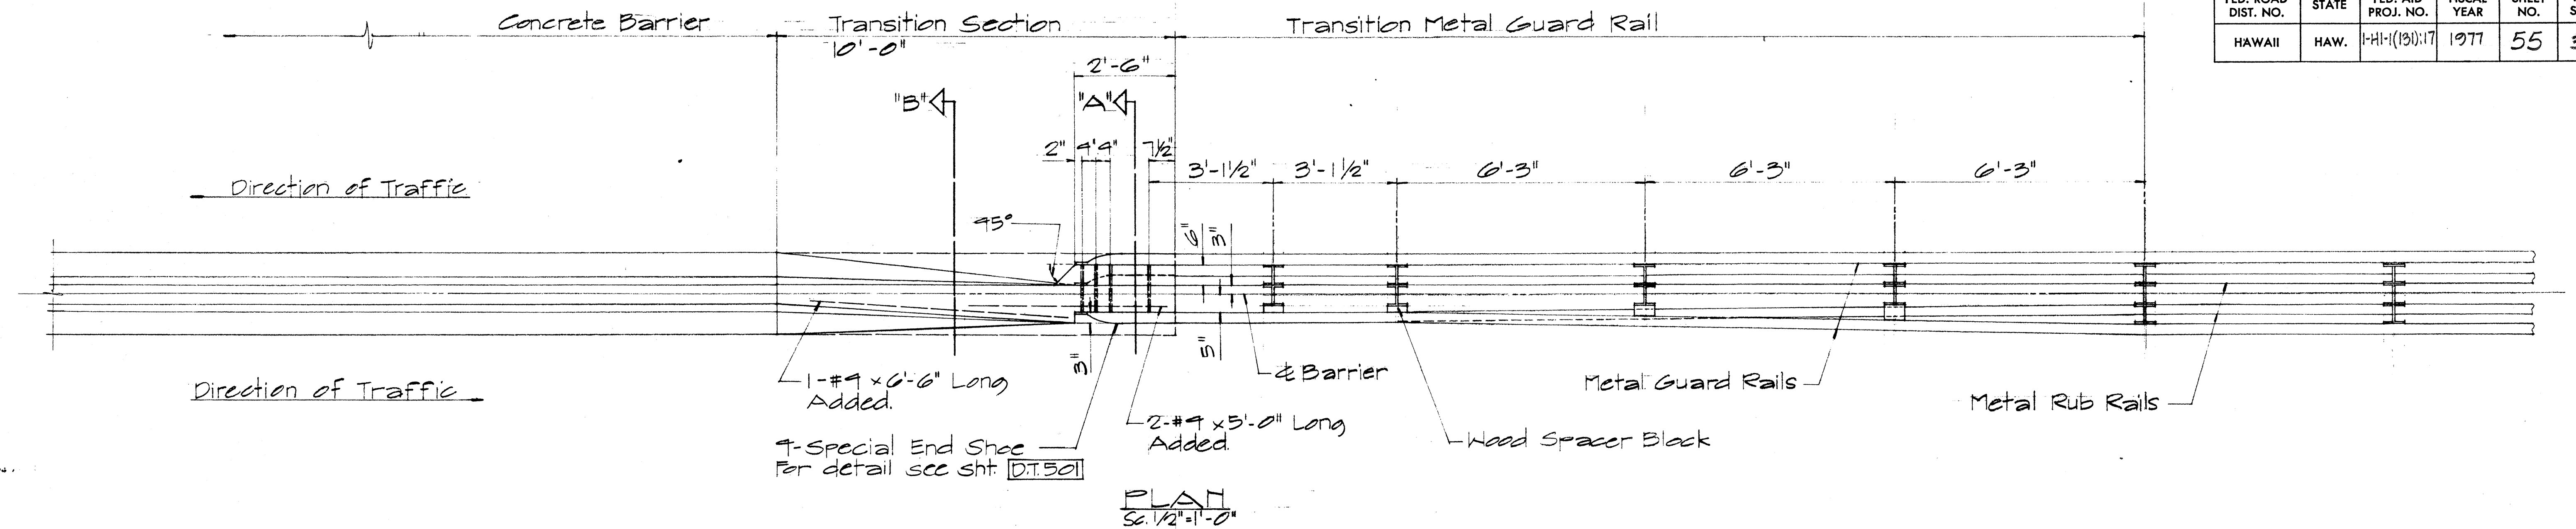

NOTE:
For anchoring metal guard rail elements to concrete barrier, the Contractor shall furnish and install reinforcing steel, bolts of appropriate lengths and size with appurtenant washers, nuts, wooden blocks and pipe sleeves. (Payments shall be incidental to concrete barrier.)

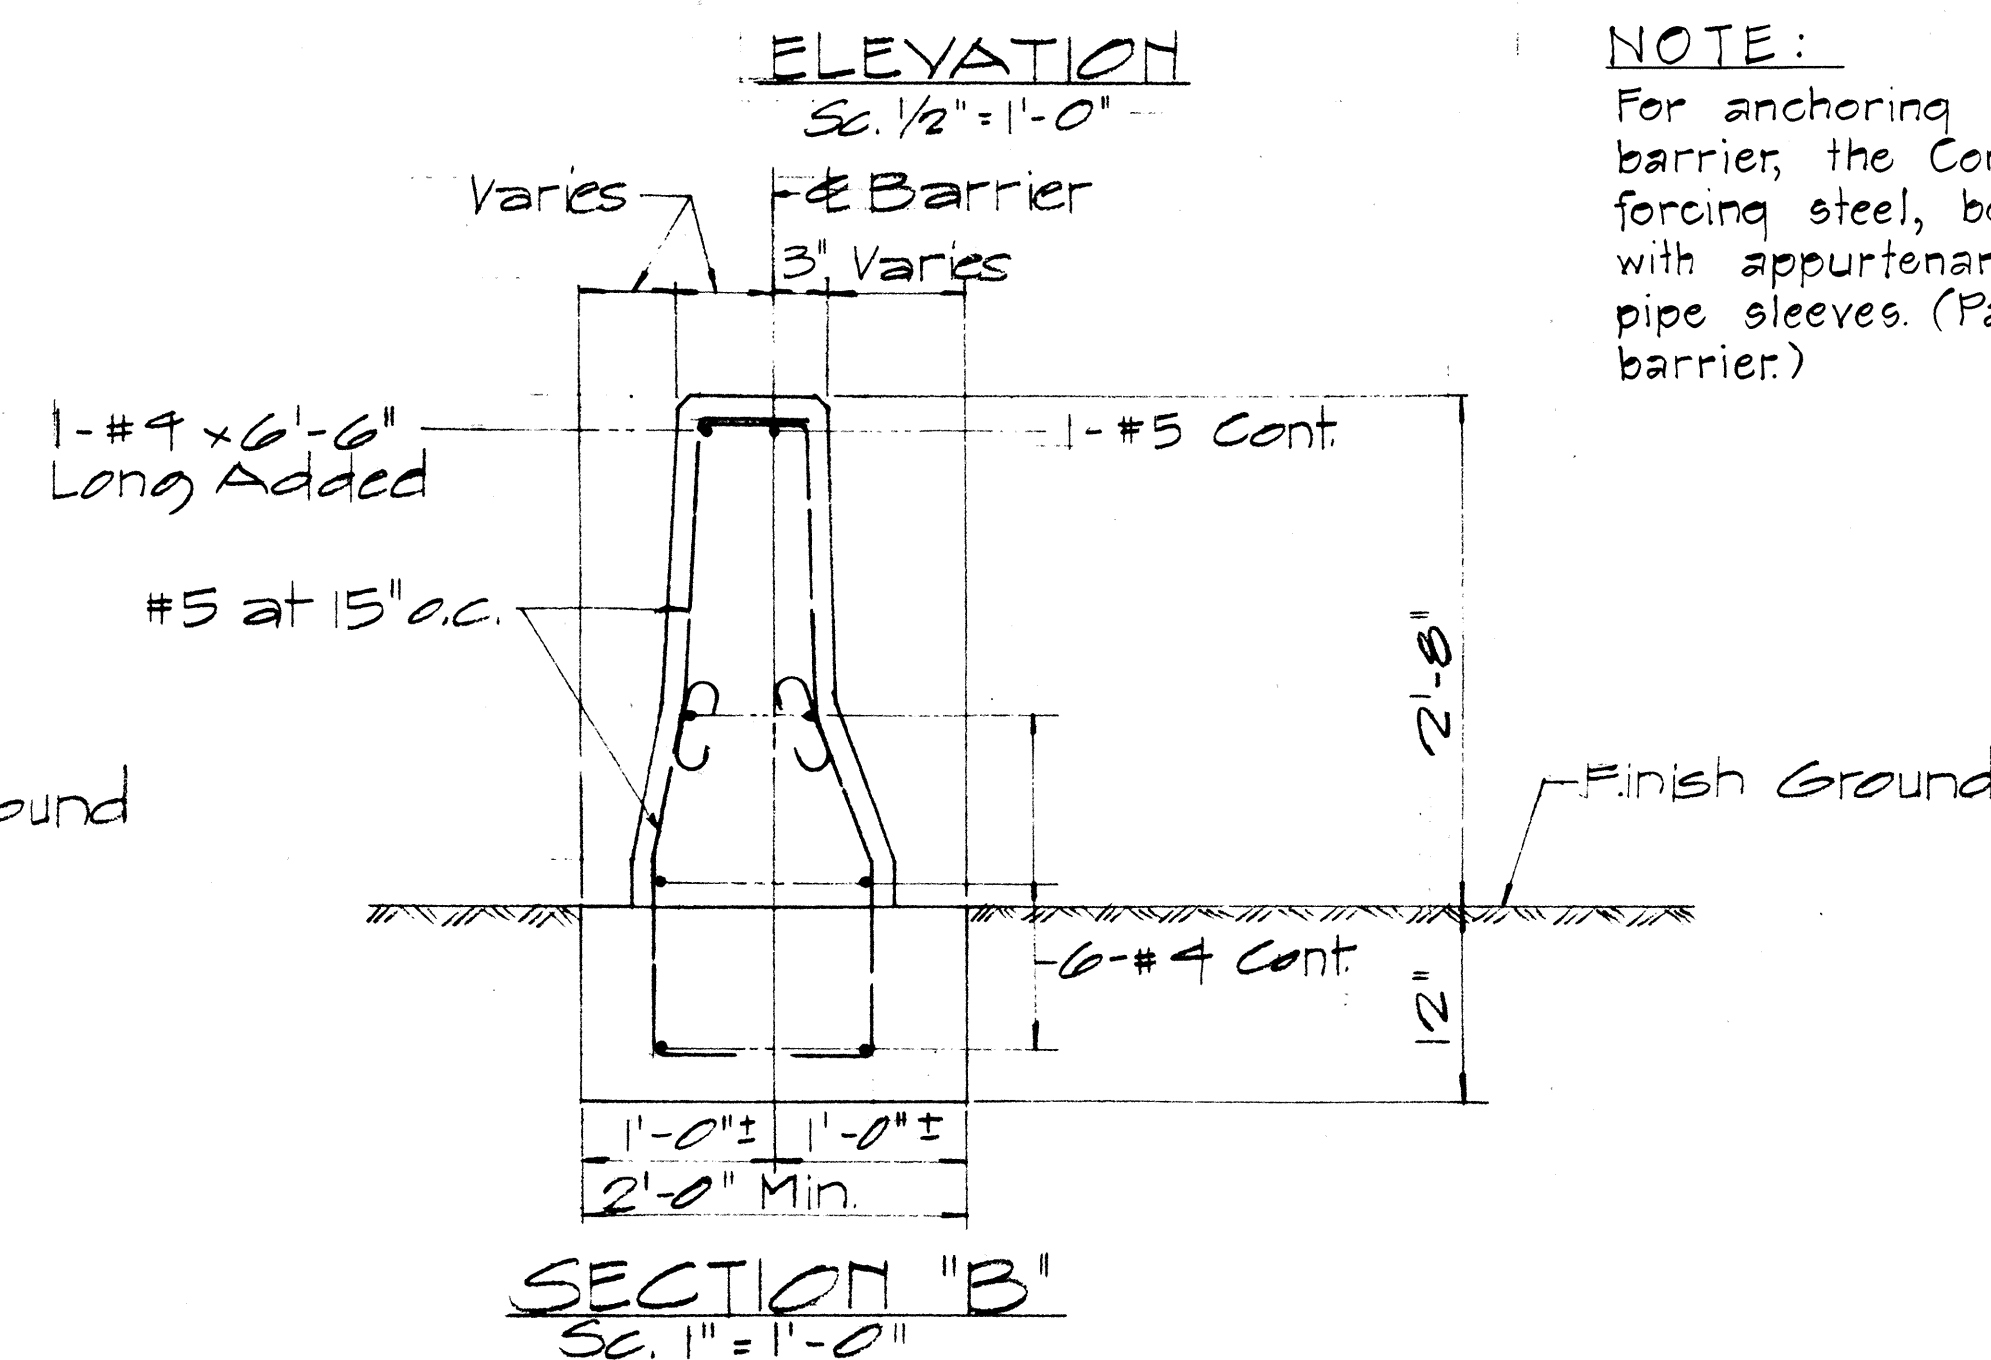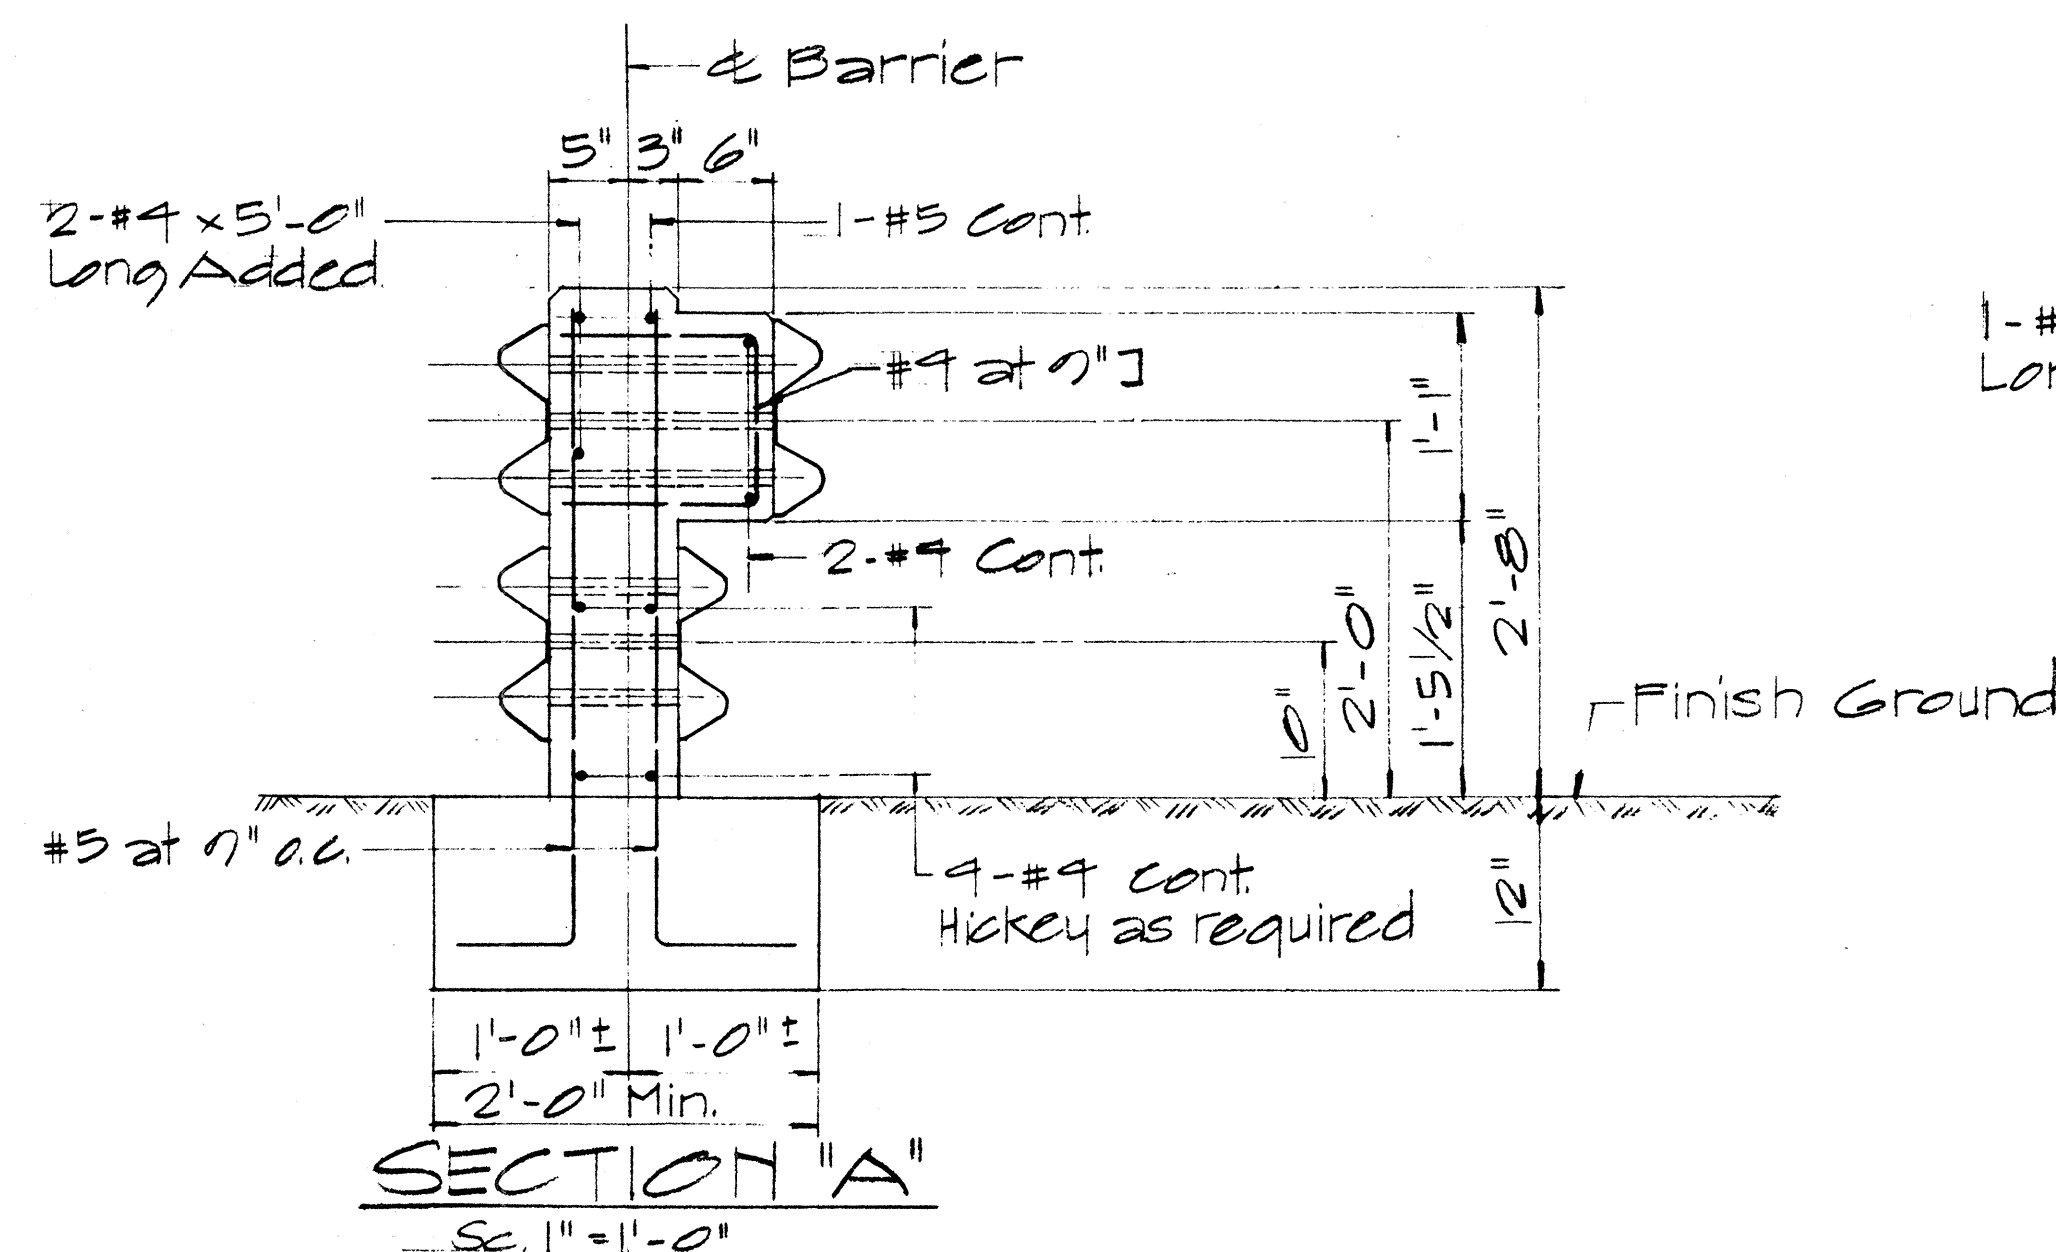

APPROVAL RECOMMENDED:
Eishi Tanaka
TRAFFIC ENGINEER 12/29/69
DATE

APPROVED:
2/2/70
ASSISTANT CHIEF, ENGINEERING 12-30-69
DATE

NO.	REVISION	APPROVED BY	DATE








STATE OF HAWAII
DEPARTMENT OF TRANSPORTATION
LAND TRANSPORTATION FACILITIES DIVISION

STANDARD DETAIL
METAL GUARD RAIL
CONNECTION TO CONG.
BARRIER




Scale As Noted Feb. 1969

SHEET No. 18 OF 26 SHEETS DT 513

FED. ROAD DIST. NO.	STATE	FED. AID PROJ. NO.	FISCAL YEAR	SHEET NO.	TOTAL SHEETS
HAWAII	HAW.	1-HI-1(131):17	1977	56	394

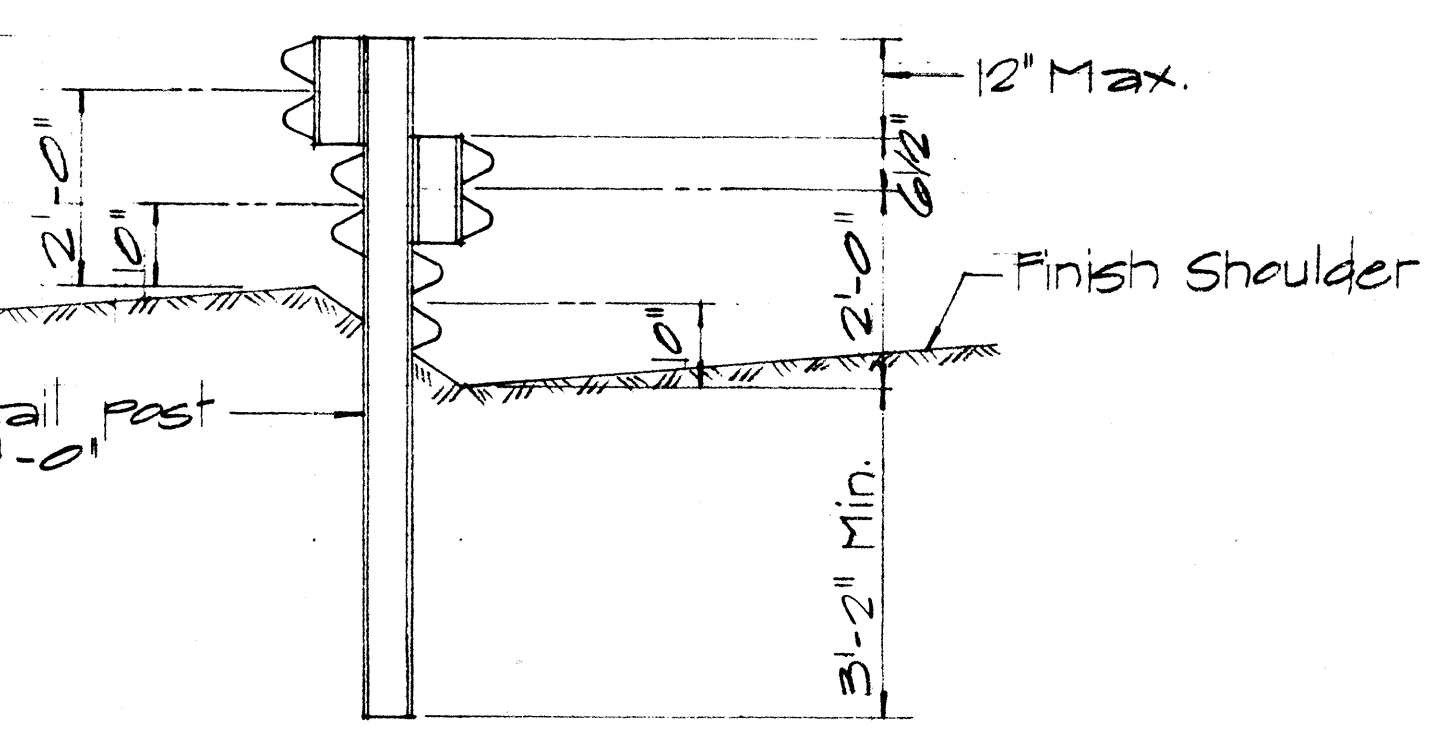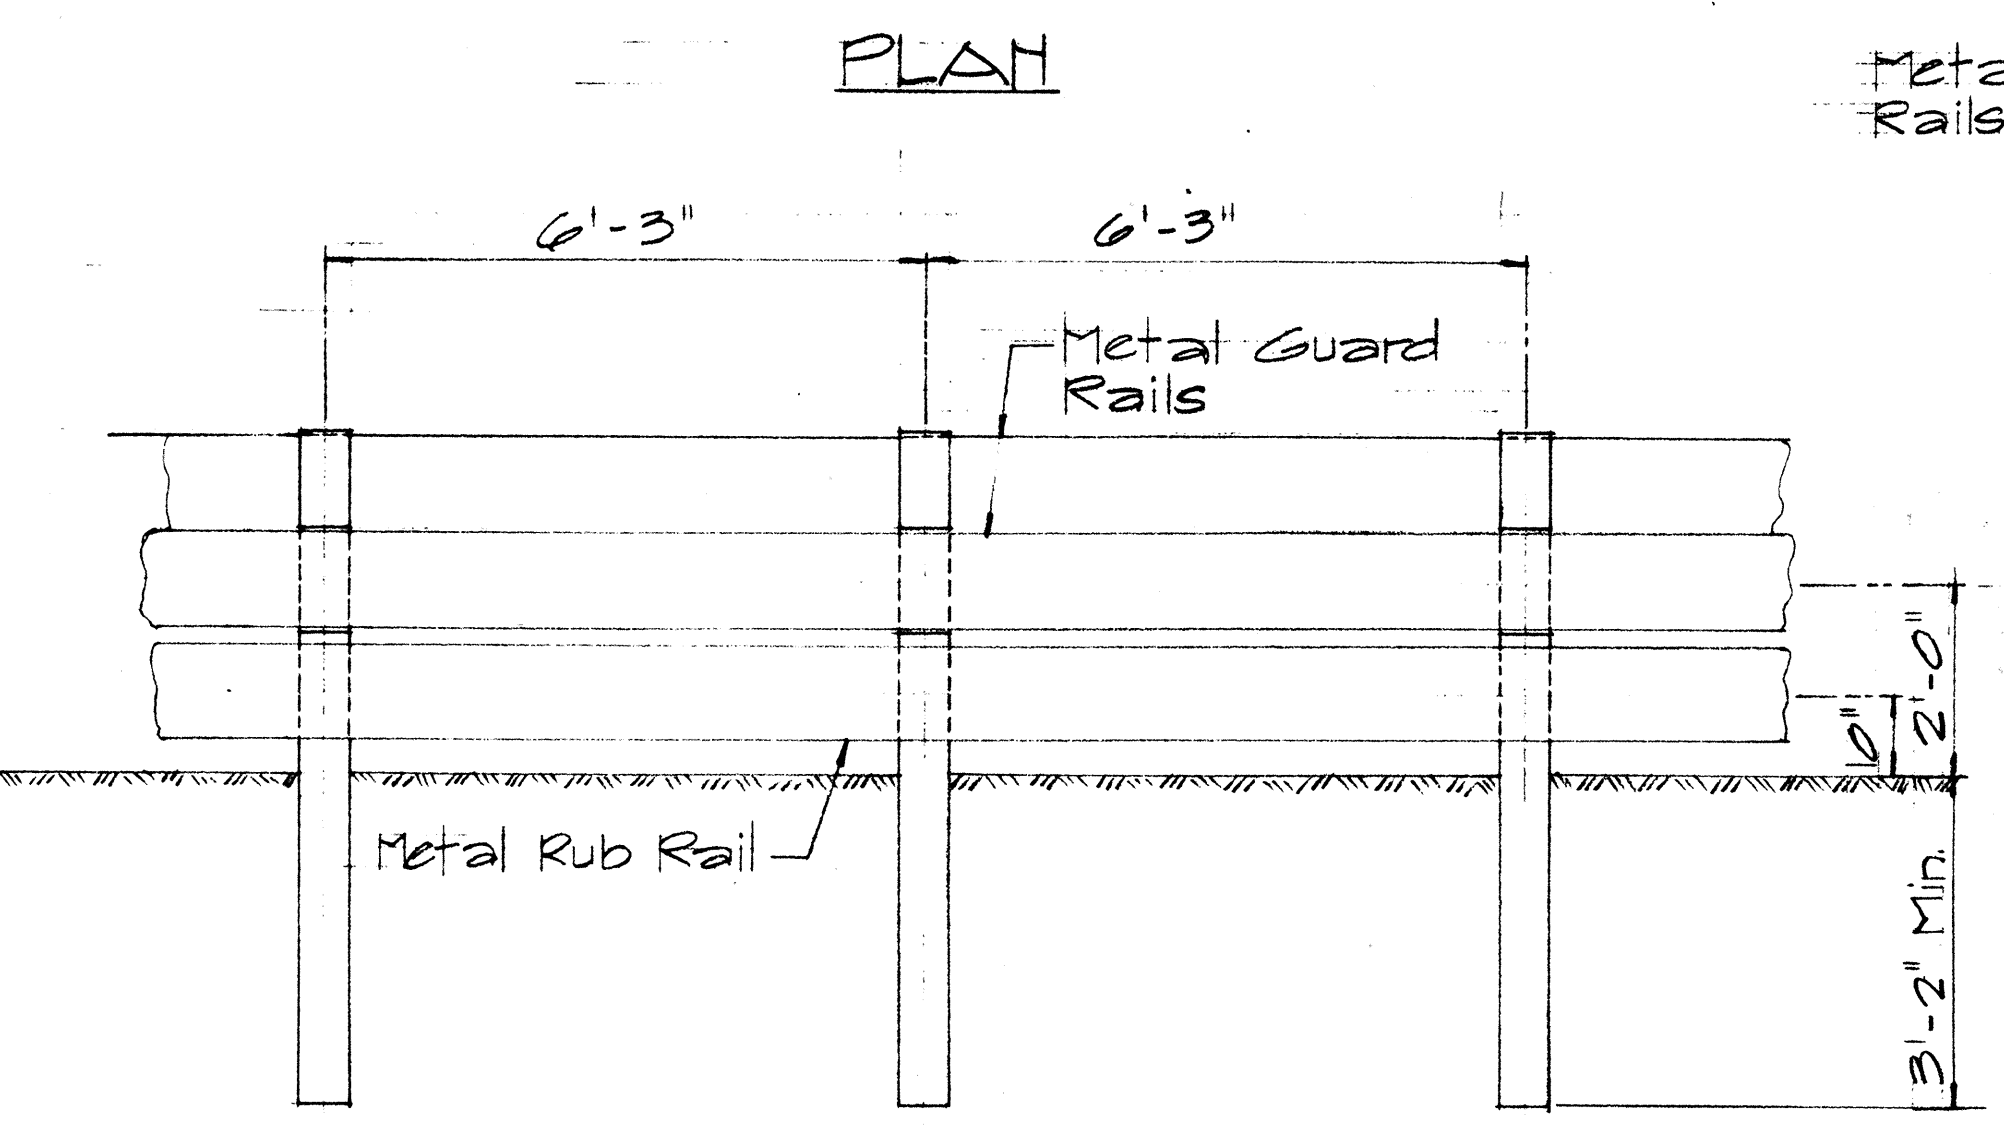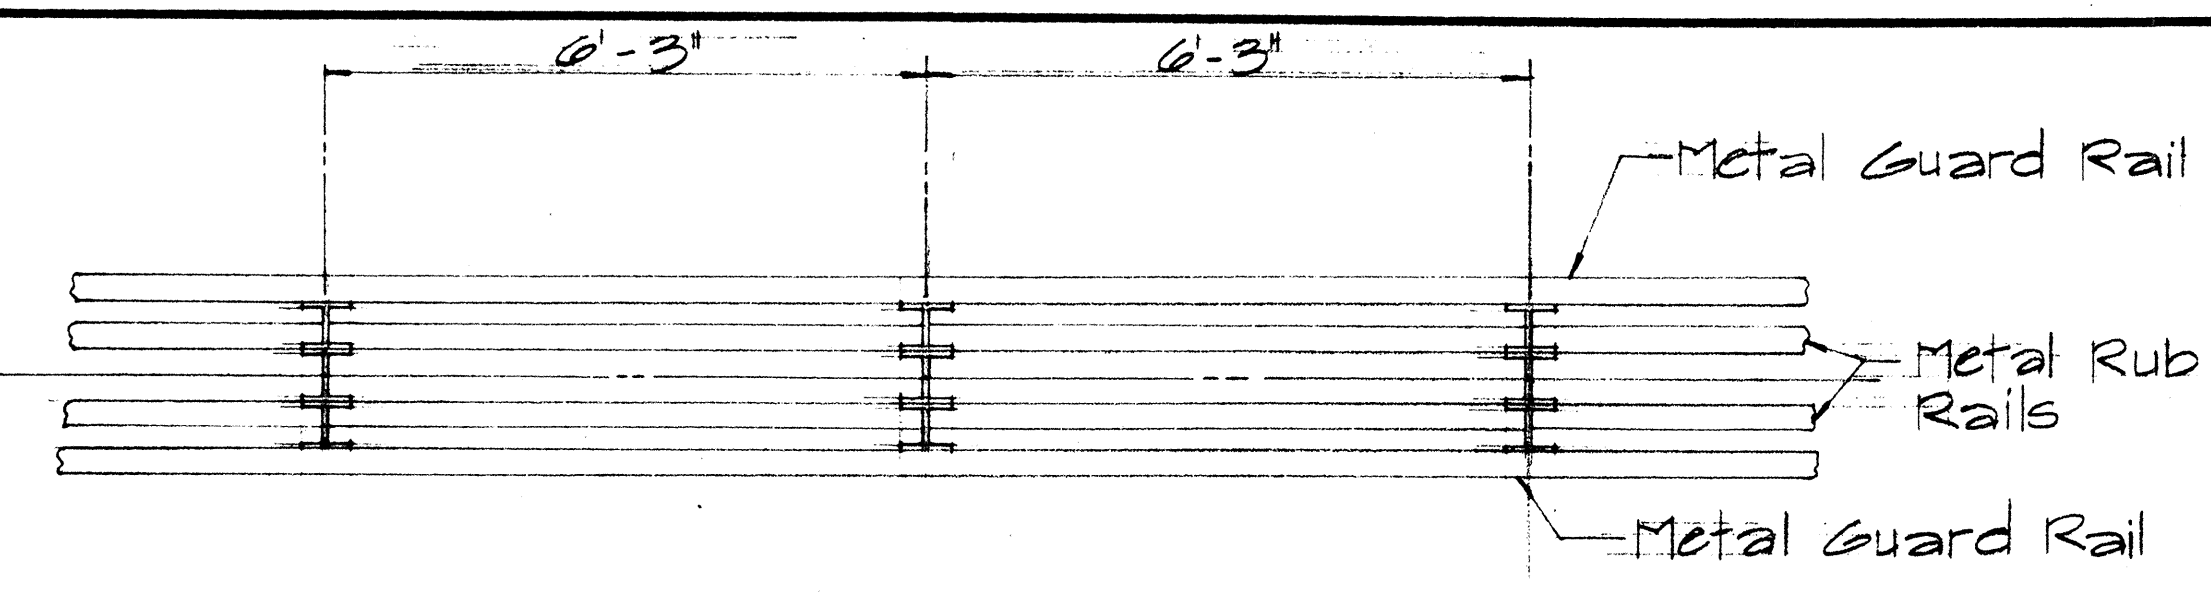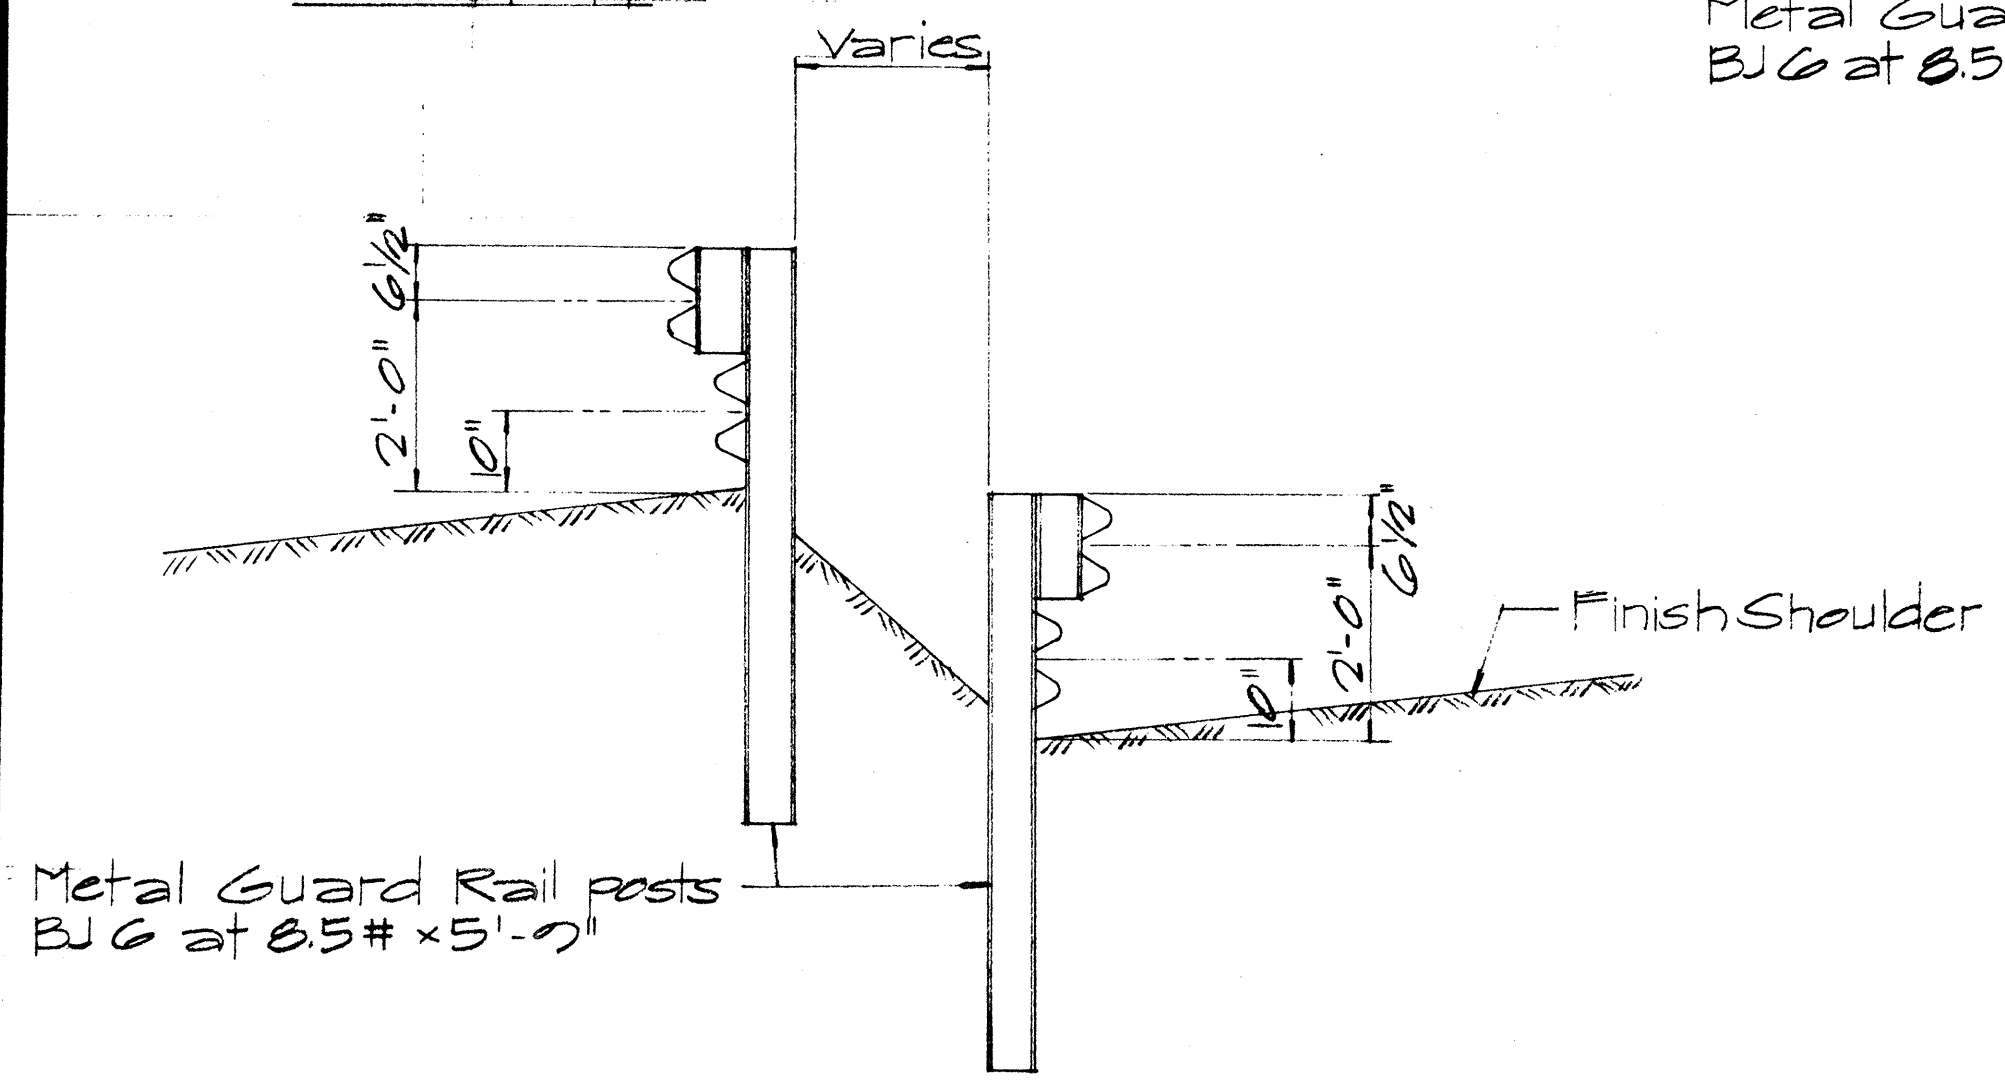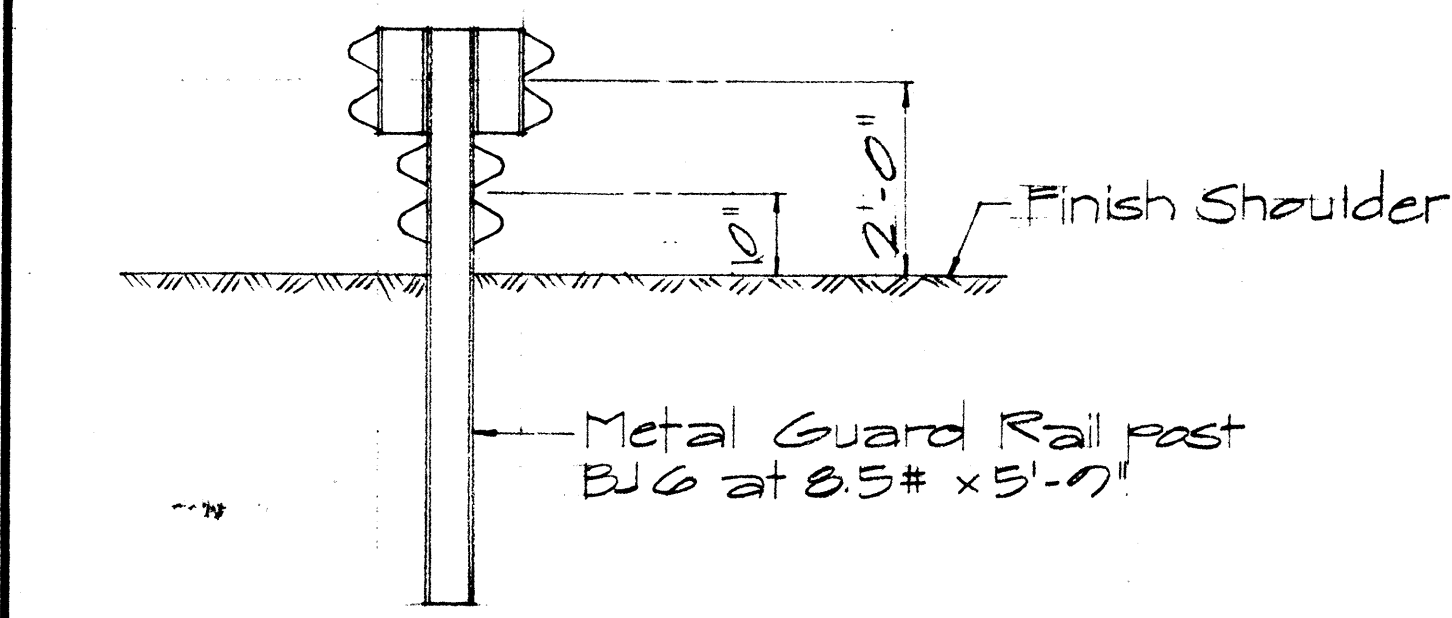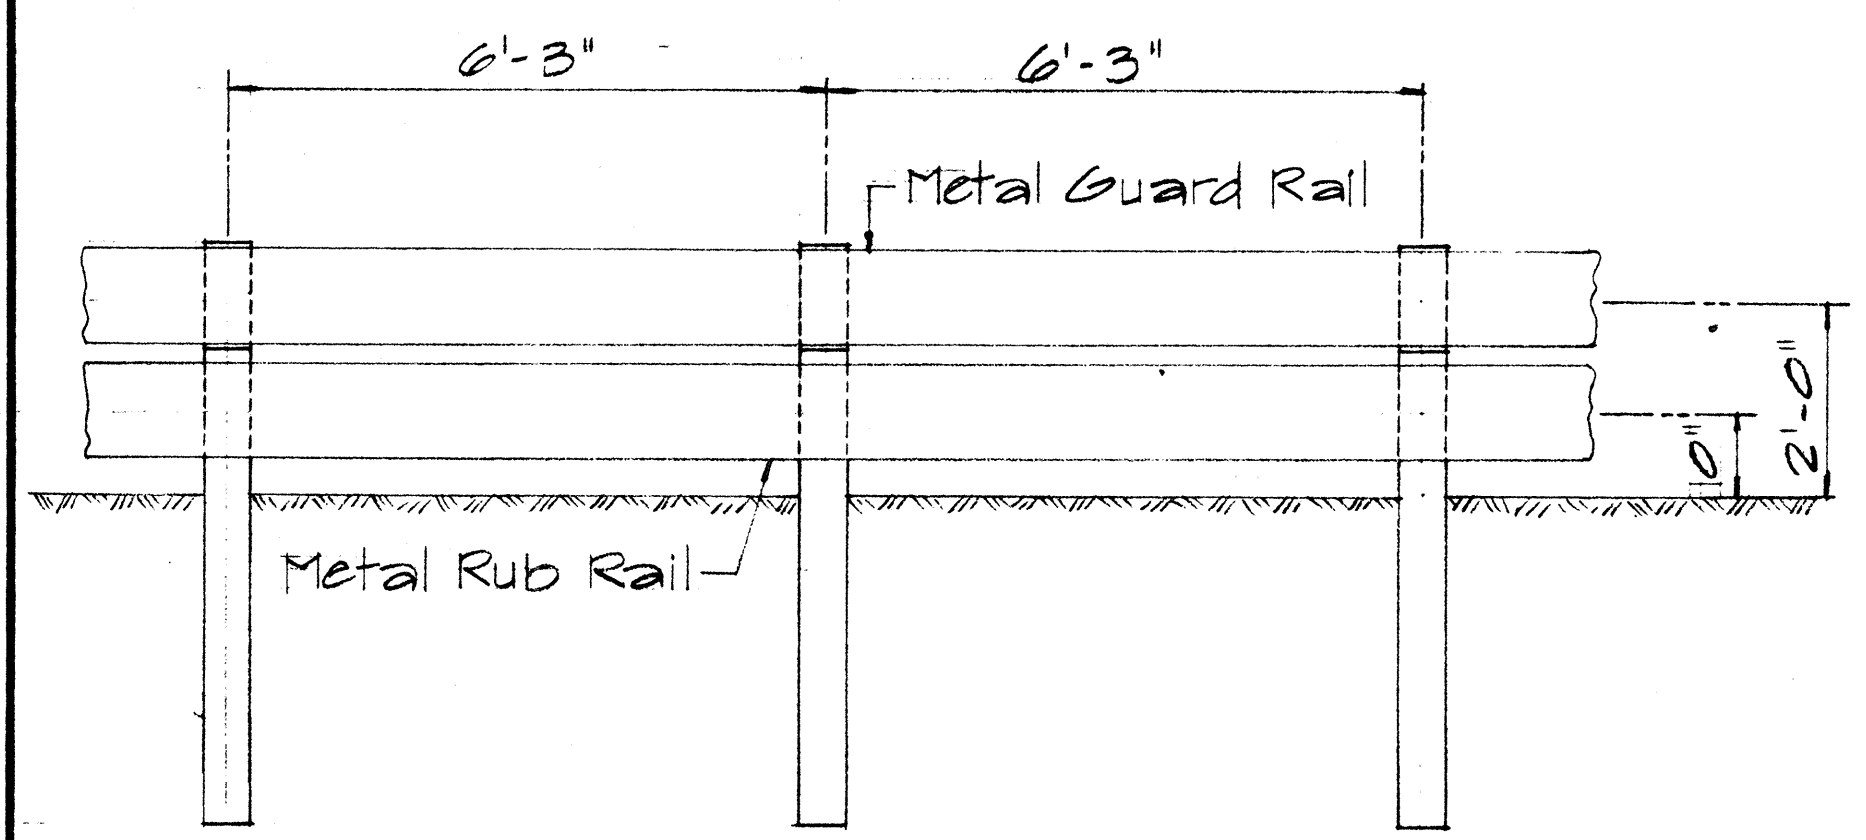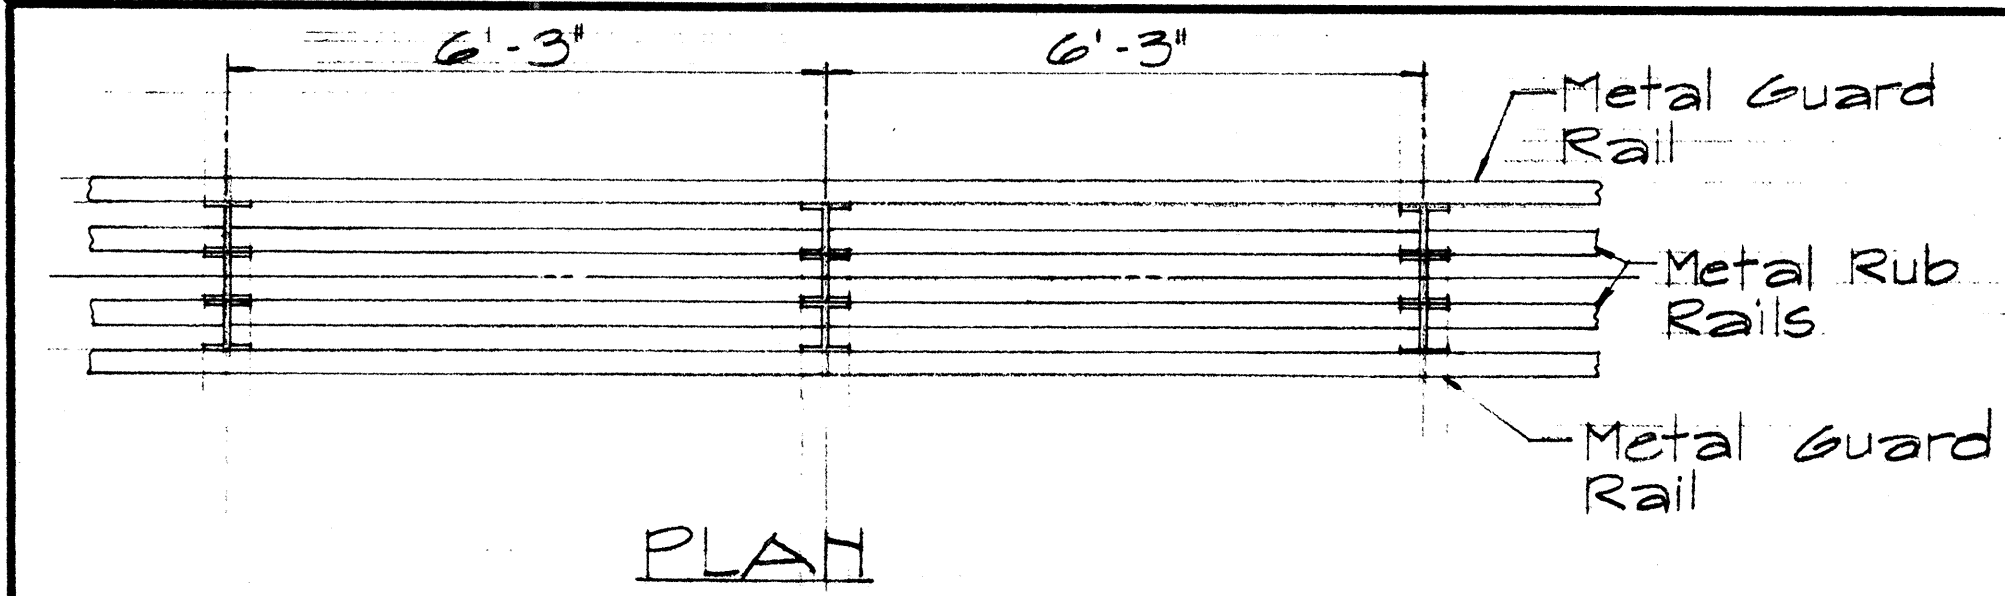

TYPICAL SAW TOOTH INSTALLATION
Sc. 1/2" = 1'-0"

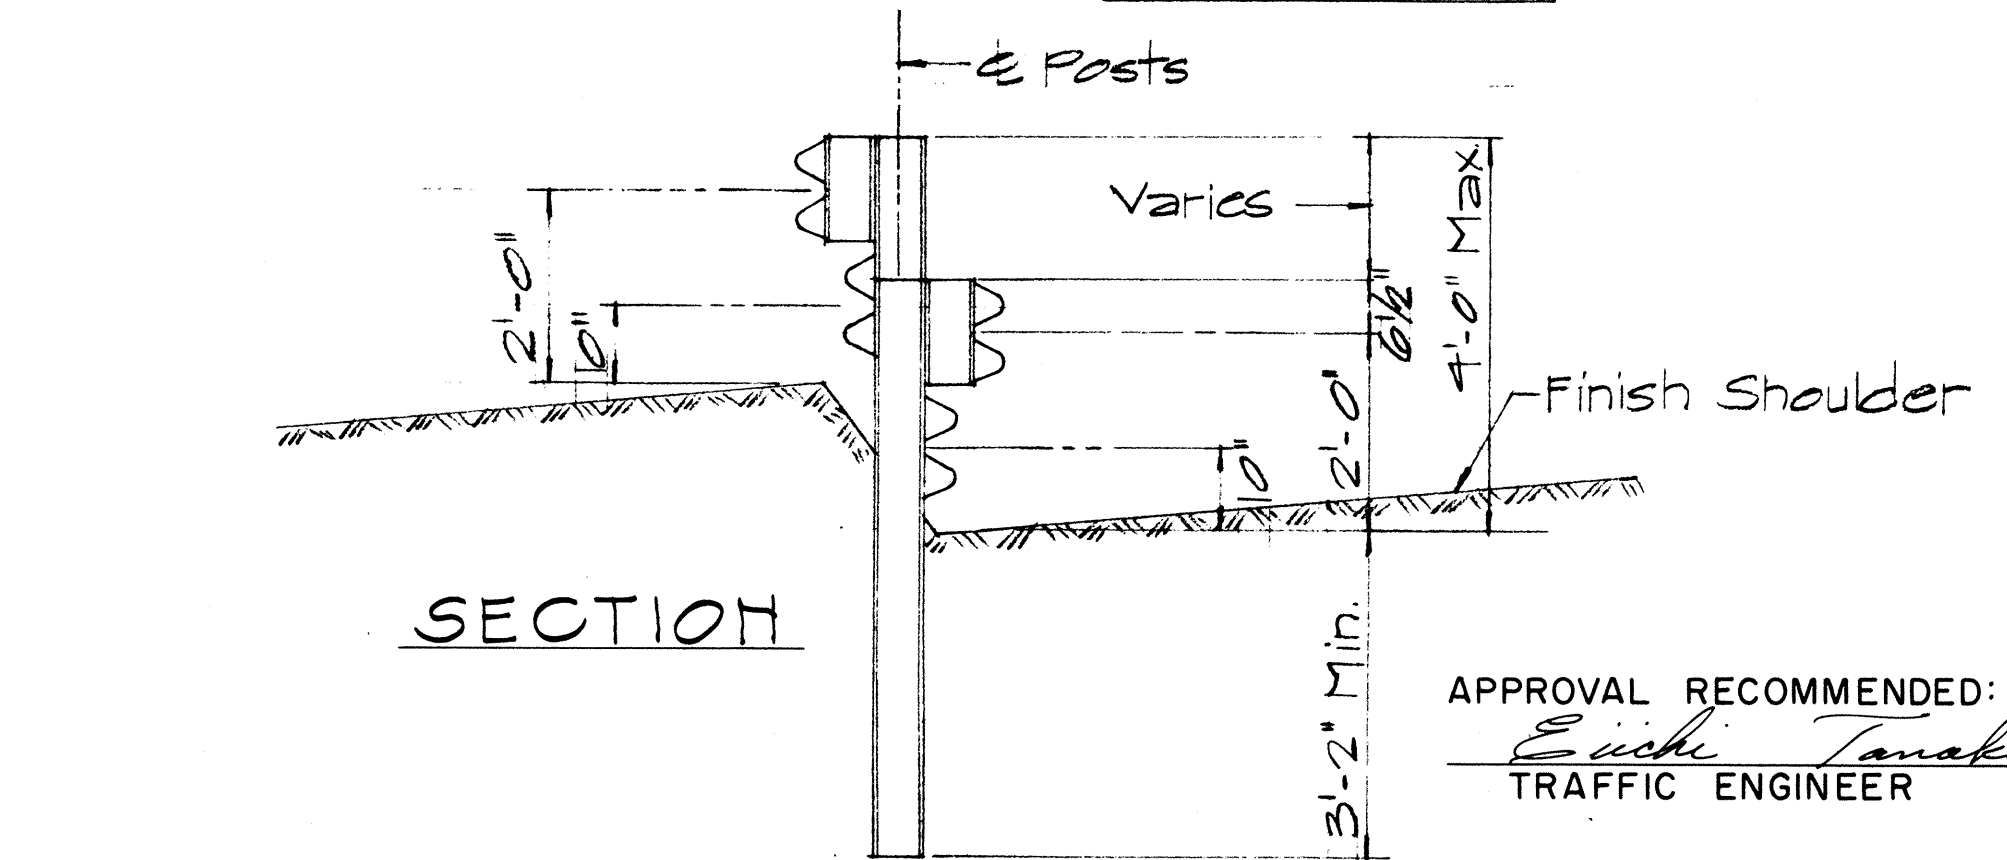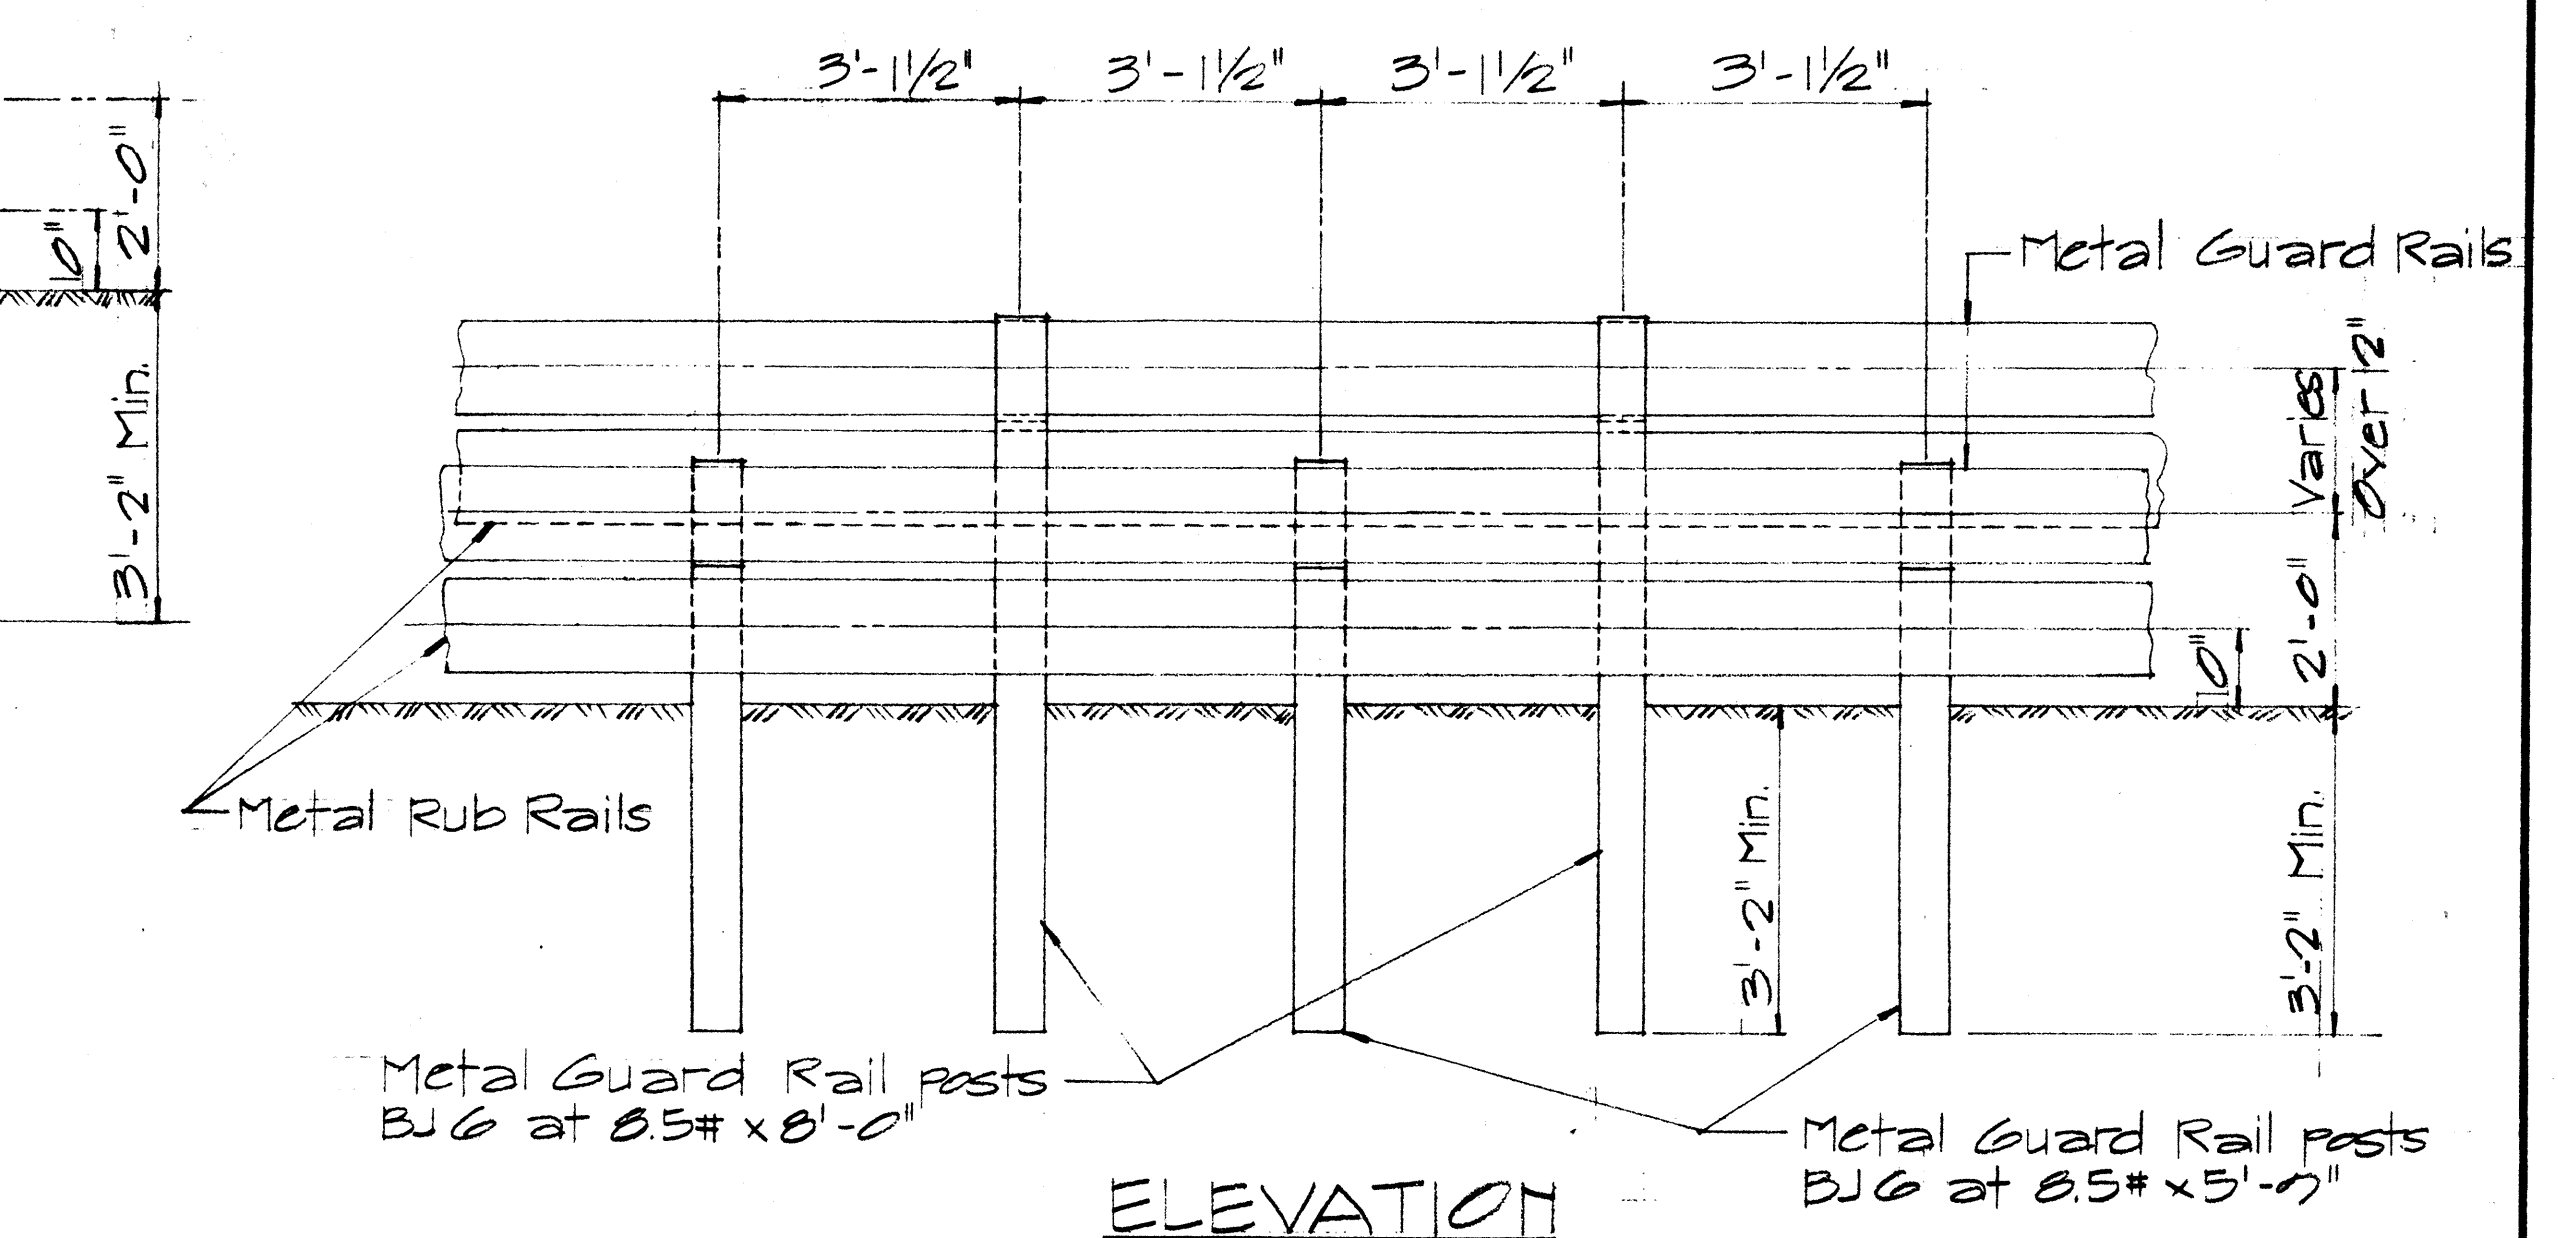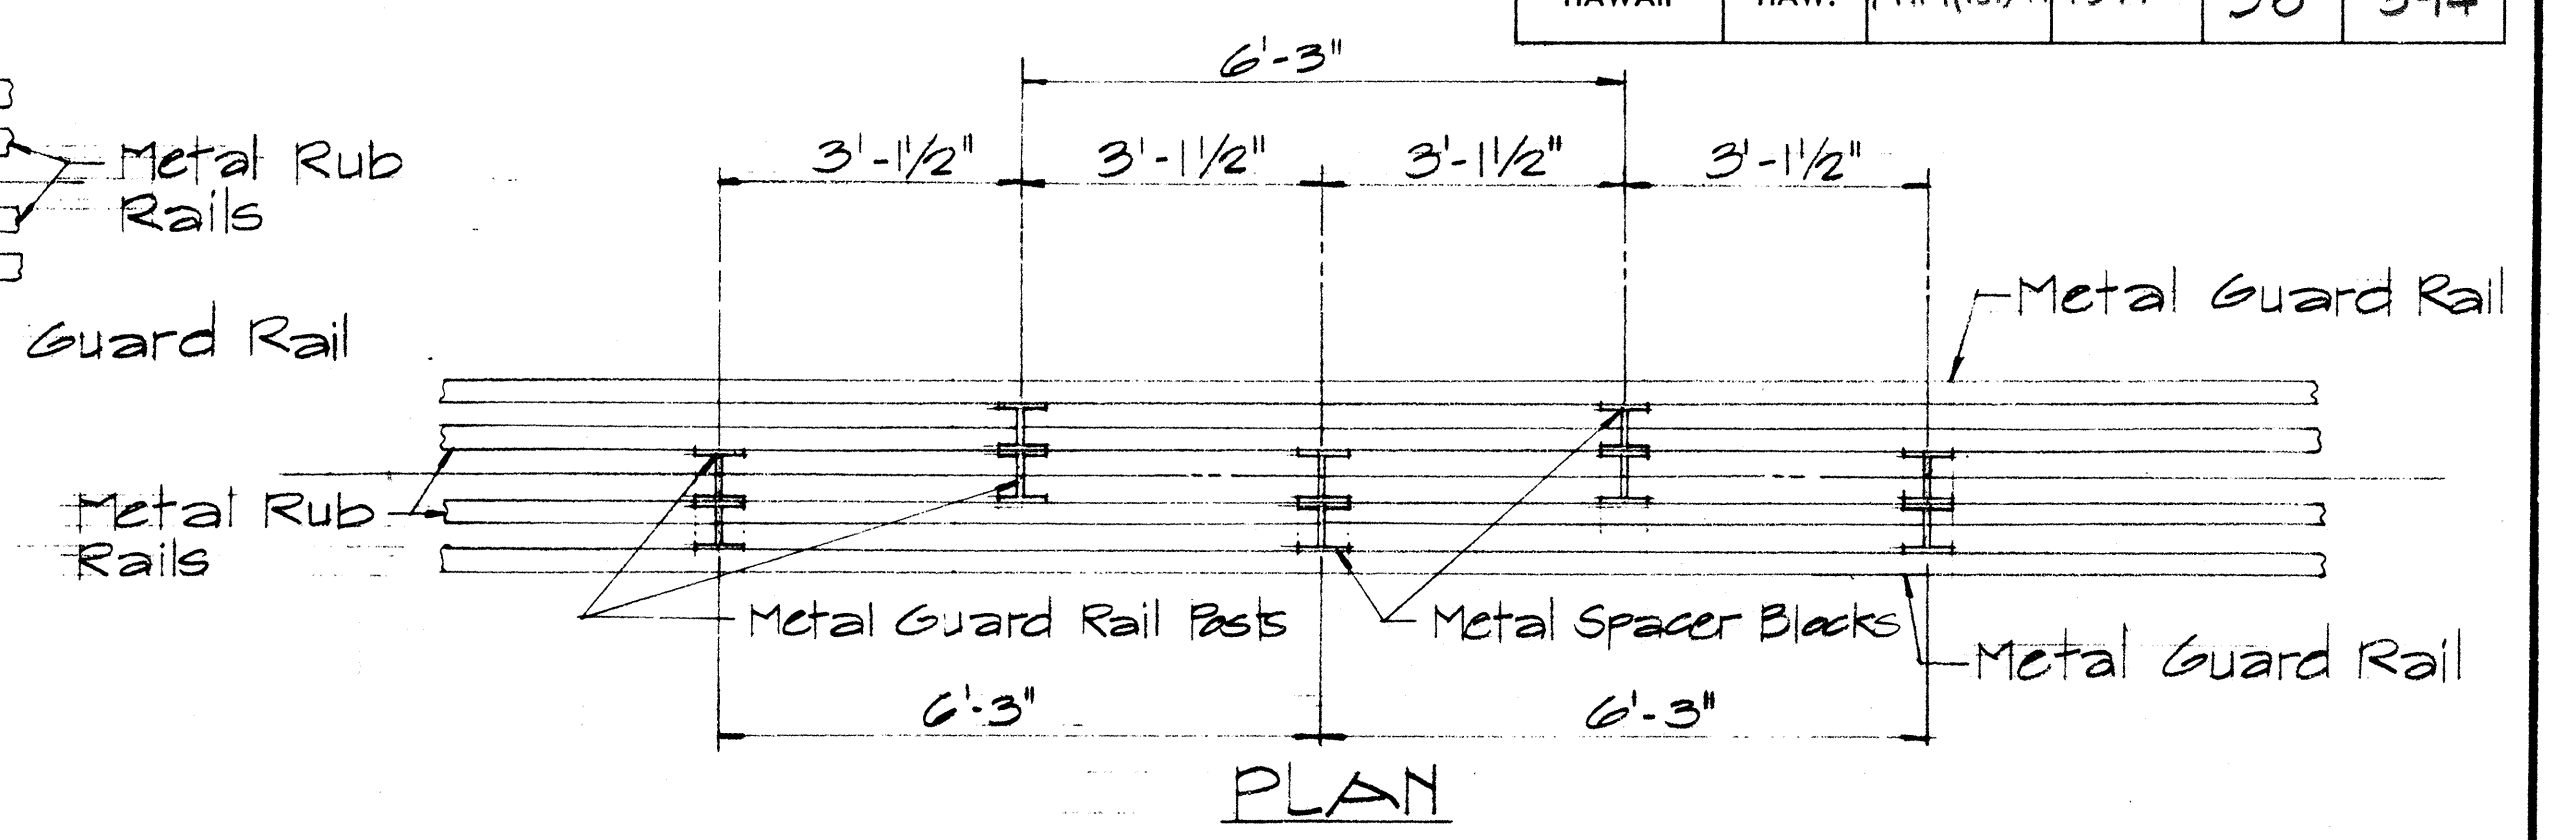

TYPICAL STAGGERED INSTALLATION
Sc. 1/2" = 1'-0"



APPROVAL RECOMMENDED:
Eichi Tanaka
TRAFFIC ENGINEER
12/29/69
DATE

APPROVED:
Shelton S. Seltzer
ASSISTANT CHIEF, ENGINEERING
12/30/69
DATE


NO.	REVISION	APPROVED BY	DATE

STATE OF HAWAII
DEPARTMENT OF TRANSPORTATION
LAND TRANSPORTATION FACILITIES DIVISION
**STANDARD DETAIL
METAL GUARD RAIL
WITH RUB RAIL**
Scale: 1/2" = 1'-0" Feb. 1969
SHEET No. 19 OF 26 SHEETS DT 514


FED. ROAD DIST. NO.	STATE	FED. AID PROJ. NO.	FISCAL YEAR	SHEET NO.	TOTAL SHEETS
HAWAII	HAW.	1-H-1(13)17	1977	57	394

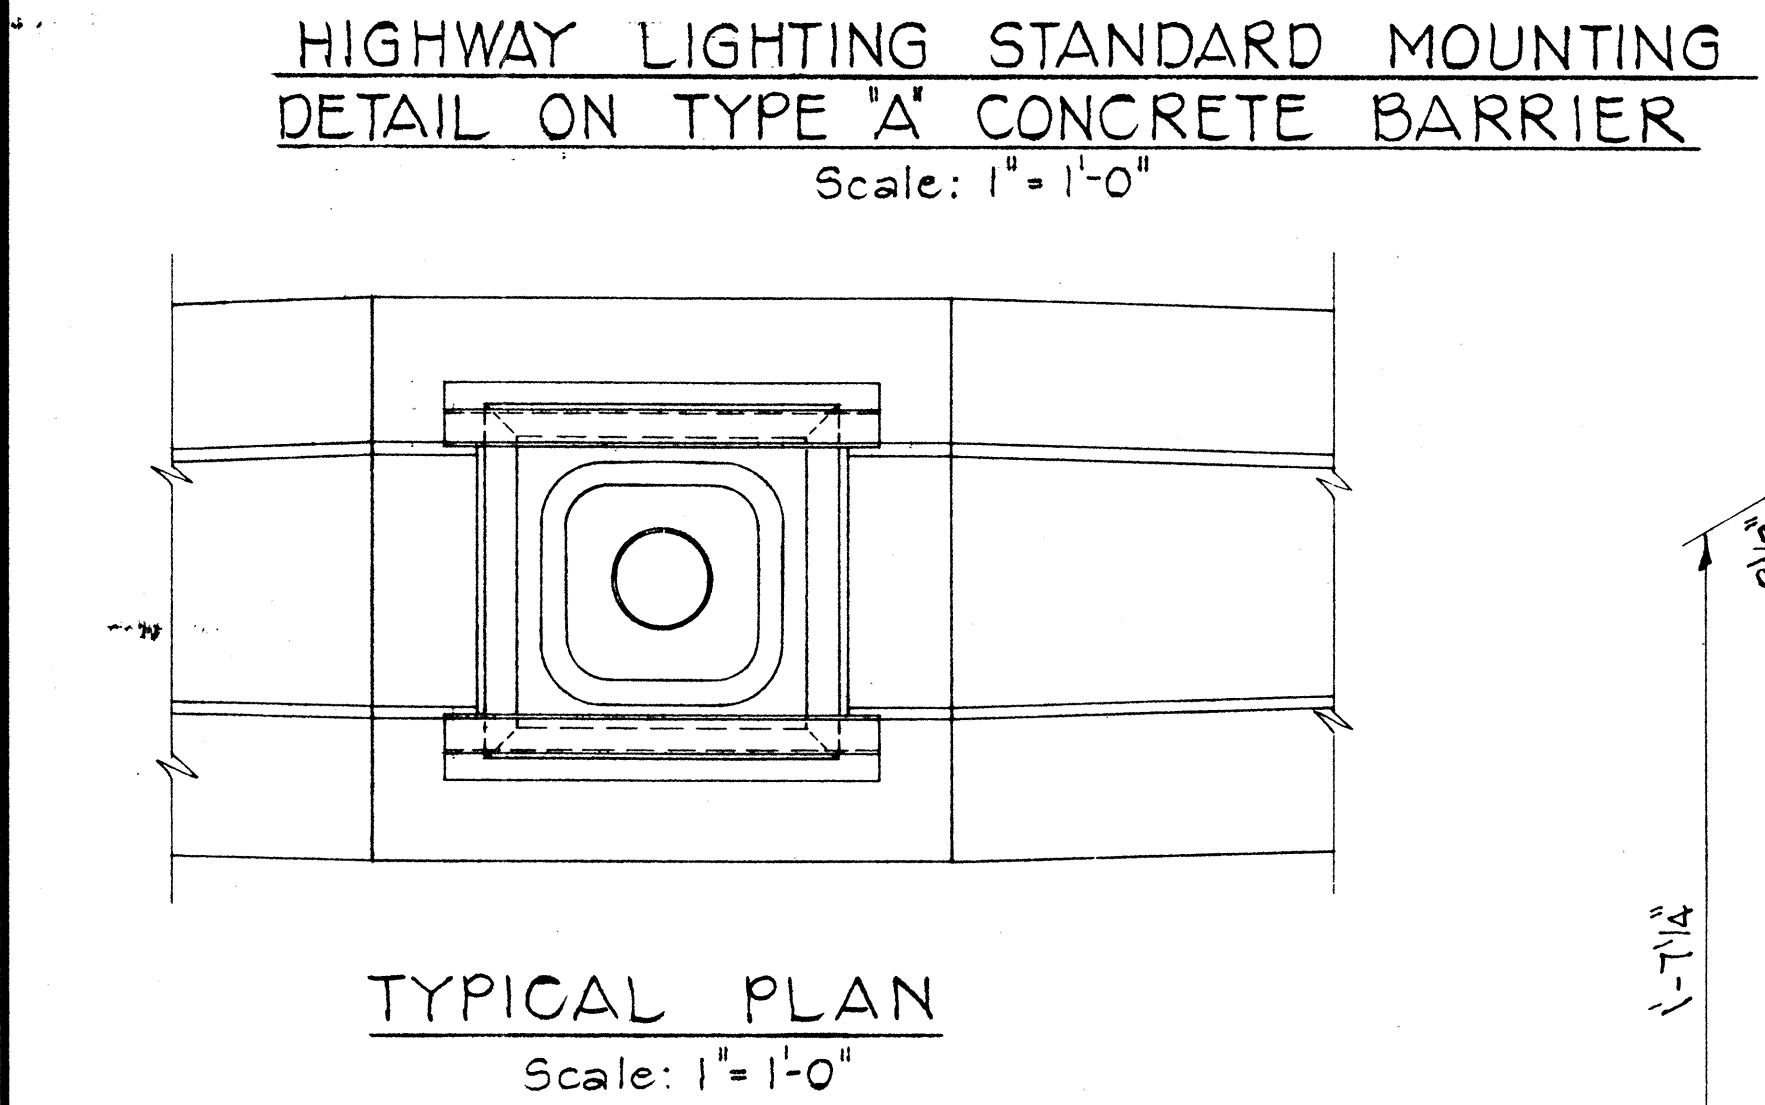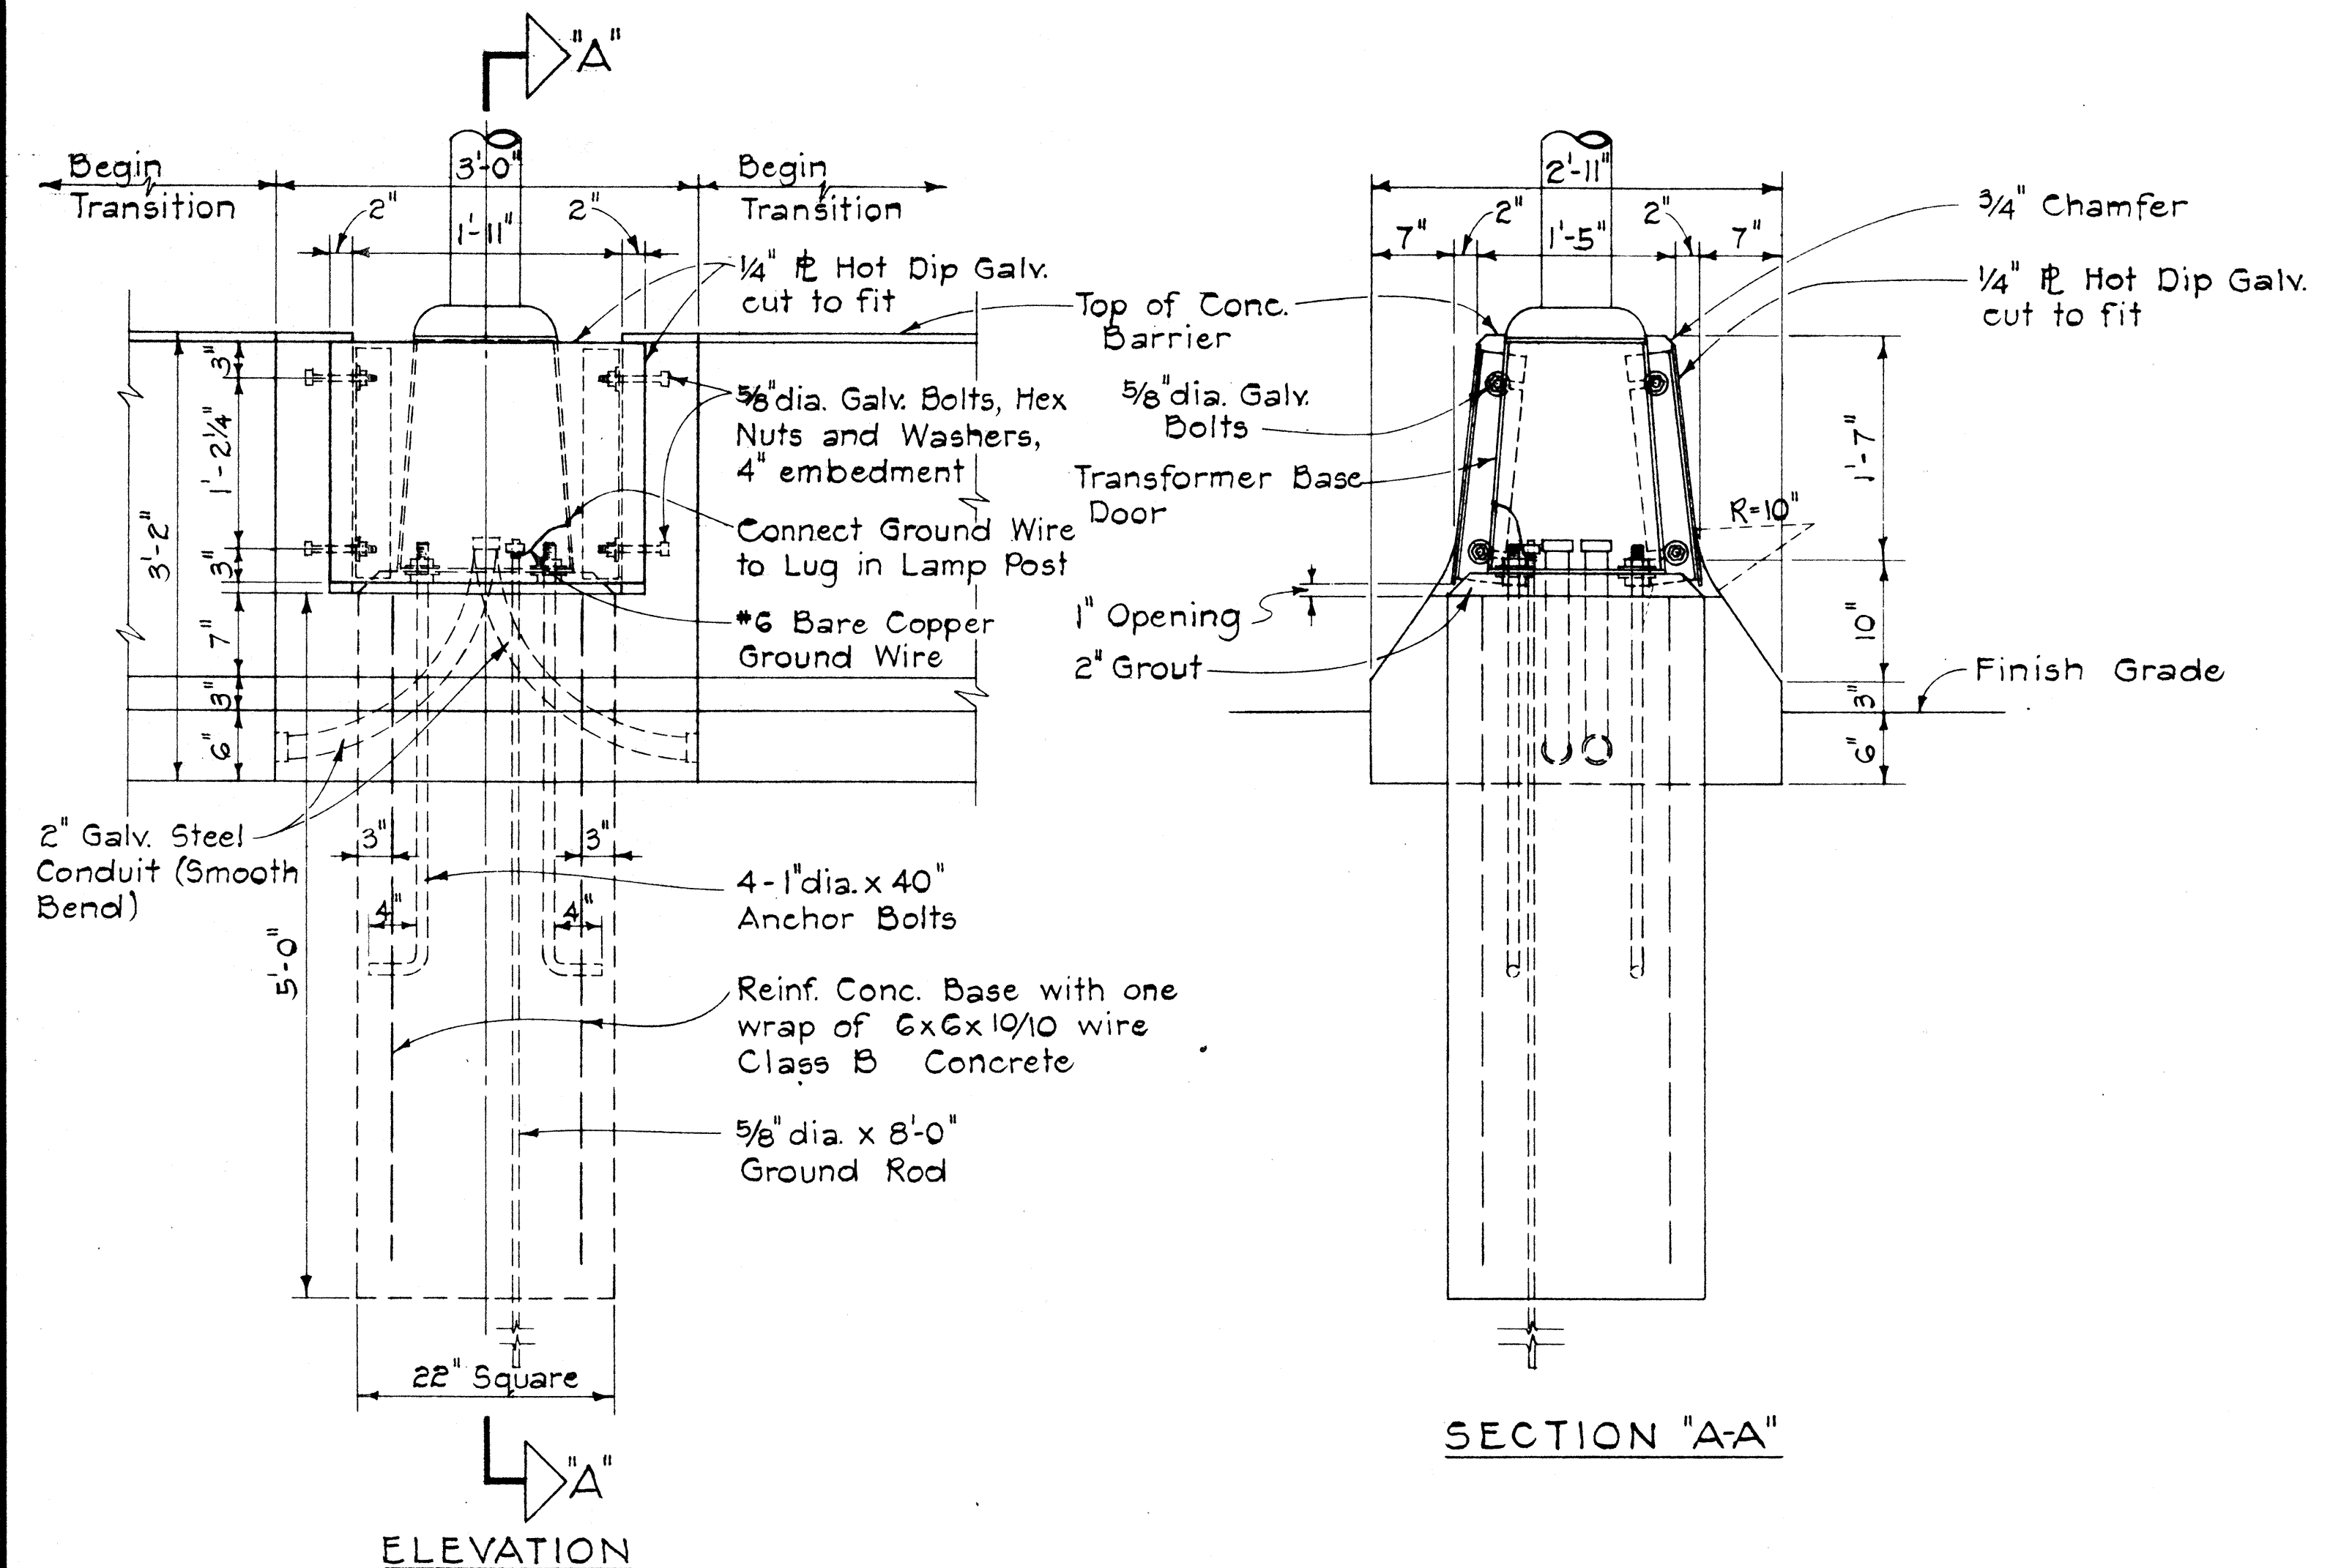

DATE	
SURVEY PLOTTED BY	
DRAWN BY	
CHECKED BY	
NOTED BY	
NO.	

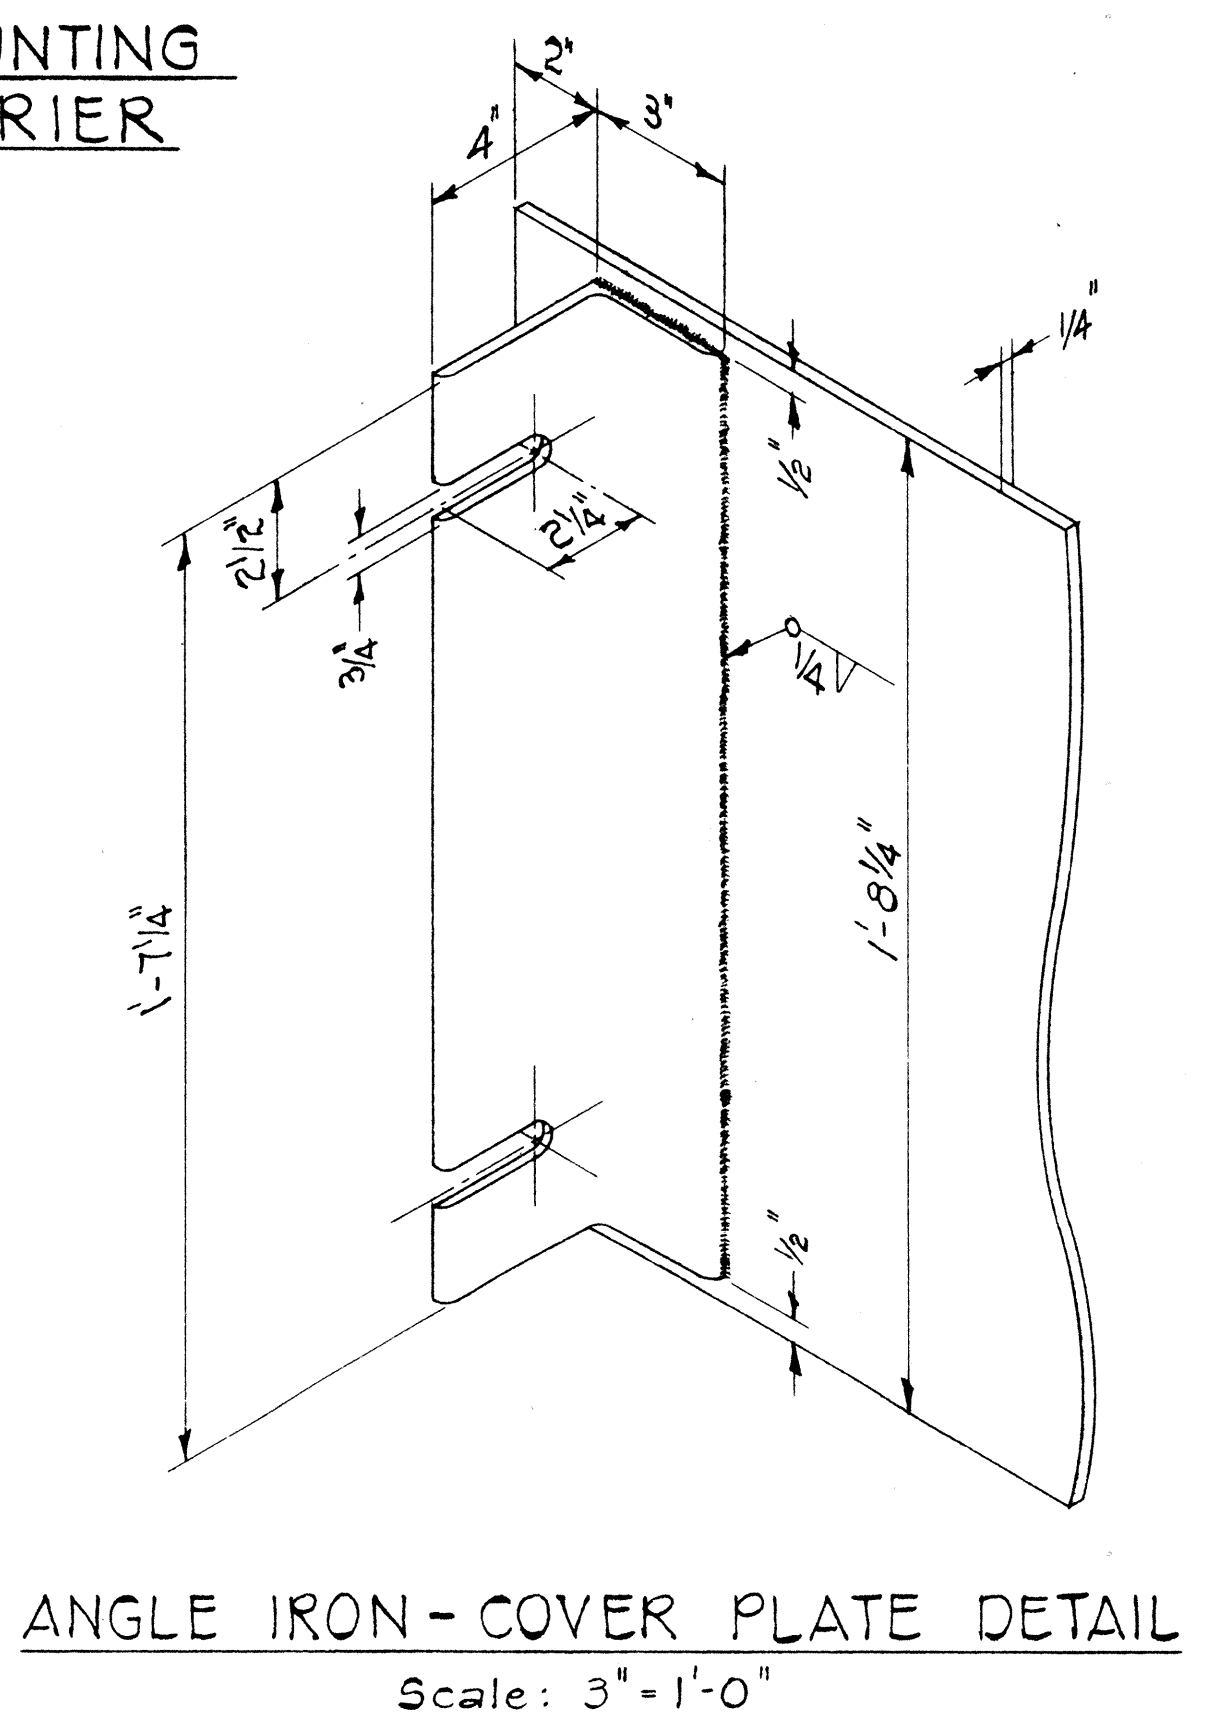

HIGHWAY LIGHTING STANDARD MOUNTING
DETAIL ON TYPE "B" CONCRETE BARRIER
Scale: 1"=1'-0"

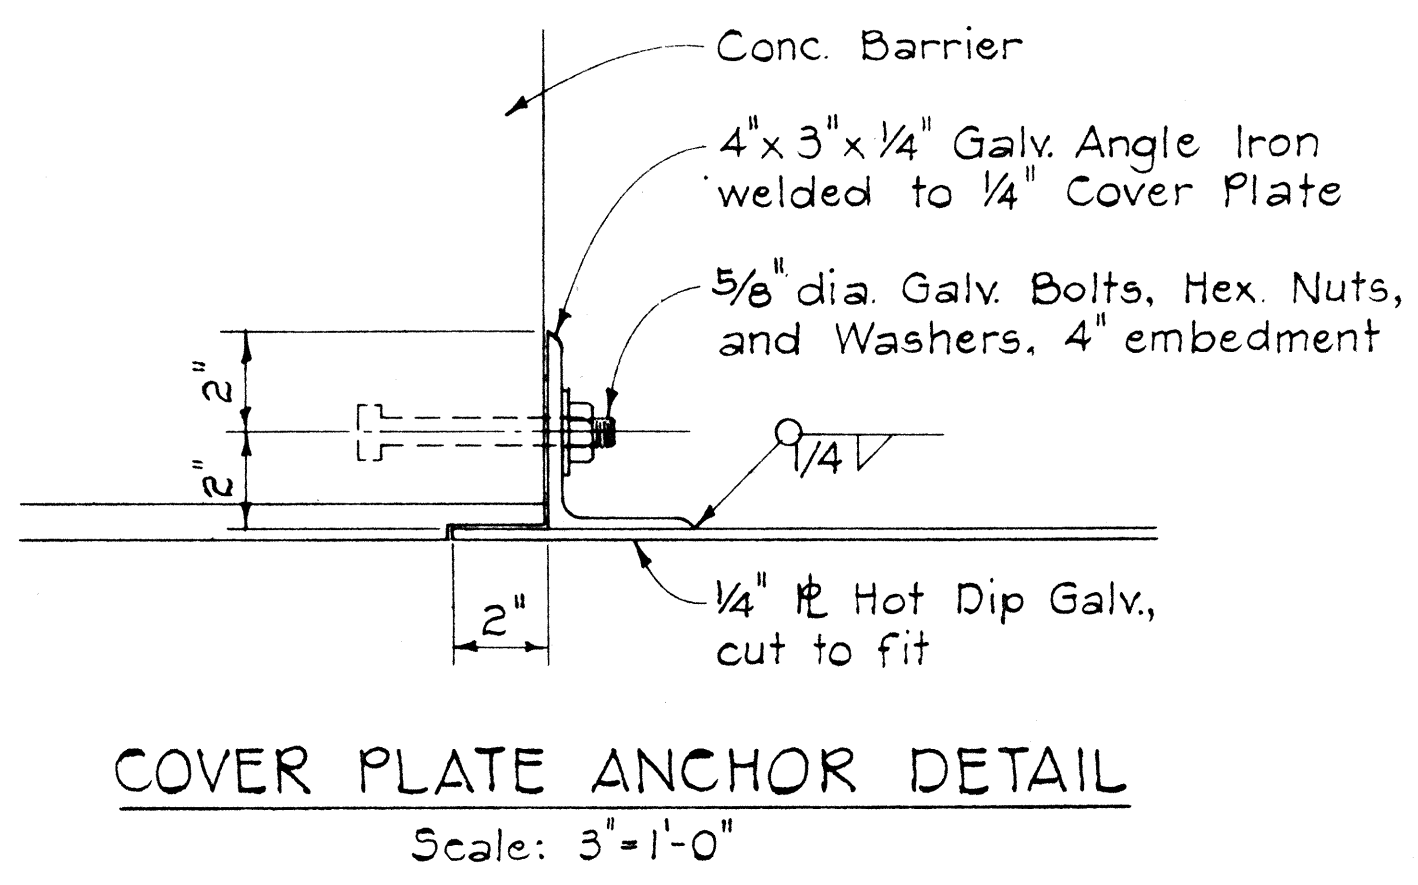


NOTES:

- Constructing conc. barrier foundation for Hwy. Lighting Standards shall consist of all work and materials necessary for constructing the 3'-0" concrete barrier section as shown on the plans. The work shall include furnishing and installing cover plate, angle iron, nuts and bolts and all other appurtenances, and labor including galvanizing, as shown and necessary to complete the work.

APPROVAL, RECOMMENDED:
TRAFFIC ENGINEER
DATE: 12/29/69

APPROVED:
ASSISTANT CHIEF, ENGINEERING
DATE: 12-30-69

NO	REVISION	APPROVED BY	DATE

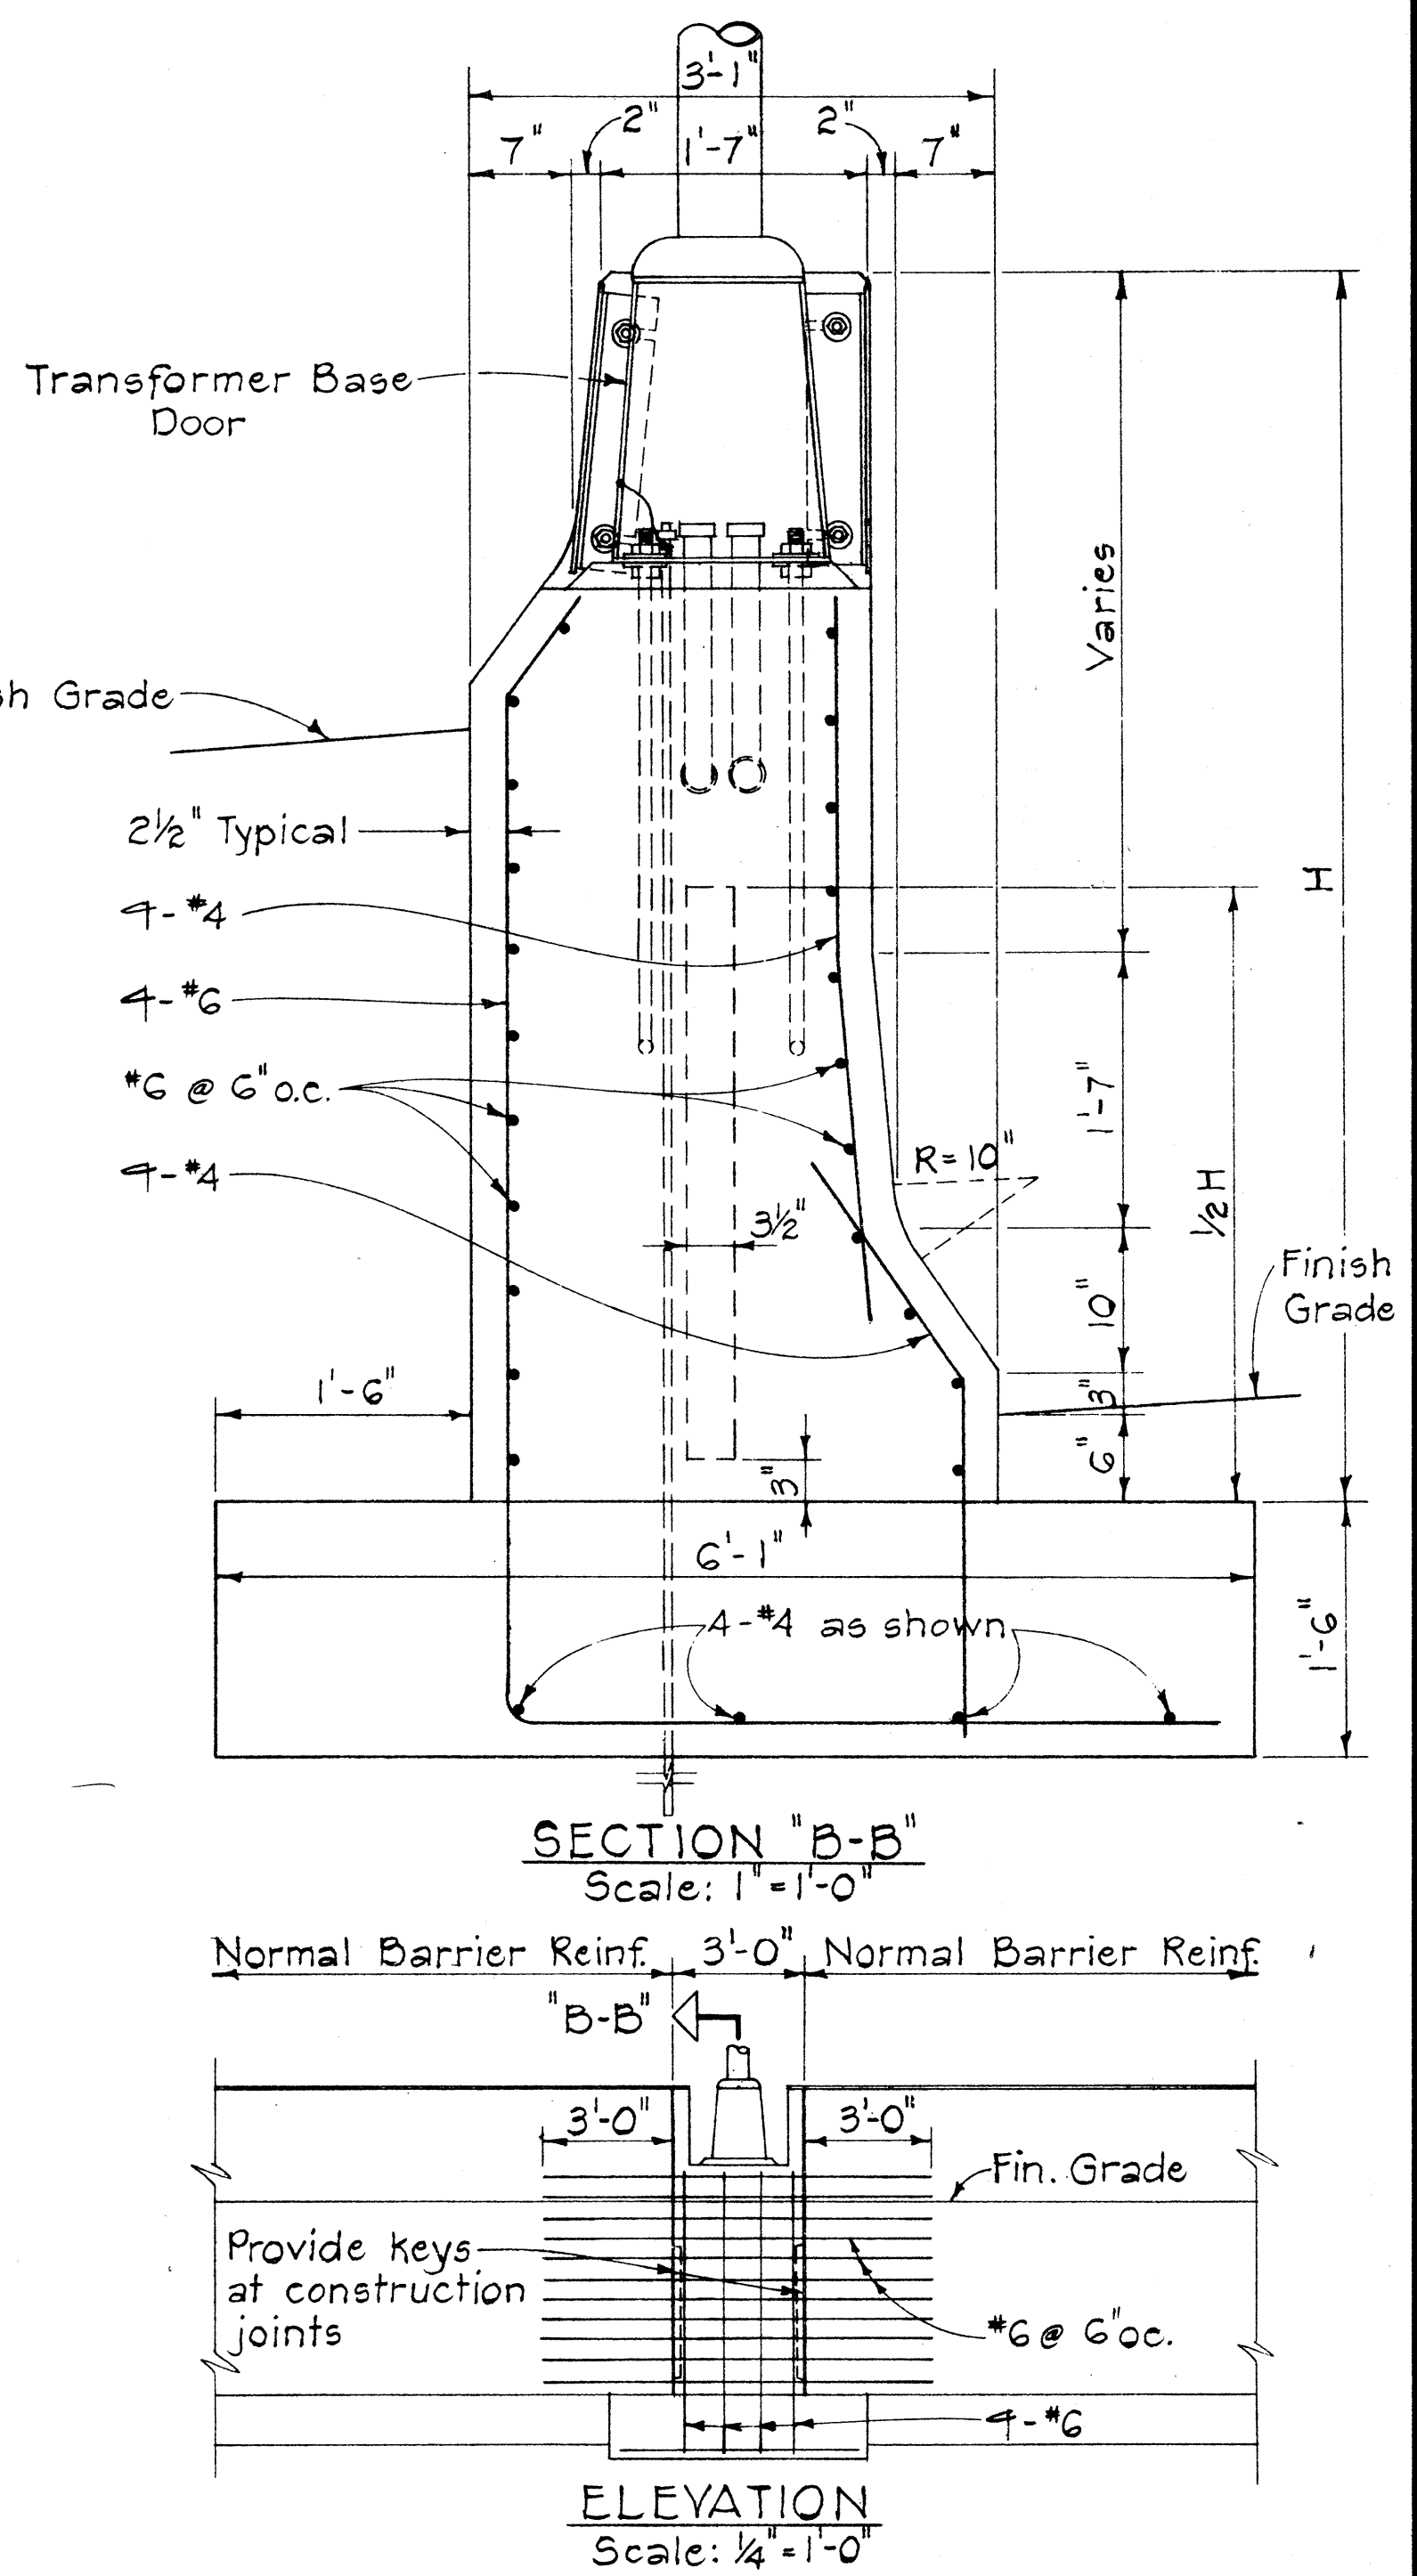

HIGHWAY LIGHTING STANDARD MOUNTING
DETAIL ON TYPE "C" & "D" CONC. BARRIER

STATE OF HAWAII
DEPARTMENT OF TRANSPORTATION
LAND TRANSPORTATION FACILITIES DIVISION






STANDARD DETAIL
HIGHWAY LIGHTING
STANDARD MOUNTING
DET. ON CONG. BARRIER

Scale: As Shown Date: April 1969

SHEET No. 20 OF 26 SHEETS DT 515

FED. ROAD DIST. NO.	STATE	FED. AID PROJ. NO.	FISCAL YEAR	SHEET NO.	TOTAL SHEETS
HAWAII	HAW.	1-HH(13)017	1977	58	394

NOTE:
Metal guard rail connection to structures requires End Post Connection. See structure plans.

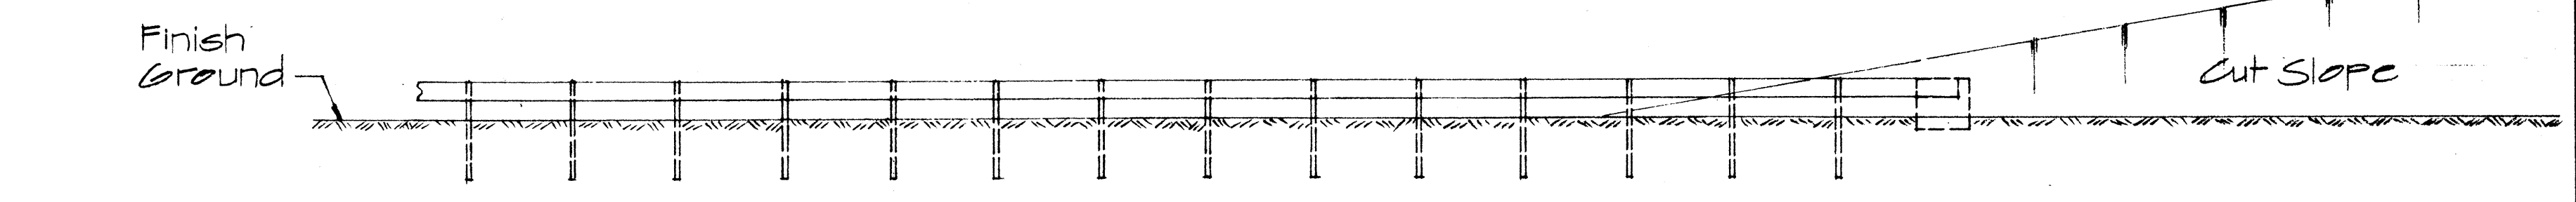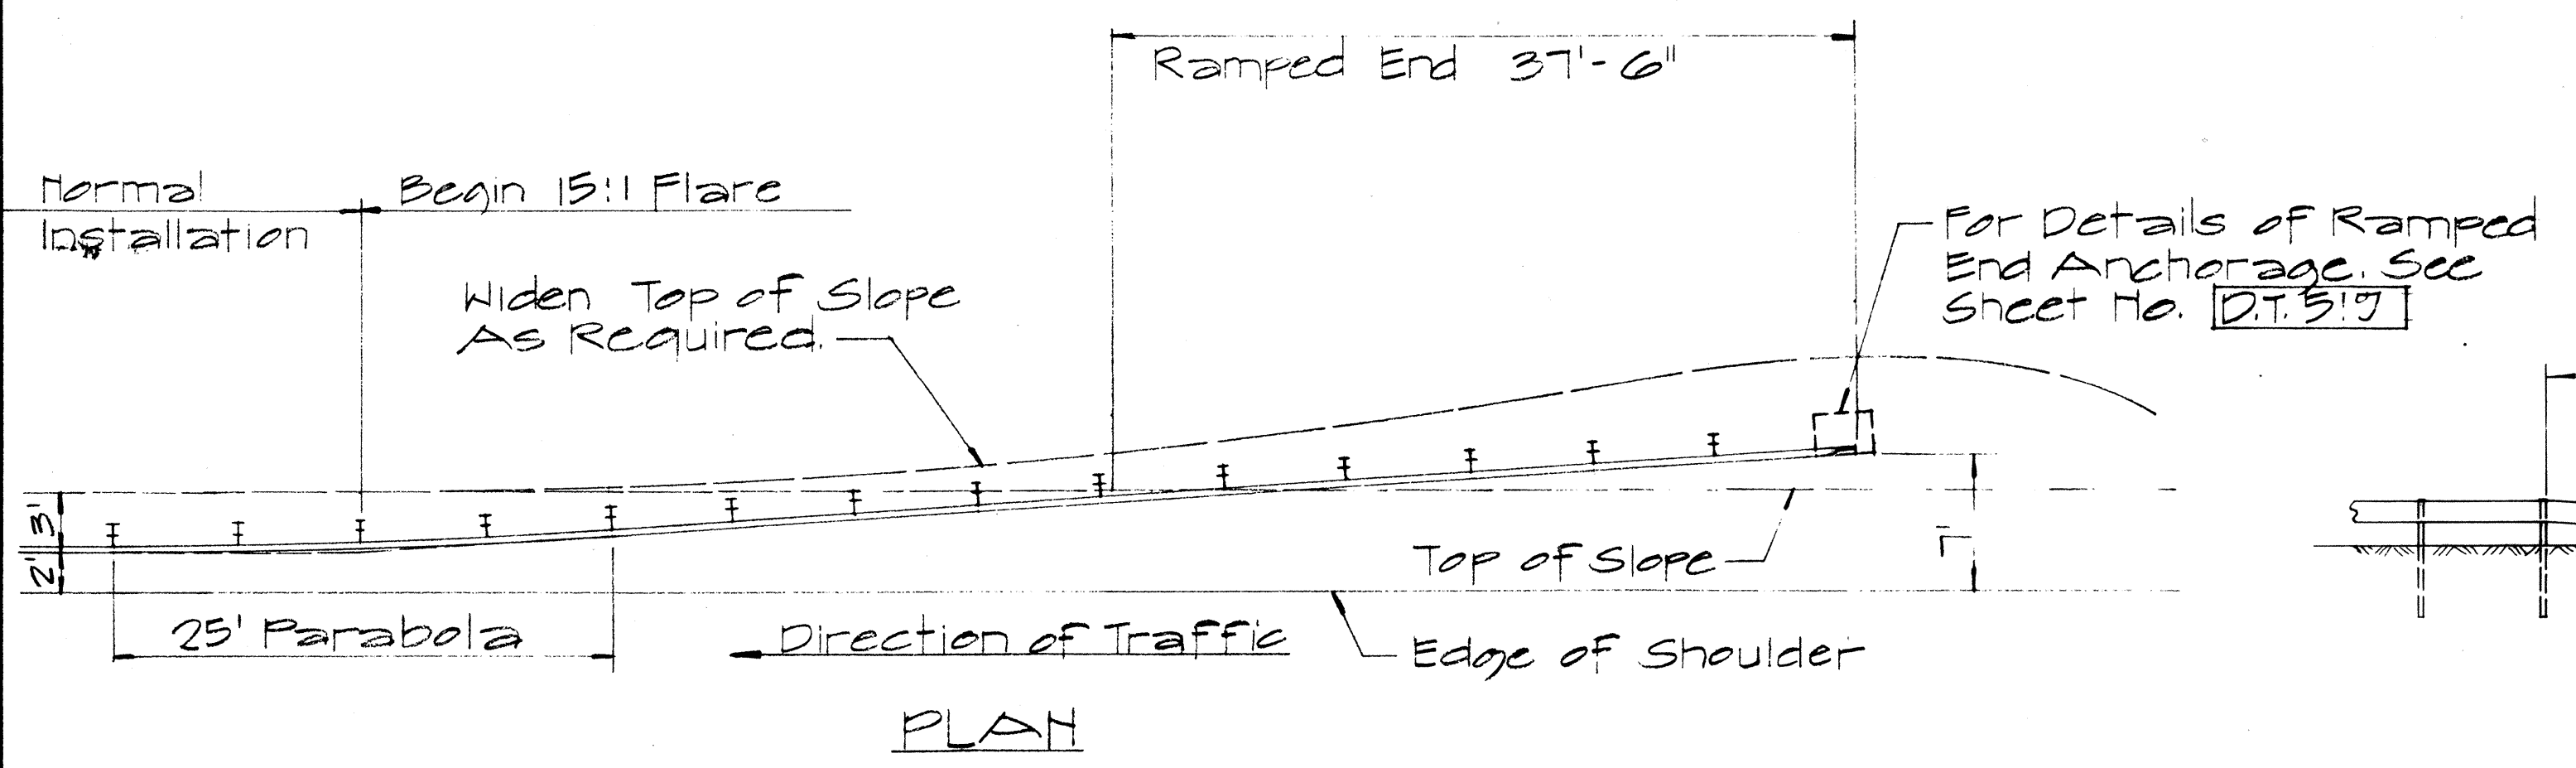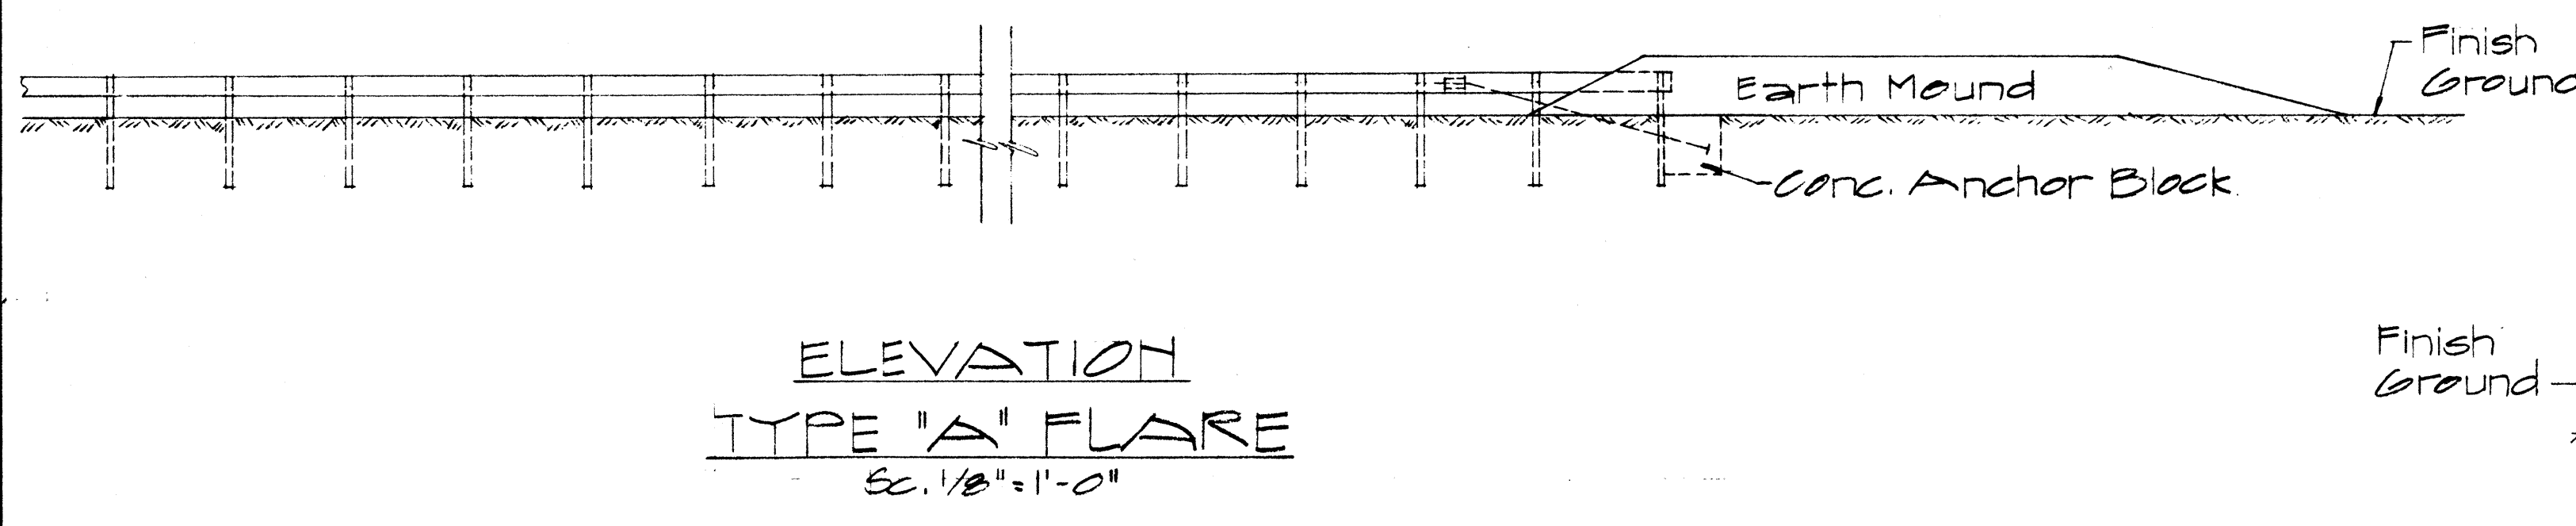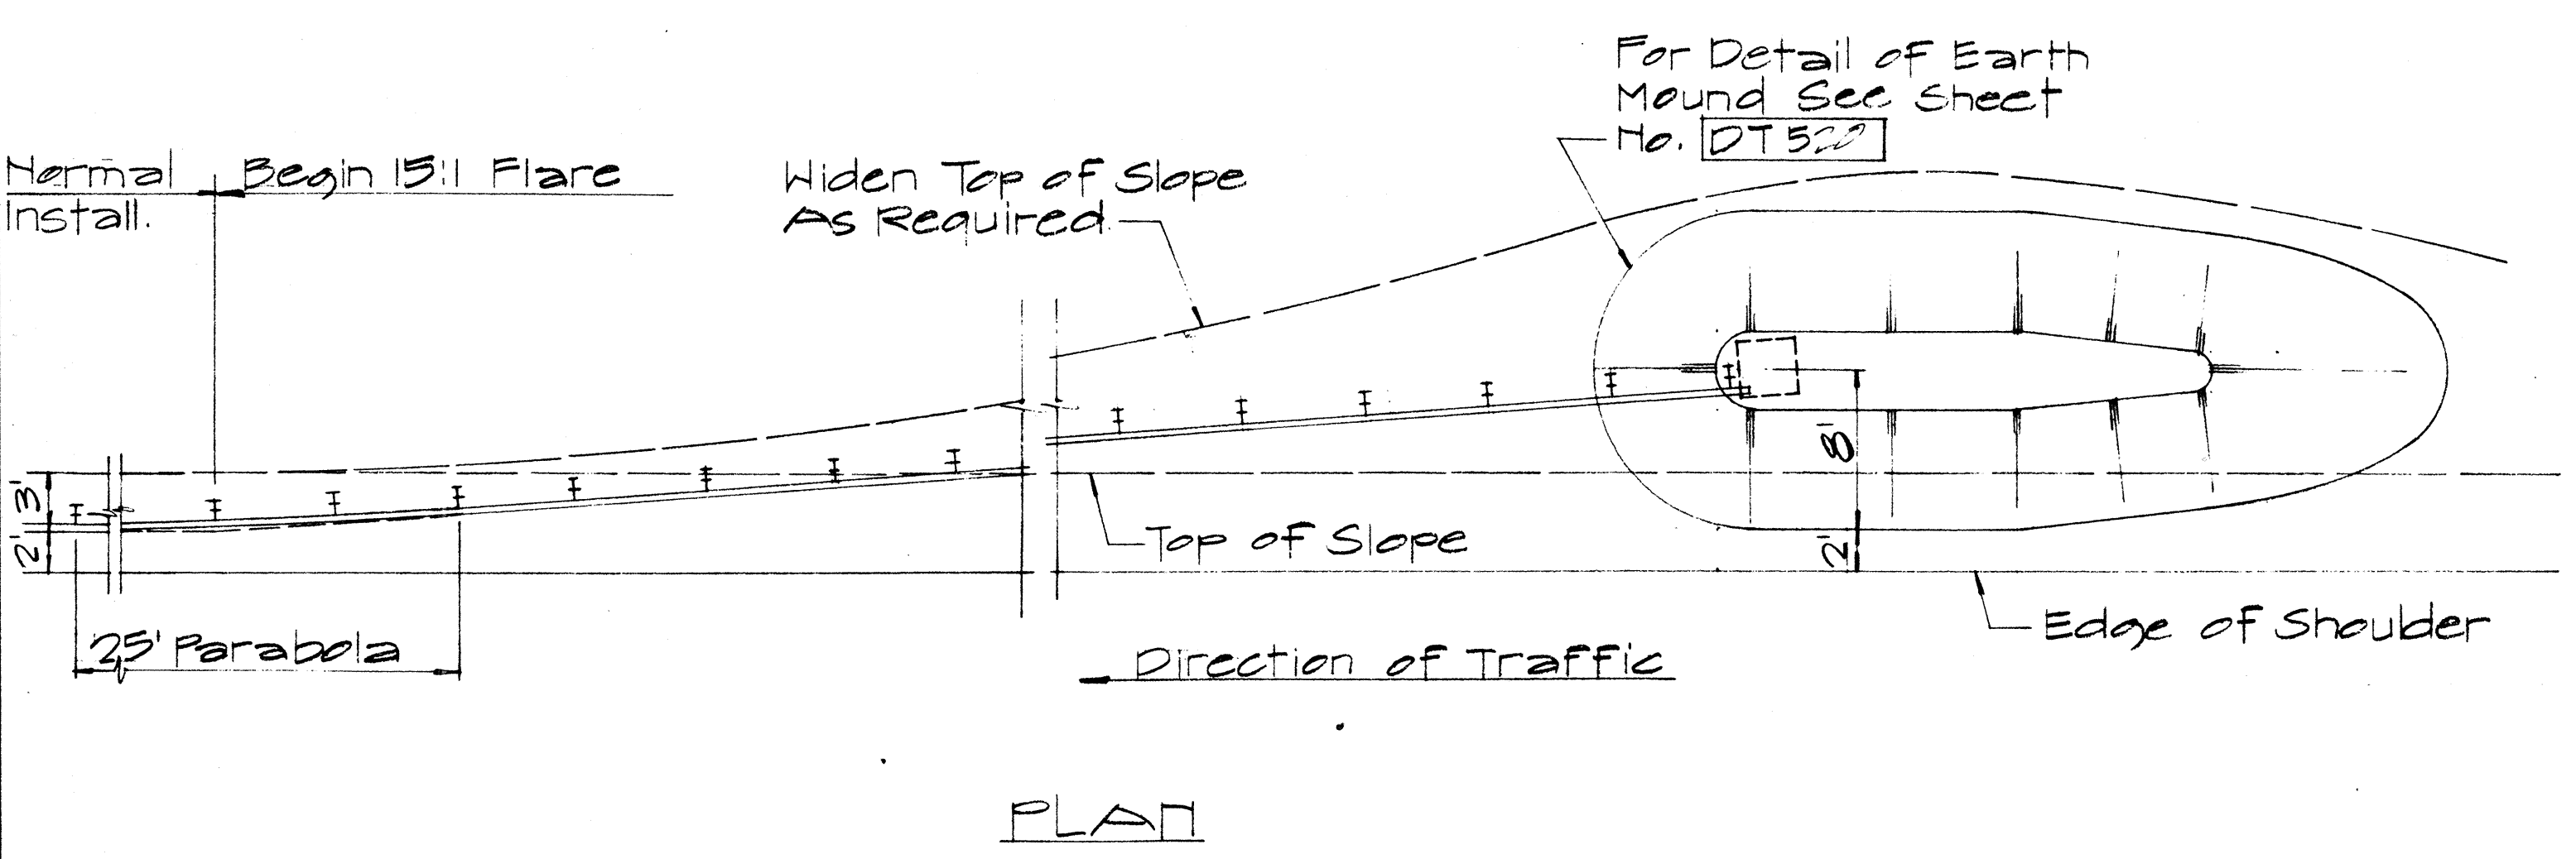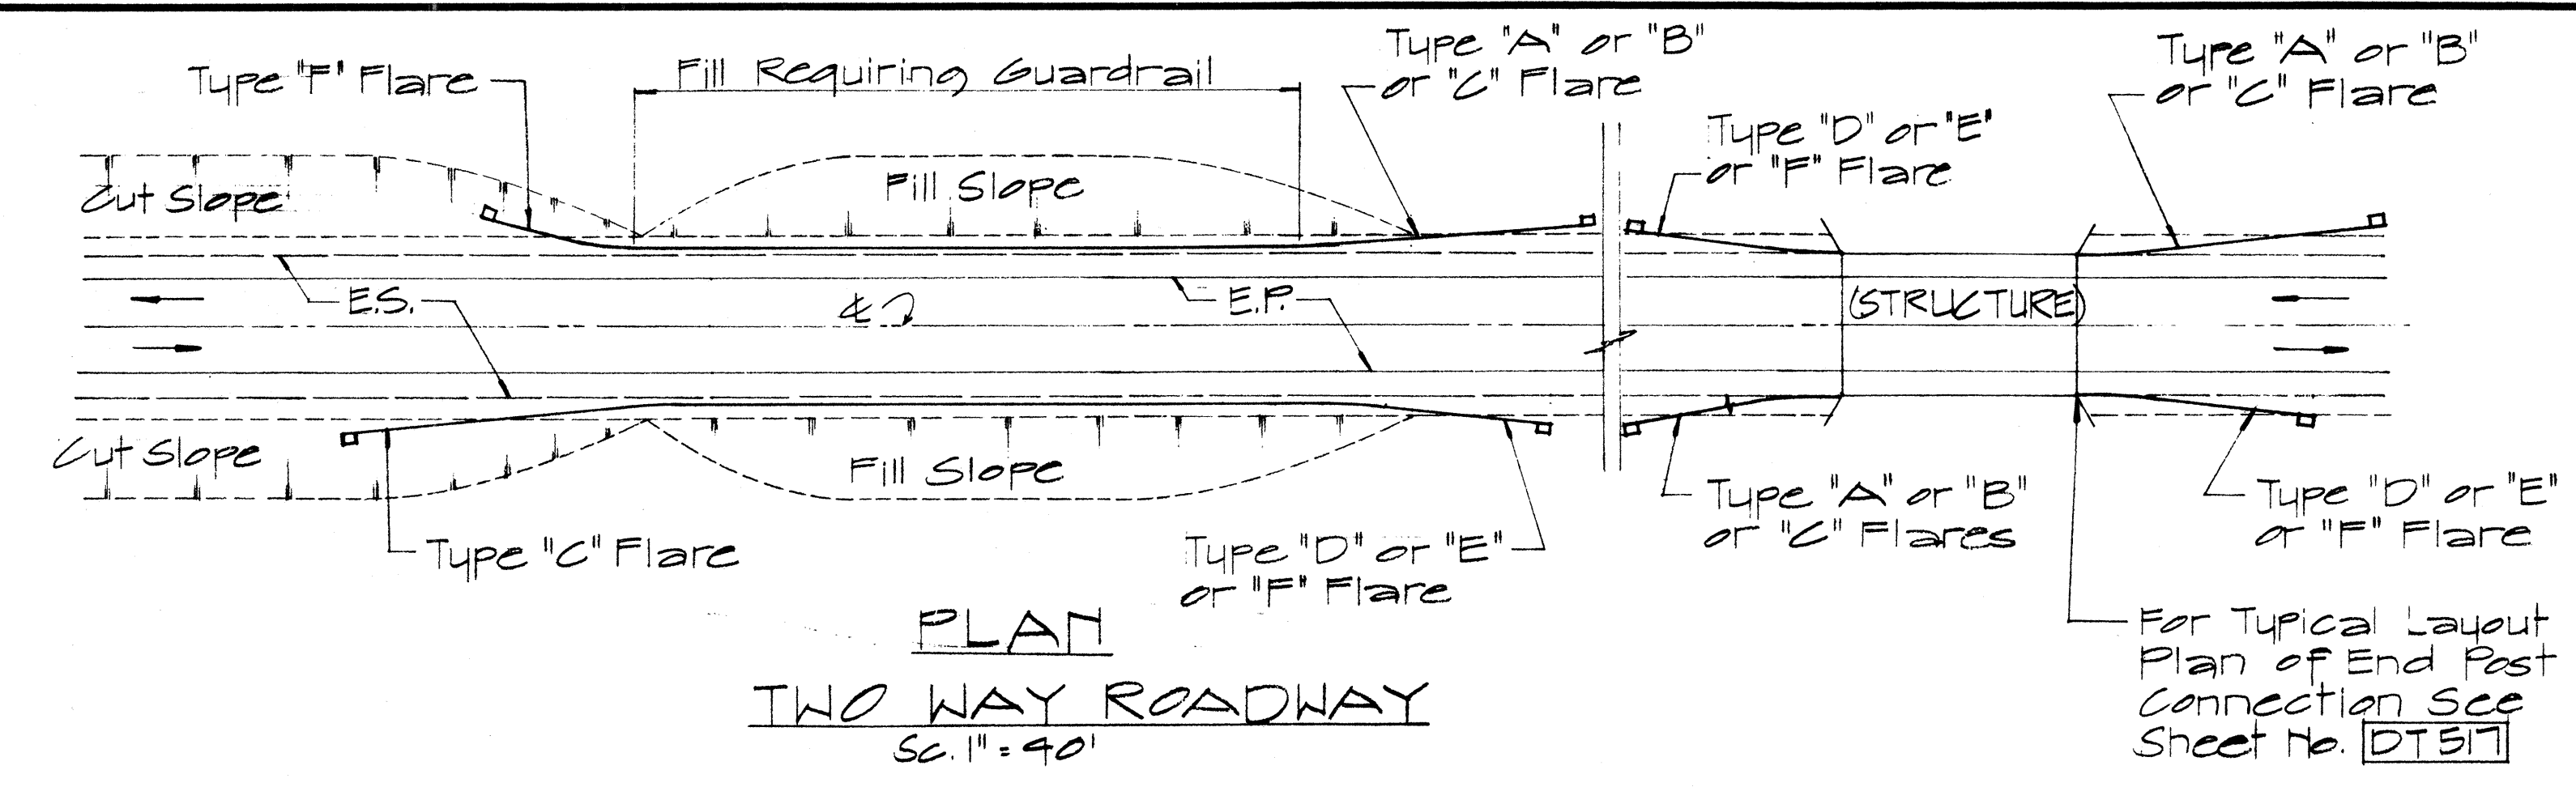

APPROVAL RECOMMENDED:
Evelyn Tanaka 12/29/62
TRAFFIC ENGINEER DATE










APPROVED:
W. S. S. S. 12-30-69
ASSISTANT CHIEF, ENGINEERING DATE

NO.	REVISION	APPROVED BY	DATE

STATE OF HAWAII
DEPARTMENT OF TRANSPORTATION
LAND TRANSPORTATION FACILITIES DIVISION
**STANDARD DETAILS
OF APPROACH END
FLARE - ONE & TWO
WAY ROADWAY**
Sc. As Noted April 1969
SHEET No. 21 OF 26 SHEETS [DT 516]

DATE
SURVEY PLOTTED BY
DRAWN BY
CHECKED BY
NOTED BY
ORIGINAL PLAN
NOTE BOOK
No.

FED. ROAD DIST. NO.	STATE	FED. AID PROJ. NO.	FISCAL YEAR	SHEET NO.	TOTAL SHEETS
HAWAII	HAW.	1-H1-1(31):17	1977	59	394

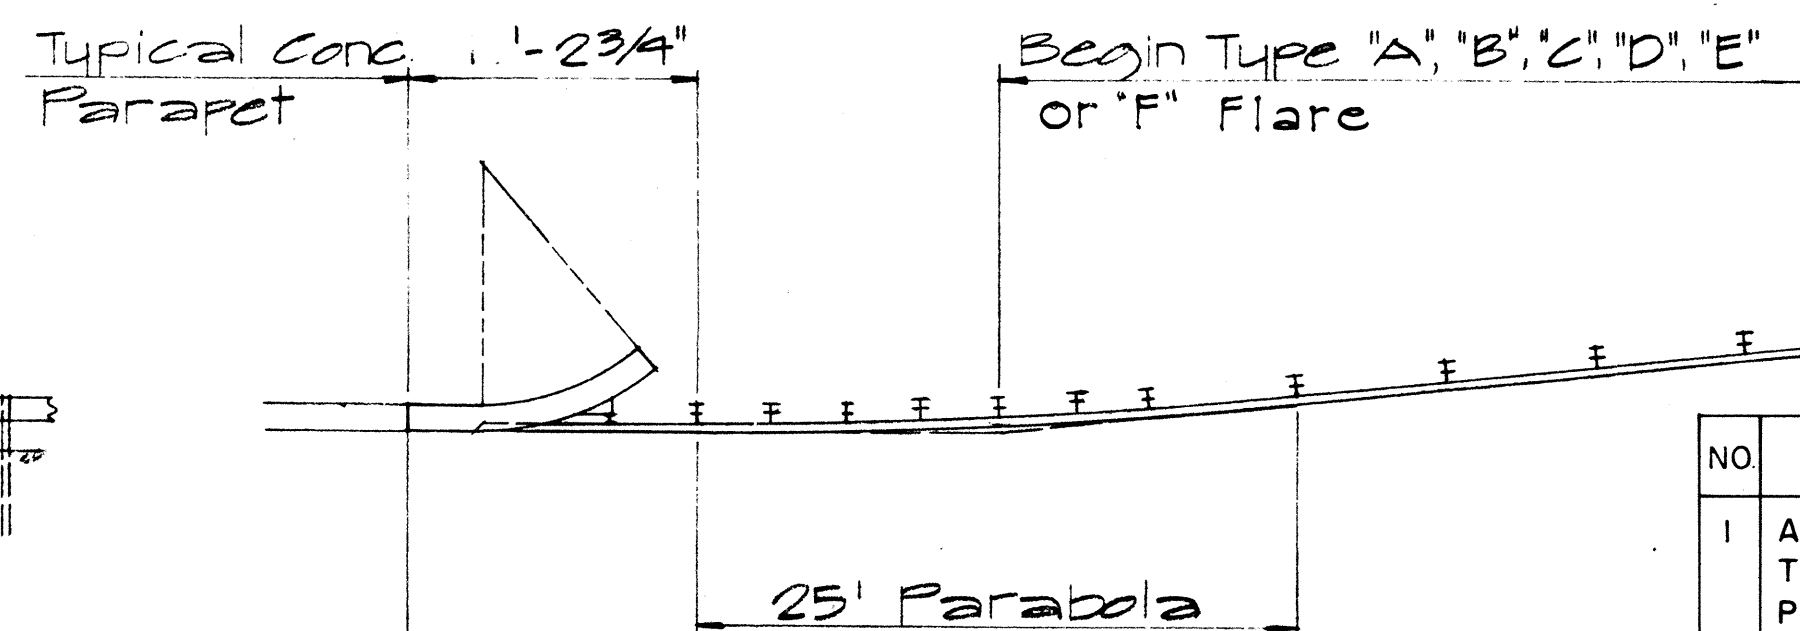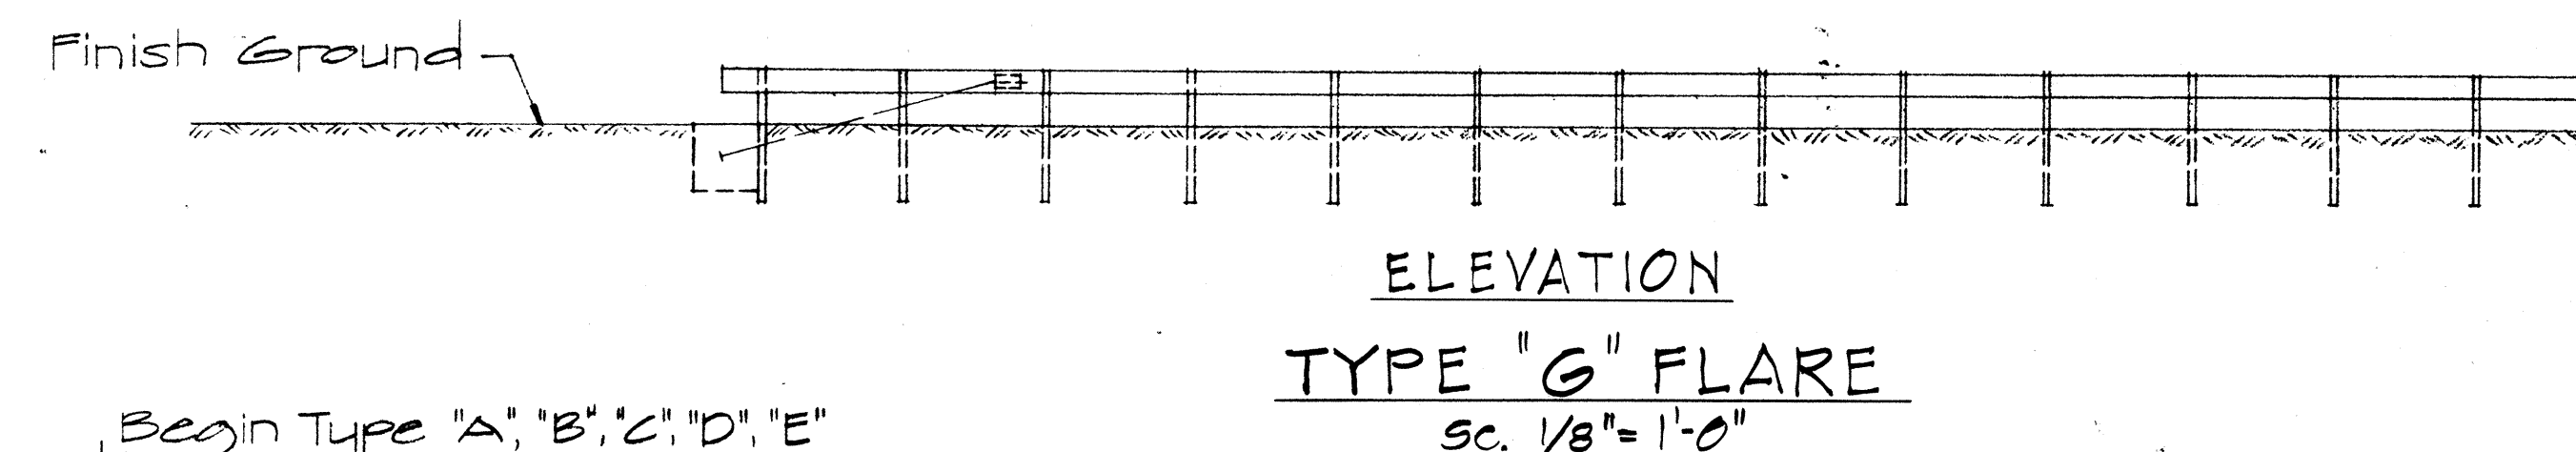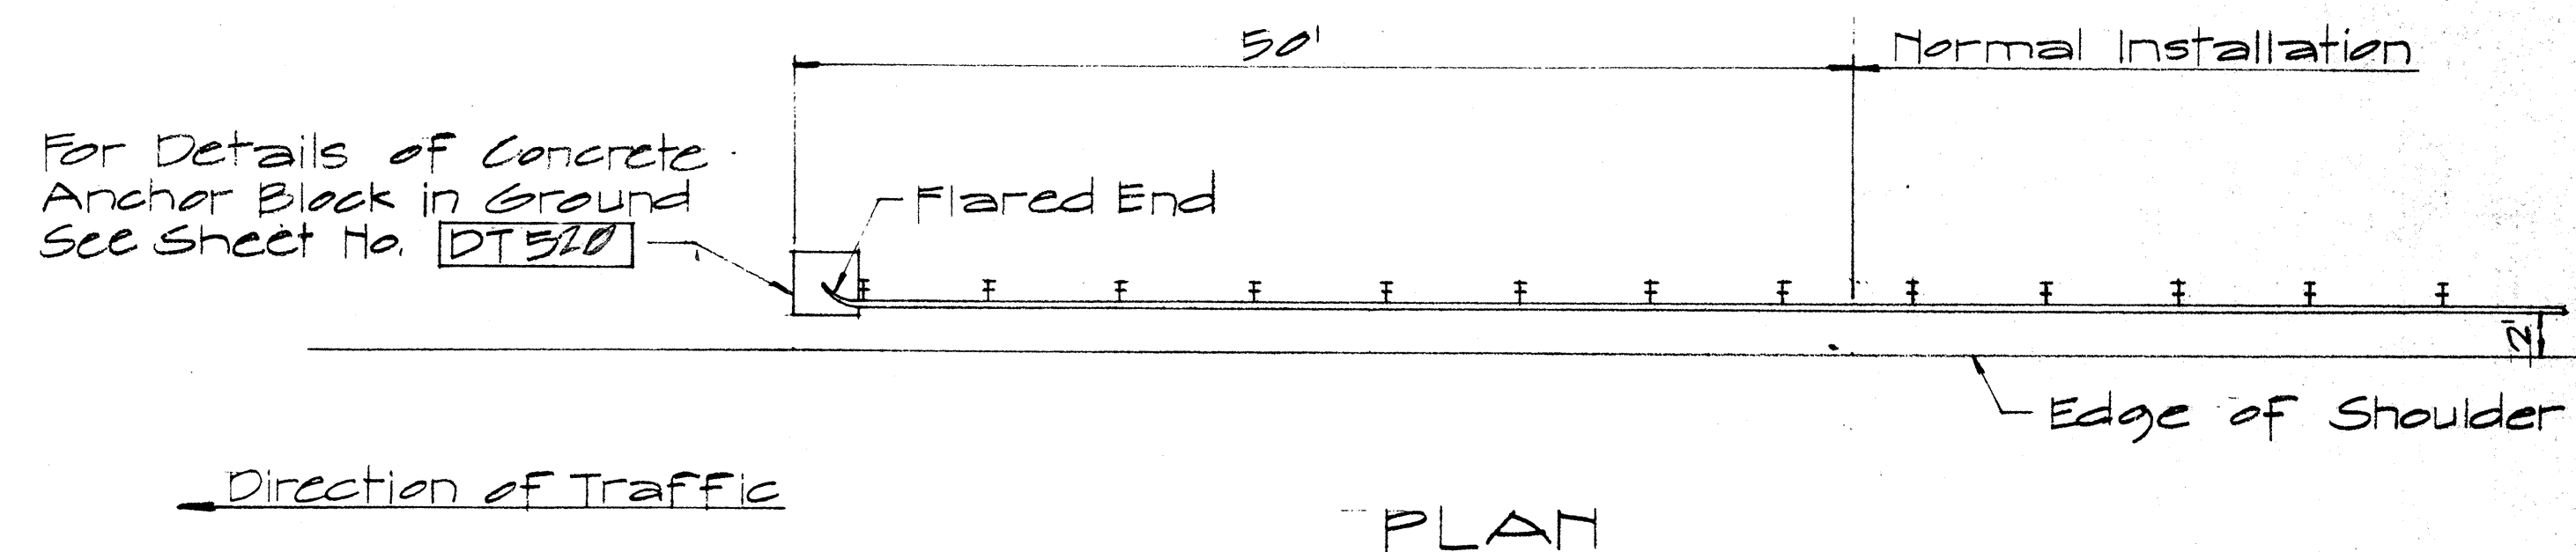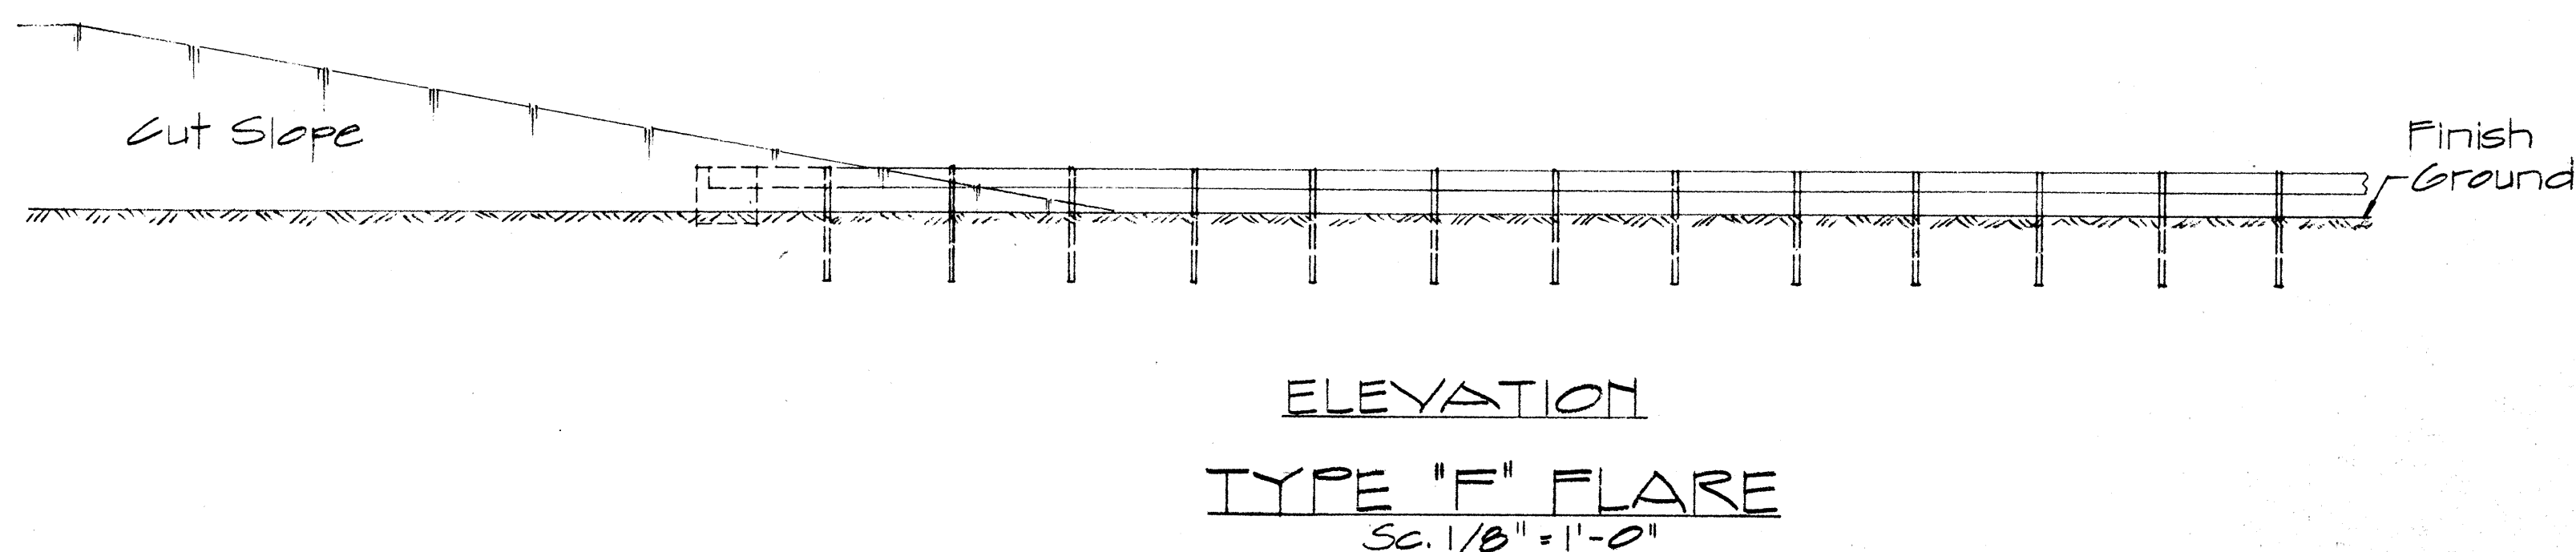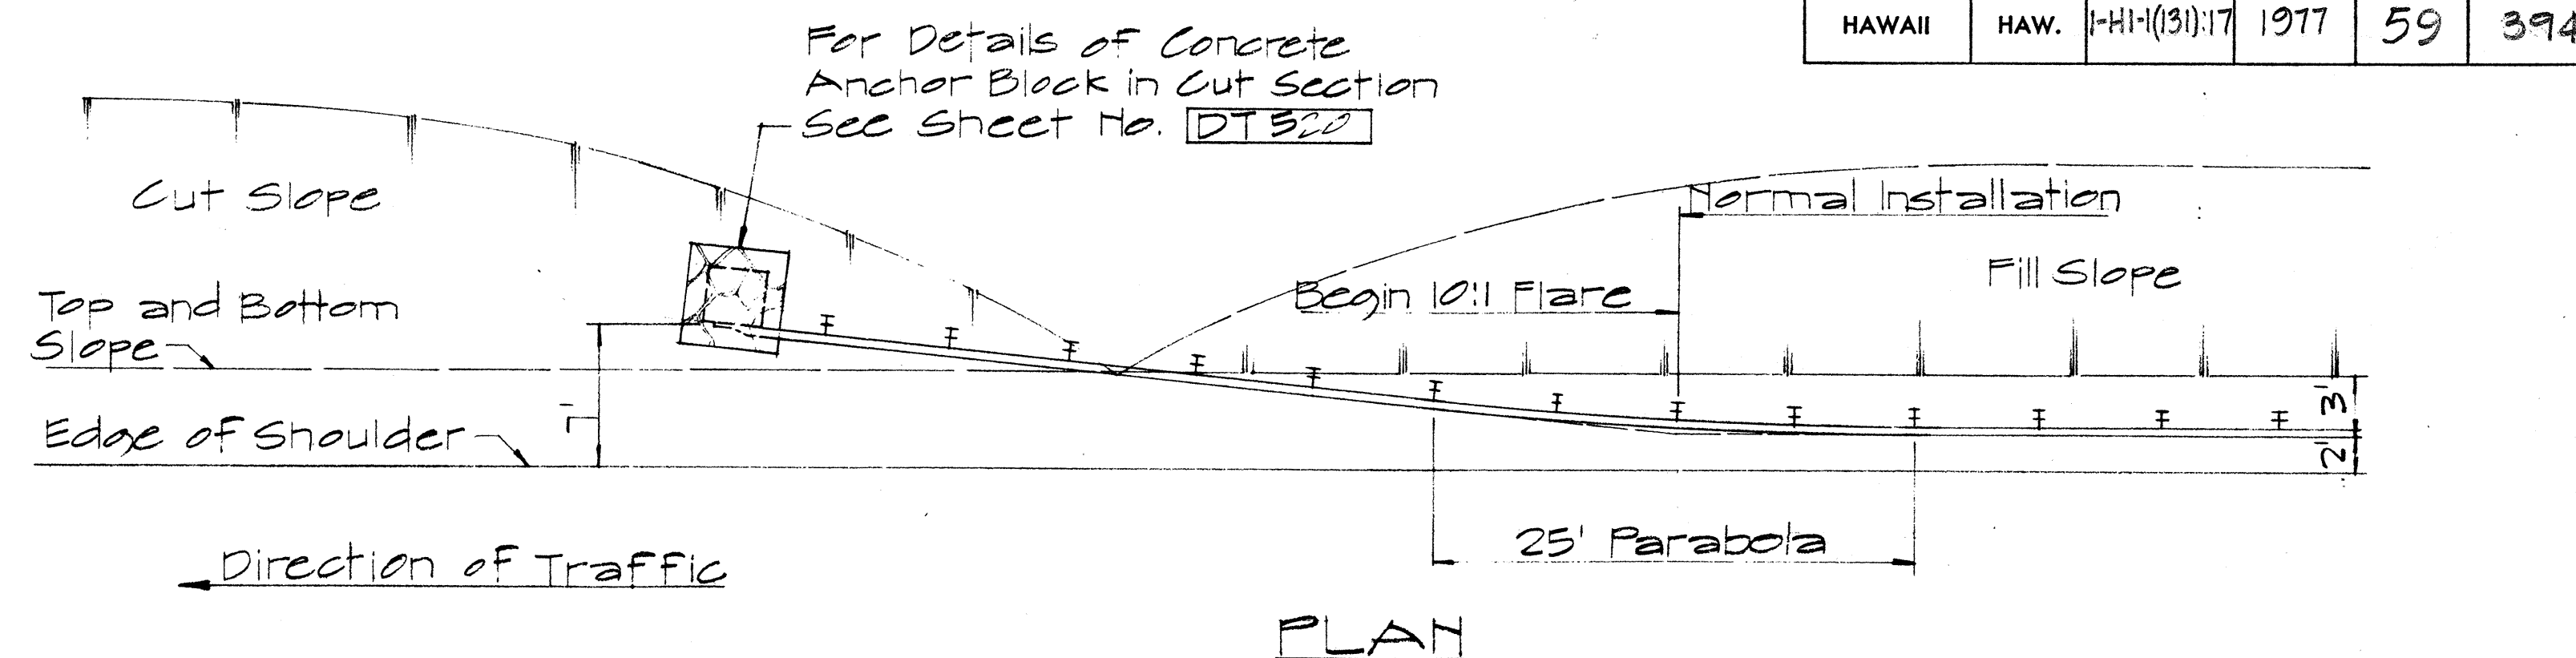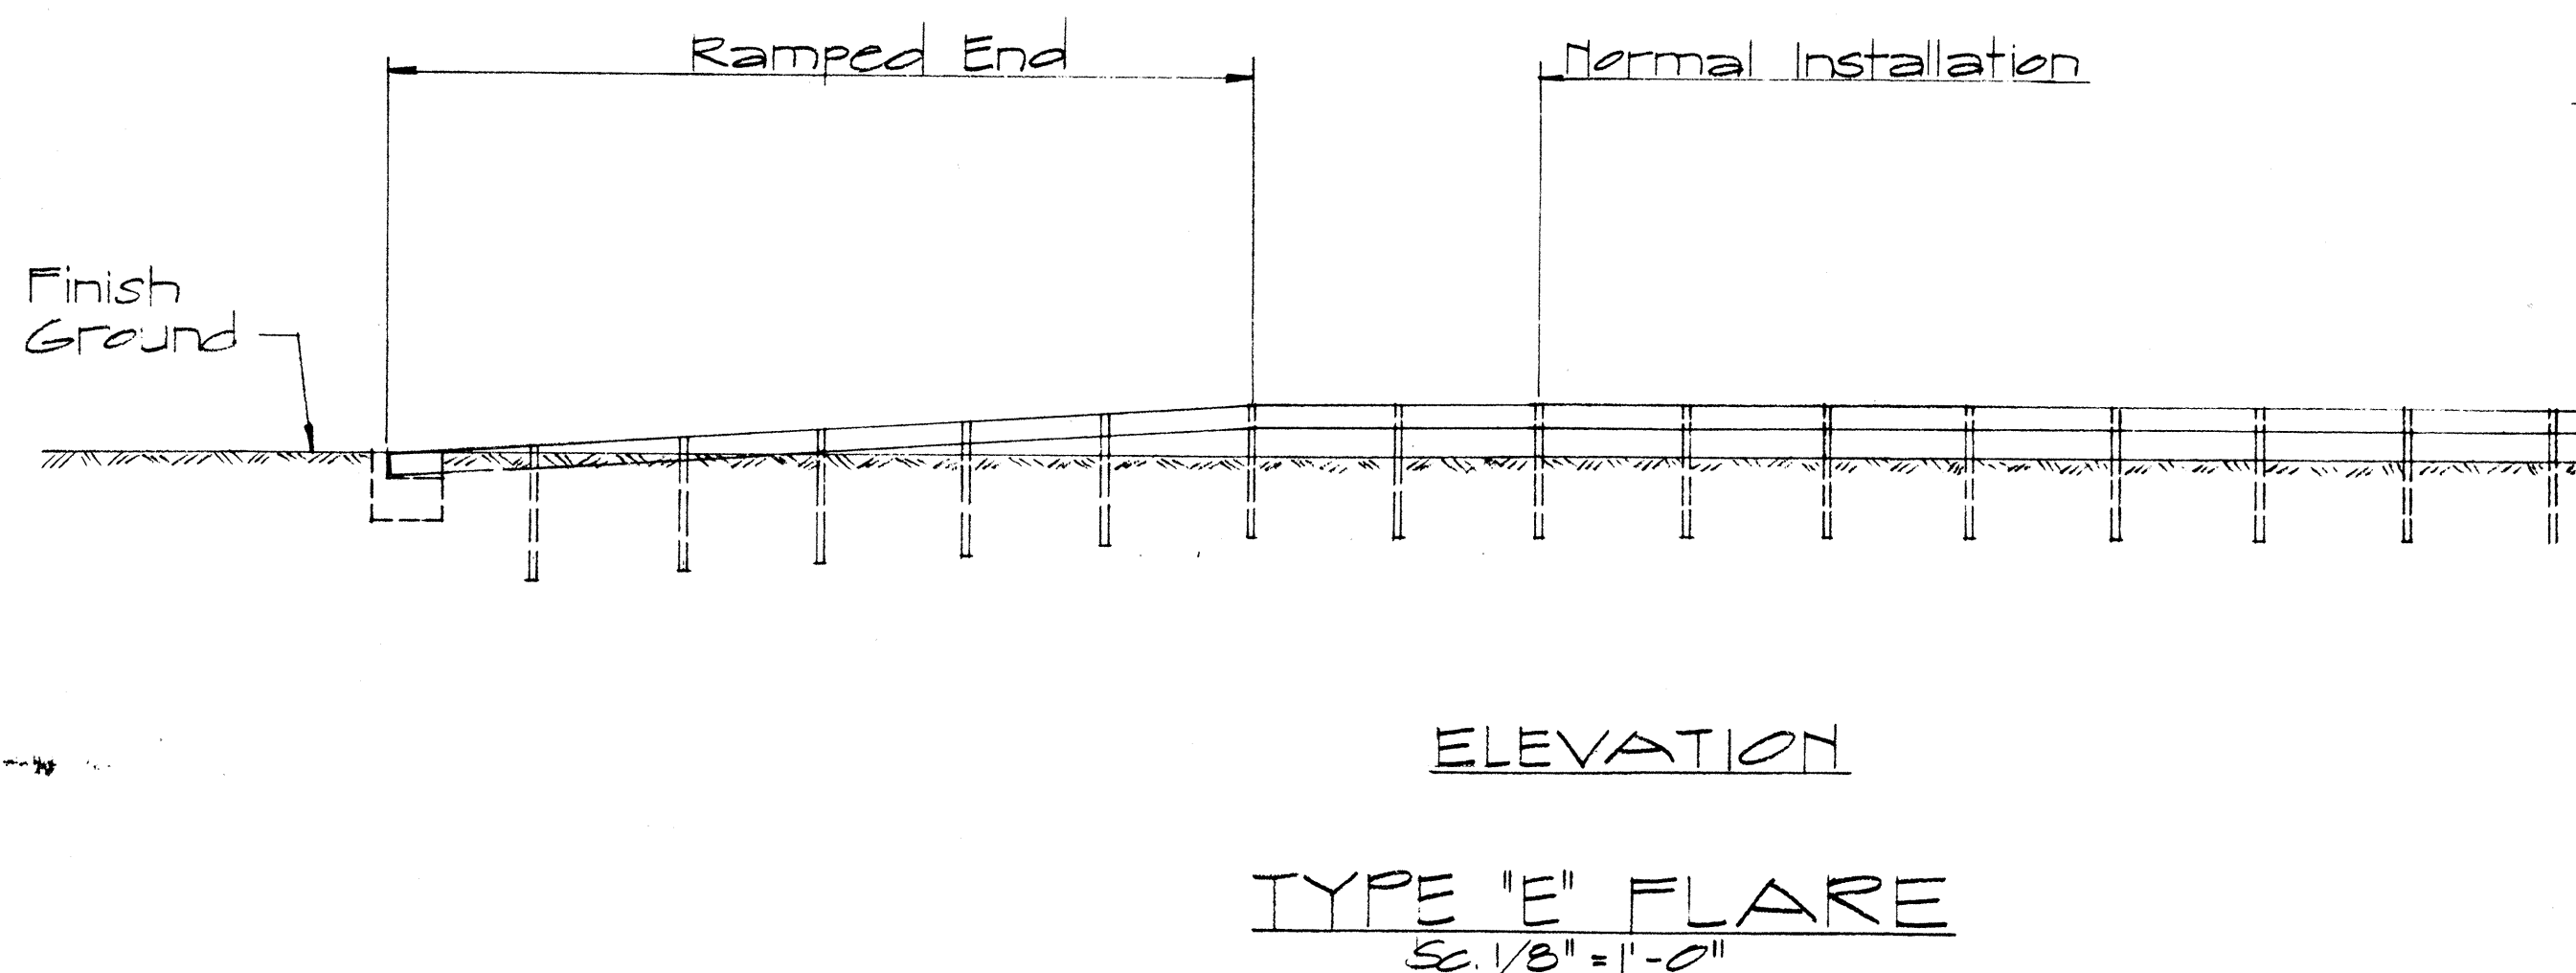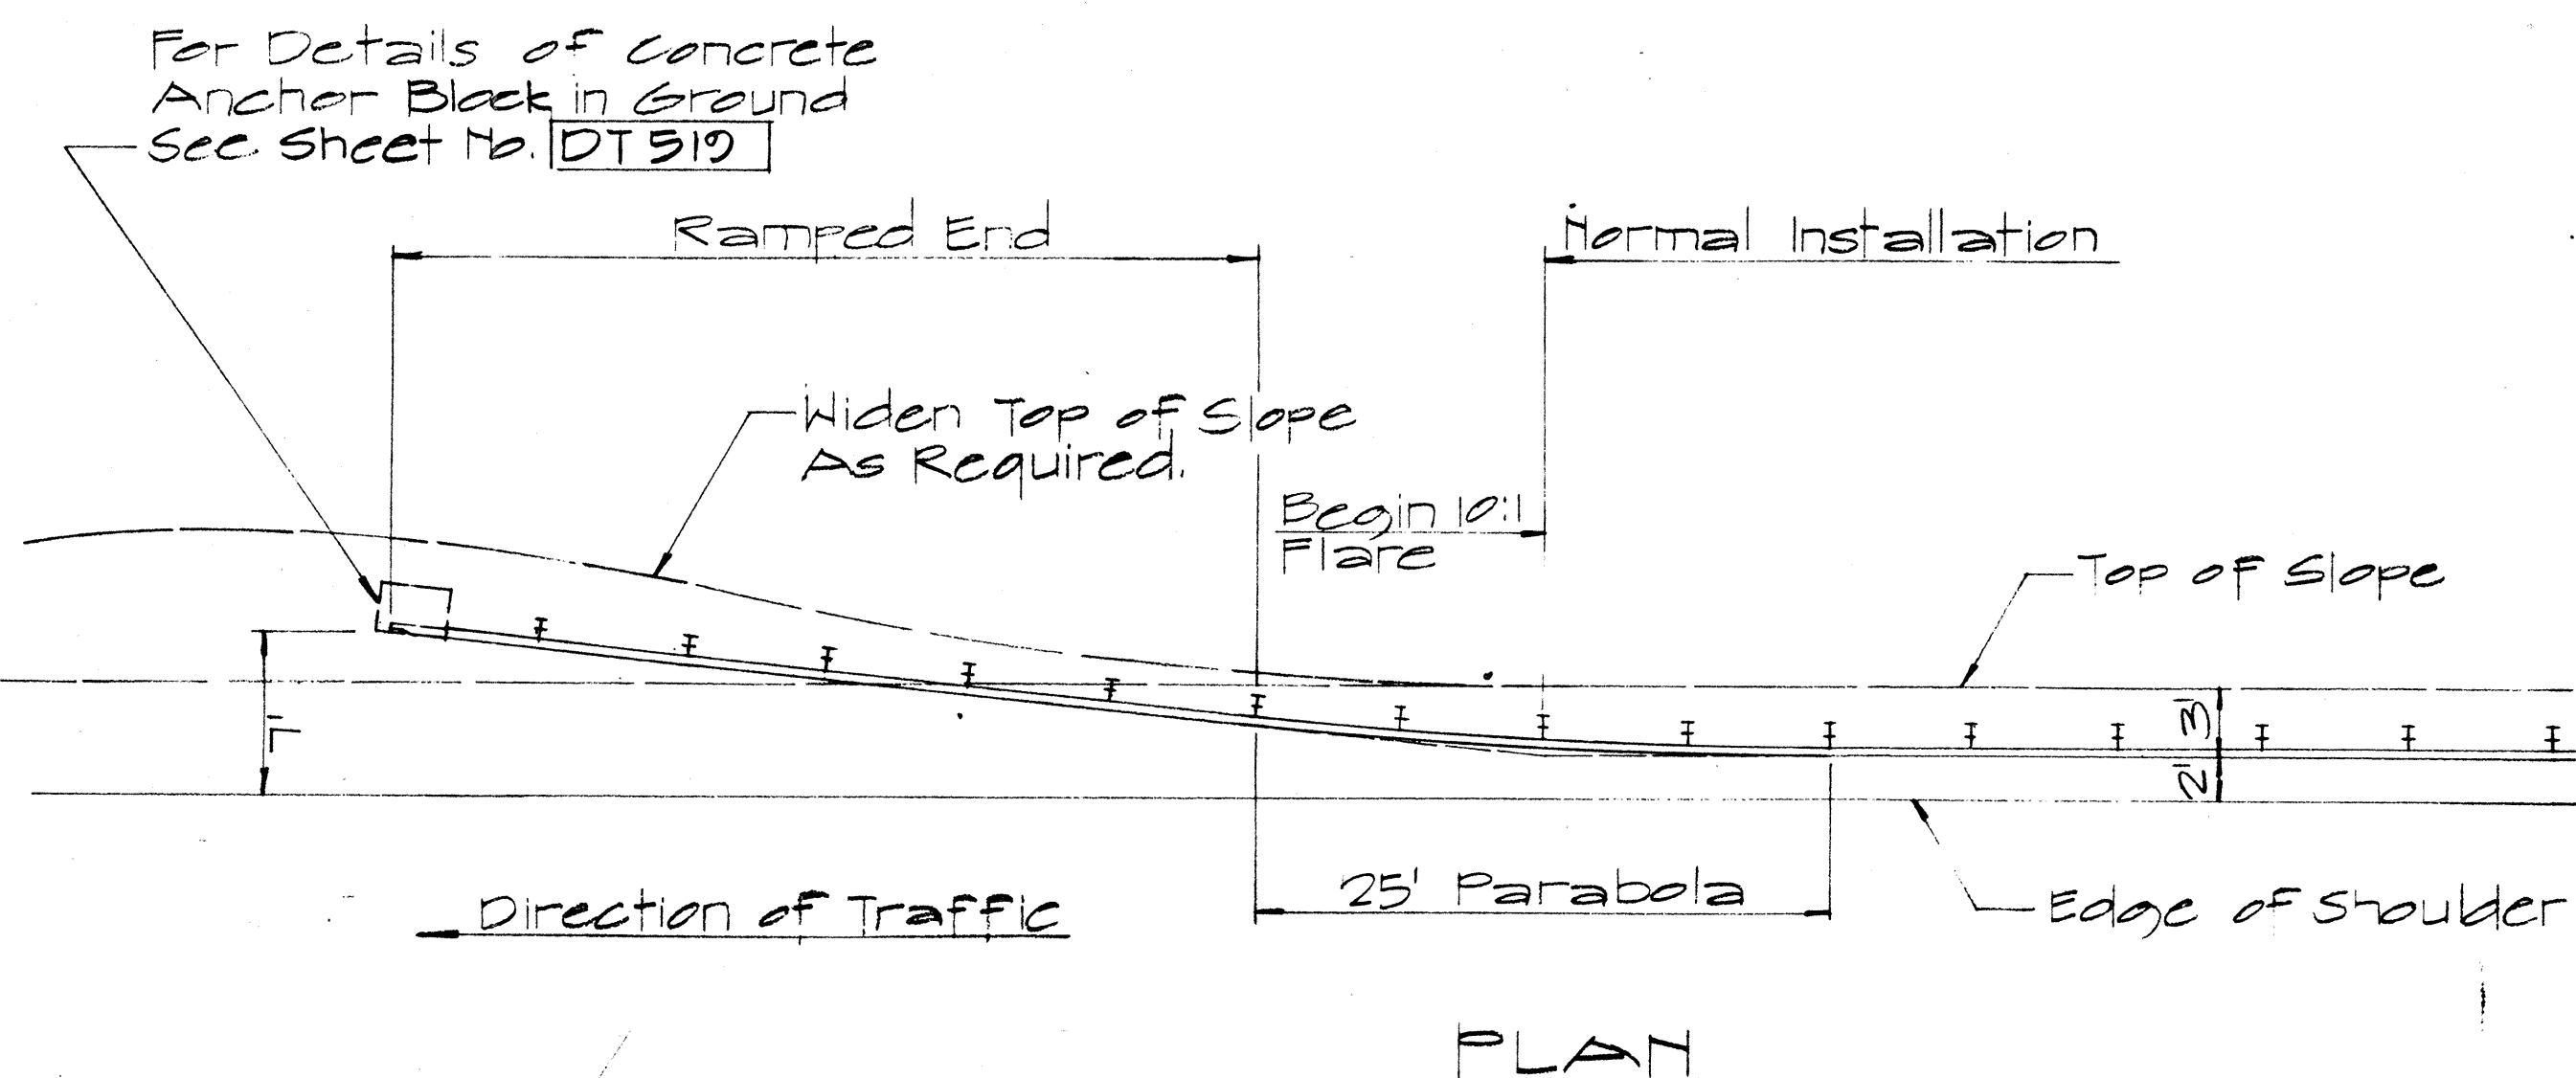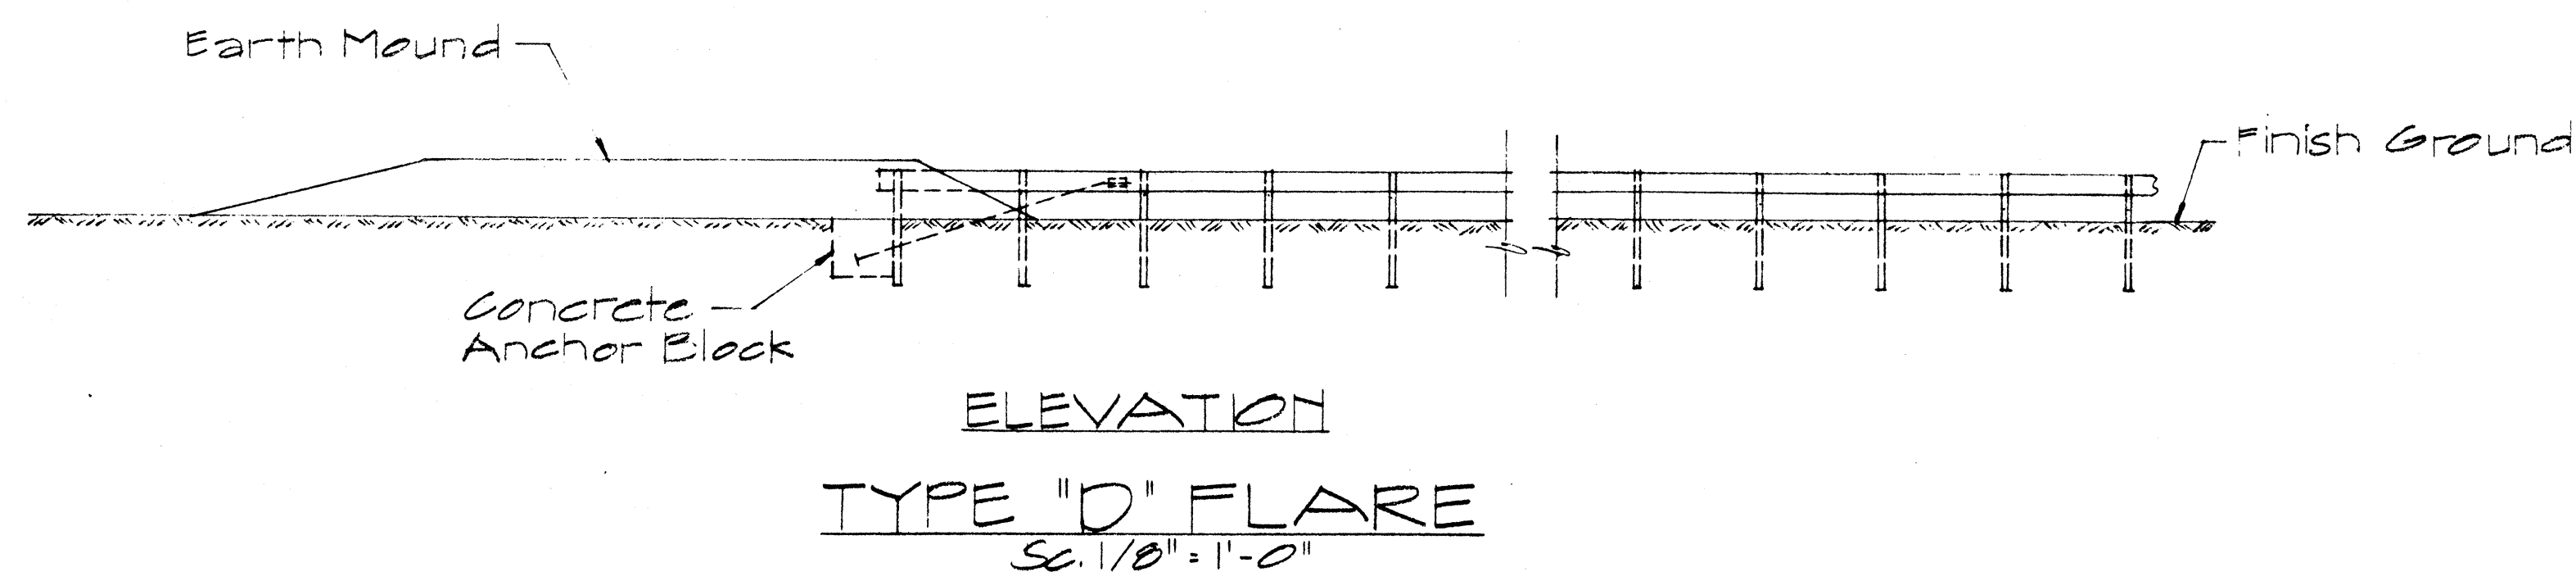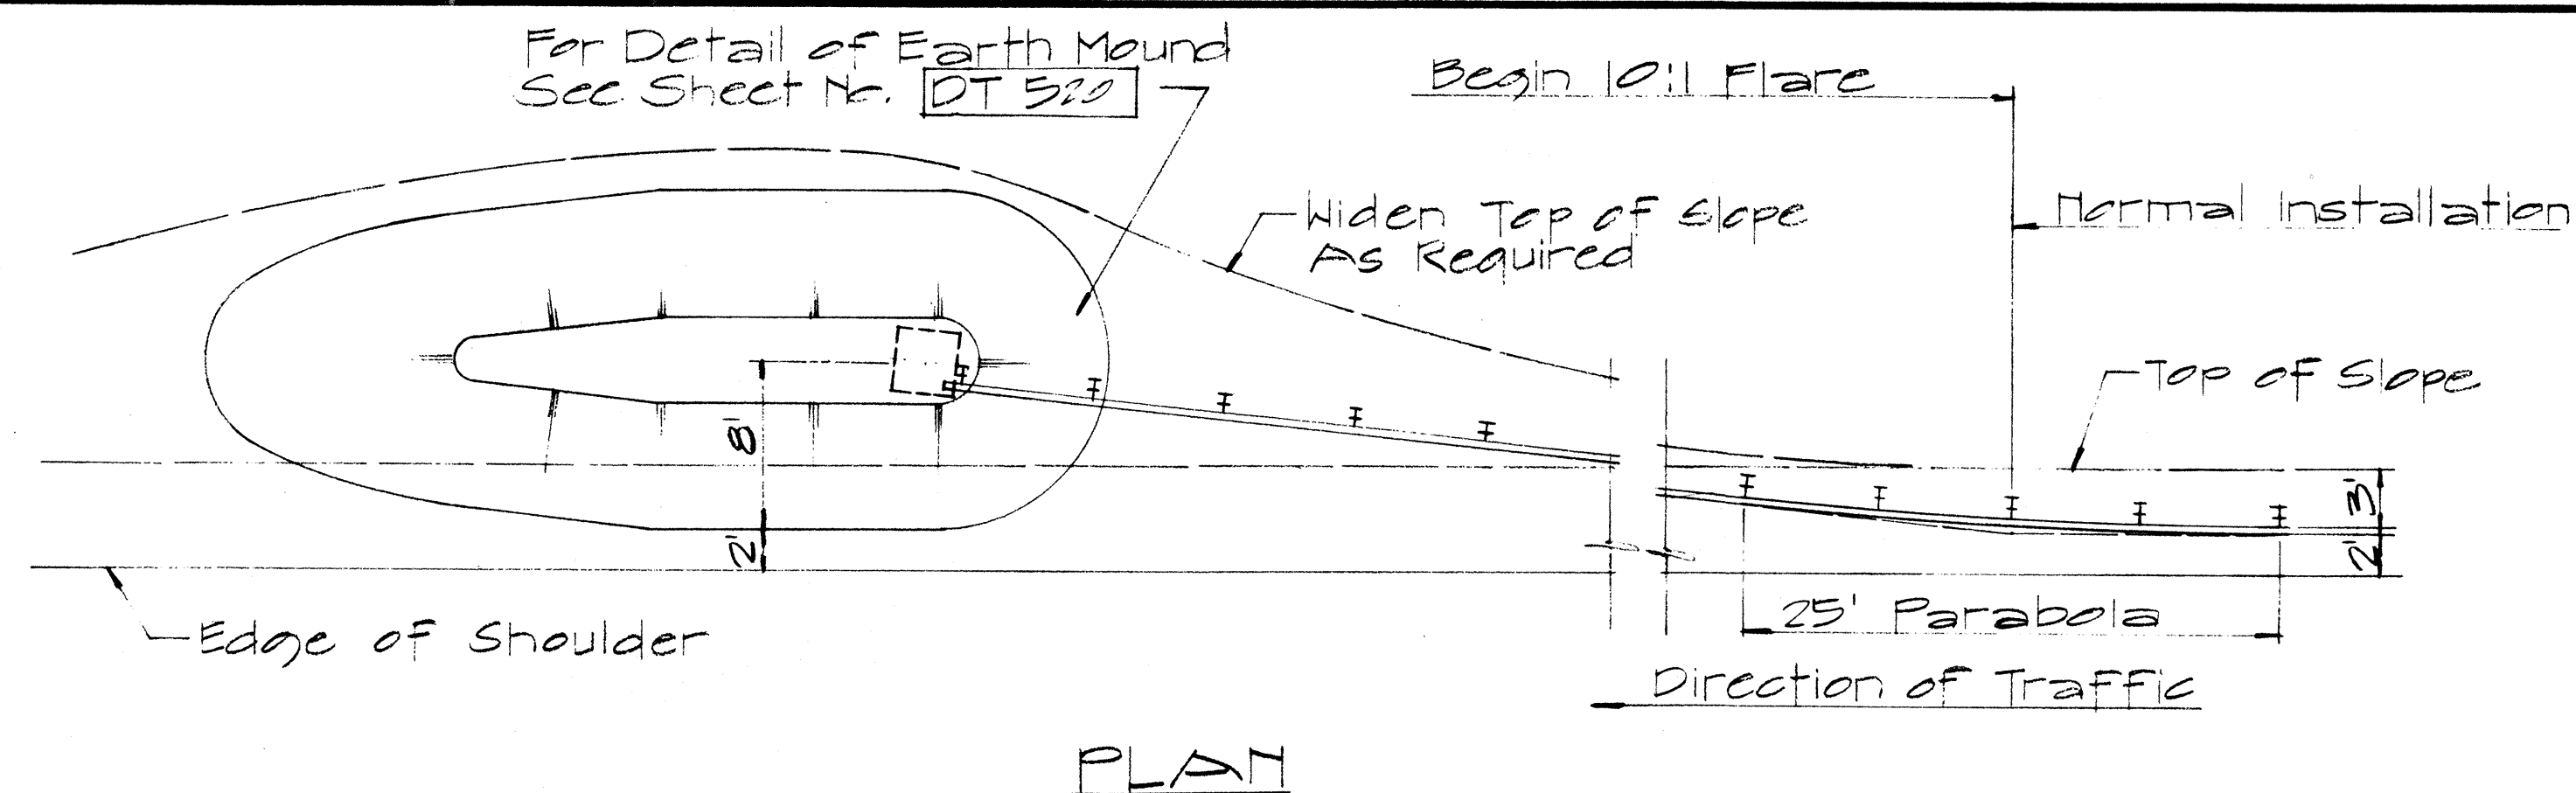

TYPICAL LAYOUT PLAN OF END POST CONNECTION

Sc. 1/8" = 1'-0"

NO.	REVISION	APPROVED BY	DATE
1	Additional Posts Added to Typical Layout Plan Of End Post Connection	H.T.	4-12-72

APPROVAL RECOMMENDED:
Eishi Tanaka 12/29/63
 TRAFFIC ENGINEER DATE


APPROVED:
Wm. S. Sal 12-29-69
 ASSISTANT CHIEF, ENGINEERING DATE

STATE OF HAWAII
 DEPARTMENT OF TRANSPORTATION
 LAND TRANSPORTATION FACILITIES DIVISION


STANDARD DETAILS
 TRAILING END
 FLARE - ONE & TWO
 WAY ROADWAY

Scale: As Noted April 1967
 SHEET No. 22 OF 26 SHEETS DT 517

FED. ROAD DIST. NO.	STATE	FED. AID PROJ. NO.	FISCAL YEAR	SHEET NO.	TOTAL SHEETS
HAWAII	HAW.	1-HI-1(131)-17	1977	60	394

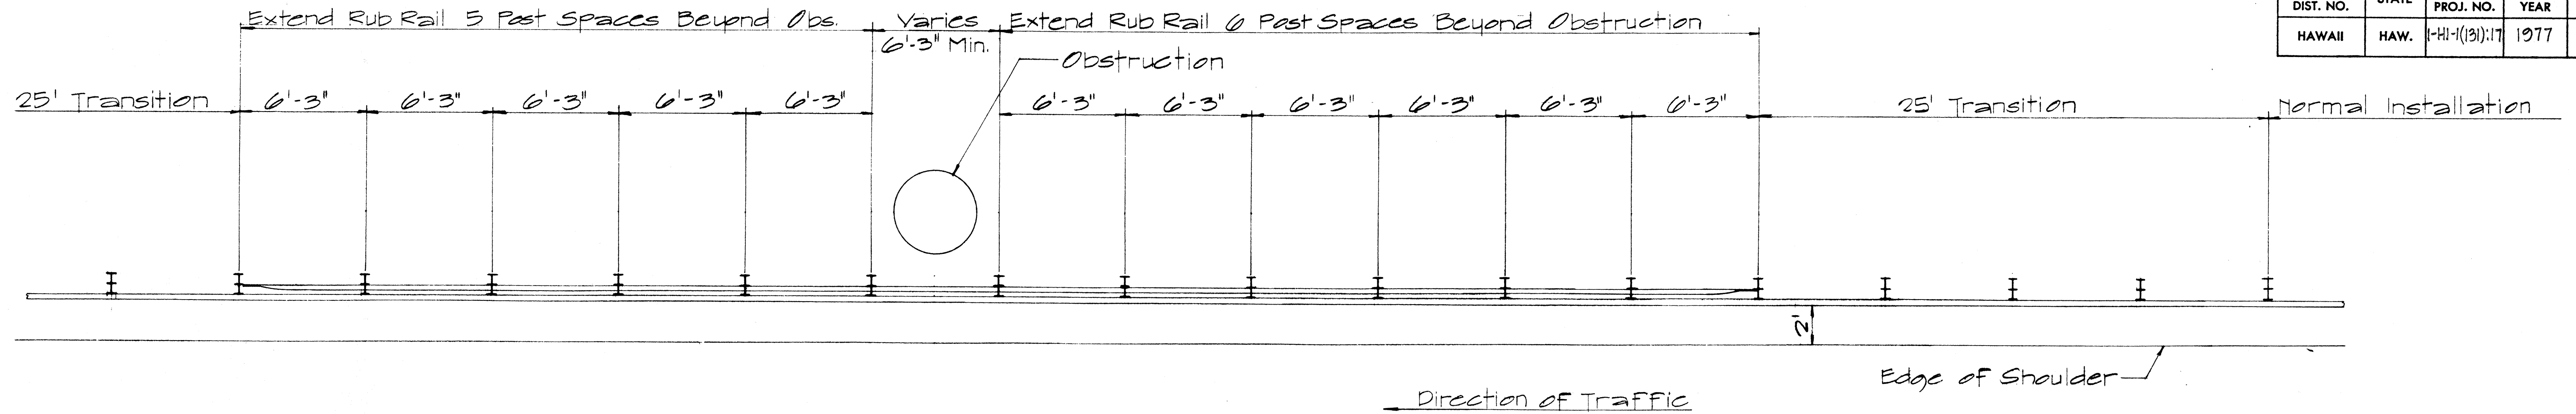


PLAN

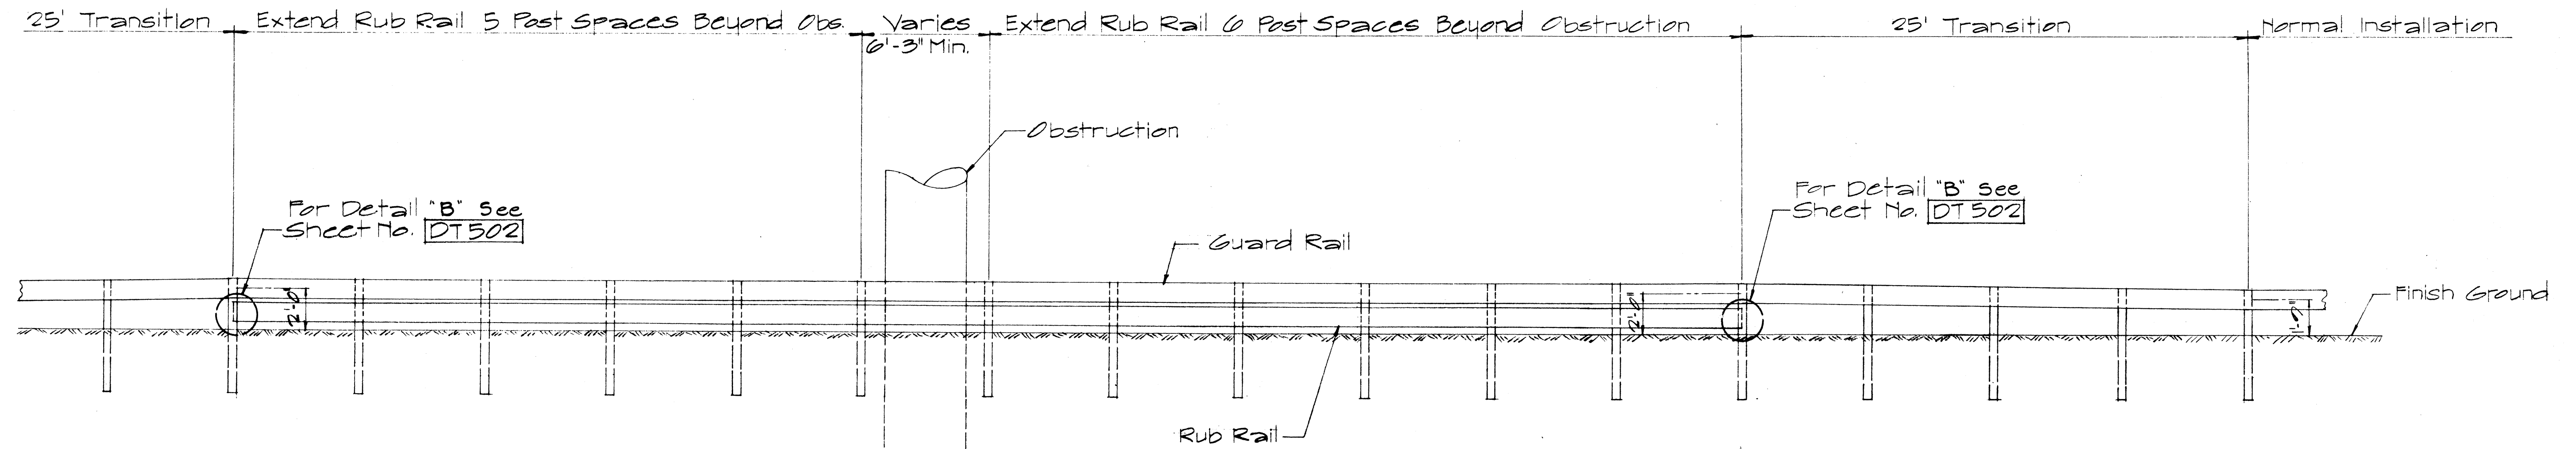

ELEVATION

DETAIL OF BEAM TYPE GUARD RAIL WITH RUB RAIL AT OBSTRUCTION
SC. 1/4" = 1'-0"

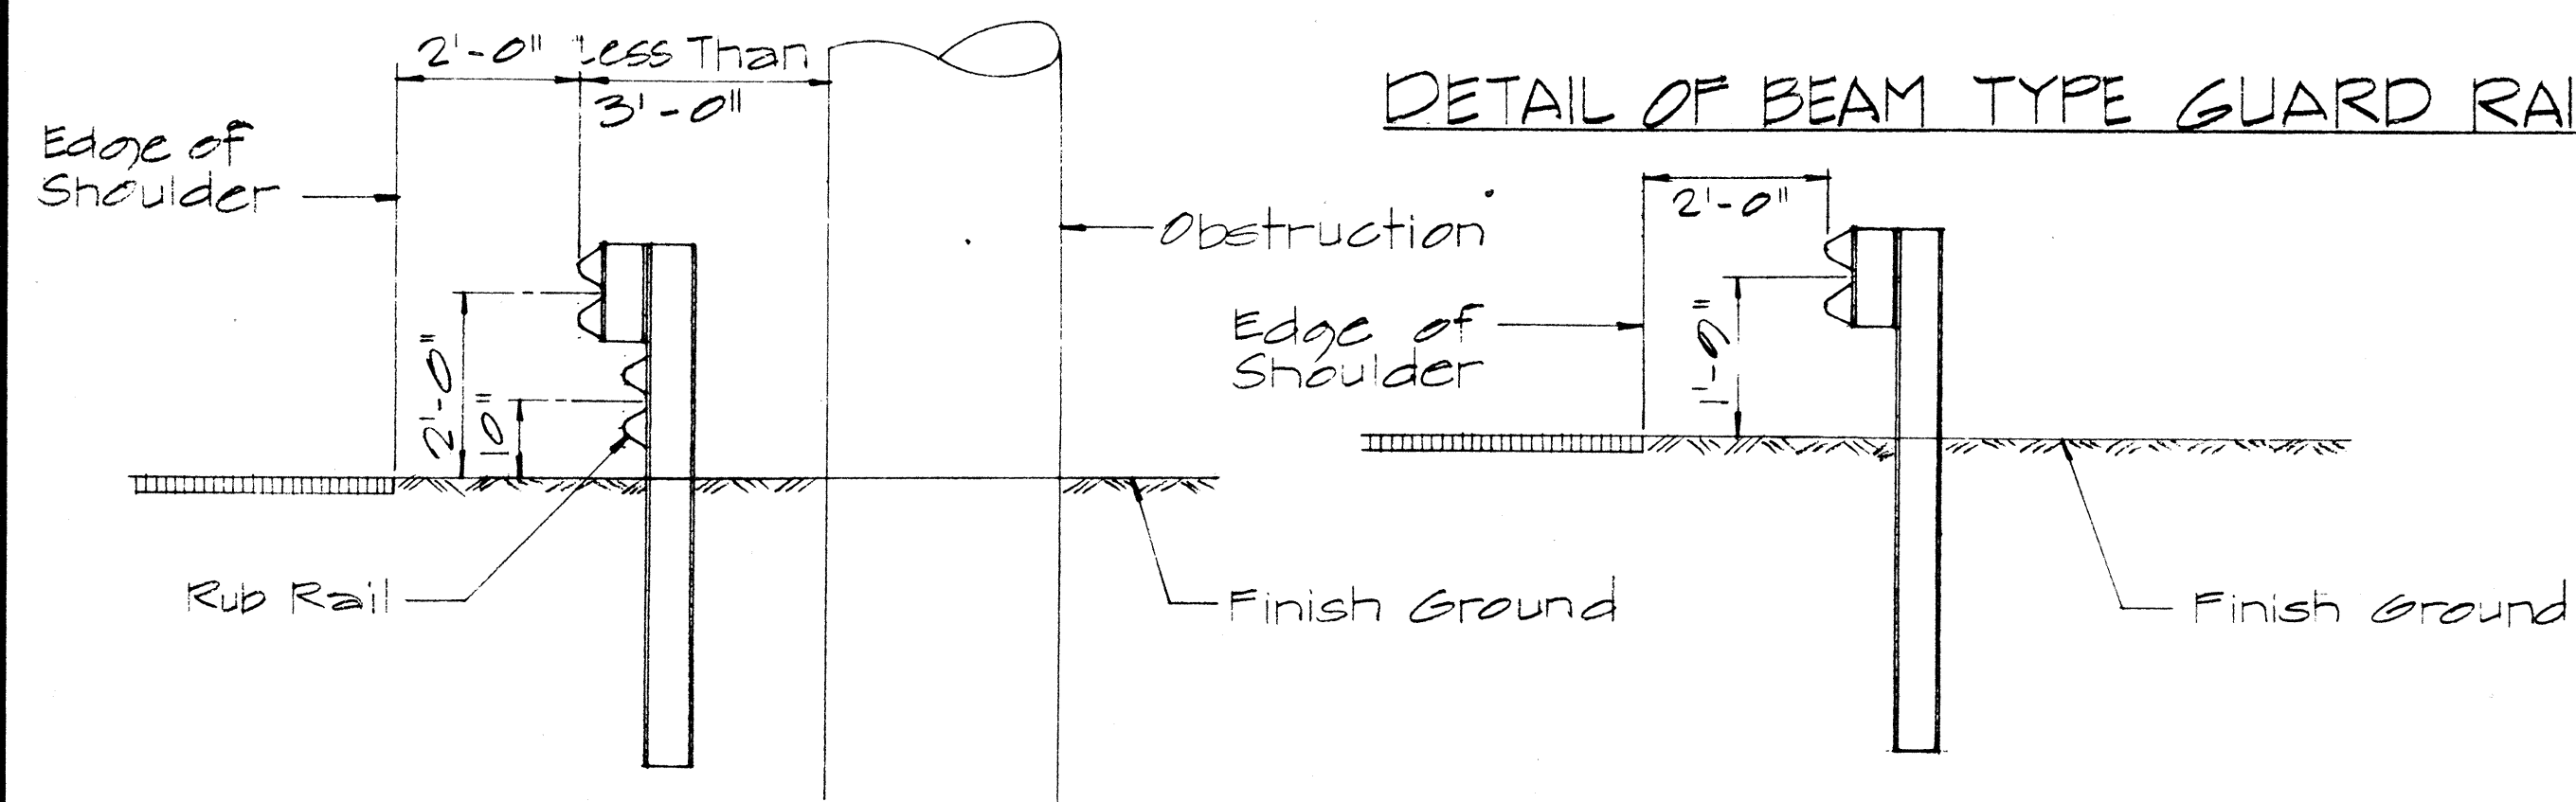

TYP. SEC. AT OBSTRUCTION

TYP. SEC. AT NORMAL INSTALLATION

TYP. GUARD RAIL SECTIONS
SC. 1/2" = 1'-0"

APPROVAL RECOMMENDED:
E. Ichi Tanaka
TRAFFIC ENGINEER
12/29/69
DATE

APPROVED:
John E. Selig
ASSISTANT CHIEF, ENGINEERING
12/30/69
DATE


NO.	REVISION	APPROVED BY	DATE

STATE OF HAWAII
DEPARTMENT OF TRANSPORTATION
LAND TRANSPORTATION FACILITIES DIVISION
STANDARD DETAIL
BEAM TYPE GUARD RAIL
WITH RUB RAIL AT OB-
STRUCTION (SHOULDER INSTALL)
SC. AS SHOWN
DATE: JUNE 1969
SHEET No. 23 OF 26 SHEETS DT 50

FED. ROAD DIST. NO.	STATE	FED. AID PROJ. NO.	FISCAL YEAR	SHEET NO.	TOTAL SHEETS
HAWAII	HAW.	I-41(121)-17	1977	61	394

- NOTES:**
- Anchor Plate and Anchor Cable Assembly (Standard Swaged Fitting and Stud). See Standard Detail Sheet No. DT 520.
 - Other Anchor Cable Assemblies may be used. Minimum breaking strength of assembly should be 40,000 lbs.
 - Second Terminal Post does not require holes to accomodate Anchor Cable.
 - Slip Base Load shall be controlled with a Calibrated Torque Wrench - Torque 155 - 170 ft. lbs.
 - Concrete shall be Class A.

NOTE:
This tracing is similar to Sheet C.O. 585-1, during 'As-Built' posting.

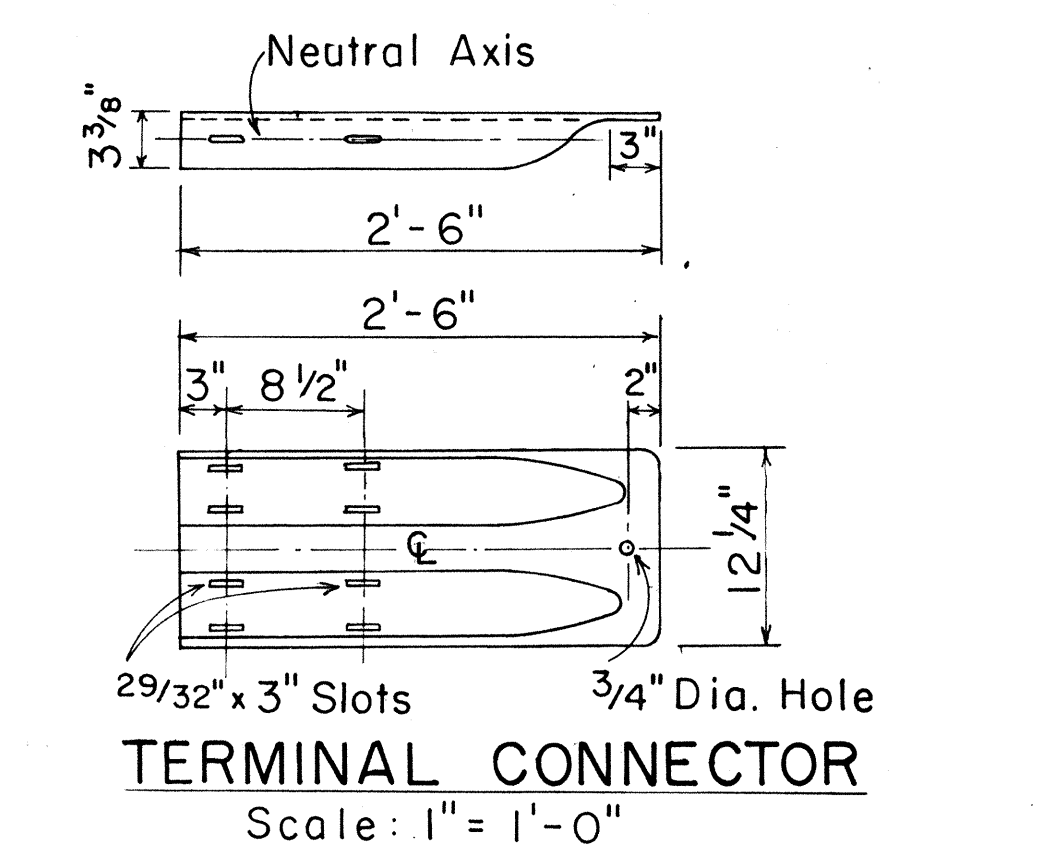

APPROVAL RECOMMENDED:
Eiichi Tanaka 6/14/78
TRAFFIC ENGINEER DATE

APPROVED:
Harbor Satoishi 6/15/78
ASSISTANT CHIEF, ENGINEERING DATE








STATE OF HAWAII
DEPARTMENT OF TRANSPORTATION
LAND TRANSPORTATION FACILITIES DIVISION

STANDARD DETAIL

BREAKAWAY CABLE TERMINAL (BCT)






Scale: As Shown
SHEET No. OF SHEETS DT 519

Date: June 1978

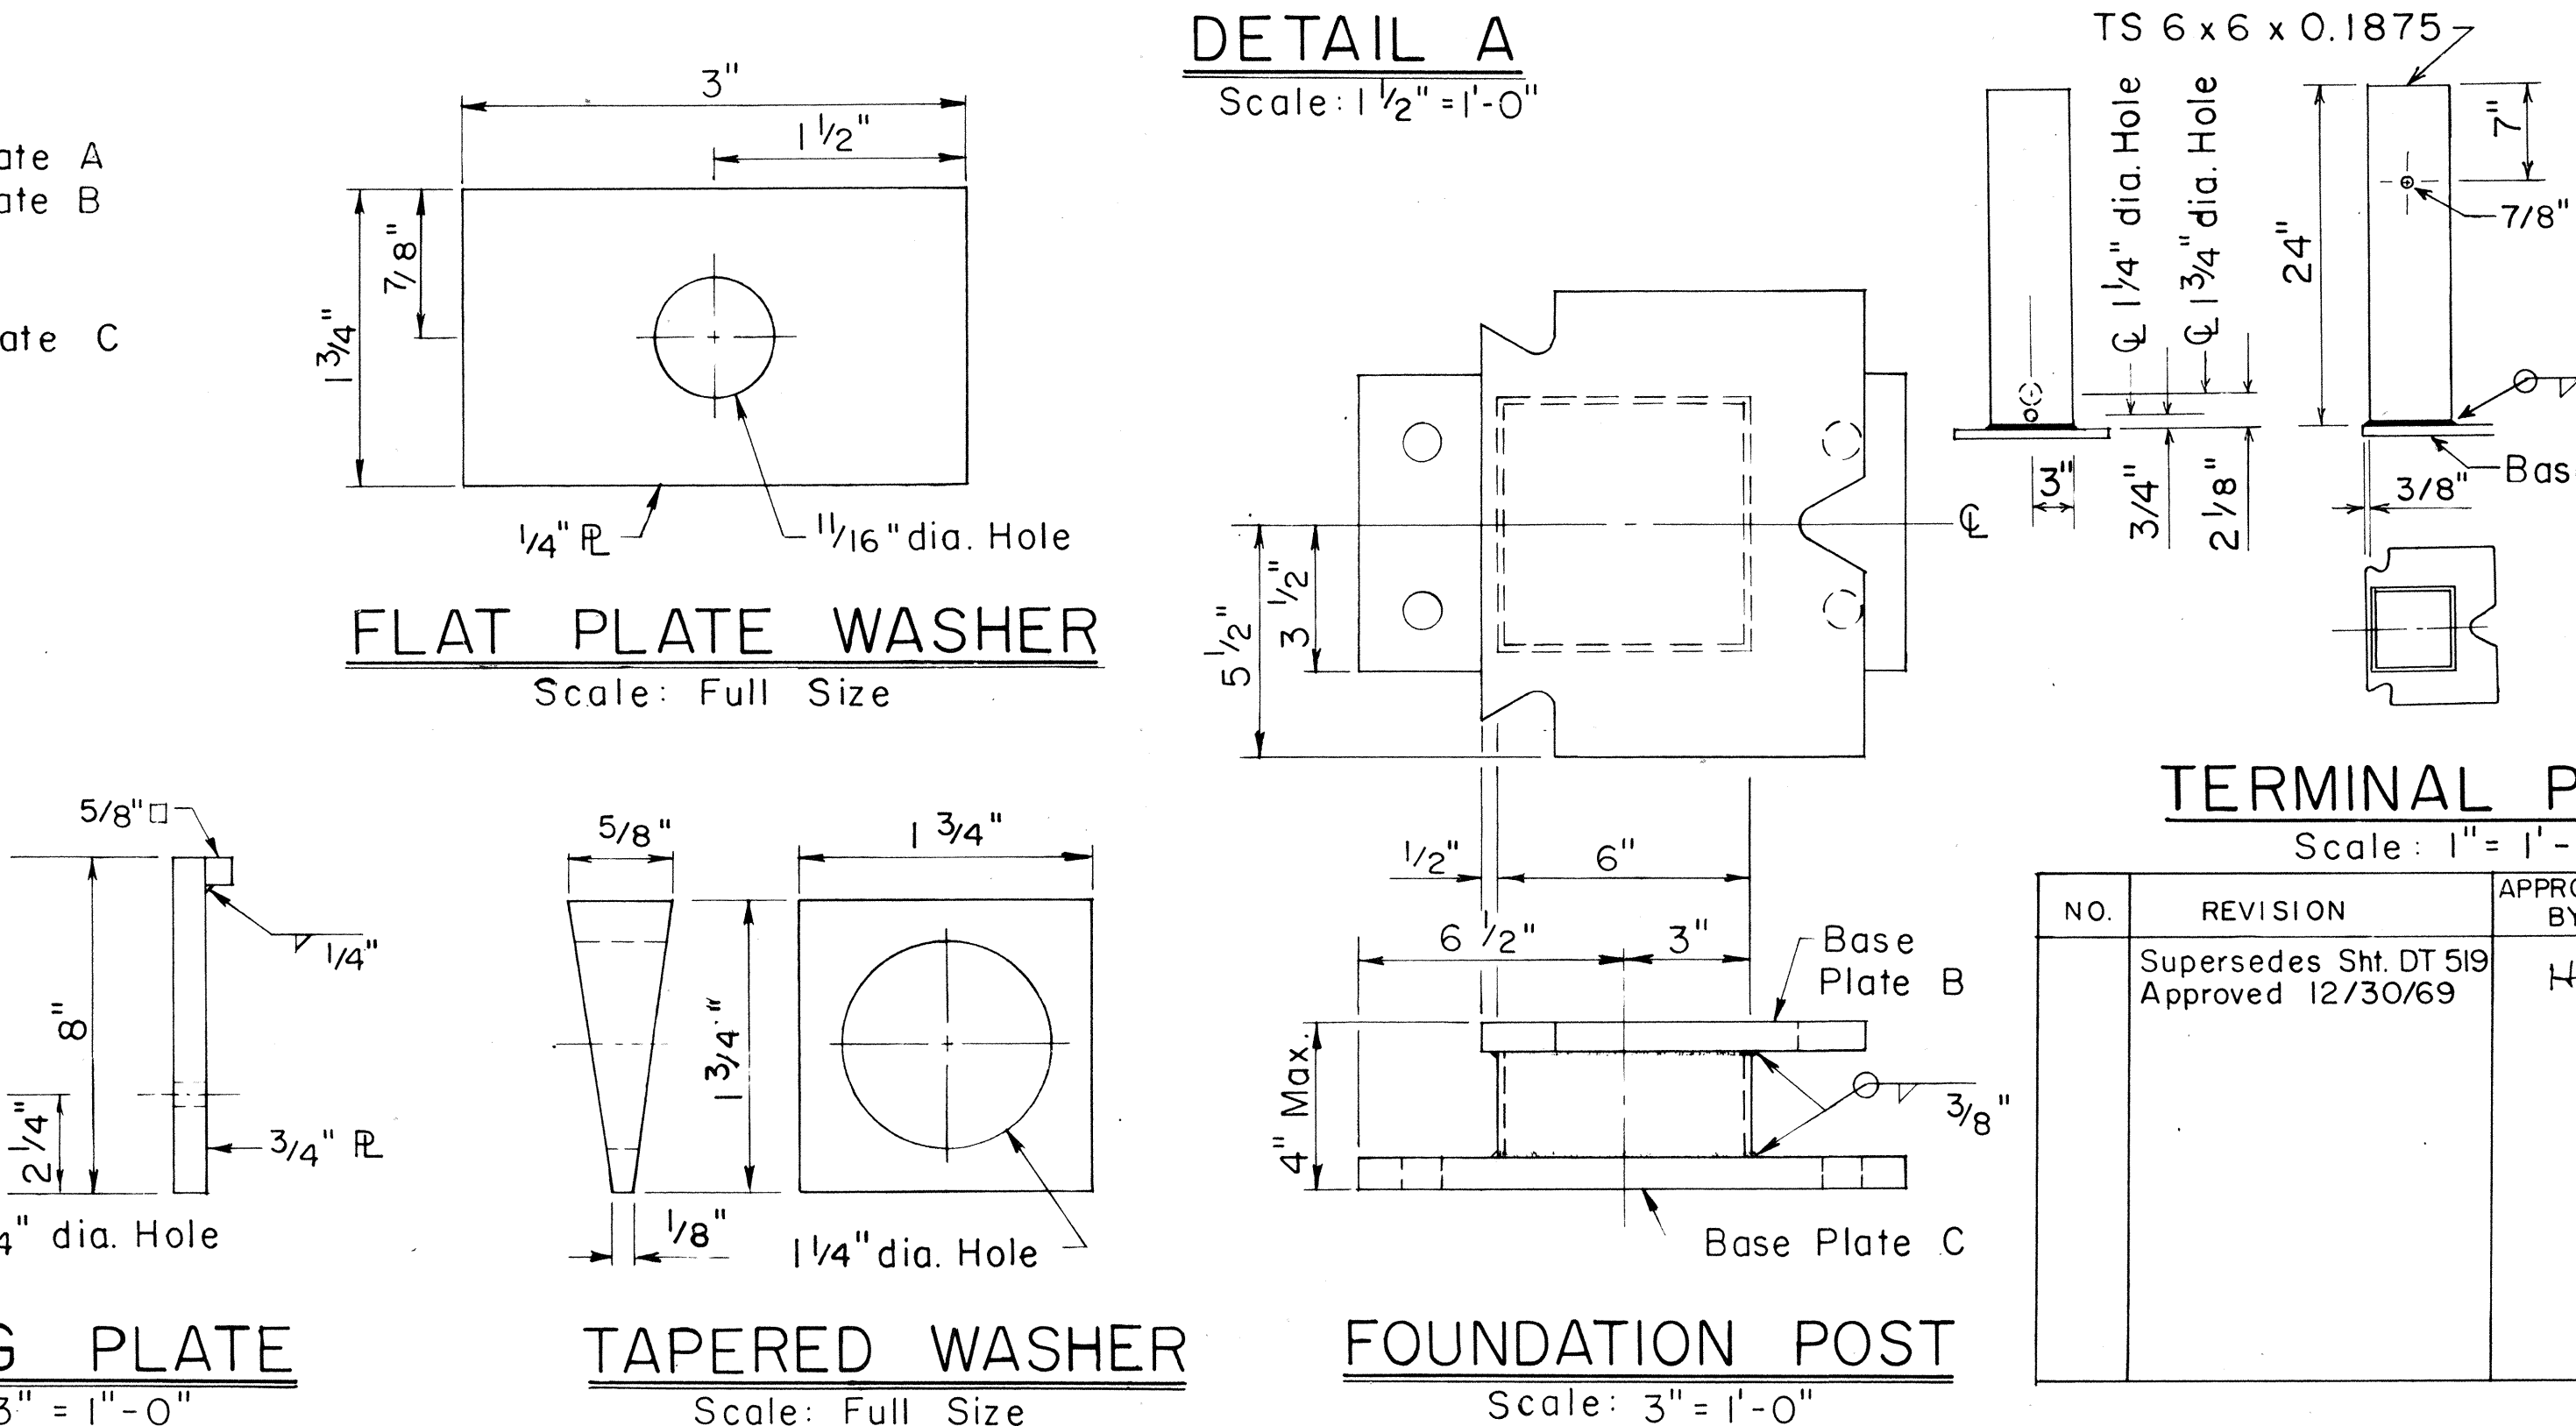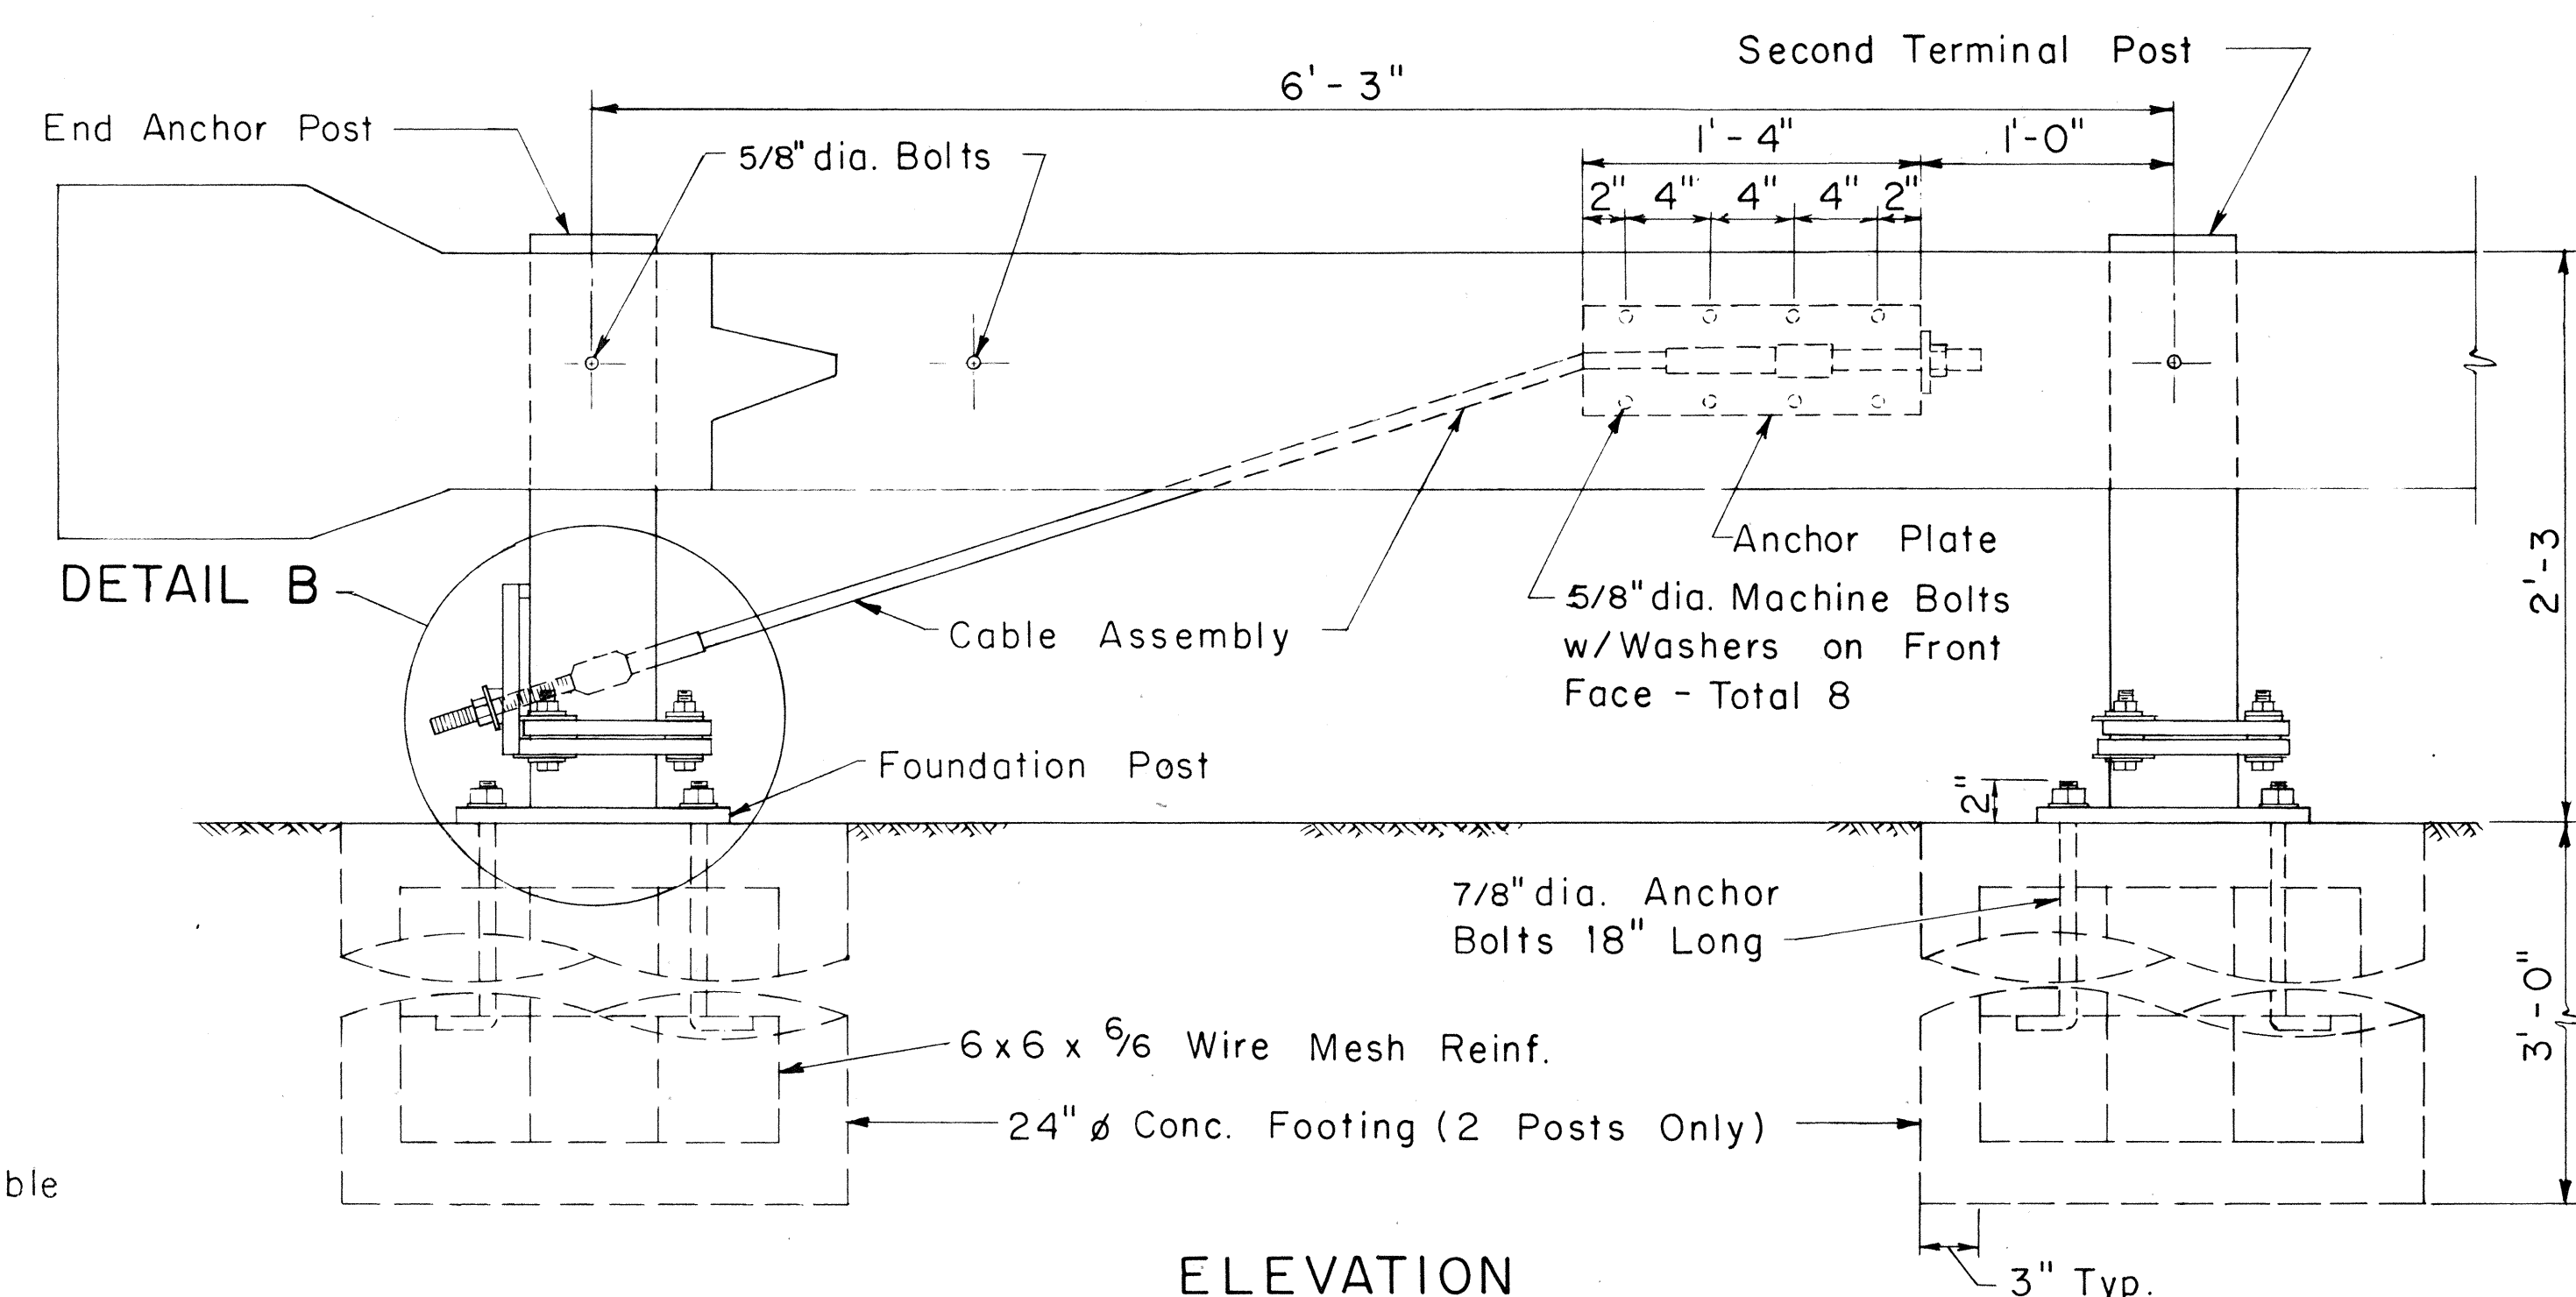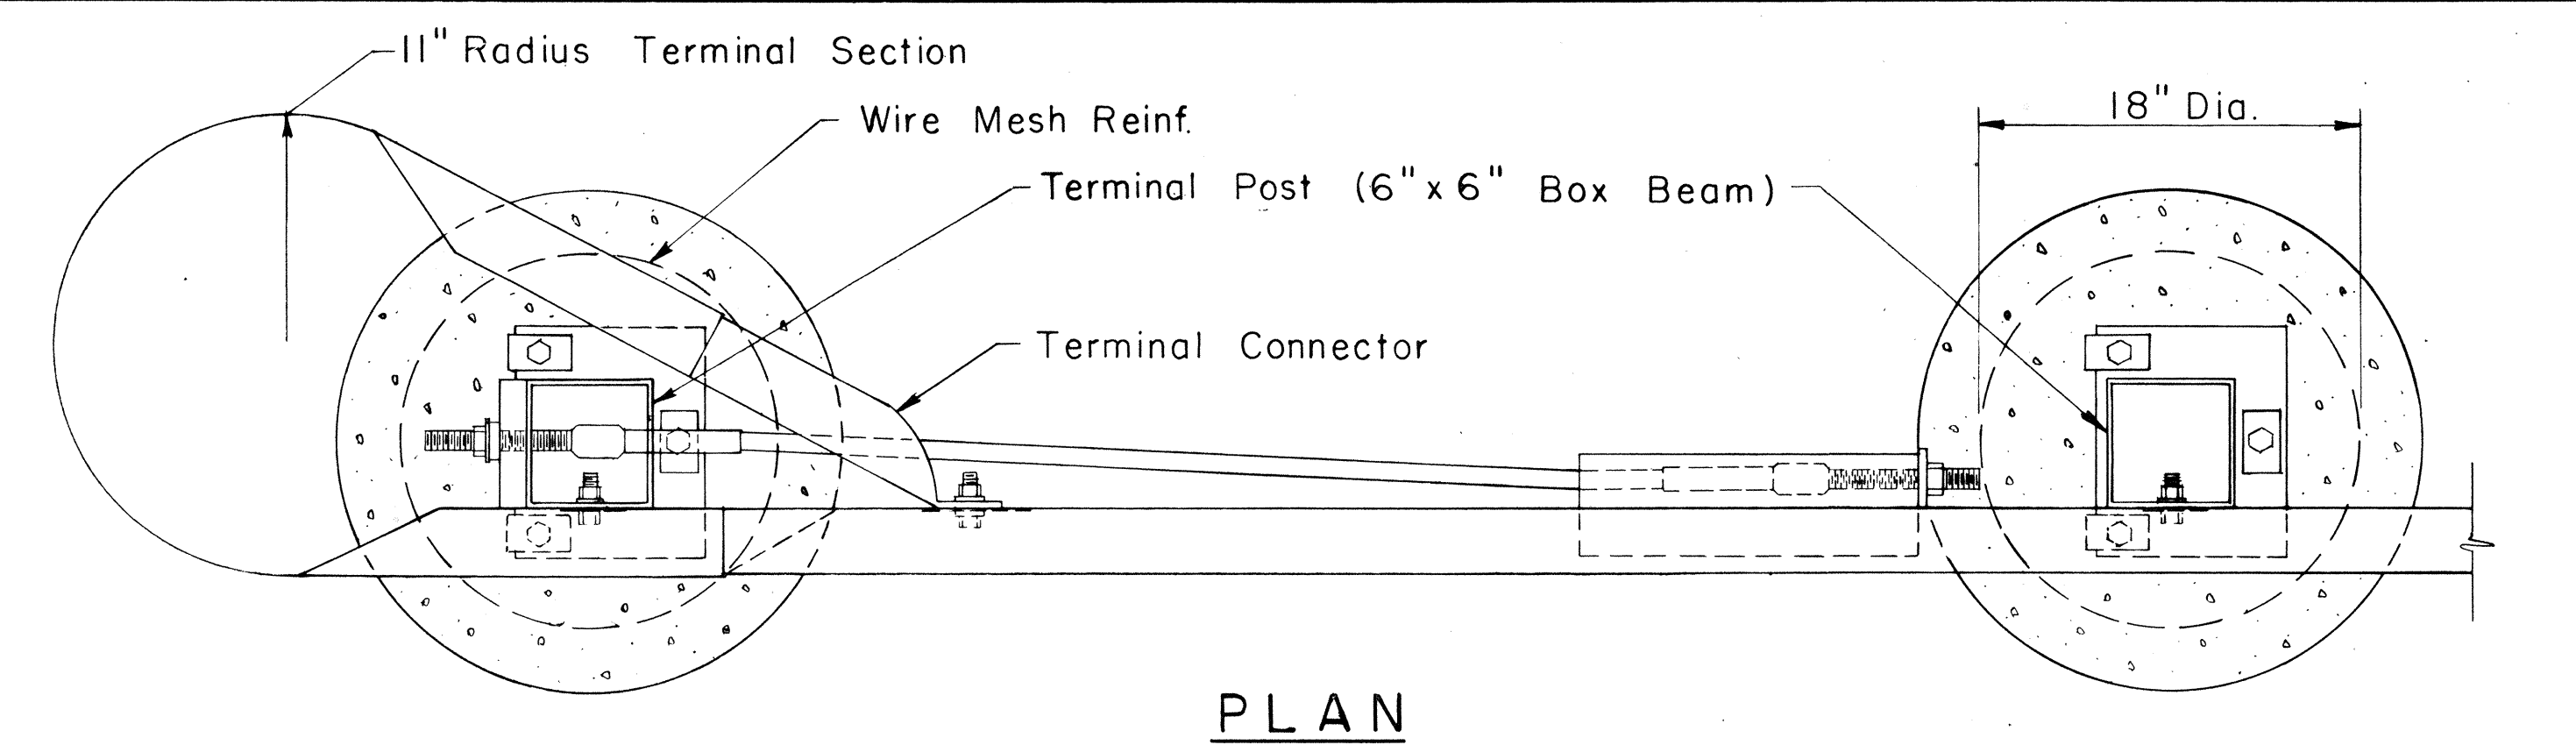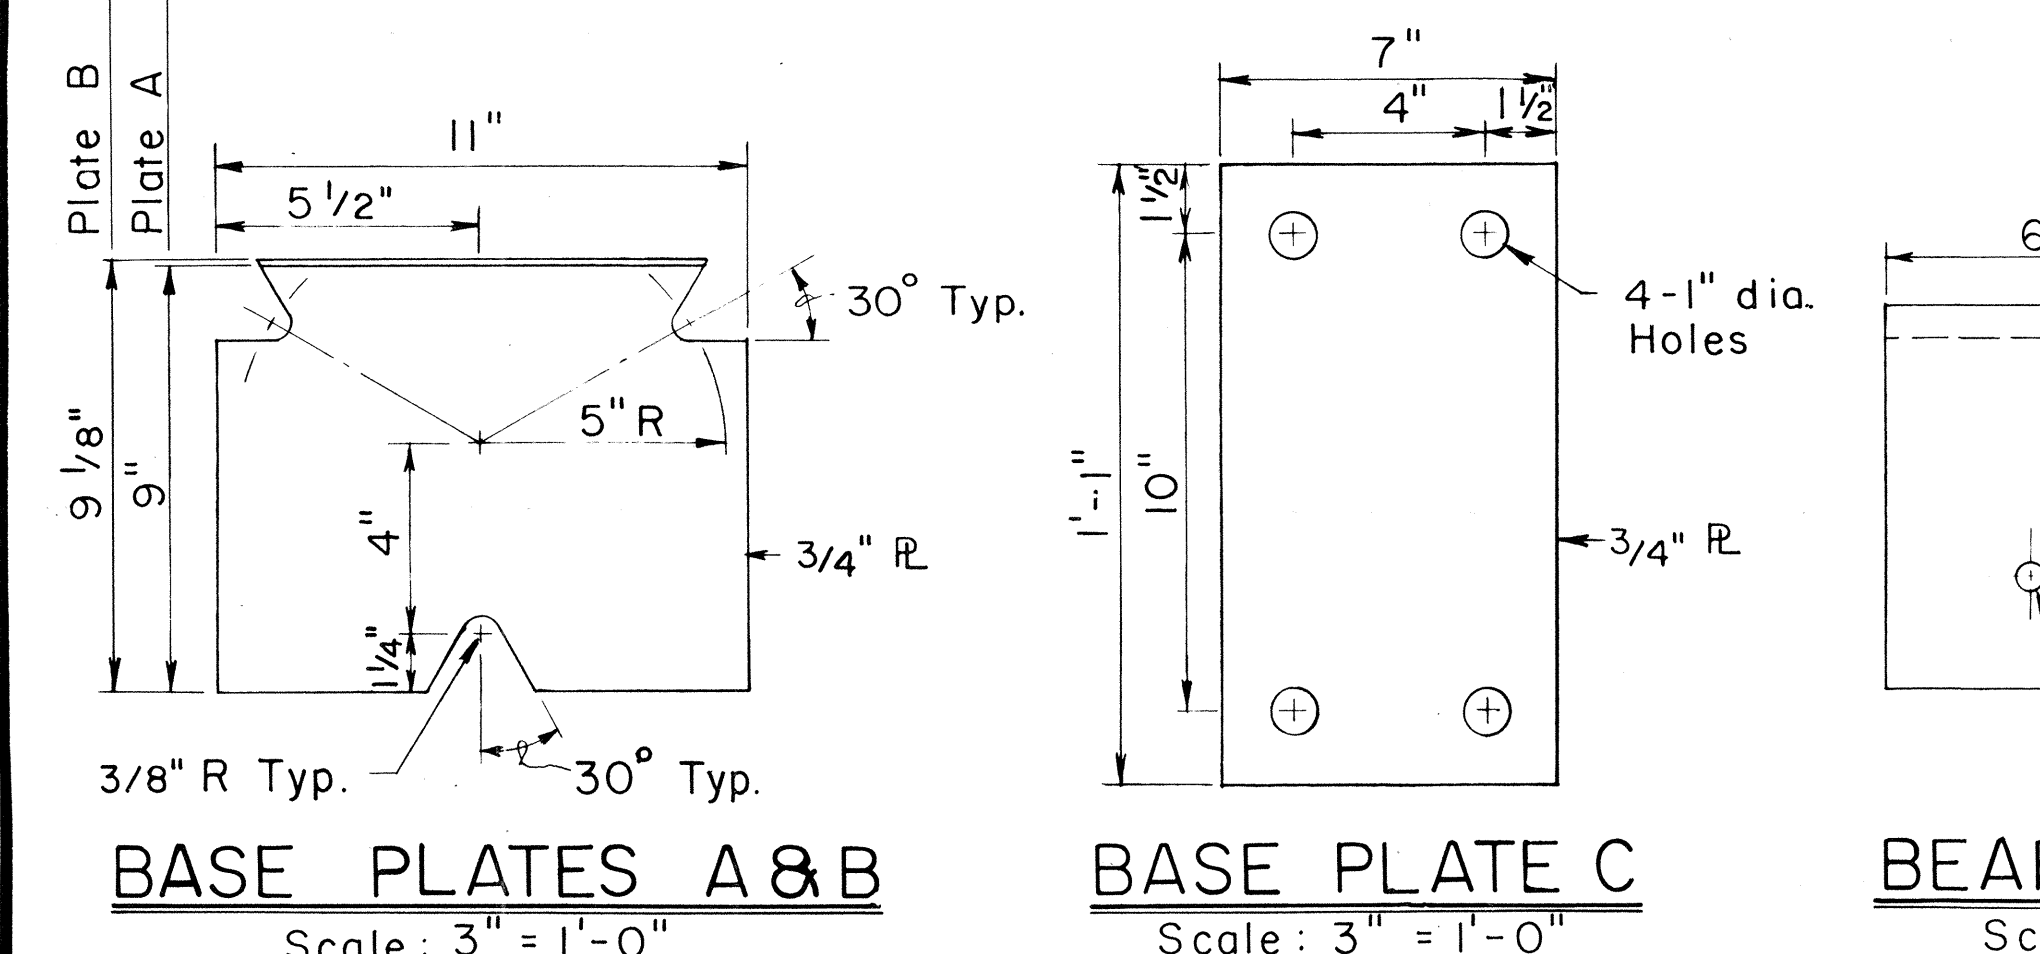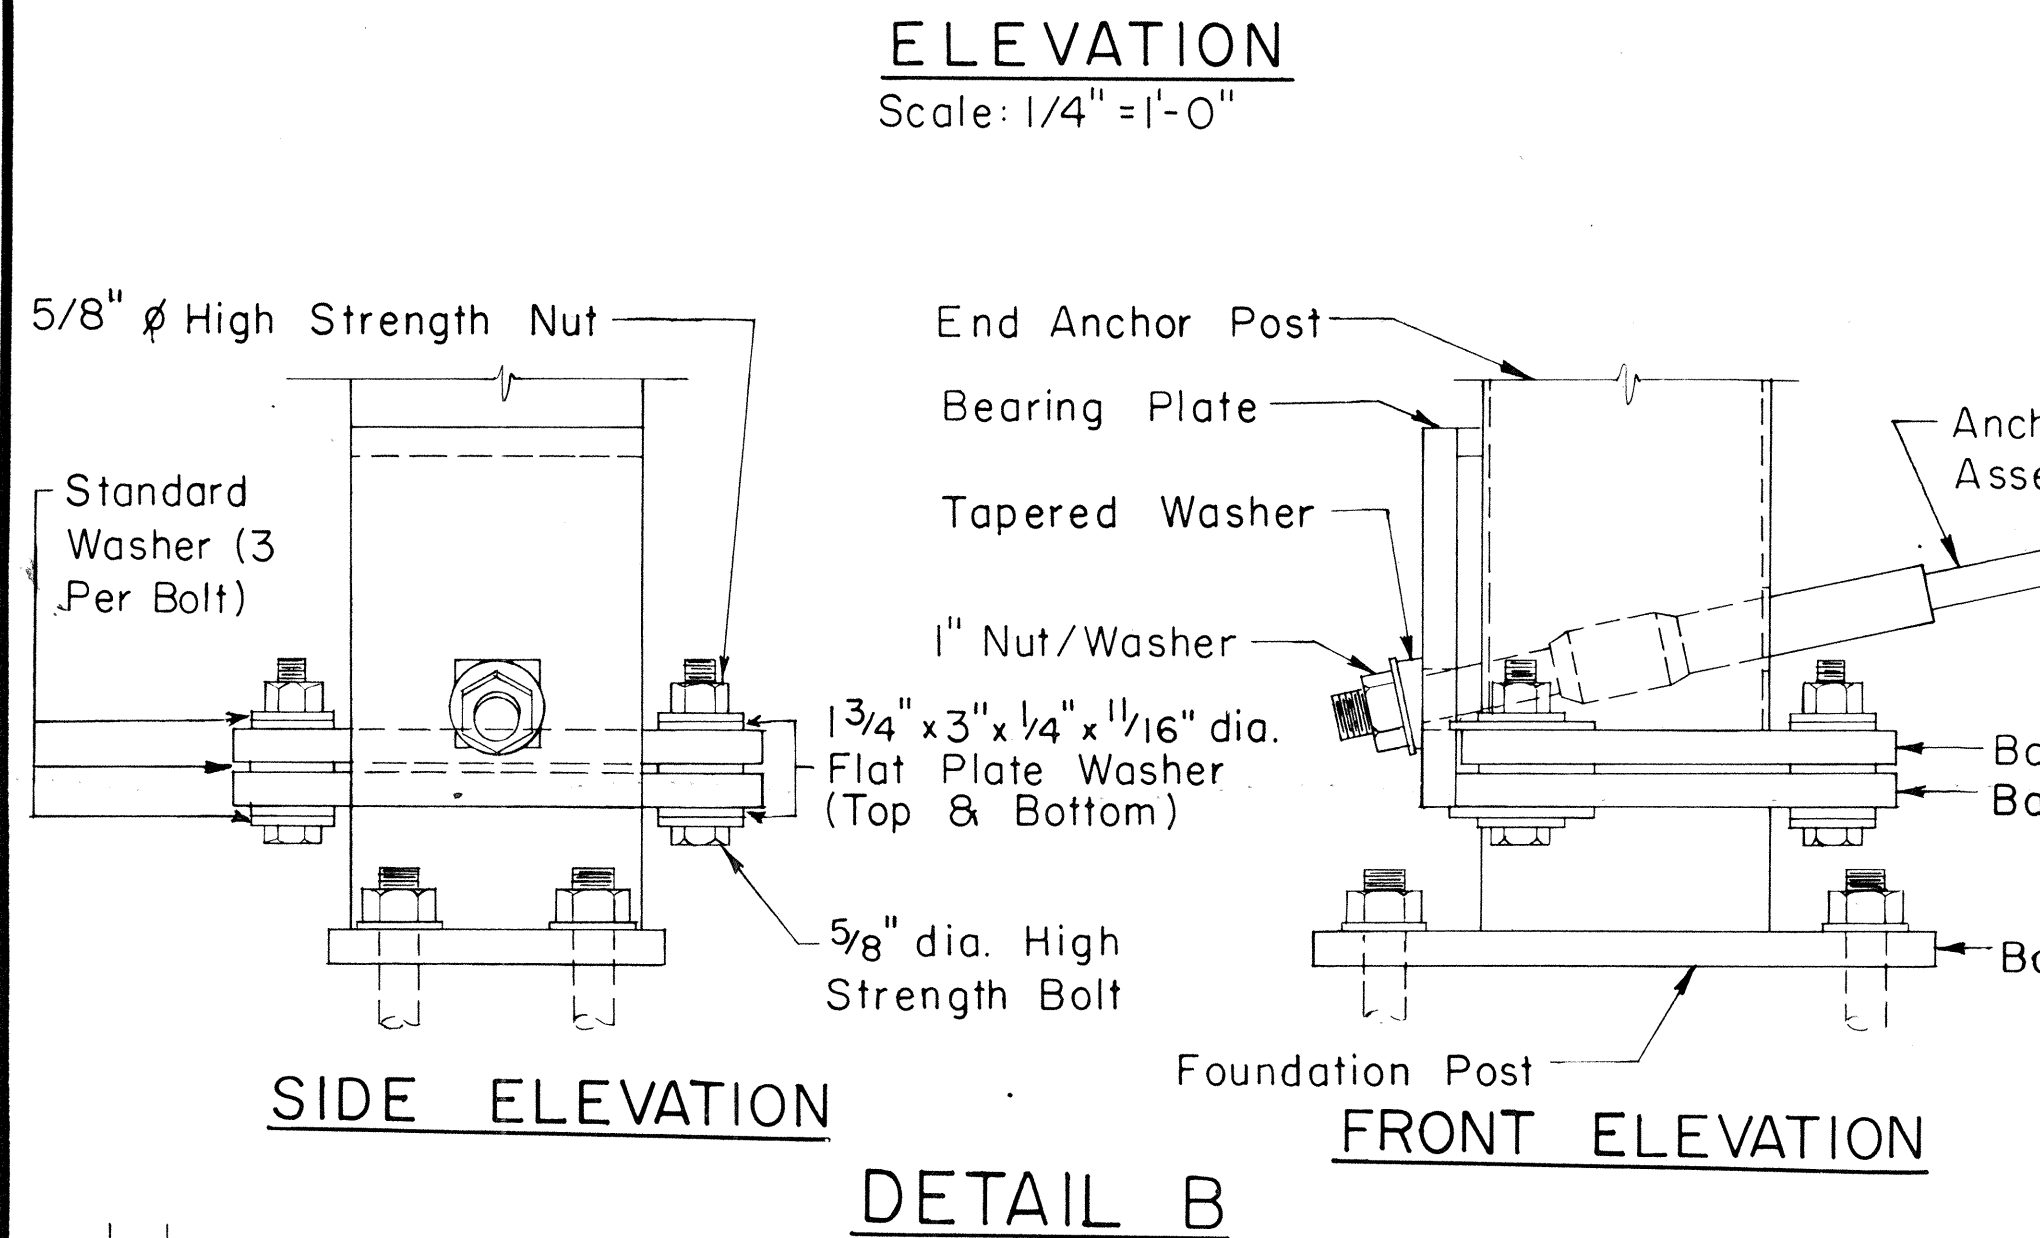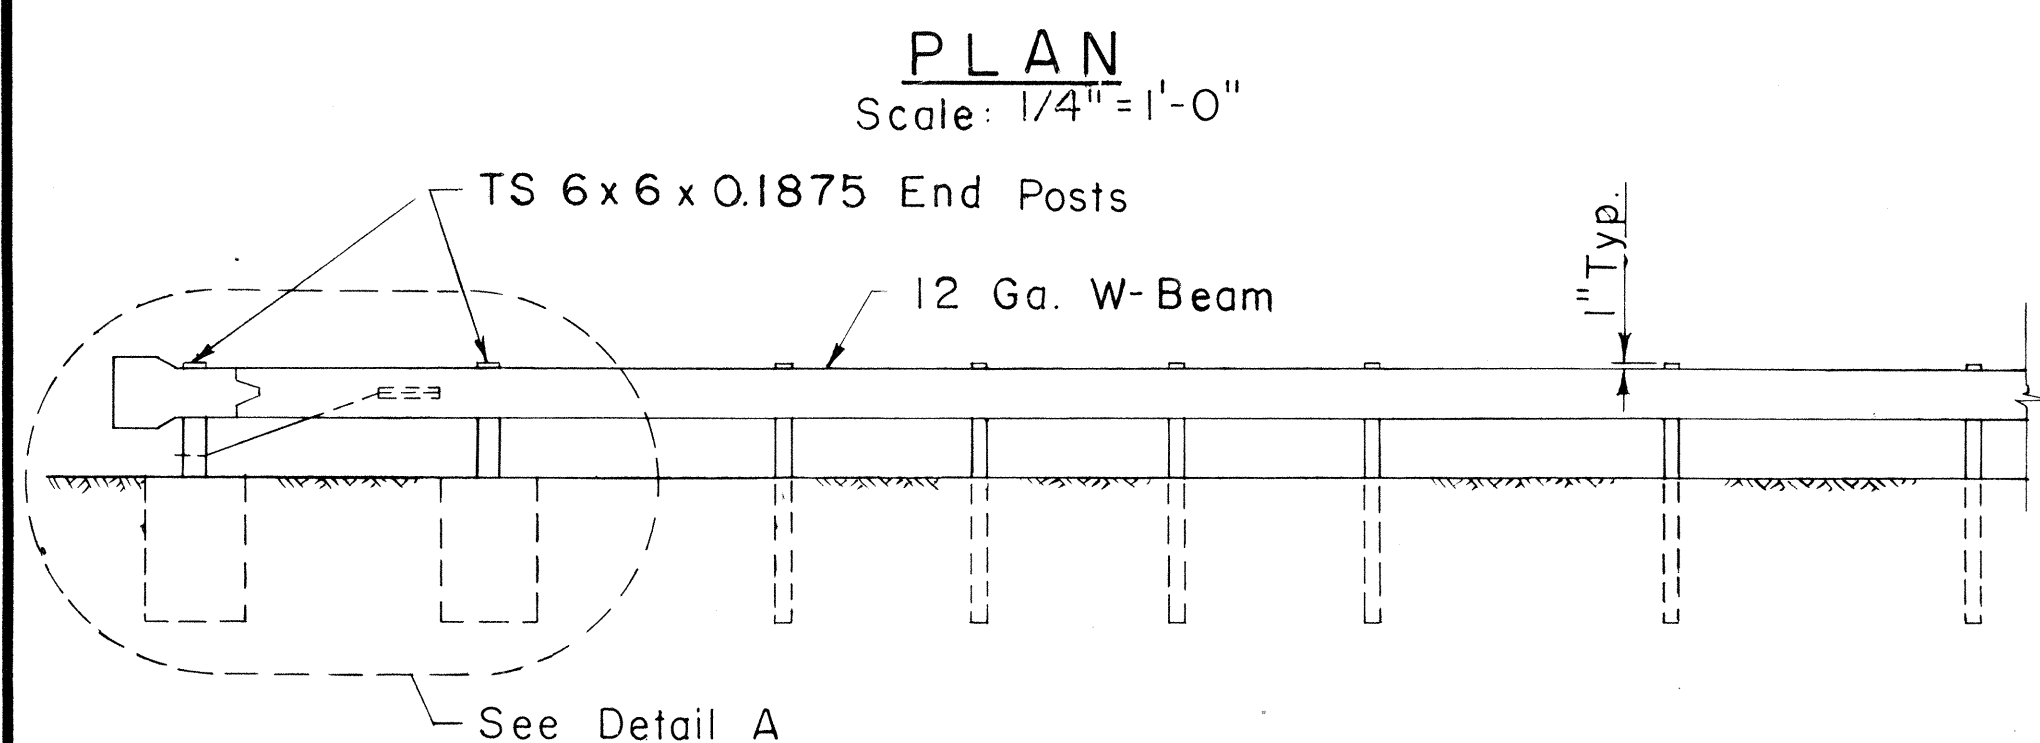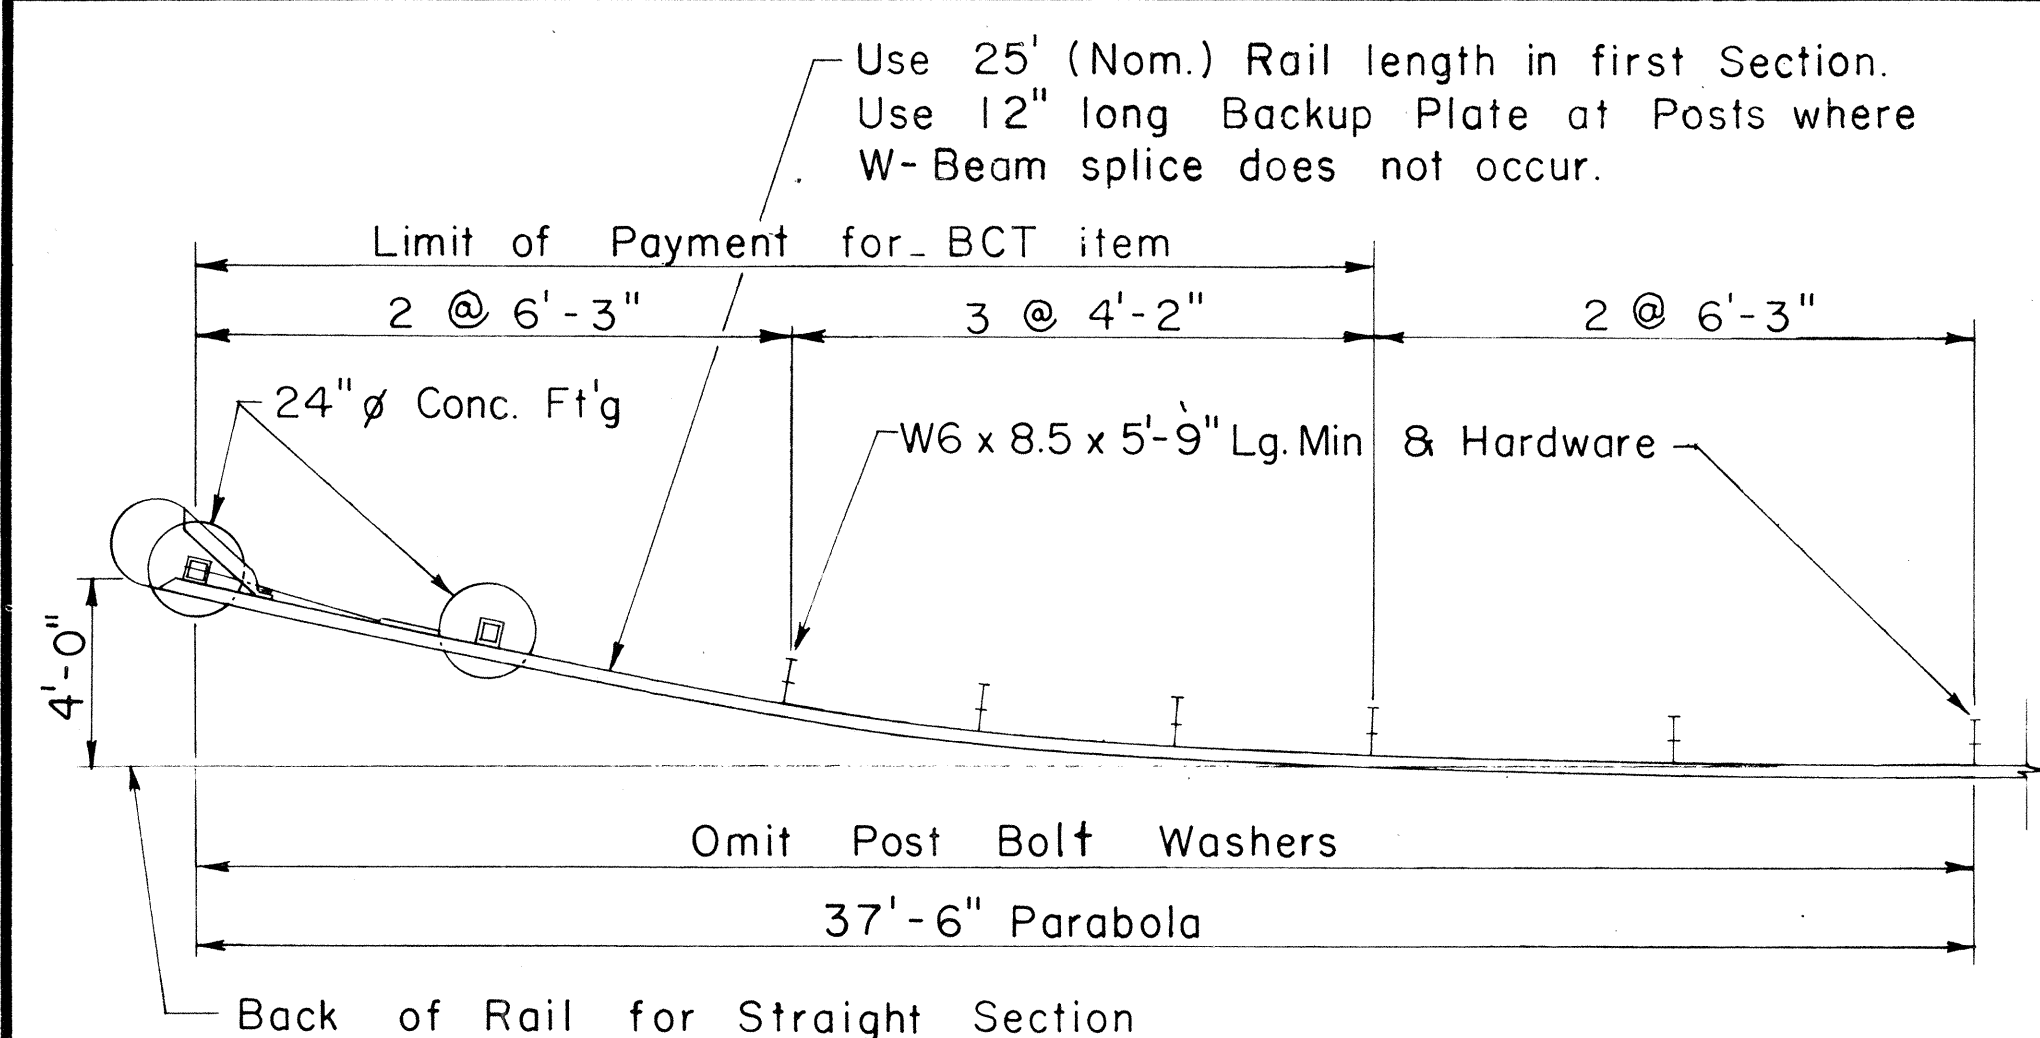


SURVEY PLOTTED BY	DATE
DRAWN BY	
DESIGNED BY	
NOTE BOOK	
QUANTITIES BY	
CHECKED BY	
No.	

FED. ROAD DIST. NO.	STATE	FED. AID PROJ. NO.	FISCAL YEAR	SHEET NO.	TOTAL SHEETS
HAWAII	HAW.	1-HI-1(13)17	1977	62	394

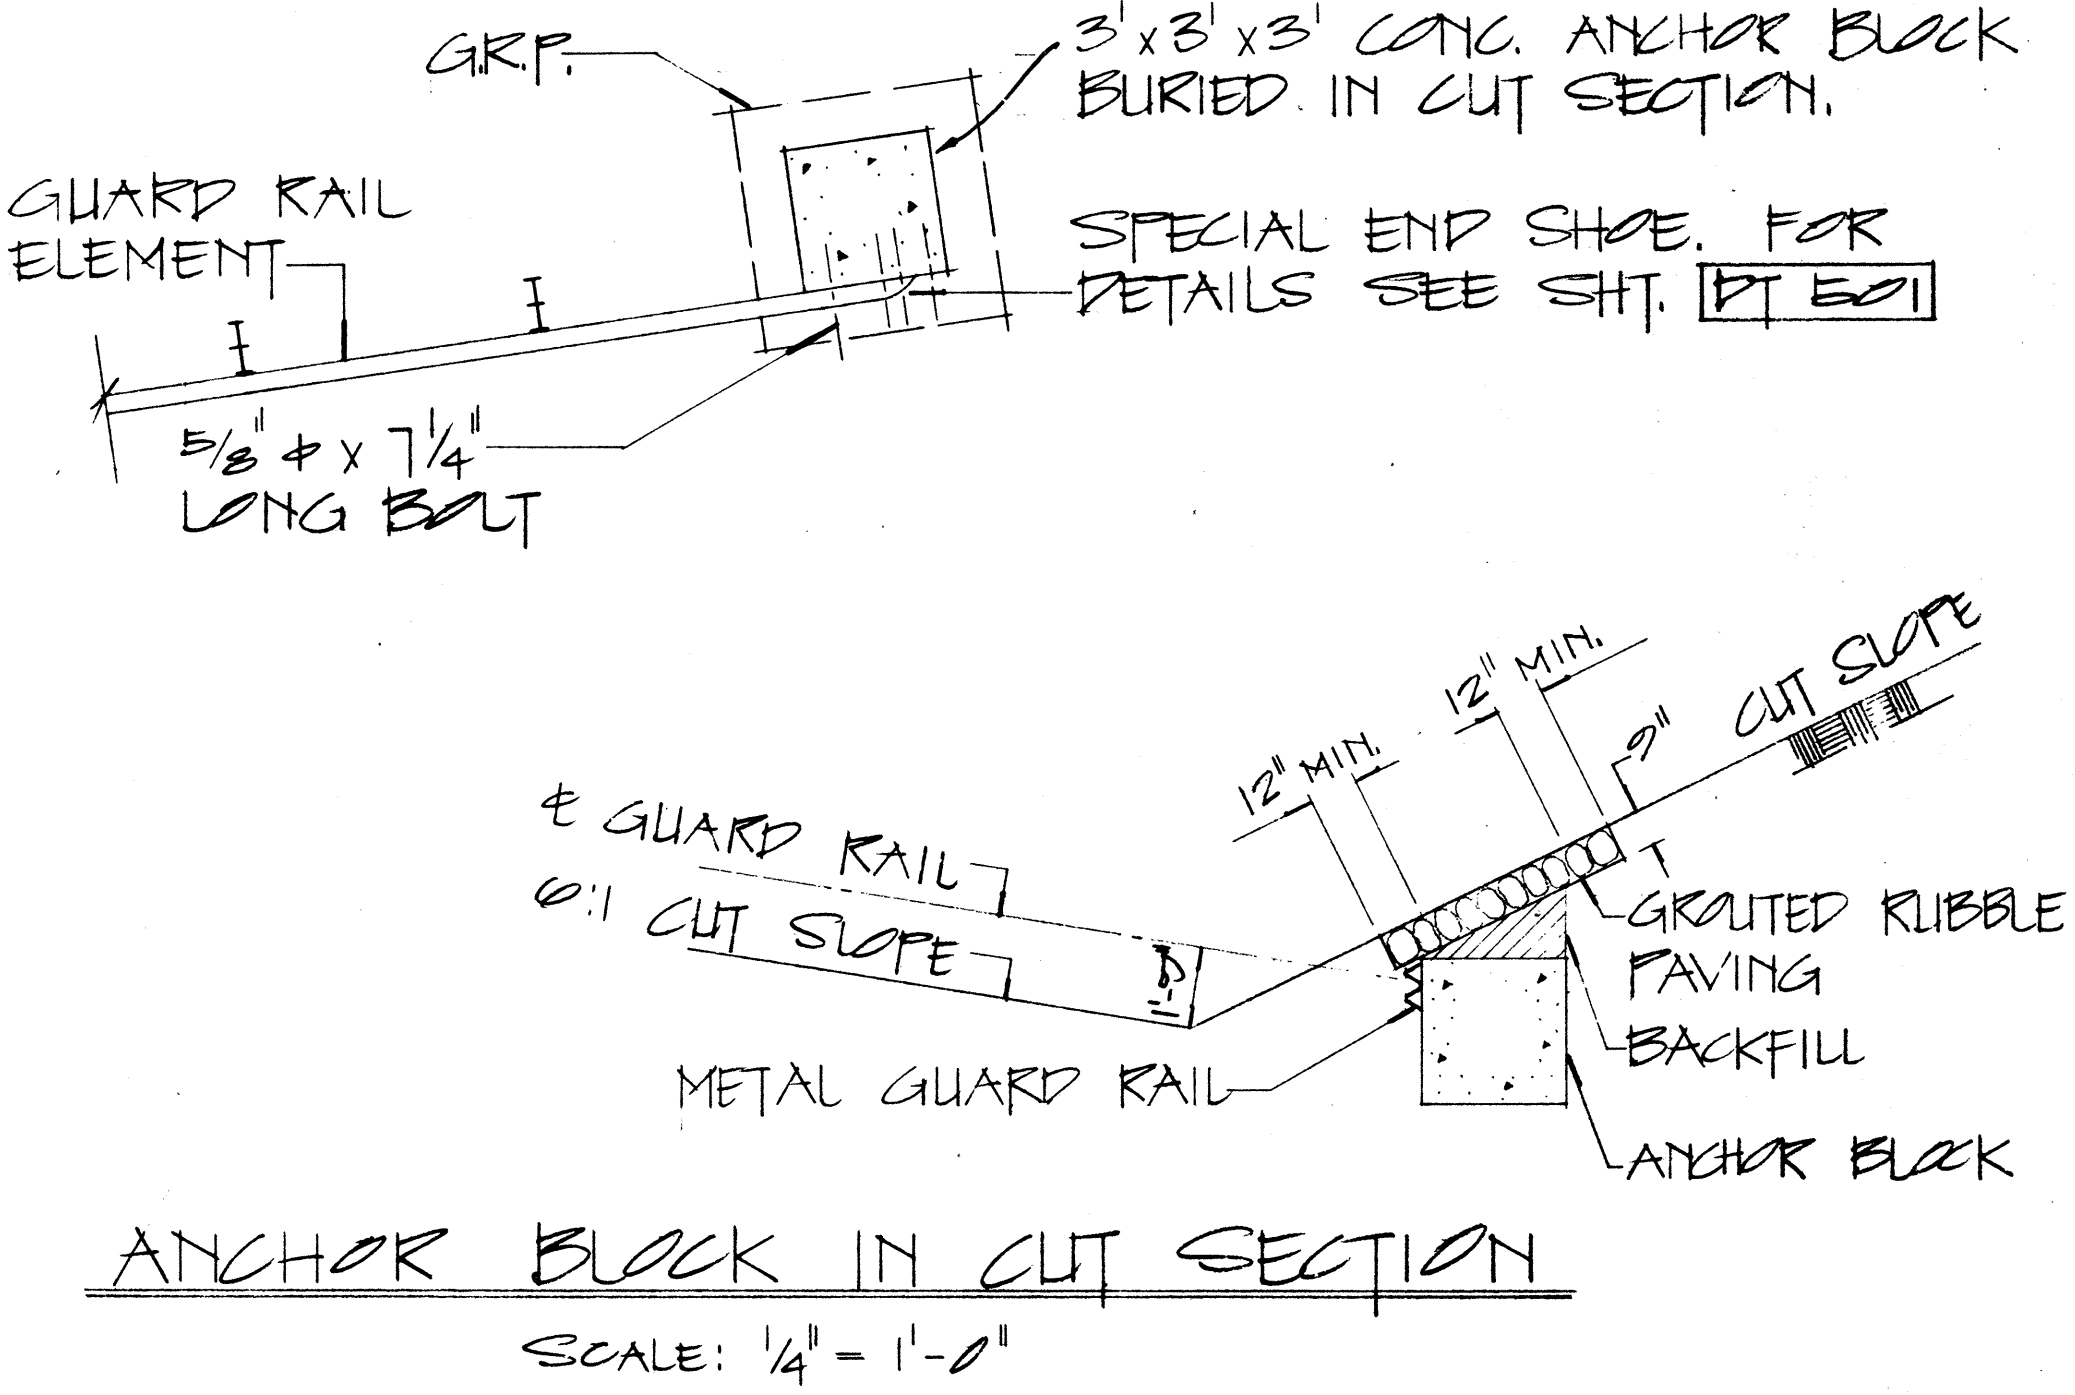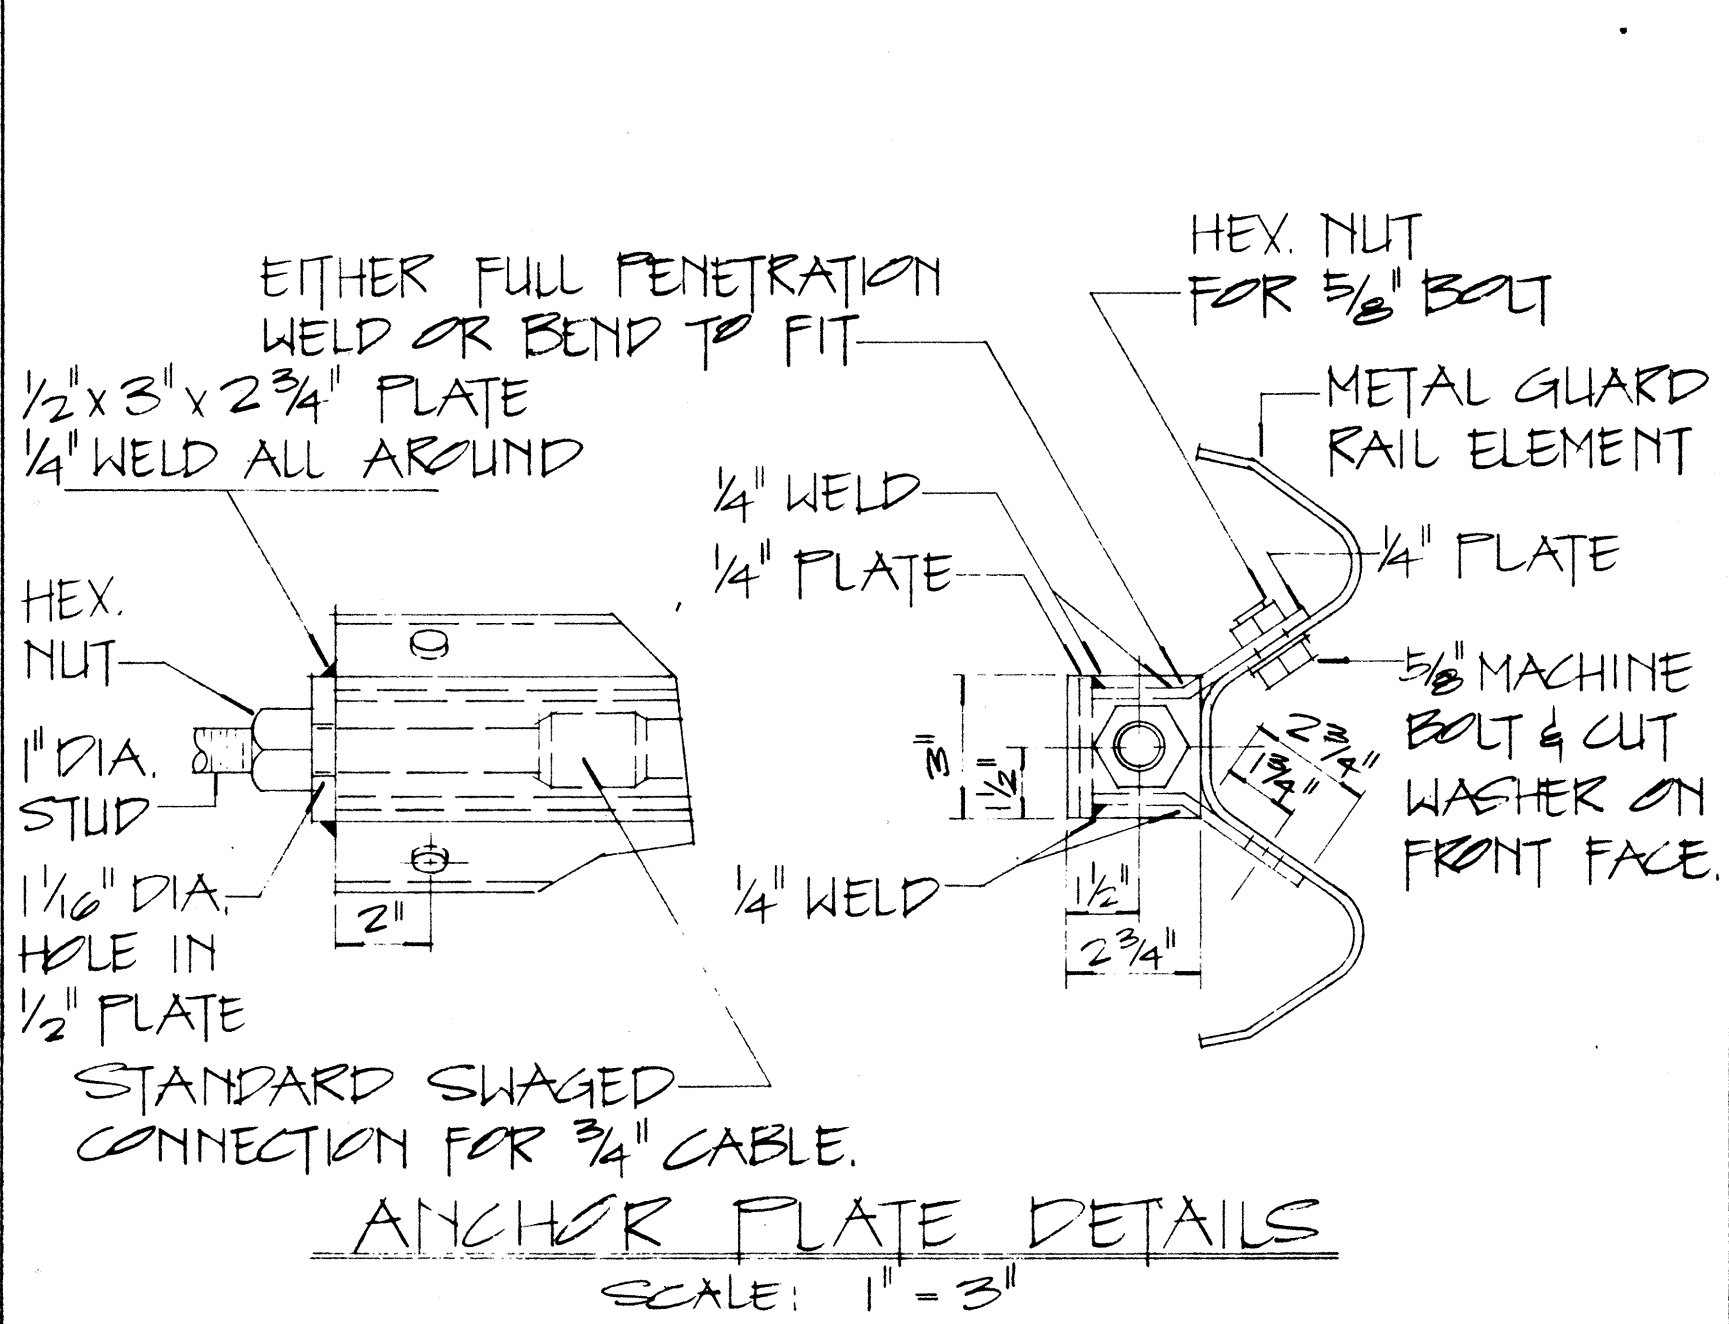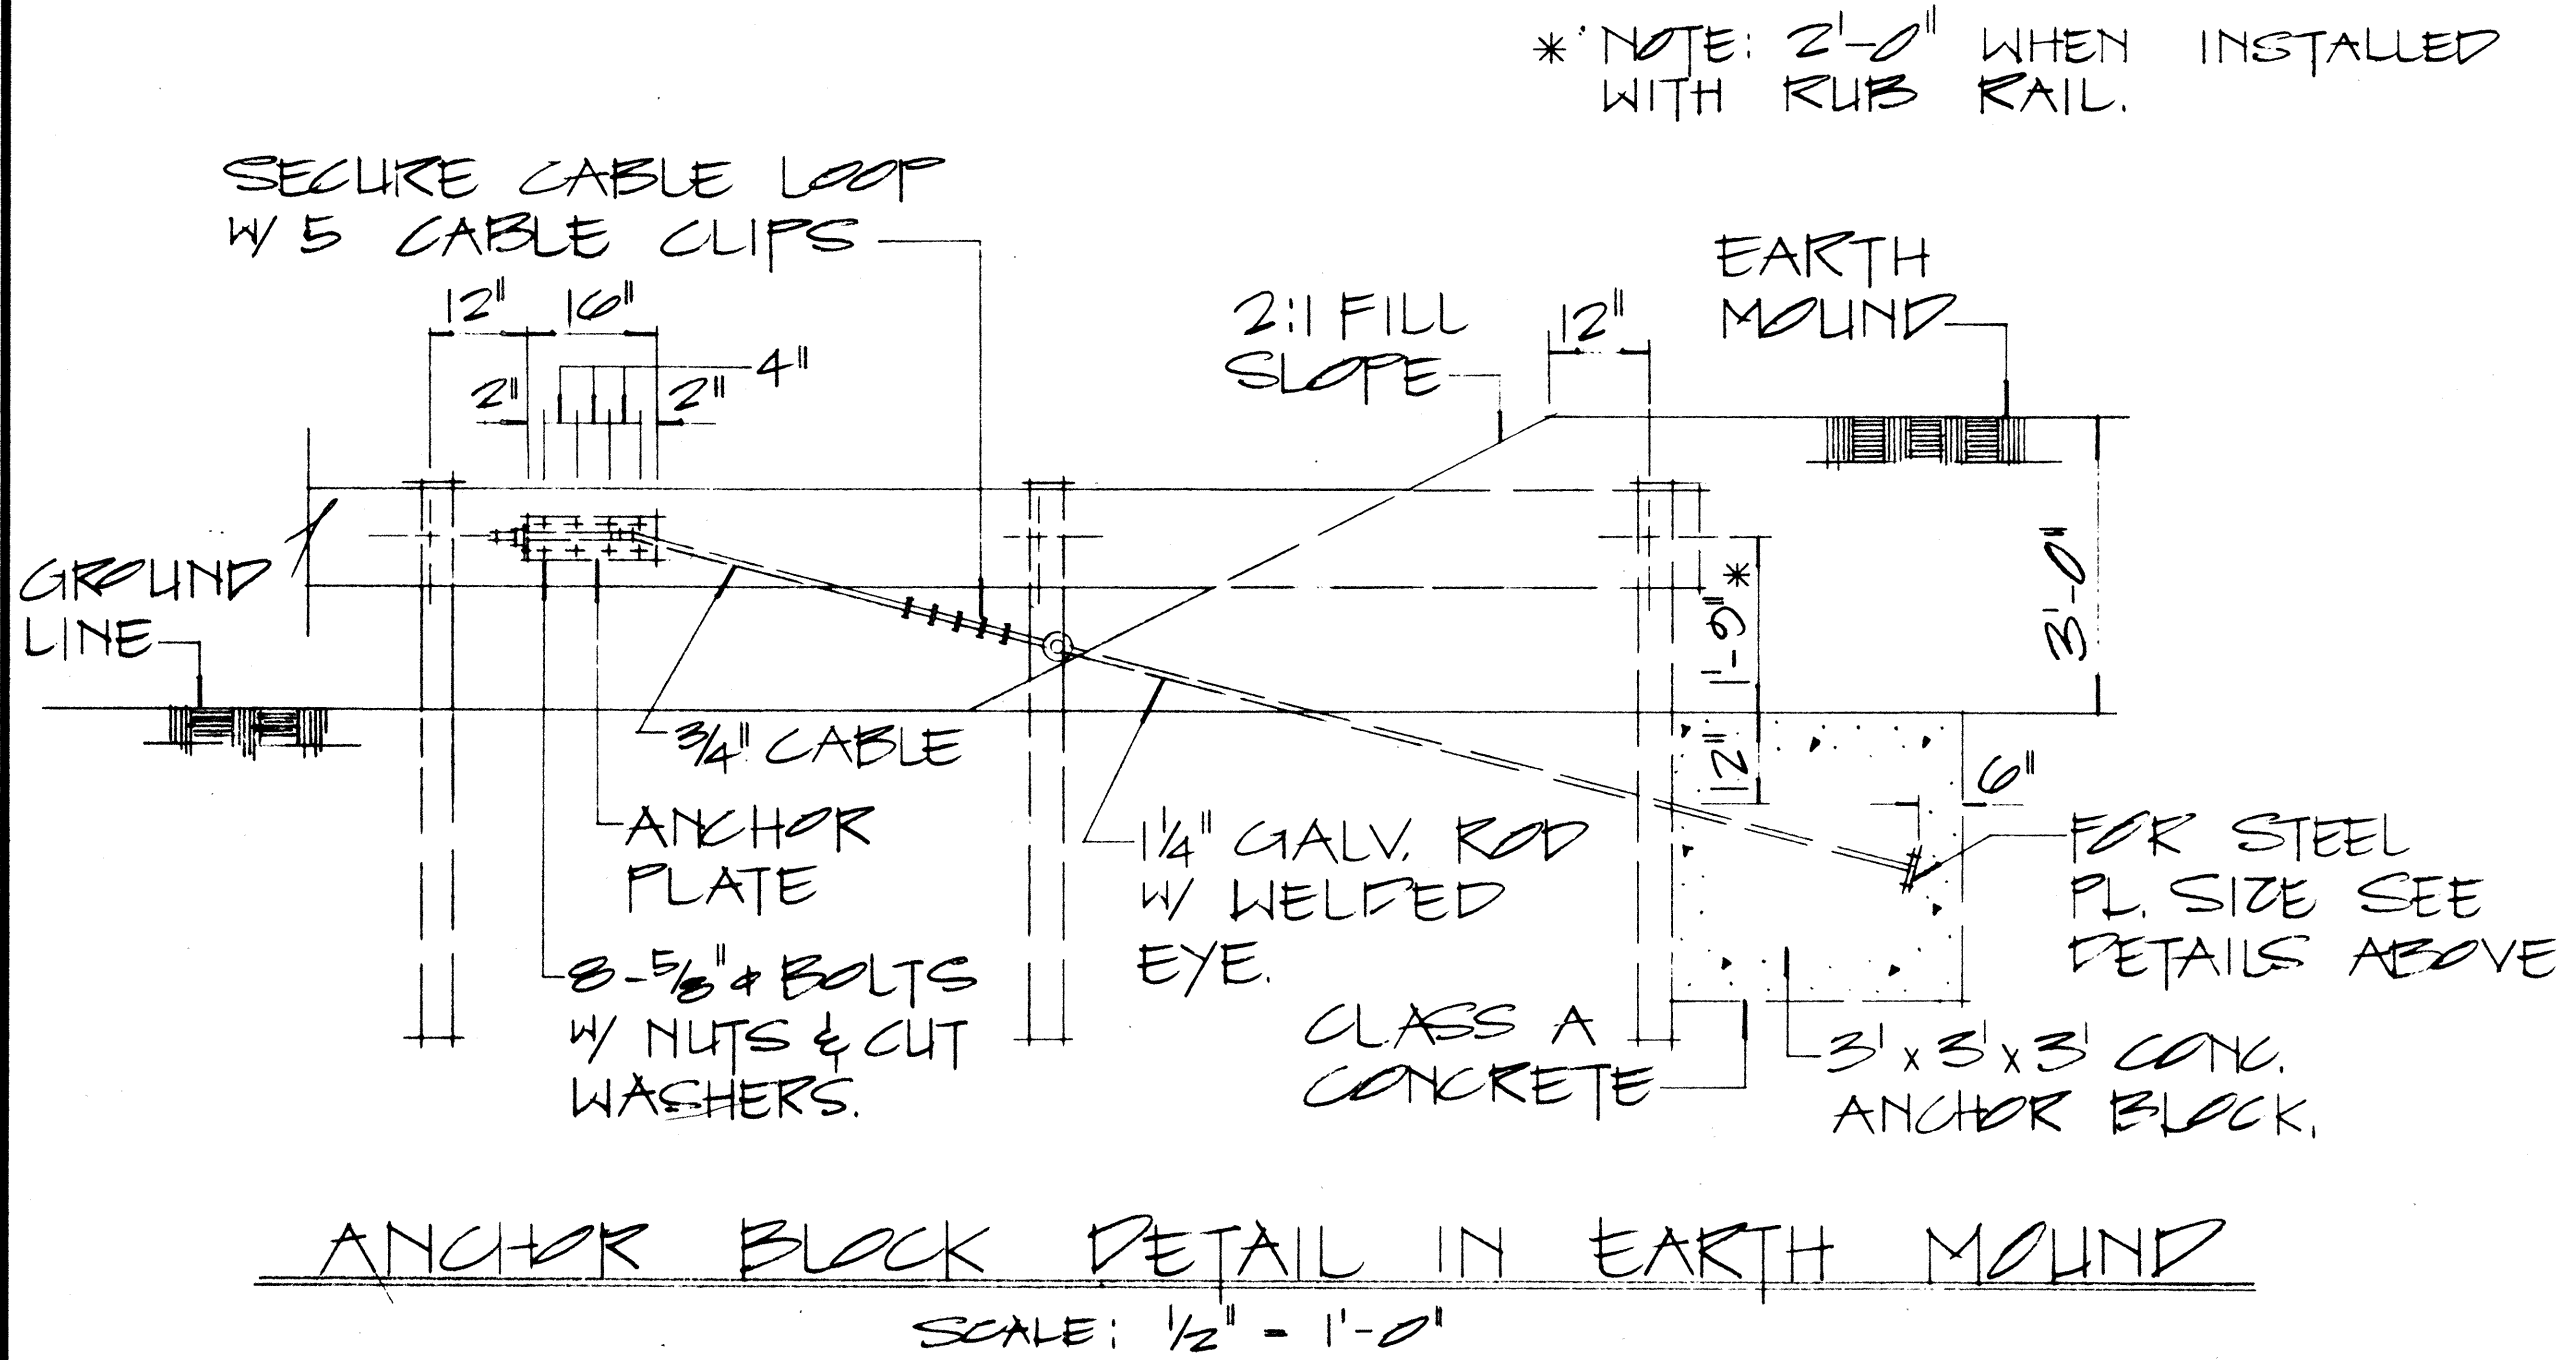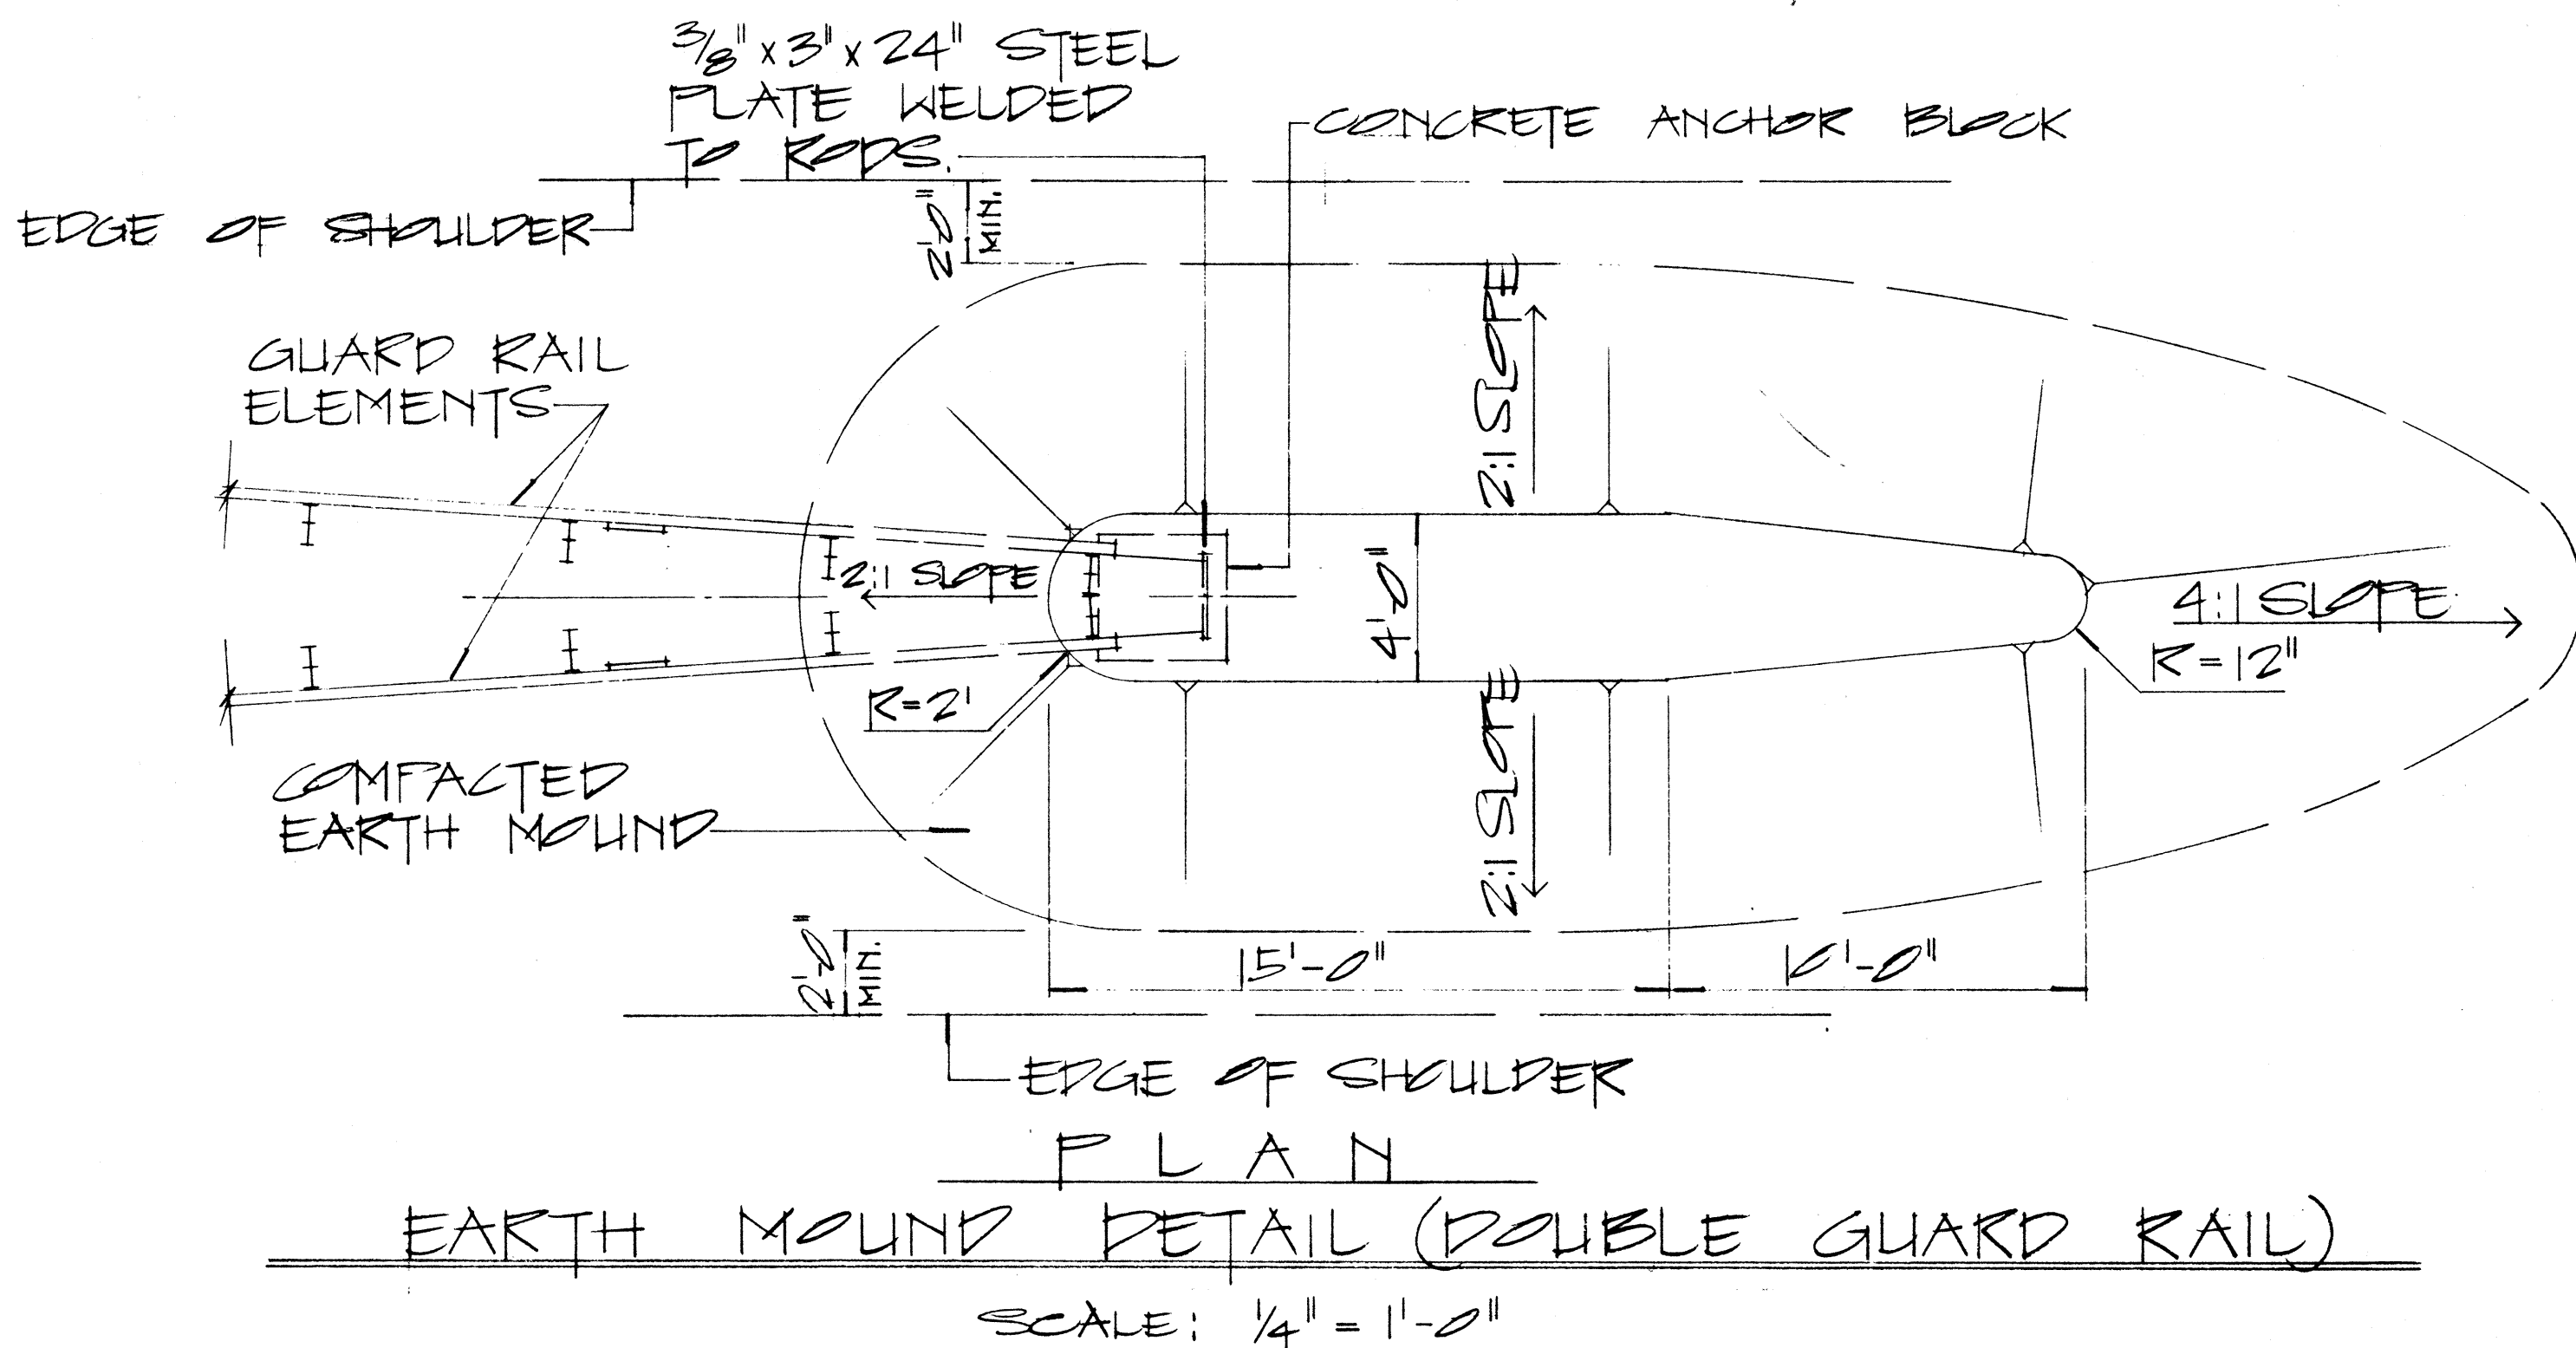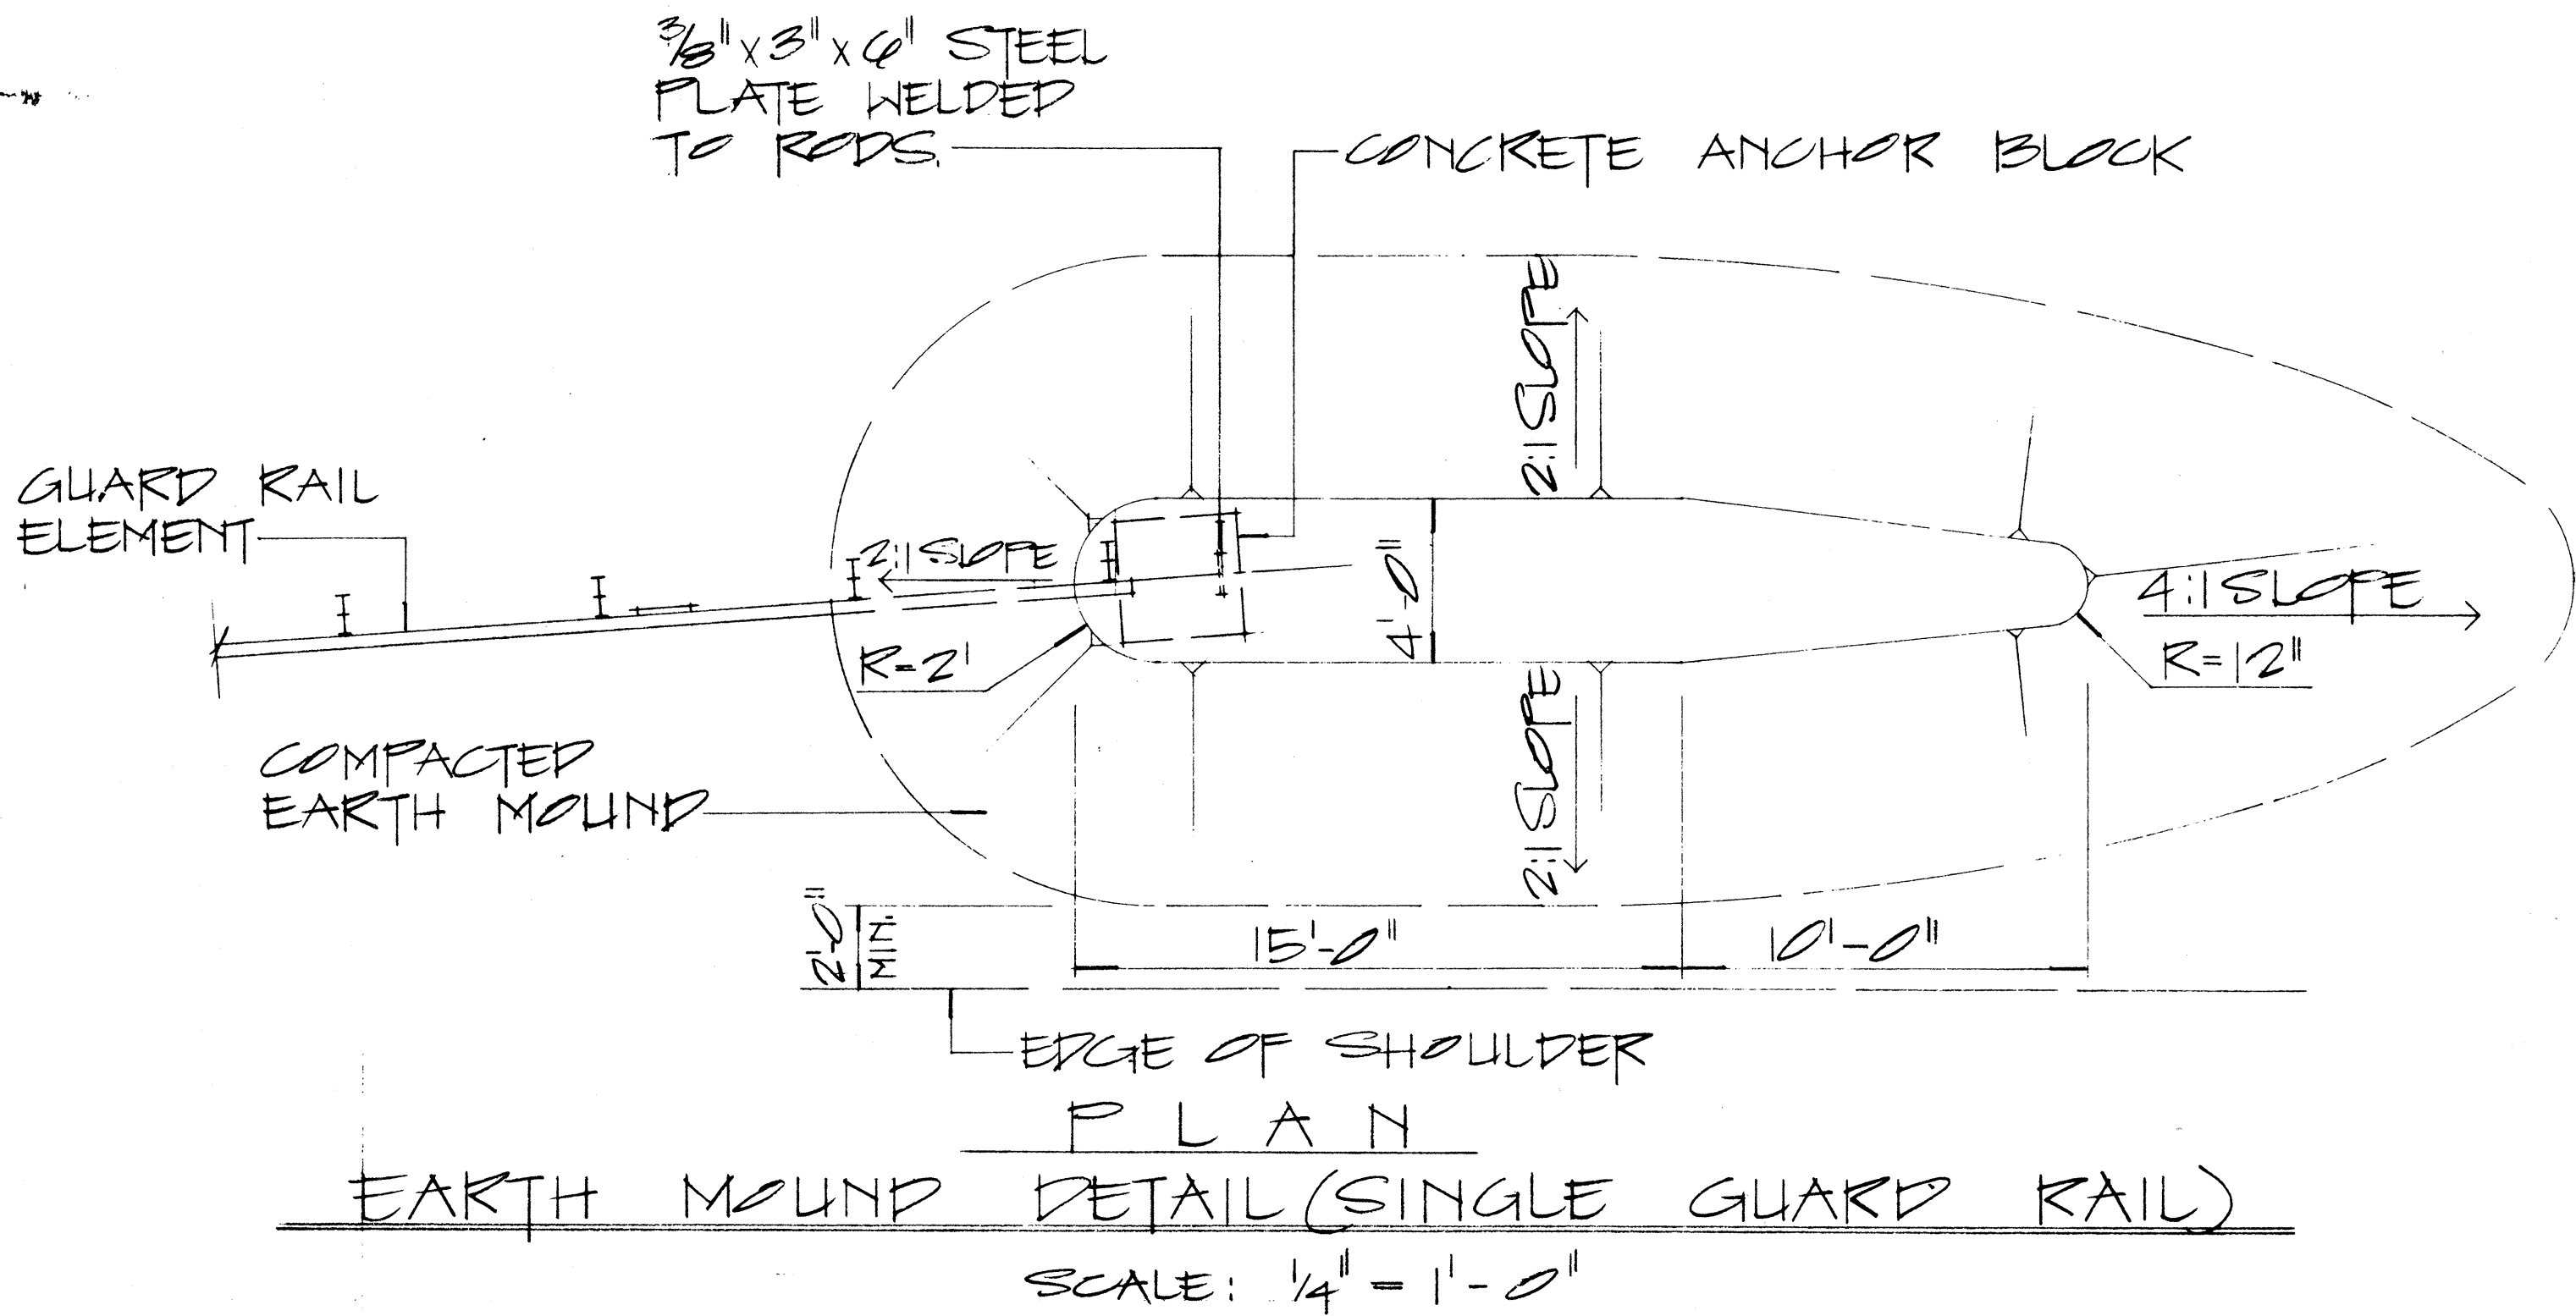

- NOTE:
1. GALVANIZED ANCHOR ROD, METAL GUARD RAIL AND FAST BURIED IN GROUND SHALL BE COVERED WITH A Min. 20-Mil thickness of coal TAR ENAMEL conforming to AWWA Standard: C 203
 2. CONCRETE, GRP, EXCAVATION, EARTH MOUND, ANCHOR RODS AND MISCELLANEOUS APPURTENANCES NECESSARY TO ANCHOR THE GUARD RAIL ENDS SHALL BE INCIDENTAL TO THE METAL GUARD RAIL.

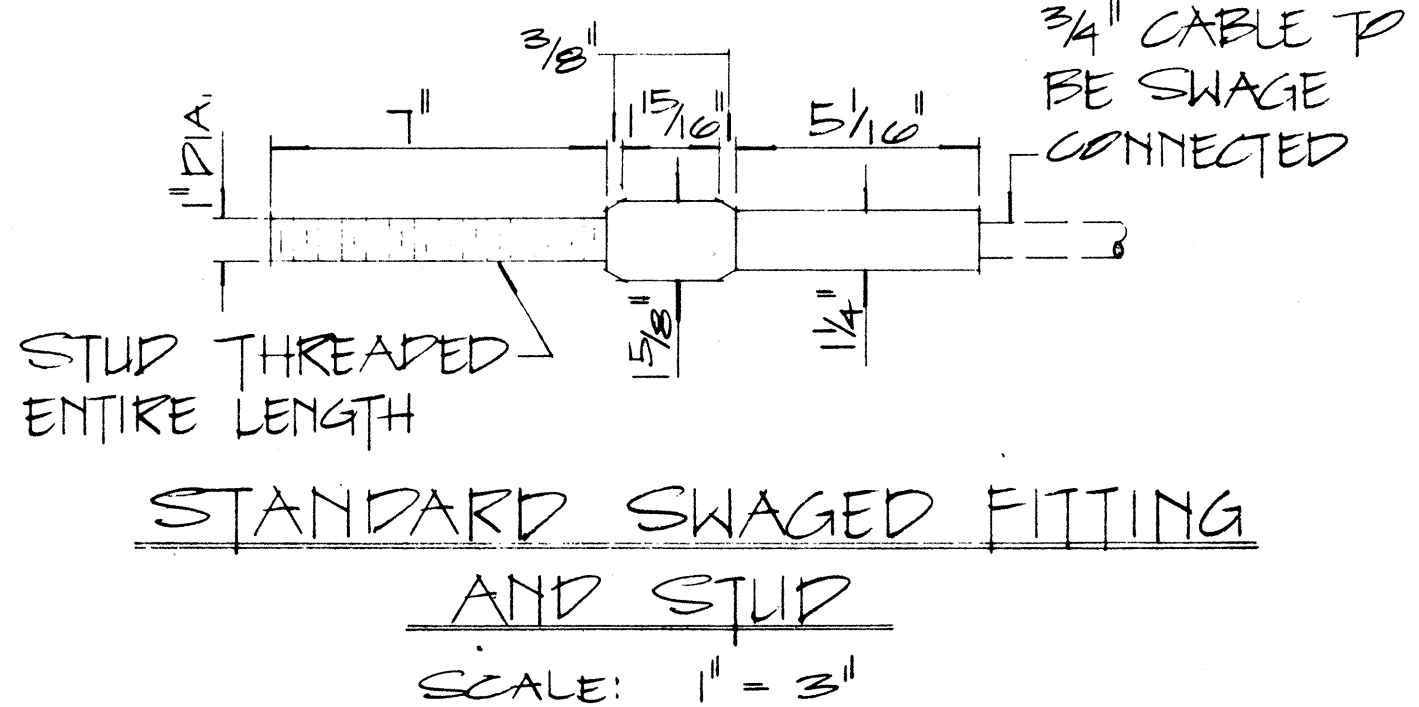

APPROVAL RECOMMENDED:		12/29/69	
TRAFFIC ENGINEER		DATE	
APPROVED:		12-30-69	
ASSISTANT CHIEF, ENGINEERING		DATE	
NO.	REVISION	APPROVED BY	DATE

STATE OF HAWAII
DEPARTMENT OF TRANSPORTATION
LAND TRANSPORTATION FACILITIES DIVISION

STANDARD DETAILS


EARTH MOUND AND ANCHOR BLOCK DETAILS

SCALE: AS SHOWN


SHEET No. 25 OF 26 SHEETS

DATE	
DESIGNED BY	
DRAWN BY	
CHECKED BY	
NOTED BY	
ORIGINAL PLAN	
NOTE BOOK	


FED. ROAD DIST. NO.	STATE	FED. AID PROJ. NO.	FISCAL YEAR	SHEET NO.	TOTAL SHEETS
HAWAII	HAW.				

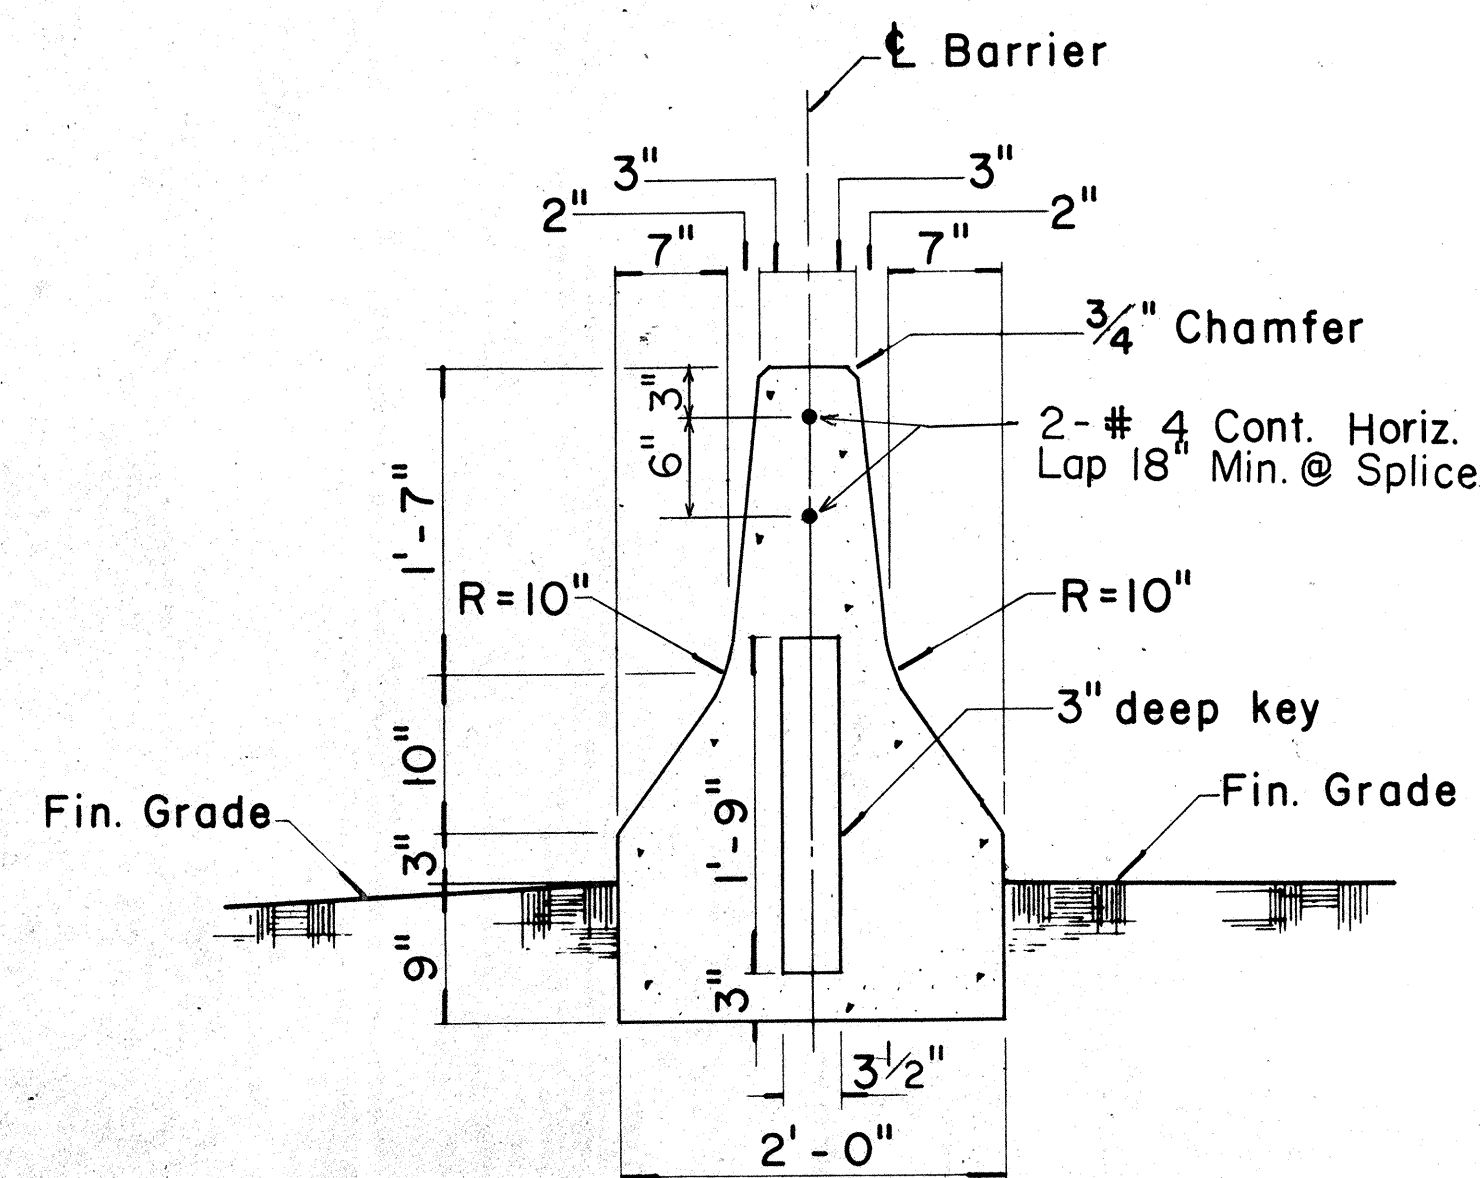

TYPE 4A
Scale: 1" = 1'-0"

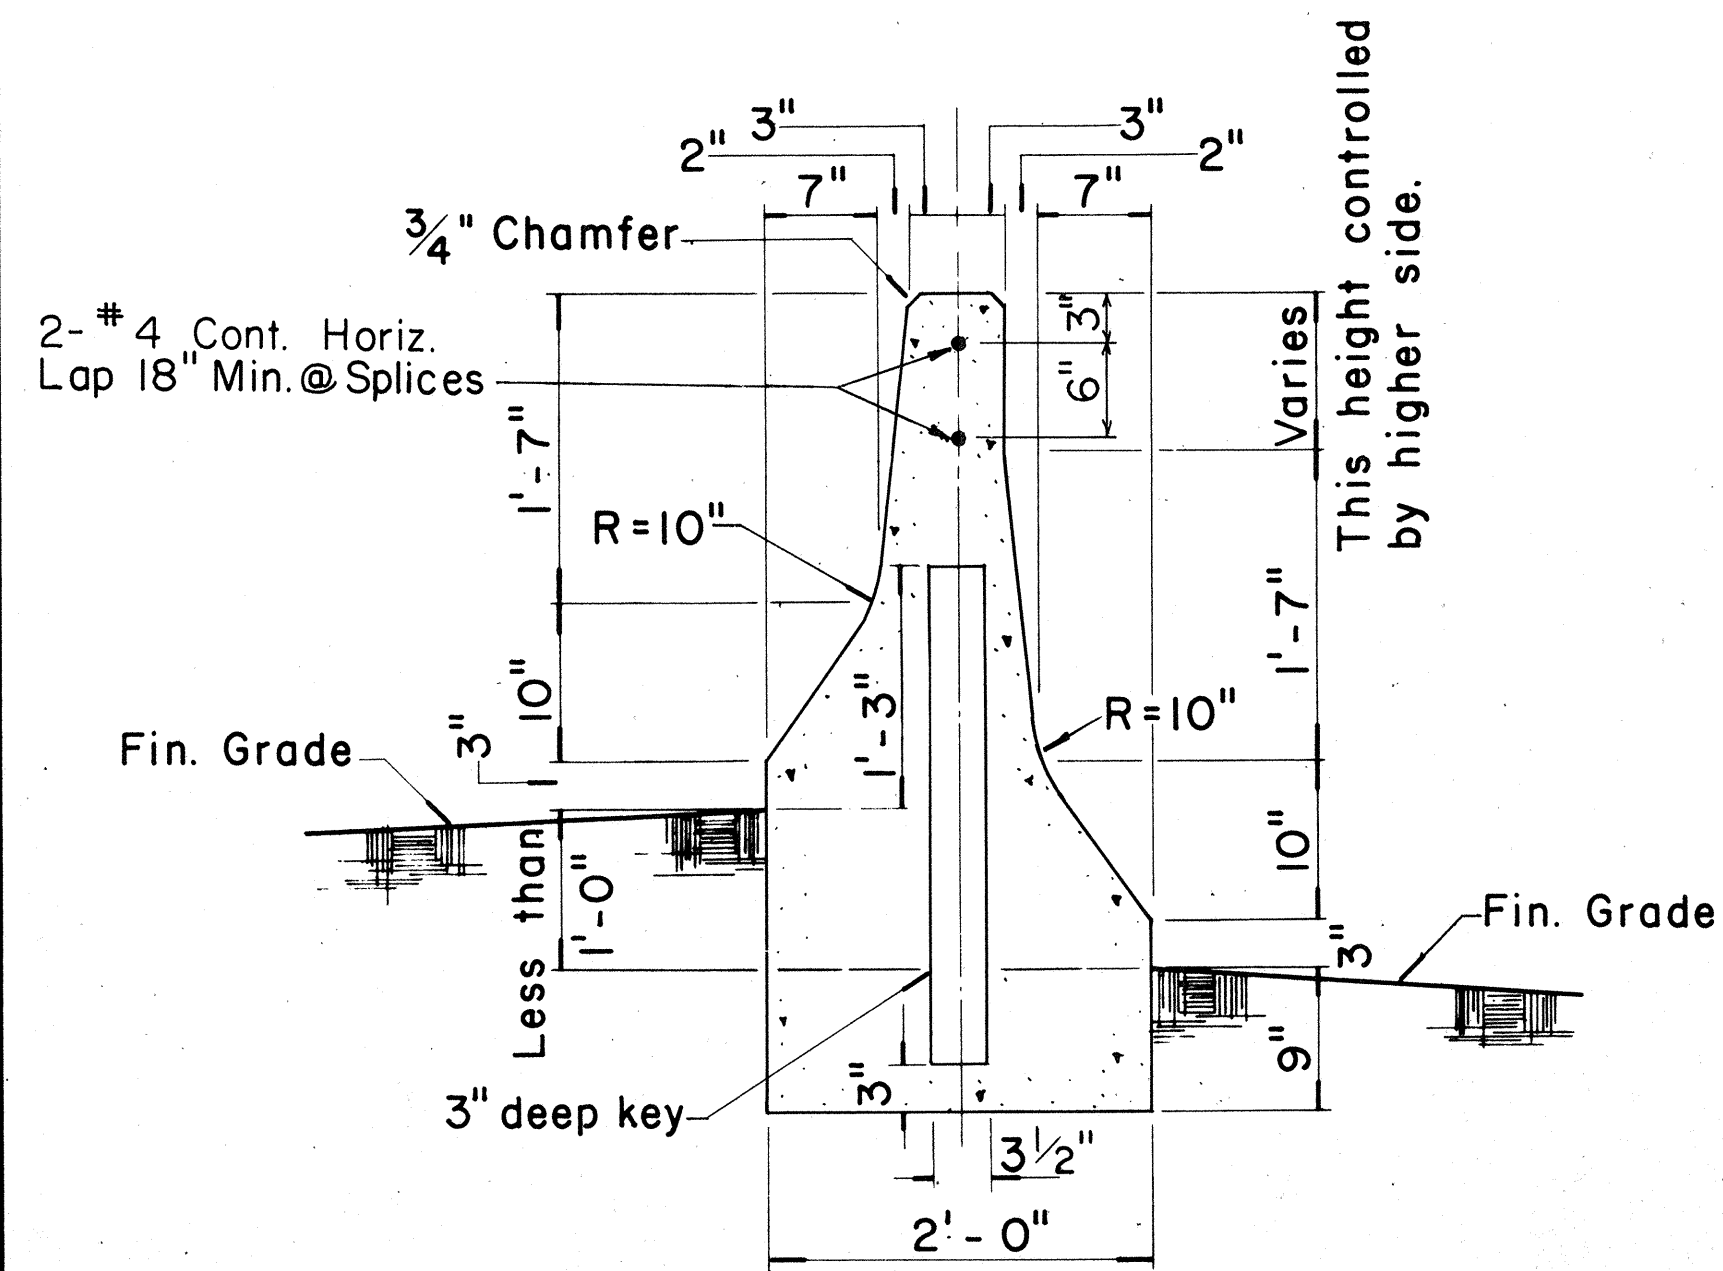

TYPE 4B
Scale: 1" = 1'-0"

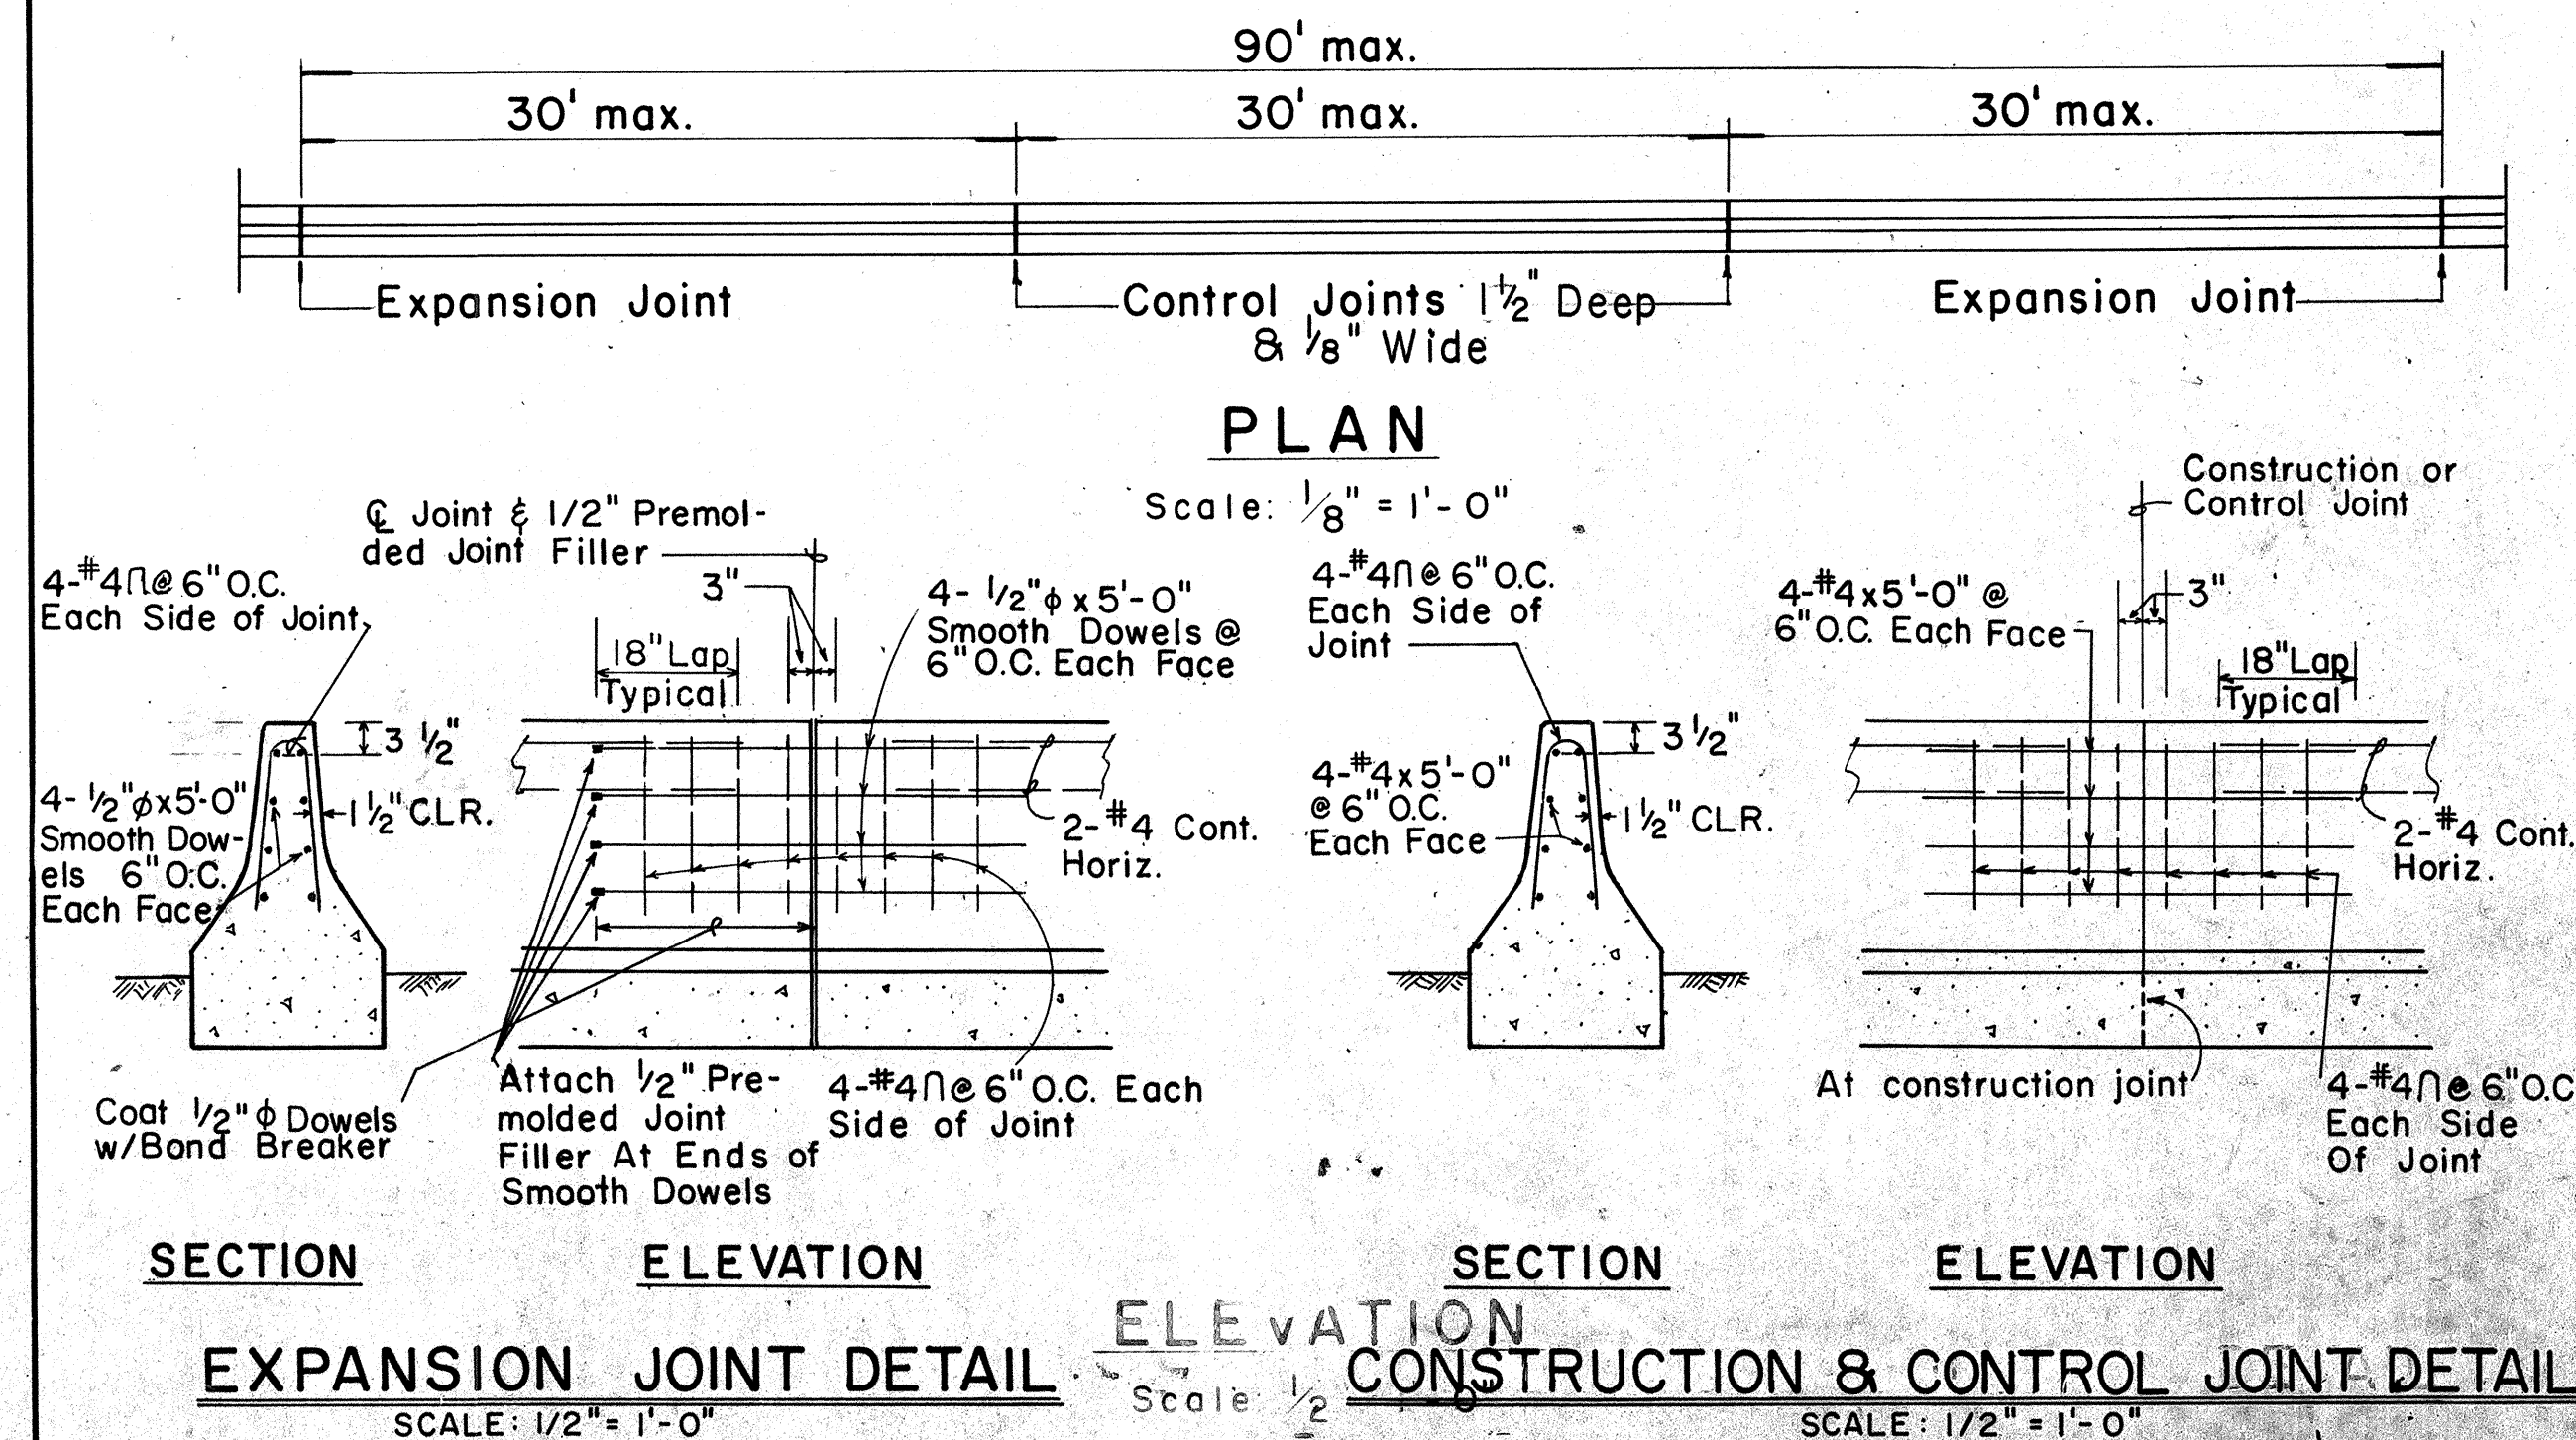


EXPANSION JOINT DETAIL Scale: 1/2" = 1'-0"
CONSTRUCTION & CONTROL JOINT DETAIL Scale: 1/2" = 1'-0"

GENERAL NOTES

- Precast Rigid Barrier Guard Rail may be installed as an option to cast-in-place Type 4 Rigid Barrier Guard Rail. Contractor shall submit shop drawings to Engineer for approval.
- Expansion Joints shall be constructed at ninety-foot (90 ft.) maximum intervals and at existing expansion joints of structures. (Use 1/2" pre-molded joint filler, incidental to Type 4 Rigid Barrier Guard Rail). Control Joints shall be placed between expansion joints at 30' maximum. Shear keys shall be required at all construction joints.
- The exterior surface and vertical alignment of the Type 4 Rigid Barrier Guard Rail shall be constructed to give a uniform and presentable appearance. Variation of more than 1/4" in 20' max. and 1/2" in 40' or more will be considered objectionable. The Engineer will determine the acceptability of the work. During the course of the work, samples may be tested and measurements made to establish whether or not the specified values or dimensions are being met. If the specified values or dimensions are not being met, the Engineer will determine the degree of the non-conformance, the effect on the serviceability of the project, whether the work be accepted and remain in place and, if so, the amount to be paid for such work, or whether the work shall be removed and replaced or otherwise corrected at the Contractor's expense.

NOTE: 1/2" PREMOLDED JOINT FILLER IS NOT REQUIRED AT CONSTRUCTION JOINTS.

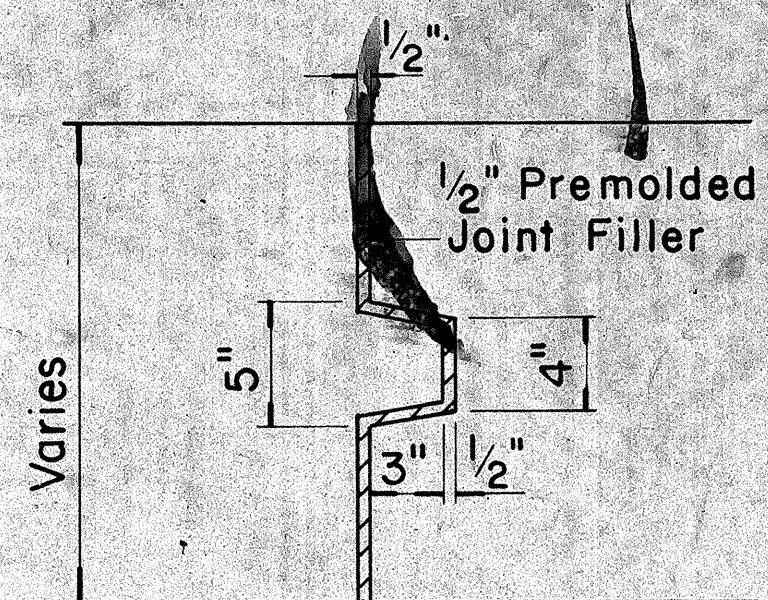

SECTION THRU KEY AT EXPANSION JOINT
Scale: 1 1/2" = 1'-0"

APPROVAL RECOMMENDED:
Erich Tanaka 1/20/81
TRAFFIC ENGINEER DATE


APPROVED:
Harold A. Leisner 1/21/81
ASSISTANT CHIEF, ENGINEERING DATE

STATE OF HAWAII
DEPARTMENT OF TRANSPORTATION
HIGHWAYS DIVISION

STANDARD DETAILS GUARD RAIL TYPE 4 (RIGID BARRIER)

Scale: As Shown
SHEET No. OF SHEETS DT 521


NO.	REVISION	APPROVED BY	DATE
1	Supersede Sht. DT 521 Approved 2-18-89		2/21/89
2	Add 4" Steel Reinforcement Bar Dimension Detail.		
3	Add additional detail.		

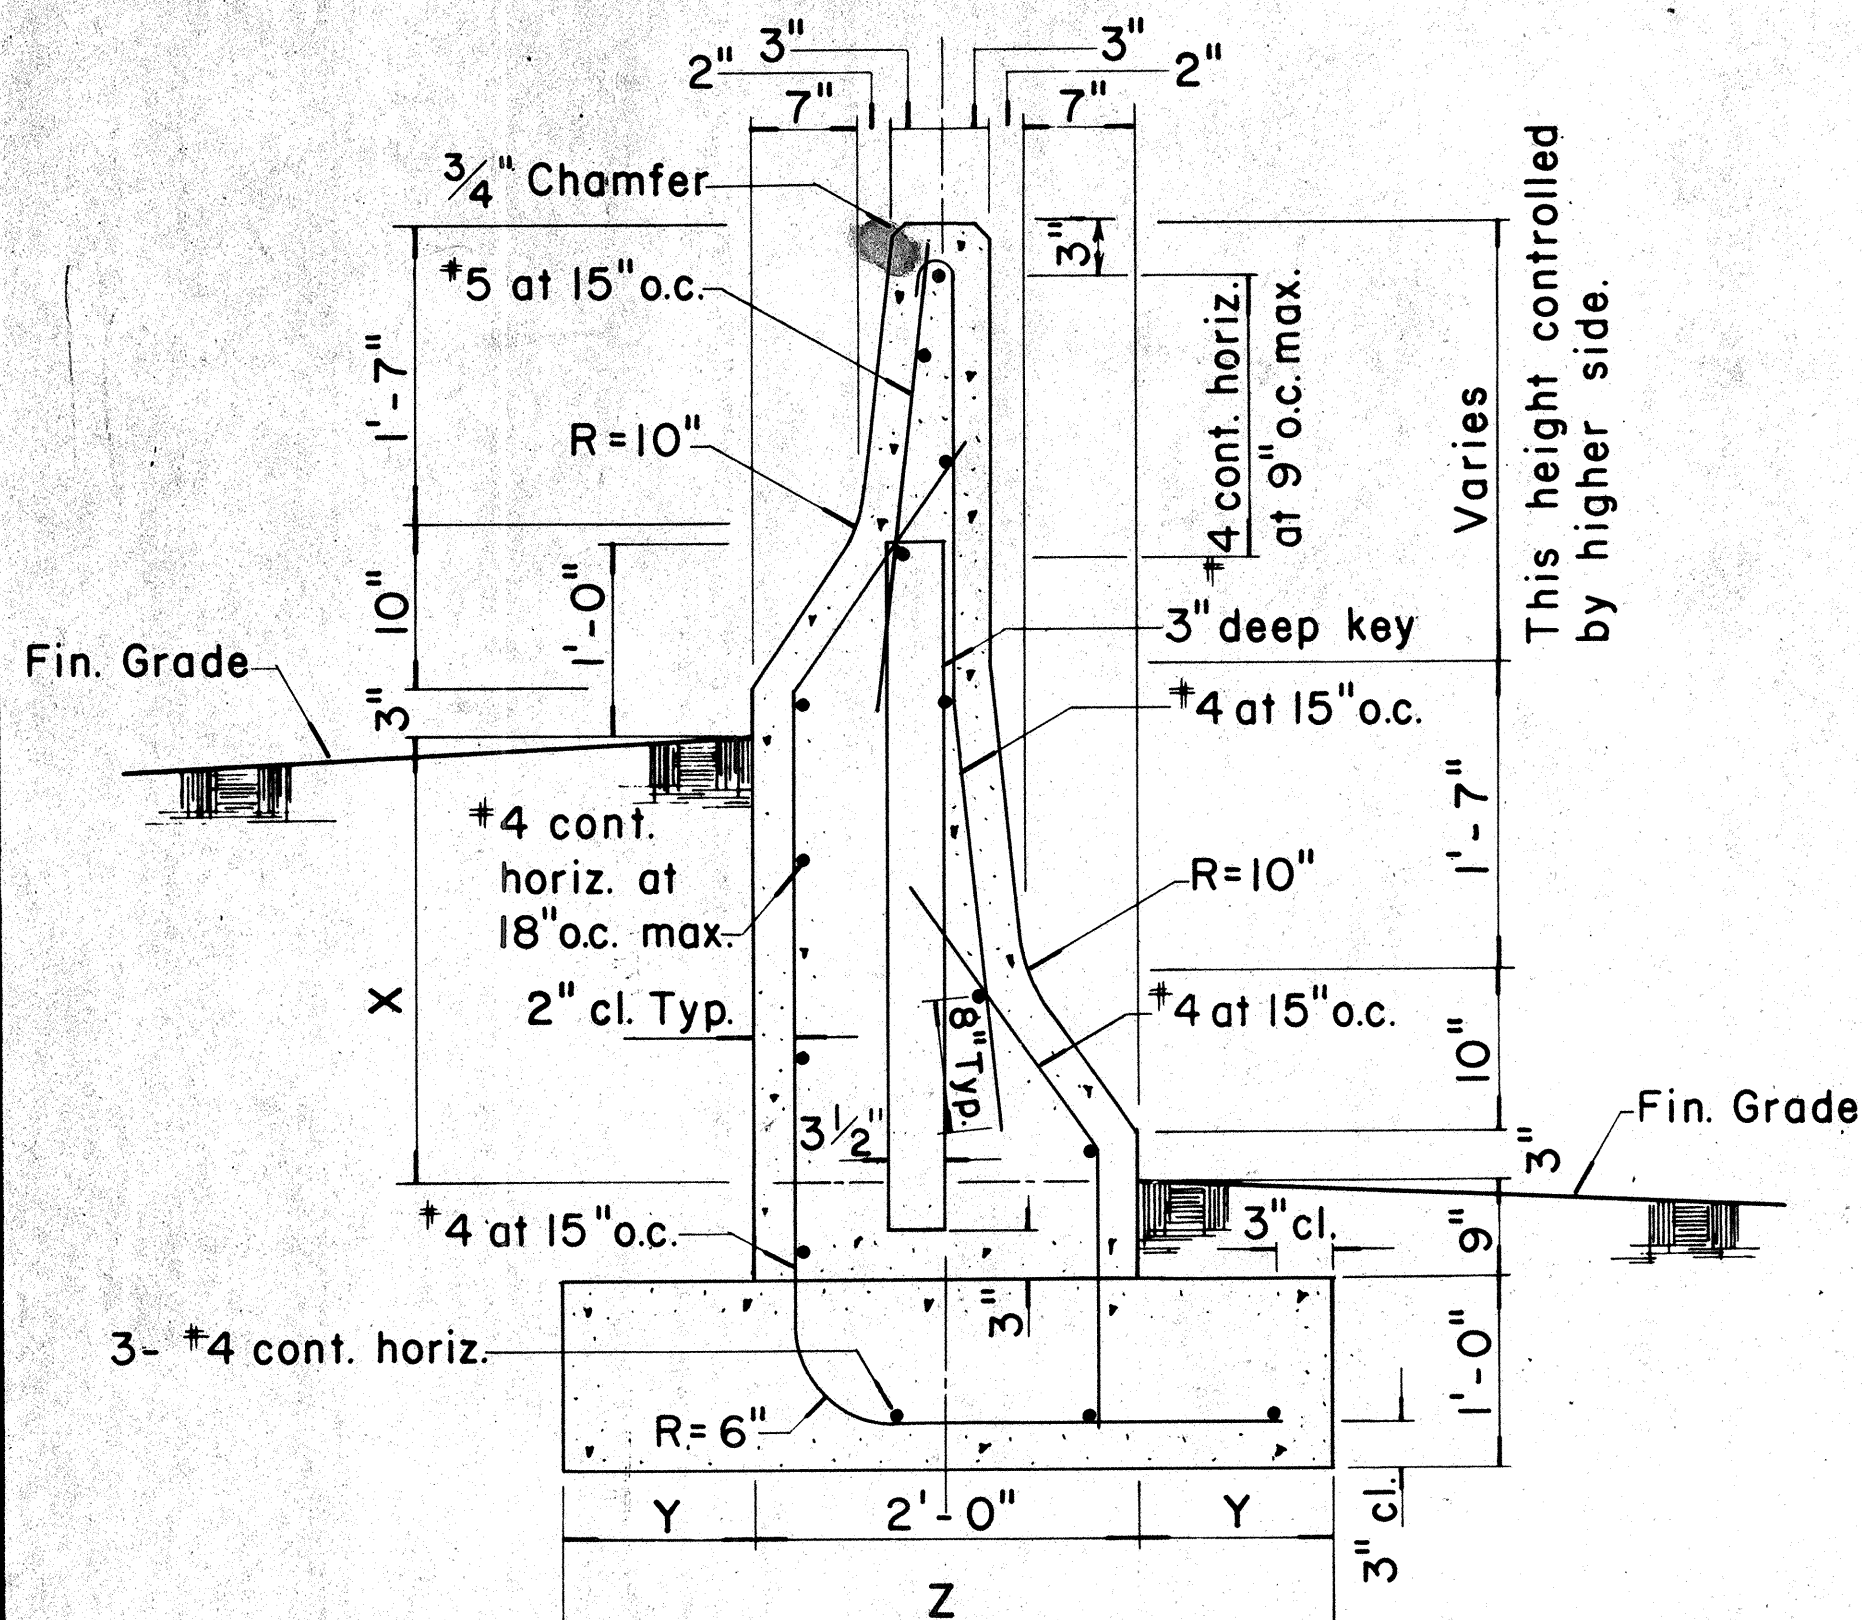

TYPE 4C & TYPE 4D
Scale: 1" = 1'-0"

TYPE	DIFFERENCE IN FIN. GRADE	FOOTING
	X	Y Z
4C	1'-0" min., 2'-4" max.	1'-0" 4'-0"
4D	Greater than 2'-4", 4'-4" max.	1'-3" 4'-6"

NOTE:
Except where noted all dimensions shall be the same for Type 4C and Type 4D.

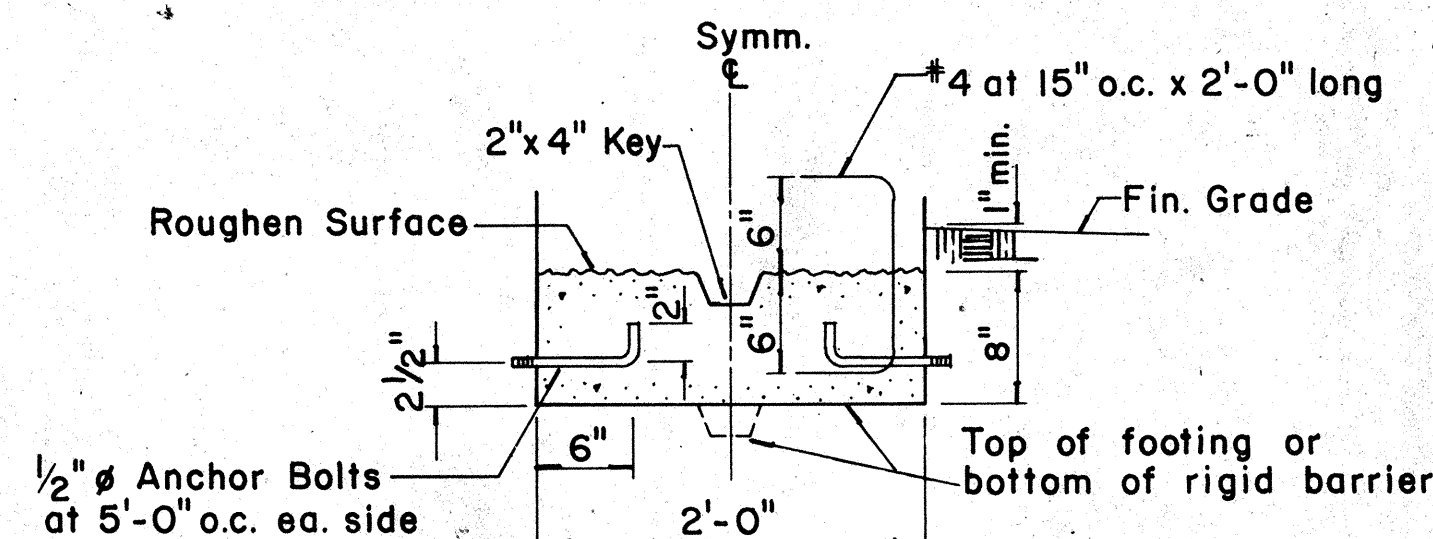


OPTIONAL CONSTRUCTION JOINT DETAILS
Scale: 1" = 1'-0"

NOTE:
The intent of the optional construction joint details for the Type 4 Rigid Barrier Guard Rail is to provide a method of securing the forms and preventing uplift so that the barrier will have a uniform and presentable appearance. The Contractor may submit an alternate method of constructing the barrier for the approval of the Engineer and for use on a trial basis. Any unsatisfactory work shall be removed or corrected as directed by the Engineer and at the Contractor's expense.

DATE	DESIGNED BY	CHECKED BY
1/20/81	Erich Tanaka	Harold A. Leisner
PLAN	DESIGNED BY	CHECKED BY
NOTE BOOK	DESIGNED BY	CHECKED BY
NO.	DESIGNED BY	CHECKED BY



FED. ROAD DIST. NO.	STATE	FED. AID PROJ. NO.	FISCAL YEAR	SHEET NO.	TOTAL SHEETS
HAWAII	HAW.	1-H1-1(131):17	1977	635-1	394

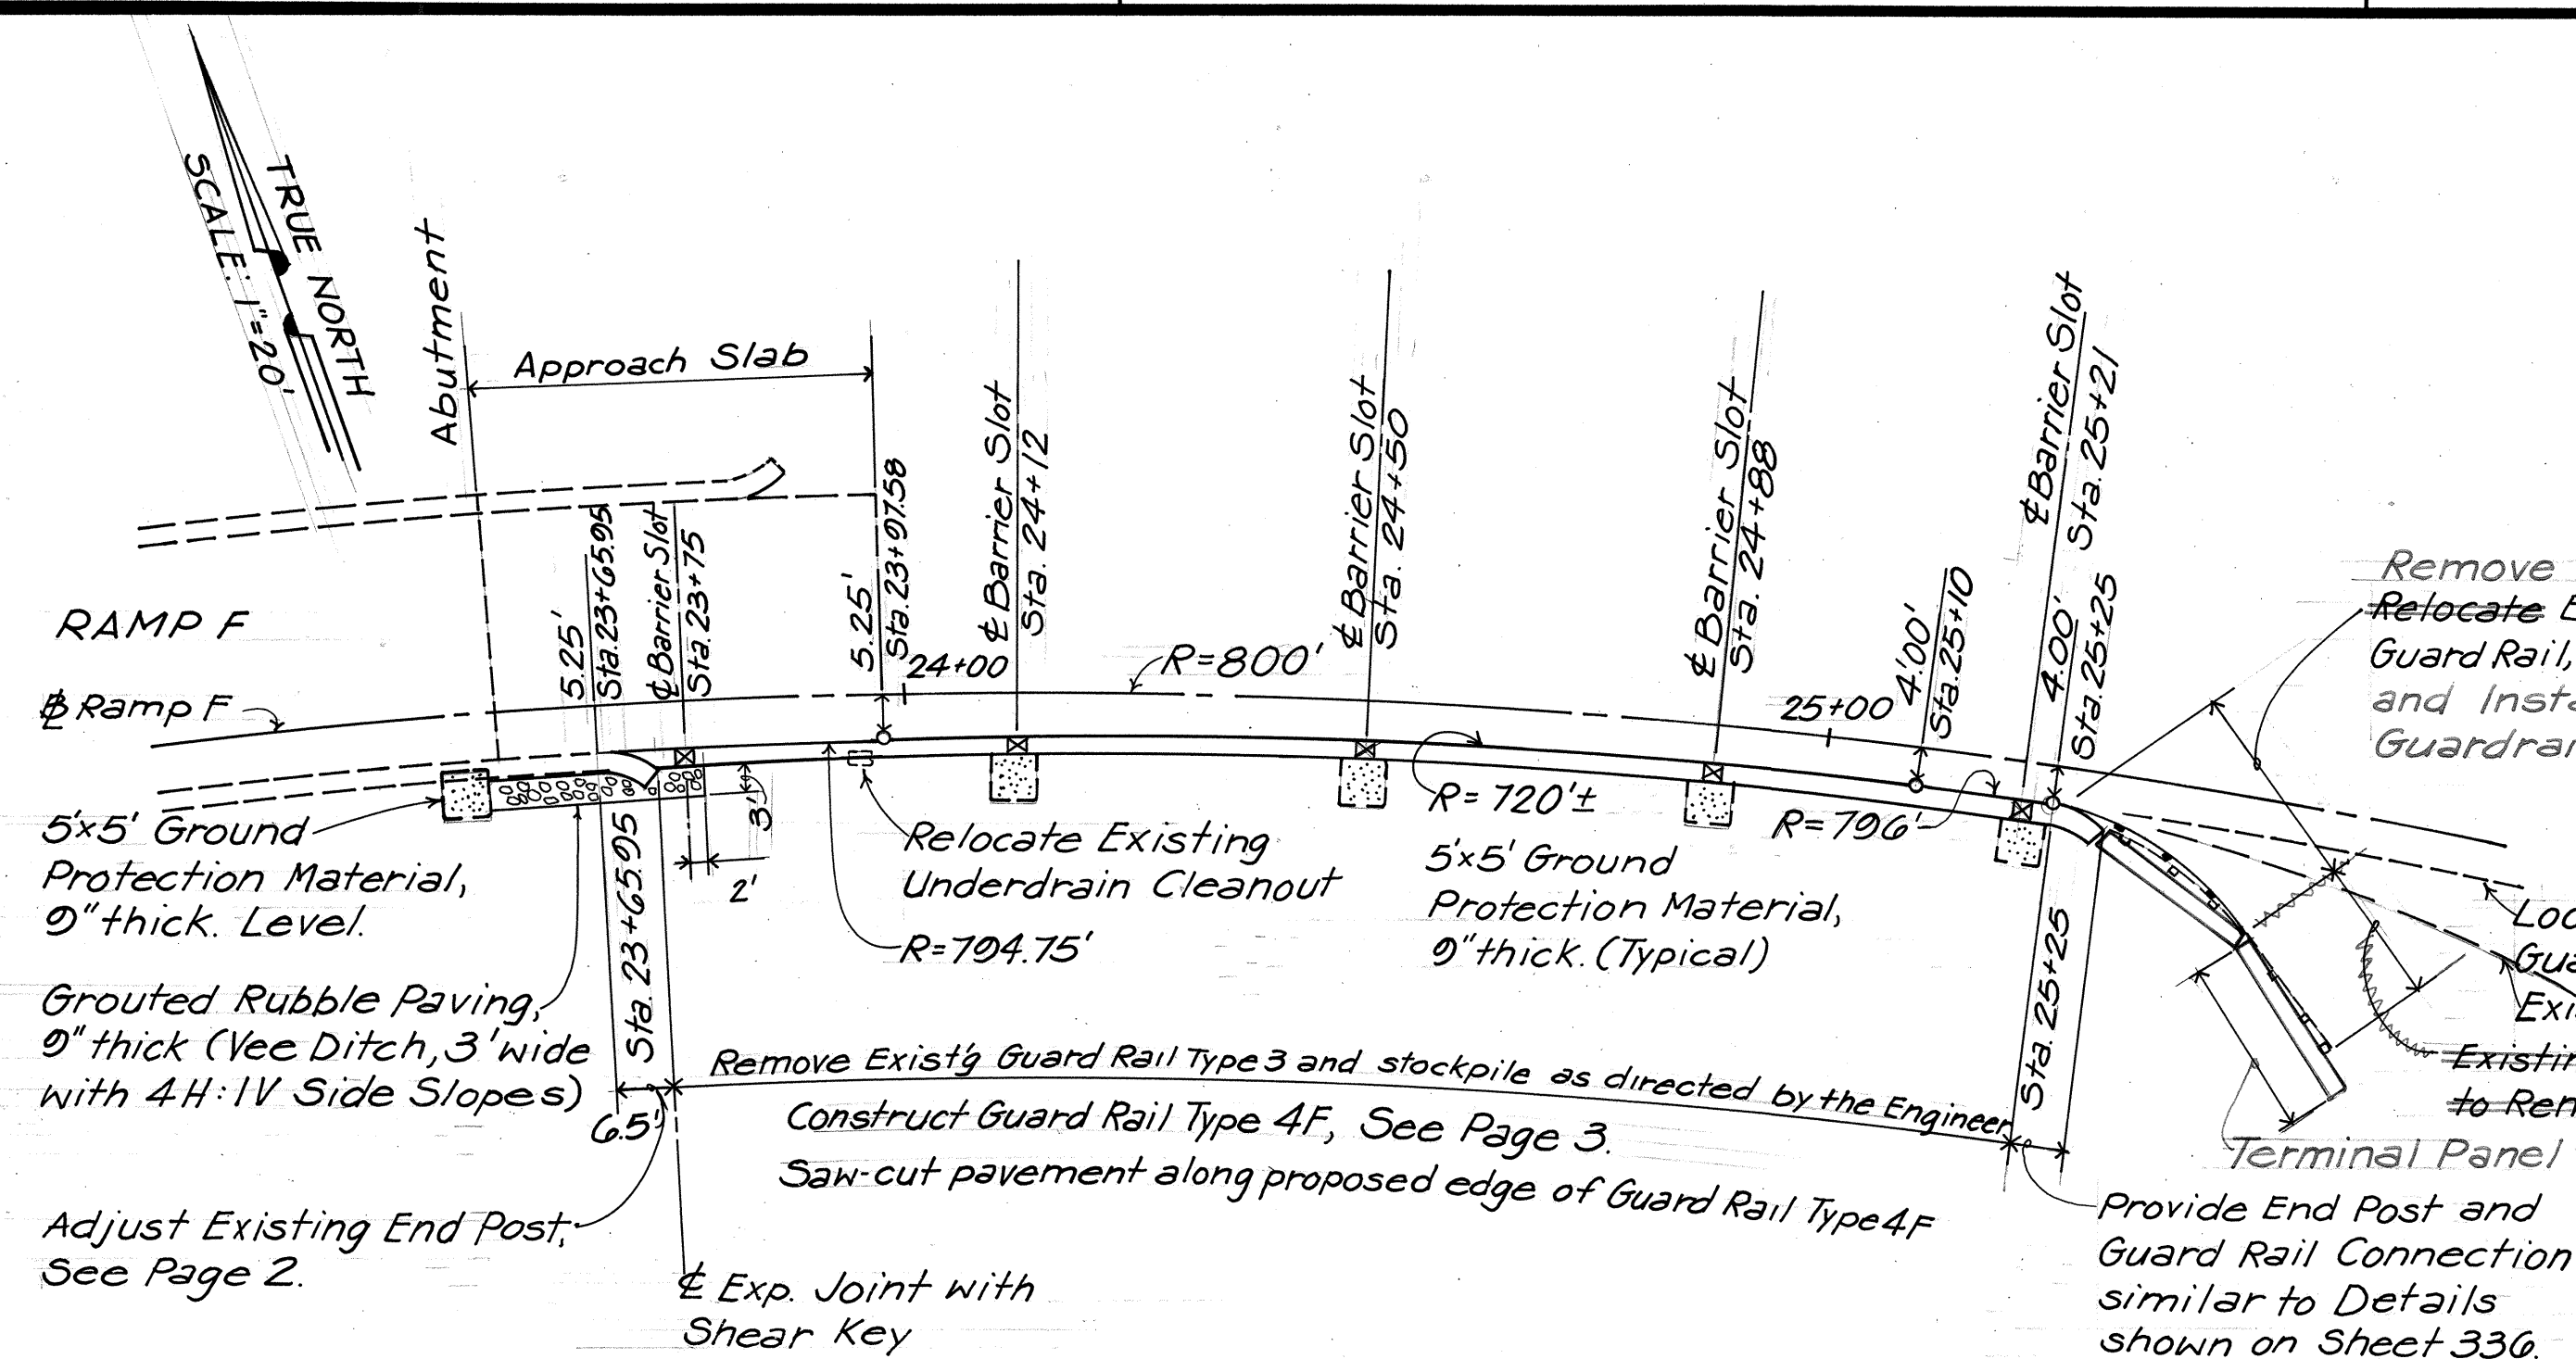

GUARDRAIL TRANSITION TO MEET EXISTING GUARDRAIL
RAMP F STA. 23+65.95


PLAN
SCALE: 1" = 20'

PLAN-ADJUSTMENT OF EXISTING END POST
SCALE: 1/2" = 1'-0"

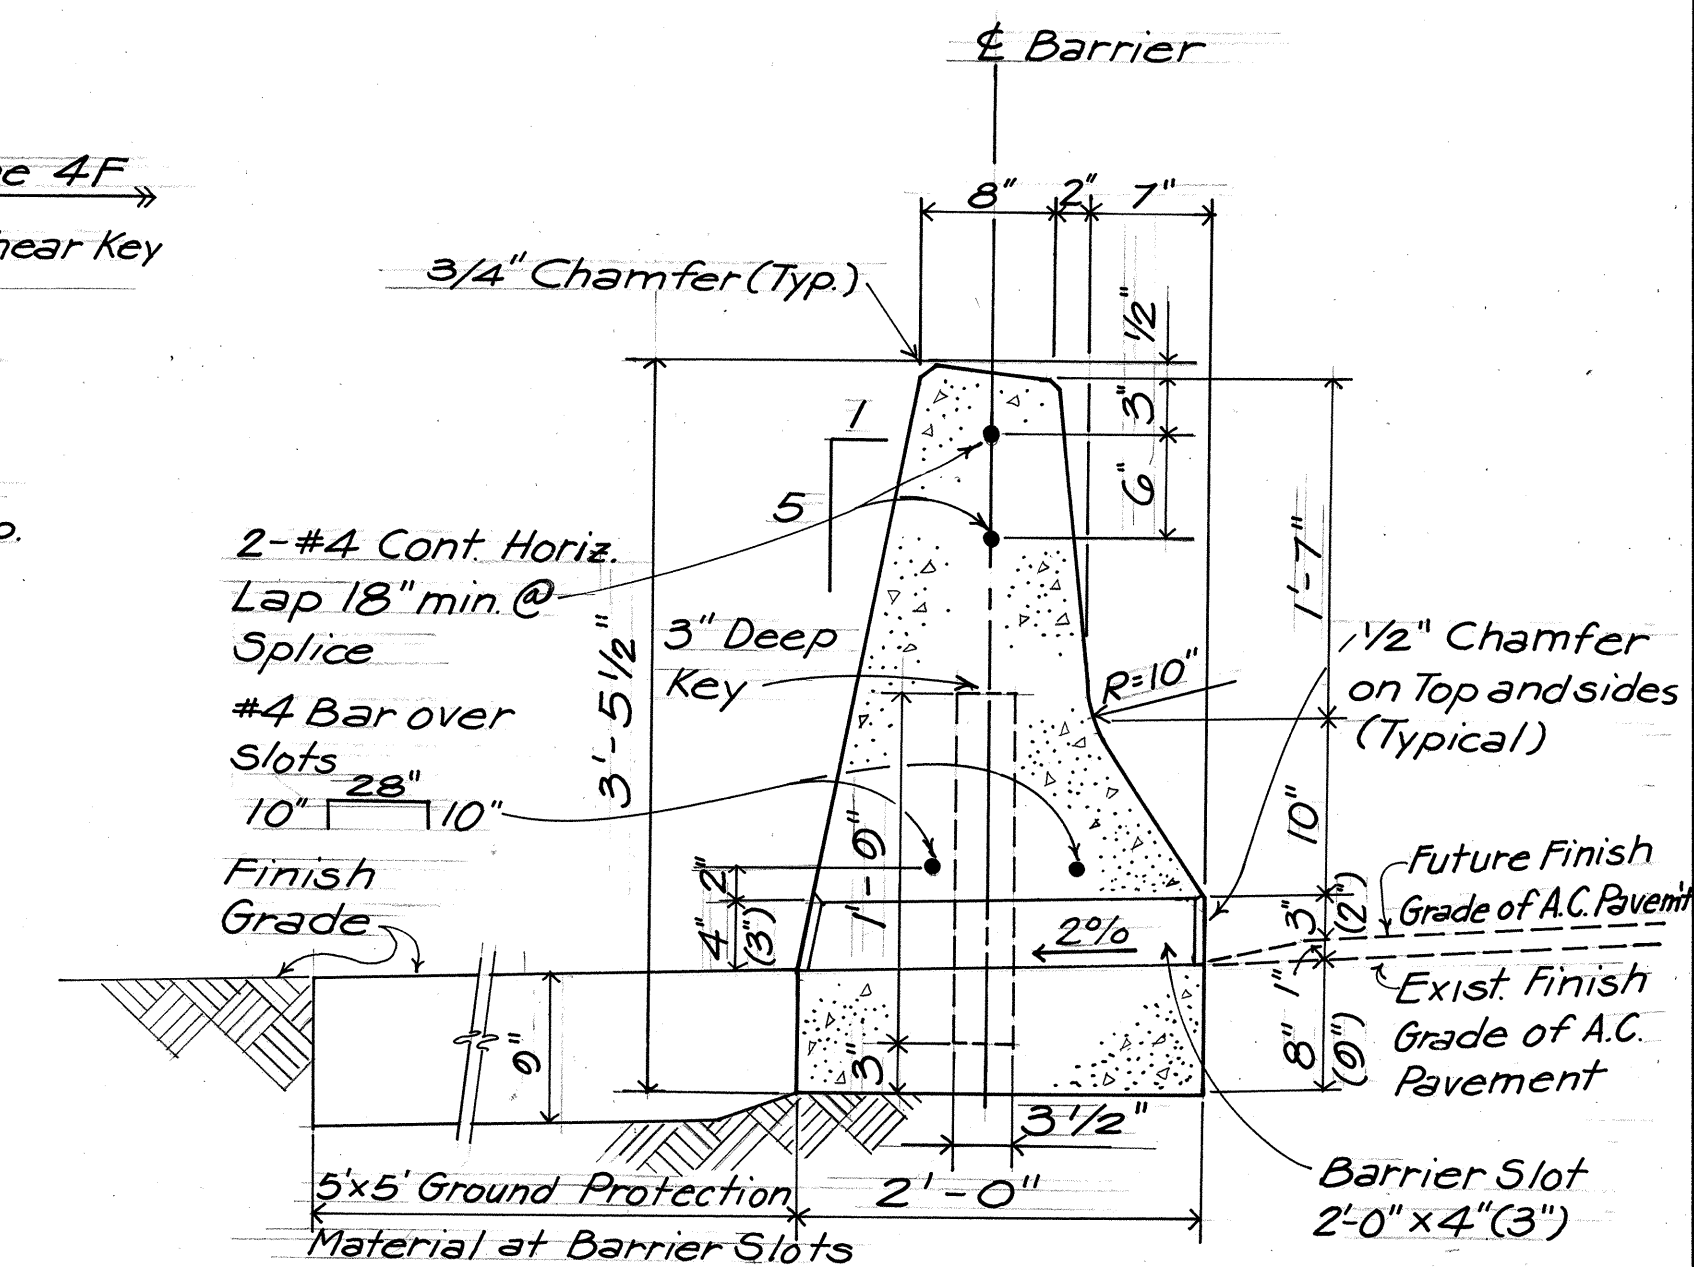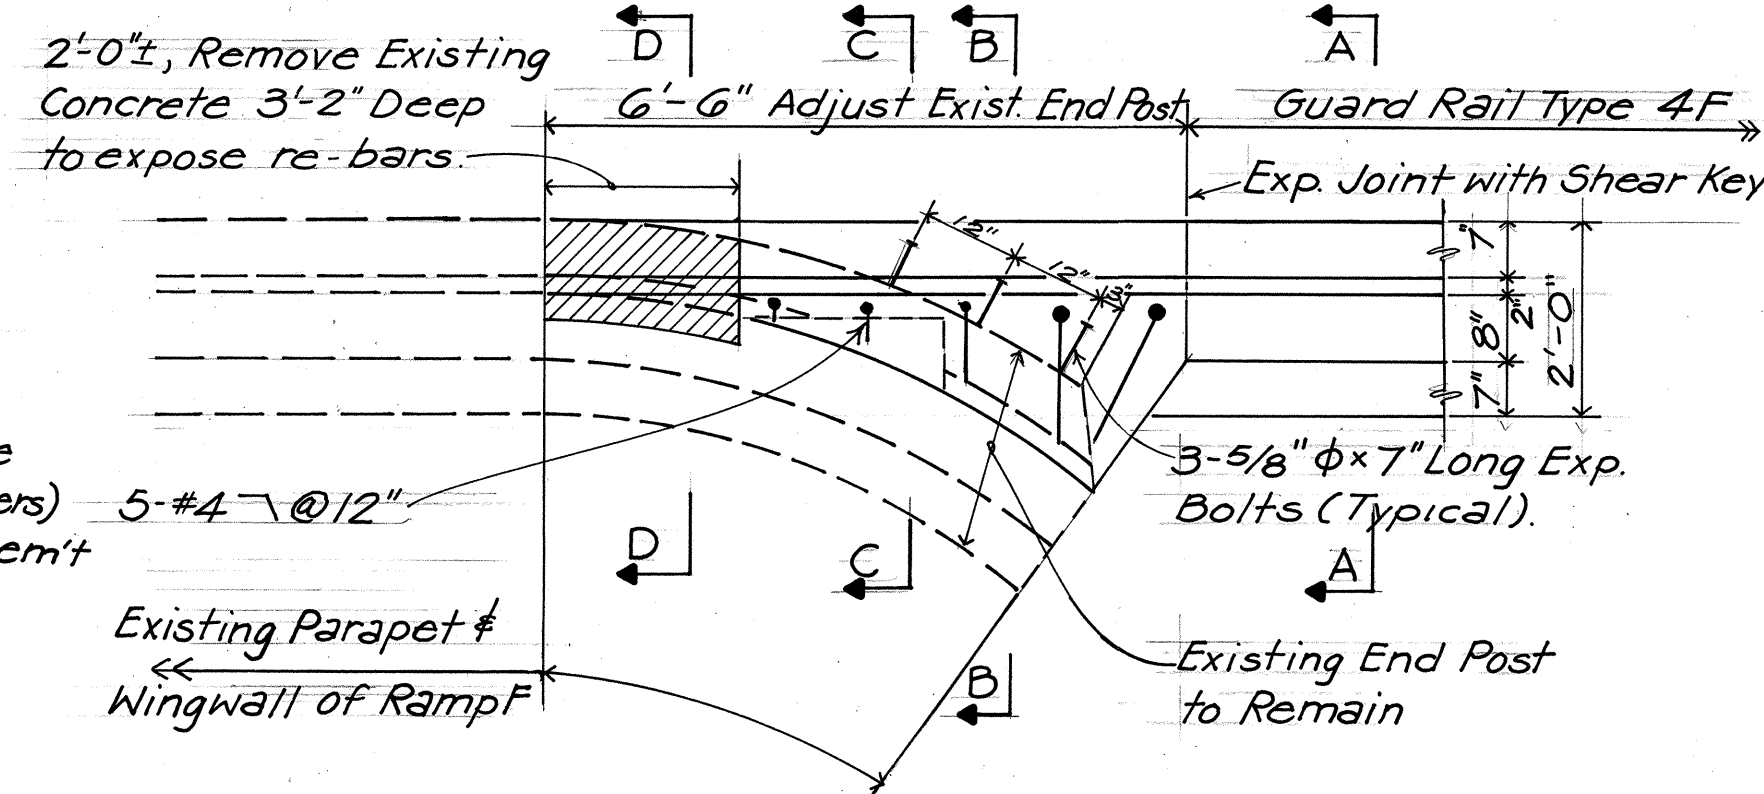


Notes: 1. Dimensions in () apply only to Barrier Slot adjacent to Approach Slab.
2. For General Notes see Standard Sheet G3.


SECTION A-A
TYPICAL SECTION-GUARDRAIL TYPE 4F
SCALE: 1" = 1'-0"

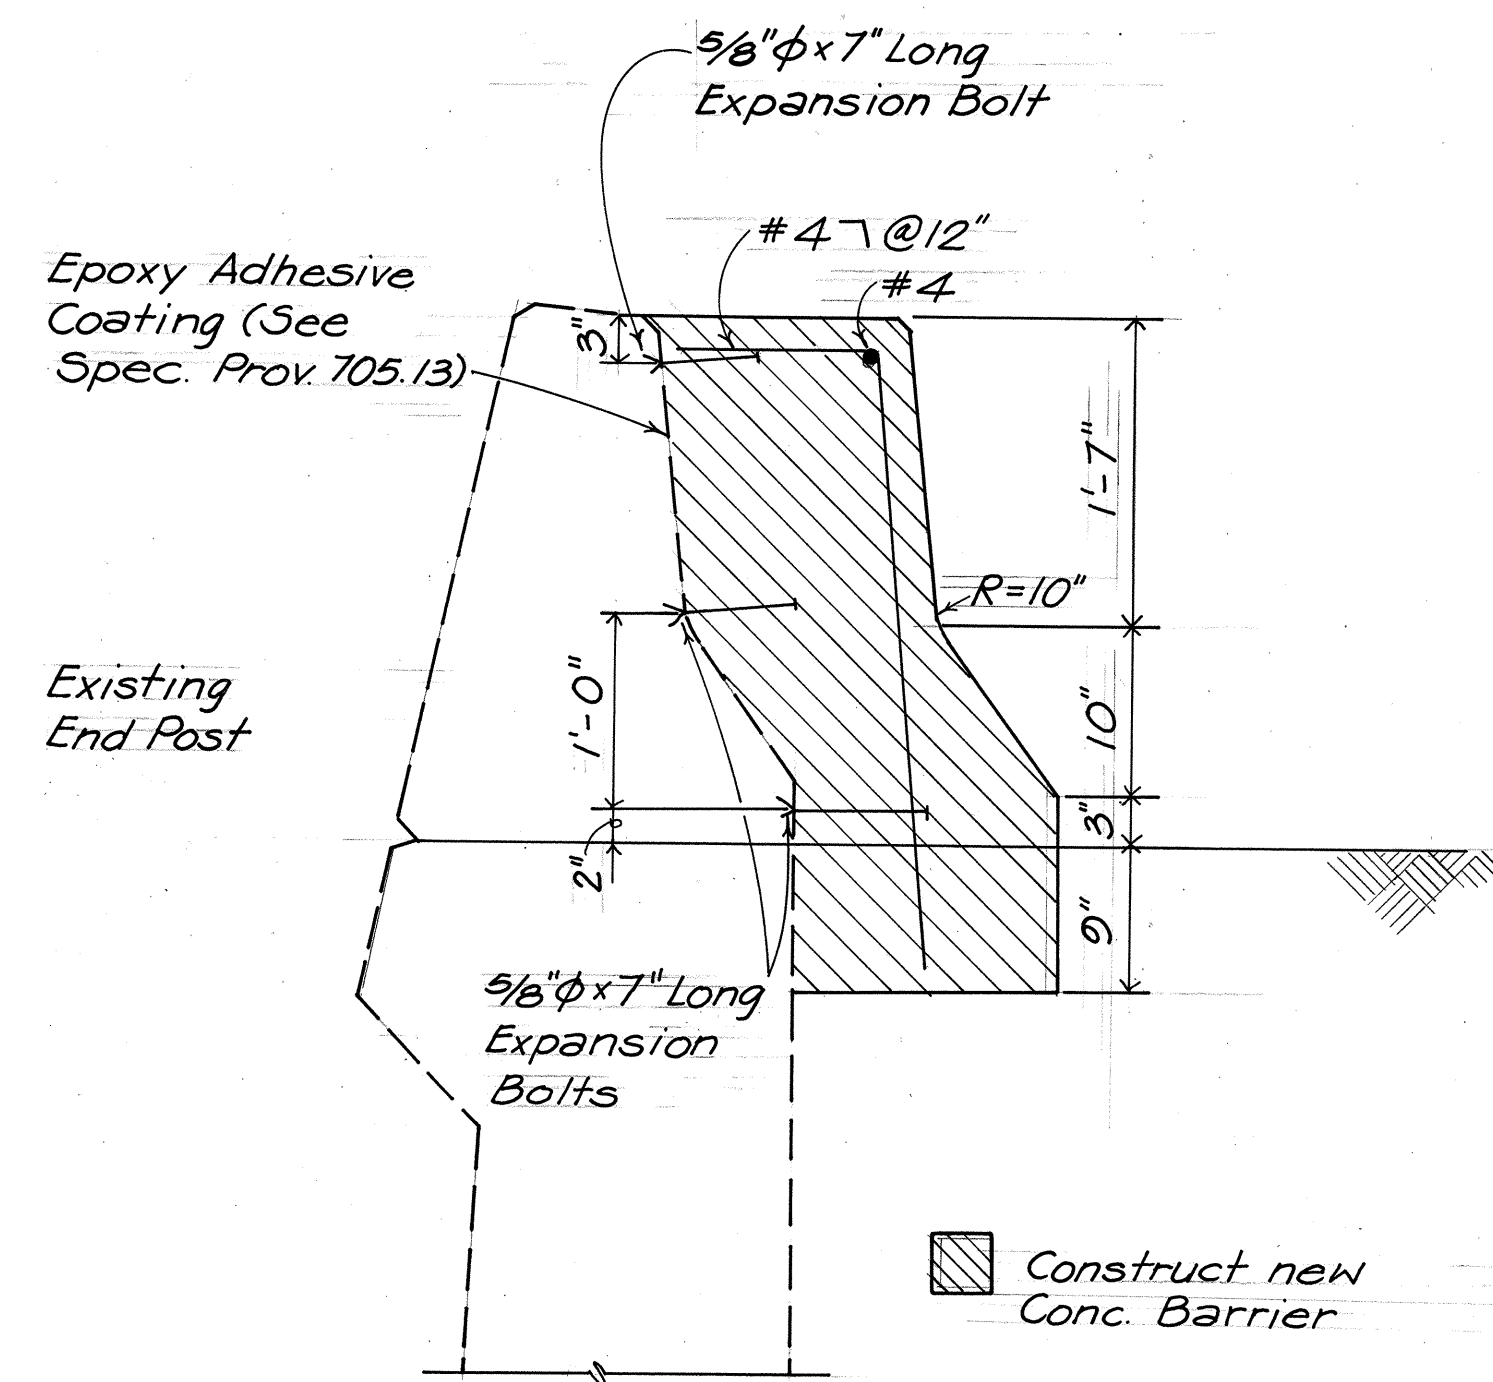

SECTION B-B
SCALE: 1" = 1'-0"

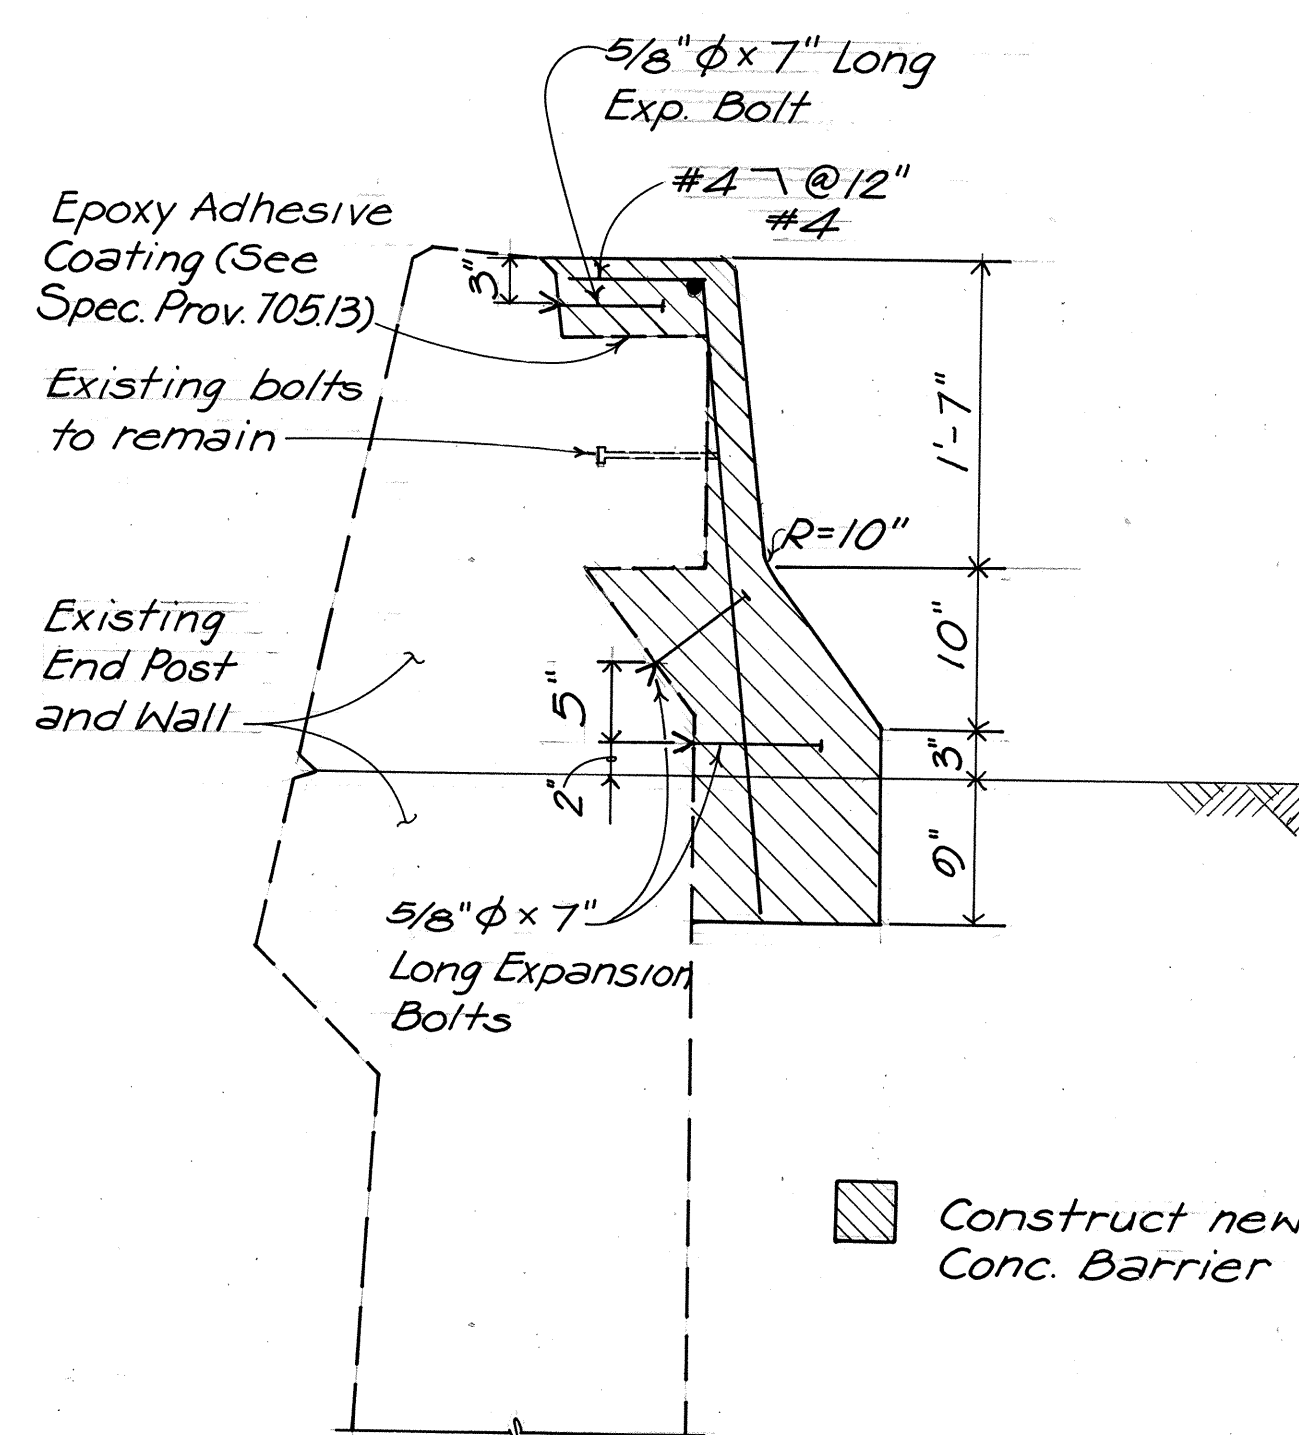

SECTION C-C
SCALE: 1" = 1'-0"

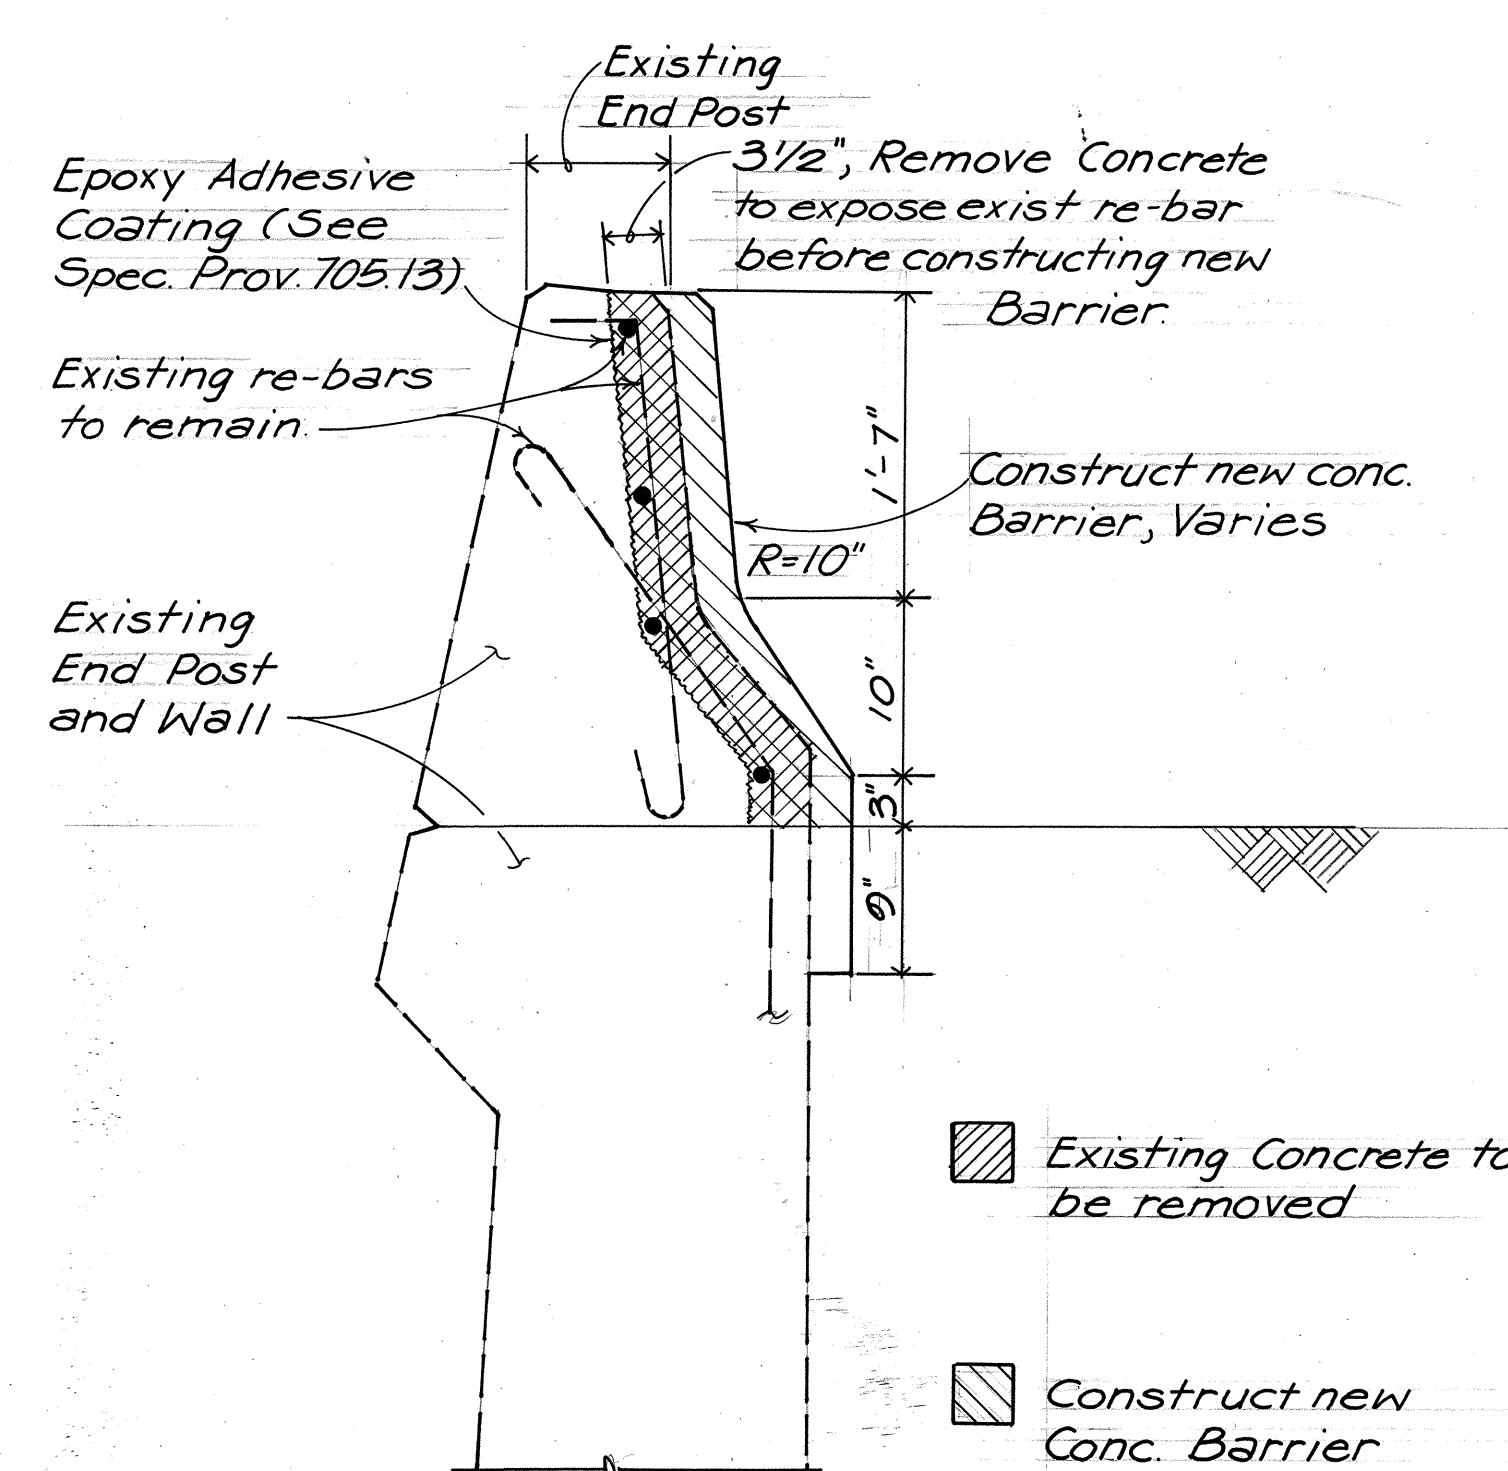

SECTION D-D
SCALE: 1" = 1'-0"

Note: This tracing prepared during 'As-Built' posting.

STATE OF HAWAII
DEPARTMENT OF TRANSPORTATION
HIGHWAYS DIVISION

TYPE 4F GUARDRAIL
RAMP F STA. 23+65.95 TO 25+31

INTERSTATE ROUTE H-1
PROJECT NO 1-H1-1(131):17

SCALE: AS SHOWN