

| INDEX TO DRAWINGS |                                                               |
|-------------------|---------------------------------------------------------------|
| SHEET NO.         | DESCRIPTION                                                   |
| 1                 | TITLE SHEET                                                   |
| 2-3               | CONSTRUCTION PHASING                                          |
| 4-7               | TYPICAL ROADWAY SECTIONS                                      |
| 8-12              | ALIGNMENT PLANS                                               |
| 13-25             | ROADWAY PROFILES AND SUPERELEVATION DIAGRAMS                  |
| 26-32             | RAMP TERMINAL AND INTERSECTION DETAILS                        |
| 33-37             | ROADWAY CONSTRUCTION PLANS                                    |
| 38-63             | ROADWAY DETAILS                                               |
| 64-68             | DRAINAGE AND GRADING PLANS                                    |
| 69-74             | DRAINAGE PROFILES                                             |
| 75                | STREAM IMPROVEMENTS                                           |
| 76-97             | DRAINAGE SUMMARY                                              |
| 98-114            | DRAINAGE DETAILS                                              |
| 115               | RAMP E SOIL STABILIZATION                                     |
| 116-123           | SIGNING AND PAVEMENT MARKING PLANS                            |
| 124-153           | SIGNING DETAILS                                               |
| 154-172           | HIGHWAY LIGHTING AND TRAFFIC SIGNALS                          |
| 173-195           | UTILITIES                                                     |
| 196-214           | LANDSCAPING AND IRRIGATION                                    |
| 215-228           | BORING LOCATION PLAN AND LOGS                                 |
| 229-231           | RETAINING WALL 'Y' AND 'Z'                                    |
| 232-276           | H-I VIADUCT (EB & WB), RAMP A, F&G, RETAINING WALL 'X'        |
| 277-302           | RAMP D & G STRUCTURE                                          |
| 303-325           | KALIHI STREAM BRIDGE #1 WIDENING                              |
| 326-331           | REINFORCED EARTH ALTERNATIVE FOR H-I ABUTMENT & RET. WALL 'X' |
| 332-348           | STRUCTURE STANDARD DETAILS                                    |
| 349-394           | CROSS SECTIONS & KEY SHEET                                    |


- ① C.O. 33S-1, C.O. 34S-1,  
② C.O. 63S-1,  
③ C.O. 64S-1, C.O. 65S-1, ④ C.O. 103S-1  
⑤ C.O. 116S-1, C.O. 116S-2, C.O. 121S-1,  
⑥ C.O. 123S-1, C.O. 123S-2  
⑦ C.O. ADD. 134S-1  
⑧ C.O. 242S-1 TO C.O. 242S-5,  
⑨ C.O. 243S-1, C.O. 269S-1,  
C.O. 283S-1, C.O. 296S-1,  
C.O. 382S-1, C.O. 382S-1,  
ARE SUPPLEMENT SHEETS  
TO THE CONTRACT PLANS  
TOTAL = 417 SHEETS.

PARSONS BRINCKERHOFF -  
HIROTA ASSOC.  
DESIGNED BY  
S. UEHARA  
P. S. & E. BY  
521-3051  
AUG 31, 1977  
DATE

STATE OF HAWAII  
DEPARTMENT OF TRANSPORTATION  
LAND TRANSPORTATION FACILITIES DIVISION  
HONOLULU, HAWAII  
"AS-BUILT"  
PLANS FOR  
CONSTRUCTION OF A PORTION OF  
INTERSTATE ROUTE H-1  
KEEHI INTERCHANGE

FEDERAL AID INTERSTATE PROJECT NO. I-HI-I.(131):17


DISTRICT OF HONOLULU  
ISLAND OF OAHU

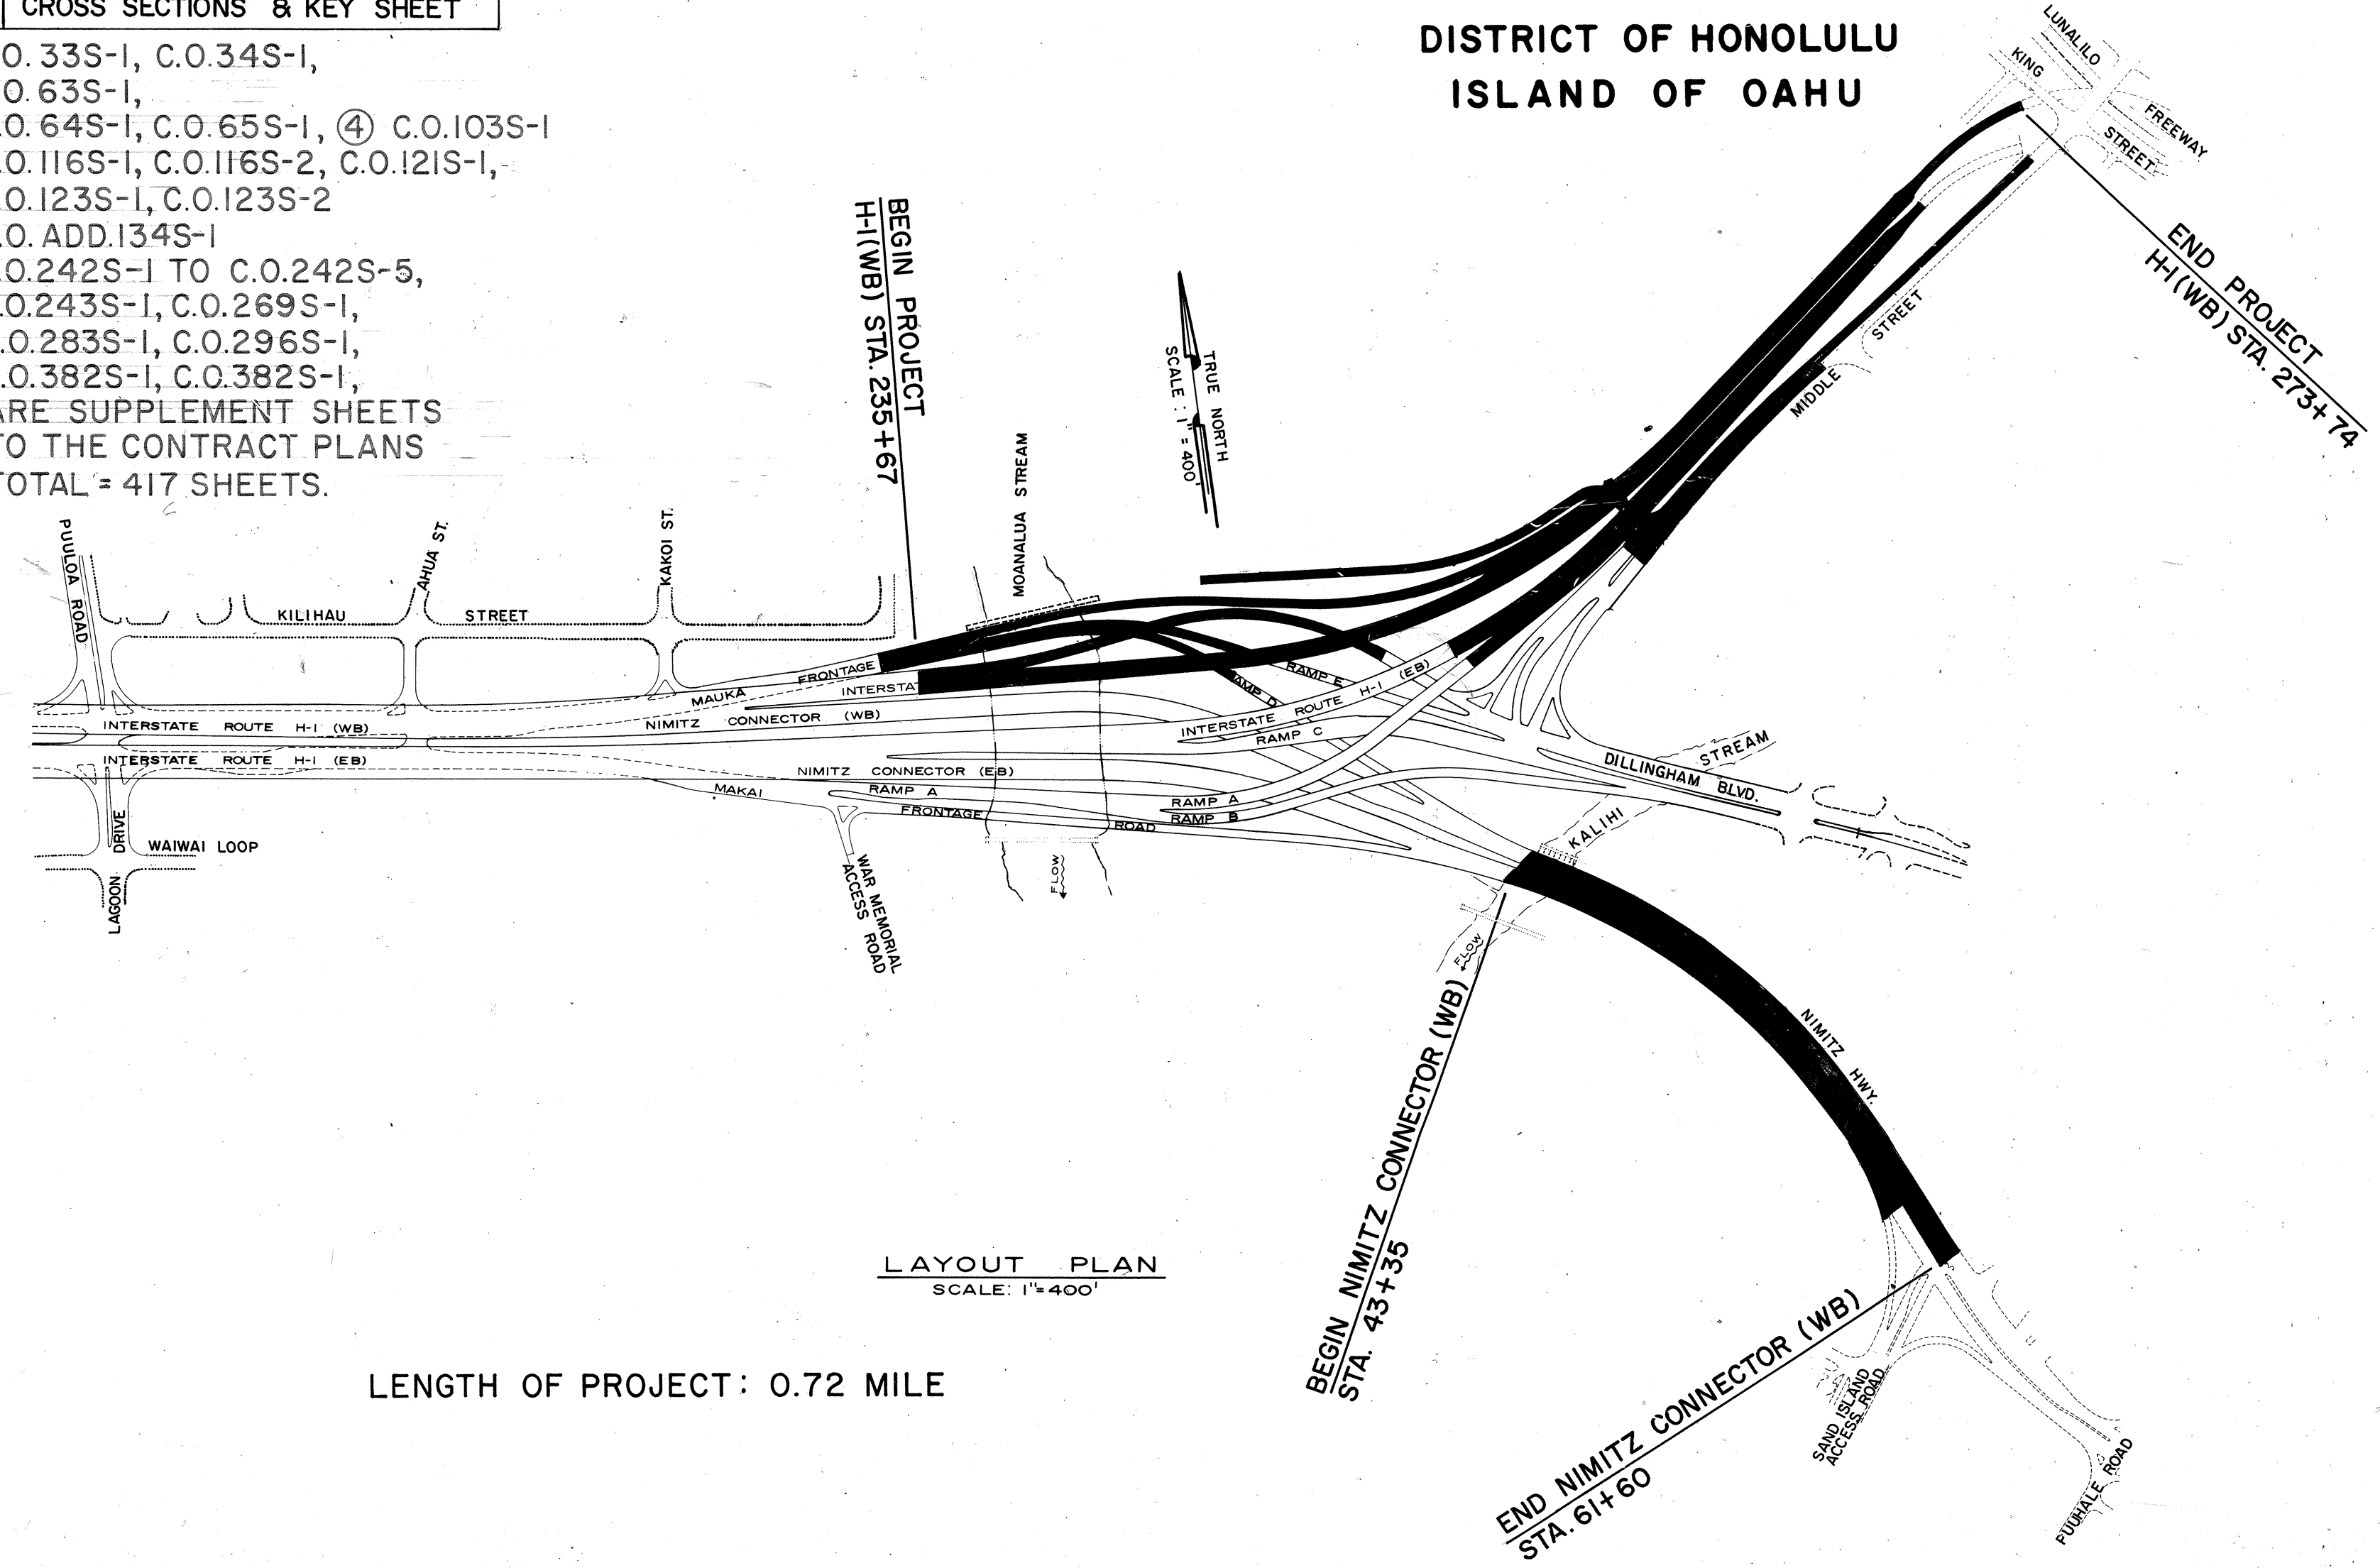

LAYOUT PLAN  
SCALE: 1"=400'

LENGTH OF PROJECT: 0.72 MILE

| FED. ROAD DIST. NO. | STATE | FED. AID PROJ. NO. | FISCAL YEAR | SHEET NO. | TOTAL SHEETS |
|---------------------|-------|--------------------|-------------|-----------|--------------|
| HAWAII              | HAW.  | I-HI-I(131):17     | 1977        | 1         | 394          |

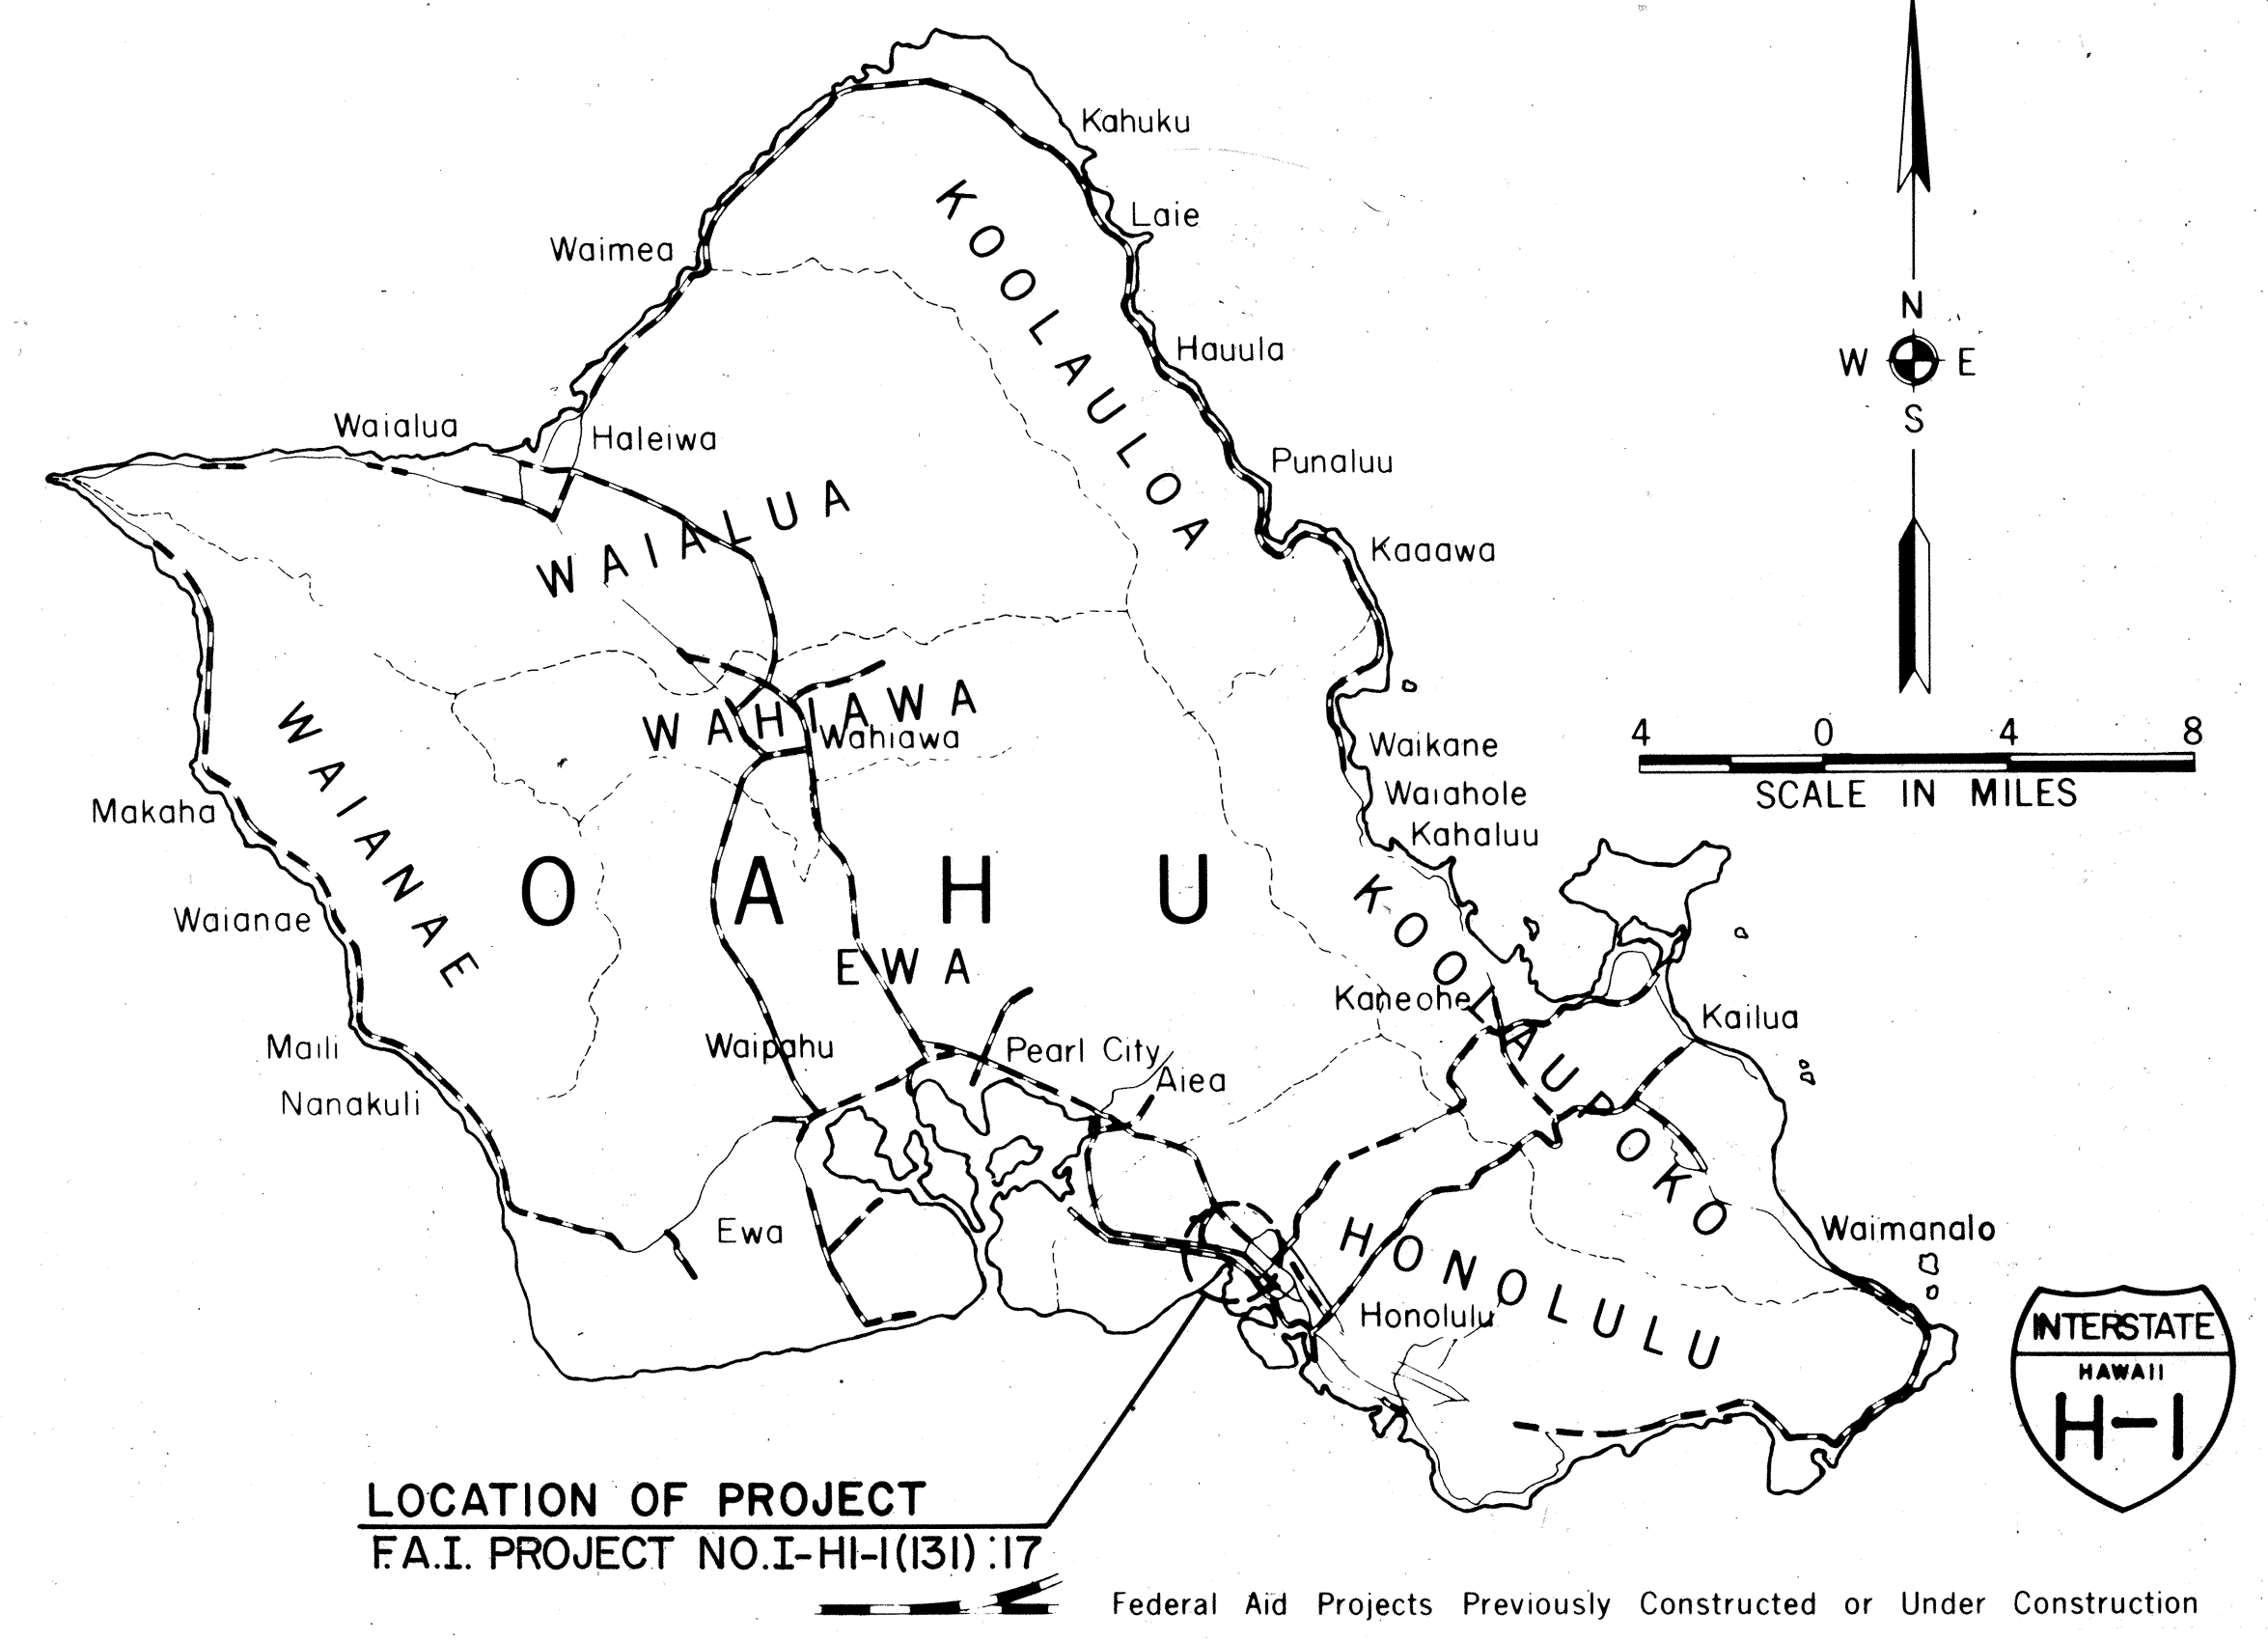

LOCATION OF PROJECT  
F.A.I. PROJECT NO. I-HI-I.(131):17

DESIGN CLASSIFICATION

DESIGN ADT (1994).....98,000  
DHV.....10,800  
D.....60/40  
T.....5%  
V.....60 MPH

CHANGES MADE DURING CONSTRUCTION HAVE BEEN INCORPORATED ON THESE PLANS EXCEPT CHANGES IN THE ORIGINAL THEORETICAL QUANTITIES. FOR ACTUAL QUANTITIES, REFER TO PROJECT LEDGER AND/OR COMPUTATION BOOK.

*Mula d. B. Lee* 12/23/88  
RESIDENT ENGINEER DATE

DEPARTMENT OF TRANSPORTATION  
FEDERAL HIGHWAY ADMINISTRATION  
APPROVED: *[Signature]* 9-29-77  
DIVISION ADMINISTRATOR DATE

DEPARTMENT OF TRANSPORTATION  
STATE OF HAWAII  
APPROVED: *R. Higashikawa* 9-28-77  
DIR. OF TRANSPORTATION DATE