


FED. ROAD DIST. NO.	STATE	FED. AID PROJ. NO.	FISCAL YEAR	SHEET NO.	TOTAL SHEETS
HAWAII	HAW.	I-HI-1(144):13	1977	2	52

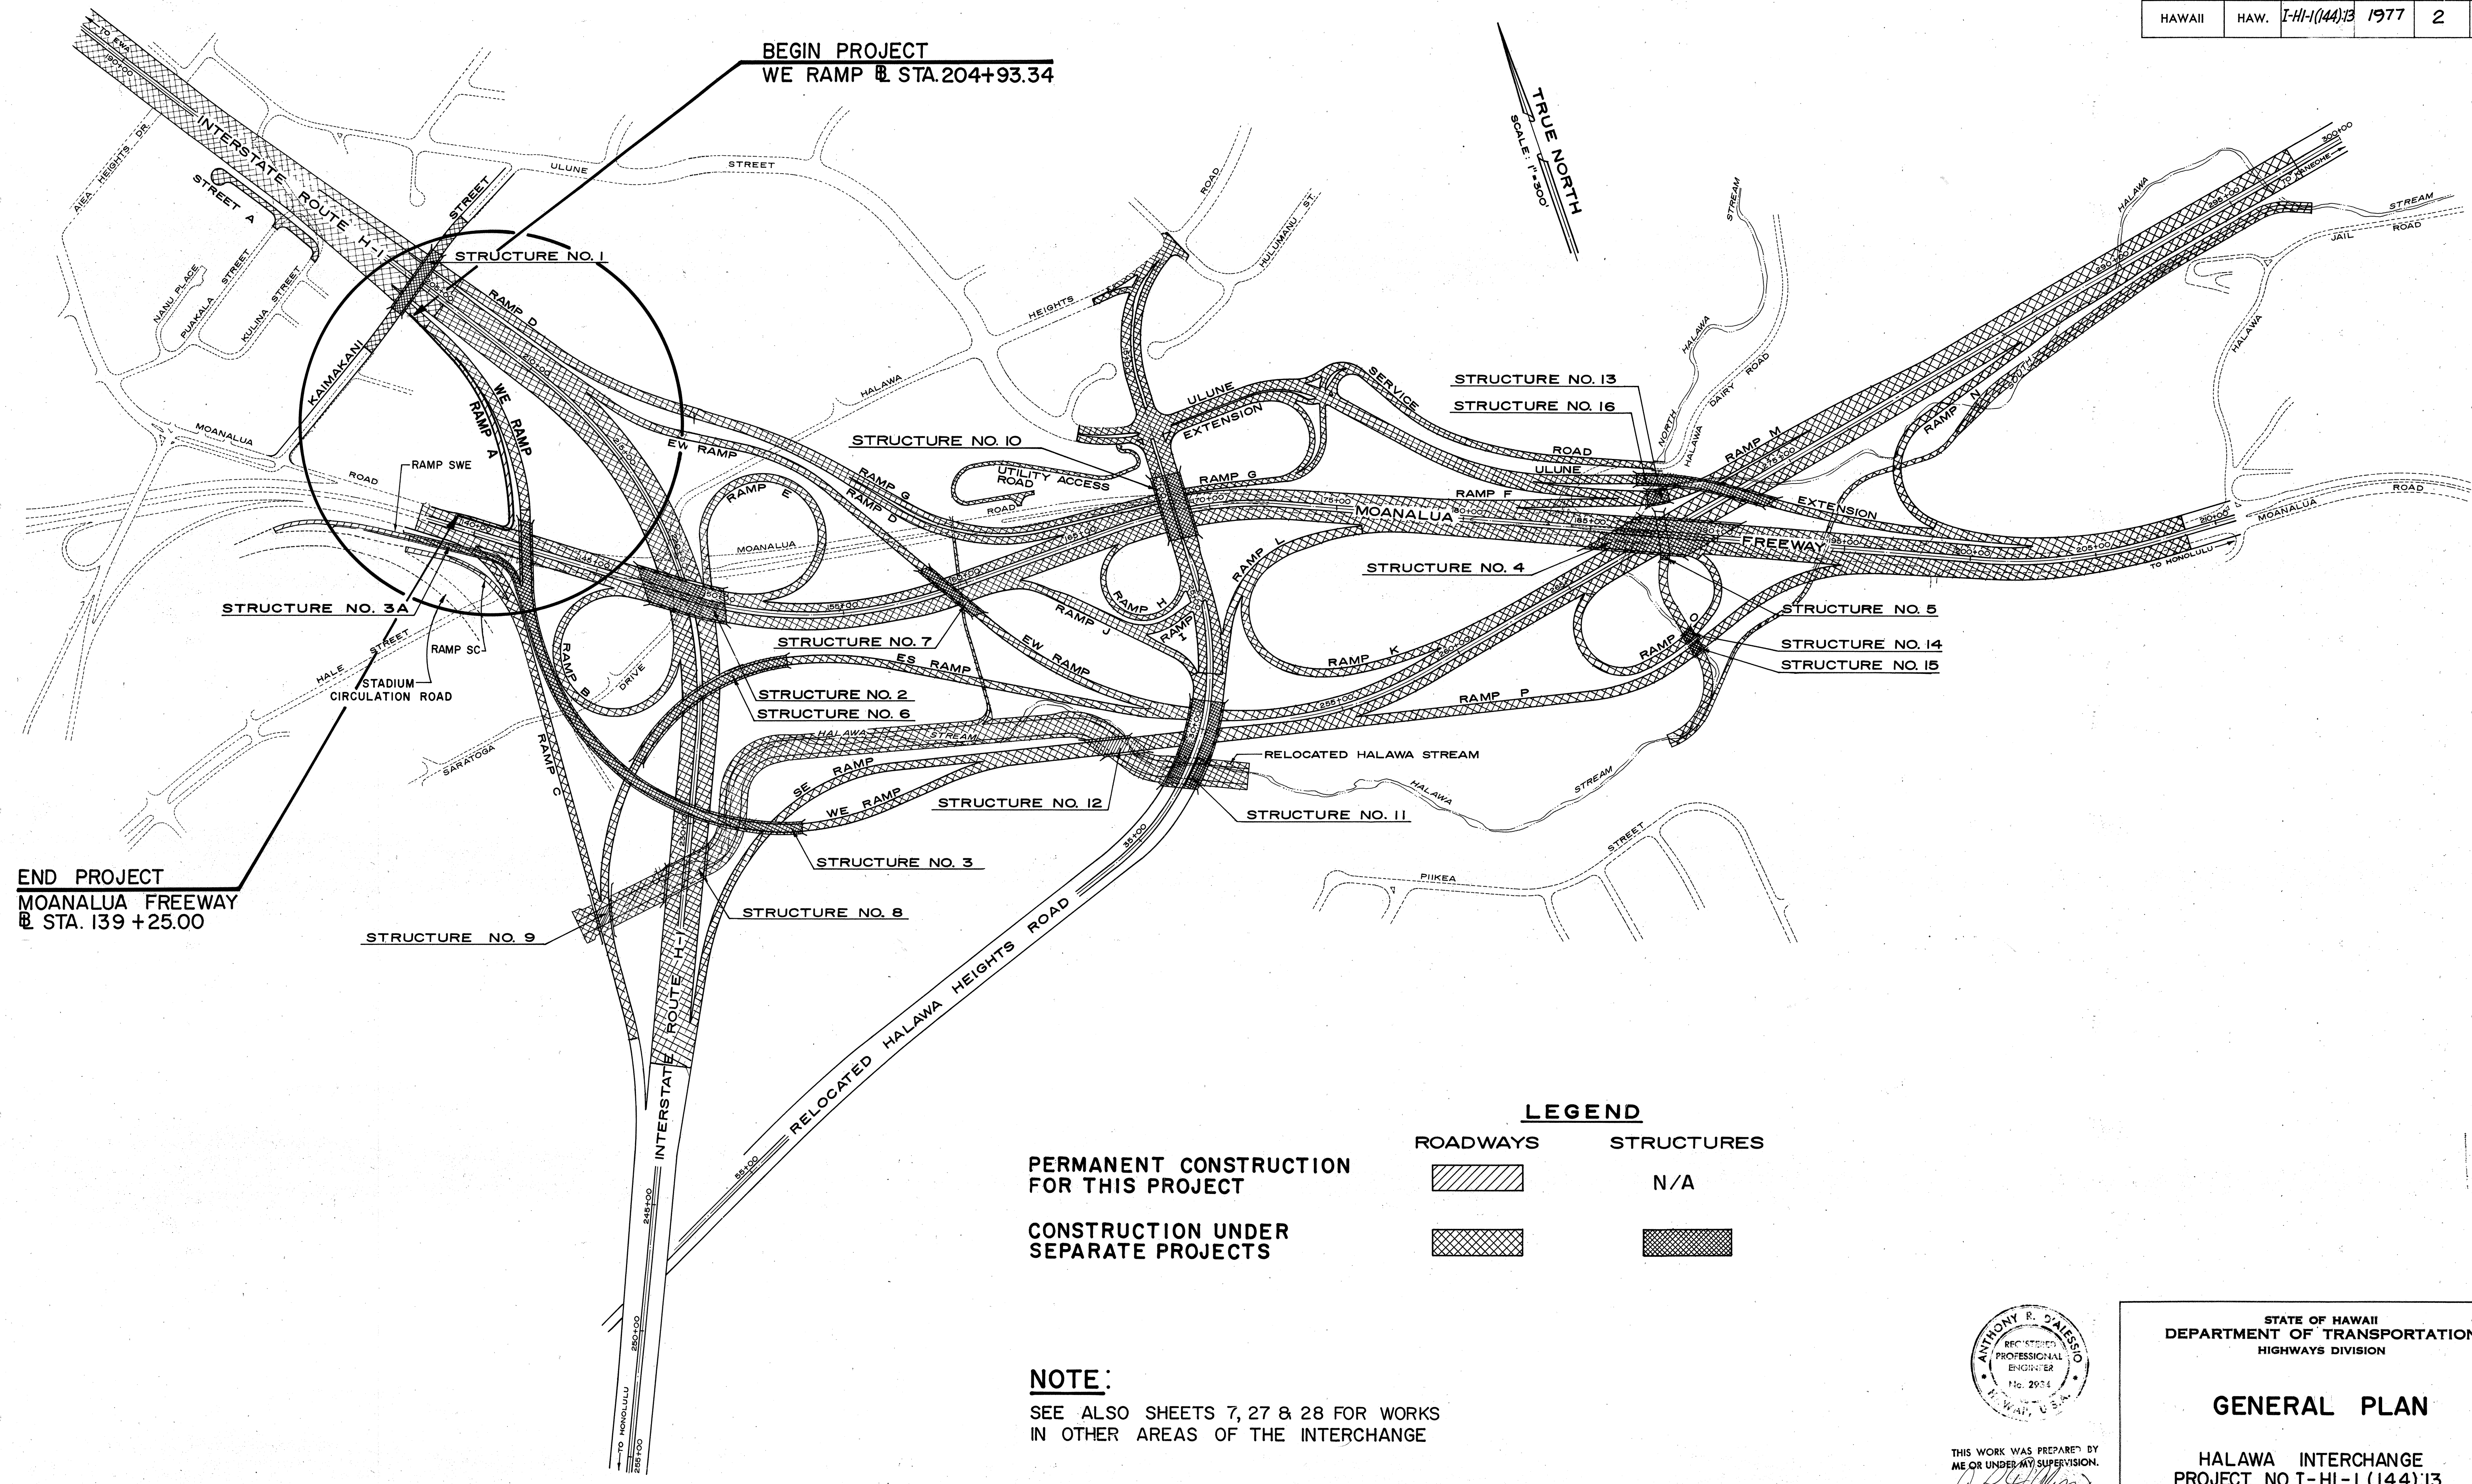


DATE	_____
DESIGNED BY	_____
CHECKED BY	_____
NO.	_____

PERMANENT CONSTRUCTION FOR THIS PROJECT

CONSTRUCTION UNDER SEPARATE PROJECTS

LEGEND	
ROADWAYS	STRUCTURES
	N/A

NOTE:
SEE ALSO SHEETS 7, 27 & 28 FOR WORKS IN OTHER AREAS OF THE INTERCHANGE

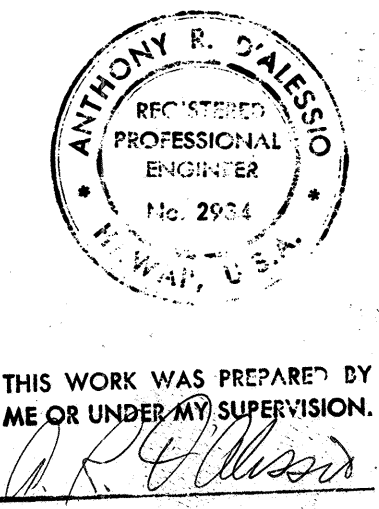

THIS WORK WAS PREPARED BY ME OR UNDER MY SUPERVISION.

STATE OF HAWAII
DEPARTMENT OF TRANSPORTATION
HIGHWAYS DIVISION

GENERAL PLAN

HALAWA INTERCHANGE
PROJECT NO. I-HI-1 (144):13

SCALE: AS SHOWN DATE: JULY, 1977
SHEET No. 1 OF 1 SHEETS