


FED. ROAD DIST. NO.	STATE	FED. AID PROJ. NO.	FISCAL YEAR	SHEET NO.	TOTAL SHEETS
HAWAII	HAW.	I-HI-1(144):13	1977	27	52

DESIGNED BY	DATE
DRAWN BY	
CHECKED BY	
NOTED BY	
ORIGINAL PLAN	
NOTE BOOK	
No.	

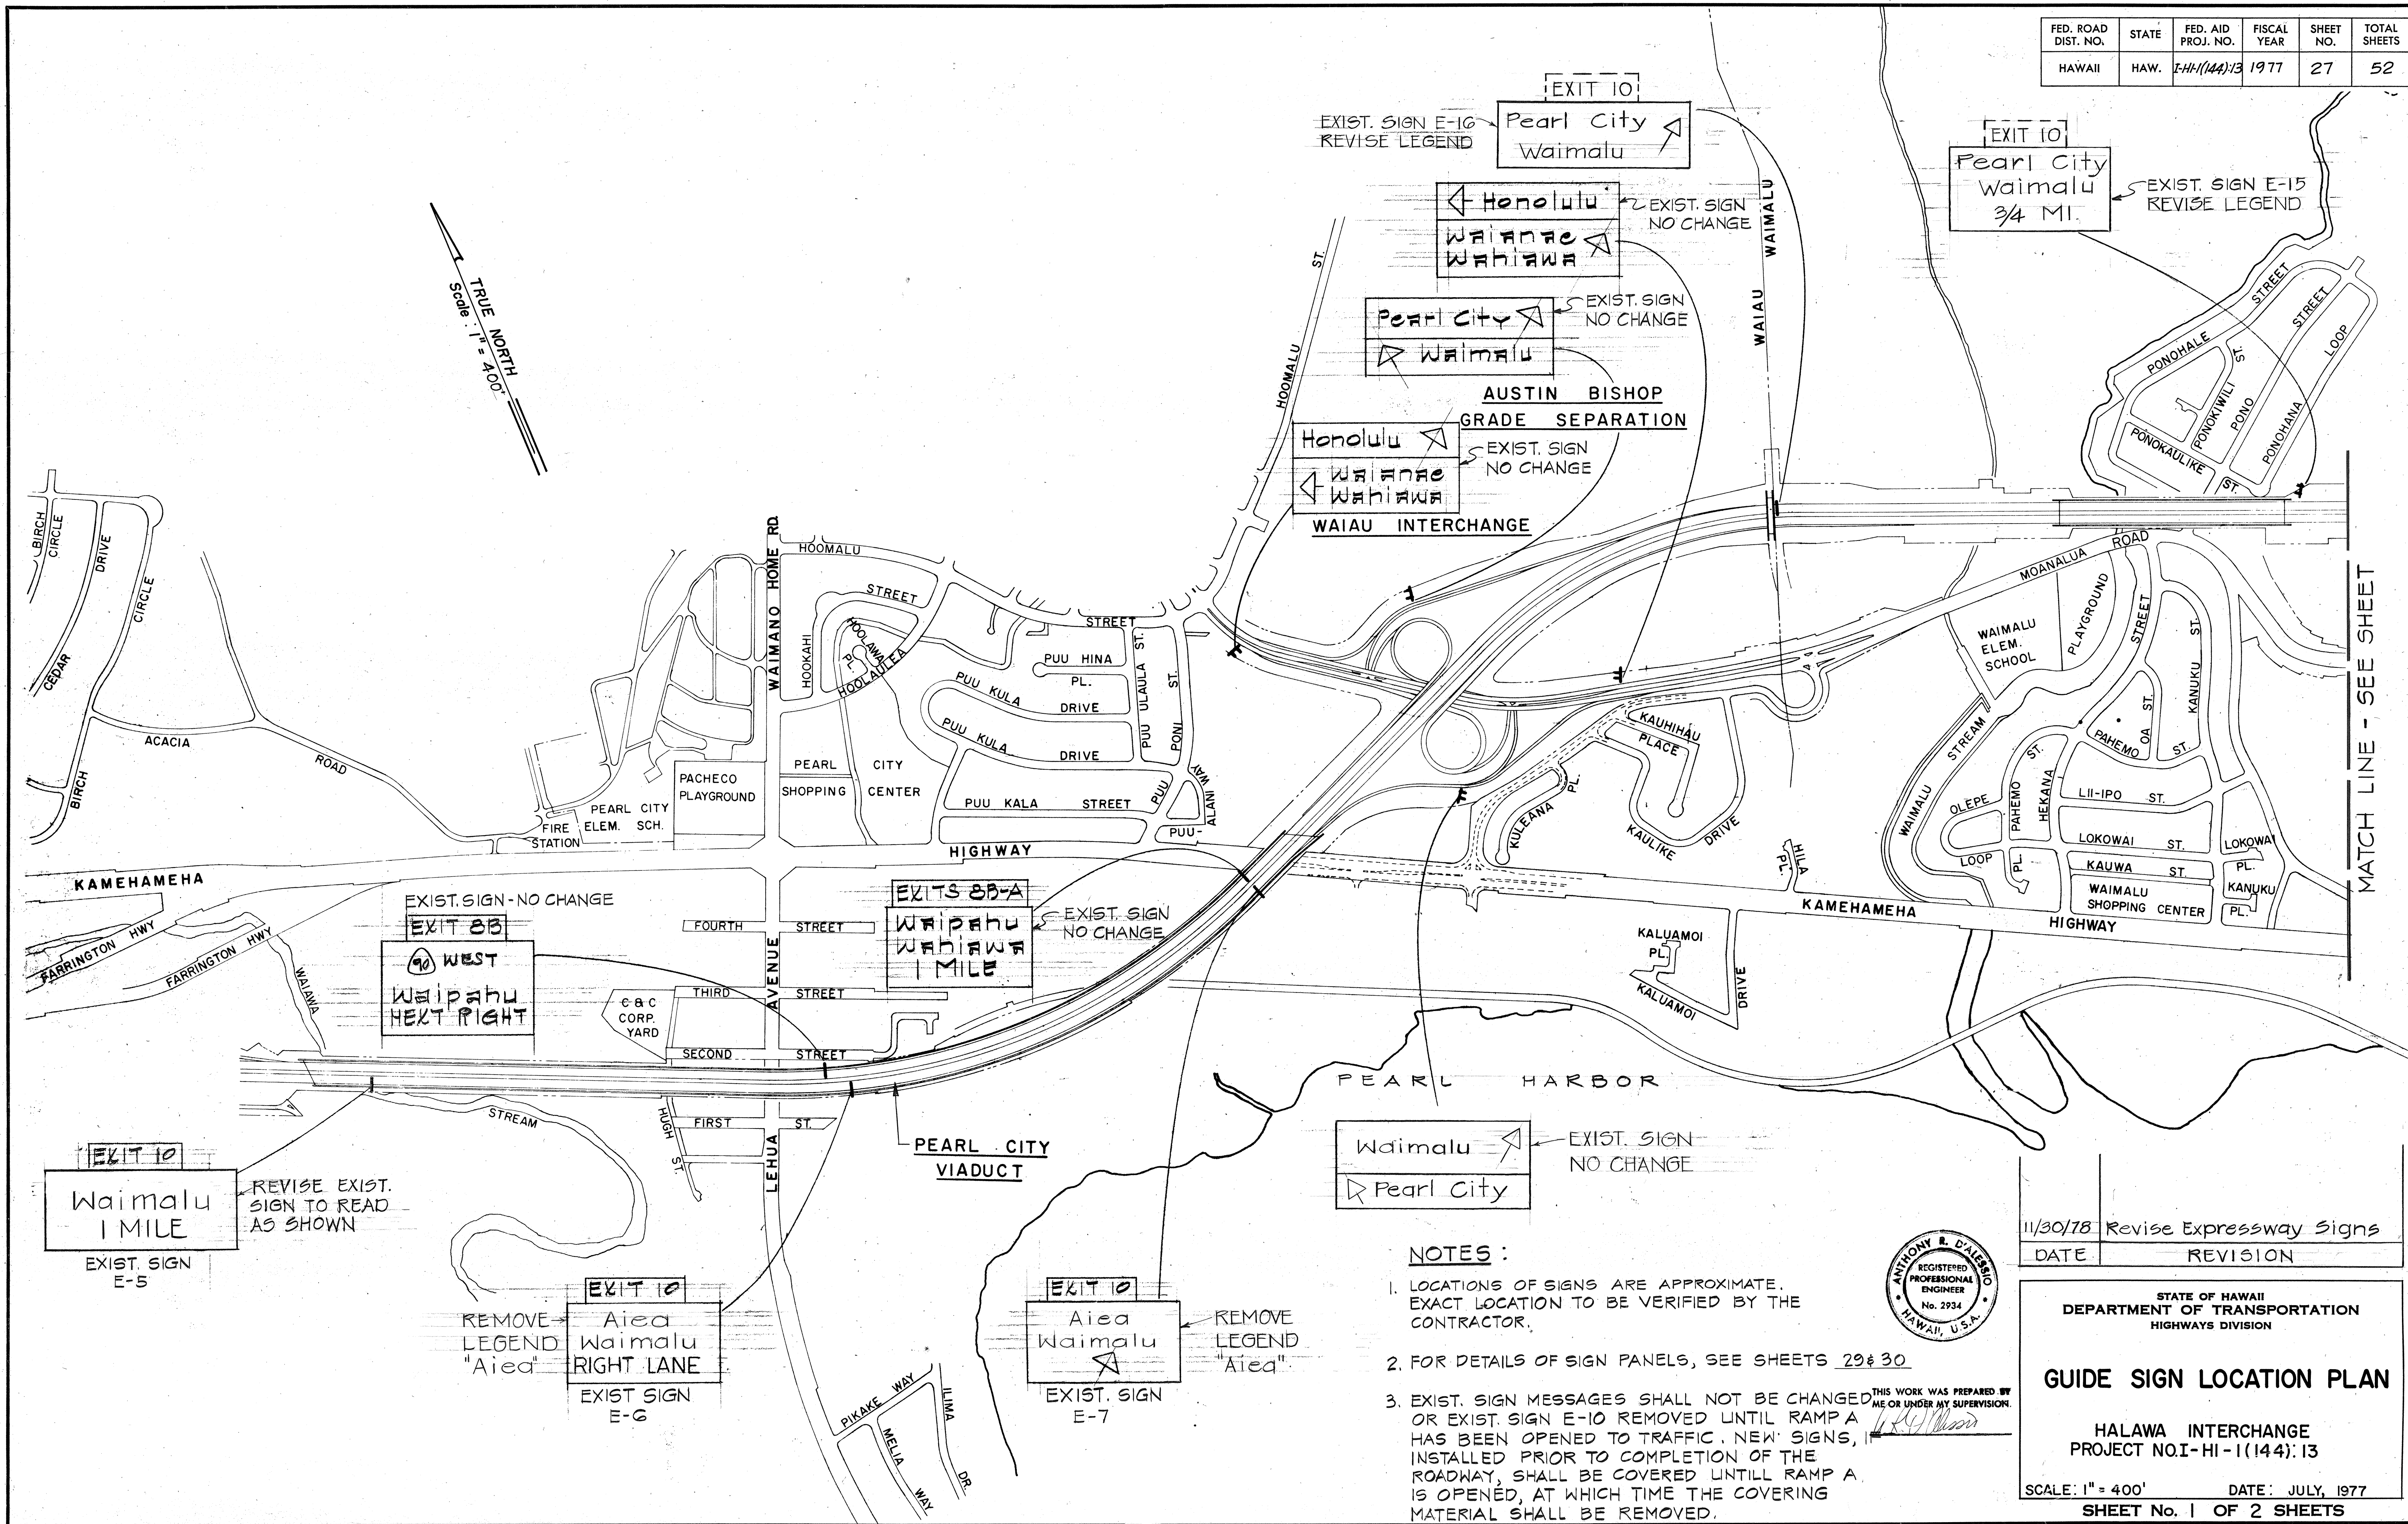

NOTES:

- LOCATIONS OF SIGNS ARE APPROXIMATE. EXACT LOCATION TO BE VERIFIED BY THE CONTRACTOR.
- FOR DETAILS OF SIGN PANELS, SEE SHEETS 29 & 30.
- EXIST. SIGN MESSAGES SHALL NOT BE CHANGED OR EXIST. SIGN E-10 REMOVED UNTIL RAMP A HAS BEEN OPENED TO TRAFFIC. NEW SIGNS, INSTALLED PRIOR TO COMPLETION OF THE ROADWAY, SHALL BE COVERED UNTILL RAMP A IS OPENED, AT WHICH TIME THE COVERING MATERIAL SHALL BE REMOVED.



11/30/78	Revise Expressway Signs
DATE	REVISION


STATE OF HAWAII
DEPARTMENT OF TRANSPORTATION
HIGHWAYS DIVISION

GUIDE SIGN LOCATION PLAN

HALAWA INTERCHANGE
PROJECT NO. I-HI-1(144):13

SCALE: 1" = 400' DATE: JULY, 1977
SHEET No. 1 OF 2 SHEETS

FED. ROAD DIST. NO.	STATE	FED. AID PROJ. NO.	FISCAL YEAR	SHEET NO.	TOTAL SHEETS
HAWAII	HAW.	HH-1(144)-13	1977	28	52

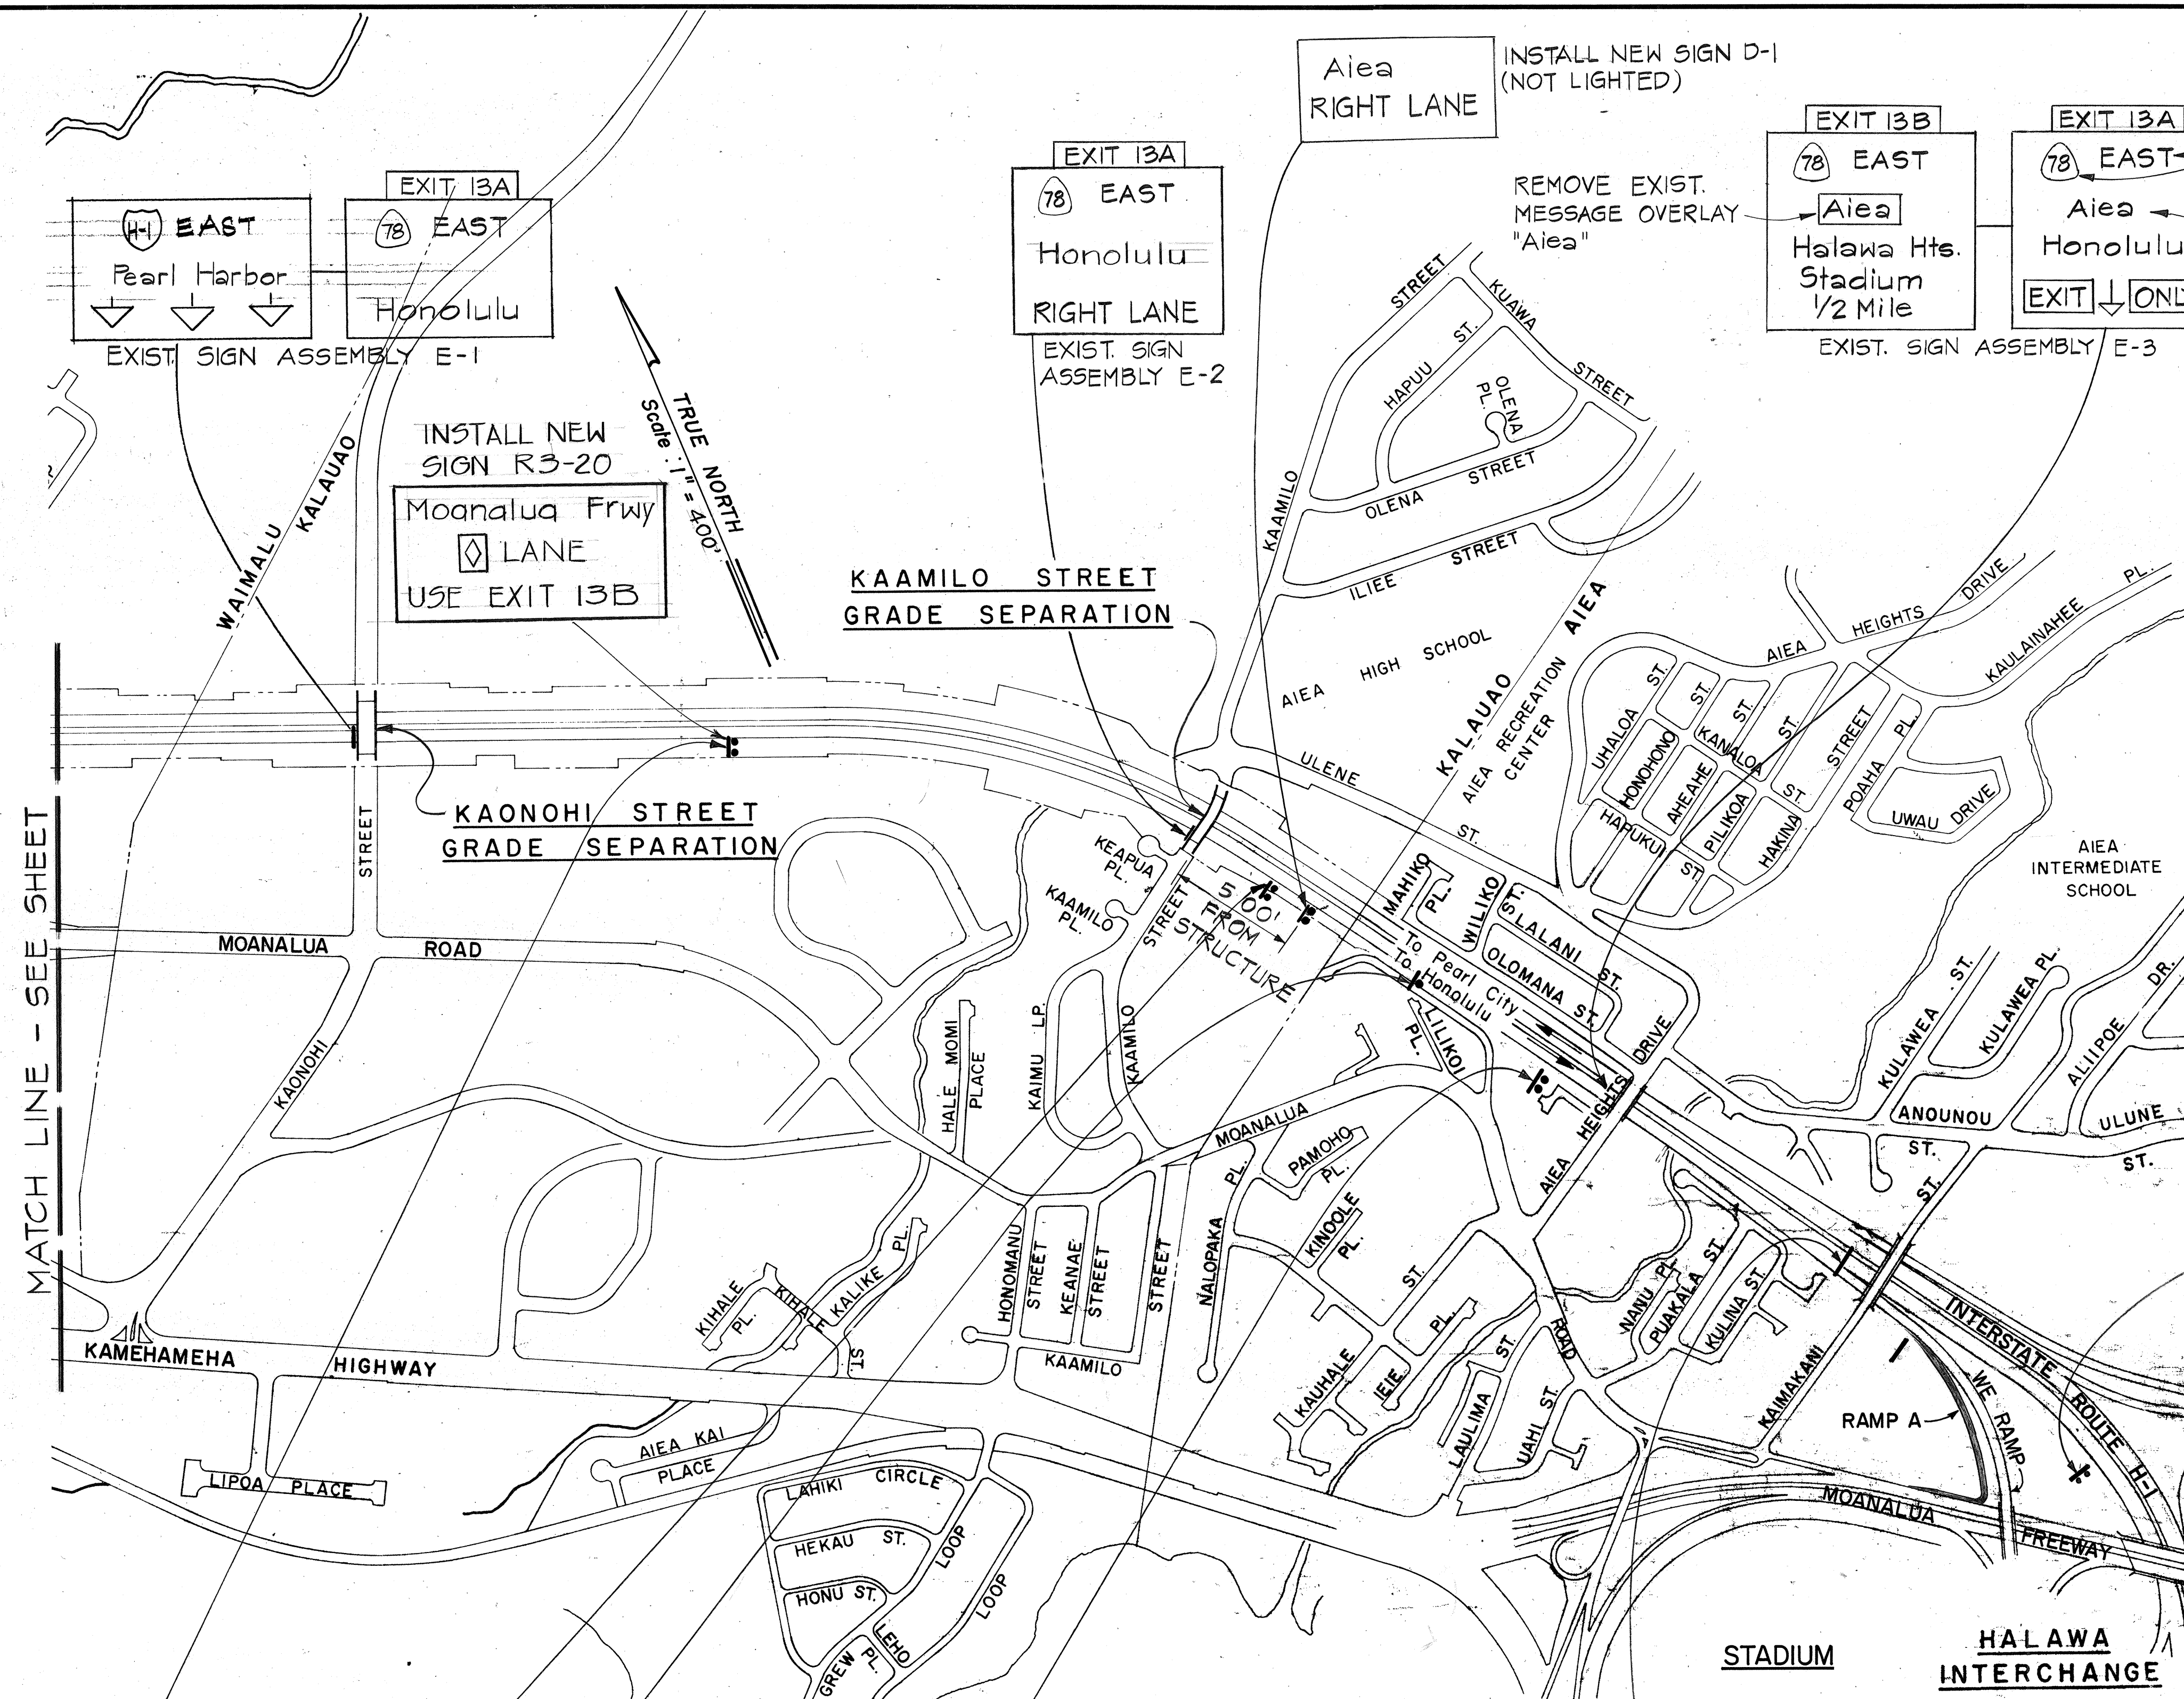

NOTE :

SIGNS AND SIGN OVERLAY PANELS DESIGNATED TO BE REMOVED SHALL BECOME THE PROPERTY OF THE CONTRACTOR AND SHALL BE DISPOSED OF AT HIS EXPENSE. REMOVAL AND DISPOSAL OF SIGNS AND PANELS SHALL BE CONSIDERED INCIDENTAL TO THE OTHER SIGN ITEMS AND WILL NOT BE MEASURED SEPARATELY FOR PAYMENT.


Aiea

REMOVE EXIST. SIGN E-10

EXIST. SIGN E-10

SEE SHEET 30 FOR NOTES

11/30/78	Revise Expressway Signs Add Sign R3-20
DATE	REVISION

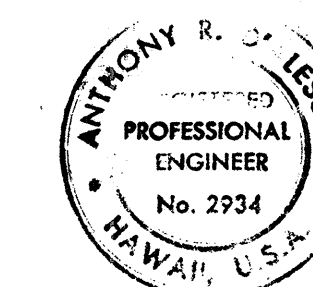

THIS WORK WAS PREPARED FOR ME OR UNDER MY SUPERVISION

[Signature]

STATE OF HAWAII
DEPARTMENT OF TRANSPORTATION
HIGHWAYS DIVISION

GUIDE SIGN LOCATION PLAN

HALAWA INTERCHANGE
PROJECT NO. I-HI-1 (144):13

SCALE: 1" = 400' DATE: JULY, 1977
SHEET No. 2 OF 2 SHEETS

C.O. 28

ORIGINAL PLAN	SURVEY PLOTTED BY.....	DATE.....
	DRAWN BY.....	".....
	TRACED BY.....	".....
NOTE BOOK	DESIGNED BY.....	".....
	QUANTITIES BY.....	".....
	CHECKED BY.....	".....
No.....		