

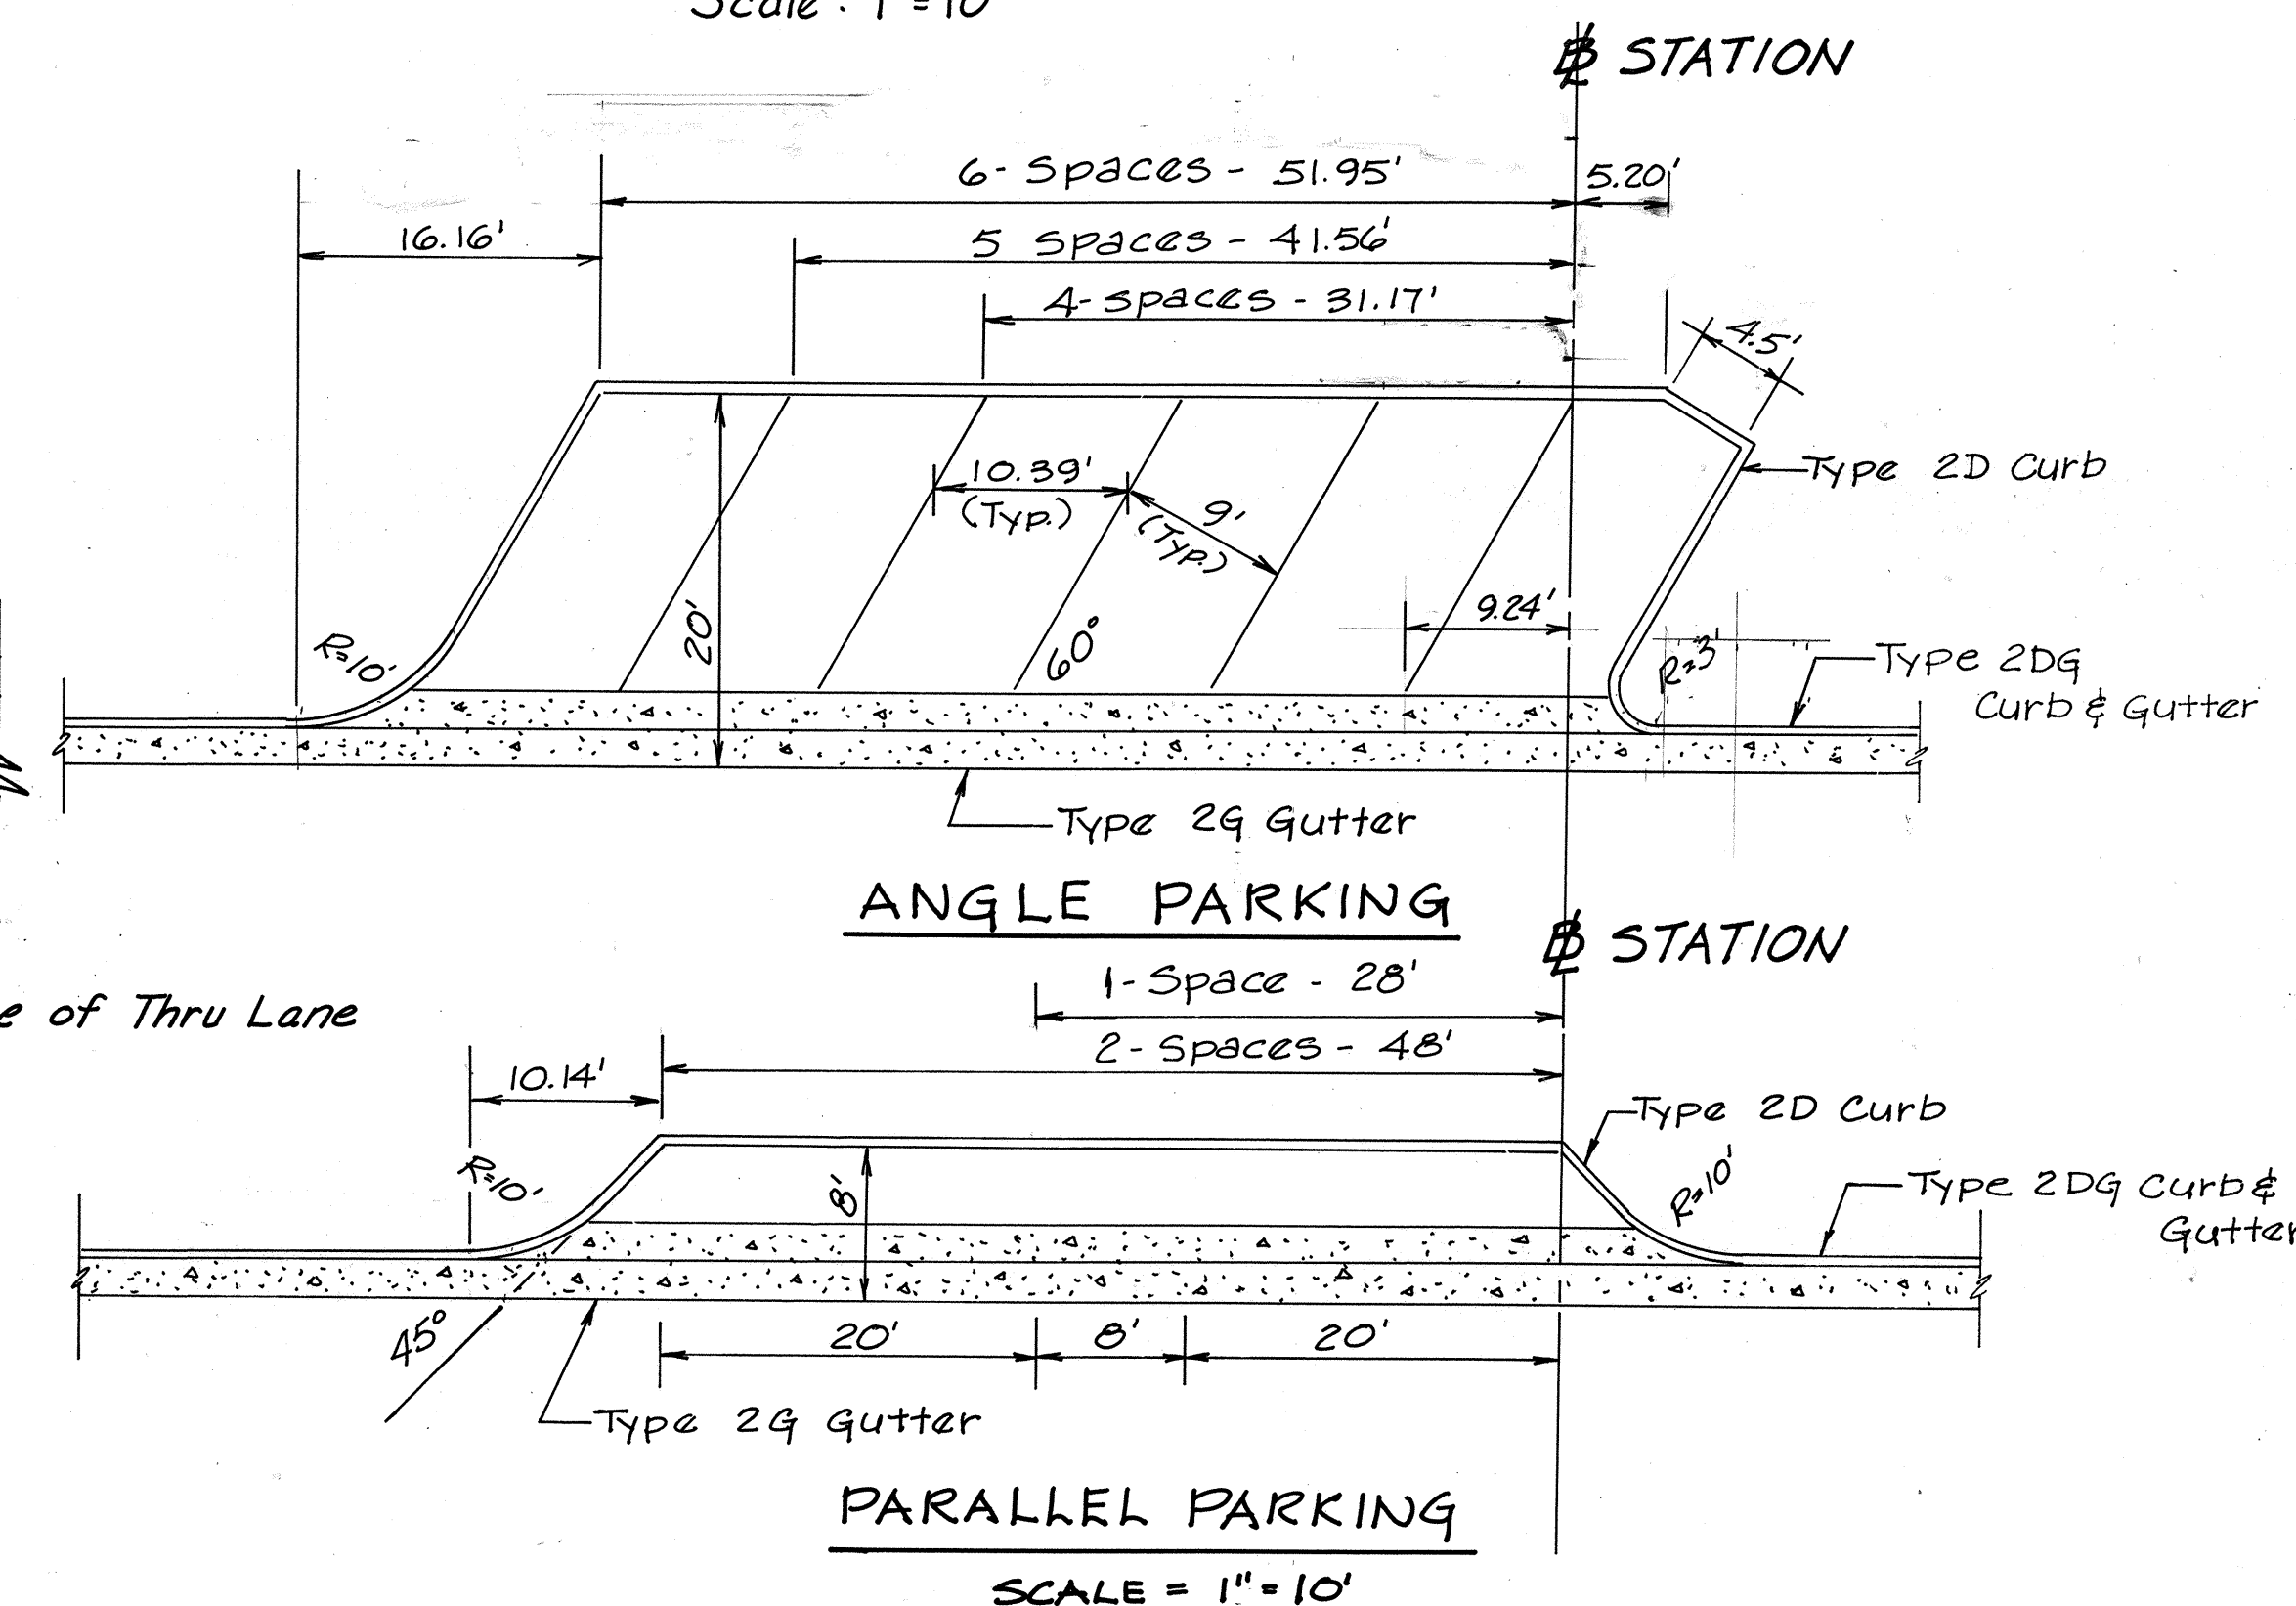
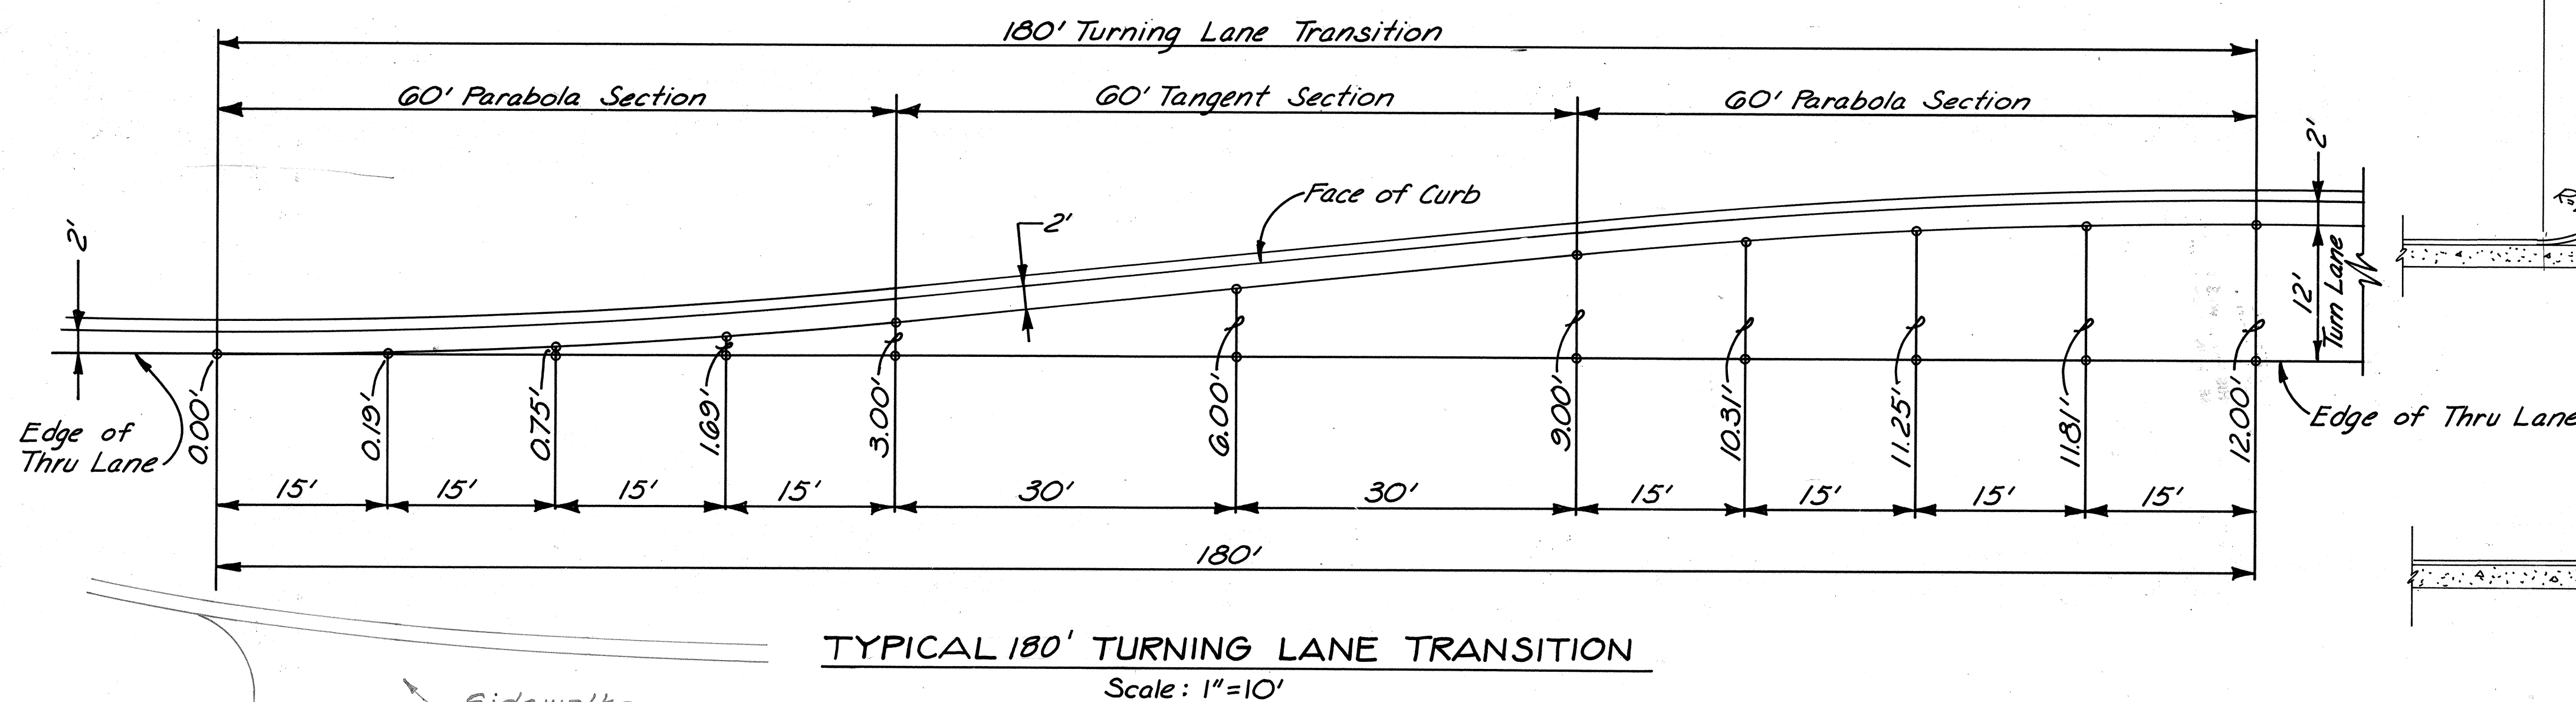
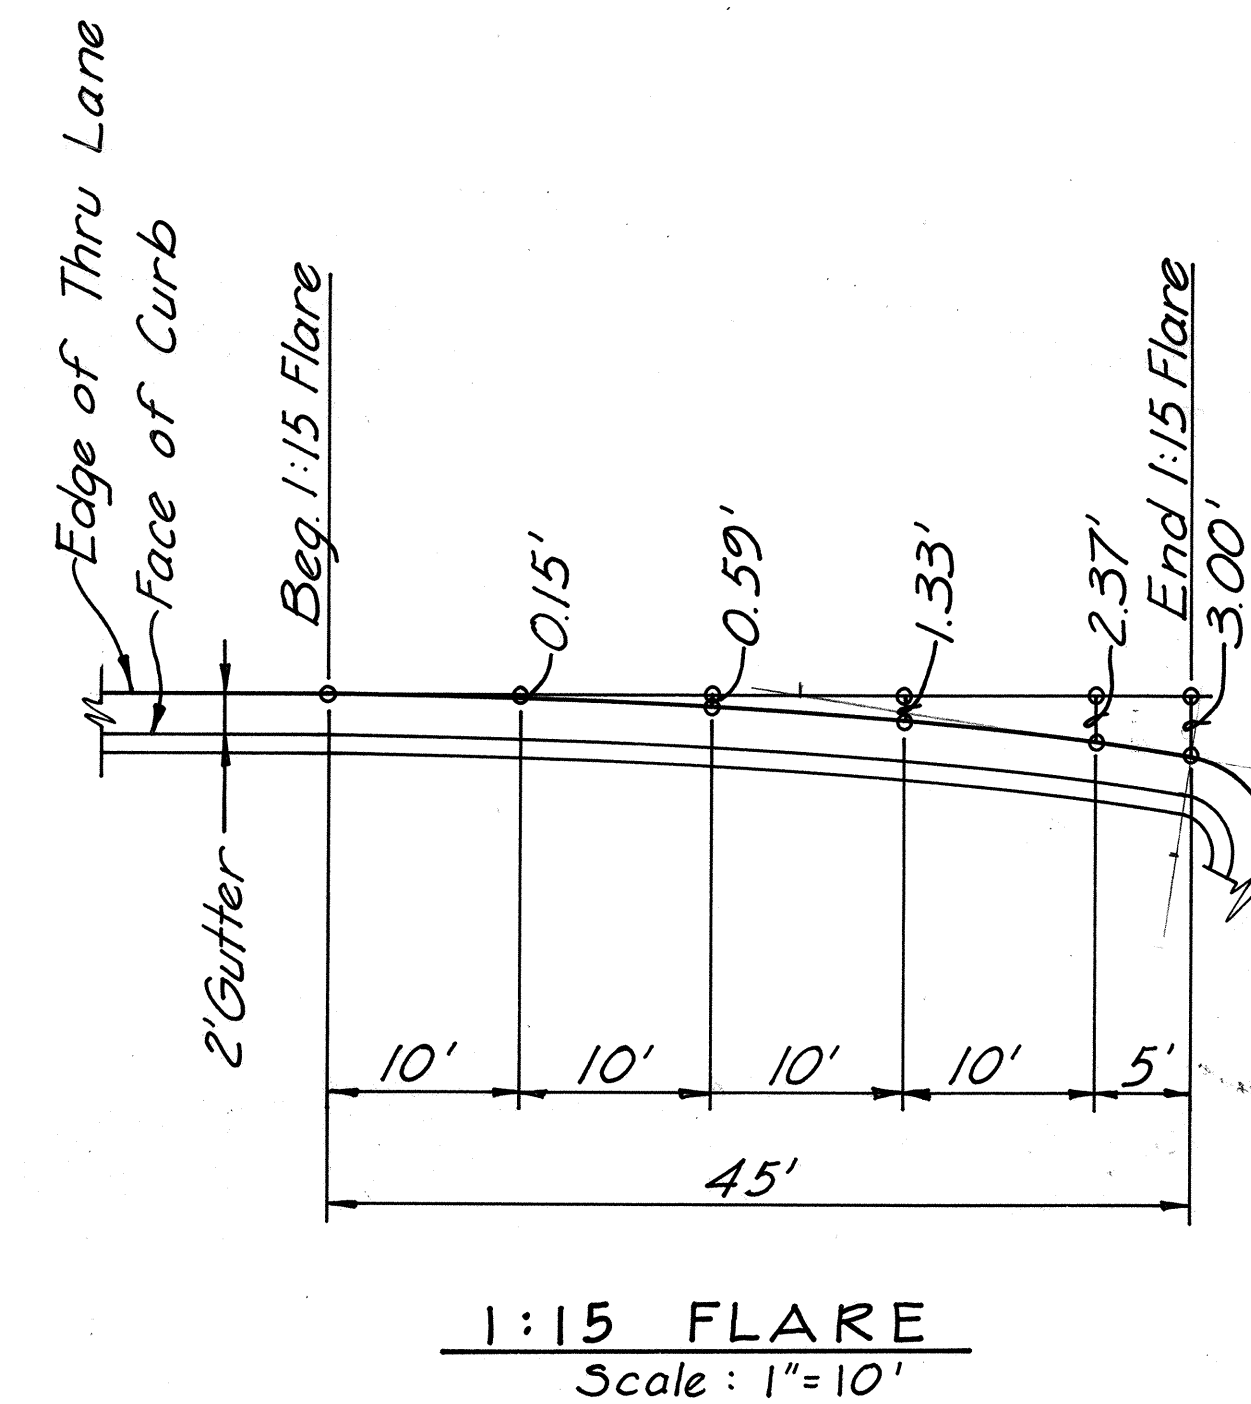


FED. ROAD DIST. NO.	STATE	FED. AID PROJ. NO.	FISCAL YEAR	SHEET NO.	TOTAL SHEETS
HAWAII	HAW.	I-HI-1(34)-16	1978	19	466

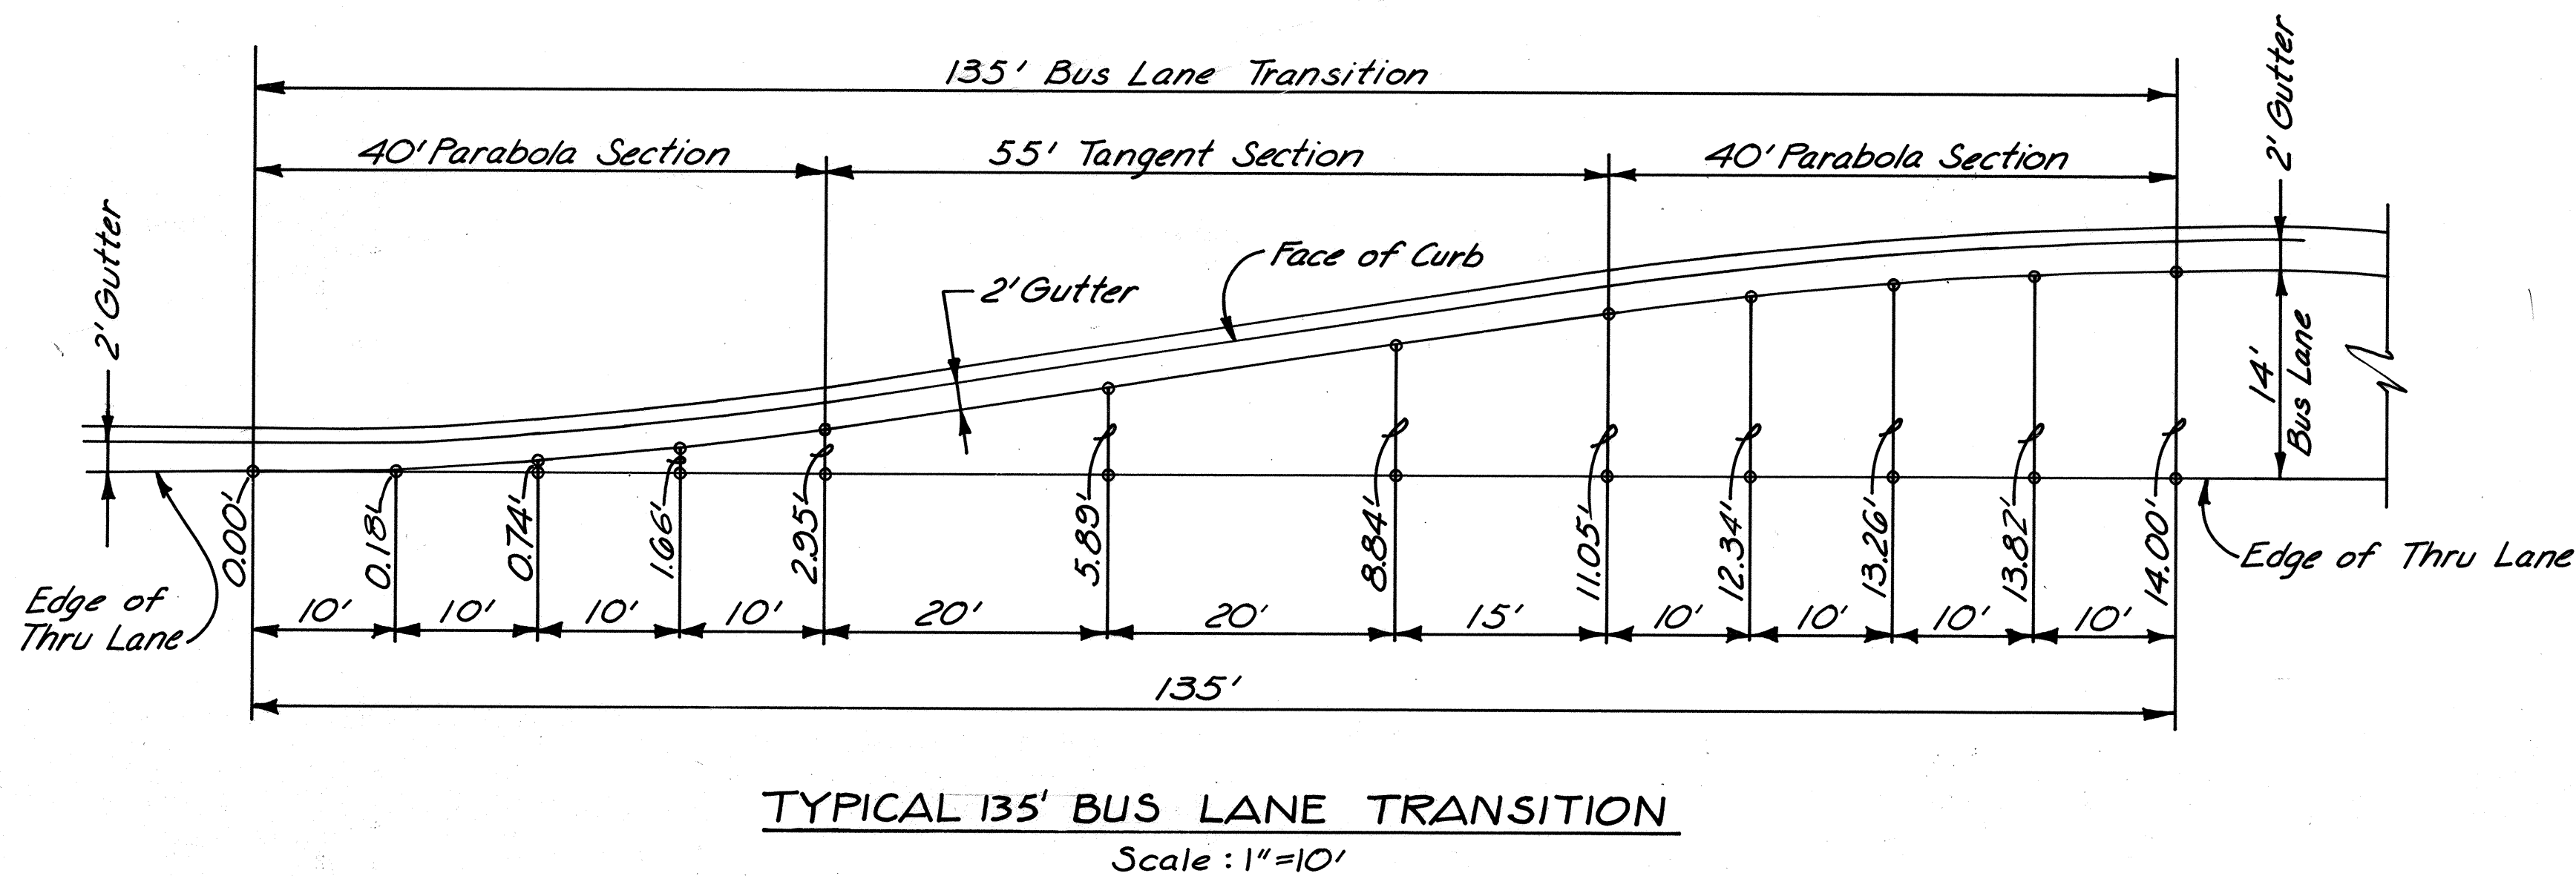


ORIGINAL PLAN	SURVEY PLOTTED BY	DATE
NOTE BOOK	DRAWN BY	
	TRACED BY	
	CHECKED BY	
	QUANTITIES BY	
	CHECKED BY	

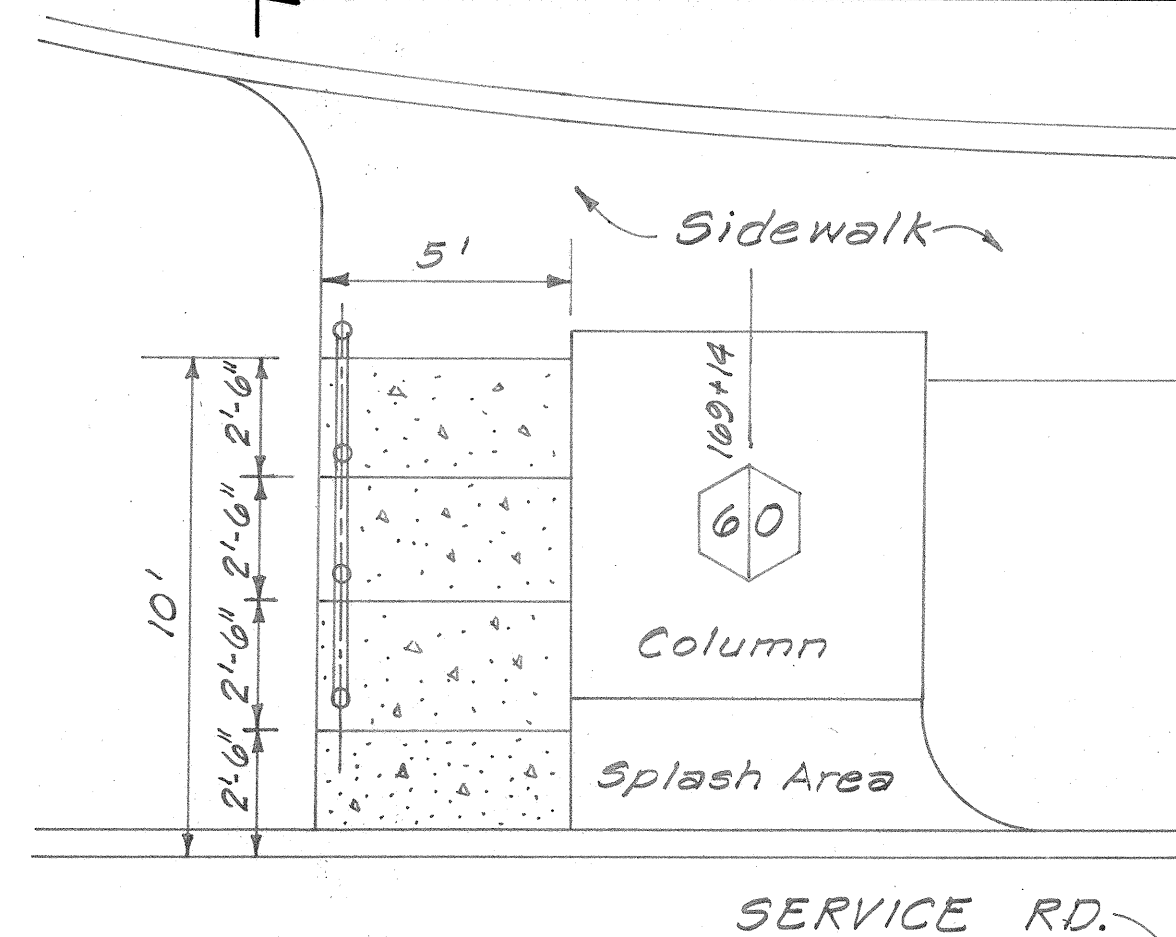

STAIRWAY W/ HANDRAIL AT H-1 BASELINE
STA. 162 + 05±, 2/5 100' RT. (C.C.O.#101)

NO.	DATE	REVISION
2	8-14-80	Added Parking Details.
1	4-6-79	Deleted Gutter at Turning Lane Transition

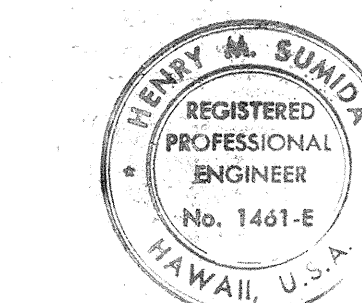

THIS WORK WAS PREPARED BY ME OR UNDER MY SUPERVISION.
Henry M. Sumida

STATE OF HAWAII
DEPARTMENT OF TRANSPORTATION
HIGHWAYS DIVISION


LANE TRANSITIONS
PARKING STALLS
AIRPORT INTERCHANGE
F.A.I. PROJ. NO. I-HI-1(34)-16
SCALE: AS SHOWN
DATE: SEP 30, 1977
SHEET No. 1 OF 2 SHEETS

FED. ROAD DIST. NO.	STATE	FED. AID PROJ. NO.	FISCAL YEAR	SHEET NO.	TOTAL SHEETS
HAWAII	HAW.	I-HI-1(84):16	1978	20	466

FENCE SCHEDULE			
Item No.	GOT.	GOT.	
	0040	0190	
	4' Chain Link Fence with Top Rail and with Concrete Footings	Relocate 8' Chain Link Fence with Wooden Pickets	
Location			
H-1 @ Station to Station	Lin.Ft.	Lin.Ft.	
162+00 (191' Lt.) to 167+03.17 (191' Lt.)			503
167+03.17 (191' Lt.) to 171+77 (167.75' Lt.)			474
172+57.1 (163.83' Lt.) to 173+22 (160.65' Lt.)			63
172+93± (120'± Lt.) to 173+38 (104' Lt.)	45		
174+30 (155.32' Lt.) to 181+09.64 (122' Lt.)			680
181+09.64 (122' Lt.) to 198+07.43 (122' Lt.)			1698
194+80 (83' Lt.) to 195+20 (83' Lt.)	40		
198+07.43 (122' Lt.) to 199+39.17 (126.84' Lt.)			132
199+39.17 (126.84' Lt.) to 199+39.17 (117.11' Lt.)			10
199+39.17 (117.11' Lt.) to 199+58± (117.11' Lt.)			19
TOTAL	85	3579	

DRIVEWAY SCHEDULE		
Item No.		G.I.O.
		0600
LOCATION		Sq. Yd.
164+63 H-1 @ -131.3' Rt.		17
168+94 H-1 @ -132.6' Rt.		20
169+46.5 H-1 @ -132.6' Rt.		13
189+07 H-1 @ -132.6' Rt.		14
12+06 Ohohia St. B - 21.5' Rt.		28
12+16 Ohohia St. B - 21' Lt.		37
* 19+60 Ohohia St. B		8
Total		139

* Reconstruction due to new Box Culvert (See Sht. D-10)

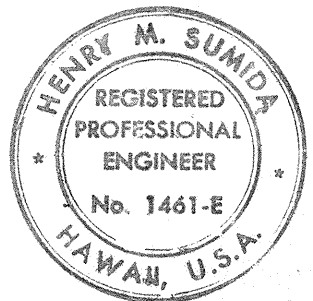

STATE OF HAWAII
DEPARTMENT OF TRANSPORTATION
HIGHWAYS DIVISION

LANE TRANSITIONS MISC. SCHEDULE


AIRPORT INTERCHANGE
F.A.I. PROJ. NO. I-HI-1(84):16

SCALE: AS SHOWN DATE: JULY 19, 1978

SHEET No. 2 OF 2 SHEETS



THIS WORK WAS PREPARED BY
ME OR UNDER MY SUPERVISION
Henry M. Sumida

NO.	DATE	REVISION
1	4-6-79	Deleted Gutter

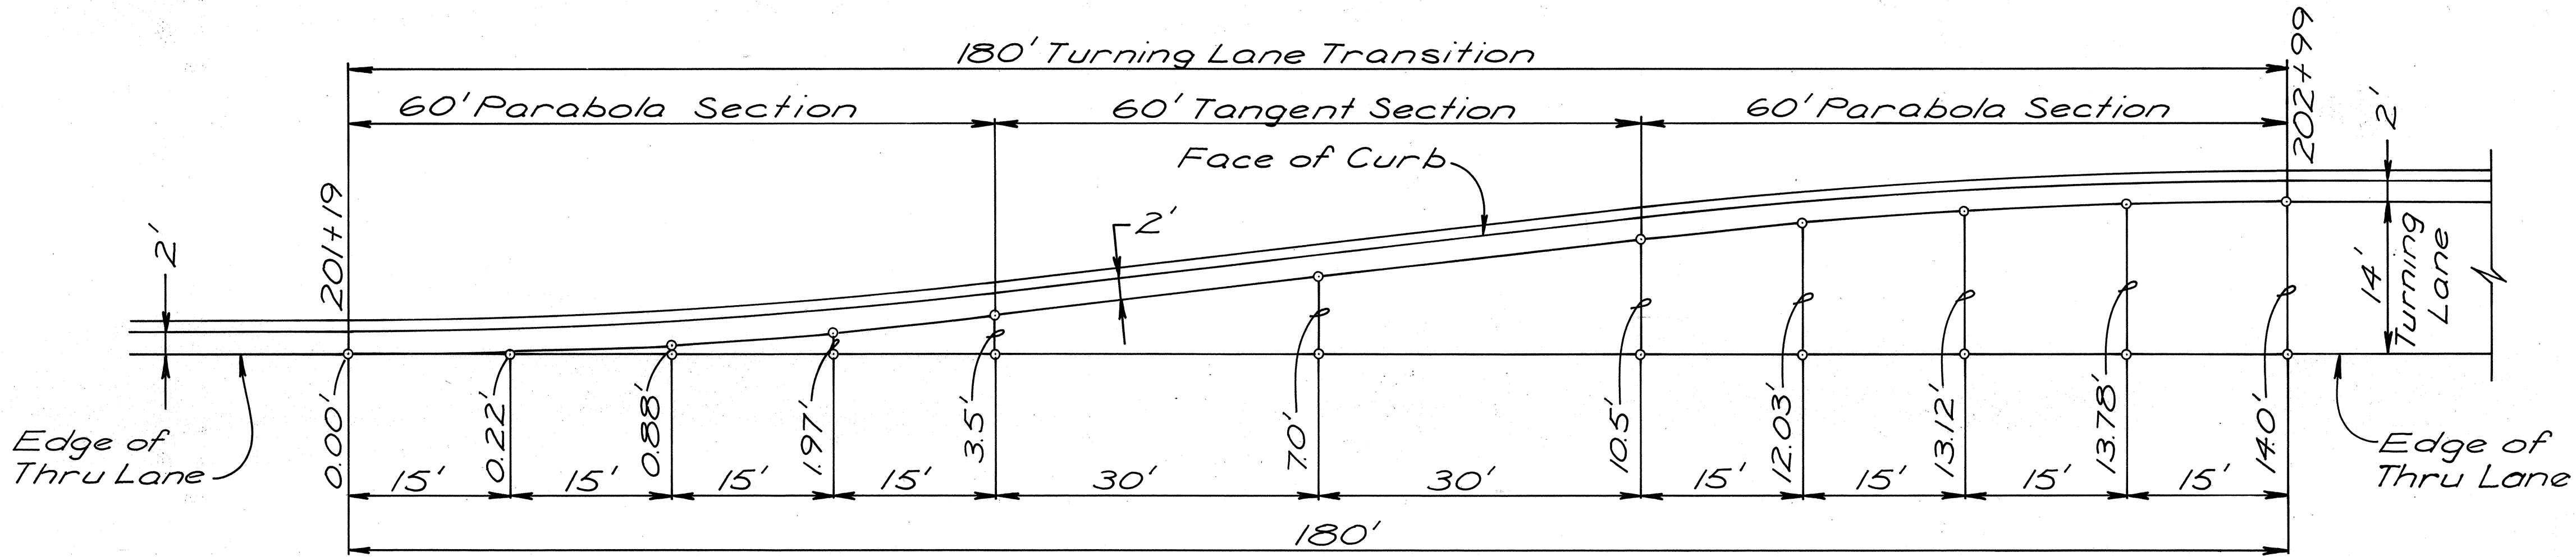

TURNING LANE TRANSITION

STA. 201+19 to 202+99
(LT. MAKAI FR. RD.)
Scale: 1" = 10'

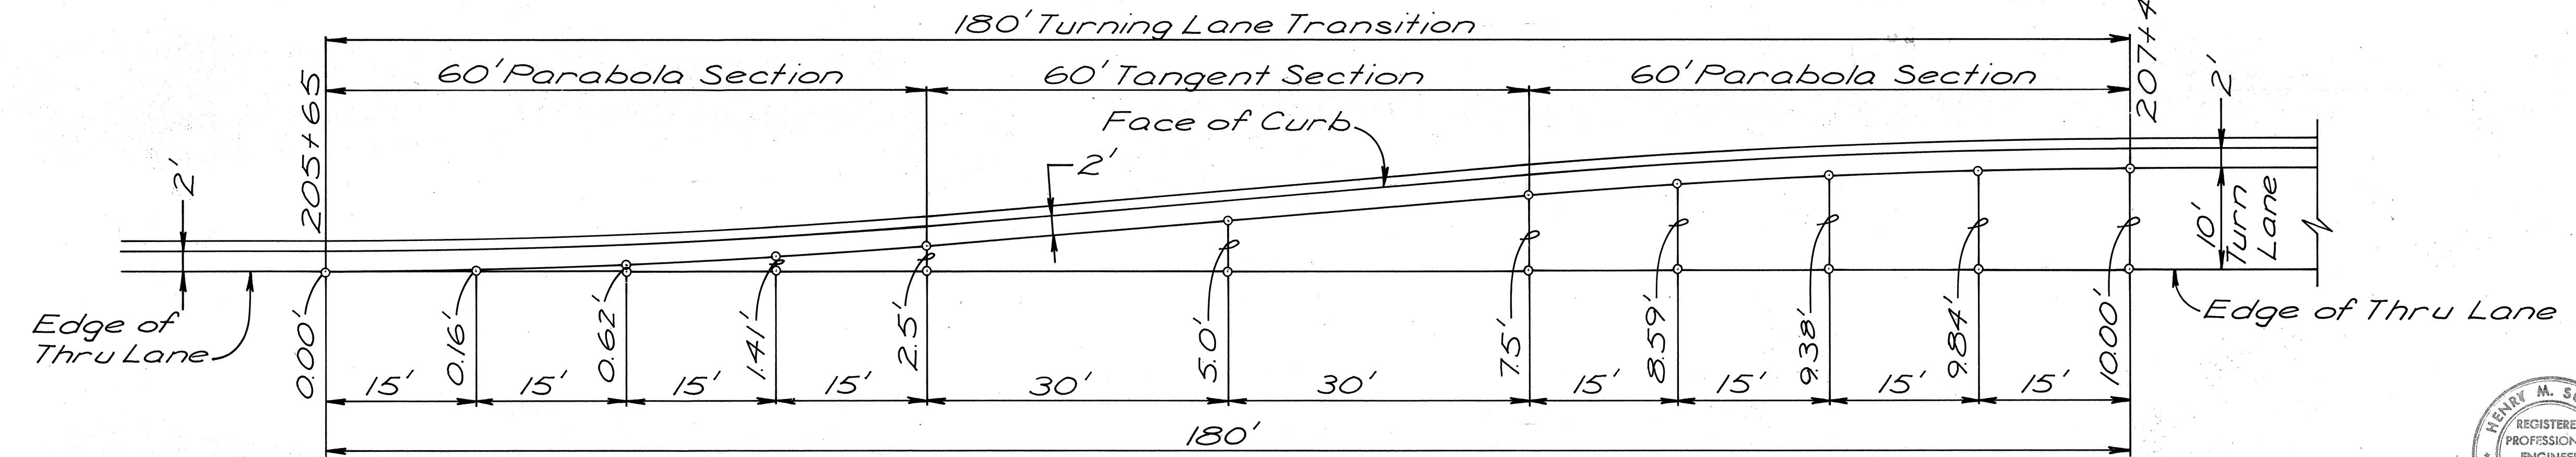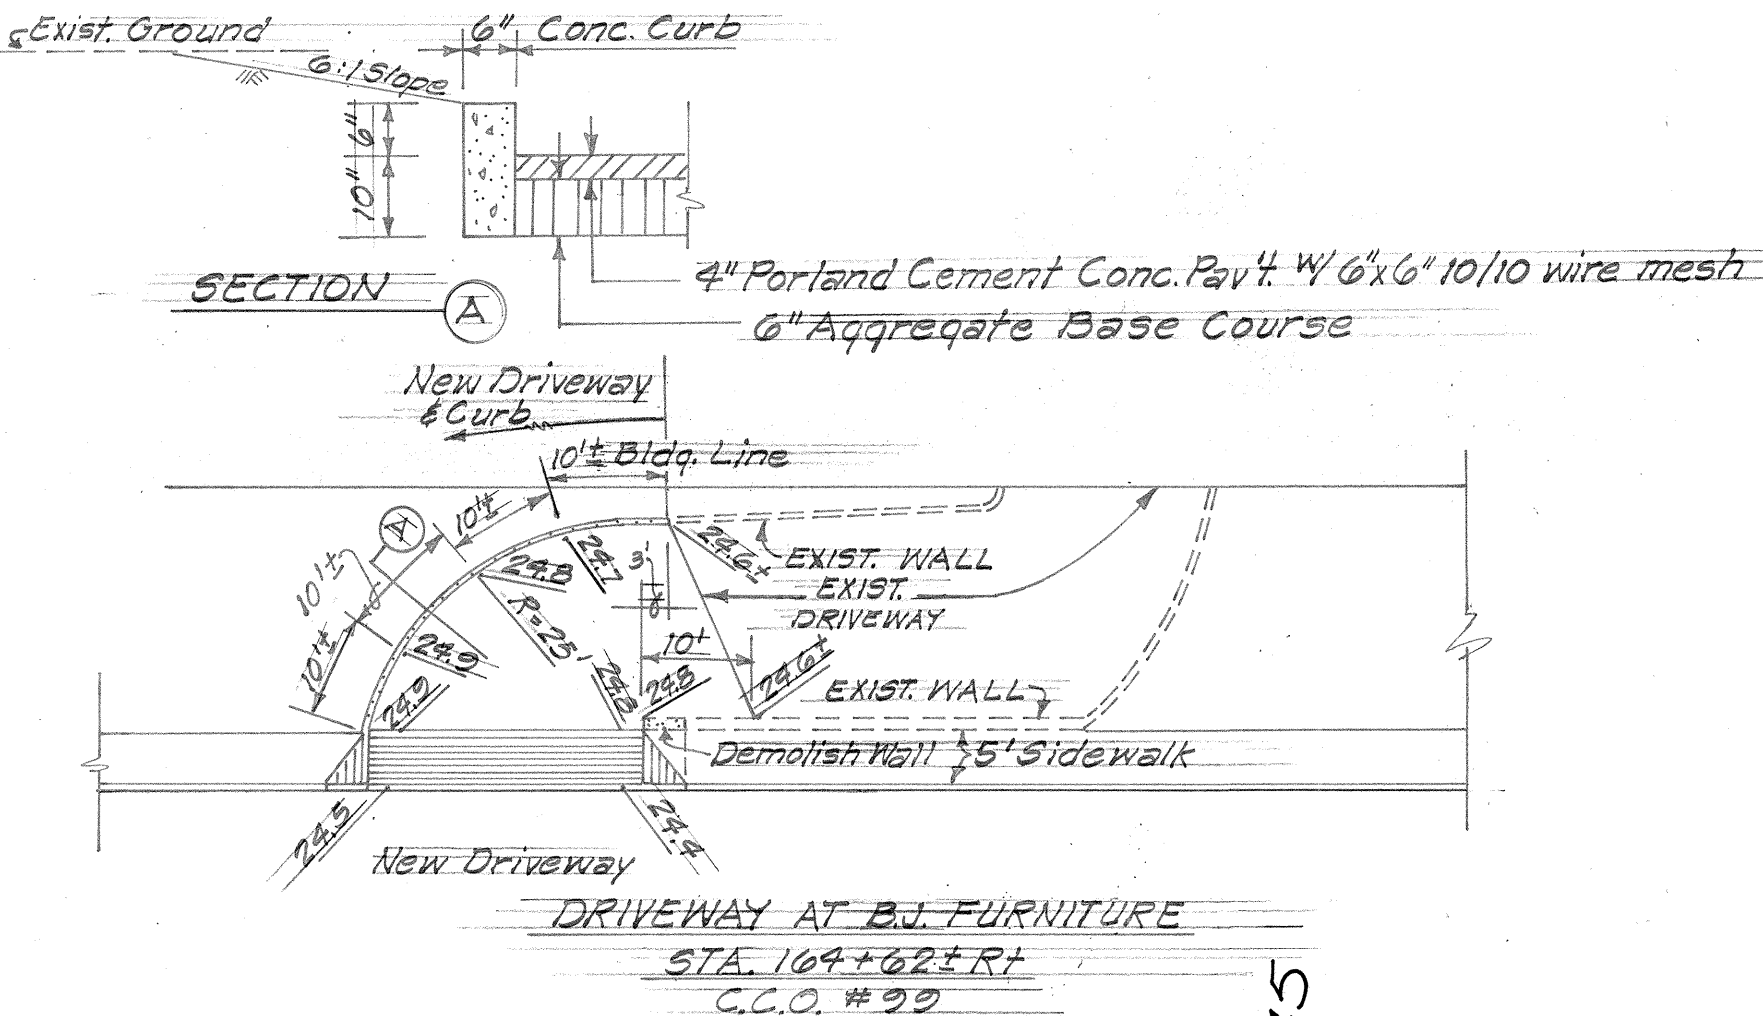

TURNING LANE TRANSITION

STA. 205+65 to 207+45
(LT. MAKAI FR. RD.)
Scale: 1" = 10'

PROFILE	DATE
SURVEYED	
PLOTTED	
CHECKED	
NOTE BOOK	
NO.	