

SIDEWALK SCHEDULE

STATION		DESCRIPTION	Item No.	
FROM	TO		608.0200	608.6000
161+05 H-1Q-Rt.	165+54.40 H-1Q-Rt.	5' Sidewalk Rt. Ser. Rd. "B"	4" Plain Conc. Sidewalk	Bed Course Material for Sidewalk
165+54.40 H-1Q-Rt.	68+72.33 Paiea St.-Rt.	5' Sidewalk Rt. Paiea St.	97	10.8
68+72.33 Paiea St.-Lt.	169+70 Ser. Rd. "C"-Rt.	5' Sidewalk Lt. Paiea St.	140	15.5
166+30 H-1Q-Rt.	166+67 H-1Q-Rt.	Sidewalk, Island	98	10.8
166+47 H-1Q	166+61.6 H-1Q	Sidewalk, Median	76	8.4
168+15 H-1Q-Lt.	169+35 H-1Q-Lt.	Bus Stop Platform Lt. Mauka F.R.	160	17.8
169+70 H-1Q-Rt.	171+87 H-1Q-Rt.	Bus Stop Platform Rt. Makai F.R.	247	27.2
171+04 H-1Q-Lt.	11+94.56 Salt Lake Blvd.-Lt.	5' Sidewalk Lt. Salt Lake Blvd.	89	9.9
11+93.75 Salt Lake Blvd.-Rt.	173+28 H-1Q-Lt	5' Sidewalk Rt. Salt Lake Blvd.	88	9.8
171+50 H-1Q-Lt.	171+97 H-1Q-Lt.	Sidewalk, Island	63	7.0
172+39 H-1Q-Lt.	172+81 H-1Q-Lt	Sidewalk, Island	56	6.2
171+69.75 H-1Q	171+83.68 H-1Q	Sidewalk, Median	32	3.6
180+90 H-1Q-Rt.	182+25 H-1Q-Rt.	Bus Stop Platform Rt. Makai F.R.	137	15.0
187+90 H-1Q-Rt.	190+57.80 H-1Q-Rt.	5' Sidewalk Rt. Makai F.R.	133	14.8
190+57.80 H-1Q-Rt.	12+35 Ohohia St.-Rt	Sidewalk Rt. Ohohia St.	60	6.7
12+35 Ohohia St.-Lt.	192+15 H-1Q-Rt.	Sidewalk Lt. Ohohia St.	63	7.0
189+77 H-1Q-Lt.	190+95 H-1Q-Lt.	Bus Stop Platform Lt. Mauka F.R.	171	19.0
190+81 H-1Q	190+95.2 H-1Q	Sidewalk, Median	73	8.1
190+84 H-1Q-Rt.	190+99 H-1Q-Rt.	Sidewalk, Island	60	6.6
192+70.25 H-1Q-Rt.	193+73.75 H-1Q-Rt.	Bus Stop Platform Rt. Makai F.R.	126	14.0
196+26 H-1Q-Lt.	197+60 H-1Q-Lt.	Bus Stop Platform Lt. Mauka F.R.	194	21.6
199+25 H-1Q-Lt.	11+92.84 Peltier Ave.-Lt.	5' Sidewalk Lt. Peltier Ave.	89	9.9
11+92.59 Peltier Ave.-Rt.	201+47 H-1Q-Lt.	5' Sidewalk Rt. Peltier Ave.	92	10.2
199+90 H-1Q-Lt.	200+17 H-1Q-Lt.	Sidewalk, Island	65	7.2
200+60 H-1Q-Lt.	200+85 H-1Q-Lt.	Sidewalk, Island	42	4.7
199+90.75 H-1Q	200+03.8 H-1Q	Sidewalk, Median	40	4.4
200+00 H-1Q-Rt.		5' Sidewalk Rt. Makai F.R.	12	1.3
201+79 H-1Q-Rt.	202+10 H-1Q-Rt.	Bus Stop Platform Rt. Makai F.R.	135	14.9
Total			2927	324.5

CURB & GUTTER SCHEDULE

STATION		LOCATION	Item No.				
FROM	TO		609.2010	609.2720	609.2725	609.2020	609.2140
161+05 H-1Q-Lt.	11+94.56 Salt Lake Blvd.-Lt.	Lt. Mauka F.R. to Lt. Salt Lake Blvd.	Curb Type 2A	Curb & Gutter Type 2DG	Curb & Gutter Type 2DGM	Curb Type 2D	Gutter Type 2g
161+05 H-1Q	166+64.22 H-1Q	Rt. Mauka F.R. & Lt. Makai F.R.	1188				
161+05 H-1Q-Rt.	166+67.20 H-1Q-Rt.	Rt. Makai F.R. & Lt. Serv. Rd. "B"		1041	126		
161+05 H-1Q-Rt.	68+72.33 Paiea St.-Rt.	Rt. Serv. Rd. "B" to Rt. Paiea St.		118	21	493	
67+45 Paiea St.-Lt.	167+84 H-1Q-Rt.	Paiea St. Island		67	75		
68+72.33 Paiea St.-Lt.	169+70 H-1Q-Rt.	Lt. Paiea St. to Rt. Serv. Rd. "C"		157	157		
167+26.22 H-1Q	171+84.48 H-1Q	Rt. Mauka F.R. & Lt. Makai F.R.	982				
168+01.91 H-1Q-Rt.	172+94.42 H-1Q-Rt.	Rt. Makai F.R. & Lt. Serv. Rd. "C"		680	322		
171+13 H-1Q-Lt.	171+90 H-1Q-Lt.	Salt Lake Blvd. Island			140	75	
172+41 H-1Q-Lt.	172+97 H-1Q-Lt.	Salt Lake Blvd. Island			139	88	
11+93.75 Salt Lake Blvd.-Rt.	12+12 Peltier Ave.-Lt.	Rt. Salt Lake Blvd. to Lt. Mauka F.R. to Lt. Peltier Ave.		2899			
172+48.54 H-1Q	190+96.03 H-1Q	Rt. Mauka F.R. & Lt. Makai F.R.	3796				
172+93.78 H-1Q-Rt.	188+39.01 H-1Q-Rt.	Rt. Makai F.R. & Lt. Serv. Rd. "C"		2494	136	635	524
188+39.98 H-1Q-Rt.	190+94 H-1Q-Rt.	Rt. Makai F.R. & Lt. Serv. Rd. "C"		259	314		
187+90 H-1Q-Rt.	12+35 Ohohia St.-Rt.	Rt. Serv. Rd. "C" to Rt. Ohohia St.		317	78		
191+57 H-1Q-Rt.	192+12 H-1Q-Rt.	Ohohia St. Island		92	36		
11+45 Ohohia St.-Lt.	192+15 H-1Q-Rt.	Lt. Ohohia St.		40	78		
192+36.08 H-1Q-Rt.	197+57.74 H-1Q-Rt.	Rt. Makai F.R. & Lt. Serv. Rd. "D"		862	50	252	156
191+60.03 H-1Q	200+04.08 H-1Q	Lt. Makai F.R. & Rt. Mauka F.R.	1746				
197+62.31 Ser. Rd. "D"-Lt.	200+43.09 Ser. Rd. "D"-Lt.	Lt. Serv. Rd. "D" & Rt. Makai F.R.		412		168	104
199+35 H-1Q-Lt.	200+15 H-1Q-Lt.	Peltier Ave. Island			145	90	
200+62 H-1Q-Lt.	201+13 H-1Q-Lt.	Peltier Ave. Island			133	83	
11+97 Peltier Ave.-Rt.	206+00 H-1Q-Lt.	Rt. Peltier Ave. to Lt. Mauka F.R.		598			
200+68.6 H-1Q	206+00 H-1Q	Rt. Mauka F.R. & Lt. Makai F.R.	991				
200+72 Makai F.R.-Rt.	203+35 Makai F.R.-Rt.	Rt. Makai F.R.		263			
200+68.98 Makai F.R.-Rt.	204+52 Serv. Rd. "D"-Lt.	Lt. Serv. Rd. "D"		163		249	211
19+55 Ohohia St.-Rt.	19+57 Ohohia St.-Rt.			9			
Total			8703	11613	1890	2133	995


Note: Fence and Driveway Schedules on Sheet 20.

DATE: _____
DRAWN BY: _____
DESIGNED BY: _____
QUANTITIES BY: _____
CHECKED BY: _____
ORIGINAL PLAN: _____
NOTE BOOK: _____
No. _____

CUSHION BARRIER SCHEDULE

STATION		DESCRIPTION	Item No.	
FROM	TO		650.1000	650.2000
165+45	168+40	H-1Q Sta. of Makai Columns	Cushion Barrier	Reset Cushion Barrier
173+60	183+15		Each	Each
189+80	192+75		1	1
198+05	201+75		1	1
Total			8	5

2	10-21-80	Delete Cushion Barriers. Added Gutter, Type 2g. Revised Quantities for Curb Gutter & Sidewalk.
Δ	4-25-79	Replaced portion of C&G Type 2DGM with Curb Type 2D. Replaced C&G Type 2AGM with Curb Type 2A.
No.	DATE	REVISION

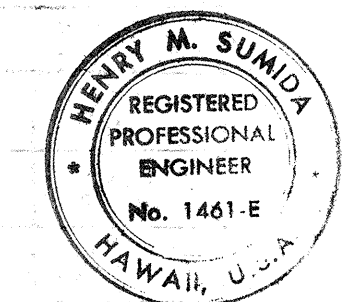

THIS WORK WAS PREPARED BY
ME OR UNDER MY SUPERVISION
Henry M. Sumida

STATE OF HAWAII
DEPARTMENT OF TRANSPORTATION
HIGHWAYS DIVISION

MISCELLANEOUS
SCHEDULES


AIRPORT INTERCHANGE
F.A.I. PROJ. NO. I-HI-1(34)16

SCALE: AS SHOWN DATE: Sep 30, '77


SHEET No. 1 OF 1 SHEETS

FED. ROAD DIST. NO.	STATE	FED. AID PROJ. NO.	FISCAL YEAR	SHEET NO.	TOTAL SHEETS
HAWAII	HAW.	I-HI-1(B4)16	1978	CQ 22A	466

SURVEY PLOTTED BY	DATE
DRAWN BY	
TRACED BY	
QUANTITIES BY	
CHECKED BY	
ORIGINAL PLAN	
NOTE BOOK	
No.	

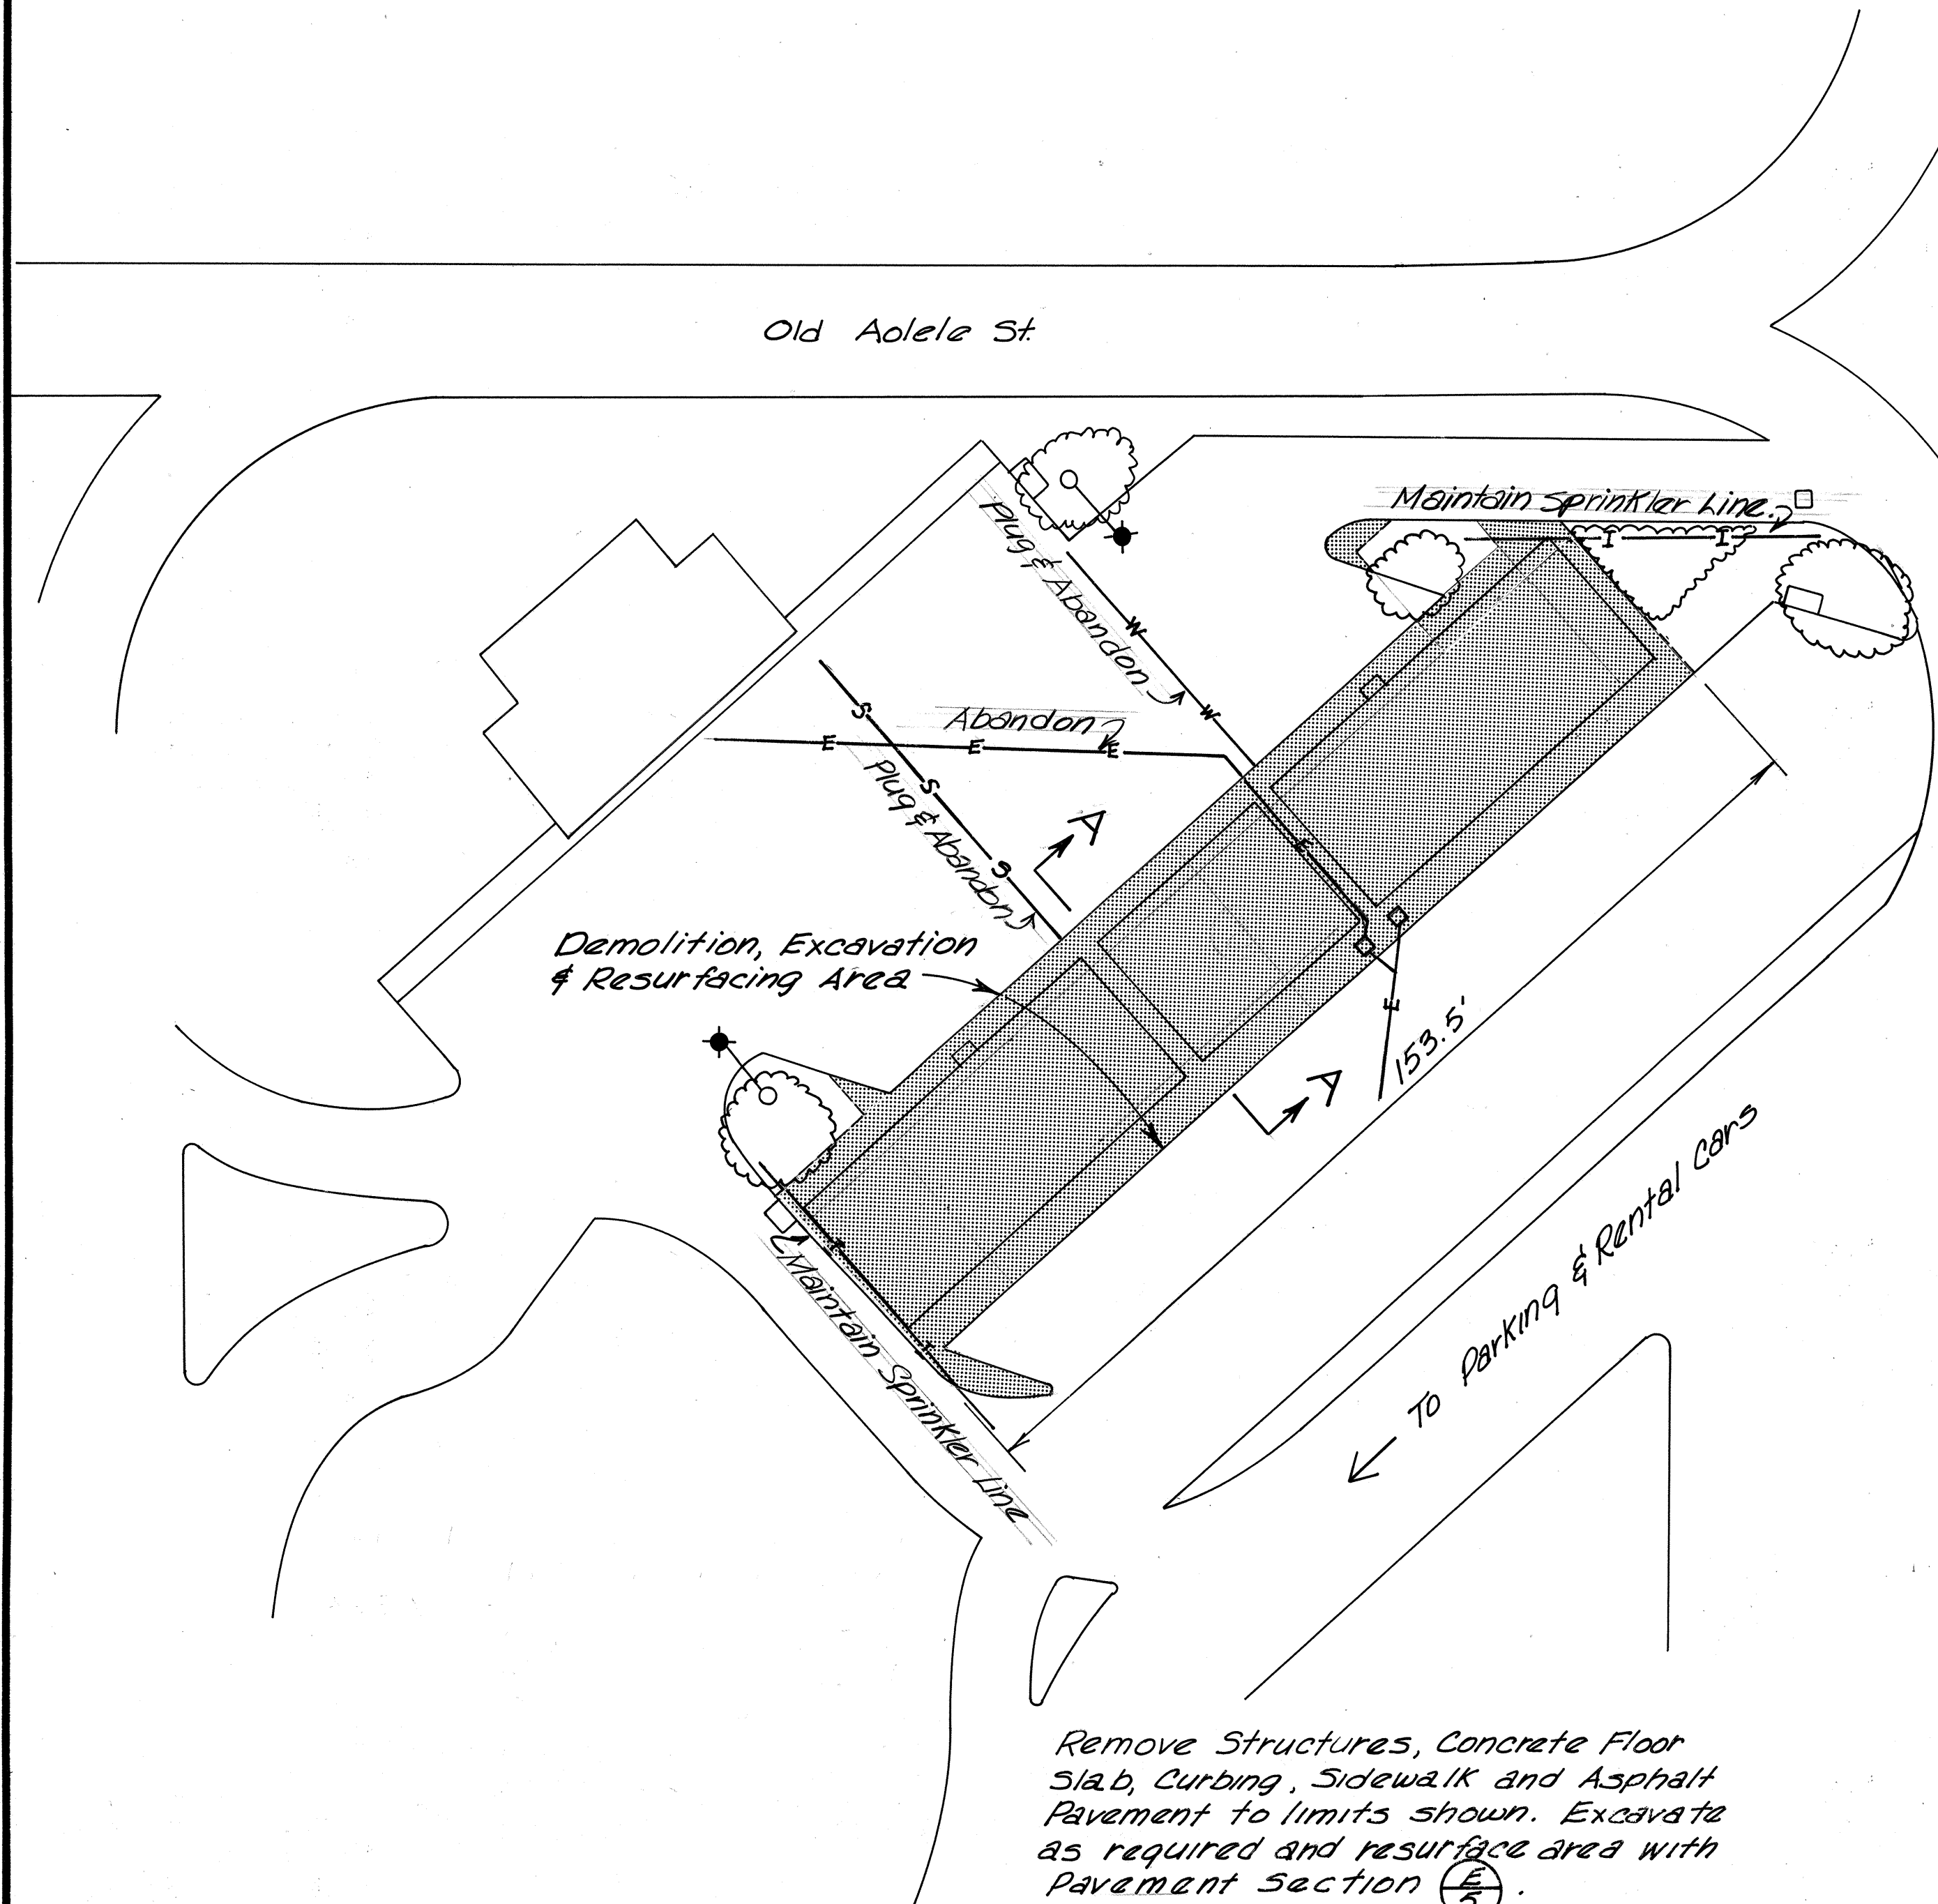


DEMOLITION PLAN
SCALE: 1" = 20'

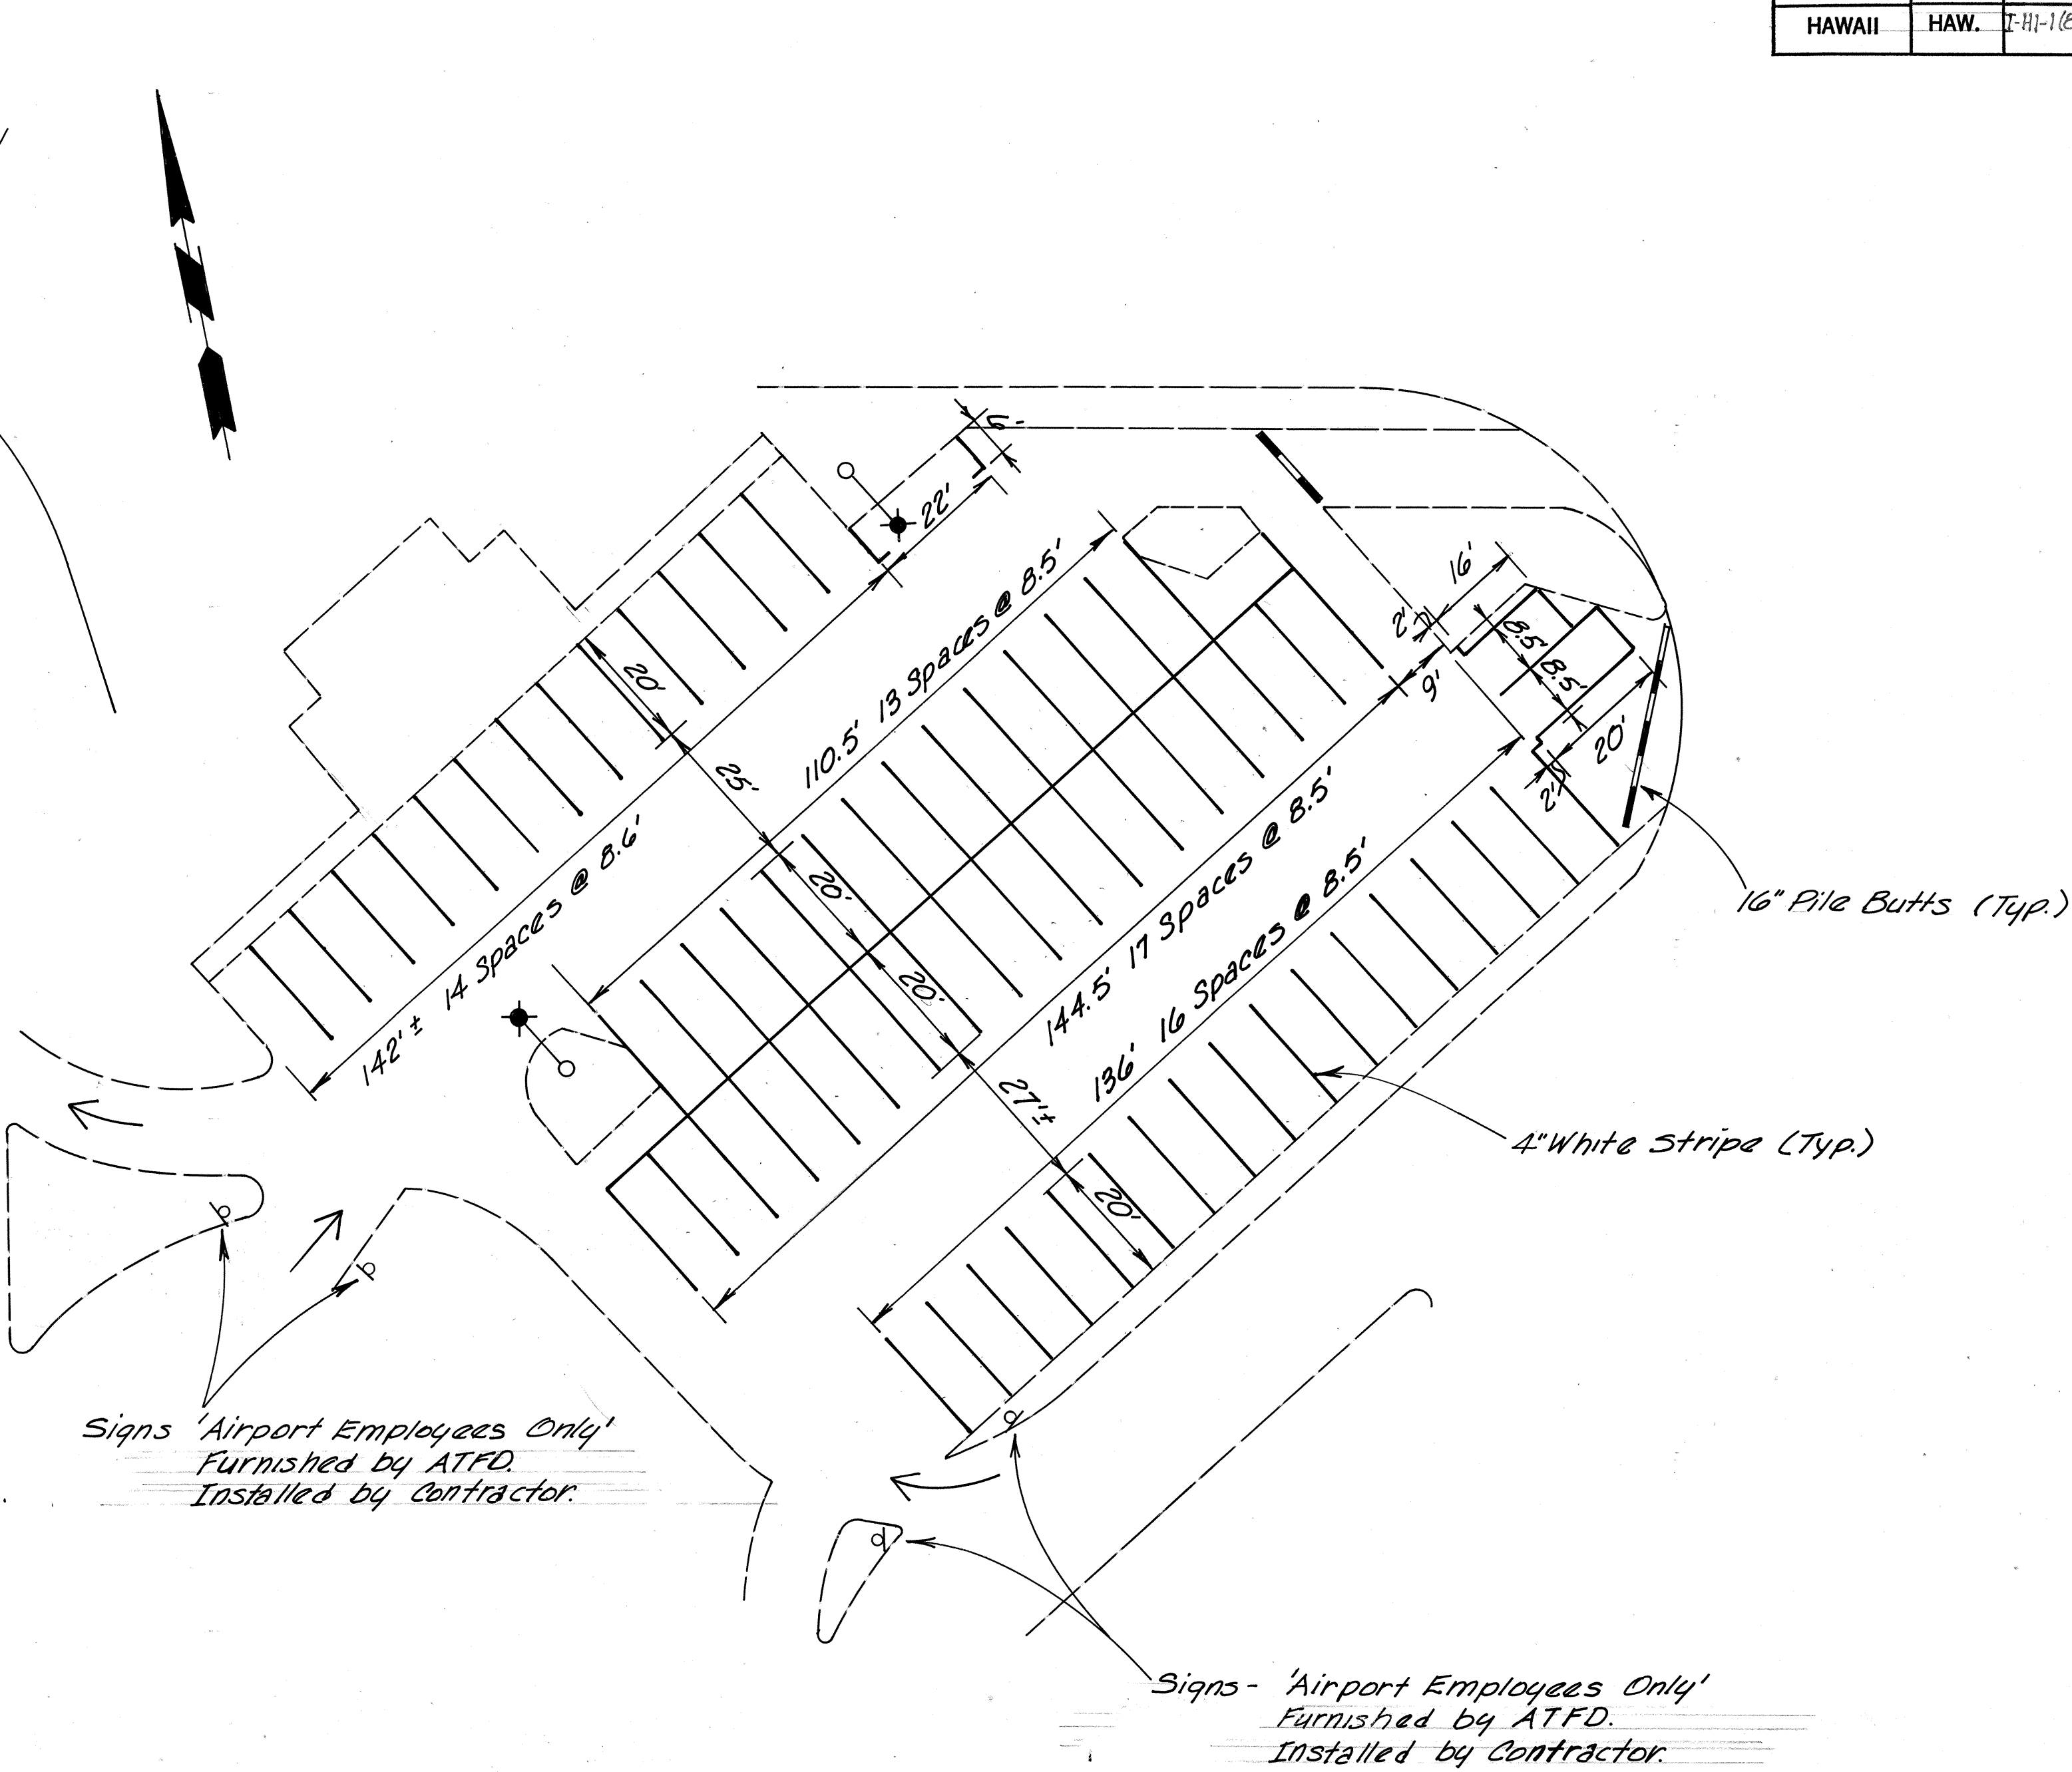


STRIPING PLAN
SCALE: 1" = 20'


Note: Remove Existing Striping.

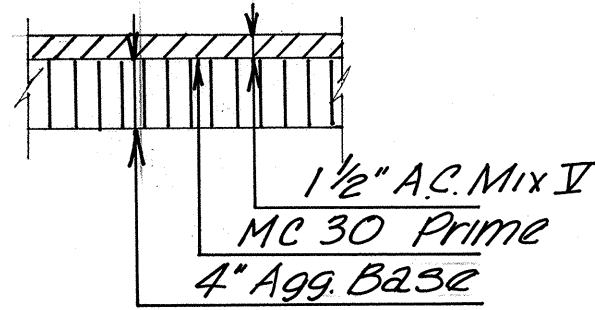

PARKING LOT PAVING $\frac{E}{5}$

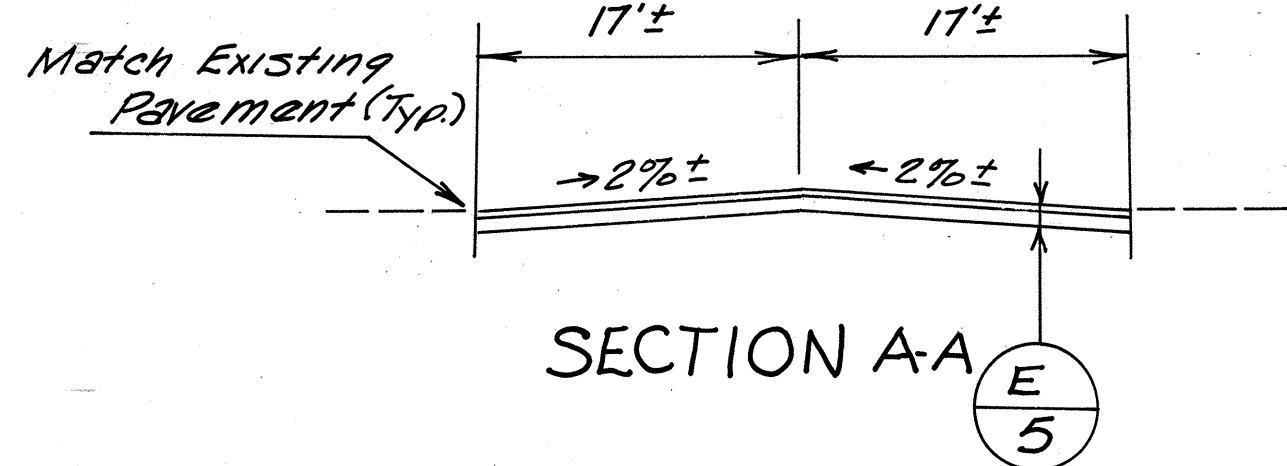

- LEGEND
- W 1 1/2" Water Line
 - E Electric & Communications Lines
 - S 4" Sanitary Line
 - I Sprinkler Line

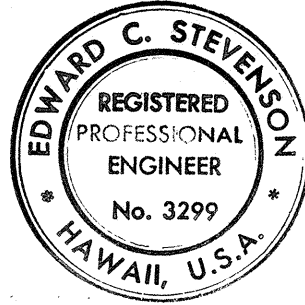

THIS WORK WAS PREPARED BY:
ME OR UNDER MY SUPERVISION.
Edward C. Stevenson
Signature

12-4-78	Added Sheet.
DATE	REVISION

STATE OF HAWAII
DEPARTMENT OF TRANSPORTATION
LAND TRANSPORTATION FACILITIES DIVISION

DEMOLITION AND
RESURFACING OF
LEI STAND AREA
AIRPORT INTERCHANGE
F.A.I. PROJECT I-HI-1(B4):16

SCALE: AS SHOWN DATE: DEC. 1978
SHEET NO. 1 OF 1 SHEETS

CO 22A