




FED. ROAD DIST. NO.	STATE	FED. AID PROJ. NO.	FISCAL YEAR	SHEET NO.	TOTAL SHEETS
HAWAII	HAW.	I-HI-1(84)-16	1978	15	466

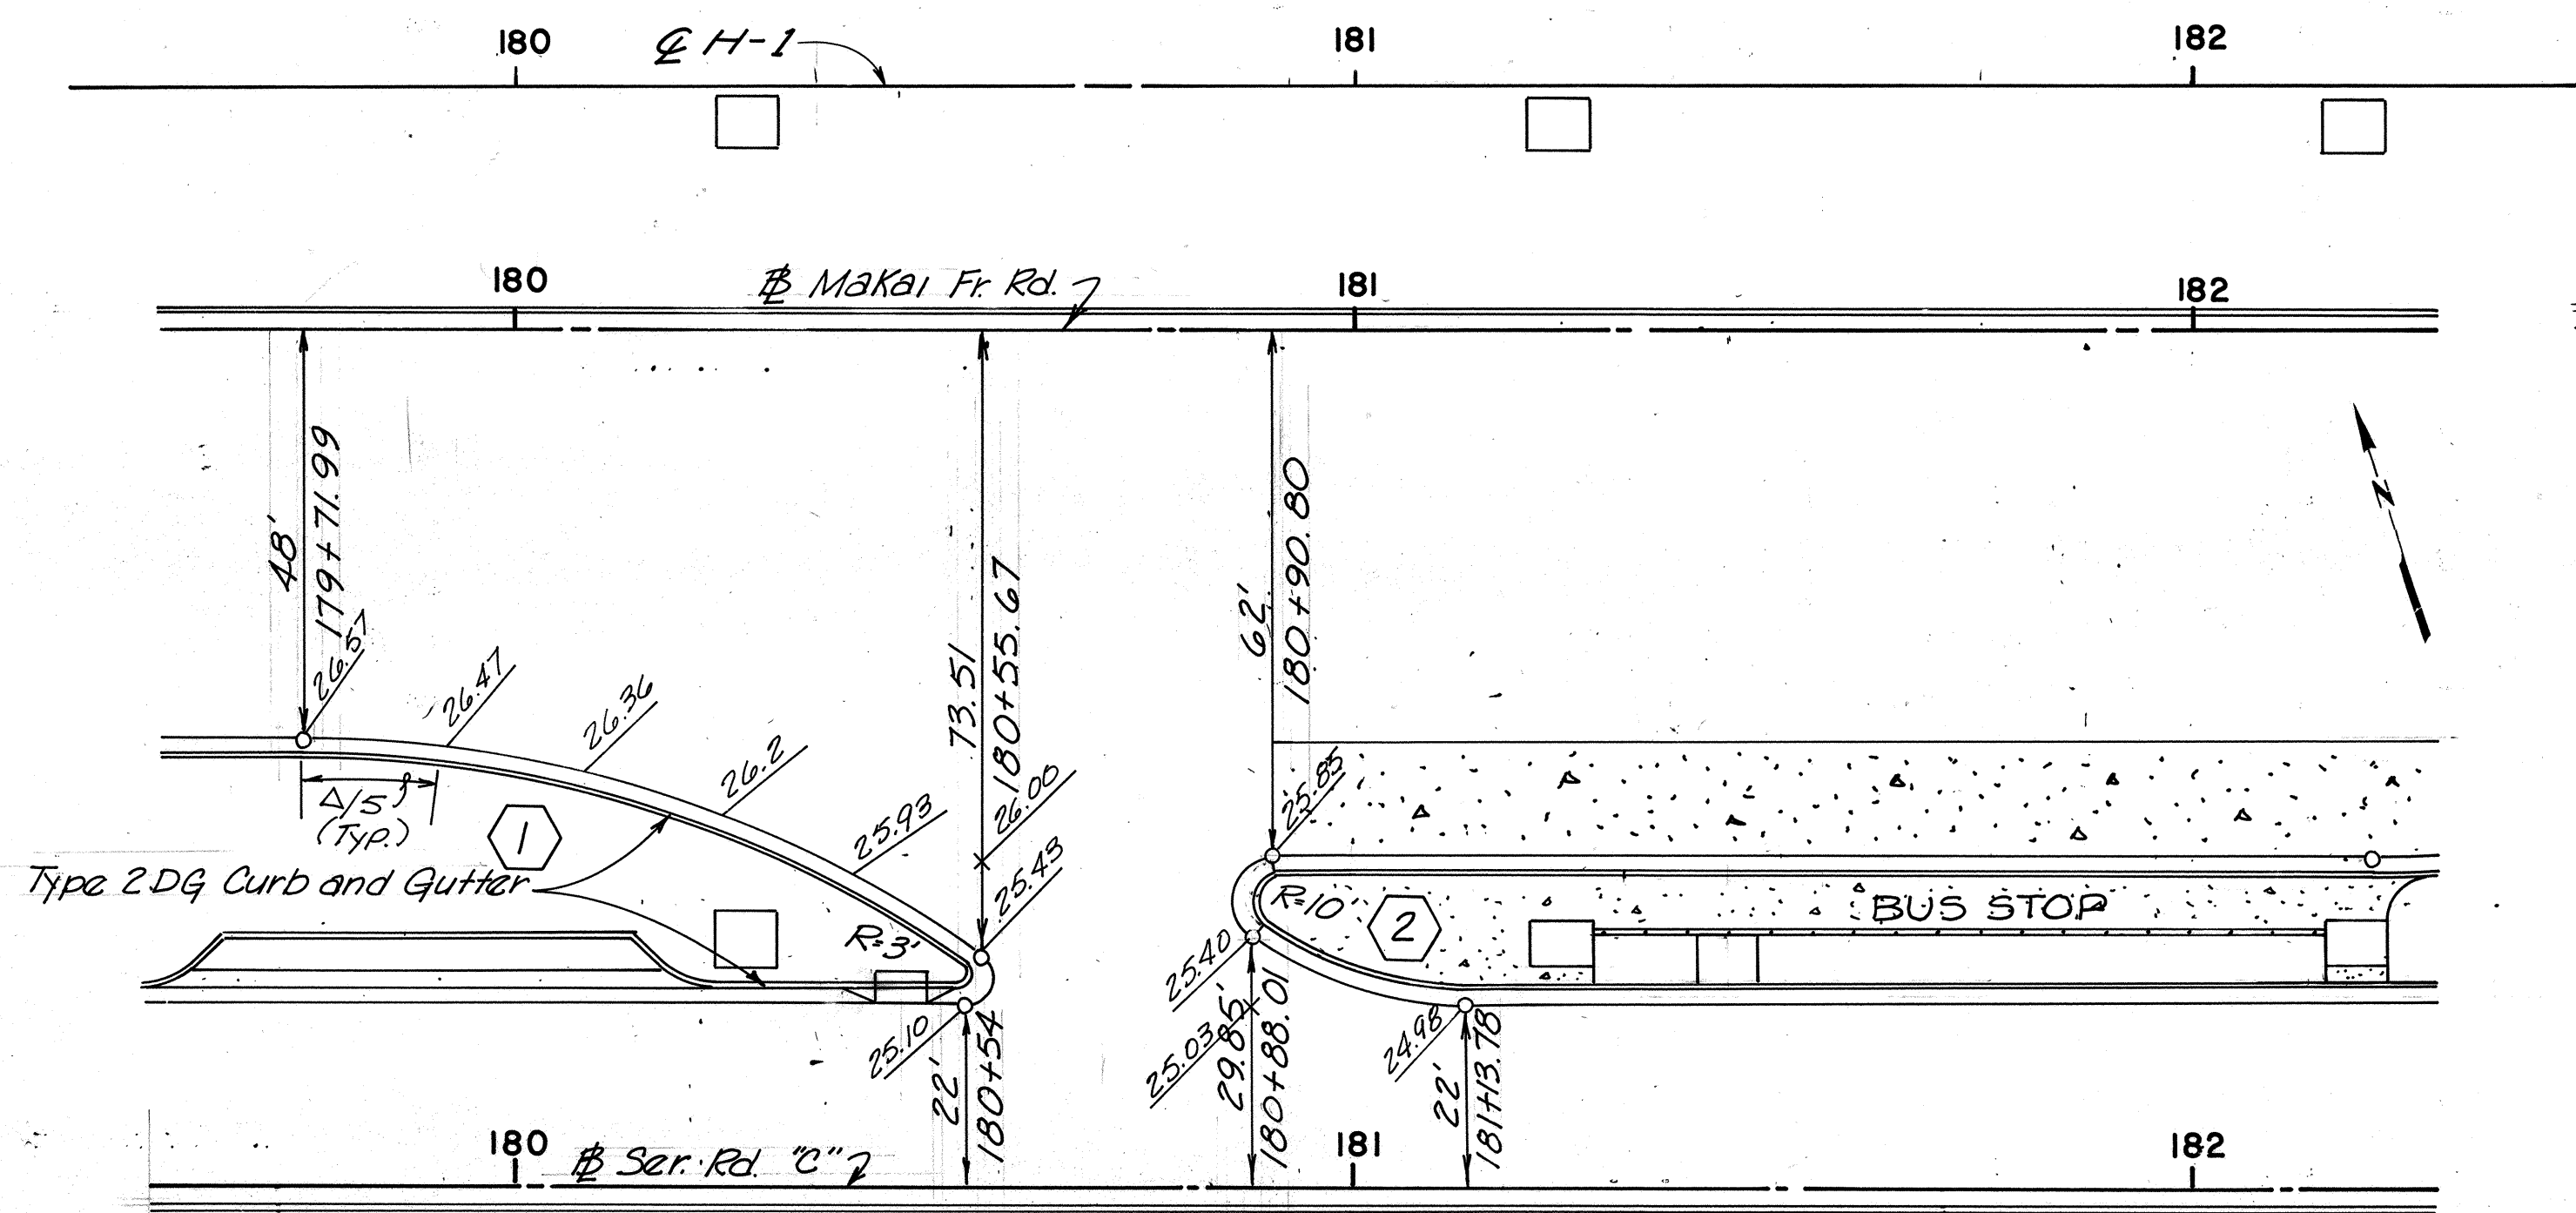


	1	2
Δ	33°54'30"	33°54'30"
$\Delta/2$	16°57'15"	16°57'15"
R	150.00'	46.18'
T	45.73'	14.08'
Ch	87.48'	26.93'
LC	88.77'	27.33'

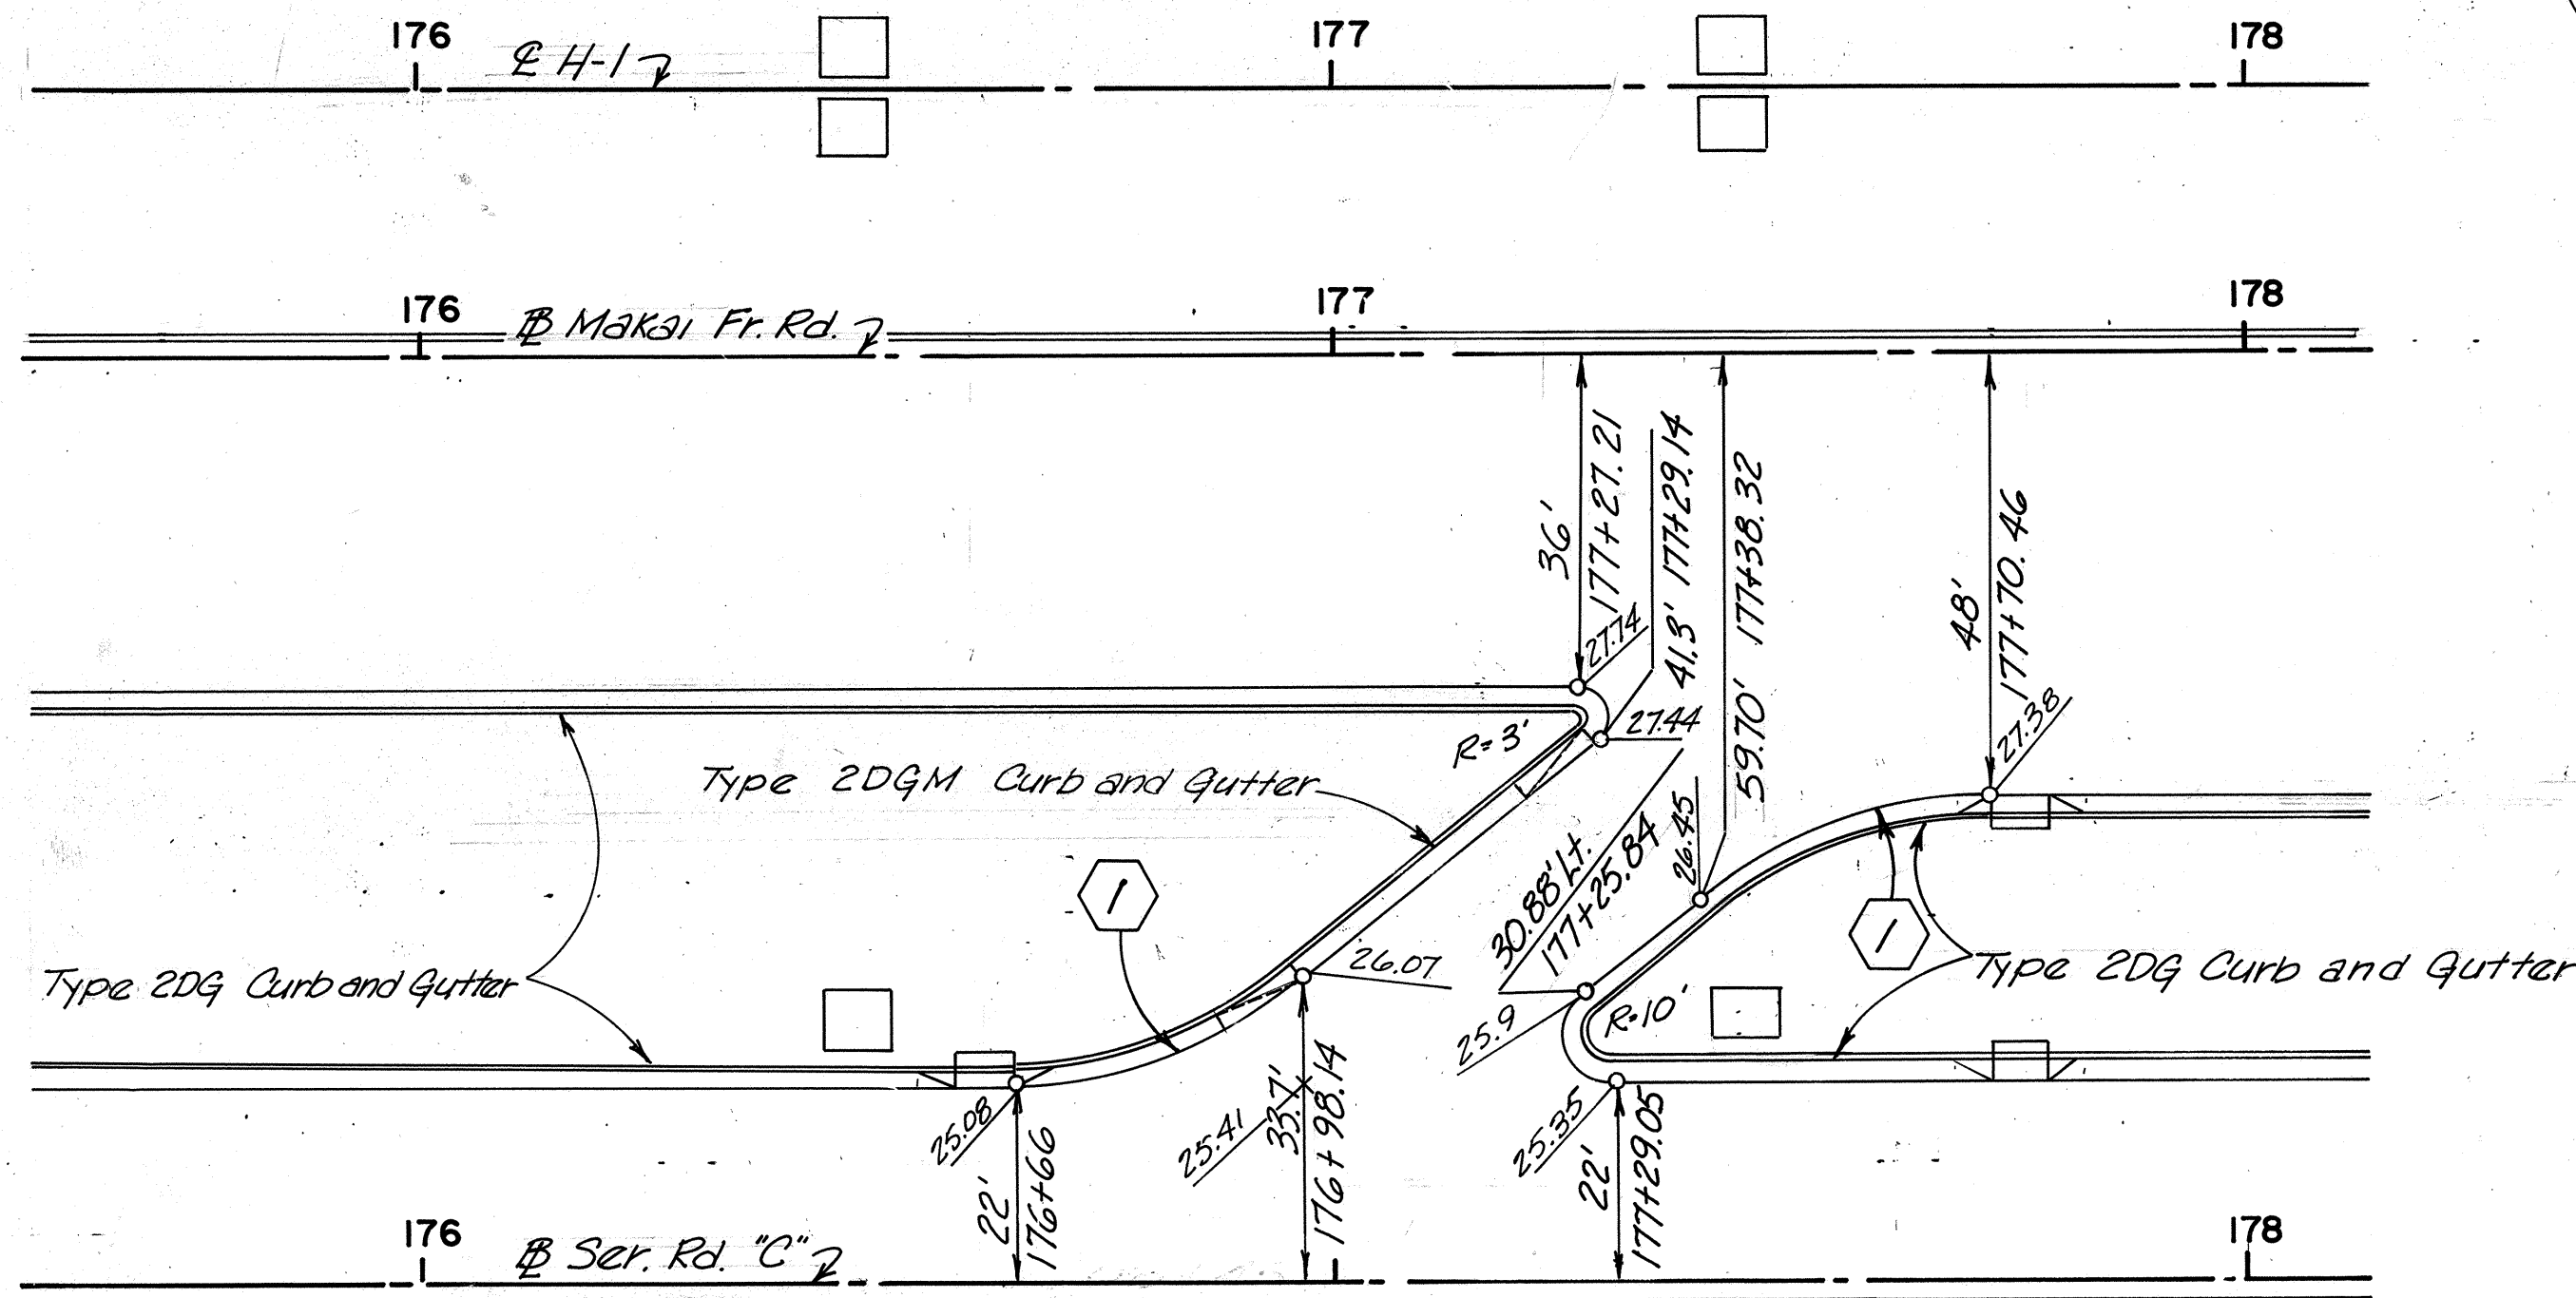

	1
Δ	40°00'00"
$\Delta/2$	20°00'00"
R	50.00'
T	18.20'
Ch	34.20'
LC	34.91'

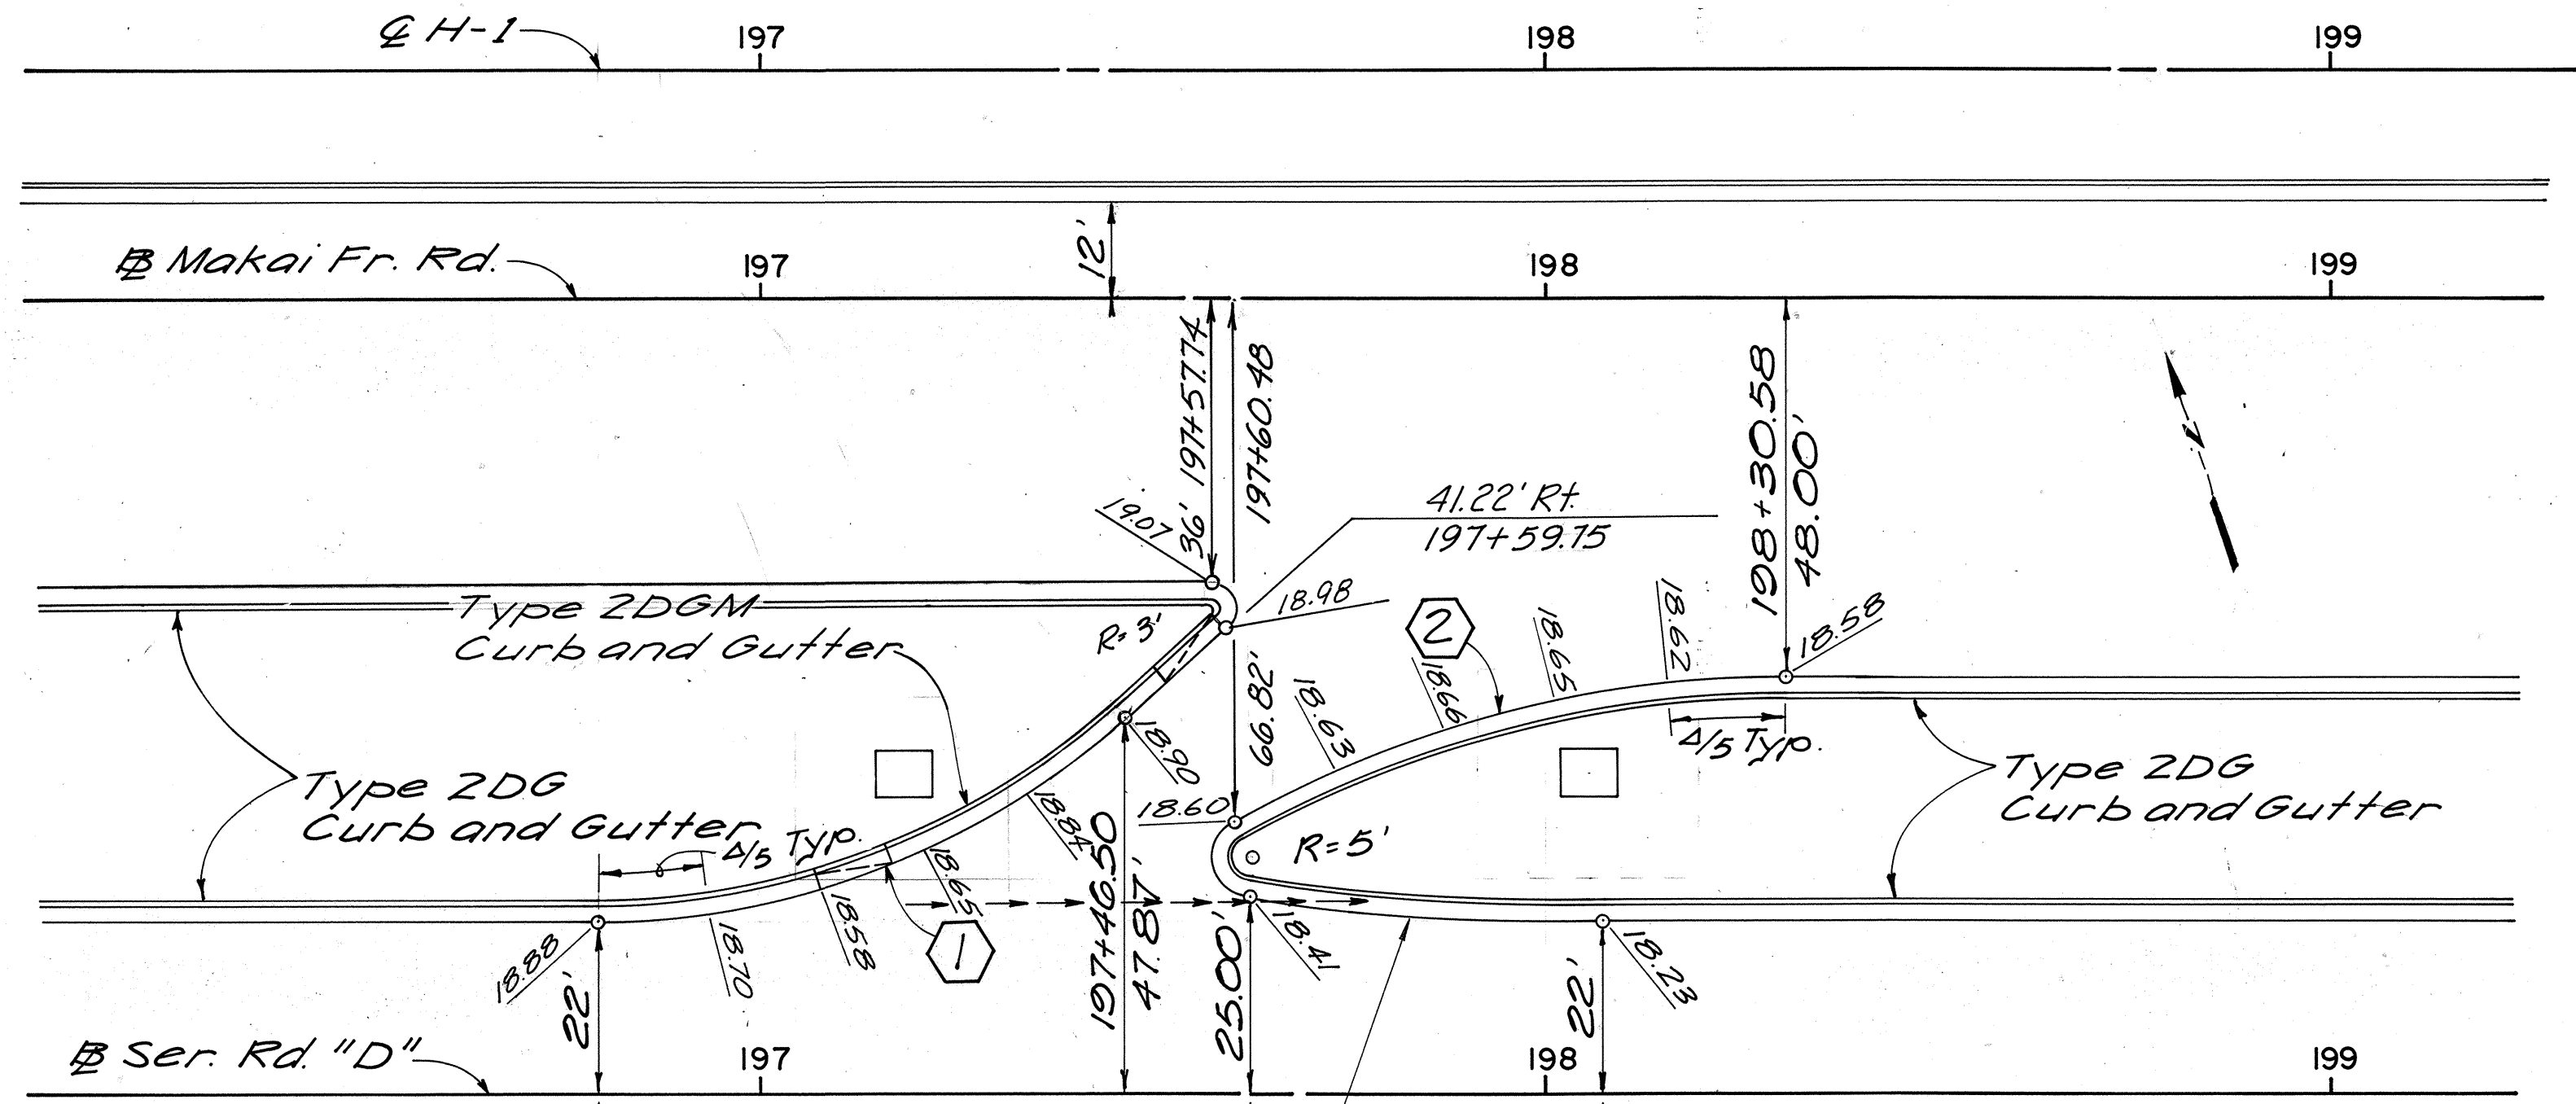


	1	2
Δ	42°00'41"	33°03'00"
$\Delta/2$	21°04'50.5"	16°31'30"
R	100.00'	140.00'
T	38.55'	37.58'
Ch	71.24'	72.59'
LC	73.59'	73.43'

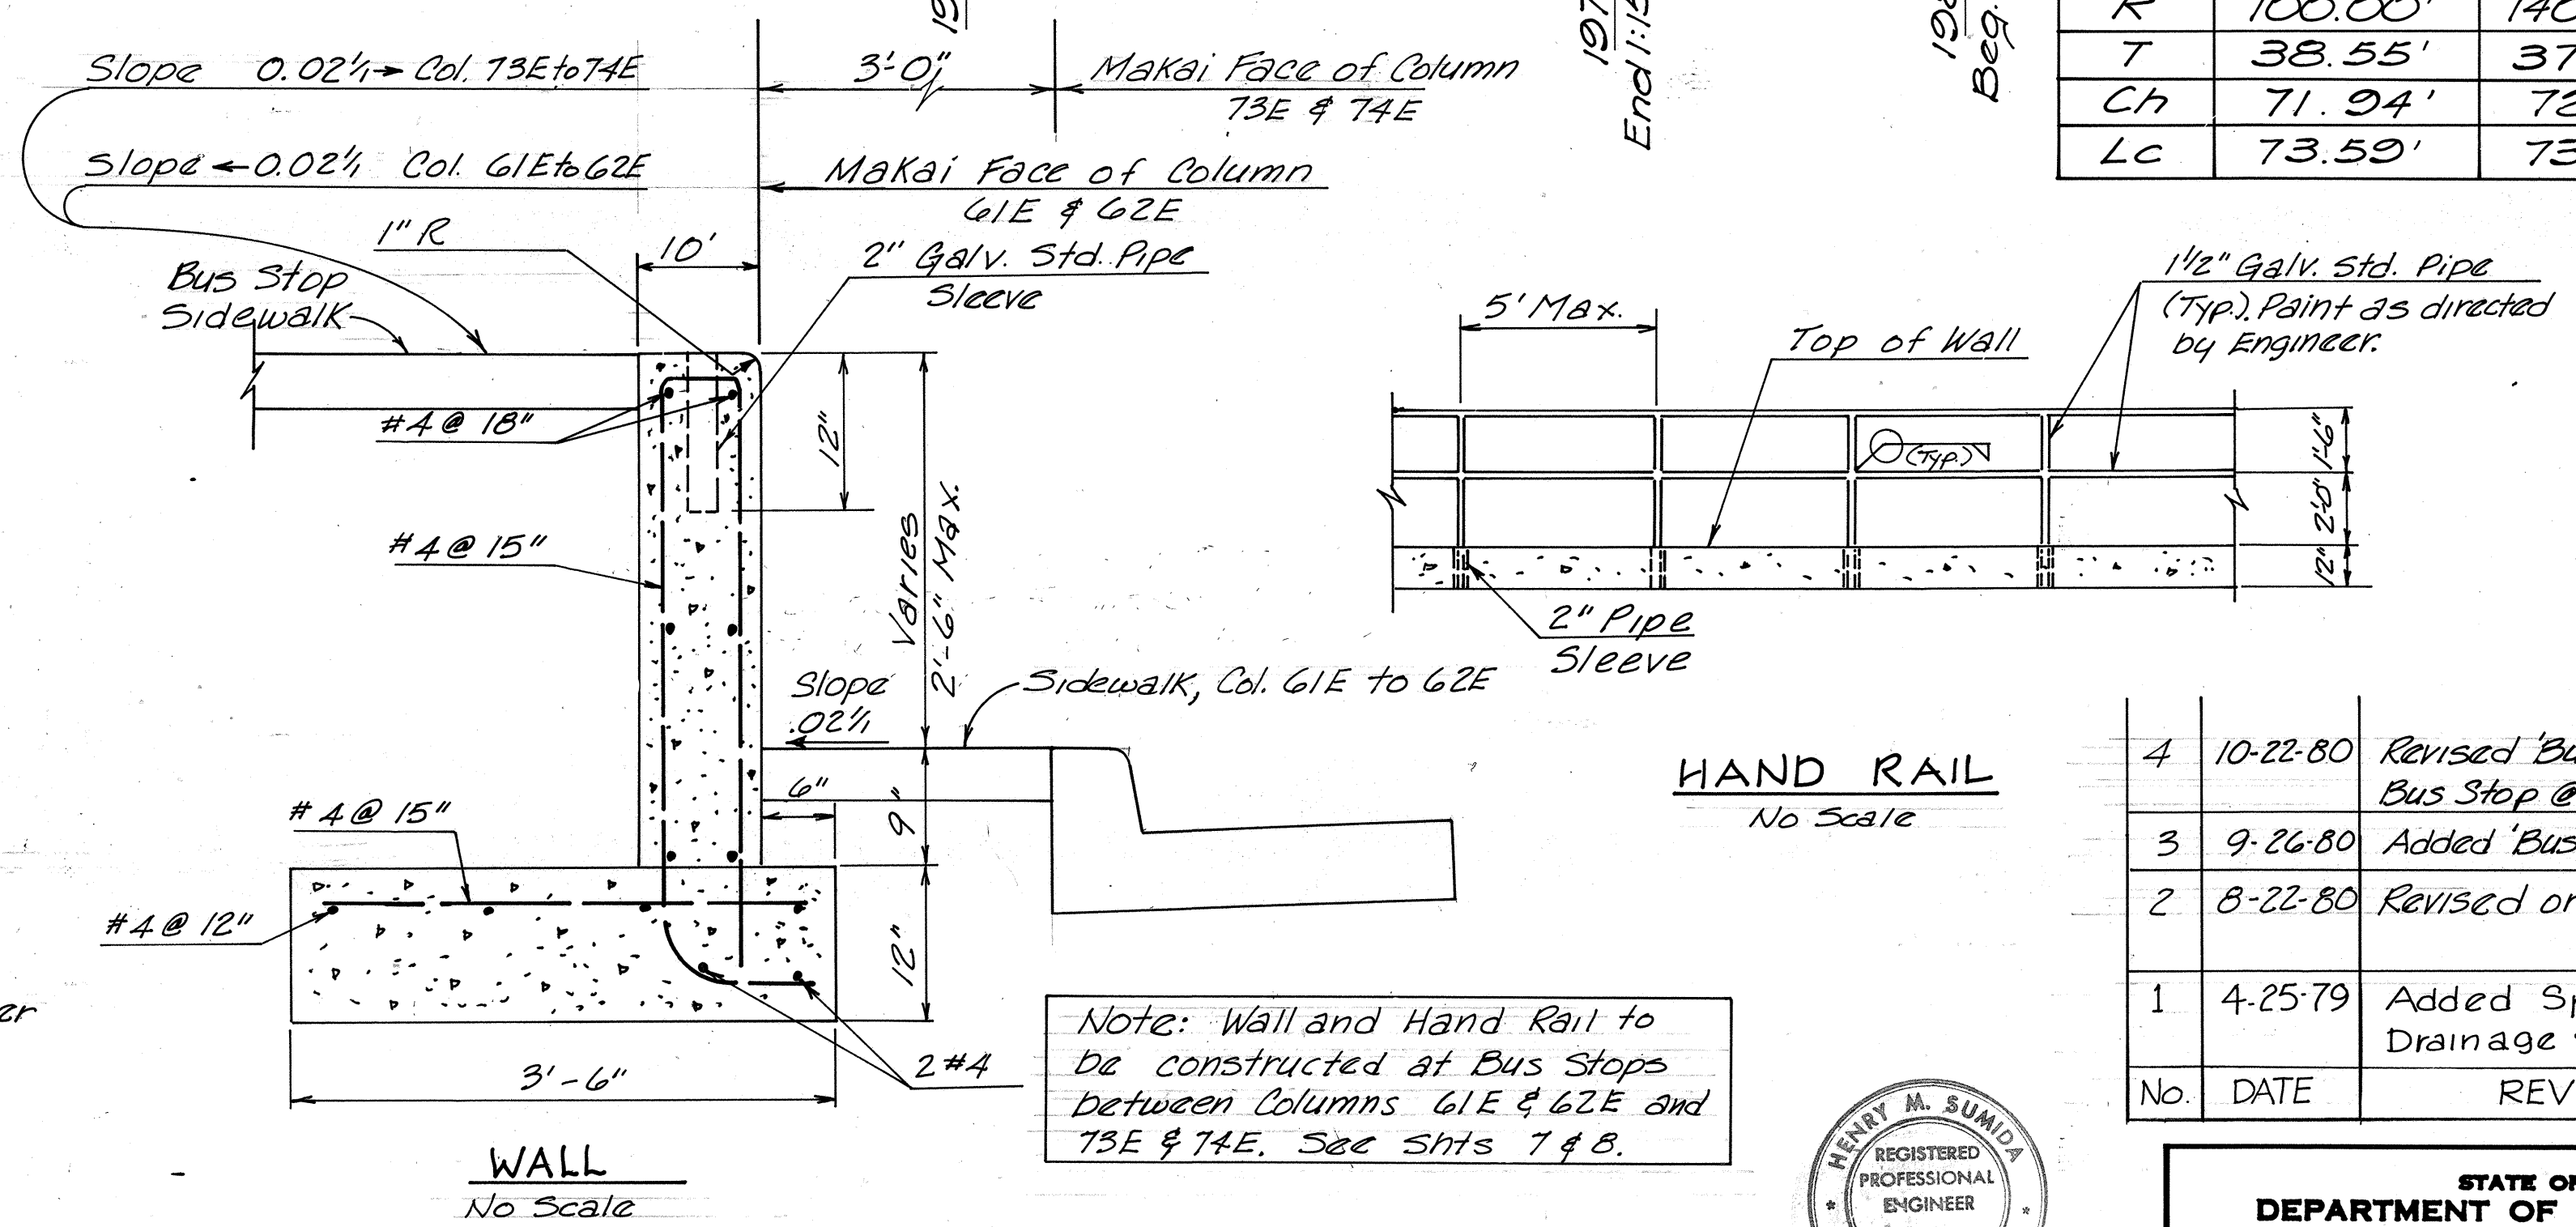

LEGEND

- 20.00 Finish Grade Elevations
- Drainage Flowline
- 10' Curb & Gutter Transition

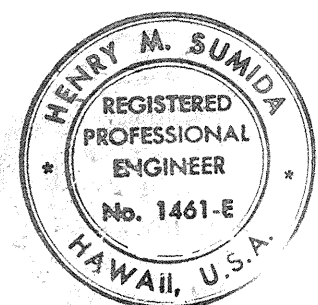

No.	DATE	REVISION
4	10-22-80	Revised 'Bus Stop' wall detail & Bus Stop @ Sta 181+00 to 182+00 ±
3	9-26-80	Added 'Bus Stop' wall & hand rail.
2	8-22-80	Revised or Relocated all Ramps
1	4-25-79	Added Spot Elevations & Drainage Structures-Sta. 201-210

STATE OF HAWAII
DEPARTMENT OF TRANSPORTATION
HIGHWAYS DIVISION

SERVICE RD. SLIP RAMPS
BUS STOP DETAILS

AIRPORT INTERCHANGE
F.A.I. PROJ. NO. I-HI-1(84)-16

SCALE: 1" = 20' DATE: SEP 30, 1977
SHEET No. 1 OF 1 SHEETS