
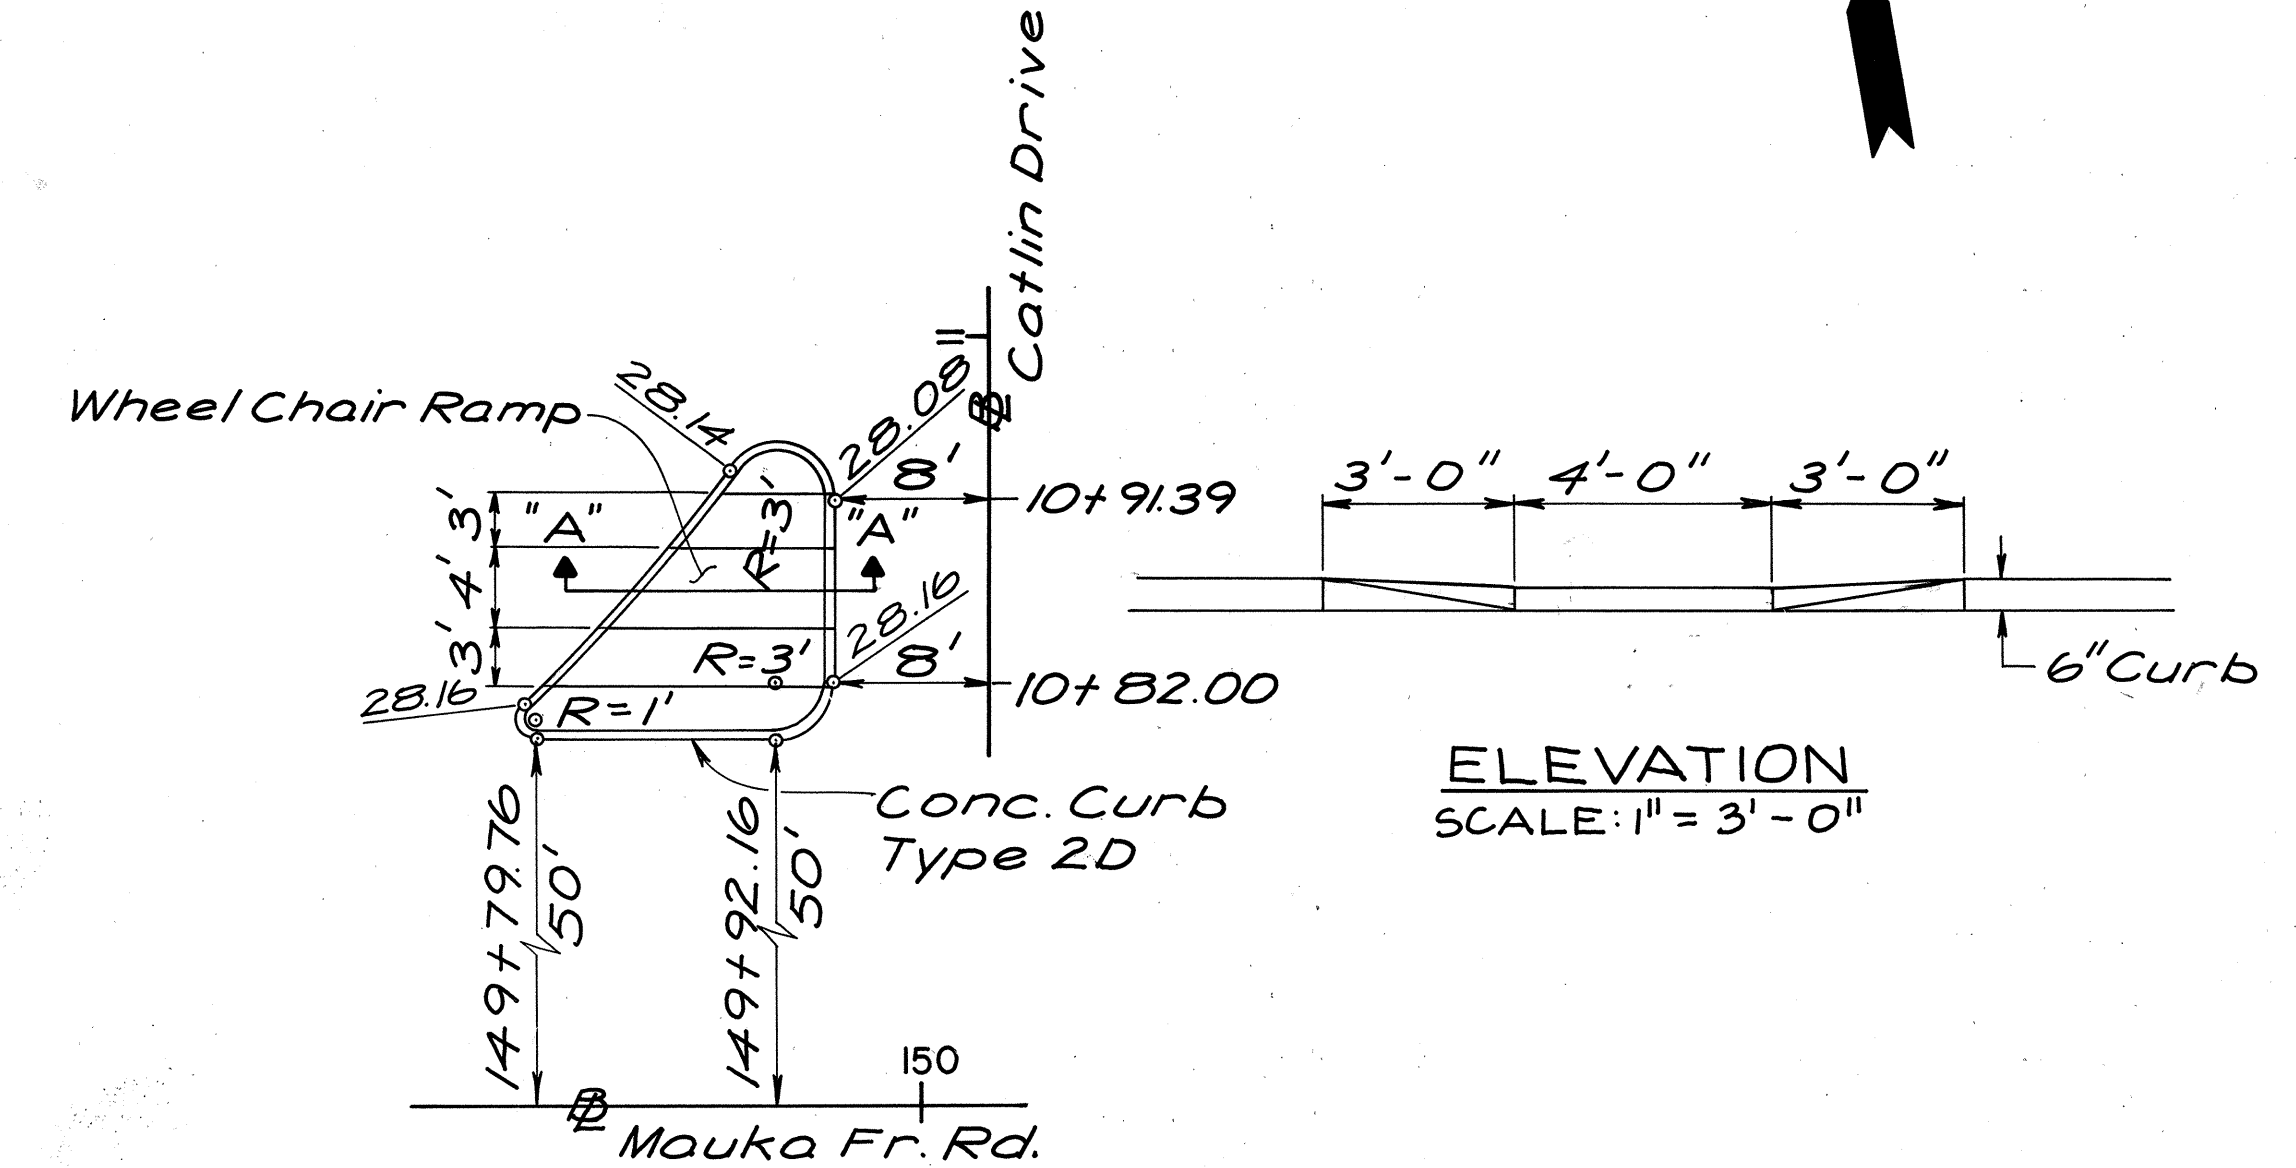
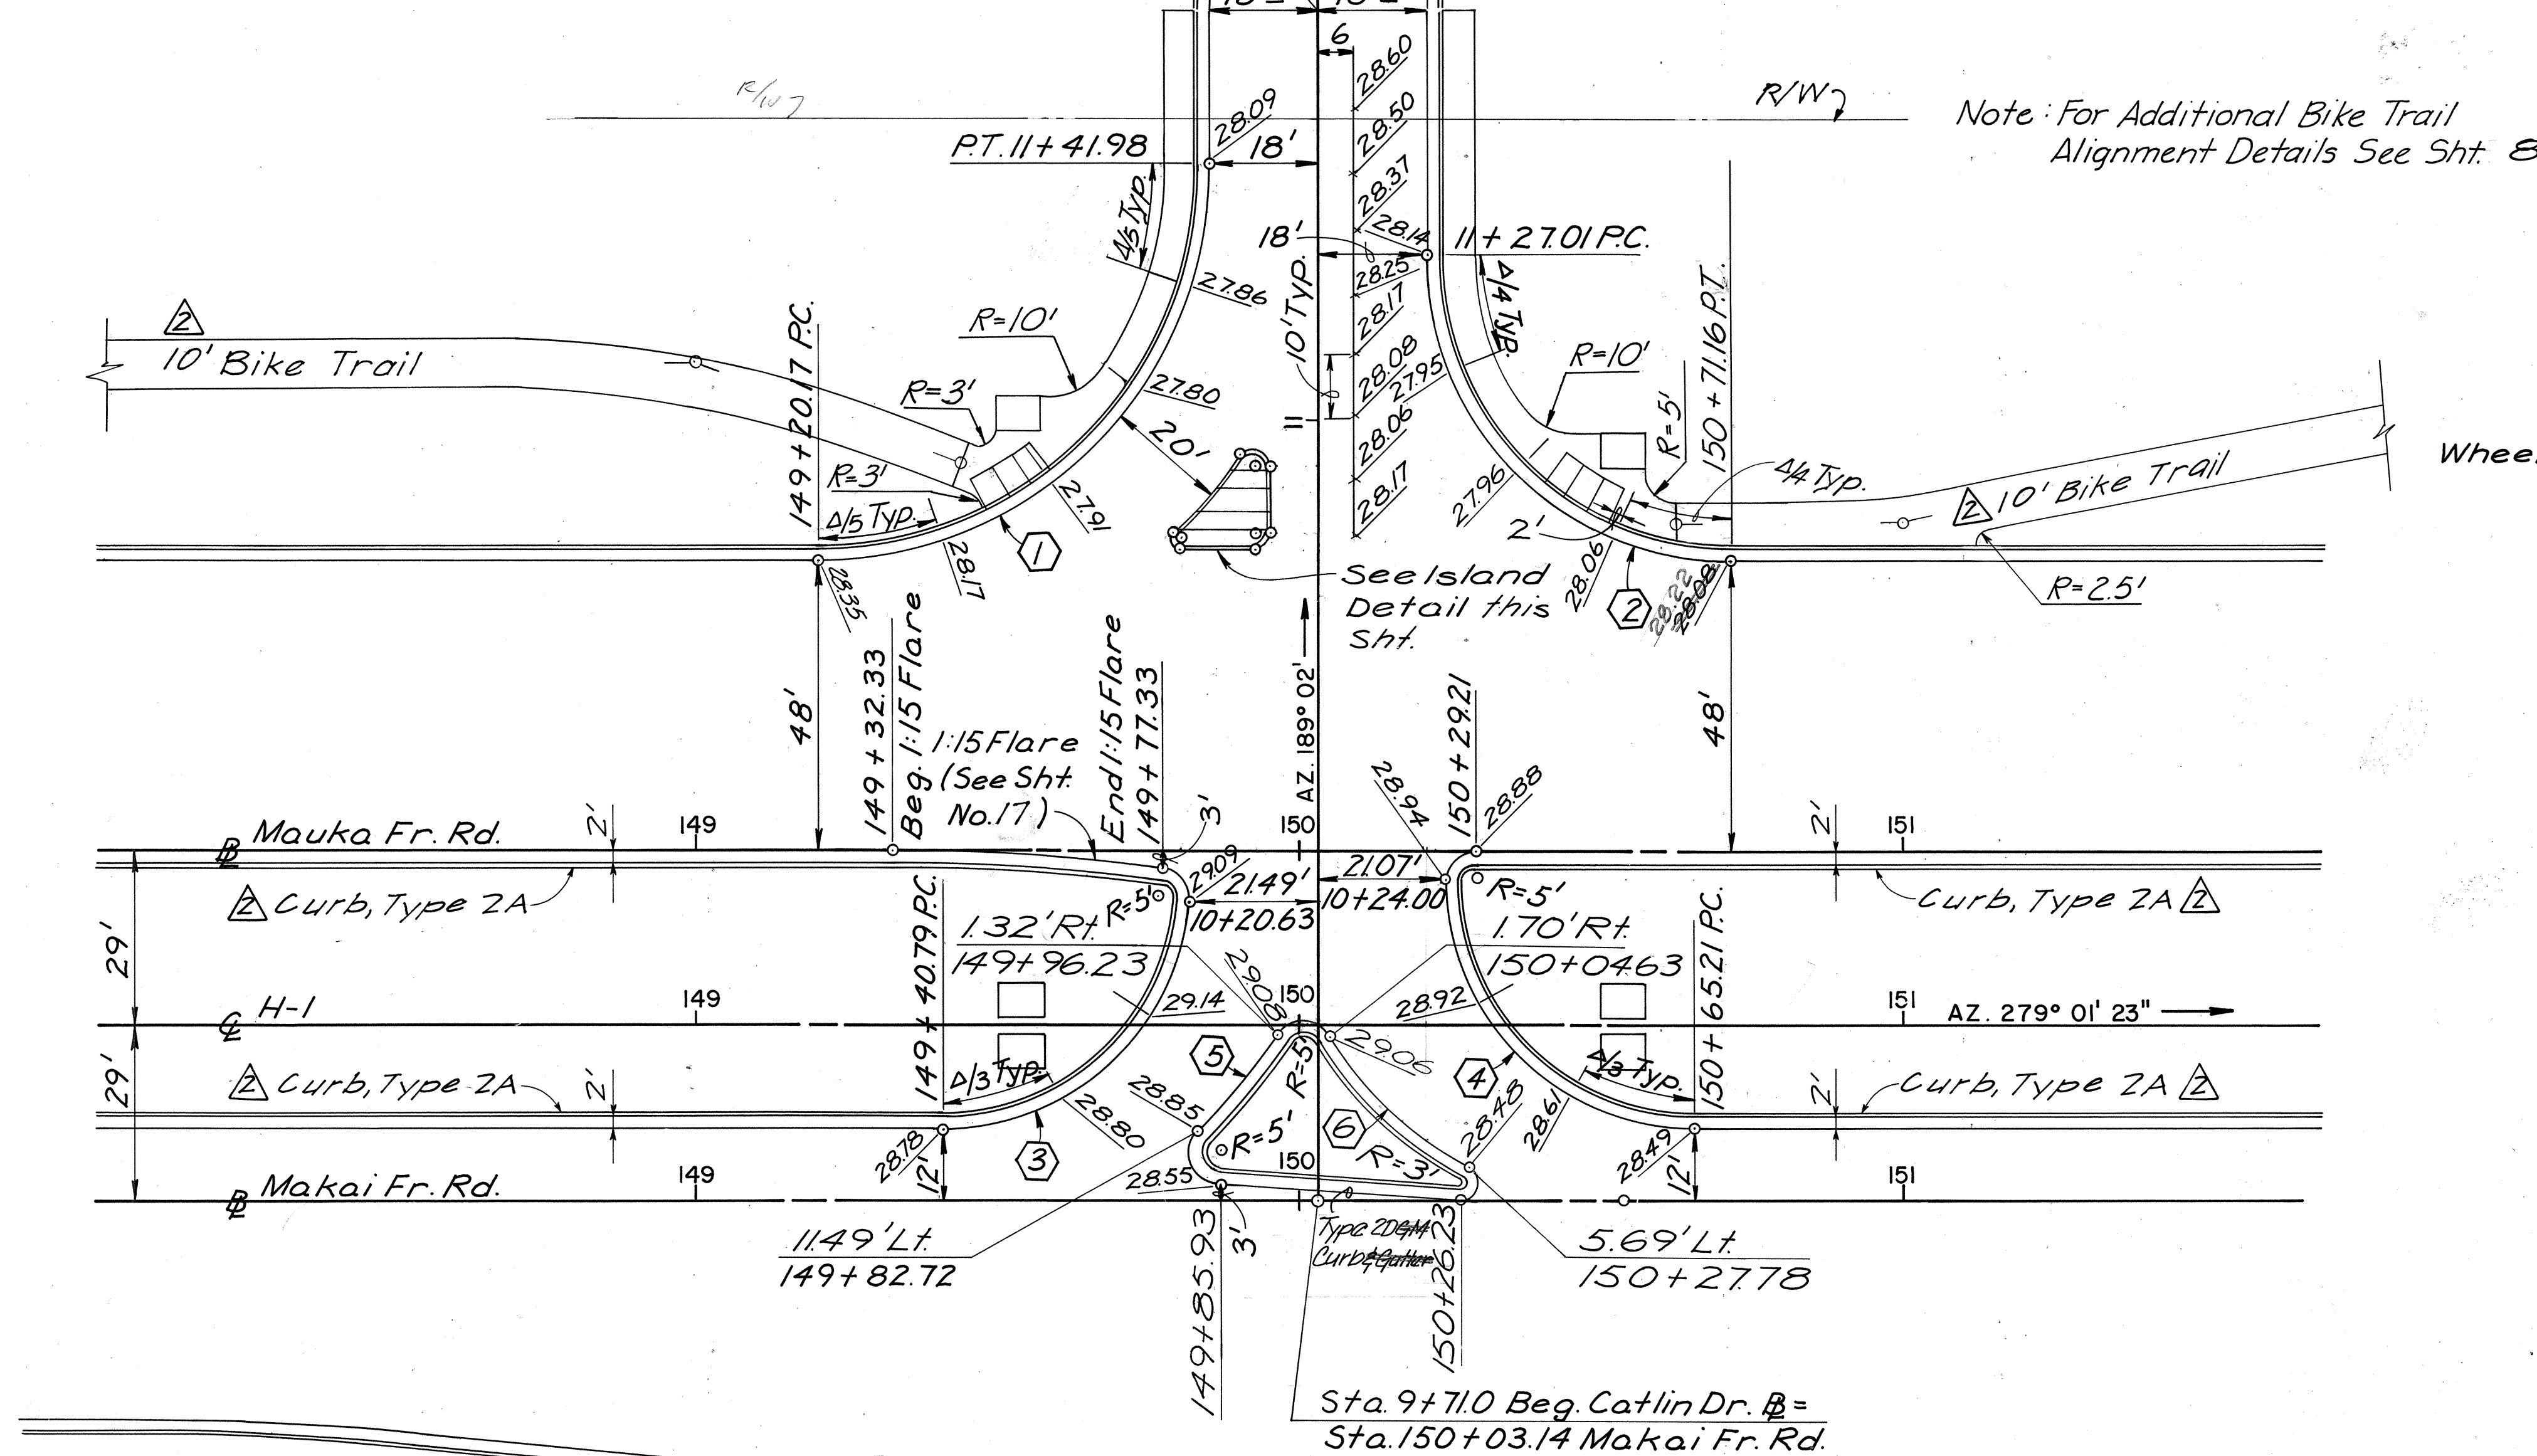


	1	2	3	1495
--	---	---	---	---	---	---	---	---	---	----	----	-----	-----	------	------	

Sta. 11+67.5 Catlin Dr.
Match Existing Pavement
Warp Curb to Match Exist.
Curb Section in last 5'±.
Begin 5' Concrete Sidewalk
and Type 2DG Curb &
Gutter Lt. & Rt.

	1	2	3	4	5	6
Δ	89°59'23"	90°00'37"	85°17'25"	90°00'00"	8°57'24"	33°28'12"
A/2	44°59'41.5"	45°00'18.5"	42°38'42.5"	45°00'00"	4°28'42"	16°44'06"
R	65.00	50.00	41.00	41.00	135.00	55.00
T	64.99	50.01	37.76	41.00	10.57	16.54
Ch	91.92	70.72	55.55	57.98	21.08	31.67
Lc	102.09	78.55	61.03	64.40	21.10	32.13

FED. ROAD DIST. NO.	STATE	FED. AID PROJ. NO.	FISCAL YEAR	SHEET NO.	TOTAL SHEETS
HAWAII	HAW.	I-H-1(124)16	1978	11	223

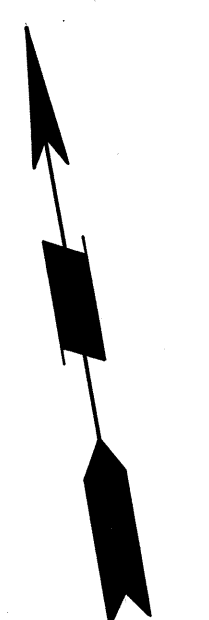


PLAN
SCALE: 1"=10'

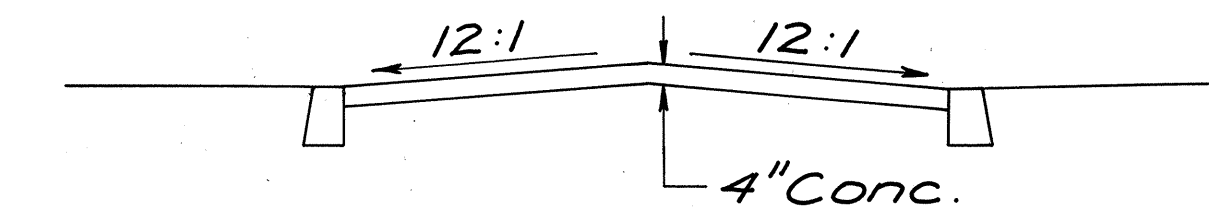

SECTION "A-A"
SCALE: 1"=3'-0"

ISLAND DETAIL


LEGEND:

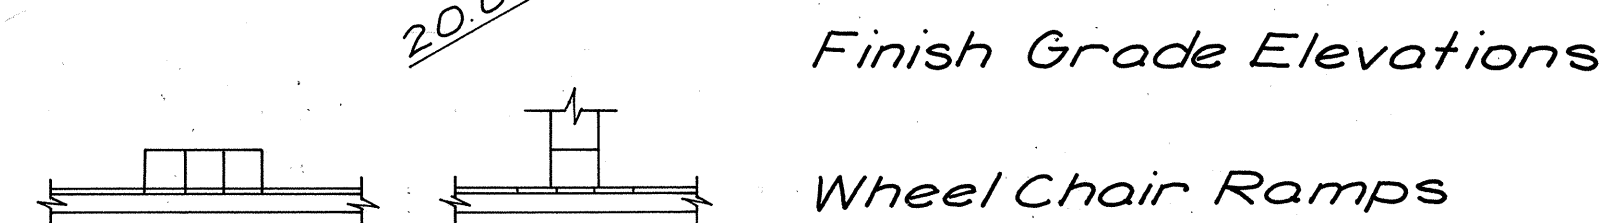

CATLIN DR. AND FRONTAGE ROAD
INTERSECTION


NO.	DATE	REVISION
1	4-6-79	Changed Curb Type & Bike Trail Width
1	1-19-79	Added Approval Block

THIS WORK WAS PREPARED BY
ME OR UNDER MY SUPERVISION.
Kenny J. [Signature]

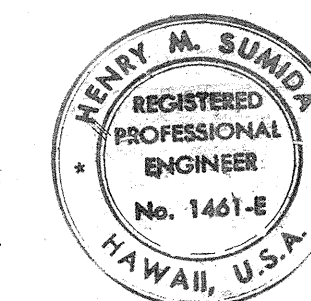

APPROVED FOR GRADING ONLY:	
<i>[Signature]</i>	DATE
CHIEF, DIVISION OF ENGINEERING, DPW	
STATE OF HAWAII DEPARTMENT OF TRANSPORTATION HIGHWAYS DIVISION	
INTERSECTION DETAILS CATLIN DRIVE	
AIRPORT INTERCHANGE F.A.I. PROJ. NO I-H-1(124)16	
SCALE: 1"=20'	DATE: AUG. 9, 1977
SHEET No. 5 OF 6 SHEETS	

FED. ROAD DIST. NO.	STATE	FED. AID PROJ. NO.	FISCAL YEAR	SHEET NO.	TOTAL SHEETS
HAWAII	HAW.	FH-1(124)-16	1978	12	223

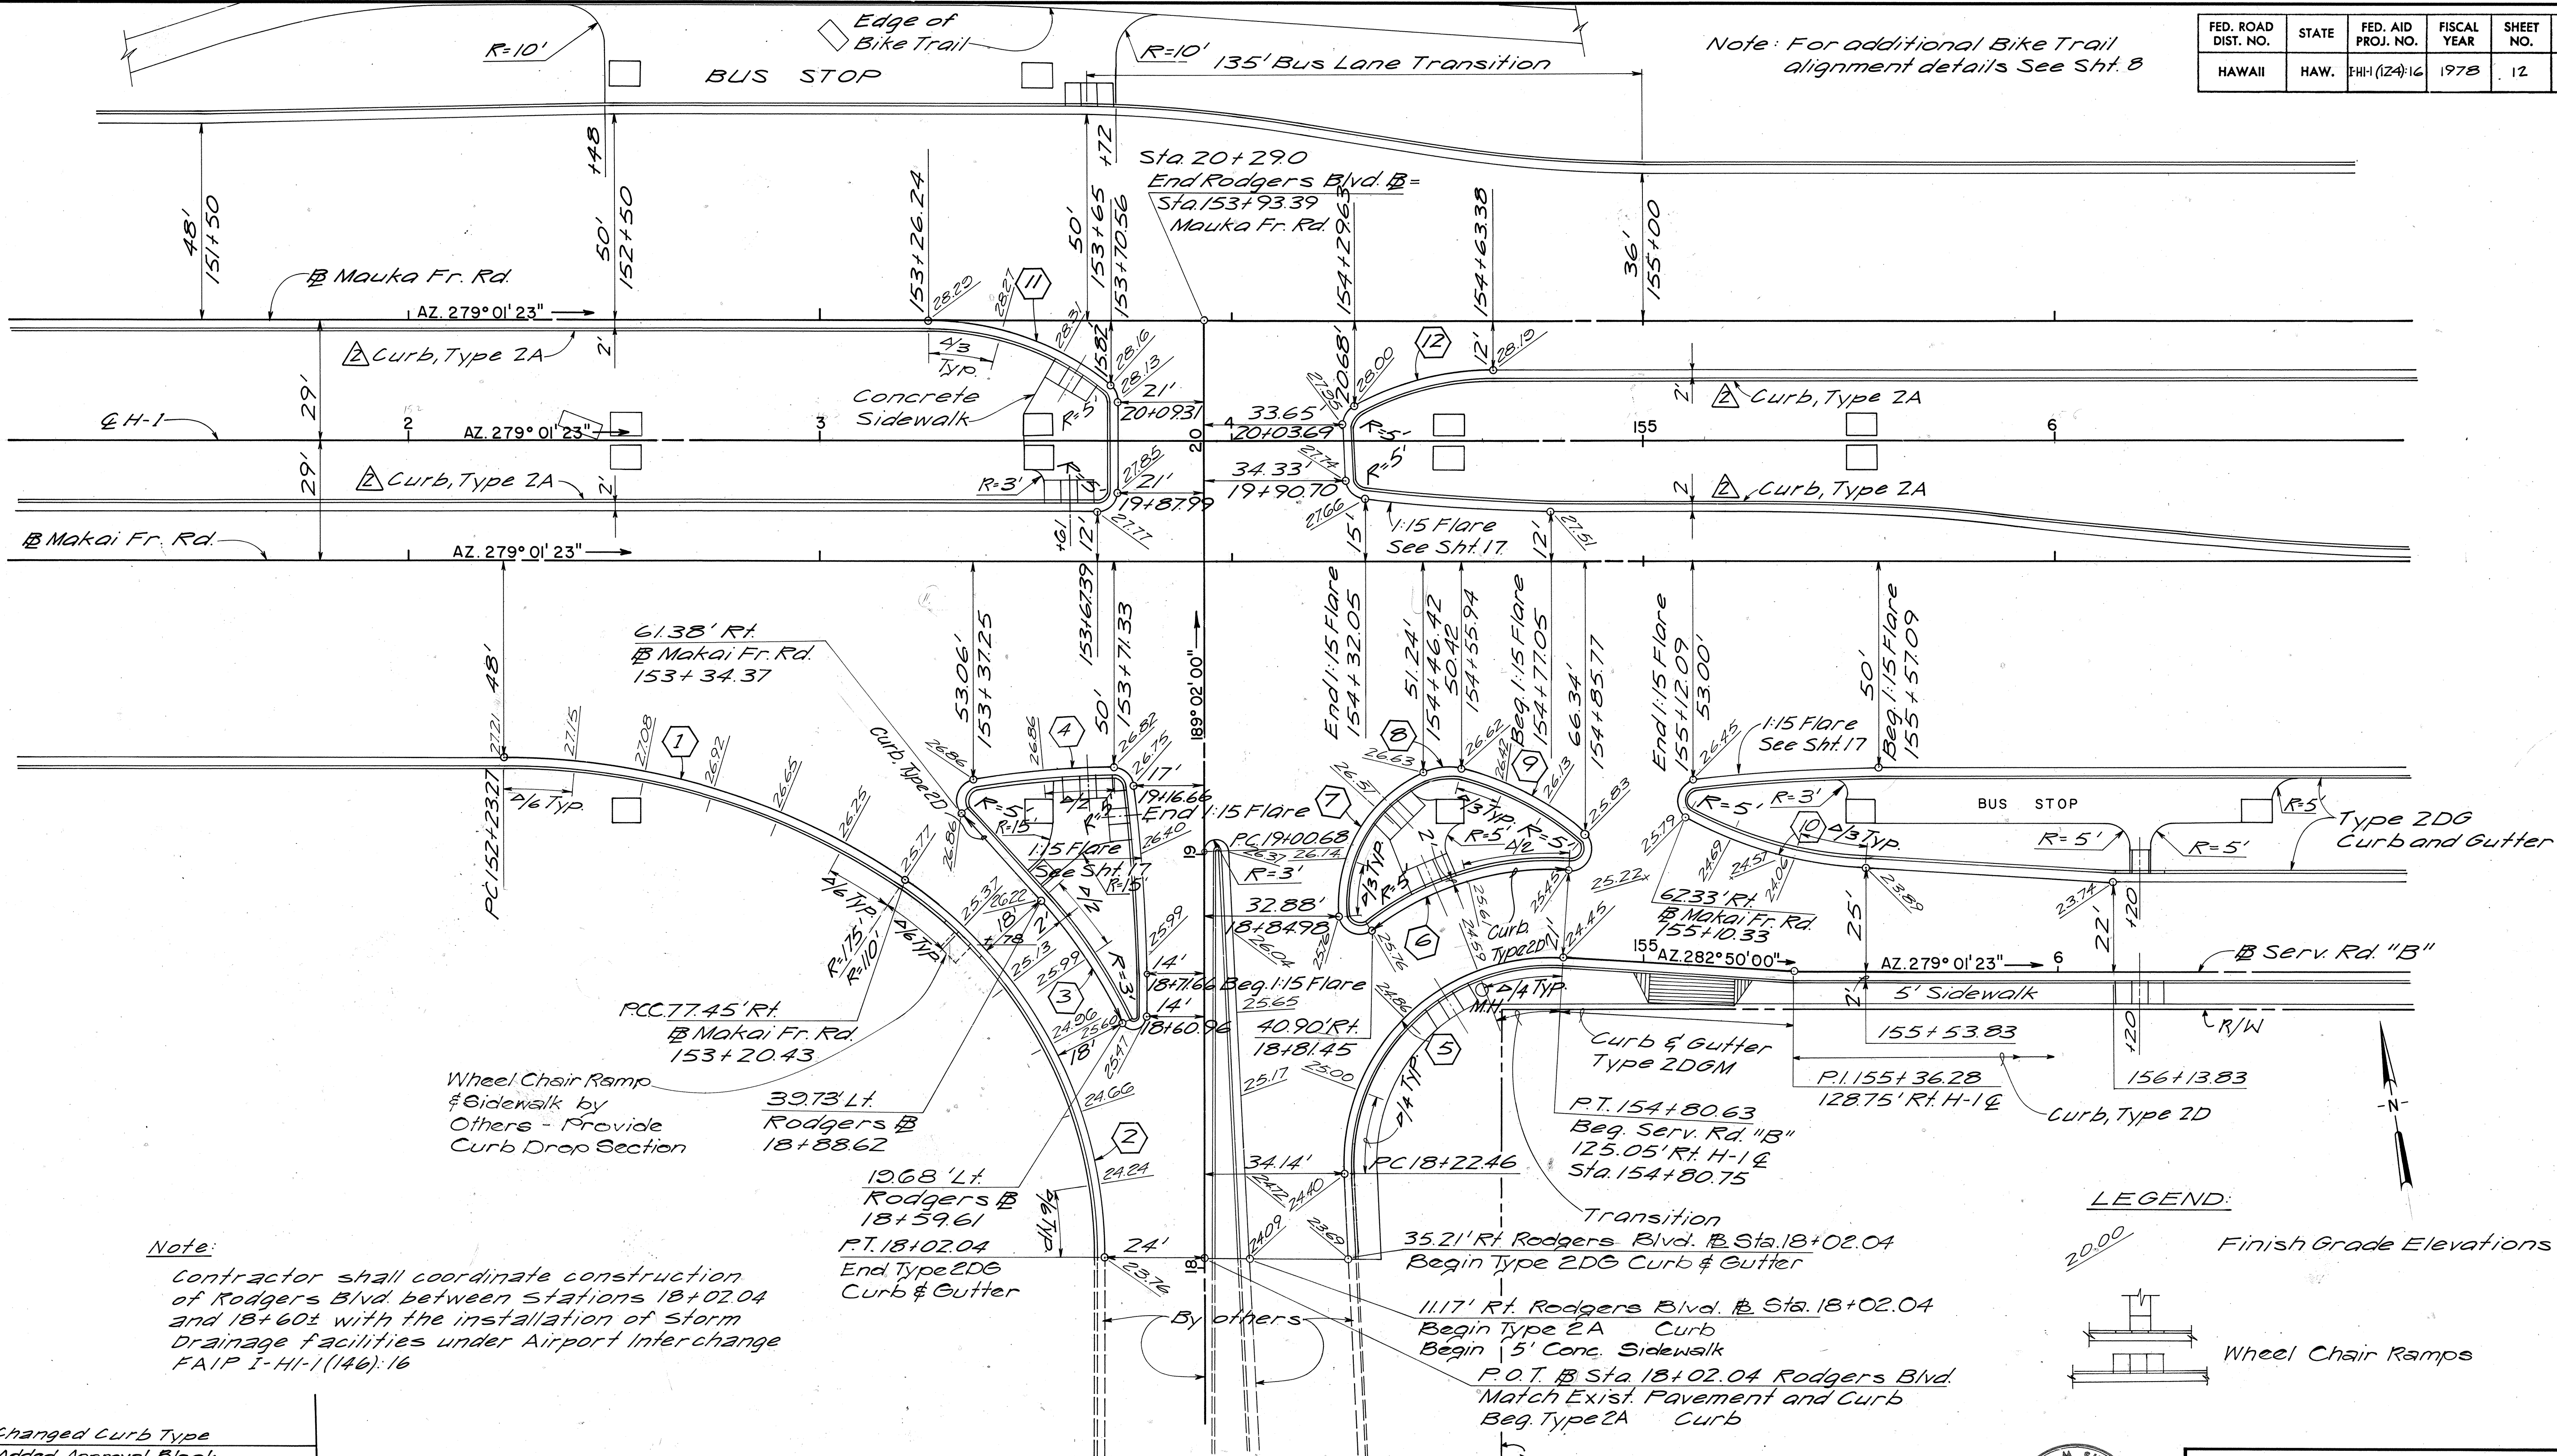


Note:
Contractor shall coordinate construction of Rodgers Blvd between Stations 18+02.04 and 18+60± with the installation of storm drainage facilities under Airport Interchange FAIP I-HI-1(146)-16

NO.	DATE	REVISION
1	4-9-79	Changed Curb Type
2	1-19-79	Added Approval Block Added Right of Way at Rodgers Blvd. Designated Begin 5' Conc. Sidewalk Rt. of Rodgers 18+02.04

	1	2	3	4	5	6	7	8	9	10	11	12
Δ	33° 43' 29"	56° 17' 08"	15° 50' 11"	8° 10' 29"	96° 48' 00"	41° 14' 28"	70° 06' 52"	39° 54' 07"	26° 03' 05"	26° 08' 50"	39° 17' 06"	28° 49' 54"
Δ/2	16° 51' 44.5"	28° 08' 34"	7° 55' 05.5"	4° 05' 14.5"	48° 24' 00"	20° 37' 14"	35° 03' 26"	19° 57' 03.5"	13° 01' 32.5"	13° 04' 25"	19° 38' 33"	14° 24' 57"
R	175.00'	110.00'	128.00'	50.00'	240.00'	71.00'	35.00'	14.00'	75.00'	100.00'	70.00'	70.00'
T	53.04'	58.84'	17.80'	17.15'	56.32'	26.72'	24.56'	5.08'	17.35'	23.22'	24.98'	17.99'
Ch	101.53'	103.77'	35.27'	34.21'	74.78'	50.01'	40.21'	9.55'	33.81'	45.24'	47.06'	34.85'
LC	103.01'	108.06'	35.38'	34.24'	84.47'	51.11'	42.83'	9.75'	34.10'	45.64'	48.00'	35.22'

APPROVED FOR GRADING ONLY:

CHIEF, DIVISION OF ENGINEERING, DPW DATE

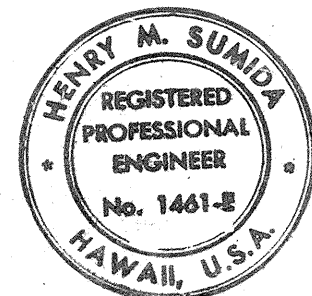

STATE OF HAWAII
DEPARTMENT OF TRANSPORTATION
HIGHWAYS DIVISION

INTERSECTION DETAILS
RODGERS BLVD.
& H-1 STA. 153+93
AIRPORT INTERCHANGE
F.A.I. PROJ. NO. I-HI-1(124)-16

SCALE: 1"=20' DATE: AUG 9, 1977
SHEET No. 6 OF 6 SHEETS