




FED. ROAD DIST. NO.	STATE	FED. AID PROJ. NO.	FISCAL YEAR	SHEET NO.	TOTAL SHEETS
HAWAII	HAW.	I-HI-1(124)16	1978	17	223

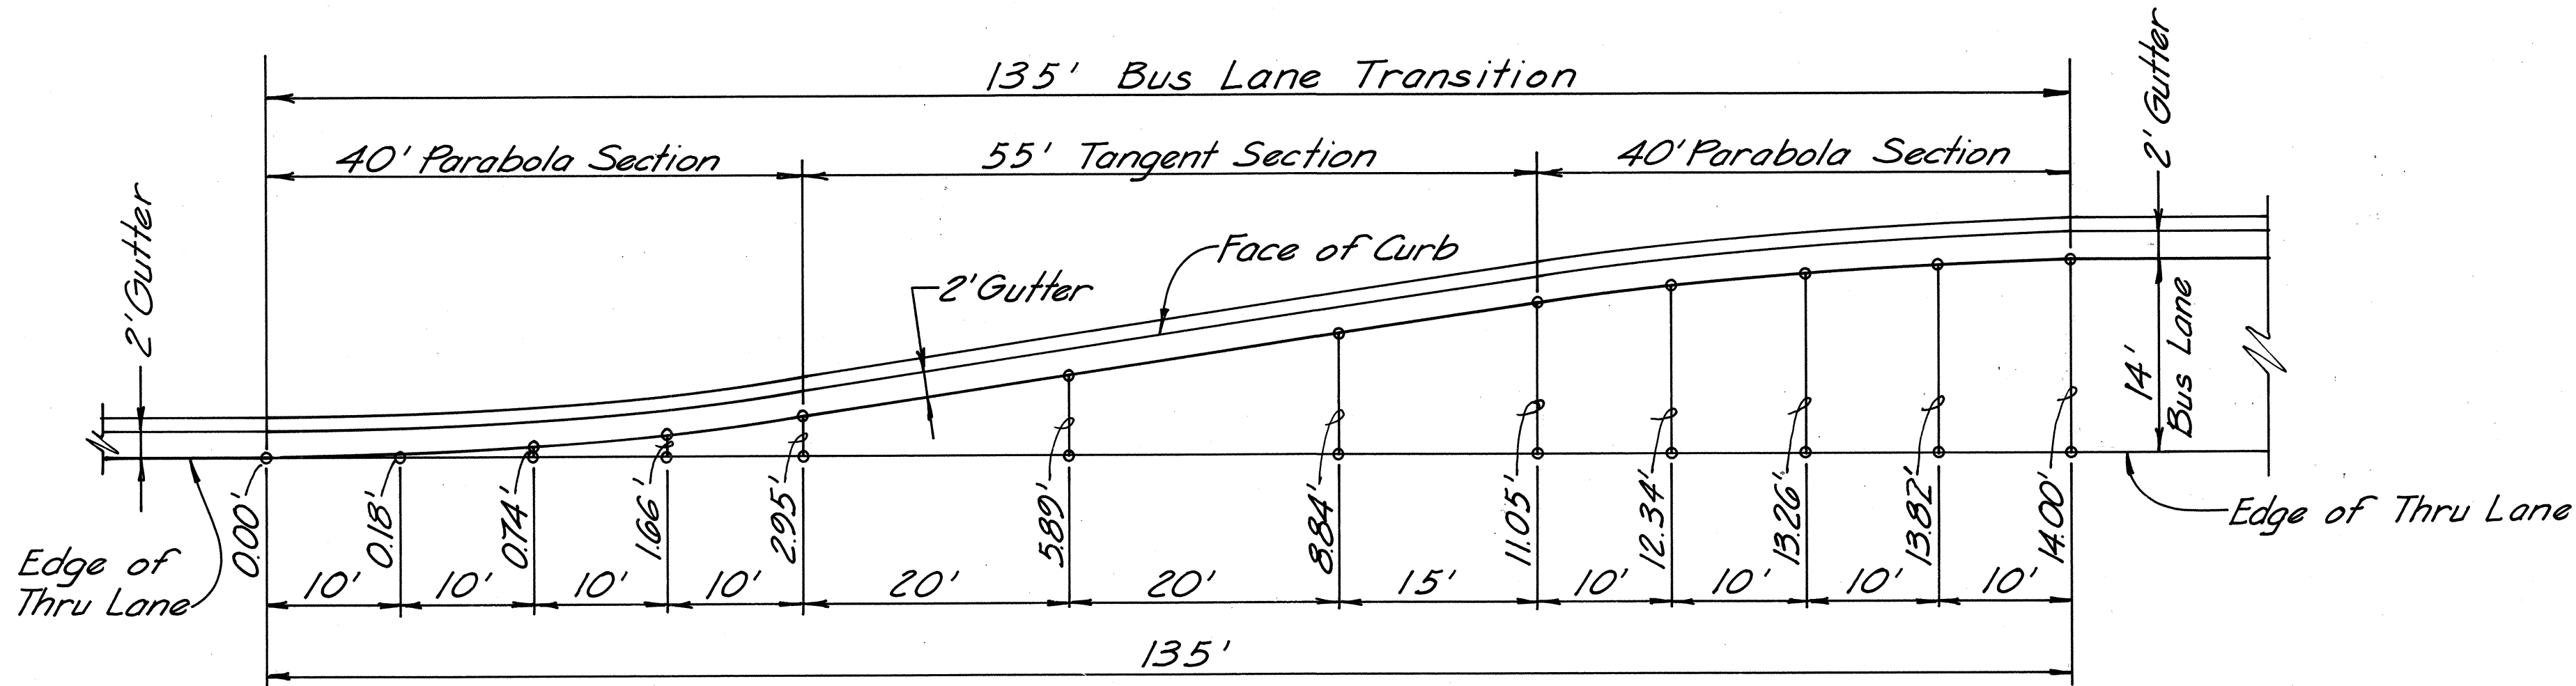

TYPICAL 135' BUS LANE TRANSITION

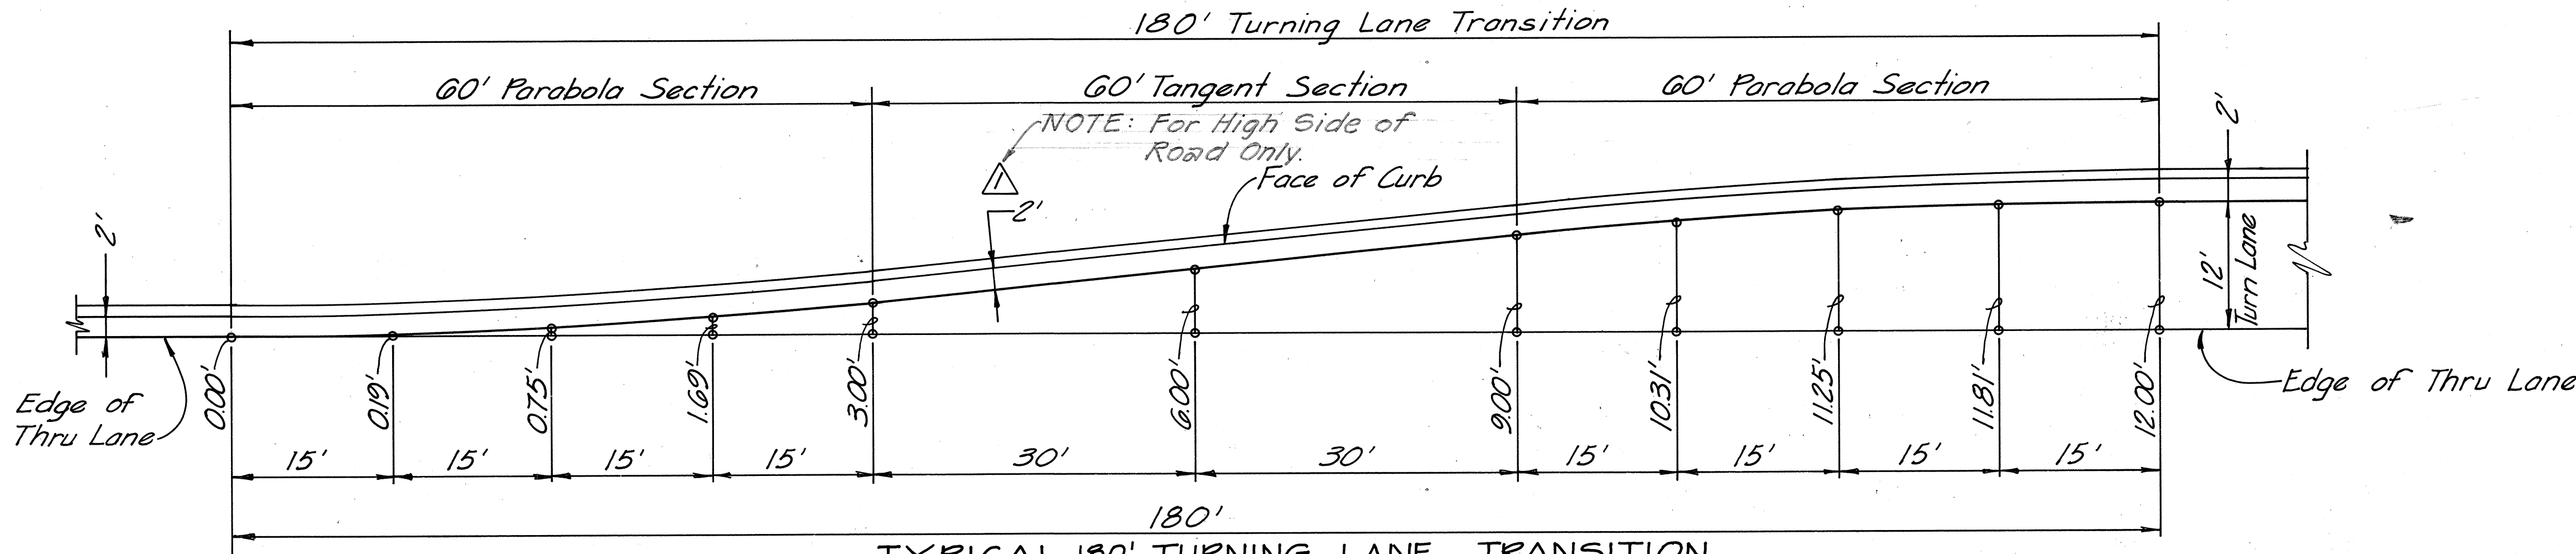

TYPICAL 180' TURNING LANE TRANSITION

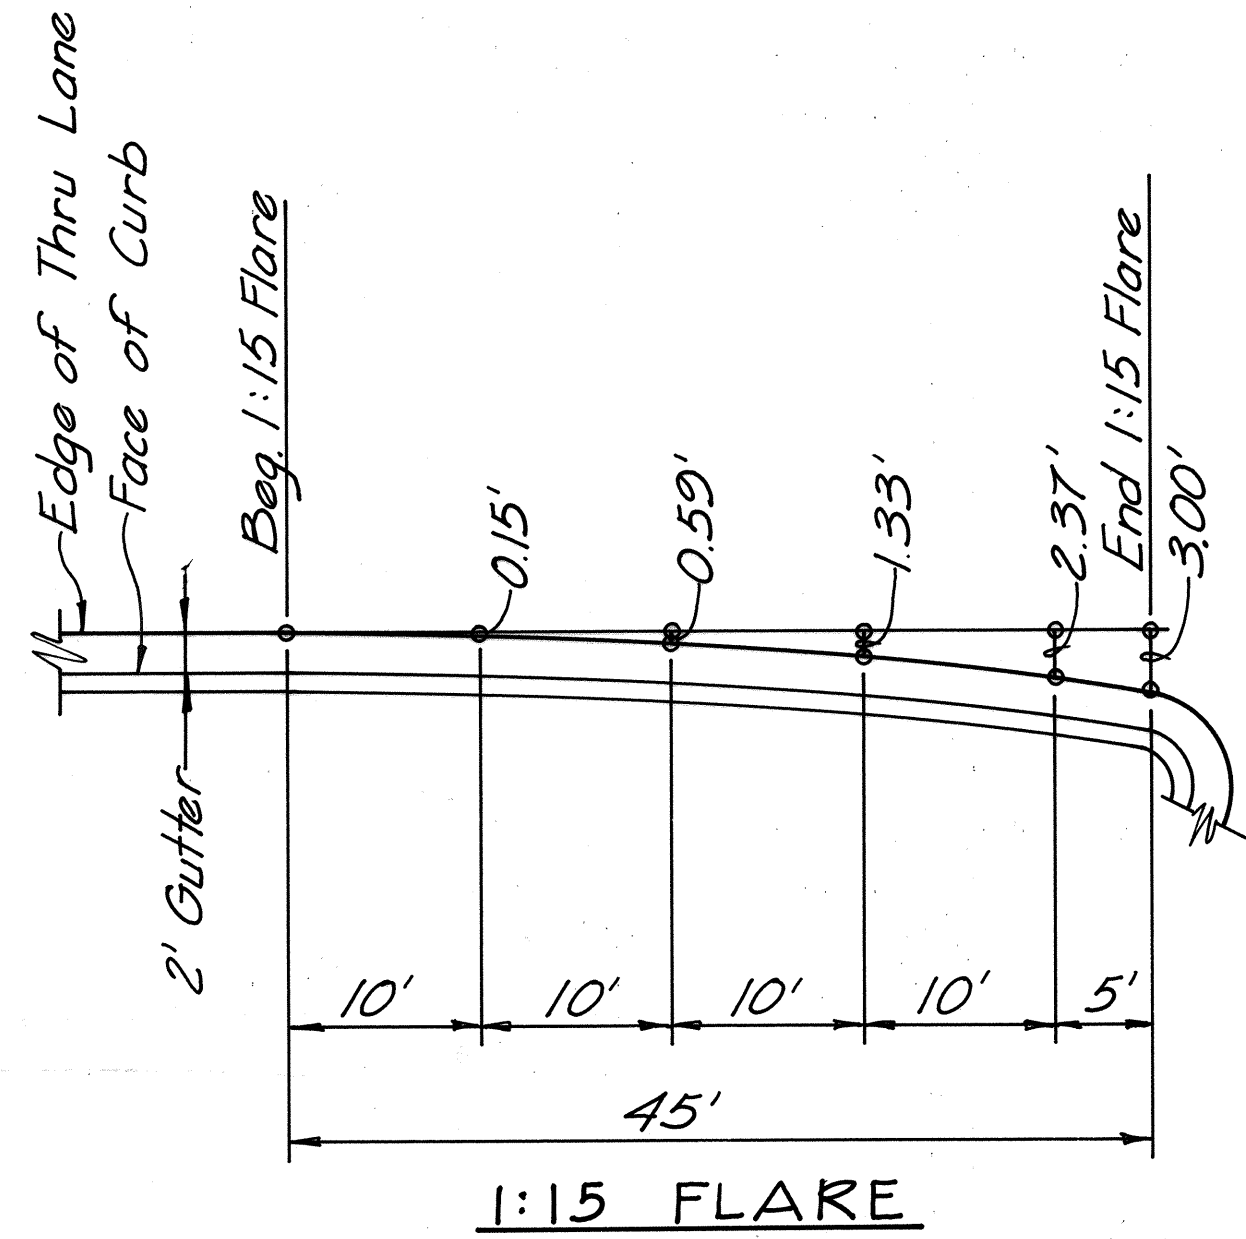


1:15 FLARE

SURVEY PLOTTED BY	DATE
DRAWN BY	
CHECKED BY	
NOTED BY	
QUANTITIES BY	
CHECKED BY	

NO.	DATE	REVISION
1	4-9-79	Deleted Gutter

THIS WORK WAS PREPARED BY ME OR UNDER MY SUPERVISION.

Henry M. Sumida

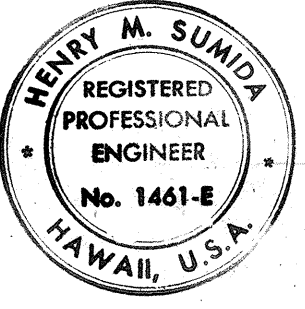

STATE OF HAWAII
DEPARTMENT OF TRANSPORTATION
HIGHWAYS DIVISION

LANE TRANSITIONS

AIRPORT INTERCHANGE
F.A.I. PROJ. NO. I-HI-1(124)16

SCALE: 1" = 10' DATE: AUG. 9, 1977

SHEET No. / OF / SHEETS