

FED. ROAD DIST. NO.	STATE	FED. AID PROJ. NO.	FISCAL YEAR	SHEET NO.	TOTAL SHEETS
HAWAII	HAW.	I-HI-1(124)16	1978	13	223

	1	2	3
Δ	2°52'23"	1°57'03"	33°54'01"
$\Delta/2$	1°26'11.5"	0°58'31.5"	16°57'0.5"
R	2000.00'	2018.00'	180.00'
T	50.15'	34.36'	54.86'
Ch	100.27'	68.71'	104.95'
Lc	100.28'	68.71'	106.50'

	4	5	6
Δ	31°33'53"	90°00'00"	92°51'45"
$\Delta/2$	15°46'56.5"	45°00'00"	46°25'52.5"
R	150.00'	55.00'	76.00'
T	42.40'	55.00'	79.90'
Ch	81.60'	77.78'	110.13'
Lc	82.64'	86.39'	123.18'

	7	8	9	10
Δ	68°08'47"	65°16'25"	29°53'33"	61°16'11"
$\Delta/2$	34°04'23.5"	32°38'12.5"	14°56'46.5"	30°38'05.5"
R	75.00'	50.00'	55.00'	50.00'
T	50.73'	32.02'	14.68'	29.61'
Ch	84.04'	53.93'	28.37'	50.96'
Lc	89.20'	56.96'	28.69'	53.47'

DATE	
DESIGNED BY	
TRACED BY	
QUANTITIES BY	
CHECKED BY	
NO.	

NO.	DATE	REVISION
4-6-79		Changed Curb Type
1-19-79		Added Approval Block

APPROVED FOR GRADING ONLY:


CHIEF, DIVISION OF ENGINEERING, DPW DATE 7/9/79

LEGEND

Finish Grade Elevations

Drainage Flowline

See Sht. 18 for Detail

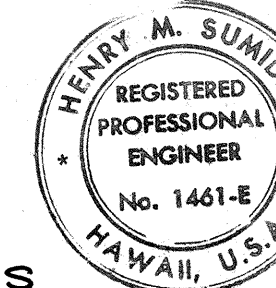

STATE OF HAWAII
DEPARTMENT OF TRANSPORTATION
HIGHWAYS DIVISION

SERVICE RD. A


AIRPORT INTERCHANGE
F.A.I. PROJ. NO. I-HI-1(124)16

SCALE: 1"=20' DATE: AUG. 9, 1977


SHEET No. 1 OF 2 SHEETS

CO13

FED. ROAD DIST. NO.	STATE	FED. AID PROJ. NO.	FISCAL YEAR	SHEET NO.	TOTAL SHEETS
HAWAII	HAW.	11-1(124):16	1978	14	223

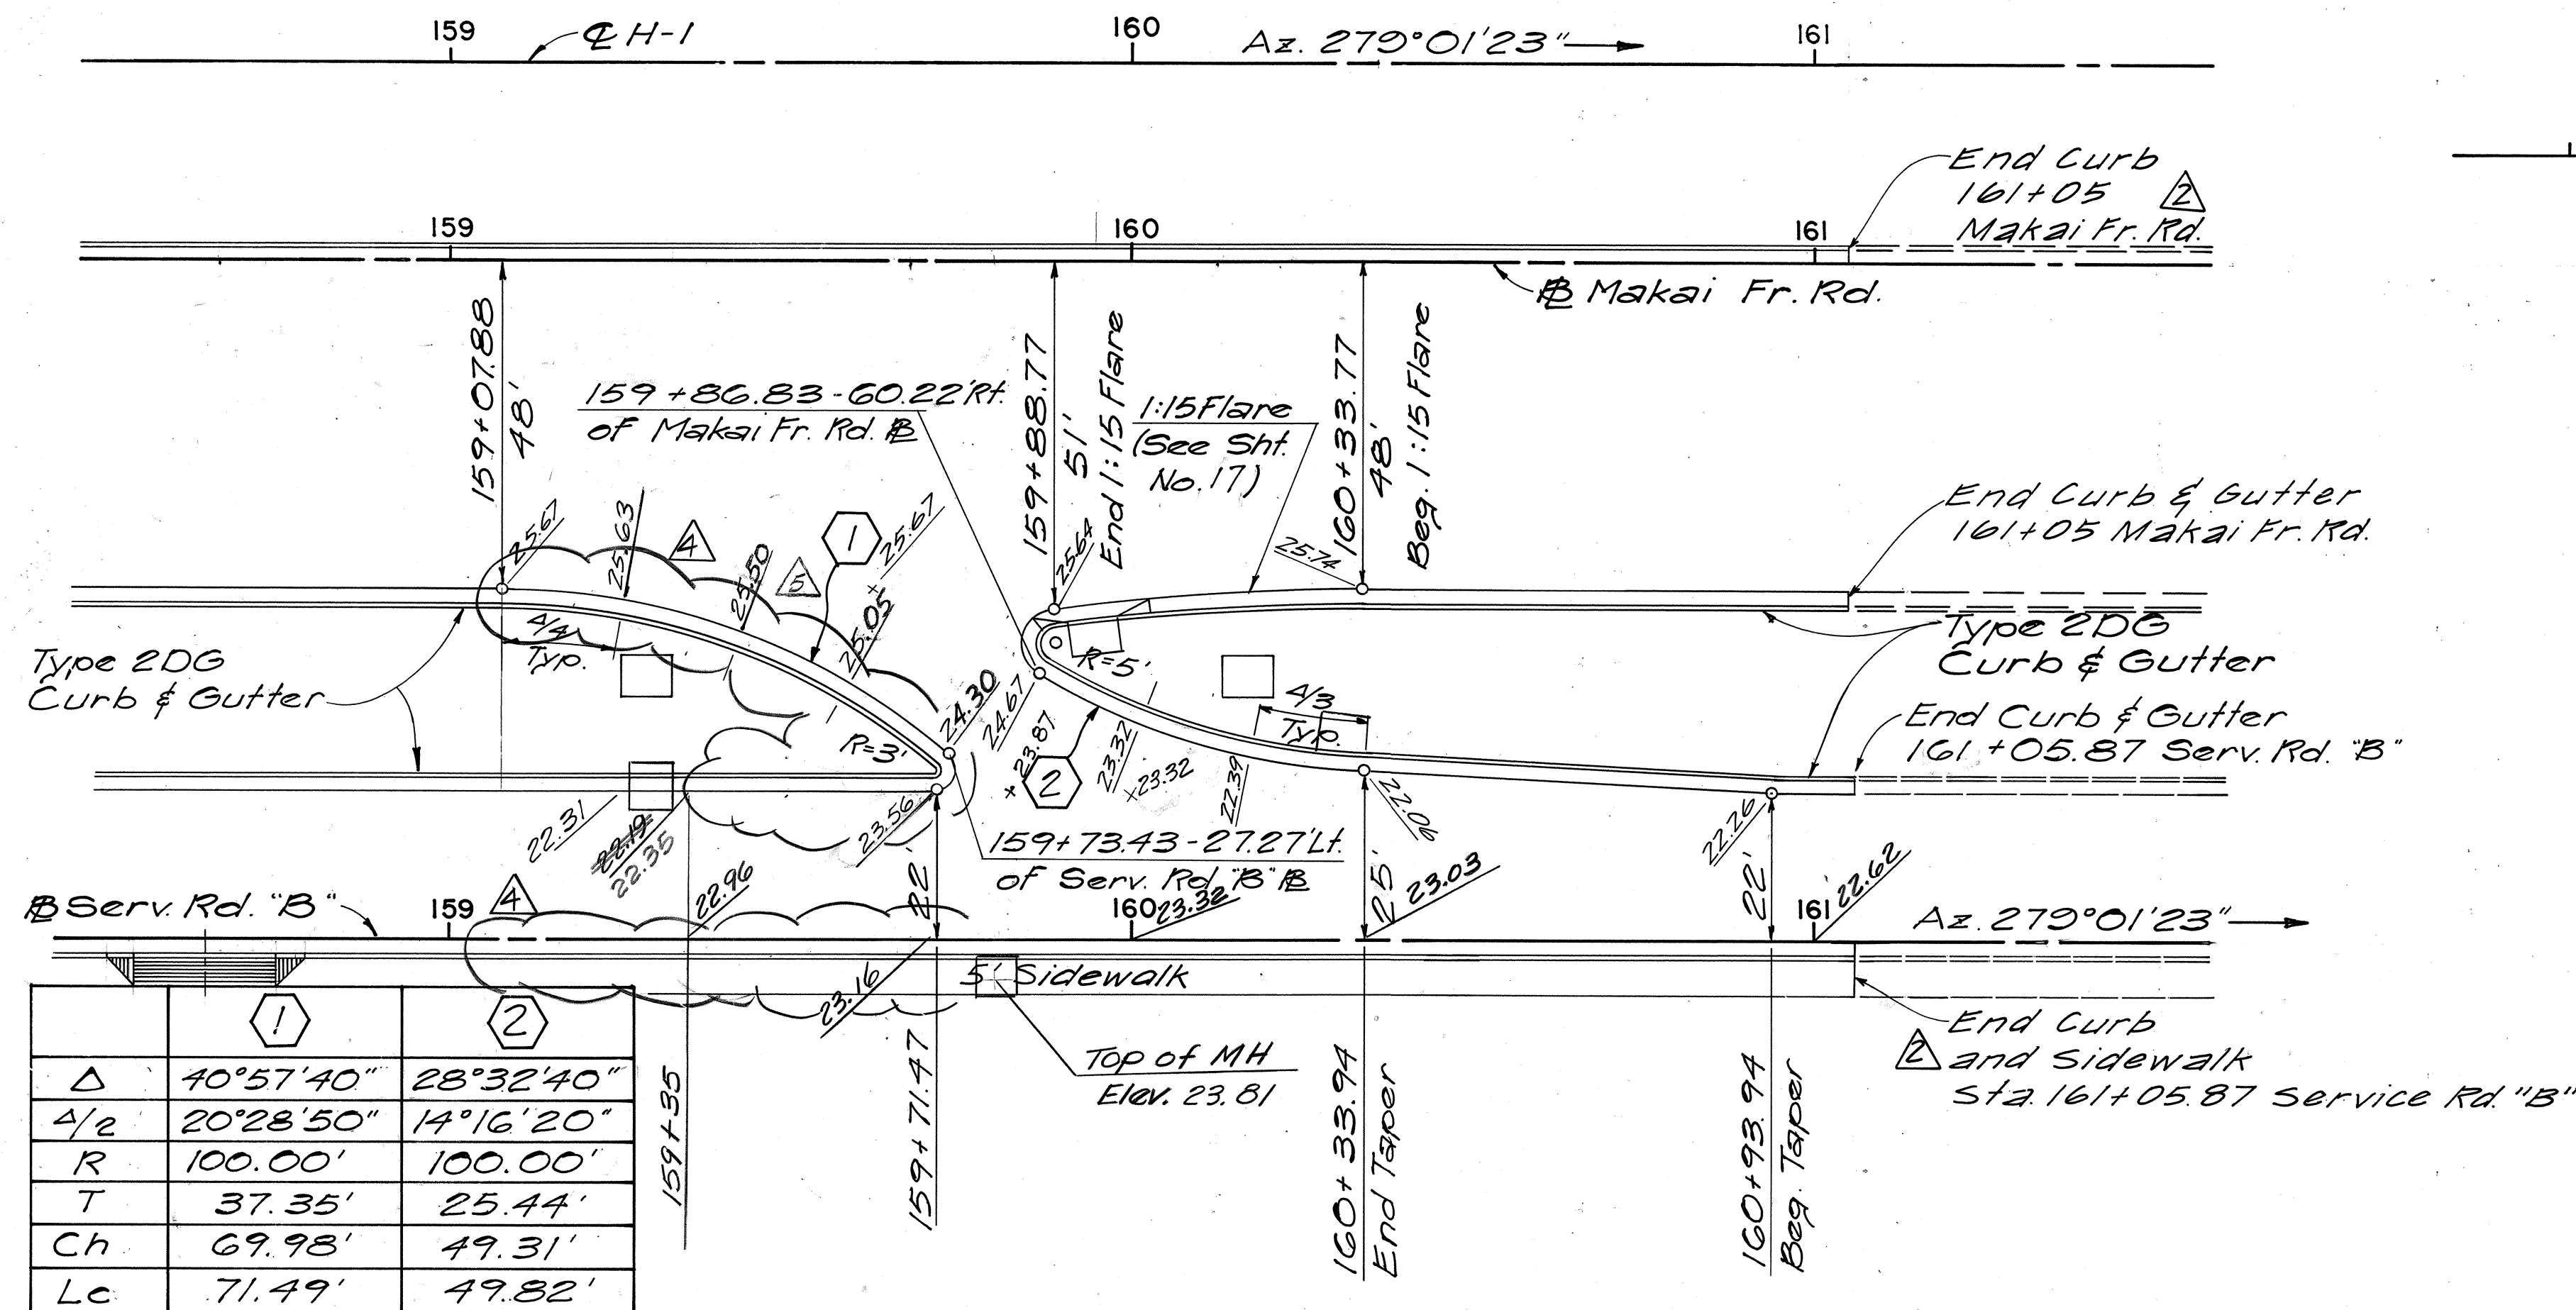


SLIP RAMP STA 160+00
Scale: 1"=20'

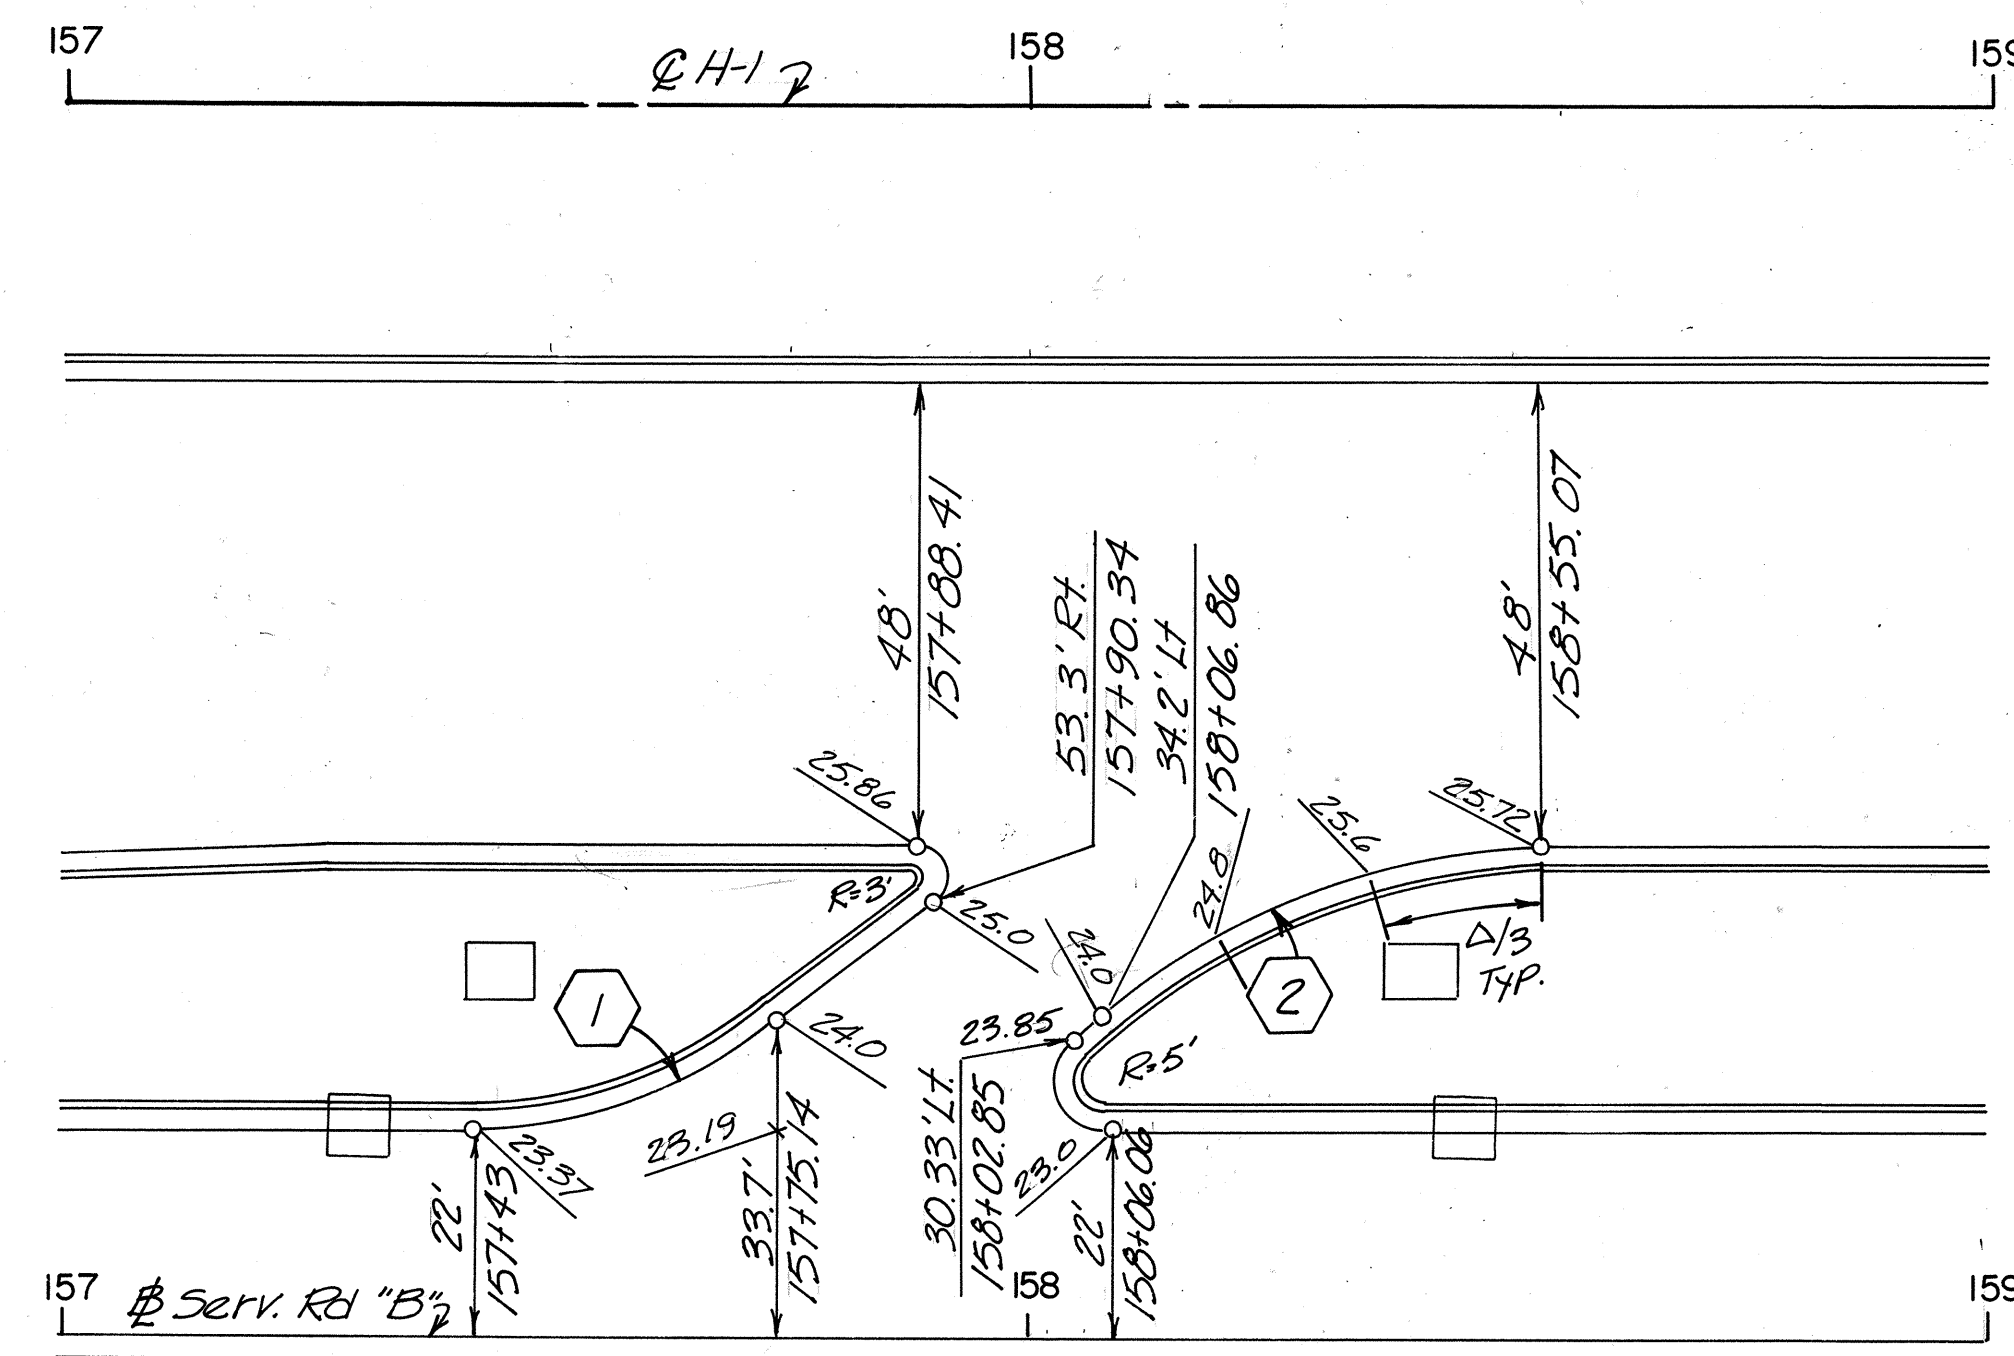


SLIP RAMP STA 158+00
Scale: 1"=20'

	①	②
Δ	40°00'00"	40°00'00"
Δ/2	20°00'00"	20°00'00"
R	50.00'	75.00'
T	18.20'	27.30'
Ch	34.20'	51.30'
Lc	34.91'	52.36'

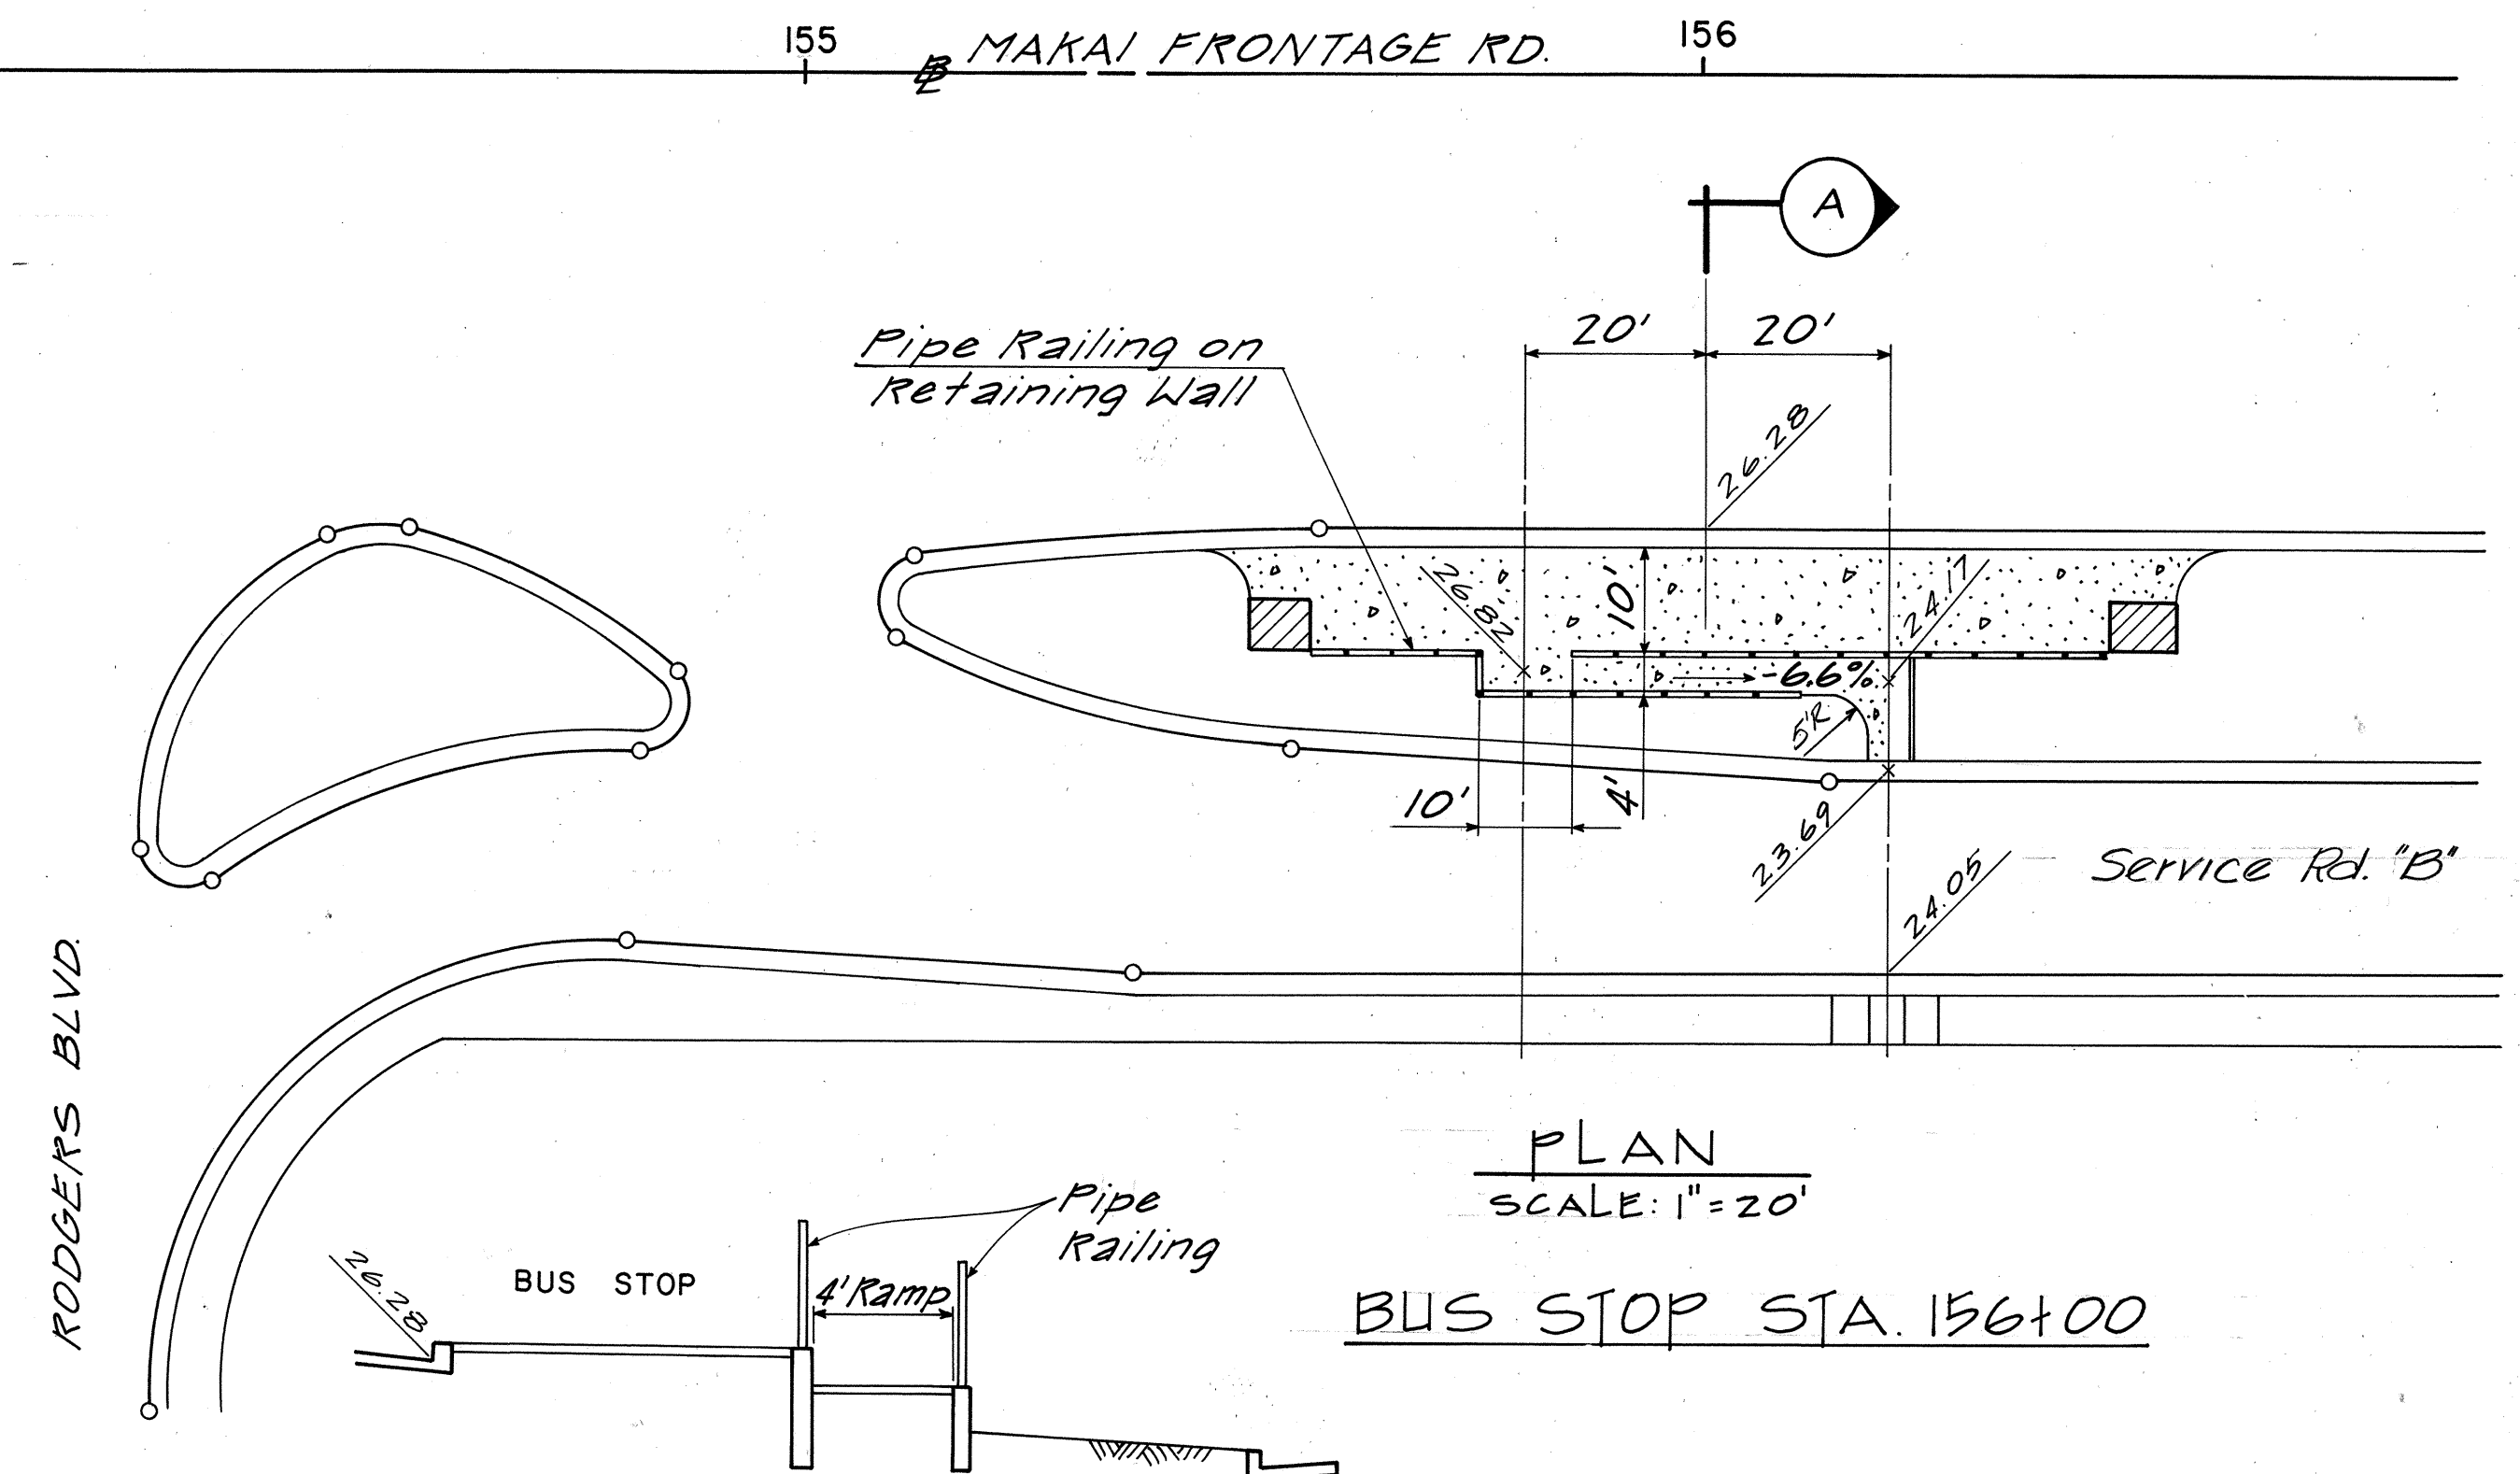


SECTION A

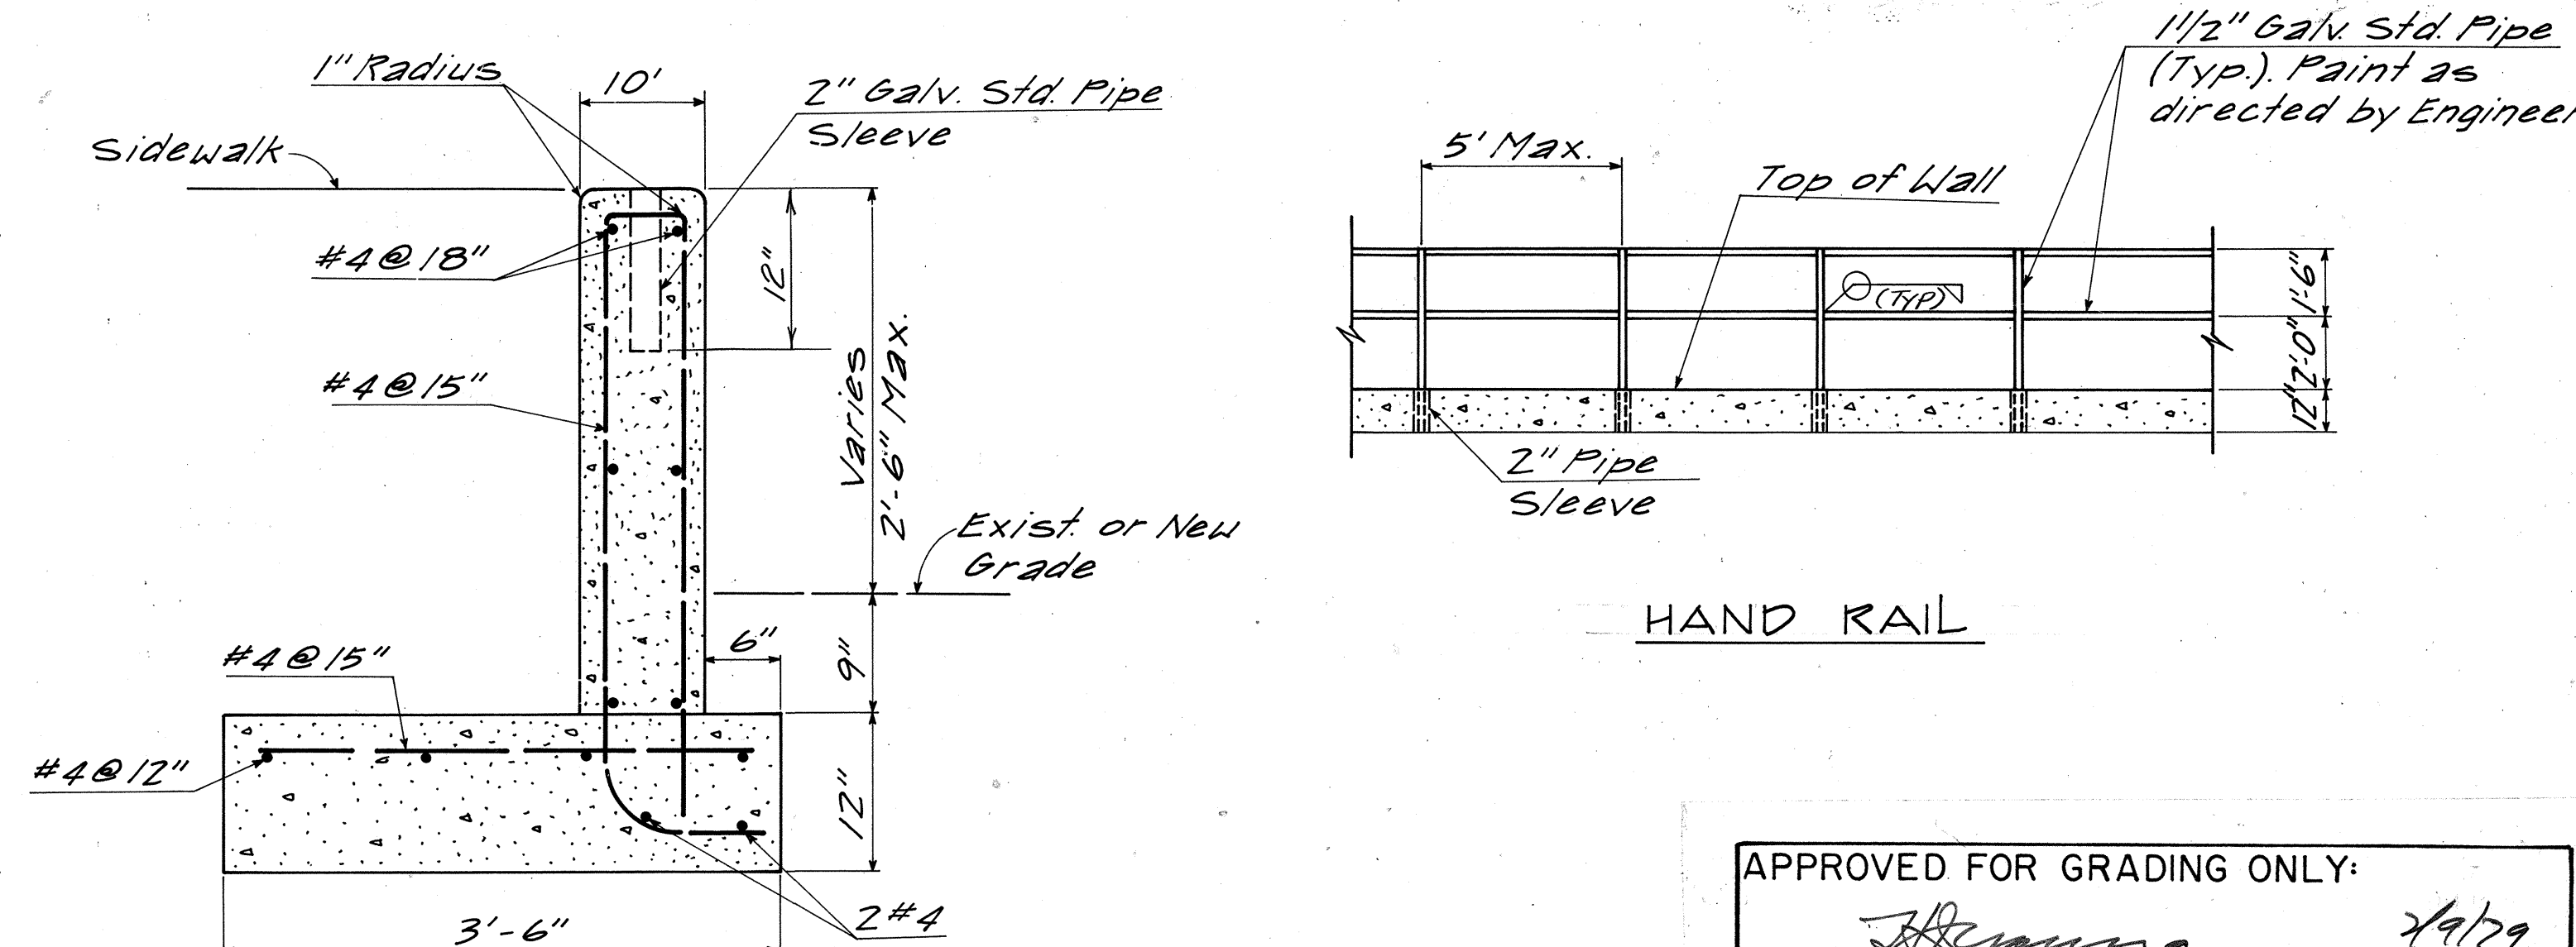

HAND RAIL

NO.	DATE	REVISION
6	9-5-80	Added Slip Ramp at Sta 158+00 Rt.
5	3-28-80	Revised Elev. @ Curve ①
4	3-20-80	Revise Curb & Service Rd. B Grade @ Slip Ramp
3	3-7-80	Added Bus Stop Sta 156+00 and Details.
2	4-9-79	Changed Curb Type
1	1-19-79	Added Approval Block

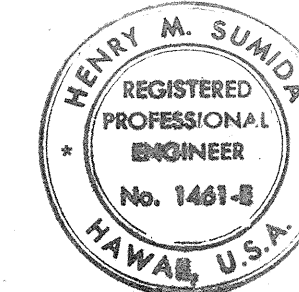

THIS WORK WAS PREPARED BY ME OR UNDER MY SUPERVISION.
Henry M. Sumida

APPROVED FOR GRADING ONLY:
Henry M. Sumida
 CHIEF, DIVISION OF ENGINEERING, DPW DATE
 STATE OF HAWAII
 DEPARTMENT OF TRANSPORTATION
 HIGHWAYS DIVISION
 SERVICE ROAD "B"
 AIRPORT INTERCHANGE
 F.A.I. PROJ. NO. I-HI-1(124):16
 SCALE: AS SHOWN DATE: AUG. 9, 1977
 SHEET No. 1 OF 2 SHEETS