


LEGEND

Note:
See Sheet 2 for
Construction Phasing
of Detours.


NOTES:

1. The Contractor shall provide clearance through the falsework for Airport traffic at all times. Clearance dimensions are 13'-6" height & 2'-0" on each side for Rodgers Blvd. Detours & Adelle St.
2. The Contractor shall maintain the AC Walkways, Clearing Weeds along edges and providing night lighting over walkways through falsework
3. The Contractor shall maintain 2 inbound & 2 outbound lanes at all times
4. The Contractor shall submit to the Engineer for approval a Traffic Control Plan for each detour change. The Traffic Control Plan shall be in full accordance w/ FHPM 6-4-2-12.
5. Profile for Detour 2A shall match finished grade for Parking lot Paving. See Sheet No 44. Use Paving Section

(D)
3

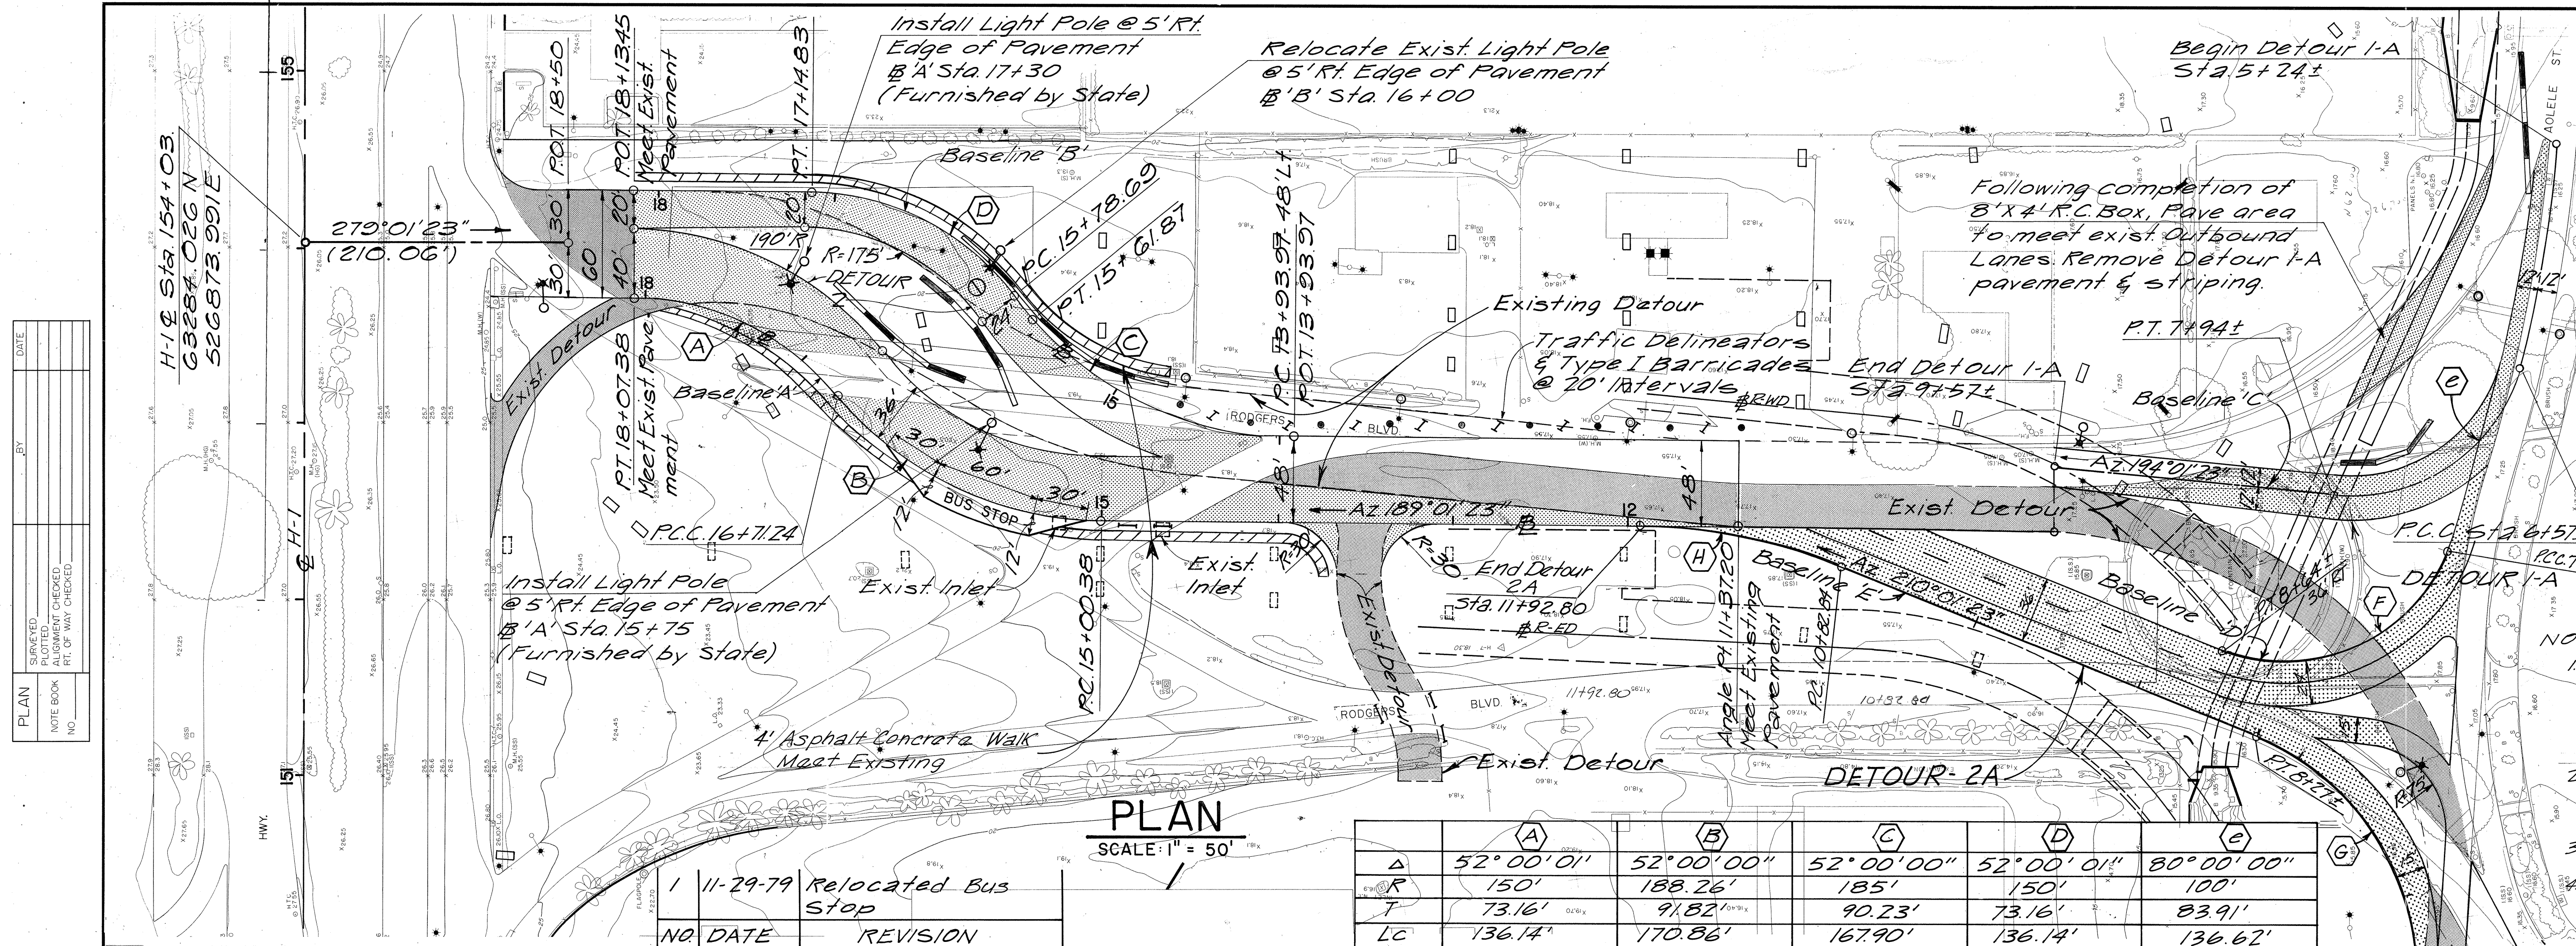

	(A)	(B)	(C)	(D)	(e)
Δ	52° 00' 01"	52° 00' 00"	52° 00' 00"	52° 00' 01"	80° 00' 00"
R	150'	188.26'	185'	150'	100'
T	73.16'	91.82' $\pm 0.9\%$	90.23'	73.16'	83.91'
Lc	136.14'	170.86'	167.90'	136.14'	136.62'
	(F)	(G)	(H)		
Δ	90° 00' 00"	78° 00' 00"	21° 00' 00"		
R	100'	150'	300'		
T	100'	121.47'	55.60'		
Lc	157.08'	204.20'	109.96'		

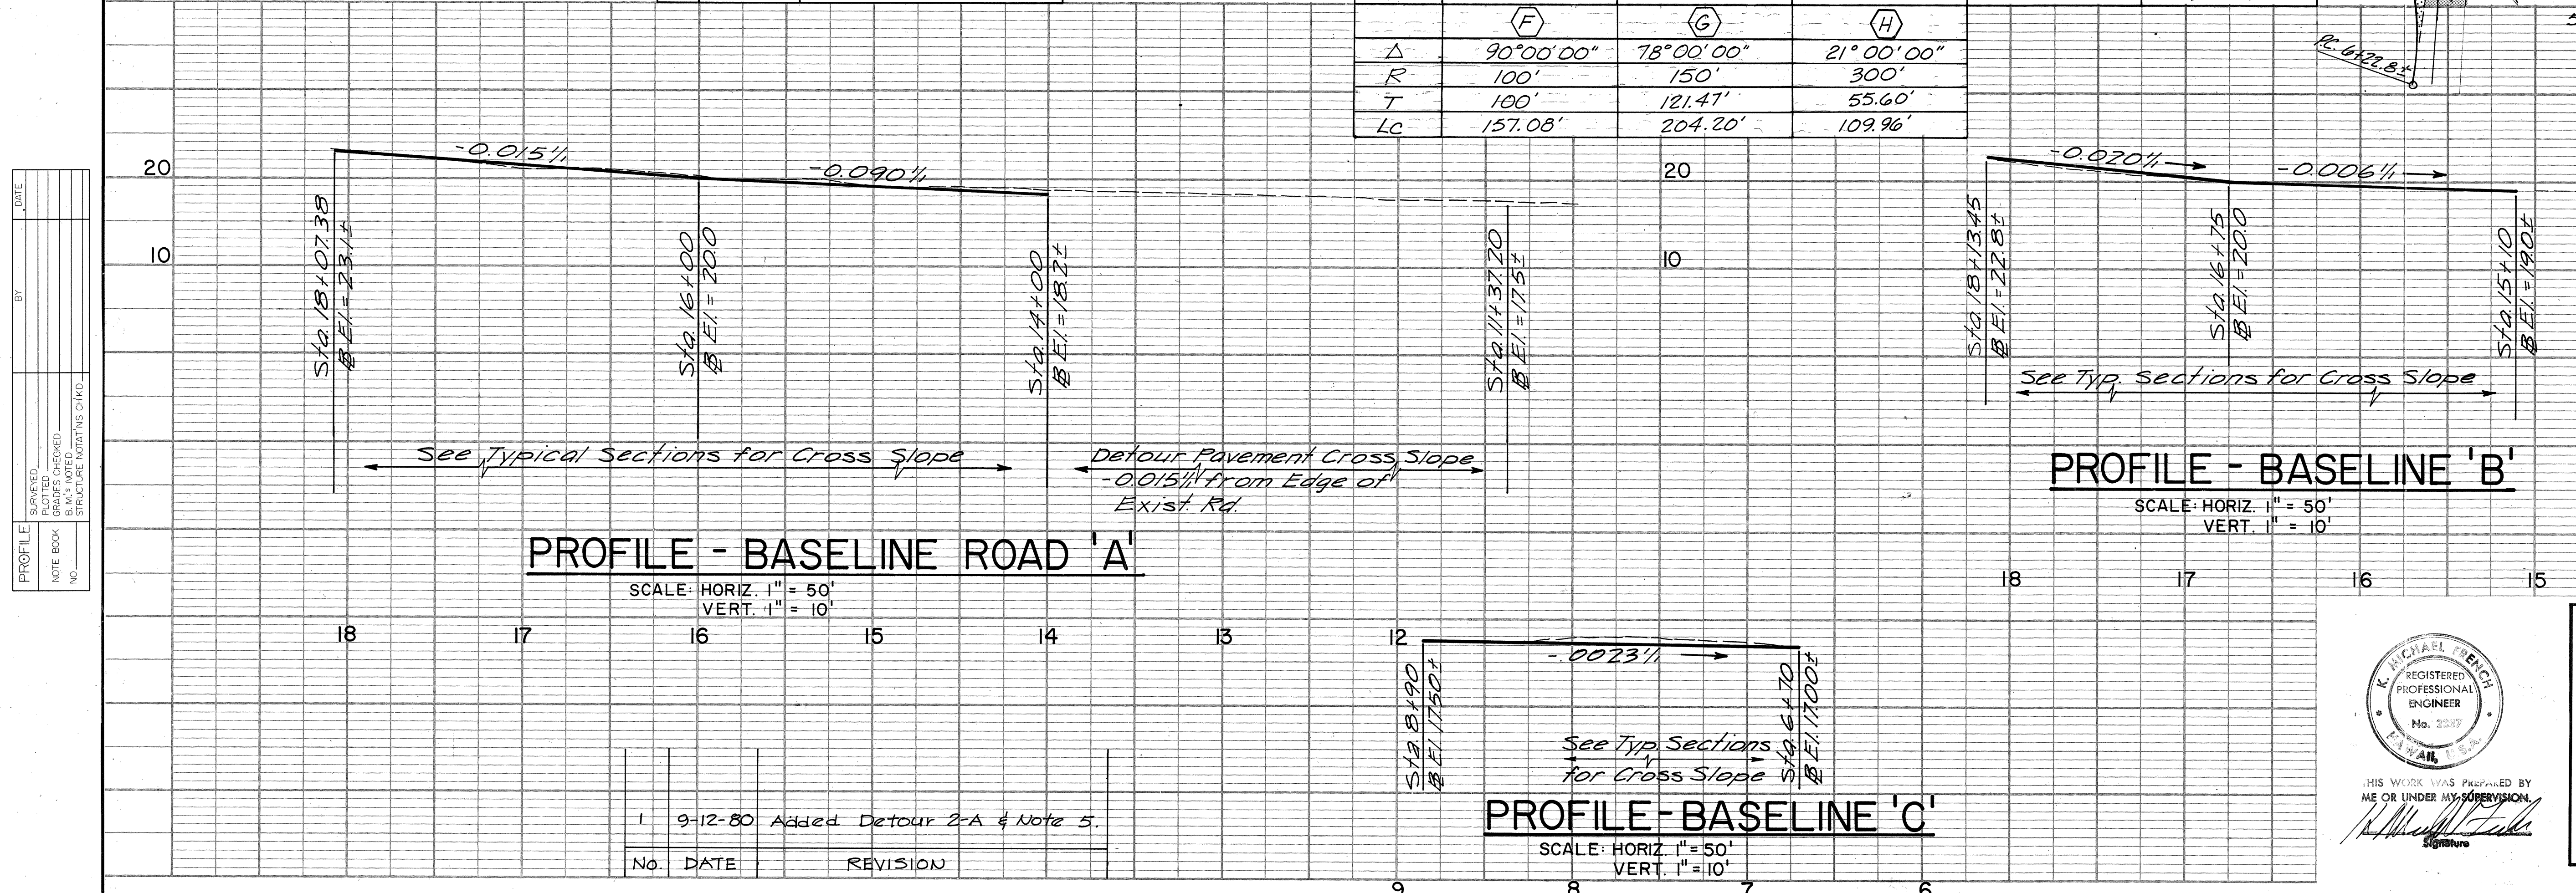

STATE OF HAWAII
DEPARTMENT OF TRANSPORTATION
HIGHWAYS DIVISION

RODGERS BLVD. DETOUR

AIRPORT INTERCHANGE
F.A.I. PROJ. NO. I-HI-1 (146):16

SCALE: AS SHOWN DATE: JUNE 1, 1979



SHEET No. 1 OF 1 SHEETS

CO ADD30

FED. ROAD DIST. NO.	STATE	FED. AID PROJ. NO.	FISCAL YEAR	SHEET NO.	TOTAL SHEETS
HAWAII	HAW.	IHI-1(146)-16	1978	31	283

NOTES:

1. Relocation of Light Poles included in item 622.0750
2. The conc. bases from the relocated Light Post shall be removed and disposed of by the contractor.

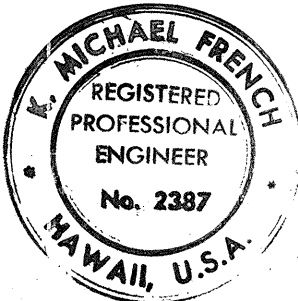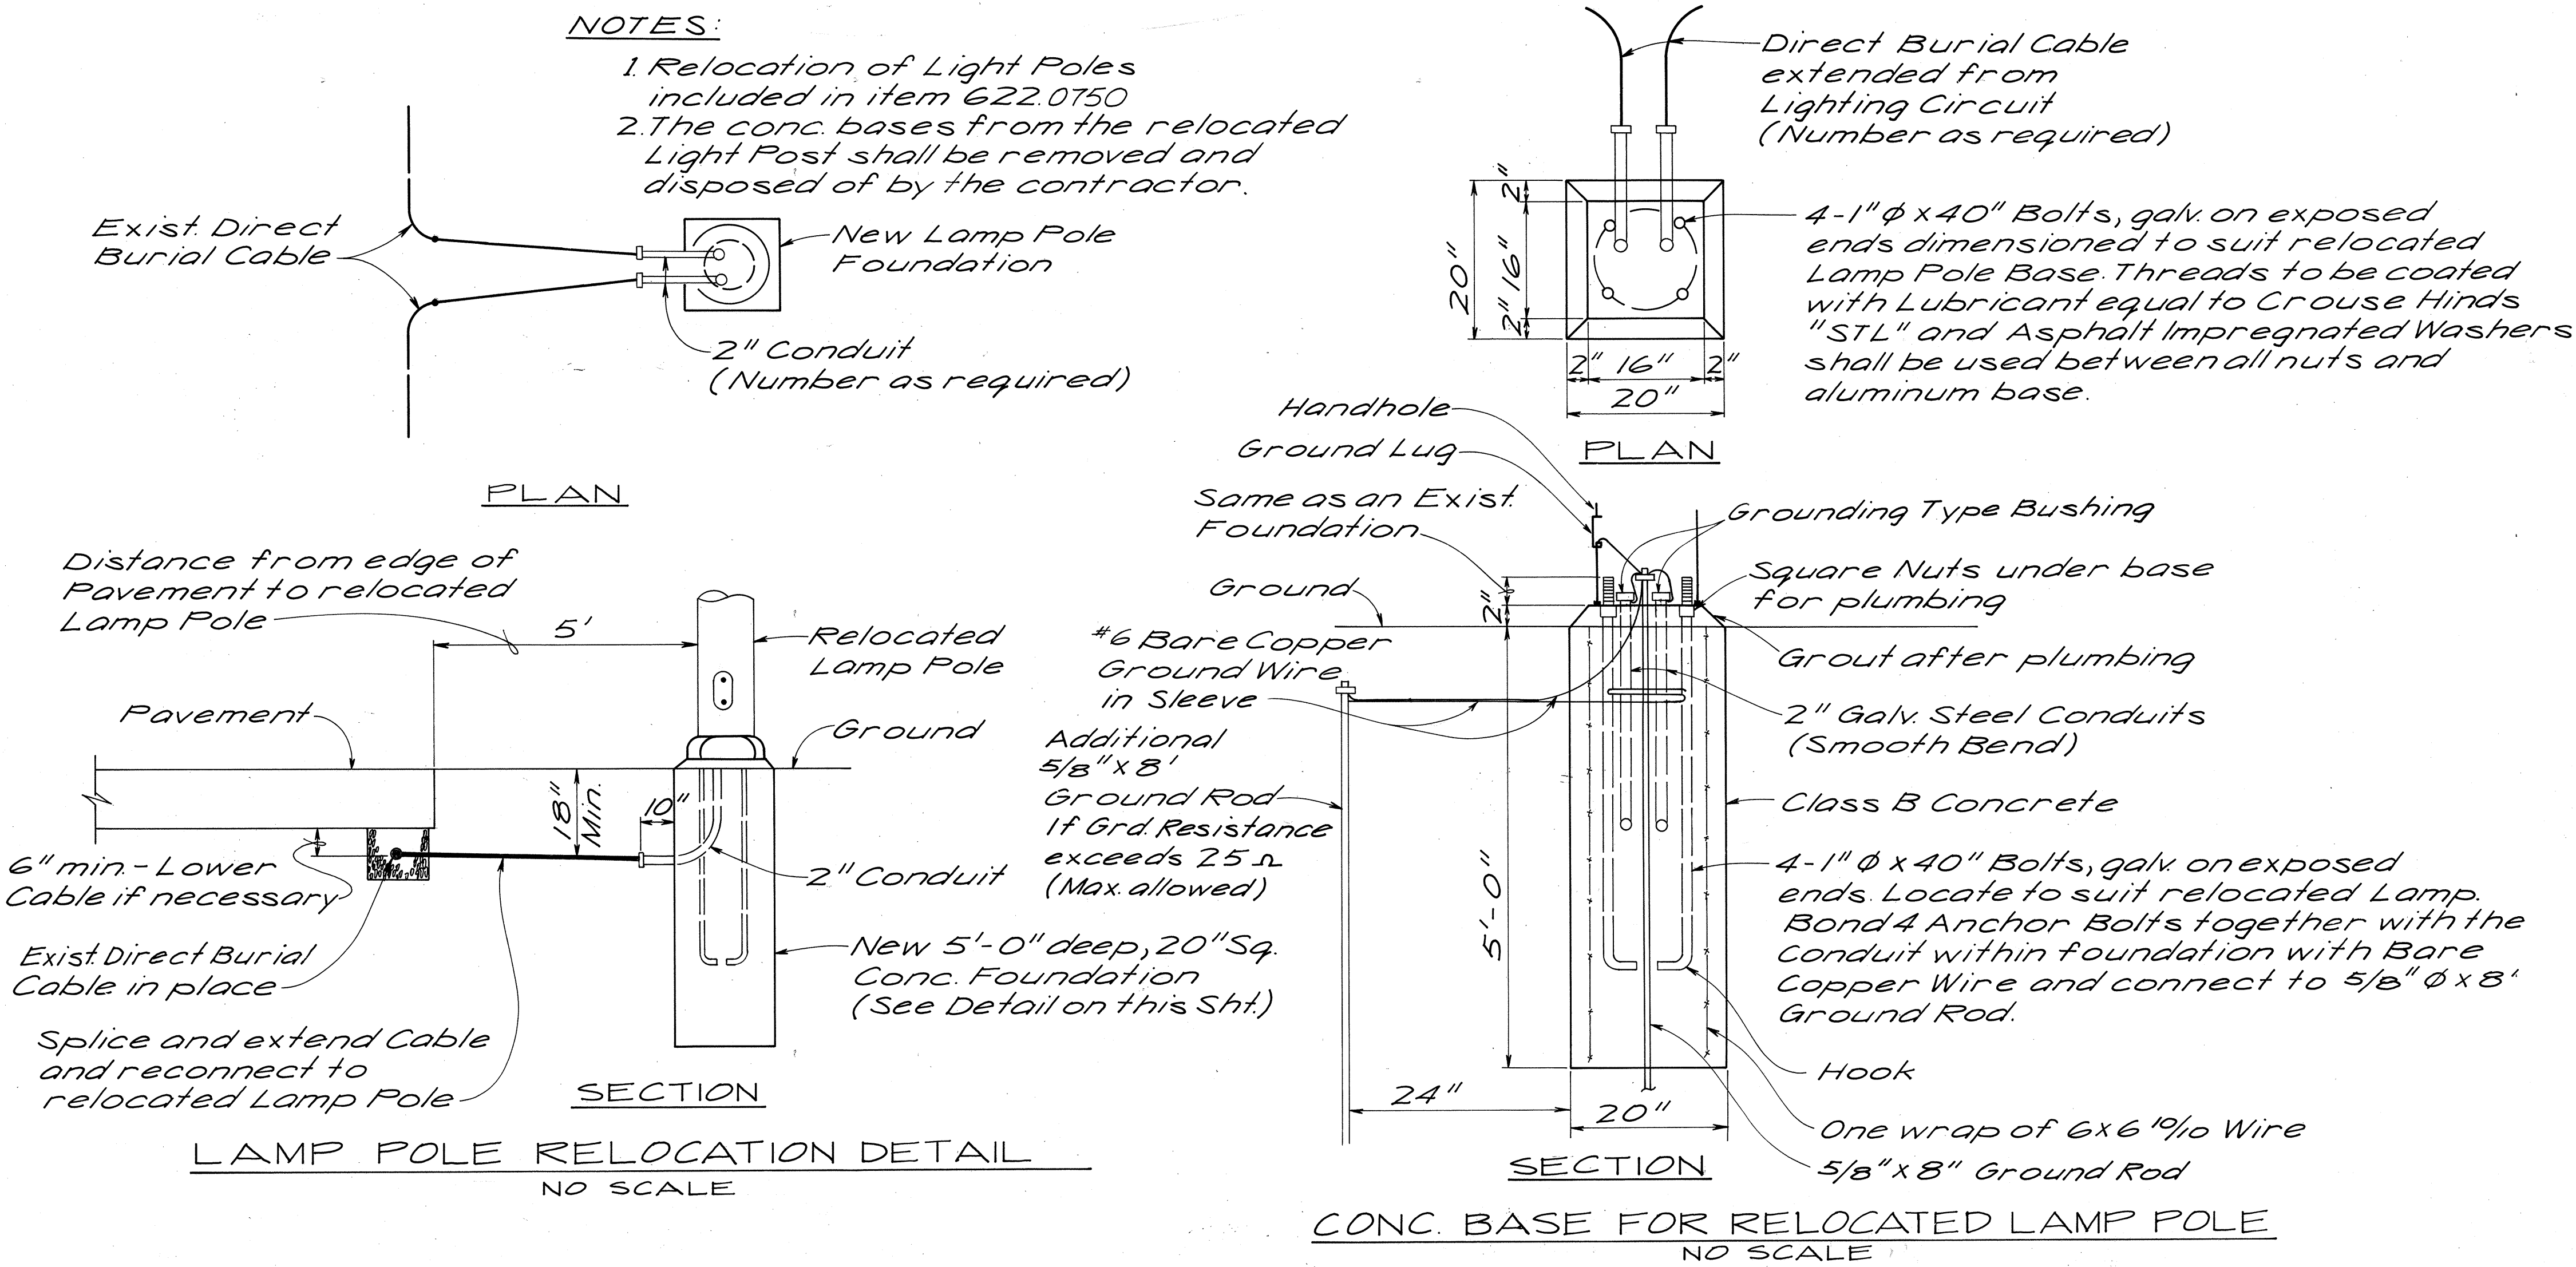

THIS WORK WAS PREPARED BY
ME OR UNDER MY SUPERVISION.
Signature

STATE OF HAWAII
DEPARTMENT OF TRANSPORTATION
HIGHWAYS DIVISION

RODGERS BLVD DETOUR
LIGHT POLE RELOCATION

AIRPORT INTERCHANGE
F.A. I. PROJ. NO. I-HI-1(146)-16

SCALE: AS SHOWN DATE: JUNE 1, 1979
SHEET No. 1 OF 1 SHEETS