


| FED. ROAD DIST. NO. | STATE | FED. AID PROJ. NO. | FISCAL YEAR | SHEET NO. | TOTAL SHEETS |
|---------------------|-------|--------------------|-------------|-----------|--------------|
| HAWAII              | HAW.  | HI-1(146)-16       | 1979        | 41        | 283          |

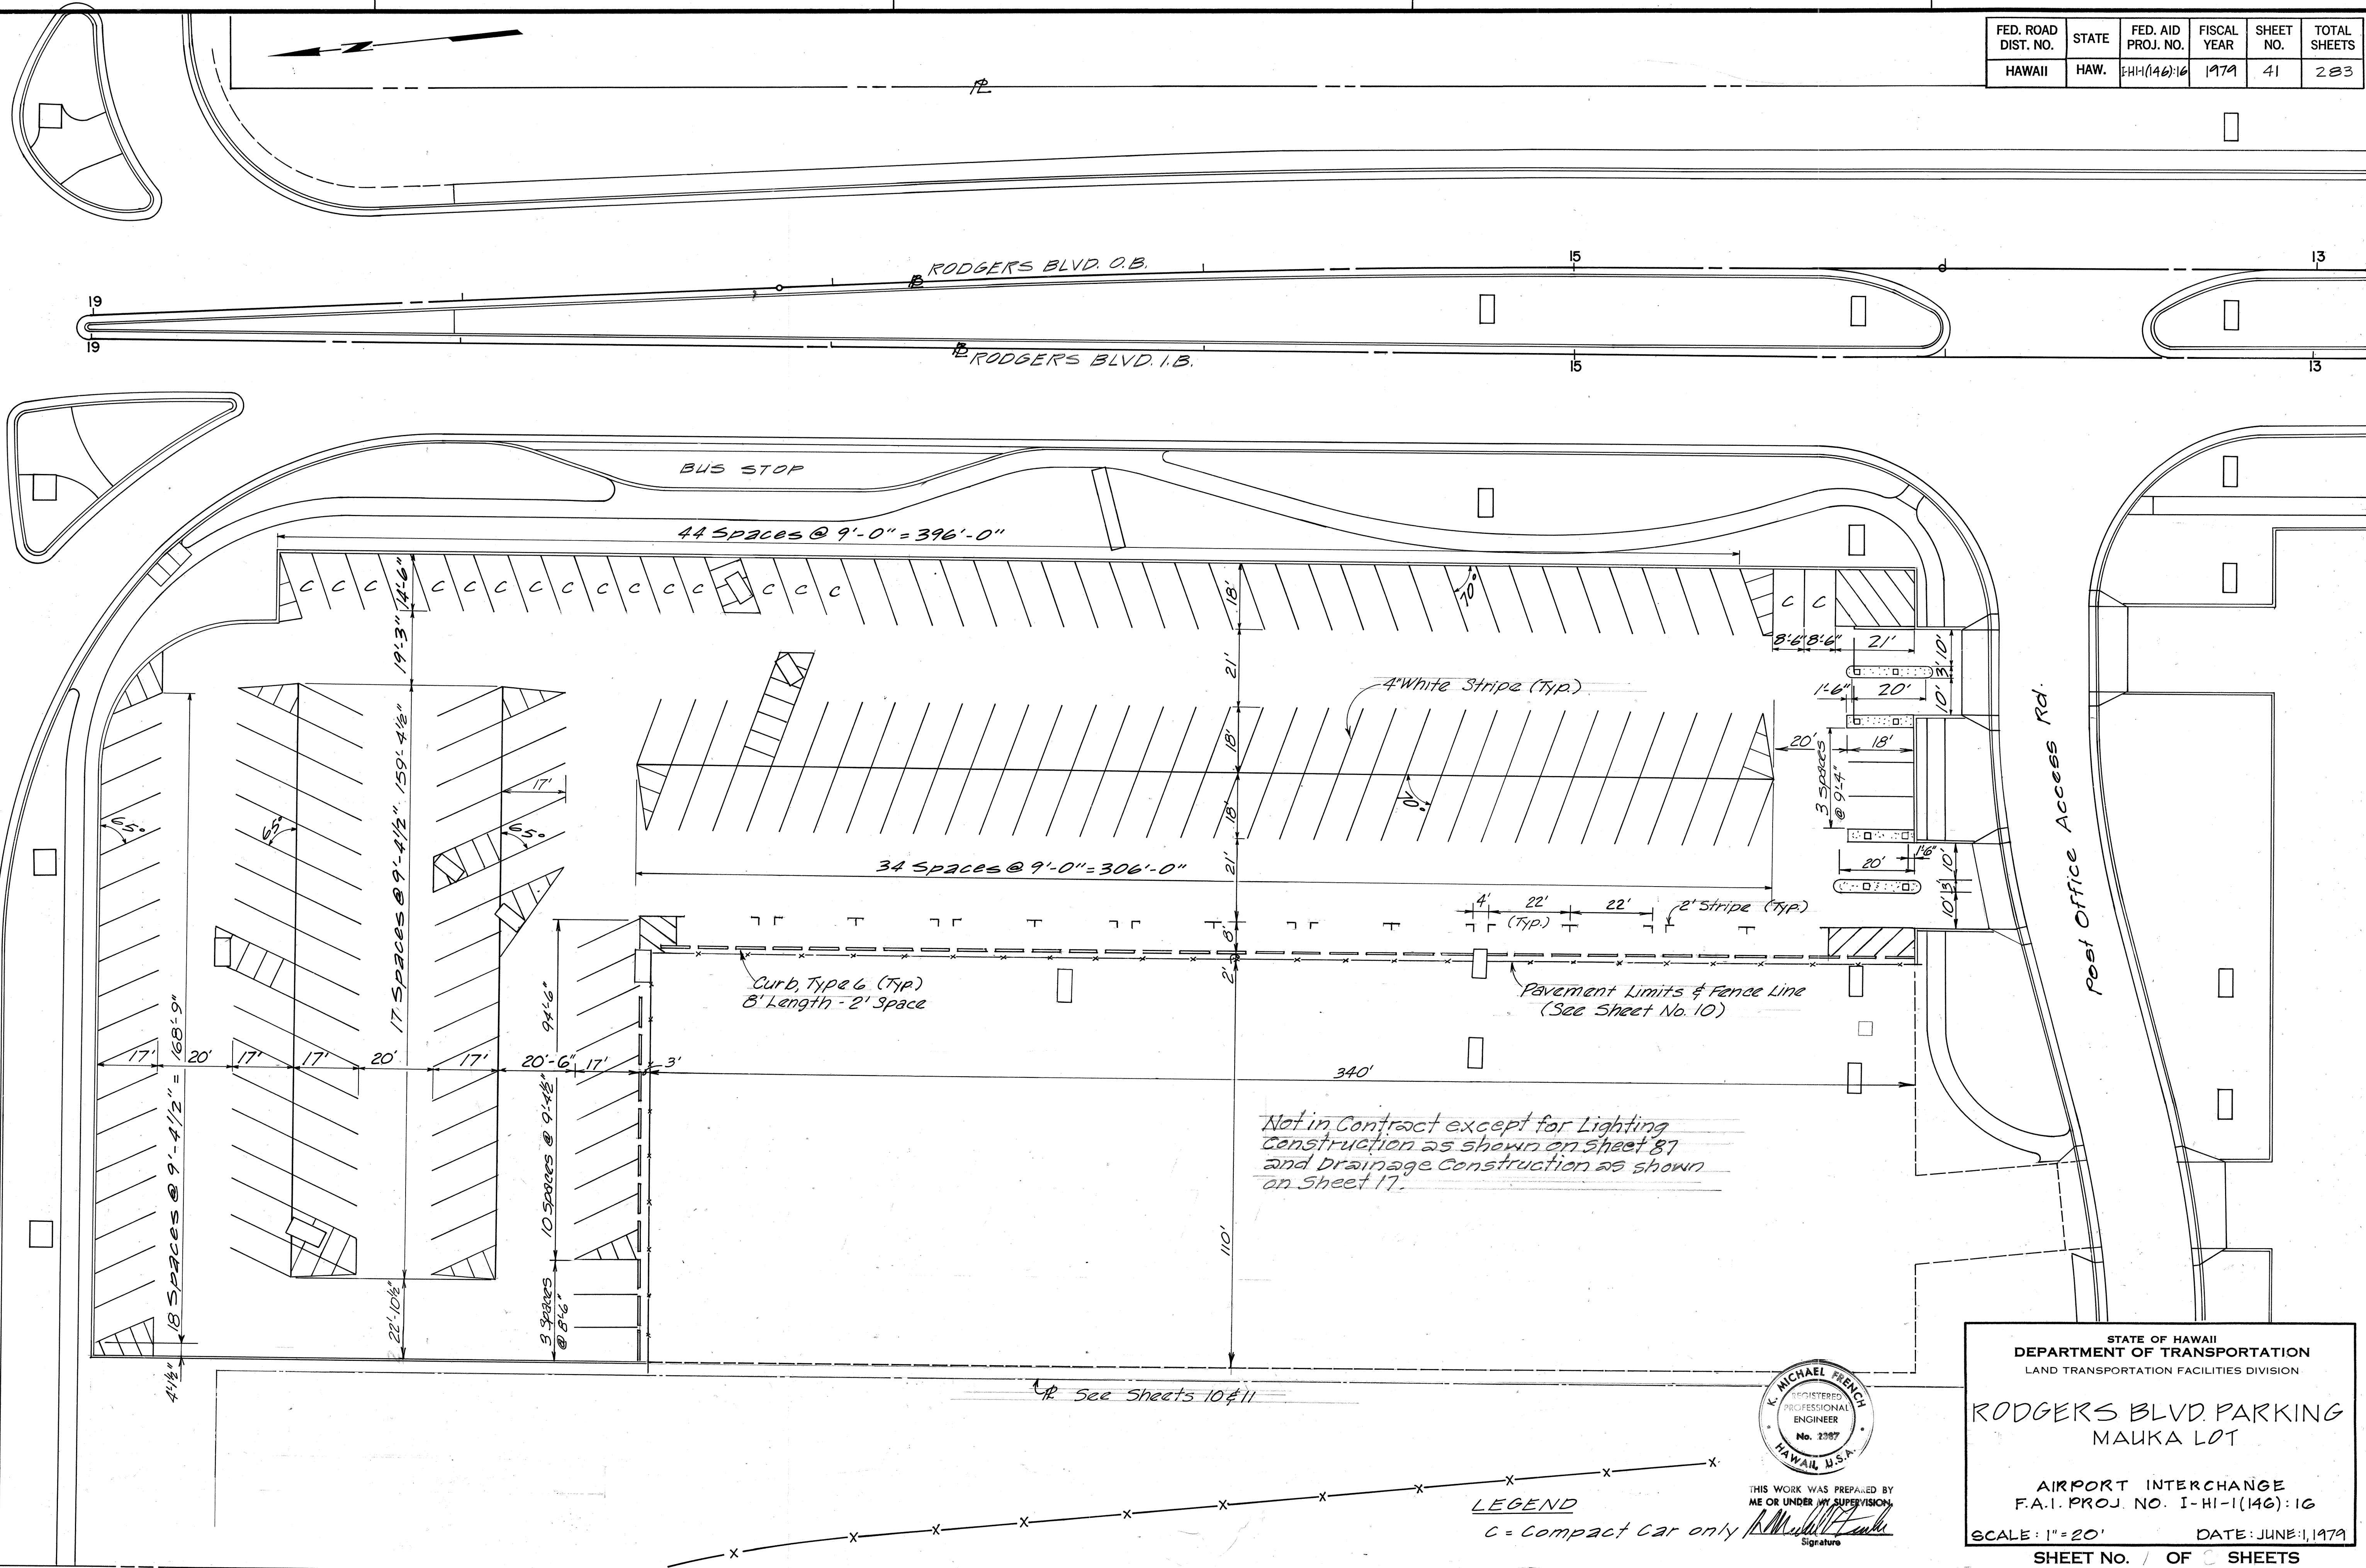

|               |                   |      |
|---------------|-------------------|------|
| ORIGINAL PLAN | SURVEY PLOTTED BY | DATE |
| NOTE BOOK     | DRAWN BY          |      |
|               | DESIGNED BY       |      |
|               | QUANTITIES BY     |      |
|               | CHECKED BY        |      |
| No.           |                   |      |

STATE OF HAWAII  
DEPARTMENT OF TRANSPORTATION  
LAND TRANSPORTATION FACILITIES DIVISION


RODGERS BLVD. PARKING  
MAUKA LOT

AIRPORT INTERCHANGE  
F.A.I. PROJ. NO. I-HI-1(146)-16

SCALE: 1" = 20' DATE: JUNE 1, 1979

SHEET NO. 41 OF 283 SHEETS

| FED. ROAD<br>DIST. NO. | STATE | FED. AID<br>PROJ. NO. | FISCAL<br>YEAR | SHEET<br>NO. | TOTAL<br>SHEETS |
|------------------------|-------|-----------------------|----------------|--------------|-----------------|
| HAWAII                 | HAW.  | 1-HI-1(46)-16         | 1979           | 42           | 283             |

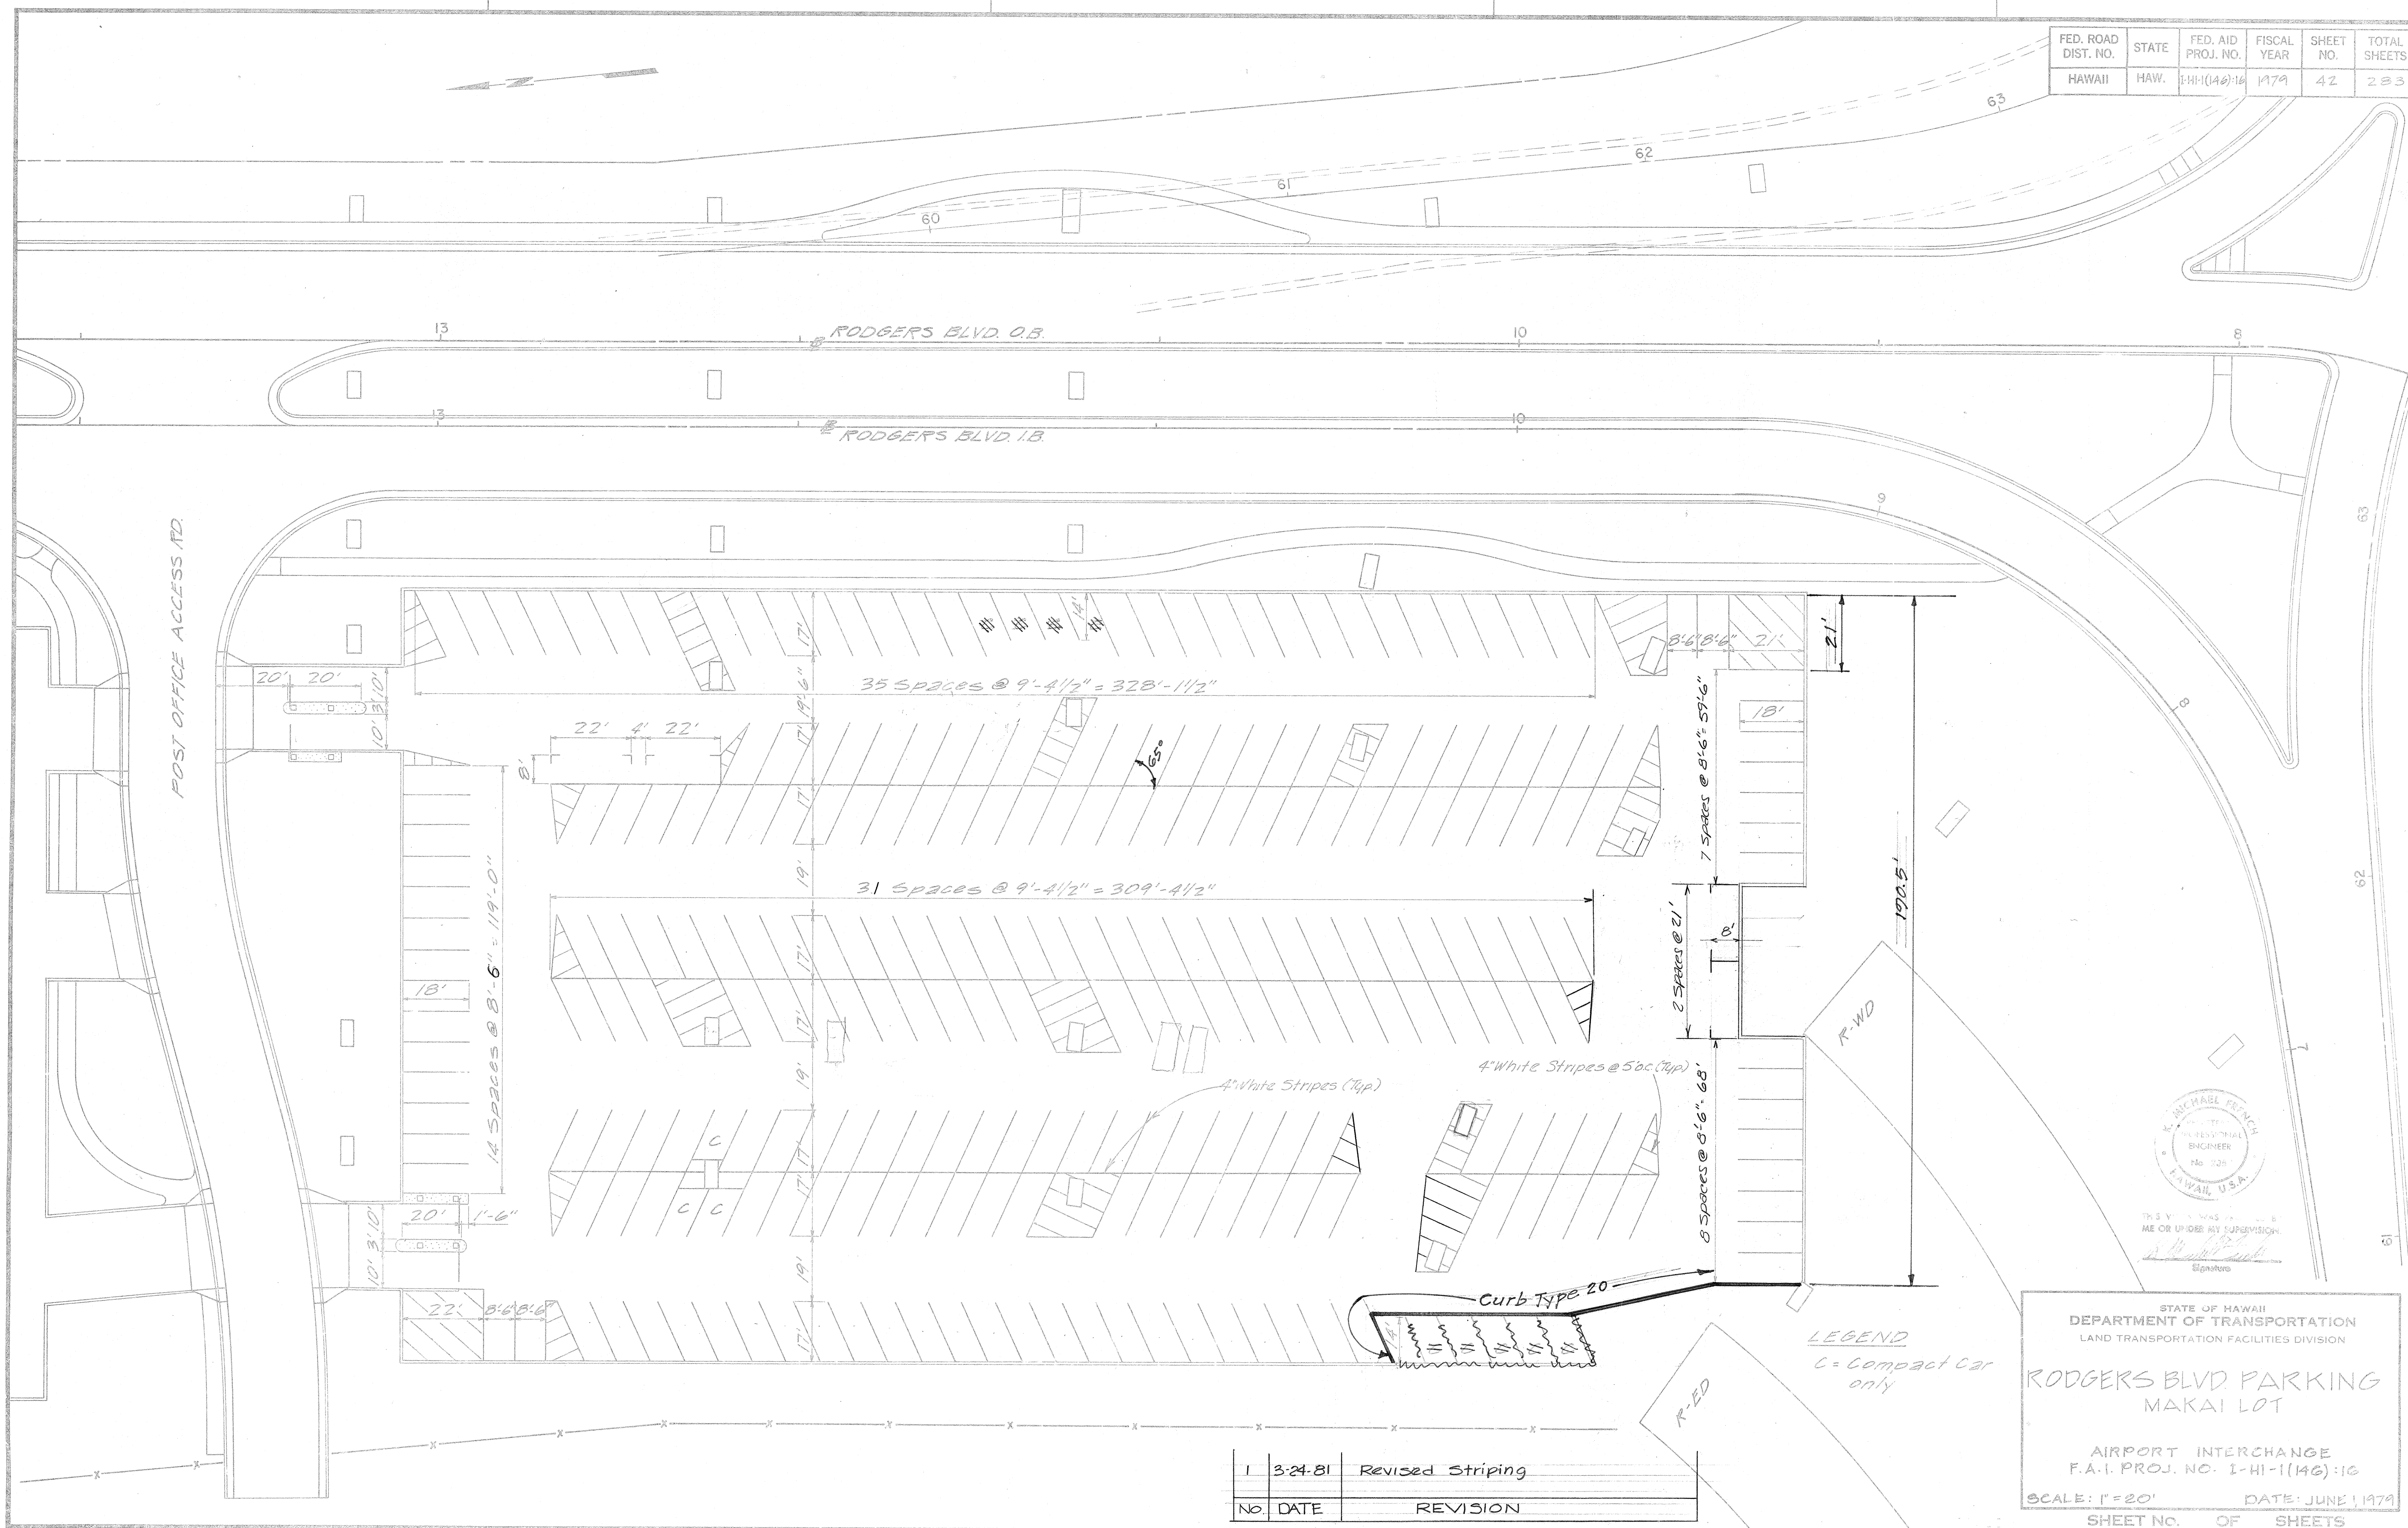

|     |         |                  |
|-----|---------|------------------|
| 1   | 3-24-81 | Revised Striping |
| No. | DATE    | REVISION         |

STATE OF HAWAII  
DEPARTMENT OF TRANSPORTATION  
LAND TRANSPORTATION FACILITIES DIVISION



RODGERS BLVD PARKING  
MAKAI LOT

AIRPORT INTERCHANGE  
F.A.I. PROJ. NO. I-HI-1(146)-1G


SCALE: 1"=20' DATE: JUNE 1 1979

SHEET NO. OF SHEETS

| FED. ROAD DIST. NO. | STATE | FED. AID PROJ. NO. | FISCAL YEAR | SHEET NO. | TOTAL SHEETS |
|---------------------|-------|--------------------|-------------|-----------|--------------|
| HAWAII              | HAW.  | EH-1(146)16        | 1979        | 43        | 283          |

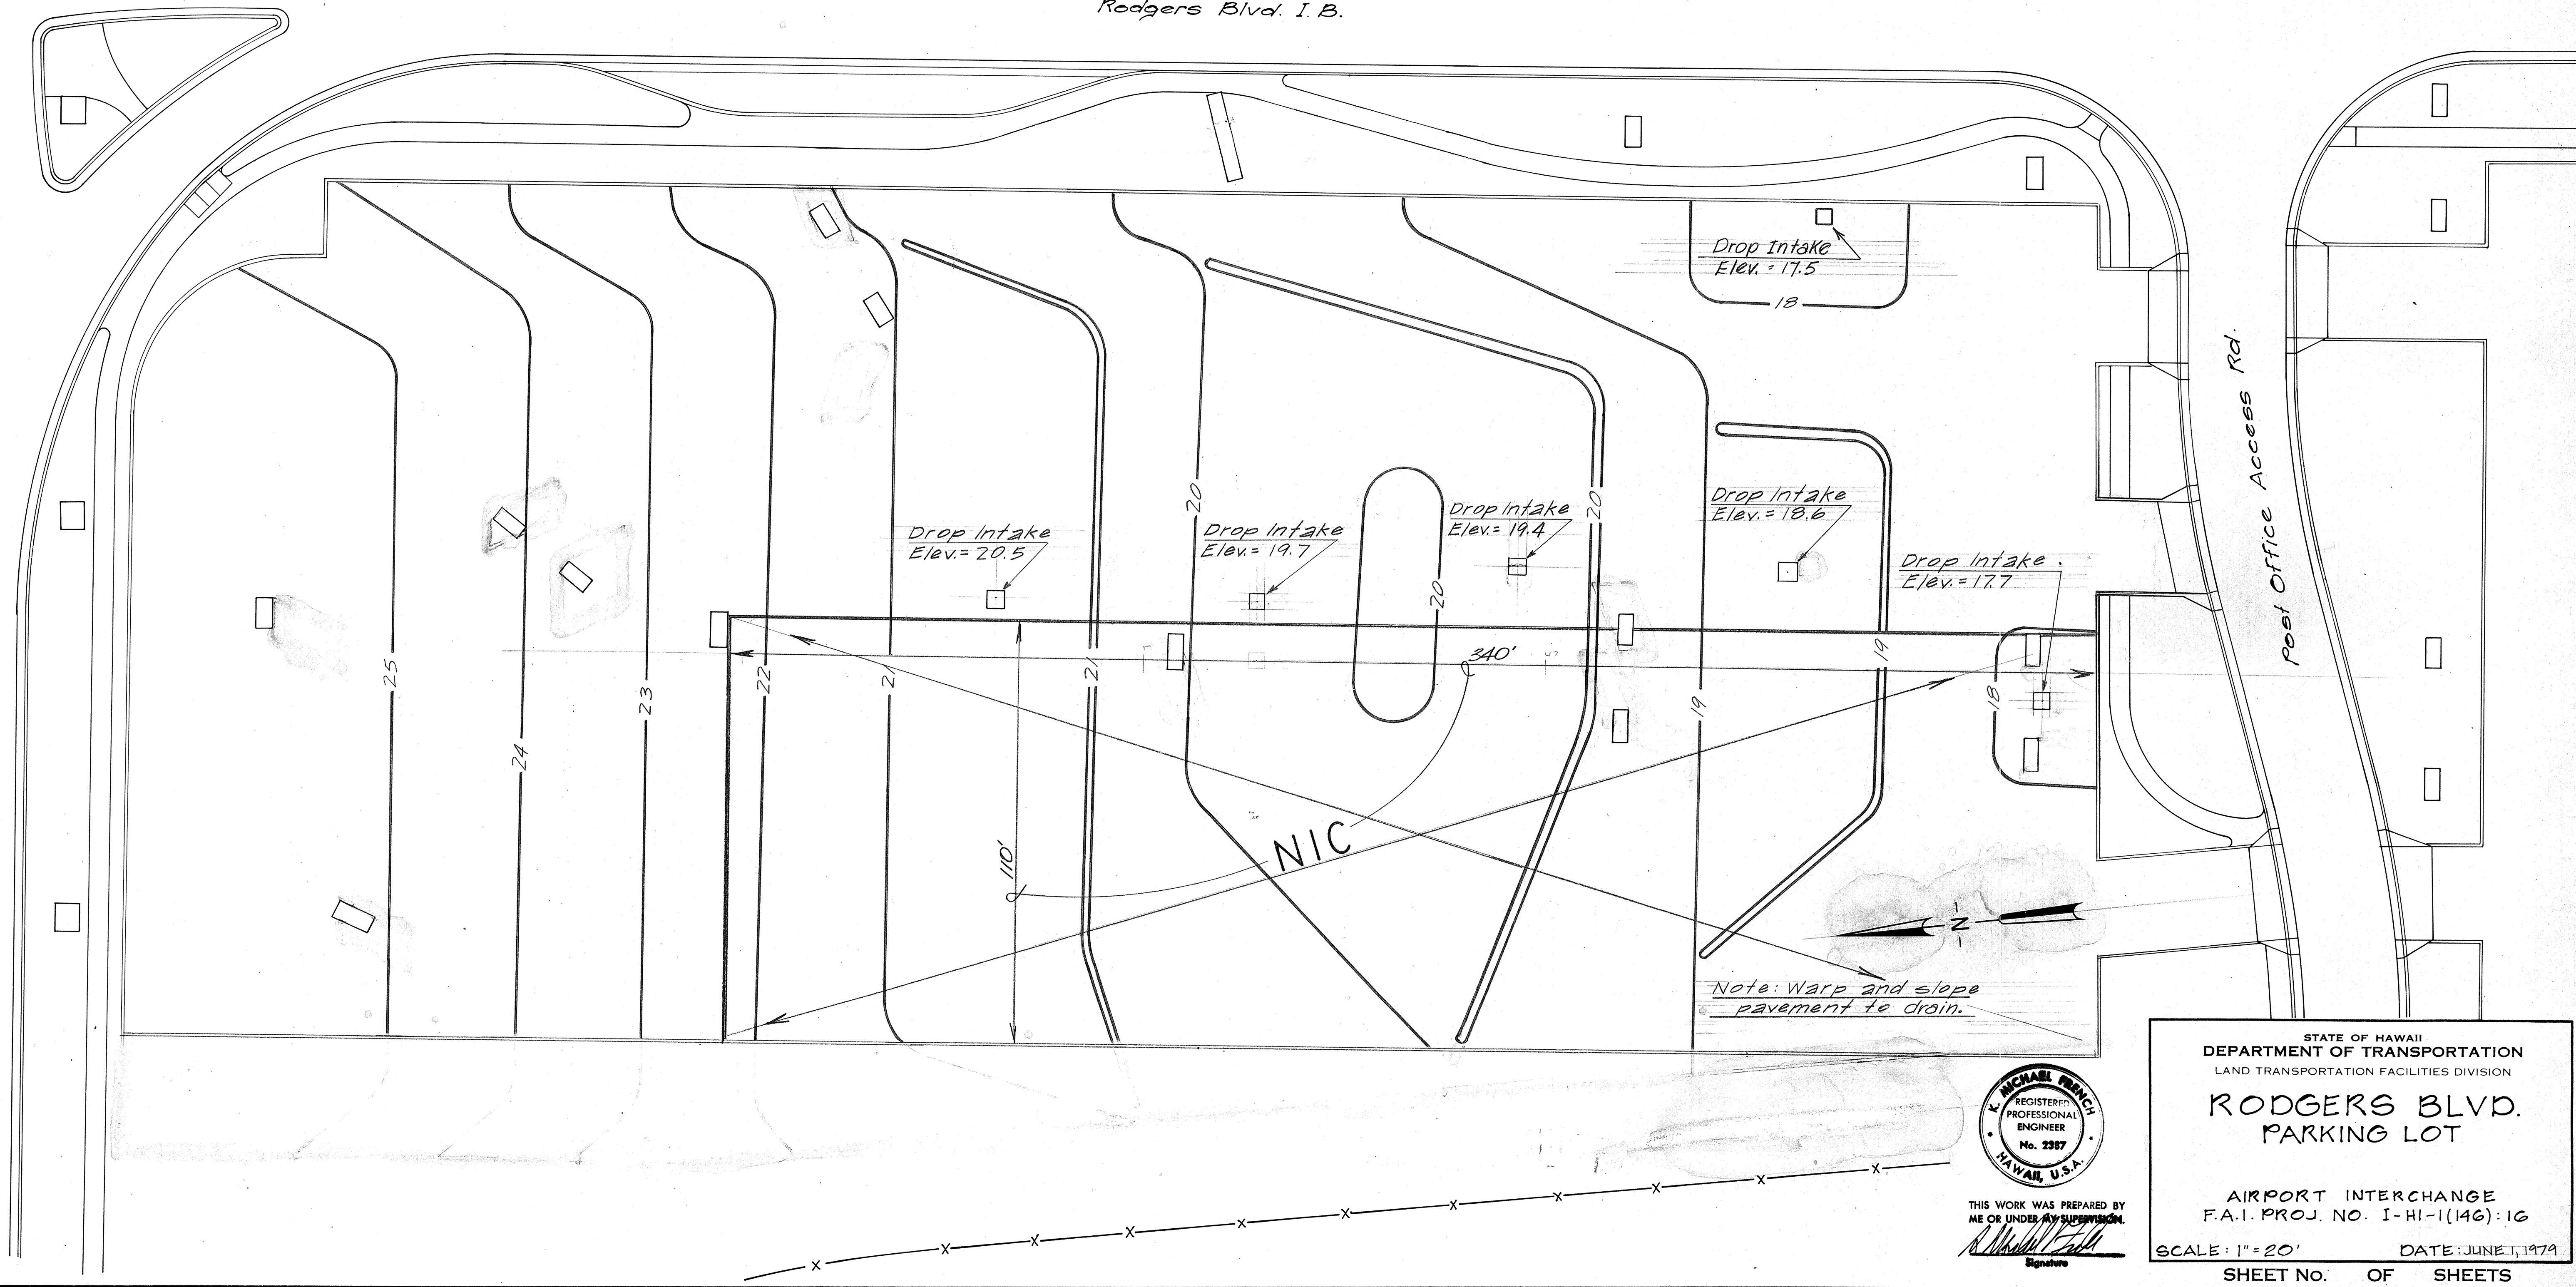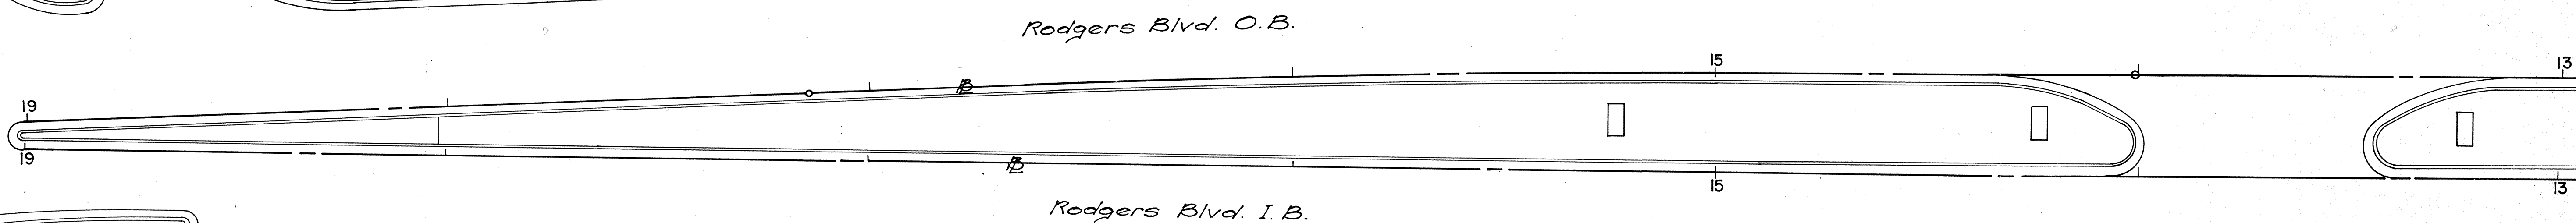

|                   |      |
|-------------------|------|
| ORIGINAL PLAN     | DATE |
| SURVEY PLOTTED BY |      |
| DESIGNED BY       |      |
| QUANTITIES BY     |      |
| CHECKED BY        |      |

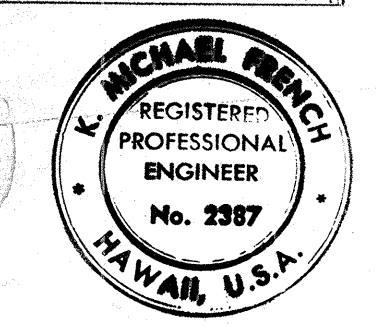

THIS WORK WAS PREPARED BY ME OR UNDER MY SUPERVISION.  
*[Signature]*  
 Signature

STATE OF HAWAII  
 DEPARTMENT OF TRANSPORTATION  
 LAND TRANSPORTATION FACILITIES DIVISION

**RODGERS BLVD.  
 PARKING LOT**



AIRPORT INTERCHANGE  
 F.A.I. PROJ. NO. I-HI-1(146):16

SCALE: 1" = 20'      DATE: JUNE 1, 1979

SHEET NO. 43 OF 43 SHEETS

| FED. ROAD DIST. NO. | STATE | FED. AID PROJ. NO. | FISCAL YEAR | SHEET NO. | TOTAL SHEETS |
|---------------------|-------|--------------------|-------------|-----------|--------------|
| HAWAII              | HAW.  | 1-HI-1(146):16     | 1979        | 44        | 283          |

|               |                   |      |
|---------------|-------------------|------|
| ORIGINAL PLAN | SURVEY PLOTTED BY | DATE |
| DRAWN BY      | DESIGNED BY       |      |
| NOTE BOOK     | CHECKED BY        |      |
| No.           |                   |      |

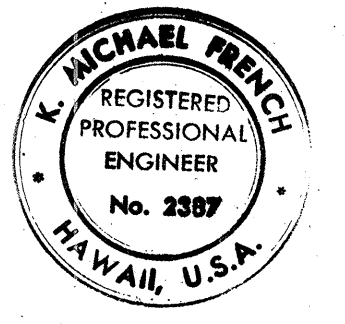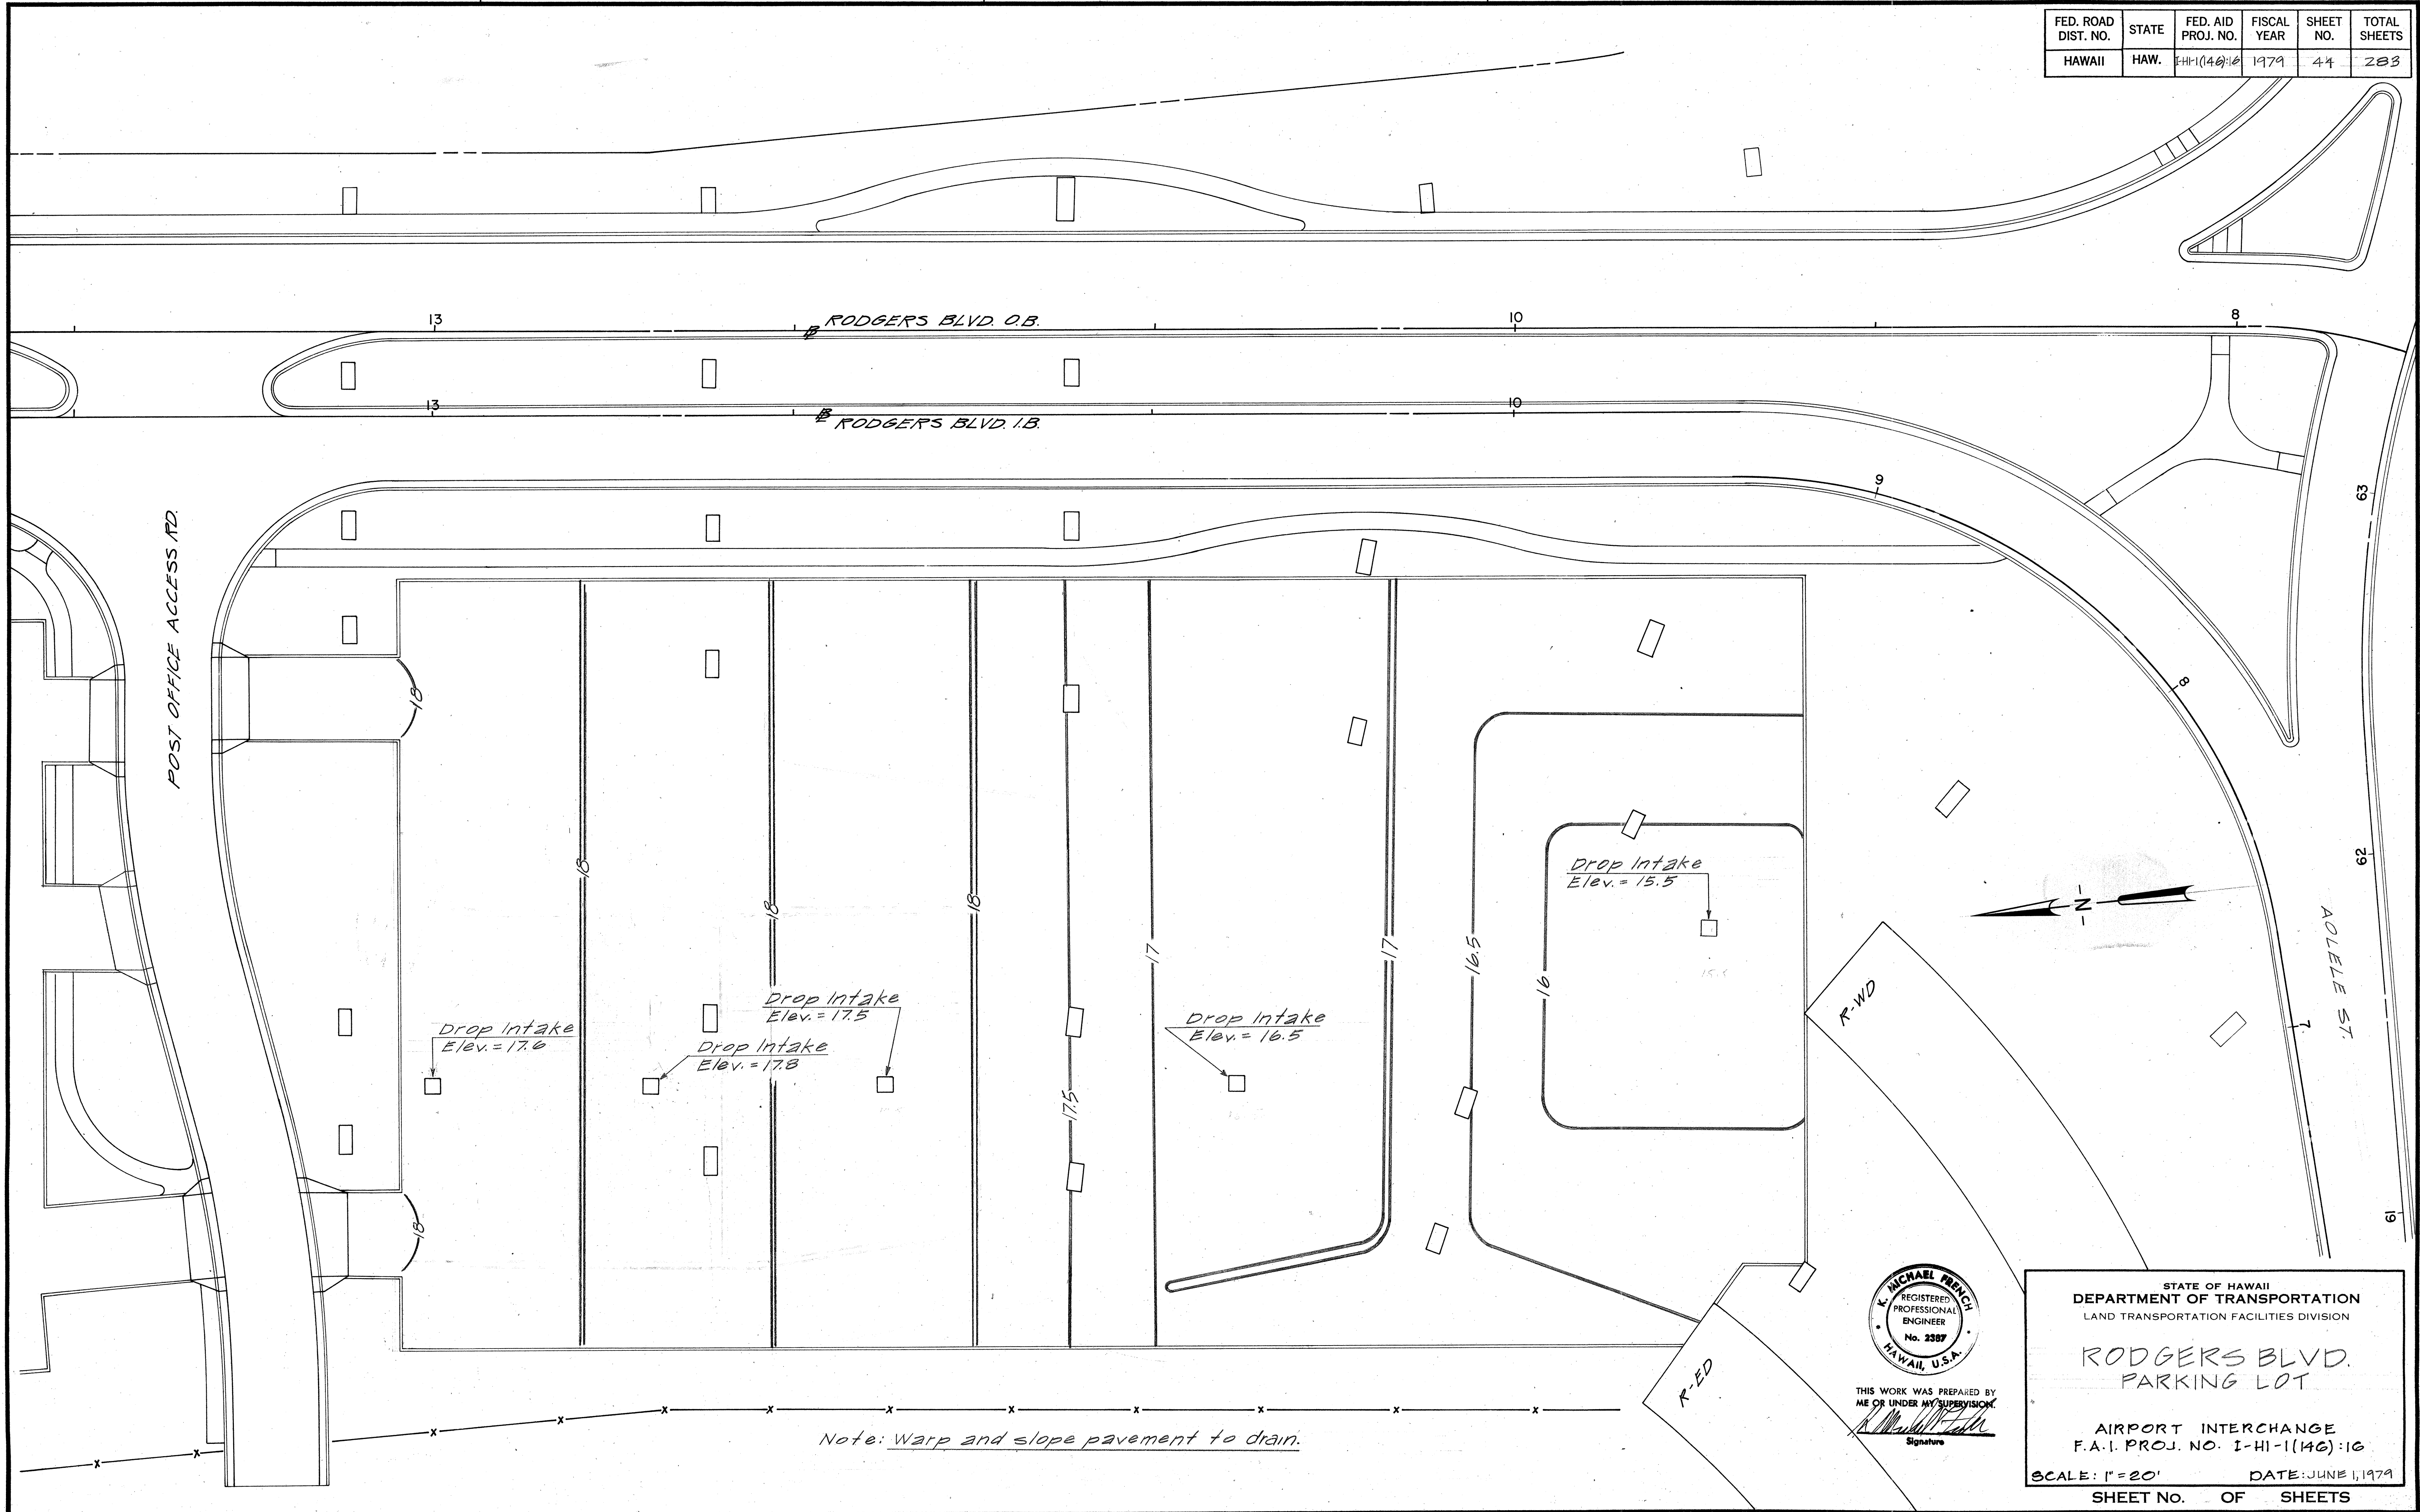

THIS WORK WAS PREPARED BY  
ME OR UNDER MY SUPERVISION  
Signature

STATE OF HAWAII  
DEPARTMENT OF TRANSPORTATION  
LAND TRANSPORTATION FACILITIES DIVISION  
  
RODGERS BLVD.  
PARKING LOT  
  
AIRPORT INTERCHANGE  
F.A.I. PROJ. NO. 1-HI-1(146):16  
SCALE: 1"=20' DATE: JUNE 1, 1979  
SHEET NO. 44 OF 44 SHEETS