


INDEX TO DRAWINGS	
SHEET NO	DESCRIPTION
1	TITLE
2	CONSTRUCTION PHASING
3-6	TYPICAL SECTIONS
7	MISCELLANEOUS DETAILS
8-12	GROUND LEVEL PLANS
13-14	GROUND LEVEL PROFILES
15	SCHEDULES
16-29	DRAINAGE
30-31	RODGERS BOULEVARD DETOUR
32-40	SIGNING AND STRIPING
41-44	RODGERS BOULEVARD PARKING
45-48	MISCELLANEOUS DETAILS
49-72	STANDARD DETAILS
73-83	UTILITIES
84-93	HIGHWAY LIGHTING
94-246	RAMP STRUCTURE PLANS
247-270	LANDSCAPING
271-283	CROSS SECTIONS
① C.O. 2A, ② IOS-1, ③ C.O. 37A, ④ ADD 65A, ⑤ ADD 243A, ADD 243B, ARE SUPPLEMENT SHEETS TO THE CONTRACT PLANS. NEW TOTAL = 289	

STATE OF HAWAII
DEPARTMENT OF TRANSPORTATION
HIGHWAY DIVISION
HONOLULU, HAWAII
"AS BUILT"
PLANS FOR
CONSTRUCTION OF A PORTION OF
INTERSTATE ROUTE H-1
AIRPORT INTERCHANGE
RODGERS BOULEVARD RAMPS WA/WD/WI
FEDERAL AID INTERSTATE PROJECT I-HI-1(146):16
DISTRICT OF HONOLULU
ISLAND OF OAHU

FED. ROAD DIST. NO.	STATE	FED. AID PROJ. NO.	FISCAL YEAR	SHEET NO.	TOTAL SHEETS
HAWAII	HAW.	I-HI-1(146):16	1979	1	283

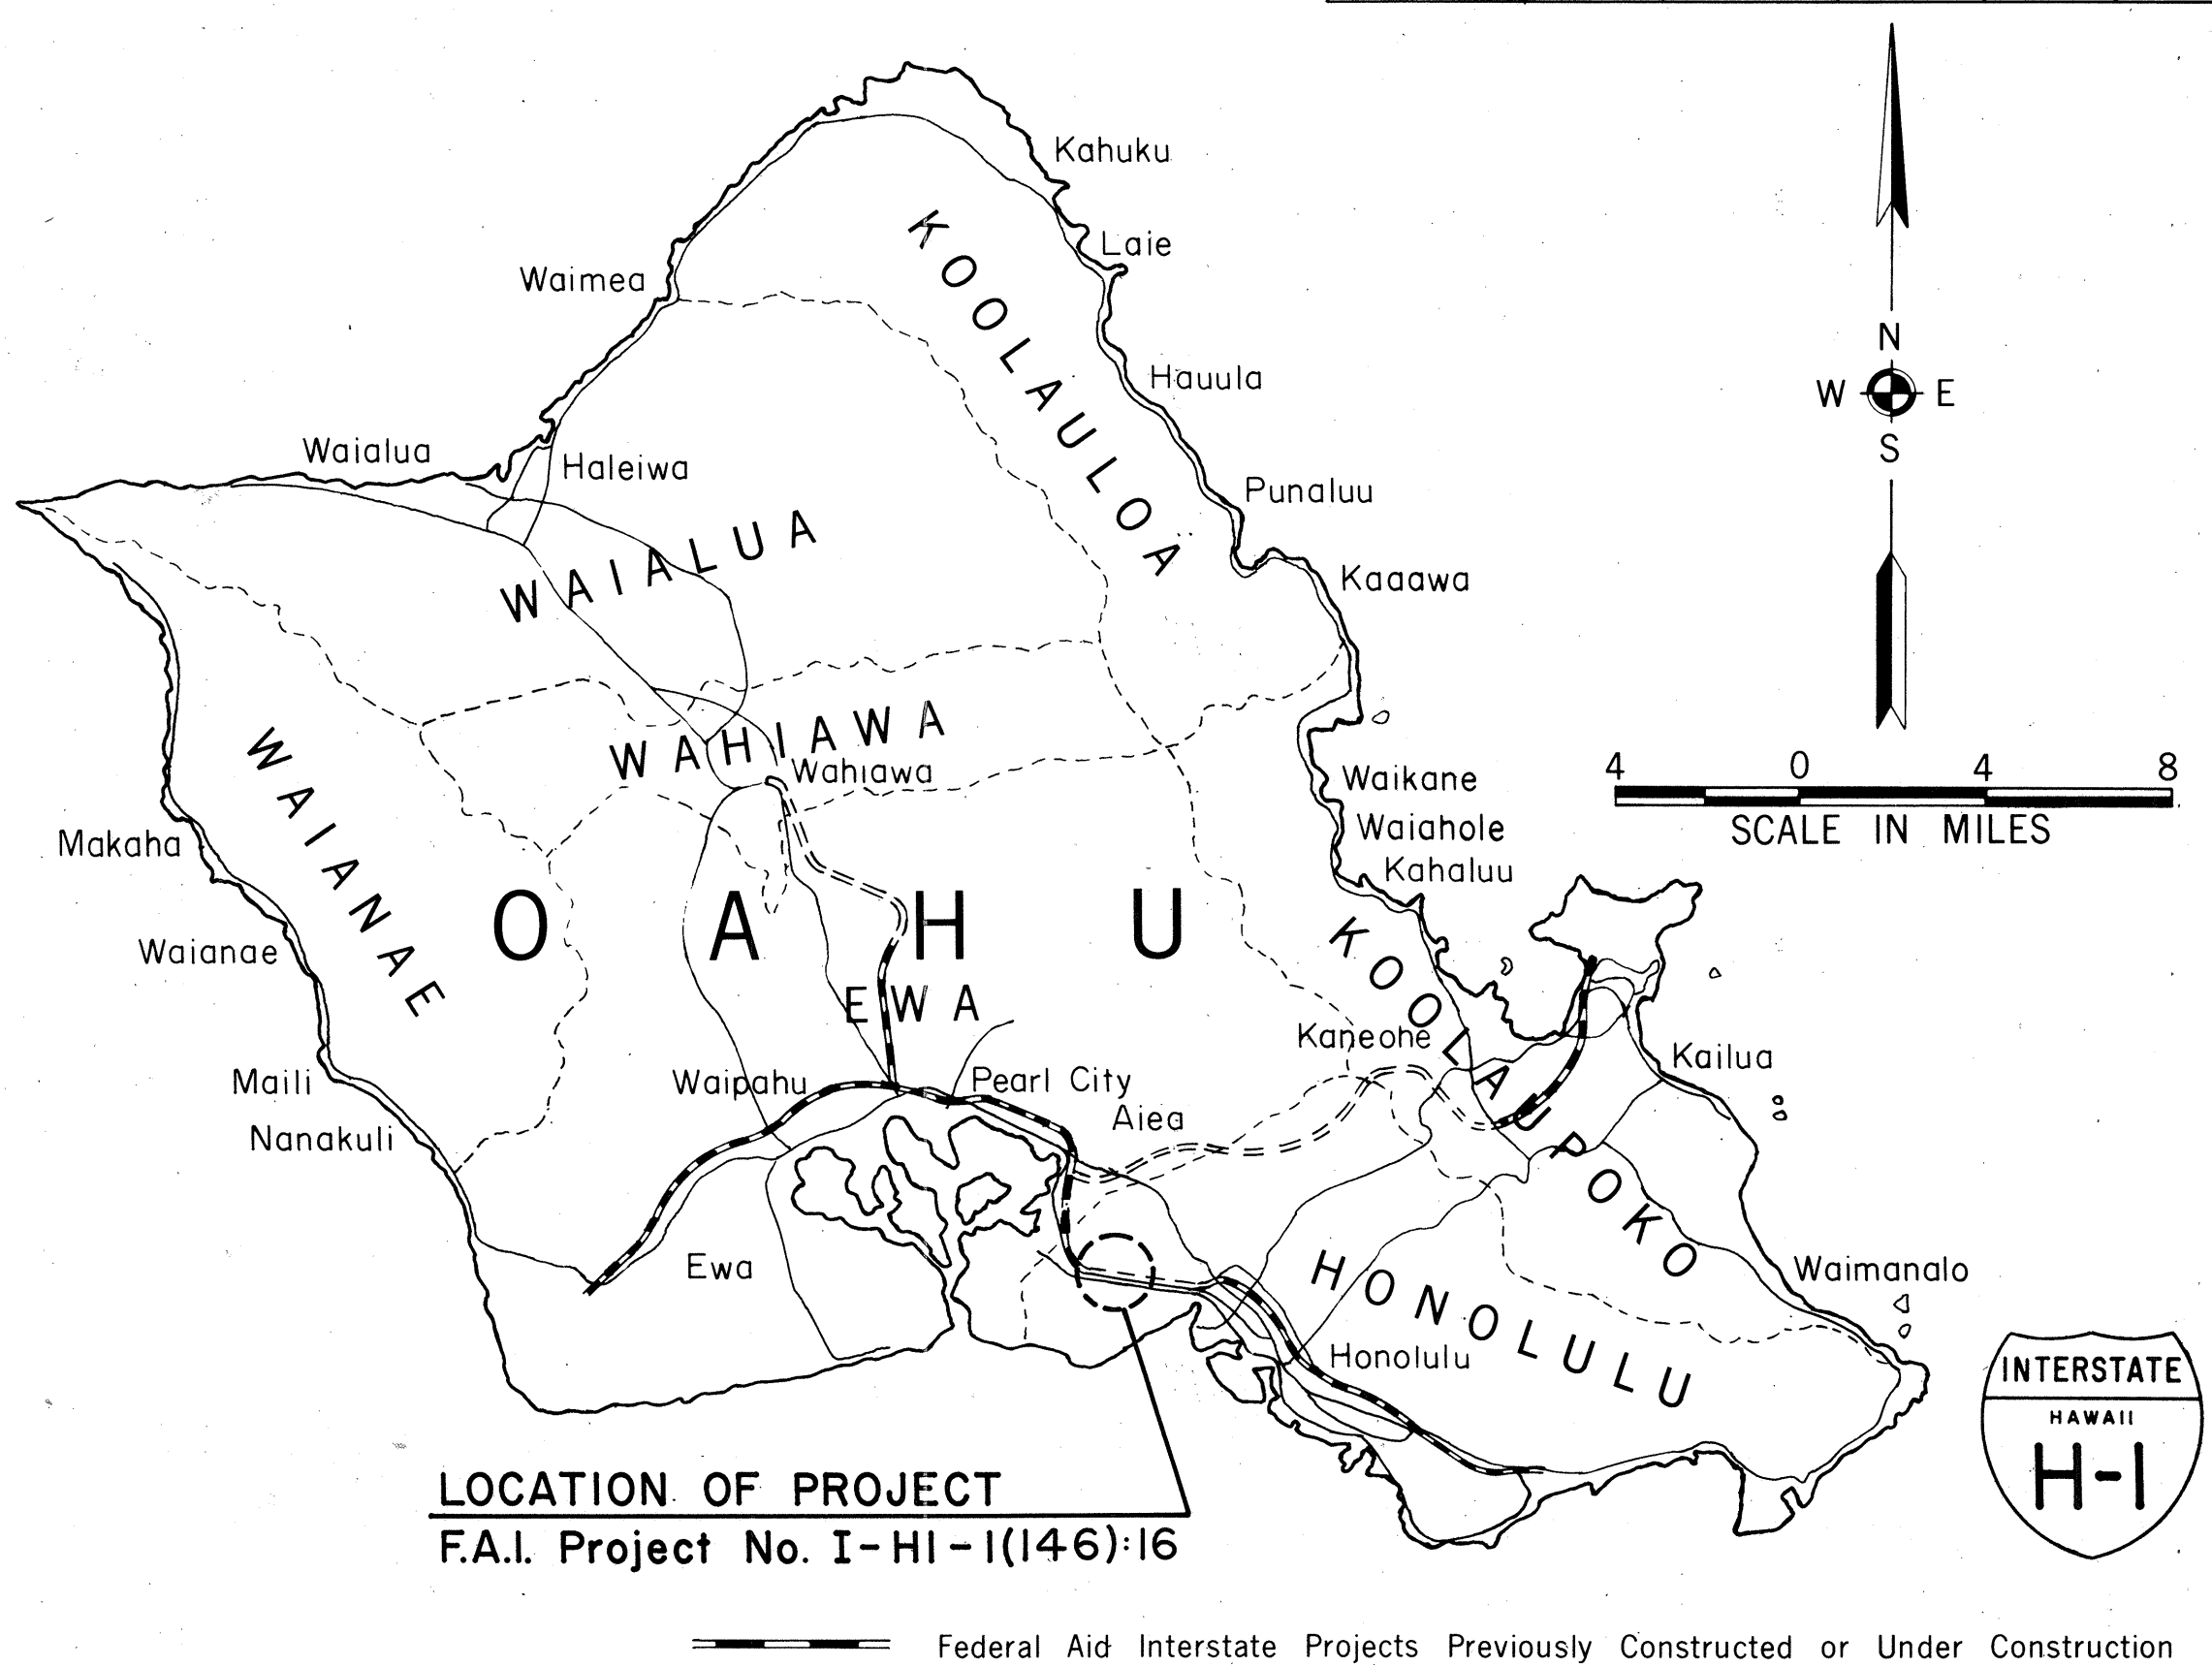

DESIGN CLASSIFICATION

DESIGN ADT (1994)	102,675
DHV	11%
D	60/40
T	5%
V	60 M.P.H.

SCALES:

PLANS	HOR.	1" = 50'
PROFILES	HOR.	1" = 50'
	VER.	1" = 10'
DETAIL ROADWAY PLANS	HOR.	1" = 20'
CROSS SECTIONS	HOR.	1" = 10'
	VER.	1" = 5'

CHANGES MADE DURING CONSTRUCTION HAVE BEEN INCORPORATED ON THESE PLANS EXCEPT CHANGES IN THE ORIGINAL THEORETICAL QUANTITIES. FOR ACTUAL QUANTITIES, REFER TO PROJECT LEDGER AND/OR COMPUTATION BOOK.

Robert Y. Munonaka
RESIDENT ENGINEER
11/29/84
DATE

DEPARTMENT OF TRANSPORTATION
FEDERAL HIGHWAY ADMINISTRATION
APPROVED: [Signature]
DIVISION ENGINEER
10-22-79
DATE

DEPARTMENT OF TRANSPORTATION
STATE OF HAWAII
APPROVED: [Signature]
DIR. OF TRANSPORTATION
DATE

